

OPERATION & MAINTENANCE MANUAL

DFI No.: D00033

Facility Type: Water Quality Manhole



FEBRUARY, 2011

INDEX

1. IDENTIFICATION 1

2. FACILITY CONTACT INFORMATION..... 1

3. CONSTRUCTION..... 1

4. STORM DRAIN SYSTEM AND FACILITY OVERVIEW 2

5. FACILITY HAZ MAT SPILL FEATURE(S)..... 4

6. AUXILIARY OUTLET 4

7. MAINTENANCE REQUIREMENTS 4

8. WASTE MATERIAL HANDLING 5

APPENDIX A: Operational Plan and Profile Drawing(s)

APPENDIX B: ODOT Project Plan Sheets

APPENDIX C: Proprietary Structure Maintenance Requirements

1. Identification

Drainage Facility ID (DFI): **D00033**

Facility Type: Water Quality Manhole

Construction Drawings: (V-File Number) 38V-117

Location: District: 3

Highway No.: 001

Mile Post: 252.19 (Beg. / End)

Description: This facility is located along the shoulder of the northbound travel lanes of I-5 (Hwy 001) between two bridge overcrossings; namely the Turner Road (Bridge No. 20032), and U.P.R.R. (Bridge No. 20026) overcrossings.

2. Facility Contact Information

Contact the Engineer of Record, Region Technical Center, or Geo-Environmental's Senior Hydraulics Engineer for:

- Operational clarification
- Maintenance clarification
- Repair or restoration assistance

Engineering Contacts:

Region Technical Center Hydro Unit Manager

Or

Geo-Environmental Senior Hydraulics Engineer (503) 986-3365.

3. Construction

Engineer of Record:

ODOT Designer – Region 2 Tech. Center, Chris Carman, P.E., 503-986-2691

Facility construction: 2005

Contractor: Hamilton Construction Company

4. Storm Drain System and Facility Overview

This water quality manhole is an underground facility designed to treat stormwater runoff. The system is a proprietary product manufactured by Contech Construction Products, Inc. This system is a CDS Model PMSU20_15_4 (2) and is designed to remove sediments, oils, and debris from the stormwater. Stormwater enters the diversion chamber where the diversion weir guides the flow into the unit's separation chamber and pollutants are removed from the runoff. This facility contains an Operational and Maintenance manual as prepared by the manufacturer and is provided in Appendix C.

This unit is designed to separate and trap debris, sediment, and oil and grease from stormwater runoff. Stormwater enters the diversion chamber where the diversion weir guides the flow into the unit's separation chamber and pollutants are removed from the runoff.

This particular facility is just over 17 feet in depth, it's inside diameter 48-inches, and it is located along the right shoulder of the northbound lanes of I-5 between a structure, crossing overtop Turner Road (bridge No. 20032), and another structure, crossing overtop the U.P.R.R. railway (bridge No. 20026). To date, the manhole has in been difficult to actually locate and has likely been buried beneath an asphalt preservation overlay; see photo 1.

This water quality manhole receives stormwater flow from two detention pipe facilities located to the west (D00036 and D00037). These two facilities collect runoff along I-5 (Hwy 001) between the bridge structures. The drainage area for the detention facilities includes the area from the southern end panel of the U.P.R.R. overcrossing to the southern end panel of the Turner Road overcrossing. After detention, the water is released into a 15-inch storm pipe that discharges into the water quality structure (Refer to both Photo 1 and Point A on the Operational Plan, Appendix A). After treatment, the flow is directed to the southeast an additional 77 feet via a 15-inch storm pipe. Another 18-inch storm pipe drains water to a ditch (Point B) that ultimately drains into Pringle Creek.

For further information and details regarding the system refer to Appendix A for the Operational Plan, Appendix B for the Construction/As-built Plans, and Appendix C for the Proprietary Structure Maintenance Requirements, regarding the water quality structure.



Photo 1: This photo depicts the location of the water quality manhole at the edge of the end panel of Bridge No. 20032.

A. Maintenance equipment access:

By plan this facility is located along a 12 foot shoulder of the northbound lanes of I-5. The width of the shoulder should provide adequate space to perform maintenance activities. To date, the manhole has in been difficult to actually locate and has likely been buried beneath an asphalt preservation overlay; see photo 1.

B. Heavy equipment access into facility:

- Allowed (no limitations)
- Allowed (with limitations)
- Not allowed

C. Special Features:

- Amended Soils
- Porous Pavers
- Liners
- Underdrains

5. Facility Haz Mat Spill Feature(s)

This water quality manhole facility does not have features to block liquid from draining from the manhole. However, the manhole's sump and the outlet pipes may provide some storage capacity for hazardous liquids. It may be possible to block the 18-inch outfall pipe downstream from the manhole and store a volume of hazardous liquids between the water quality manhole and the outfall. This pipe outfall is noted as Point B in the Operational Plan.

6. Auxiliary Outlet

Auxiliary Outlets are provided if the primary outlet control structure can not safely pass the projected high flows. Broad-crested spillway weirs and over flow risers are the two most common auxiliary outlets used in stormwater treatment facility design. The auxiliary outlet feature is either a part of the facility or an additional storm drain feature/structure.

The auxiliary outlet feature for this facility is:

Designed into facility

High flows bypass the treatment features and exit the manhole by draining into an interior high flow bypass weir. See Appendix C.

Other, as noted below

7. Maintenance Requirements

Routine maintenance table for non-proprietary stormwater treatment and storage/detention facilities have been incorporated into ODOT's Maintenance Guide. These tables summarize the maintenance requirements for ponds, swales, filter strips, bioslopes, and detention tanks and vaults. Special maintenance requirements in addition to the routine requirements are noted below when applicable.

The ODOT Maintenance Guide can be viewed at the following website:

<http://www.oregon.gov/ODOT/HWY/OOM/MGuide.shtml>

Maintenance requirements for proprietary structures, such as underground water quality manholes and/or vaults with filter media are noted in Appendix C when applicable.

The following stormwater facility maintenance table (See ODOT Maintenance Guide) should be used to maintain the facility outlined in this Operation and Maintenance Manual or follow the Maintenance

requirements outlined in Appendix C when proprietary structure is selected below:

- Table 1 (general maintenance)
- Table 2 (stormwater ponds)
- Table 3 (water quality biofiltration swales)
- Table 4 (water quality filter strips)
- Table 5 (water quality bioslopes)
- Table 6 (detention tank)
- Table 7 (detention vault)
- Appendix C (proprietary structure)
- Special Maintenance requirements:
See Appendix C and the Proprietary Structure Maintenance Requirements for an O&M Manual specifically written for the water quality structure.

Note: Special maintenance Requirements Require Concurrence from ODOT SR Hydraulics Engineer.

8. Waste Material Handling

Material removed from the facility is defined as waste by DEQ. Refer to the roadwaste section of the ODOT Maintenance Yard Environmental Management System (EMS) Policy and Procedures Manual for disposal options: <http://egov.oregon.gov/ODOT/HWY/OOM/EMS.shtml>



Contact any of the following for more detailed information about management of waste materials found on site:

| | |
|-----------------------------------|----------------|
| ODOT Clean Water Unit | (503) 986-3008 |
| ODOT Statewide Hazmat Coordinator | (503) 229-5129 |
| ODOT Region Hazmat Coordinator | (503) 986-2647 |
| ODEQ Northwest Region Office | (503) 229-5263 |

Appendix A


Content:

- **Operational Plan and Profile Drawing(s)**

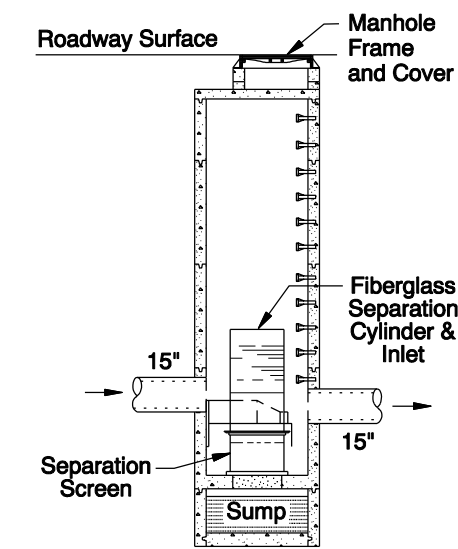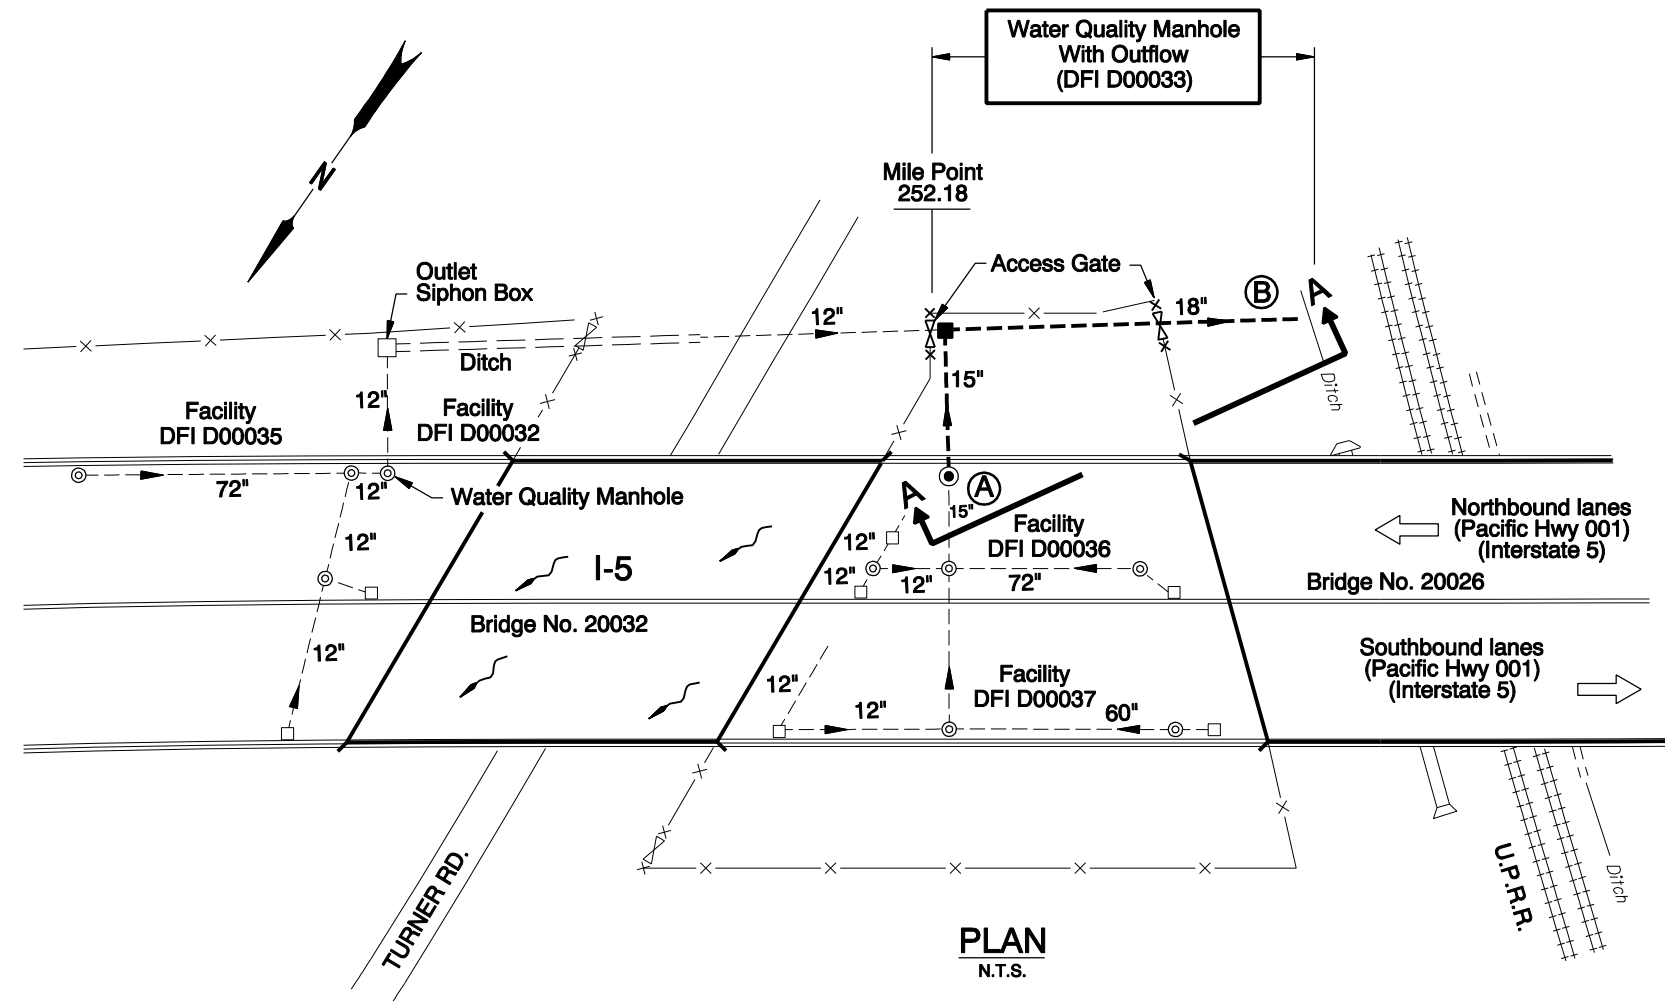

WATER QUALITY MANHOLE - CDS UNIT
N.T.S.

- LEGEND:**
- (A) Water Quality Manhole
 - (B) Outfall
 - and ○ Manhole
 - and □ Inlet
 - x-x-x Access Gate
 - - - Storm Pipe (Facility)
 - - - Storm Pipe
 - ← Conveyance Direction
 - ~ Pavement / Facility Flow Path

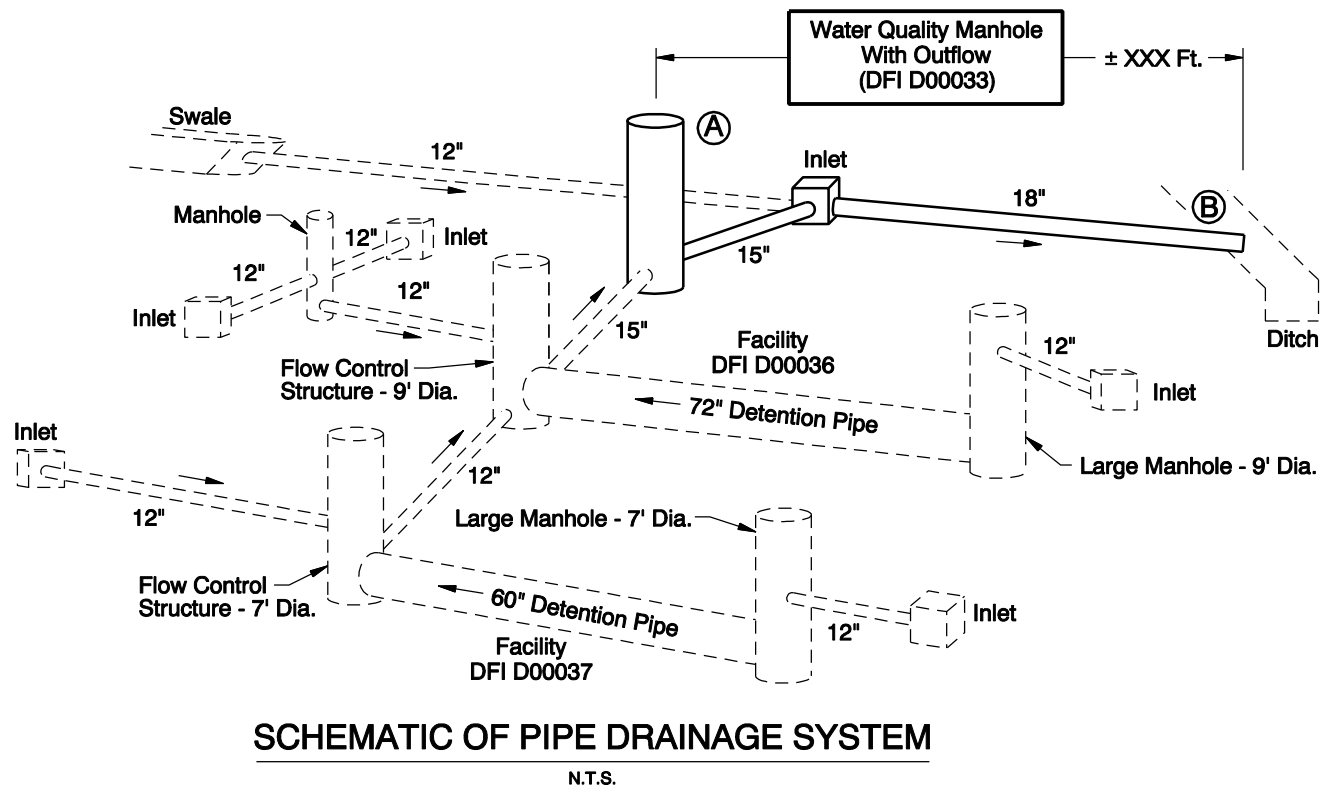

SCHEMATIC OF PIPE DRAINAGE SYSTEM
N.T.S.

Sht. 1 of 1 OREGON DEPARTMENT OF TRANSPORTATION

Prepared By: Bob Knorr
Drafted By: Jim Holeman

DFI D00033
MAINTENANCE DISTRICT 3 HWY 1
WATER QUALITY MANHOLE
PACIFIC HIGHWAY MP 252.18
MARION COUNTY

Appendix B

Content:

- **ODOT Project Plan Sheets**
 - *Cover/Title Sheet*
 - *Water Quality/Detention Plan Sheets*
 - *Other Details*

| INDEX OF SHEETS | |
|-----------------|-------------------------|
| SHEET NO. | DESCRIPTION |
| 1 | Title Sheet |
| 1A | Index Of Sheets Cont'd. |
| 1A-2 | Index Of Sheets Cont'd. |
| 1A-3 | Index Of Sheets Cont'd. |
| 1A-4 | Standard Drawing Nos. |
| 1B | Layout Sheet |

STATE OF OREGON
DEPARTMENT OF TRANSPORTATION

PLANS FOR PROPOSED PROJECT


GRADING, DRAINAGE, STRUCTURES, PAVING, SIGNING,
ILLUMINATION, SIGNALS & ROADSIDE DEVELOPMENT

**I-5: N. SANTIAM HWY. -
KUEBLER BLVD. (SALEM) SEC.**

PACIFIC HIGHWAY

MARION COUNTY


OCTOBER 2005

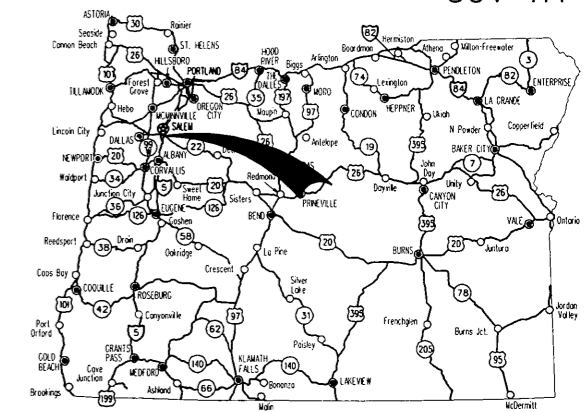

Overall Length Of Project - 4.02 km (2.49 Miles)

ATTENTION:
Oregon Law Requires You To Follow Rules Adopted By The Oregon Utility Notification Center. Those Rules Are Set Forth In OAR 952-001-0010 Through OAR 952-001-0090. You May Obtain Copies Of The Rules By Calling The Center. (Note: The Telephone Number For The Oregon Utility Center Is (503) 232-1987.)

OTIA-NH-IM-S001(196)
BEGINNING OF PROJECT
STA. "L" 10+280 (M.P. 254.58)

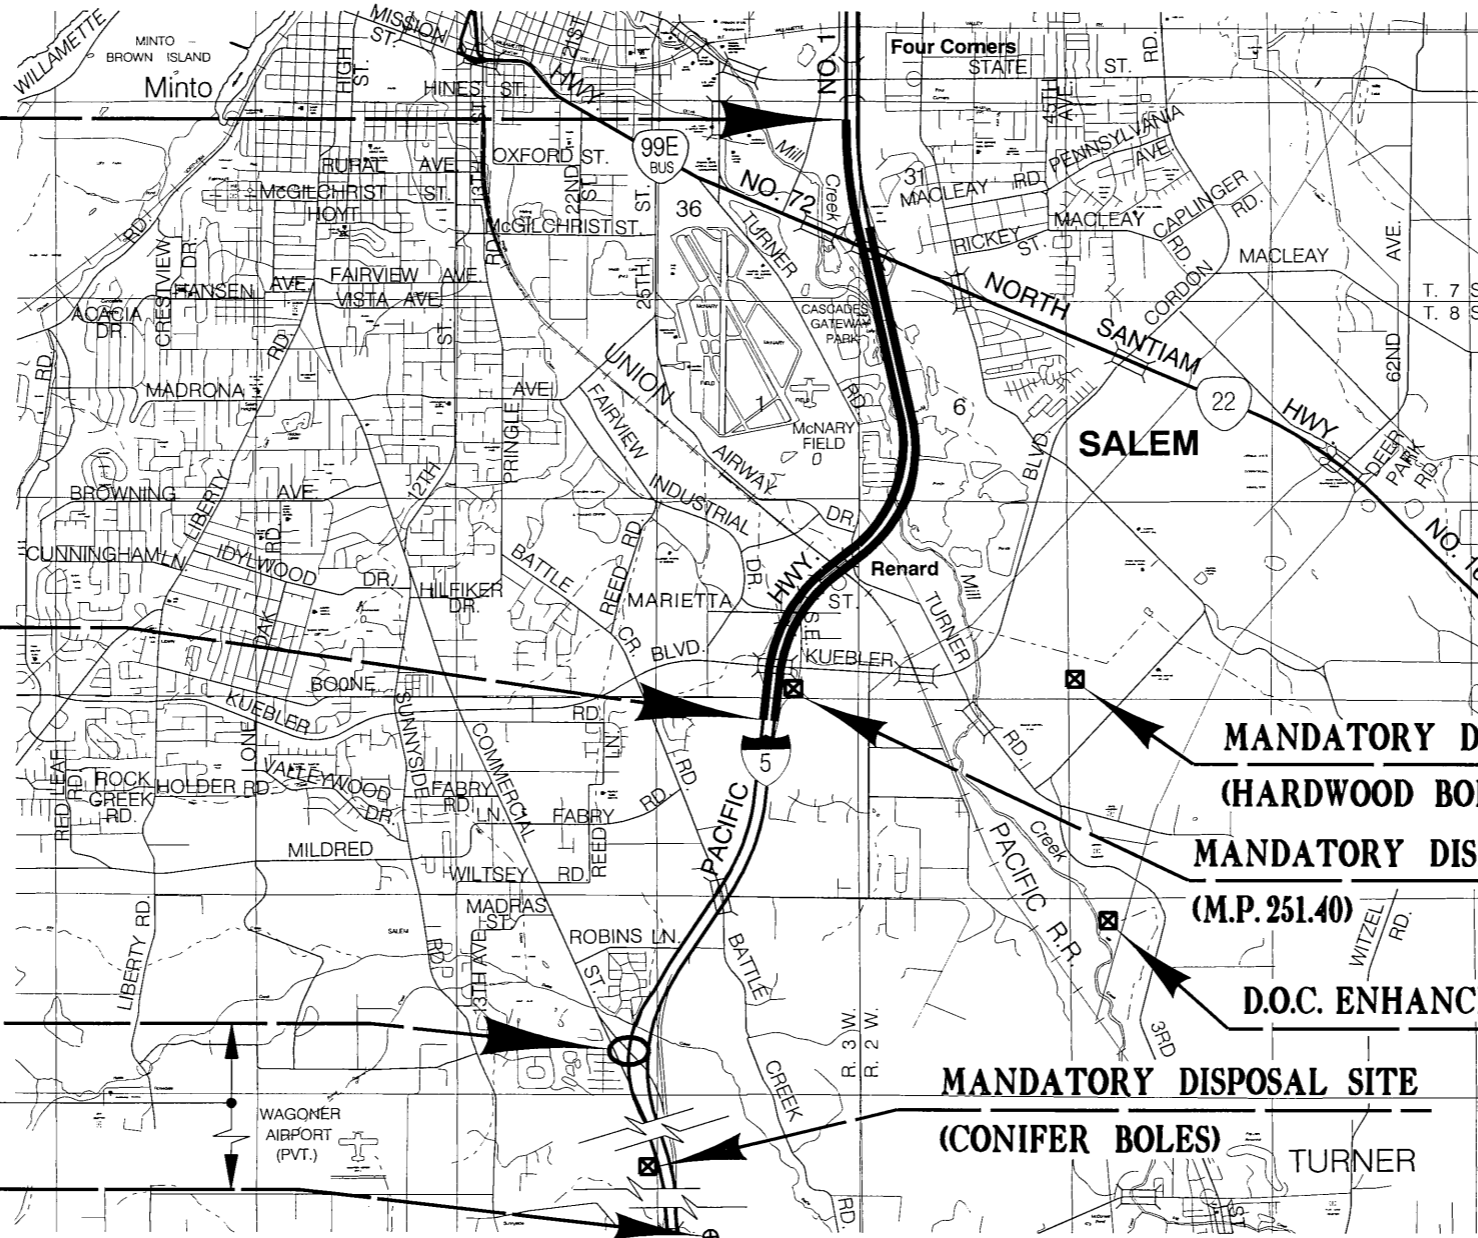

END OF WORK AREA
STA. "L" 15+682.3 (M.P. 251.22)

NO WORK AREA


OTIA-NH-IM-S001(196)
END OF PROJECT
STA. "LS" 18+664.61 (M.P. 249.38)

Approx. 28 Mi. South

PROSPECTIVE MATERIAL SOURCE
(M.P. 221.13)




LET'S ALL
WORK TOGETHER
TO MAKE THIS
JOB SAFE

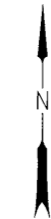

T. 7, 8 S.,
R. 2, 3 W., W.M.

OREGON TRANSPORTATION COMMISSION

- | | |
|-------------------|----------------------------|
| Stuart Foster | CHAIRMAN |
| Gail L. Achterman | COMMISSIONER |
| Mike Nelson | COMMISSIONER |
| Randall Papé | COMMISSIONER |
| Janice J. Wilson | COMMISSIONER |
| Bruce A. Warner | DIRECTOR OF TRANSPORTATION |

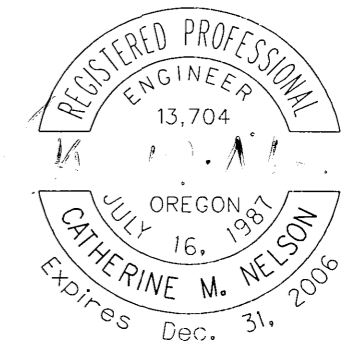


Catherine M. Nelson
TECHNICAL SERVICES MANAGING ENGINEER

**I-5: N. SANTIAM HWY. -
KUEBLER BLVD. (SALEM) SEC.**
PACIFIC HIGHWAY
MARION COUNTY

| | | |
|--------------------------------|----------------------|-----------|
| FEDERAL HIGHWAY ADMINISTRATION | PROJECT NUMBER | SHEET NO. |
| OREGON DIVISION | OTIA-NH-IM-S001(196) | 1 |



PE000950

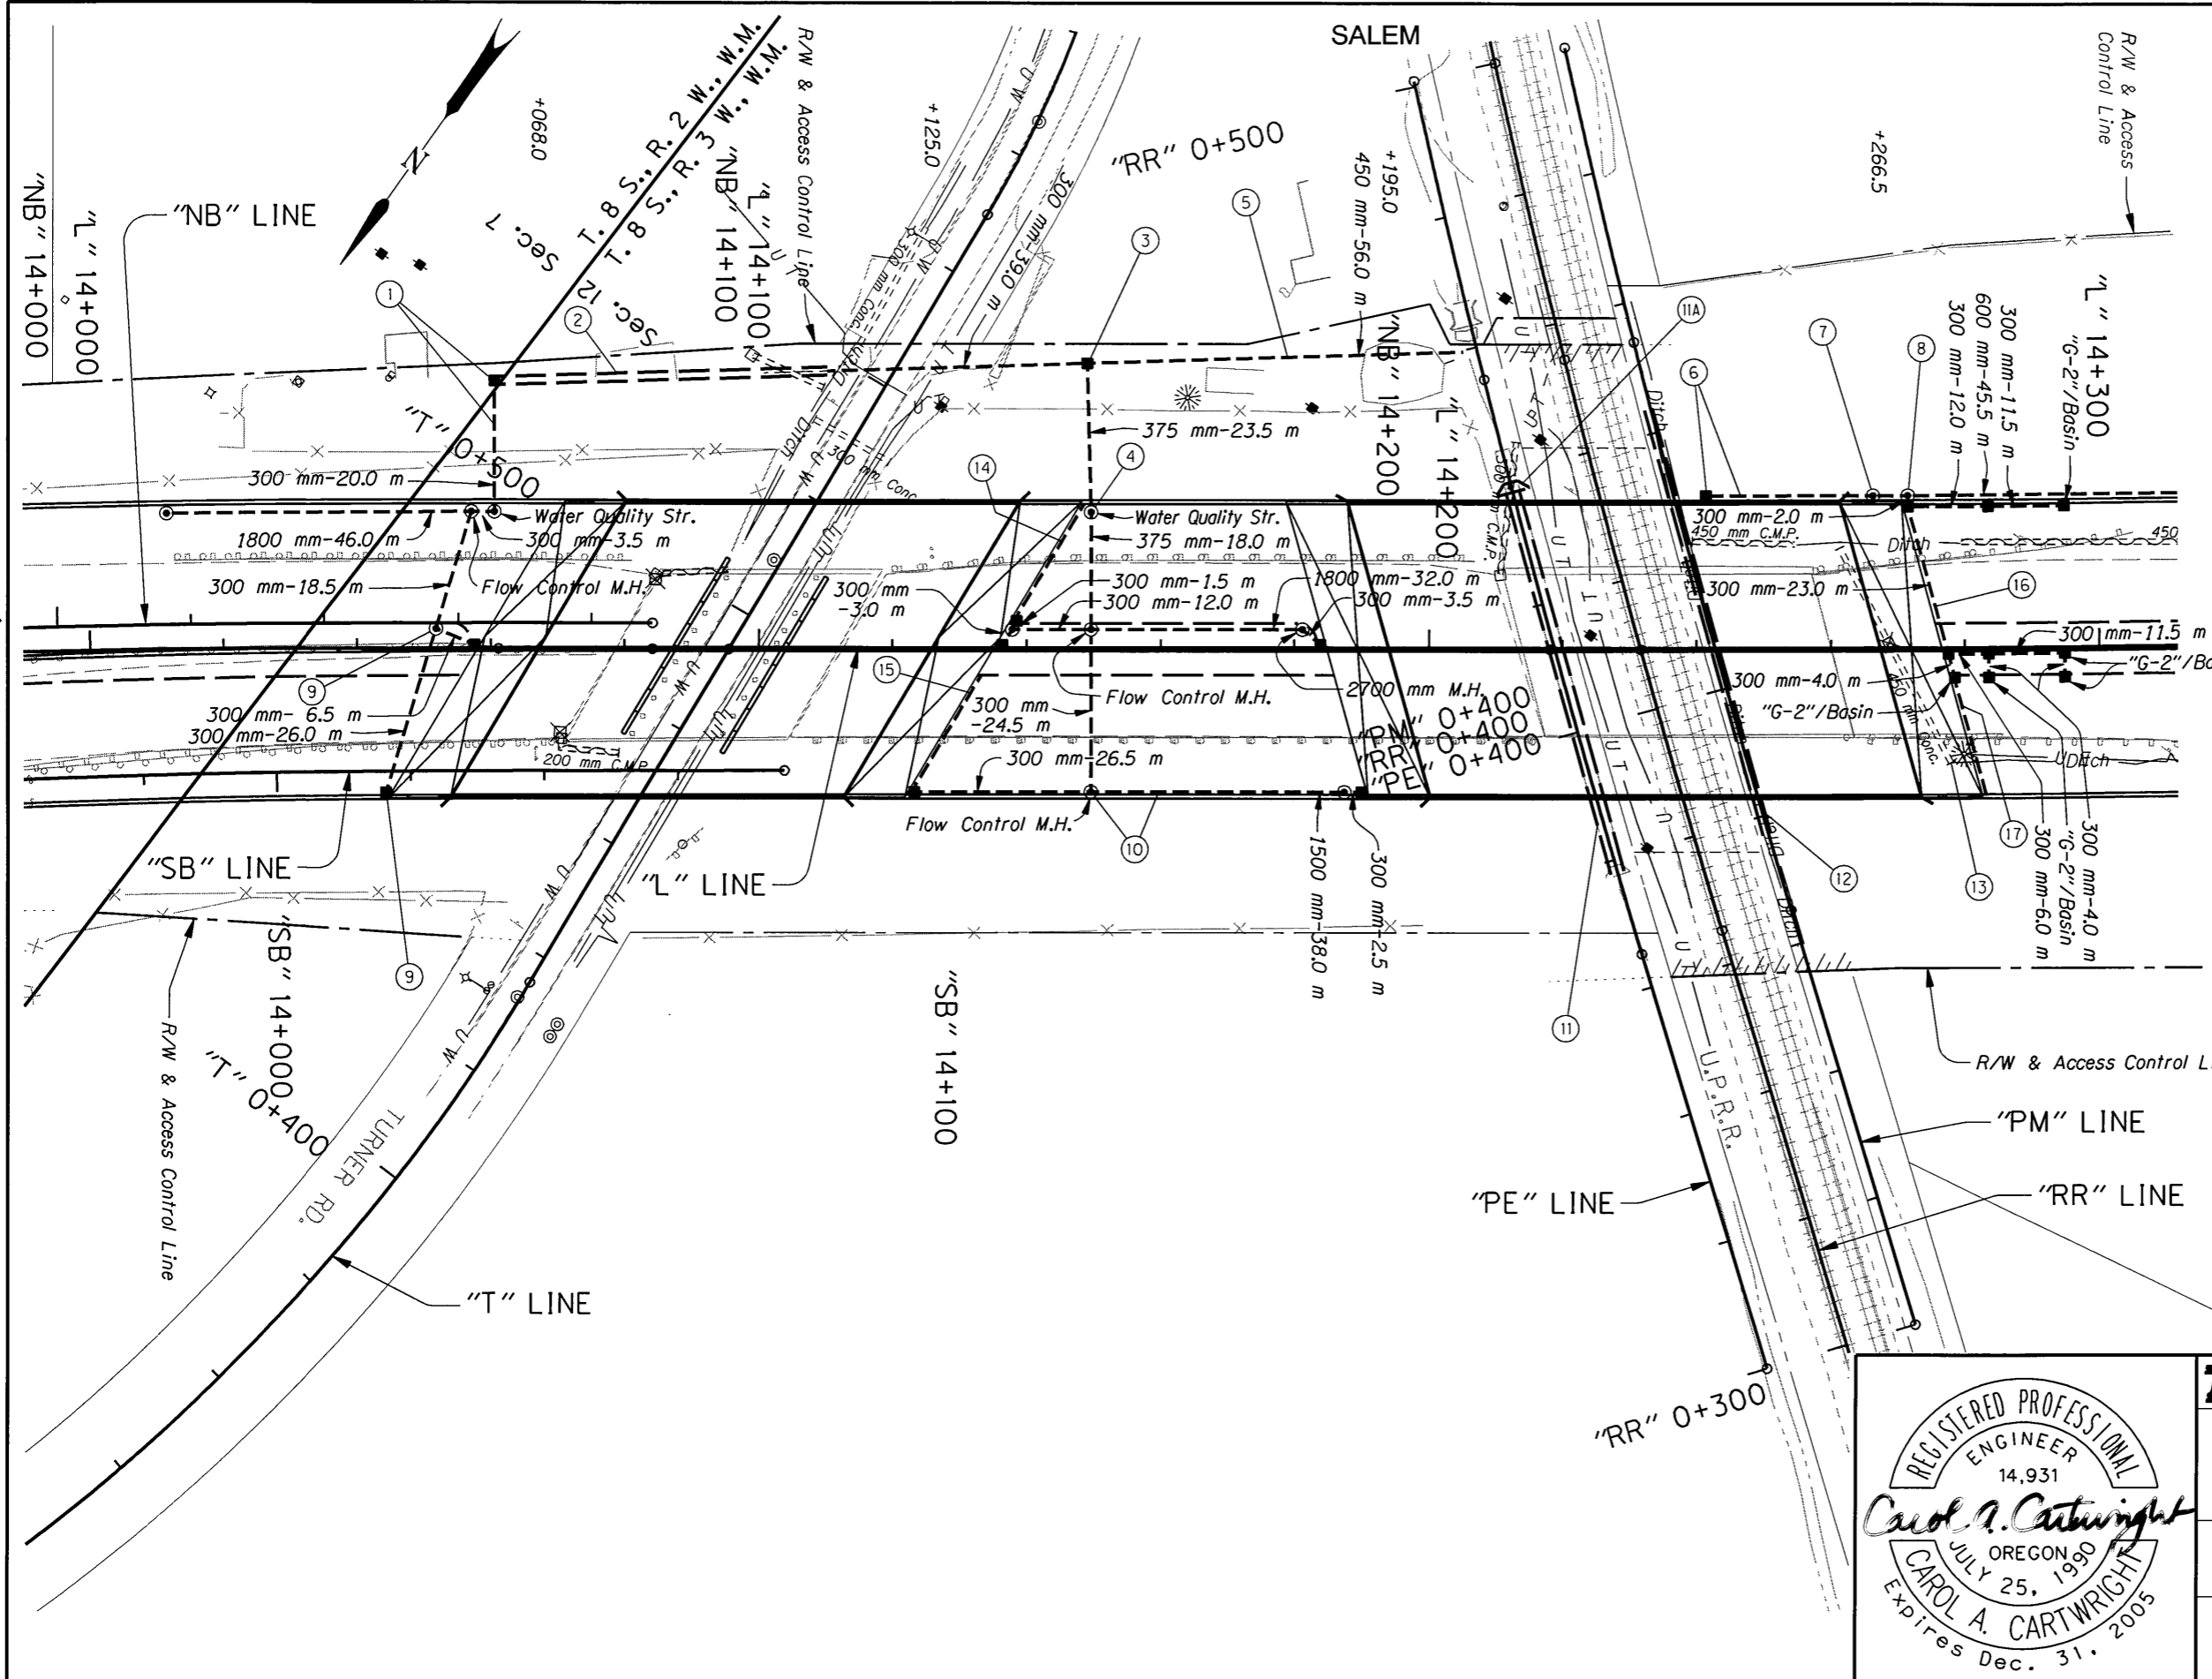

STRUCTURAL DETAILS CHECKED

Plug And Abandon Extg. Pipe Shown Thus:

All Dimensions Are Shown In Meters (m)
Unless Otherwise Noted.




| | |
|---|-----|
| OREGON DEPARTMENT OF TRANSPORTATION ROADWAY ENGINEERING SECTION | |
| 1-5: N. SANTIAM HWY. - KUEBLER BLVD. (SALEM) SEC. PACIFIC HIGHWAY MARION COUNTY | |
| Design Team Leader - Carol Cartwright Designed By - John Lucas Drafted By - Jeff Larson | |
| DRAINAGE & UTILITIES | |
| SHEET NO. | 16C |

STRUCTURAL DETAILS CHECKED *MA*



- ① Sta. "L"14+051.1 To Sta. "NB"14+065.4
Const. Manhole 2700 mm Dia.
Const. Water Quality Structure
Const. Flow Control Manhole 2400 mm Dia.
Const. Siphon Box
Inst. 300 mm Sew. Pipe - 18.5 m
3.0 m Depth
Inst. 300 mm Sew. Pipe - 23.5 m
6.0 m Depth
Inst. 1800 mm Sew. Pipe - 46.0 m
6.0 m Depth
(For Details, See Sht. GJ-4)
(See Drg. No. RD376)
- ② Const. Ditch
"V" Bottom, 1:3 Slopes
Dt. Exc. - 48 m³
- ③ Sta. "L"14+110.1 To Sta. "L"14+148.9
Const. Type "G-2MA" Inlet
Shape Bottom
Inst. 300 mm Sew. Pipe - 39.0 m
1.5 m Depth
Inst. 375 mm Sew. Pipe - 23.5 m
6.0 m Depth
Inst. Slope Anchors
(See Drg. Nos. RD330 & RD364)
- ④ Sta. "L"14+136.4 To Sta. "L"14+183.9
Const. Water Quality Structure
Const. Flow Control Manhole 2700 mm Dia.
Const. Large Manhole 2700 mm Dia.
Const. Manhole
Const. Type "G-2" Open Grade HMAC Inlet
With Basin - 2
0.45 m Deep
Const. Type "G-2" Open Grade HMAC Inlet
Shape Bottom
Adjust Inlet For Wearing Course - 2
Inst. 300 mm Sew. Pipe - 20.0 m
1.5 m Depth
Inst. 300 mm Sew. Pipe - 24.5 m
3.0 m Depth
Inst. 375 mm Sew. Pipe - 18.0 m
6.0 m Depth
Inst. 1800 mm Sew. Pipe - 32.0 m
6.0 m Depth
(For Details, See Sht. GJ-4)
- ⑤ Sta. "L"14+148.9 To Sta. "L"14+205.0
Inst. 450 mm Sew. Pipe - 56.0 m
1.5 m Depth

- ⑥ Sta. "L"14+241.4 To Sta. "L"14+266.3
Const. Type "D MOD" Inlet
Inst. 300 mm Sew. Pipe - 26.5 m
1.5 m Depth
Inst. Slope Anchors
(For Details, See Sht. GJ-9)
(See Drg. No. RD370)
- ⑦ Sta. "L"14+266.3 To Sta. "L"14+271.5
Const. Water Quality Structure
Inst. 600 mm Sew. Pipe - 5.5 m
1.5 m Depth
- ⑧ Sta. "L"14+271.5 To Sta. "L"14+317.4
Const. Manhole
Const. Type "G-2" Open Grade HMAC Inlet
With Basin - 5
0.45 m Deep
Const. Type "G-2" Open Grade HMAC Inlet - 4
Shape Bottom
Adjust Inlet For Wearing Course - 6
Inst. 300 mm Sew. Pipe - 78.0 m
1.5 m Depth
Inst. 600 mm Sew. Pipe - 45.5 m
1.5 m Depth
- ⑨ Sta. "SB"14+016.3 To Sta. "L"14+051.1
Const. Manhole
Const. Type "G-2" Open Grade HMAC Inlet
With Basin - 2
0.45 m Deep
Adjust Inlet For Wearing Course - 2
Inst. 300 mm Sew. Pipe - 6.5 m
1.5 m Depth
Inst. 300 mm Sew. Pipe - 26.0 m
3.0 m Depth
- ⑩ Sta. "L"14+123.4 To Sta. "L"14+190.1
Const. Large Manhole 2100 mm Dia.
Const. Flow Control Manhole 2100 mm Dia.
Const. Type "G-2" Open Grade HMAC Inlet
With Basin - 2
0.45 m Deep
Adjust Inlet For Wearing Course - 2
Inst. 300 mm Sew. Pipe - 2.5 m
1.5 m Depth
Inst. 300 mm Sew. Pipe - 26.5 m
3.0 m Depth
Inst. 1500 mm Sew. Pipe - 38.0 m
6.0 m Depth
(For Details, See Sht. GJ-4)


- ⑪ Remove Extg. 2.1 m x 1.2 m R.C.B.C.
Const. Channel Change
⑪A Const. Outlet
(For Details, See Shts. GE-1, GE-2, GE-3 & GF-1)
- ⑫ Const. Channel Change
(For Details, See Sht. GF-2)
- ⑬ Remove Pipe
- ⑭ Sta. "L"14+135.6
Const. Open Grade Wearing Surface Drain
Outlet To Inlet
- ⑮ Sta. "L"14+135.6
Const. Open Grade Wearing Surface Drain
Outlet To Inlet
- ⑯ Sta. "L"14+272.0
Const. Open Grade Wearing Surface Drain
Outlet To Inlet
- ⑰ Sta. "L"14+278.5
Const. Open Grade Wearing Surface Drain
Outlet To Inlet

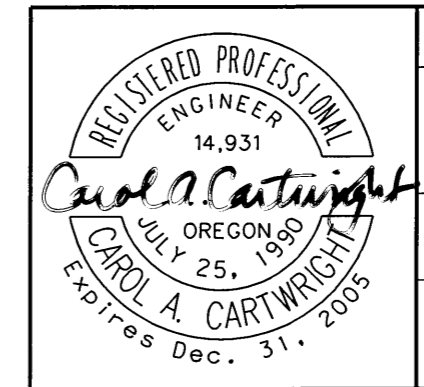

| | |
|--|----------------------------|
| OREGON DEPARTMENT OF TRANSPORTATION ROADWAY ENGINEERING SECTION | |
| 1-5: N. SANTIAM HWY. - KUEBLER BLVD. (SALEM) SEC. PACIFIC HIGHWAY MARION COUNTY | |
| Design Team Leader - Carol Cartwright Designed By - John Lucas Drafted By - Jeff Larson | |
| NOTES | SHEET NO. 16D |

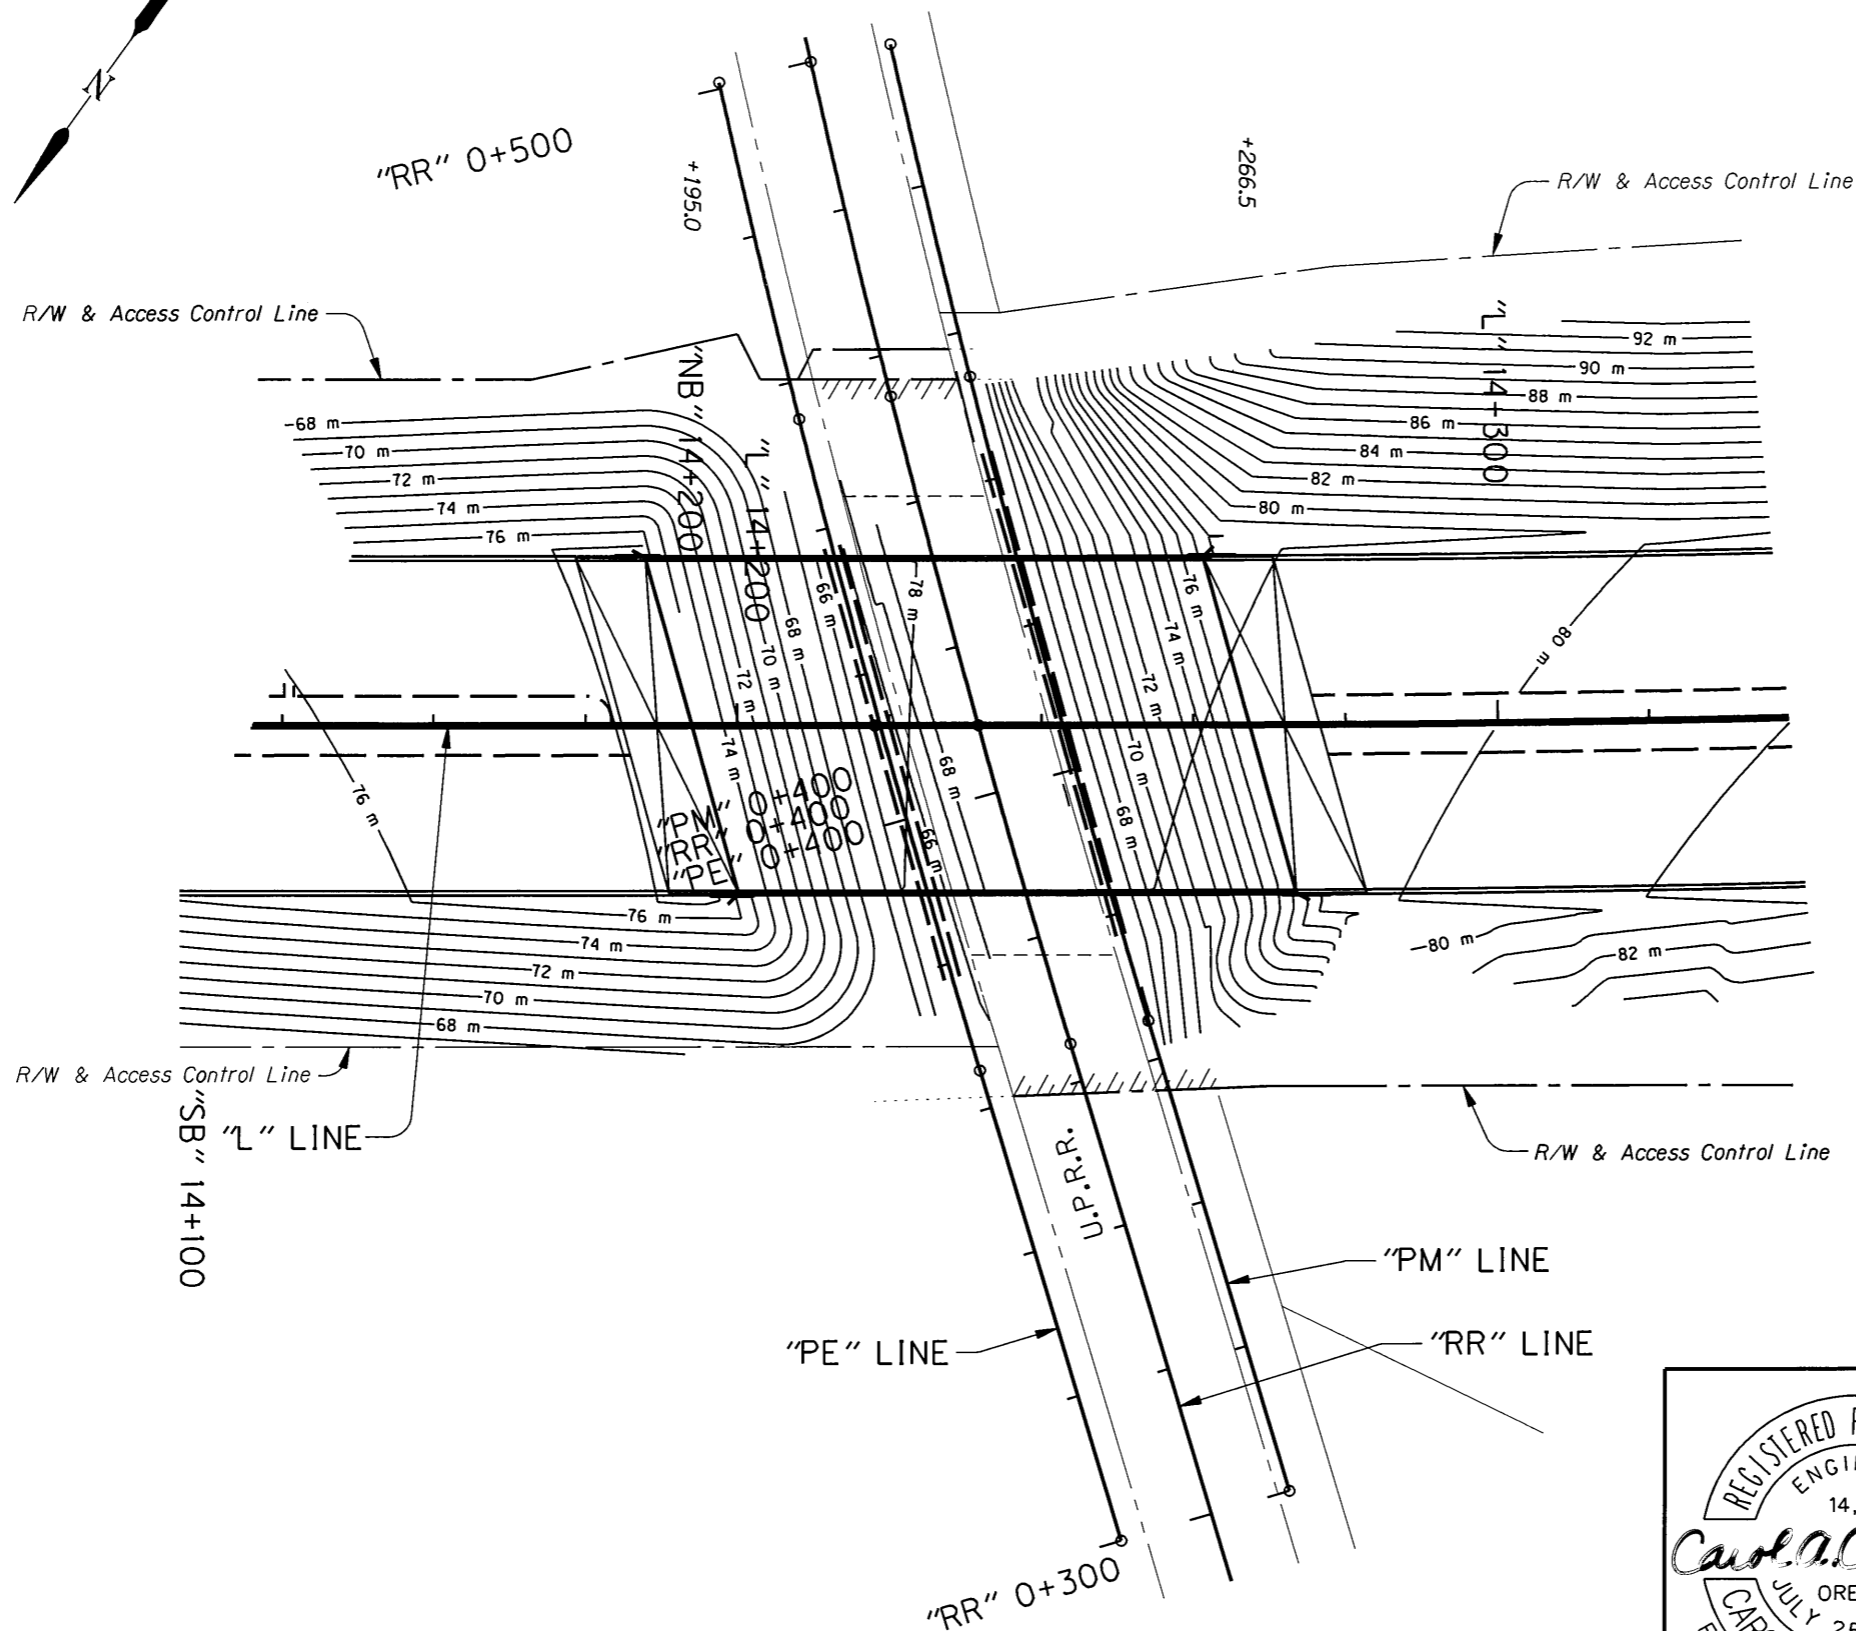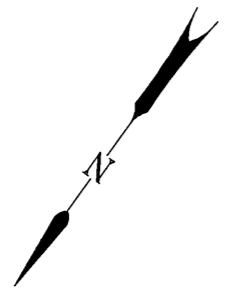

All Dimensions Are Shown In Meters (m)
Unless Otherwise Noted.

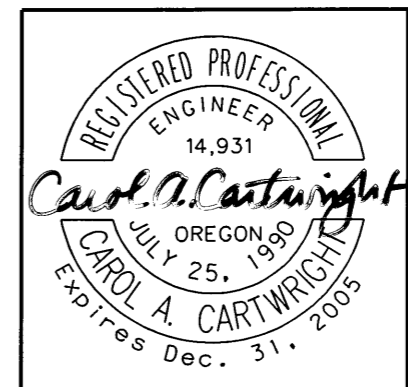


| | |
|---|----------------------------|
| OREGON DEPARTMENT OF TRANSPORTATION ROADWAY ENGINEERING SECTION | |
| 1-5: N. SANTIAM HWY. - KUEBLER BLVD. (SALEM) SEC. PACIFIC HIGHWAY MARION COUNTY | |
| Design Team Leader - Carol Cartwright Designed By - John Lucas Drafted By - Jeff Larson | |
| CONTOUR GRADING PLAN | SHEET NO. 16E |

"L" LINE RIGHT (Southbound)



84
83
82
71
69
68
67

83
82
81
80
79
78
77
76
75
74
73
72
71
71
69
68
67

STRUCTURAL DETAILS CHECKED

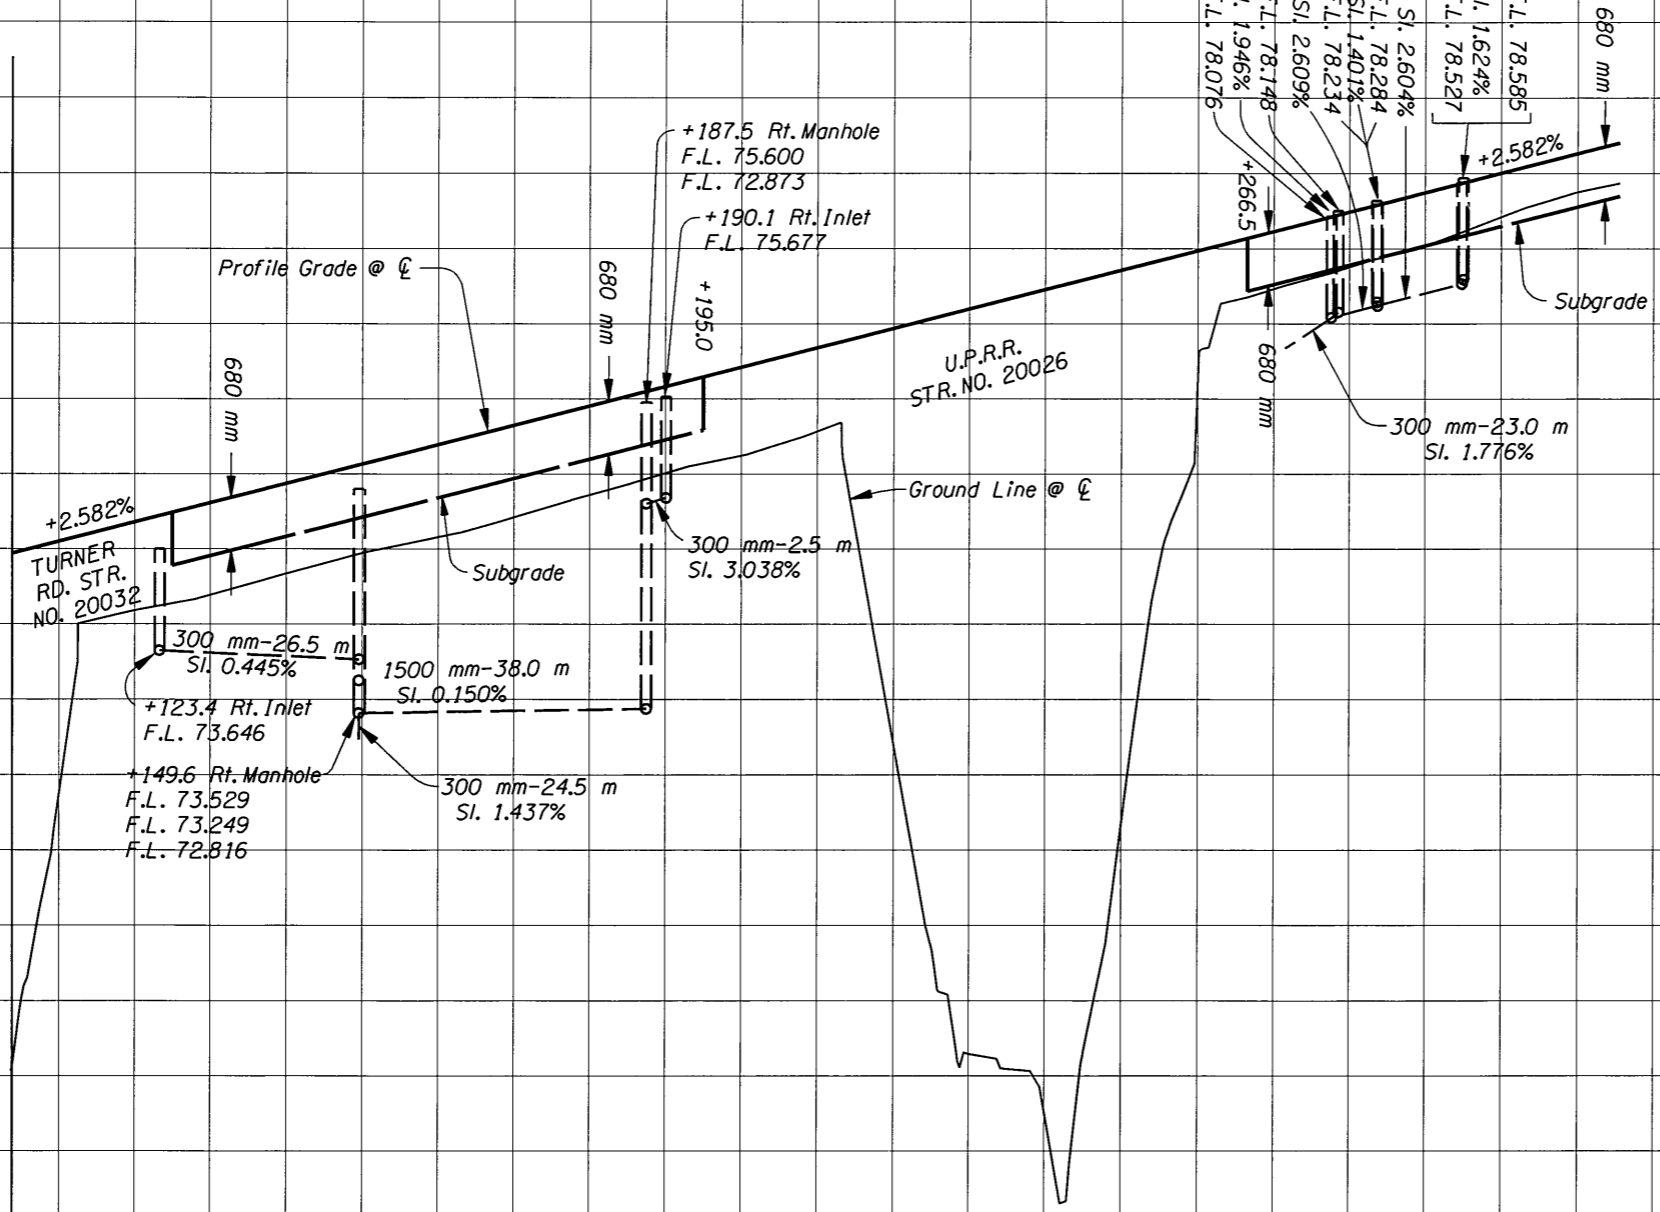

"L" 14+103.886 P.O.T.
"SB" 14+075.837 P.T.
"NB" 14+108.771 P.O.T.

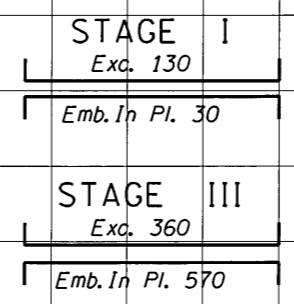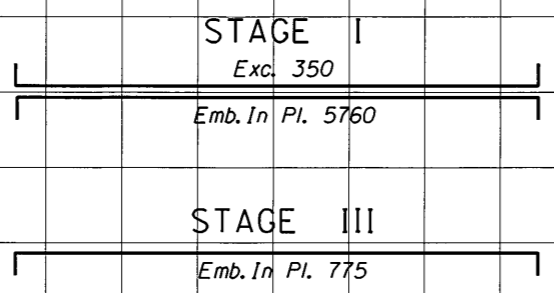

14+100

14+200

14+300



**OREGON DEPARTMENT OF TRANSPORTATION
ROADWAY ENGINEERING SECTION**

**1-5: N. SANTIAM HWY. -
KUEBLER BLVD. (SALEM) SEC.
PACIFIC HIGHWAY
MARION COUNTY**

Design Team Leader - Carol Cartwright P.E.
Designed By - John Lucas
Drafted By - Steve Donaldson


PROFILE

SHEET NO. **16F**

"L" LINE LEFT (Northbound)

84
83
82
71
69
68
67
66
65

83
82
81
80
79
78
77
76
75
74
73
72
71
71
69
68
67
66
65

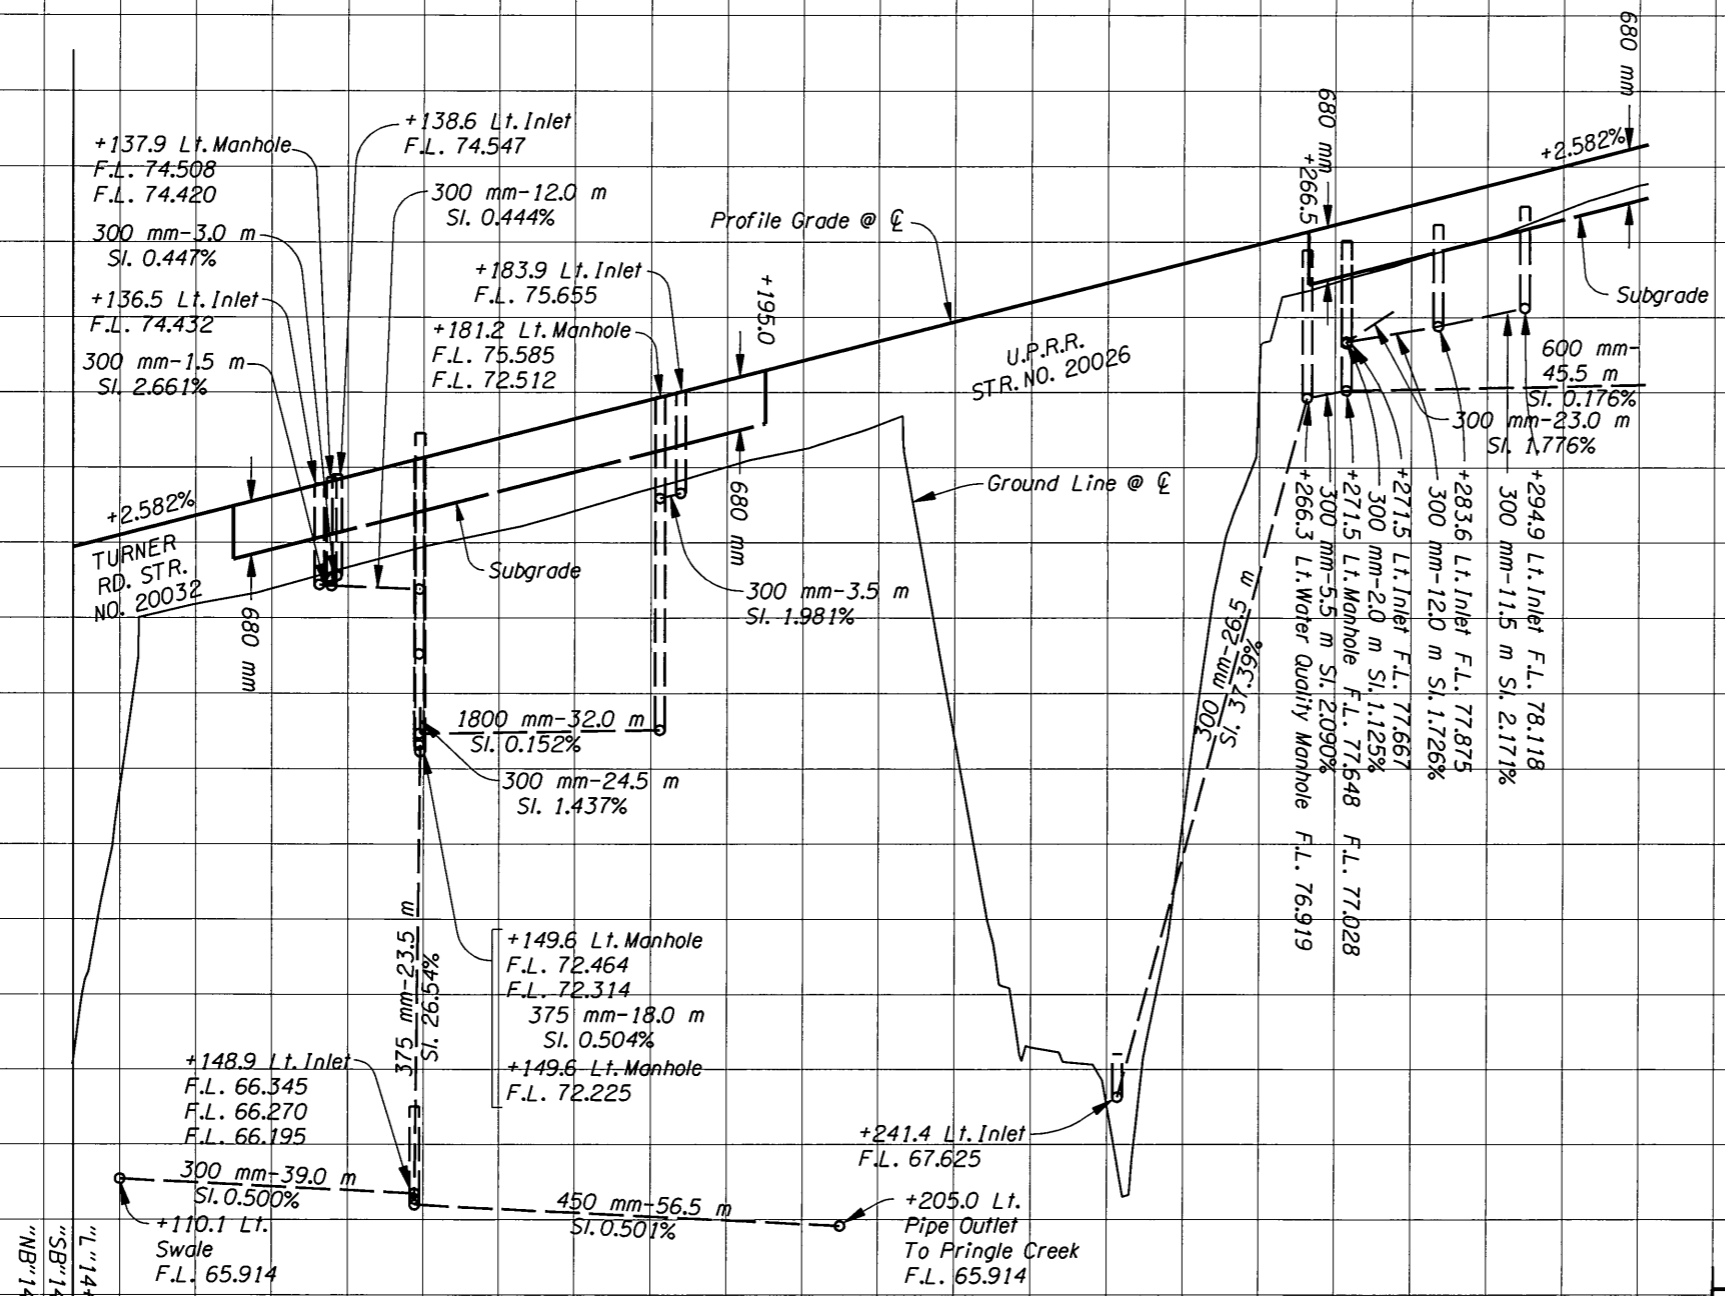

"L" 14+103.866 P.O.T.
"SB" 14+075.837 P.T.
"NB" 14+108.771 P.O.T.

STAGE II
Emb. In Pl. 5890

| |
|---------------|
| STAGE II |
| Exc. 3835 |
| Emb. In Pl. 0 |
| STAGE IV |
| Exc. 5 |
| Emb. In Pl. 5 |



**OREGON DEPARTMENT OF TRANSPORTATION
ROADWAY ENGINEERING SECTION**

**I-5: N. SANTIAM HWY. -
KUEBLER BLVD. (SALEM) SEC.
PACIFIC HIGHWAY
MARION COUNTY**

Design Team Leader - Carol Cartwright P.E.
Designed By - John Lucas
Drafted By - Steve Donaldson

PROFILE

SHEET NO.
16G

14+100


14+200

14+300

STRUCTURAL DETAILS CHECKED

"SB" LINE

STRUCTURAL DETAILS CHECKED

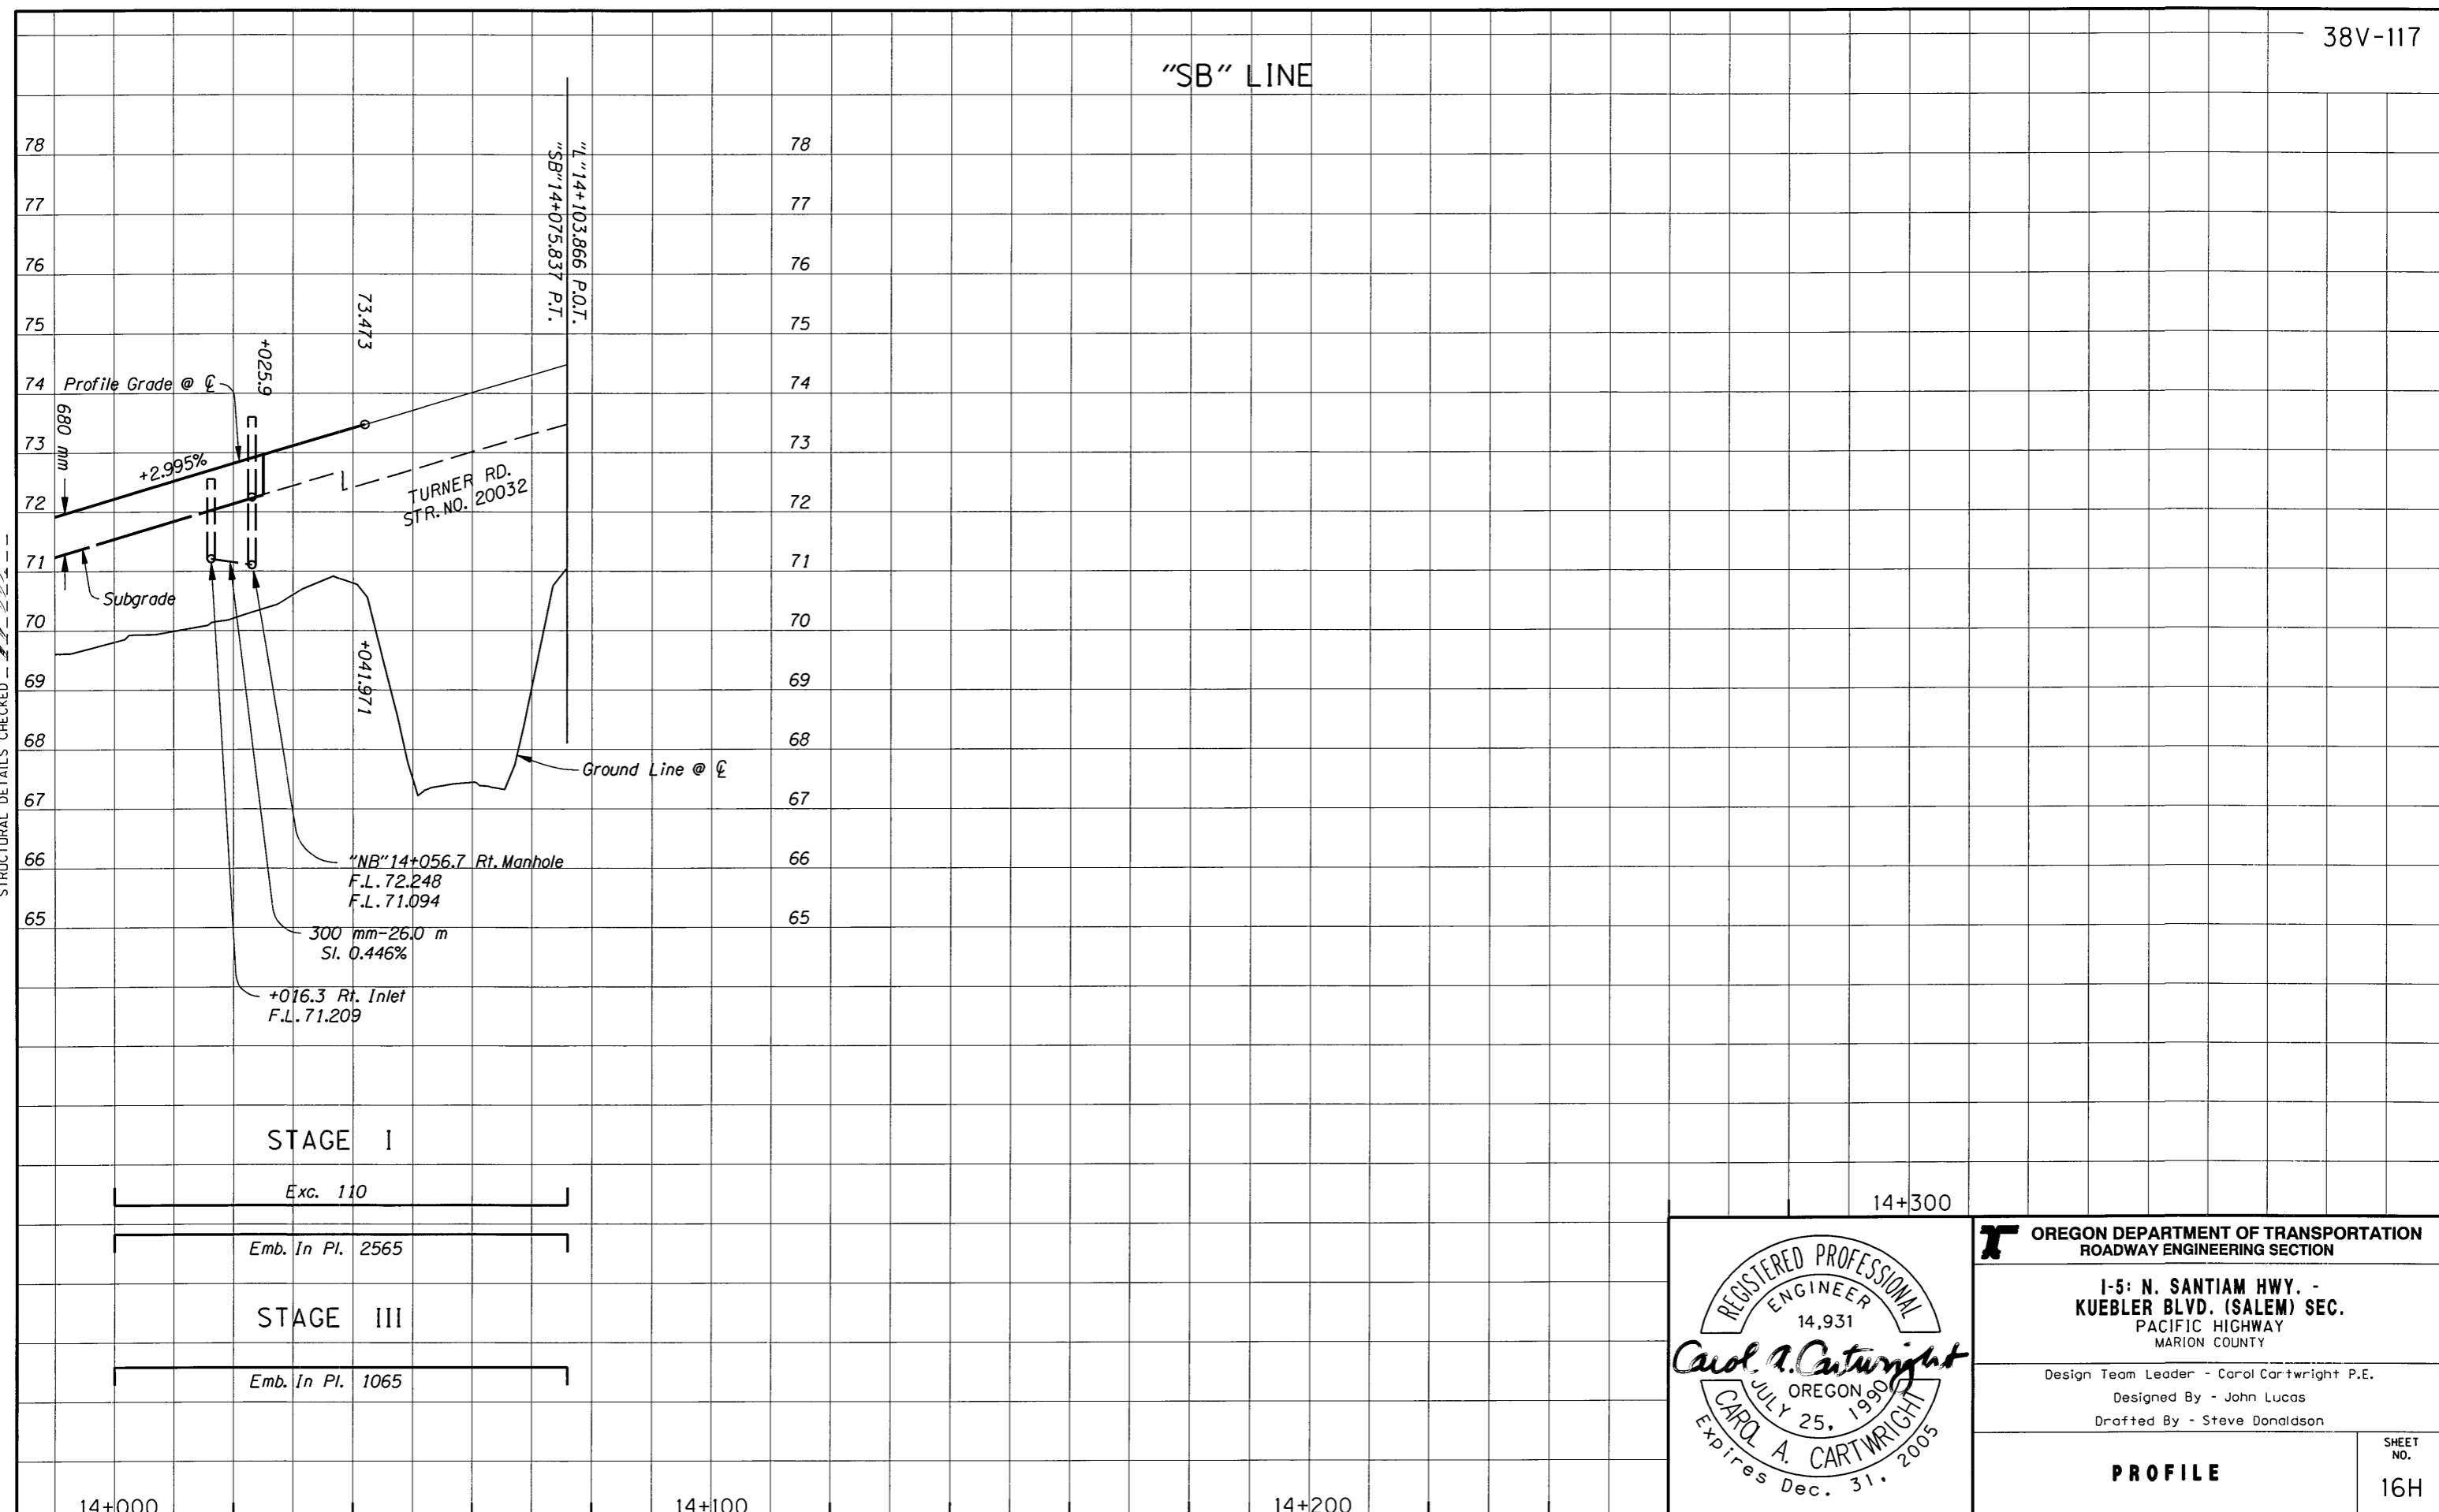

STAGE I

Exc. 110

Emb. In Pl. 2565

STAGE III

Emb. In Pl. 1065

14+300



OREGON DEPARTMENT OF TRANSPORTATION
ROADWAY ENGINEERING SECTION


I-5: N. SANTIAM HWY. - KUEBLER BLVD. (SALEM) SEC.
PACIFIC HIGHWAY
MARION COUNTY

Design Team Leader - Carol Cartwright P.E.
Designed By - John Lucas
Drafted By - Steve Donaldson

PROFILE

SHEET NO. 16H

"NB" LINE

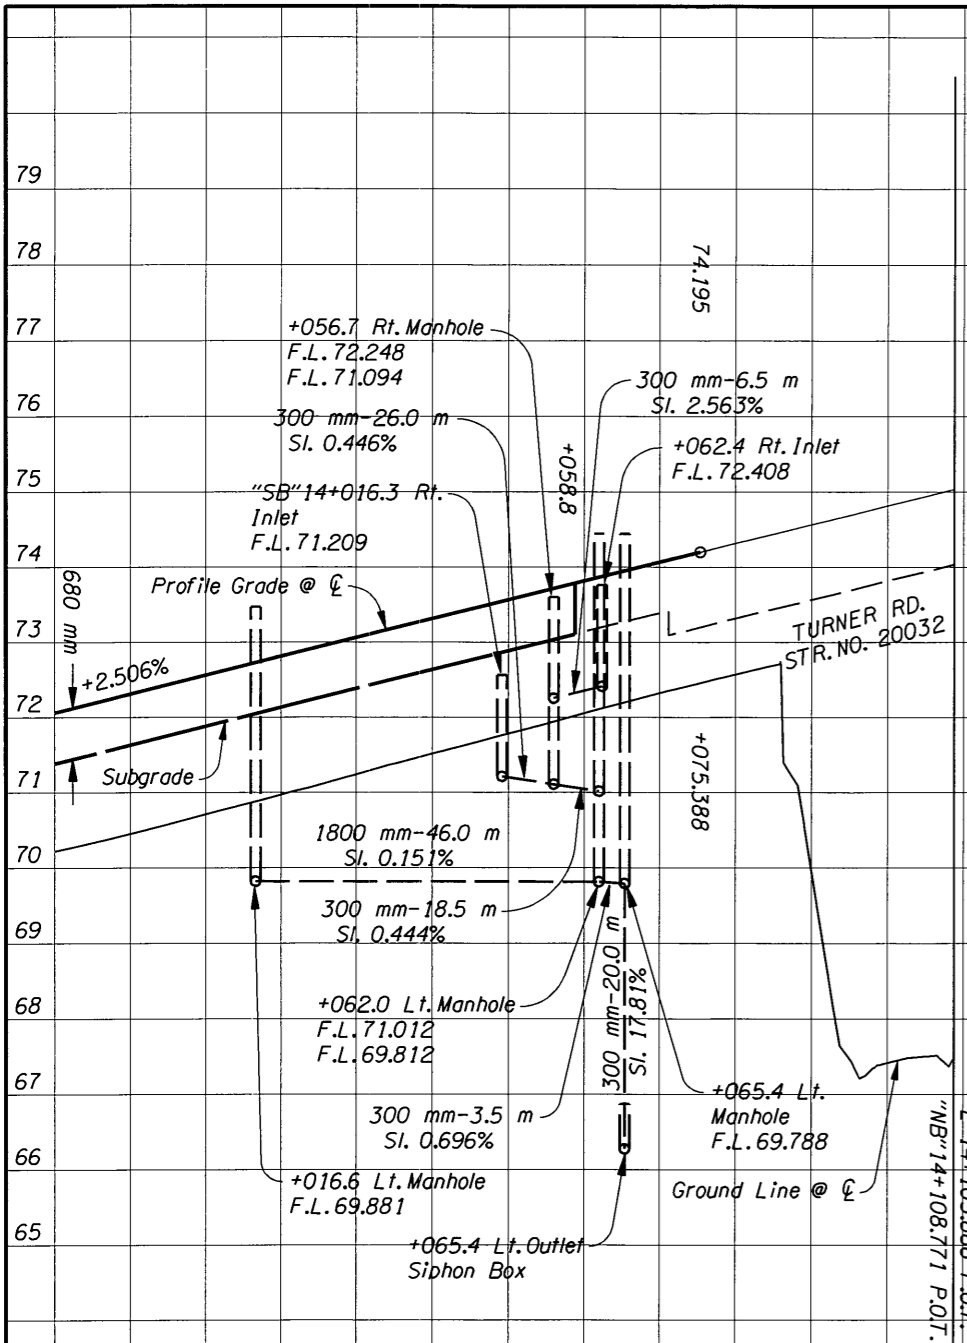

STRUCTURAL DETAILS CHECKED

STAGE II

Emb. In Pl. 6115

STAGE IV

Exc. 5

Emb. In Pl. 15

14+300




OREGON DEPARTMENT OF TRANSPORTATION
ROADWAY ENGINEERING SECTION

I-5: N. SANTIAM HWY. - KUEBLER BLVD. (SALEM) SEC.
PACIFIC HIGHWAY
MARION COUNTY

Design Team Leader - Carol Cartwright P.E.
Designed By - John Lucas
Drafted By - Steve Donaldson

PROFILE

SHEET NO.
16J

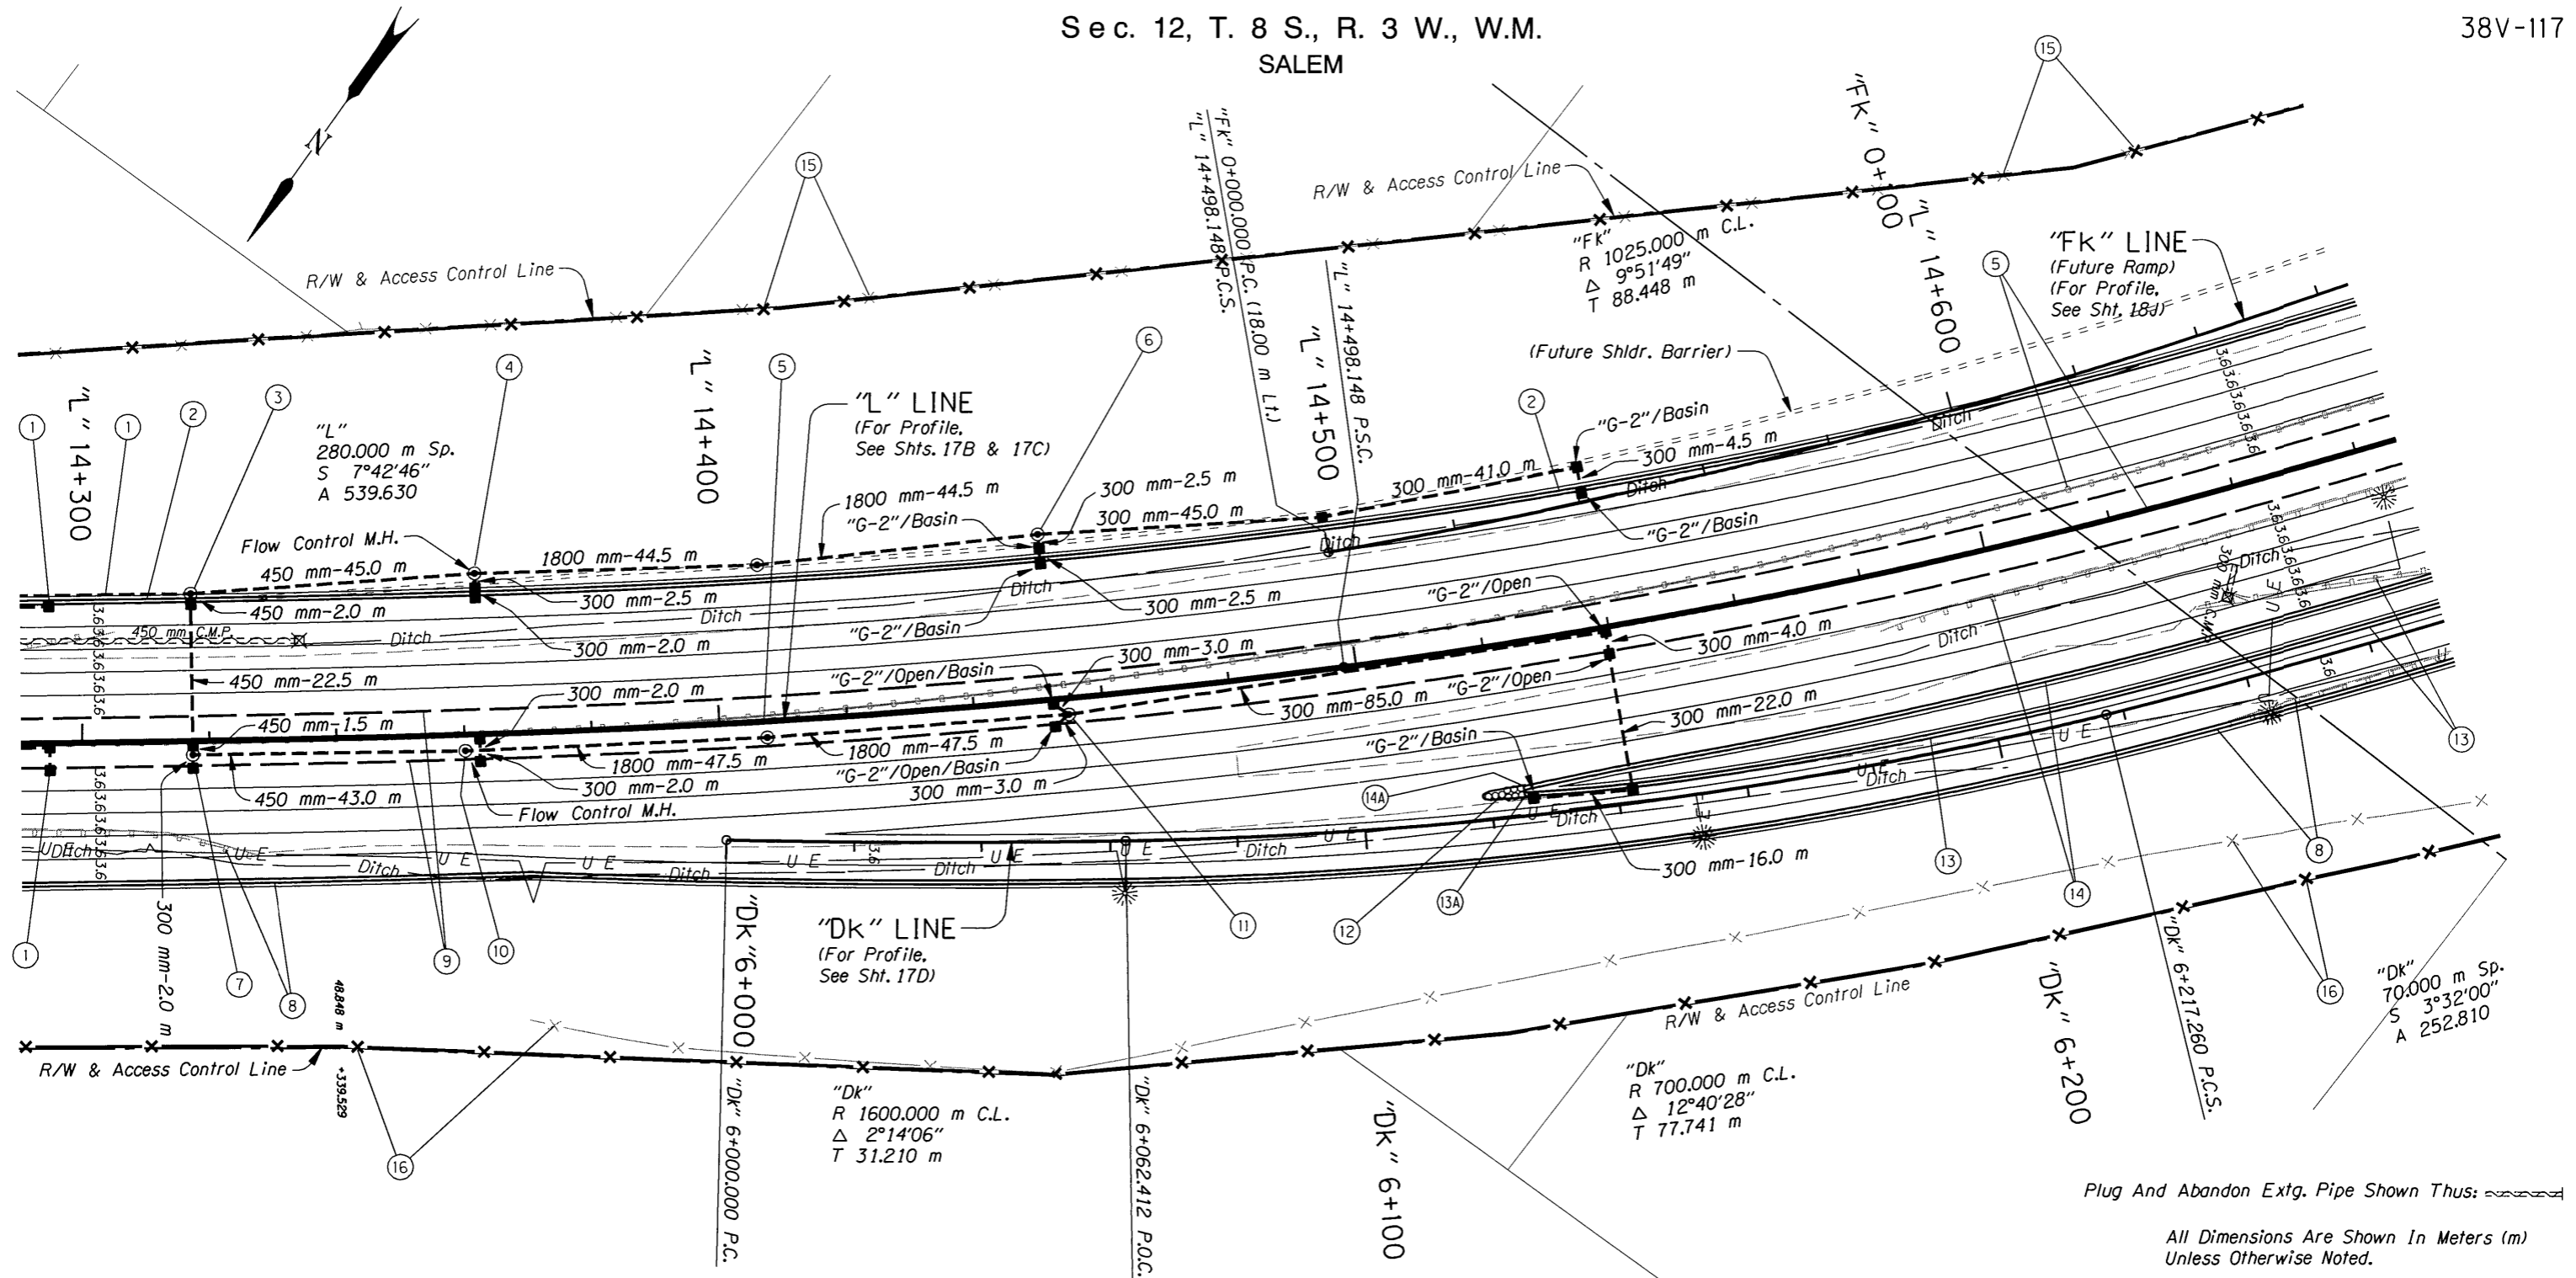

Plug And Abandon Extg. Pipe Shown Thus:

All Dimensions Are Shown In Meters (m)
Unless Otherwise Noted.



| | |
|---|-----------------|
| OREGON DEPARTMENT OF TRANSPORTATION ROADWAY ENGINEERING SECTION | |
| I-5: N. SANTIAM HWY. - KUEBLER BLVD. (SALEM) SEC. PACIFIC HIGHWAY MARION COUNTY | |
| Design Team Leader - Carol Cartwright Designed By - John Lucas Drafted By - Jeff Larson | |
| GENERAL CONSTRUCTION | SHEET NO. 17 |

① See Sht. 16D, Note 8
Inst. 600 mm Sew. Pipe

② See Sht. 16B, Note 5
Const. Precast Conc. Shldr. Barrier

③ Sta. "L"14+317.4 To Sta. "L"14+362.4
Const. Manhole
Const. Type "G-2" Open Grade HMAC Inlet - 2
Shape Bottom
Adjust Inlet For Wearing Course
Inst. 450 mm Sew. Pipe - 2.0 m
1.5 m Depth
Inst. 450 mm Sew. Pipe - 69.0 m
3.0 m Depth

④ Sta. "L"14+362.4 To Sta. "L"14+452.4
Const. Flow Control Manhole 2700 mm Dia.
Const. Manhole 2700 mm Dia.
Const. Type "G-2" Open Grade HMAC Inlet
With Basin - 2
0.45 m Deep
Adjust Inlet For Wearing Course
Inst. 300 mm Sew. Pipe - 4.5 m
1.5 m Depth
Inst. 1800 mm Sew. Pipe - 89.0 m
6.0 m Depth
(For Details, See Sht. GJ-4)

⑤ See Sht. 14B, Note 16
Remove Extg. Metal Median Barrier
Const. Precast Tall Conc. Median Barrier

⑥ Sta. "L"14+452.4 To Sta. "L"14+539.4
Const. Manhole 2700 mm Dia.
Const. Type "G-2" Open Grade HMAC Inlet
With Basin - 4
0.45 m Deep
Const. Type "G-2" Open Grade HMAC Inlet
Shape Bottom
Adjust Inlet For Wearing Course - 2
Inst. 300 mm Sew. Pipe - 95.5 m
1.5 m Depth
(For Details, See Sht. GJ-4)

⑦ Sta. "L"14+317.4 To Sta. "L"14+360.1
Const. Manhole
Const. Type "G-2" Open Grade HMAC Inlet
With Basin
0.45 m Deep
Adjust Inlet For Wearing Course
Inst. 300 mm Sew. Pipe - 2.0 m
1.5 m Depth
Inst. 450 mm Sew. Pipe - 43.0 m
3.0 m Depth

⑧ See Sht. 16B, Note 16
Remove Extg. Guardrail
Const. Precast Conc. Shldr. Barrier

⑨ Const. Low Profile Mountable Curb

⑩ Sta. "L"14+360.1 To Sta. "L"14+454.6
Const. Flow Control Manhole 2700 mm Dia.
Const. Manhole 2700 mm Dia.
Const. Type "G-2" Open Grade HMAC Inlet
With Basin - 2
0.45 m Deep
Adjust Inlet For Wearing Course
Inst. 300 mm Sew. Pipe - 4.0 m
1.5 m Depth
Inst. 1800 mm Sew. Pipe - 95.0 m
6.0 m Depth
(For Details, See Sht. GJ-4)

⑪ Sta. "L"14+454.6 To Sta. "L"14+539.4
Const. Manhole 2700 mm Dia.
Const. Type "G-2" Inlet With Basin
0.45 m Deep
Const. Type "G-2" Inlet
Shape Bottom
Const. Type "G-2" Open Grade HMAC Inlet - 2
Shape Bottom
Const. Type "G-2" Open Grade HMAC Inlet
With Basin - 2
Adjust Inlet For Wearing Course - 2
Inst. 300 mm Sew. Pipe - 133.0 m
1.5 m Depth
(For Details, See Sht. GJ-4)

⑫ Sta. "L"14+523.0
Inst. Impact Attenuator
(For Details, See Sht. 2B-5)

⑬ Sta. "Dk"6+125.4 To Sta. "Dk"6+350.0
Remove Extg. Guardrail - 110.5 m
Const. Precast Conc. Shldr. Barrier - 222.4 m
(Reflectorized)
Plug Scuppers


⑬A Connect To Impact Attenuator
Flare Rate=1:20, W=0.7 m, E=0
(For Details, See Sht. 2B-5)

⑭ Sta. "L"14+523.0 To Sta. "L"14+743.3
Remove Extg. Guardrail - 156.2 m
Const. Precast Conc. Shldr. Barrier - 218.6 m
(Reflectorized)
Plug Scuppers

⑭A Connect To Impact Attenuator
Flare Rate=1:20, W=0.7 m, E=0
(For Details, See Sht. 2B-5)


⑮ See Sheet 16B, Note 21
Remove Extg. Fence
Const. Type CL-6 Fence

⑯ See Sheet 16B, Note 22
Remove Extg. Fence
Const. Type CL-6 Fence

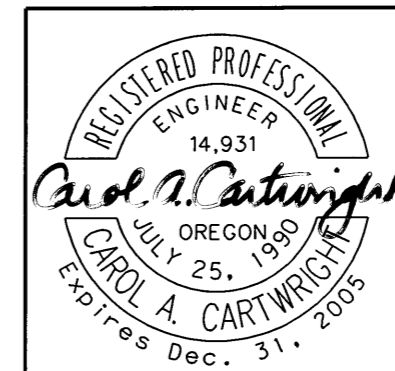

| | |
|---|---------------------|
| OREGON DEPARTMENT OF TRANSPORTATION ROADWAY ENGINEERING SECTION | |
| I-5: N. SANTIAM HWY. - KUEBLER BLVD. (SALEM) SEC. PACIFIC HIGHWAY MARION COUNTY | |
| Design Team Leader - Carol Cartwright Designed By - John Lucas Drafted By - Jeff Larson | |
| NOTES | SHEET NO. 17A |

"L" LINE RIGHT (Southbound)

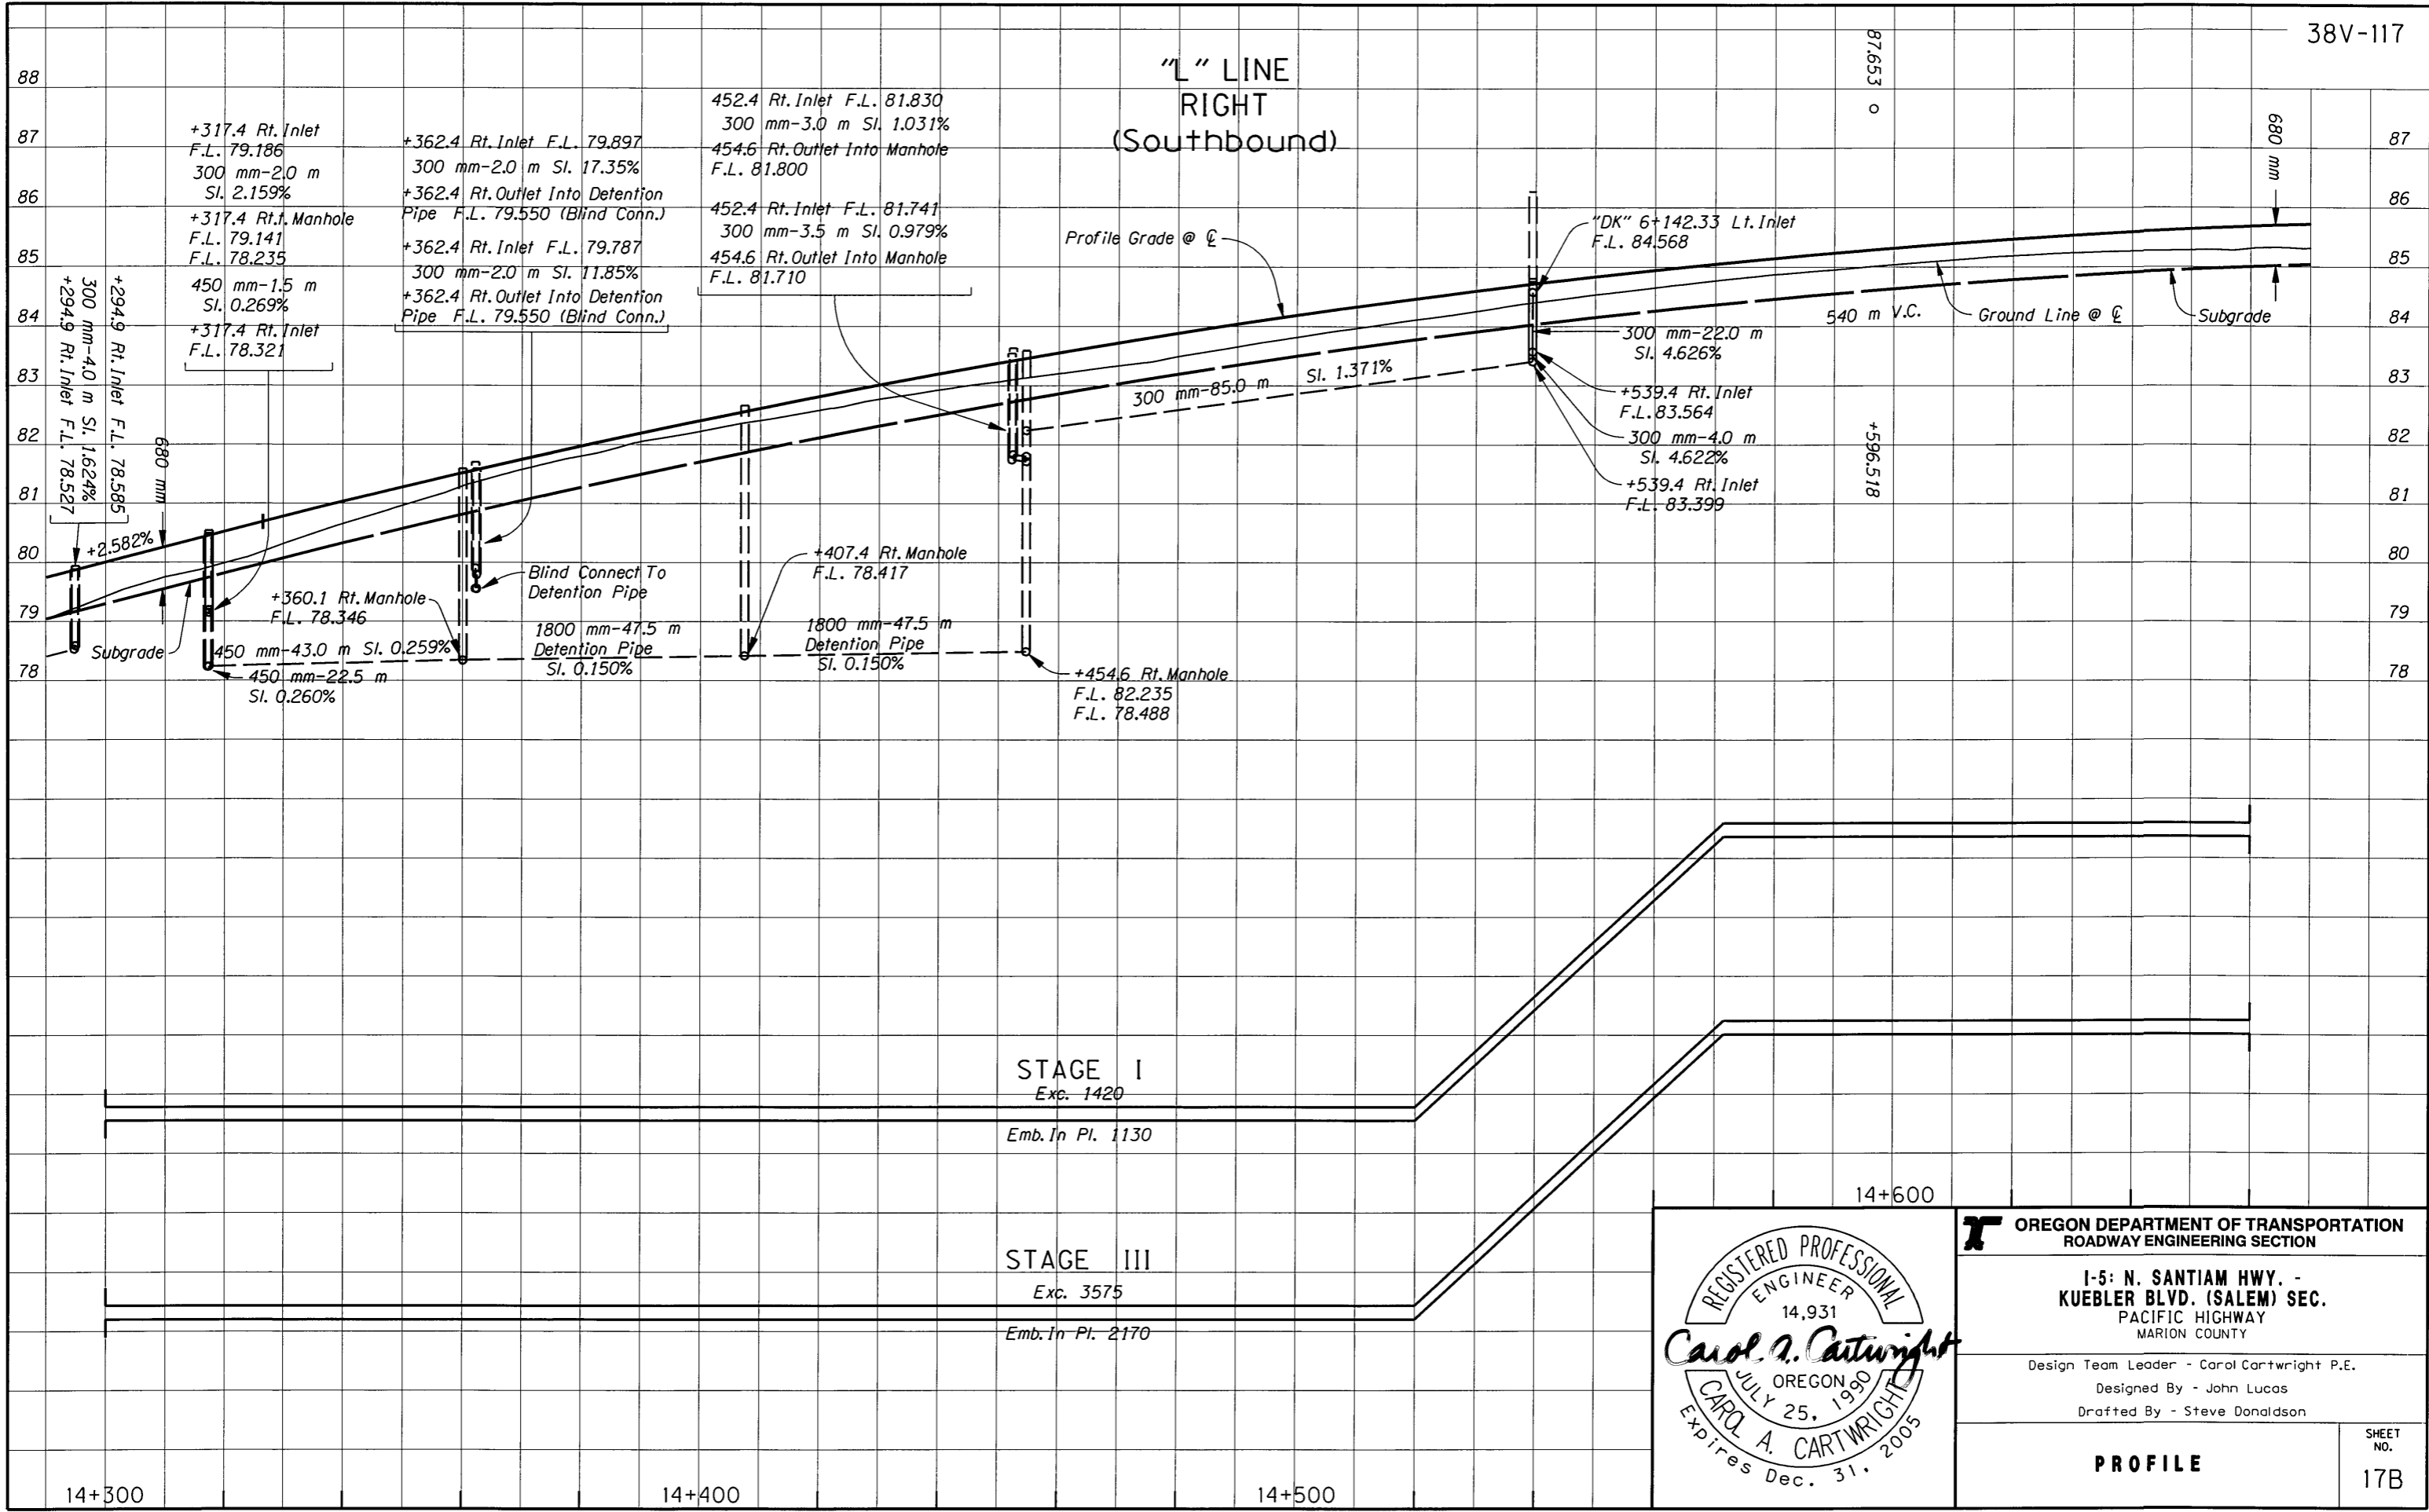

STAGE I
Exc. 1420

Emb. In Pl. 1130

STAGE III
Exc. 3575

Emb. In Pl. 2170



**OREGON DEPARTMENT OF TRANSPORTATION
ROADWAY ENGINEERING SECTION**


**1-5: N. SANTIAM HWY. -
KUEBLER BLVD. (SALEM) SEC.**
PACIFIC HIGHWAY
MARION COUNTY

Design Team Leader - Carol Cartwright P.E.
Designed By - John Lucas
Drafted By - Steve Donaldson

PROFILE

SHEET NO.
17B

"L" LINE LEFT (Northbound)

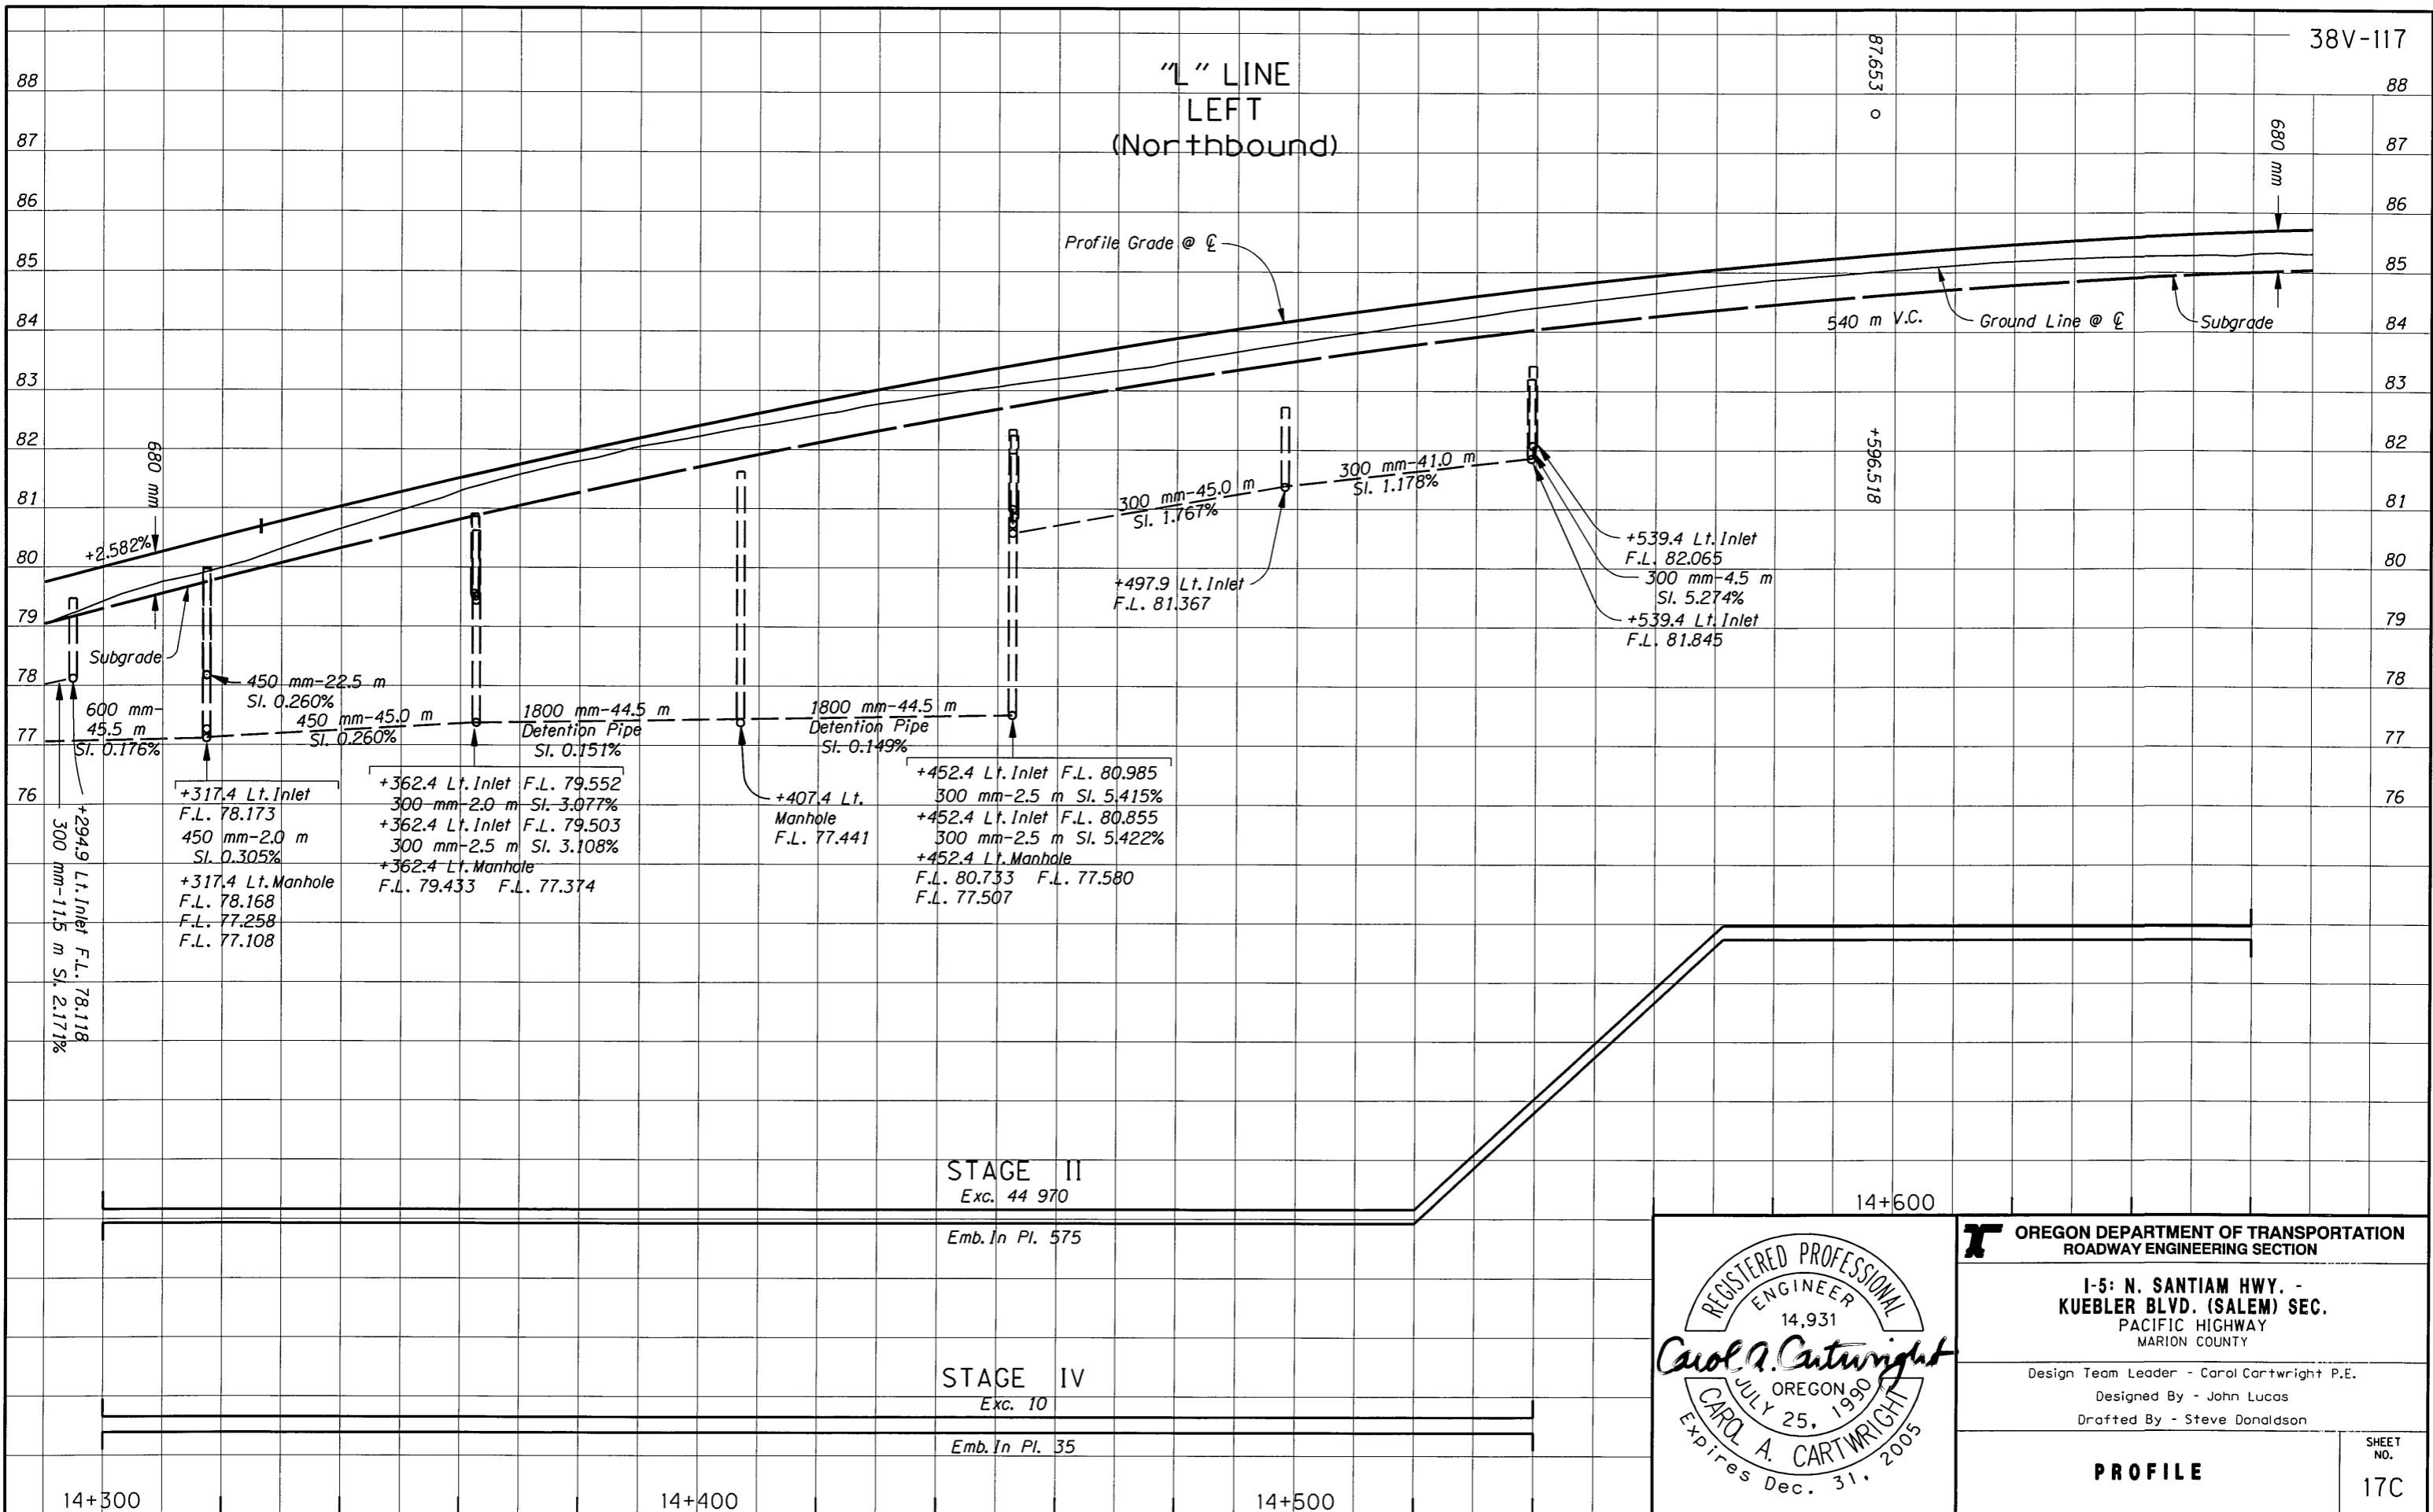

**OREGON DEPARTMENT OF TRANSPORTATION
ROADWAY ENGINEERING SECTION**


**1-5: N. SANTIAM HWY. -
KUEBLER BLVD. (SALEM) SEC.
PACIFIC HIGHWAY
MARION COUNTY**

Design Team Leader - Carol Cartwright P.E.
Designed By - John Lucas
Drafted By - Steve Donaldson


PROFILE

SHEET NO.
17C

- NOTES:**
- Hardware, Fasteners And Anchors To Be Stainless Steel; Use 3 mm Stainless Steel Cable.
 - For Manhole Details Not Shown, See RD346
 - Hardware, Fasteners, Anchors, Fittings, Appurtenances, Labor, And Equipment Are Incidental.

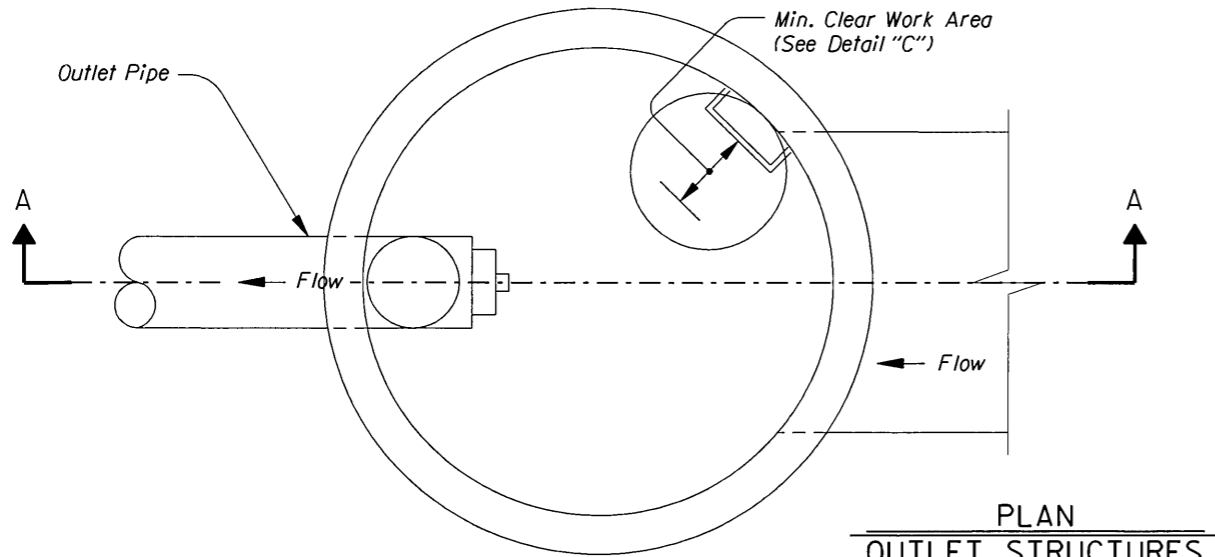

PLAN
OUTLET STRUCTURES
(For Location, See Sht. 16C and 17)
Not To Scale

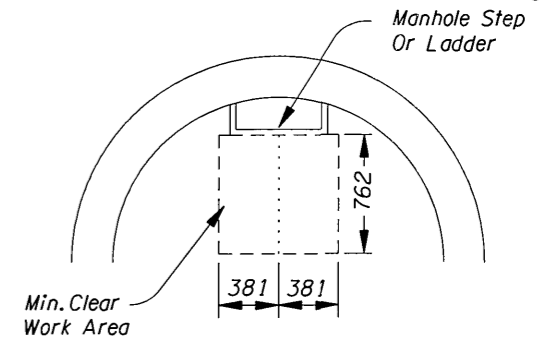

Locate Pipes, Etc. So That No Portion Of Them Are Within Min. Clear Work Area

DETAIL "C"
MIN. CLEAR WORK AREA
Not To Scale


| Sta "L" 14+149.633 21.510 Rt. | | |
|-------------------------------|---------------|--|
| | ELEVATION (m) | DESCRIPTION |
| A | 73.251 | Detention Pipe Inlet |
| B | 74.733 | Elev. Of Detention Water Surface 50 Year Storm |
| C | 74.247 | Fl. Elev. Of Elbow |
| D | 75.033 | Rim Of Overflow Riser |
| E | 73.247 | Fl. Elev. Of Outlet Pipe |
| F | 75.796 | Top Of Manhole |

| Sta "L" 14+149.601 0.720 Lt. | | |
|------------------------------|---------------|--|
| | ELEVATION (m) | DESCRIPTION |
| A | 72.466 | Detention Pipe Inlet |
| B | 74.131 | Elev. Of Detention Water Surface 50 Year Storm |
| C | 73.058 | Fl. Elev. Of Elbow |
| D | 74.431 | Rim Of Overflow Riser |
| E | 72.458 | Fl. Elev. Of Outlet Pipe |
| F | 76.124 | Top Of Manhole |

| Sta "L" 14+362.421 25.372 Lt. | | |
|-------------------------------|---------------|--|
| | ELEVATION (m) | DESCRIPTION |
| A | 77.376 | Detention Pipe Inlet |
| B | 78.839 | Elev. Of Detention Water Surface 50 Year Storm |
| C | 78.071 | Fl. Elev. Of Elbow |
| D | 79.139 | Rim Of Overflow Riser |
| E | 77.371 | Fl. Elev. Of Outlet Pipe |
| F | 80.618 | Top Of Manhole |

| Sta "L" 14+061.972 16.794 Lt. | | |
|-------------------------------|---------------|--|
| | ELEVATION (m) | DESCRIPTION |
| A | 69.814 | Detention Pipe Inlet |
| B | 71.408 | Elev. Of Detention Water Surface 50 Year Storm |
| C | 70.353 | Fl. Elev. Of Elbow |
| D | 71.708 | Rim Of Overflow Riser |
| E | 69.803 | Fl. Elev. Of Outlet Pipe |
| F | 74.439 | Top Of Manhole |


| Sta "L" 14+360.118 2.547 Rt. | | |
|------------------------------|---------------|--|
| | ELEVATION (m) | DESCRIPTION |
| A | 78.348 | Detention Pipe Inlet |
| B | 79.723 | Elev. Of Detention Water Surface 50 Year Storm |
| C | 79.043 | Fl. Elev. Of Elbow |
| D | 80.023 | Rim Of Overflow Riser |
| E | 78.343 | Fl. Elev. Of Outlet Pipe |
| F | 81.590 | Top Of Manhole |

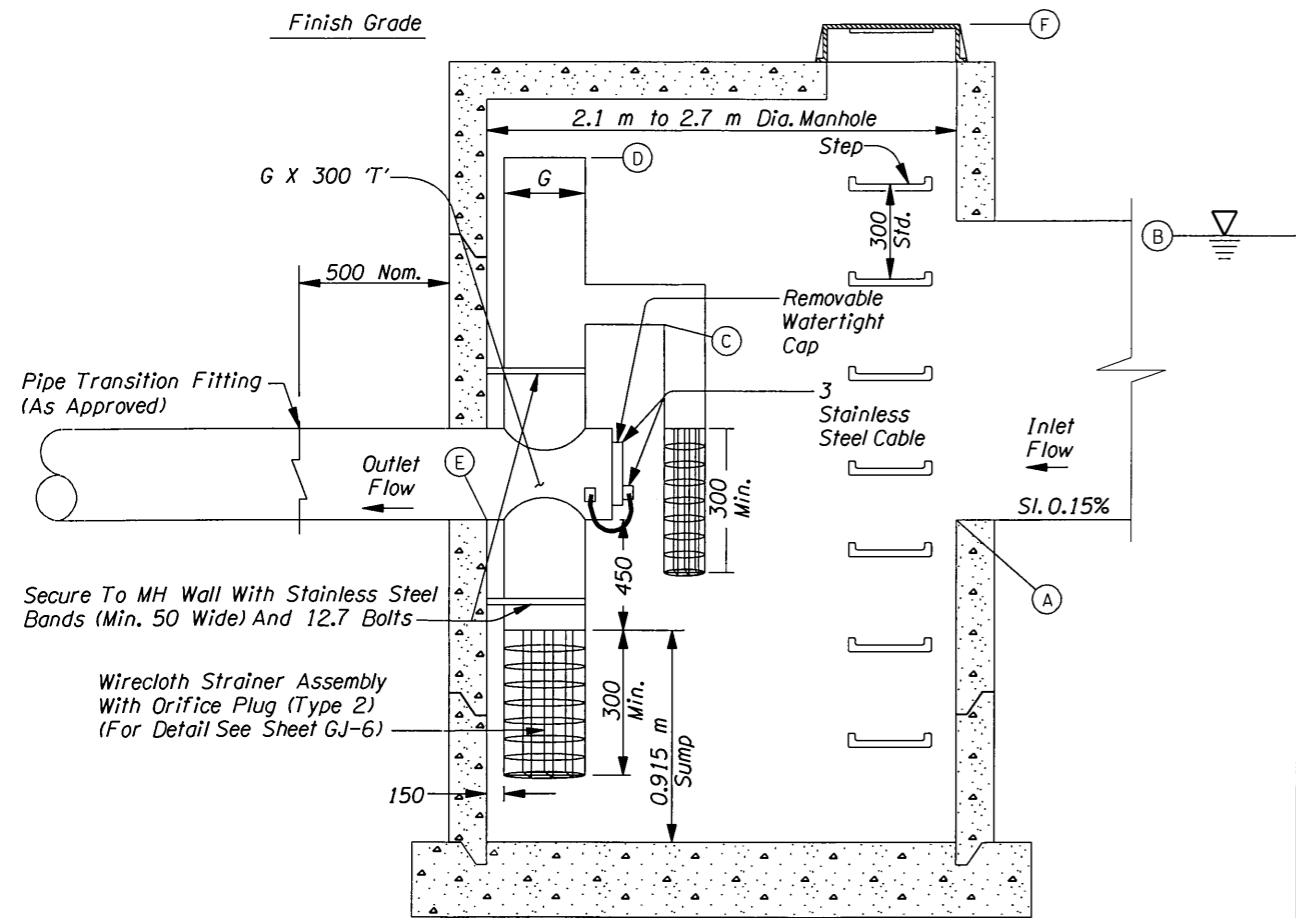

SECTION A-A
FLOW CONTROL MANHOLE
Not To Scale

| Location | G(mm) |
|--------------------------------|-------|
| Sta. "L" 14+149.633 21.510 Rt. | 250 |
| Sta. "L" 14+149.601 0.720 Lt. | 250 |
| Sta. "L" 14+061.972 16.494 Lt. | 250 |
| Sta. "L" 14+362.421 25.372 Lt. | 300 |
| Sta. "L" 14+360.118 2.547 Rt. | 450 |

All Dimensions Shown Are In Millimeters (mm) Unless Otherwise Noted

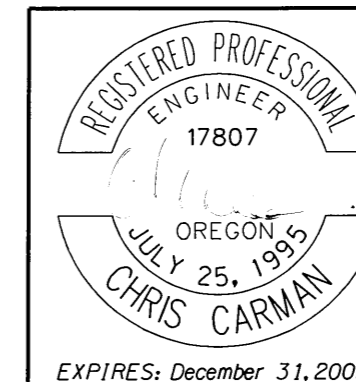


OREGON DEPARTMENT OF TRANSPORTATION
REGION 2 TECH CENTER

I-5: NORTH SANTIAM HWY. - KUEBLER BLVD. (SALEM) SEC.
PACIFIC HIGHWAY
MARION COUNTY

Reviewed By - Alvin Shoblom
Designed By - Chris Carman
Drafted By - Chris Shearer


DETAILS

SHEET NO. GJ-4

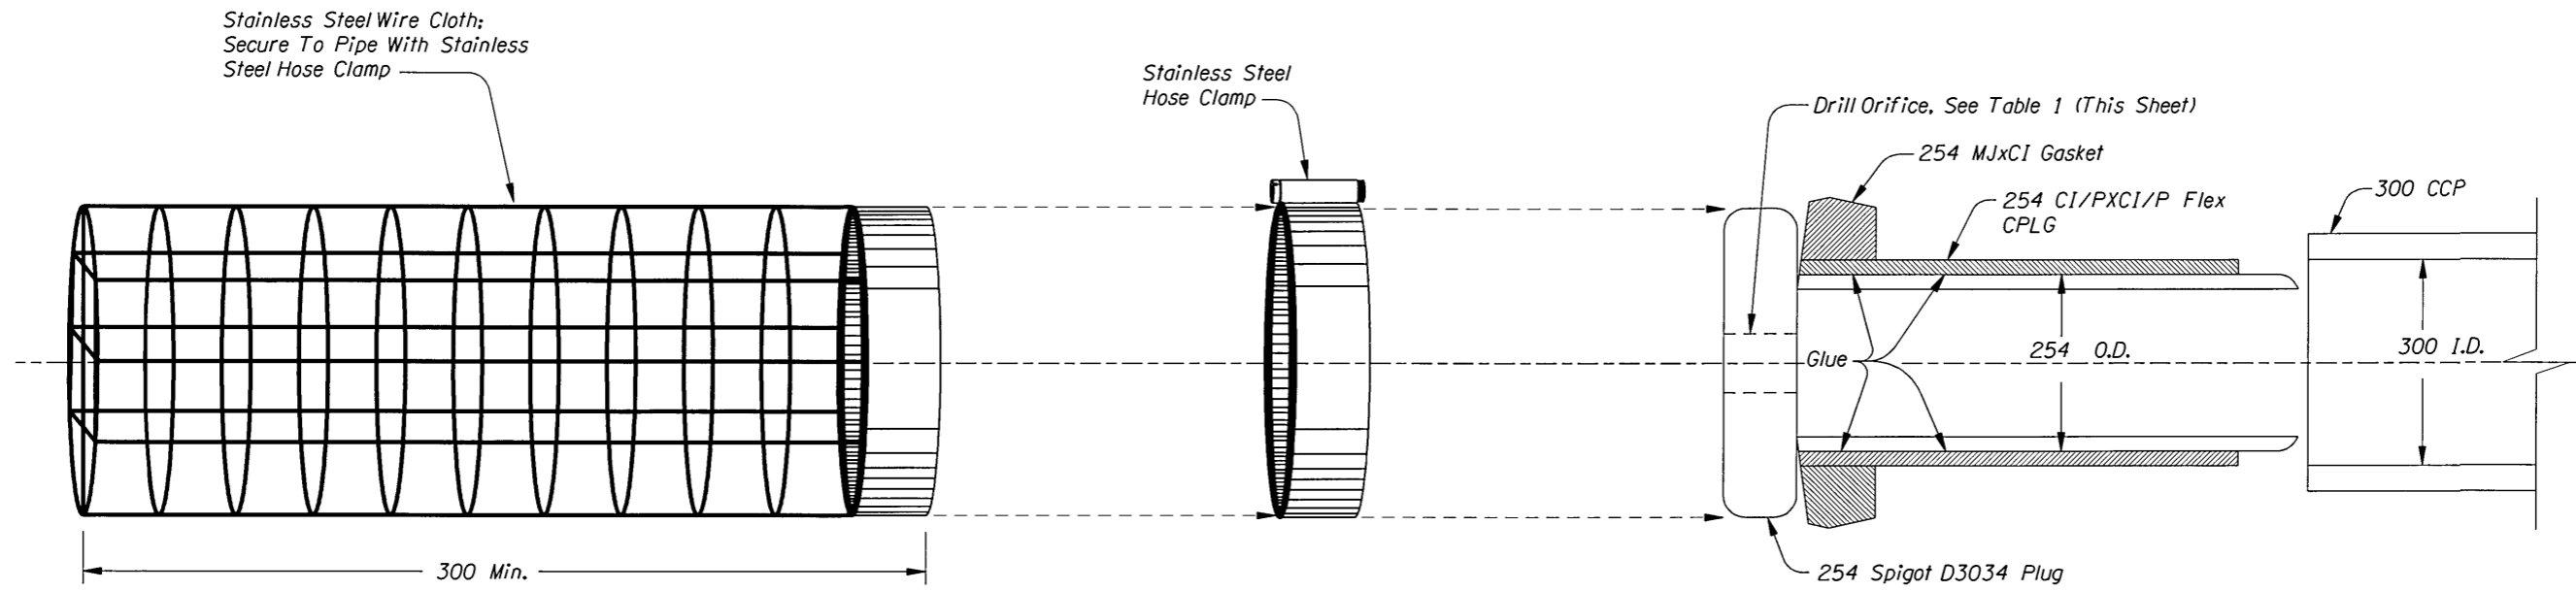

**FLOW CONTROL MANHOLE
WIRE CLOTH STRAINER ASSEMBLY**
Not To Scale

ORIFICE PLUG (TYPE 2)
Not To Scale

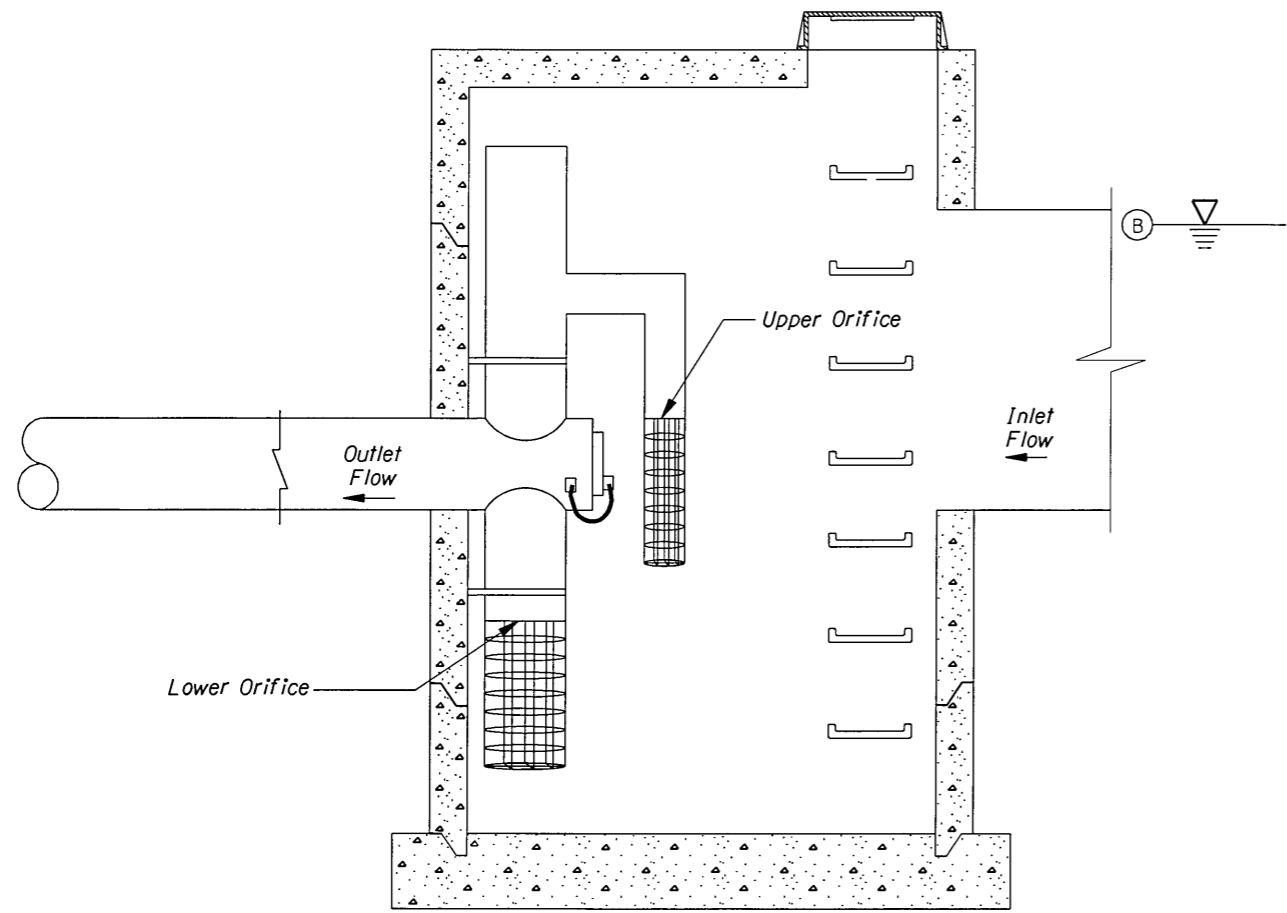


**SECTION A-A
FLOW CONTROL MANHOLE**
Not To Scale

Table 1

| Location | Lower Orifice Dia.(mm) | Upper Orifice Dia.(mm) |
|-------------------------------|------------------------|------------------------|
| North Santiam Interchange | 63.5 | N/A |
| Sta."L" 14+360.118 2.547 Rt. | 50 | 250 |
| Sta."L" 14+362.421 25.372 Lt. | 25 | 175 |
| Sta."L" 14+149.633 21.50 Rt. | 25 | 75 |
| Sta."L" 14+149.601 0.720 Lt. | 50 | 115 |
| Sta."L" 14+061.976 16.794 Lt. | 25 | 75 |
| Kuebler Blvd. Interchange | 25 | 400 |

All Dimensions Shown Are In Millimeters (mm) Unless Otherwise Noted

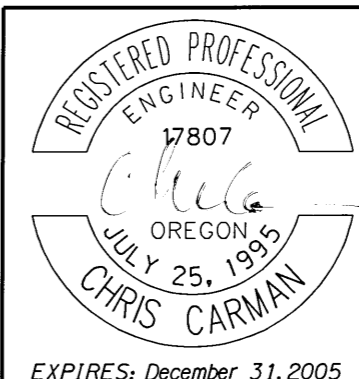


**OREGON DEPARTMENT OF TRANSPORTATION
REGION 2 TECH CENTER**

**1-5: NORTH SANTIAM HWY. -
KUEBLER BLVD. (SALEM) SEC.**
PACIFIC HIGHWAY
MARION COUNTY

Reviewed By - Alvin Shoblom
Designed By - Chris Carman
Drafted By - Chris Shearer


DETAILS

SHEET NO.
GJ-6

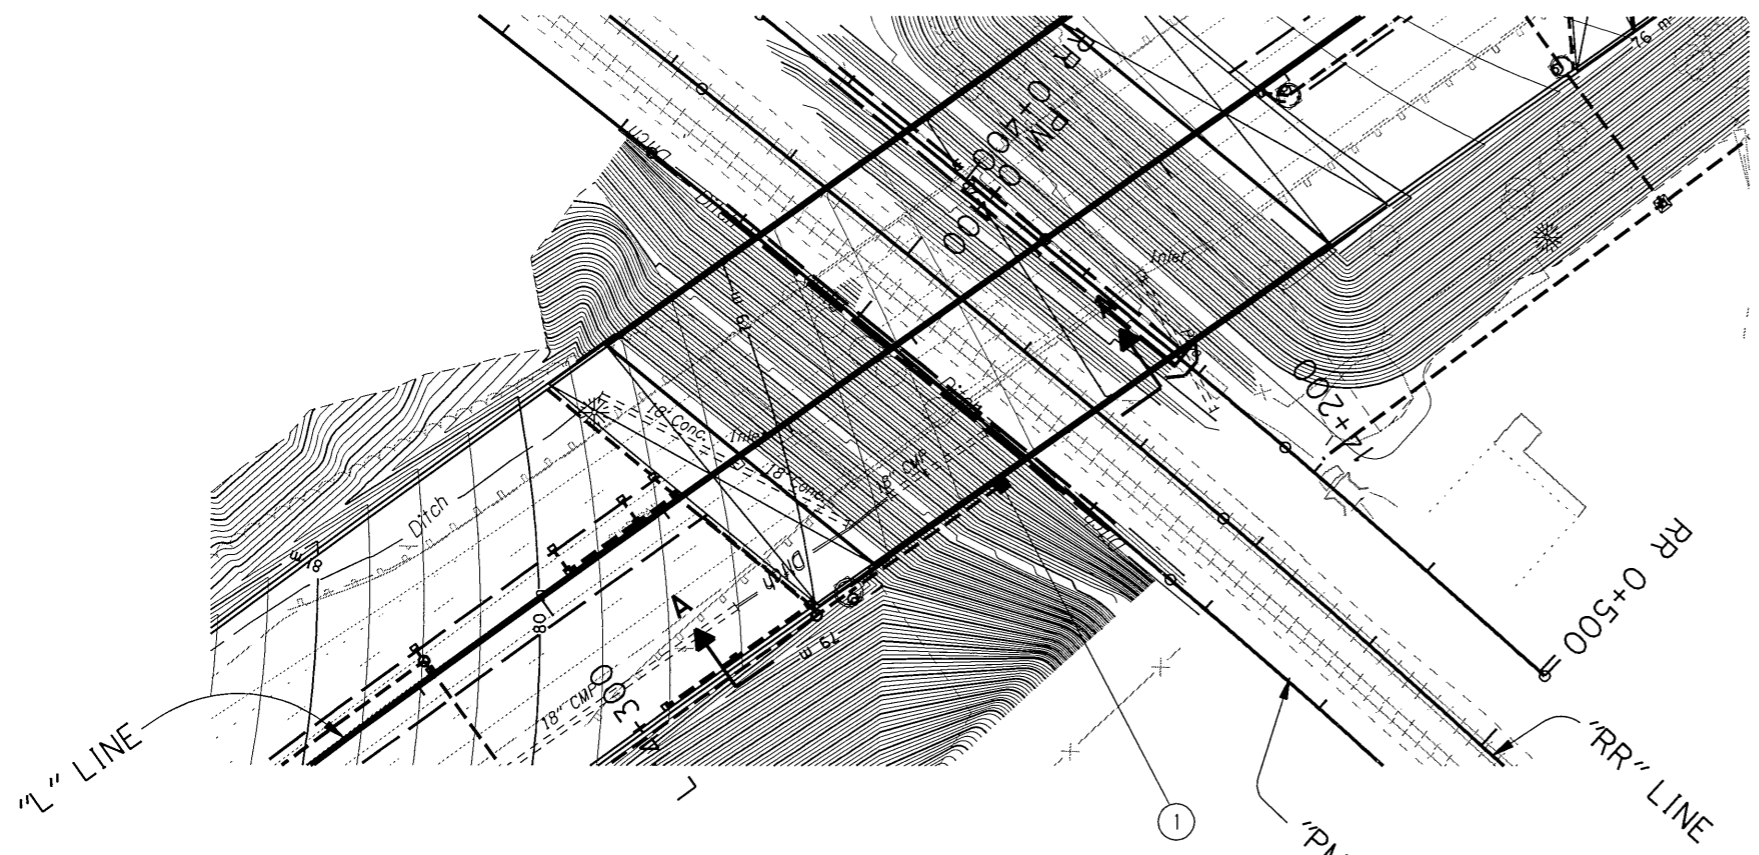


PLAN
Scale 1:1000


① Sta. "L"14+241.4 To Sta. "L"14+266.3
Const. Type Modified "D" Inlet
Inst. 300 mm Sew. Pipe - 26.5 m
Inst. Metal Pipe Slope Anchors
(See Sht. 16D, Note 6)
(See Details Below And
Drg. Nos. RD330, RD370)

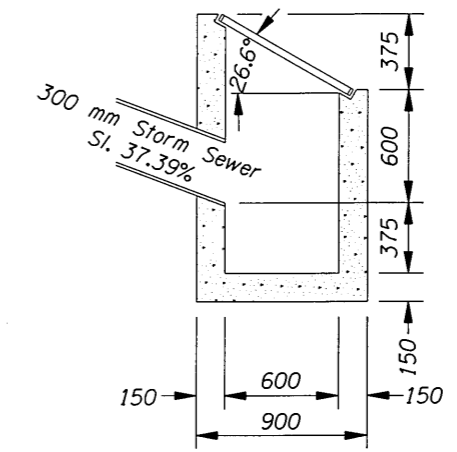



SECTION A-A

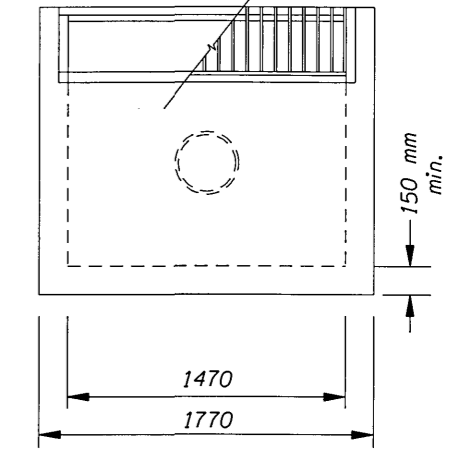

SECTION B-B

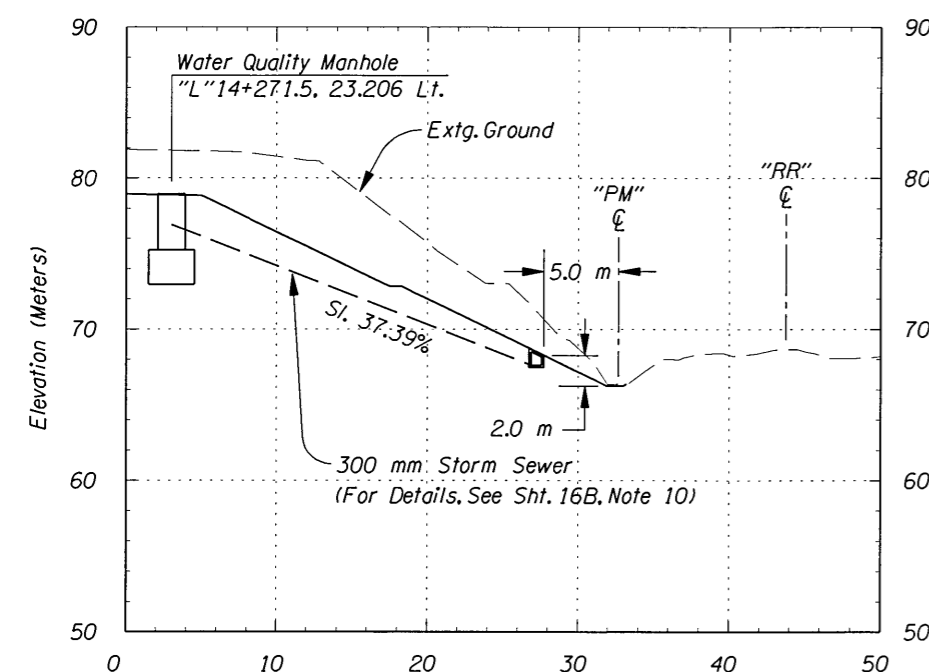


SECTION A-A

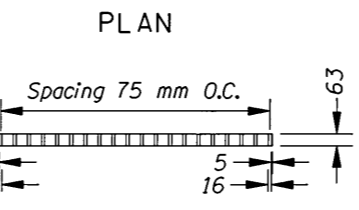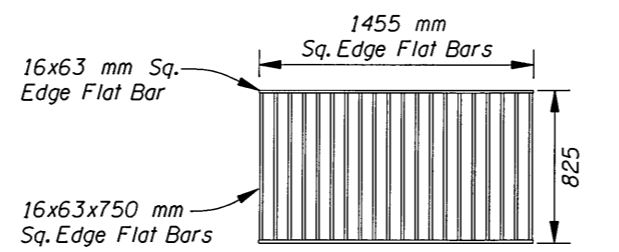


GRATE SECTION
TYPE 1


Note:
9 mm Cross Bars Shall Be Flush With The Grate Surface And
May Be Fillet Welded, Resistance Welded Or Electroforged
To Bearing Bars.

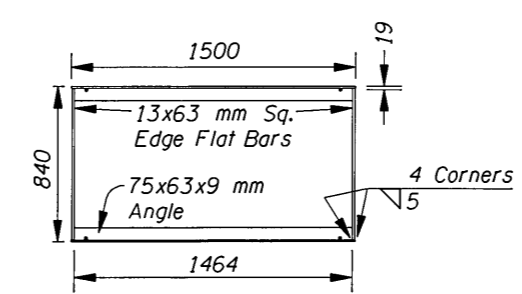

FRAME PLAN

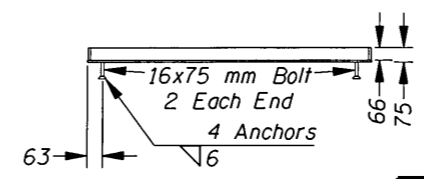

FRAME SECTION

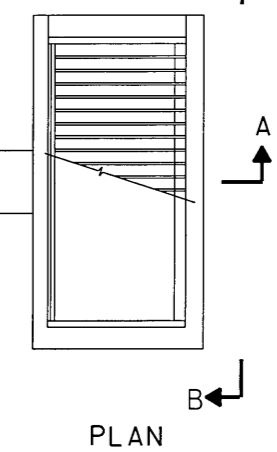

PLAN

- Notes:
1. Concrete Strength Shall Be Commercial Grade Concrete.
 2. G-2 Grates May Be Used If Approved By The Engineer.
 3. Catch Basin, Frame, And Grates Shall Meet MS18 Loading.

All Dimensions Are Shown In Millimeters (mm)
Unless Otherwise Noted.

U.P.R.R. ENERGY DISSIPATOR



**OREGON DEPARTMENT OF TRANSPORTATION
ROADWAY ENGINEERING SECTION**

1-5: N. SANTIAM HWY. -
KUEBLER BLVD. (SALEM) SEC.
PACIFIC HIGHWAY
MARION COUNTY

Reviewed By - Luis Rivas
Designed By - Chris Carman
Drafted By - Steve Donaldson

STORMWATER

SHEET NO.
GJ-9

Appendix C

Content:


- **Proprietary Structure Maintenance Requirements**

Operation & Maintenance Manual

For D00033

I-5: N. Santiam Highway Kuebler Blvd Salem, Oregon

6 RECEIVED
DEC 01 2008
OBBDP

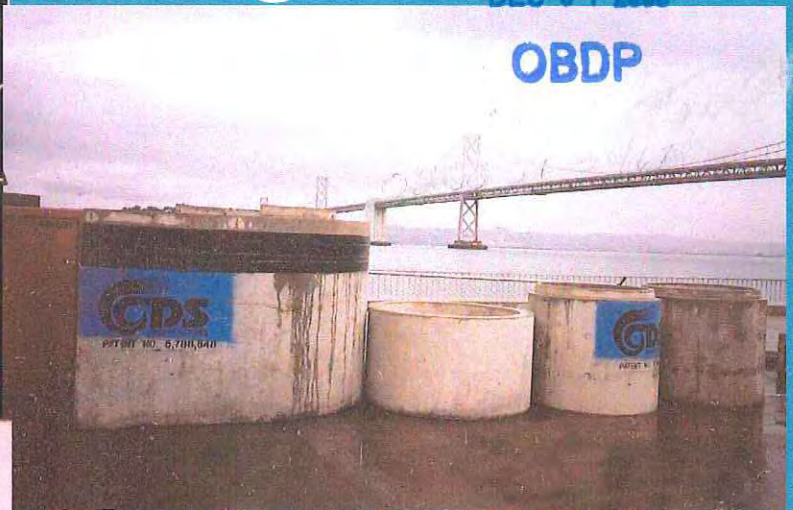

CDS Technologies
PMB #438, 4110 SE Hawthorne Blvd.
Portland, OR 97214-5246
503-872-8593
503-872-8597 fax



OPERATIONS AND MAINTENANCE GUIDELINES
For the CDS Technologies Models PMSU, PSW & PSWC
CONTINUOUS DEFLECTIVE SEPARATION UNIT

Located at

I-5: N. Santiam Highway Kuebler Blvd
Salem, OR

INTRODUCTION

The CDS unit is an important and effective component of your storm water management program and proper operation and maintenance of the unit are essential to demonstrate your compliance with local, state and federal water pollution control requirements.

The CDS technology features a patented non-blocking, indirect screening technique developed in Australia to treat water runoff. The unit is highly effective in the capture of suspended solids, fine sands and larger particles. Because of its non-blocking screening capacity, the CDS unit is un-matched in its ability to capture and retain gross pollutants such as trash and debris. In short, CDS units capture a very wide range of organic and in-organic solids and pollutants that typically result in tons of captured solids each year: total suspended solids (TSS), sediments, oil and greases and captured trash and debris (including floatables, neutrally buoyant, and negatively buoyant debris) under very high flow rate conditions.

CDS units are equipped with conventional oil baffles to capture and retain oil and grease. Laboratory evaluations show that the CDS units are capable of capturing up to 70% of the free oil and grease from storm water. CDS units can also accommodate the addition of oil sorbents within their separation chambers. The addition of the oil sorbents can ensure the permanent removal of 80% to 90% of the free oil and grease from the storm water runoff.

OPERATIONS

The CDS unit is a non-mechanical self-operating system and will function any time there is flow in the storm drainage system. The unit will continue to effectively capture pollutants in flows up to the design capacity even during extreme rainfall events when the design capacity may be exceeded. Pollutants captured in the CDS unit's separation chamber and sump will be retained even when the units design capacity is exceeded.

CDS UNIT CLEANOUT

The frequency of cleaning the CDS unit will depend upon the generation of trash and debris and sediments in your application. Cleanout and preventive maintenance schedules will be determined based on operating experience unless precise pollutant loadings have been determined. The unit should be periodically inspected to determine the amount of accumulated pollutants and to ensure that the cleanout frequency is adequate to handle the predicted pollutant load being processed by the CDS unit. The recommended cleanout of solids within the CDS unit's sump should occur at 75% of the sump capacity. However, the sump may be completely full with no impact to the CDS unit's performance.

Access to the CDS unit is typically achieved through two manhole access covers – one allows inspection and cleanout of the separation chamber (screen/cylinder) & sump and another allows inspection and cleanout of sediment captured and retained behind the screen. The PSW & PSWC off-line models have an additional access cover over the weir of the diversion vault. For units possessing a sizable depth below grade (depth to pipe), a single manhole access point would allow both sump cleanout and access behind the screen.

CDS Technologies Recommends The Following:

NEW INSTALLATIONS – Check the condition of the unit after every runoff event for the first 30 days. The visual inspection should ascertain that the unit is functioning properly (no blockages or obstructions to inlet and/or separation screen), measuring the amount of solid materials that have accumulated in the sump, the amount of fine sediment accumulated behind the screen, and determining the amount floating trash and debris in the separation chamber. This can be done with a calibrated “dip stick” so that the depth of deposition can be tracked. Refer to **Appendix A – Annual Record of Maintenance & Cleanout Elevation View** for allowable deposition depths and critical distances. Schedules for inspections and cleanout should be based on storm events and pollutant accumulation.

ONGOING OPERATION – During the rainfall season, the unit should be inspected at least once every 30 days. The floatables should be removed and the sump cleaned when the sump is 75-85% full. If floatables accumulate more rapidly than the settleable solids, the floatables should be removed using a vactor truck or dip net before the layer thickness exceeds one to two feet.

Cleanout of the CDS unit at the end of a rainfall season is recommended because of the nature of pollutants collected and the potential for odor generation from the decomposition of material collected and retained. This end of season cleanout will assist in preventing the discharge of pore water from the CDS® unit during summer months.

USE OF SORBENTS – It needs to be emphasized that the addition of sorbents is not a requirement for CDS units to effectively control oil and grease from storm water. The conventional oil baffle within a unit assures satisfactory oil and grease removal. However, the addition of sorbents is a unique enhancement capability special to CDS units, enabling increased oil and grease capture efficiencies beyond that obtainable by conventional oil baffle systems.

Under normal operations, CDS units will provide effluent concentrations of oil and grease that are less than 15 parts per million (ppm) for all dry weather spills where the volume is less than or equal to the spill capture volume of the CDS unit. During wet weather flows, the oil baffle system can be expected to remove between 40 and 70% of the free oil and grease from the storm water runoff.

CDS Technologies only recommends the addition of sorbents to the separation chamber if there are specific land use activities in the catchment watershed that could produce exceptionally large concentrations of oil and grease in the runoff,

concentration levels well above typical amounts. If site evaluations merit an increased control of free oil and grease then oil sorbents can be added to the CDS unit to thoroughly address these particular pollutants of concern.

Recommended Oil Sorbents

Rubberizer® Particulate 8-4 mesh or OARS™ Particulate for Filtration, HPT4100 or equal. Rubberizer® is supplied by Haz-Mat Response Technologies, Inc. 4626 Santa Fe Street, San Diego, CA 92109 (800) 542-3036. OARS™ is supplied by AbTech Industries, 4110 N. Scottsdale Road, Suite 235, Scottsdale, AZ 85251 (800) 545-8999.

The amount of sorbent to be added to the CDS separation chamber can be determined if sufficient information is known about the concentration of oil and grease in the runoff. Frequently the actual concentrations of oil and grease are too variable and the amount to be added and frequency of cleaning will be determined by periodic observation of the sorbent. As an initial application, CDS recommends that approximately 4 to 8 pounds of sorbent material be added to the separation chamber of the CDS units per acre of parking lot or road surface per year. Typically this amount of sorbent results in a ½ inch to one (1") inch depth of sorbent material on the liquid surface of the separation chamber. The oil and grease loading of the sorbent material should be observed after major storm events. Oil Sorbent material may also be furnished in pillow or boom configurations.

The sorbent material should be replaced when it is fully discolored by skimming the sorbent from the surface. The sorbent may require disposal as a special or hazardous waste, but will depend on local and state regulatory requirements.

CLEANOUT AND DISPOSAL

A vactor truck is recommended for cleanout of the CDS unit and can be easily accomplished in less than 30-40 minutes for most installations. Standard vactor operations should be employed in the cleanout of the CDS unit. Disposal of material from the CDS unit should be in accordance with the local municipality's requirements. Disposal of the decant material to a POTW is recommended. Field decanting to the storm drainage system is not recommended. Solids can be disposed of in a similar fashion as those materials collected from street sweeping operations and catch-basin cleanouts.

MAINTENANCE

The CDS unit should be pumped down at least once a year and a thorough inspection of the separation chamber (inlet/cylinder and separation screen) and oil baffle performed. The unit's internal components should not show any signs of damage or any loosening of the bolts used to fasten the various components to the manhole structure and to each other. Ideally, the screen should be power washed for the

inspection. If any of the internal components is damaged or if any fasteners appear to be damaged or missing, please contact CDS Technologies to make arrangements to have the damaged items repaired or replaced:

CDS Technologies, Inc.
16360 Monterey Road, Suite 250
Morgan Hill, CA 95037-5406

Phone, Toll Free: (888) 535-7559
Fax: (408) 782-0721

The screen assembly is fabricated from Type 316 stainless steel and fastened with Type 316 stainless steel fasteners that are easily removed and/or replaced with conventional hand tools. The damaged screen assembly should be replaced with the new screen assembly placed in the same orientation as the one that was removed.

CONFINED SPACE

The CDS unit is a confined space environment and only properly trained personnel possessing the necessary safety equipment should enter the unit to perform maintenance or inspection procedures. Inspections of the internal components can, in most cases, be accomplished through observations from the ground surface.

RECORDS OF OPERATION AND MAINTENANCE

CDS Technologies recommends that the owner maintain annual records of the operation and maintenance of the CDS unit to document the effective maintenance of this important component of your storm water management program. The attached **Annual Record of Operations and Maintenance** form (see **Appendix A**) is suggested and should be retained for a minimum period of three years.



STORM WATER • CSO/SSO • WASTEWATER

Date: 11/20/2006

Project: I-5: N. Santiam Highway Kuebler Blvd

Subject: Maintenance Pump Volume – Replacement Oil Sorbent Quantity

Location: Salem, OR

CDS Model Number: PMSU20_15_4 (2)

The CDS PMSU20_15_14, 0.7 unit installed at the I-5: N. Santiam Highway Kuebler Blvd project in Salem, OR is designed with 1.39 cubic yards (38 cubic feet) (282 gallons) of storage volume. This volume includes the pounds of sediments that will settle inside of the sump, fine sediment on the separation slab, trash and debris along with the water. Once the unit is maintained the above listed volume of water should be added to the cleaned unit to prepare for treatment of the next storm event.

If oil sorbent material is to be used in this unit, 8 sorbent booms are recommended to be installed inside the fiberglass cylinder on the water surface. This material will provide 80% removal of floatable oil and grease in storm water at an average concentration of 15 ppm. It is recommended that booms are replaced more frequently if higher oil and grease loadings occur.

Please contact CDS Technologies to coordinate ordering new oil sorbent material or see page 3 of this manual for manufacturers of the sorbent material if you wish to order it direct.



APPENDIX A
ANNUAL RECORD OF
OPERATIONS AND MAINTENANCE
&
CLEANOUT ELEVATION VIEW
(PROJECT SPECIFIC)

**CDS TECHNOLOGIES
ANNUAL RECORD
OF
OPERATION AND MAINTENANCE**

OWNER _____
ADDRESS _____
OWNER REPRESENTATIVE _____ **PHONE** _____

CDS INSTALLATION:

MODEL DESIGNATION _____ DATE _____
 SITE LOCATION _____
 DEPTH FROM COVER TO BOTTOM OF SUMP _____
 VOLUME OF SUMP _____ CUYD VOLUME/INCH DEPTH _____ CUYD

INSPECTIONS:

| DATE/INSPECTOR | SCREEN INTEGRITY | FLOATABLES DEPTH | SEDIMENT VOLUME | SORBENT DISCOLORATION |
|----------------|------------------|------------------|-----------------|-----------------------|
| | | | | |
| | | | | |
OBSERVATIONS OF FUNCTION: _____

CLEANOUT:

| DATE | VOLUME FLOATABLES | VOLUME SEDIMENTS | METHOD OF DISPOSAL OF FLOATABLES, SEDIMENTS, DECANT AND SORBENTS |
|------|-------------------|------------------|--|
| | | | |
| | | | |
| | | | |
| | | | |

OBSERVATIONS: _____

SCREEN MAINTENANCE:

DATE OF POWER WASHING, INSPECTION AND OBSERVATIONS: _____

CERTIFICATION: _____ **TITLE:** _____
DATE: _____





APPENDIX B
SITE LOCATION PLANS
(PROJECT SPECIFIC)

CLEAN OUT VIEW

CDS MODEL PMSU20_15_4, 0.7 CFS CAPACITY
 CDS 2 Sta. 14+149 LT 20.7

☉ RISER &
 SEPARATION
 SECTION

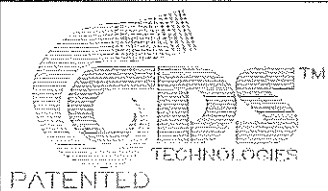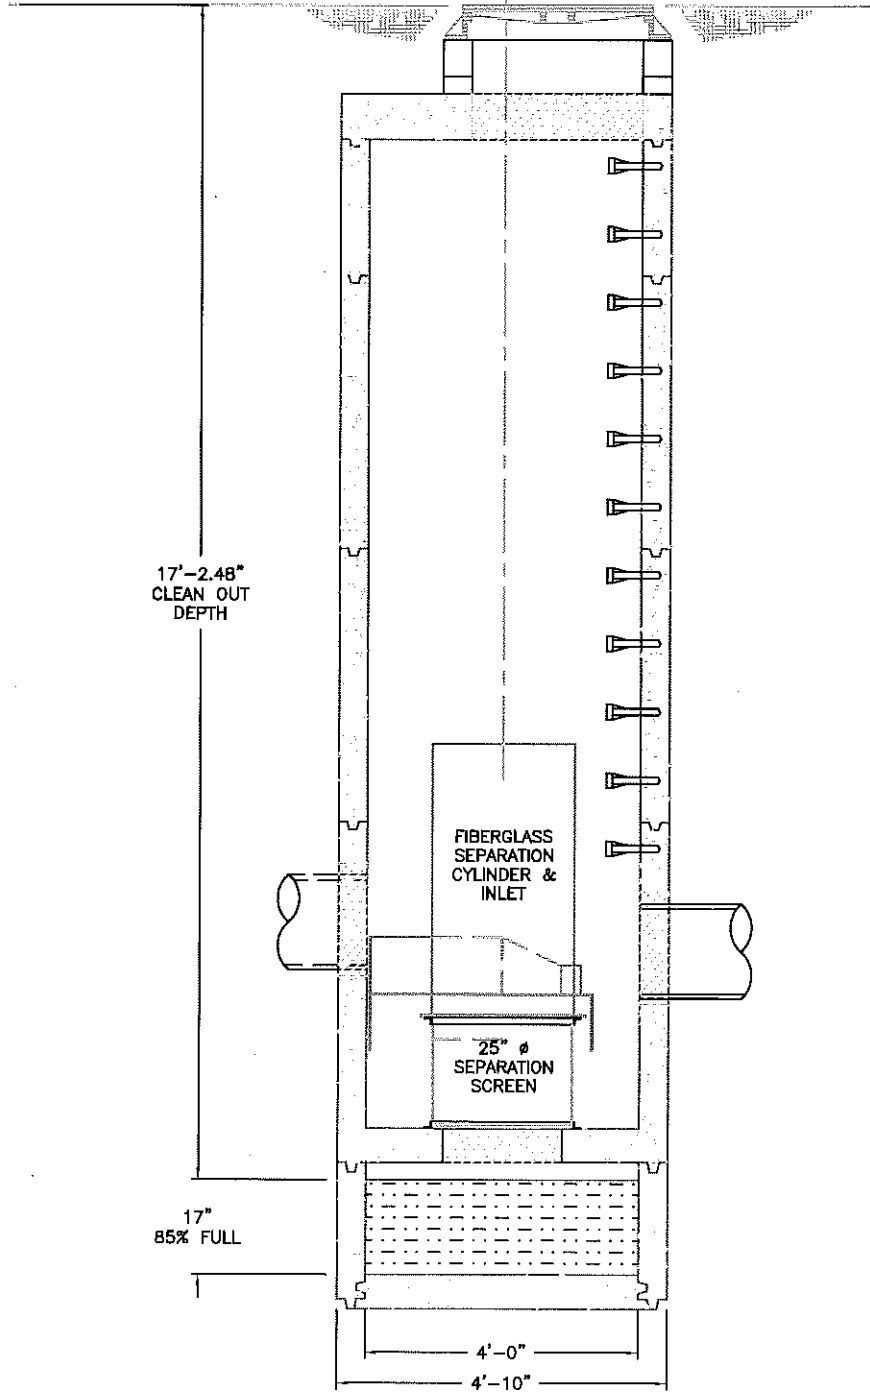

I-5 N Santiam Hwy
 Kuebler Blvd
 Salem Oregon

| | |
|---------|----------|
| DATE | 01/10/06 |
| DRAWN | D.J. |
| APPROV. | |


| | |
|-------|-------|
| SCALE | 1"=4' |
| SHEET | 02 |

APPENDIX B
SITE LOCATION PLANS

(PROJECT SPECIFIC)

SITE PLAN VIEW

CDS MODEL PMSU20_15_4, 0.7 CFS CAPACITY
CDS 2 Sta. 14+149 LT 16.7

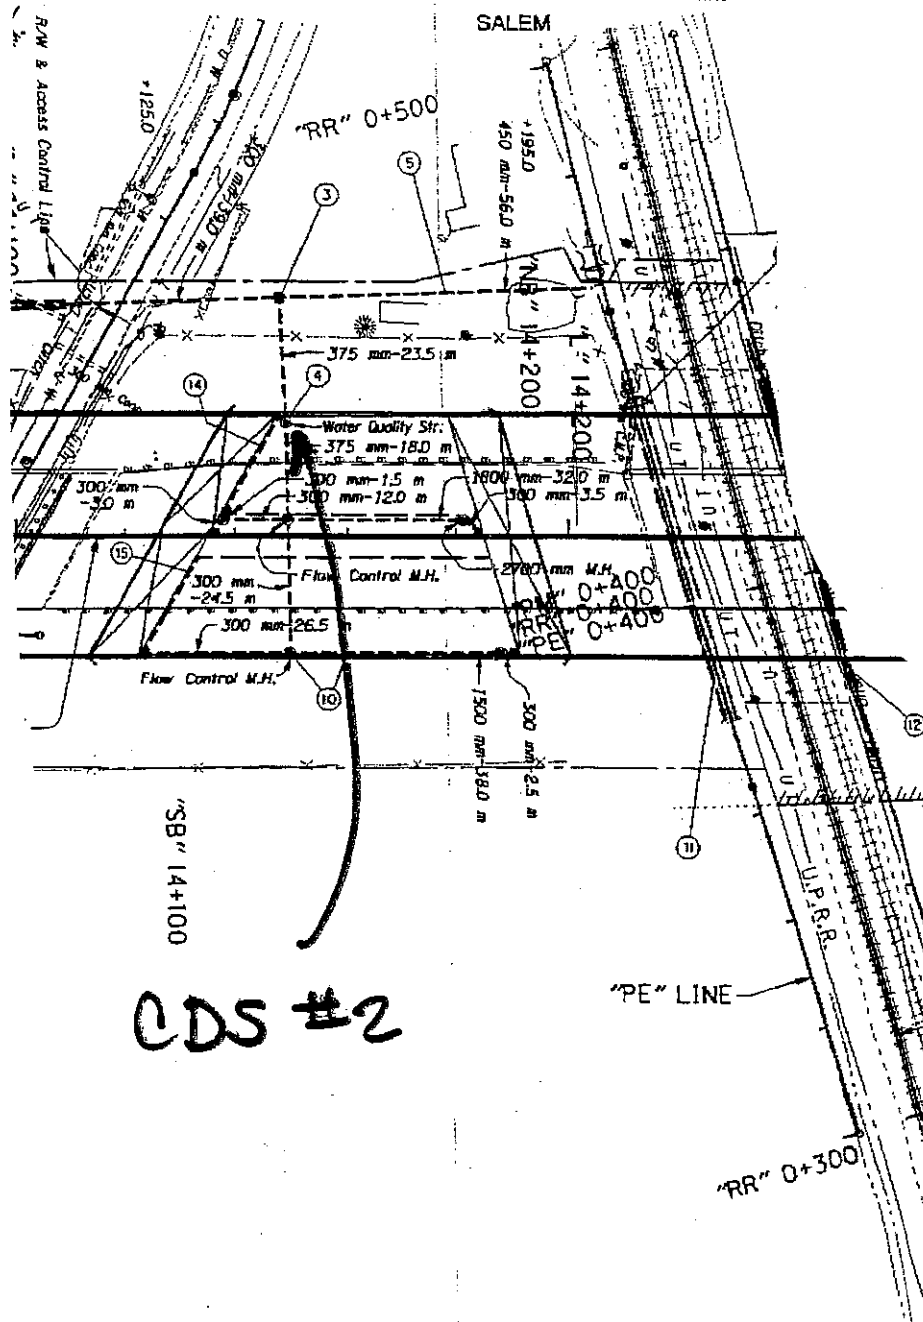

CDS #2



I-5 N Santiam Hwy
Kuebler Blvd
Salem Oregon


| | | |
|---------|----------|--|
| DATE | 01/10/06 | SCALE 1"=4' SHEET S2 |
| DRAWN | D.J. | |
| APPROV. | | |

SC

APPENDIX C
PLAN & PROFILE DRAWINGS
(PROJECT SPECIFIC)

PLAN VIEW

CDS MODEL PMSU20_15_4, 0.7 CFS CAPACITY
CDS 2 Sta. 14+149 LT 20.7

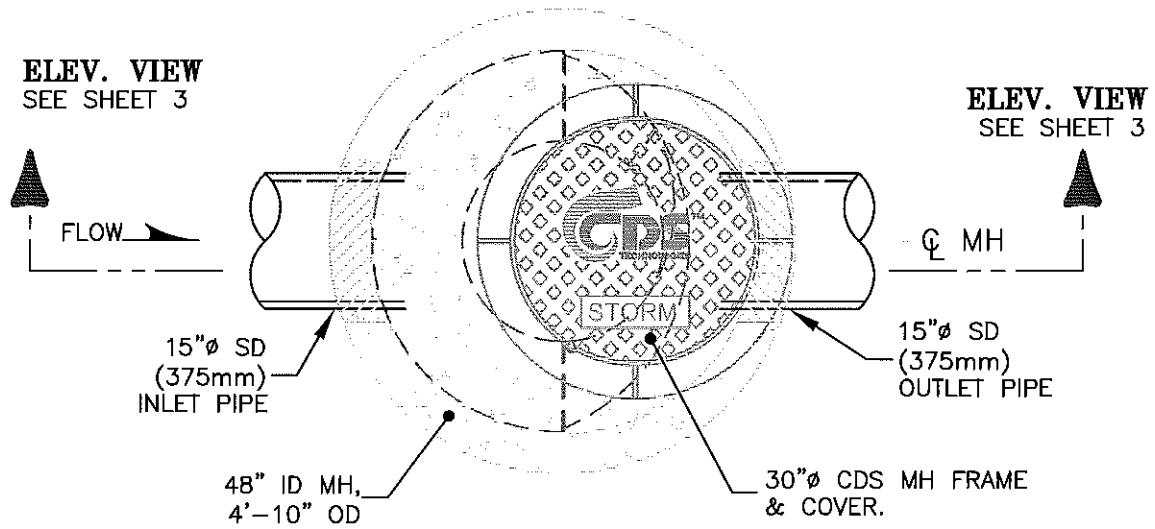


I-5 N Santiam Hwy
Kuebler Blvd
Salem Oregon

| | |
|---------|----------|
| DATE | 07/21/06 |
| DRAWN | D.J. |
| APPROV. | |

| | |
|-------|-------|
| SCALE | 1"=2' |
| SHEET | 5 |

SECTION CUT

CDS MODEL PMSU20_15_4, 0.7 CFS CAPACITY
CDS 2 Sta. 14+149 LT 20.7

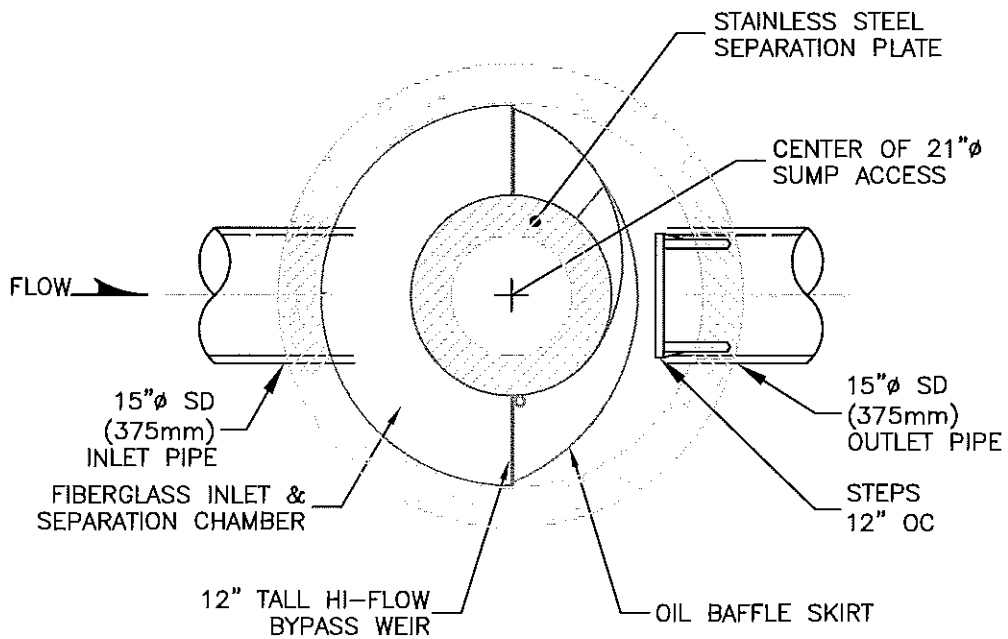


I-5 N Santiam Hwy
Kuebler Blvd
Salem Oregon

| | | |
|---------|----------|-------|
| DATE | 07/21/06 | SCALE |
| DRAWN | D.J. | 1"=2' |
| APPROV. | | SHEET |
| | | 6 |

30

ELEVATION VIEW

CDS MODEL PMSU20_15_4, 0.7 CFS CAPACITY
CDS 2 Sta. 14+149 LT 20.7

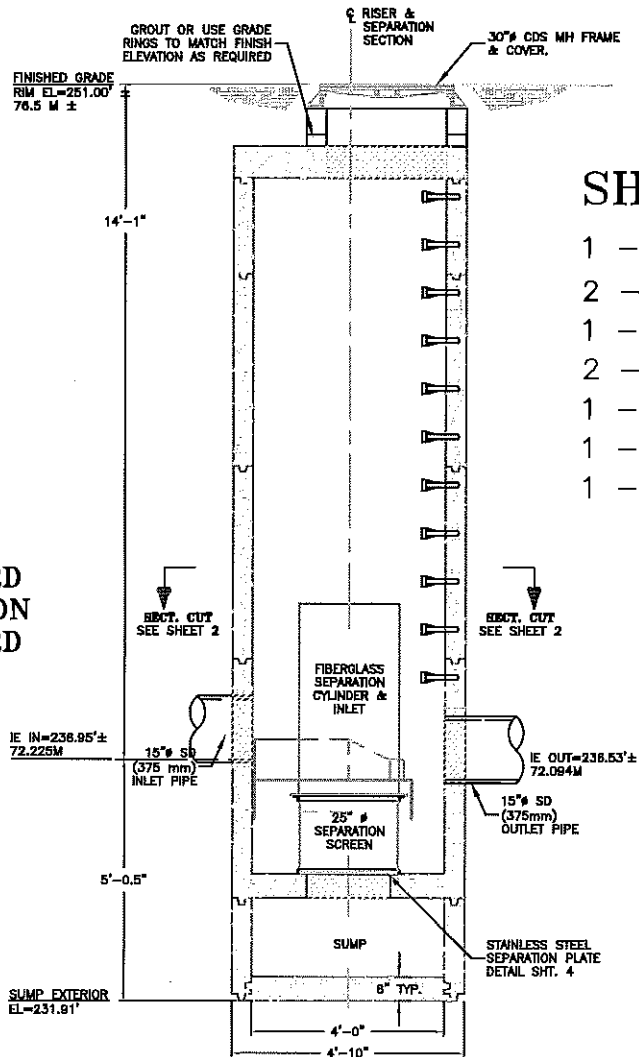

SHIPPING MATERIAL:

- 1 - 30"Ø CDS FRAME AND COVER
- 2 - 30" X 4" GRADE RING
- 1 - 48"Ø FLAT CAP
- 2 - 48"Ø X 48" RISER SECTION
- 1 - 48"Ø X 36" RISER SECTION
- 1 - 48"Ø X 60" SEPERATION SECTION
- 1 - 48"Ø X 24" SUMP BASE

NOTE:
NON-STANDARD
INLET LOCATION
NON-STANDARD
WIER HEIGHT



I-5 N Santiam Hwy
Kuebler Blvd
Salem Oregon

DATE 07/21/06

DRAWN D.J.

APPROV.

SCALE
1"=4'

SHEET

7