

# OPERATION & MAINTENANCE MANUAL

**DFI No.: D00034**

**Facility Type: Water Quality Manhole**



**MARCH, 2011**

**INDEX**

**1. IDENTIFICATION ..... 1**

**2. FACILITY CONTACT INFORMATION..... 1**

**3. CONSTRUCTION..... 1**

**4. STORM DRAIN SYSTEM AND FACILITY OVERVIEW ..... 2**

**5. FACILITY HAZ MAT SPILL FEATURE(S)..... 7**

**6. AUXILIARY OUTLET ..... 7**

**7. MAINTENANCE REQUIREMENTS ..... 7**

**8. WASTE MATERIAL HANDLING ..... 8**

**APPENDIX A: Operational Plan and Profile Drawing(s)**

**APPENDIX B: ODOT Project Plan Sheets**

**APPENDIX C: Proprietary Structure Maintenance Requirements**

## 1. Identification

Drainage Facility ID (DFI): **D00034**

Facility Type: Water Quality Manhole

Construction Drawings: (V-File Number) 38V-117

Location: District: 3

Highway No.: 001

Mile Post: 252.14; 252.14 (beg./end)

Description: This facility is located behind a concrete barrier along the right shoulder of the northbound lanes of I-5 (Hwy 001), immediately south of bridge No. 20026 (U.P.R.R. overcrossing).

## 2. Facility Contact Information

Contact the Engineer of Record, Region Technical Center, or Geo-Environmental's Senior Hydraulics Engineer for:

- Operational clarification
- Maintenance clarification
- Repair or restoration assistance

Or

Region Technical Center (Geo-Hydro)

Or

Geo-Environmental Senior Hydraulics Engineer (503) 986-3365.

## 3. Construction

Engineer of Record:

ODOT Designer – Region 2 Tech. Center  
Chris Carman, (503) 986-2691

Facility construction: 2005

Contractor: Hamilton Construction Company

#### **4. Storm Drain System and Facility Overview**

This water quality manhole is an underground facility designed to treat stormwater runoff. The system is a proprietary product manufactured by Contech Solutions. This system is a CDS Model PMSU30\_30 designed to remove sediments, oils, and debris from the stormwater. Stormwater enters the diversion chamber where the diversion weir guides the flow into the unit's separation chamber and pollutants are removed from the runoff. This facility contains an Operational and Maintenance manual as prepared by the manufacturer and is provided in Appendix C.

This water quality manhole facility is just over 15 feet in depth, 72-inches in its inside diameter, and located on the southeastern side of the northbound travel lanes of I-5 (Hwy 001); see Photo 1 and Photo 2 for a view of the facility and neighboring features. Also refer to Point A in the Operational Plan found in Appendix A. The facility is separated from the travel lanes and shoulder of I-5 by a concrete barricade. The facility receives runoff from a series of catch basins immediately south to southwest of the U.P.R.R. overcrossing (Bridge No. 20026) that enter a nearby manhole. The flows from nearby detention facilities, including D00038 and D00039, are also routed to this facility for treatment via a 24-inch storm pipe. The facility also receives stormwater runoff collected by a roadside ditch and ditch inlet that conveys the runoff from a nearby hillside directly into the water quality manhole (Photo 1). Refer to Photo 3 for the drainage area for the facility including the roadside ditch.

After treatment through the manhole, the water is conveyed north and northeast down the embankment to a ditch/inlet outlet structure. The outlet structure serves as an energy dissipater and discharges the water through the rim and grate of the structure into a nearby drainage ditch that travels along the south side of the U.P.R.R corridor.

For further information and details regarding the system refer to Appendix A for the Operational Plan and Profile Drawing, to Appendix B for as-built drawings, and to Appendix C for the Proprietary Structure Maintenance Requirements.



Photo 1: Photo looking at water quality manhole and ditch inlet towards the north at the U.P.R.R corridor overpass.



Photo 2: Water quality facility location with northbound travel lanes of I-5 (Hwy 001).



Photo 3: Area of highway that drains towards facility. To the left is the roadside ditch that is collected by the ditch inlet adjacent to the water quality manhole.



Photo 4: Inside view of water quality manhole looking at separation cylinder filled with floating debris.



Photo 5: This photo depicts the access ladder for the facility.



Photo 6: The ditch inlet (2 grates) serves as the outlet structure for the stormwater treated through the water quality manhole facility.



Photo 7: The drainage ditch receiving the water from the ditch inlet-outlet structure.

A. Maintenance equipment access:

This facility is located behind a concrete barrier just south of the U.P.R.R. overpass. For typical maintenance using a vacuum truck, the 12-foot shoulder should serve adequately. Vehicle access behind the barrier is prohibited due to difficult maneuverability. Hand equipment will need to be used to maintain the vegetation around the facility.

B. Heavy equipment access into facility:

- Allowed (no limitations)
- Allowed (with limitations)
- Not allowed

C. Special Features:

- Amended Soils
- Porous Pavers
- Liners
- Underdrains



## 5. Facility Haz Mat Spill Feature(s)

This manhole facility does not have features to block liquid from draining from the manhole. In an emergency, the manhole just upstream of the facility can be used to block hazardous liquids.

## 6. Auxiliary Outlet

Auxiliary Outlets are provided if the primary outlet control structure can not safely pass the projected high flows. Broad-crested spillway weirs and over flow risers are the two most common auxiliary outlets used in stormwater treatment facility design. The auxiliary outlet feature is either a part of the facility or an additional storm drain feature/structure.

The auxiliary outlet feature for this facility is:

Designed into facility

High flows bypass the treatment features and exit the manhole by draining into an interior high flow bypass weir. See Appendix C.

Other, as noted below

## 7. Maintenance Requirements

Routine maintenance table for non-proprietary stormwater treatment and storage/detention facilities have been incorporated into ODOT's Maintenance Guide. These tables summarize the maintenance requirements for ponds, swales, filter strips, bioslopes, and detention tanks and vaults. Special maintenance requirements in addition to the routine requirements are noted below when applicable.

The ODOT Maintenance Guide can be viewed at the following website:

<http://www.oregon.gov/ODOT/HWY/OOM/MGuide.shtml>

Maintenance requirements for proprietary structures, such as underground water quality manholes and/or vaults with filter media are noted in Appendix C when applicable.

The following stormwater facility maintenance table (See ODOT Maintenance Guide) should be used to maintain the facility outlined in this Operation and Maintenance Manual or follow the Maintenance requirements outlined in Appendix C when proprietary structure is selected below:

- Table 1 (general maintenance)
- Table 2 (stormwater ponds)
- Table 3 (water quality biofiltration swales)
- Table 4 (water quality filter strips)
- Table 5 (water quality bioslopes)
- Table 6 (detention tank)
- Table 7 (detention vault)
- Appendix C (proprietary structure)

Special Maintenance requirements: See Appendix C and the Proprietary Structure Maintenance Requirements for an O&M Manual specifically written for the water quality structure.

Note: Special maintenance Requirements Require Concurrence from ODOT SR Hydraulics Engineer.

## 8. Waste Material Handling

Material removed from the facility is defined as waste by DEQ. Refer to the roadwaste section of the ODOT Maintenance Yard Environmental Management System (EMS) Policy and Procedures Manual for disposal options: <http://egov.oregon.gov/ODOT/HWY/OOM/EMS.shtml>


Contact any of the following for more detailed information about management of waste materials found on site:

ODOT Clean Water Unit	(503) 986-3008
ODOT Statewide Hazmat Coordinator	(503) 229-5129
ODOT Region Hazmat Coordinator	(503) 986-2647
ODEQ Northwest Region Office	(503) 229-5263


# Appendix A

## Content:


- **Operational Plan and Profile Drawing(s)**

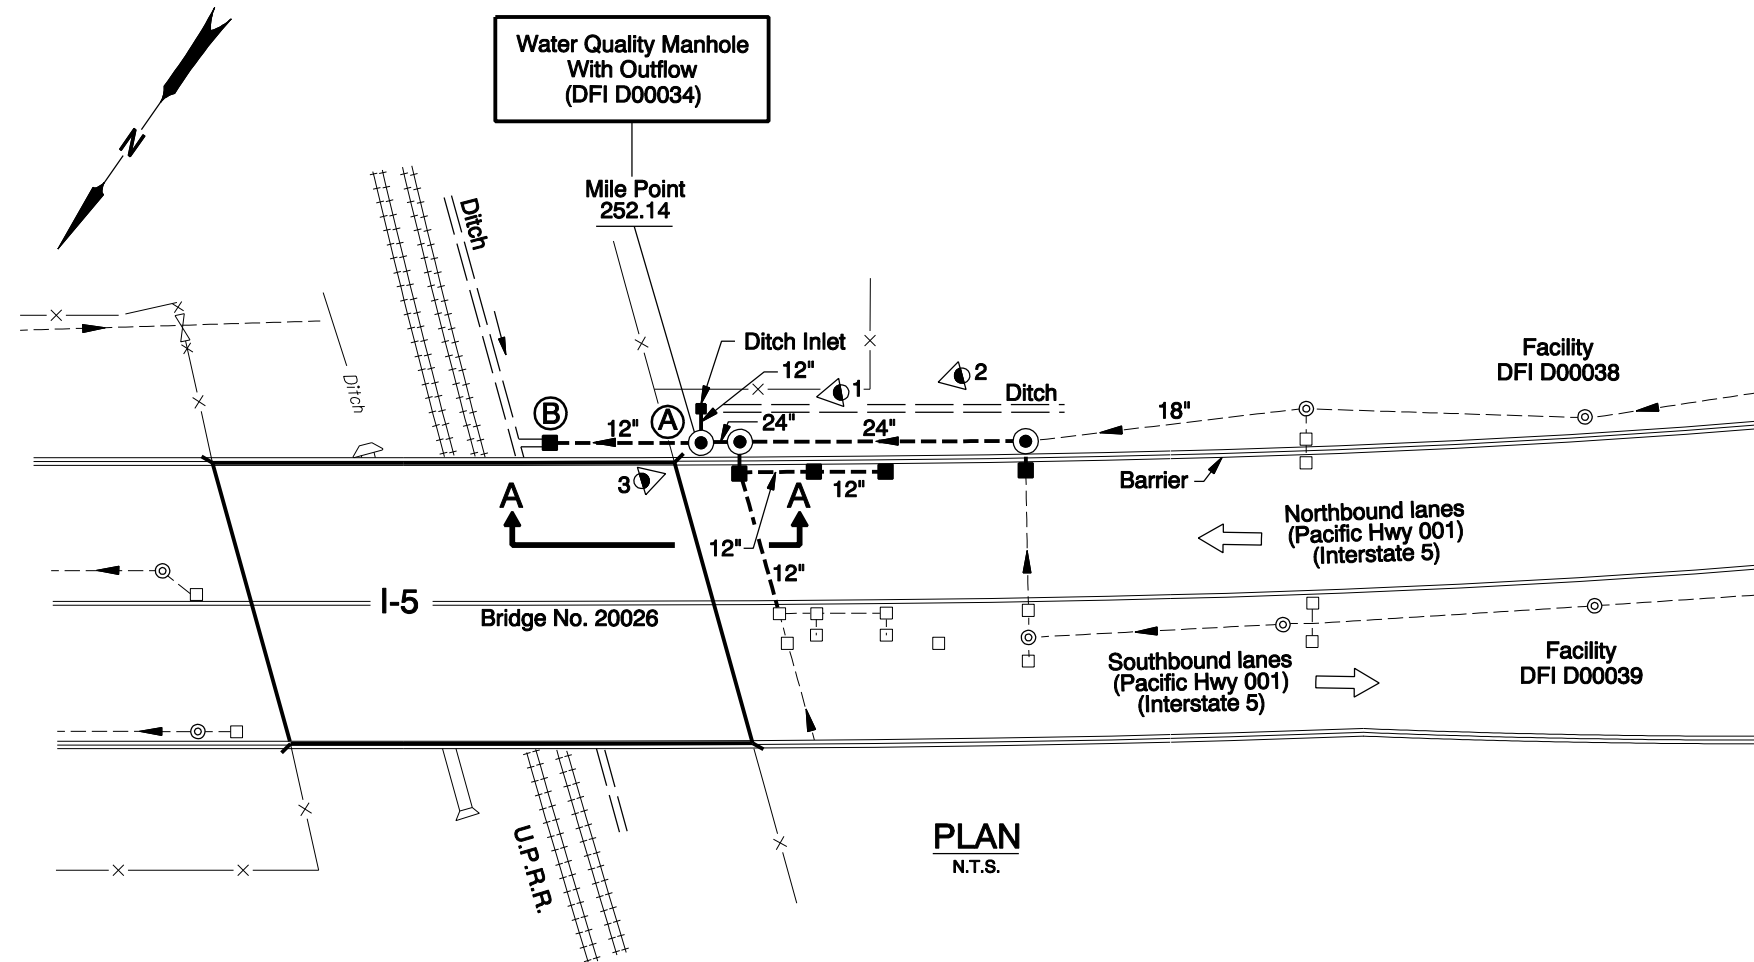

**PLAN**  
N.T.S.

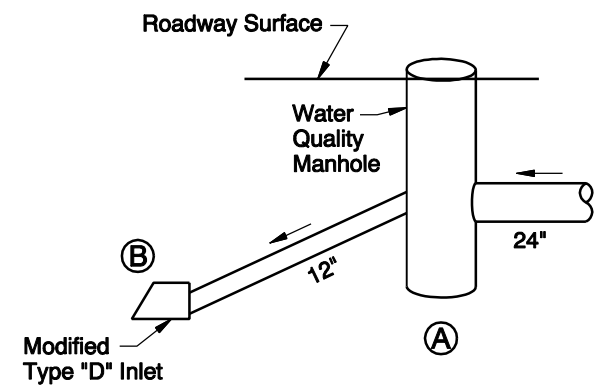

**SECTION A-A**  
N.T.S.

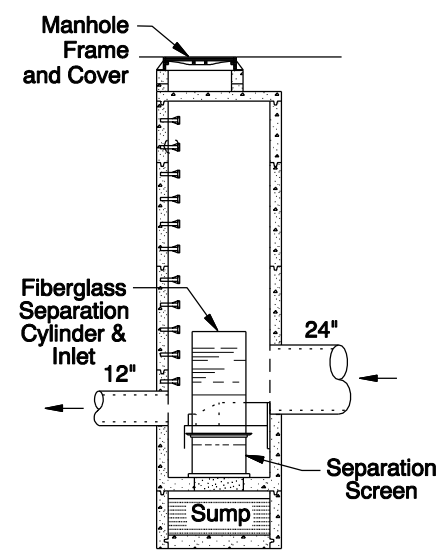

**WATER QUALITY MANHOLE - CDS UNIT**  
N.T.S.

- LEGEND:**
- Photo Locaton / Direction
  - Water Quality Manhole
  - Ditch Inlet Structure
  - Manhole
  - Inlet
  - Storm Pipe (Facility)
  - Storm Pipe
  - Conveyance Direction
  - Pavement / Facility Flow Path

Sht. 1 of 1

**OREGON DEPARTMENT OF TRANSPORTATION**

**DFI D00034**  
**MAINTENANCE DISTRICT 3 HWY 1**  
**WATER QUALITY MANHOLE**  
PACIFIC HIGHWAY MP 252.14  
MARION COUNTY

Prepared By: Bob Knorr	
Drafted By: Jim Holeman	

# Appendix B

## Content:

- **ODOT Project Plan Sheets**
  - *Cover/Title Sheet*
  - *Water Quality/Detention Plan Sheets*
  - *Other Details*

INDEX OF SHEETS	
SHEET NO.	DESCRIPTION
1	Title Sheet
1A	Index Of Sheets Cont'd.
1A-2	Index Of Sheets Cont'd.
1A-3	Index Of Sheets Cont'd.
1A-4	Standard Drawing Nos.
1B	Layout Sheet

STATE OF OREGON  
DEPARTMENT OF TRANSPORTATION

PLANS FOR PROPOSED PROJECT


GRADING, DRAINAGE, STRUCTURES, PAVING, SIGNING,  
ILLUMINATION, SIGNALS & ROADSIDE DEVELOPMENT

**I-5: N. SANTIAM HWY. -  
KUEBLER BLVD. (SALEM) SEC.**

PACIFIC HIGHWAY

MARION COUNTY


OCTOBER 2005

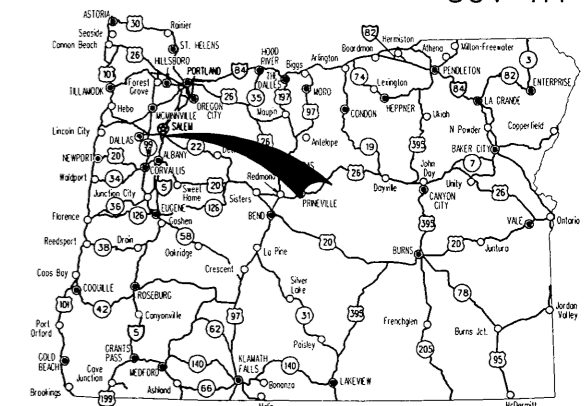

Overall Length Of Project - 4.02 km (2.49 Miles)

**ATTENTION:**  
Oregon Law Requires You To Follow Rules Adopted By The Oregon Utility Notification Center. Those Rules Are Set Forth In OAR 952-001-0010 Through OAR 952-001-0090. You May Obtain Copies Of The Rules By Calling The Center. (Note: The Telephone Number For The Oregon Utility Center Is (503) 232-1987.)

**OTIA-NH-IM-S001(196)**  
**BEGINNING OF PROJECT**  
STA. "L" 10+280 (M.P. 254.58)

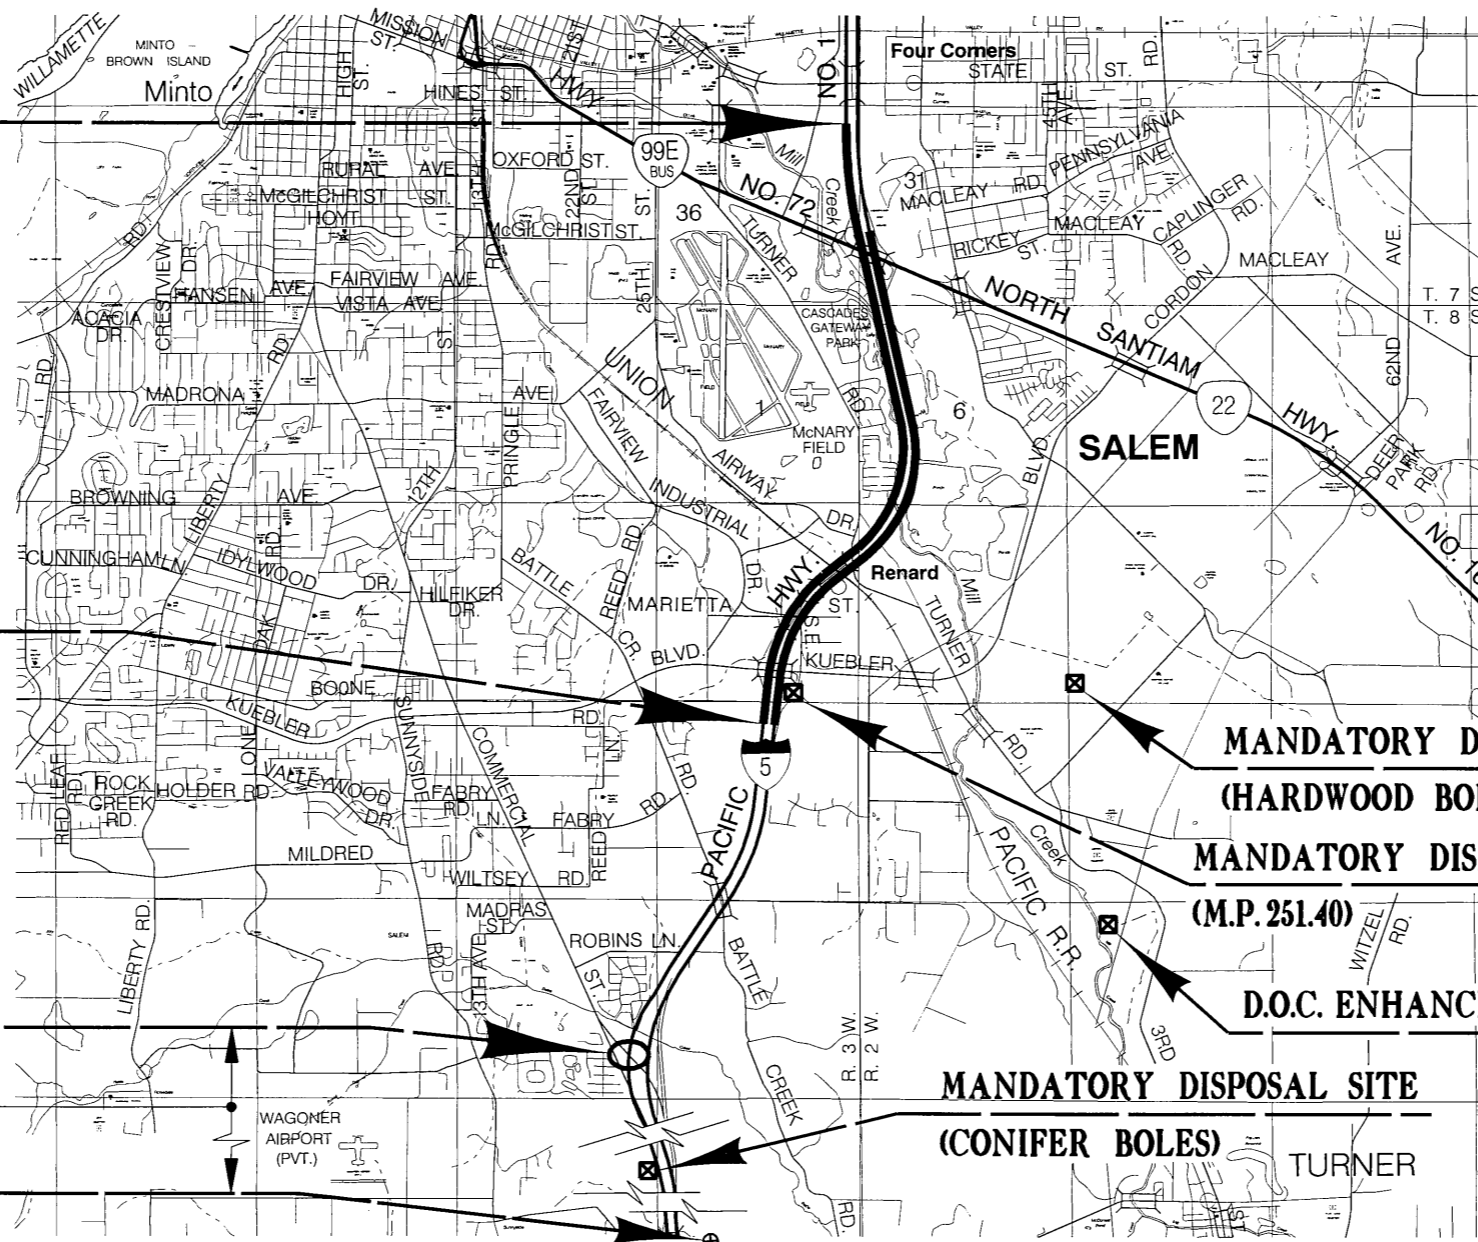

**END OF WORK AREA**  
STA. "L" 15+682.3 (M.P. 251.22)

NO WORK AREA


**OTIA-NH-IM-S001(196)**  
**END OF PROJECT**  
STA. "LS" 18+664.61 (M.P. 249.38)

Approx. 28 Mi. South

**PROSPECTIVE MATERIAL SOURCE**  
(M.P. 221.13)



LET'S ALL  
WORK TOGETHER  
TO MAKE THIS  
JOB SAFE

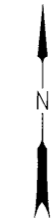

T. 7, 8 S.,  
R. 2, 3 W., W.M.

**OREGON TRANSPORTATION COMMISSION**

Stuart Foster	CHAIRMAN
Gail L. Achterman	COMMISSIONER
Mike Nelson	COMMISSIONER
Randall Papé	COMMISSIONER
Janice J. Wilson	COMMISSIONER
Bruce A. Warner	DIRECTOR OF TRANSPORTATION

**REGISTERED PROFESSIONAL ENGINEER**  
13,704  
JULY 16, 1987  
**CATHERINE M. NELSON**  
Expires Dec. 31, 2006


Catherine M. Nelson  
TECHNICAL SERVICES MANAGING ENGINEER

**I-5: N. SANTIAM HWY. -  
KUEBLER BLVD. (SALEM) SEC.  
PACIFIC HIGHWAY  
MARION COUNTY**

FEDERAL HIGHWAY ADMINISTRATION	PROJECT NUMBER	SHEET NO.
OREGON DIVISION	OTIA-NH-IM-S001(196)	1



PE000950

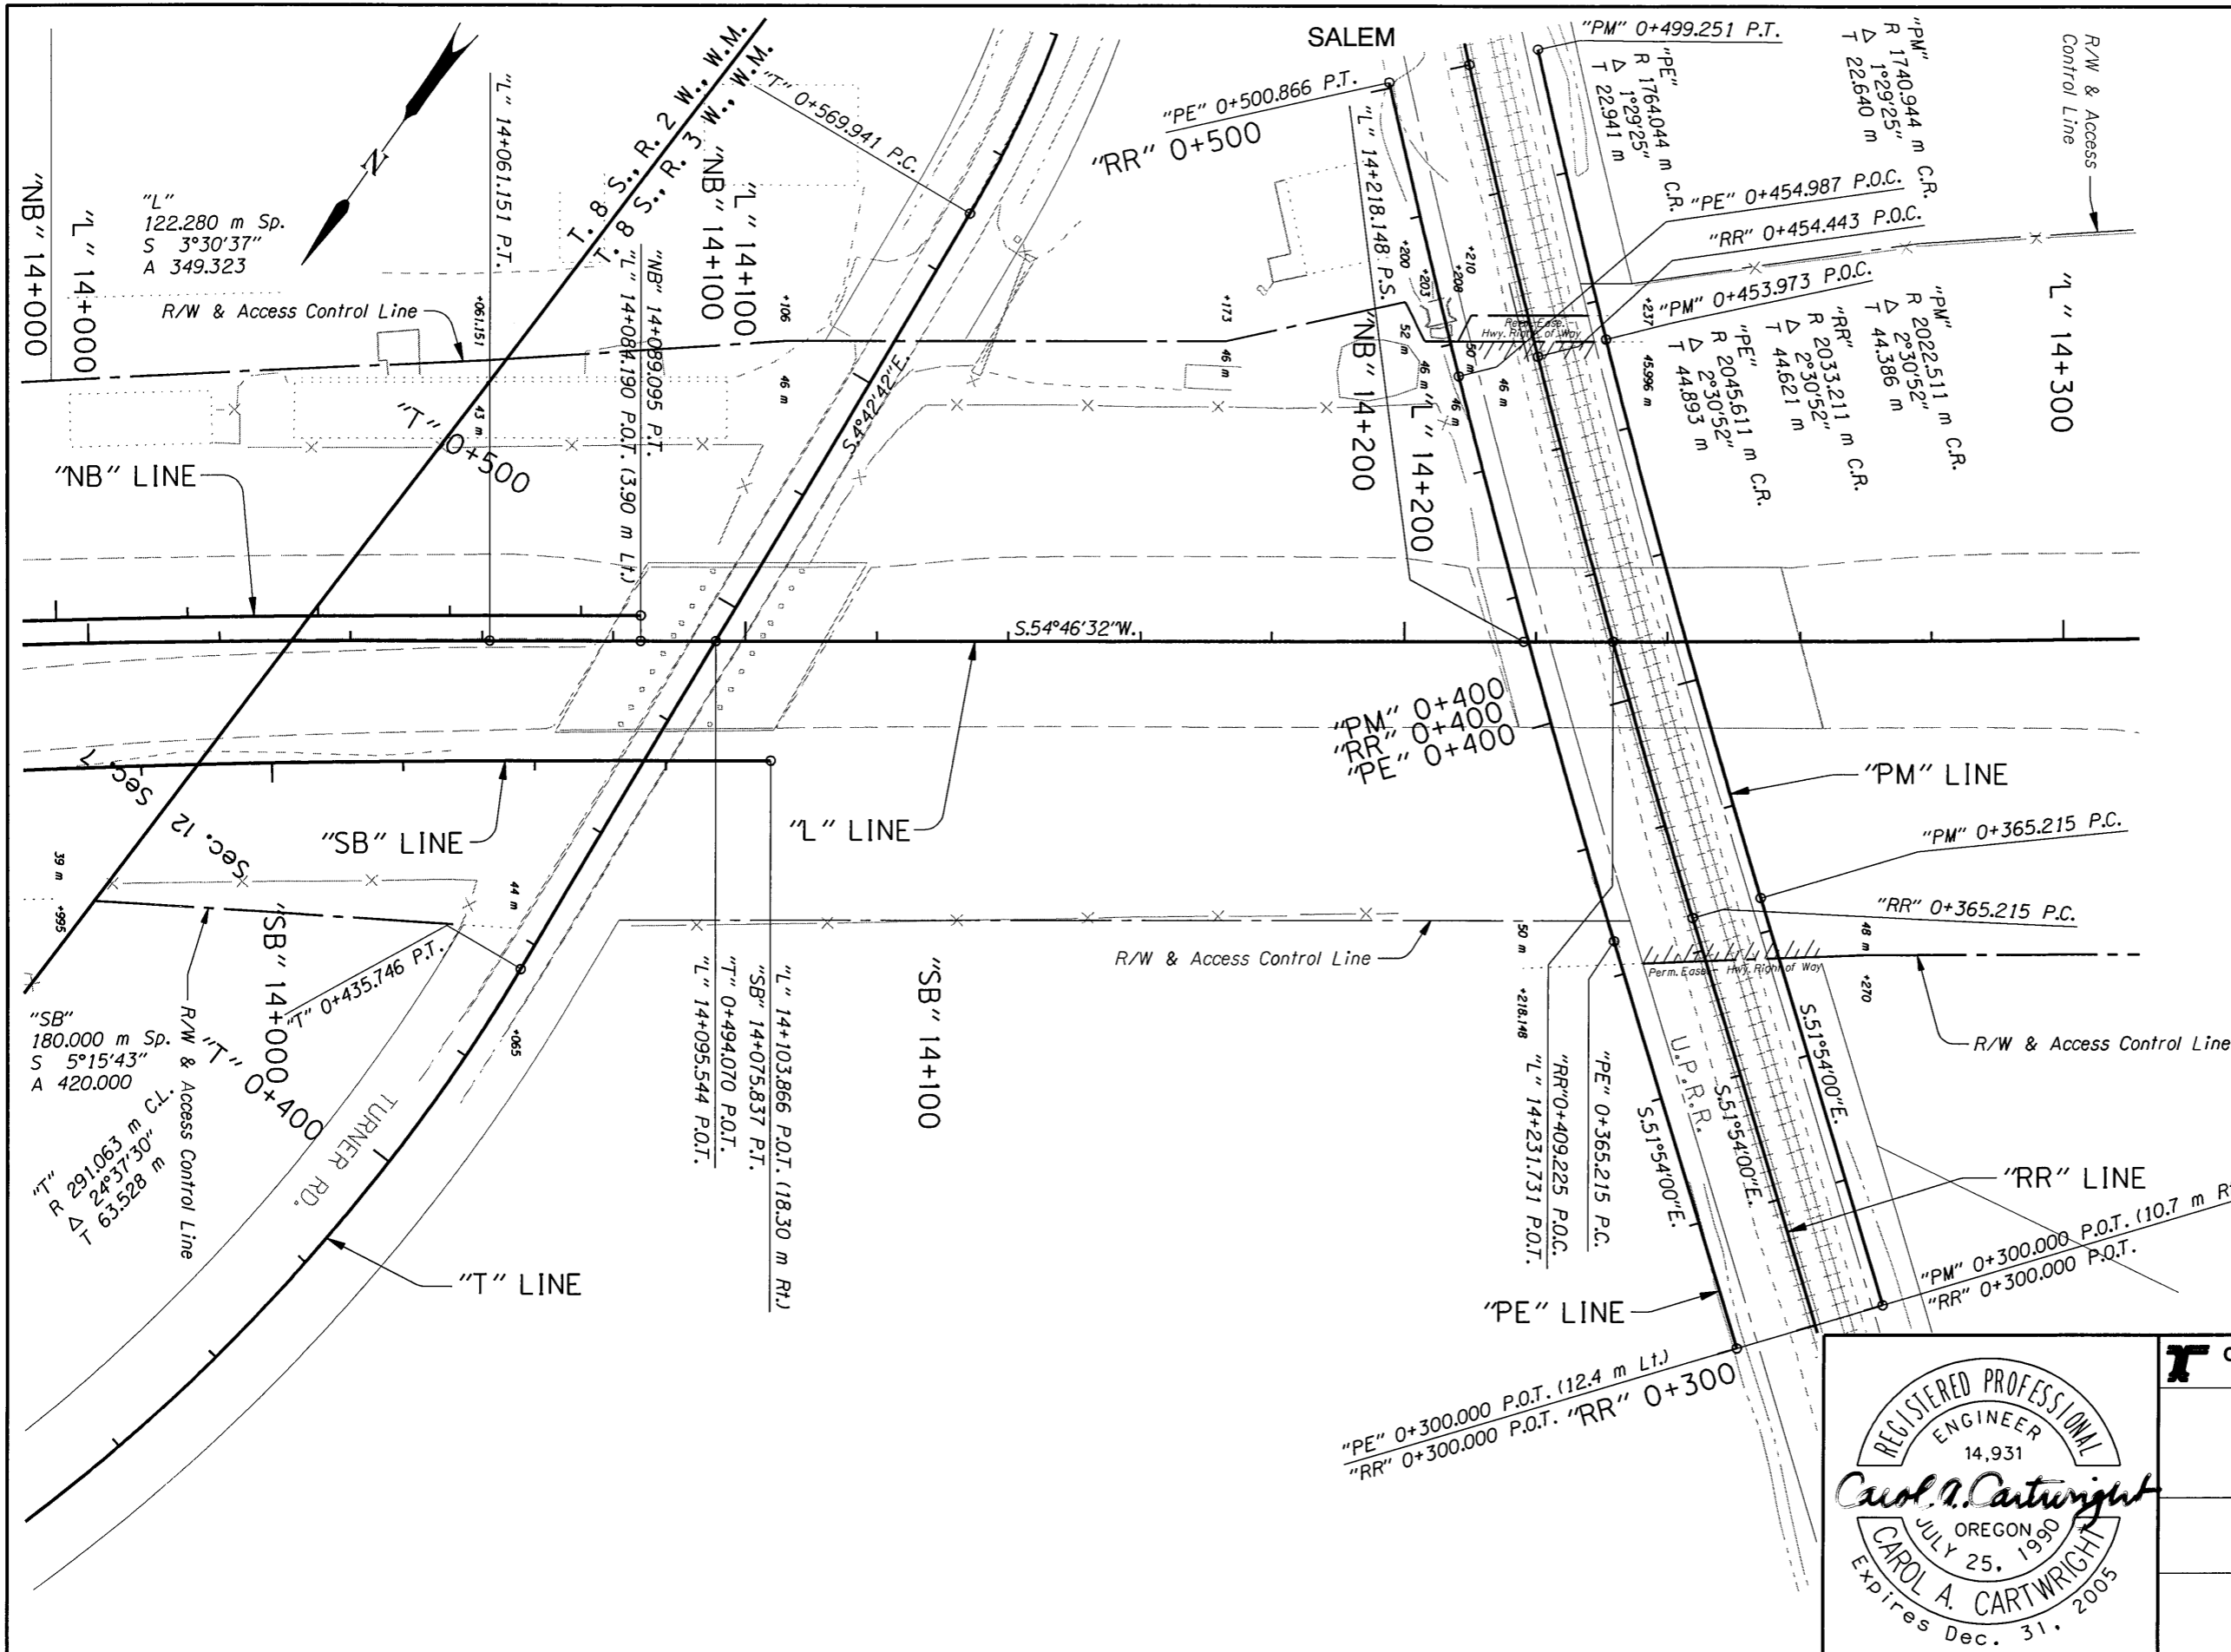

All Dimensions Are Shown In Meters (m) Unless Otherwise Noted.



OREGON DEPARTMENT OF TRANSPORTATION  
ROADWAY ENGINEERING SECTION


1-5: N. SANTIAM HWY. -  
KUEBLER BLVD. (SALEM) SEC.  
PACIFIC HIGHWAY  
MARION COUNTY

Design Team Leader - Carol Cartwright  
Designed By - John Lucas  
Drafted By - Jeff Larson

ALIGNMENT

SHEET NO.  
16

STRUCTURAL DETAILS CHECKED

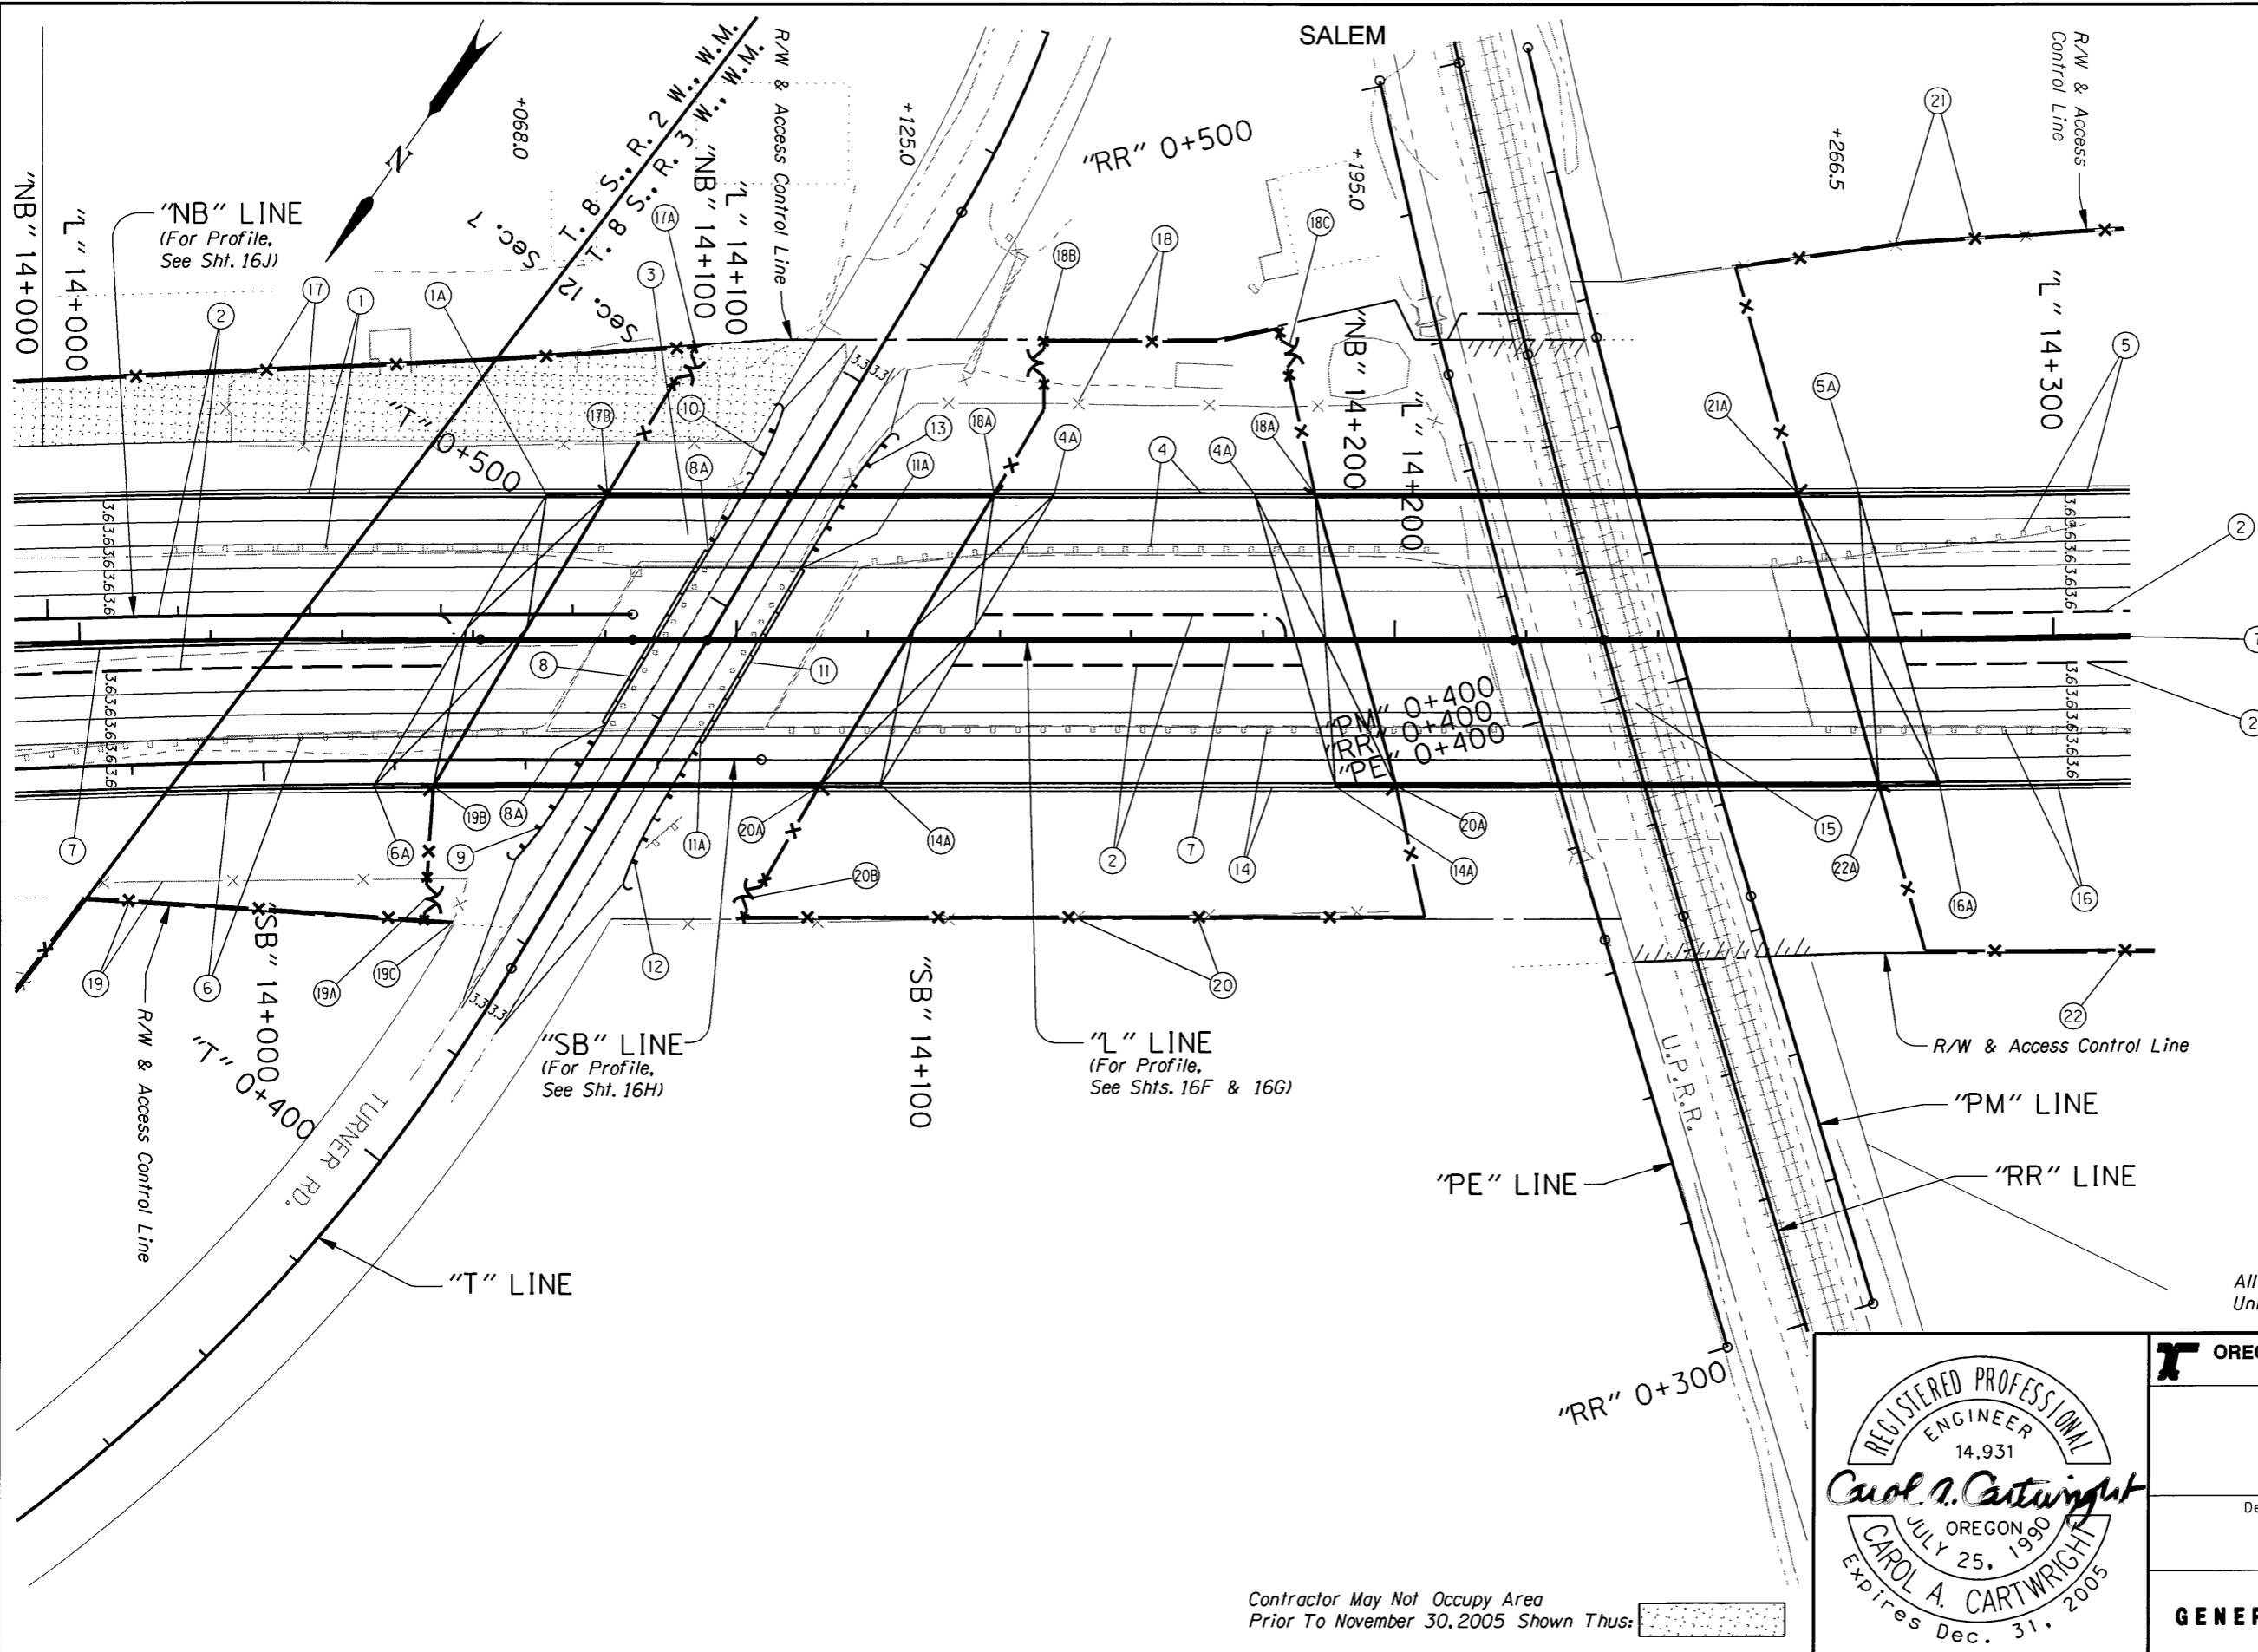

All Dimensions Are Shown In Meters (m) Unless Otherwise Noted.



OREGON DEPARTMENT OF TRANSPORTATION  
ROADWAY ENGINEERING SECTION

I-5: N. SANTIAM HWY. -  
KUEBLER BLVD. (SALEM) SEC.  
PACIFIC HIGHWAY  
MARION COUNTY

Design Team Leader - Carol Cartwright  
Designed By - John Lucas  
Drafted By - Jeff Larson

GENERAL CONSTRUCTION

SHEET NO.  
16A

Contractor May Not Occupy Area  
Prior To November 30, 2005 Shown Thus:




STRUCTURAL DETAILS CHECKED *MM*

- ① See Sht. 14B, Note 6  
Remove Extg. Guardrail  
Const. Precast Conc. Shldr. Barrier
- ①A Const. Conc. Barrier Transition To Bridge Rail - 3.8 m
  
- ② Const. Low Profile Mountable Curb
  
- ③ Sta. "L"14+068.0 To Sta. "L"14+125.0  
Structure No. 20032  
Remove Extg. Structure  
Const. Structure - 57.0 m  
Rdwy. Width - 43.8 m  
(For Drg. Nos., See Sht. 1A-2)
  
- ④ Sta. "L"14+148.0 To Sta. "L"14+178.7  
Remove Extg. Guardrail - 110.5 m  
Const. Precast Conc. Shldr. Barrier - 23.0 m  
Plug Scuppers
- ④A Const. Conc. Barrier Transition To Bridge Rail - 7.6 m  
Flare Rate=0, W=0, E=0
  
- ⑤ Sta. "L"14+270.6 To Sta. "L"14+745.1  
Remove Extg. Guardrail - 49.5 m  
Const. Precast Conc. Shldr. Barrier - 467.9 m  
(Reflectorized)  
Plug Scuppers
- ⑤A Const. Conc. Barrier Transition To Bridge Rail - 3.8 m  
Flare Rate=0, W=0, E=0
  
- ⑥ See Sht. 14B, Note 15  
Remove Extg. Guardrail  
Const. Precast Conc. Shldr. Barrier
- ⑥A Const. Conc. Barrier Transition To Bridge Rail - 3.8 m
  
- ⑦ See Sht. 14B, Note 16  
Const. Precast Tall Conc. Median Barrier
  
- ⑧ Sta. "T"0+475.1 To Sta. "T"0+505.8  
Const. Precast Conc. Shldr. Barrier - 22.9 m  
(Reflectorized)  
Plug Scuppers
- ⑧A Const. Guardrail Connection To Conc. Barrier - 7.6 m
  
- ⑨ Sta. "T"0+450.6 To Sta. "T"0+475.1  
Const. Guardrail - 3.8 m (Type 2A)  
Const. Guardrail - 3.8 m (Type 3)  
Const. Guardrail Transition  
Flare Rate=0, W=1.22 m, E=0  
Const. Guardrail Terminal, Flared  
Test Level 3  
(See Drg. No. RD425)
  
- ⑩ Sta. "T"0+505.8 To Sta. "T"0+530.3  
Const. Guardrail - 3.8 m (Type 2A)  
Const. Guardrail - 3.8 m (Type 3)  
Const. Guardrail Transition  
Flare Rate=0, W=1.22 m, E=0  
Const. Guardrail Terminal, Flared  
Test Level 3
  
- ⑪ Sta. "T"0+481.1 To Sta. "T"0+510.8  
Const. Precast Conc. Shldr. Barrier - 22.9 m  
(Reflectorized)  
Plug Scuppers
- ⑪A Const. Guardrail Connection To Conc. Barrier - 7.6 m
  
- ⑫ Sta. "T"0+455.6 To Sta. "T"0+480.1  
Const. Guardrail - 3.8 m (Type 2A)  
Const. Guardrail - 3.8 m (Type 3)  
Const. Guardrail Transition  
Flare Rate=0, W=1.22 m, E=0  
Const. Guardrail Terminal, Flared  
Test Level 3
  
- ⑬ Sta. "T"0+510.8 To Sta. "T"0+535.3  
Const. Guardrail - 3.8 m (Type 2A)  
Const. Guardrail - 3.8 m (Type 3)  
Const. Guardrail Transition  
Flare Rate=0, W=1.22 m, E=0  
Const. Guardrail Terminal, Flared  
Test Level 3
  
- ⑭ Sta. "L"14+122.0 To Sta. "L"14+191.0  
Remove Extg. Guardrail - 110.5 m  
Const. Precast Conc. Shldr. Barrier - 61.4 m  
(Reflectorized)  
Plug Scuppers
- ⑭A Const. Conc. Barrier Transition To Bridge Rail - 7.6 m  
Flare Rate=0, W=0, E=0
  
- ⑮ Sta. "L"14+195.0 To Sta. "L"14+266.5  
Structure No. 20026  
Remove Extg. Structure  
Const. Structure - 71.5 m  
Rdwy. Width - 43.8 m  
(For Drg. Nos., See Sht. 1A-2)
  
- ⑯ Sta. "L"14+282.7 To Sta. "DK"6+355.5  
Remove Extg. Guardrail - 182.9 m  
Const. Precast Conc. Shldr. Barrier - 460.2 m  
(Reflectorized)  
Plug Scuppers
- ⑯A Const. Conc. Barrier Transition To Bridge Rail - 3.8 m  
Flare Rate=0, W=0, E=0
  
- ⑰ See Sht. 14B, Note 19  
Remove Extg. Fence  
Const. Type CL-6 Fence
- ⑰A Inst. Double Type "CL-6" Locked Gate - 4.2 m
- ⑰B End At Bridge
  
- ⑱ Sta. "L"14+139.1 To Sta. "L"14+190.5  
Remove Extg. Fence
- ⑱A Const. Type CL-6 Fence
- ⑱B End At Bridge
- ⑱C Inst. Double Type "CL-6" Locked Gate - 4.2 m  
Inst. Double Type "CL-6" Locked Gate - 4.2 m
  
- ⑲ See Sht. 14B, Note 20  
Remove Extg. Fence  
Const. Type CL-6 Fence
- ⑲A Inst. Double Type "CL-6" Locked Gate - 4.2 m
- ⑲B End At Bridge
- ⑲C Connect To Extg. Fence
  
- ⑳ Sta. "L"14+101.1 To Sta. "L"14+207.3  
Remove Extg. Fence  
Const. Type CL-6 Fence
- ⑳A End At Bridge
- ⑳B Inst. Double Type "CL-6" Locked Gate - 4.2 m
  
- ㉑ Sta. "L"14+251.8 To Sta. "L"14+756.8  
Remove Extg. Fence  
Const. Type CL-6 Fence
- ㉑A End At Bridge
  
- ㉒ Sta. "L"14+273.5 To Sta. "L"14+763.6  
Const. Type CL-6 Fence
- ㉒A End At Bridge



<b>OREGON DEPARTMENT OF TRANSPORTATION ROADWAY ENGINEERING SECTION</b>	
<b>I-5: N. SANTIAM HWY. - KUEBLER BLVD. (SALEM) SEC. PACIFIC HIGHWAY MARION COUNTY</b>	
Design Team Leader - Carol Cartwright Designed By - John Lucas Drafted By - Jeff Larson	
<b>NOTES</b>	SHEET NO. <b>16B</b>

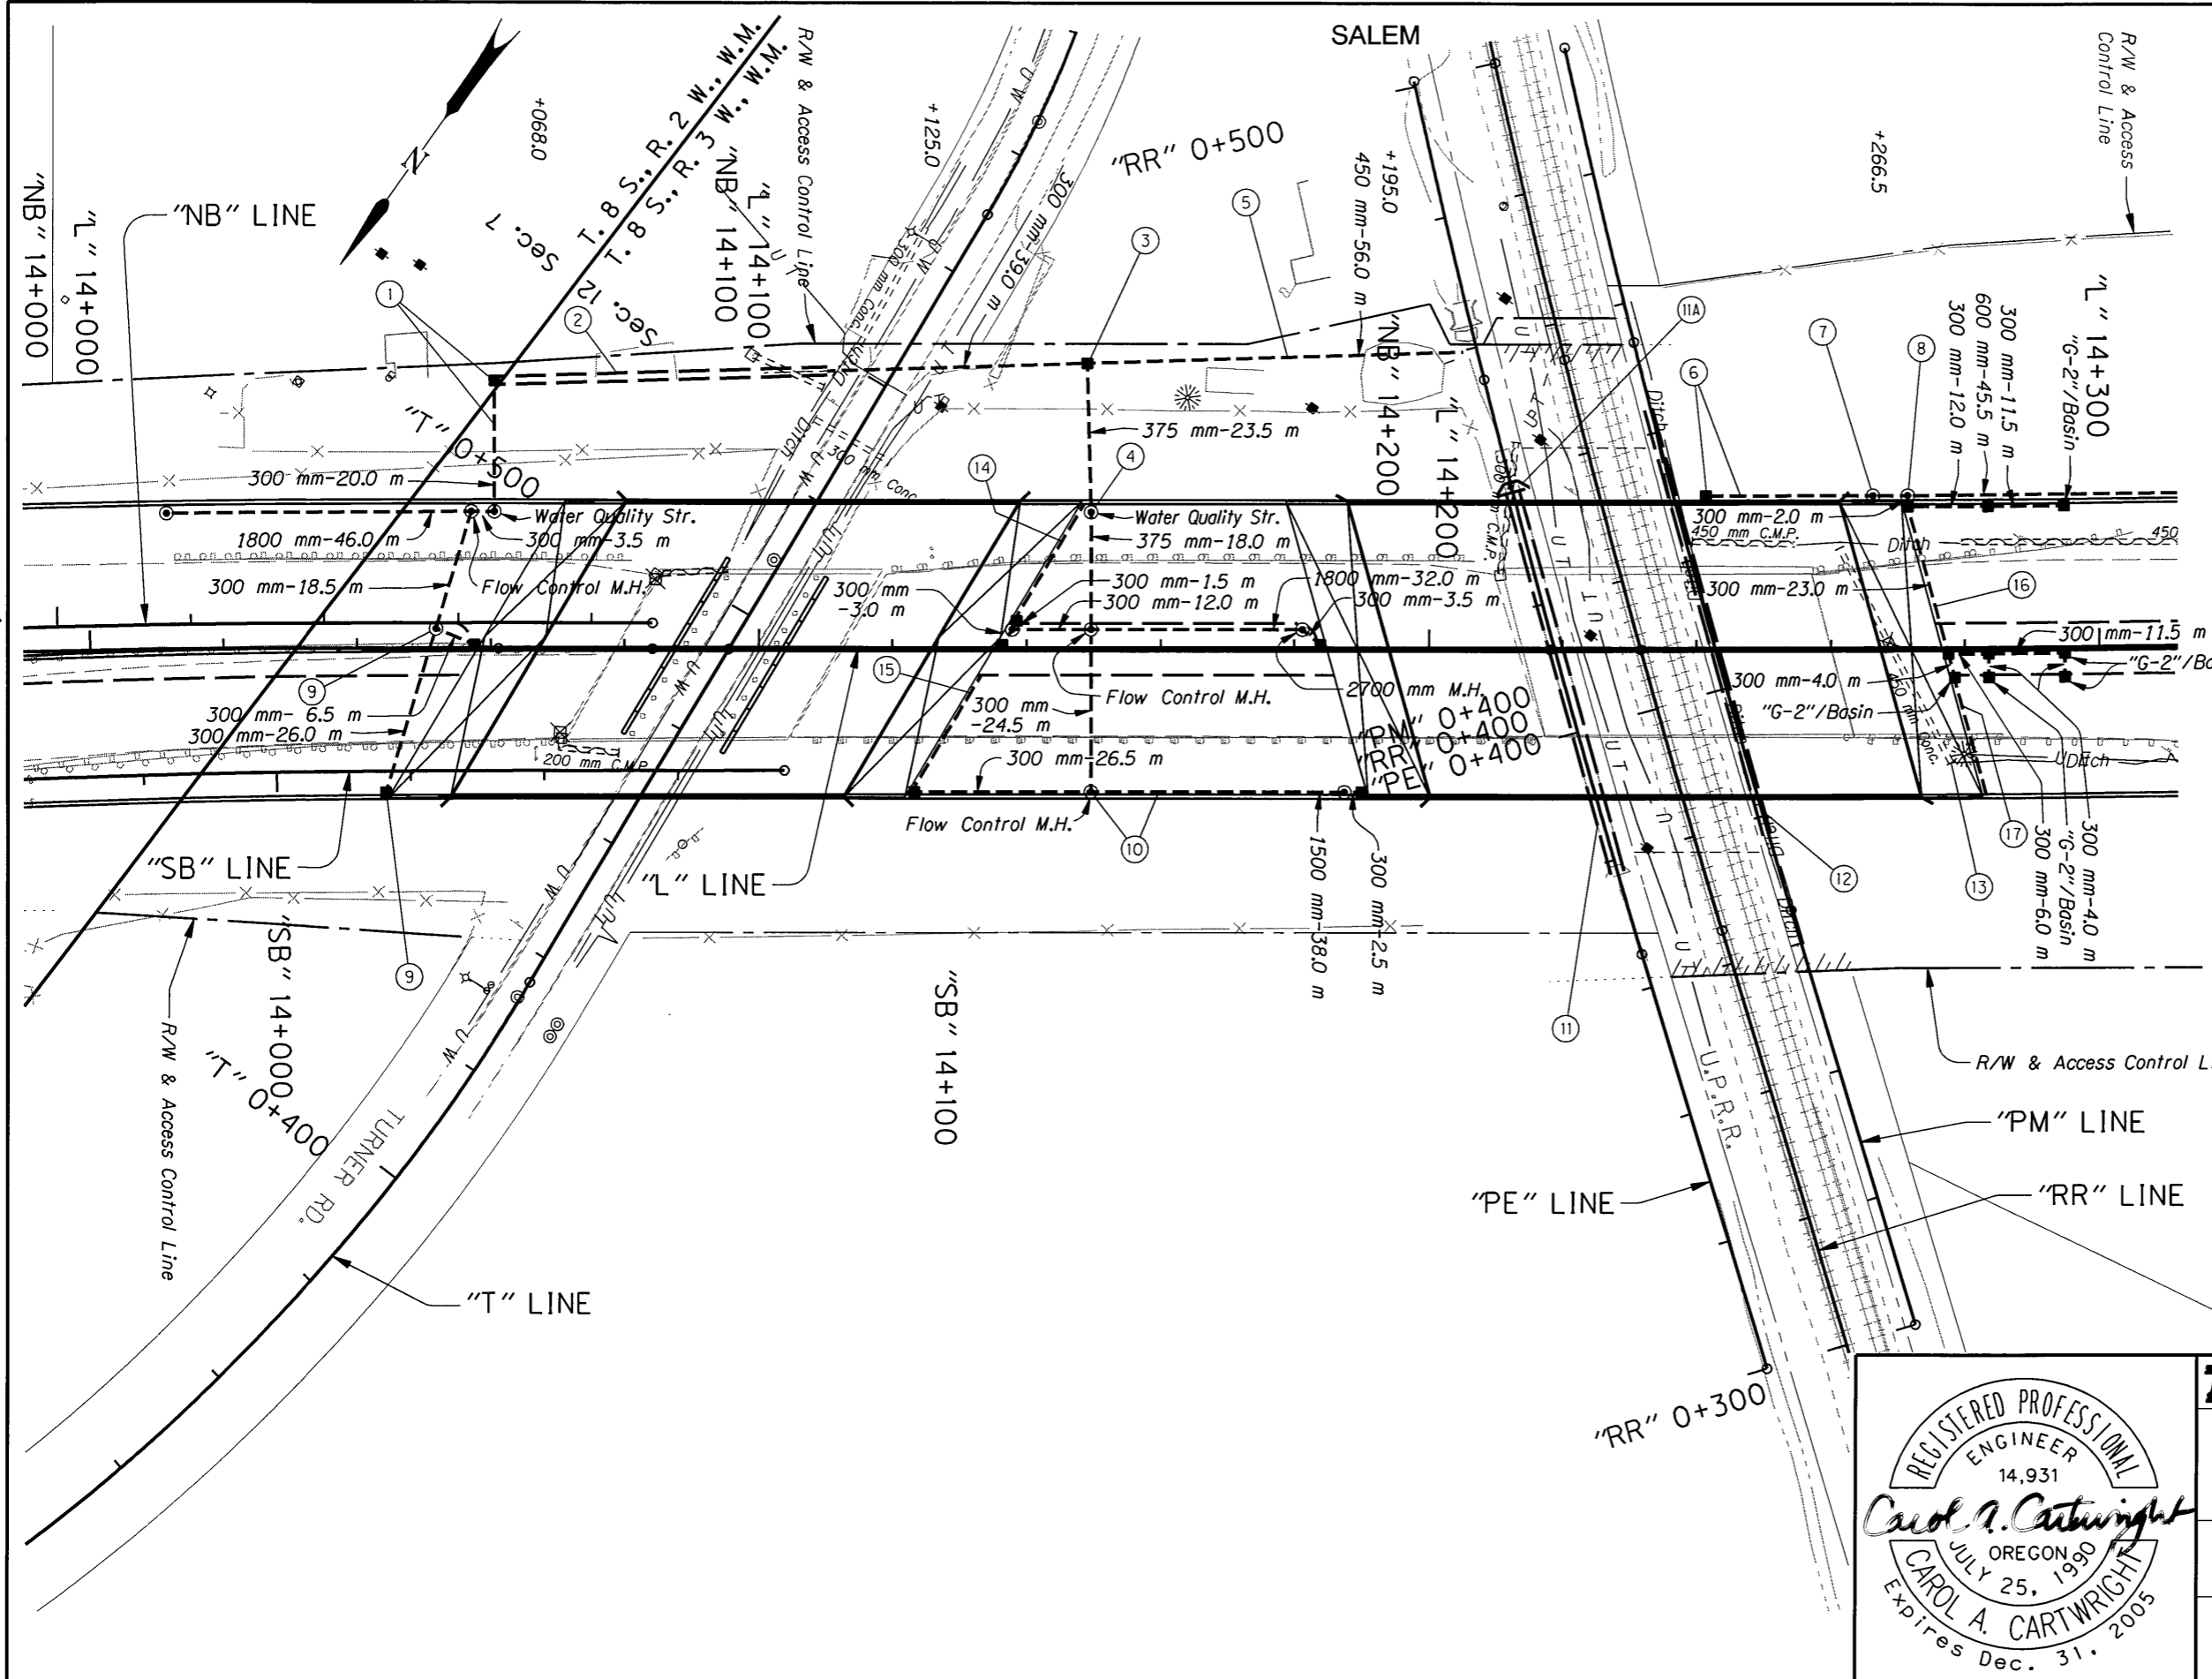

STRUCTURAL DETAILS CHECKED

Plug And Abandon Extg. Pipe Shown Thus: [symbol]

All Dimensions Are Shown In Meters (m)  
Unless Otherwise Noted.



<b>OREGON DEPARTMENT OF TRANSPORTATION</b> ROADWAY ENGINEERING SECTION	
1-5: N. SANTIAM HWY. - KUEBLER BLVD. (SALEM) SEC. PACIFIC HIGHWAY MARION COUNTY	
Design Team Leader - Carol Cartwright Designed By - John Lucas Drafted By - Jeff Larson	
<b>DRAINAGE &amp; UTILITIES</b>	
SHEET NO. <b>16C</b>	

STRUCTURAL DETAILS CHECKED *MA*



- ① Sta. "L"14+051.1 To Sta. "NB"14+065.4  
Const. Manhole 2700 mm Dia.  
Const. Water Quality Structure  
Const. Flow Control Manhole 2400 mm Dia.  
Const. Siphon Box  
Inst. 300 mm Sew. Pipe - 18.5 m  
3.0 m Depth  
Inst. 300 mm Sew. Pipe - 23.5 m  
6.0 m Depth  
Inst. 1800 mm Sew. Pipe - 46.0 m  
6.0 m Depth  
(For Details, See Sht. GJ-4)  
(See Drg. No. RD376)
- ② Const. Ditch  
"V" Bottom, 1:3 Slopes  
Dt. Exc. - 48 m<sup>3</sup>
- ③ Sta. "L"14+110.1 To Sta. "L"14+148.9  
Const. Type "G-2MA" Inlet  
Shape Bottom  
Inst. 300 mm Sew. Pipe - 39.0 m  
1.5 m Depth  
Inst. 375 mm Sew. Pipe - 23.5 m  
6.0 m Depth  
Inst. Slope Anchors  
(See Drg. Nos. RD330 & RD364)
- ④ Sta. "L"14+136.4 To Sta. "L"14+183.9  
Const. Water Quality Structure  
Const. Flow Control Manhole 2700 mm Dia.  
Const. Large Manhole 2700 mm Dia.  
Const. Manhole  
Const. Type "G-2" Open Grade HMAC Inlet  
With Basin - 2  
0.45 m Deep  
Const. Type "G-2" Open Grade HMAC Inlet  
Shape Bottom  
Adjust Inlet For Wearing Course - 2  
Inst. 300 mm Sew. Pipe - 20.0 m  
1.5 m Depth  
Inst. 300 mm Sew. Pipe - 24.5 m  
3.0 m Depth  
Inst. 375 mm Sew. Pipe - 18.0 m  
6.0 m Depth  
Inst. 1800 mm Sew. Pipe - 32.0 m  
6.0 m Depth  
(For Details, See Sht. GJ-4)
- ⑤ Sta. "L"14+148.9 To Sta. "L"14+205.0  
Inst. 450 mm Sew. Pipe - 56.0 m  
1.5 m Depth

- ⑥ Sta. "L"14+241.4 To Sta. "L"14+266.3  
Const. Type "D MOD" Inlet  
Inst. 300 mm Sew. Pipe - 26.5 m  
1.5 m Depth  
Inst. Slope Anchors  
(For Details, See Sht. GJ-9)  
(See Drg. No. RD370)
- ⑦ Sta. "L"14+266.3 To Sta. "L"14+271.5  
Const. Water Quality Structure  
Inst. 600 mm Sew. Pipe - 5.5 m  
1.5 m Depth
- ⑧ Sta. "L"14+271.5 To Sta. "L"14+317.4  
Const. Manhole  
Const. Type "G-2" Open Grade HMAC Inlet  
With Basin - 5  
0.45 m Deep  
Const. Type "G-2" Open Grade HMAC Inlet - 4  
Shape Bottom  
Adjust Inlet For Wearing Course - 6  
Inst. 300 mm Sew. Pipe - 78.0 m  
1.5 m Depth  
Inst. 600 mm Sew. Pipe - 45.5 m  
1.5 m Depth
- ⑨ Sta. "SB"14+016.3 To Sta. "L"14+051.1  
Const. Manhole  
Const. Type "G-2" Open Grade HMAC Inlet  
With Basin - 2  
0.45 m Deep  
Adjust Inlet For Wearing Course - 2  
Inst. 300 mm Sew. Pipe - 6.5 m  
1.5 m Depth  
Inst. 300 mm Sew. Pipe - 26.0 m  
3.0 m Depth
- ⑩ Sta. "L"14+123.4 To Sta. "L"14+190.1  
Const. Large Manhole 2100 mm Dia.  
Const. Flow Control Manhole 2100 mm Dia.  
Const. Type "G-2" Open Grade HMAC Inlet  
With Basin - 2  
0.45 m Deep  
Adjust Inlet For Wearing Course - 2  
Inst. 300 mm Sew. Pipe - 2.5 m  
1.5 m Depth  
Inst. 300 mm Sew. Pipe - 26.5 m  
3.0 m Depth  
Inst. 1500 mm Sew. Pipe - 38.0 m  
6.0 m Depth  
(For Details, See Sht. GJ-4)


- ⑪ Remove Extg. 2.1 m x 1.2 m R.C.B.C.  
Const. Channel Change  
⑪A Const. Outlet  
(For Details, See Shts. GE-1, GE-2, GE-3 & GF-1)
- ⑫ Const. Channel Change  
(For Details, See Sht. GF-2)
- ⑬ Remove Pipe
- ⑭ Sta. "L"14+135.6  
Const. Open Grade Wearing Surface Drain  
Outlet To Inlet
- ⑮ Sta. "L"14+135.6  
Const. Open Grade Wearing Surface Drain  
Outlet To Inlet
- ⑯ Sta. "L"14+272.0  
Const. Open Grade Wearing Surface Drain  
Outlet To Inlet
- ⑰ Sta. "L"14+278.5  
Const. Open Grade Wearing Surface Drain  
Outlet To Inlet



<b>OREGON DEPARTMENT OF TRANSPORTATION ROADWAY ENGINEERING SECTION</b>	
<b>1-5: N. SANTIAM HWY. - KUEBLER BLVD. (SALEM) SEC. PACIFIC HIGHWAY MARION COUNTY</b>	
Design Team Leader - Carol Cartwright Designed By - John Lucas Drafted By - Jeff Larson	
<b>NOTES</b>	SHEET NO. <b>16D</b>

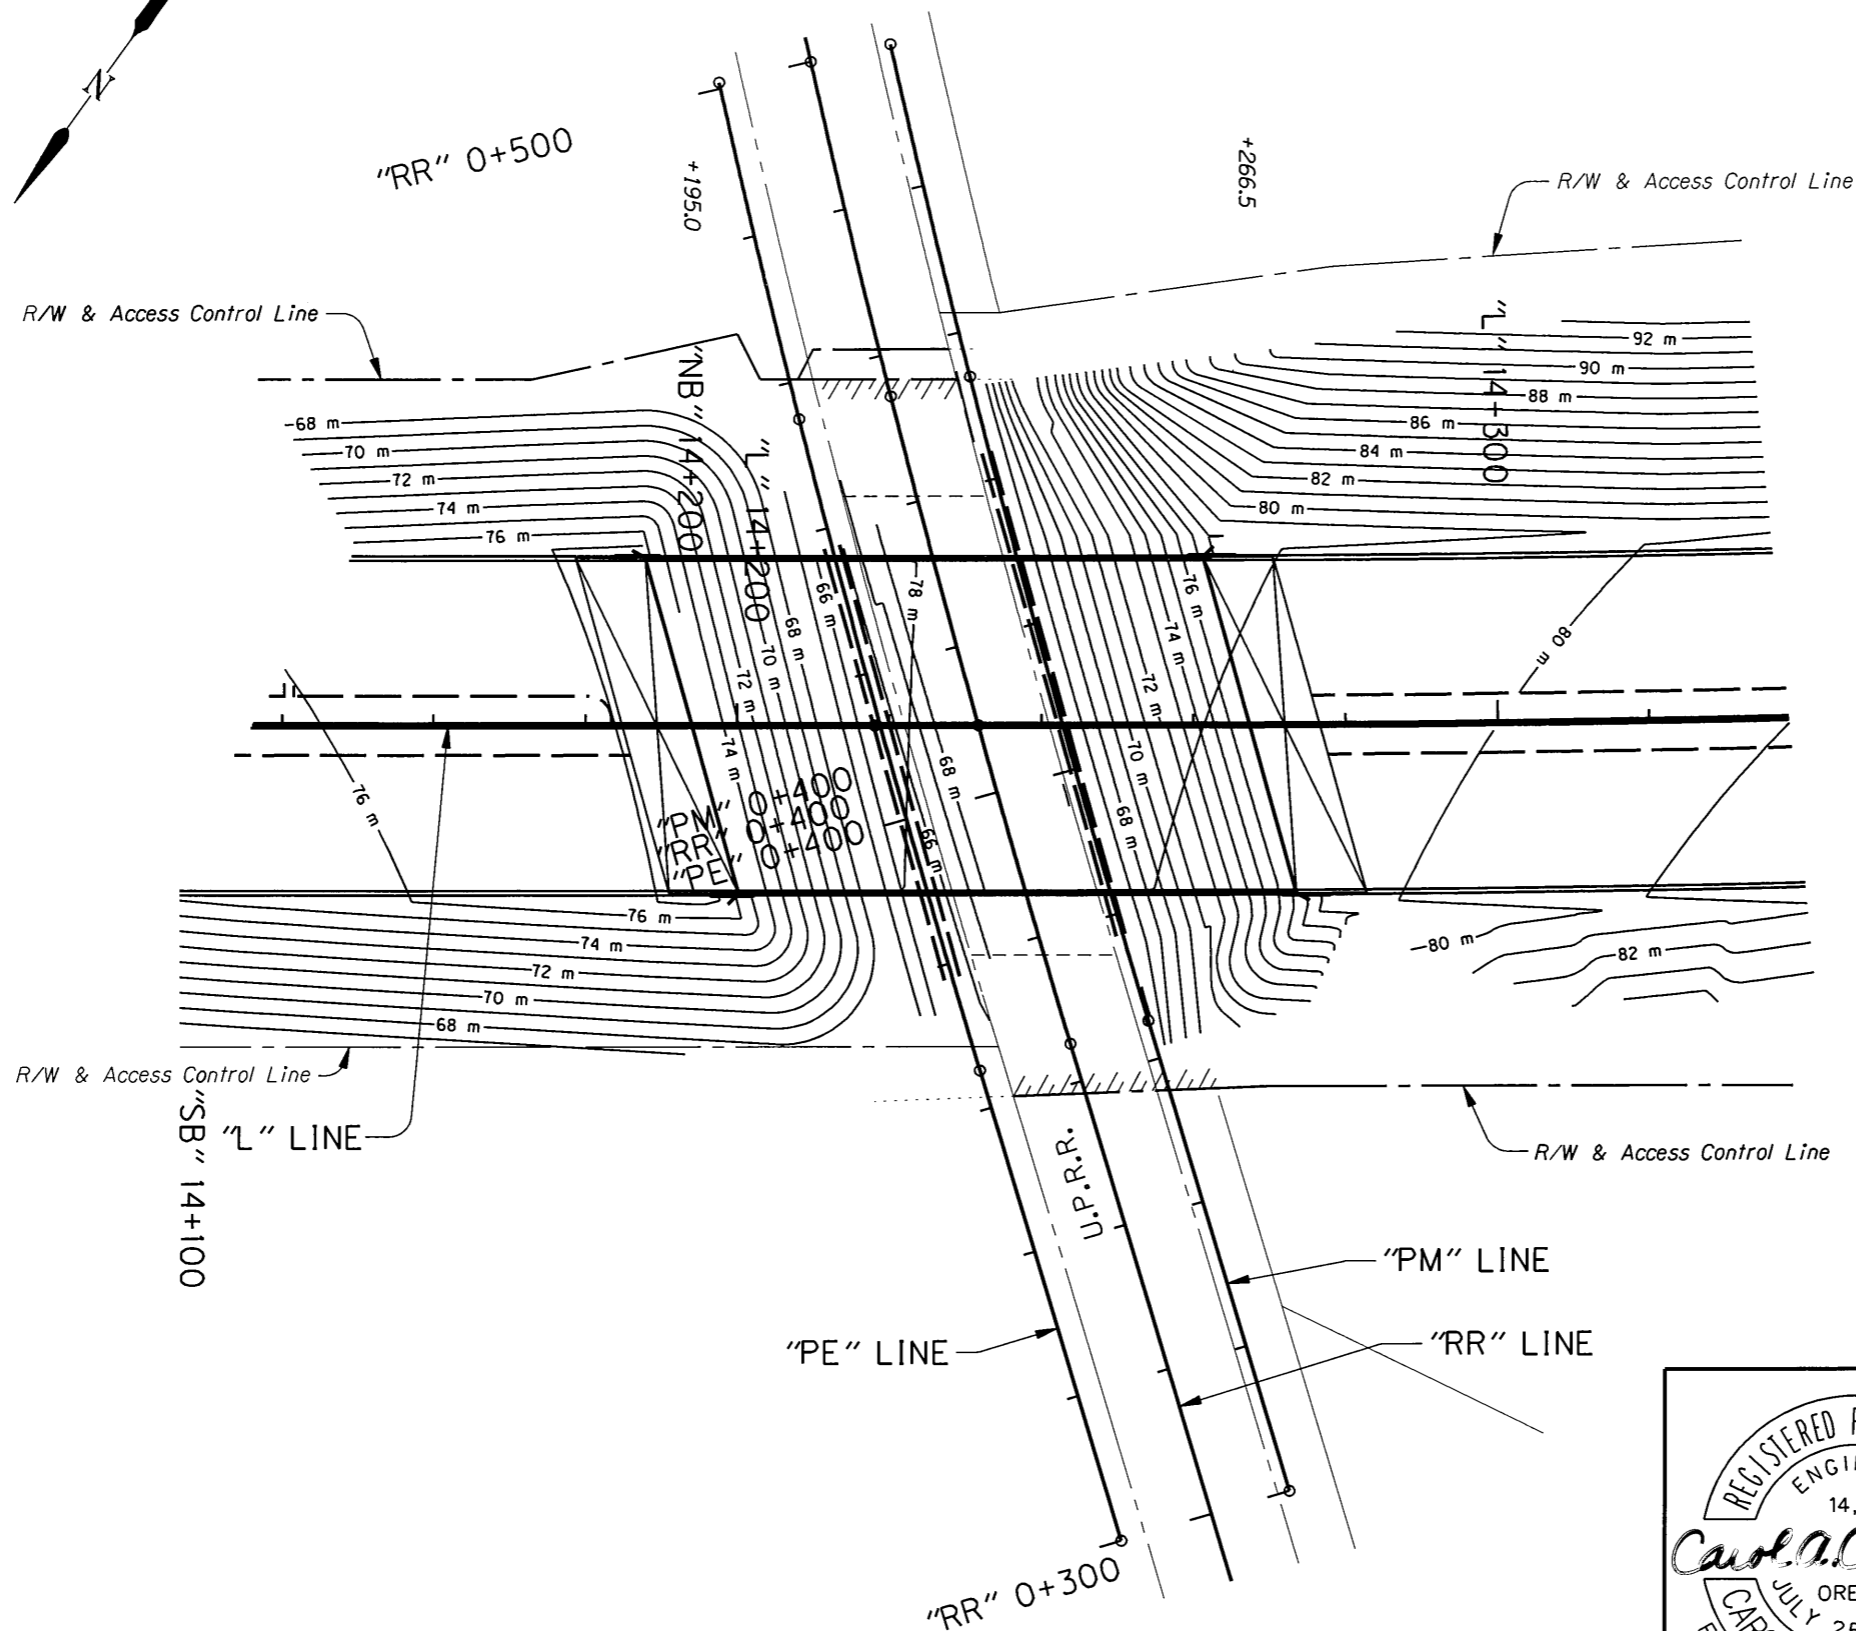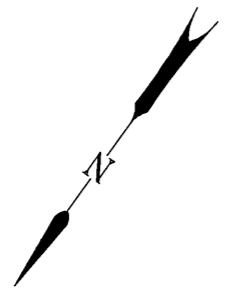

All Dimensions Are Shown In Meters (m)  
Unless Otherwise Noted.

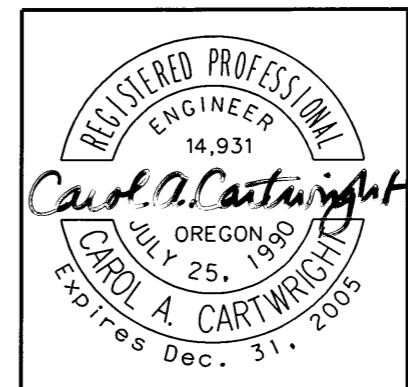


<b>OREGON DEPARTMENT OF TRANSPORTATION</b> ROADWAY ENGINEERING SECTION	
1-5: N. SANTIAM HWY. - KUEBLER BLVD. (SALEM) SEC. PACIFIC HIGHWAY MARION COUNTY	
Design Team Leader - Carol Cartwright Designed By - John Lucas Drafted By - Jeff Larson	
<b>CONTOUR GRADING PLAN</b>	SHEET NO. <b>16E</b>

"L" LINE  
LEFT  
(Northbound)

84  
83  
82  
71  
69  
68  
67  
66  
65

83  
82  
81  
80  
79  
78  
77  
76  
75  
74  
73  
72  
71  
71  
69  
68  
67  
66  
65

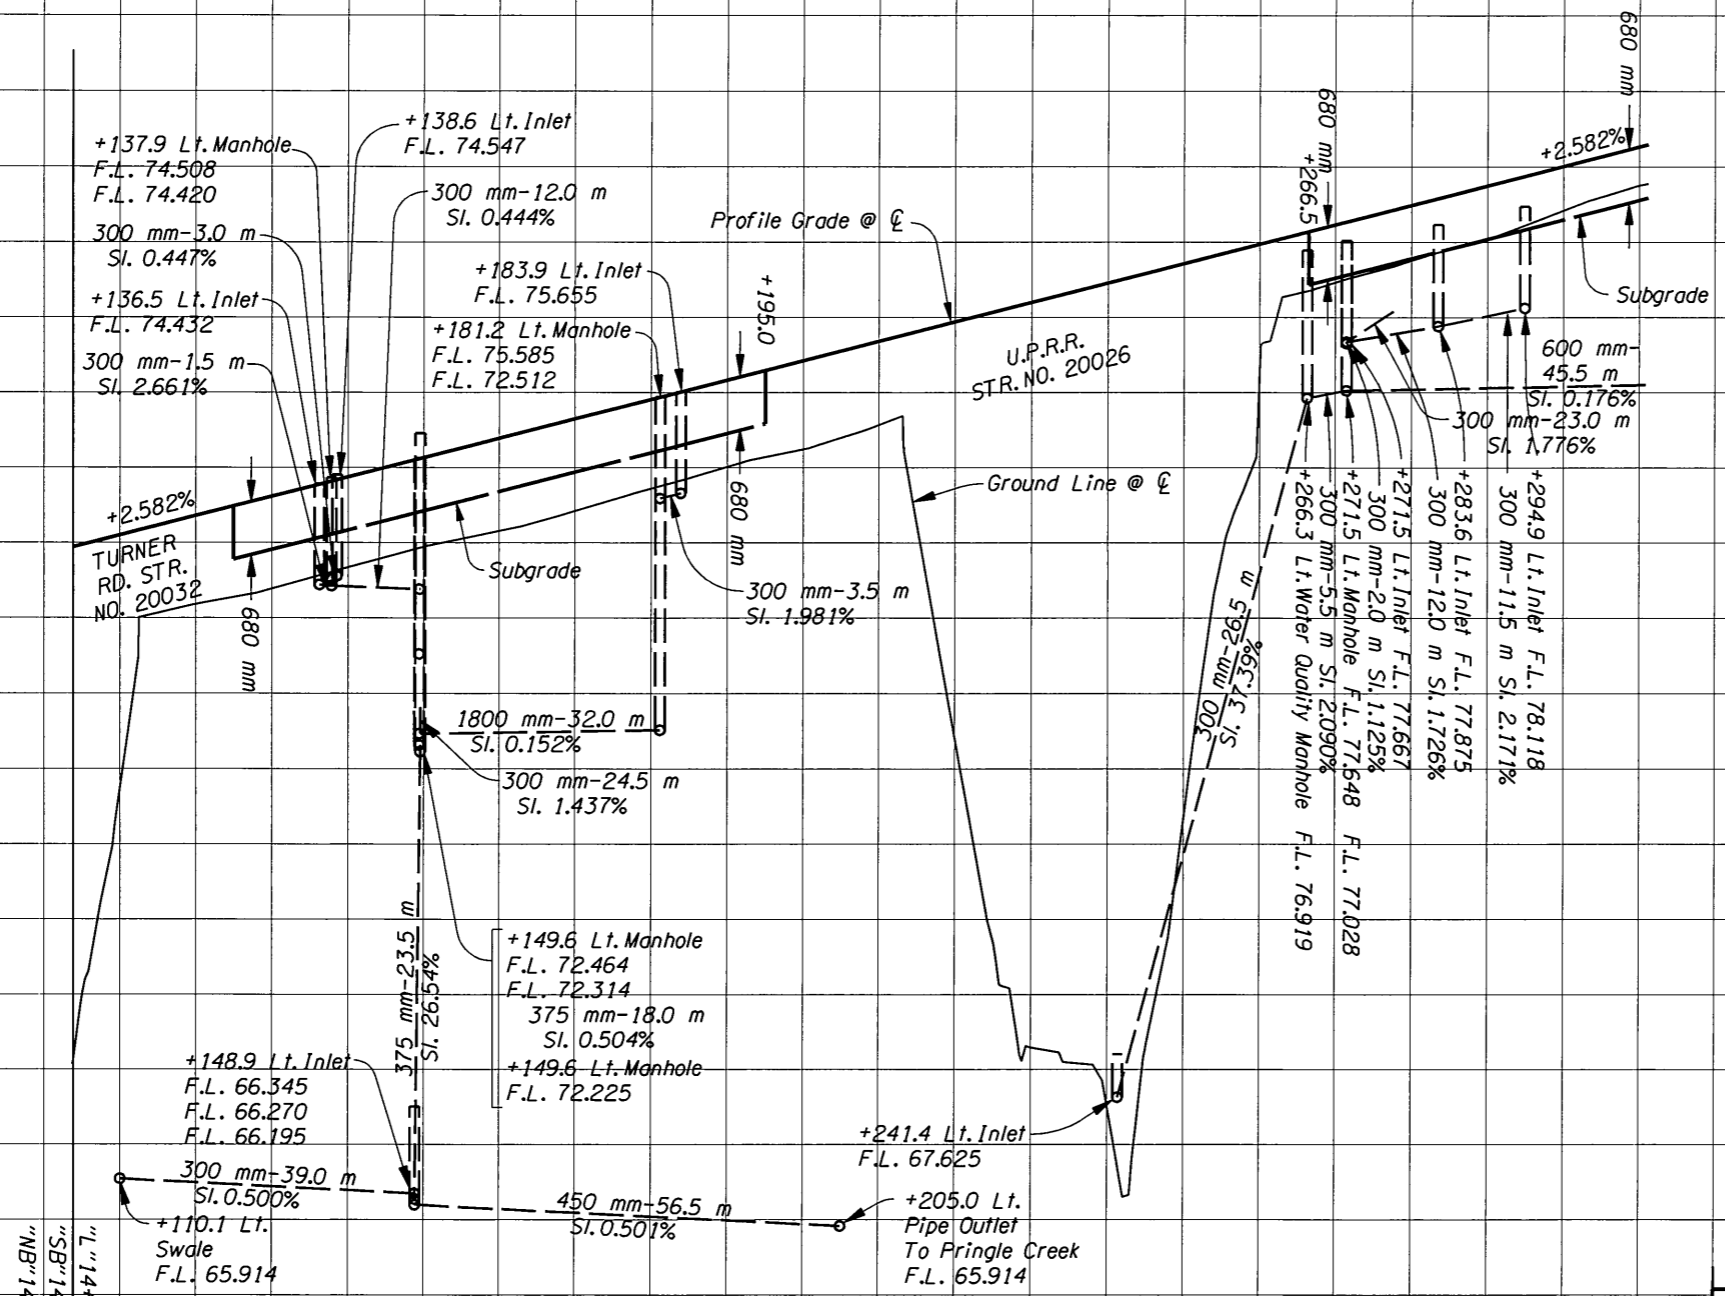

STRUCTURAL DETAILS CHECKED

STAGE II  
Emb. In Pl. 5890

STAGE II  
Exc. 3835  
Emb. In Pl. 0  
STAGE IV  
Exc. 5  
Emb. In Pl. 5



**OREGON DEPARTMENT OF TRANSPORTATION  
ROADWAY ENGINEERING SECTION**

**I-5: N. SANTIAM HWY. -  
KUEBLER BLVD. (SALEM) SEC.  
PACIFIC HIGHWAY  
MARION COUNTY**

Design Team Leader - Carol Cartwright P.E.  
Designed By - John Lucas  
Drafted By - Steve Donaldson

**PROFILE**

SHEET NO.  
**16G**



14+100

14+200

14+300

"SB" LINE

STRUCTURAL DETAILS CHECKED

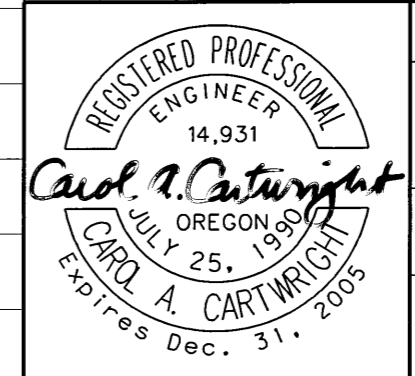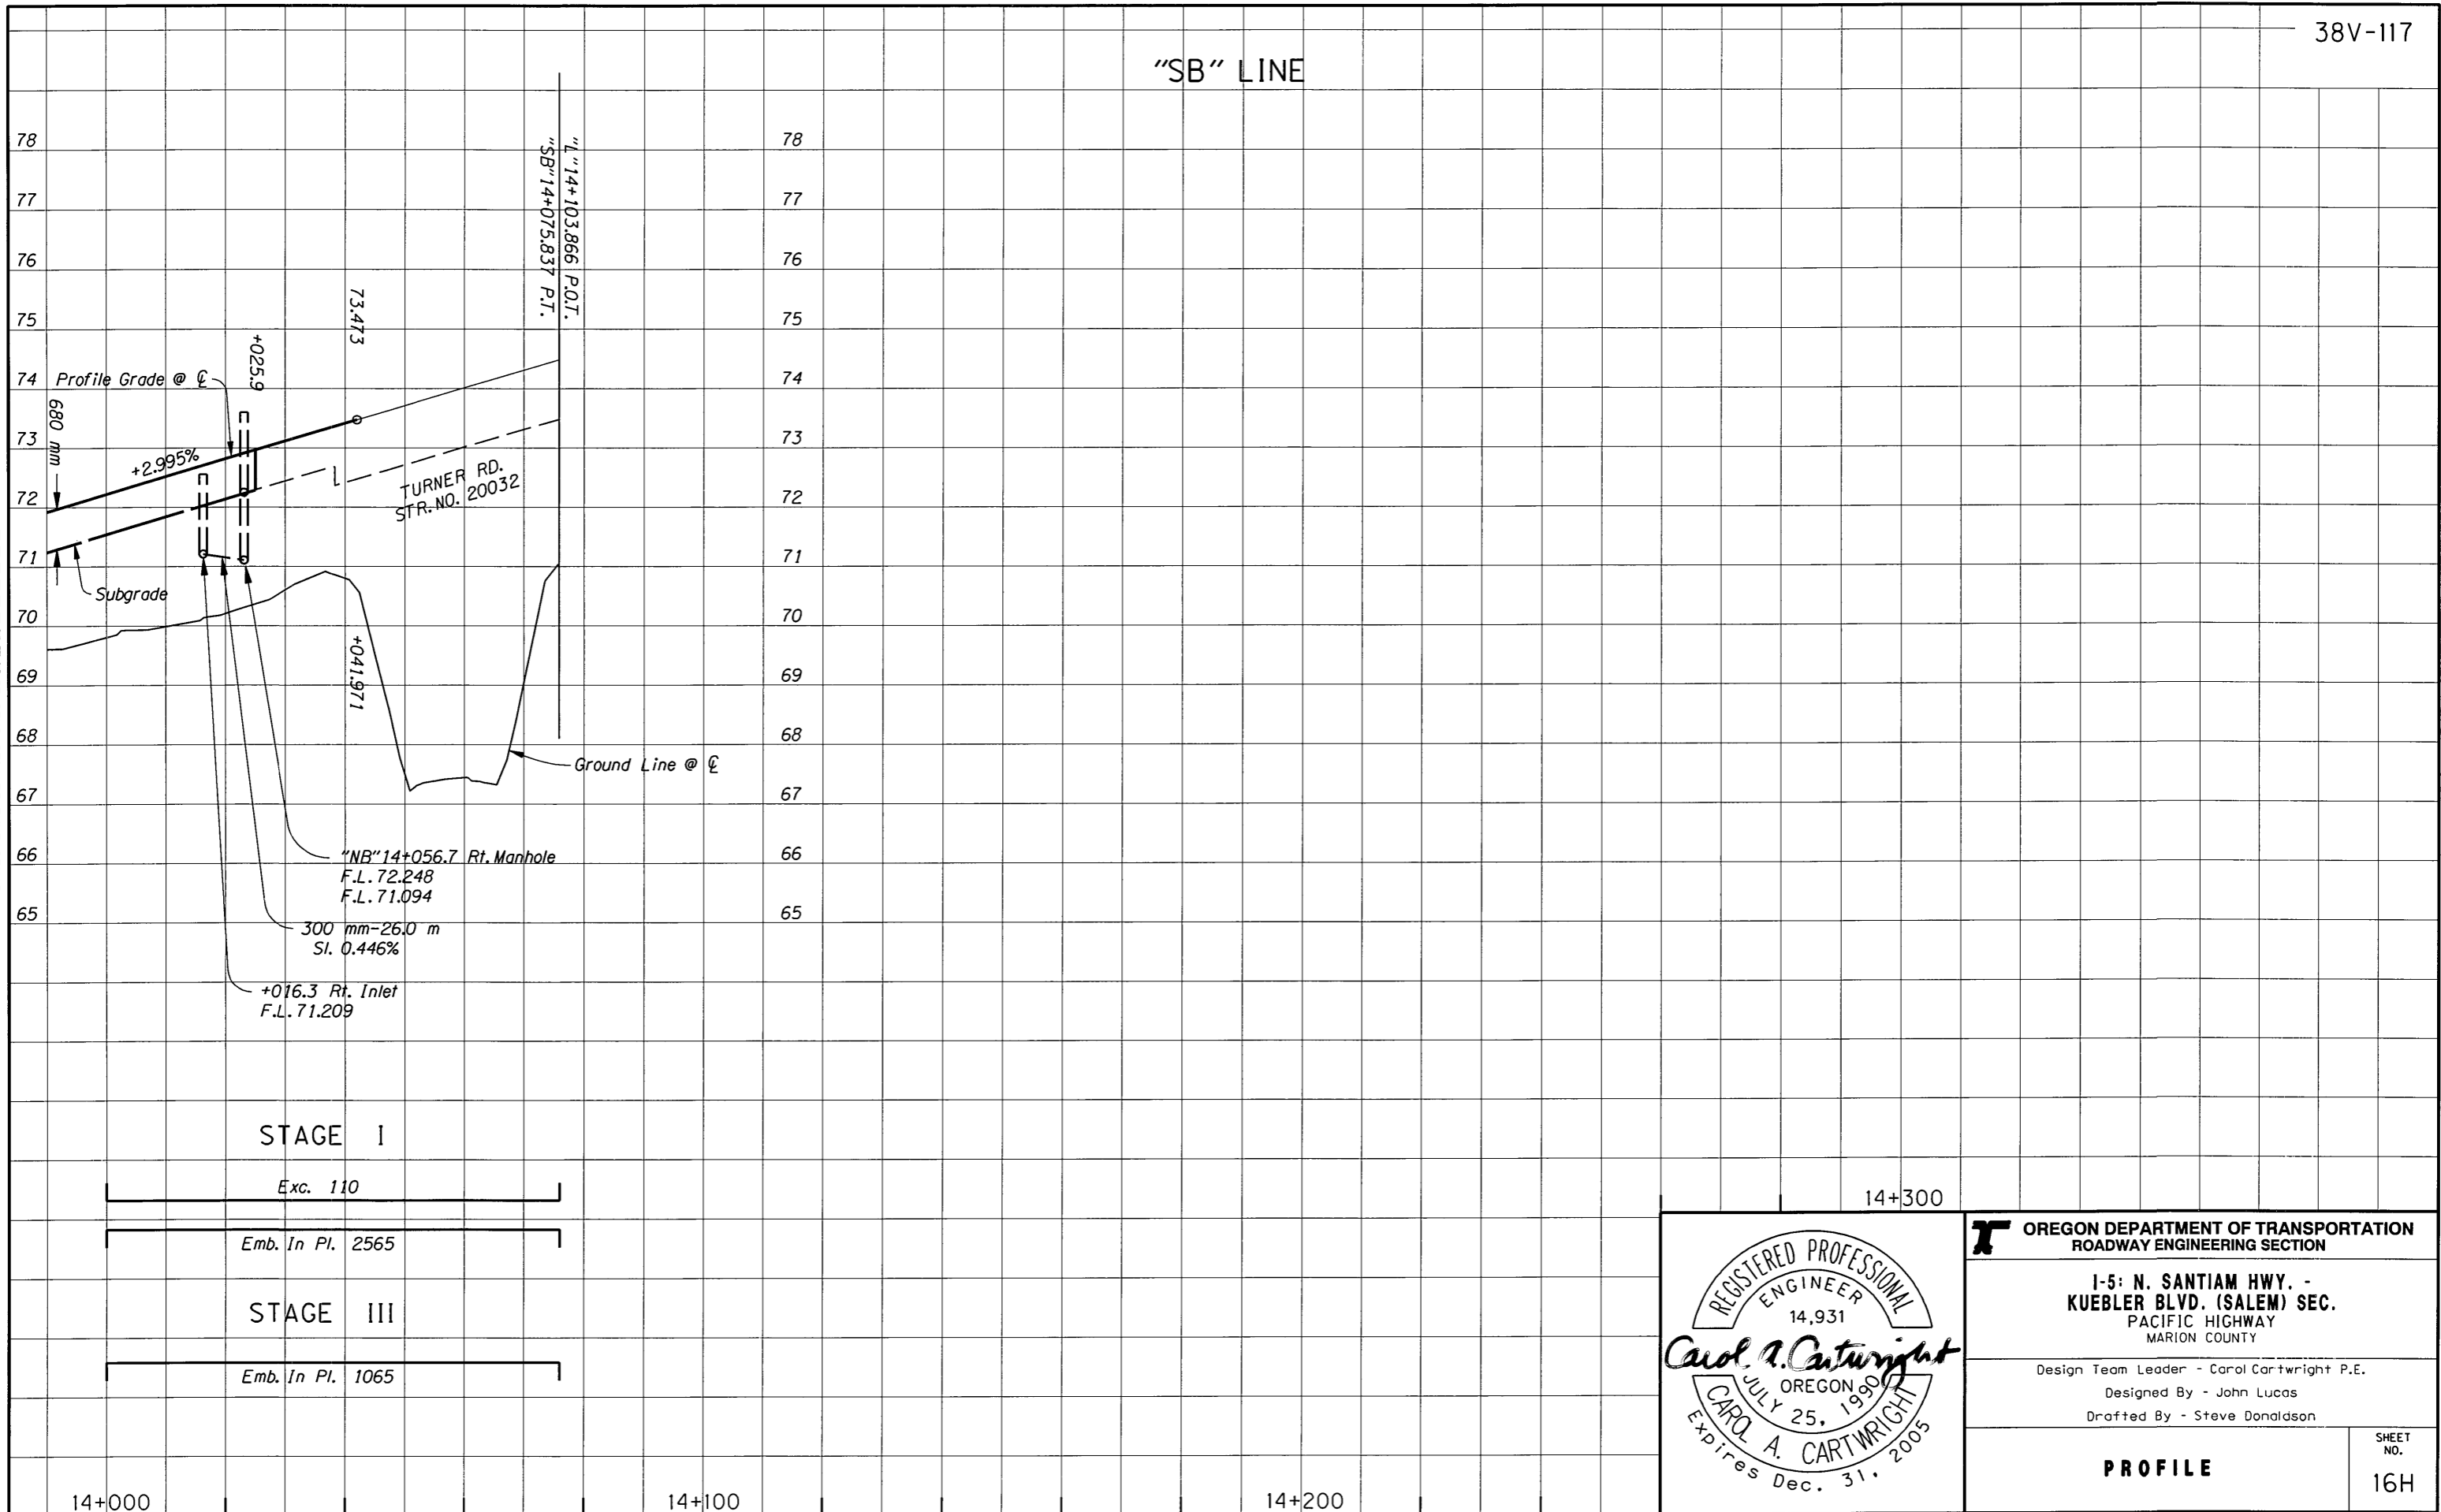

**OREGON DEPARTMENT OF TRANSPORTATION**  
ROADWAY ENGINEERING SECTION


**I-5: N. SANTIAM HWY. - KUEBLER BLVD. (SALEM) SEC.**  
PACIFIC HIGHWAY  
MARION COUNTY

Design Team Leader - Carol Cartwright P.E.  
Designed By - John Lucas  
Drafted By - Steve Donaldson

**PROFILE**

SHEET NO. 16H

"NB" LINE

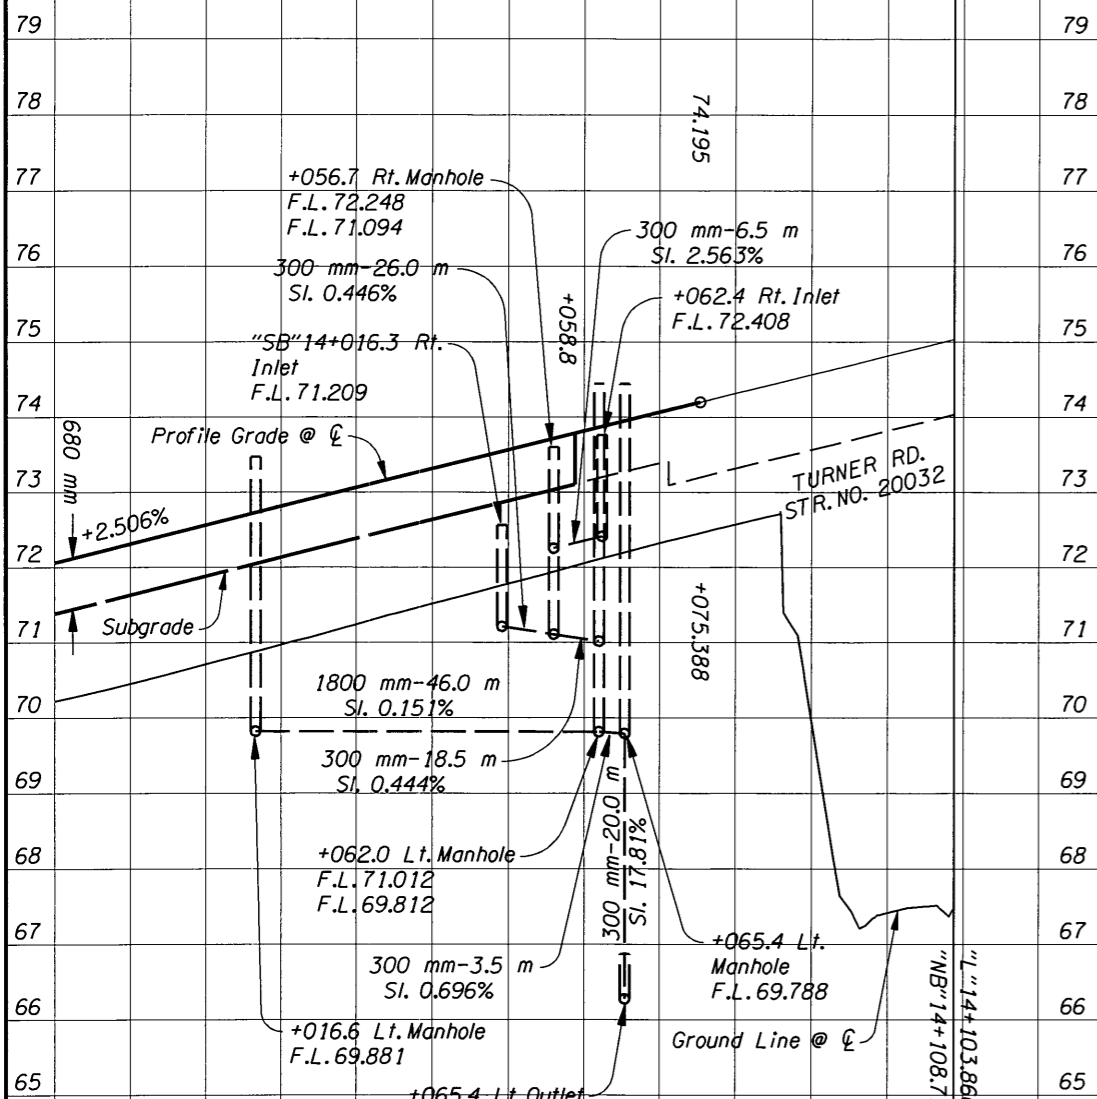

STRUCTURAL DETAILS CHECKED

STAGE II

Emb. In Pl. 6115

STAGE IV

Exc. 5

Emb. In Pl. 15

14+300




OREGON DEPARTMENT OF TRANSPORTATION ROADWAY ENGINEERING SECTION

I-5: N. SANTIAM HWY. - KUEBLER BLVD. (SALEM) SEC. PACIFIC HIGHWAY MARION COUNTY

Design Team Leader - Carol Cartwright P.E. Designed By - John Lucas Drafted By - Steve Donaldson

PROFILE

SHEET NO. 16J

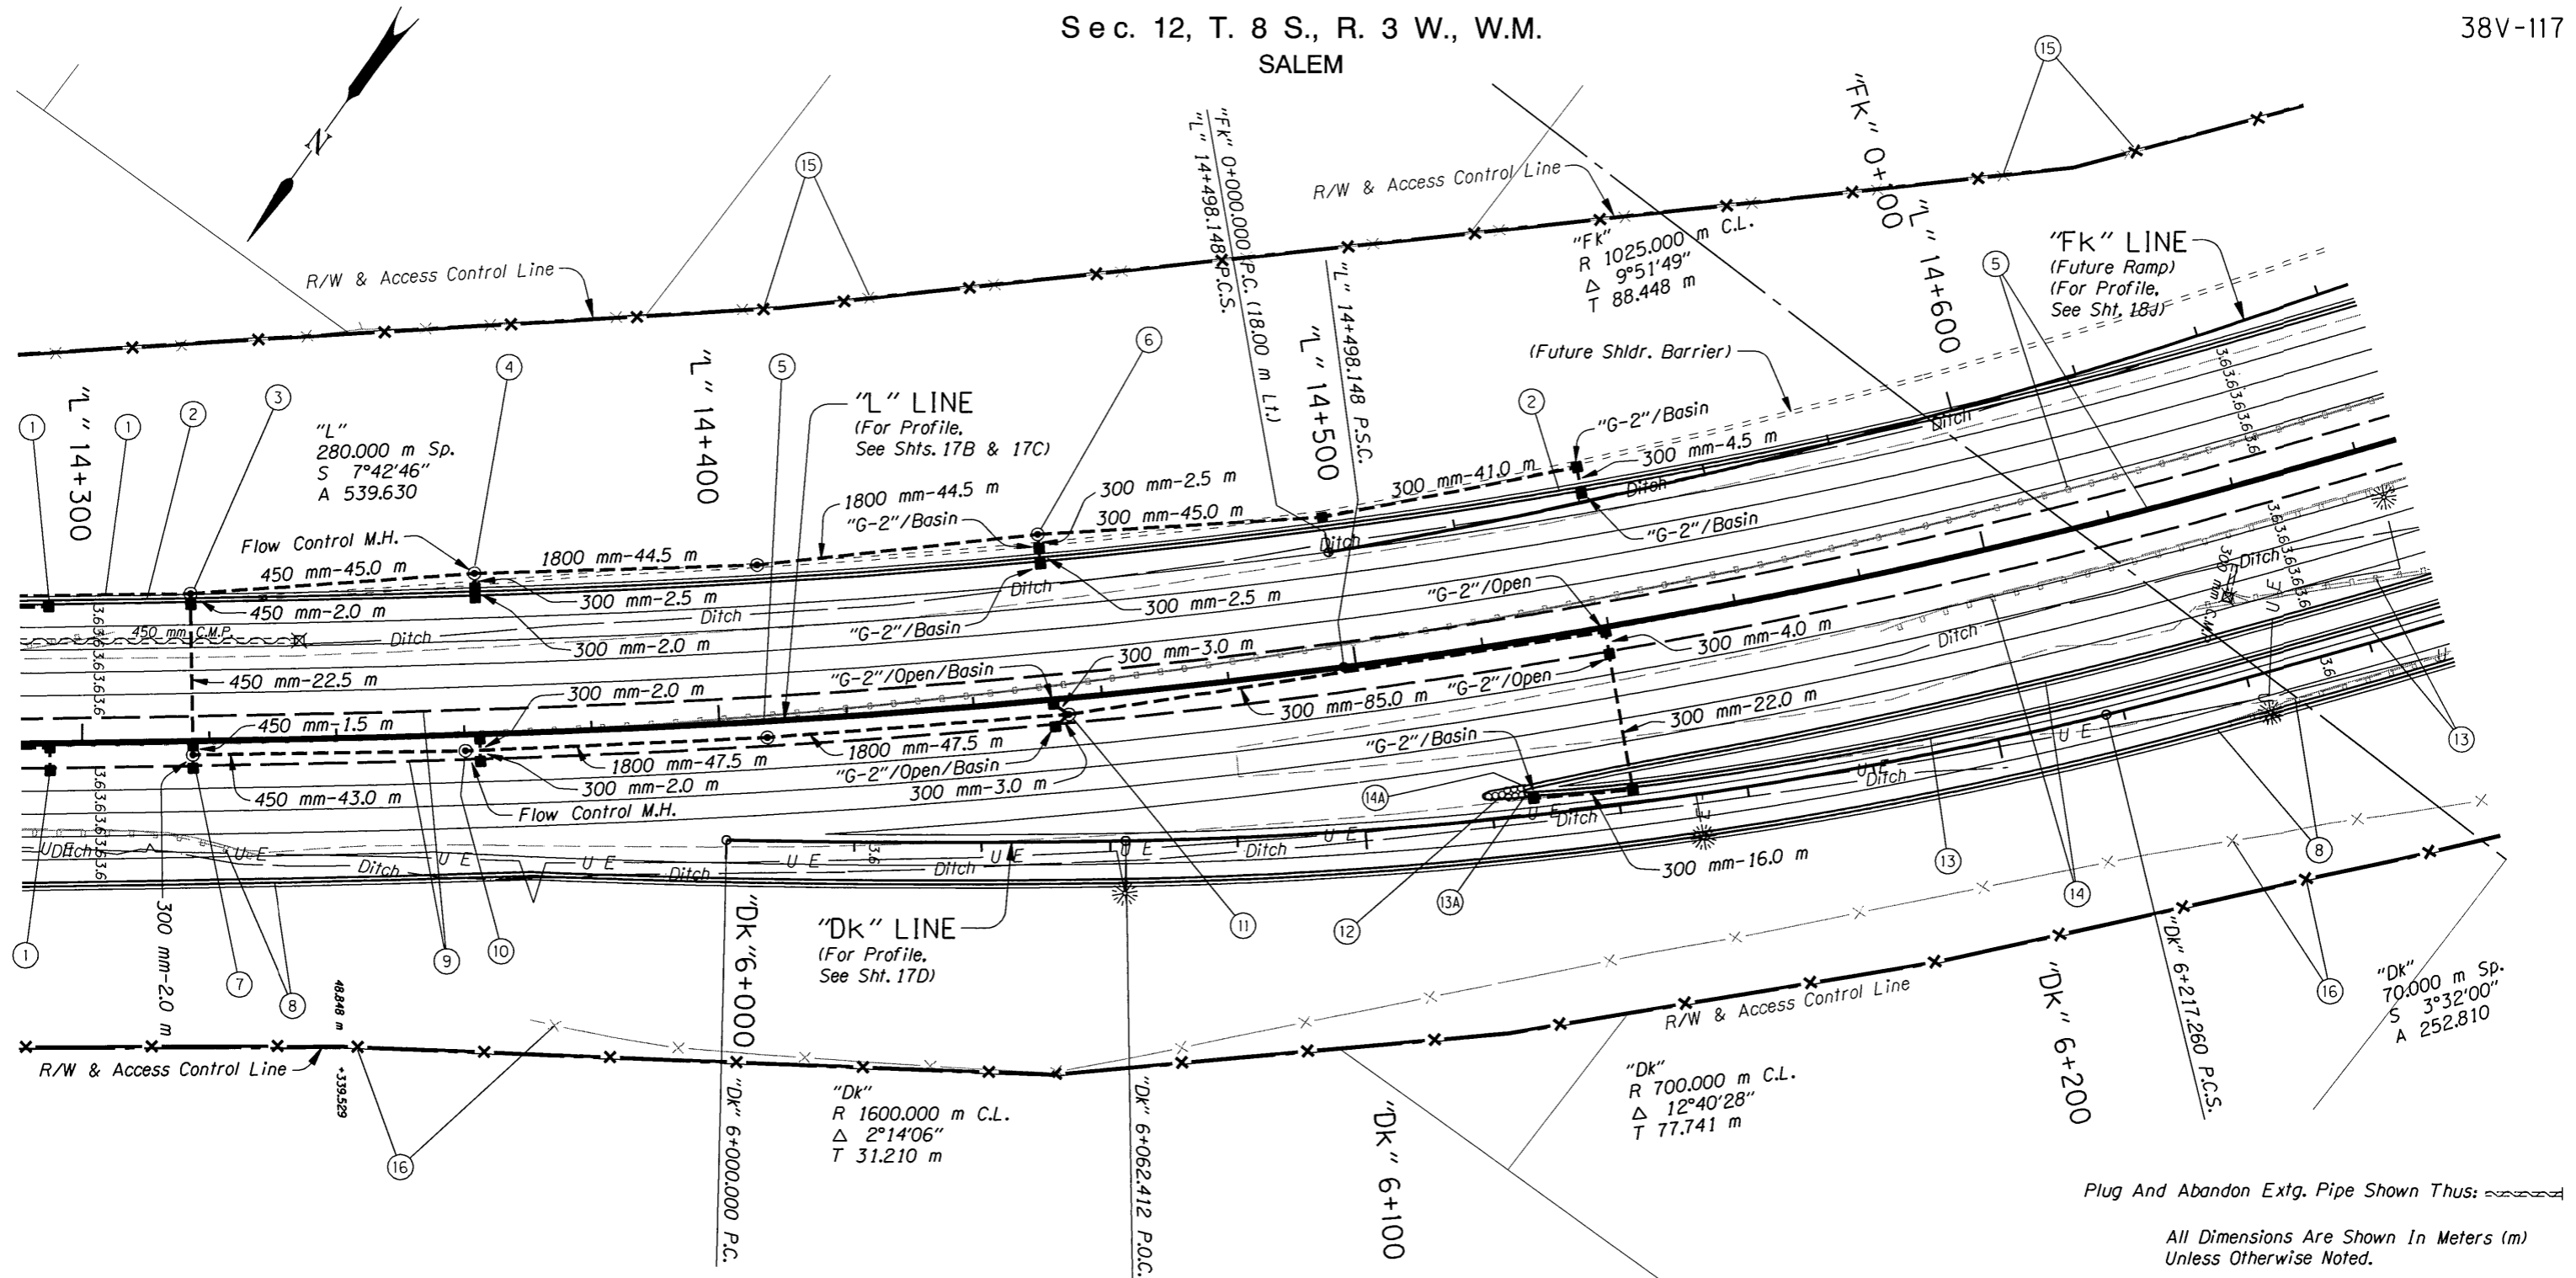

Plug And Abandon Extg. Pipe Shown Thus:

All Dimensions Are Shown In Meters (m)  
Unless Otherwise Noted.



<b>OREGON DEPARTMENT OF TRANSPORTATION</b> ROADWAY ENGINEERING SECTION	
I-5: N. SANTIAM HWY. - KUEBLER BLVD. (SALEM) SEC. PACIFIC HIGHWAY MARION COUNTY	
Design Team Leader - Carol Cartwright Designed By - John Lucas Drafted By - Jeff Larson	
<b>GENERAL CONSTRUCTION</b>	SHEET NO. 17



① See Sht. 16D, Note 8  
Inst. 600 mm Sew. Pipe

② See Sht. 16B, Note 5  
Const. Precast Conc. Shldr. Barrier

③ Sta. "L"14+317.4 To Sta. "L"14+362.4  
Const. Manhole  
Const. Type "G-2" Open Grade HMAC Inlet - 2  
Shape Bottom  
Adjust Inlet For Wearing Course  
Inst. 450 mm Sew. Pipe - 2.0 m  
1.5 m Depth  
Inst. 450 mm Sew. Pipe - 69.0 m  
3.0 m Depth

④ Sta. "L"14+362.4 To Sta. "L"14+452.4  
Const. Flow Control Manhole 2700 mm Dia.  
Const. Manhole 2700 mm Dia.  
Const. Type "G-2" Open Grade HMAC Inlet  
With Basin - 2  
0.45 m Deep  
Adjust Inlet For Wearing Course  
Inst. 300 mm Sew. Pipe - 4.5 m  
1.5 m Depth  
Inst. 1800 mm Sew. Pipe - 89.0 m  
6.0 m Depth  
(For Details, See Sht. GJ-4)

⑤ See Sht. 14B, Note 16  
Remove Extg. Metal Median Barrier  
Const. Precast Tall Conc. Median Barrier

⑥ Sta. "L"14+452.4 To Sta. "L"14+539.4  
Const. Manhole 2700 mm Dia.  
Const. Type "G-2" Open Grade HMAC Inlet  
With Basin - 4  
0.45 m Deep  
Const. Type "G-2" Open Grade HMAC Inlet  
Shape Bottom  
Adjust Inlet For Wearing Course - 2  
Inst. 300 mm Sew. Pipe - 95.5 m  
1.5 m Depth  
(For Details, See Sht. GJ-4)

⑦ Sta. "L"14+317.4 To Sta. "L"14+360.1  
Const. Manhole  
Const. Type "G-2" Open Grade HMAC Inlet  
With Basin  
0.45 m Deep  
Adjust Inlet For Wearing Course  
Inst. 300 mm Sew. Pipe - 2.0 m  
1.5 m Depth  
Inst. 450 mm Sew. Pipe - 43.0 m  
3.0 m Depth

⑧ See Sht. 16B, Note 16  
Remove Extg. Guardrail  
Const. Precast Conc. Shldr. Barrier

⑨ Const. Low Profile Mountable Curb

⑩ Sta. "L"14+360.1 To Sta. "L"14+454.6  
Const. Flow Control Manhole 2700 mm Dia.  
Const. Manhole 2700 mm Dia.  
Const. Type "G-2" Open Grade HMAC Inlet  
With Basin - 2  
0.45 m Deep  
Adjust Inlet For Wearing Course  
Inst. 300 mm Sew. Pipe - 4.0 m  
1.5 m Depth  
Inst. 1800 mm Sew. Pipe - 95.0 m  
6.0 m Depth  
(For Details, See Sht. GJ-4)

⑪ Sta. "L"14+454.6 To Sta. "L"14+539.4  
Const. Manhole 2700 mm Dia.  
Const. Type "G-2" Inlet With Basin  
0.45 m Deep  
Const. Type "G-2" Inlet  
Shape Bottom  
Const. Type "G-2" Open Grade HMAC Inlet - 2  
Shape Bottom  
Const. Type "G-2" Open Grade HMAC Inlet  
With Basin - 2  
Adjust Inlet For Wearing Course - 2  
Inst. 300 mm Sew. Pipe - 133.0 m  
1.5 m Depth  
(For Details, See Sht. GJ-4)

⑫ Sta. "L"14+523.0  
Inst. Impact Attenuator  
(For Details, See Sht. 2B-5)

⑬ Sta. "Dk"6+125.4 To Sta. "Dk"6+350.0  
Remove Extg. Guardrail - 110.5 m  
Const. Precast Conc. Shldr. Barrier - 222.4 m  
(Reflectorized)  
Plug Scuppers


⑬A Connect To Impact Attenuator  
Flare Rate=1:20, W=0.7 m, E=0  
(For Details, See Sht. 2B-5)

⑭ Sta. "L"14+523.0 To Sta. "L"14+743.3  
Remove Extg. Guardrail - 156.2 m  
Const. Precast Conc. Shldr. Barrier - 218.6 m  
(Reflectorized)  
Plug Scuppers

⑭A Connect To Impact Attenuator  
Flare Rate=1:20, W=0.7 m, E=0  
(For Details, See Sht. 2B-5)

⑮ See Sheet 16B, Note 21  
Remove Extg. Fence  
Const. Type CL-6 Fence

⑯ See Sheet 16B, Note 22  
Remove Extg. Fence  
Const. Type CL-6 Fence

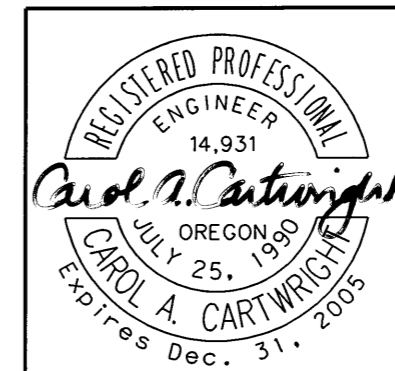

**OREGON DEPARTMENT OF TRANSPORTATION**  
ROADWAY ENGINEERING SECTION


1-5: N. SANTIAM HWY. -  
KUEBLER BLVD. (SALEM) SEC.  
PACIFIC HIGHWAY  
MARION COUNTY

Design Team Leader - Carol Cartwright  
Designed By - John Lucas  
Drafted By - Jeff Larson

**NOTES**

SHEET  
NO.  
17A

# "L" LINE RIGHT (Southbound)

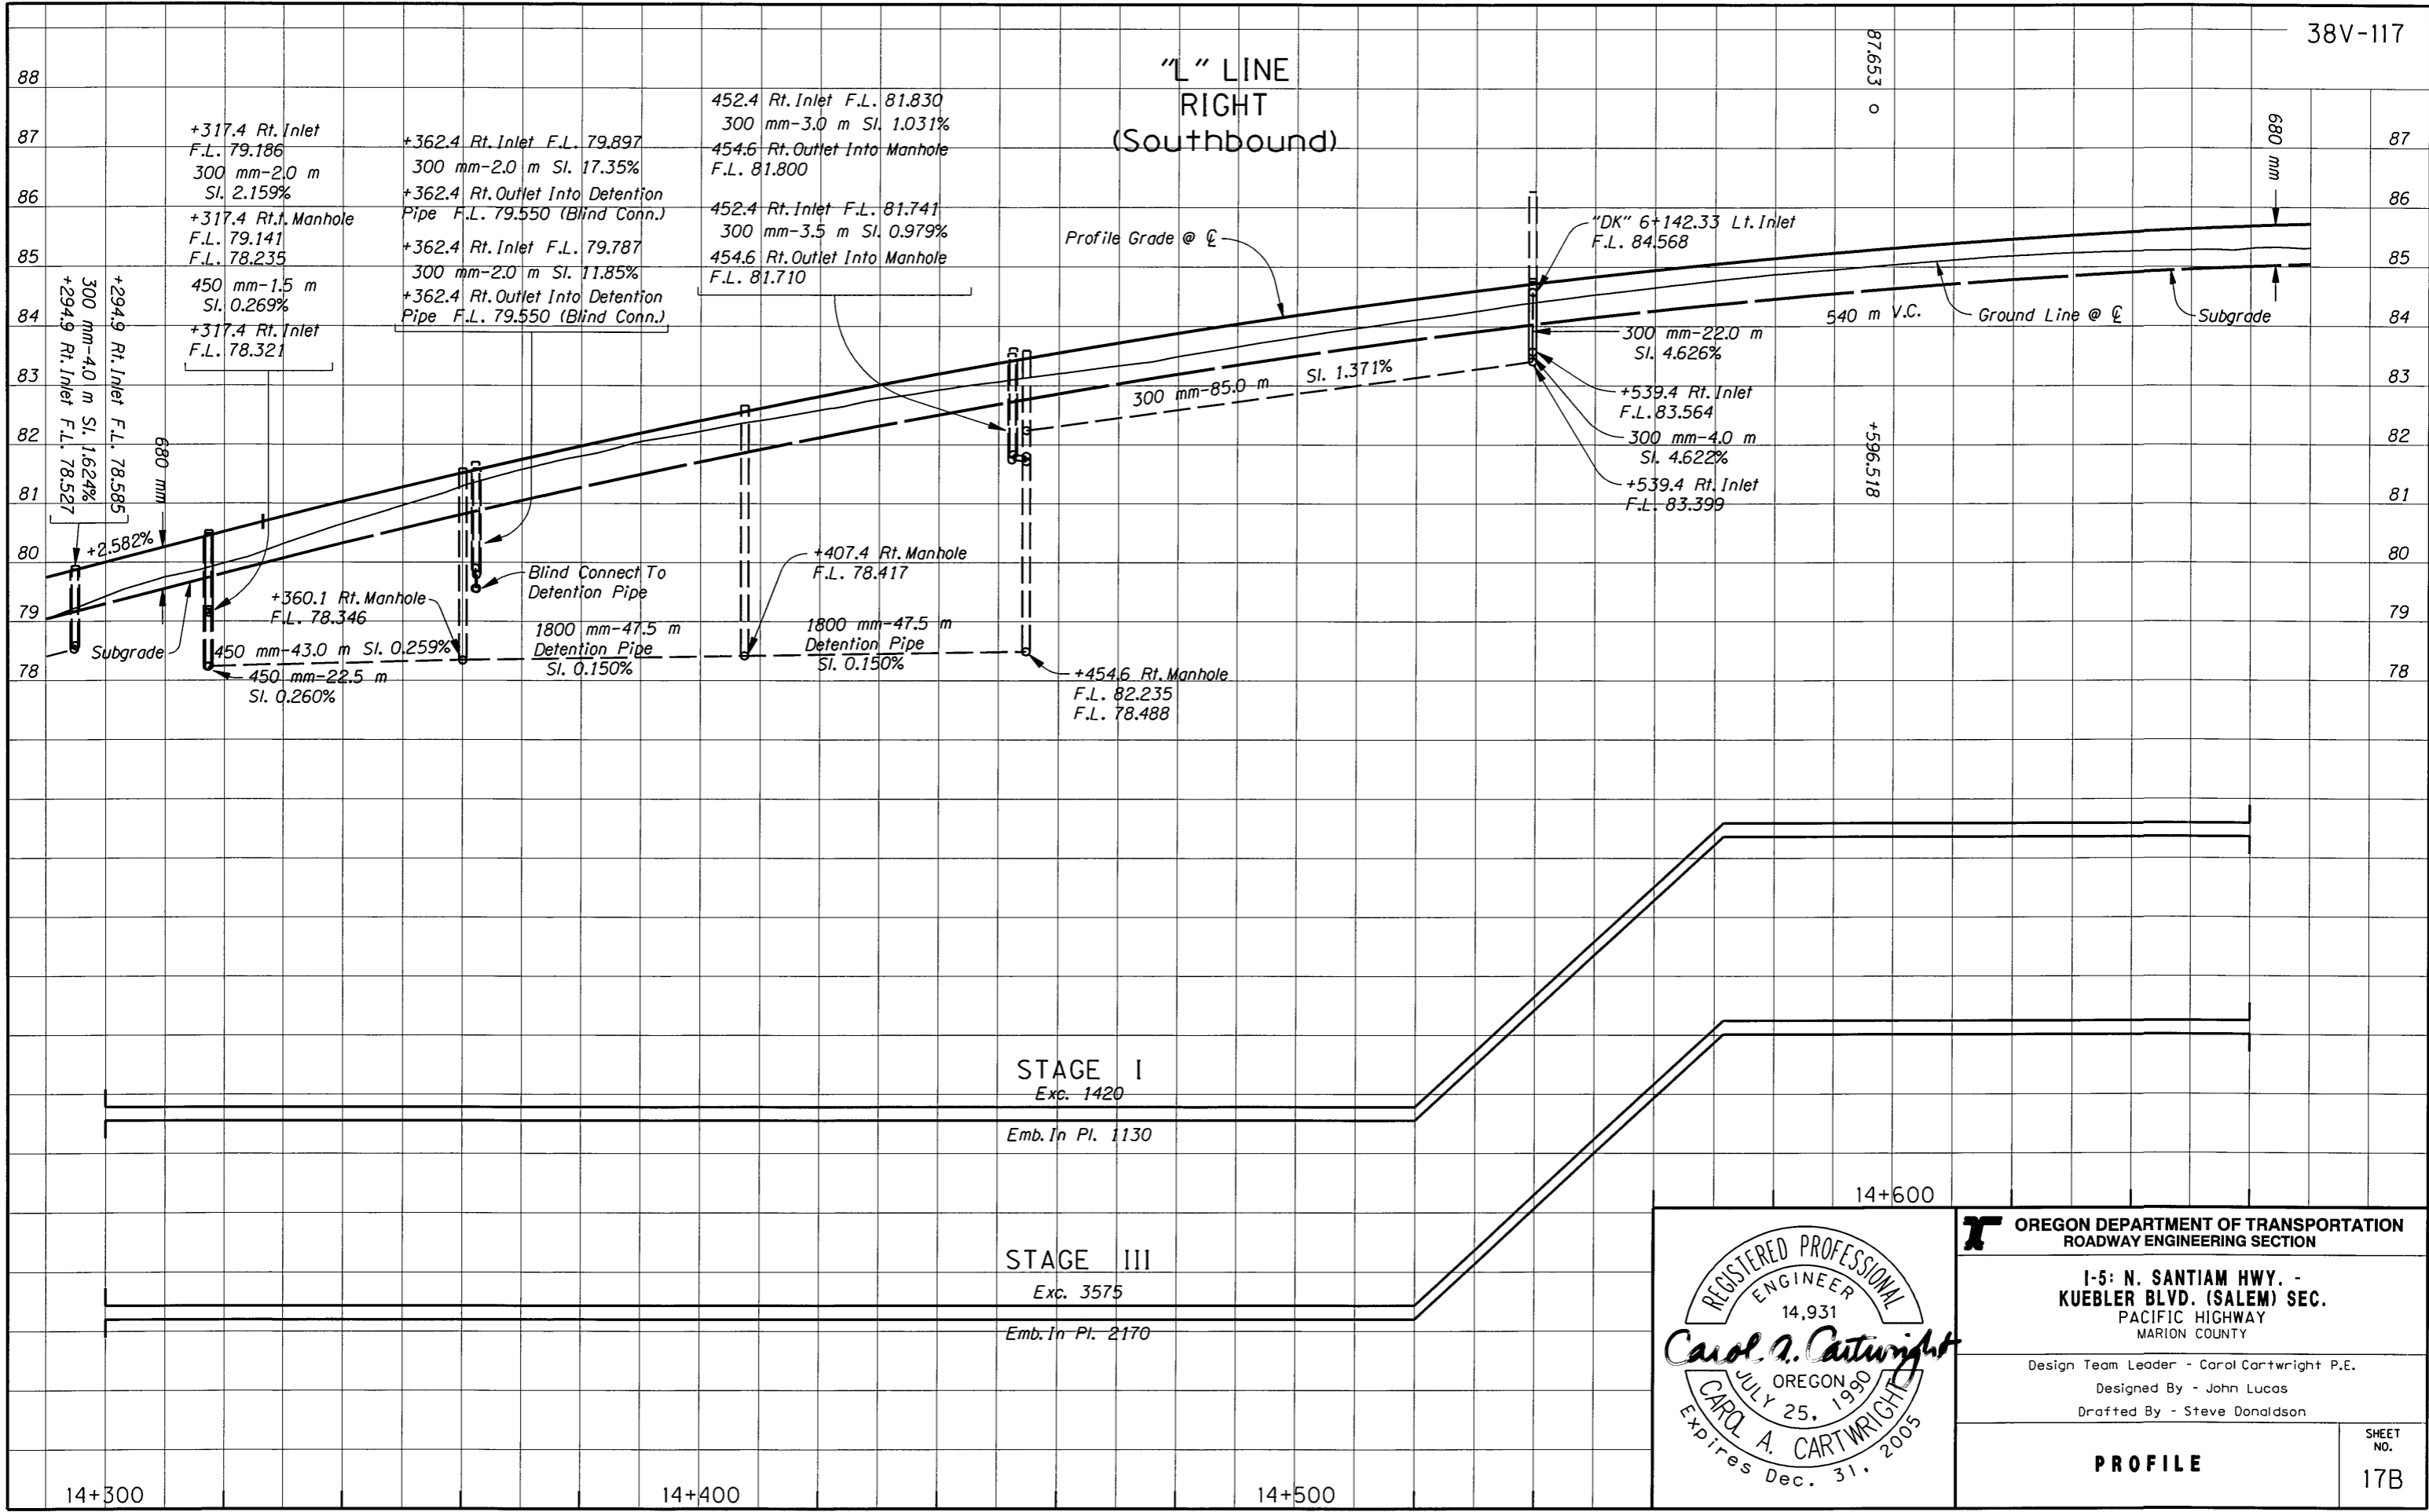

STAGE I  
Exc. 1420

Emb. In Pl. 1130

STAGE III  
Exc. 3575

Emb. In Pl. 2170



**OREGON DEPARTMENT OF TRANSPORTATION**  
ROADWAY ENGINEERING SECTION


**1-5: N. SANTIAM HWY. - KUEBLER BLVD. (SALEM) SEC.**  
PACIFIC HIGHWAY  
MARION COUNTY

Design Team Leader - Carol Cartwright P.E.  
Designed By - John Lucas  
Drafted By - Steve Donaldson

**PROFILE**

SHEET NO. 17B

# "L" LINE LEFT (Northbound)

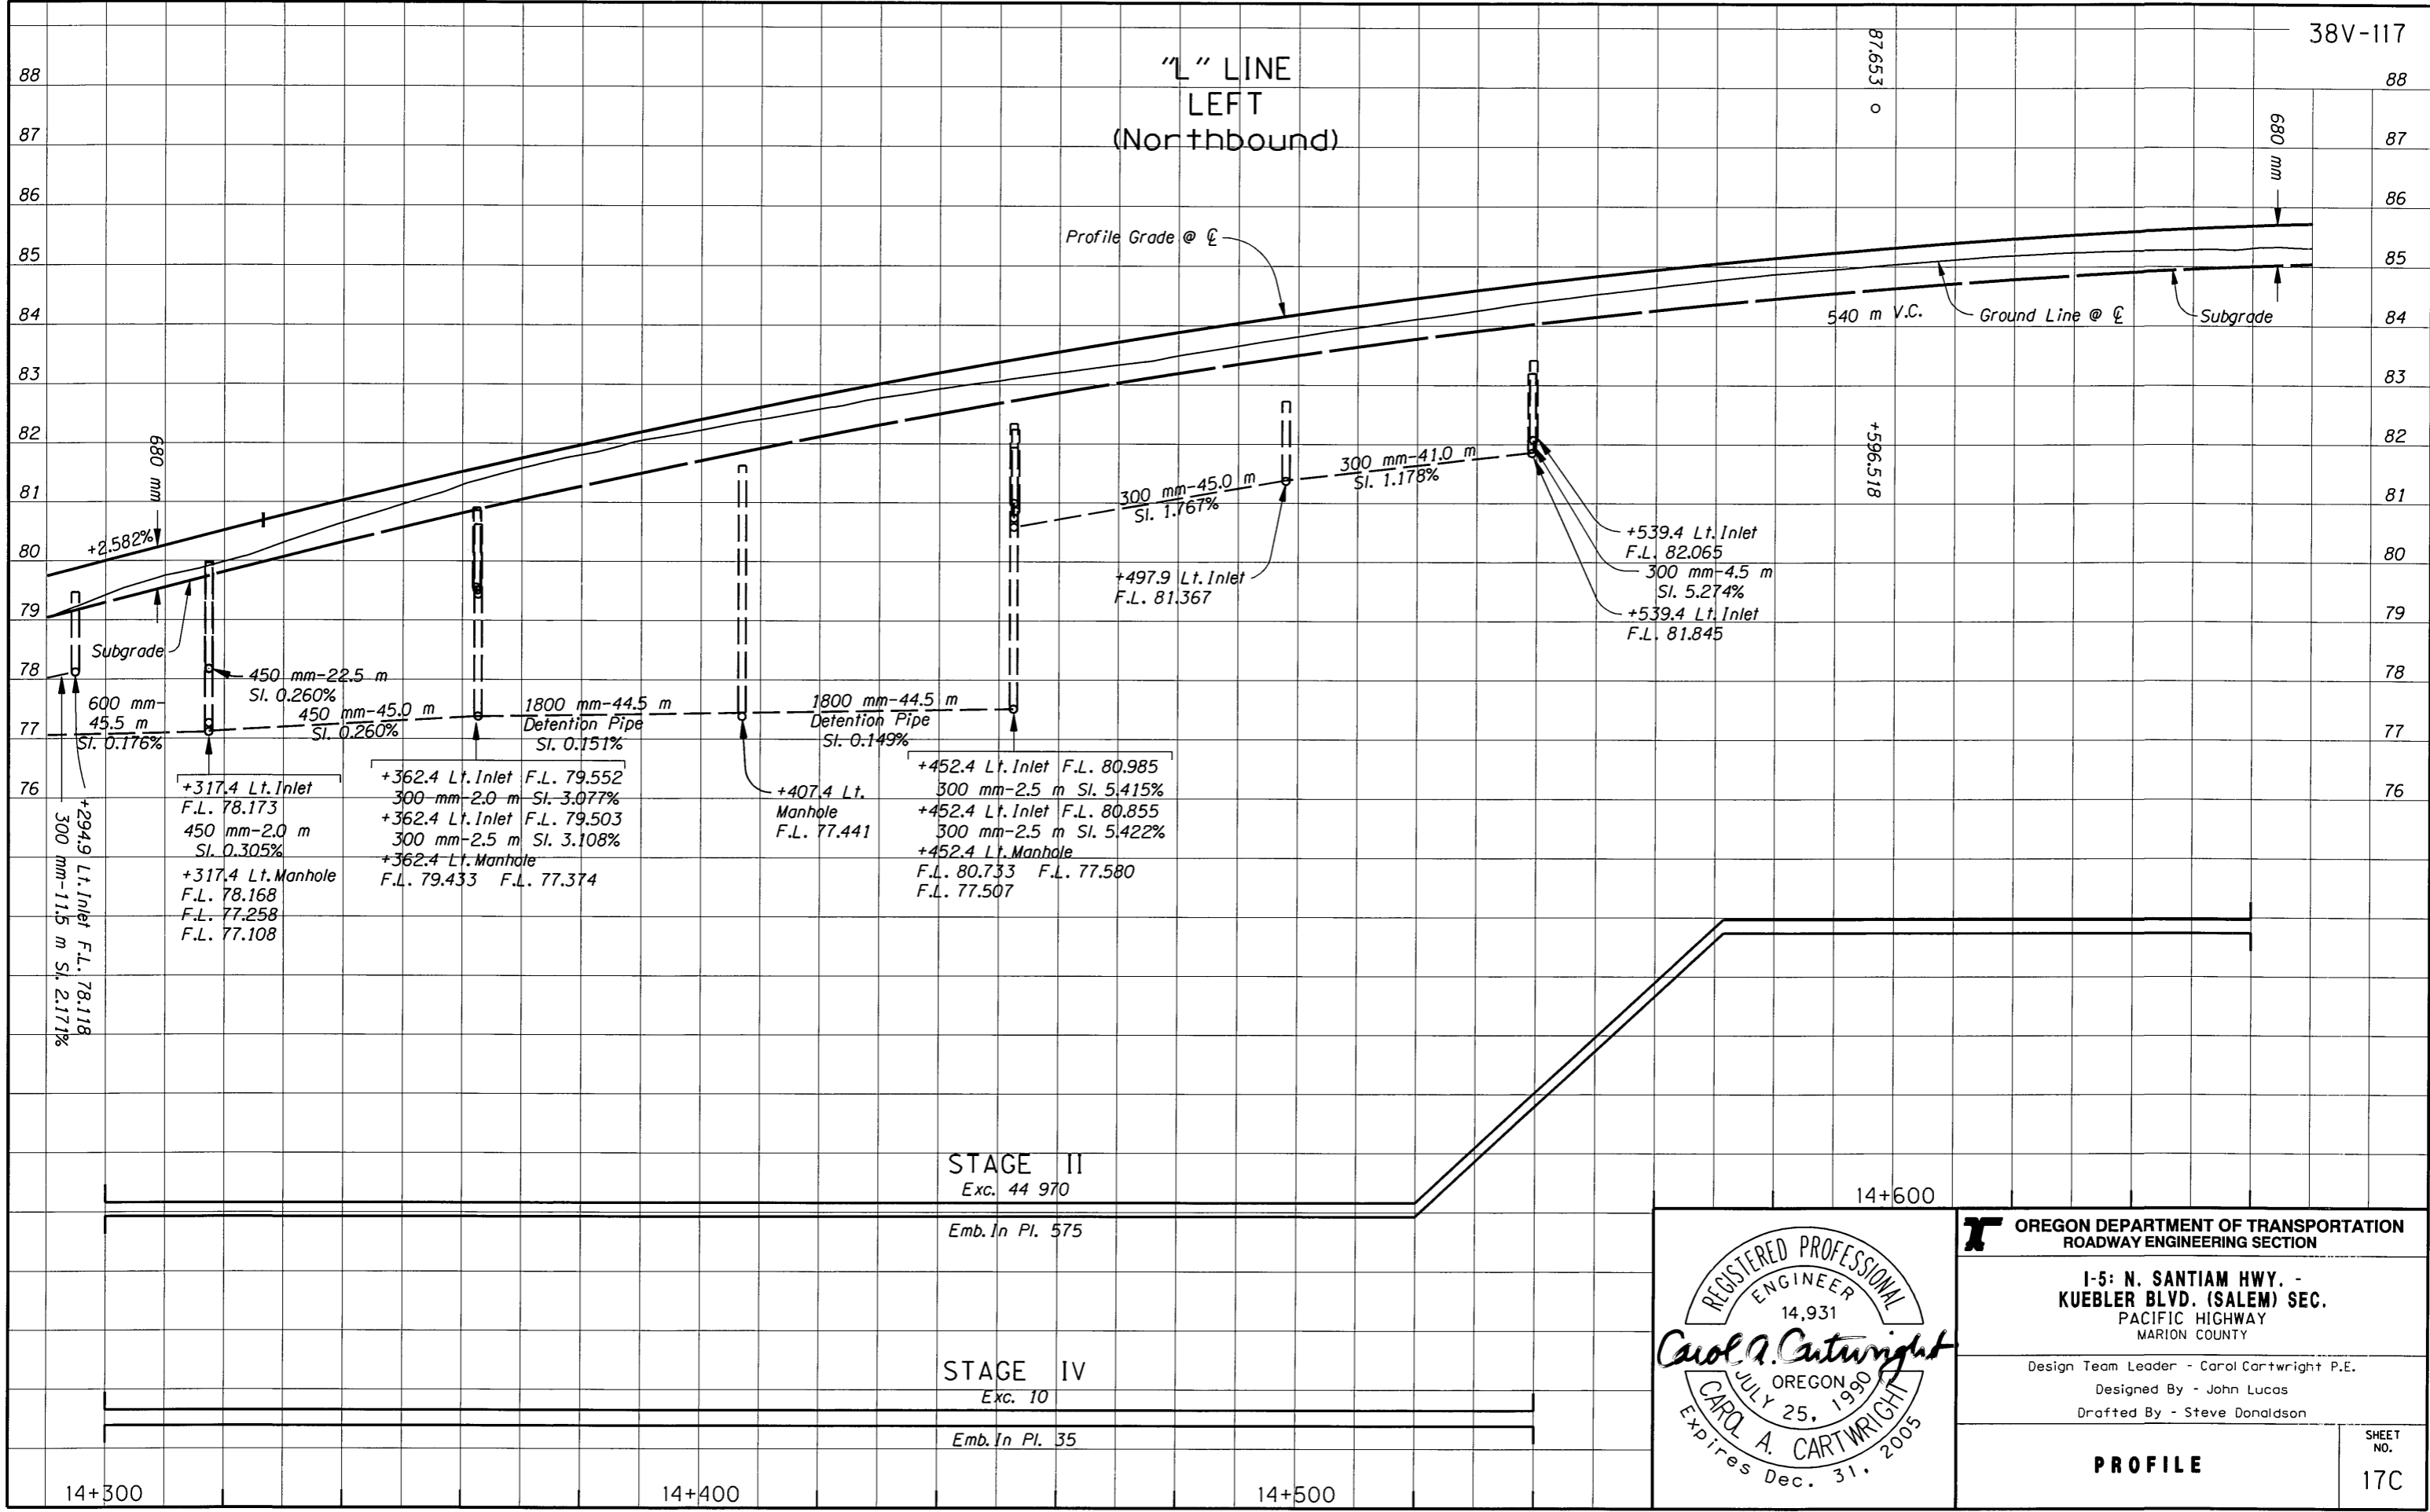


**OREGON DEPARTMENT OF TRANSPORTATION  
ROADWAY ENGINEERING SECTION**

**1-5: N. SANTIAM HWY. -  
KUEBLER BLVD. (SALEM) SEC.  
PACIFIC HIGHWAY  
MARION COUNTY**

Design Team Leader - Carol Cartwright P.E.  
Designed By - John Lucas  
Drafted By - Steve Donaldson


**PROFILE**

SHEET NO.  
**17C**

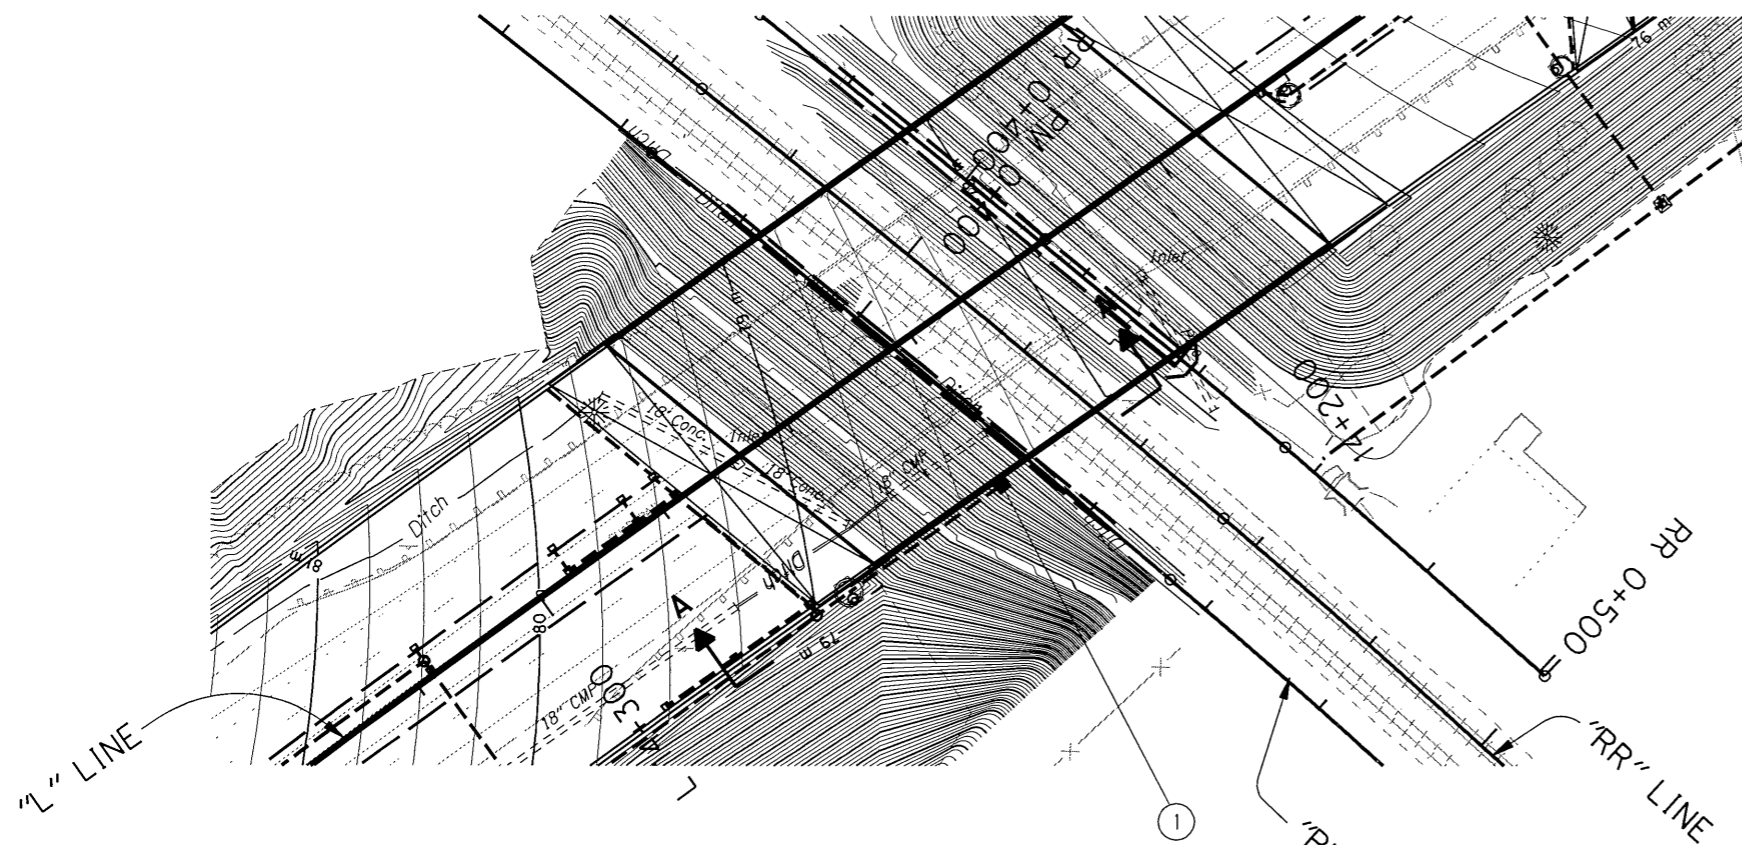


PLAN  
Scale 1:1000


① Sta. "L"14+241.4 To Sta. "L"14+266.3  
Const. Type Modified "D" Inlet  
Inst. 300 mm Sew. Pipe - 26.5 m  
Inst. Metal Pipe Slope Anchors  
(See Sht. 16D, Note 6)  
(See Details Below And  
Drg. Nos. RD330, RD370)

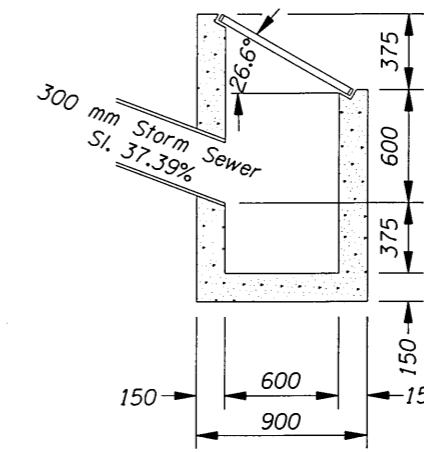


SECTION A-A

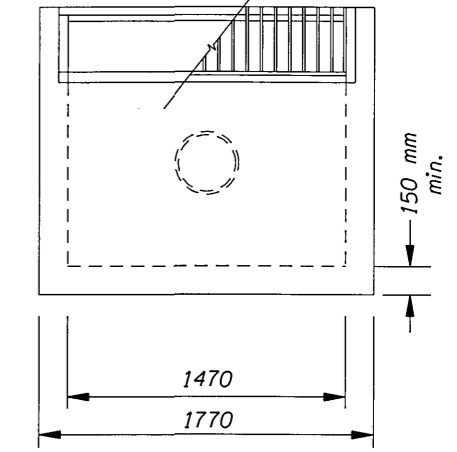

SECTION B-B

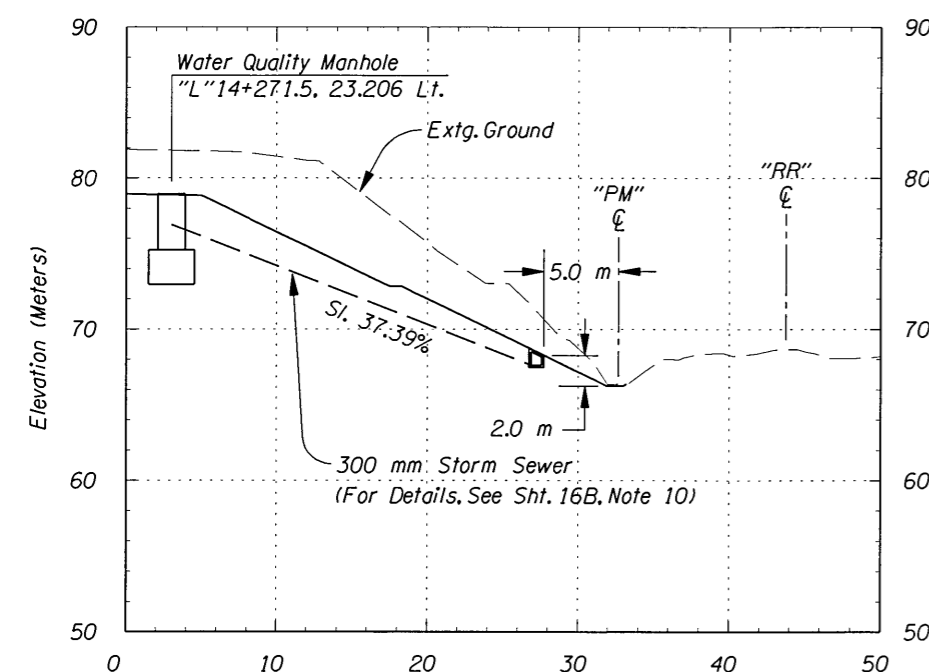


SECTION A-A

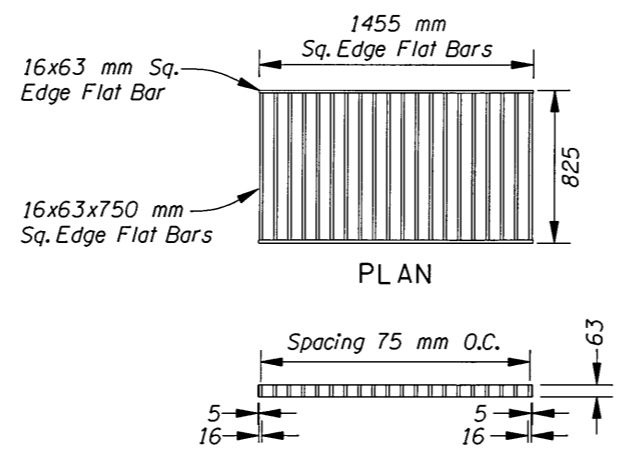


GRATE SECTION TYPE 1


Note:  
9 mm Cross Bars Shall Be Flush With The Grate Surface And  
May Be Fillet Welded, Resistance Welded Or Electroforged  
To Bearing Bars.

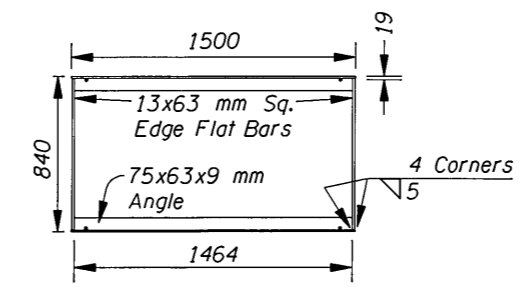

FRAME PLAN

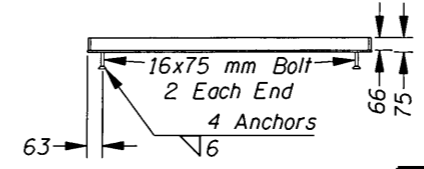

FRAME SECTION

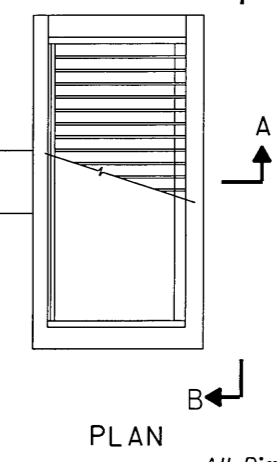

PLAN

- Notes:
1. Concrete Strength Shall Be Commercial Grade Concrete.
  2. G-2 Grates May Be Used If Approved By The Engineer.
  3. Catch Basin, Frame, And Grates Shall Meet MS18 Loading.

All Dimensions Are Shown In Millimeters (mm)  
Unless Otherwise Noted.



OREGON DEPARTMENT OF TRANSPORTATION  
ROADWAY ENGINEERING SECTION

1-5: N. SANTIAM HWY. -  
KUEBLER BLVD. (SALEM) SEC.  
PACIFIC HIGHWAY  
MARION COUNTY

Reviewed By - Luis Rivas  
Designed By - Chris Carman  
Drafted By - Steve Donaldson

**STORMWATER**

SHEET NO.  
GJ-9

U.P.R.R ENERGY DISSIPATOR

# Appendix C

## Content:


- **Proprietary Structure Maintenance Requirements**

# Operation & Maintenance Manual

For D00034

## I-5: N. Santiam Highway Kuebler Blvd Salem, Oregon

6 RECEIVED  
DEC 01 2008  
OBDDP

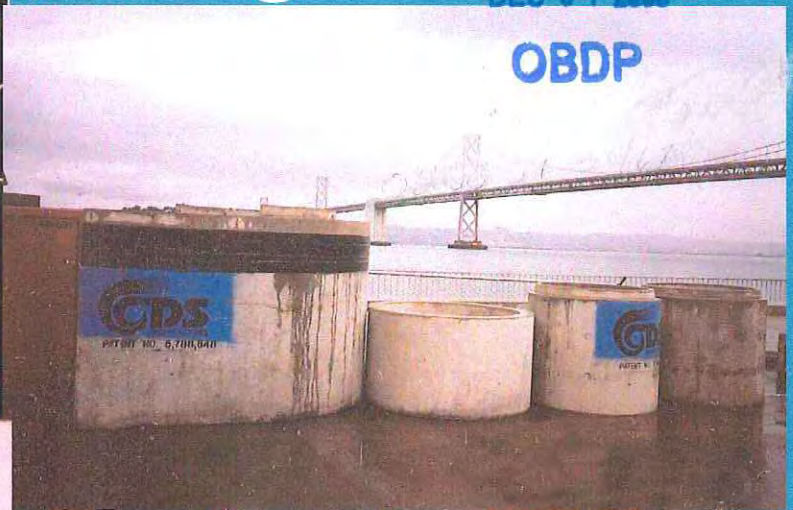

CDS Technologies  
PMB #438, 4110 SE Hawthorne Blvd.  
Portland, OR 97214-5246  
503-872-8593  
503-872-8597 fax



**OPERATIONS AND MAINTENANCE GUIDELINES**  
**For the CDS Technologies Models PMSU, PSW & PSWC**  
**CONTINUOUS DEFLECTIVE SEPARATION UNIT**

**Located at**

I-5: N. Santiam Highway Kuebler Blvd  
Salem, OR

**INTRODUCTION**

The CDS unit is an important and effective component of your storm water management program and proper operation and maintenance of the unit are essential to demonstrate your compliance with local, state and federal water pollution control requirements.

The CDS technology features a patented non-blocking, indirect screening technique developed in Australia to treat water runoff. The unit is highly effective in the capture of suspended solids, fine sands and larger particles. Because of its non-blocking screening capacity, the CDS unit is un-matched in its ability to capture and retain gross pollutants such as trash and debris. In short, CDS units capture a very wide range of organic and in-organic solids and pollutants that typically result in tons of captured solids each year: total suspended solids (TSS), sediments, oil and greases and captured trash and debris (including floatables, neutrally buoyant, and negatively buoyant debris) under very high flow rate conditions.

CDS units are equipped with conventional oil baffles to capture and retain oil and grease. Laboratory evaluations show that the CDS units are capable of capturing up to 70% of the free oil and grease from storm water. CDS units can also accommodate the addition of oil sorbents within their separation chambers. The addition of the oil sorbents can ensure the permanent removal of 80% to 90% of the free oil and grease from the storm water runoff.

**OPERATIONS**

The CDS unit is a non-mechanical self-operating system and will function any time there is flow in the storm drainage system. The unit will continue to effectively capture pollutants in flows up to the design capacity even during extreme rainfall events when the design capacity may be exceeded. Pollutants captured in the CDS unit's separation chamber and sump will be retained even when the units design capacity is exceeded.

**CDS UNIT CLEANOUT**

The frequency of cleaning the CDS unit will depend upon the generation of trash and debris and sediments in your application. Cleanout and preventive maintenance schedules will be determined based on operating experience unless precise pollutant loadings have been determined. The unit should be periodically inspected to determine the amount of accumulated pollutants and to ensure that the cleanout frequency is adequate to handle the predicted pollutant load being processed by the CDS unit. The recommended cleanout of solids within the CDS unit's sump should occur at 75% of the sump capacity. However, the sump may be completely full with no impact to the CDS unit's performance.

Access to the CDS unit is typically achieved through two manhole access covers – one allows inspection and cleanout of the separation chamber (screen/cylinder) & sump and another allows inspection and cleanout of sediment captured and retained behind the screen. The PSW & PSWC off-line models have an additional access cover over the weir of the diversion vault. For units possessing a sizable depth below grade (depth to pipe), a single manhole access point would allow both sump cleanout and access behind the screen.

CDS Technologies Recommends The Following:

**NEW INSTALLATIONS** – Check the condition of the unit after every runoff event for the first 30 days. The visual inspection should ascertain that the unit is functioning properly (no blockages or obstructions to inlet and/or separation screen), measuring the amount of solid materials that have accumulated in the sump, the amount of fine sediment accumulated behind the screen, and determining the amount floating trash and debris in the separation chamber. This can be done with a calibrated “dip stick” so that the depth of deposition can be tracked. Refer to **Appendix A – Annual Record of Maintenance & Cleanout Elevation View** for allowable deposition depths and critical distances. Schedules for inspections and cleanout should be based on storm events and pollutant accumulation.

**ONGOING OPERATION** – During the rainfall season, the unit should be inspected at least once every 30 days. The floatables should be removed and the sump cleaned when the sump is 75-85% full. If floatables accumulate more rapidly than the settleable solids, the floatables should be removed using a vactor truck or dip net before the layer thickness exceeds one to two feet.

Cleanout of the CDS unit at the end of a rainfall season is recommended because of the nature of pollutants collected and the potential for odor generation from the decomposition of material collected and retained. This end of season cleanout will assist in preventing the discharge of pore water from the CDS® unit during summer months.

**USE OF SORBENTS** – It needs to be emphasized that the addition of sorbents is not a requirement for CDS units to effectively control oil and grease from storm water. The conventional oil baffle within a unit assures satisfactory oil and grease removal. However, the addition of sorbents is a unique enhancement capability special to CDS units, enabling increased oil and grease capture efficiencies beyond that obtainable by conventional oil baffle systems.

Under normal operations, CDS units will provide effluent concentrations of oil and grease that are less than 15 parts per million (ppm) for all dry weather spills where the volume is less than or equal to the spill capture volume of the CDS unit. During wet weather flows, the oil baffle system can be expected to remove between 40 and 70% of the free oil and grease from the storm water runoff.

CDS Technologies only recommends the addition of sorbents to the separation chamber if there are specific land use activities in the catchment watershed that could produce exceptionally large concentrations of oil and grease in the runoff,



concentration levels well above typical amounts. If site evaluations merit an increased control of free oil and grease then oil sorbents can be added to the CDS unit to thoroughly address these particular pollutants of concern.

### **Recommended Oil Sorbents**

Rubberizer® Particulate 8-4 mesh or OARS™ Particulate for Filtration, HPT4100 or equal. Rubberizer® is supplied by Haz-Mat Response Technologies, Inc. 4626 Santa Fe Street, San Diego, CA 92109 (800) 542-3036. OARS™ is supplied by AbTech Industries, 4110 N. Scottsdale Road, Suite 235, Scottsdale, AZ 85251 (800) 545-8999.

The amount of sorbent to be added to the CDS separation chamber can be determined if sufficient information is known about the concentration of oil and grease in the runoff. Frequently the actual concentrations of oil and grease are too variable and the amount to be added and frequency of cleaning will be determined by periodic observation of the sorbent. As an initial application, CDS recommends that approximately 4 to 8 pounds of sorbent material be added to the separation chamber of the CDS units per acre of parking lot or road surface per year. Typically this amount of sorbent results in a ½ inch to one (1") inch depth of sorbent material on the liquid surface of the separation chamber. The oil and grease loading of the sorbent material should be observed after major storm events. Oil Sorbent material may also be furnished in pillow or boom configurations.

The sorbent material should be replaced when it is fully discolored by skimming the sorbent from the surface. The sorbent may require disposal as a special or hazardous waste, but will depend on local and state regulatory requirements.

### **CLEANOUT AND DISPOSAL**

A vactor truck is recommended for cleanout of the CDS unit and can be easily accomplished in less than 30-40 minutes for most installations. Standard vactor operations should be employed in the cleanout of the CDS unit. Disposal of material from the CDS unit should be in accordance with the local municipality's requirements. Disposal of the decant material to a POTW is recommended. Field decanting to the storm drainage system is not recommended. Solids can be disposed of in a similar fashion as those materials collected from street sweeping operations and catch-basin cleanouts.

### **MAINTENANCE**

The CDS unit should be pumped down at least once a year and a thorough inspection of the separation chamber (inlet/cylinder and separation screen) and oil baffle performed. The unit's internal components should not show any signs of damage or any loosening of the bolts used to fasten the various components to the manhole structure and to each other. Ideally, the screen should be power washed for the

inspection. If any of the internal components is damaged or if any fasteners appear to be damaged or missing, please contact CDS Technologies to make arrangements to have the damaged items repaired or replaced:

CDS Technologies, Inc.  
16360 Monterey Road, Suite 250  
Morgan Hill, CA 95037-5406

Phone, Toll Free: (888) 535-7559  
Fax: (408) 782-0721

The screen assembly is fabricated from Type 316 stainless steel and fastened with Type 316 stainless steel fasteners that are easily removed and/or replaced with conventional hand tools. The damaged screen assembly should be replaced with the new screen assembly placed in the same orientation as the one that was removed.

### **CONFINED SPACE**

The CDS unit is a confined space environment and only properly trained personnel possessing the necessary safety equipment should enter the unit to perform maintenance or inspection procedures. Inspections of the internal components can, in most cases, be accomplished through observations from the ground surface.

### **RECORDS OF OPERATION AND MAINTENANCE**

CDS Technologies recommends that the owner maintain annual records of the operation and maintenance of the CDS unit to document the effective maintenance of this important component of your storm water management program. The attached **Annual Record of Operations and Maintenance** form (see **Appendix A**) is suggested and should be retained for a minimum period of three years.



STORM WATER • CSO/SSO • WASTEWATER

**Date:** 11/20/2006

**Project:** I-5: N. Santiam Highway Kuebler Blvd

**Subject:** Maintenance Pump Volume – Replacement Oil Sorbent Quantity

**Location:** Salem, OR

**CDS Model Number:** PMSU30\_30 (1)

The CDS PMSU30\_30, 3.0 unit installed at the I-5: N. Santiam Highway Kuebler Blvd project in Salem, OR is designed with 6.41 cubic yards (173 cubic feet) (1295 gallons) of storage volume. This volume includes the pounds of sediments that will settle inside of the sump, fine sediment on the separation slab, trash and debris along with the water. Once the unit is maintained the above listed volume of water should be added to the cleaned unit to prepare for treatment of the next storm event.

If oil sorbent material is to be used in this unit, 36 sorbent booms are recommended to be installed inside the fiberglass cylinder on the water surface. This material will provide 80% removal of floatable oil and grease in storm water at an average concentration of 15 ppm. It is recommended that booms are replaced more frequently if higher oil and grease loadings occur.

Please contact CDS Technologies to coordinate ordering new oil sorbent material or see page 3 of this manual for manufacturers of the sorbent material if you wish to order it direct.



APPENDIX A  
ANNUAL RECORD OF  
OPERATIONS AND MAINTENANCE  
&  
CLEANOUT ELEVATION VIEW  
(PROJECT SPECIFIC)

**CDS TECHNOLOGIES  
ANNUAL RECORD  
OF  
OPERATION AND MAINTENANCE**

**OWNER** \_\_\_\_\_

**ADDRESS** \_\_\_\_\_

**OWNER REPRESENTATIVE** \_\_\_\_\_ **PHONE** \_\_\_\_\_

**CDS INSTALLATION:**

MODEL DESIGNATION \_\_\_\_\_ DATE \_\_\_\_\_

SITE LOCATION \_\_\_\_\_

DEPTH FROM COVER TO BOTTOM OF SUMP \_\_\_\_\_

VOLUME OF SUMP \_\_\_\_\_ CUYD VOLUME/INCH DEPTH \_\_\_\_\_ CUYD

**INSPECTIONS:**

DATE/INSPECTOR	SCREEN INTEGRITY	FLOATABLES DEPTH	SEDIMENT VOLUME	SORBENT DISCOLORATION

OBSERVATIONS OF FUNCTION: \_\_\_\_\_

**CLEANOUT:**

DATE	VOLUME FLOATABLES	VOLUME SEDIMENTS	METHOD OF DISPOSAL OF FLOATABLES, SEDIMENTS, DECANT AND SORBENTS

OBSERVATIONS:

\_\_\_\_\_  
\_\_\_\_\_  
\_\_\_\_\_  
\_\_\_\_\_

**SCREEN MAINTENANCE:**

DATE OF POWER WASHING, INSPECTION AND OBSERVATIONS: \_\_\_\_\_

\_\_\_\_\_

**CERTIFICATION:**


**TITLE:** \_\_\_\_\_

**DATE:** \_\_\_\_\_



APPENDIX B  
SITE LOCATION PLANS  
  
(PROJECT SPECIFIC)

**CLEAN OUT VIEW**  
**CDS MODEL PMSU30\_30, 3.0 CFS CAPACITY**  
**CDS 3 Sta. 14+266.3 LT 17±**

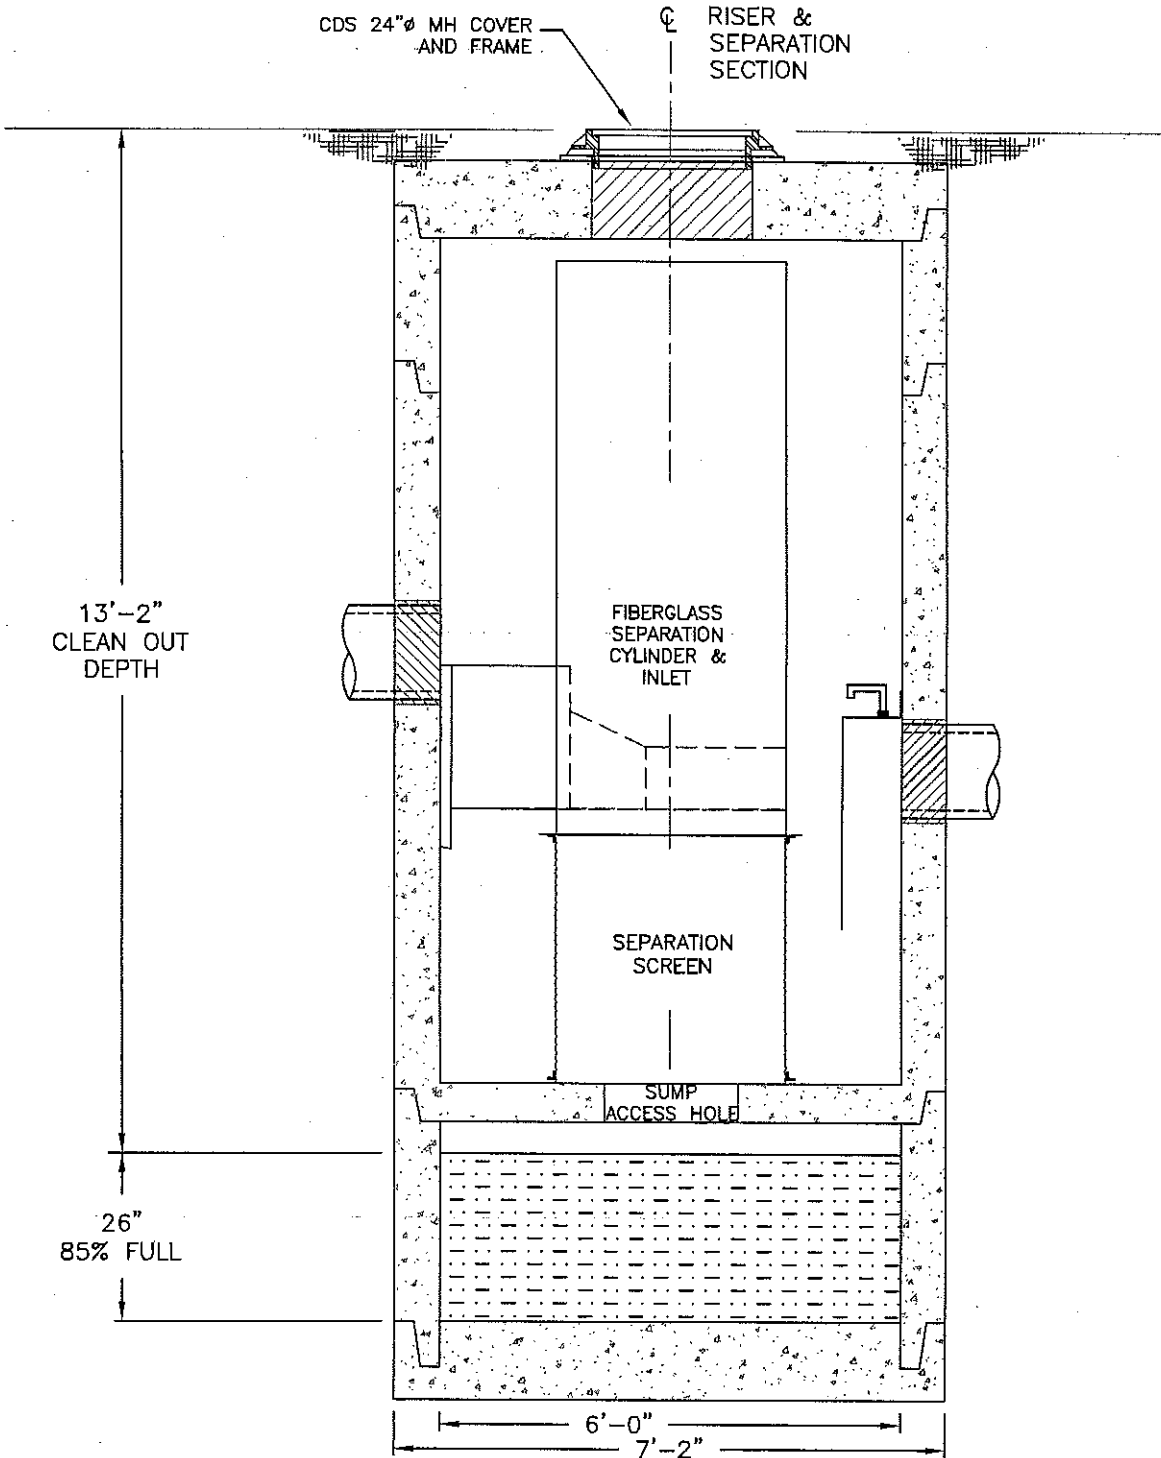

I-5 N Santiam Hwy  
 Kuebler Blvd  
 Salem Oregon

DATE	01/16/06	SCALE	1"=2.5'
DRAWN	D.J.	SHEET	<b>C3</b>
APPROV.	W. STEIN		

80


APPENDIX B  
SITE LOCATION PLANS  
(PROJECT SPECIFIC)



# SITE PLAN VIEW

## CDS MODEL PMSU30\_30, 3.0 CFS CAPACITY

### CDS 3 Sta. 14+266.3 LT 17±

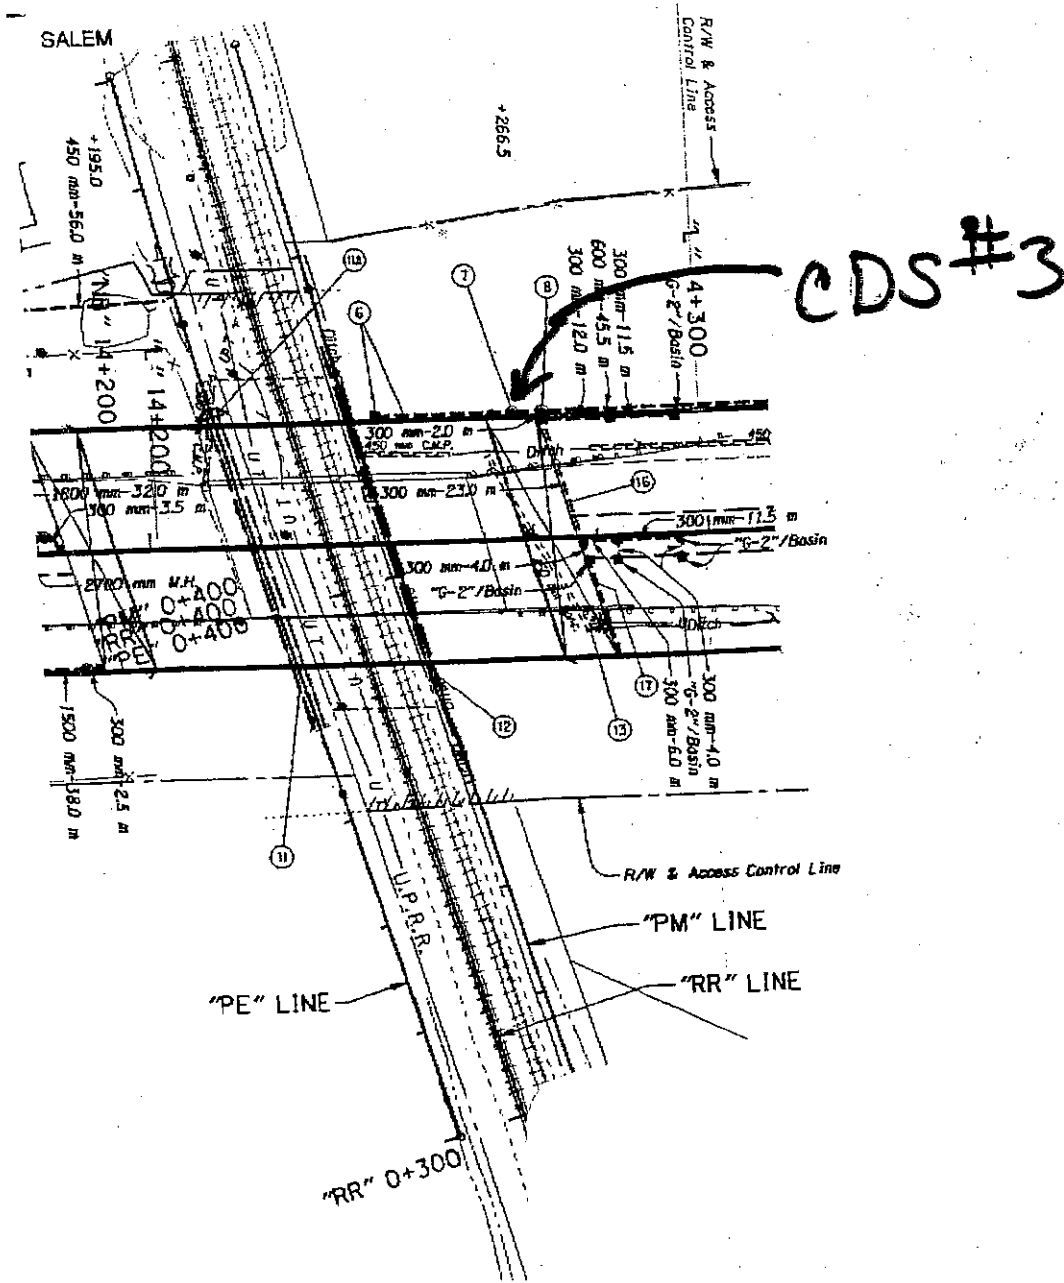

I-5 N Santiam Hwy  
Kuebler Blvd  
Salem Oregon

DATE	01/16/06	SCALE 1"=2.5'
DRAWN	D.J.	SHEET <b>S3</b>
APPROV.	W. STEIN	



SC

APPENDIX C  
PLAN & PROFILE DRAWINGS  
(PROJECT SPECIFIC)

# PLAN VIEW

## CDS MODEL PMSU30\_30, 3.0 CFS CAPACITY CDS 3 Sta. 14+266.3 LT 17±

**NOTE:** CDS UNIT COMES COMPLETE WITH FIBERGLASS INLET/DIVERSION STRUCTURE, OIL BAFFLE AND SCREEN CYLINDER PRE-INSTALLED.

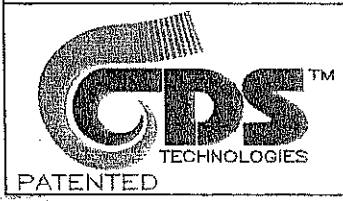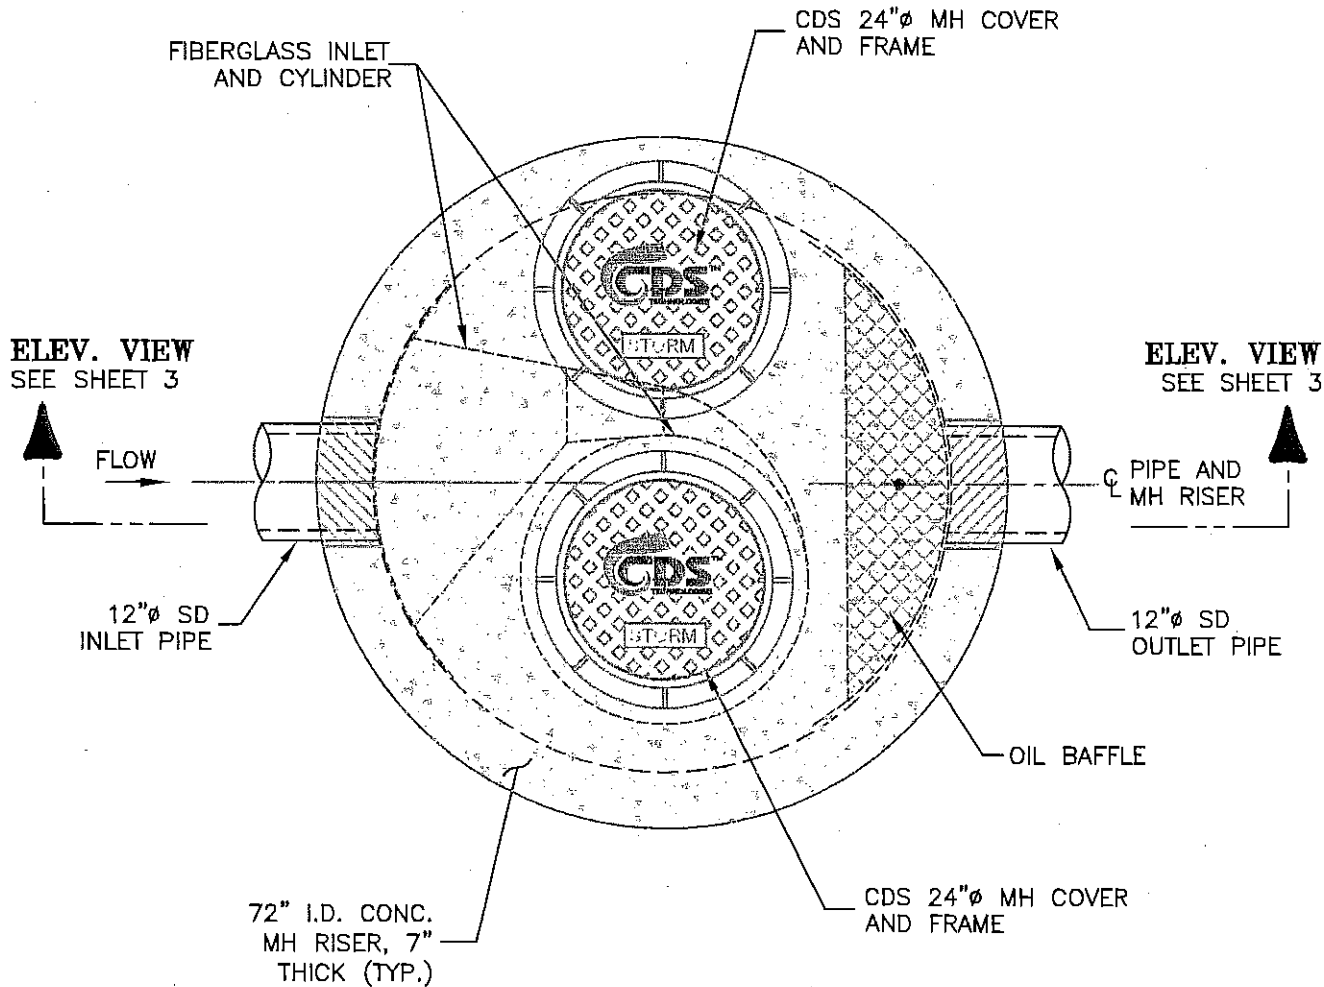

I-5 N Santiam Hwy  
Kuebler Blvd  
Salem Oregon



DATE	01/16/06	SCALE 1"=2'  SHEET <b>9</b>
DRAWN	D.J.	
APPROV.	W. STEIN	

SC

# SECTION CUT

## CDS MODEL PMSU30\_30, 3.0 CFS CAPACITY CDS 3 Sta. 14+266.3 LT 17±

**NOTE:** CDS UNIT COMES COMPLETE WITH FIBERGLASS INLET/DIVERSION STRUCTURE, OIL BAFFLE AND SCREEN CYLINDER PRE-INSTALLED.

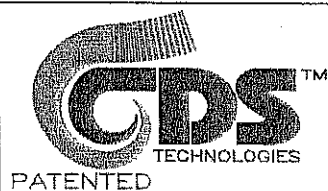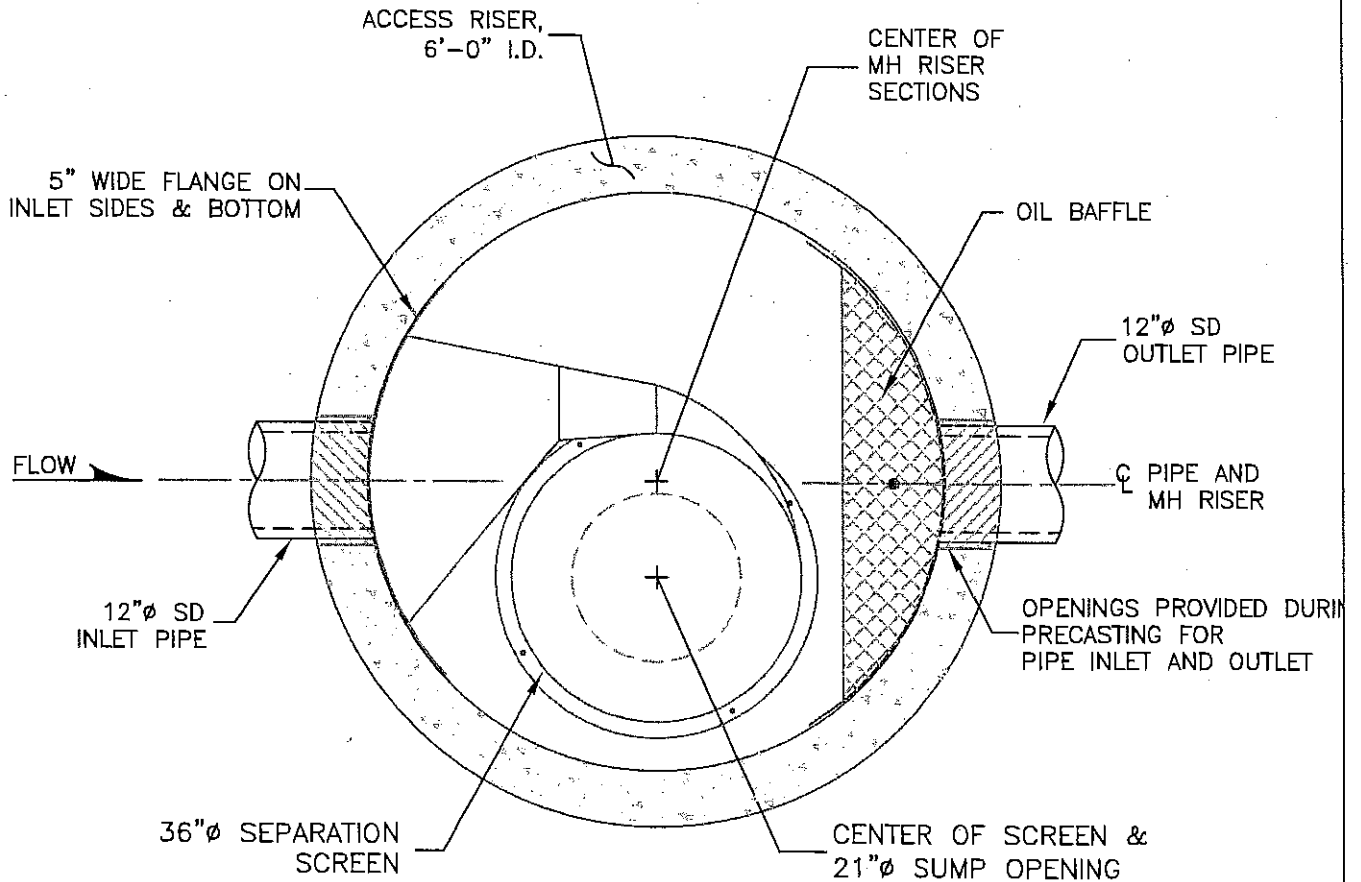

I-5 N Santiam Hwy  
Kuebler Blvd  
Salem Oregon

DATE	01/16/06
DRAWN	D.J.
APPROV.	W. STEIN

SCALE  
1"=2'


SHEET

10


# ELEVATION VIEW

## CDS MODEL PMSU30\_30, 3.0 CFS CAPACITY

### CDS 3 Sta. 14+266.3 LT 17±

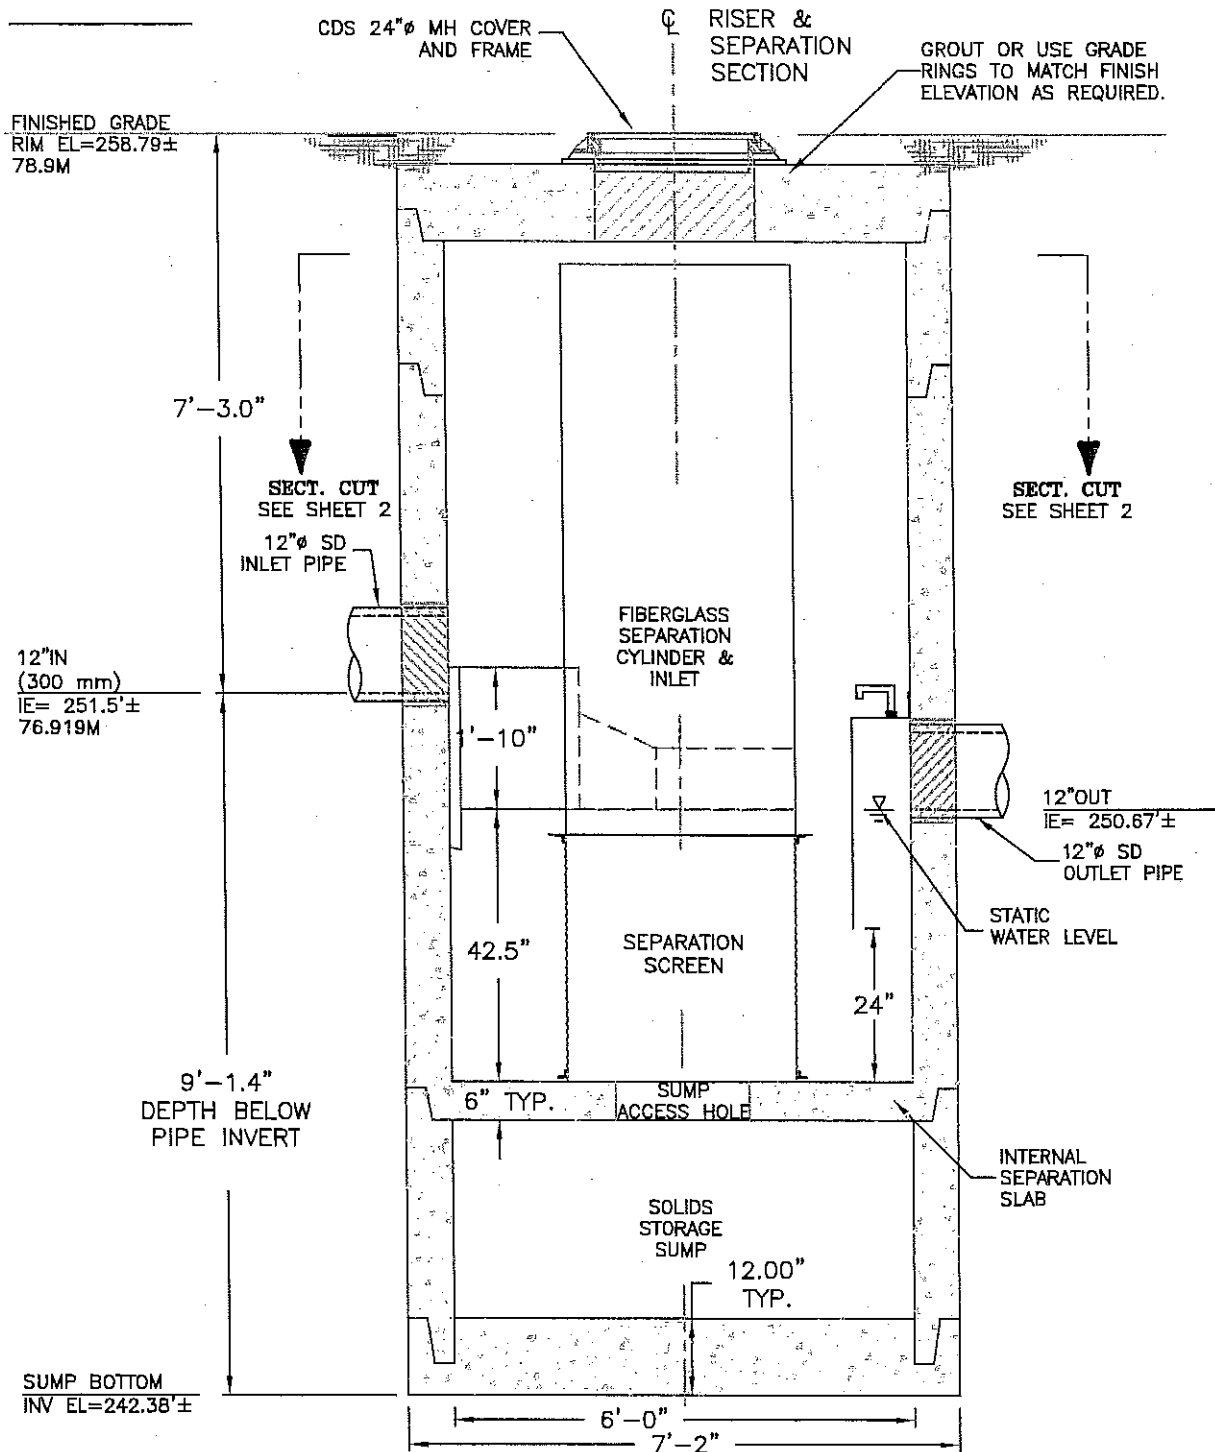

**NOTE:** CDS UNIT COMES COMPLETE WITH FIBERGLASS INLET/DIVERSION STRUCTURE, OIL BAFFLE AND SCREEN CYLINDER PRE-INSTALLED.

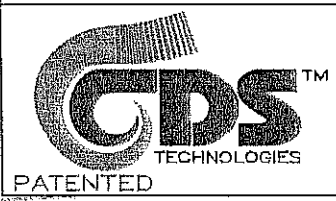


I-5 N Santiam Hwy  
Kuebler Blvd  
Salem Oregon

DATE	01/16/06
DRAWN	D.J.
APPROV.	W. STEIN

SCALE	1"=2.5'
SHEET	11

SC

**NOTE:** CDS UNIT COMES COMPLETE WITH FIBERGLASS INLET/DIVERSION STRUCTURE, OIL BAFFLE AND SCREEN CYLINDER PRE-INSTALLED.

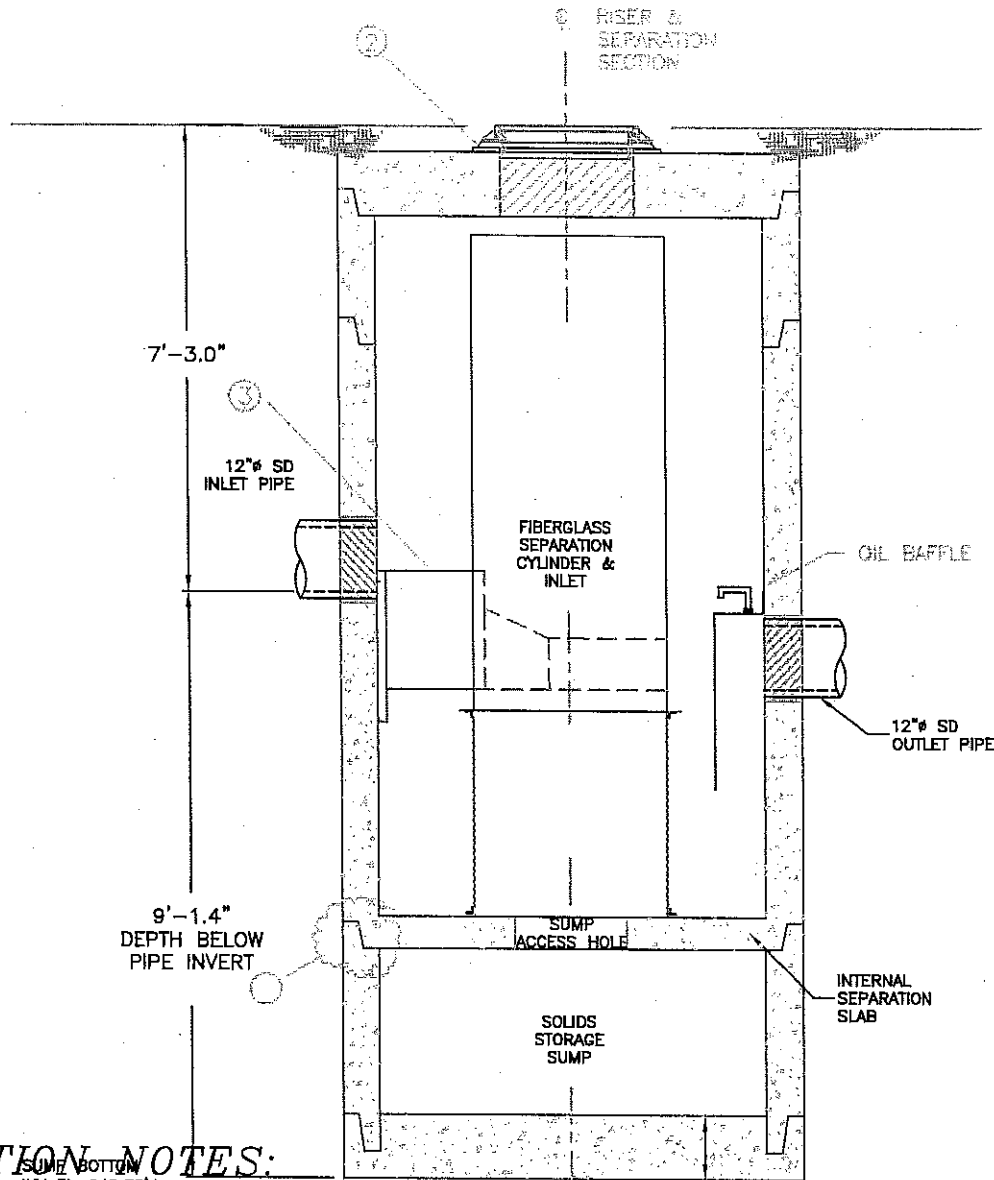


**CONSTRUCTION NOTES:**

1. APPLY RUBBER GASKET AND TWO LAYERS OF BUTYL MASTIC AS PROVIDED BY PRECASTOR ON TOP AND BOTTOM SHELF OF JOINT TO SEAL RISER JOINTS. APPLY LOAD TO MP SECTIONS TO COMPRESS BUTYL MASTIC SEALANT IF NECESSARY. UNIT MUST BE WATER TIGHT, HOLDING WATER UP TO 2' FLOWLINE INVERT (MINIMUM).
2. USE GRADE RINGS, BLOCKS AND/OR GROUT TO MATCH GRADE. SEAL AS REQUIRED.
3. GROUT PIPE CONNECTIONS TO SEAL JOINT.

**GENERAL NOTES:**

1. CDS UNIT COMES COMPLETE WITH FIBERGLASS INLET/DIVERSION STRUCTURE, OIL BAFFLE AND SCREEN CYLINDER PRE-INSTALLED.
2. INSTALL CDS UNIT PER CDS INSTALLATION SPECIFICATIONS.
3. INTERNAL COMPONENTS MAY BE INSTALLED IN THE FIELD TO FACILITATE IMMEDIATE DELIVERY AND INSTALLATION OF PRECAST STRUCTURE. CONTACT CDS FOR DETAILS AND COORDINATION OF THIS CONSTRUCTION OPTION.

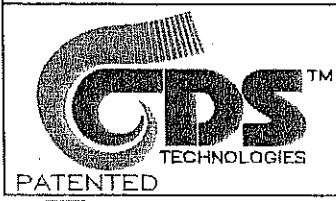

**GENERAL INSTALLATION  
NOTES & DETAILS  
PMSU30\_30**

DATE	11/22/01	SCALE N.T.S. SHEET <b>12</b>
DRAWN	W. STEIN	
APPROV.	W. STEIN	