

OPERATION & MAINTENANCE MANUAL

DFI No.: D00037

Facility Type: Detention Tank/Pipe



MARCH, 2011

INDEX

1. IDENTIFICATION 1

2. FACILITY CONTACT INFORMATION..... 1

3. CONSTRUCTION..... 1

4. STORM DRAIN SYSTEM AND FACILITY OVERVIEW 2

5. FACILITY HAZ MAT SPILL FEATURE(S)..... 5

6. AUXILIARY OUTLET 5

7. MAINTENANCE REQUIREMENTS 5

8. WASTE MATERIAL HANDLING 6

APPENDIX A: Operational Plan and Profile Drawing(s)

APPENDIX B: ODOT Project Plan Sheets

1. Identification

Drainage Facility ID (DFI): **D00037**
Facility Type: Detention Tank/Pipe
Construction Drawings: (V-File Number) 38V-117
Location: District: 3
Highway No.: 001
Mile Post: 252.16 / 252.19 (beg./end)
Description: This facility is located along the right shoulder of the southbound travel lanes of I-5 (Hwy 001) between two bridge structures overcrossing Turner Road (Bridge No. 20032) and the U.P.R.R. (No. 20026) rail line. Access can be obtained from the southbound travel lane.

2. Facility Contact Information

Contact the Engineer of Record, Region Technical Center, or Geo-Environmental's Senior Hydraulics Engineer for:

- Operational clarification
- Maintenance clarification
- Repair or restoration assistance

Engineering Contacts:

Region Technical Center Hydro Unit Manager

Or

Geo-Environmental Senior Hydraulics Engineer (503) 986-3365.

3. Construction

Engineer of Record: ODOT Designer – Region 2 Tech. Center
Chris Carman, 503-986-2691
Facility construction: 2005
Contractor: Hamilton Construction Company

4. Storm Drain System and Facility Overview

A detention facility is designed to control the quantity of runoff, by reducing the peak discharge and only detaining runoff for some short period of time. These facilities are designed to store and gradually release or attenuate stormwater runoff via a control structure or release mechanism, and completely drain after the design storm has passed. The most common detention facilities include:

- Dry ponds - these are depressed storage areas that store runoff during wet weather and are dry the rest of the time. Usually they are earthen depressions.
- Tanks - these are underground storage facilities that are typically constructed from large diameter pipe.
- Vaults - these are enclosed underground storage facilities. They are typically constructed from reinforced concrete.

The detention pipe facility is located within the right shoulder of the southbound travel lanes of I-5 (Hwy 001), between two bridge structures overcrossing Turner Road (Bridge No. 20032) and the U.P.R.R (Bridge No. 20026) rail line. The facility can be accessed from the southbound travel lanes. The detention pipe facility is composed of one 60-inch diameter pipe segment (Point B of the Operational Plan in Appendix A) totaling 125 feet long. Refer to Photo 1 for a surface view of the detention facility. Each end of the facility is a manhole structure with the flow control manhole located on the north end (See Point C of the Operational Plan in Appendix A).

The roadway within this area slopes downward towards the north. The drainage basin for the detention facility includes the area from the southern end panel of the U.P.R.R. overcrossing to the southern end panel of the Turner Road overcrossing. Stormwater enters the detention facility from both the north and south through a total of two inlets. The north inlet ties into the flow control manhole (Point C) of the detention facility through a 12-inch storm pipe. The south inlet lies next to the south manhole (Point A) of the detention facility.

The northern-most structure, a flow control manhole (Point C) releases flow to an 80-foot long 12-inch diameter pipe. This storm pipe connects into a second flow control manhole associated with another detention pipe facility (DFI No. D00036) located within the median of I-5 (Hwy 001). The detained stormwater from both detention facilities is treated through a water quality structure (DFI No. D00033) located another 60 feet east within the right shoulder of the northbound travel lanes. The flow continues an additional 77 feet east via a 15-inch pipe that discharges into a ditch that ultimately drains into Pringle Creek.

For further information and details regarding the system refer to Appendix A for the Operational Plan and Appendix B for As-Built Drawings.



Photo 1: Detention pipe facility looking south. Detention pipe is located between the flow control manhole and the south manhole.



Photo 2: This photo is looking at the south manhole located on south end of detention facility.



Photo 3: This photo is looking in the interior of the flow control manhole.

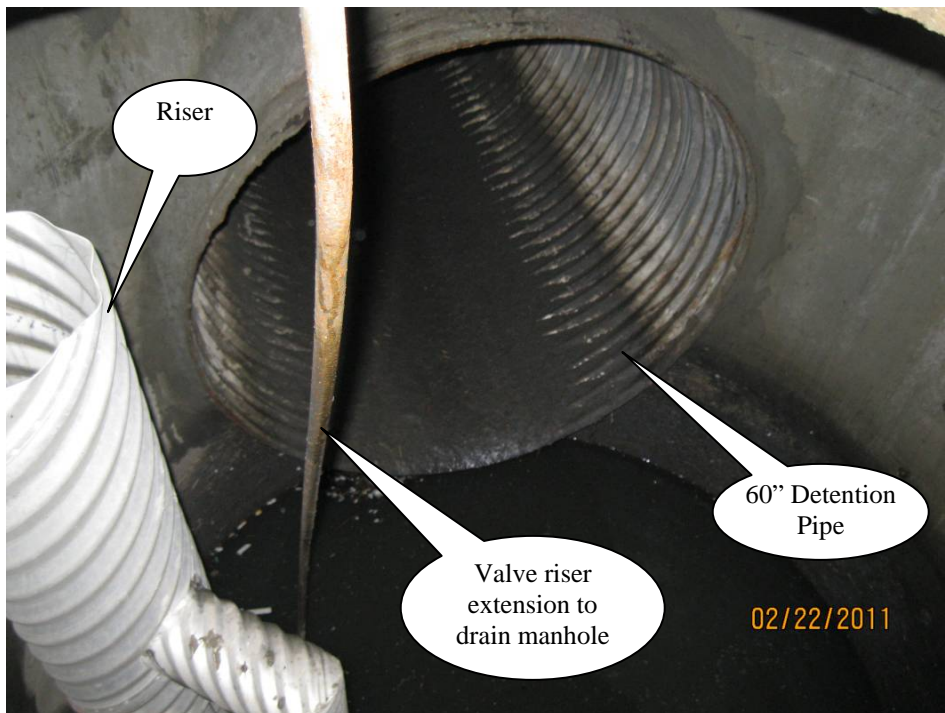


Photo 4: This photo is looking at the interior of the flow control facility with a view of the 60-inch diameter detention pipe.

A. Maintenance equipment access:

This facility is located along a 12 foot shoulder of the southbound lanes of I-5 (Hwy 001). Sufficient room to utilize the shoulder area should

allow adequate access to the system when performing maintenance activities such as using a vactor truck to clean the manholes.

B. Heavy equipment access into facility:

- Allowed (no limitations)
- Allowed (with limitations)
- Not allowed

C. Special Features:

- Amended Soils
- Porous Pavers
- Liners
- Underdrains

5. Facility Haz Mat Spill Feature(s)

This detention facility can be used to store hazardous liquids entering the system until the liquid level reaches the two orifices in the flow control manhole. If additional storage is required, detention of this system may be achieved from the immediate downstream manhole associated with D00036. The inlet pipe to this structure can be plugged.

6. Auxiliary Outlet

Auxiliary Outlets are provided if the primary outlet control structure can not safely pass the projected high flows. Broad-crested spillway weirs and over flow risers are the two most common auxiliary outlets used in stormwater treatment facility design. The auxiliary outlet feature is either a part of the facility or an additional storm drain feature/structure.

The auxiliary outlet feature for this facility is:

- Designed into facility
This particular detention piping system includes a flow control structure with a high flow riser.
- Other, as noted below

7. Maintenance Requirements

Routine maintenance table for non-proprietary stormwater treatment and storage/detention facilities have been incorporated into ODOT's Maintenance Guide. These tables summarize the maintenance

requirements for ponds, swales, filter strips, bioslopes, and detention tanks and vaults. Special maintenance requirements in addition to the routine requirements are noted below when applicable.

The ODOT Maintenance Guide can be viewed at the following website:

<http://www.oregon.gov/ODOT/HWY/OOM/MGuide.shtml>

Maintenance requirements for proprietary structures, such as underground water quality manholes and/or vaults with filter media are noted in Appendix C when applicable.

The following stormwater facility maintenance table (See ODOT Maintenance Guide) should be used to maintain the facility outlined in this Operation and Maintenance Manual or follow the Maintenance requirements outlined in Appendix C when proprietary structure is selected below:

- Table 1 (general maintenance)
- Table 2 (stormwater ponds)
- Table 3 (water quality biofiltration swales)
- Table 4 (water quality filter strips)
- Table 5 (water quality bioslopes)
- Table 6 (detention tank)
- Table 7 (detention vault)
- Appendix C (proprietary structure)
- Special Maintenance requirements:

Note: Special maintenance Requirements Require Concurrence from ODOT SR Hydraulics Engineer.

8. Waste Material Handling

Material removed from the facility is defined as waste by DEQ. Refer to the roadwaste section of the ODOT Maintenance Yard Environmental Management System (EMS) Policy and Procedures Manual for disposal options: <http://egov.oregon.gov/ODOT/HWY/OOM/EMS.shtml>


Contact any of the following for more detailed information about management of waste materials found on site:

ODOT Clean Water Unit	(503) 986-3008
ODOT Statewide Hazmat Coordinator	(503) 229-5129
ODOT Region Hazmat Coordinator	(503) 986-2647
ODEQ Northwest Region Office	(503) 229-5263

Appendix A


Content:

- **Operational Plan and Profile Drawing(s)**

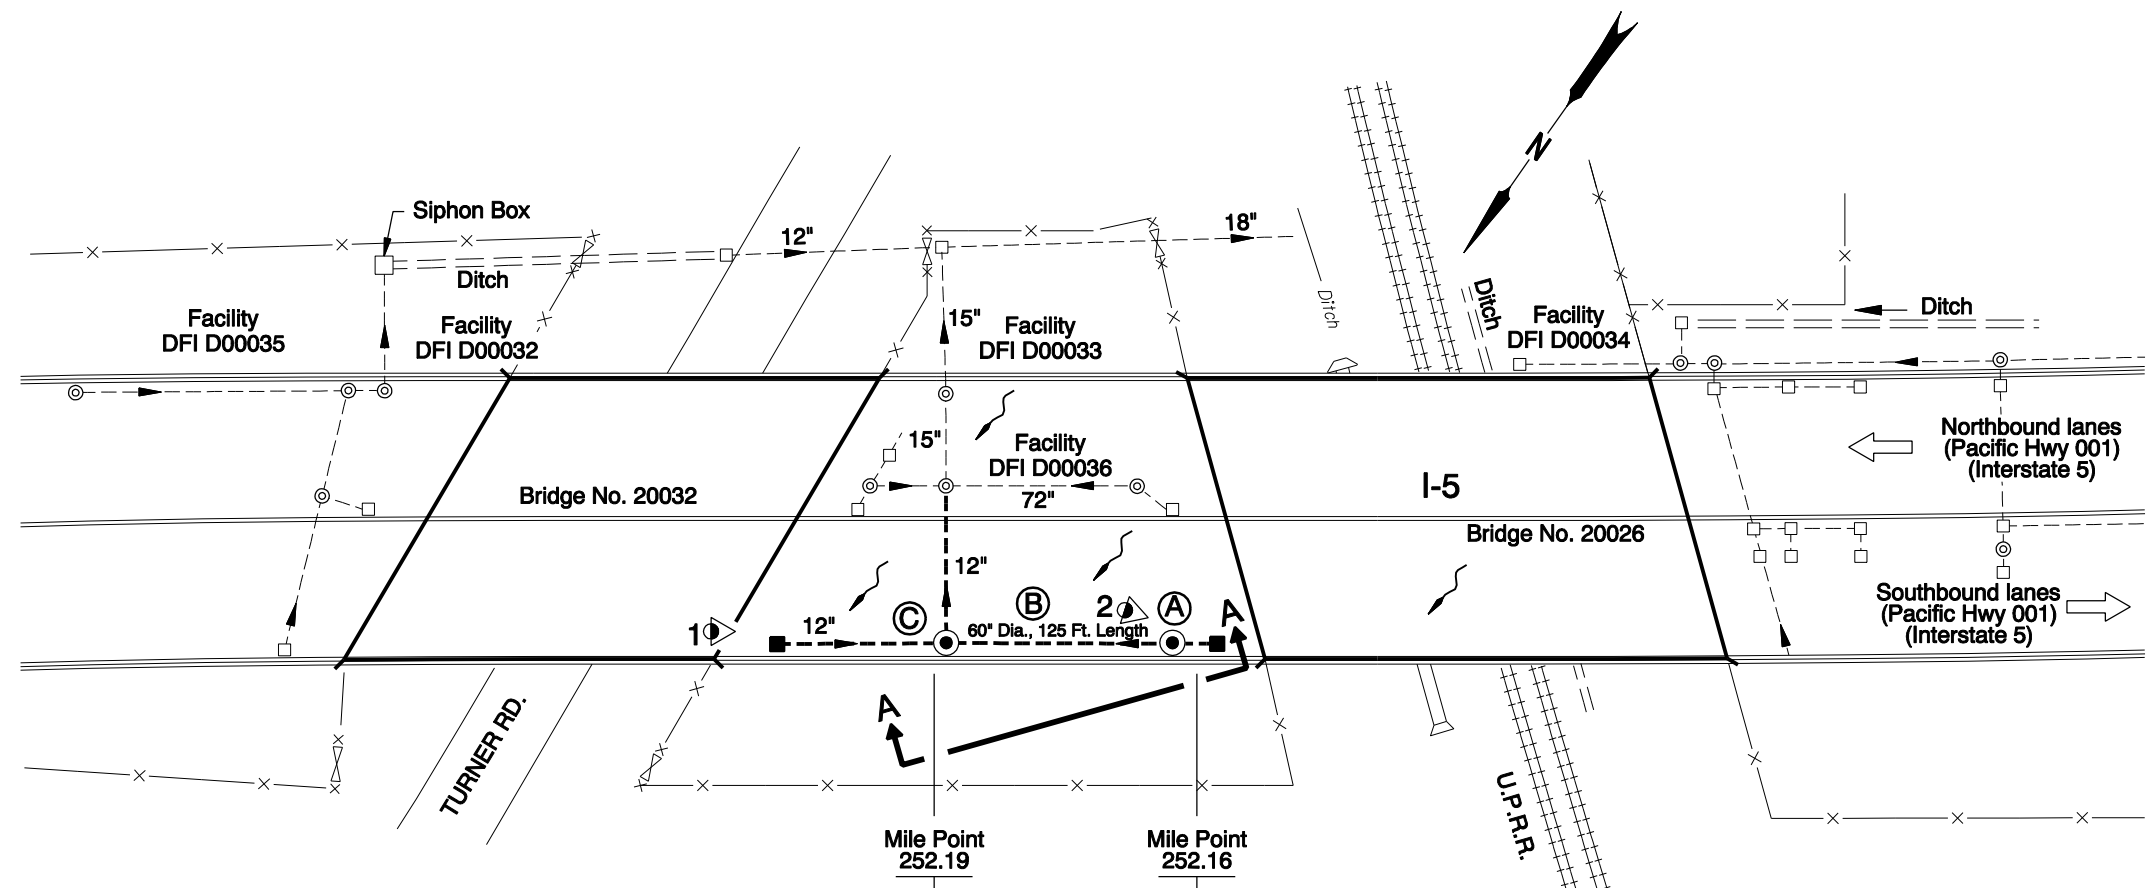


PLAN
N.T.S.

Detention Tank/Pipe
(DFI D00037)

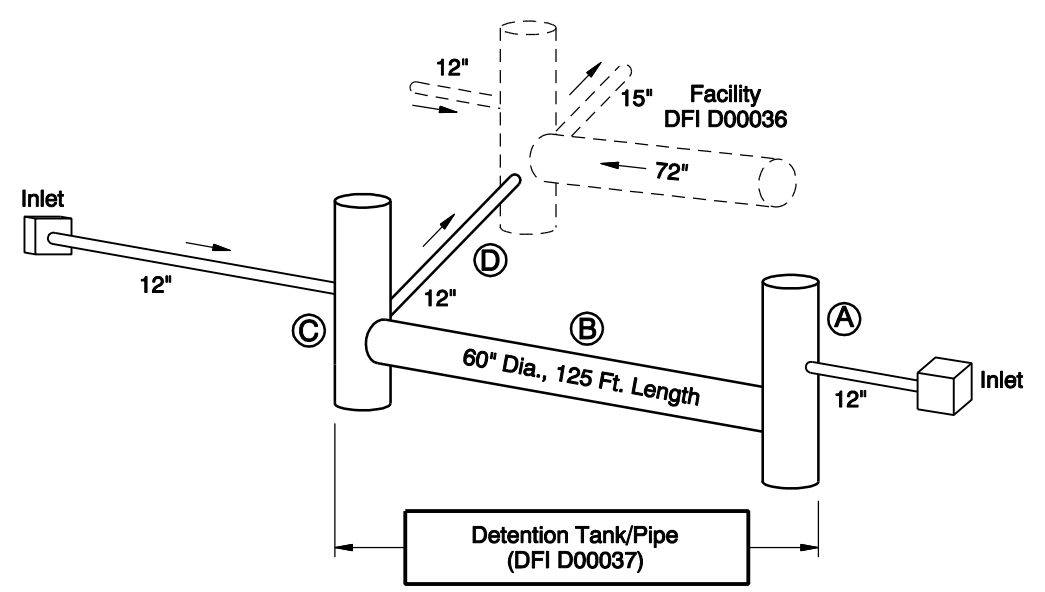

SCHMATIC OF PIPE DRAINAGE SYSTEM
N.T.S.

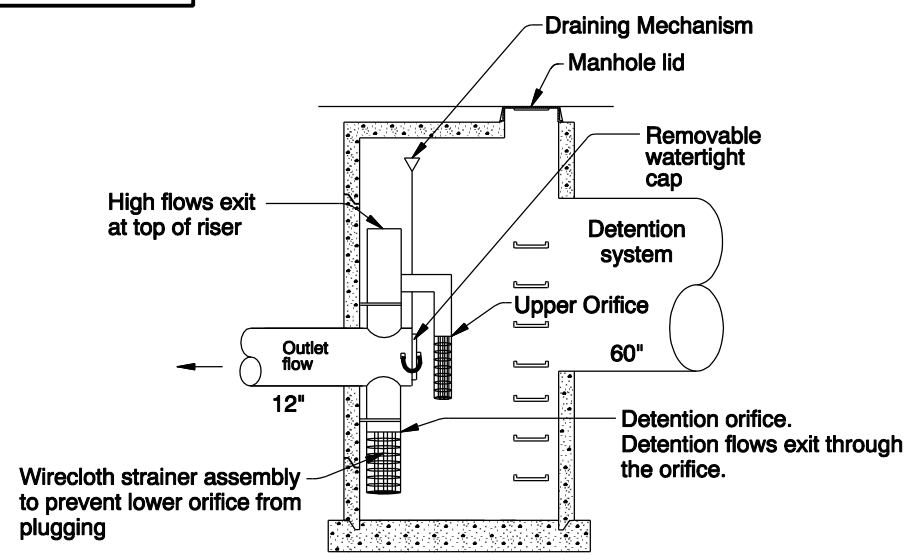

**Flow Control Structure for
Underground Detention System (DFI D00037)**

- LEGEND:**
- Photo Location / Direction
 - South Manhole - 7' Dia.
 - Detention Pipe - 60" Dia.
 - Flow Control Structure - 7' Dia.
 - Manhole
 - Inlet
 - Storm Pipe (Facility)
 - Storm Pipe
 - Conveyance Direction
 - Pavement / Facility Flow Path

Sht. 1 of 1

OREGON DEPARTMENT OF TRANSPORTATION

Prepared By: Bob Knorr
Drafted By: Jim Holeman

DFI D00037
MAINTENANCE DISTRICT 3 HWY 1
DETENTION PIPE
PACIFIC HIGHWAY MP 252.16-252.19
MARION COUNTY

Appendix B

Content:

- **ODOT Project Plan Sheets**
 - *Cover/Title Sheet*
 - *Water Quality/Detention Plan Sheets*
 - *Other Details*

INDEX OF SHEETS	
SHEET NO.	DESCRIPTION
1	Title Sheet
1A	Index Of Sheets Cont'd.
1A-2	Index Of Sheets Cont'd.
1A-3	Index Of Sheets Cont'd.
1A-4	Standard Drawing Nos.
1B	Layout Sheet

STATE OF OREGON
DEPARTMENT OF TRANSPORTATION

PLANS FOR PROPOSED PROJECT


GRADING, DRAINAGE, STRUCTURES, PAVING, SIGNING,
ILLUMINATION, SIGNALS & ROADSIDE DEVELOPMENT

**I-5: N. SANTIAM HWY. -
KUEBLER BLVD. (SALEM) SEC.**

PACIFIC HIGHWAY

MARION COUNTY


OCTOBER 2005

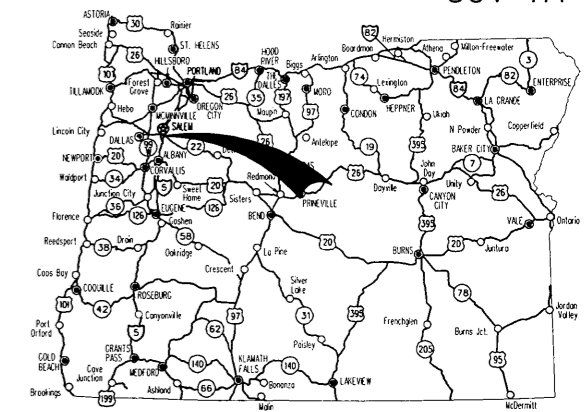

Overall Length Of Project - 4.02 km (2.49 Miles)

ATTENTION:
Oregon Law Requires You To Follow Rules Adopted By The Oregon Utility Notification Center. Those Rules Are Set Forth In OAR 952-001-0010 Through OAR 952-001-0090. You May Obtain Copies Of The Rules By Calling The Center. (Note: The Telephone Number For The Oregon Utility Center Is (503) 232-1987.)

OTIA-NH-IM-S001(196)
BEGINNING OF PROJECT
STA. "L" 10+280 (M.P. 254.58)

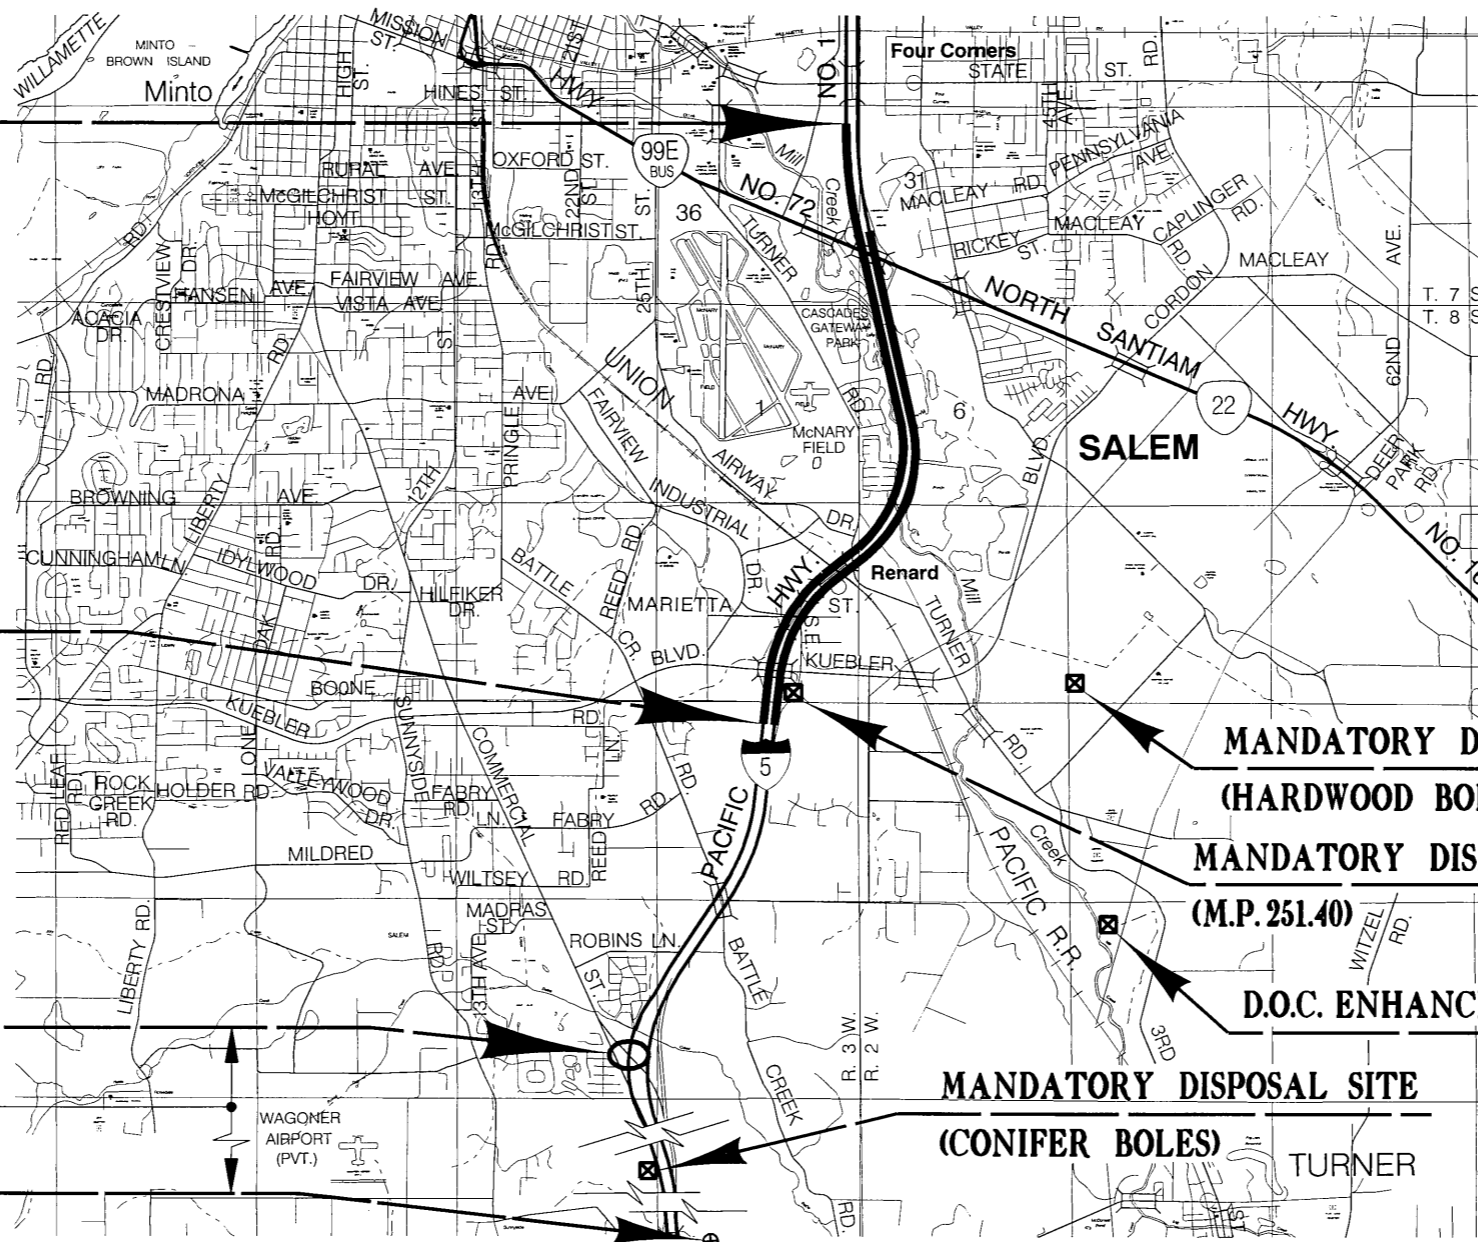

END OF WORK AREA
STA. "L" 15+682.3 (M.P. 251.22)

OTIA-NH-IM-S001(196)
END OF PROJECT
STA. "LS" 18+664.61 (M.P. 249.38)

PROSPECTIVE MATERIAL SOURCE
(M.P. 221.13)



LET'S ALL WORK TOGETHER TO MAKE THIS JOB SAFE



T. 7, 8 S.,
R. 2, 3 W., W.M.

OREGON TRANSPORTATION COMMISSION

Stuart Foster	CHAIRMAN
Gail L. Achterman	COMMISSIONER
Mike Nelson	COMMISSIONER
Randall Papé	COMMISSIONER
Janice J. Wilson	COMMISSIONER
Bruce A. Warner	DIRECTOR OF TRANSPORTATION

REGISTERED PROFESSIONAL ENGINEER
13,704
JULY 16, 1987
CATHERINE M. NELSON
Expires Dec. 31, 2006


Catherine M. Nelson
TECHNICAL SERVICES MANAGING ENGINEER

**I-5: N. SANTIAM HWY. -
KUEBLER BLVD. (SALEM) SEC.
PACIFIC HIGHWAY
MARION COUNTY**

FEDERAL HIGHWAY ADMINISTRATION	PROJECT NUMBER	SHEET NO.
OREGON DIVISION	OTIA-NH-IM-S001(196)	1



PE000950

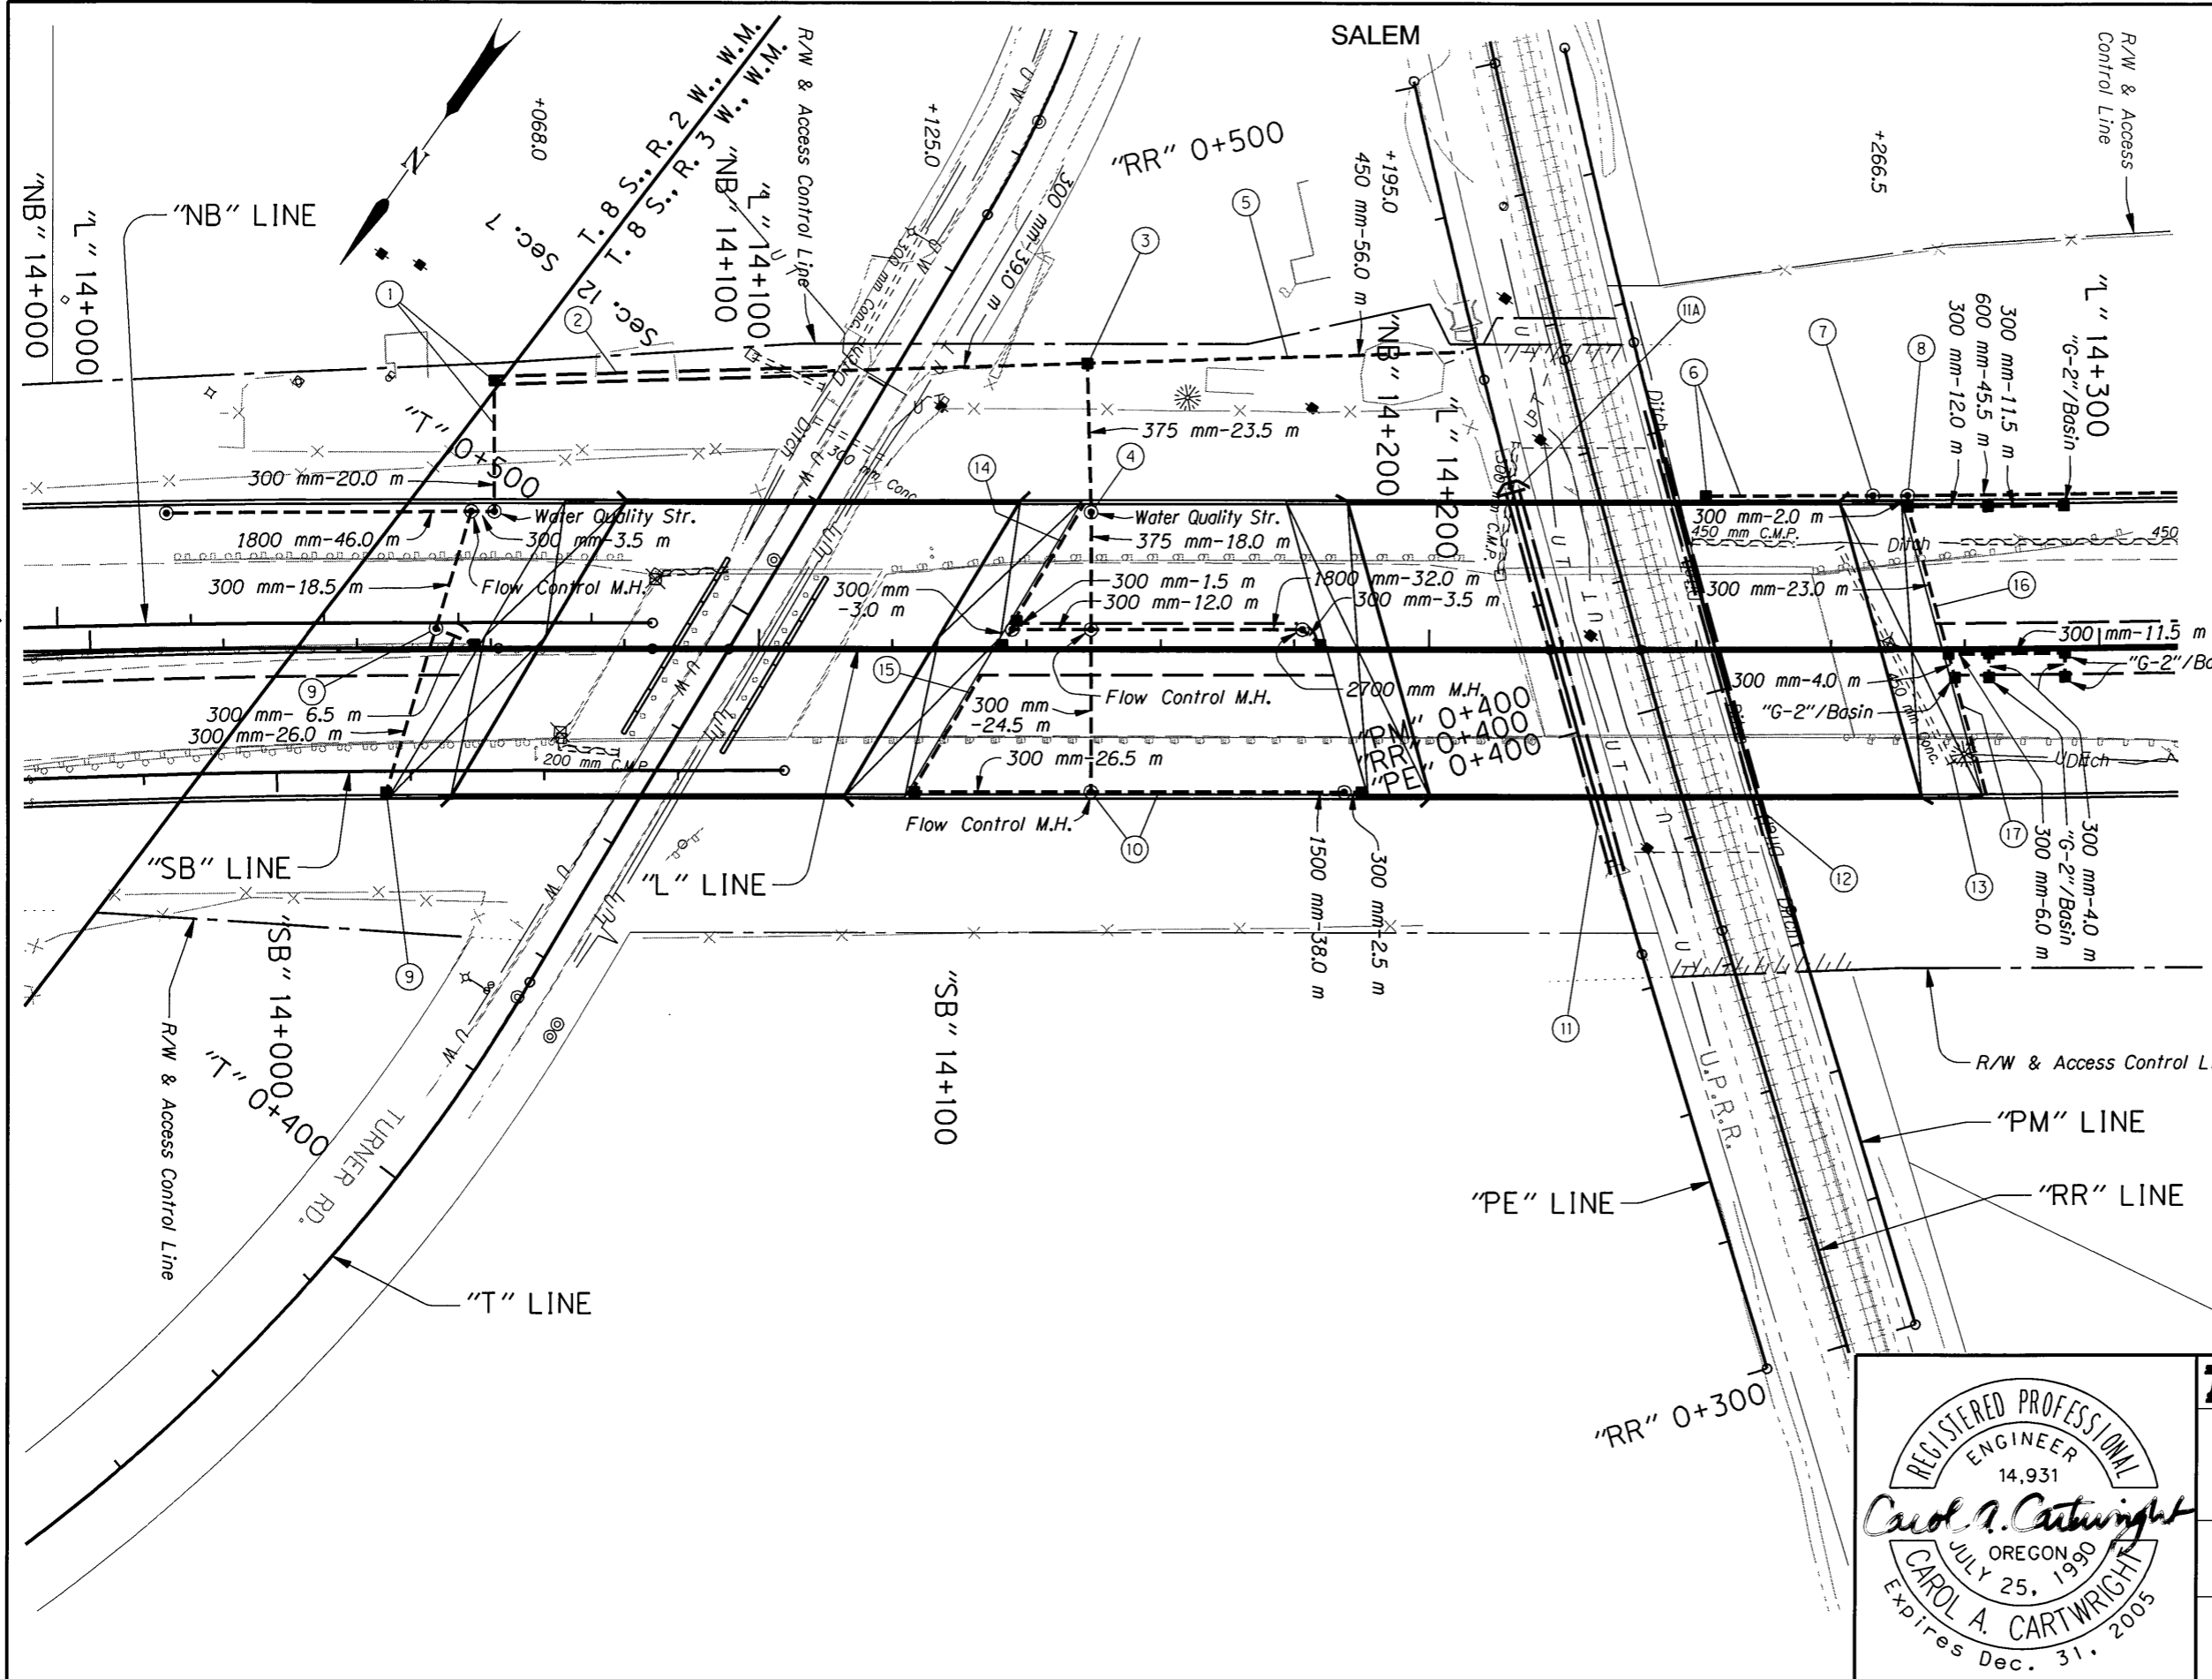

STRUCTURAL DETAILS CHECKED

Plug And Abandon Extg. Pipe Shown Thus:

All Dimensions Are Shown In Meters (m)
Unless Otherwise Noted.




OREGON DEPARTMENT OF TRANSPORTATION ROADWAY ENGINEERING SECTION	
1-5: N. SANTIAM HWY. - KUEBLER BLVD. (SALEM) SEC. PACIFIC HIGHWAY MARION COUNTY	
Design Team Leader - Carol Cartwright Designed By - John Lucas Drafted By - Jeff Larson	
DRAINAGE & UTILITIES	
SHEET NO. 16C	

STRUCTURAL DETAILS CHECKED *MA*



- ① Sta. "L"14+051.1 To Sta. "NB"14+065.4
Const. Manhole 2700 mm Dia.
Const. Water Quality Structure
Const. Flow Control Manhole 2400 mm Dia.
Const. Siphon Box
Inst. 300 mm Sew. Pipe - 18.5 m
3.0 m Depth
Inst. 300 mm Sew. Pipe - 23.5 m
6.0 m Depth
Inst. 1800 mm Sew. Pipe - 46.0 m
6.0 m Depth
(For Details, See Sht. GJ-4)
(See Drg. No. RD376)
- ② Const. Ditch
"V" Bottom, 1:3 Slopes
Dt. Exc. - 48 m³
- ③ Sta. "L"14+110.1 To Sta. "L"14+148.9
Const. Type "G-2MA" Inlet
Shape Bottom
Inst. 300 mm Sew. Pipe - 39.0 m
1.5 m Depth
Inst. 375 mm Sew. Pipe - 23.5 m
6.0 m Depth
Inst. Slope Anchors
(See Drg. Nos. RD330 & RD364)
- ④ Sta. "L"14+136.4 To Sta. "L"14+183.9
Const. Water Quality Structure
Const. Flow Control Manhole 2700 mm Dia.
Const. Large Manhole 2700 mm Dia.
Const. Manhole
Const. Type "G-2" Open Grade HMAC Inlet
With Basin - 2
0.45 m Deep
Const. Type "G-2" Open Grade HMAC Inlet
Shape Bottom
Adjust Inlet For Wearing Course - 2
Inst. 300 mm Sew. Pipe - 20.0 m
1.5 m Depth
Inst. 300 mm Sew. Pipe - 24.5 m
3.0 m Depth
Inst. 375 mm Sew. Pipe - 18.0 m
6.0 m Depth
Inst. 1800 mm Sew. Pipe - 32.0 m
6.0 m Depth
(For Details, See Sht. GJ-4)
- ⑤ Sta. "L"14+148.9 To Sta. "L"14+205.0
Inst. 450 mm Sew. Pipe - 56.0 m
1.5 m Depth

- ⑥ Sta. "L"14+241.4 To Sta. "L"14+266.3
Const. Type "D MOD" Inlet
Inst. 300 mm Sew. Pipe - 26.5 m
1.5 m Depth
Inst. Slope Anchors
(For Details, See Sht. GJ-9)
(See Drg. No. RD370)
- ⑦ Sta. "L"14+266.3 To Sta. "L"14+271.5
Const. Water Quality Structure
Inst. 600 mm Sew. Pipe - 5.5 m
1.5 m Depth
- ⑧ Sta. "L"14+271.5 To Sta. "L"14+317.4
Const. Manhole
Const. Type "G-2" Open Grade HMAC Inlet
With Basin - 5
0.45 m Deep
Const. Type "G-2" Open Grade HMAC Inlet - 4
Shape Bottom
Adjust Inlet For Wearing Course - 6
Inst. 300 mm Sew. Pipe - 78.0 m
1.5 m Depth
Inst. 600 mm Sew. Pipe - 45.5 m
1.5 m Depth
- ⑨ Sta. "SB"14+016.3 To Sta. "L"14+051.1
Const. Manhole
Const. Type "G-2" Open Grade HMAC Inlet
With Basin - 2
0.45 m Deep
Adjust Inlet For Wearing Course - 2
Inst. 300 mm Sew. Pipe - 6.5 m
1.5 m Depth
Inst. 300 mm Sew. Pipe - 26.0 m
3.0 m Depth
- ⑩ Sta. "L"14+123.4 To Sta. "L"14+190.1
Const. Large Manhole 2100 mm Dia.
Const. Flow Control Manhole 2100 mm Dia.
Const. Type "G-2" Open Grade HMAC Inlet
With Basin - 2
0.45 m Deep
Adjust Inlet For Wearing Course - 2
Inst. 300 mm Sew. Pipe - 2.5 m
1.5 m Depth
Inst. 300 mm Sew. Pipe - 26.5 m
3.0 m Depth
Inst. 1500 mm Sew. Pipe - 38.0 m
6.0 m Depth
(For Details, See Sht. GJ-4)


- ⑪ Remove Extg. 2.1 m x 1.2 m R.C.B.C.
Const. Channel Change
⑪A Const. Outlet
(For Details, See Shts. GE-1, GE-2, GE-3 & GF-1)
- ⑫ Const. Channel Change
(For Details, See Sht. GF-2)
- ⑬ Remove Pipe
- ⑭ Sta. "L"14+135.6
Const. Open Grade Wearing Surface Drain
Outlet To Inlet
- ⑮ Sta. "L"14+135.6
Const. Open Grade Wearing Surface Drain
Outlet To Inlet
- ⑯ Sta. "L"14+272.0
Const. Open Grade Wearing Surface Drain
Outlet To Inlet
- ⑰ Sta. "L"14+278.5
Const. Open Grade Wearing Surface Drain
Outlet To Inlet

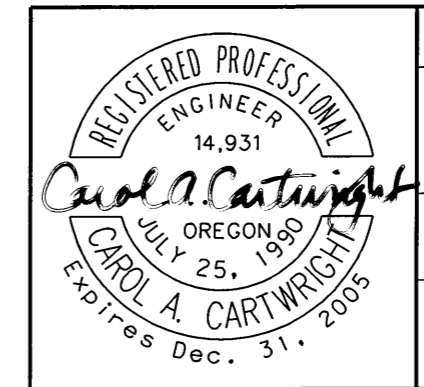

OREGON DEPARTMENT OF TRANSPORTATION ROADWAY ENGINEERING SECTION	
1-5: N. SANTIAM HWY. - KUEBLER BLVD. (SALEM) SEC. PACIFIC HIGHWAY MARION COUNTY	
Design Team Leader - Carol Cartwright Designed By - John Lucas Drafted By - Jeff Larson	
NOTES	SHEET NO. 16D

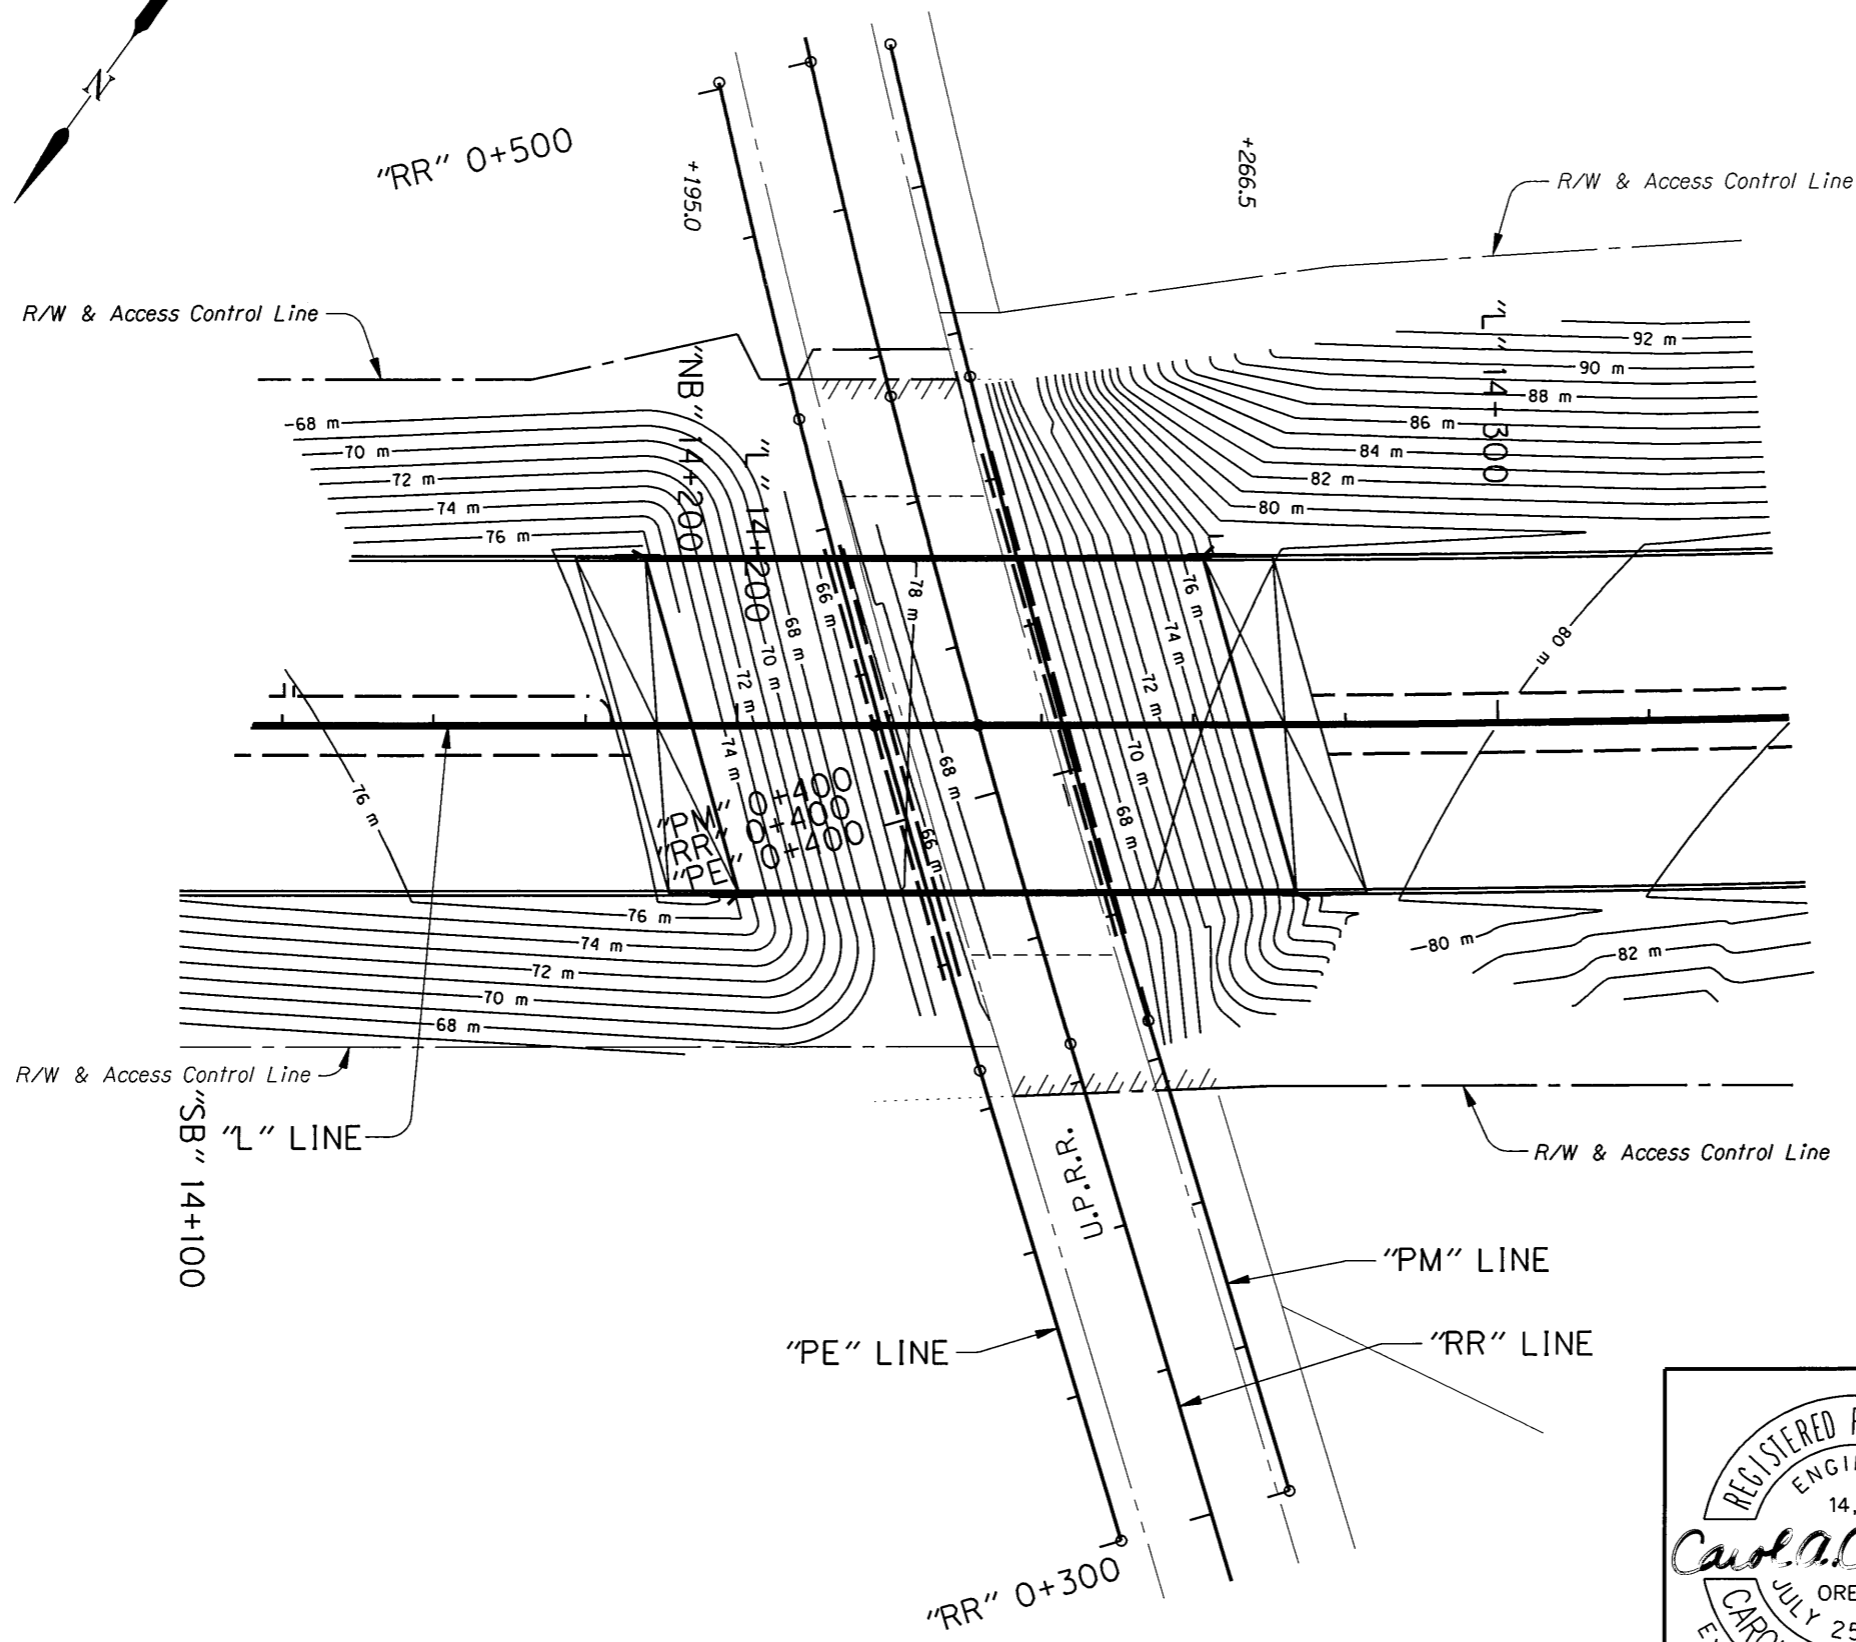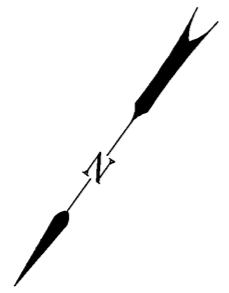

All Dimensions Are Shown In Meters (m)
Unless Otherwise Noted.

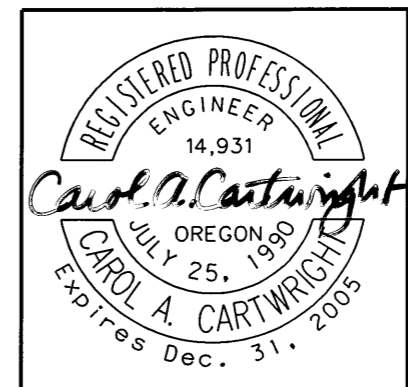

OREGON DEPARTMENT OF TRANSPORTATION ROADWAY ENGINEERING SECTION	
1-5: N. SANTIAM HWY. - KUEBLER BLVD. (SALEM) SEC. PACIFIC HIGHWAY MARION COUNTY	
Design Team Leader - Carol Cartwright Designed By - John Lucas Drafted By - Jeff Larson	
CONTOUR GRADING PLAN	SHEET NO. 16E




"L" LINE
RIGHT
(Southbound)

84
83
82
71
69
68
67

83
82
81
80
79
78
77
76
75
74
73
72
71
71
69
68
67

STRUCTURAL DETAILS CHECKED

"L" 14+103.886 P.O.T.
"SB" 14+075.837 P.T.
"NB" 14+108.771 P.O.T.

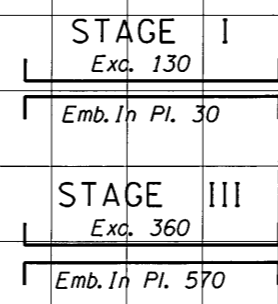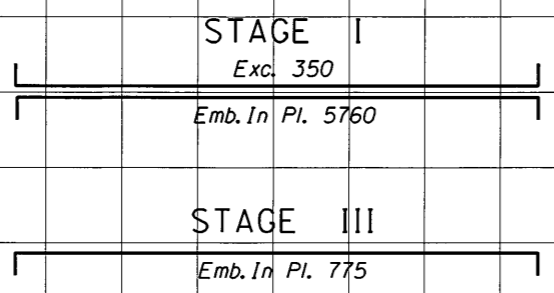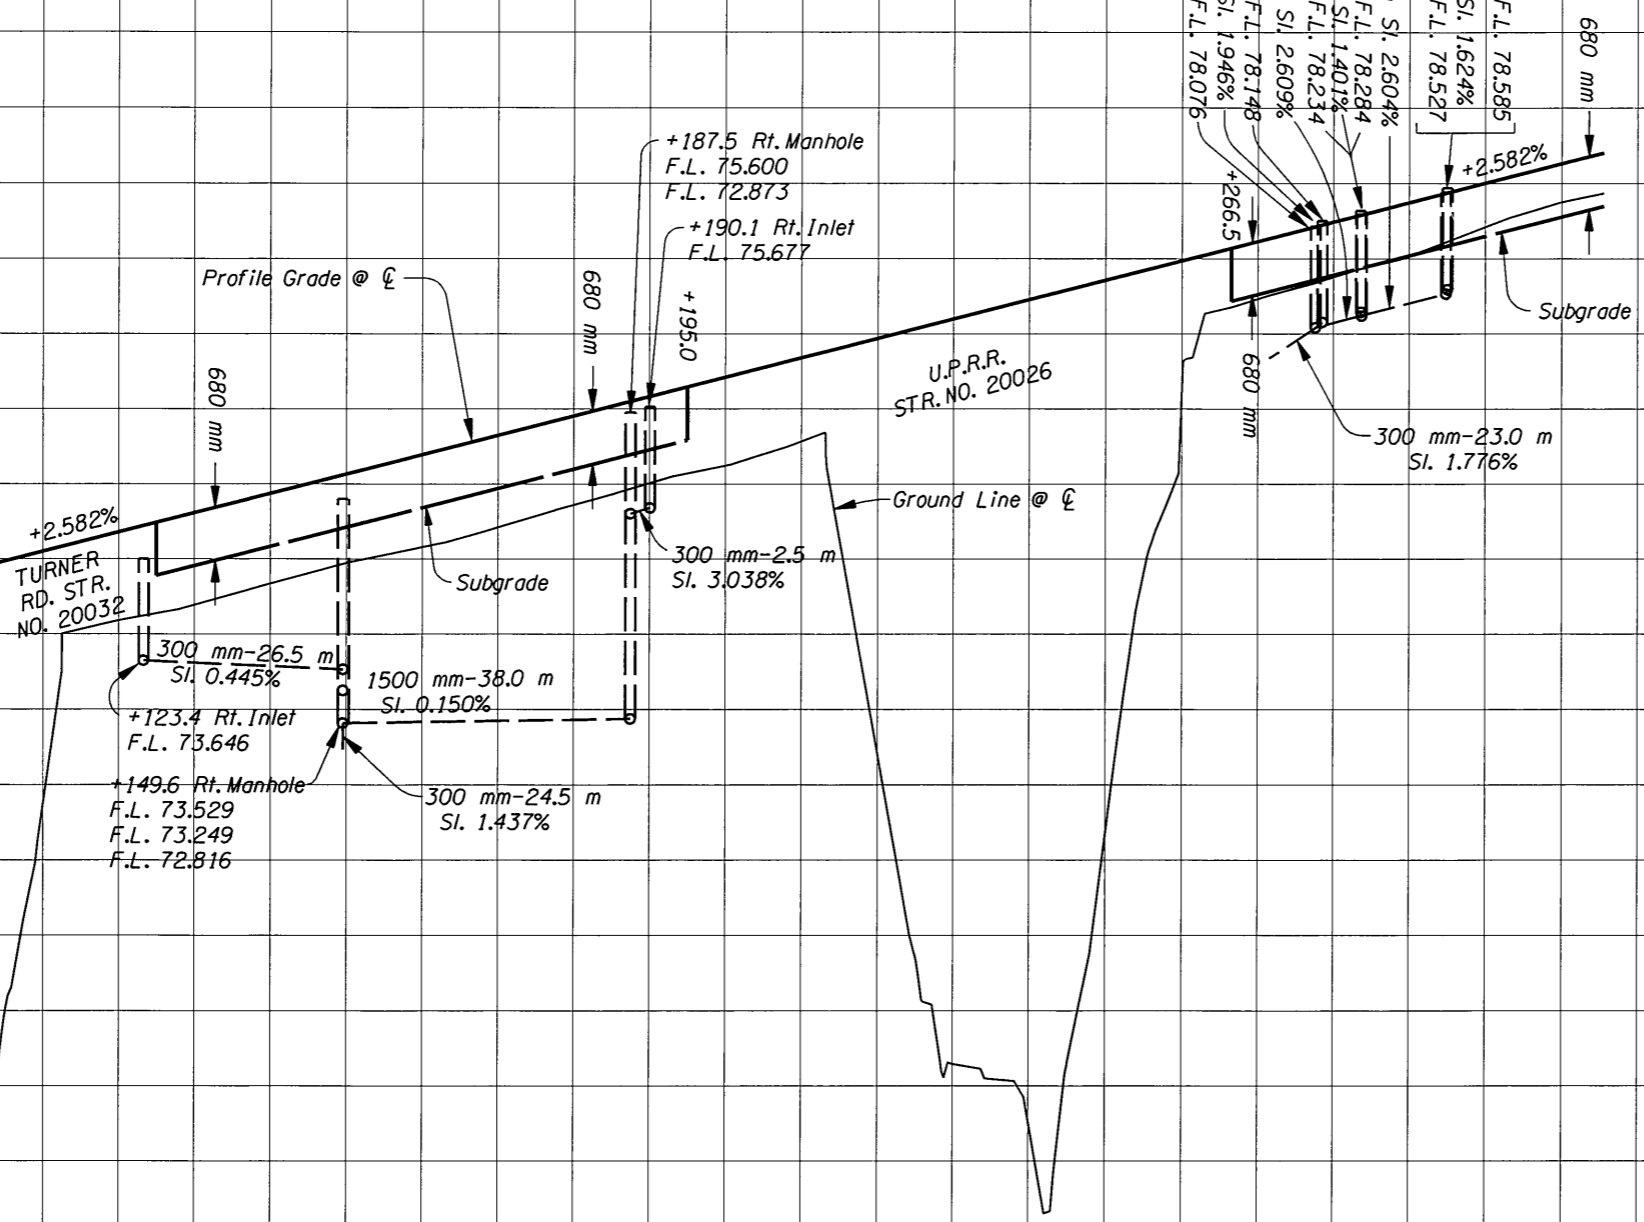

14+100

14+200

14+300



**OREGON DEPARTMENT OF TRANSPORTATION
ROADWAY ENGINEERING SECTION**

**1-5: N. SANTIAM HWY. -
KUEBLER BLVD. (SALEM) SEC.
PACIFIC HIGHWAY
MARION COUNTY**

Design Team Leader - Carol Cartwright P.E.
Designed By - John Lucas
Drafted By - Steve Donaldson


PROFILE

SHEET NO. **16F**

"L" LINE LEFT (Northbound)

84
83
82
71
69
68
67
66
65

83
82
81
80
79
78
77
76
75
74
73
72
71
71
69
68
67
66
65

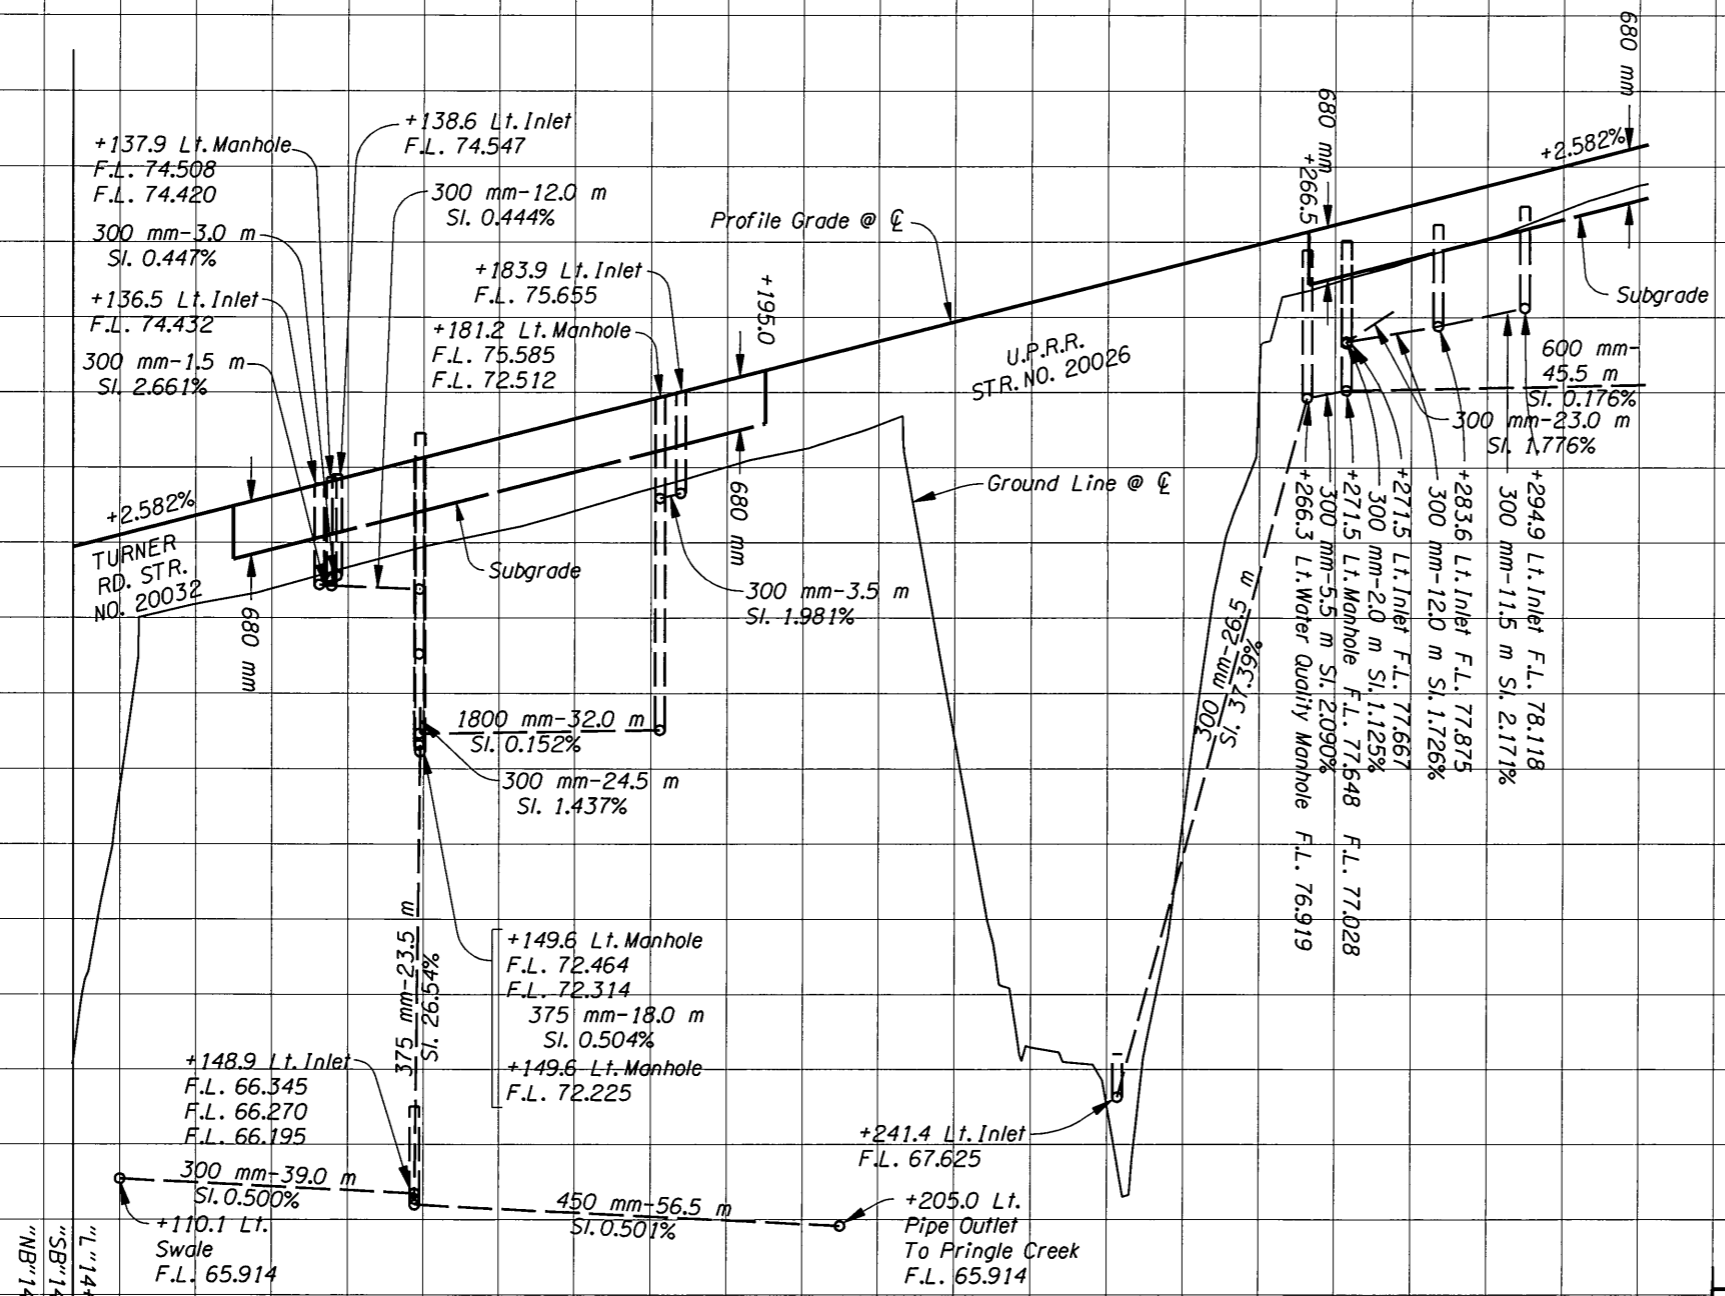

"L" 14+103.866 P.O.T.
"SB" 14+075.837 P.T.
"NB" 14+108.771 P.O.T.

STAGE II
Emb. In Pl. 5890

STAGE II
Exc. 3835
Emb. In Pl. 0
STAGE IV
Exc. 5
Emb. In Pl. 5



**OREGON DEPARTMENT OF TRANSPORTATION
ROADWAY ENGINEERING SECTION**

**I-5: N. SANTIAM HWY. -
KUEBLER BLVD. (SALEM) SEC.
PACIFIC HIGHWAY
MARION COUNTY**

Design Team Leader - Carol Cartwright P.E.
Designed By - John Lucas
Drafted By - Steve Donaldson

PROFILE

SHEET NO.
16G


14+100

14+200


14+300

STRUCTURAL DETAILS CHECKED

- NOTES:
- Hardware, Fasteners And Anchors To Be Stainless Steel; Use 3 mm Stainless Steel Cable.
 - For Manhole Details Not Shown, See RD346
 - Hardware, Fasteners, Anchors, Fittings, Appurtenances, Labor, And Equipment Are Incidental.

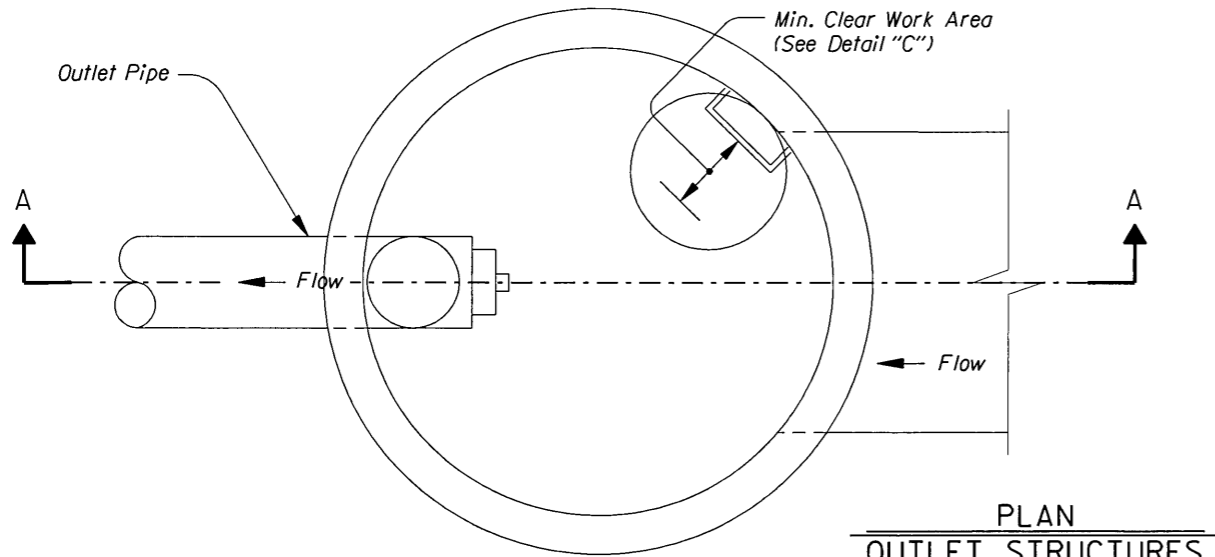

PLAN
OUTLET STRUCTURES
(For Location, See Sht. 16C and 17)
Not To Scale

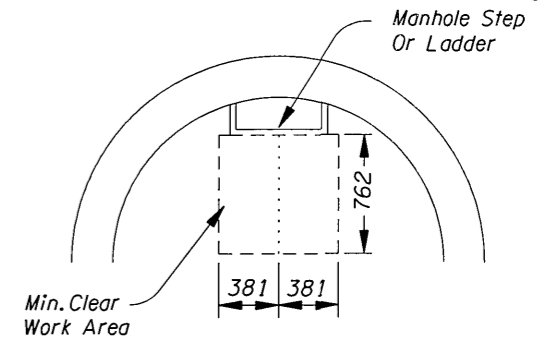

Locate Pipes, Etc. So That No Portion Of Them Are Within Min. Clear Work Area

DETAIL "C"
MIN. CLEAR WORK AREA
Not To Scale


Sta "L" 14+149.633 21.510 Rt.		
	ELEVATION (m)	DESCRIPTION
A	73.251	Detention Pipe Inlet
B	74.733	Elev. Of Detention Water Surface 50 Year Storm
C	74.247	Fl. Elev. Of Elbow
D	75.033	Rim Of Overflow Riser
E	73.247	Fl. Elev. Of Outlet Pipe
F	75.796	Top Of Manhole

Sta "L" 14+149.601 0.720 Lt.		
	ELEVATION (m)	DESCRIPTION
A	72.466	Detention Pipe Inlet
B	74.131	Elev. Of Detention Water Surface 50 Year Storm
C	73.058	Fl. Elev. Of Elbow
D	74.431	Rim Of Overflow Riser
E	72.458	Fl. Elev. Of Outlet Pipe
F	76.124	Top Of Manhole

Sta "L" 14+362.421 25.372 Lt.		
	ELEVATION (m)	DESCRIPTION
A	77.376	Detention Pipe Inlet
B	78.839	Elev. Of Detention Water Surface 50 Year Storm
C	78.071	Fl. Elev. Of Elbow
D	79.139	Rim Of Overflow Riser
E	77.371	Fl. Elev. Of Outlet Pipe
F	80.618	Top Of Manhole

Sta "L" 14+061.972 16.794 Lt.		
	ELEVATION (m)	DESCRIPTION
A	69.814	Detention Pipe Inlet
B	71.408	Elev. Of Detention Water Surface 50 Year Storm
C	70.353	Fl. Elev. Of Elbow
D	71.708	Rim Of Overflow Riser
E	69.803	Fl. Elev. Of Outlet Pipe
F	74.439	Top Of Manhole


Sta "L" 14+360.118 2.547 Rt.		
	ELEVATION (m)	DESCRIPTION
A	78.348	Detention Pipe Inlet
B	79.723	Elev. Of Detention Water Surface 50 Year Storm
C	79.043	Fl. Elev. Of Elbow
D	80.023	Rim Of Overflow Riser
E	78.343	Fl. Elev. Of Outlet Pipe
F	81.590	Top Of Manhole

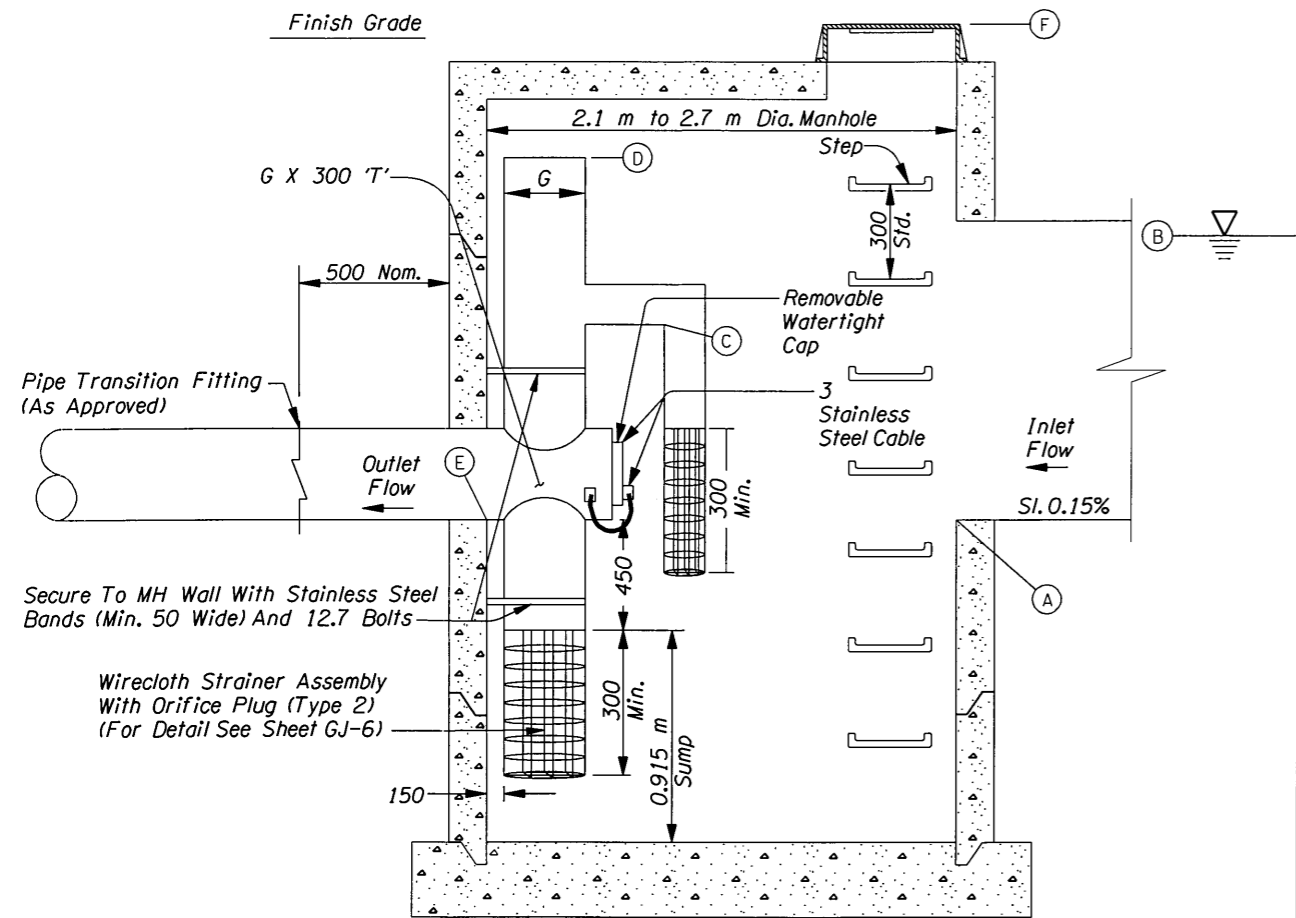

SECTION A-A
FLOW CONTROL MANHOLE
Not To Scale

Location	G(mm)
Sta. "L" 14+149.633 21.510 Rt.	250
Sta. "L" 14+149.601 0.720 Lt.	250
Sta. "L" 14+061.972 16.494 Lt.	250
Sta. "L" 14+362.421 25.372 Lt.	300
Sta. "L" 14+360.118 2.547 Rt.	450

All Dimensions Shown Are In Millimeters (mm) Unless Otherwise Noted

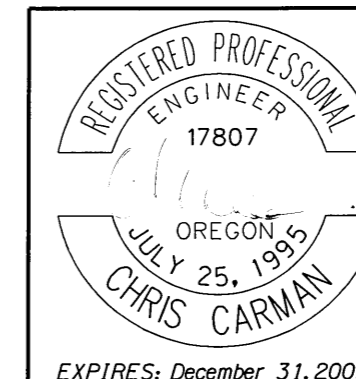


OREGON DEPARTMENT OF TRANSPORTATION
REGION 2 TECH CENTER

I-5: NORTH SANTIAM HWY. - KUEBLER BLVD. (SALEM) SEC.
PACIFIC HIGHWAY
MARION COUNTY

Reviewed By - Alvin Shoblom
Designed By - Chris Carman
Drafted By - Chris Shearer


DETAILS

SHEET NO.
GJ-4

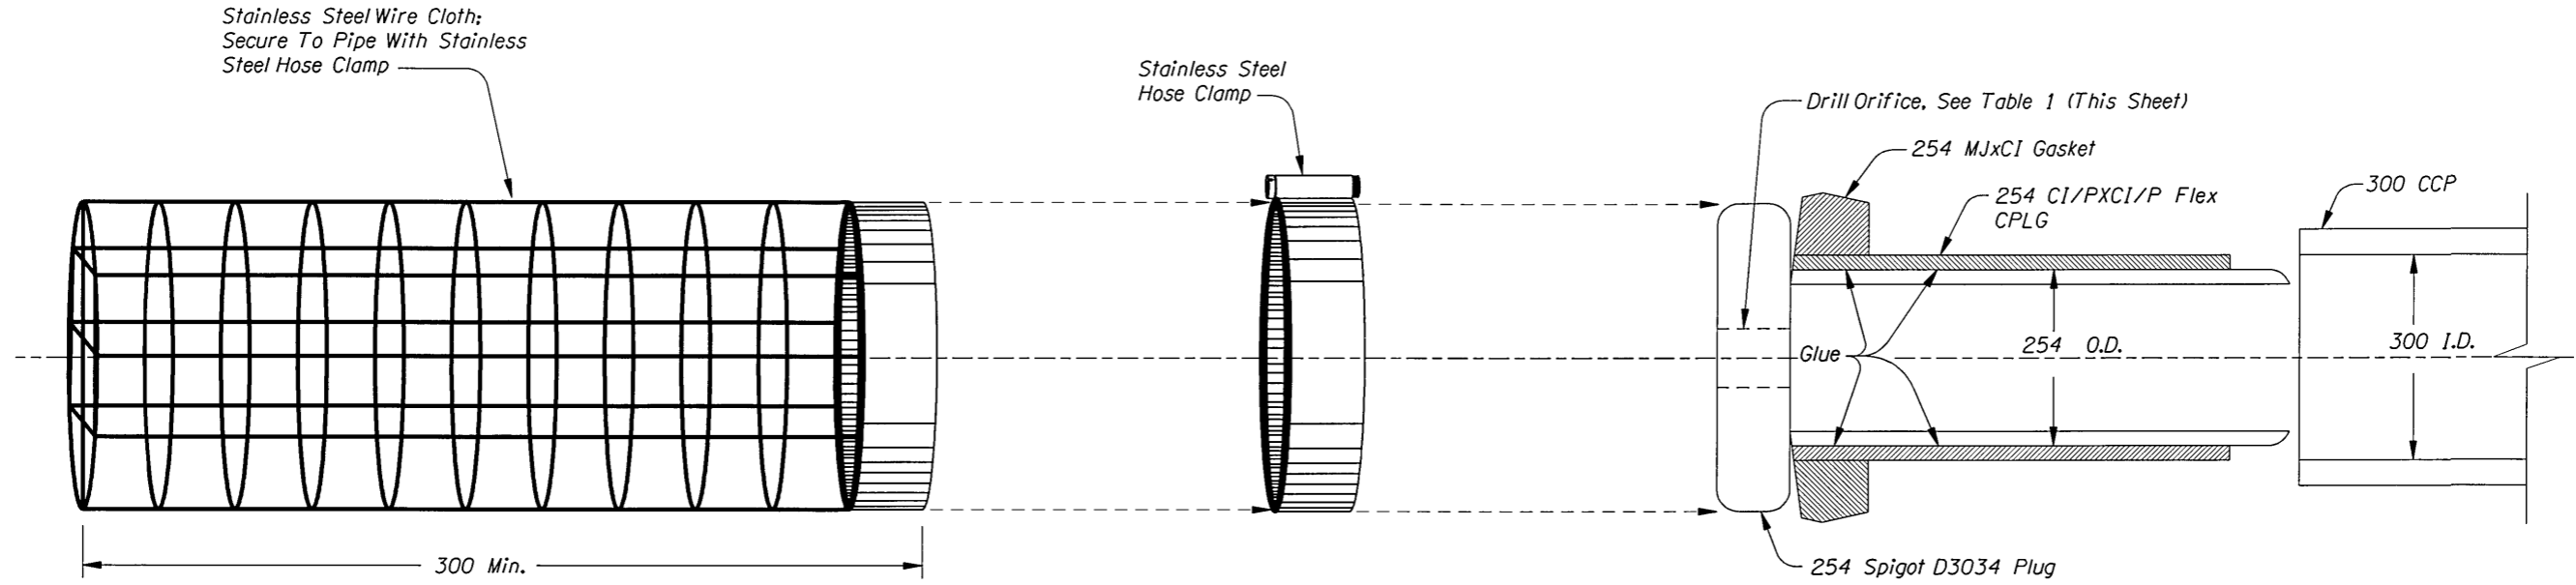

**FLOW CONTROL MANHOLE
WIRE CLOTH STRAINER ASSEMBLY**
Not To Scale

ORIFICE PLUG (TYPE 2)
Not To Scale

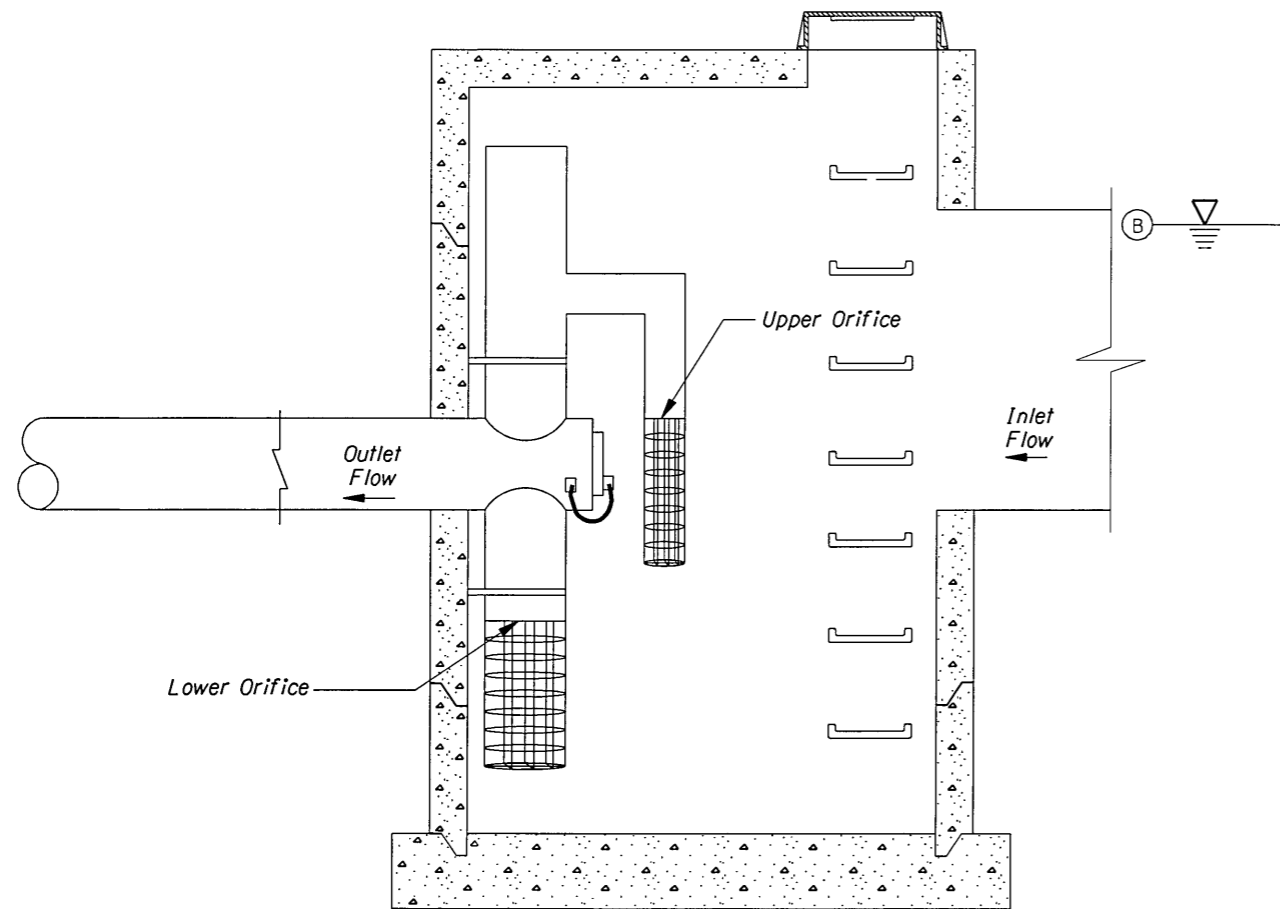


**SECTION A-A
FLOW CONTROL MANHOLE**
Not To Scale

Table 1

Location	Lower Orifice Dia.(mm)	Upper Orifice Dia.(mm)
North Santiam Interchange	63.5	N/A
Sta."L" 14+360.118 2.547 Rt.	50	250
Sta."L" 14+362.421 25.372 Lt.	25	175
Sta."L" 14+149.633 21.50 Rt.	25	75
Sta."L" 14+149.601 0.720 Lt.	50	115
Sta."L" 14+061.976 16.794 Lt.	25	75
Kuebler Blvd. Interchange	25	400

All Dimensions Shown Are In Millimeters (mm) Unless Otherwise Noted

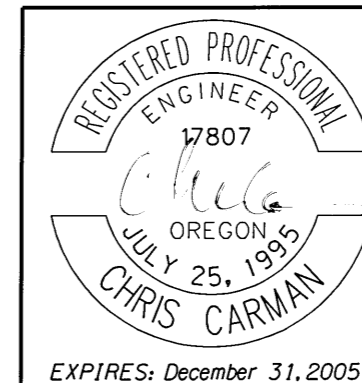

**OREGON DEPARTMENT OF TRANSPORTATION
REGION 2 TECH CENTER**


**1-5: NORTH SANTIAM HWY. -
KUEBLER BLVD. (SALEM) SEC.
PACIFIC HIGHWAY
MARION COUNTY**

Reviewed By - Alvin Shoblom
Designed By - Chris Carman
Drafted By - Chris Shearer

DETAILS


SHEET NO.

GJ-6

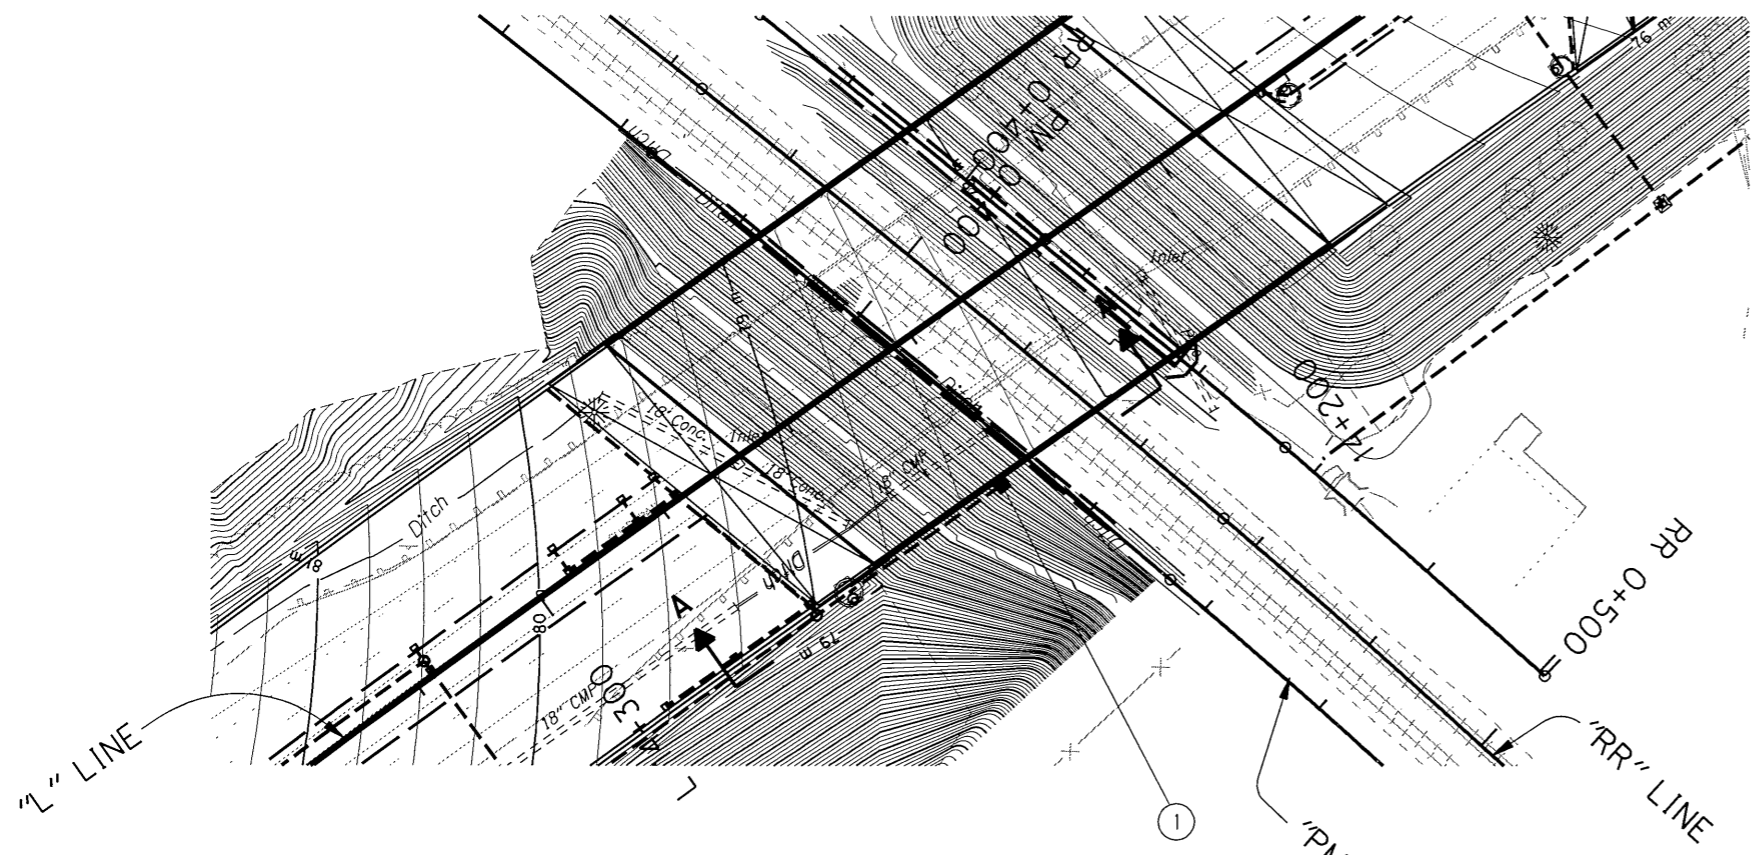


PLAN
Scale 1:1000


① Sta. "L"14+241.4 To Sta. "L"14+266.3
Const. Type Modified "D" Inlet
Inst. 300 mm Sew. Pipe - 26.5 m
Inst. Metal Pipe Slope Anchors
(See Sht. 16D, Note 6)
(See Details Below And
Drg. Nos. RD330, RD370)

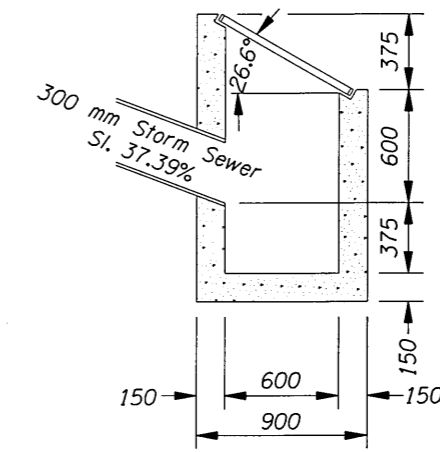



SECTION A-A

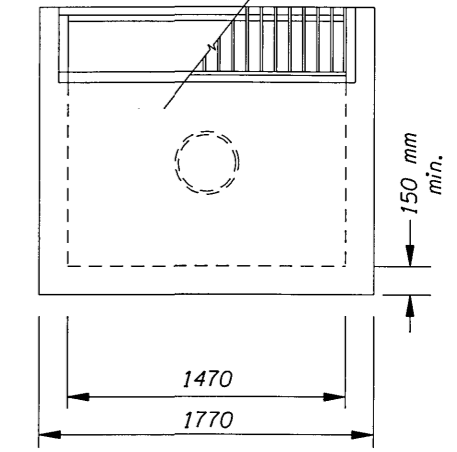

SECTION B-B

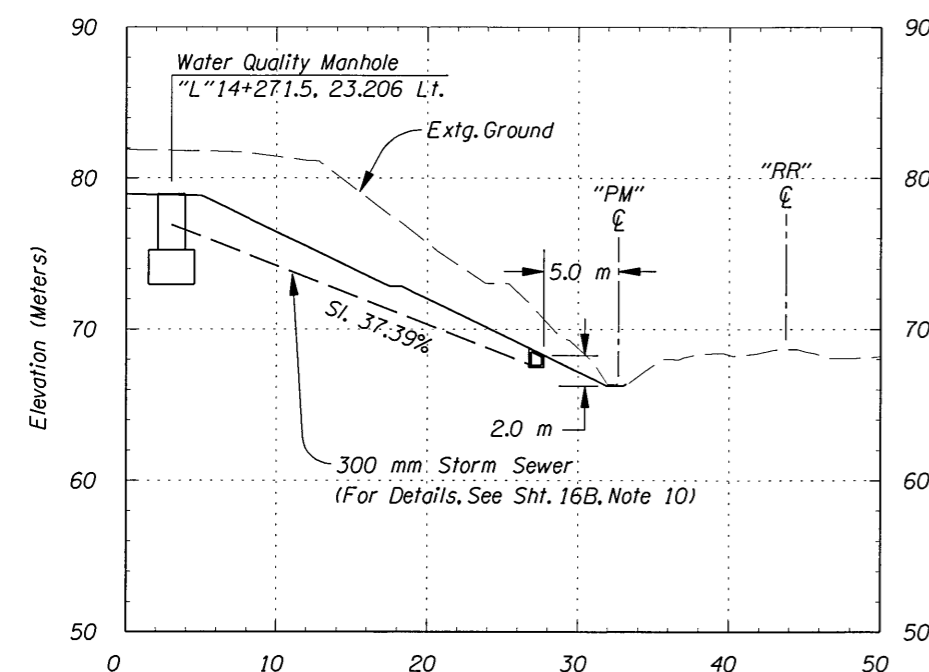


SECTION A-A

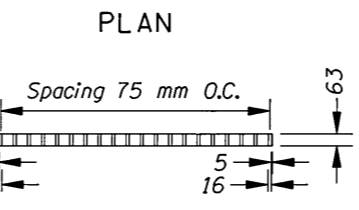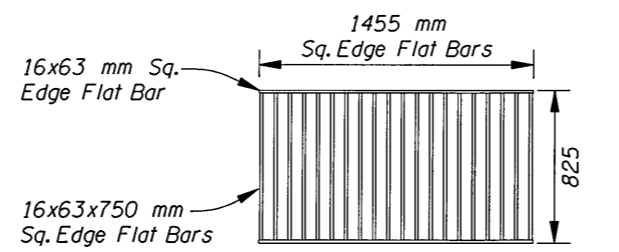


GRATE SECTION
TYPE 1


Note:
9 mm Cross Bars Shall Be Flush With The Grate Surface And
May Be Fillet Welded, Resistance Welded Or Electroforged
To Bearing Bars.

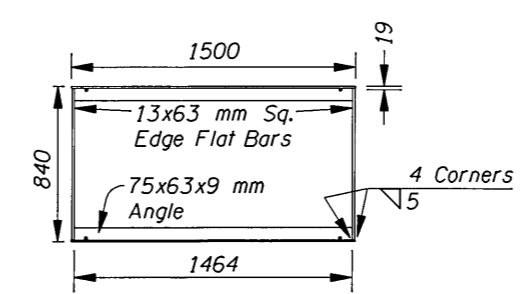

FRAME PLAN

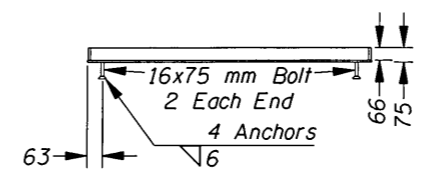

FRAME SECTION

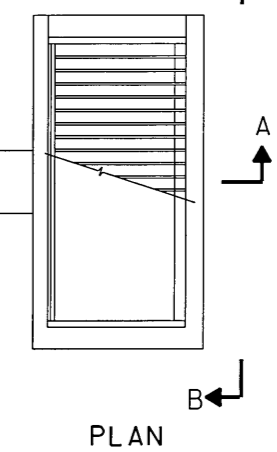


PLAN

- Notes:
1. Concrete Strength Shall Be Commercial Grade Concrete.
 2. G-2 Grates May Be Used If Approved By The Engineer.
 3. Catch Basin, Frame, And Grates Shall Meet MS18 Loading.

All Dimensions Are Shown In Millimeters (mm)
Unless Otherwise Noted.

U.P.R.R. ENERGY DISSIPATOR

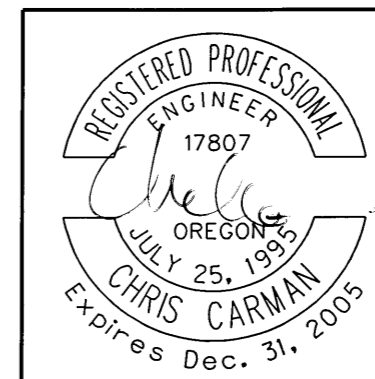

**OREGON DEPARTMENT OF TRANSPORTATION
ROADWAY ENGINEERING SECTION**

1-5: N. SANTIAM HWY. -
KUEBLER BLVD. (SALEM) SEC.
PACIFIC HIGHWAY
MARION COUNTY

Reviewed By - Luis Rivas
Designed By - Chris Carman
Drafted By - Steve Donaldson

STORMWATER

SHEET NO.
GJ-9