

OPERATION & MAINTENANCE MANUAL

DFI No. D00052

**Facility Type: Water Quality Biofiltration
Swale**



DECEMBER, 2011

INDEX

1. IDENTIFICATION 1

2. FACILITY CONTACT INFORMATION..... 1

3. CONSTRUCTION..... 1

4. STORM DRAIN SYSTEM AND FACILITY OVERVIEW 1

5. FACILITY HAZ MAT SPILL FEATURE(S)..... 5

6. AUXILIARY OUTLET (HIGH FLOW BYPASS) 5

7. MAINTENANCE REQUIREMENTS 5

8. WASTE MATERIAL HANDLING 6

APPENDIX A: Operational Plan and Profile Drawing(s)

APPENDIX B: ODOT Project Plan Sheets

1. Identification

Drainage Facility ID (DFI): **D00052**
Facility Type: Water Quality Biofiltration Swale
Construction Drawings: (V-File Number) 34V-107
Location: District: 1
Highway No.: 009
Mile Post: 4.35 / 4.37 (beg./end)
Description: This facility is located in the southwest corner of the intersection of US 101 (Hwy 009-Oregon Coast Hwy.) and OR 202 (Hwy 102 – Nehalem Hwy.). Access may be obtained from the right shoulder.

2. Facility Contact Information

Contact the Engineer of Record, Region Technical Center, or Geo-Environmental's Senior Hydraulics Engineer for:

- Operational clarification
- Maintenance clarification
- Repair or restoration assistance

Engineering Contacts:

Region Technical Center Hydro

Or

Geo-Environmental Senior Hydraulics Engineer (503) 986-3365.

3. Construction

Engineer of Record: ODOT Designers: Region 2 Tech. Center, T. Yamada, K. Austin, 503-986-2990

Facility construction: 2001
Contractor: NB Hatch Company

4. Storm Drain System and Facility Overview

A water quality swale is a flat-bottomed open channel designed to treat stormwater runoff from highway pavement areas. This type of facility is lined with grass. Treatment by trapping sediment occurs when stormwater runoff flows through the grass.

This facility is located in the southwest corner of the intersection of US 101 (Hwy 009-Oregon Coast Hwy.) and OR 202 (Hwy 102 – Nehalem Hwy.). This is a round-a-bout configured intersection where access may be obtained from the right shoulder of EB US 101.

Stormwater from the roundabout and a portion of US 101 is directed to the swale. A 12-inch diameter swale inlet directs water into the western most portion of the swale (Point A of the Operational Plan in Appendix A). This swale is cut unusually deep, perhaps to accommodate the storm pipe conveyance system (Photo 2). Water conveyed into the swale undergoes treatment as it flows through the length of the channel. The treated water flows out of the swale through a ditch inlet (Point B on the Operational Plan in Appendix A; Photo 3, Photo 4). The swale outlets into a nearby manhole where it is combined with other stormwater flow (some from facilities DFI D00050 and DFI D00051). At this point it discharges into a 24-inch outfall into Young's Bay (Photo 4).

A. Maintenance equipment access:

This facility is located in the southwest corner of the intersection of US 101 (Hwy 009-Oregon Coast Hwy.) and OR 202 (Hwy 102 – Nehalem Hwy.). The facility is located along the radius of the round-a-bout configured intersection where access may be obtained from the right shoulder of EB US 101 as one is rounding the intersection, heading right, toward Nehalem Highway.

B. Heavy equipment access into facility:

- Allowed (no limitations)
- Allowed (with limitations)
- Not allowed

C. Special Features:

- Amended Soils
- Porous Pavers
- Liners
- Underdrains



Photo 1: Looking towards the west to south-west at the swale inlet.



Photo 2: Looking towards the west of the swale from new the swale outlet.



Photo 3: Swale outlet (Point B) and nearby manhole (Point C) looking west to southwest.



Photo 4: Swale outlet (Point B) and nearby manhole (Point C) looking south towards Young's Bay.

5. Facility Haz Mat Spill Feature(s)

The swale can be used to store a volume of liquid by blocking the 12-inch diameter outlet pipe and open-grated inlet located at the outlet of the swale. This pipe and inlet are noted as Point B on the Operational Plan, Appendix A. Sandbags and steel plates may be considered useful options to blocking the grated inlet.

6. Auxiliary Outlet (High Flow Bypass)

Auxiliary Outlets are provided if the primary outlet control structure can not safely pass the projected high flows. Broad-crested spillway weirs and over flow risers are the two most common auxiliary outlets used in stormwater treatment facility design. The auxiliary outlet feature is either a part of the facility or an additional storm drain feature/structure.

The auxiliary outlet feature for this facility is:

Designed into facility

The auxiliary outlet is included in the design of the swale by including deeper channels and pipes connecting to adjacent swales. By linking the swales, stormwater can flow into neighboring facilities and slow down while undergoing treatment.

Other, as noted below

7. Maintenance Requirements

Routine maintenance table for non-proprietary stormwater treatment and storage/detention facilities have been incorporated into ODOT's Maintenance Guide. These tables summarize the maintenance requirements for ponds, swales, filter strips, bioslopes, and detention tanks and vaults. Special maintenance requirements in addition to the routine requirements are noted below when applicable.

The ODOT Maintenance Guide can be viewed at the following website:

<http://www.oregon.gov/ODOT/HWY/OOM/MGuide.shtml>

Maintenance requirements for proprietary structures, such as underground water quality manholes and/or vaults with filter media are noted in Appendix C when applicable.

The following stormwater facility maintenance table (See ODOT Maintenance Guide) should be used to maintain the facility outlined in this Operation and Maintenance Manual or follow the Maintenance

requirements outlined in Appendix C when proprietary structure is selected below:

- Table 1 (general maintenance)
- Table 2 (stormwater ponds)
- Table 3 (water quality biofiltration swales)
- Table 4 (water quality filter strips)
- Table 5 (water quality bioslopes)
- Table 6 (detention tank)
- Table 7 (detention vault)
- Appendix C (proprietary structure)
- Special Maintenance requirements:

Note: Special maintenance Requirements Require Concurrence from ODOT SR Hydraulics Engineer.

8. Waste Material Handling

Material removed from the facility is defined as waste by DEQ. Refer to the road waste section of the ODOT Maintenance Yard Environmental Management System (EMS) Policy and Procedures Manual for disposal options: <http://egov.oregon.gov/ODOT/HWY/OOM/EMS.shtml>



Contact any of the following for more detailed information about management of waste materials found on site:

ODOT Clean Water Unit	(503) 986-3008
ODOT Statewide Hazmat Coordinator	(503) 229-5129
ODOT Region Hazmat Coordinator	(503) 986-2647
ODEQ Northwest Region Office	(503) 229-5263

Appendix A

Content:

- **Operational Plan and Profile Drawing(s)**

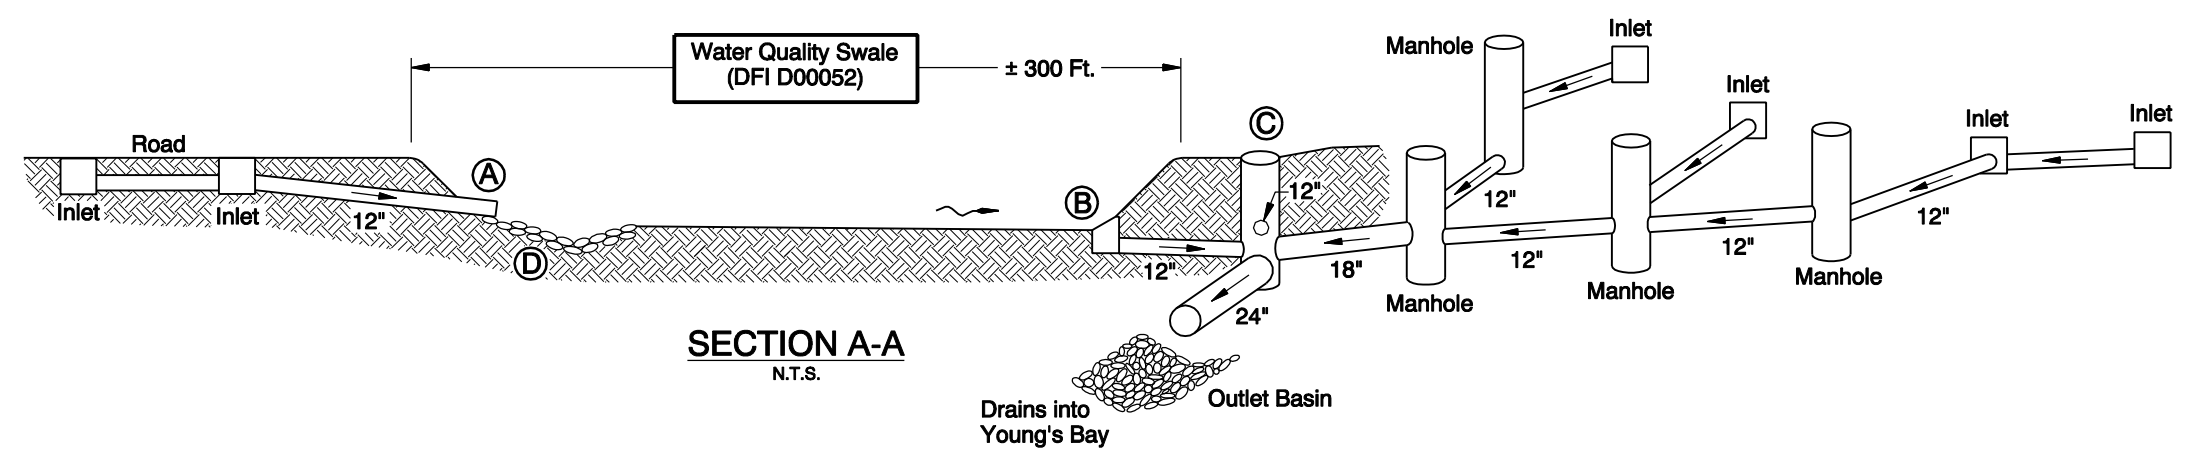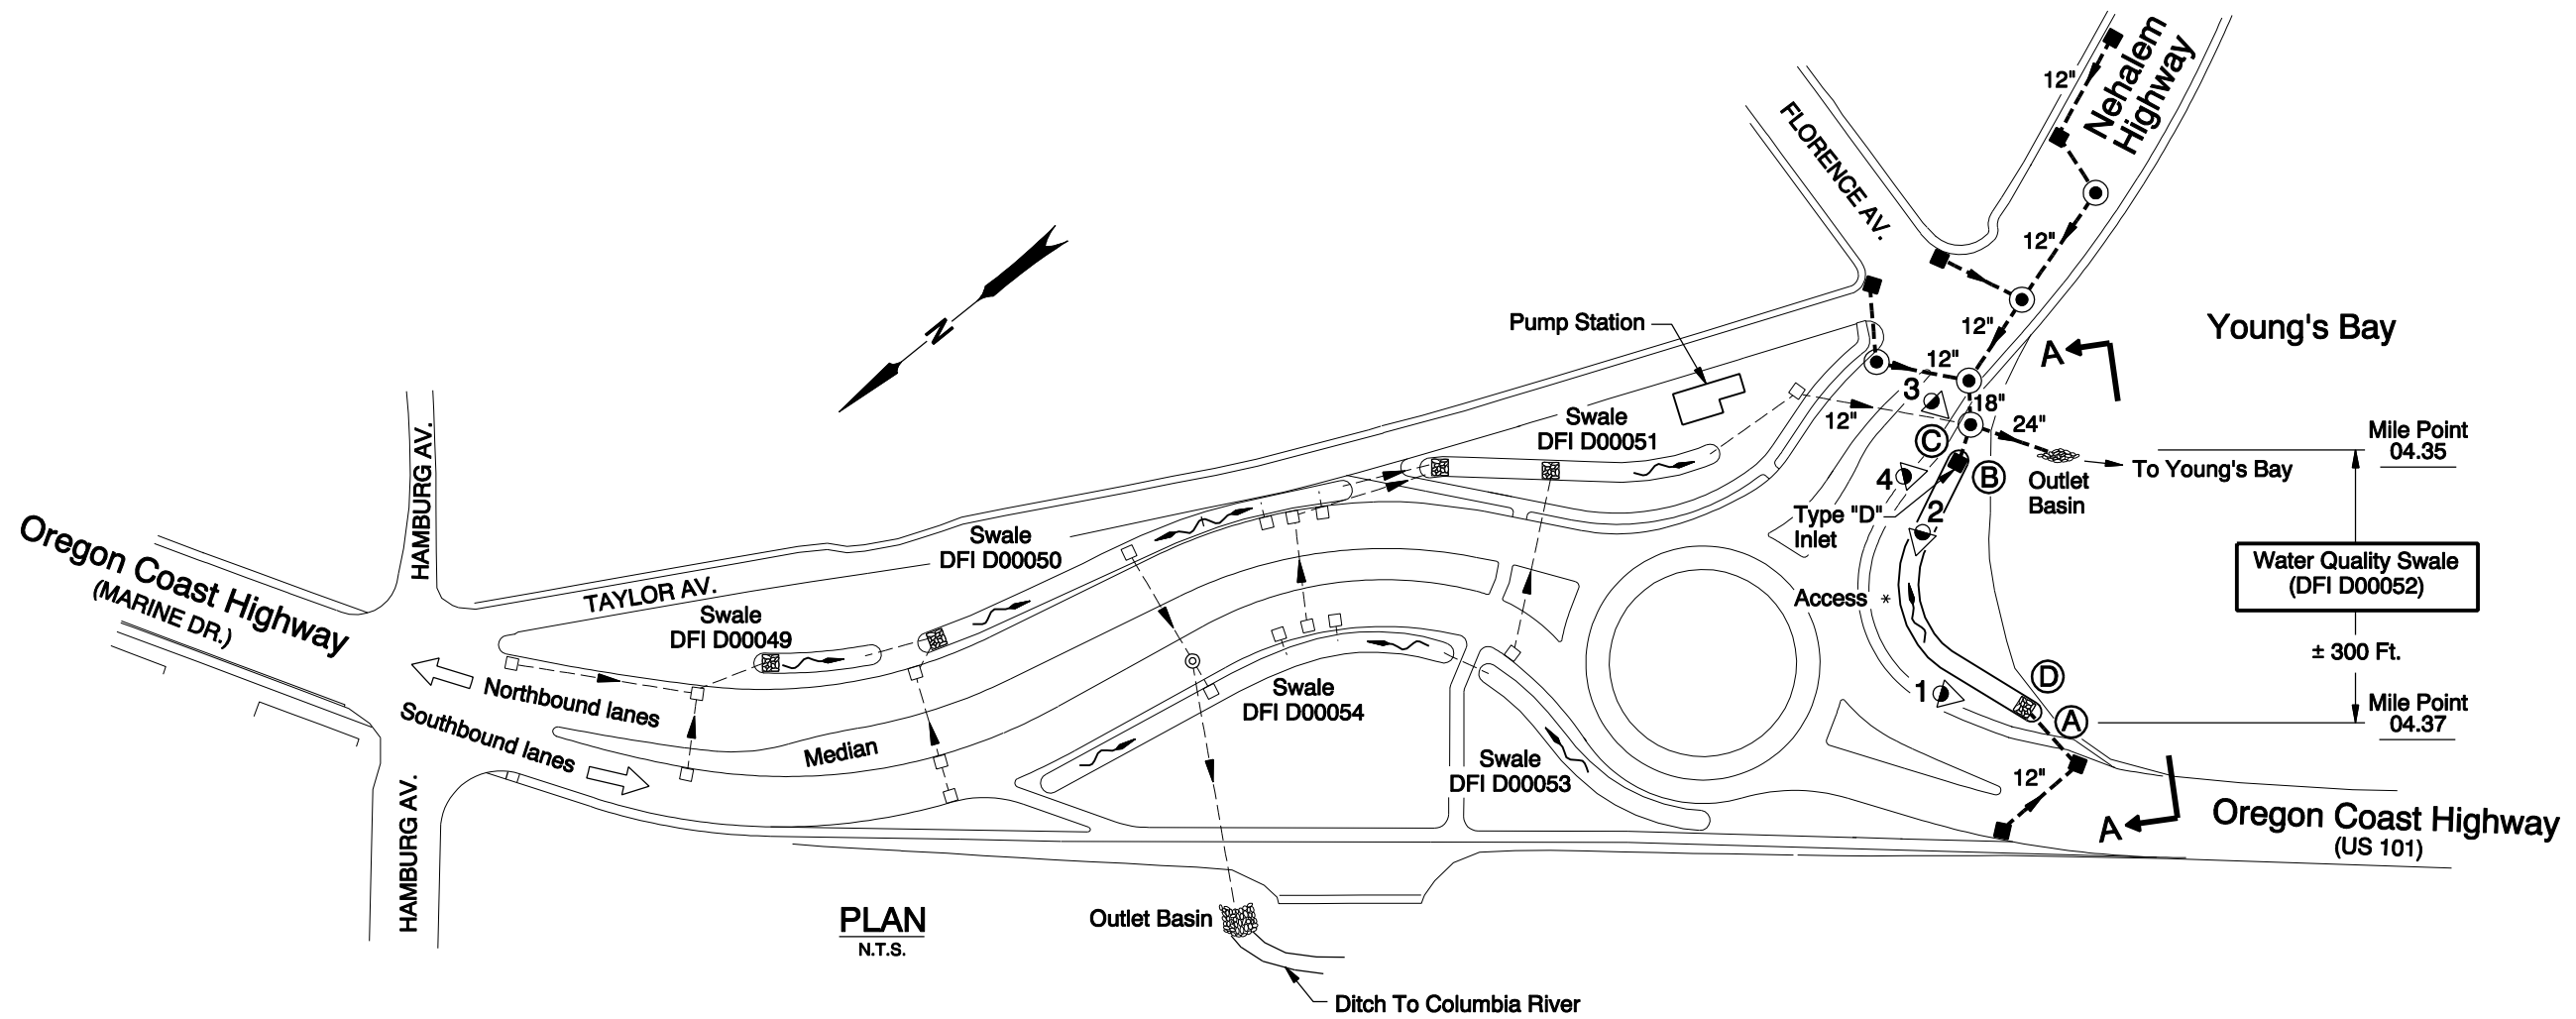

- LEGEND:**
- Photo Location / Direction
 - Swale Inlet, 12" Dia.
 - Swale Outlet Via Ditch Inlet
 - 5' Diameter Manhole
 - Inlet basin (Flow spreader)
 - Manhole
 - Inlet
 - Storm Pipe (Facility)
 - Storm Pipe
 - Conveyance Direction
 - Pavement / Facility Flow Path

Sht. 1 of 1

OREGON DEPARTMENT OF TRANSPORTATION

DFI D00052
MAINTENANCE DISTRICT 1 HWY 9
WATER QUALITY BIOFILTRATION SWALE
 OREGON COAST HIGHWAY MP 04.35-04.37
 CLATSOP COUNTY

Prepared By: M. Wittenbrink

Drafted By: Jim Holeman

Appendix B


Content:

- **ODOT Project Plan Sheets**
 - *Cover/Title Sheet*
 - *Water Quality/Detention Plan Sheets*
 - *Other Details*

STATE OF OREGON
DEPARTMENT OF TRANSPORTATION

PLANS FOR PROPOSED PROJECT

GRADING, PAVING, & SIGNING
**US-101 AT NEHALEM HWY.
(ASTORIA) SEC.**
OREGON COAST & NEHALEM HWYS.
CLATSOP COUNTY
OCTOBER 2001

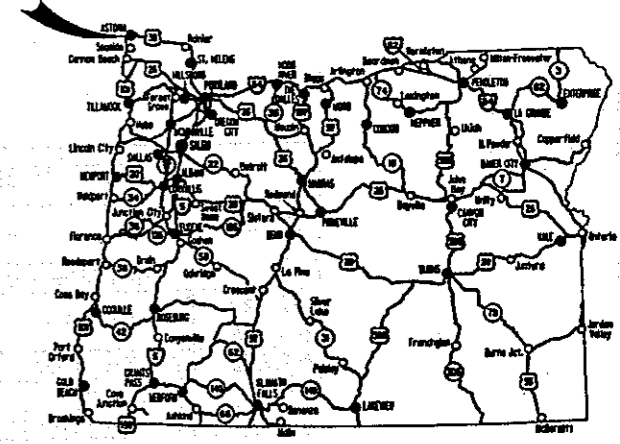

Overall Length Of Project - 0.61 km (0.38 Mile)

INDEX OF SHEETS	
SHEET NO.	DESCRIPTION
1	Title Sheet
1A	Index Of Sheets Cont'd. & Standard Drawing Nos.
2, 2A, 2A-2	Typical Sections
2B Thru 2B-6 Incl.	Details
2C	Traffic Control Detour & Details
2C-2 Thru 2C-21 Incl.	Traffic Control Plans
2D, 2D-2	Erosion Control Details
2D-3 Thru 2D-4 Incl.	Erosion Control Plans
2E	Pipe Data
3	"ML", "MR" Line Alignment
3A, 3B	General Construction
3C	"ML", "MR" Line Profile
4	"ML", "MR", "MC", "C", "TL", "TR" Line Alignment
4A, 4B	General Construction
4C	"ML", "MR" Line Profile
4D	"C" Line Profile
5	"MC", "TL", "TR" Line Alignment
5A, 5B	General Construction
5C	"MC" Line Profile
6	"TL", "TR" Line Alignment
6A, 6B	General Construction
6C	"TL", "TR" Line Profile
7	"TL" Line Alignment
7A, 7B	General Construction
7C	"TL" Line Profile

ATTENTION :
Oregon Law Requires You To Follow Rules Adopted By The Oregon Utility Notification Center. Those Rules Are Set Forth In OAR 952-001-0010 Through OAR 952-001-0030. You May Obtain Copies Of The Rules From The Center, Or Answers To Questions About The Rules By Calling (503) 232-1987.





22-AUG-2001 11:54

NH-HPP-ACHPP-S009(128)
BEGINNING OF PROJECT
STA. 'MR' 10 + 060

END OF PROJECT **NH-HPP-ACHPP-S009(128)**
STA. 'MR' 10 + 450

NH-HPP-ACHPP-S009(128)
END OF PROJECT
STA. 'TL' 30 + 640

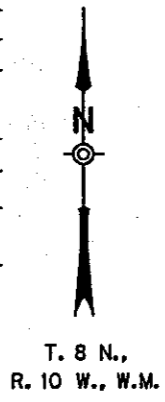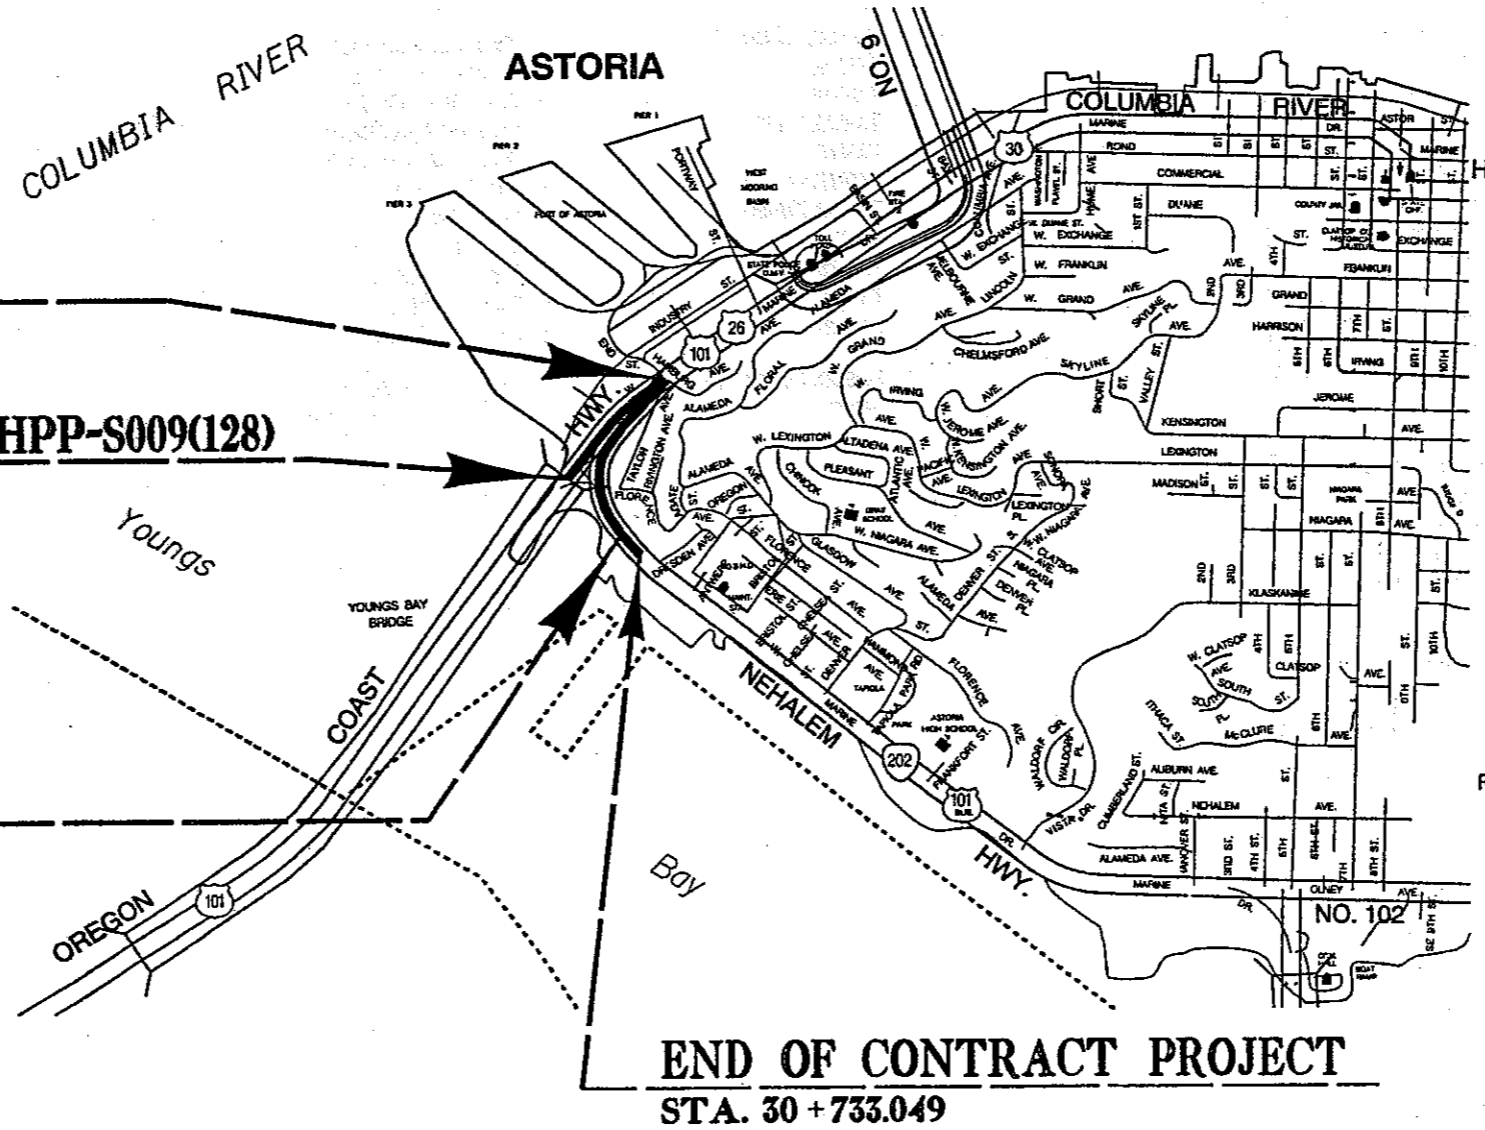

OREGON TRANSPORTATION COMMISSION

- Steven H. Corey CHAIRMAN
- Gail L. Achterman COMMISSIONER
- Stuart Foster COMMISSIONER
- Randall Pape COMMISSIONER
- John Russell COMMISSIONER
- Bruce A. Warner DIRECTOR OF TRANSPORTATION



Catherine M. Nelson

ACTING TECHNICAL SERVICES MANAGING ENGINEER


**US-101 AT NEHALEM HWY.
(ASTORIA) SEC.**
OREGON COAST & NEHALEM HWYS.
CLATSOP COUNTY

FEDERAL HIGHWAY ADMINISTRATION	PROJECT NUMBER	SHEET NO.
OREGON DIVISION	NH-HPP-ACHPP-S009(128)	1




AS CONSTRUCTED
A *Diana* PROJECT MANAGER 8/20/03 DATE


END OF CONTRACT PROJECT
STA. 30 + 733.049

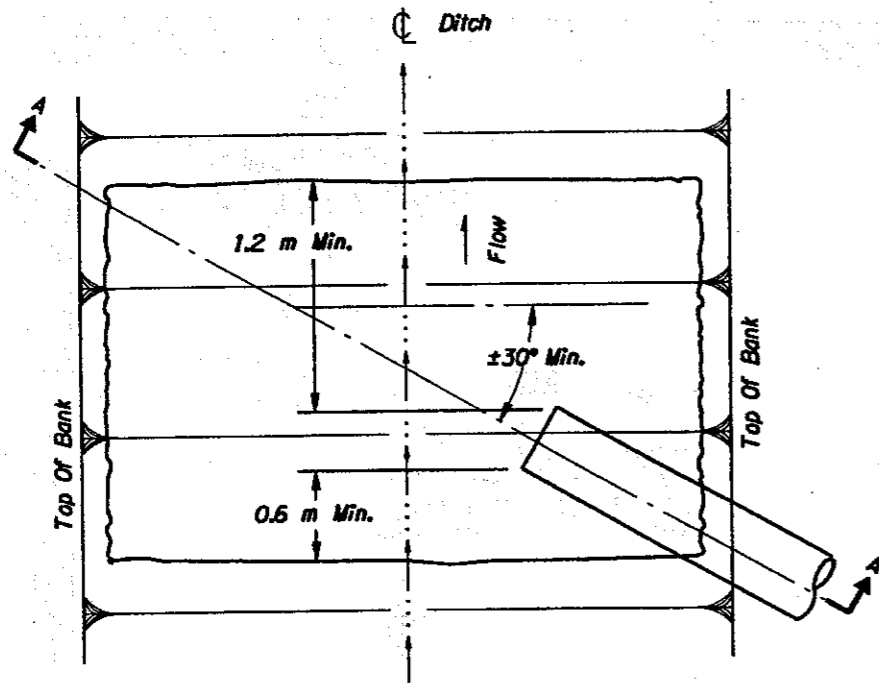

PLAN

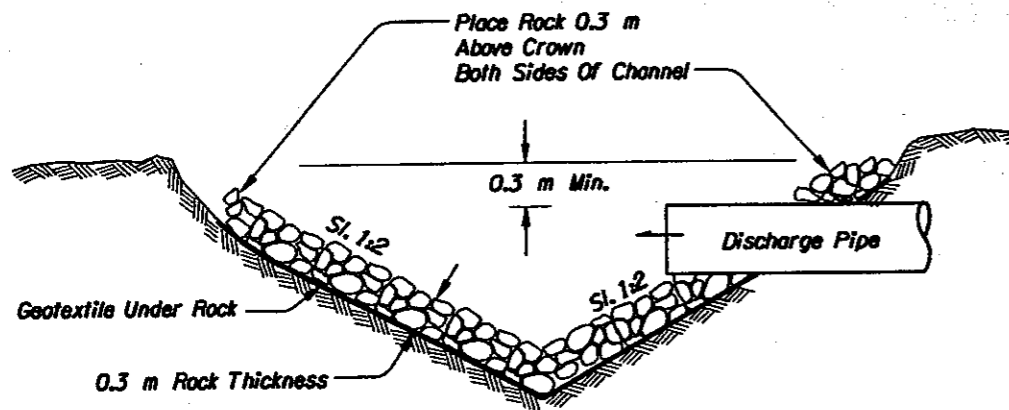

SECTION A - A
OUTLET BASIN

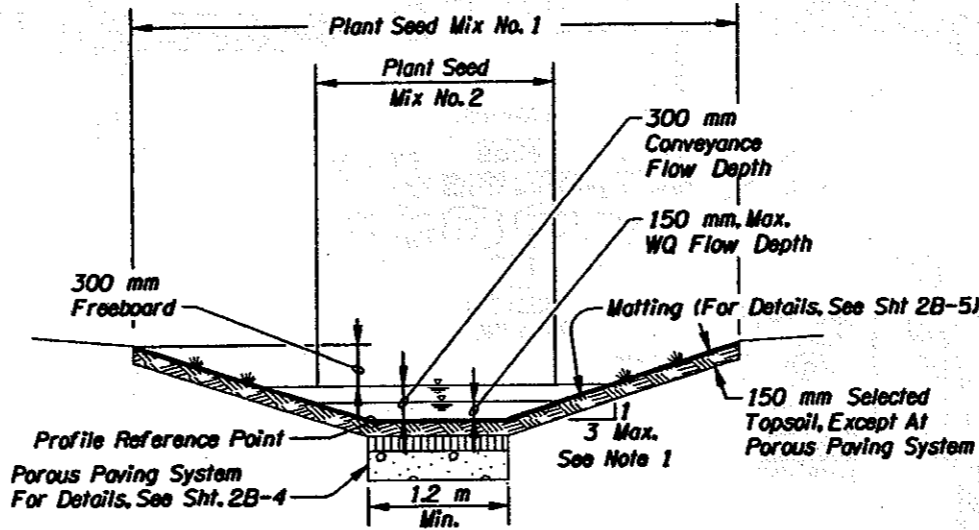


Eastside Ditch
Sta. "ML" 20+125.3 Lt. To Sta. "ML" 20+217.8 Lt.
Sta. "ML" 20+275.6 Lt. To Sta. "TL" 30+424.9 Lt.

Southside Ditch
Sta. "MC" 10+403.2 Lt. To Sta. "TL" 30+489.3 Rt.

NOTE:


- Increase Slope To IV : 2H Adjacent To Existing Wastewater Pump Station (Sta. "TL" 30+432.7 Lt. To Sta. "TL" 30+452.9 Lt.)

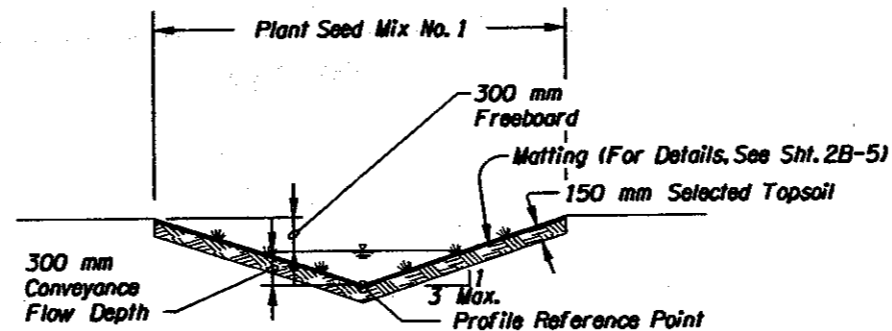

Westside ditch
Sta. "MC" 10+342.9 Rt. To Sta. "MR" 10+163.4 Rt.

Eastside Ditch
Sta. "ML" 20+217.8 Lt. To Sta. "ML" 20+275.6 Lt.


DRAINAGE SWALE DETAIL

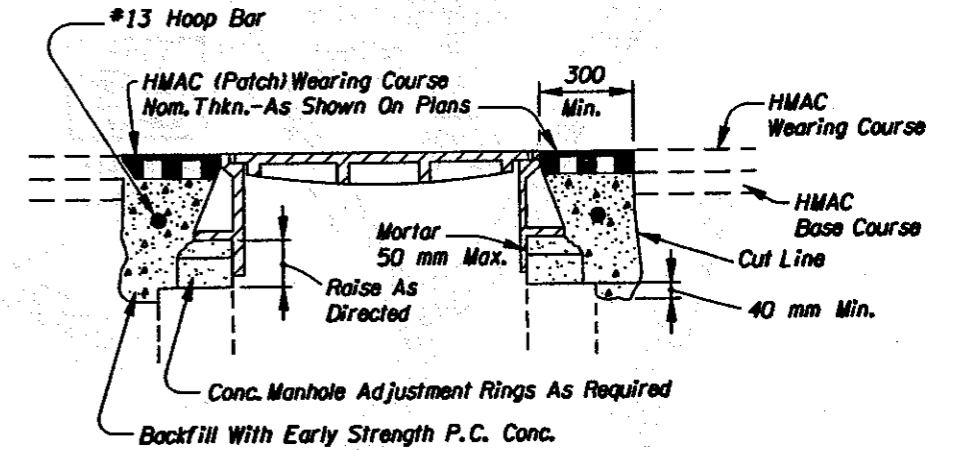

- Cover Manhole With Building Paper And Const. HMAC Base And Wearing Courses.
- Sawcut Square Or Circular Excavation Around Manhole 300 mm Min. From M. H. Frame. Orient Diagonal Of Square So That Its Is Parallel To Roadway Center Line.
- Raise Manhole Frame And Cover To Finish Grade By Installing Conc. Rings And Levelling Mortar.
- Backfill With Early Strength P. C. Conc. And HMAC Wearing Course.

METHOD "A"
MANHOLE ADJUSTMENT SEQUENCE

Note:
All Dimensions Are
In Millimeters (mm) Unless
Otherwise Indicated.

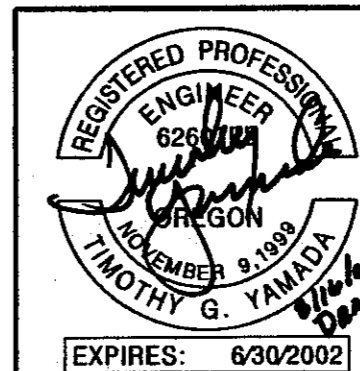

OREGON DEPARTMENT OF TRANSPORTATION
ROADWAY ENGINEERING SECTION

U.S.-101 AT NEHALEM HWY. (ASTORIA) SEC.
OREGON COAST & NEHALEM HWYS.
CLATSOP COUNTY


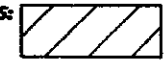



Designed By - Tim Yamada
Drafted By - Rob Luke


DETAILS

SHEET NO.
2B-6

15-AUG-2001 09:51 C:\Users\sgifford\Documents\153739 Astoria\10417.dwg

NH-HPP-ACHPP-S009(128)
BEGINNING OF PROJECT
STA. "MR" 10+060
STA. "ML" 20+060


- Concrete Island
Shown Thus: 
(For Details, See Sht. 2B-4)
- Pavement Removal
Shown Thus: 
(For Details, See Sht. 2B-4)
- Aggregate Base
Shown Thus: 
(For Details, See Sht. 2B-4)
- Porous Pavers
Shown Thus: 
(For Details, See Sht. 2B-4)
- P.C. Conc. Walk
Shown Thus: 

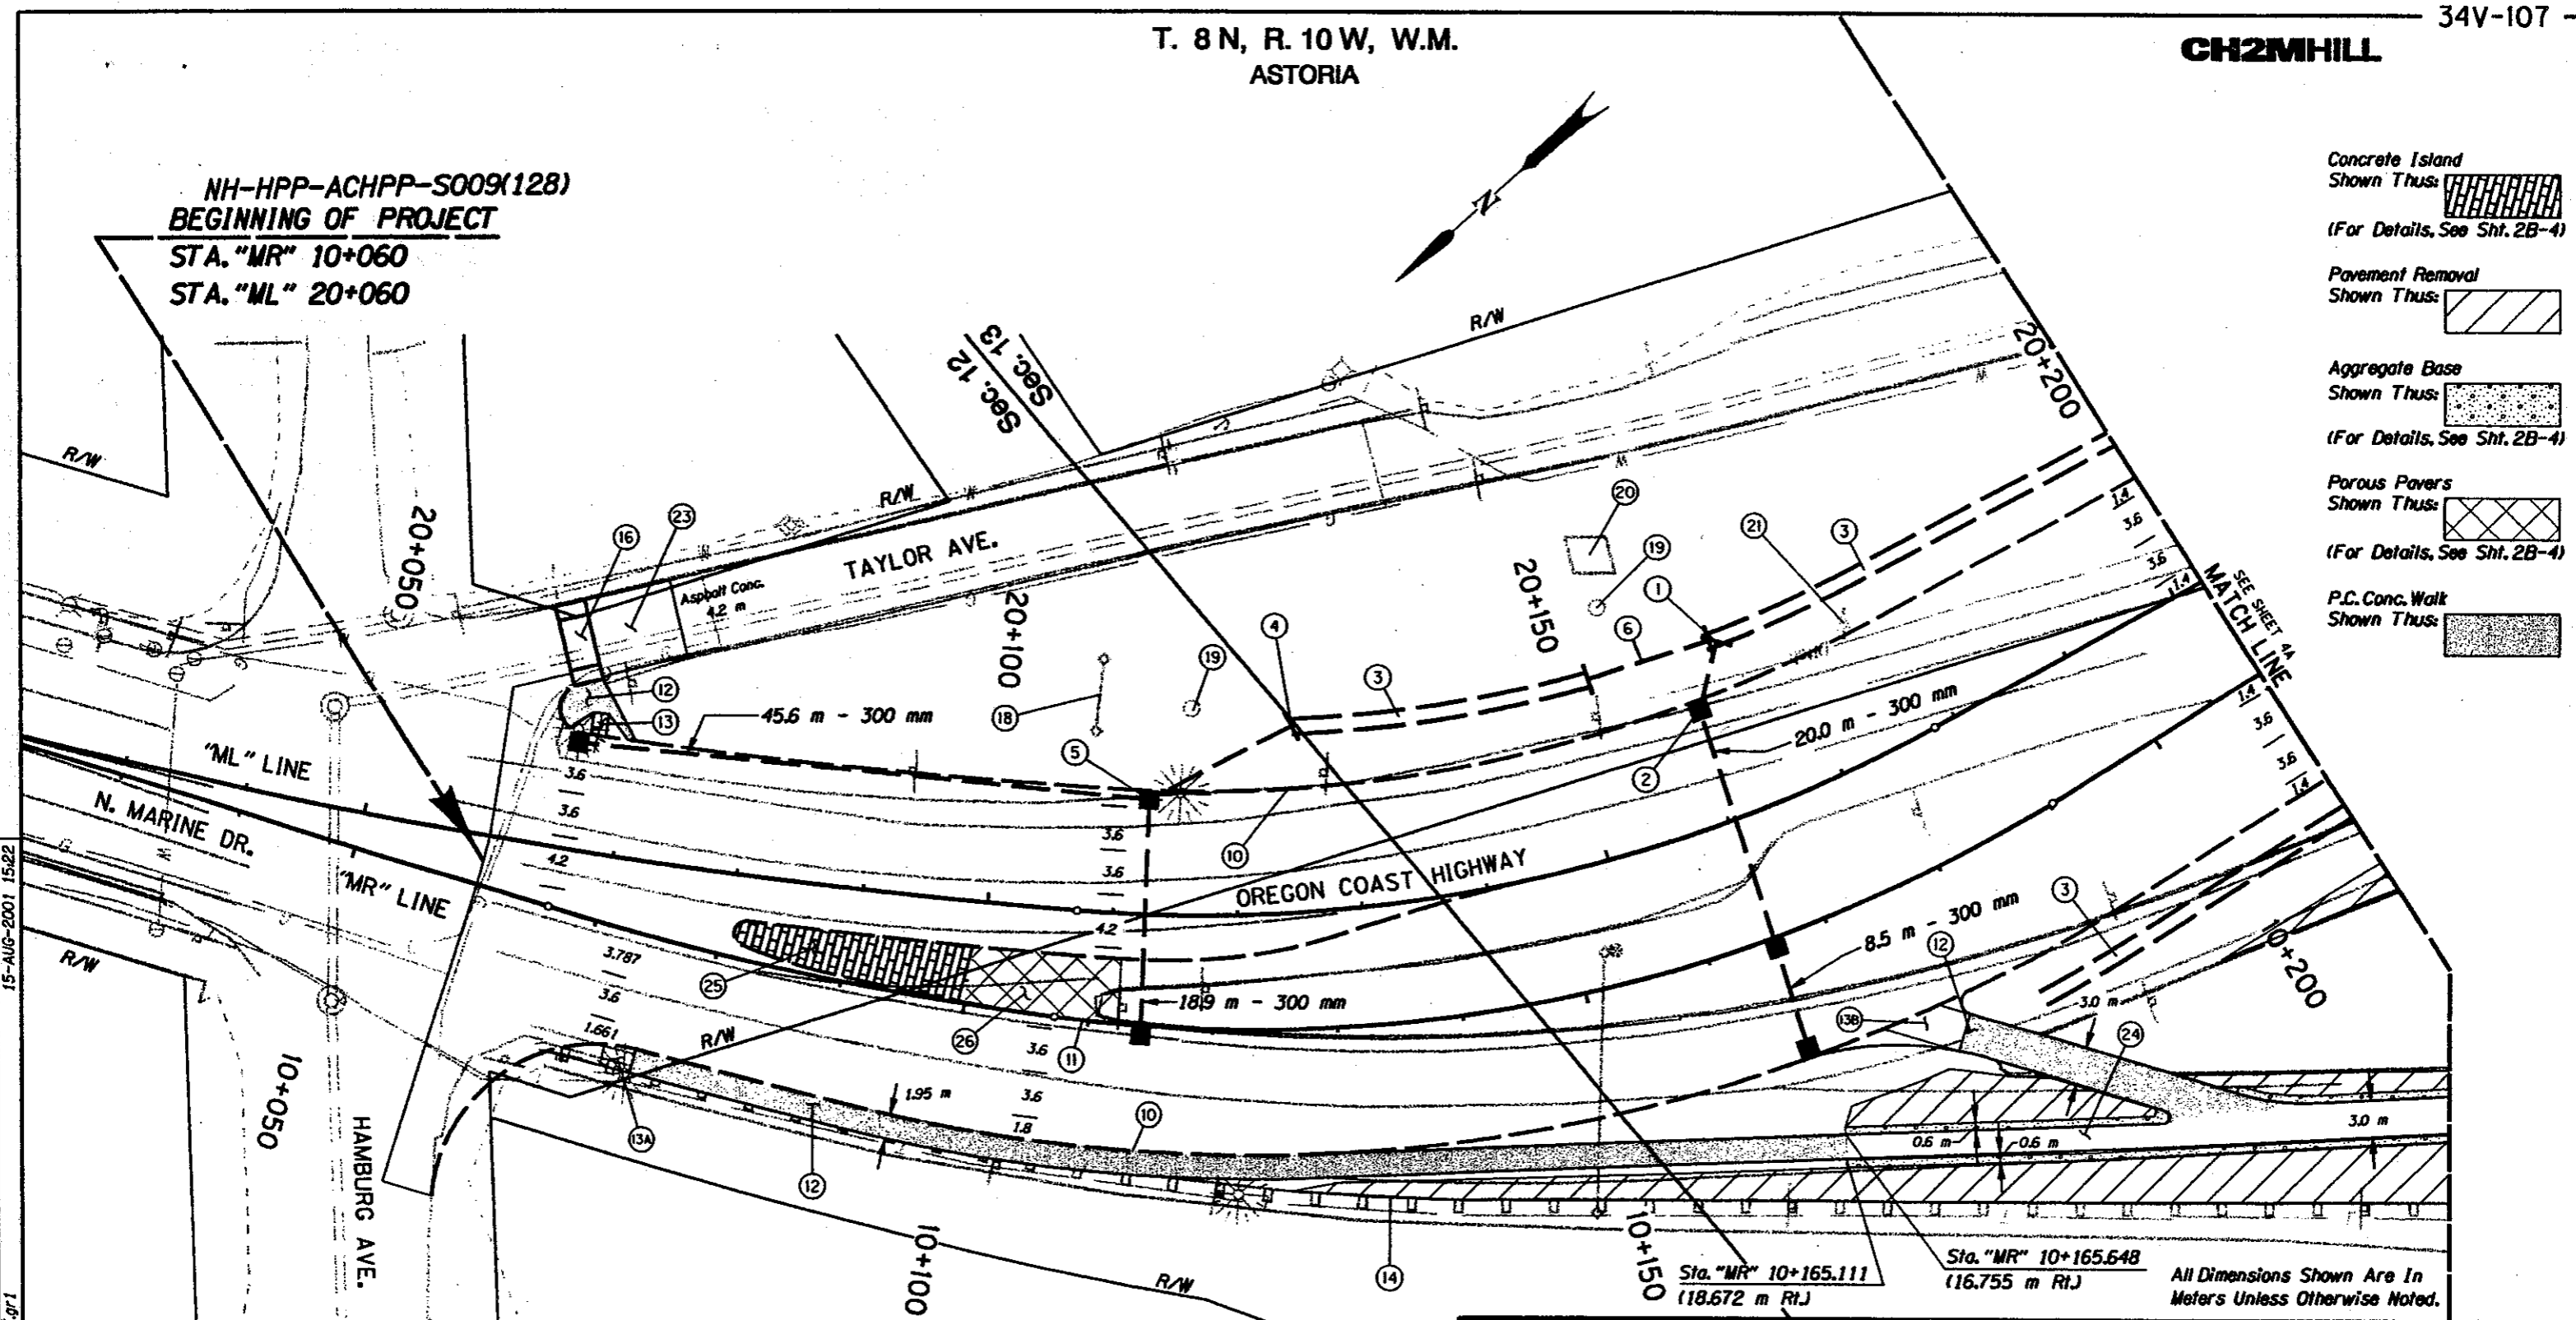

Sta. "MR" 10+165.111 (18.672 m Rt.)
Sta. "MR" 10+165.648 (16.755 m Rt.)

All Dimensions Shown Are In Meters Unless Otherwise Noted.

15-AUG-2001 15:22
C:\User\sjhg\fordr\153739 Astoria\10417.gr1

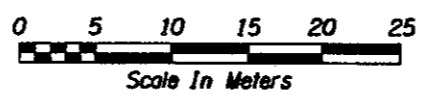

REGISTERED PROFESSIONAL ENGINEER
6260
Timothy G. Yamada
OREGON
NOVEMBER 9, 1999
TIMOTHY G. YAMADA
EXPIRES: 6/30/2002

REGISTERED PROFESSIONAL ENGINEER
16,901
James F. Bauman
OREGON
NOV. 16, 1993
JAMES F. BAUMAN
EXPIRES: 12/31/01

OREGON DEPARTMENT OF TRANSPORTATION
ROADWAY ENGINEERING SECTION

U.S.-101 AT NEHALEM HWY. (ASTORIA) SEC.
OREGON COAST & NEHALEM HWYS.
CLATSOP COUNTY

Designed By - Tim Yamada
Designed By - Kristin Austin
Drafted By - Rob Luke

GENERAL CONSTRUCTION



SHEET NO. 3A

CH2MHILL

- ① Sta. "ML" 20+164.65
Inst. 300 mm Sew. Pipe Outfall - 5.8 m
Trench Exc. - 4.1 m³
Inst. Outlet Basin
(For Details, See Sht. 2B-6)
- ② Sta. "ML" 20+161.03
Const. Type "CG-2" Inlet - 2
Const. Type "G-2" Inlet
Inst. 300 mm Sew. Pipe - 28.5 m
Trench Exc. - 19.7 m³
(See Drg. No. RD336)
- ③ Const. Drainage Swale
(For Details, See Sht. 2B-6)
- ④ Sta. "ML" 20+125.26
Inst. 300 mm Sew. Pipe Outfall - 12.8 m
Trench Exc. - 11.2 m³
Inst. Outlet Basin
(For Details, See Sht. 2B-6)
- ⑤ Sta. "ML" 20+112.60
Const. Type "CG-2" Inlet
Const. Type "G-2" Inlet - 2
Inst. 300 mm Sew. Pipe - 64.5 m
Trench Exc. - 57.4 m³
(See Drg. No. RD336)
- ⑥ Sta. "ML" 20+152.65
Inst. 450 mm Culvert Pipe - 10.0 m
Trench Exc. 9.8 m³
- ⑩ Const. Type "A" Curb
(See Drg. No. RD700)
- ⑪ Const. Type "F" Curb
(See Drg. No. RD700)
- ⑫ Const. P.C. Conc. Walk
- ⑬ Const. Sidewalk Ramp
(See Drg. No. RD725)
- ⑬A Const. Modified Sidewalk Ramp
(For Details, See Sht. 2B-4)
- ⑬B Const. Modified Sidewalk Ramp (Bikeway)
(See Drg. No. RD725, General Note 7)
- ⑭ Sta. "MR" 10+068 To Sta. "MC" 10+453
Remove Extg. Guardrail - 384 m
- ⑯ Const. P.C. Conc. Driveway, Option A
(See Drg. No. 720)
- ⑱ Maintain And Protect Historic Sign
- ⑲ Maintain And Protect Stone Monument - 2
- ⑳ Maintain And Protect Historic Statue
- ㉑ Remove Utility Pole
- ㉒ Const. Asphalt Conc. Connection
(See Drg. No. 715)
- ㉓ Sawcut Extg. Pavement To Maintain 3.0 m
Wide Asphalt Conc. Path.
(For Details, See Sht. 2B-4)
Const. Connection Between P.C. Conc. Walks
And Asphalt Conc. Path As Directed By
Engineer.
- ㉔ Const. Conc. Island - 65 m²
Stamped Conc. Island Surfacing
(For Details, See Sht 2B-4)
- ㉕ Const. Porous Paver System - 60 m²
(For Details, See Sht 2B-4)

15-AUG-2001 15:16

C:\Users\pgriff\ford\153739 Astoria\10417.n1


 <p>REGISTERED PROFESSIONAL ENGINEER 6260 OREGON NOVEMBER 9, 1998 TIMOTHY G. YAMADA EXPIRES: 6/30/2002</p>	 <p>REGISTERED PROFESSIONAL ENGINEER 16,901 OREGON NOV. 16, 1993 JAMES F. BAUMAN EXPIRES: 12/31/01</p>	<p>OREGON DEPARTMENT OF TRANSPORTATION ROADWAY ENGINEERING SECTION</p>	
		<p>U.S.-101 AT NEHALEM HWY. (ASTORIA) SEC. OREGON COAST & NEHALEM HWYS. CLATSOP COUNTY</p>	
		<p>Designed By - Tim Yamada Designed By - Kristin Austin Drafted By - Rob Luke</p>	
		<p>GENERAL CONSTRUCTION</p>	<p>SHEET NO. 3B</p>

NH-HPP-ACHPP-S009(128)

BEGINNING OF PROJECT

STA. "ML" 20+060

"ML" LINE

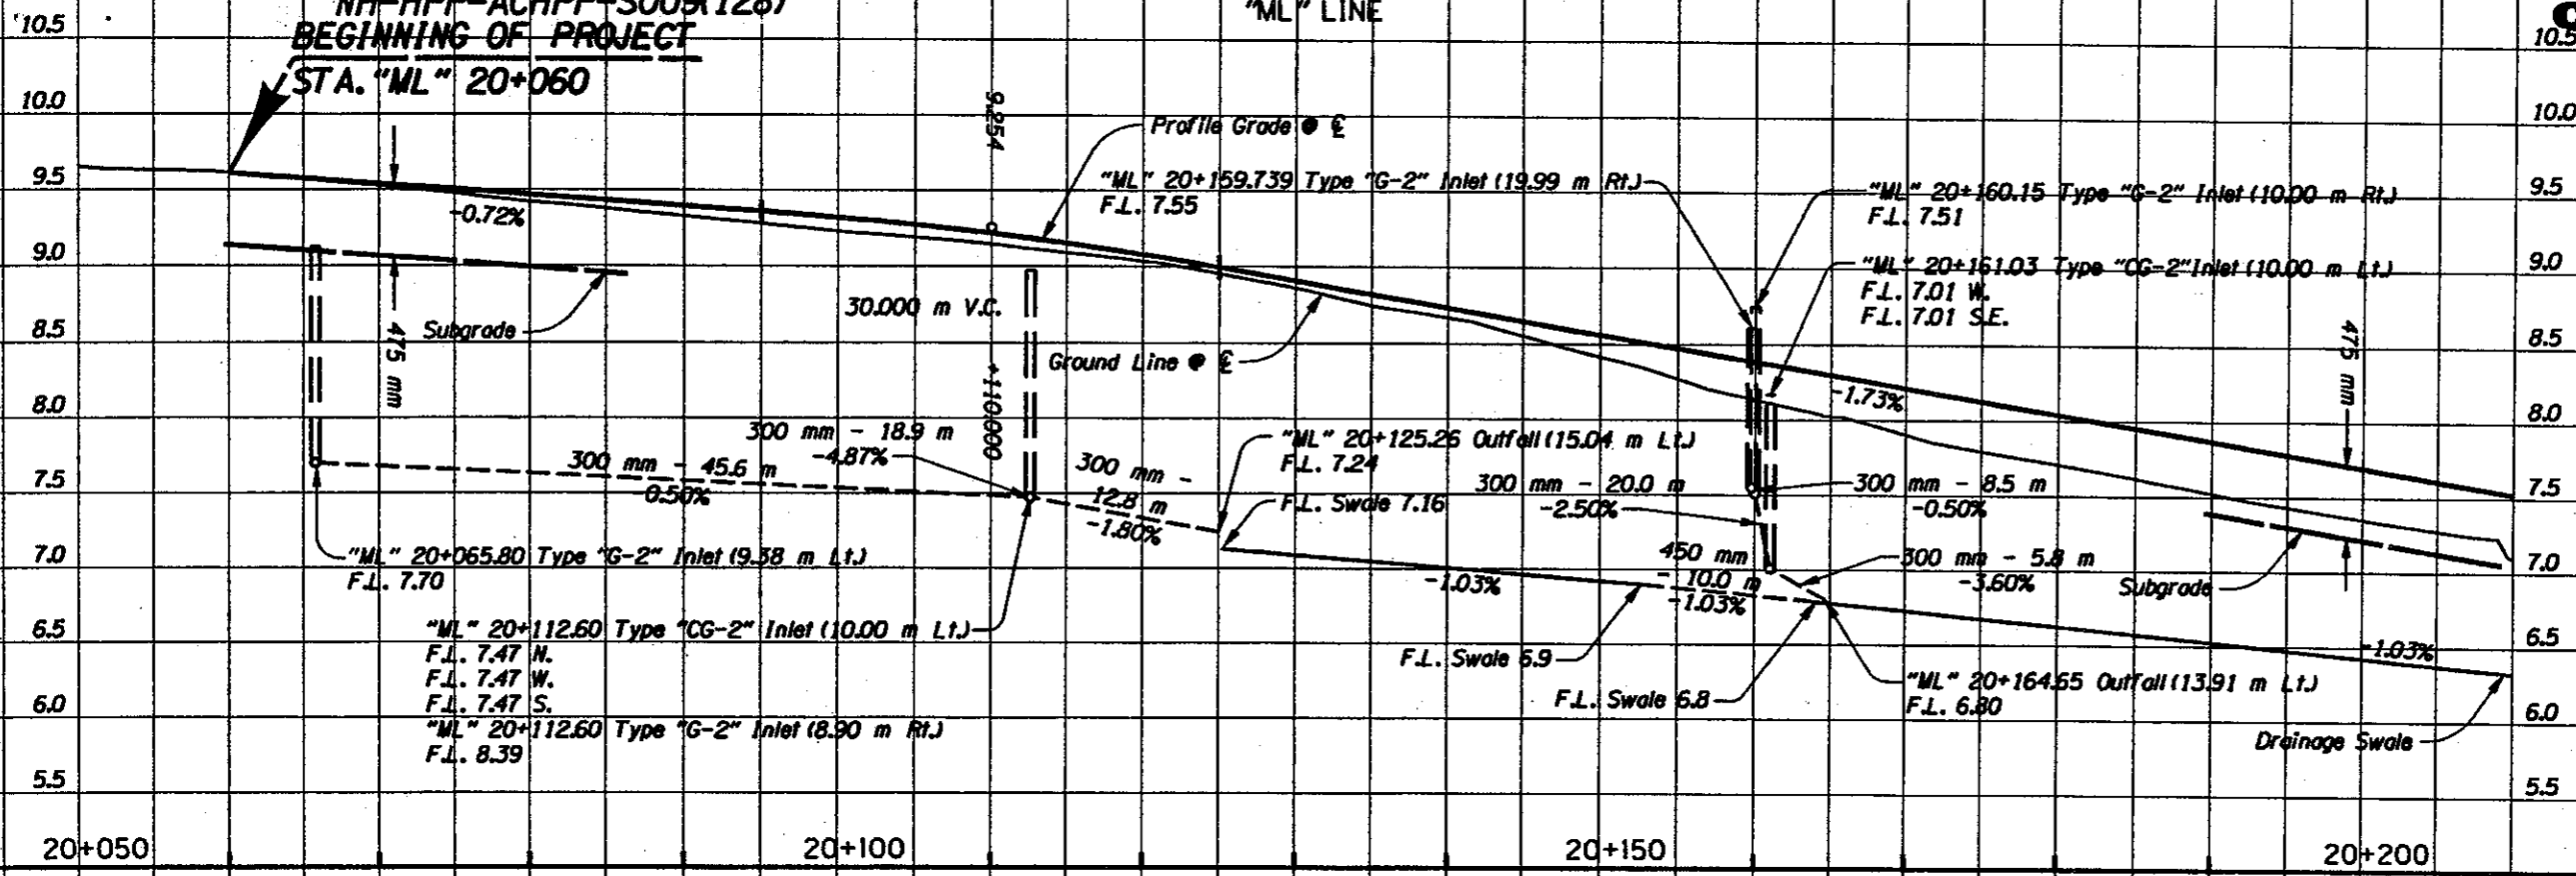


"ML" Line
Earthwork Quantities:
Exc. 590 m³
Emb. 1000 m³
Ditch Exc. 260 m³

BEGINNING OF PROJECT

STA. "MR" 10+060


"MR" LINE

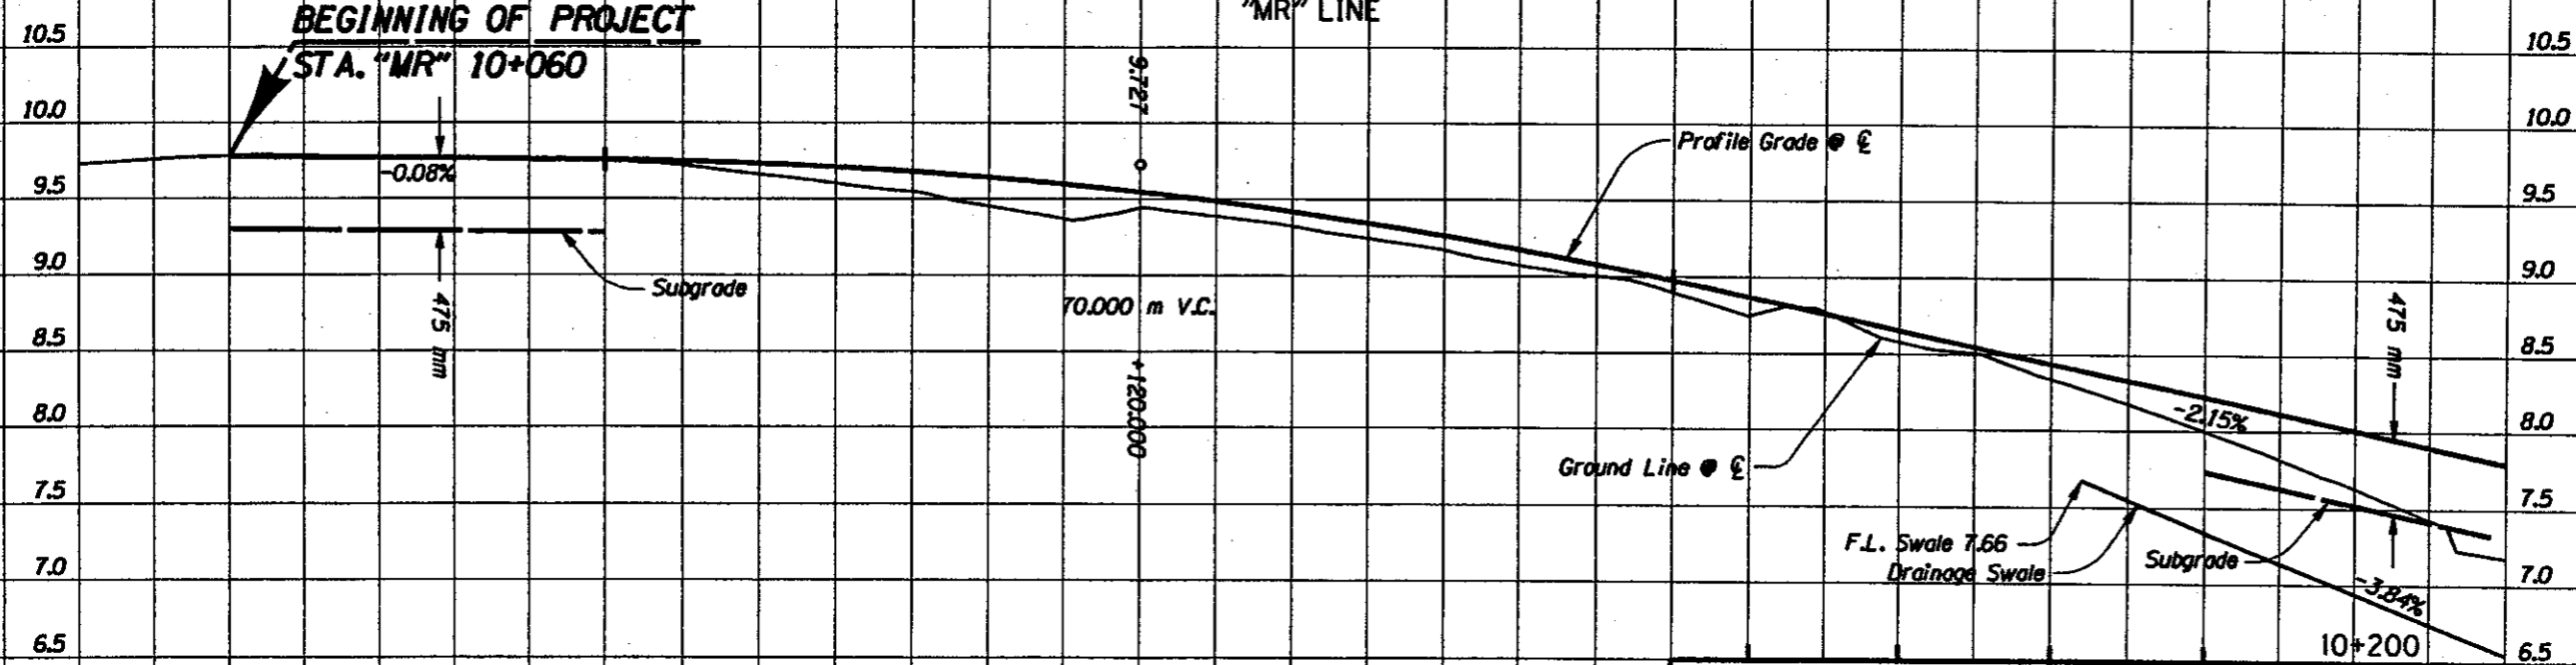

"MR" Line
Earthwork Quantities:
Exc. 1190 m³
Emb. 970 m³
Ditch Exc. 100 m³

All Dimensions Shown Are In Meters Unless Otherwise Noted.

15-AUG-2001 10:43
C:\Users\slightford\Documents\153739 Astoria\10417.dwg

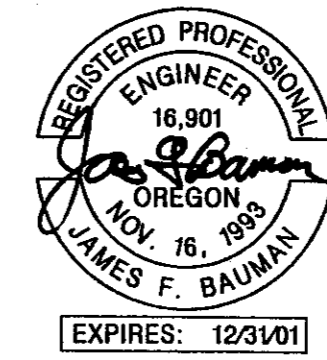


OREGON DEPARTMENT OF TRANSPORTATION
ROADWAY ENGINEERING SECTION

U.S.-101 AT NEHALEM HWY. (ASTORIA) SEC.
OREGON COAST & NEHALEM HWYS.
CLATSOP COUNTY

Designed By - Timothy Yamada
Designed By - Kristin Austin
Drafted By - Rob Luke

PROFILE

SHEET NO.
3C

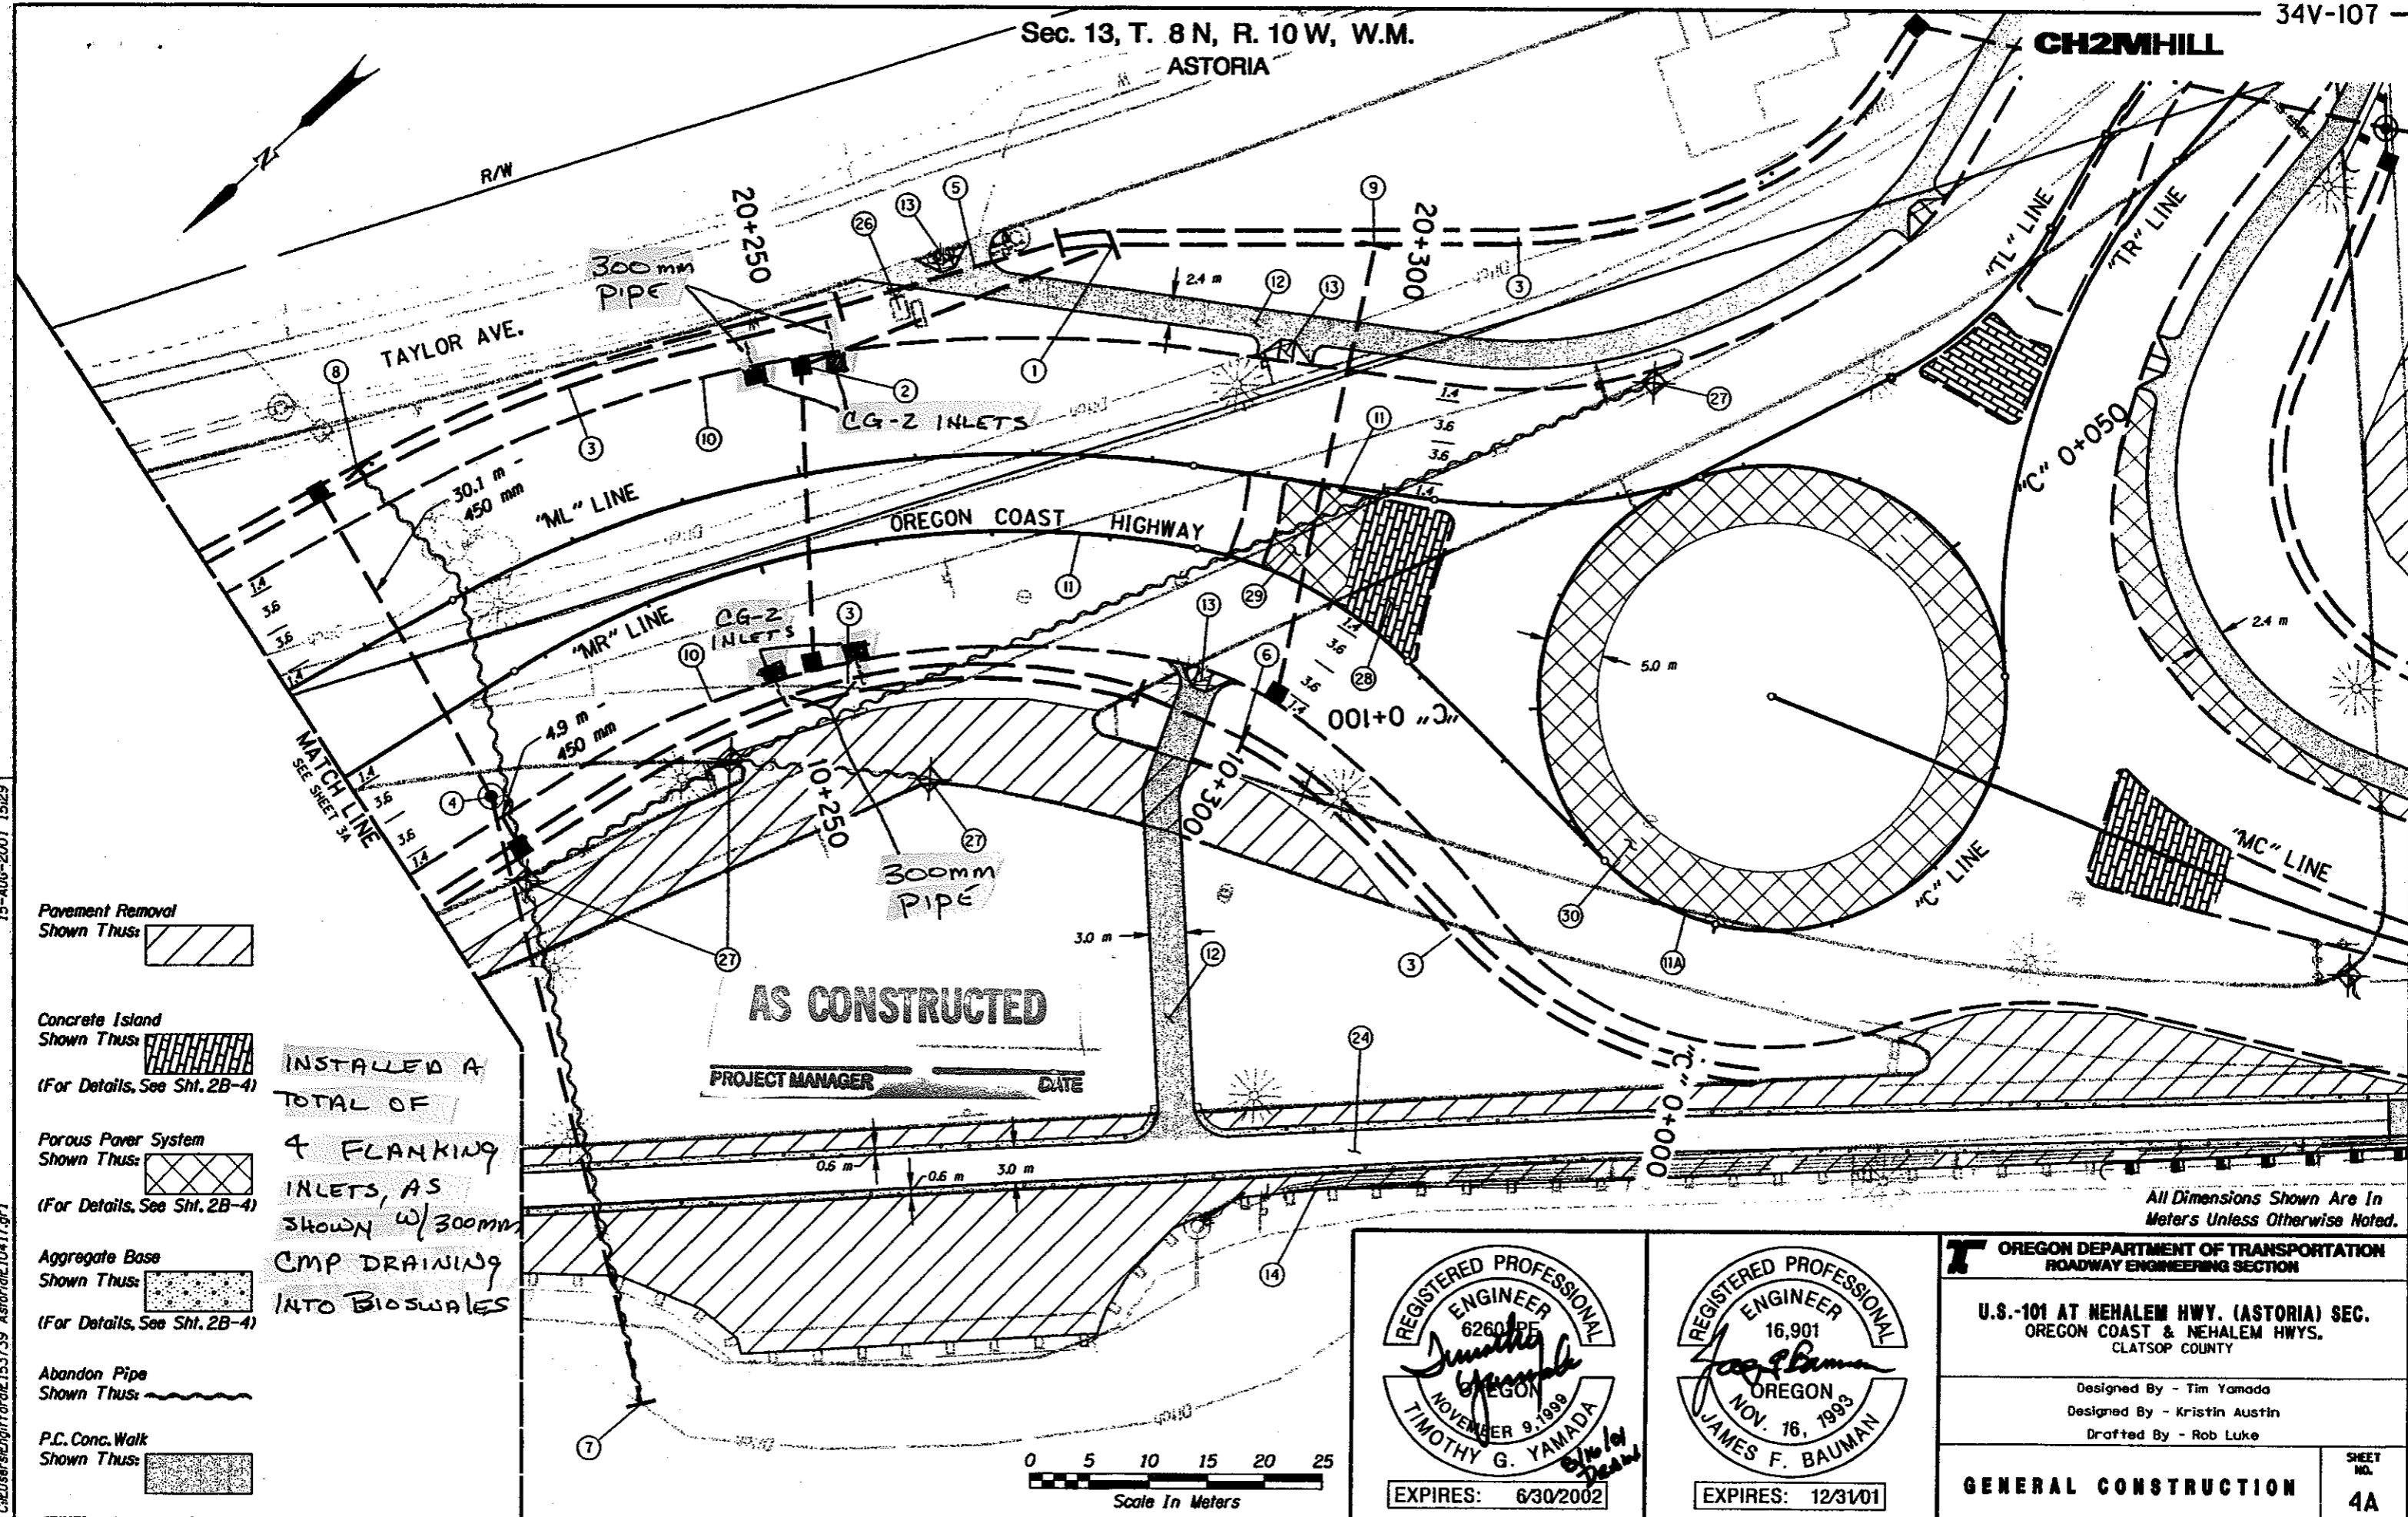


15-AUG-2001 15:23
C:\Users\hgf\ford\153739 Astoria\10417.g1

- Pavement Removal
Shown Thus:
- Concrete Island
Shown Thus:
(For Details, See Sht. 2B-4)
- Porous Paver System
Shown Thus:
(For Details, See Sht. 2B-4)
- Aggregate Base
Shown Thus:
(For Details, See Sht. 2B-4)
- Abandon Pipe
Shown Thus:
- P.C. Conc. Walk
Shown Thus:

INSTALLED A
TOTAL OF
4 FLANKING
INLETS, AS
SHOWN w/ 300mm
CMP DRAINING
INTO BIOSWALES

AS CONSTRUCTED

PROJECT MANAGER _____ DATE _____

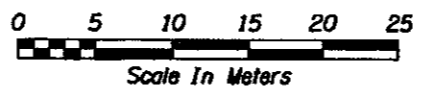

All Dimensions Shown Are In Meters Unless Otherwise Noted.

REGISTERED PROFESSIONAL ENGINEER
6260 PE
Timothy G. Yamada
OREGON
NOVEMBER 9, 1999
TIMOTHY G. YAMADA
EXPIRES: 6/30/2002

REGISTERED PROFESSIONAL ENGINEER
16,901
James F. Bauman
OREGON
NOV. 16, 1993
JAMES F. BAUMAN
EXPIRES: 12/31/01

OREGON DEPARTMENT OF TRANSPORTATION
ROADWAY ENGINEERING SECTION

U.S.-101 AT NEHALEM HWY. (ASTORIA) SEC.
OREGON COAST & NEHALEM HWYS.
CLATSOP COUNTY

Designed By - Tim Yamada
Designed By - Kristin Austin
Drafted By - Rob Luke



GENERAL CONSTRUCTION
SHEET NO. 4A

CH2MHILL

- ① Sta. "ML" 20+275.58
Inst. 450 mm Sew. Pipe Outfall - 28.5 m
Trench Exc. - 23.0 m³
Inst. Outlet Basin
(For Details, See Sht. 2B-6)
- ② Sta. "ML" 20+251.75
Const. Type "CG-2" Inlet - 2
Inst. 300 mm Sew. Pipe - 25.6 m
Trench Exc. - 20.3 m³
- ③ Const. Drainage Swale
(For Details, See Sht. 2B-6)
- ④ Sta. "MR" 10+219.74
Const. Manhole
(See Drg. No. RD327)
Const. Type "D" mod. Inlet - 2
(For Details, See Sht. 2B-4)
Inst. 450 mm Sew. Pipe - 35.0 m
Trench Exc. 29.2 m³
- ⑤ Sta. "ML" 20+255.29
Inst. 300 mm Culvert Pipe - 19.6 m
Trench Exc. - 14.5 m³
- ⑥ Sta. "MR" 10+284.69
Inst. 300 mm Culvert Pipe - 9.8 m
Trench Exc. - 5.9 m³
- ⑦ Sta. "MR" 10+203.11
Inst. 450 mm Sew. Pipe Outfall - 53.5 m
Trench Exc. - 87.6 m³
Inst. Outlet Basin
Remove Extg. Sew. Pipe
(For Details, See Sht. 2B-6)
- ⑧ Sta. "ML" 20+216.95
Cut Extg. Sew. Pipe At Proposed Ditch
I.E. 6.35
Inst. Outlet Basin
(For Details, See Sht. 2B-6)
- ⑨ Sta. "ML" 20+296.17
Inst. 300 mm Sew. Pipe Outfall - 39.5 m
Trench Exc. - 6.5 m³
Inst. Outlet Basin
(For Details, See Sht. 2B-6)
Const. Type "CG-2" Inlet - 1
- ⑩ Const. Type "A" Curb
- ⑪ Const. Type "F" Curb
- ⑪A Const. Type "B" Curb
(See Drg. No. RD700)
- ⑫ Const. P.C. Conc. Walk
- ⑬ Const. Sidewalk Ramp - 3
- ⑭ See Sht. 3B, Note 14
- ⑮ See Sht. 3B, Note 24
- ⑯ Abandon RV Dump Site (By Others)
- ⑰ Remove Inlet - 4
- ⑱ Const. Conc. Island - 84 m²
Stamped Conc. Island Surfacing
(For Details, See Sht 2B-4)
- ⑲ Const. Porous Paver System - 63 m²
- ⑳ Const. Porous Paver System - 550 m²
(For Details, See Sht 2B-4)


15-AUG-2001 15:09

C:\Users\hofford\153739 Astoria\10417.dwg

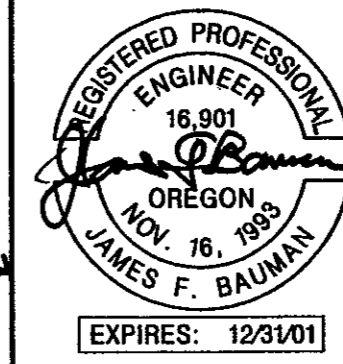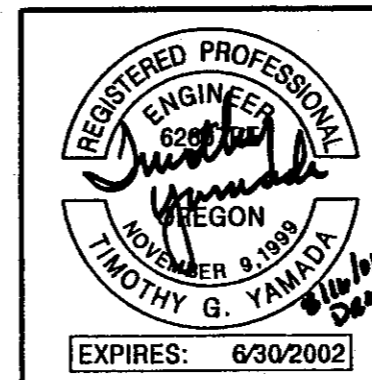


OREGON DEPARTMENT OF TRANSPORTATION ROADWAY ENGINEERING SECTION	
U.S.-101 AT NEHALEM HWY. (ASTORIA) SEC. OREGON COAST & NEHALEM HWYS. CLATSOP COUNTY	
Designed By - Tim Yamada Designed By - Kristin Austin Drafted By - Rob Luke	
GENERAL CONSTRUCTION	SHEET NO. 4B

"ML" LINE

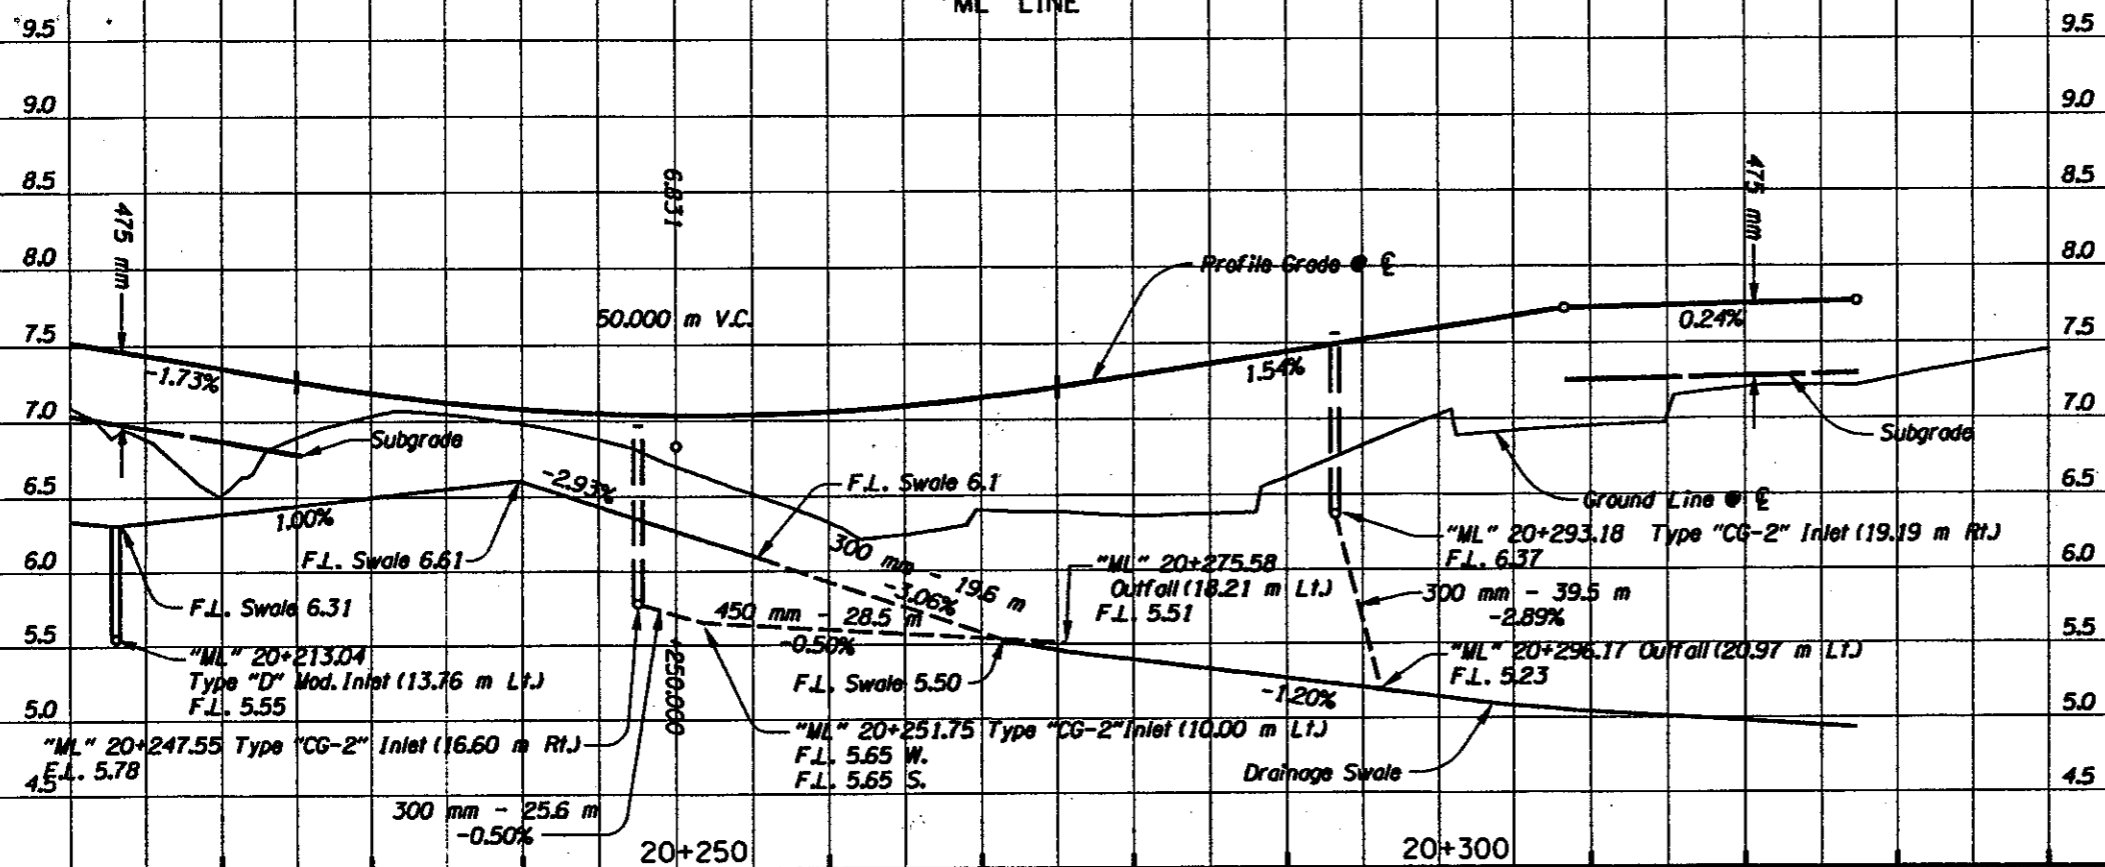


"ML" Line
Earthwork Quantities:
Exc. 490 m³
Emb. 1100 m³
Ditch Exc. 460 m³

"MR" LINE

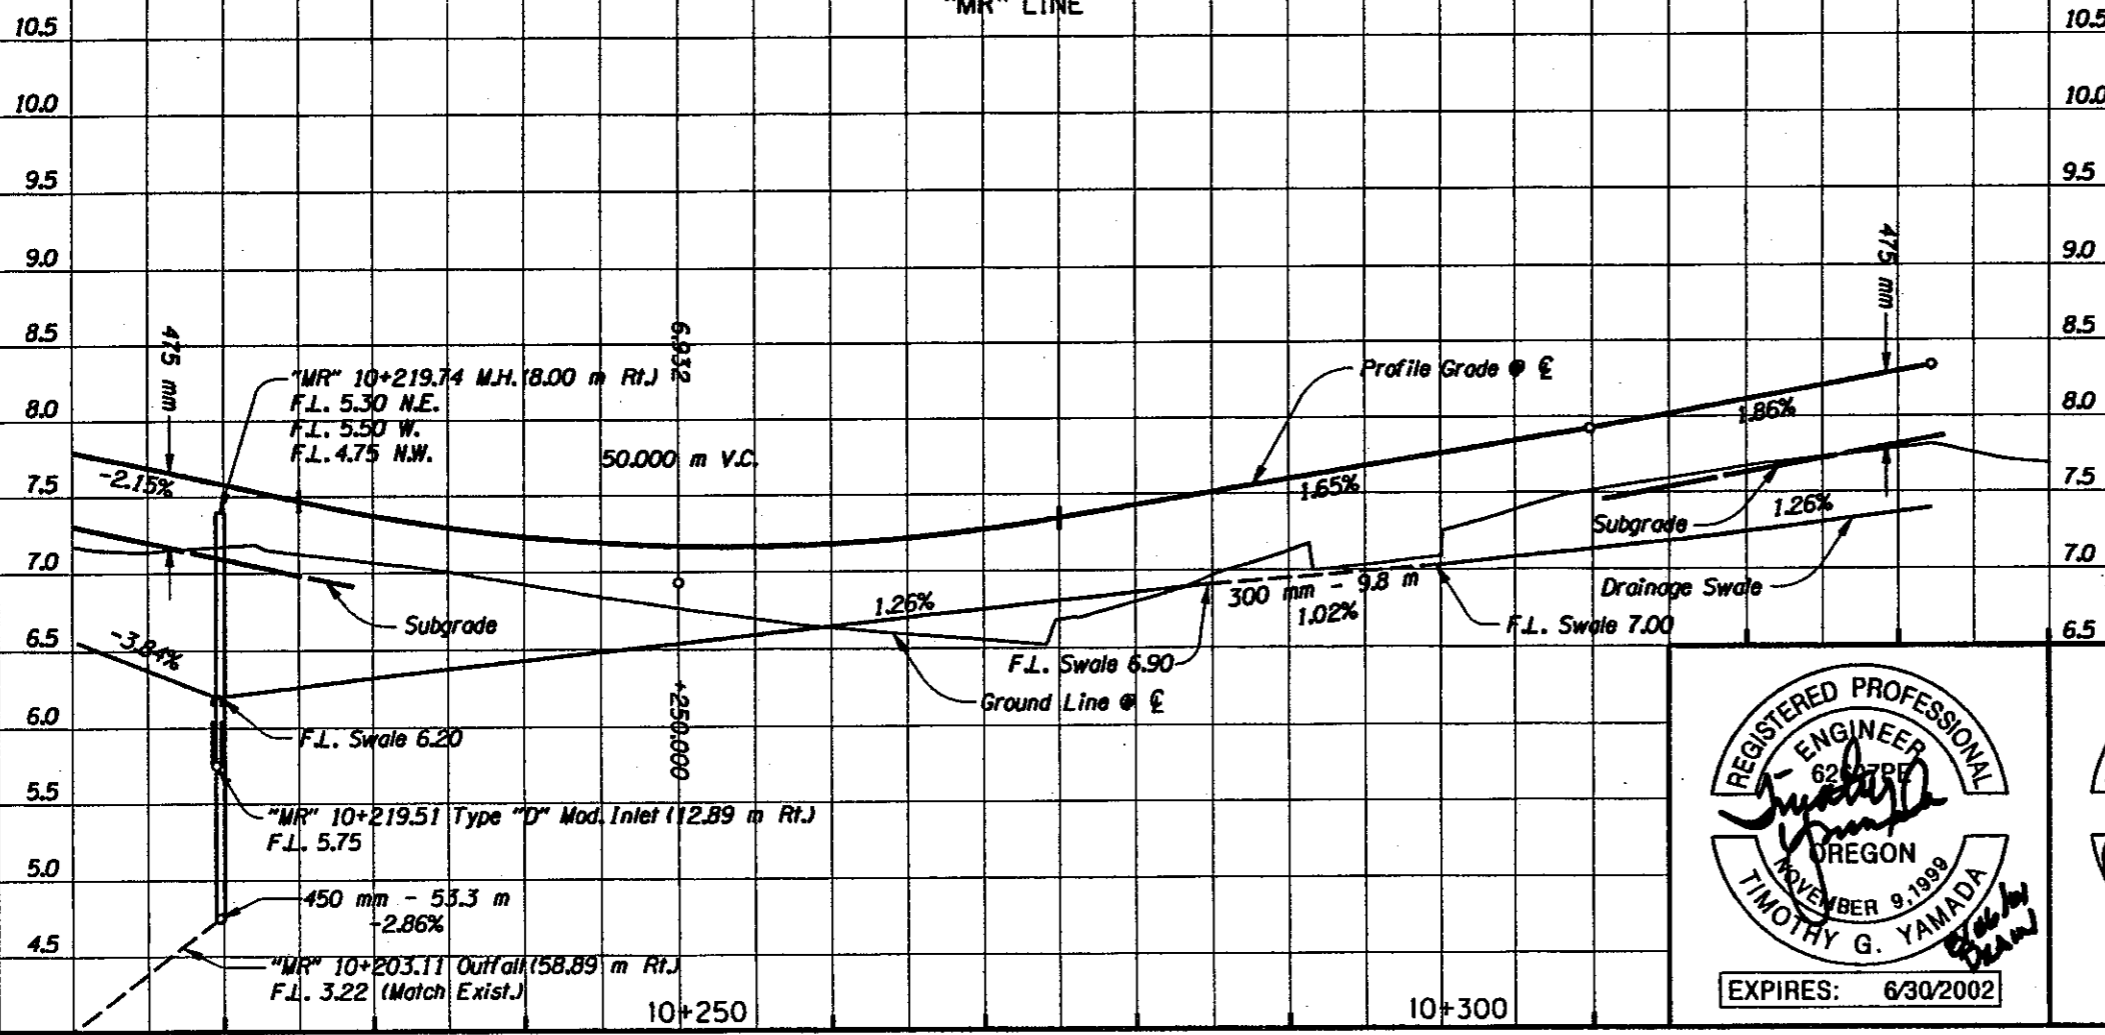

"MR" Line
Earthwork Quantities:
Exc. 520 m³
Emb. 620 m³
Ditch Exc. 390 m³

All Dimensions Shown Are In Meters Unless Otherwise Noted.

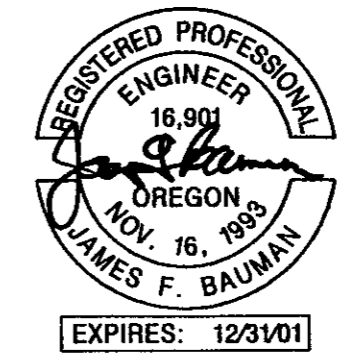

OREGON DEPARTMENT OF TRANSPORTATION
ROADWAY ENGINEERING SECTION


U.S.-101 AT NEHALEM HWY. (ASTORIA) SEC.
OREGON COAST & NEHALEM HWYS.
CLATSOP COUNTY

Designed By - Timothy Yamada
Designed By - Kristin Austin
Drafted By - Rob Luke

PROFILE


SHEET NO.
4C

15-AUG-2001 12:27
C:\Users\ngifford\153739 Astoria\10+17.dwg

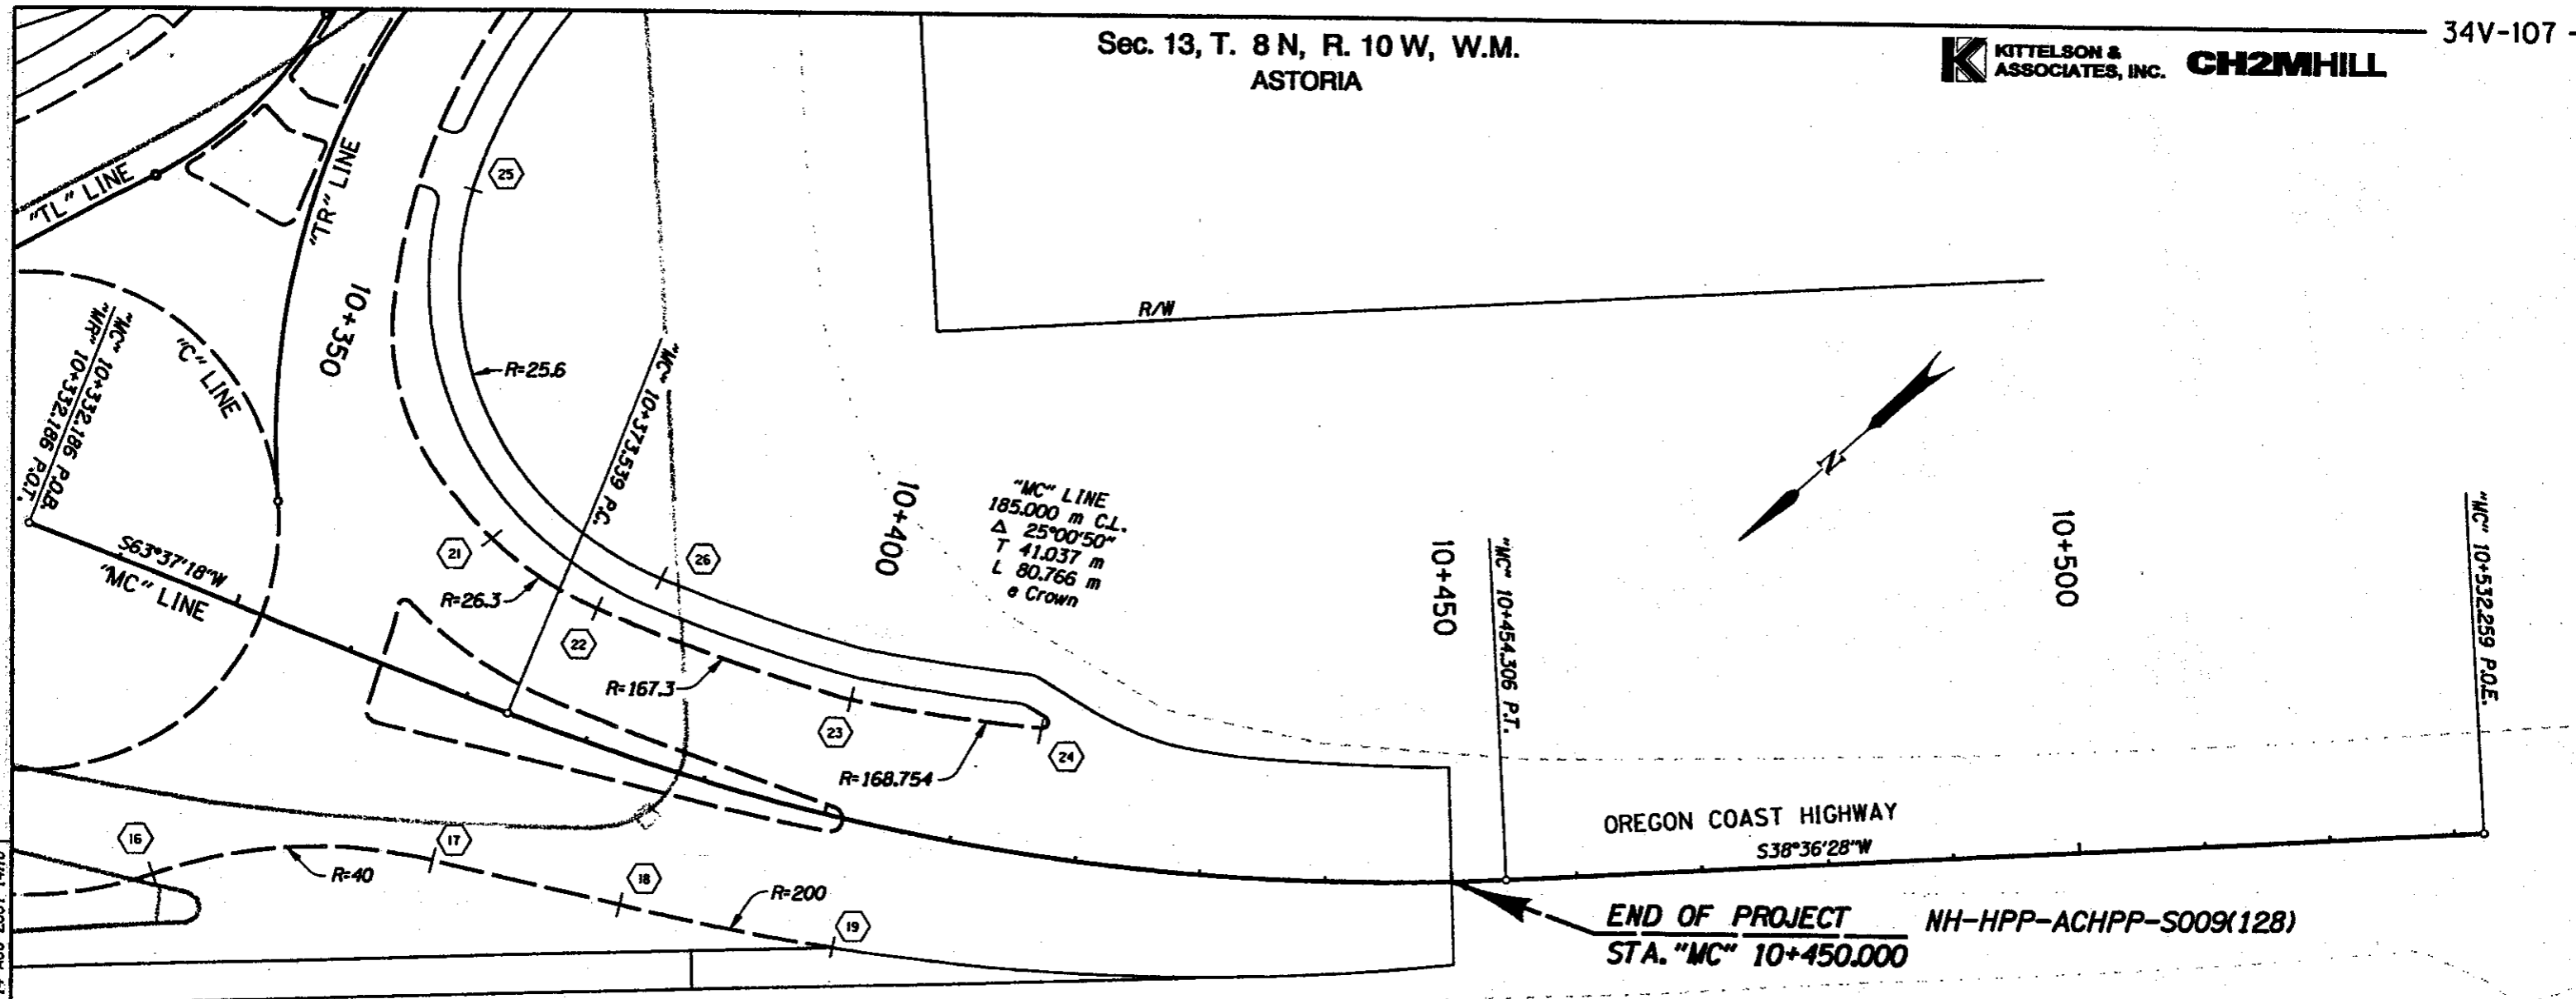


END OF PROJECT NH-HPP-ACHPP-S009(128)
STA. "MC" 10+450.000

Point No.	Station
16	"C" 0+011.374 (10.000 Rt.)
17	"MC" 10+372.423 (13.194 Rt.)
18	"MC" 10+386.636 (11.507 Rt.)
19	"MC" 10+402.993 (10.248 Rt.)
21	"MC" 10+363.364 (14.613 Lt.)
22	"MC" 10+377.070 (10.407 Lt.)
23	"MC" 10+399.805 (9.463 Lt.)
24	"MC" 10+415.681 (10.181 Lt.)
25	"TR" 40+458.805 (11.702 Rt.)
26	"MC" 10+381.358 (14.424 Lt.)

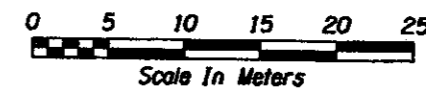

All Dimensions Shown Are In Meters Unless Otherwise Noted.

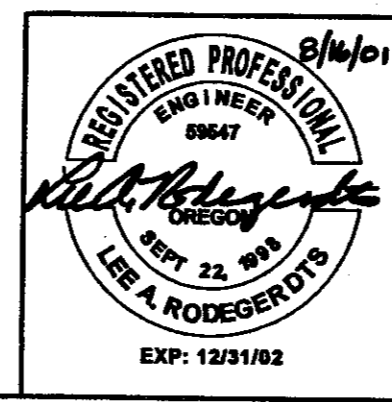

OREGON DEPARTMENT OF TRANSPORTATION
ROADWAY ENGINEERING SECTION

U.S.-101 AT NEHALEM HWY. (ASTORIA) SEC.
OREGON COAST & NEHALEM HWYS.
CLATSOP COUNTY


Designed By - Lee Rodegerdts
Designed By - Kristin Austin
Drafted By - Rob Luke

ALIGNMENT

SHEET NO. 5




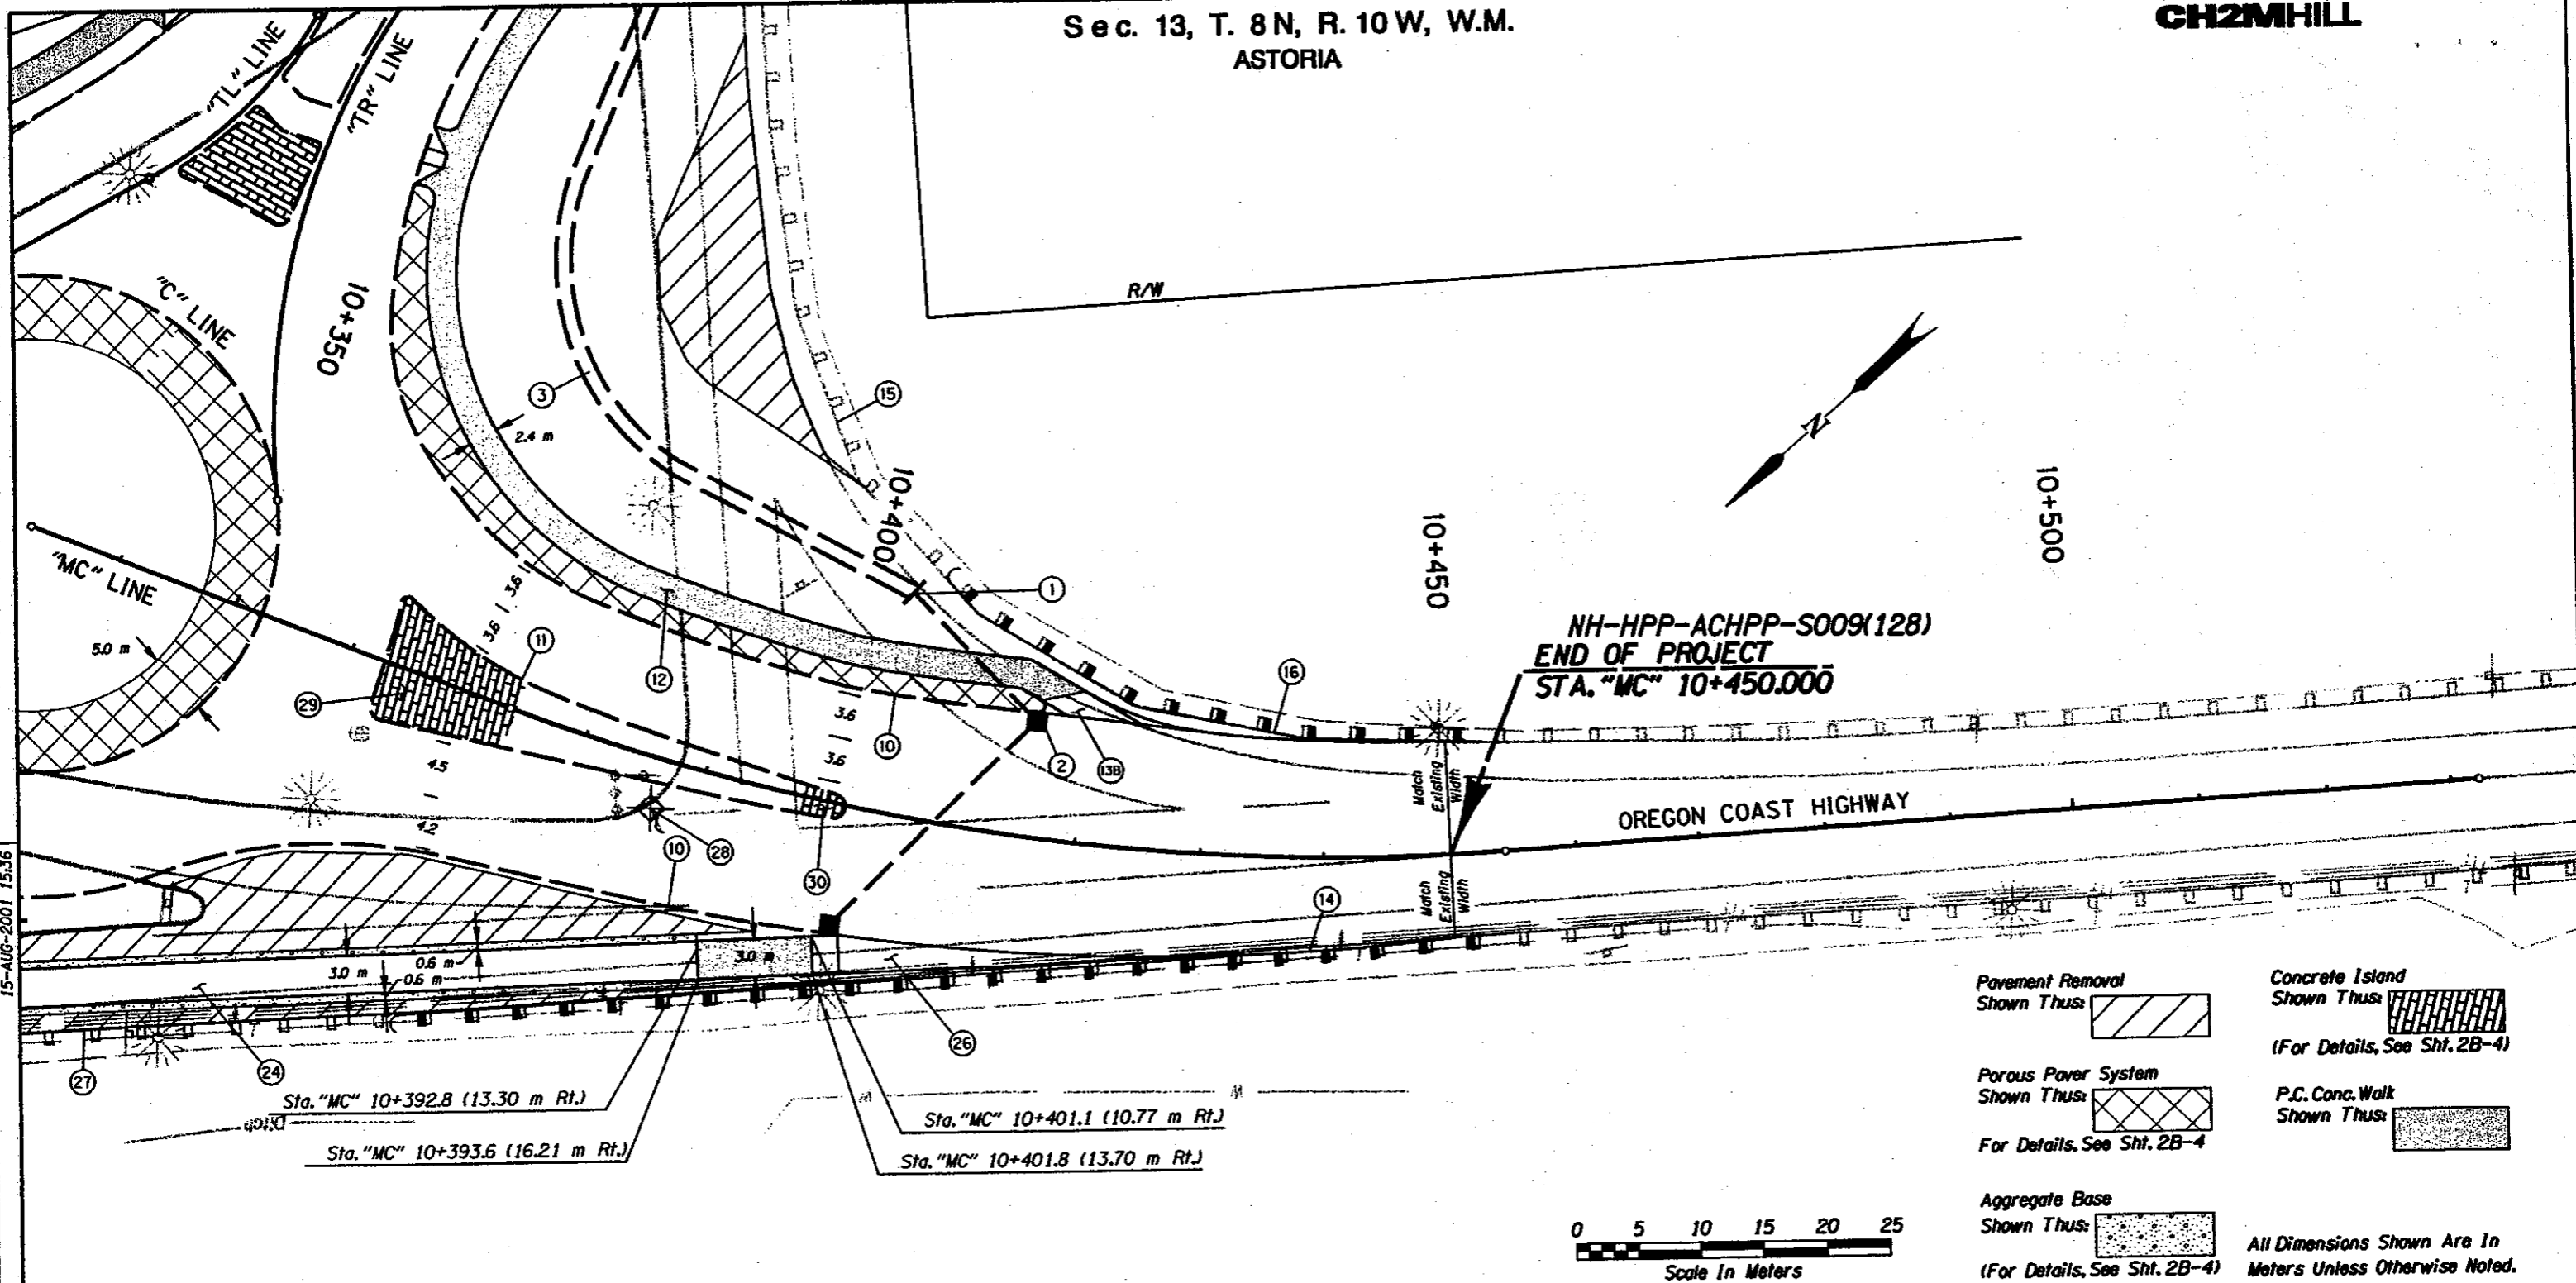

C:\Users\hpifford\Documents\153739 Astoria\10417.dwg 14-AUG-2001 14:18


Sec. 13, T. 8 N, R. 10 W, W.M.
ASTORIA

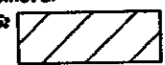

NH-HPP-ACHPP-S009(128)
END OF PROJECT
STA. "MC" 10+450.000

OREGON COAST HIGHWAY

Pavement Removal Shown Thus: 	Concrete Island Shown Thus:  (For Details, See Sht. 2B-4)
Porous Paver System Shown Thus:  For Details, See Sht. 2B-4	P.C. Conc. Walk Shown Thus: 
Aggregate Base Shown Thus:  (For Details, See Sht. 2B-4)	All Dimensions Shown Are In Meters Unless Otherwise Noted.

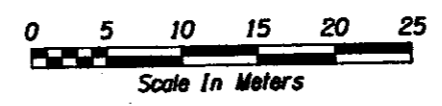

REGISTERED PROFESSIONAL
ENGINEER
6267PE
Timothy G. Yamada
OREGON
NOVEMBER 9, 1998
TIMOTHY G. YAMADA
EXPIRES: 6/30/2002

REGISTERED PROFESSIONAL
ENGINEER
16,901
James F. Bauman
OREGON
NOV. 16, 1993
JAMES F. BAUMAN
EXPIRES: 12/31/01

OREGON DEPARTMENT OF TRANSPORTATION
ROADWAY ENGINEERING SECTION

U.S.-101 AT NEHALEM HWY. (ASTORIA) SEC.
OREGON COAST & NEHALEM HWYS.
CLATSOP COUNTY

Designed By - Tim Yamada
Designed By - Kristin Austin
Drafted By - Rob Luke

GENERAL CONSTRUCTION



SHEET NO. 5A

15-AUG-2001 15:36
C:\Users\hgifford\p153739 Astoria\10417.gr1

- ① Sta. "MC" 10+403.39
Inst. 300 mm Sew. Pipe Outfall - 14.3 m
Trench Exc. - 11.1 m³
Inst. Outlet Basin
(For Details, See Sht. 2B-6)
- ② Sta. "MC" 10+415.68
Const. Type "CG-2" Inlet - 2
Inst. 300 mm Sew. Pipe - 23.3 m
Trench Exc. - 16.7 m³
- ③ Const. Drainage Swale
(For Details, See Sht. 2B-6)
- ⑩ Const. Type "A" Curb
- ⑪ Const. Type "F" Curb
- ⑫ Const. P.C. Conc. Walk
- ⑬ Const. Sidewalk Ramp (Bikeway)
- ⑭ Sta. "MC" 10+373.9 (26.2 Rt.)
To Sta. "MC" 10+453.0 (6.6 Rt.)
Const. Guardrail - 87.63 m (Type 2A)
Const. Anchor (Type 1)
Inst. End Piece (Type B)
Const. Guardrail Connection
(See Drg. No. RD400, RD405, RD415,
RD417, RD440)
- ⑮ Sta. "TL" 30+627 To Sta. "MC" 10+453
Remove Extg. Guardrail - 245 m ±
- ⑯ Sta. "MC" 10+406.4 (19.4 Lt.)
To Sta. "MC" 10+453.0 (8.9 Lt.)
Const. Guardrail - 45.72 m (Type 2A)
Const. Anchor (Type 1)
Inst. End Piece (Type B)
Const. Guardrail Connection
- ⑳ See Sht. 3B, Note 24
- ㉔ Const. Asphalt Ramp
(For Details, See Sht. 2B-4)
- ㉕ See Sht. 3B, Note 14
- ㉖ Remove Inlet
- ㉗ Const. Conc. Island - 87 m²
Stamped Conc. Island Surfacing
(For Details, See Sht 2B-4)
- ㉘ Const. Conc. Island - 8 m²
Stamped Conc. Island Surfacing
(For Details, See Sht 2B-4)

15-AUG-2001 15:03

C:\Users\shgifford\153739 Astoria\10417.dwg

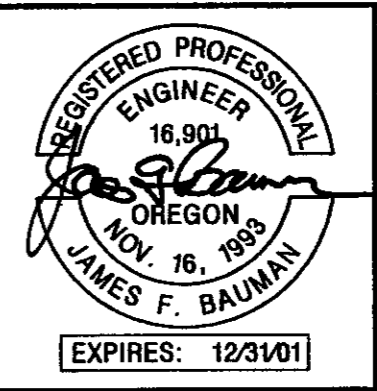
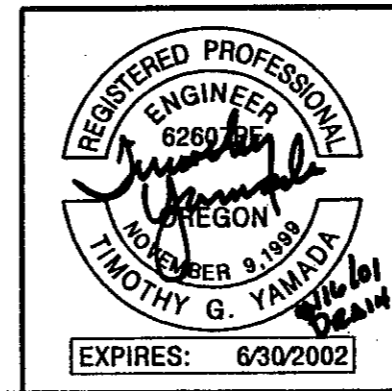


OREGON DEPARTMENT OF TRANSPORTATION ROADWAY ENGINEERING SECTION	
U.S.-101 AT NEHALEM HWY. (ASTORIA) SEC. OREGON COAST & NEHALEM HWYS. CLATSOP COUNTY	
Designed By - Tim Yamada Designed By - Kristin Austin Drafted By - Rob Luke	
GENERAL CONSTRUCTION	SHEET NO. 5B

CH2MHILL

- ① Sta. "TL" 30+499.26
Const. 1200 mm MH w/ Type "G-2" Inlet
Const. 1200 mm MH w/ Type "CG-2" Inlet
Const. Type "G-2" Inlet
Inst. 300 mm Sew. Pipe - 55.3 m
Trench Exc. - 86.1 m³
- ② Sta. "TL" 30+517.72
Const. Manhole
Const. Type "CG-2" Inlet
Inst. 300 mm Sew. Pipe - 49.1 m
Trench Exc. - 67.1 m³
- ③ Sta. "TL" 30+547.99
Const. Manhole
Const. Type "G-2" Inlet - 2
Inst. 300 mm Sew. Pipe - 35.9 m
Trench Exc. - 27.2 m³
- ④ Const. Drainage Swale
(For Details, See Sht. 2B-6)
- ⑤ Sta. "TL" 30+491.30
Const. 1500 mm Manhole
Inst. 300 mm Sew. Pipe - 2.9 m
Inst. 450 mm Sew. Pipe - 52.5
Const. Type "D" Mod. Inlet
Const. Type "D" Inlet
Trench Exc. - 55.0 m³
- ⑥ Sta. "TL" 30+499.33
Inst. 600 mm Sew. Pipe Outfall - 14.1 m
Trench Exc. - 26.2 m³
Inst. Outlet Basin
(For Details, See Sht. 2B-6)
- ⑩ Const. Type "A" Curb
- ⑪ Const. Type "F" Curb
- ⑫ Const. P.C. Conc. Walk
- ⑬ Const. Sidewalk Ramp - 3
- ⑬A Const. Modified Sidewalk Ramp
(For Details, See Sht. 2B-4)
- ⑭ Sta. "TL" 30+486.8 (17.6 Rt.)
To Sta. "TL" 30+640.8 (6.6 Rt.)
Const. Guardrail - 160.02 m (Type 2A)
Const. Anchor (Type 1)
Inst. End Piece (Type B)
- ⑮ Const. Street Connection
- ⑯ Const. P.C. Conc. Driveway, Option A - 4
- ⑰ Relocate Utility Pole
(By Others)
- ⑳ Const. Asphalt Conc. Connection - 4
- ㉑ Remove Inlet
- ㉒ Adjust Inlet - 2
- ㉓ Adjust Valve Box (By City Of Astoria)
- ㉔ Adjust Manhole, Method A -5
(For Details, See Sht. 2B-6)
- ㉕ See Sht. 5B, Note 15
- ㉖ Const. Conc. Island - 57 m²
Stamp Conc. Island Surfacing
(For Details, See Sht 2B-4)
- ㉗ Const. Conc. Island - 3 m²
Stamp Conc. Island Surfacing
(For Details, See Sht 2B-4)

15-AUG-2001 14:57 C:\Users\zhigiffora\153739 Astoria\10417.nfl

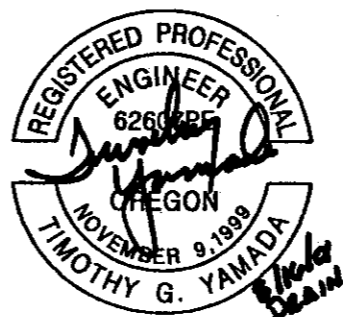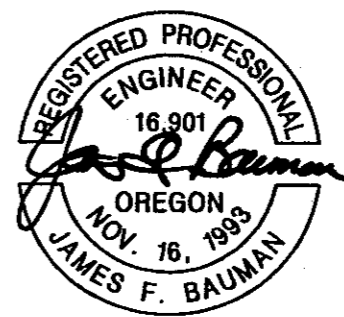 <p>REGISTERED PROFESSIONAL ENGINEER 62602 OREGON NOVEMBER 9, 1999 TIMOTHY G. YAMADA Expires: 6/30/2002</p>	 <p>REGISTERED PROFESSIONAL ENGINEER 16,901 OREGON NOV. 16, 1993 JAMES F. BAUMAN Expires: 12/31/01</p>	<p>OREGON DEPARTMENT OF TRANSPORTATION ROADWAY ENGINEERING SECTION</p> <p>U.S.-101 AT NEHALEM HWY. (ASTORIA) SEC. OREGON COAST & NEHALEM HWYS. CLATSOP COUNTY</p> <p>Designed By - Tim Yamada Designed By - Kristin Austin Drafted By - Rob Luke</p> <p>GENERAL CONSTRUCTION</p>
		<p>SHEET NO. 6B</p>

