

OPERATION & MAINTENANCE MANUAL

DFI No. D00053

**Facility Type: Water Quality Biofiltration
Swale**



DECEMBER, 2011

INDEX

1.	IDENTIFICATION	1
2.	FACILITY CONTACT INFORMATION.....	1
3.	CONSTRUCTION.....	1
4.	STORM DRAIN SYSTEM AND FACILITY OVERVIEW	1
5.	FACILITY HAZ MAT SPILL FEATURE(S).....	4
6.	AUXILIARY OUTLET (HIGH FLOW BYPASS)	4
7.	MAINTENANCE REQUIREMENTS	4
8.	WASTE MATERIAL HANDLING	5

APPENDIX A: Operational Plan and Profile Drawing(s)

APPENDIX B: ODOT Project Plan Sheets

1. Identification

Drainage Facility ID (DFI): **D00053**
Facility Type: Water Quality Biofiltration Swale
Construction Drawings: (V-File Number) 34V-107
Location: District: 1
Highway No.: 009
Mile Post: 4.29 / 4.32 (beg./end)
Description: This facility is located on the western side of the southbound lane of the US 101 (Hwy 009). Access may be obtained directly from the right shoulder of the southbound travel lane.

2. Facility Contact Information

Contact the Engineer of Record, Region Technical Center, or Geo-Environmental's Senior Hydraulics Engineer for:

- Operational clarification
- Maintenance clarification
- Repair or restoration assistance

Engineering Contacts:

Region Technical Center Hydro

Or

Geo-Environmental Senior Hydraulics Engineer (503) 986-3365.

3. Construction

Engineer of Record: ODOT Designers: Region 2 Tech. Center, T. Yamada, K. Austin, 503-986-2990

Facility construction: 2001
Contractor: NB Hatch Company

4. Storm Drain System and Facility Overview

A water quality swale is a flat-bottomed open channel designed to treat stormwater runoff from highway pavement areas. This type of facility is lined with grass. Treatment by trapping sedimentation occurs when stormwater runoff flows through the grass.

This facility is located in the northwest corner of the intersection of US 101 (Hwy 009-Oregon Coast Hwy.) and OR 202 (Hwy 102 – Nehalem Hwy.). This is a round-a-bout configured intersection where access may be obtained from the right shoulder of SB US 101. Access may be obtained directly from the right shoulder of the southbound travel lane when rounding the round-a-bout, heading south.

The drainage area for this swale includes the paved surfaces of US 101 (Hwy 009) and the stormwater sheet-flow runoff, flowing toward the swale. There is no inlet piping for this swale. After the stormwater is treated through this facility it is discharged into a downstream swale facility (DFI D00054) through a 12-inch culvert; see Point A on the Operational Plan, Appendix A and Photos 1 and 2. The 12-inch culvert conveys the water underneath a 10-foot wide concrete sidewalk.

A. Maintenance equipment access:

This is a round-a-bout configured intersection where access may be obtained from the right shoulder of SB US 101. Access may be obtained directly from the right shoulder of the southbound travel lane when rounding the round-a-bout, heading south.

B. Heavy equipment access into facility:

- Allowed (no limitations)
- Allowed (with limitations)
- Not allowed

C. Special Features:

- Amended Soils
- Porous Pavers
- Liners
- Underdrains



Photo 1: The swale looking east towards US 101. The swale outlet is a 12-inch culvert pipe.



Photo 2: Swale outlet which is a 12-inch culvert that discharges in DFI D00054.

5. Facility Haz Mat Spill Feature(s)

The water quality biofiltration swale can be used to store a volume of liquid by blocking the 12-inch diameter outlet pipe located at the outlet of the swale. This pipe is noted as point A on the Operational Plan, Appendix A.

6. Auxiliary Outlet (High Flow Bypass)

Auxiliary Outlets are provided if the primary outlet control structure can not safely pass the projected high flows. Broad-crested spillway weirs and over flow risers are the two most common auxiliary outlets used in stormwater treatment facility design. The auxiliary outlet feature is either a part of the facility or an additional storm drain feature/structure.

The auxiliary outlet feature for this facility is:

Designed into facility

The auxiliary outlet is included in the design of the swale by including deeper channels and pipes connecting to adjacent swales. By linking the swales, stormwater can flow into neighboring facilities and slow down while undergoing treatment.

Other, as noted below

7. Maintenance Requirements

Routine maintenance table for non-proprietary stormwater treatment and storage/detention facilities have been incorporated into ODOT's Maintenance Guide. These tables summarize the maintenance requirements for ponds, swales, filter strips, bioslopes, and detention tanks and vaults. Special maintenance requirements in addition to the routine requirements are noted below when applicable.

The ODOT Maintenance Guide can be viewed at the following website:

<http://www.oregon.gov/ODOT/HWY/OOM/MGuide.shtml>

Maintenance requirements for proprietary structures, such as underground water quality manholes and/or vaults with filter media are noted in Appendix C when applicable.

The following stormwater facility maintenance table (See ODOT Maintenance Guide) should be used to maintain the facility outlined in this Operation and Maintenance Manual or follow the Maintenance requirements outlined in Appendix C when proprietary structure is selected below:

- Table 1 (general maintenance)
- Table 2 (stormwater ponds)
- Table 3 (water quality biofiltration swales)
- Table 4 (water quality filter strips)
- Table 5 (water quality bioslopes)
- Table 6 (detention tank)
- Table 7 (detention vault)
- Appendix C (proprietary structure)
- Special Maintenance requirements:

Note: Special maintenance Requirements Require Concurrence from ODOT SR Hydraulics Engineer.

8. Waste Material Handling

Material removed from the facility is defined as waste by DEQ. Refer to the roadwaste section of the ODOT Maintenance Yard Environmental Management System (EMS) Policy and Procedures Manual for disposal options: <http://egov.oregon.gov/ODOT/HWY/OOM/EMS.shtml>


Contact any of the following for more detailed information about management of waste materials found on site:

ODOT Clean Water Unit	(503) 986-3008
ODOT Statewide Hazmat Coordinator	(503) 229-5129
ODOT Region Hazmat Coordinator	(503) 986-2647
ODEQ Northwest Region Office	(503) 229-5263

Appendix A

Content:

- **Operational Plan and Profile Drawing(s)**

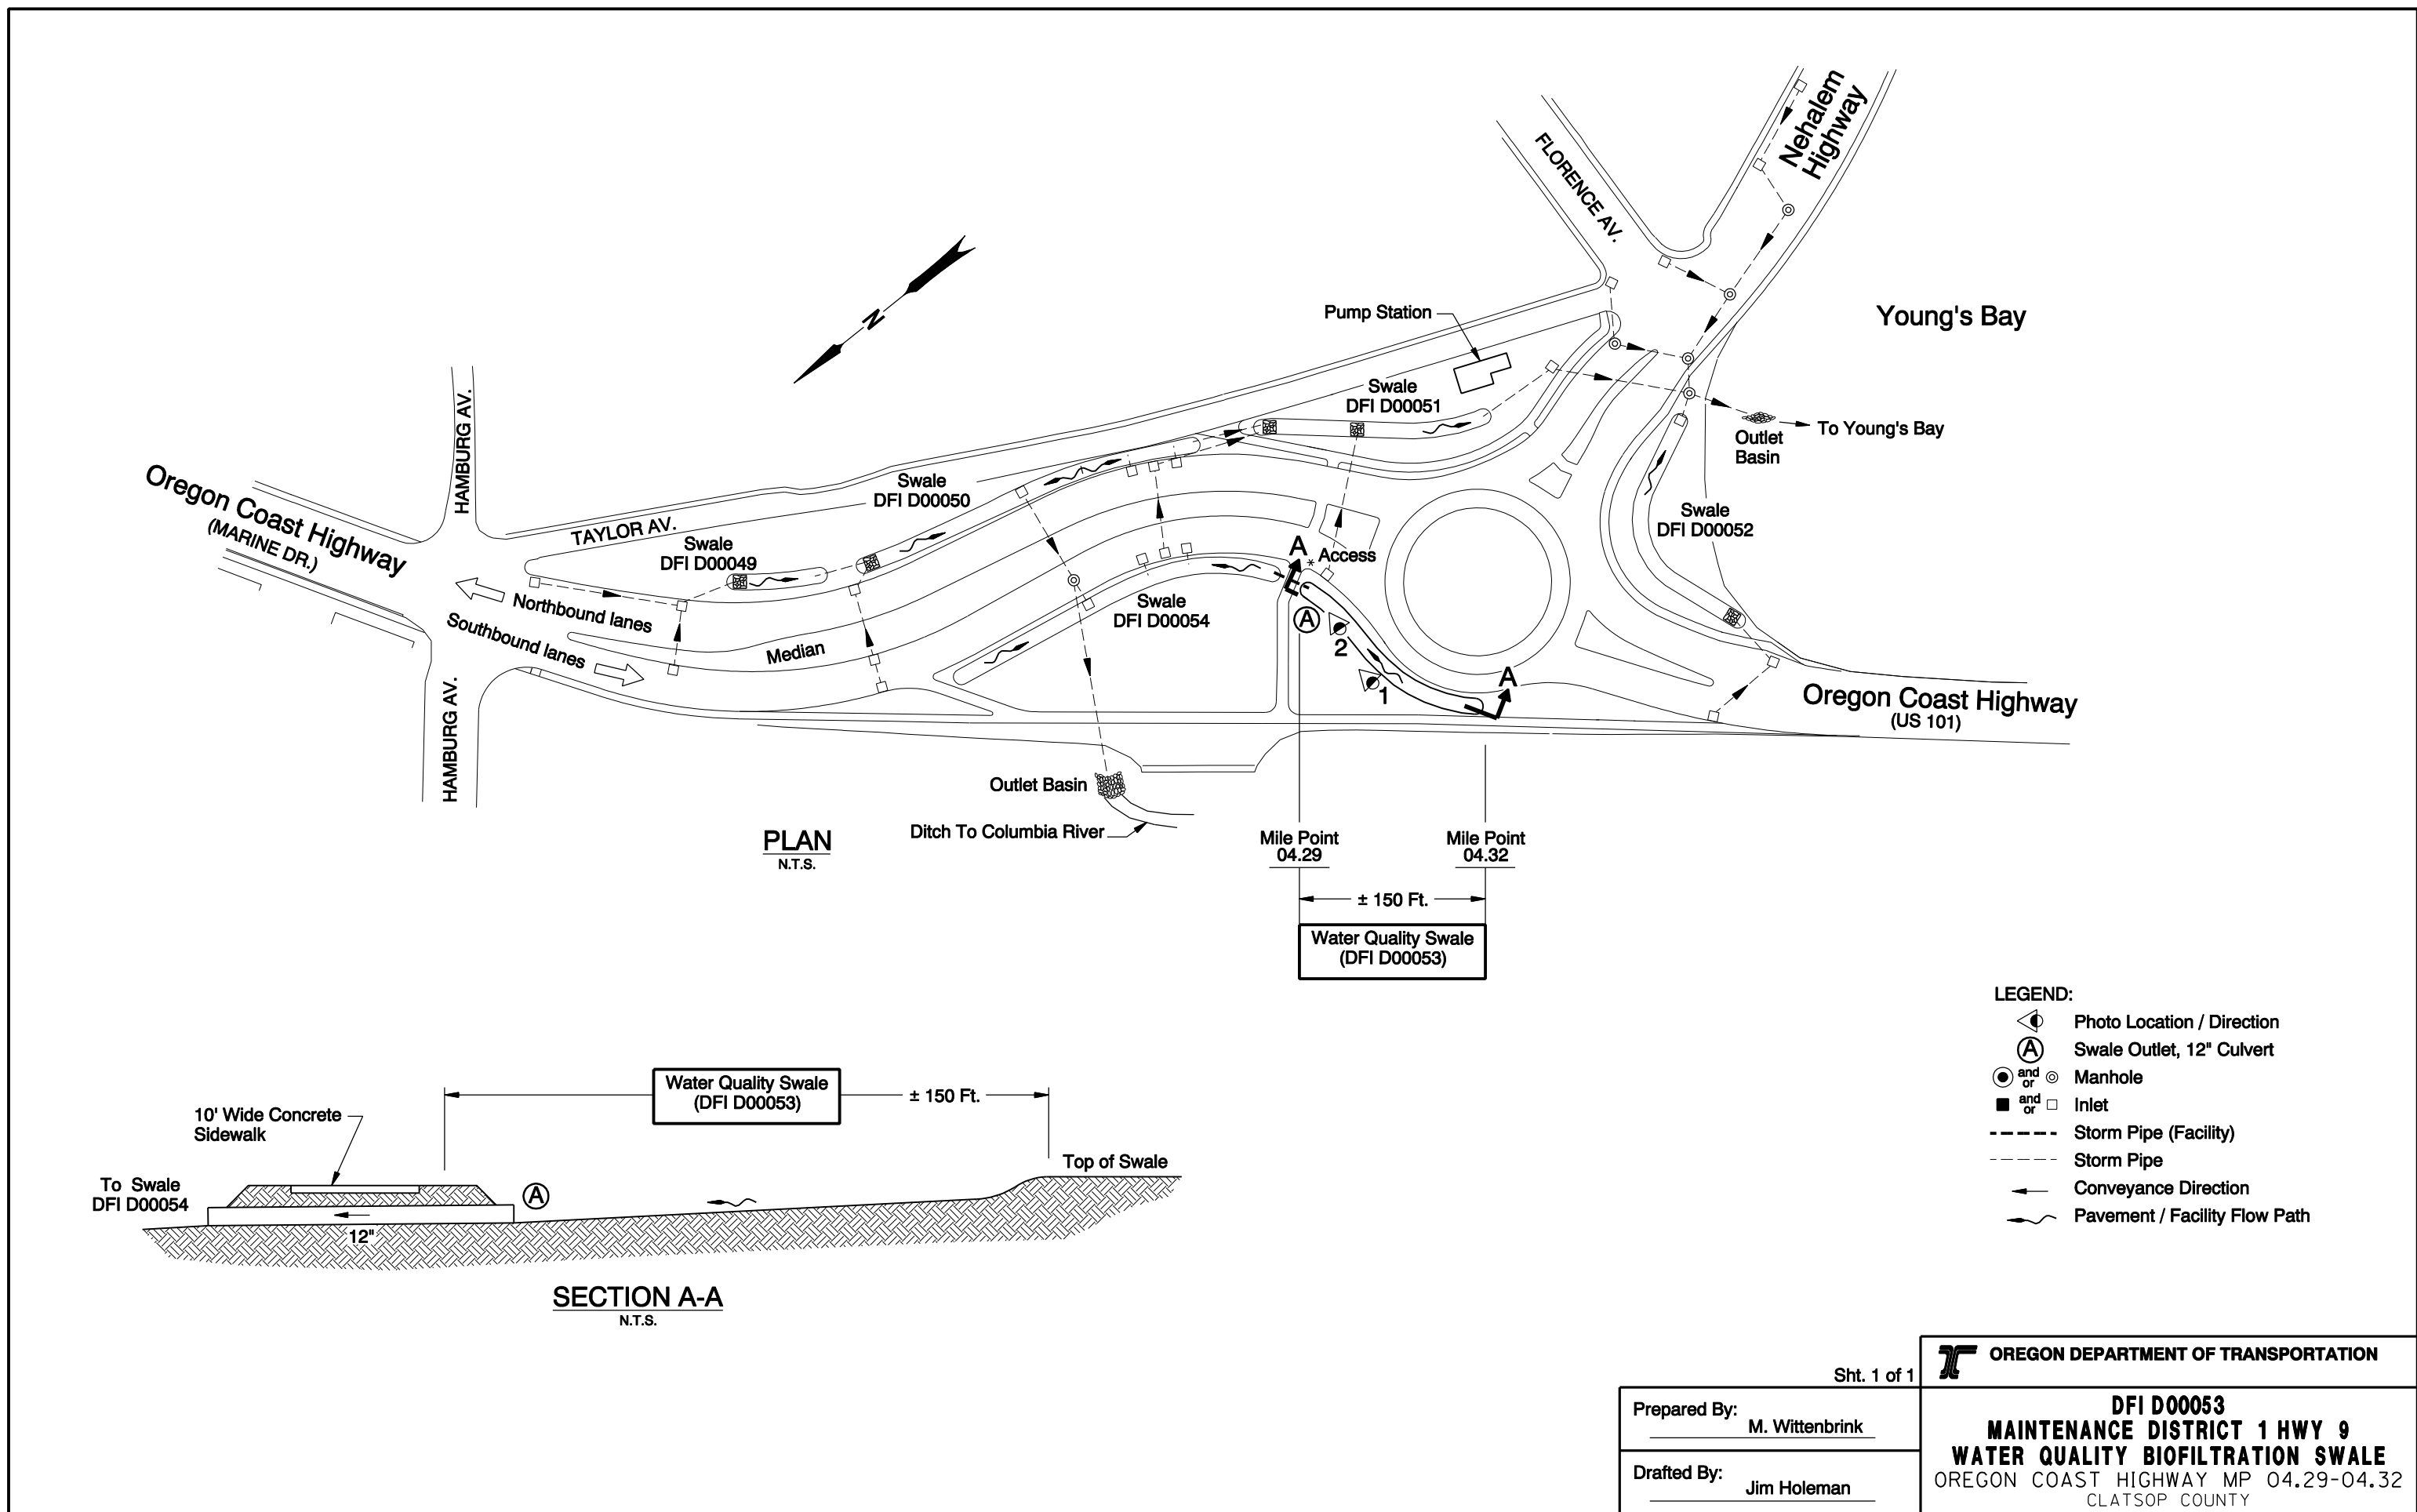

Sht. 1 of 1

OREGON DEPARTMENT OF TRANSPORTATION

Prepared By: M. Wittenbrink

Drafted By: Jim Holeman

DFI D00053
MAINTENANCE DISTRICT 1 HWY 9
WATER QUALITY BIOFILTRATION SWALE
 OREGON COAST HIGHWAY MP 04.29-04.32
 CLATSOP COUNTY

Appendix B


Content:

- **ODOT Project Plan Sheets**
 - *Cover/Title Sheet*
 - *Water Quality/Detention Plan Sheets*
 - *Other Details*

STATE OF OREGON
DEPARTMENT OF TRANSPORTATION

PLANS FOR PROPOSED PROJECT

GRADING, PAVING, & SIGNING
**US-101 AT NEHALEM HWY.
(ASTORIA) SEC.**
OREGON COAST & NEHALEM HWYS.
CLATSOP COUNTY
OCTOBER 2001

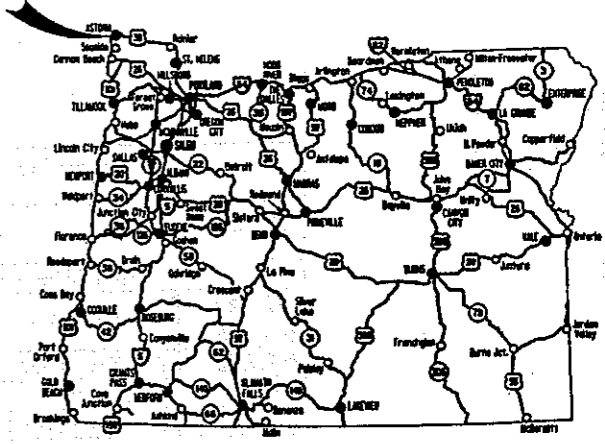

Overall Length Of Project - 0.61 km (0.38 Mile)

INDEX OF SHEETS	
SHEET NO.	DESCRIPTION
1	Title Sheet
1A	Index Of Sheets Cont'd. & Standard Drawing Nos.
2, 2A, 2A-2	Typical Sections
2B Thru 2B-6 Incl.	Details
2C	Traffic Control Detour & Details
2C-2 Thru 2C-21 Incl.	Traffic Control Plans
2D, 2D-2	Erosion Control Details
2D-3 Thru 2D-4 Incl.	Erosion Control Plans
2E	Pipe Data
3	"ML", "MR" Line Alignment
3A, 3B	General Construction
3C	"ML", "MR" Line Profile
4	"ML", "MR", "MC", "C", "TL", "TR" Line Alignment
4A, 4B	General Construction
4C	"ML", "MR" Line Profile
4D	"C" Line Profile
5	"MC", "TL", "TR" Line Alignment
5A, 5B	General Construction
5C	"MC" Line Profile
6	"TL", "TR" Line Alignment
6A, 6B	General Construction
6C	"TL", "TR" Line Profile
7	"TL" Line Alignment
7A, 7B	General Construction
7C	"TL" Line Profile



ATTENTION :
Oregon Law Requires You To Follow Rules Adopted By The Oregon Utility Notification Center. Those Rules Are Set Forth In OAR 952-001-0010 Through OAR 952-001-0030. You May Obtain Copies Of The Rules From The Center, Or Answers To Questions About The Rules By Calling (503) 232-1987.

LET'S ALL
WORK TOGETHER
TO MAKE THIS
JOB SAFE

NH-HPP-ACHPP-S009(128)
BEGINNING OF PROJECT
STA. 'MR' 10 + 060

END OF PROJECT NH-HPP-ACHPP-S009(128)
STA. 'MR' 10 + 450

NH-HPP-ACHPP-S009(128)
END OF PROJECT
STA. 'TL' 30 + 640

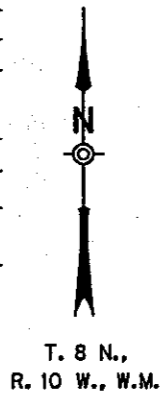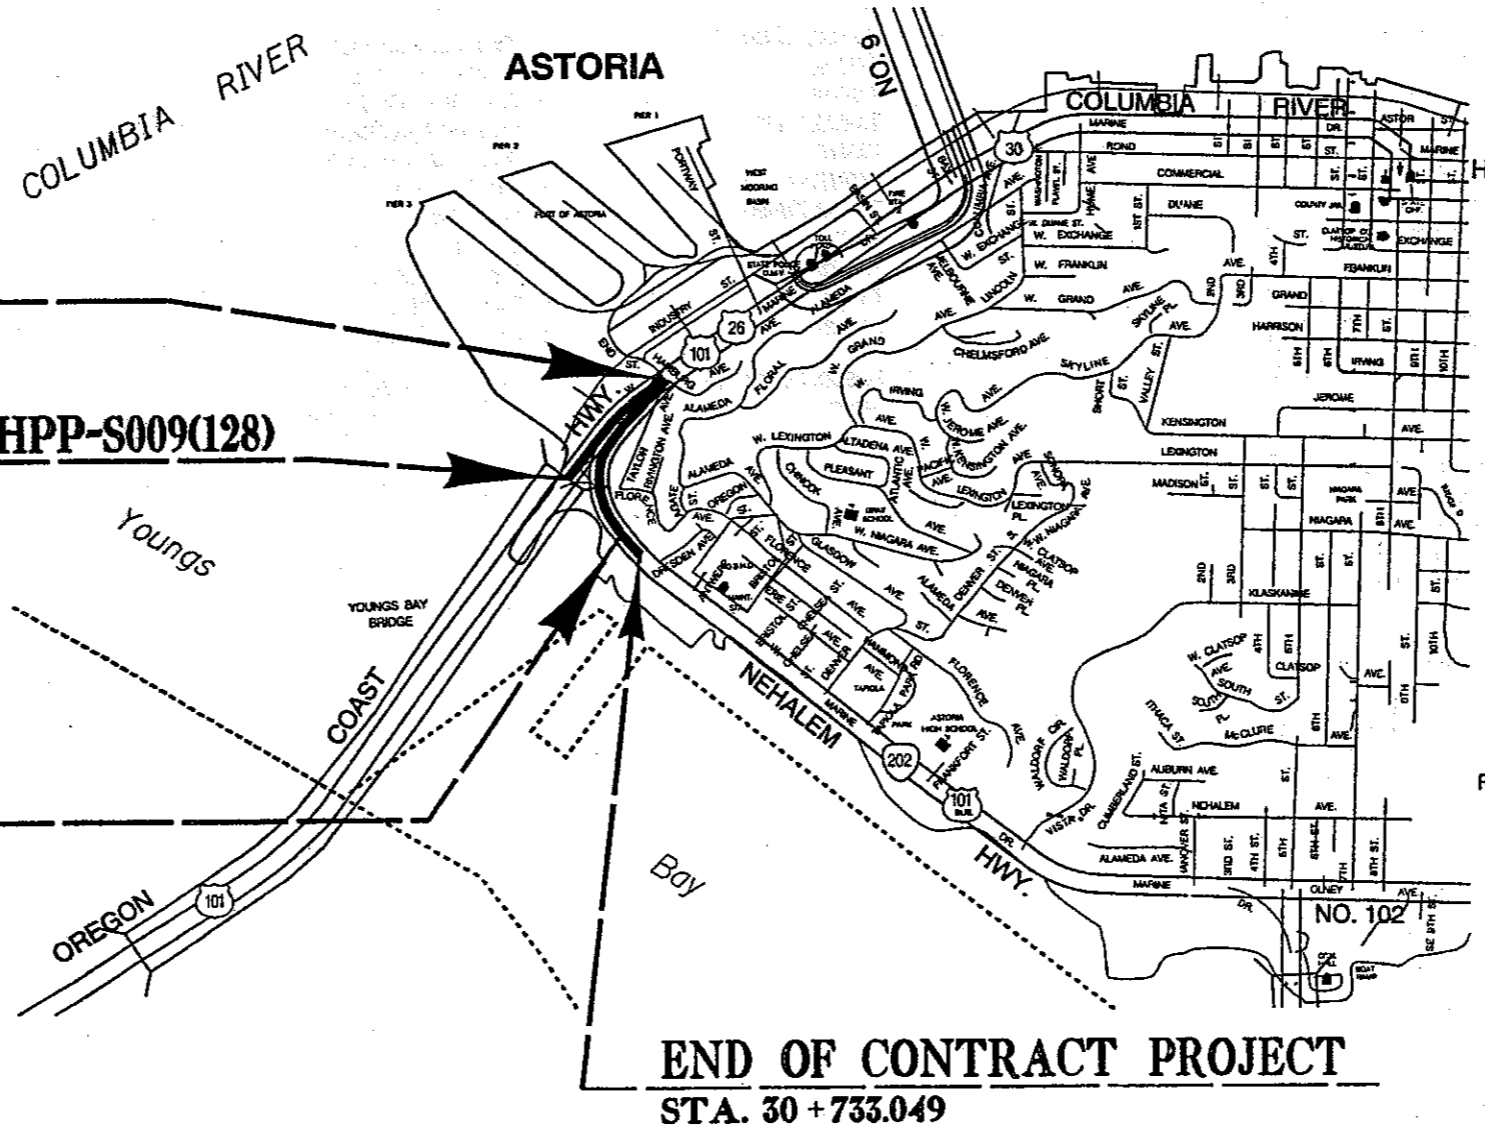

OREGON TRANSPORTATION COMMISSION

- Steven H. Corey CHAIRMAN
- Gail L. Achterman COMMISSIONER
- Stuart Foster COMMISSIONER
- Randall Pape COMMISSIONER
- John Russell COMMISSIONER
- Bruce A. Warner DIRECTOR OF TRANSPORTATION



Catherine M. Nelson

ACTING TECHNICAL SERVICES MANAGING ENGINEER

**US-101 AT NEHALEM HWY.
(ASTORIA) SEC.**
OREGON COAST & NEHALEM HWYS.
CLATSOP COUNTY

FEDERAL HIGHWAY ADMINISTRATION	PROJECT NUMBER	SHEET NO.
OREGON DIVISION	NH-HPP-ACHPP-S009(128)	1




END OF CONTRACT PROJECT
STA. 30 + 733.049


AS CONSTRUCTED
A *Diana* PROJECT MANAGER 8/20/03 DATE

22-AUG-2001 11:54


C:\usr\proj\sect\ACHPP\2.mxd

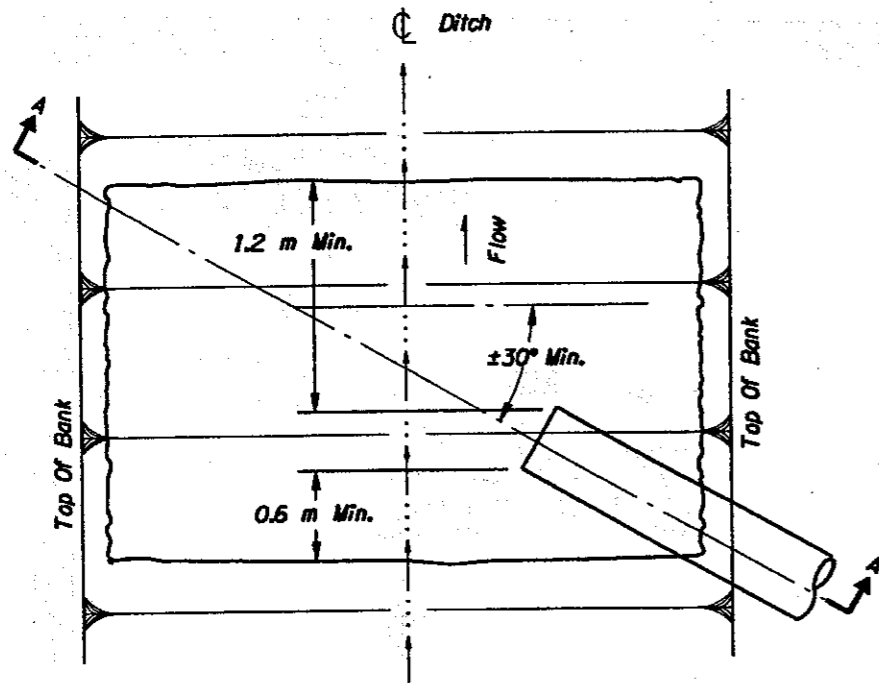

PLAN

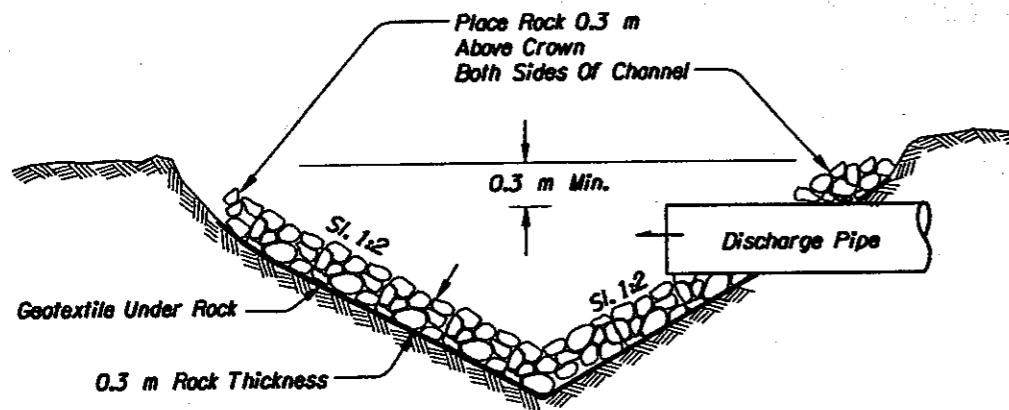

SECTION A - A
OUTLET BASIN

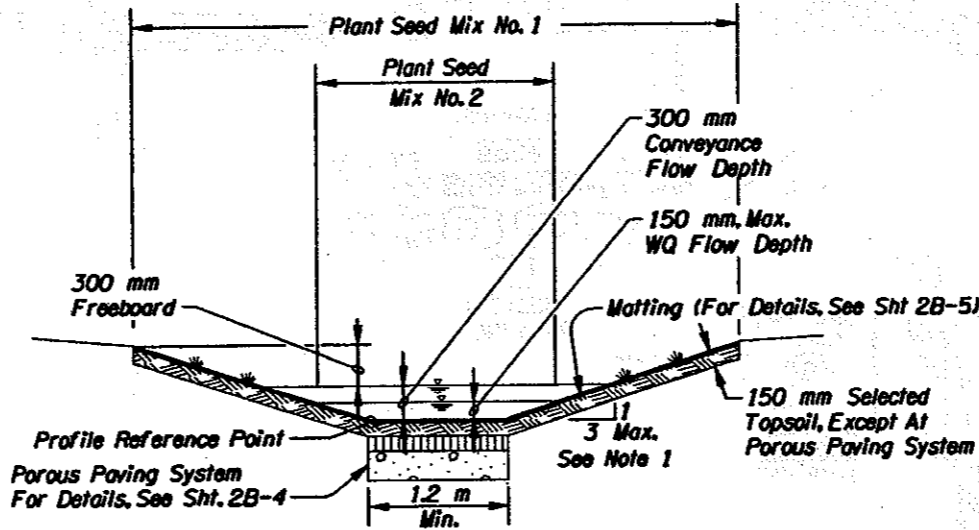


Eastside Ditch
Sta. "ML" 20+125.3 Lt. To Sta. "ML" 20+217.8 Lt.
Sta. "ML" 20+275.6 Lt. To Sta. "TL" 30+424.9 Lt.

Southside Ditch
Sta. "MC" 10+403.2 Lt. To Sta. "TL" 30+489.3 Rt.

NOTE:


- Increase Slope To IV : 2H Adjacent To Existing Wastewater Pump Station (Sta. "TL" 30+432.7 Lt. To Sta. "TL" 30+452.9 Lt.)

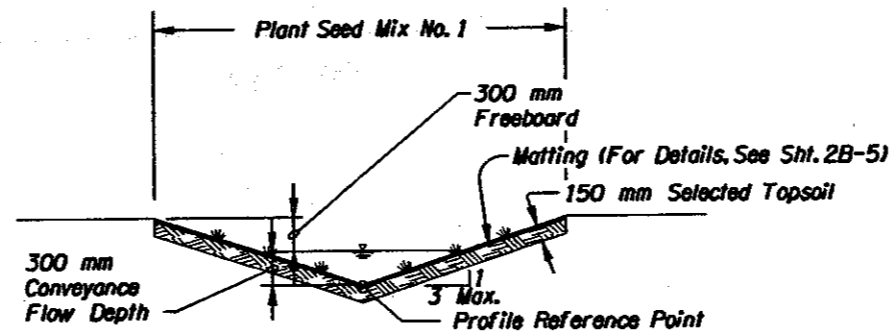

Westside ditch
Sta. "MC" 10+342.9 Rt. To Sta. "MR" 10+163.4 Rt.

Eastside Ditch
Sta. "ML" 20+217.8 Lt. To Sta. "ML" 20+275.6 Lt.


DRAINAGE SWALE DETAIL

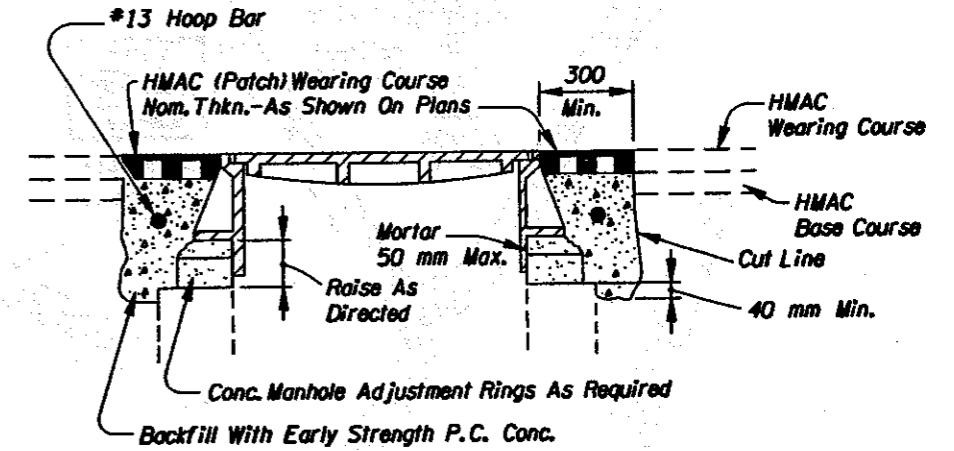

- Cover Manhole With Building Paper And Const. HMAC Base And Wearing Courses.
- Sawcut Square Or Circular Excavation Around Manhole 300 mm Min. From M. H. Frame. Orient Diagonal Of Square So That Its Is Parallel To Roadway Center Line.
- Raise Manhole Frame And Cover To Finish Grade By Installing Conc. Rings And Levelling Mortar.
- Backfill With Early Strength P. C. Conc. And HMAC Wearing Course.

METHOD "A"
MANHOLE ADJUSTMENT SEQUENCE

Note:
All Dimensions Are
In Millimeters (mm) Unless
Otherwise Indicated.

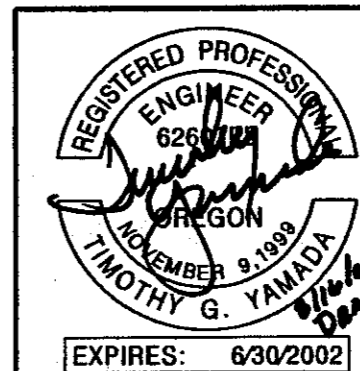

OREGON DEPARTMENT OF TRANSPORTATION
ROADWAY ENGINEERING SECTION

U.S.-101 AT NEHALEM HWY. (ASTORIA) SEC.
OREGON COAST & NEHALEM HWYS.
CLATSOP COUNTY

Designed By - Tim Yamada
Drafted By - Rob Luke

DETAILS


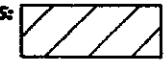



SHEET NO.
2B-6


15-AUG-2001 09:51 C:\Users\sgifford\Documents\153739 Astoria\10417.dwg

T. 8 N, R. 10 W, W.M.
ASTORIA

CH2MHILL

NH-HPP-ACHPP-S009(128)
BEGINNING OF PROJECT
STA. "MR" 10+060
STA. "ML" 20+060


- Concrete Island
Shown Thus: 
(For Details, See Sht. 2B-4)
- Pavement Removal
Shown Thus: 
(For Details, See Sht. 2B-4)
- Aggregate Base
Shown Thus: 
(For Details, See Sht. 2B-4)
- Porous Pavers
Shown Thus: 
(For Details, See Sht. 2B-4)
- P.C. Conc. Walk
Shown Thus: 

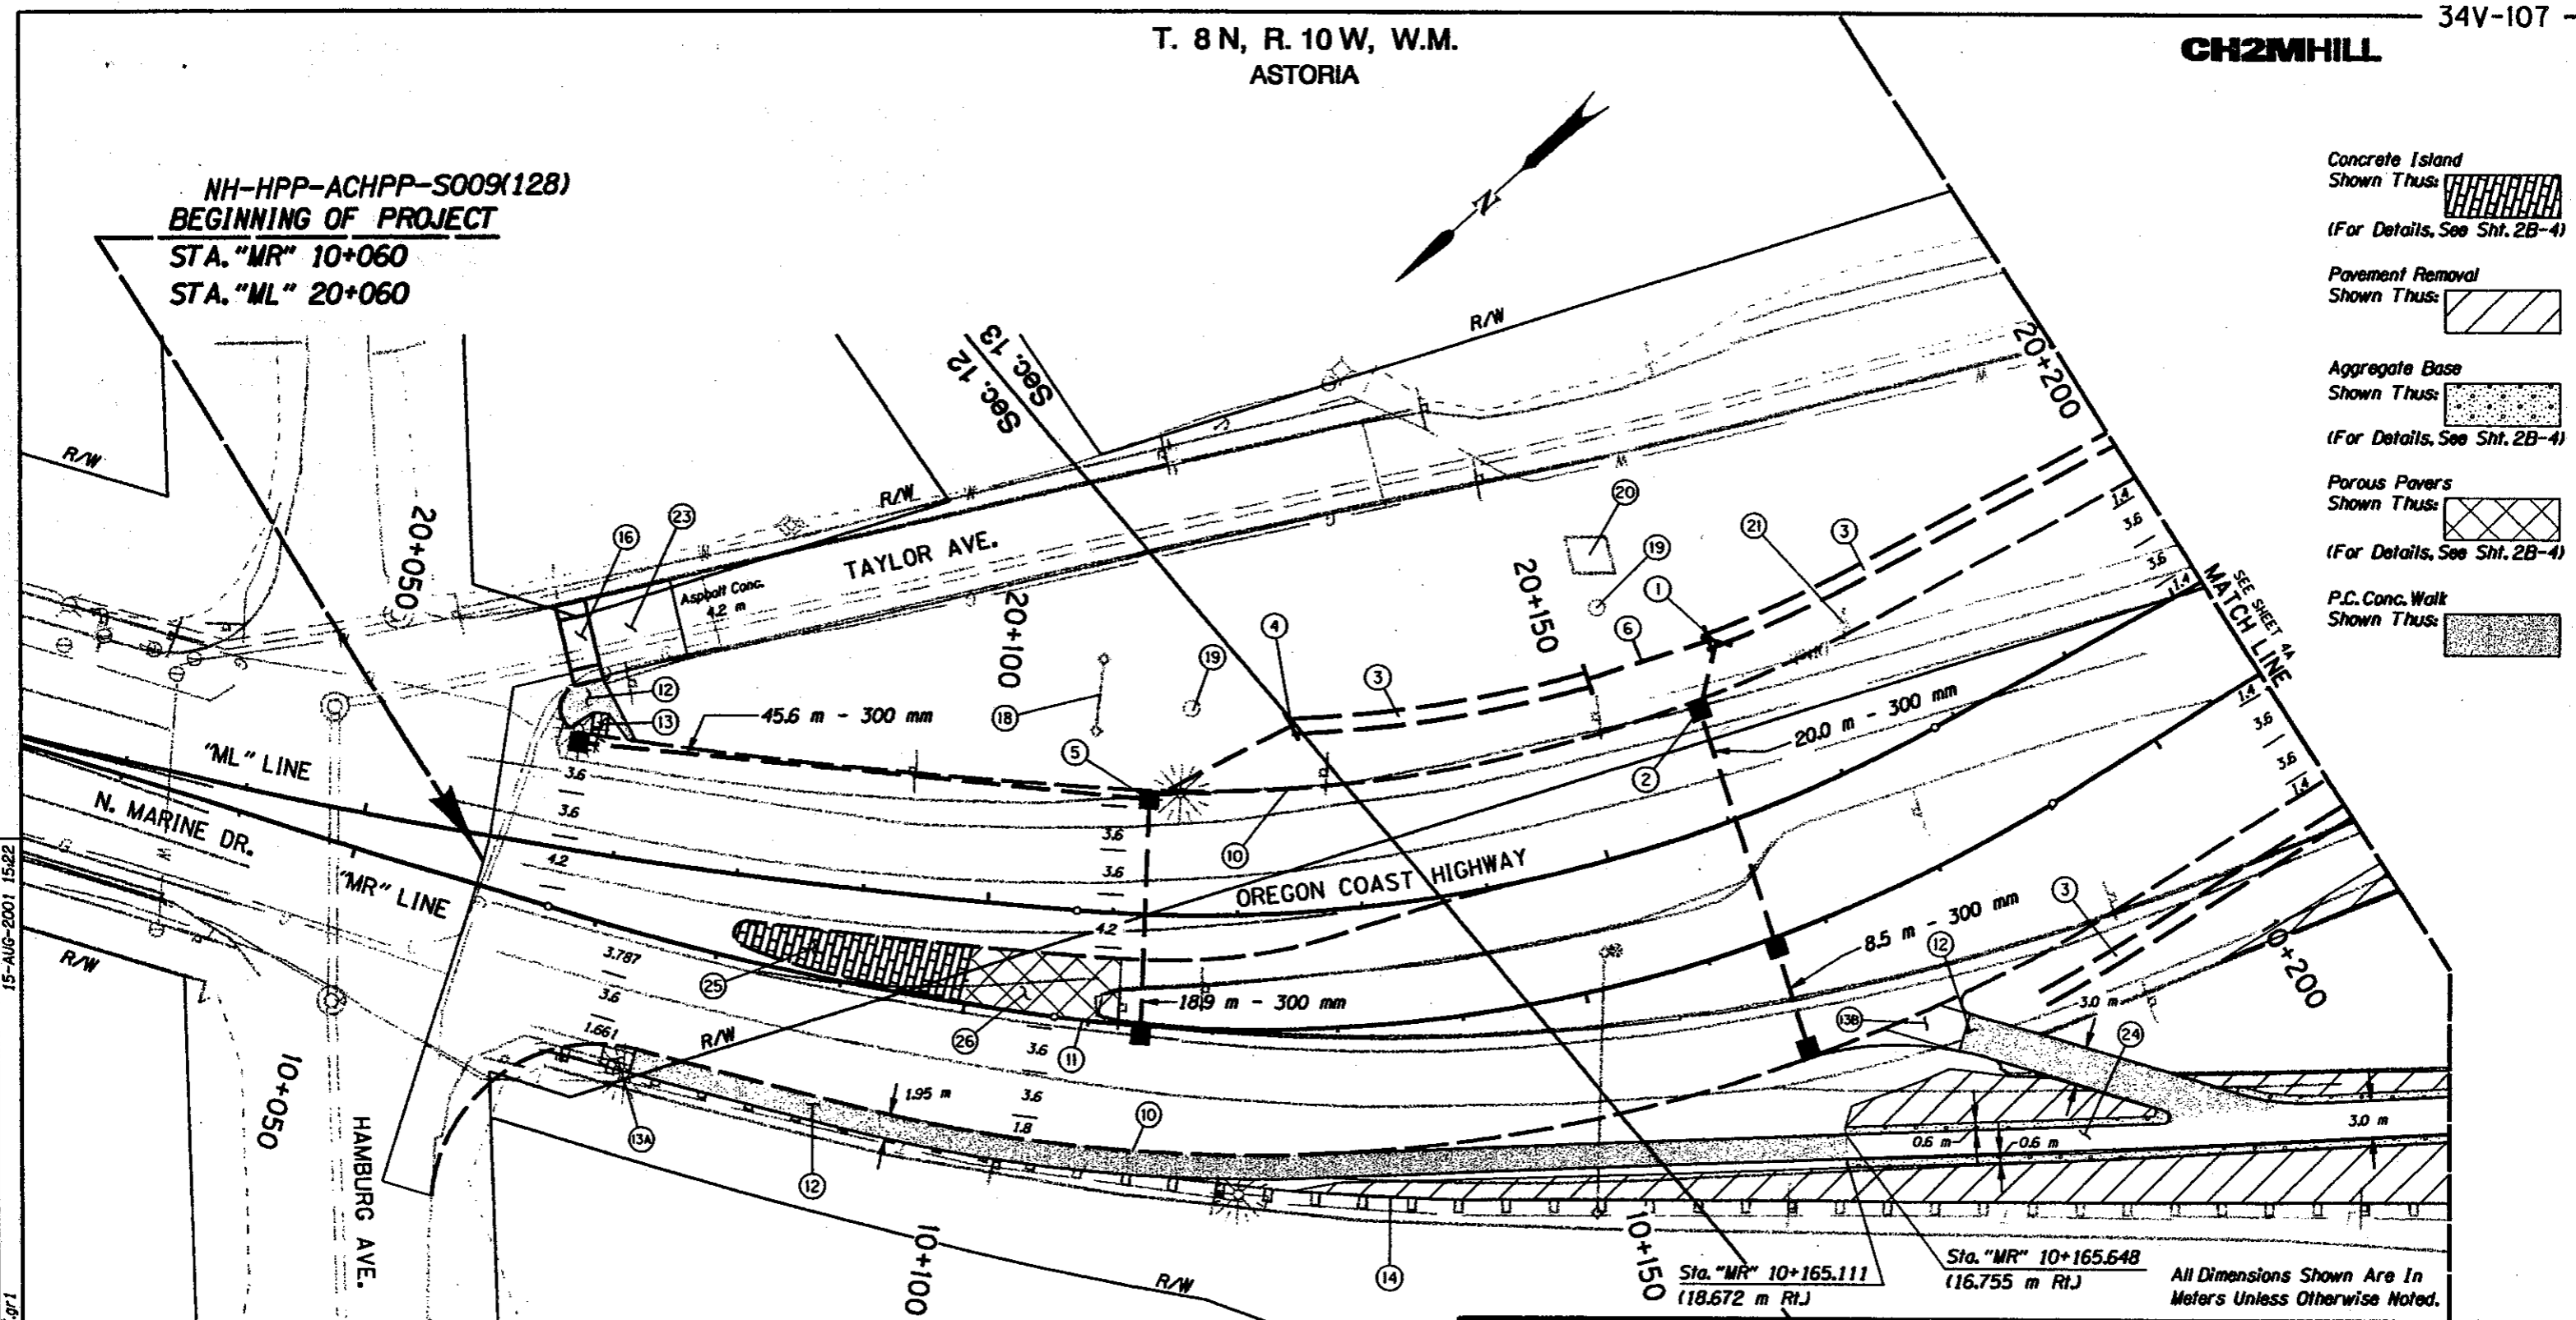

Sta. "MR" 10+165.111 (18.672 m Rt.)
Sta. "MR" 10+165.648 (16.755 m Rt.)

All Dimensions Shown Are In Meters Unless Otherwise Noted.

15-AUG-2001 15:22
C:\User\sljg\fordr\153739 Astoria\10417.gr1

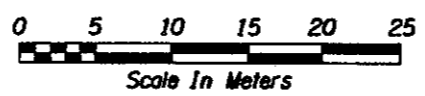

REGISTERED PROFESSIONAL ENGINEER
6260
Timothy G. Yamada
OREGON
NOVEMBER 9, 1999
TIMOTHY G. YAMADA
EXPIRES: 6/30/2002

REGISTERED PROFESSIONAL ENGINEER
16,901
James F. Bauman
OREGON
NOV. 16, 1993
JAMES F. BAUMAN
EXPIRES: 12/31/01

OREGON DEPARTMENT OF TRANSPORTATION
ROADWAY ENGINEERING SECTION

U.S.-101 AT NEHALEM HWY. (ASTORIA) SEC.
OREGON COAST & NEHALEM HWYS.
CLATSOP COUNTY

Designed By - Tim Yamada
Designed By - Kristin Austin
Drafted By - Rob Luke

GENERAL CONSTRUCTION


SHEET NO. 3A

CH2MHILL

- ① Sta. "ML" 20+164.65
Inst. 300 mm Sew. Pipe Outfall - 5.8 m
Trench Exc. - 4.1 m³
Inst. Outlet Basin
(For Details, See Sht. 2B-6)
- ② Sta. "ML" 20+161.03
Const. Type "CG-2" Inlet - 2
Const. Type "G-2" Inlet
Inst. 300 mm Sew. Pipe - 28.5 m
Trench Exc. - 19.7 m³
(See Drg. No. RD336)
- ③ Const. Drainage Swale
(For Details, See Sht. 2B-6)
- ④ Sta. "ML" 20+125.26
Inst. 300 mm Sew. Pipe Outfall - 12.8 m
Trench Exc. - 11.2 m³
Inst. Outlet Basin
(For Details, See Sht. 2B-6)
- ⑤ Sta. "ML" 20+112.60
Const. Type "CG-2" Inlet
Const. Type "G-2" Inlet - 2
Inst. 300 mm Sew. Pipe - 64.5 m
Trench Exc. - 57.4 m³
(See Drg. No. RD336)
- ⑥ Sta. "ML" 20+152.65
Inst. 450 mm Culvert Pipe - 10.0 m
Trench Exc. 9.8 m³
- ⑩ Const. Type "A" Curb
(See Drg. No. RD700)
- ⑪ Const. Type "F" Curb
(See Drg. No. RD700)
- ⑫ Const. P.C. Conc. Walk
- ⑬ Const. Sidewalk Ramp
(See Drg. No. RD725)
- ⑬A Const. Modified Sidewalk Ramp
(For Details, See Sht. 2B-4)
- ⑬B Const. Modified Sidewalk Ramp (Bikeway)
(See Drg. No. RD725, General Note 7)
- ⑭ Sta. "MR" 10+068 To Sta. "MC" 10+453
Remove Extg. Guardrail - 384 m
- ⑯ Const. P.C. Conc. Driveway, Option A
(See Drg. No. 720)
- ⑱ Maintain And Protect Historic Sign

- ⑲ Maintain And Protect Stone Monument - 2
- ⑳ Maintain And Protect Historic Statue
- ㉑ Remove Utility Pole
- ㉒ Const. Asphalt Conc. Connection
(See Drg. No. 715)
- ㉓ Sawcut Extg. Pavement To Maintain 3.0 m
Wide Asphalt Conc. Path.
(For Details, See Sht. 2B-4)
Const. Connection Between P.C. Conc. Walks
And Asphalt Conc. Path As Directed By
Engineer.
- ㉔ Const. Conc. Island - 65 m²
Stamped Conc. Island Surfacing
(For Details, See Sht 2B-4)
- ㉕ Const. Porous Paver System - 60 m²
(For Details, See Sht 2B-4)

C:\Users\pgriff\ford\153739 Astoria\10417.n1 15-AUG-2001 15:16

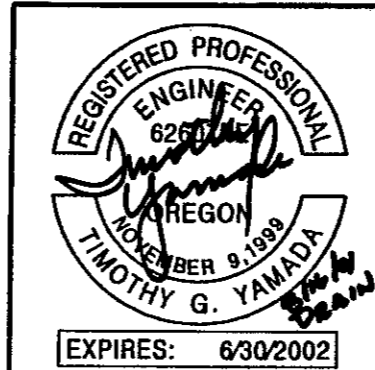


OREGON DEPARTMENT OF TRANSPORTATION ROADWAY ENGINEERING SECTION	
U.S.-101 AT NEHALEM HWY. (ASTORIA) SEC. OREGON COAST & NEHALEM HWYS. CLATSOP COUNTY	
Designed By - Tim Yamada Designed By - Kristin Austin Drafted By - Rob Luke	
GENERAL CONSTRUCTION	SHEET NO. 3B

NH-HPP-ACHPP-S009(128)
BEGINNING OF PROJECT

STA. "ML" 20+060

"ML" LINE

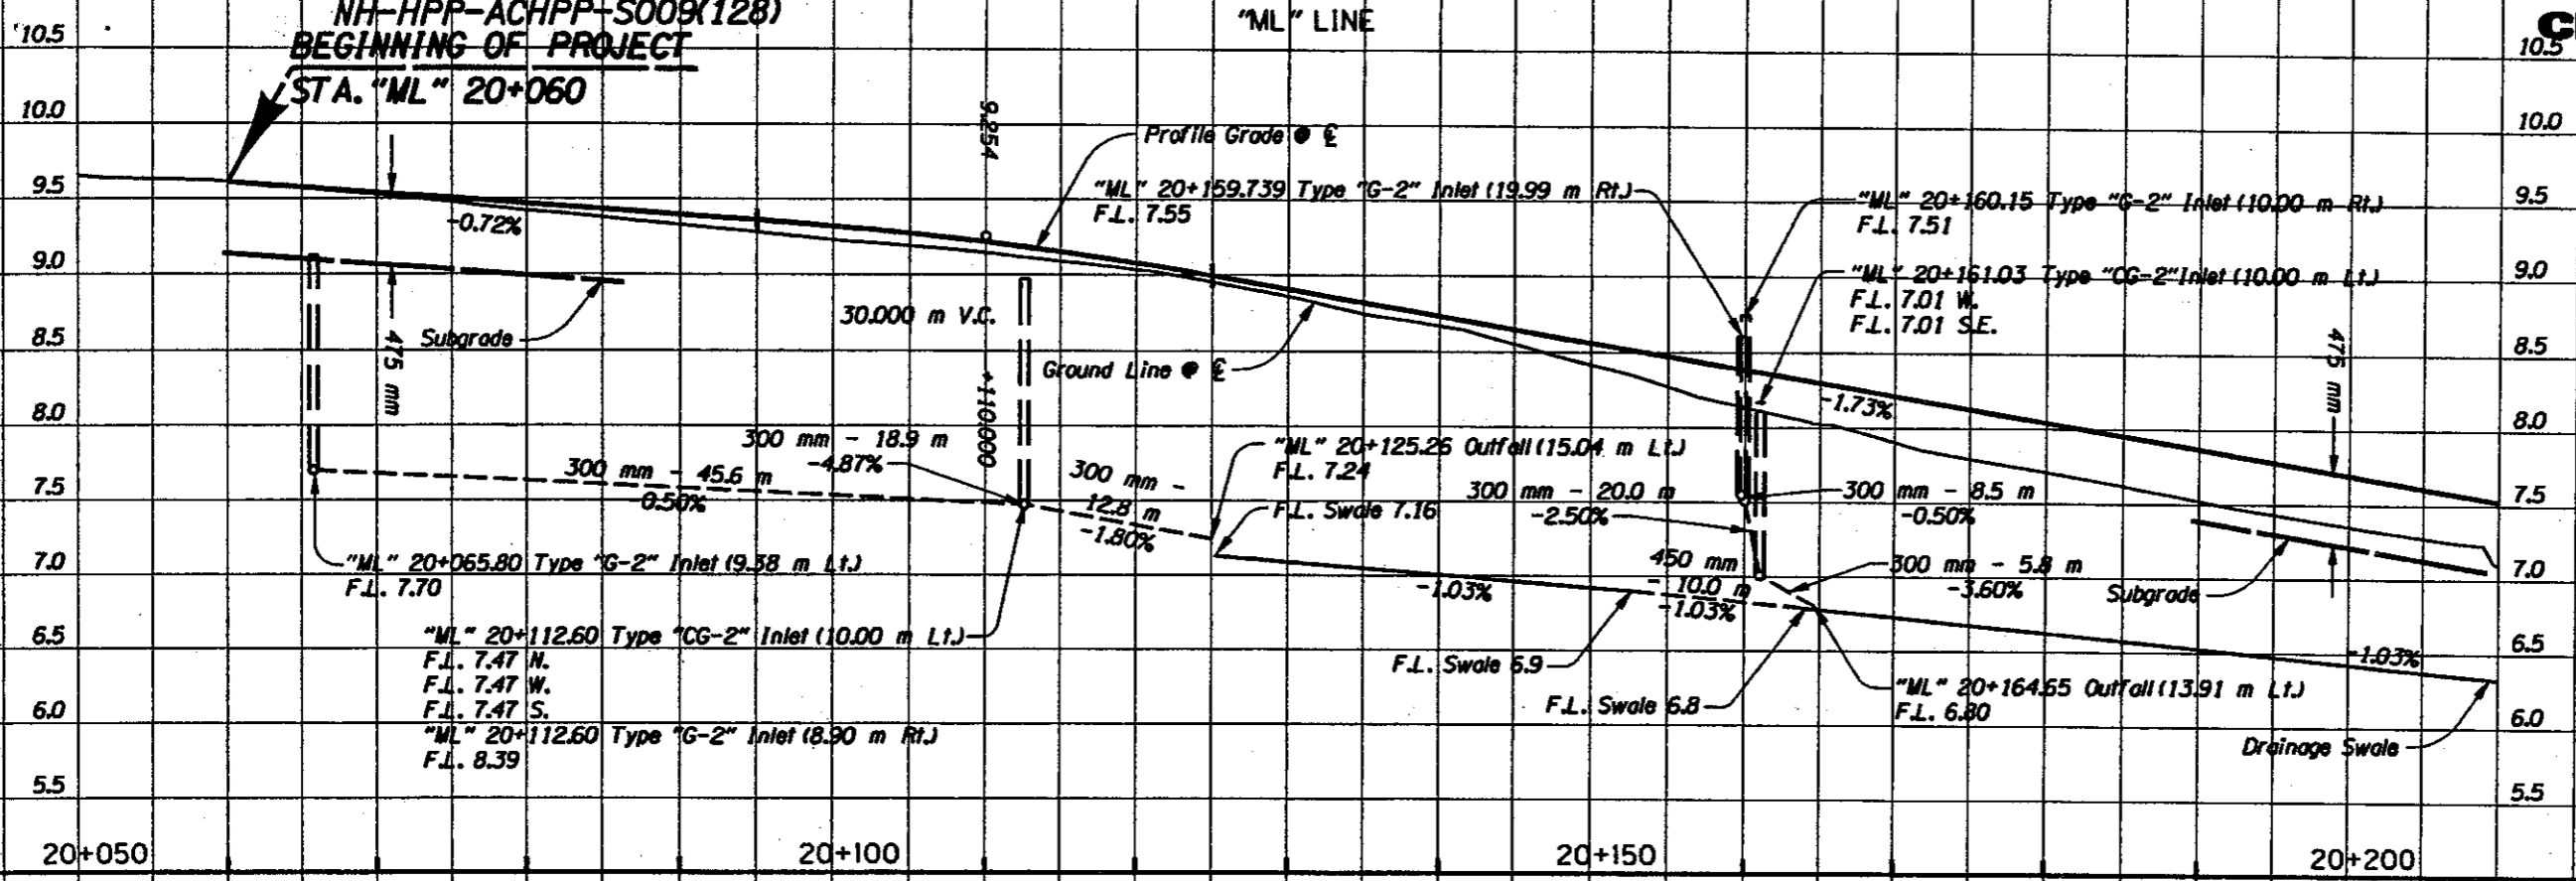


"ML" Line
Earthwork Quantities:

Exc.	590 m ³
Emb.	1000 m ³
Ditch Exc.	260 m ³

BEGINNING OF PROJECT

STA. "MR" 10+060


"MR" LINE

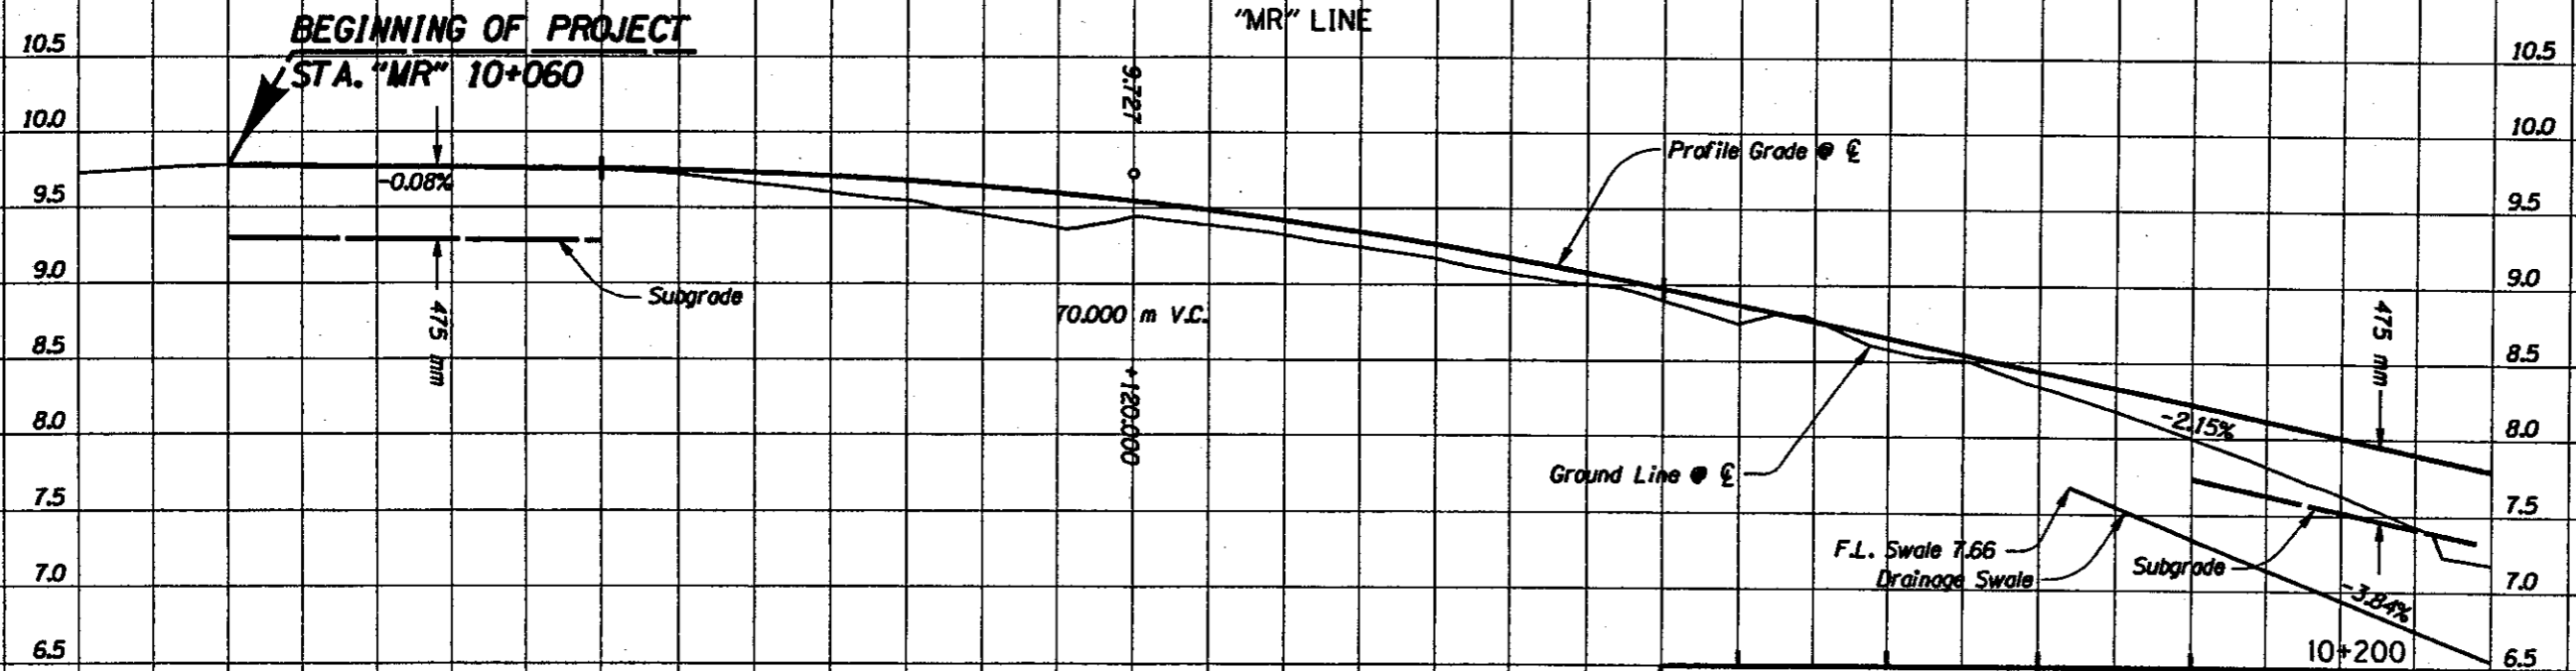

"MR" Line
Earthwork Quantities:

Exc.	1190 m ³
Emb.	970 m ³
Ditch Exc.	100 m ³

All Dimensions Shown Are In Meters Unless Otherwise Noted.

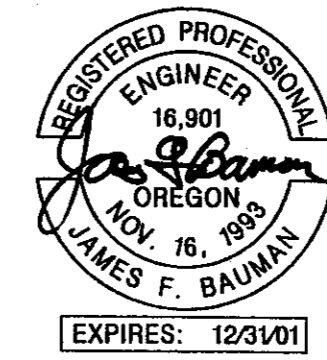

OREGON DEPARTMENT OF TRANSPORTATION
ROADWAY ENGINEERING SECTION


U.S.-101 AT NEHALEM HWY. (ASTORIA) SEC.
OREGON COAST & NEHALEM HWYS.
CLATSOP COUNTY

Designed By - Timothy Yamada
Designed By - Kristin Austin
Drafted By - Rob Luke

PROFILE

SHEET NO.
3C

15-AUG-2001 10:43
C:\Users\slightford\p153739 Astoria\10417.dwg

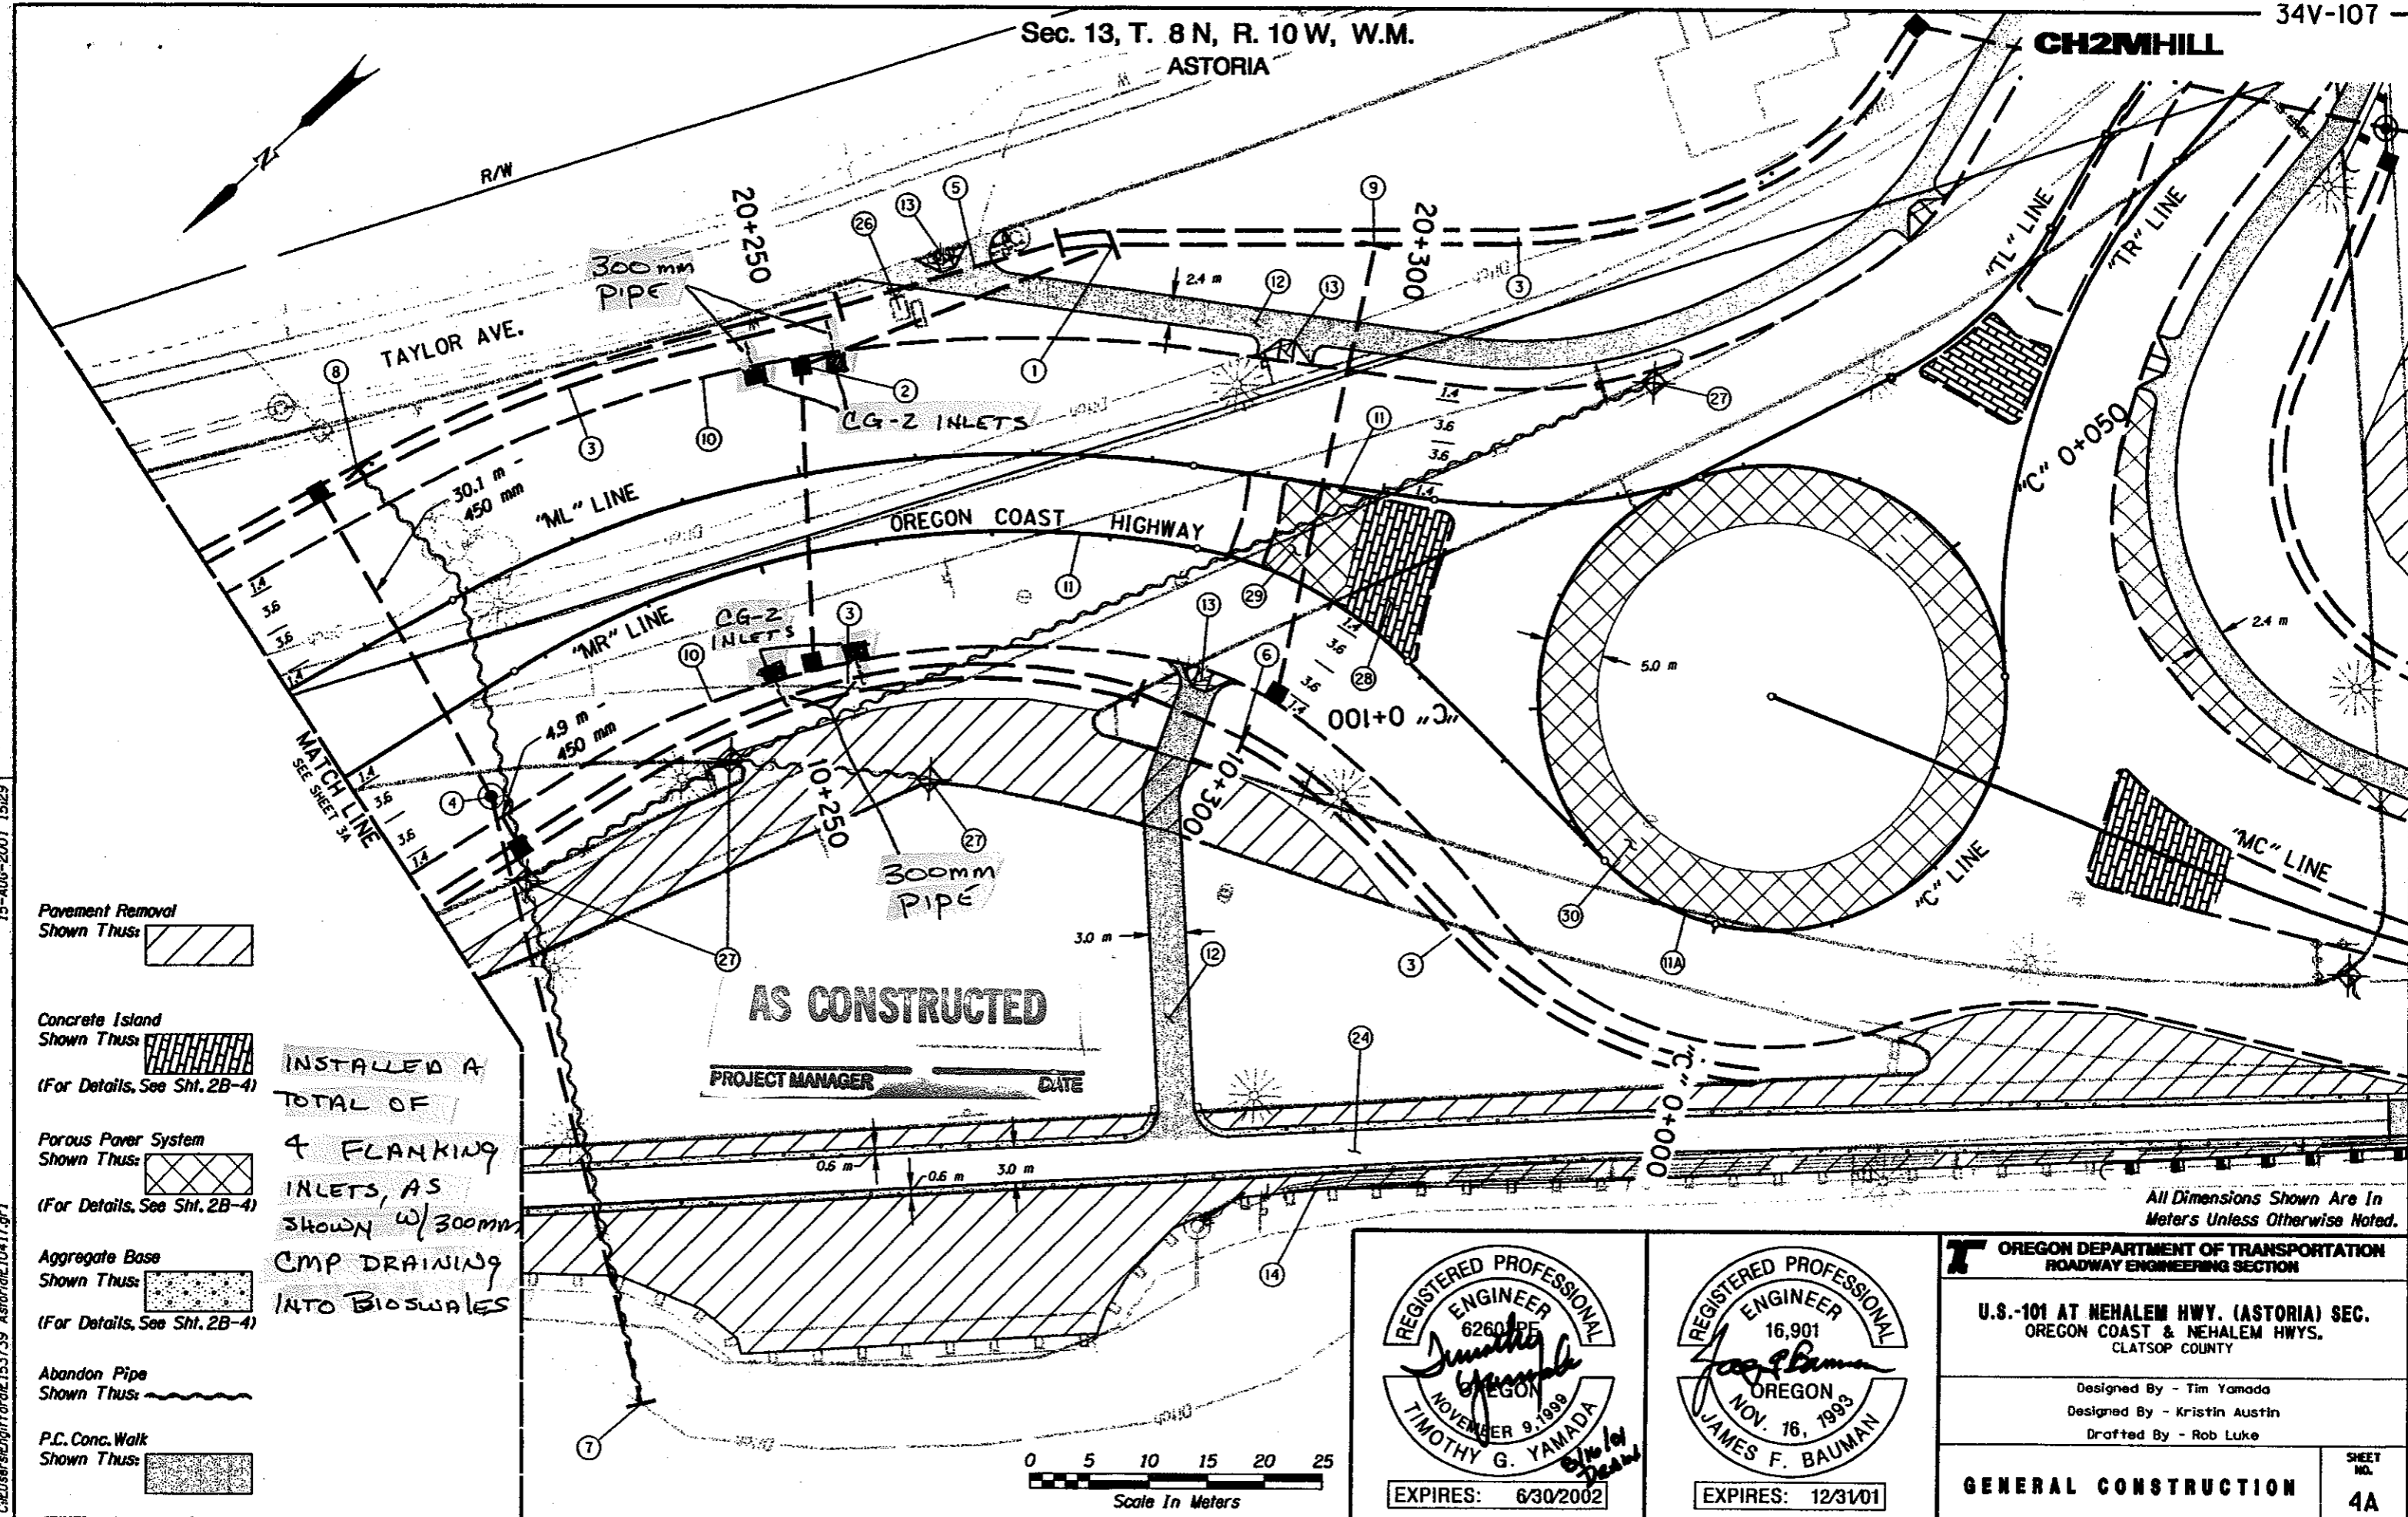

Pavement Removal
Shown Thus: [Hatched Box]

Concrete Island
Shown Thus: [Grid Hatched Box]

Porous Paver System
Shown Thus: [Cross-hatched Box]

Aggregate Base
Shown Thus: [Dotted Box]

Abandon Pipe
Shown Thus: [Wavy Line]

P.C. Conc. Walk
Shown Thus: [Stippled Box]

INSTALLED A
TOTAL OF
4 FLANKING
INLETS, AS
SHOWN w/ 300mm
CMP DRAINING
INTO BIOSWALES

AS CONSTRUCTED
PROJECT MANAGER _____ DATE _____

All Dimensions Shown Are In
Meters Unless Otherwise Noted.

REGISTERED PROFESSIONAL
ENGINEER
6260 PE
Timothy G. Yamada
NOVEMBER 9, 1999
OREGON
TIMOTHY G. YAMADA
EXPIRES: 6/30/2002

REGISTERED PROFESSIONAL
ENGINEER
16,901
James F. Bauman
NOV. 16, 1993
OREGON
JAMES F. BAUMAN
EXPIRES: 12/31/01

OREGON DEPARTMENT OF TRANSPORTATION
ROADWAY ENGINEERING SECTION

U.S.-101 AT NEHALEM HWY. (ASTORIA) SEC.
OREGON COAST & NEHALEM HWYS.
CLATSOP COUNTY

Designed By - Tim Yamada
Designed By - Kristin Austin
Drafted By - Rob Luke

GENERAL CONSTRUCTION
SHEET NO. 4A



15-AUG-2001 15:23
C:\Users\hgf\ford\153739 Astoria\10417.g1

CH2MHILL

- ① Sta. "ML" 20+275.58
Inst. 450 mm Sew. Pipe Outfall - 28.5 m
Trench Exc. - 23.0 m³
Inst. Outlet Basin
(For Details, See Sht. 2B-6)
- ② Sta. "ML" 20+251.75
Const. Type "CG-2" Inlet - 2
Inst. 300 mm Sew. Pipe - 25.6 m
Trench Exc. - 20.3 m³
- ③ Const. Drainage Swale
(For Details, See Sht. 2B-6)
- ④ Sta. "MR" 10+219.74
Const. Manhole
(See Drg. No. RD327)
Const. Type "D" mod. Inlet - 2
(For Details, See Sht. 2B-4)
Inst. 450 mm Sew. Pipe - 35.0 m
Trench Exc. 29.2 m³
- ⑤ Sta. "ML" 20+255.29
Inst. 300 mm Culvert Pipe - 19.6 m
Trench Exc. - 14.5 m³
- ⑥ Sta. "MR" 10+284.69
Inst. 300 mm Culvert Pipe - 9.8 m
Trench Exc. - 5.9 m³
- ⑦ Sta. "MR" 10+203.11
Inst. 450 mm Sew. Pipe Outfall - 53.5 m
Trench Exc. - 87.6 m³
Inst. Outlet Basin
Remove Extg. Sew. Pipe
(For Details, See Sht. 2B-6)
- ⑧ Sta. "ML" 20+216.95
Cut Extg. Sew. Pipe At Proposed Ditch
I.E. 6.35
Inst. Outlet Basin
(For Details, See Sht. 2B-6)
- ⑨ Sta. "ML" 20+296.17
Inst. 300 mm Sew. Pipe Outfall - 39.5 m
Trench Exc. - 6.5 m³
Inst. Outlet Basin
(For Details, See Sht. 2B-6)
Const. Type "CG-2" Inlet - 1
- ⑩ Const. Type "A" Curb
- ⑪ Const. Type "F" Curb
- ⑪A Const. Type "B" Curb
(See Drg. No. RD700)
- ⑫ Const. P.C. Conc. Walk
- ⑬ Const. Sidewalk Ramp - 3
- ⑭ See Sht. 3B, Note 14
- ⑮ See Sht. 3B, Note 24
- ⑯ Abandon RV Dump Site (By Others)
- ⑰ Remove Inlet - 4
- ⑱ Const. Conc. Island - 84 m²
Stamped Conc. Island Surfacing
(For Details, See Sht 2B-4)
- ⑲ Const. Porous Paver System - 63 m²
- ⑳ Const. Porous Paver System - 550 m²
(For Details, See Sht 2B-4)


15-AUG-2001 15:09

C:\Users\hofford\153739 Astoria\10417.dwg

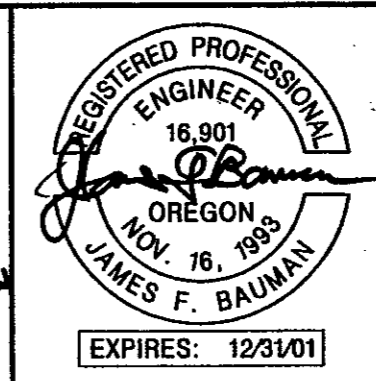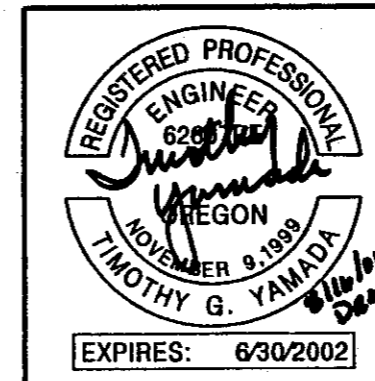


OREGON DEPARTMENT OF TRANSPORTATION ROADWAY ENGINEERING SECTION	
U.S.-101 AT NEHALEM HWY. (ASTORIA) SEC. OREGON COAST & NEHALEM HWYS. CLATSOP COUNTY	
Designed By - Tim Yamada Designed By - Kristin Austin Drafted By - Rob Luke	
GENERAL CONSTRUCTION	SHEET NO. 4B

"ML" LINE

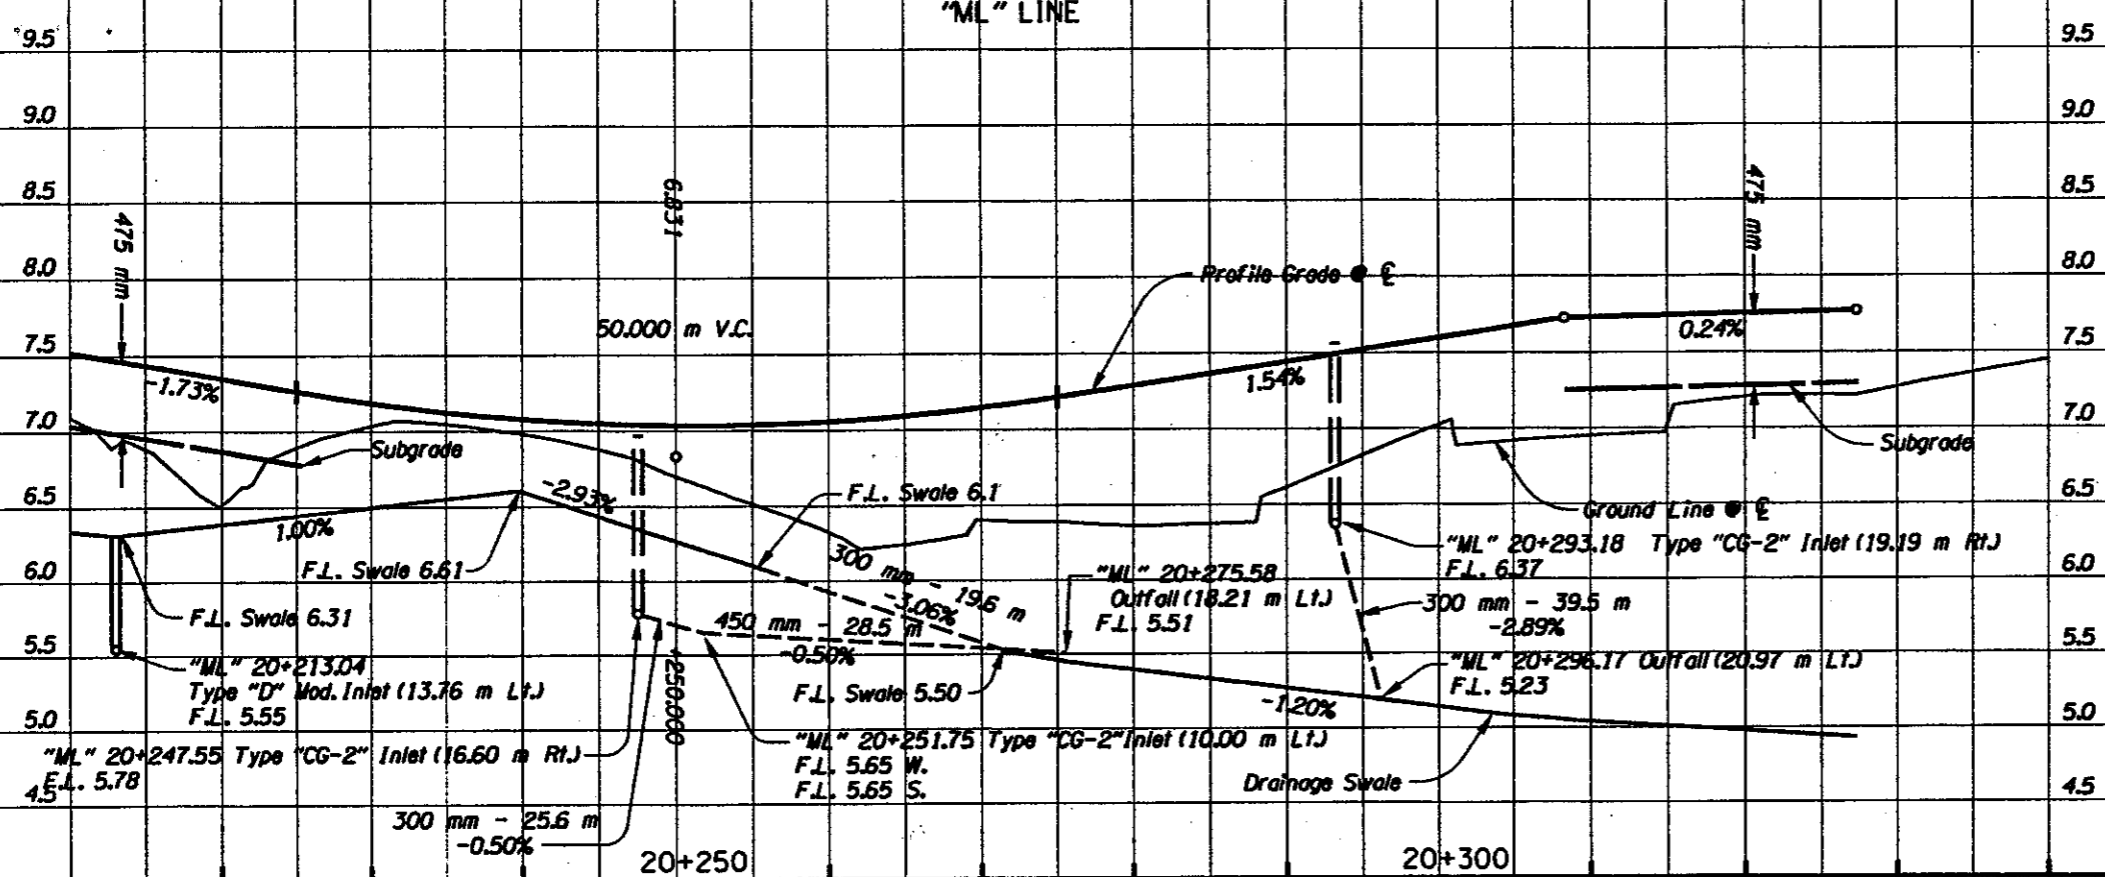



"ML" Line
Earthwork Quantities:
Exc. 490 m³
Emb. 1100 m³
Ditch Exc. 460 m³

"MR" LINE

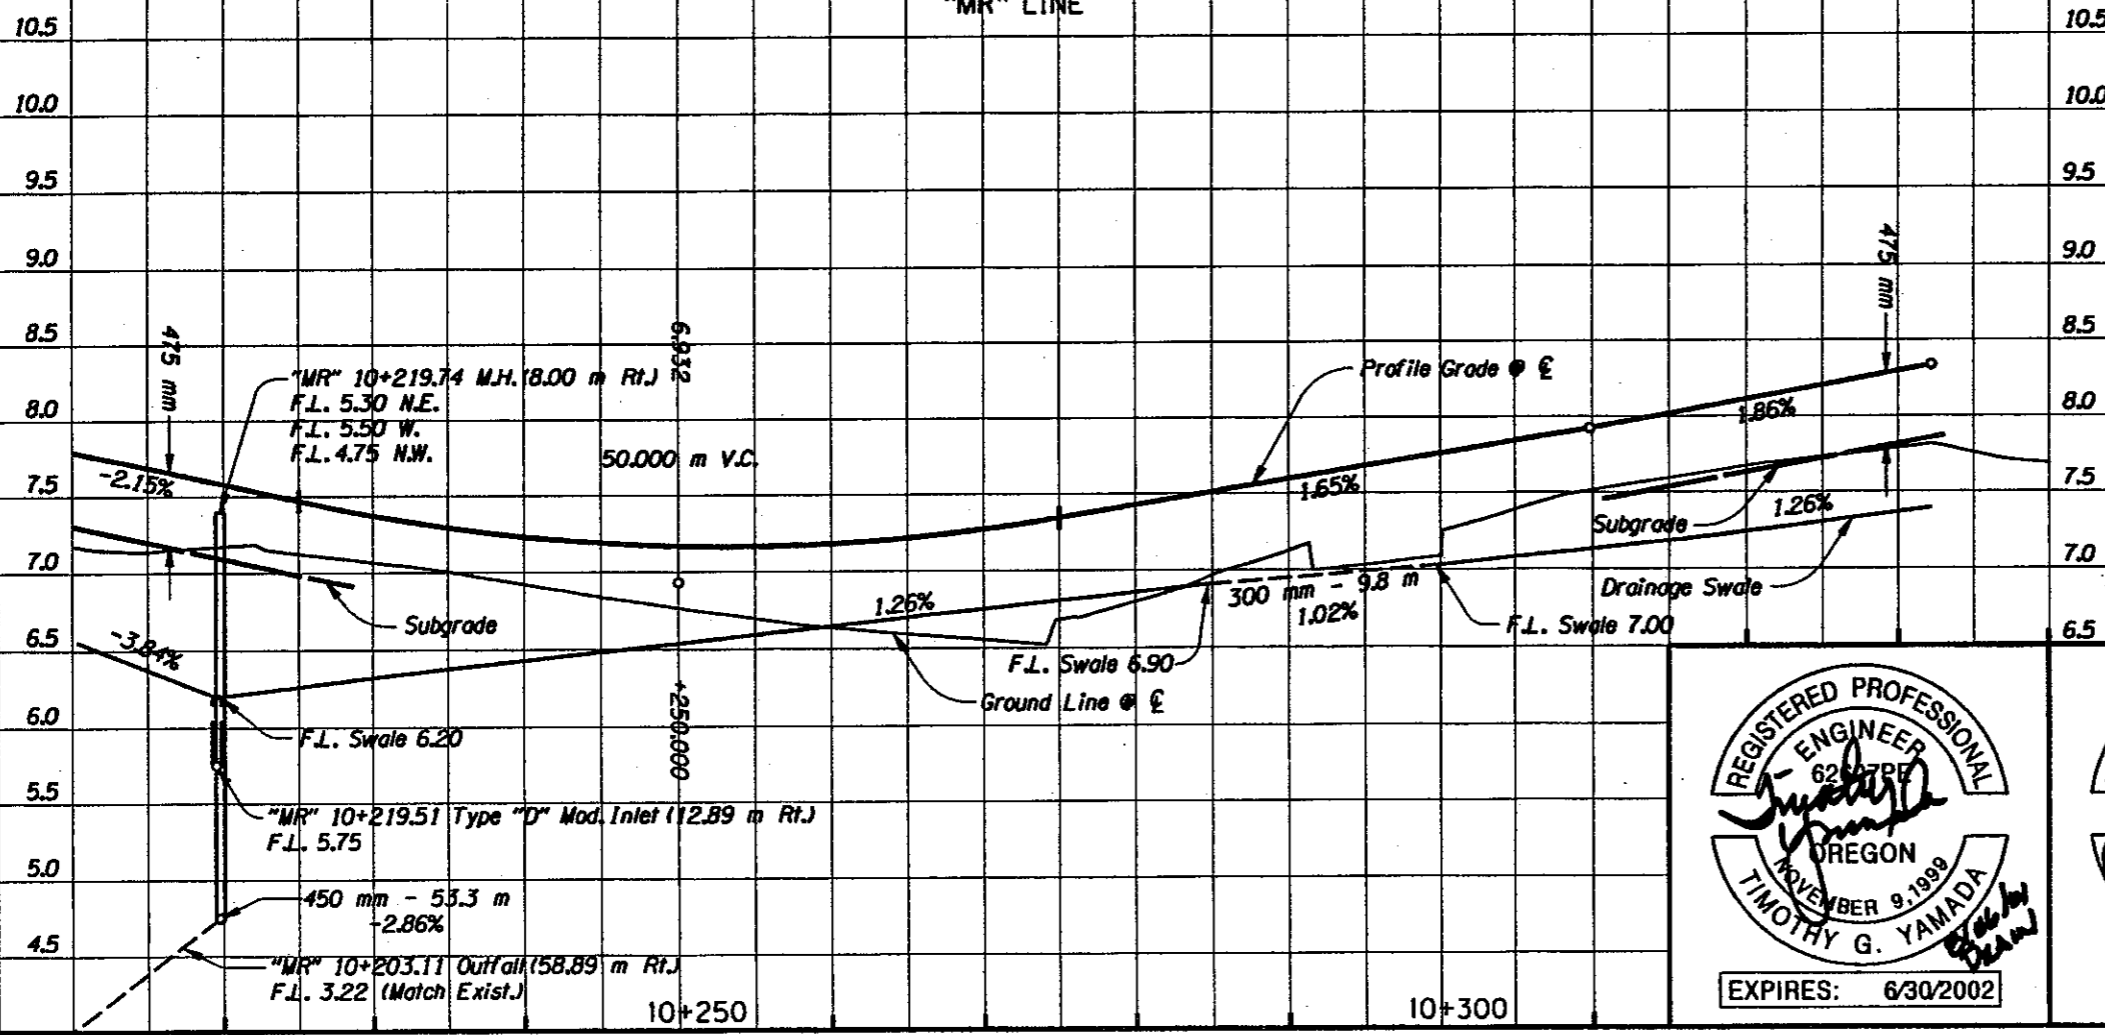

"MR" Line
Earthwork Quantities:
Exc. 520 m³
Emb. 620 m³
Ditch Exc. 390 m³

All Dimensions Shown Are In Meters Unless Otherwise Noted.

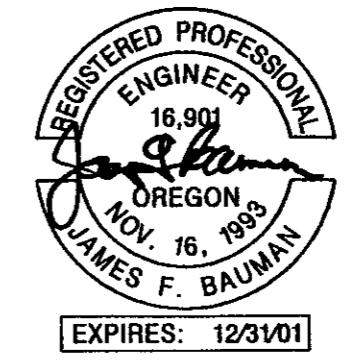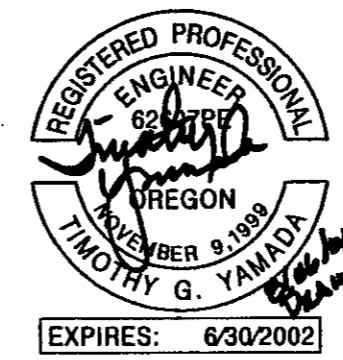

OREGON DEPARTMENT OF TRANSPORTATION
ROADWAY ENGINEERING SECTION


U.S.-101 AT NEHALEM HWY. (ASTORIA) SEC.
OREGON COAST & NEHALEM HWYS.
CLATSOP COUNTY

Designed By - Timothy Yamada
Designed By - Kristin Austin
Drafted By - Rob Luke

PROFILE


SHEET NO.
4C

15-AUG-2001 12:27
C:\Users\ngifford\Documents\153739 Astoria\10+17.dwg


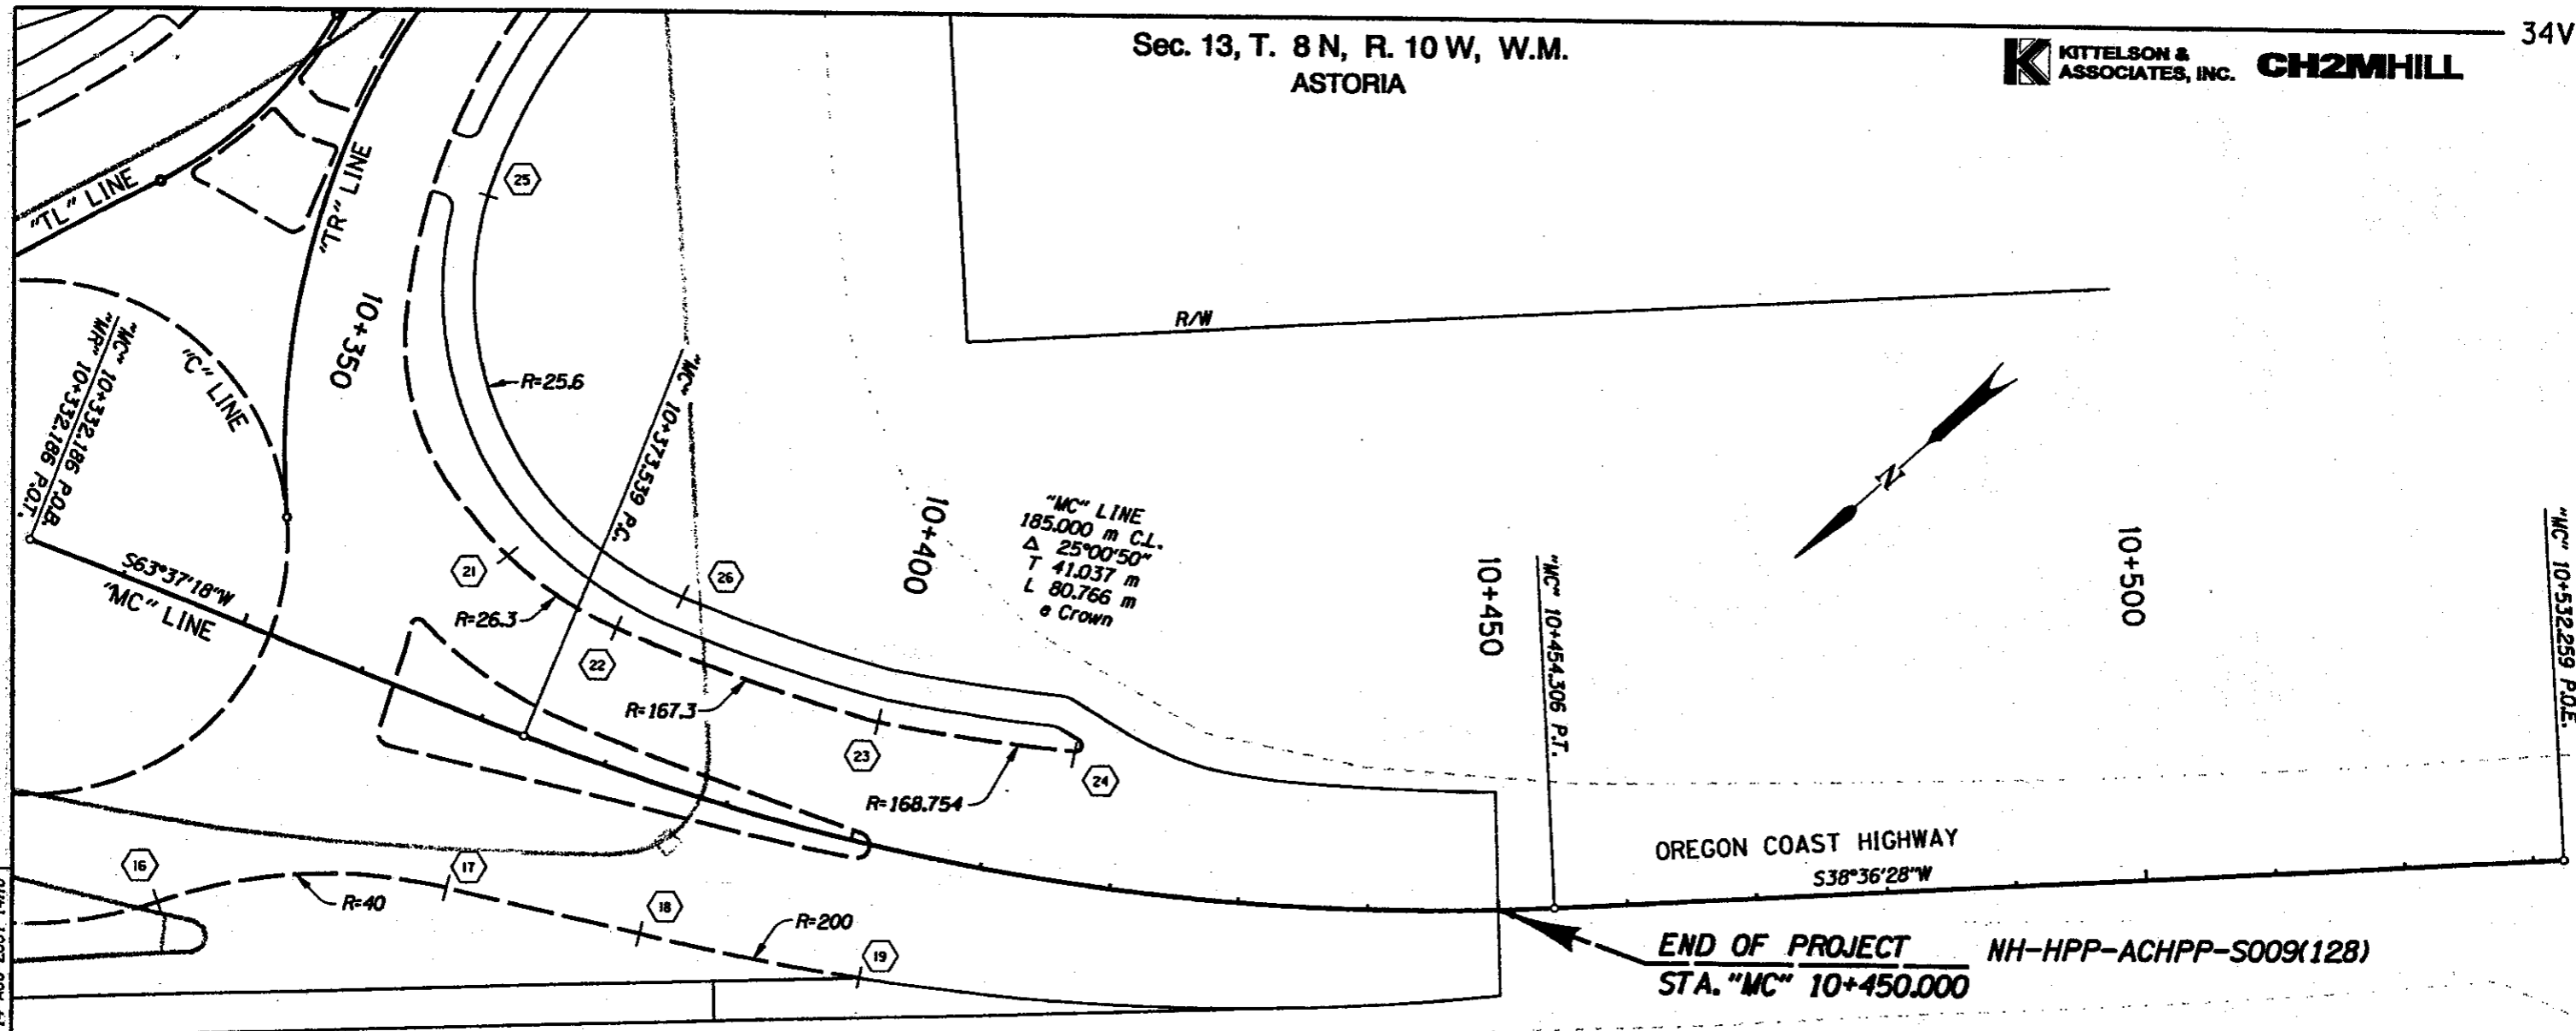


END OF PROJECT NH-HPP-ACHPP-S009(128)
STA. "MC" 10+450.000

Point No.	Station
16	"C" 0+011.374 (10.000 Rt.)
17	"MC" 10+372.423 (13.194 Rt.)
18	"MC" 10+386.636 (11.507 Rt.)
19	"MC" 10+402.993 (10.248 Rt.)
21	"MC" 10+363.364 (14.613 Lt.)
22	"MC" 10+377.070 (10.407 Lt.)
23	"MC" 10+399.805 (9.463 Lt.)
24	"MC" 10+415.681 (10.181 Lt.)
25	"TR" 40+458.805 (11.702 Rt.)
26	"MC" 10+381.358 (14.424 Lt.)

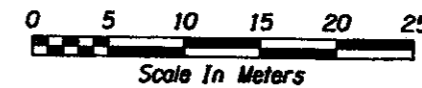

All Dimensions Shown Are In Meters Unless Otherwise Noted.

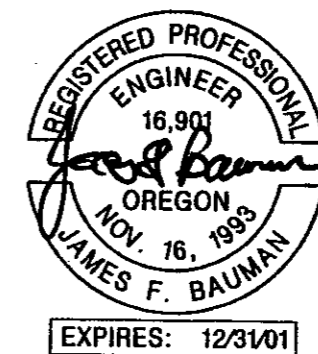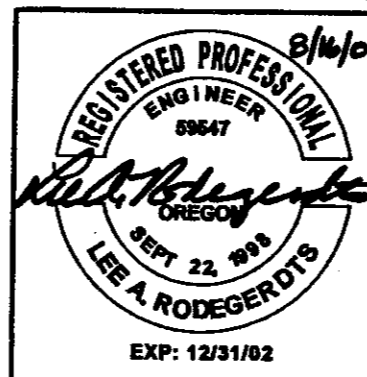

OREGON DEPARTMENT OF TRANSPORTATION
ROADWAY ENGINEERING SECTION

U.S.-101 AT NEHALEM HWY. (ASTORIA) SEC.
OREGON COAST & NEHALEM HWYS.
CLATSOP COUNTY


Designed By - Lee Rodegerdts
Designed By - Kristin Austin
Drafted By - Rob Luke

ALIGNMENT

SHEET NO. 5

14-AUG-2001 14:18
C:\Users\hifford\153739 Astoria\10417.dwg


Sec. 13, T. 8N, R. 10W, W.M.
ASTORIA

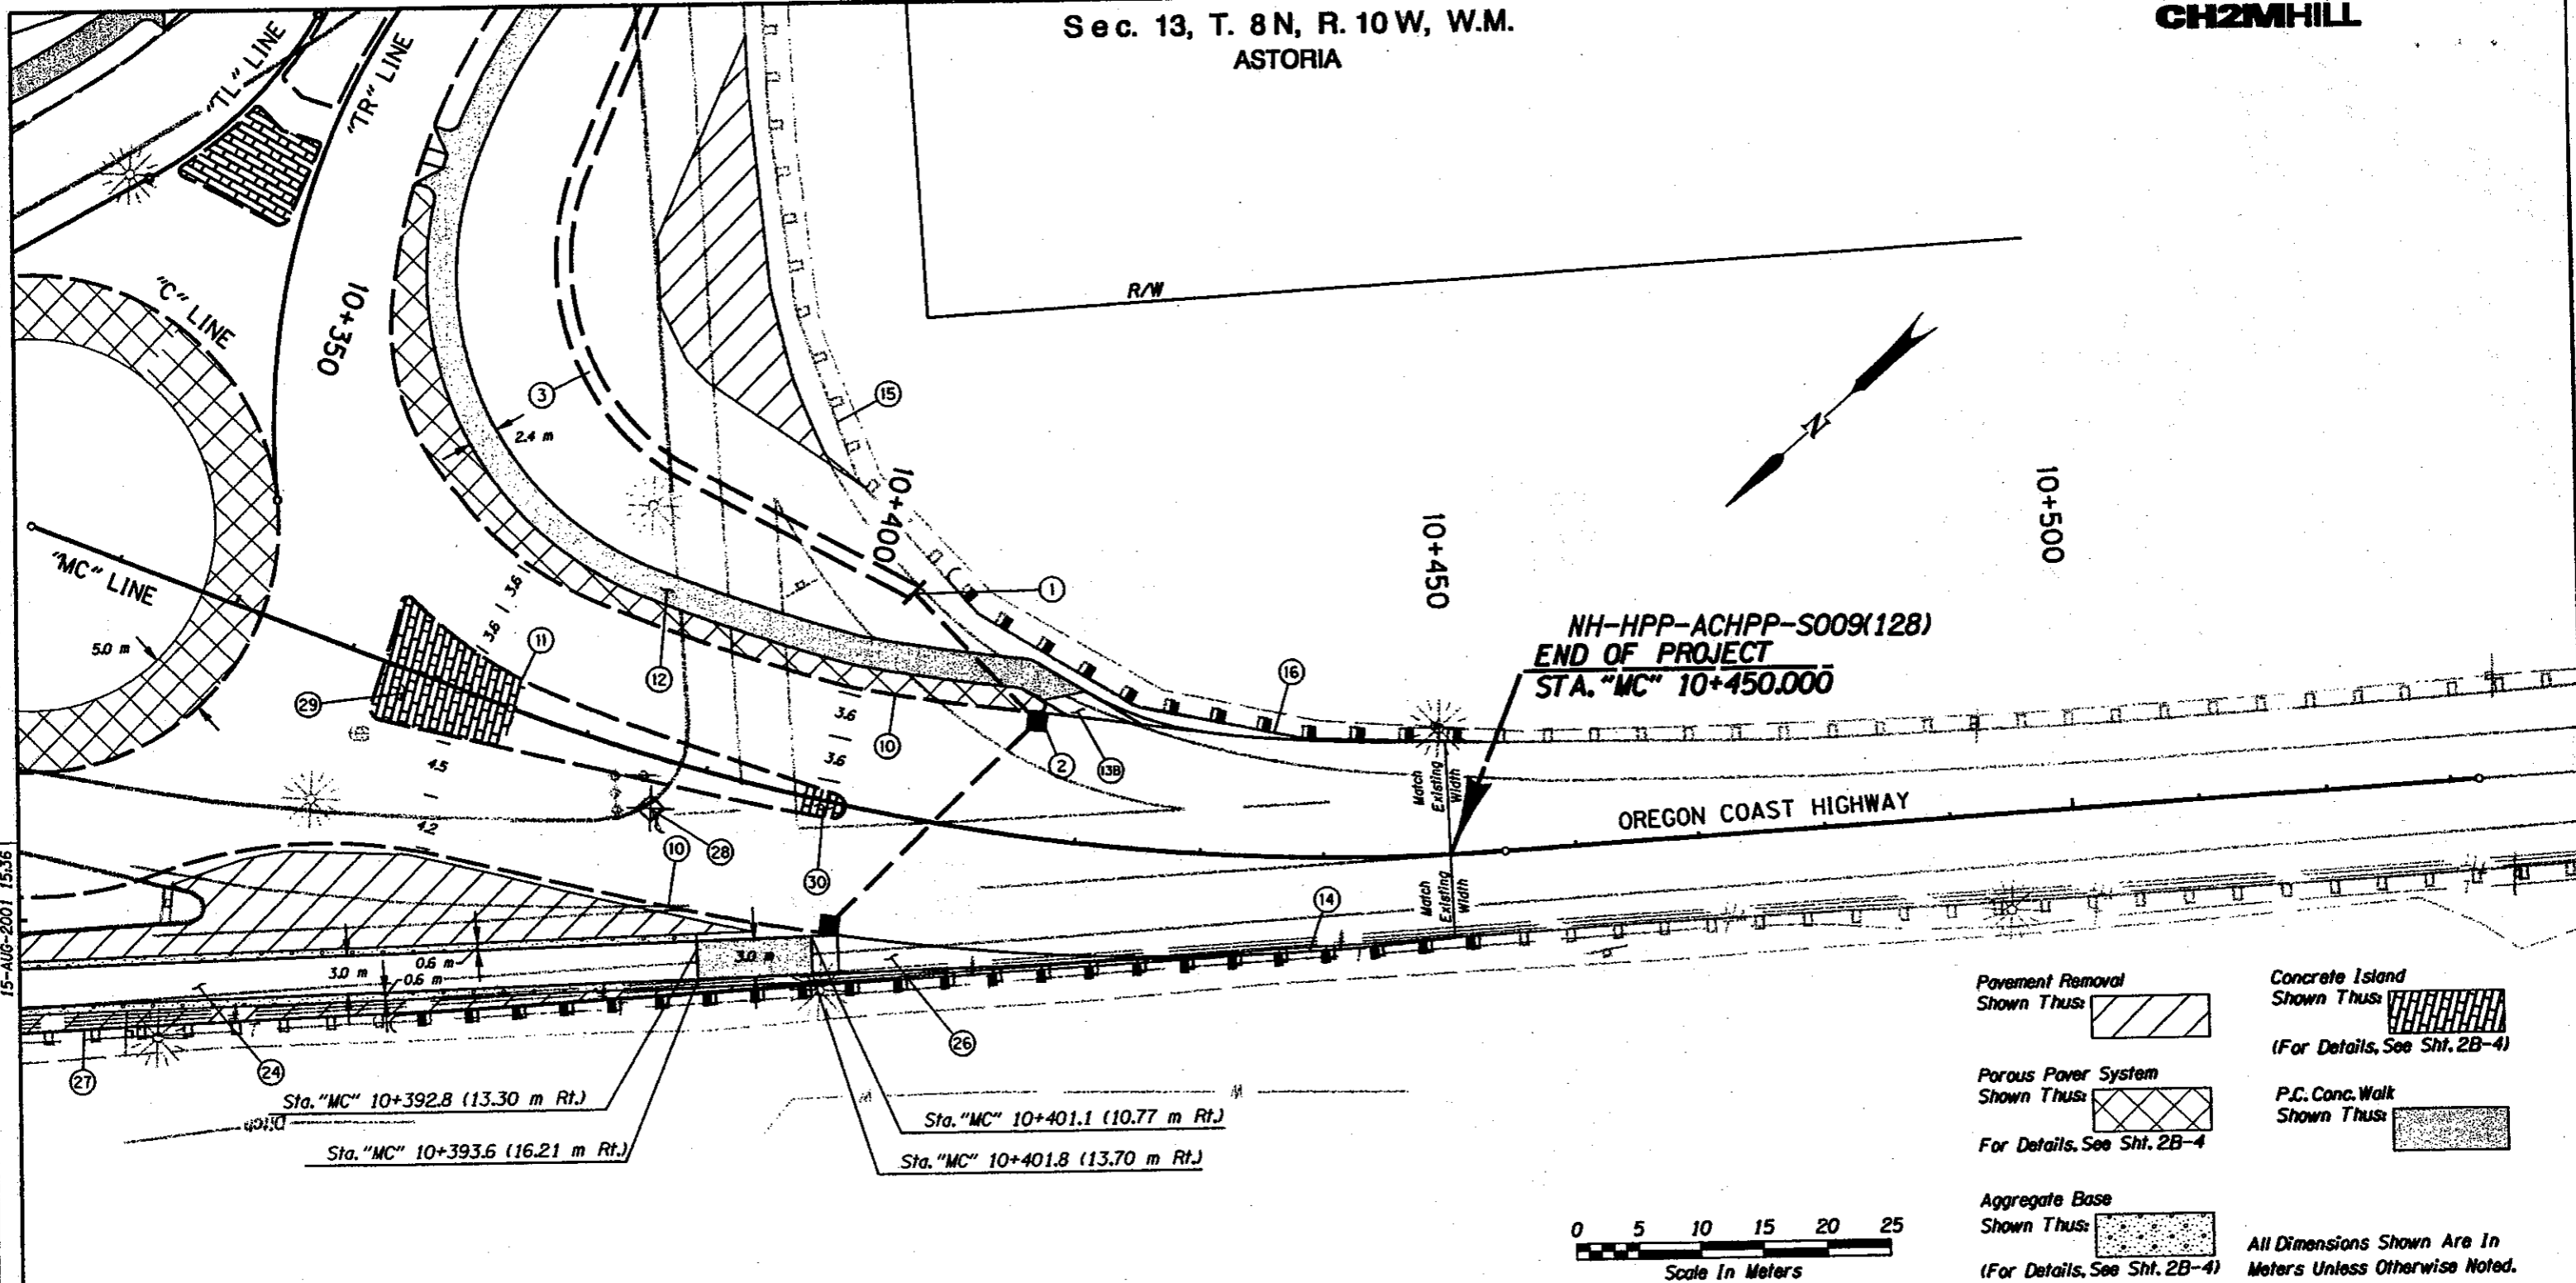

NH-HPP-ACHPP-S009(128)
END OF PROJECT
STA. "MC" 10+450.000

OREGON COAST HIGHWAY

- Pavement Removal
Shown Thus:
 - Concrete Island
Shown Thus:
(For Details, See Sht. 2B-4)
 - Porous Paver System
Shown Thus:
For Details, See Sht. 2B-4
 - P.C. Conc. Walk
Shown Thus:
 - Aggregate Base
Shown Thus:
(For Details, See Sht. 2B-4)
- All Dimensions Shown Are In Meters Unless Otherwise Noted.

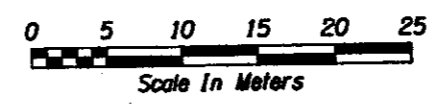

REGISTERED PROFESSIONAL
ENGINEER
6267PE
TIMOTHY G. YAMADA
NOVEMBER 9, 1998
OREGON
EXPIRES: 6/30/2002

REGISTERED PROFESSIONAL
ENGINEER
16,901
JAMES F. BAUMAN
NOV. 16, 1993
OREGON
EXPIRES: 12/31/01

OREGON DEPARTMENT OF TRANSPORTATION
ROADWAY ENGINEERING SECTION

U.S.-101 AT NEHALEM HWY. (ASTORIA) SEC.
OREGON COAST & NEHALEM HWYS.
CLATSOP COUNTY

Designed By - Tim Yamada
Designed By - Kristin Austin
Drafted By - Rob Luke

GENERAL CONSTRUCTION



SHEET NO. 5A

15-AUG-2001 15:36
C:\Users\hgifford\p\d\153739 Astoria\10417.gr1

- ① Sta. "MC" 10+403.39
Inst. 300 mm Sew. Pipe Outfall - 14.3 m
Trench Exc. - 11.1 m³
Inst. Outlet Basin
(For Details, See Sht. 2B-6)
- ② Sta. "MC" 10+415.68
Const. Type "CG-2" Inlet - 2
Inst. 300 mm Sew. Pipe - 23.3 m
Trench Exc. - 16.7 m³
- ③ Const. Drainage Swale
(For Details, See Sht. 2B-6)
- ⑩ Const. Type "A" Curb
- ⑪ Const. Type "F" Curb
- ⑫ Const. P.C. Conc. Walk
- ⑬ Const. Sidewalk Ramp (Bikeway)
- ⑭ Sta. "MC" 10+373.9 (26.2 Rt.)
To Sta. "MC" 10+453.0 (6.6 Rt.)
Const. Guardrail - 87.63 m (Type 2A)
Const. Anchor (Type 1)
Inst. End Piece (Type B)
Const. Guardrail Connection
(See Drg. No. RD400, RD405, RD415,
RD417, RD440)
- ⑮ Sta. "TL" 30+627 To Sta. "MC" 10+453
Remove Extg. Guardrail - 245 m ±
- ⑯ Sta. "MC" 10+406.4 (19.4 Lt.)
To Sta. "MC" 10+453.0 (8.9 Lt.)
Const. Guardrail - 45.72 m (Type 2A)
Const. Anchor (Type 1)
Inst. End Piece (Type B)
Const. Guardrail Connection
- ⑳ See Sht. 3B, Note 24
- ㉔ Const. Asphalt Ramp
(For Details, See Sht. 2B-4)
- ㉕ See Sht. 3B, Note 14
- ㉖ Remove Inlet
- ㉗ Const. Conc. Island - 87 m²
Stamped Conc. Island Surfacing
(For Details, See Sht 2B-4)
- ㉘ Const. Conc. Island - 8 m²
Stamped Conc. Island Surfacing
(For Details, See Sht 2B-4)

15-AUG-2001 15:03

C:\Users\shgifford\153739 Astoria\10417.dwg

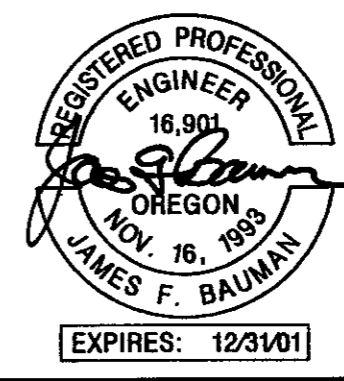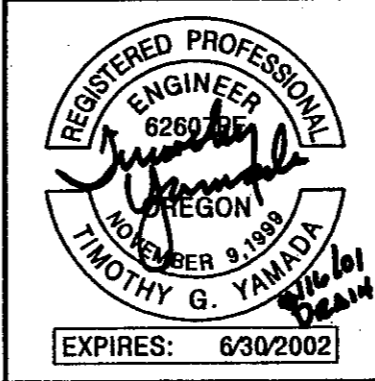

OREGON DEPARTMENT OF TRANSPORTATION ROADWAY ENGINEERING SECTION	
U.S.-101 AT NEHALEM HWY. (ASTORIA) SEC. OREGON COAST & NEHALEM HWYS. CLATSOP COUNTY	
Designed By - Tim Yamada Designed By - Kristin Austin Drafted By - Rob Luke	
GENERAL CONSTRUCTION	SHEET NO. 5B