

# OPERATION & MAINTENANCE MANUAL

**DFI No. D00054**

**Facility Type: Water Quality Biofiltration  
Swale**



**DECEMBER, 2011**

**INDEX**

**1. IDENTIFICATION ..... 1**

**2. FACILITY CONTACT INFORMATION..... 1**

**3. CONSTRUCTION..... 1**

**4. STORM DRAIN SYSTEM AND FACILITY OVERVIEW ..... 1**

**5. FACILITY HAZ MAT SPILL FEATURE(S)..... 5**

**6. AUXILIARY OUTLET (HIGH FLOW BYPASS) ..... 5**

**7. MAINTENANCE REQUIREMENTS ..... 5**

**8. WASTE MATERIAL HANDLING ..... 6**

**APPENDIX A: Operational Plan and Profile Drawing(s)**

**APPENDIX B: ODOT Project Plan Sheets**

## 1. Identification

Drainage Facility ID (DFI): **D00054**  
Facility Type: Water Quality Biofiltration Swale  
Construction Drawings: (V-File Number) 34V-107  
Location: District: 1  
Highway No.: 009  
Mile Post: 4.22 / 4.28 (beg./end)  
Description: This facility is located on the western side of the southbound lane of the US 101 (Hwy 009). Access may be obtained directly from the right shoulder of the southbound travel lane.

## 2. Facility Contact Information

Contact the Engineer of Record, Region Technical Center, or Geo-Environmental's Senior Hydraulics Engineer for:

- Operational clarification
- Maintenance clarification
- Repair or restoration assistance

Engineering Contacts:

Region Technical Center Hydro

Or

Geo-Environmental Senior Hydraulics Engineer (503) 986-3365.

## 3. Construction

Engineer of Record: ODOT Designers: Region 2 Tech. Center, T. Yamada, K. Austin, 503-986-2990

Facility construction: 2001  
Contractor: NB Hatch Company

#### 4. Storm Drain System and Facility Overview

A water quality swale is a flat-bottomed open channel designed to treat stormwater runoff from highway pavement areas. This type of facility is lined with grass. Treatment by trapping sedimentation occurs when stormwater runoff flows through the grass.

This facility is located on the western side of the southbound lane of the US 101 (Hwy 009) just north of the round-a-bout configured intersection with Newhalem Highway. Access may be obtained directly from the right shoulder of the southbound travel lane.

The drainage area for this swale includes a segment of the southbound travel lanes of US 101 (Hwy 009). The swale receives water from three sources including sheet flow throughout the swale length, inlets near the center of the swale, and the treated flow from a nearby swale facility DFI D00053. At the northern end of the swale, runoff sheet flows into the facility. At the southern end of the swale, the treated flow from DFI D00053 is directed into the swale through a 12-inch culvert pipe, conveyed beneath a 10-foot concrete sidewalk (Refer to Point A of the Operational Plan in Appendix A; and Photo 1). The inlets near the center of the swale serve as overflow stormwater inlets (Point D) for a sag (roadway low point where extra runoff collects) vertical curve.

After treatment, the stormwater exits the swale through a ditch inlet located approximately midway through the facility (Point B, and Photos 3 and 4). Piping from the ditch inlet is directed into a collector manhole (Point C) that also accommodates the flows from other adjacent swale facilities, DFI D00049, and DFI D00050. Flows from the collector manhole are then directed westerly into an 18-inch outfall and discharged toward a fairly steep ditch that drains into the Columbia River.

A. Maintenance equipment access:

Maintenance access can be obtained from the southbound travel lanes of US 101 (Hwy 009). The concrete sidewalk can be used for parking vehicles.

B. Heavy equipment access into facility:

- Allowed (no limitations)
- Allowed (with limitations)
- Not allowed

C. Special Features:

- Amended Soils
- Porous Pavers

- Liners
- Underdrains



Photo 1: Swale Inlet, 12-inch culvert pipe, at the southern portion of the swale. A 10-foot wide concrete sidewalk is shown to the right.



Photo 2: Photo of swale looking to the north.



Photo 3: Midpoint of swale where swale outlet is obtained from ditch inlet.



Photo 4: Looking southeast at the facility outlet; Point B on the Operational Plan.

## 5. Facility Haz Mat Spill Feature(s)

The water quality biofiltration swale can be used to store a volume of liquid by blocking the 18-inch diameter outlet pipe located at the outlet of the swale. This pipe is noted as point B on the Operational Plan, Appendix A.

## 6. Auxiliary Outlet (High Flow Bypass)

Auxiliary Outlets are provided if the primary outlet control structure can not safely pass the projected high flows. Broad-crested spillway weirs and over flow risers are the two most common auxiliary outlets used in stormwater treatment facility design. The auxiliary outlet feature is either a part of the facility or an additional storm drain feature/structure.

The auxiliary outlet feature for this facility is:

Designed into facility

The auxiliary outlet is included in the design of the swale by including a pipe connecting to adjacent swales. By linking the swales, stormwater can flow into neighboring facilities and slow down while undergoing treatment.

Other, as noted below

## 7. Maintenance Requirements

Routine maintenance table for non-proprietary stormwater treatment and storage/detention facilities have been incorporated into ODOT's Maintenance Guide. These tables summarize the maintenance requirements for ponds, swales, filter strips, bioslopes, and detention tanks and vaults. Special maintenance requirements in addition to the routine requirements are noted below when applicable.

The ODOT Maintenance Guide can be viewed at the following website:

<http://www.oregon.gov/ODOT/HWY/OOM/MGuide.shtml>

Maintenance requirements for proprietary structures, such as underground water quality manholes and/or vaults with filter media are noted in Appendix C when applicable.

The following stormwater facility maintenance table (See ODOT Maintenance Guide) should be used to maintain the facility outlined in this Operation and Maintenance Manual or follow the Maintenance requirements outlined in Appendix C when proprietary structure is selected below:

- Table 1 (general maintenance)
- Table 2 (stormwater ponds)
- Table 3 (water quality biofiltration swales)
- Table 4 (water quality filter strips)
- Table 5 (water quality bioslopes)
- Table 6 (detention tank)
- Table 7 (detention vault)
- Appendix C (proprietary structure)
- Special Maintenance requirements:

Note: Special maintenance Requirements Require Concurrence from ODOT SR Hydraulics Engineer.

## 8. Waste Material Handling

Material removed from the facility is defined as waste by DEQ. Refer to the roadwaste section of the ODOT Maintenance Yard Environmental Management System (EMS) Policy and Procedures Manual for disposal options: <http://egov.oregon.gov/ODOT/HWY/OOM/EMS.shtml>

Contact any of the following for more detailed information about management of waste materials found on site:


ODOT Clean Water Unit	(503) 986-3008
ODOT Statewide Hazmat Coordinator	(503) 229-5129
ODOT Region Hazmat Coordinator	(503) 986-2647
ODEQ Northwest Region Office	(503) 229-5263



# Appendix A

## Content:

- **Operational Plan and Profile Drawing(s)**

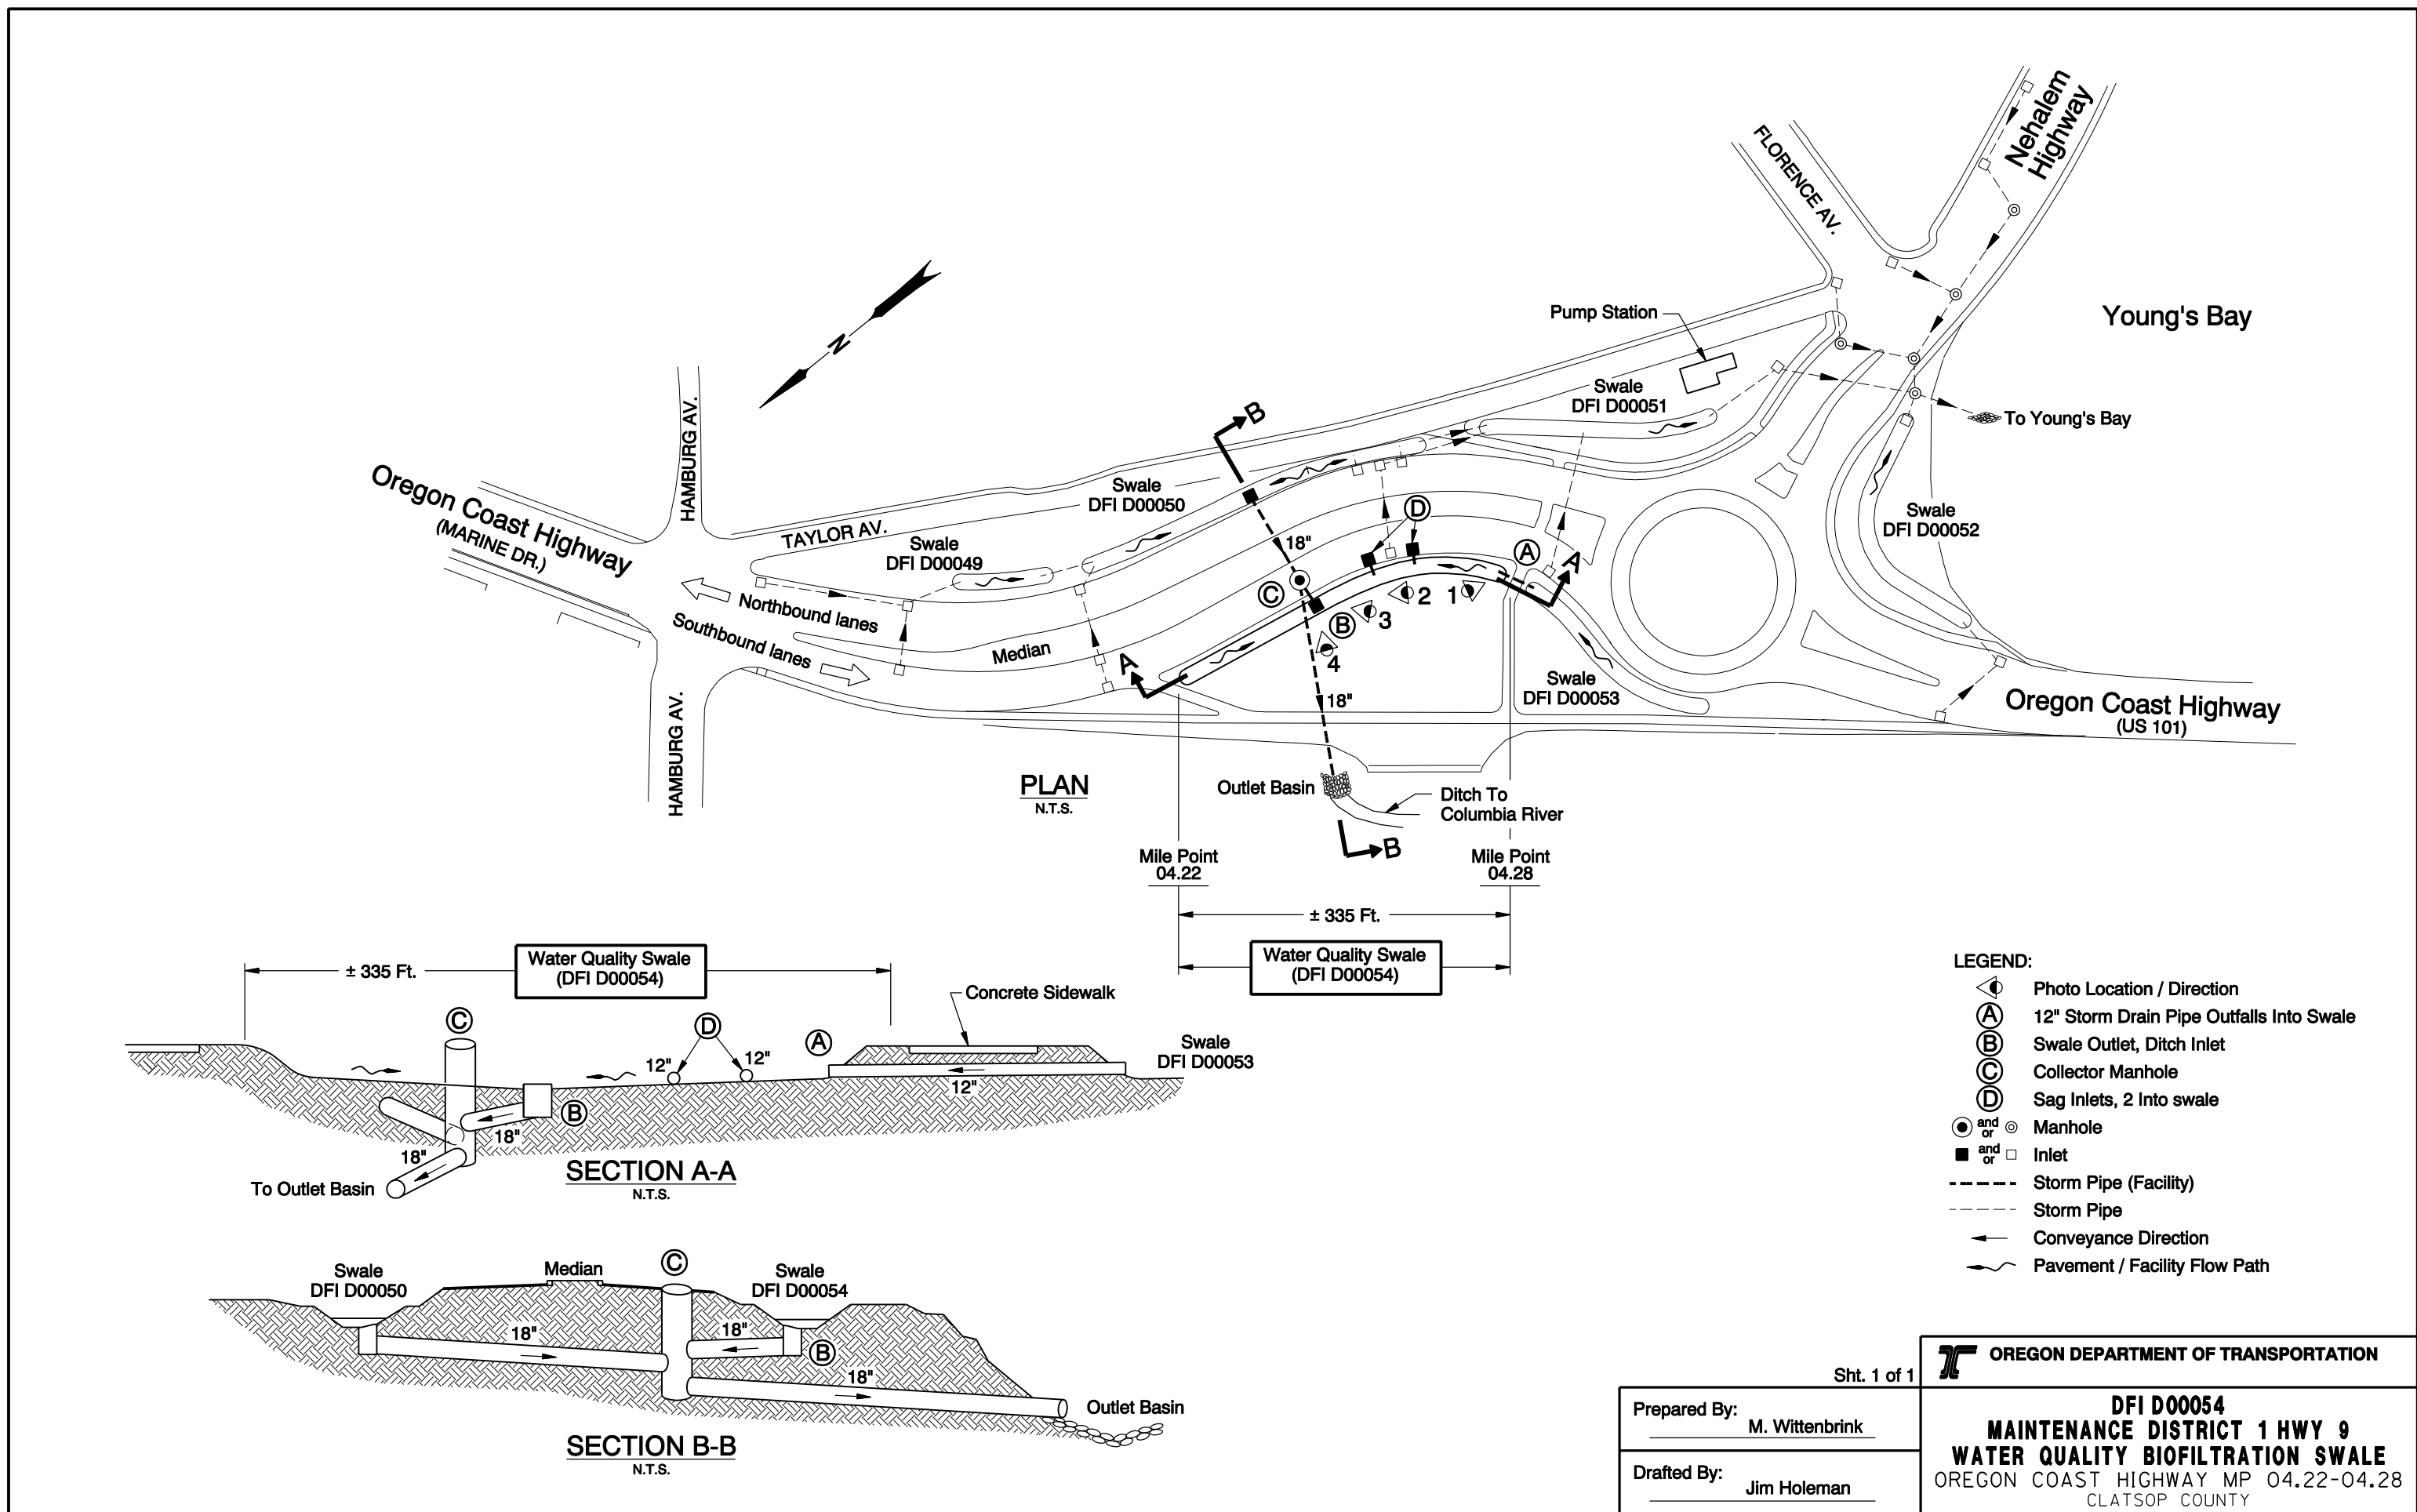

PLAN  
N.T.S.

SECTION A-A  
N.T.S.

SECTION B-B  
N.T.S.

- LEGEND:
- Photo Location / Direction
  - 12" Storm Drain Pipe Outfalls Into Swale
  - Swale Outlet, Ditch Inlet
  - Collector Manhole
  - Sag Inlets, 2 Into swale
  - Manhole
  - Inlet
  - Storm Pipe (Facility)
  - Storm Pipe
  - Conveyance Direction
  - Pavement / Facility Flow Path

Sht. 1 of 1 OREGON DEPARTMENT OF TRANSPORTATION

Prepared By: M. Wittenbrink  
 Drafted By: Jim Holeman

**DFI D00054**  
**MAINTENANCE DISTRICT 1 HWY 9**  
**WATER QUALITY BIOFILTRATION SWALE**  
 OREGON COAST HIGHWAY MP 04.22-04.28  
 CLATSOP COUNTY

# Appendix B


## Content:

- **ODOT Project Plan Sheets**
  - *Cover/Title Sheet*
  - *Water Quality/Detention Plan Sheets*
  - *Other Details*

STATE OF OREGON  
DEPARTMENT OF TRANSPORTATION

PLANS FOR PROPOSED PROJECT

GRADING, PAVING, & SIGNING  
**US-101 AT NEHALEM HWY.  
(ASTORIA) SEC.**  
**OREGON COAST & NEHALEM HWYS.**  
CLATSOP COUNTY  
OCTOBER 2001

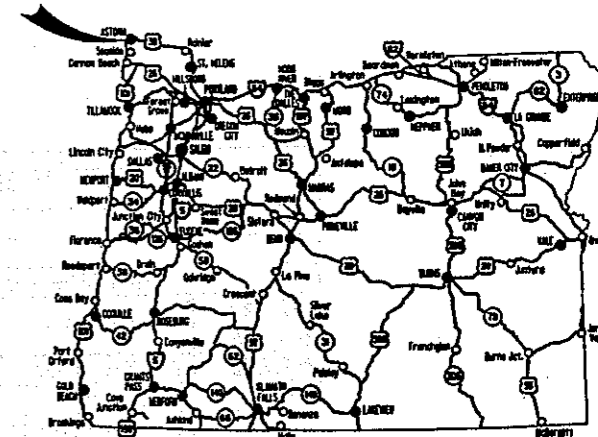

Overall Length Of Project - 0.61 km (0.38 Mile)

INDEX OF SHEETS	
SHEET NO.	DESCRIPTION
1	Title Sheet
1A	Index Of Sheets Cont'd. & Standard Drawing Nos.
2, 2A, 2A-2	Typical Sections
2B Thru 2B-6 Incl.	Details
2C	Traffic Control Detour & Details
2C-2 Thru 2C-21 Incl.	Traffic Control Plans
2D, 2D-2	Erosion Control Details
2D-3 Thru 2D-4 Incl.	Erosion Control Plans
2E	Pipe Data
3	"ML", "MR" Line Alignment
3A, 3B	General Construction
3C	"ML", "MR" Line Profile
4	"ML", "MR", "MC", "C", "TL", "TR" Line Alignment
4A, 4B	General Construction
4C	"ML", "MR" Line Profile
4D	"C" Line Profile
5	"MC", "TL", "TR" Line Alignment
5A, 5B	General Construction
5C	"MC" Line Profile
6	"TL", "TR" Line Alignment
6A, 6B	General Construction
6C	"TL", "TR" Line Profile
7	"TL" Line Alignment
7A, 7B	General Construction
7C	"TL" Line Profile



**ATTENTION :**  
Oregon Law Requires You To Follow Rules Adopted By The Oregon Utility Notification Center. Those Rules Are Set Forth In OAR 952-001-0010 Through OAR 952-001-0030. You May Obtain Copies Of The Rules From The Center, Or Answers To Questions About The Rules By Calling (503) 232-1987.

LET'S ALL  
WORK TOGETHER  
TO MAKE THIS  
JOB SAFE

NH-HPP-ACHPP-S009(128)  
**BEGINNING OF PROJECT**  
STA. 'MR' 10 + 060


**END OF PROJECT** NH-HPP-ACHPP-S009(128)  
STA. 'MR' 10 + 450

NH-HPP-ACHPP-S009(128)  
**END OF PROJECT**  
STA. 'TL' 30 + 640

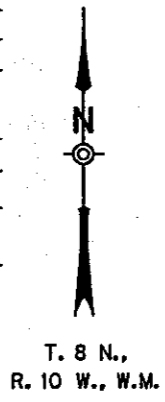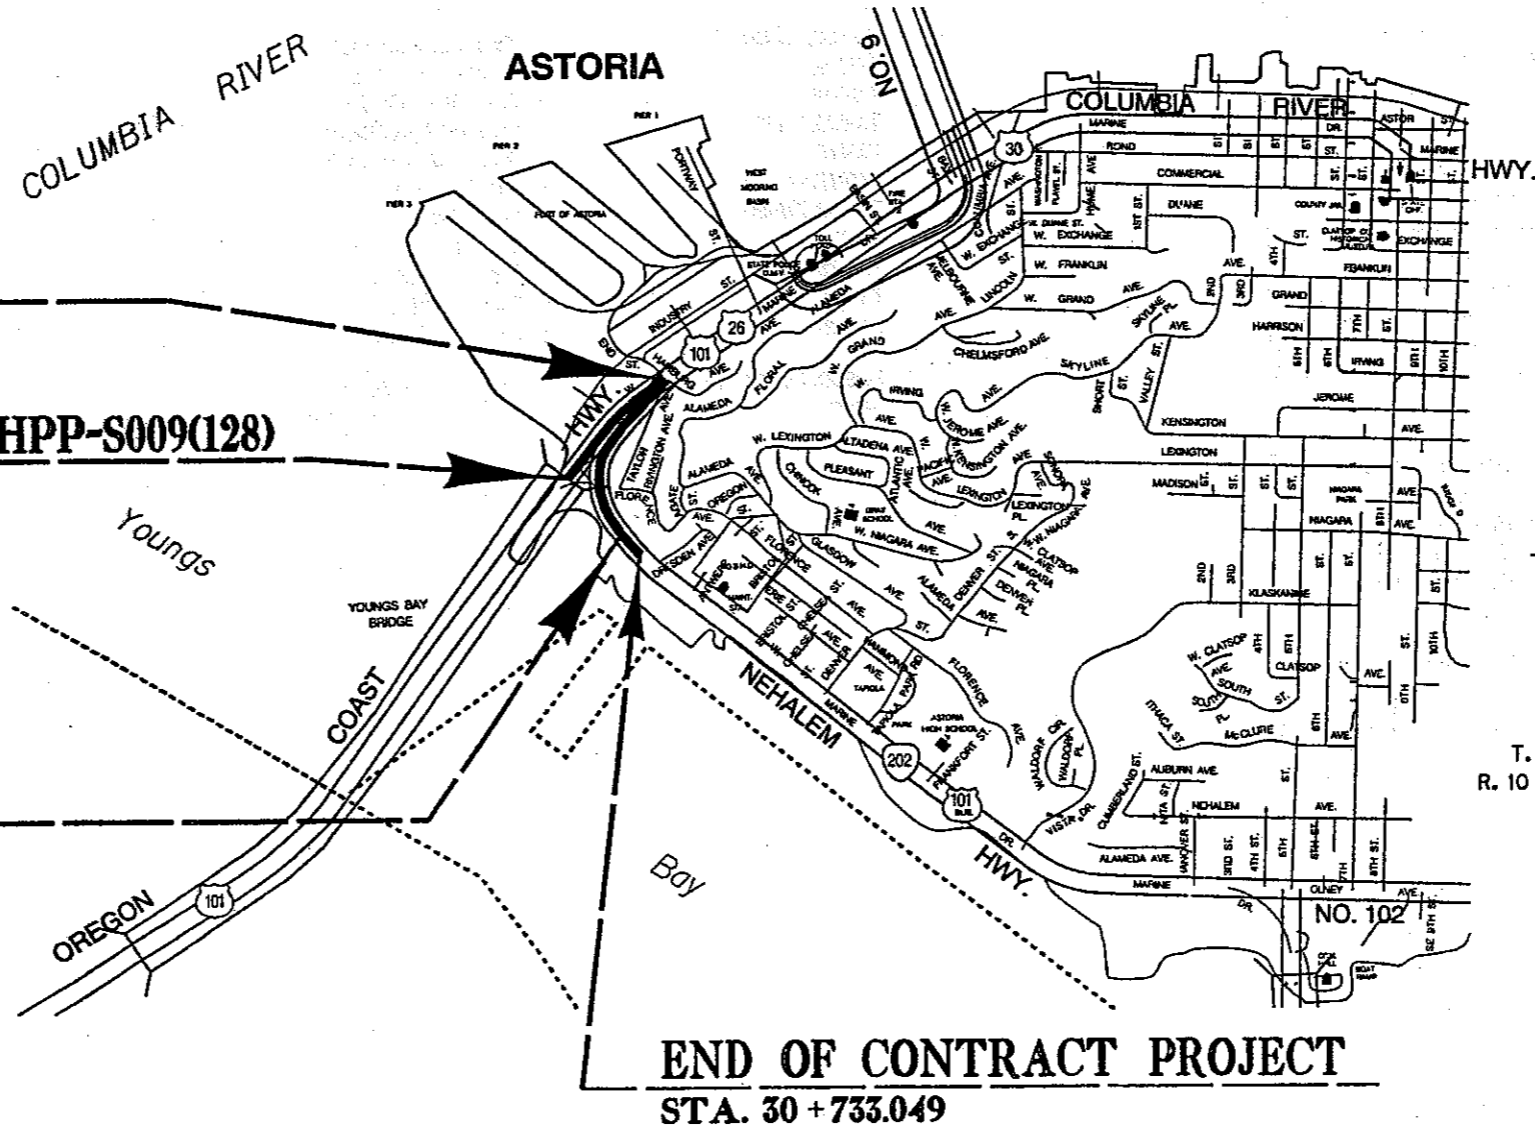

OREGON TRANSPORTATION COMMISSION

- Steven H. Corey CHAIRMAN
- Gail L. Achterman COMMISSIONER
- Stuart Foster COMMISSIONER
- Randall Pape COMMISSIONER
- John Russell COMMISSIONER
- Bruce A. Warner DIRECTOR OF TRANSPORTATION

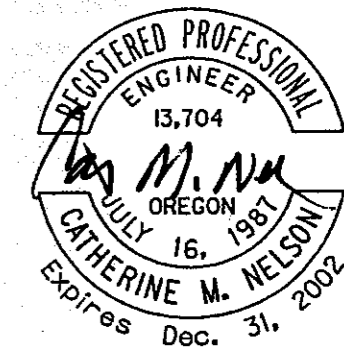

Catherine M. Nelson

ACTING TECHNICAL SERVICES MANAGING ENGINEER

**US-101 AT NEHALEM HWY.  
(ASTORIA) SEC.**  
OREGON COAST & NEHALEM HWYS.  
CLATSOP COUNTY

FEDERAL HIGHWAY ADMINISTRATION	PROJECT NUMBER	SHEET NO.
OREGON DIVISION	NH-HPP-ACHPP-S009(128)	1




**END OF CONTRACT PROJECT**  
STA. 30 + 733.049


**AS CONSTRUCTED**  
A *Diana* PROJECT MANAGER 8/20/03 DATE

22-AUG-2001 11:54


C:\usr\proj\sect\ACHPP\2.mxd

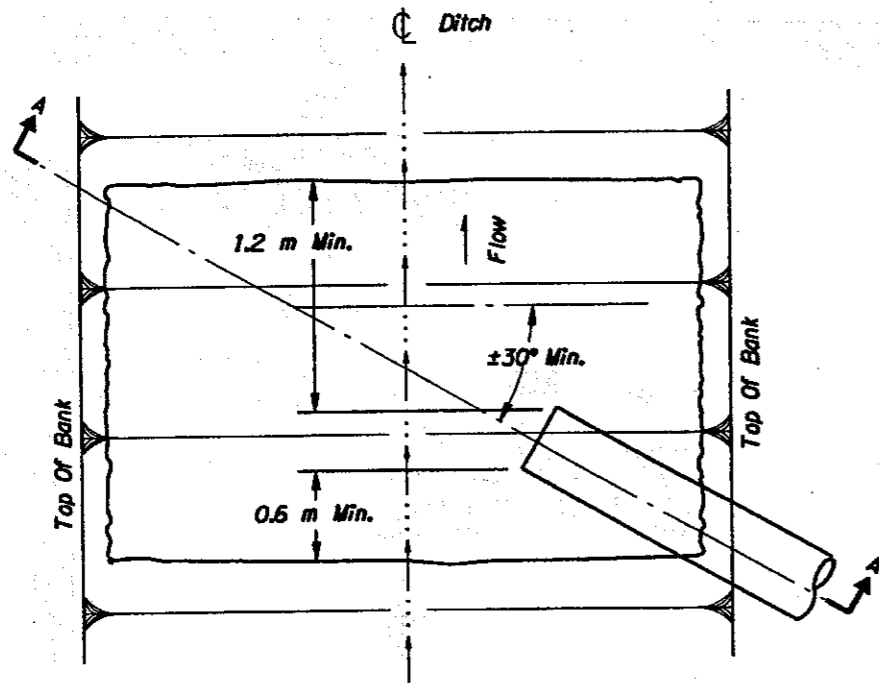

PLAN

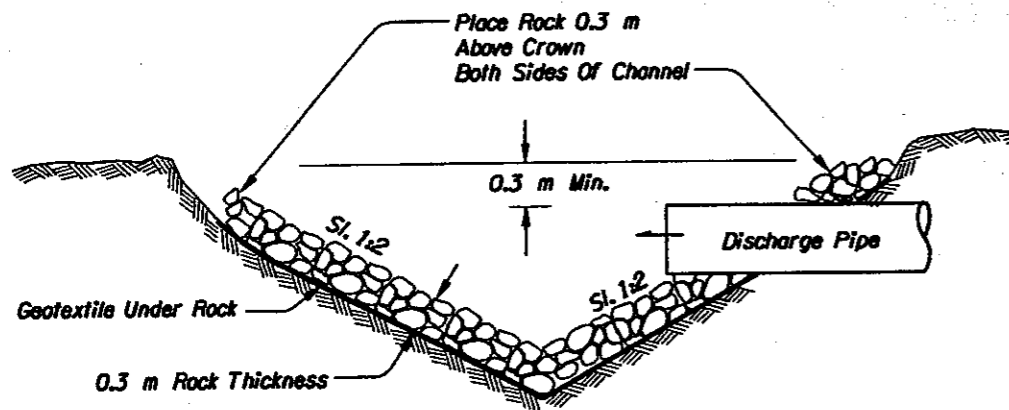

SECTION A - A  
OUTLET BASIN

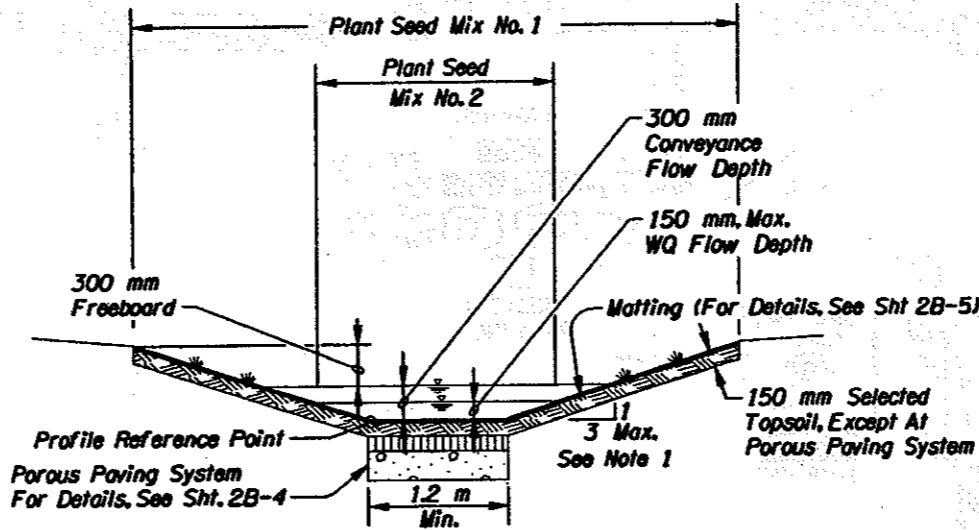


Eastside Ditch  
Sta. "ML" 20+125.3 Lt. To Sta. "ML" 20+217.8 Lt.  
Sta. "ML" 20+275.6 Lt. To Sta. "TL" 30+424.9 Lt.

Southside Ditch  
Sta. "MC" 10+403.2 Lt. To Sta. "TL" 30+489.3 Rt.

NOTE:


- Increase Slope To IV : 2H Adjacent To Existing Wastewater Pump Station (Sta. "TL" 30+432.7 Lt. To Sta. "TL" 30+452.9 Lt.)

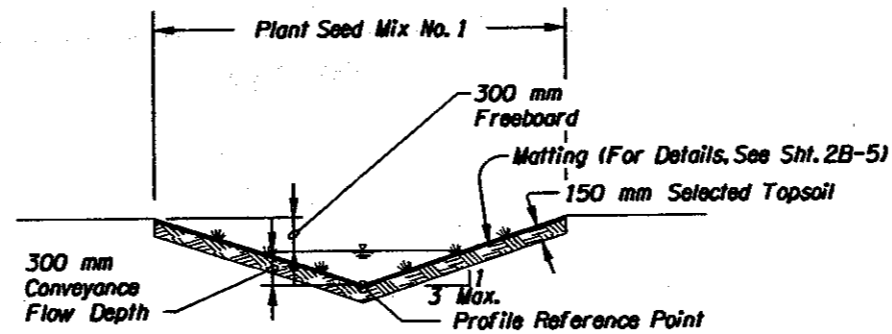

Westside ditch  
Sta. "MC" 10+342.9 Rt. To Sta. "MR" 10+163.4 Rt.

Eastside Ditch  
Sta. "ML" 20+217.8 Lt. To Sta. "ML" 20+275.6 Lt.


DRAINAGE SWALE DETAIL

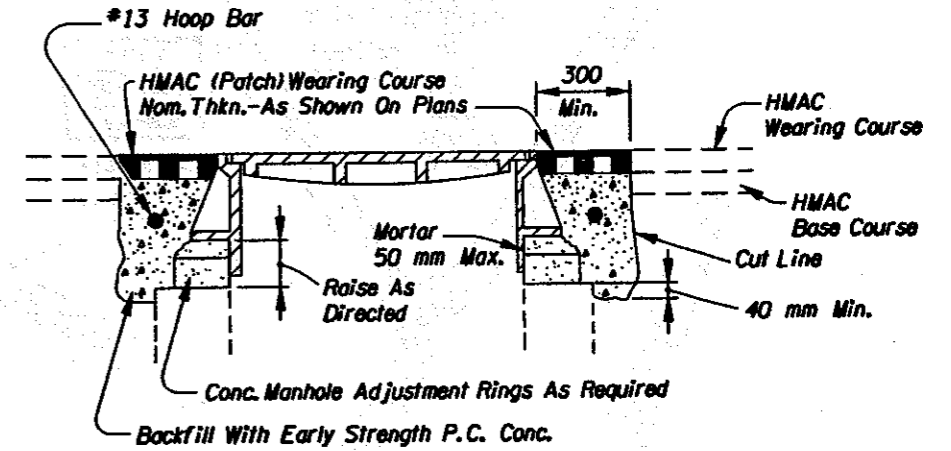

- Backfill With Early Strength P.C. Conc.
- Cover Manhole With Building Paper And Const. HMAC Base And Wearing Courses.
  - Sawcut Square Or Circular Excavation Around Manhole 300 mm Min. From M.H. Frame. Orient Diagonal Of Square So That Its Is Parallel To Roadway Center Line.
  - Raise Manhole Frame And Cover To Finish Grade By Installing Conc. Rings And Levelling Mortar.
  - Backfill With Early Strength P.C. Conc. And HMAC Wearing Course.

METHOD "A"  
MANHOLE ADJUSTMENT SEQUENCE

Note:  
All Dimensions Are  
In Millimeters (mm) Unless  
Otherwise Indicated.

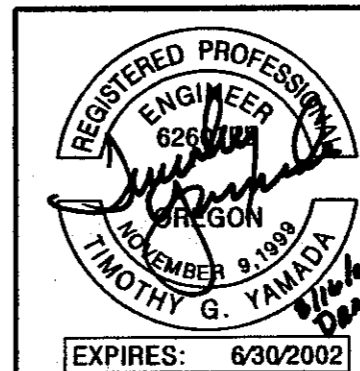

OREGON DEPARTMENT OF TRANSPORTATION  
ROADWAY ENGINEERING SECTION

U.S.-101 AT NEHALEM HWY. (ASTORIA) SEC.  
OREGON COAST & NEHALEM HWYS.  
CLATSOP COUNTY

Designed By - Tim Yamada  
Drafted By - Rob Luke

DETAILS


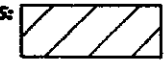



SHEET NO.  
2B-6


15-AUG-2001 09:51 C:\Users\sgifford\Documents\153739 Astoria\10417.dwg

T. 8 N, R. 10 W, W.M.  
ASTORIA

CH2MHILL

NH-HPP-ACHPP-S009(128)  
BEGINNING OF PROJECT  
STA. "MR" 10+060  
STA. "ML" 20+060


- Concrete Island  
Shown Thus:   
(For Details, See Sht. 2B-4)
- Pavement Removal  
Shown Thus:   
(For Details, See Sht. 2B-4)
- Aggregate Base  
Shown Thus:   
(For Details, See Sht. 2B-4)
- Porous Pavers  
Shown Thus:   
(For Details, See Sht. 2B-4)
- P.C. Conc. Walk  
Shown Thus: 

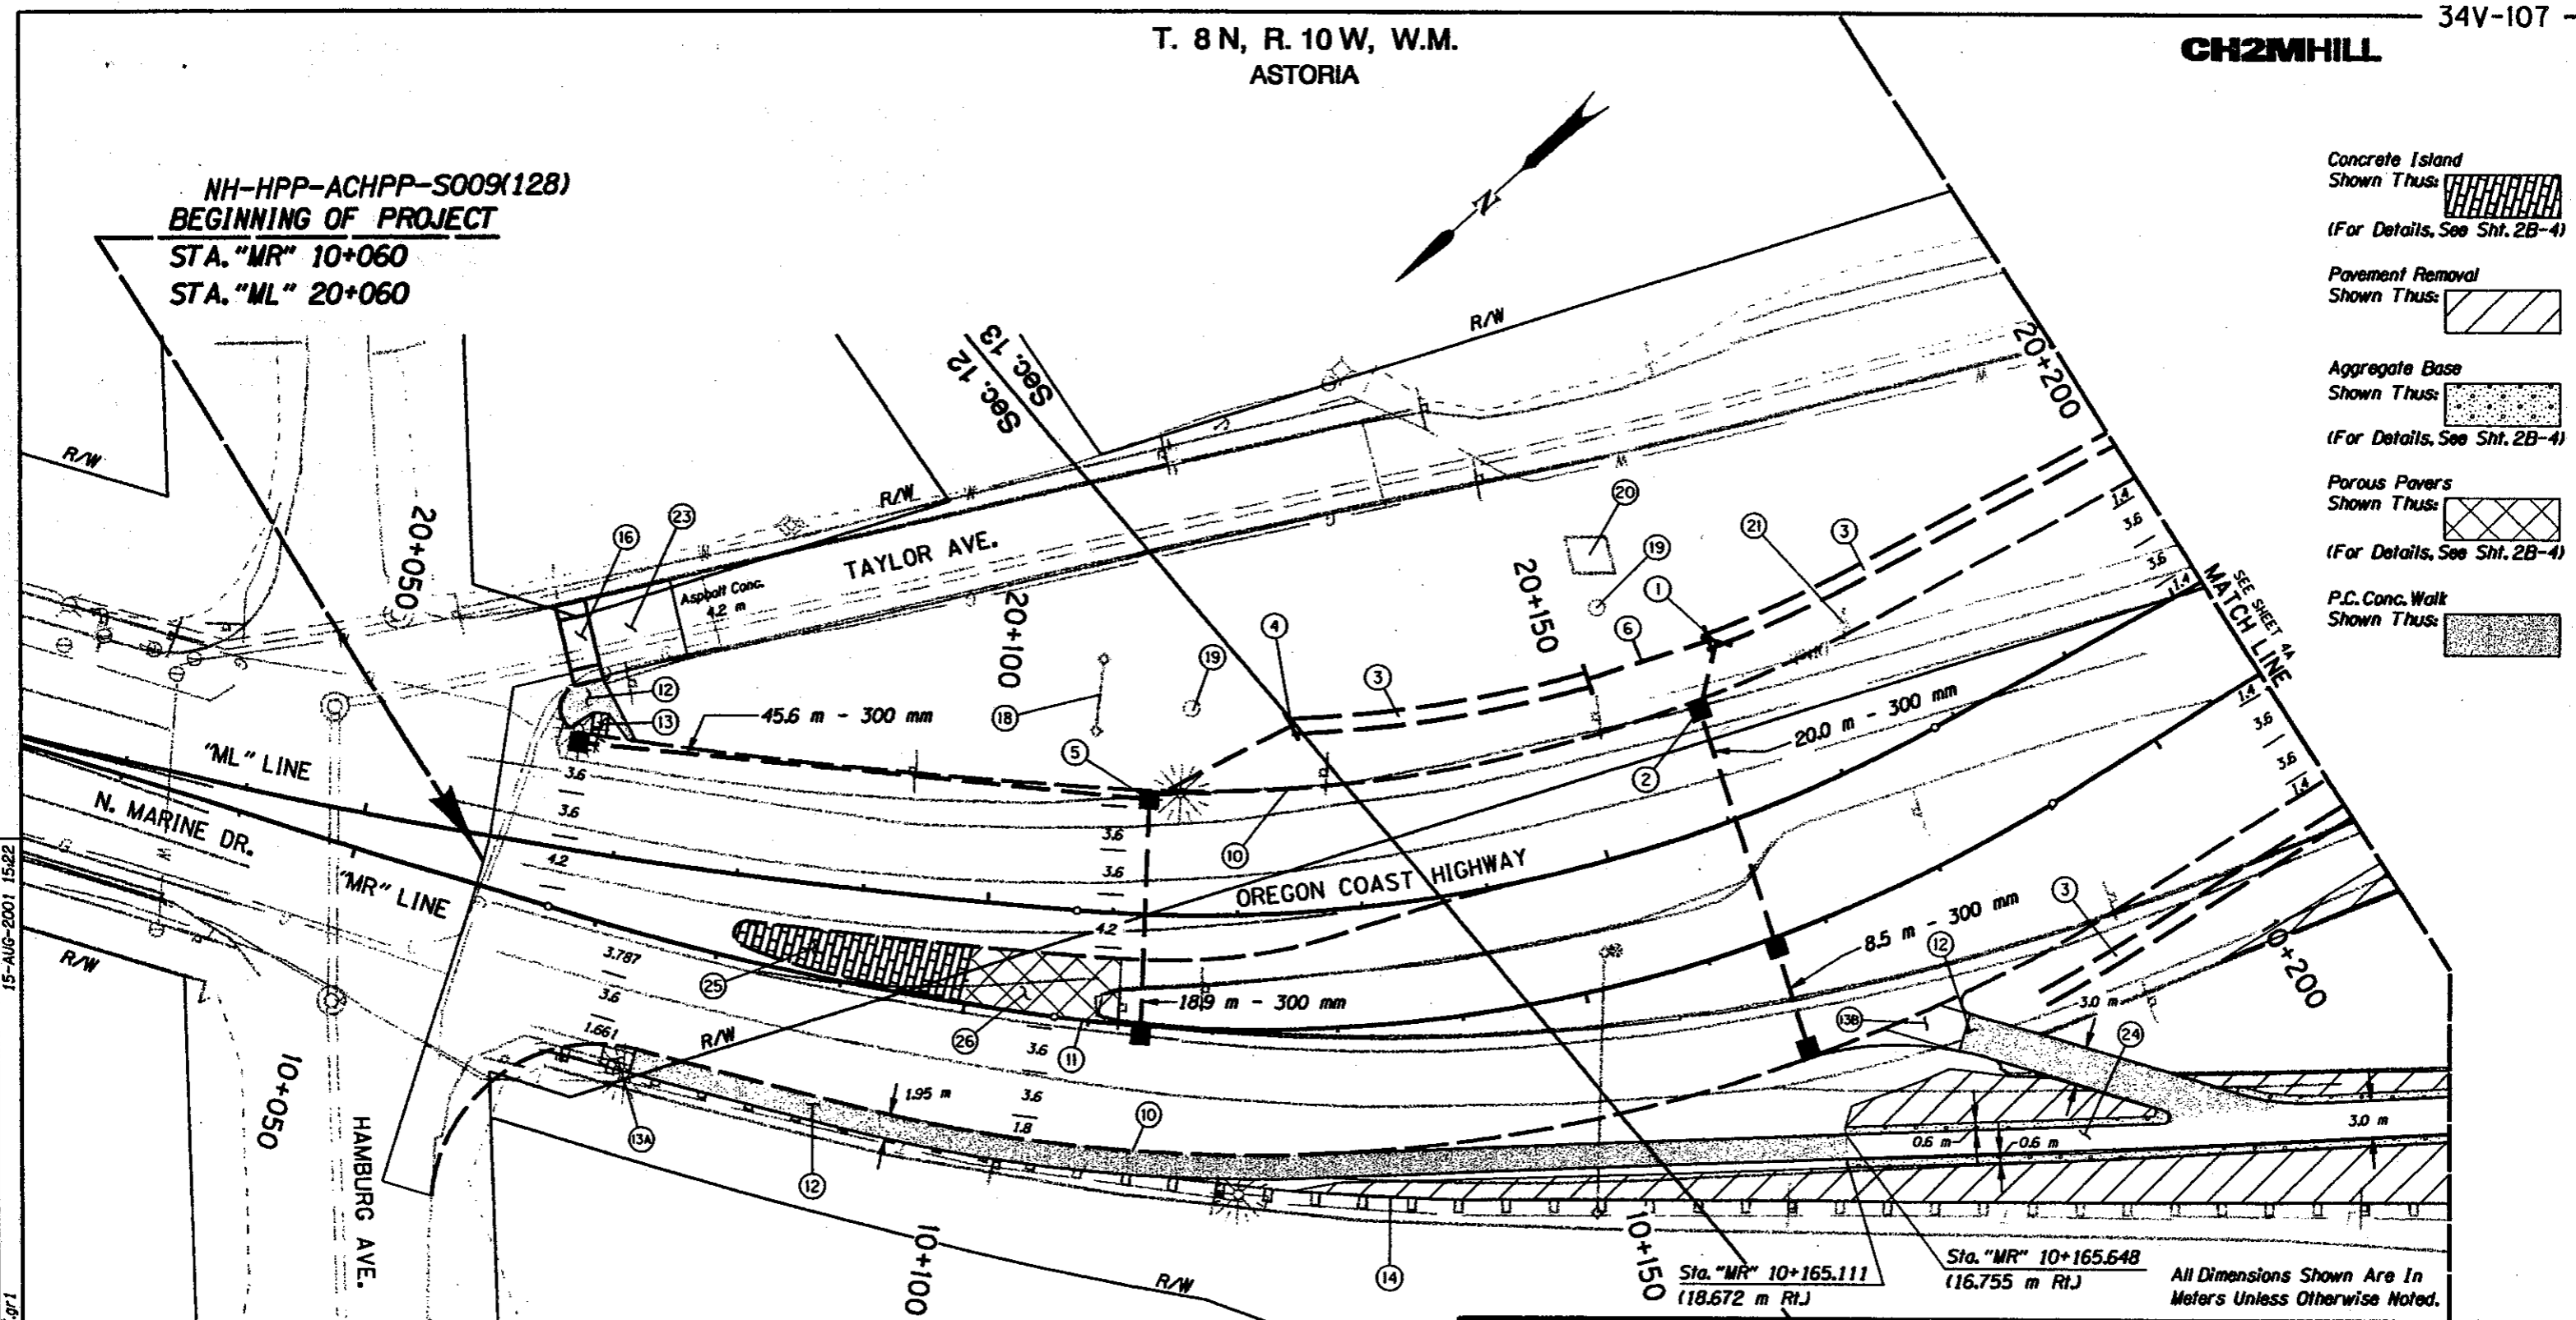

15-AUG-2001 15:22  
C:\User\sjhg\fordr\153739 Astoria\10417.gr1

Sta. "MR" 10+165.111 (18.672 m Rt.)  
Sta. "MR" 10+165.648 (16.755 m Rt.)

All Dimensions Shown Are In Meters Unless Otherwise Noted.

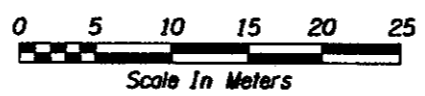

REGISTERED PROFESSIONAL ENGINEER  
6260  
*Timothy G. Yamada*  
OREGON  
NOVEMBER 9, 1999  
TIMOTHY G. YAMADA  
EXPIRES: 6/30/2002

REGISTERED PROFESSIONAL ENGINEER  
16,901  
*James F. Bauman*  
OREGON  
NOV. 16, 1993  
JAMES F. BAUMAN  
EXPIRES: 12/31/01

OREGON DEPARTMENT OF TRANSPORTATION  
ROADWAY ENGINEERING SECTION

U.S.-101 AT NEHALEM HWY. (ASTORIA) SEC.  
OREGON COAST & NEHALEM HWYS.  
CLATSOP COUNTY

Designed By - Tim Yamada  
Designed By - Kristin Austin  
Drafted By - Rob Luke


GENERAL CONSTRUCTION

SHEET NO. 3A

**CH2MHILL**

- ① Sta. "ML" 20+164.65  
Inst. 300 mm Sew. Pipe Outfall - 5.8 m  
Trench Exc. - 4.1 m<sup>3</sup>  
Inst. Outlet Basin  
(For Details, See Sht. 2B-6)
- ② Sta. "ML" 20+161.03  
Const. Type "CG-2" Inlet - 2  
Const. Type "G-2" Inlet  
Inst. 300 mm Sew. Pipe - 28.5 m  
Trench Exc. - 19.7 m<sup>3</sup>  
(See Drg. No. RD336)
- ③ Const. Drainage Swale  
(For Details, See Sht. 2B-6)
- ④ Sta. "ML" 20+125.26  
Inst. 300 mm Sew. Pipe Outfall - 12.8 m  
Trench Exc. - 11.2 m<sup>3</sup>  
Inst. Outlet Basin  
(For Details, See Sht. 2B-6)
- ⑤ Sta. "ML" 20+112.60  
Const. Type "CG-2" Inlet  
Const. Type "G-2" Inlet - 2  
Inst. 300 mm Sew. Pipe - 64.5 m  
Trench Exc. - 57.4 m<sup>3</sup>  
(See Drg. No. RD336)
- ⑥ Sta. "ML" 20+152.65  
Inst. 450 mm Culvert Pipe - 10.0 m  
Trench Exc. 9.8 m<sup>3</sup>
- ⑩ Const. Type "A" Curb  
(See Drg. No. RD700)
- ⑪ Const. Type "F" Curb  
(See Drg. No. RD700)
- ⑫ Const. P.C. Conc. Walk
- ⑬ Const. Sidewalk Ramp  
(See Drg. No. RD725)
- ⑬A Const. Modified Sidewalk Ramp  
(For Details, See Sht. 2B-4)
- ⑬B Const. Modified Sidewalk Ramp (Bikeway)  
(See Drg. No. RD725, General Note 7)
- ⑭ Sta. "MR" 10+068 To Sta. "MC" 10+453  
Remove Extg. Guardrail - 384 m
- ⑯ Const. P.C. Conc. Driveway, Option A  
(See Drg. No. 720)
- ⑰ Maintain And Protect Historic Sign
- ⑲ Maintain And Protect Stone Monument - 2
- ⑳ Maintain And Protect Historic Statue
- ㉑ Remove Utility Pole
- ㉒ Const. Asphalt Conc. Connection  
(See Drg. No. 715)
- ㉓ Sawcut Extg. Pavement To Maintain 3.0 m  
Wide Asphalt Conc. Path.  
(For Details, See Sht. 2B-4)  
Const. Connection Between P.C. Conc. Walks  
And Asphalt Conc. Path As Directed By  
Engineer.
- ㉔ Const. Conc. Island - 65 m<sup>2</sup>  
Stamped Conc. Island Surfacing  
(For Details, See Sht 2B-4)
- ㉕ Const. Porous Paver System - 60 m<sup>2</sup>  
(For Details, See Sht 2B-4)

C:\Users\pgriff\ford\153739 Astoria\10417.n1 15-AUG-2001 15:16

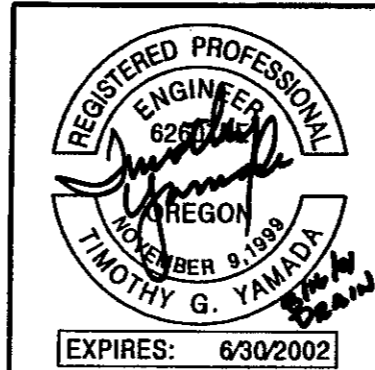


<b>OREGON DEPARTMENT OF TRANSPORTATION ROADWAY ENGINEERING SECTION</b>	
<b>U.S.-101 AT NEHALEM HWY. (ASTORIA) SEC. OREGON COAST &amp; NEHALEM HWYS. CLATSOP COUNTY</b>	
Designed By - Tim Yamada Designed By - Kristin Austin Drafted By - Rob Luke	
<b>GENERAL CONSTRUCTION</b>	SHEET NO. <b>3B</b>

NH-HPP-ACHPP-S009(128)

BEGINNING OF PROJECT

STA. "ML" 20+060

"ML" LINE

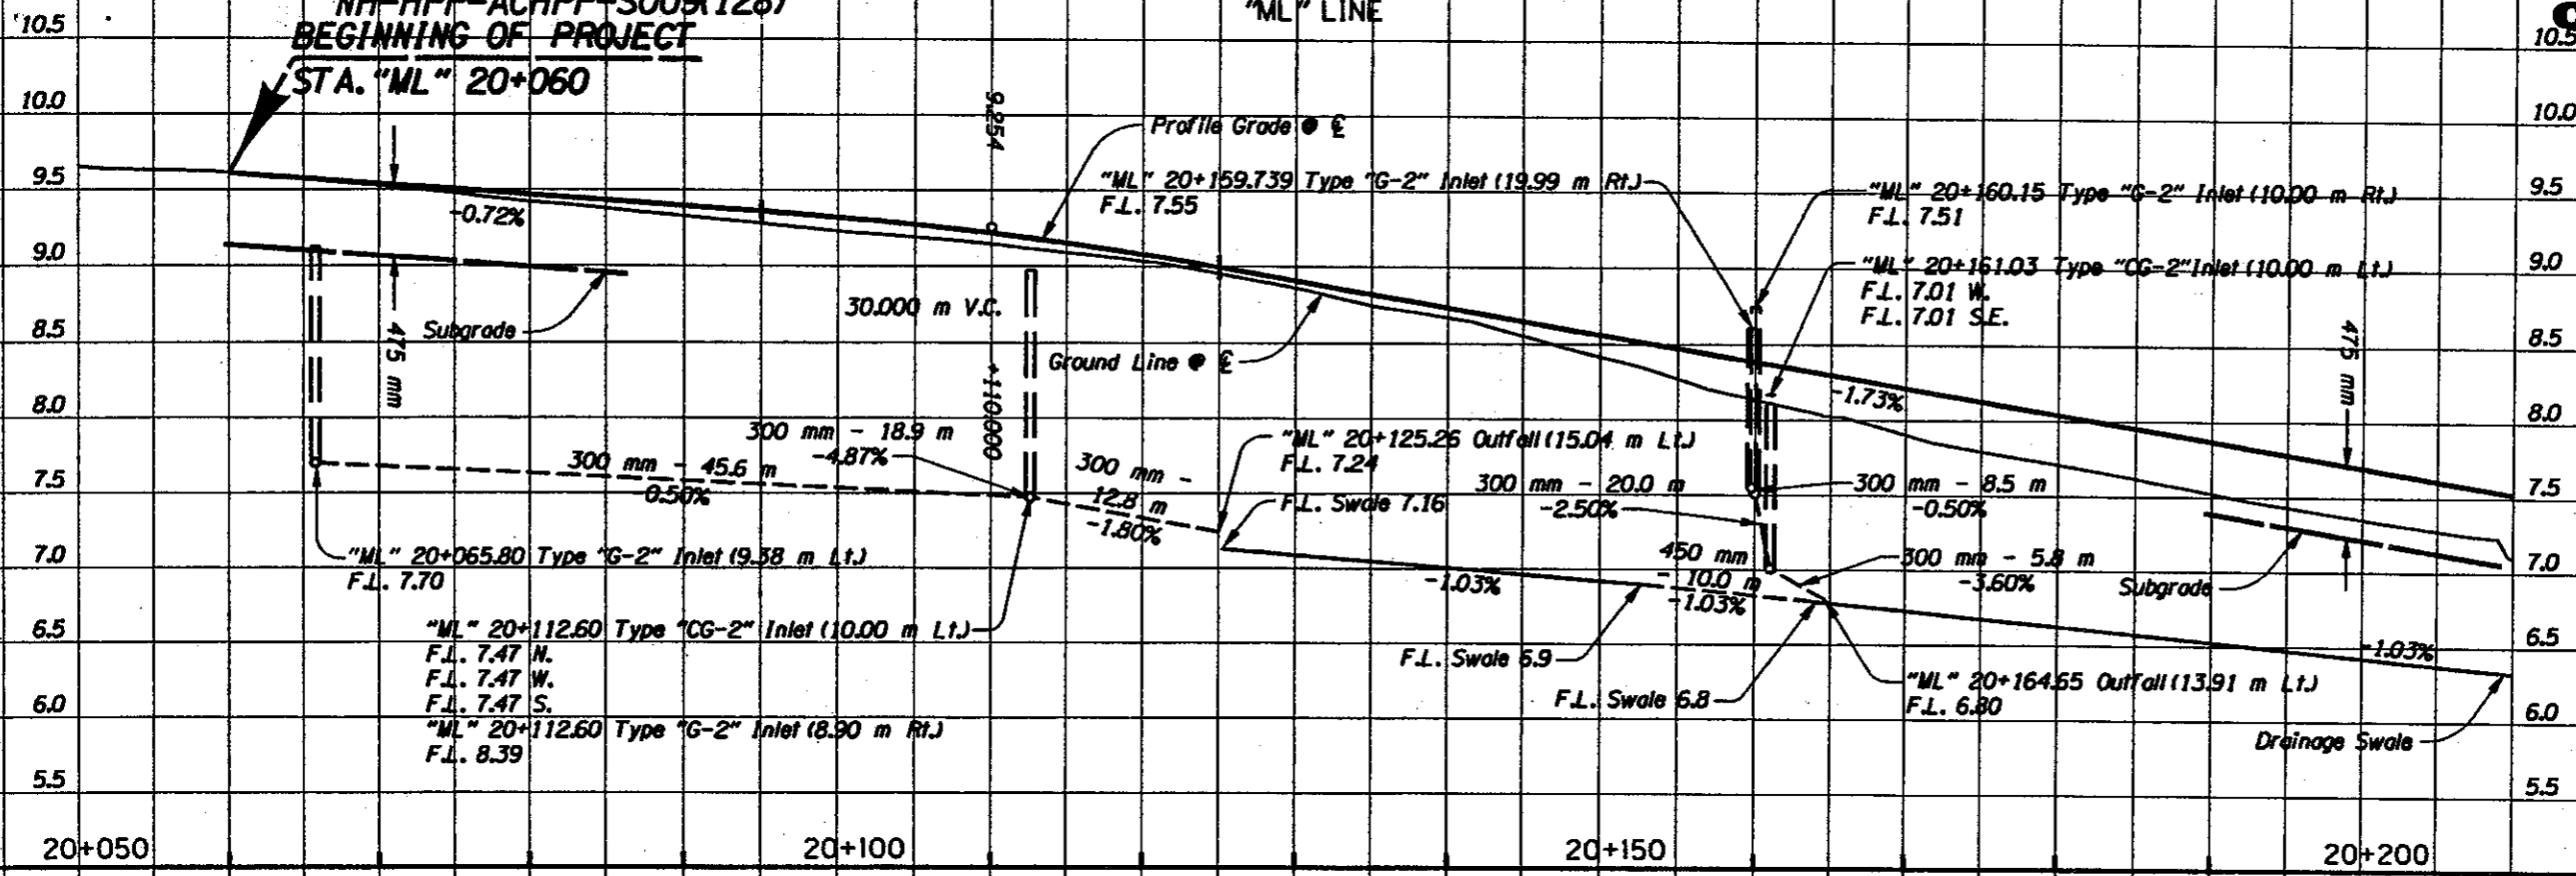


"ML" Line Earthwork Quantities:

Exc.	590 m <sup>3</sup>
Emb.	1000 m <sup>3</sup>
Ditch Exc.	260 m <sup>3</sup>

BEGINNING OF PROJECT

STA. "MR" 10+060

"MR" LINE

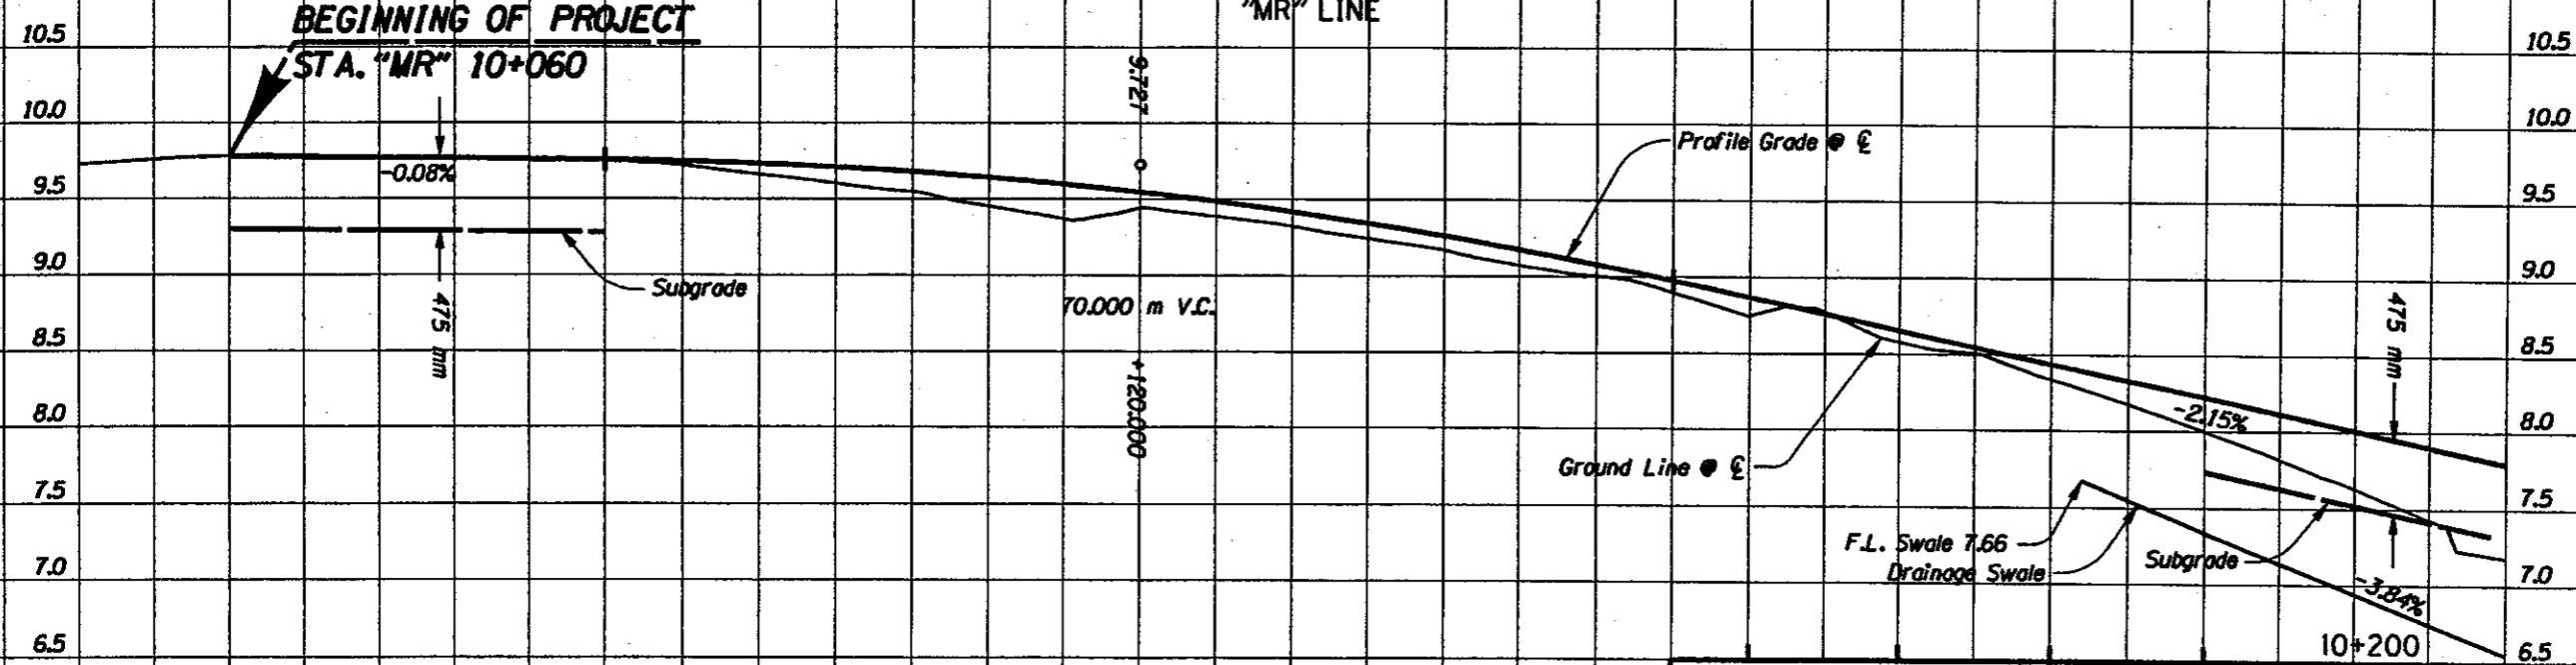

"MR" Line Earthwork Quantities:

Exc.	1190 m <sup>3</sup>
Emb.	970 m <sup>3</sup>
Ditch Exc.	100 m <sup>3</sup>

All Dimensions Shown Are In Meters Unless Otherwise Noted.

15-AUG-2001 10:43  
C:\Users\slightford\Documents\153739 Astoria\10417.dwg



OREGON DEPARTMENT OF TRANSPORTATION  
ROADWAY ENGINEERING SECTION


U.S.-101 AT NEHALEM HWY. (ASTORIA) SEC.  
OREGON COAST & NEHALEM HWYS.  
CLATSOP COUNTY

Designed By - Timothy Yamada  
Designed By - Kristin Austin  
Drafted By - Rob Luke

PROFILE

SHEET NO.  
3C



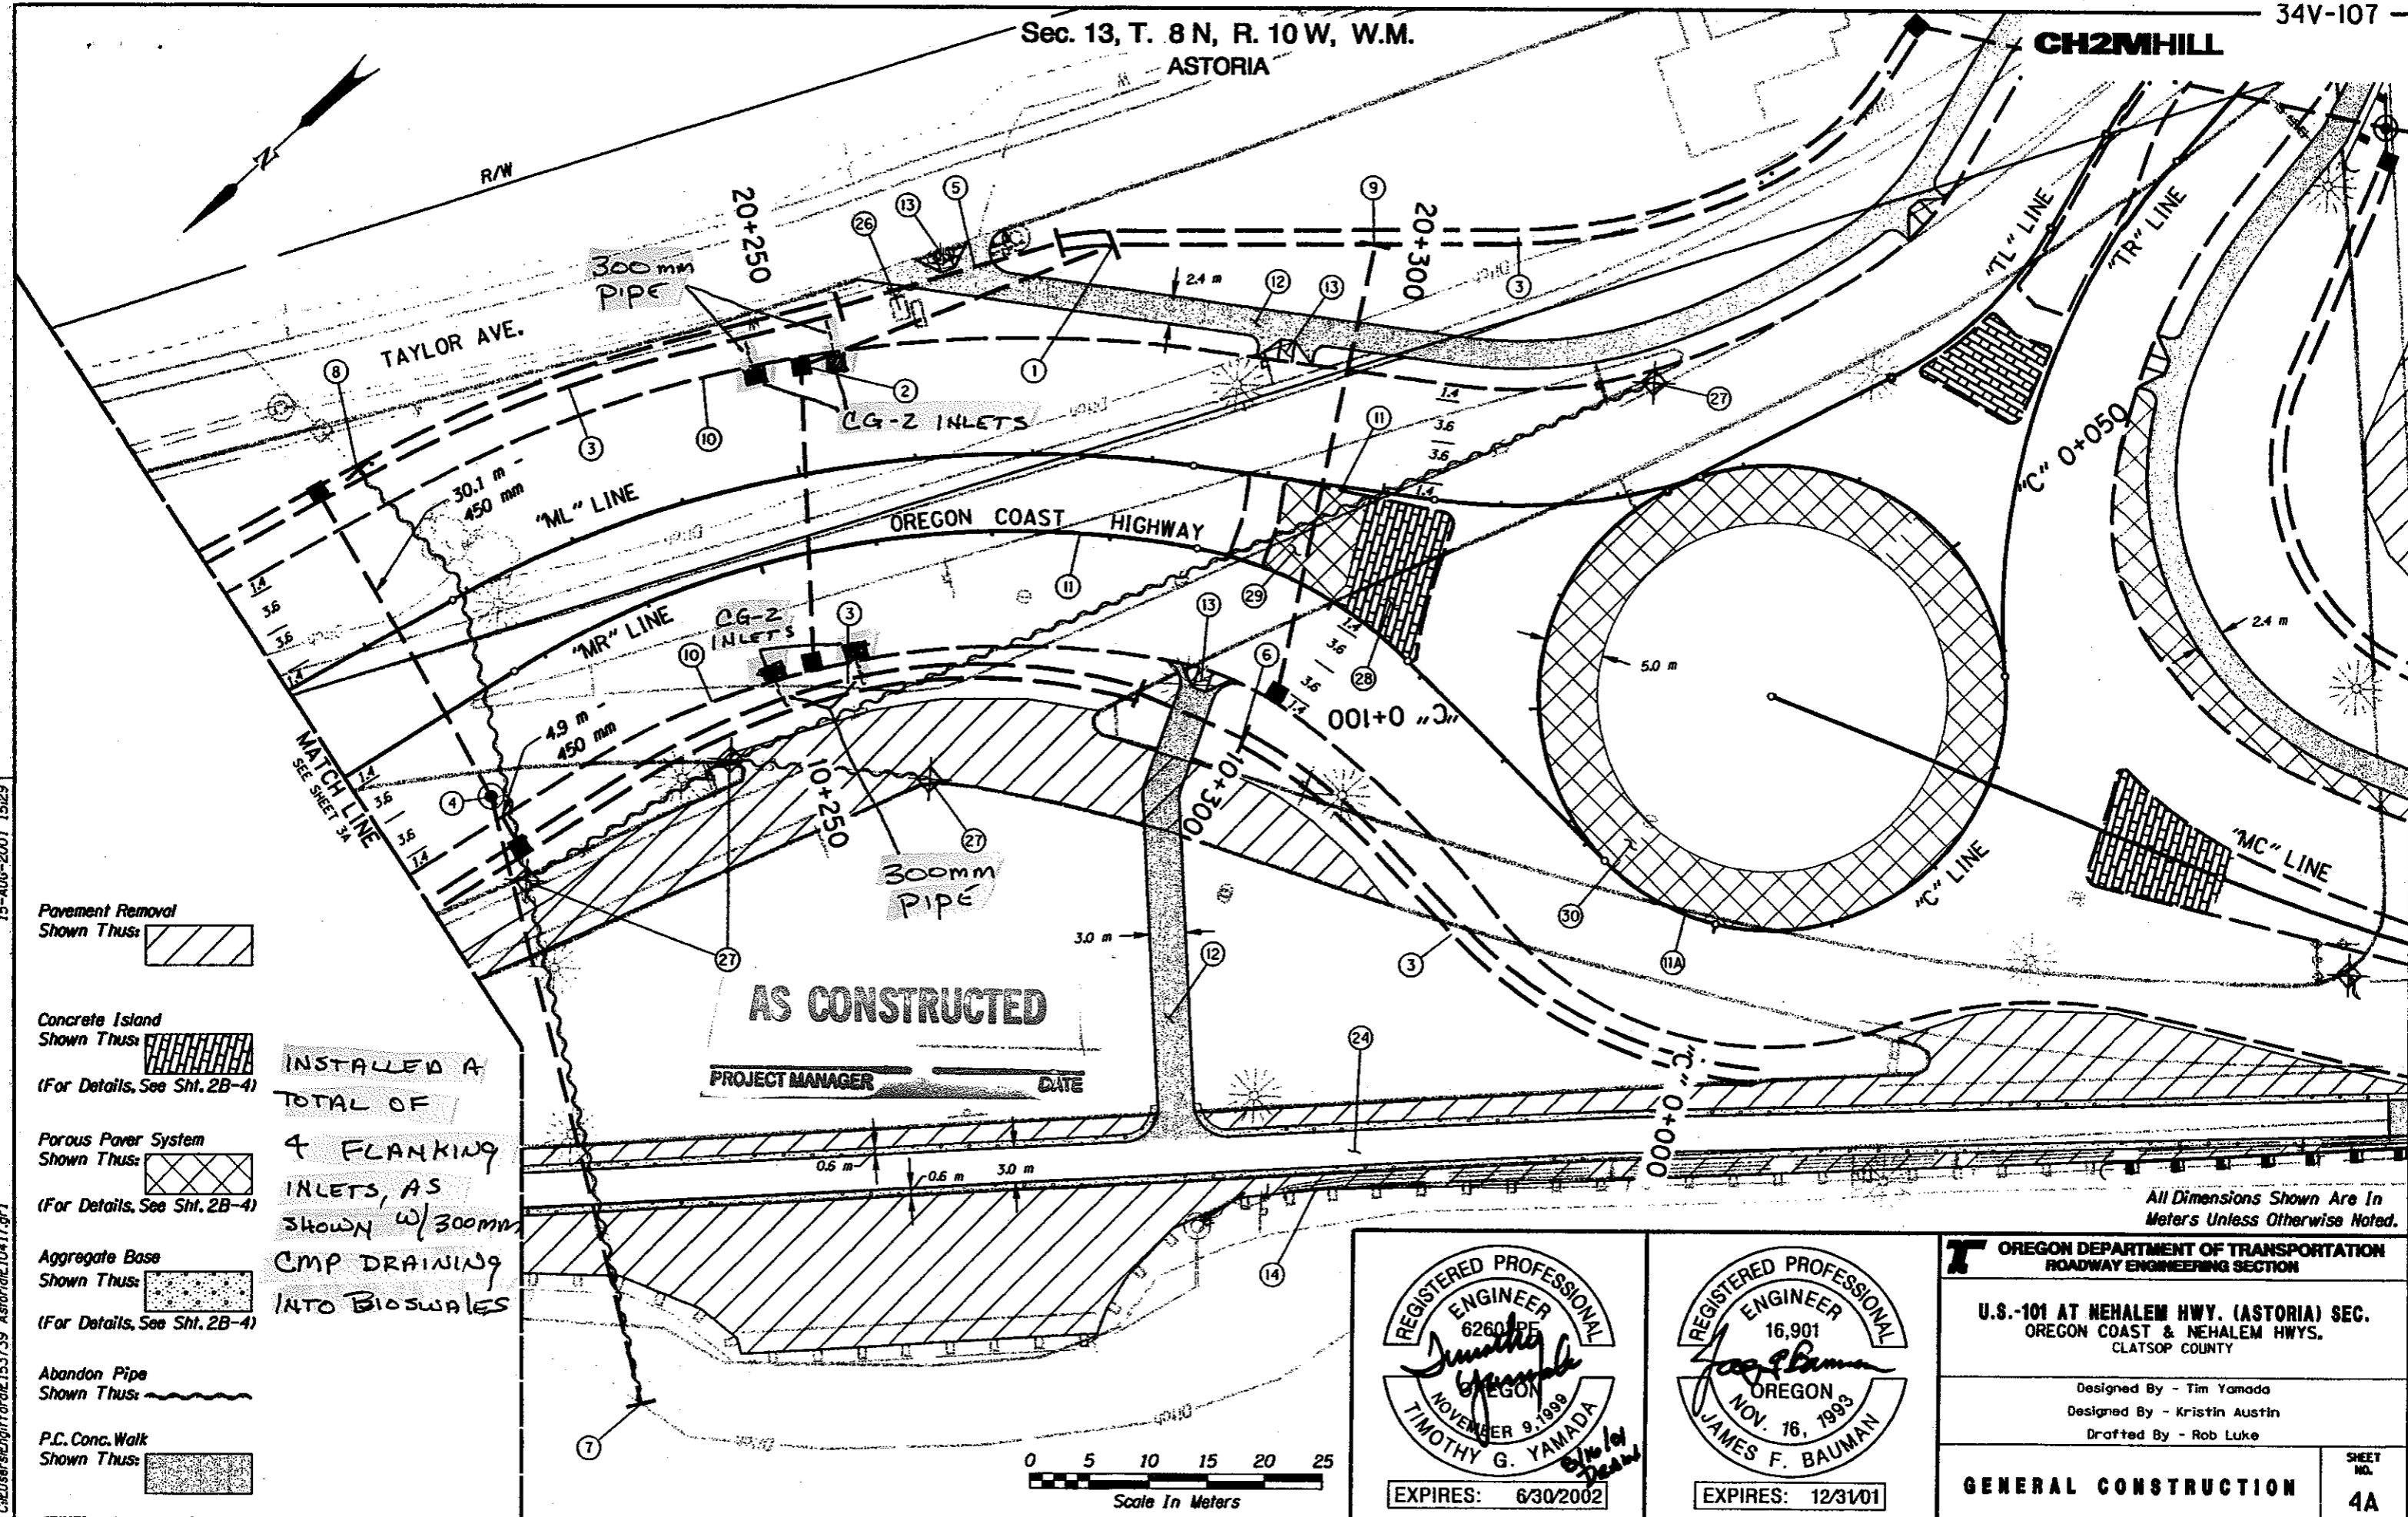

Pavement Removal  
Shown Thus: [Hatched Box]

Concrete Island  
Shown Thus: [Grid Hatched Box]

Porous Paver System  
Shown Thus: [Cross-hatched Box]

Aggregate Base  
Shown Thus: [Dotted Box]


Abandon Pipe  
Shown Thus: [Wavy Line]

P.C. Conc. Walk  
Shown Thus: [Stippled Box]

INSTALLED A  
TOTAL OF  
4 FLANKING  
INLETS, AS  
SHOWN w/ 300mm  
CMP DRAINING  
INTO BIOSWALES

**AS CONSTRUCTED**

PROJECT MANAGER \_\_\_\_\_ DATE \_\_\_\_\_

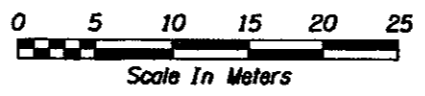

All Dimensions Shown Are In  
Meters Unless Otherwise Noted.

REGISTERED PROFESSIONAL  
ENGINEER  
6260 PE  
*Timothy G. Yamada*  
OREGON  
NOVEMBER 9, 1999  
TIMOTHY G. YAMADA  
EXPIRES: 6/30/2002

REGISTERED PROFESSIONAL  
ENGINEER  
16,901  
*James F. Bauman*  
OREGON  
NOV. 16, 1993  
JAMES F. BAUMAN  
EXPIRES: 12/31/01

OREGON DEPARTMENT OF TRANSPORTATION  
ROADWAY ENGINEERING SECTION

U.S.-101 AT NEHALEM HWY. (ASTORIA) SEC.  
OREGON COAST & NEHALEM HWYS.  
CLATSOP COUNTY

Designed By - Tim Yamada  
Designed By - Kristin Austin  
Drafted By - Rob Luke

GENERAL CONSTRUCTION  
SHEET NO. 4A


15-AUG-2001 15:23  
C:\Users\hgf\ford\153739 Astoria\10417.g1

**CH2MHILL**

- ① Sta. "ML" 20+275.58  
Inst. 450 mm Sew. Pipe Outfall - 28.5 m  
Trench Exc. - 23.0 m<sup>3</sup>  
Inst. Outlet Basin  
(For Details, See Sht. 2B-6)
- ② Sta. "ML" 20+251.75  
Const. Type "CG-2" Inlet - 2  
Inst. 300 mm Sew. Pipe - 25.6 m  
Trench Exc. - 20.3 m<sup>3</sup>
- ③ Const. Drainage Swale  
(For Details, See Sht. 2B-6)
- ④ Sta. "MR" 10+219.74  
Const. Manhole  
(See Drg. No. RD327)  
Const. Type "D" mod. Inlet - 2  
(For Details, See Sht. 2B-4)  
Inst. 450 mm Sew. Pipe - 35.0 m  
Trench Exc. 29.2 m<sup>3</sup>
- ⑤ Sta. "ML" 20+255.29  
Inst. 300 mm Culvert Pipe - 19.6 m  
Trench Exc. - 14.5 m<sup>3</sup>
- ⑥ Sta. "MR" 10+284.69  
Inst. 300 mm Culvert Pipe - 9.8 m  
Trench Exc. - 5.9 m<sup>3</sup>
- ⑦ Sta. "MR" 10+203.11  
Inst. 450 mm Sew. Pipe Outfall - 53.5 m  
Trench Exc. - 87.6 m<sup>3</sup>  
Inst. Outlet Basin  
Remove Extg. Sew. Pipe  
(For Details, See Sht. 2B-6)
- ⑧ Sta. "ML" 20+216.95  
Cut Extg. Sew. Pipe At Proposed Ditch  
I.E. 6.35  
Inst. Outlet Basin  
(For Details, See Sht. 2B-6)
- ⑨ Sta. "ML" 20+296.17  
Inst. 300 mm Sew. Pipe Outfall - 39.5 m  
Trench Exc. - 6.5 m<sup>3</sup>  
Inst. Outlet Basin  
(For Details, See Sht. 2B-6)  
Const. Type "CG-2" Inlet - 1
- ⑩ Const. Type "A" Curb
- ⑪ Const. Type "F" Curb
- ⑪A Const. Type "B" Curb  
(See Drg. No. RD700)
- ⑫ Const. P.C. Conc. Walk
- ⑬ Const. Sidewalk Ramp - 3
- ⑭ See Sht. 3B, Note 14
- ⑮ See Sht. 3B, Note 24
- ⑯ Abandon RV Dump Site (By Others)
- ⑰ Remove Inlet - 4
- ⑱ Const. Conc. Island - 84 m<sup>2</sup>  
Stamped Conc. Island Surfacing  
(For Details, See Sht 2B-4)
- ⑲ Const. Porous Paver System - 63 m<sup>2</sup>
- ⑳ Const. Porous Paver System - 550 m<sup>2</sup>  
(For Details, See Sht 2B-4)


15-AUG-2001 15:09

C:\Users\hofford\153739 Astoria\10417.dwg

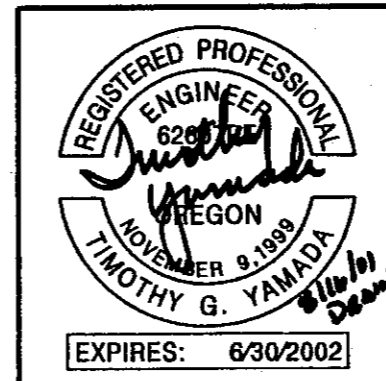


<b>OREGON DEPARTMENT OF TRANSPORTATION</b> ROADWAY ENGINEERING SECTION	
U.S.-101 AT NEHALEM HWY. (ASTORIA) SEC. OREGON COAST & NEHALEM HWYS. CLATSOP COUNTY	
Designed By - Tim Yamada Designed By - Kristin Austin Drafted By - Rob Luke	
GENERAL CONSTRUCTION	SHEET NO. <b>4B</b>

"ML" LINE

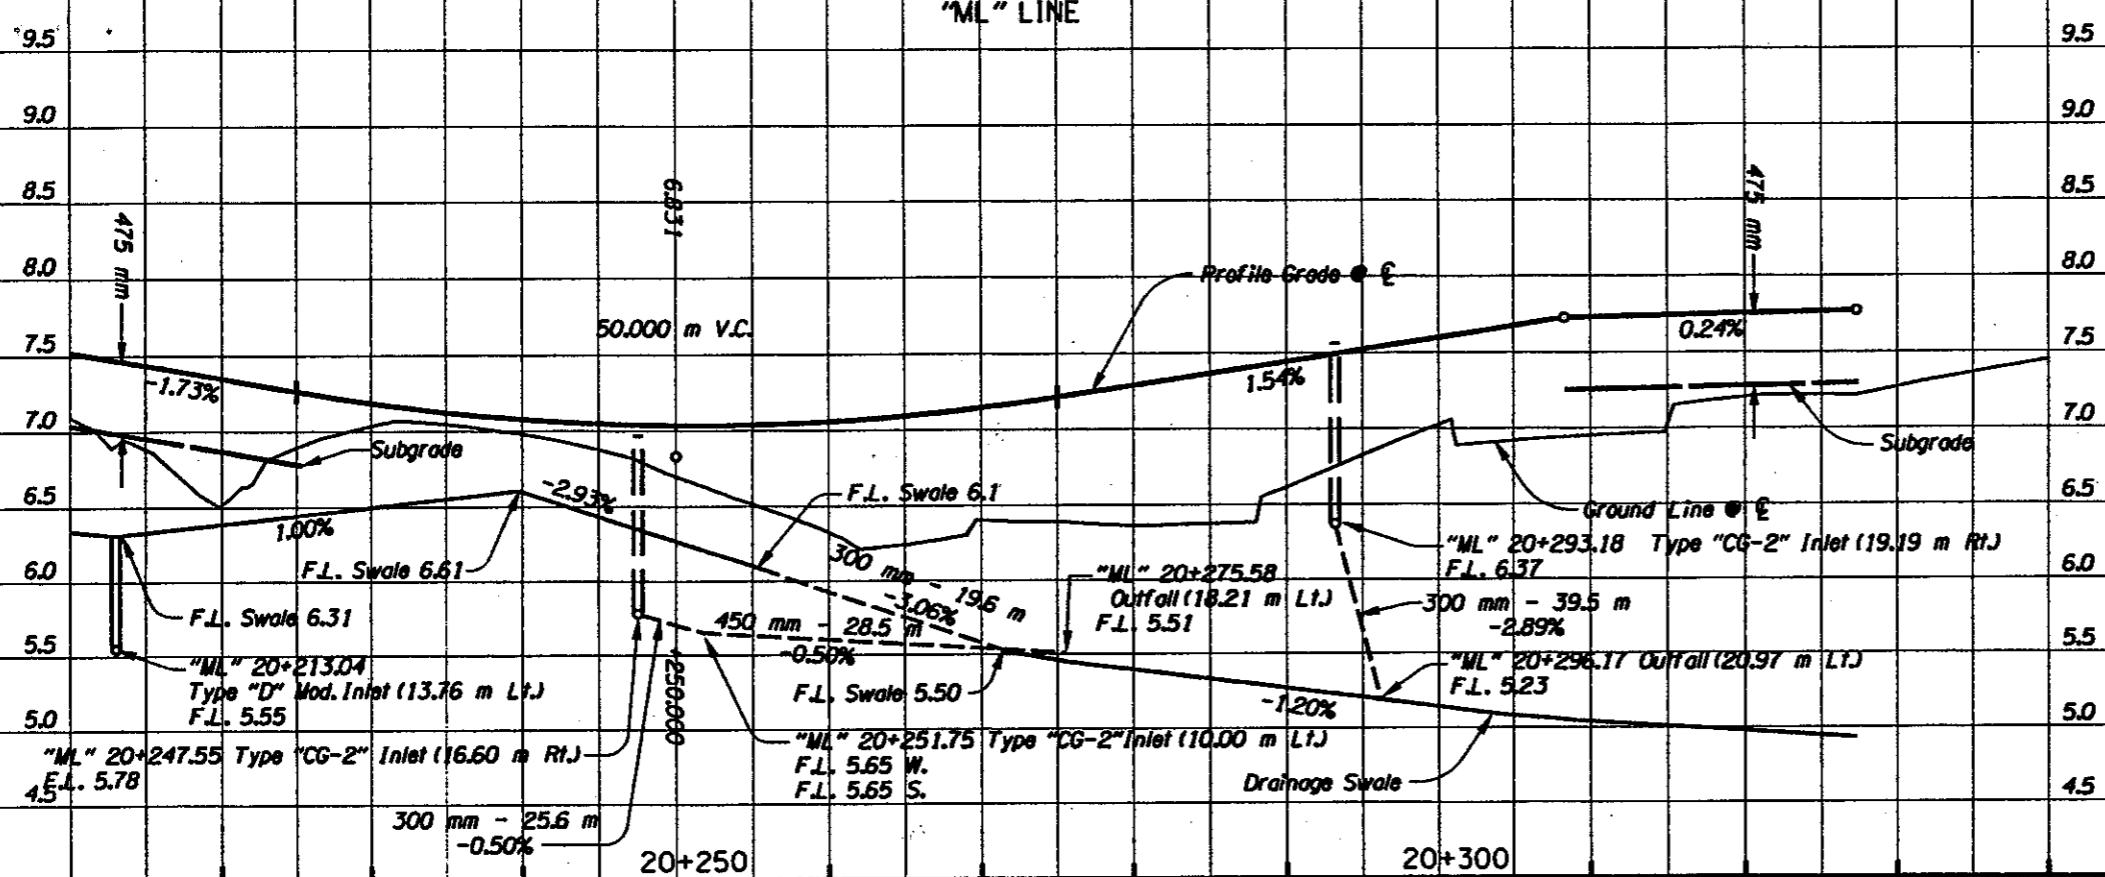


"ML" Line  
Earthwork Quantities:  
Exc. 490 m<sup>3</sup>  
Emb. 1100 m<sup>3</sup>  
Ditch Exc. 460 m<sup>3</sup>

"MR" LINE

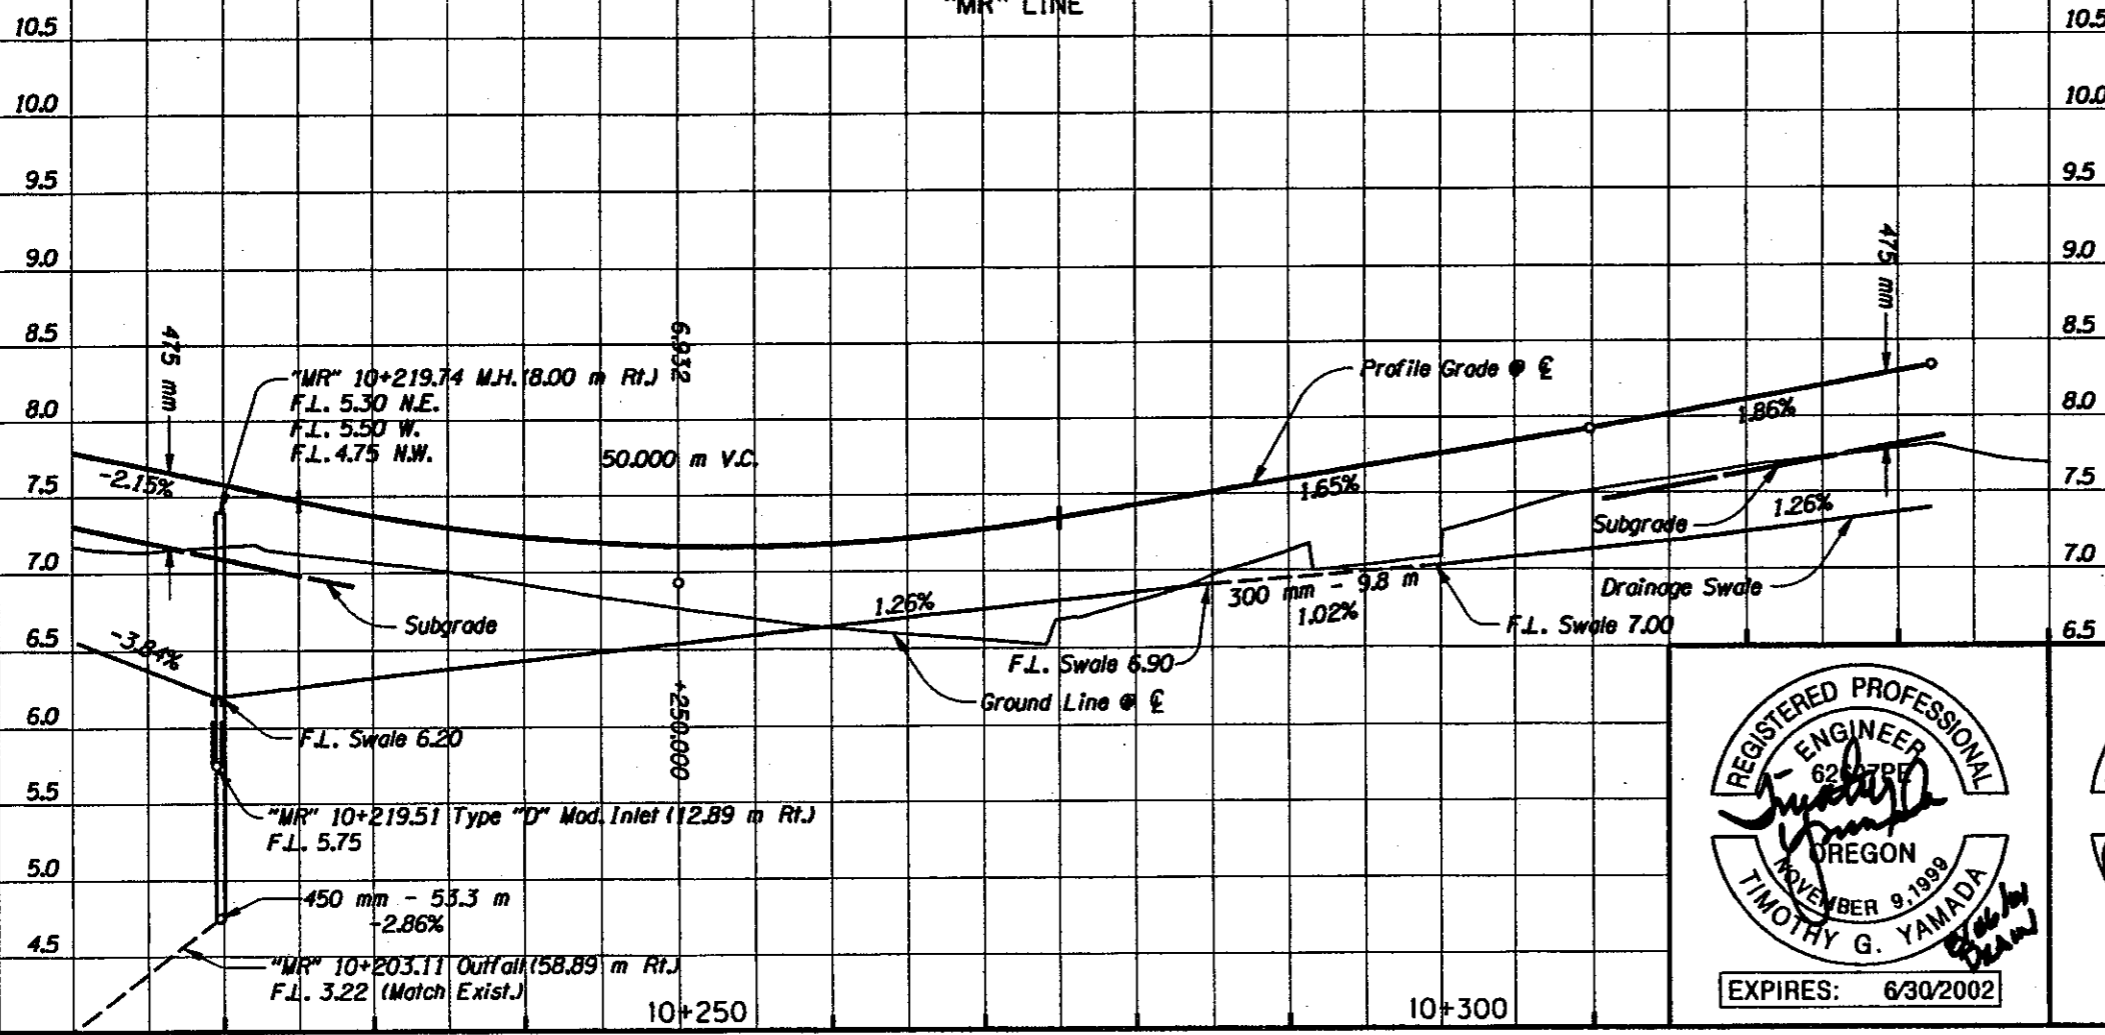

"MR" Line  
Earthwork Quantities:  
Exc. 520 m<sup>3</sup>  
Emb. 620 m<sup>3</sup>  
Ditch Exc. 390 m<sup>3</sup>

All Dimensions Shown Are In Meters Unless Otherwise Noted.

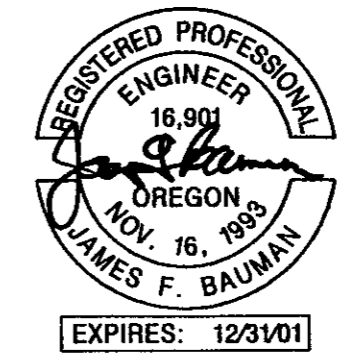

OREGON DEPARTMENT OF TRANSPORTATION  
ROADWAY ENGINEERING SECTION


U.S.-101 AT NEHALEM HWY. (ASTORIA) SEC.  
OREGON COAST & NEHALEM HWYS.  
CLATSOP COUNTY

Designed By - Timothy Yamada  
Designed By - Kristin Austin  
Drafted By - Rob Luke

PROFILE


SHEET NO.  
4C

15-AUG-2001 12:27  
C:\Users\ngifford\Documents\153739 Astoria\10+17.dwg


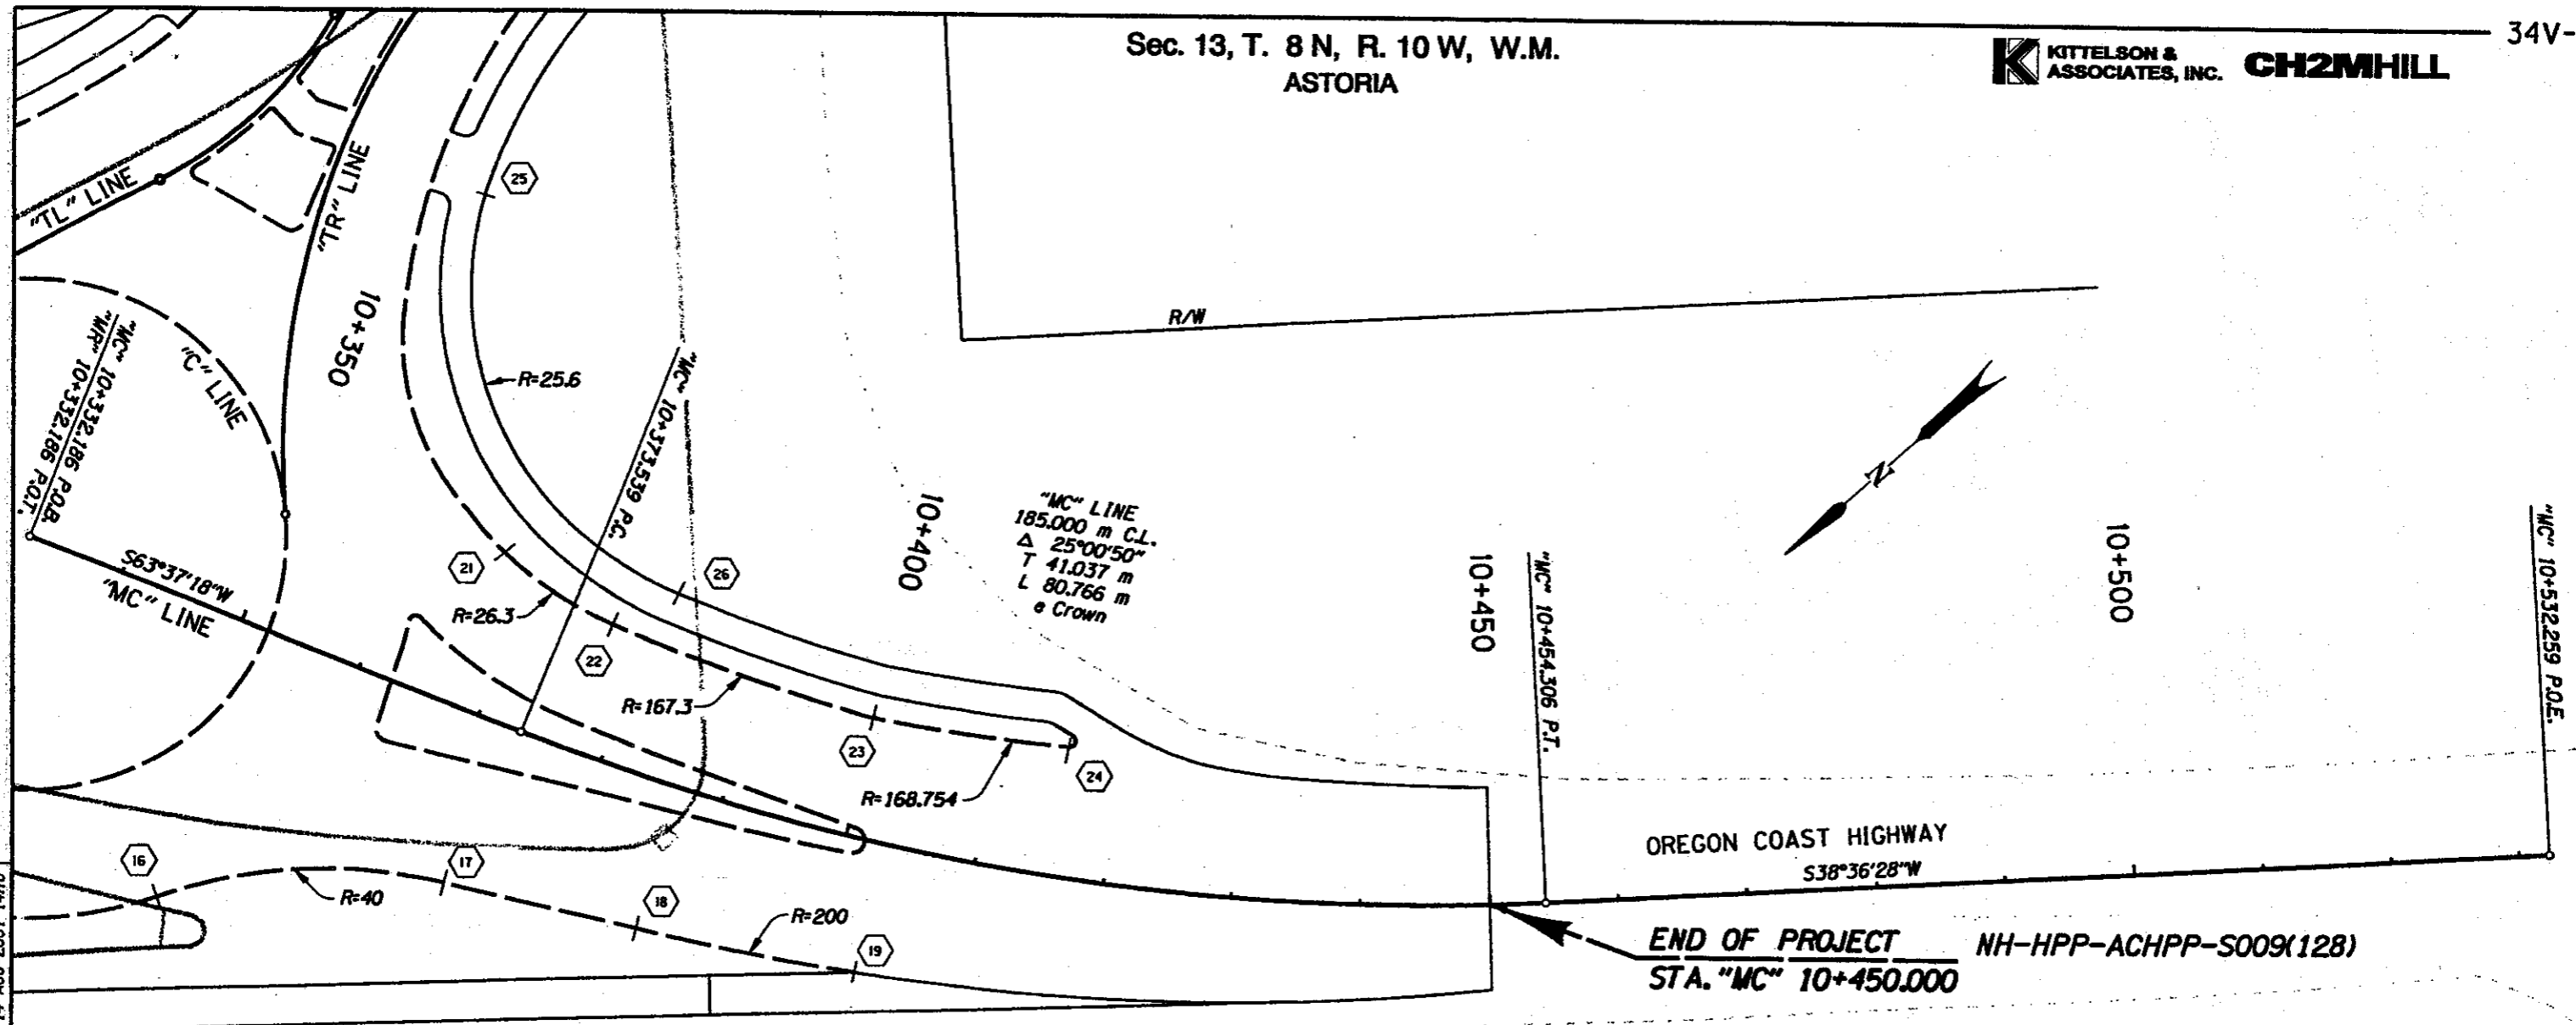


END OF PROJECT NH-HPP-ACHPP-S009(128)  
STA. "MC" 10+450.000

Point No.	Station
16	"C" 0+011.374 (10.000 Rt.)
17	"MC" 10+372.423 (13.194 Rt.)
18	"MC" 10+386.636 (11.507 Rt.)
19	"MC" 10+402.993 (10.248 Rt.)
21	"MC" 10+363.364 (14.613 Lt.)
22	"MC" 10+377.070 (10.407 Lt.)
23	"MC" 10+399.805 (9.463 Lt.)
24	"MC" 10+415.681 (10.181 Lt.)
25	"TR" 40+458.805 (11.702 Rt.)
26	"MC" 10+381.358 (14.424 Lt.)

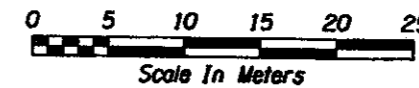

All Dimensions Shown Are In Meters Unless Otherwise Noted.

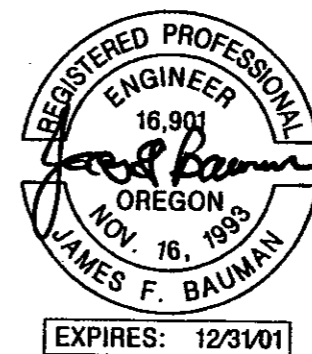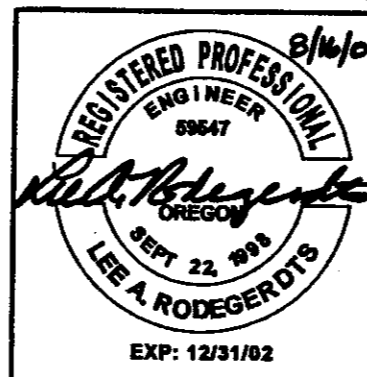

OREGON DEPARTMENT OF TRANSPORTATION  
ROADWAY ENGINEERING SECTION

U.S.-101 AT NEHALEM HWY. (ASTORIA) SEC.  
OREGON COAST & NEHALEM HWYS.  
CLATSOP COUNTY


Designed By - Lee Rodegerdts  
Designed By - Kristin Austin  
Drafted By - Rob Luke

ALIGNMENT

SHEET NO. 5

C:\Users\hpifford\153739 Astoria\10417.dwg 14-AUG-2001 14:18


Sec. 13, T. 8N, R. 10W, W.M.  
ASTORIA

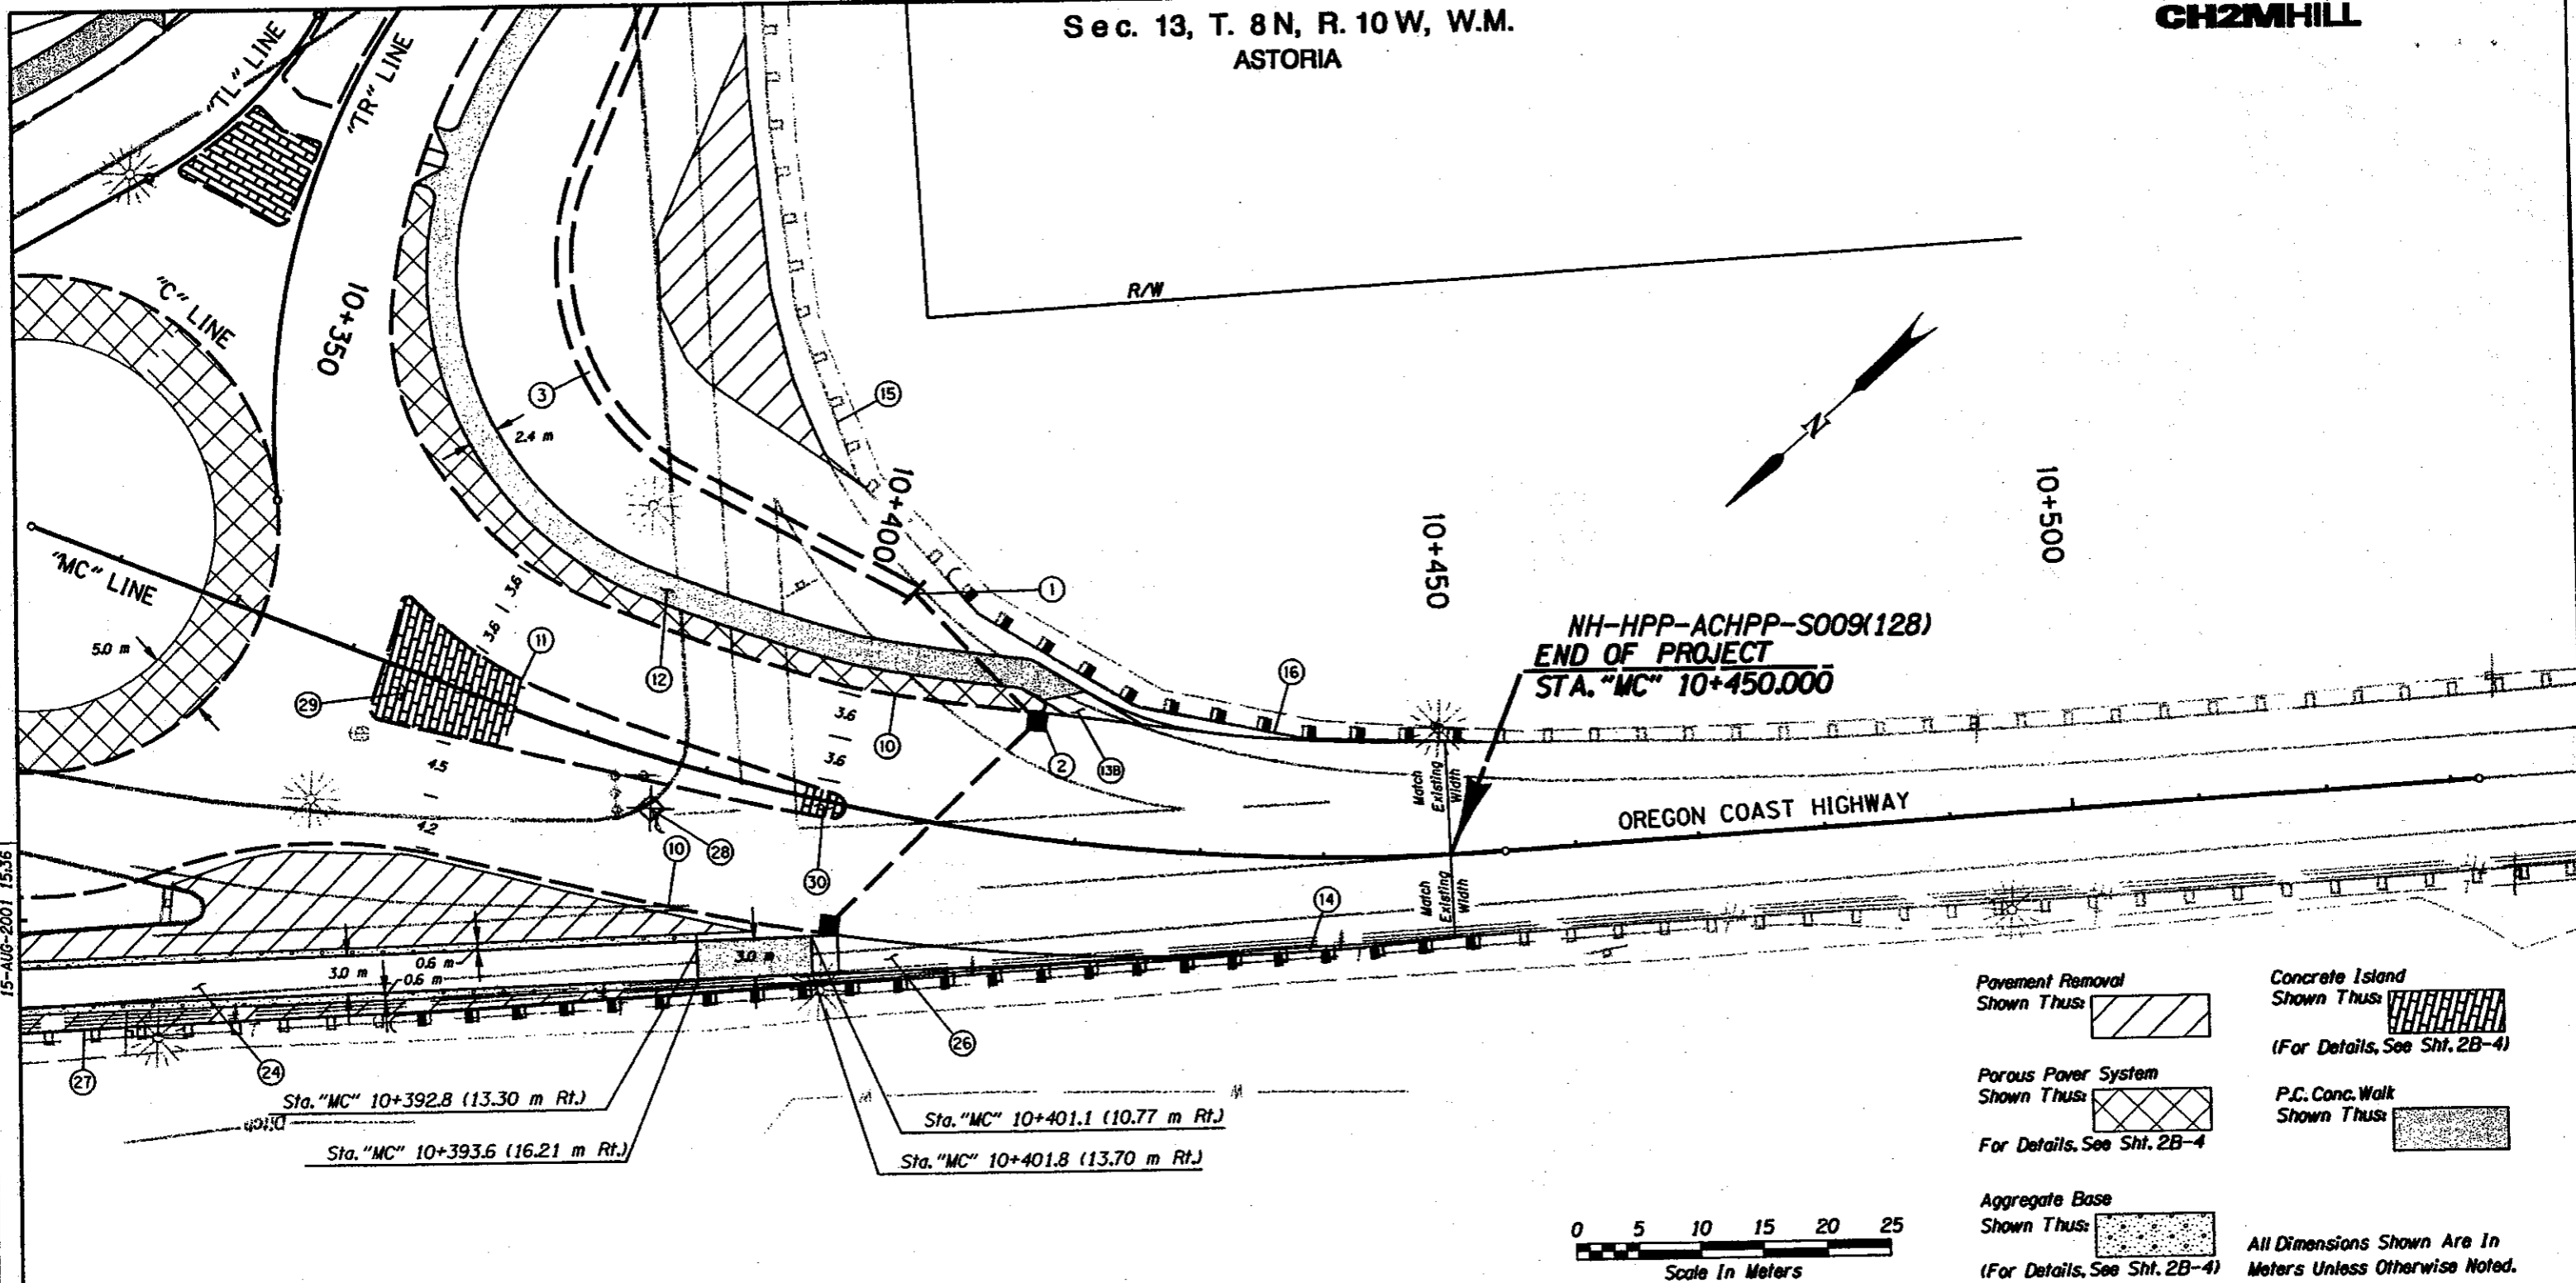

NH-HPP-ACHPP-S009(128)  
END OF PROJECT  
STA. "MC" 10+450.000

OREGON COAST HIGHWAY

- Pavement Removal  
Shown Thus:
  - Concrete Island  
Shown Thus:   
(For Details, See Sht. 2B-4)
  - Porous Paver System  
Shown Thus:   
For Details, See Sht. 2B-4
  - P.C. Conc. Walk  
Shown Thus:
  - Aggregate Base  
Shown Thus:   
(For Details, See Sht. 2B-4)
- All Dimensions Shown Are In Meters Unless Otherwise Noted.

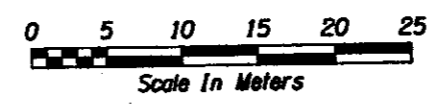

REGISTERED PROFESSIONAL  
ENGINEER  
6267PE  
*Timothy G. Yamada*  
OREGON  
NOVEMBER 9, 1998  
TIMOTHY G. YAMADA  
EXPIRES: 6/30/2002

REGISTERED PROFESSIONAL  
ENGINEER  
16,901  
*James F. Bauman*  
OREGON  
NOV. 16, 1993  
JAMES F. BAUMAN  
EXPIRES: 12/31/01

OREGON DEPARTMENT OF TRANSPORTATION  
ROADWAY ENGINEERING SECTION

U.S.-101 AT NEHALEM HWY. (ASTORIA) SEC.  
OREGON COAST & NEHALEM HWYS.  
CLATSOP COUNTY

Designed By - Tim Yamada  
Designed By - Kristin Austin  
Drafted By - Rob Luke

GENERAL CONSTRUCTION


SHEET NO. 5A

15-AUG-2001 15:36  
C:\Users\hgifford\p153739 Astoria\10417.gr1

- ① Sta. "MC" 10+403.39  
Inst. 300 mm Sew. Pipe Outfall - 14.3 m  
Trench Exc. - 11.1 m<sup>3</sup>  
Inst. Outlet Basin  
(For Details, See Sht. 2B-6)
- ② Sta. "MC" 10+415.68  
Const. Type "CG-2" Inlet - 2  
Inst. 300 mm Sew. Pipe - 23.3 m  
Trench Exc. - 16.7 m<sup>3</sup>
- ③ Const. Drainage Swale  
(For Details, See Sht. 2B-6)
- ⑩ Const. Type "A" Curb
- ⑪ Const. Type "F" Curb
- ⑫ Const. P.C. Conc. Walk
- ⑬ Const. Sidewalk Ramp (Bikeway)
- ⑭ Sta. "MC" 10+373.9 (26.2 Rt.)  
To Sta. "MC" 10+453.0 (6.6 Rt.)  
Const. Guardrail - 87.63 m (Type 2A)  
Const. Anchor (Type 1)  
Inst. End Piece (Type B)  
Const. Guardrail Connection  
(See Drg. No. RD400, RD405, RD415,  
RD417, RD440)
- ⑮ Sta. "TL" 30+627 To Sta. "MC" 10+453  
Remove Extg. Guardrail - 245 m ±
- ⑯ Sta. "MC" 10+406.4 (19.4 Lt.)  
To Sta. "MC" 10+453.0 (8.9 Lt.)  
Const. Guardrail - 45.72 m (Type 2A)  
Const. Anchor (Type 1)  
Inst. End Piece (Type B)  
Const. Guardrail Connection
- ⑳ See Sht. 3B, Note 24
- ㉔ Const. Asphalt Ramp  
(For Details, See Sht. 2B-4)
- ㉕ See Sht. 3B, Note 14
- ㉖ Remove Inlet
- ㉗ Const. Conc. Island - 87 m<sup>2</sup>  
Stamped Conc. Island Surfacing  
(For Details, See Sht 2B-4)
- ㉘ Const. Conc. Island - 8 m<sup>2</sup>  
Stamped Conc. Island Surfacing  
(For Details, See Sht 2B-4)

15-AUG-2001 15:03

C:\Users\shgifford\153739 Astoria\10417.dwg

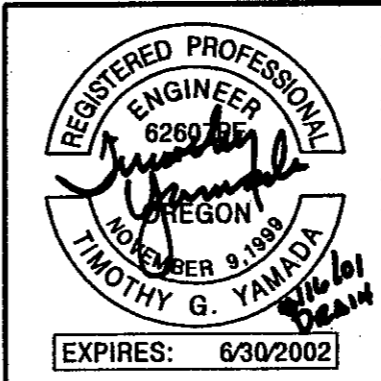

<b>OREGON DEPARTMENT OF TRANSPORTATION</b> ROADWAY ENGINEERING SECTION	
U.S.-101 AT NEHALEM HWY. (ASTORIA) SEC. OREGON COAST & NEHALEM HWYS. CLATSOP COUNTY	
Designed By - Tim Yamada Designed By - Kristin Austin Drafted By - Rob Luke	
<b>GENERAL CONSTRUCTION</b>	SHEET NO. <b>5B</b>