

# OPERATION & MAINTENANCE MANUAL

**DFI No. D00071**

**Facility Type: Water Quality Biofiltration  
Swale**



**June, 2010**

**INDEX**

**1. IDENTIFICATION..... 1**

**2. FACILITY CONTACT INFORMATION ..... 1**

**3. CONSTRUCTION..... 1**

**4. STORM DRAIN SYSTEM AND FACILITY OVERVIEW ..... 2**

**5. FACILITY HAZ MAT SPILL FEATURE(S)..... 5**

**6. AUXILIARY OUTLET (HIGH FLOW BYPASS)..... 5**

**7. MAINTENANCE REQUIREMENTS..... 5**

**8. WASTE MATERIAL HANDLING..... 6**

**APPENDIX A: Operational Plan and Profile Drawing(s)**

**APPENDIX B: ODOT Project Plan Sheets**

## 1. Identification

Drainage Facility ID (DFI): **D00071**  
Facility Type: Water Quality Biofiltration Swale  
Construction Drawings: (V-File Number) 40V-55  
Location: District: 2B (Old 2A)  
Highway No.: 001  
Mile Post: 292.74 / 292.82 (beg./end)  
Description: This facility is located on the west side of southbound I-5 (Hwy 001) at the junction of the S.W. Dartmouth Street on-ramp, south of the Haines Street Interchange.

## 2. Facility Contact Information

Contact the Engineer of Record, Region Technical Center, or Geo-Environmental's Senior Hydraulics Engineer for:

- Operational clarification
- Maintenance clarification
- Repair or restoration assistance

### Engineering Contacts:

Region Technical Center Hydro Unit Manager

Or

Geo-Environmental Senior Hydraulics Engineer (503) 986-3365.

## 3. Construction

Engineer of Record: ODOT Designer – Region 2 Tech Center,  
Gabrielle Crop, (503) 986-5838  
Consultant Designer – Murray Smith and  
Associates, Janet Masters, (503) 225-9010  
Facility construction: 2008  
Contractor: Morse Bros., Inc. DBA Knife River, Tangent, OR

#### **4. Storm Drain System and Facility Overview**

A water quality swale is a flat-bottomed open channel designed to treat stormwater runoff from highway pavement areas. This type of facility is lined with grass. Treatment by trapping sedimentation occurs when stormwater runoff flows through the grass.

The water quality biofiltration swale is approximately 400-feet and is located on the west side of I-5 (Hwy 001) just south of the Haines Street Interchange.

Drainage from the southbound lanes of the highway and a portion of the on-ramp is collected by a series of inlets and directed to the swale. See the Operational Plan in Appendix A. The stormwater is then treated by flowing through the swale. Flow spreaders are located approximately every 100-feet to control the velocities and minimize channelization or rutting of the swale bottom; see Photo 1 and Appendix B for the construction drawings. The swale bottom is lined with a rigid HDPE porous pavement system and geotextile fabric that additionally protects against erosion.

There are a total of two storm pipes that drain into this water quality swale. These pipes outfall into the swale at points A and B in the Operational Plan; see Appendix A. Treated water from this swale is collected by a ditch inlet, (indicated as point C in the Operational Plan), and conveyed into a 36-inch buried storm pipe detention system (DFI No. D00072) that ultimately discharges to a roadside ditch approximately 570 feet from the swale.



Photo 1: WQ Biofiltration Swale looking north. I-5 is located to the right.



Photo 2: Inlet B midsection of swale.

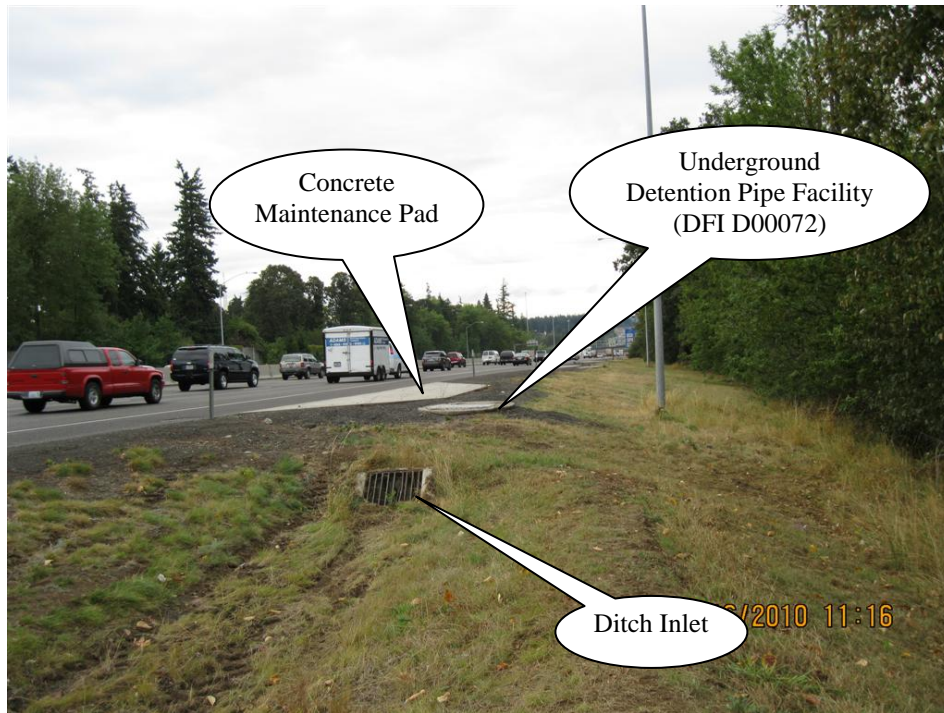


Photo 3: Ditch Inlet serves as outlet of swale.

For further information and details regarding the system refer to Appendix A for the Operational Plan and Appendix B for the Construction Project Plan sheets.

A. Maintenance equipment access:

The facility can be accessed for maintenance along the entire length via Interstate-5 (Hwy 001). Photo 3 includes a concrete maintenance pad intended for maintenance vehicles.

B. Heavy equipment access into facility:

- Allowed (no limitations)
- Allowed (with limitations)
- Not allowed

C. Special Features:

- Amended Soils
- Porous Pavers
- Liners (Riprap and Drainage Geotextile)
- Underdrains

## 5. Facility Haz Mat Spill Feature(s)

The water quality biofiltration swale is considered an online system (no flow is bypassed) and can be used to store a volume of liquid by blocking the facility outlet at either the grate of the ditch inlet, or the 12-inch diameter pipe (located within the inlet/outlet structure itself). This pipe is noted as point C in the Operation Plan.

## 6. Auxiliary Outlet (High Flow Bypass)

Auxiliary Outlets are provided if the primary outlet control structure can not safely pass the projected high flows. Broad-crested spillway weirs and over flow risers are the two most common auxiliary outlets used in stormwater treatment facility design. The auxiliary outlet feature is either a part of the facility or an additional storm drain feature/structure.

The auxiliary outlet feature for this facility is:

Designed into facility

Other, as noted below

This swale does not contain an auxiliary outlet or overflow.

## 7. Maintenance Requirements

Routine maintenance table for non-proprietary stormwater treatment and storage/detention facilities have been incorporated into ODOT's Maintenance Guide. These tables summarize the maintenance requirements for ponds, swales, filter strips, bioslopes, and detention tanks and vaults. Special maintenance requirements in addition to the routine requirements are noted below when applicable.

The ODOT Maintenance Guide can be viewed at the following website:

<http://www.oregon.gov/ODOT/HWY/OOM/MGuide.shtml>

Maintenance requirements for proprietary structures, such as underground water quality manholes and/or vaults with filter media are noted in Appendix C when applicable.

The following stormwater facility maintenance table (See ODOT Maintenance Guide) should be used to maintain the facility outlined in this Operation and Maintenance Manual or follow the Maintenance requirements outlined in Appendix C when proprietary structure is selected below:

- Table 1 (general maintenance)
- Table 2 (stormwater ponds)
- Table 3 (water quality or biofiltration swales)
- Table 4 (water quality filter strips)
- Table 5 (water quality bioslopes)
- Table 6 (detention tank)
- Table 7 (detention vault)
- Appendix C (proprietary structure)
- Special Maintenance requirements:

Note: Special maintenance requirements require concurrence from ODOT SR Hydraulics Engineer.

## 8. Waste Material Handling

Material removed from the facility is defined as waste by DEQ. Refer to the roadwaste section of the ODOT Maintenance Yard Environmental Management System (EMS) Policy and Procedures Manual for disposal options: <http://egov.oregon.gov/ODOT/HWY/OOM/EMS.shtml>

Contact any of the following for more detailed information about management of waste materials found on site:


ODOT Clean Water Unit	(503) 986-3008
ODOT Statewide Hazmat Coordinator	(503) 229-5129
ODOT Region Hazmat Coordinator	(503) 731-8304
ODEQ Northwest Region Office	(503) 229-5263




# Appendix A

## Content:


- **Operational Plan and Profile Drawing(s)**

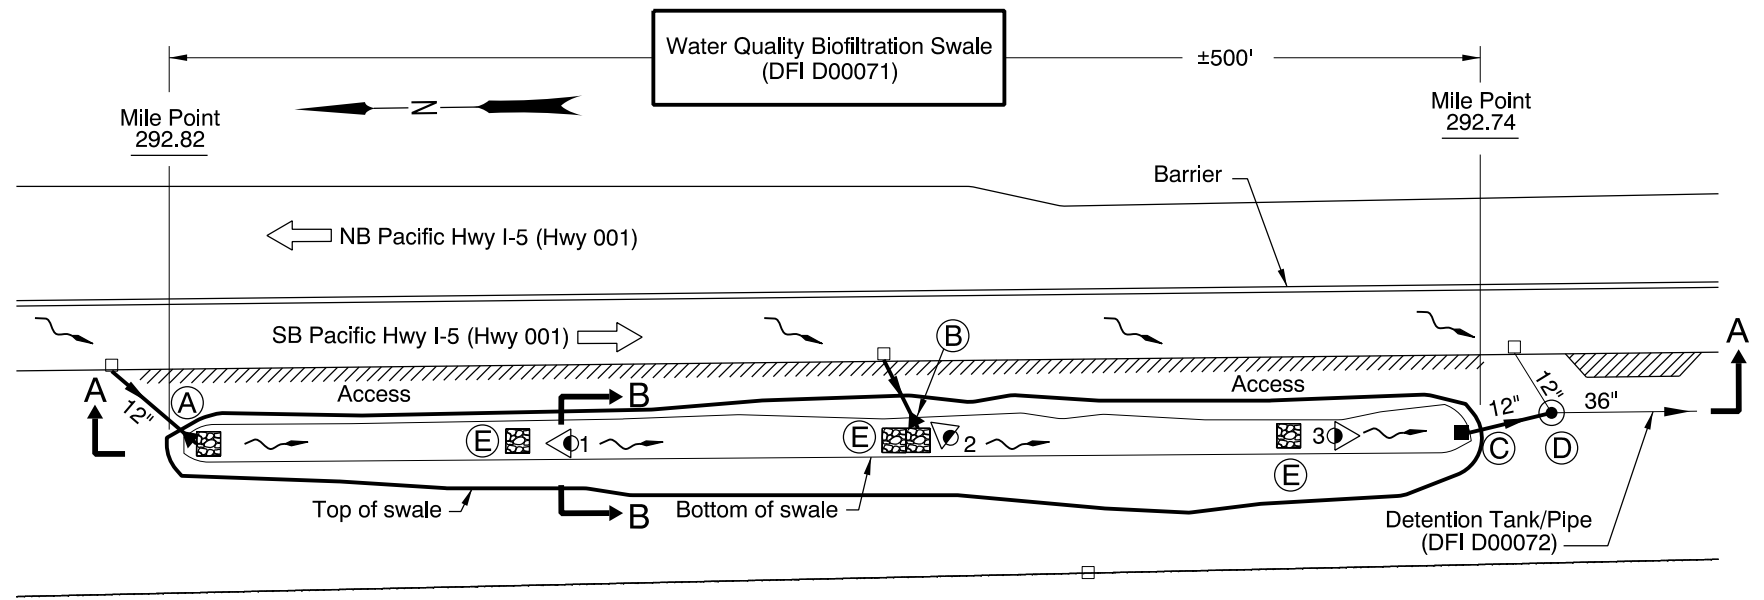


**PLAN**  
N.T.S.

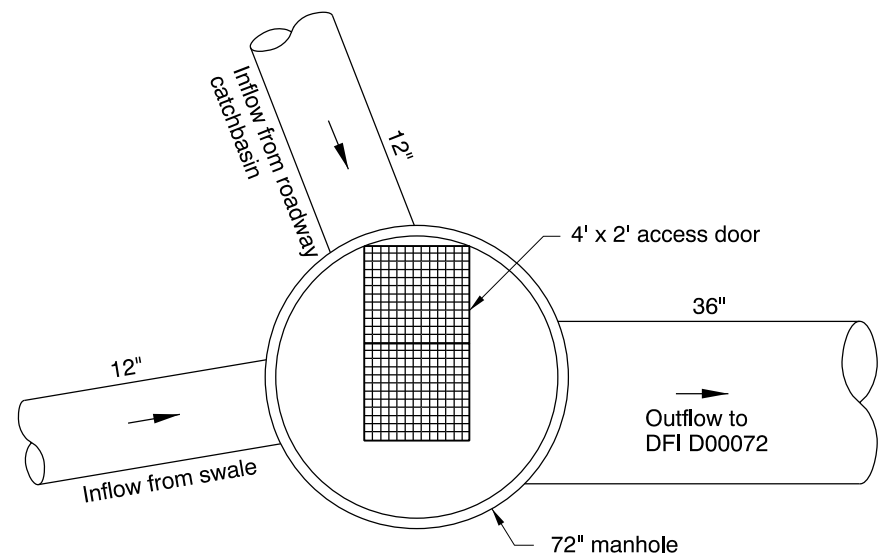

**72" MANHOLE AT POINT (D)**  
N.T.S.

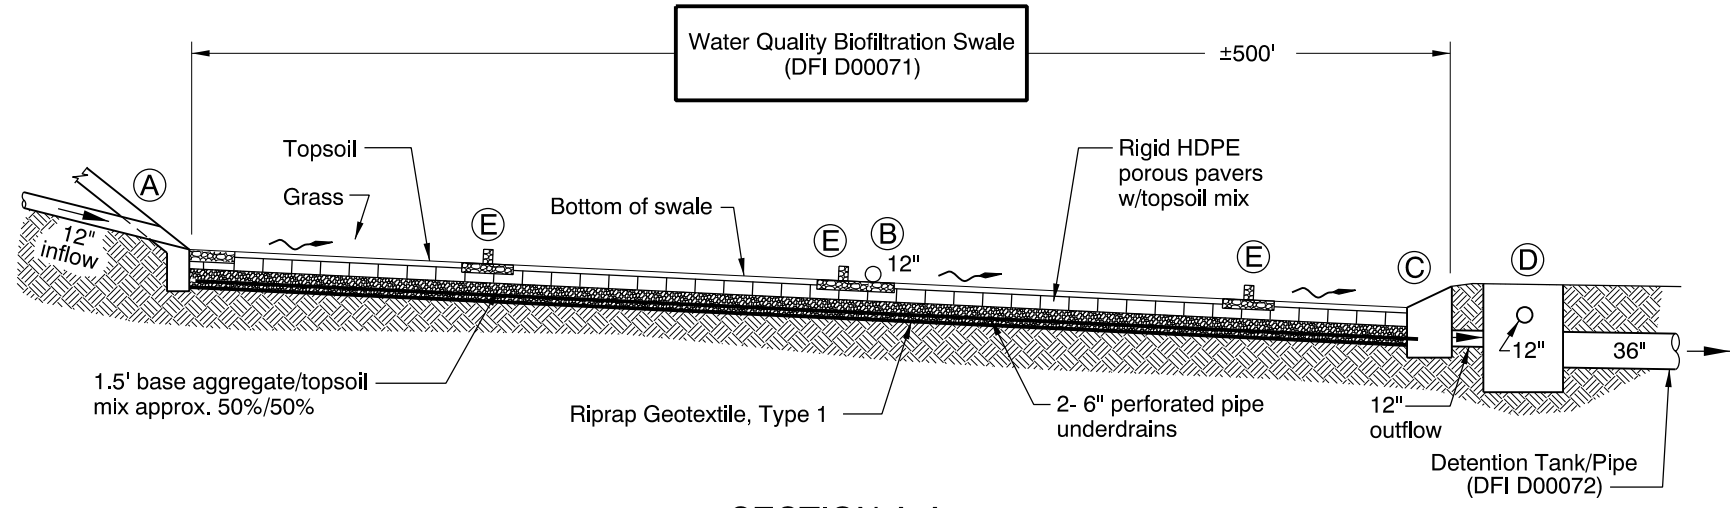

**SECTION A-A**  
N.T.S.

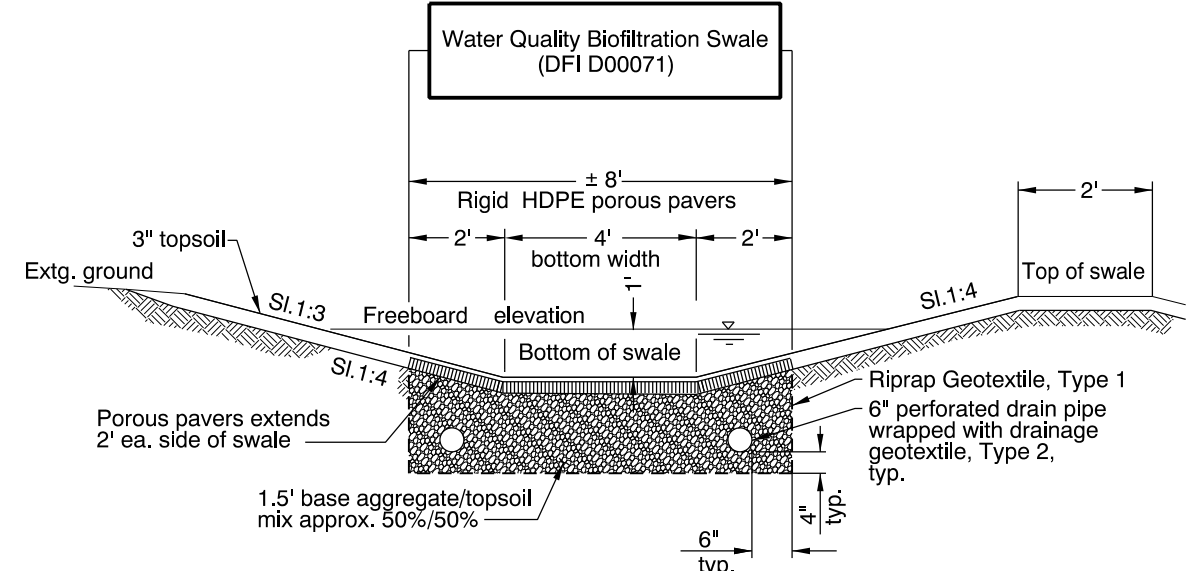

**SECTION B-B**  
N.T.S.

- LEGEND:**
- Photo Location / Direction
  - Facility inlet - 12" Pipe With Paved End Slope And Flow Spreader
  - Swale Outlet/Type "D" Inlet
  - 72" Manhole
  - Swale Flow Spreader
  - and/or Manhole
  - and/or Inlet
  - Traffic Flow/Direction
  - Storm Pipe (Facility)
  - Storm Pipe
  - Conveyance Direction
  - Pavement / Facility Flow Path
  - Riprap
  - Paved Slope Inlet
  - Maintenance Access

Sht. 1 of 1

OREGON DEPARTMENT OF TRANSPORTATION

**DFI D00071**  
**MAINTENANCE DISTRICT 2B HWY 001**  
**WATER QUALITY BIOFILTRATION SWALE**  
PACIFIC HWY MP 292.82-292.74  
MULTNOMAH, WASHINGTON & CLACKAMAS COUNTIES

Prepared By: Bob Knorr

Drafted By: Dan Claycomb

# Appendix B

## Content:

- **ODOT Project Plan Sheets**
  - *Cover/Title Sheet*
  - *Water Quality/Detention Plan Sheets*
  - *Other Details*

STATE OF OREGON  
 DEPARTMENT OF TRANSPORTATION  
 PLANS FOR PROPOSED PROJECT


GRADING, DRAINAGE, STRUCTURES, PAVING & SIGNALS

**I-5: CAPITOL HWY -  
 TUALATIN RIVER SEC.**

**PACIFIC HIGHWAY**

**MULTNOMAH, WASHINGTON & CLACKAMAS COUNTIES**

**MARCH 2007**

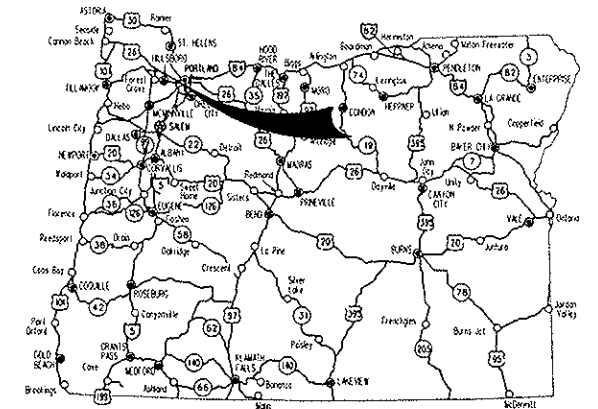

Overall Length Of Project - 4.51 Miles

**ATTENTION:**  
 Oregon Law Requires You To Follow Rules Adopted By The Oregon Utility Notification Center. Those Rules Are Set Forth In OAR 952-001-0010 Through OAR 952-001-0090. You May Obtain Copies Of The Rules By Calling The Center. (Note: The Telephone Number For The Oregon Utility Center Is (503) 232-1987.)




INDEX OF SHEETS	
SHEET NO.	DESCRIPTION
1	Title Sheet
1A	Index Of Sheets Cont'd.

REVISED AS CONSTRUCTED  
 1/15/08 CONTRACT 13351  
 PROJ. MGR. BILL EDMUNSON

**IM-S001 (243)  
 BEGINNING OF CONTRACT  
 STA. "L2" 989+45 (M.P. 294.25)**

**IM-S001 (243)  
 BEGINNING OF PAVING  
 STA. "L2" 990+52 (M.P. 294.19)**

**IM-S001 (243)  
 END OF PROJECT  
 STA. "LN2" 1226+00 (M.P. 289.74)  
 STA. "LS2" 1226+00**

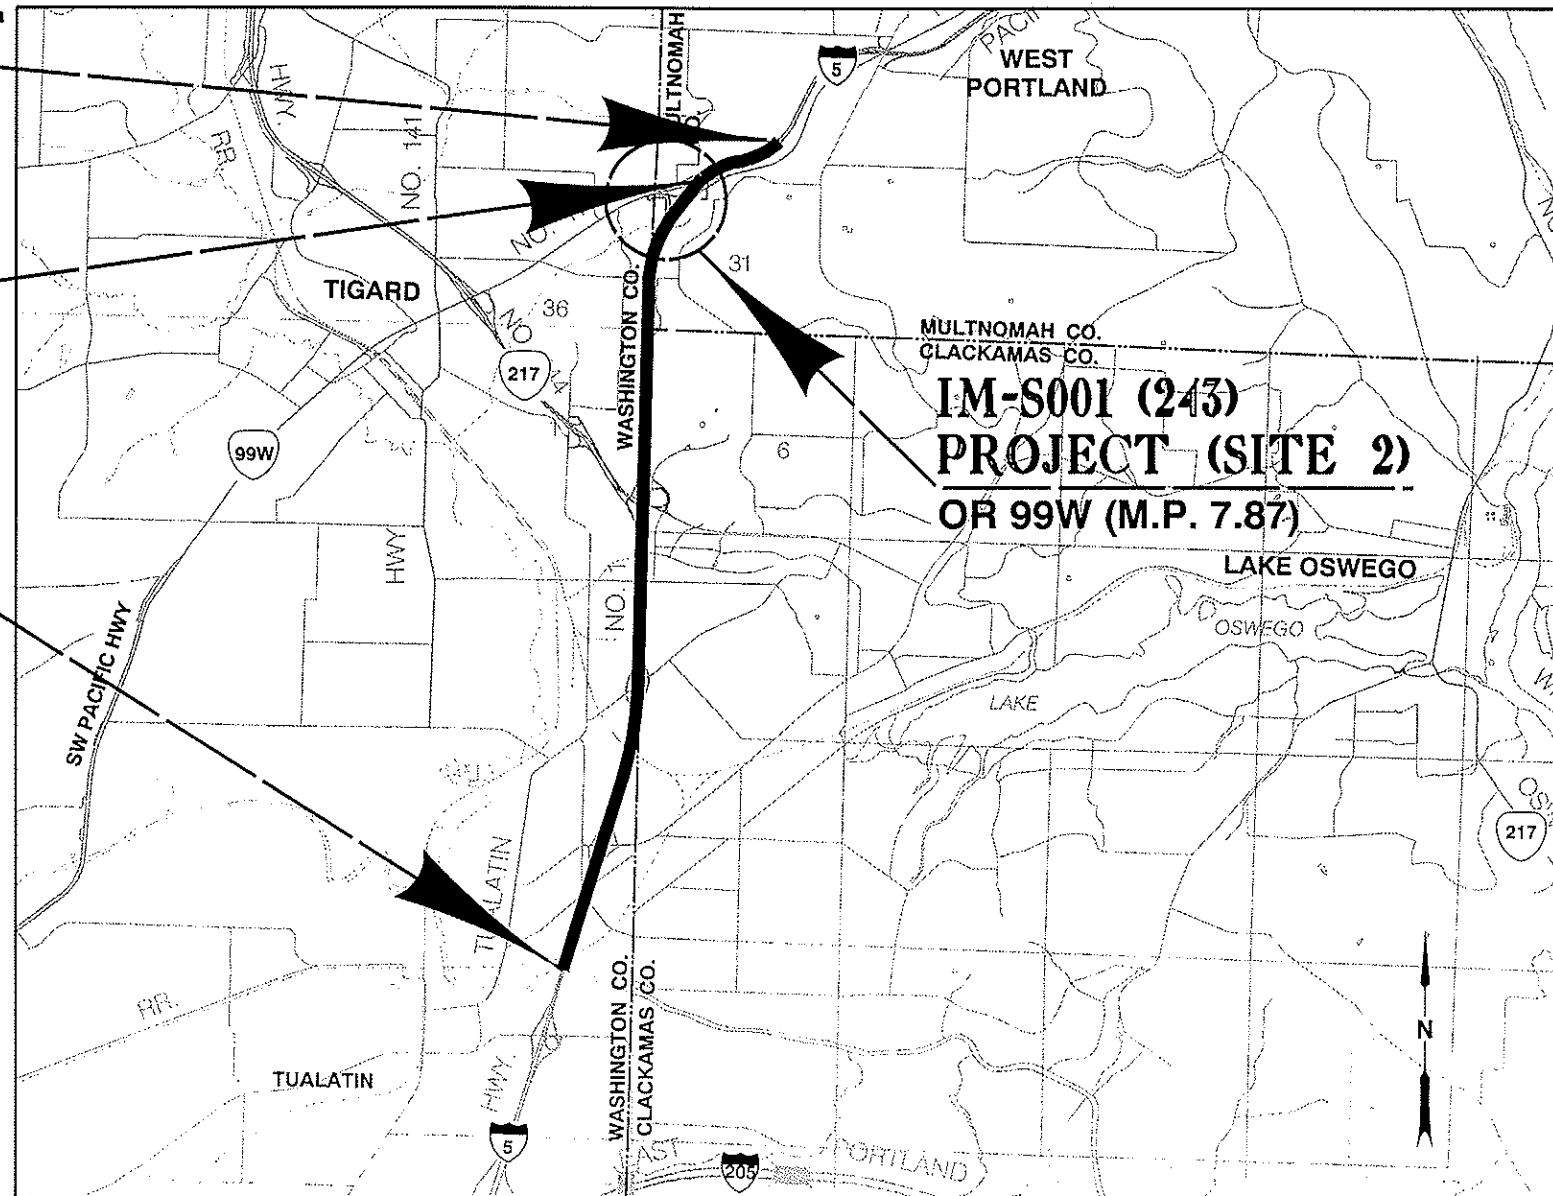

**IM-S001 (243)  
 PROJECT (SITE 2)  
 OR 99W (M.P. 7.87)**

**RECORD DRAWINGS**  
 THIS DRAWING IS FOR RECORD PURPOSES ONLY, AND HAS BEEN PREPARED BASED IN PART ON INFORMATION PROVIDED BY OTHERS RELATIVE TO REPORTED CONSTRUCTED CONDITIONS, WHILE THIS INFORMATION IS BELIEVED TO BE RELIABLE, MURRAY, SMITH & ASSOCIATES, INC. MAKES NO ASSURANCES, STATED OR IMPLIED, AS TO THE ACCURACY OF THIS DRAWING. THOSE RELYING ON THIS RECORD DRAWING FOR ANY PURPOSE ARE ADVISED TO OBTAIN INDEPENDENT VERIFICATION OF ITS ACCURACY, CONTRACT MODIFICATION INFORMATION, FABRICATOR'S SHOP DRAWINGS AND OTHER PROJECT SUBMITTAL INFORMATION PROVIDED BY THE CONTRACTOR WHICH FURTHER CLARIFY DETAILS OF CONSTRUCTION MAY BE ON FILE. SEE ORIGINAL CONTRACT DRAWINGS FOR ENGINEER'S SEAL AND SIGNATURES.  
 VERSION 4.0 12-9-97

OREGON TRANSPORTATION COMMISSION

Stuart Foster CHAIRMAN  
 Gail L. Achterman COMMISSIONER  
 Mike Nelson COMMISSIONER  
 Randall Popé COMMISSIONER  
 Janice J. Wilson COMMISSIONER  
 Matthew L. Garrett DIRECTOR OF TRANSPORTATION

PLANS PREPARED FOR  
 ODOT  
 BY:  
 Murray, Smith & Associates, Inc.

REGISTERED PROFESSIONAL  
 ENGINEER  
 16,589  
**ORIGINAL SIGNED BY**  
 OREGON  
 JULY 20, 1993  
 TROY L. BOWERS  
 Expires Dec. 31, 2007

OREGON DEPARTMENT OF TRANSPORTATION  
 CONCURRENCE

CHIEF ENGINEER \_\_\_\_\_ DATE \_\_\_\_\_

**1-5: CAPITOL HWY -  
 TUALATIN RIVER SEC.**  
 PACIFIC HIGHWAY  
 MULTNOMAH, WASHINGTON & CLACKAMAS COUNTIES

FEDERAL HIGHWAY ADMINISTRATION	PROJECT NUMBER	SHEET NO.
OREGON DIVISION	IM-S001 (243)	1


T. 2S., R. 1E., R 1W., W.M.



HAINES ST. INTERCHANGE

40V-55

REVISED AS CONSTRUCTED  
1/15/08 CONTRACT 13351

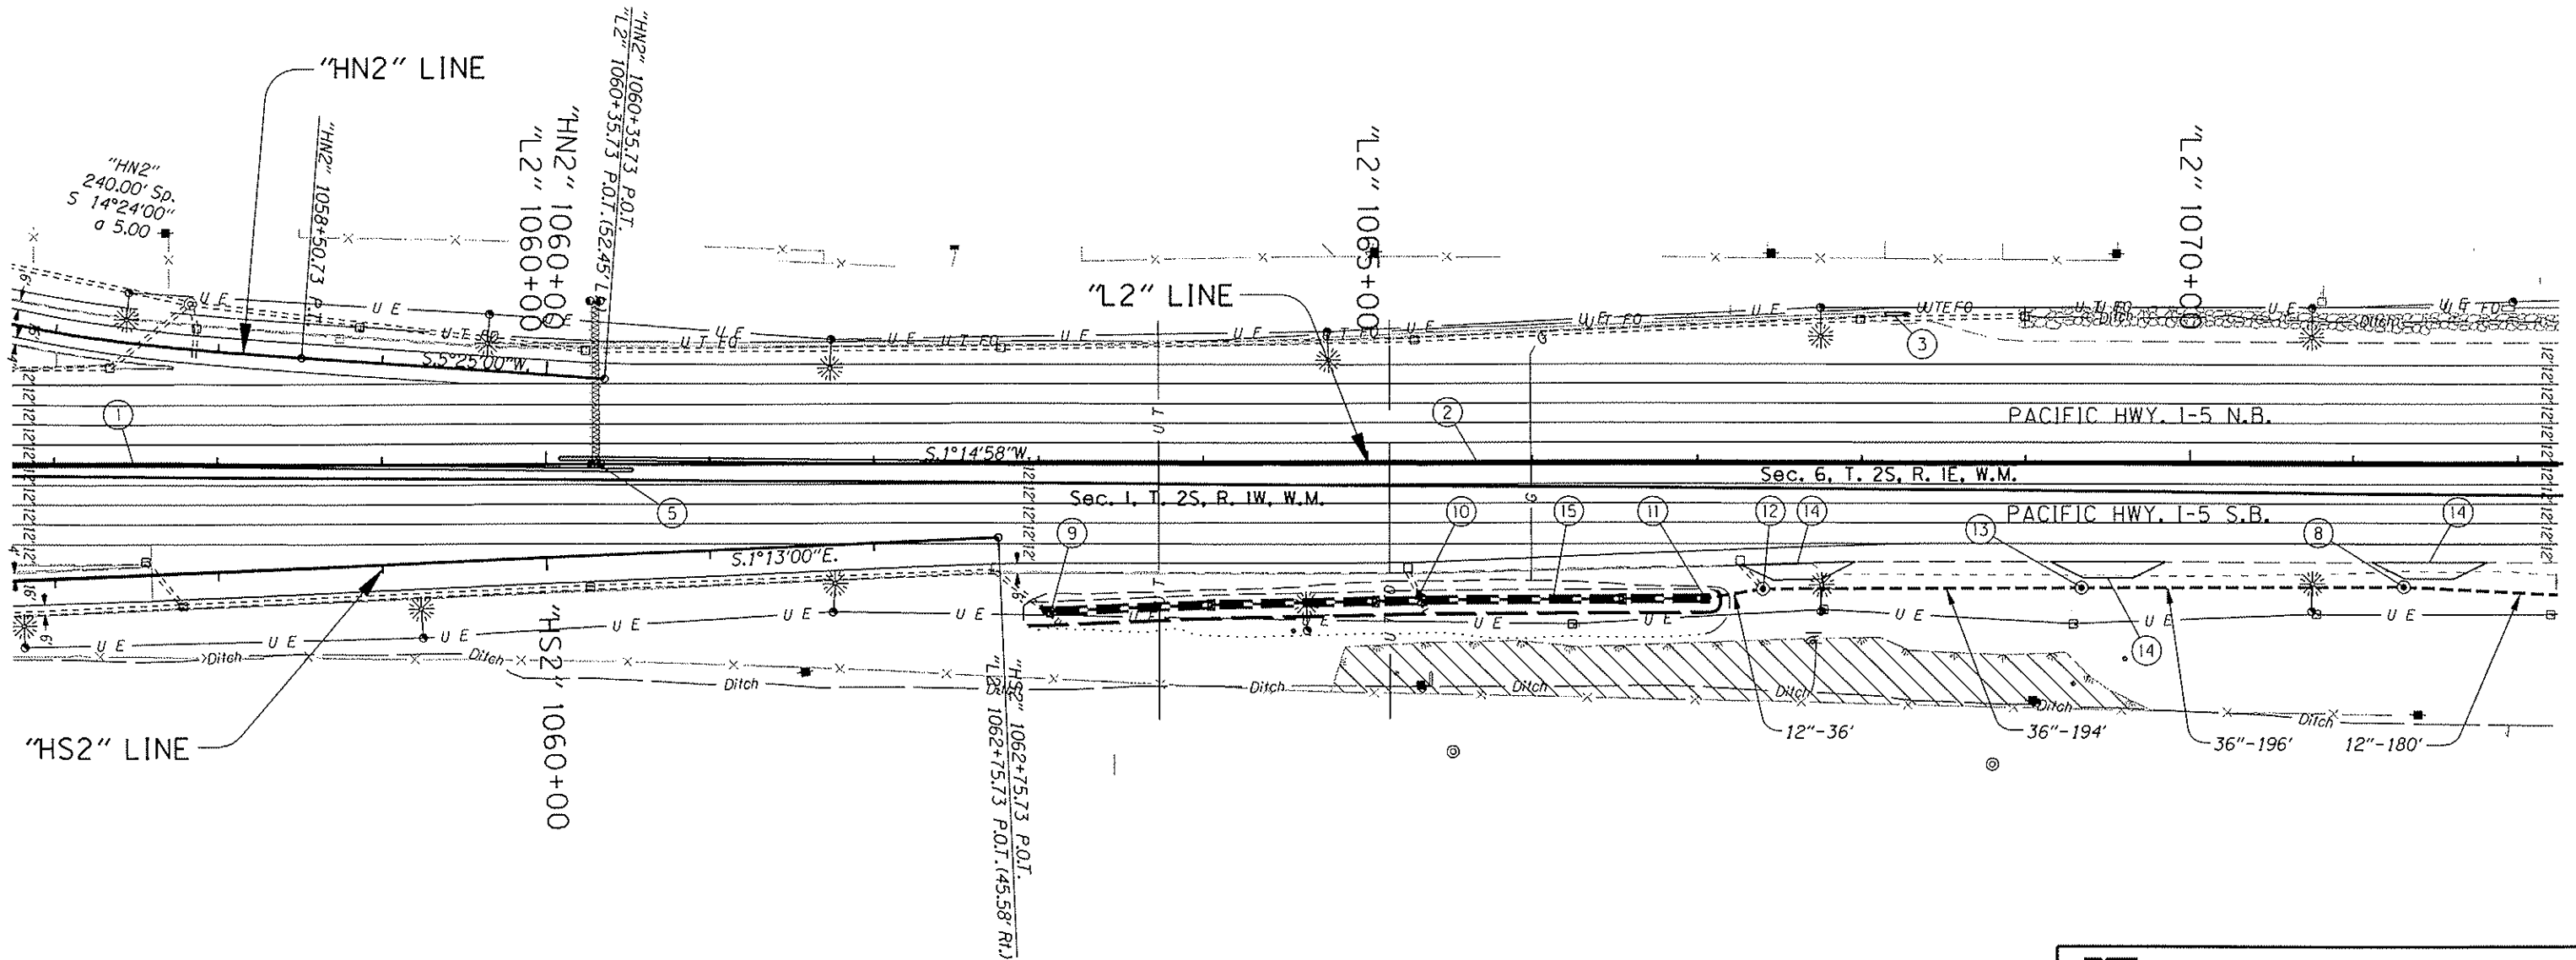

"HS2" LINE


"HN2" LINE

"L2" LINE

PACIFIC HWY. I-5 N.B.

PACIFIC HWY. I-5 S.B.

No Work Zone Shown Thus:

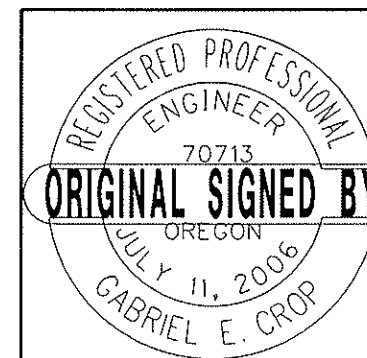

RENEWAL DATE: 12-31-2007

OREGON DEPARTMENT OF TRANSPORTATION

Murray, Smith & Associates, Inc.  
121 S.W. Salmon, Suite 900, Portland, Oregon 97204-2919  
503.225.9010



I-5: CAPITOL HWY -  
TUALATIN RIVER SEC.

PACIFIC HIGHWAY  
MULTNOMAH, WASHINGTON & CLACKAMAS COUNTIES

Reviewed By - Gabriel E. Crop

Designed By - E. Michael Kebbe

Drafted By - Susan K. Wentz

ALIGNMENT & GENERAL CONSTRUCTION

SHEET NO.  
8

① See Sht. 6A, Note 7  
Const. Reflectorized Tall Conc. Median Barrier  
Anchor Barrier To Roadway Using Vertical Anchor Rods

② Sta. "L2" 1060+08 To Sta. "L2" 1082+14  
Const. Reflectorized Tall Conc. Median Barrier - 2200'  
Anchor Barrier To Roadway Using Vertical Anchor Rods

③ Sta. "L2" 1067+95, Lt.  
Remove Extg. Earth Mound - 60 C.Y.  
Inst. Impact Attenuator  
(For Details, See Sht. 2B-13)

⑤ Overlap Barrier Around Extg. Obstacle  
(For Details, See Sht. 2B-11)

⑧ Sta. "L2" 1071+31 - 76' Rt.  
Const. Manhole 72" Dia.  
Rim Elev. = 269.83 +/-  
Inst. 12" Sew. Pipe - 180'  
10' Depth  
(See Drg. Nos. RD316 & RD318)  
(For Details, See Shts. GJ-4 & GJ-5)

⑨ Sta. "L2" 1063+05 - 90' Rt.  
Remove Extg. 12" Pipe - 10'  
Const. Paved End Slope  
(See Drg. No. RD320)  
(For Details, See Sht. GJ-2)

⑩ Sta. "L2" 1065+32 - 84' Rt.  
Remove Extg. 12" Pipe - 4'  
Const. Paved End Slope  
(For Details, See Sht. GJ-2)


⑪ Sta. "L2" 1067+05 - 79' Rt.  
Const. Type "D" Inlet  
Inst. 12" Sew. Pipe - 36'  
10' Depth  
(See Drg. No. RD370)

⑫ Sta. "L2" 1067+40 - 75' Rt.  
Const. Manhole 72" Dia.  
Rim Elev. = 282.20 +/-  
Connect To Extg. 12" Sew. Pipe (NE)  
Inst. 36" Storm Sew. Pipe - 194'  
20' Depth  
(For Details, See Sht. GJ-4)

⑬ Sta. 1069+34 - 75' Rt.  
Const. Manhole 72" Dia.  
Rim Elev. = 276.10 +/-  
Inst. 36" Sew. Pipe - 197'  
10' Depth  
Connect To Proposed Manhole (N)  
(For Details, Shts. GJ-4 & GJ-6)

⑭ Const. Conc. Maintenance Pad - 3  
(See Drg. No. TM434)

⑮ Const. Water Quality Swale  
(For Drg. Nos., See Sht. 1A)

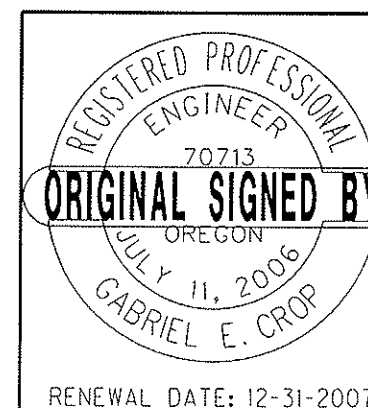

**OREGON DEPARTMENT OF TRANSPORTATION**

Murray, Smith & Associates, Inc.  
121 S.W. Salmon, Suite 900, Portland, Oregon 97204-2919  
503.225.9010



**I-5: CAPITOL HWY -  
TUALATIN RIVER SEC.**

PACIFIC HIGHWAY  
MULTNOMAH, WASHINGTON & CLACKAMAS COUNTIES

Reviewed By - Gabriel E. Crop

Designed By - E. Michael Kebbe

Drafted By - Susan K. Wentz



**GENERAL CONSTRUCTION**

SHEET NO.

**8A**

"L2" LINE PROFILE  
 (For Location, See Sht. 8)  
 NORTHBOUND

40V-55  
 REVISED AS CONSTRUCTED  
 1/15/08 CONTRACT 13351

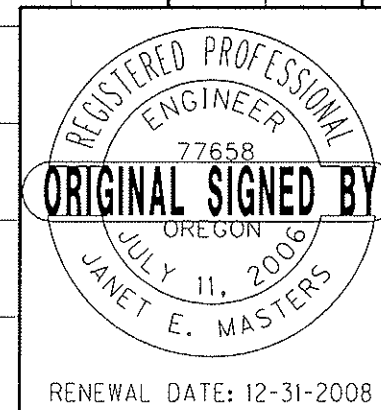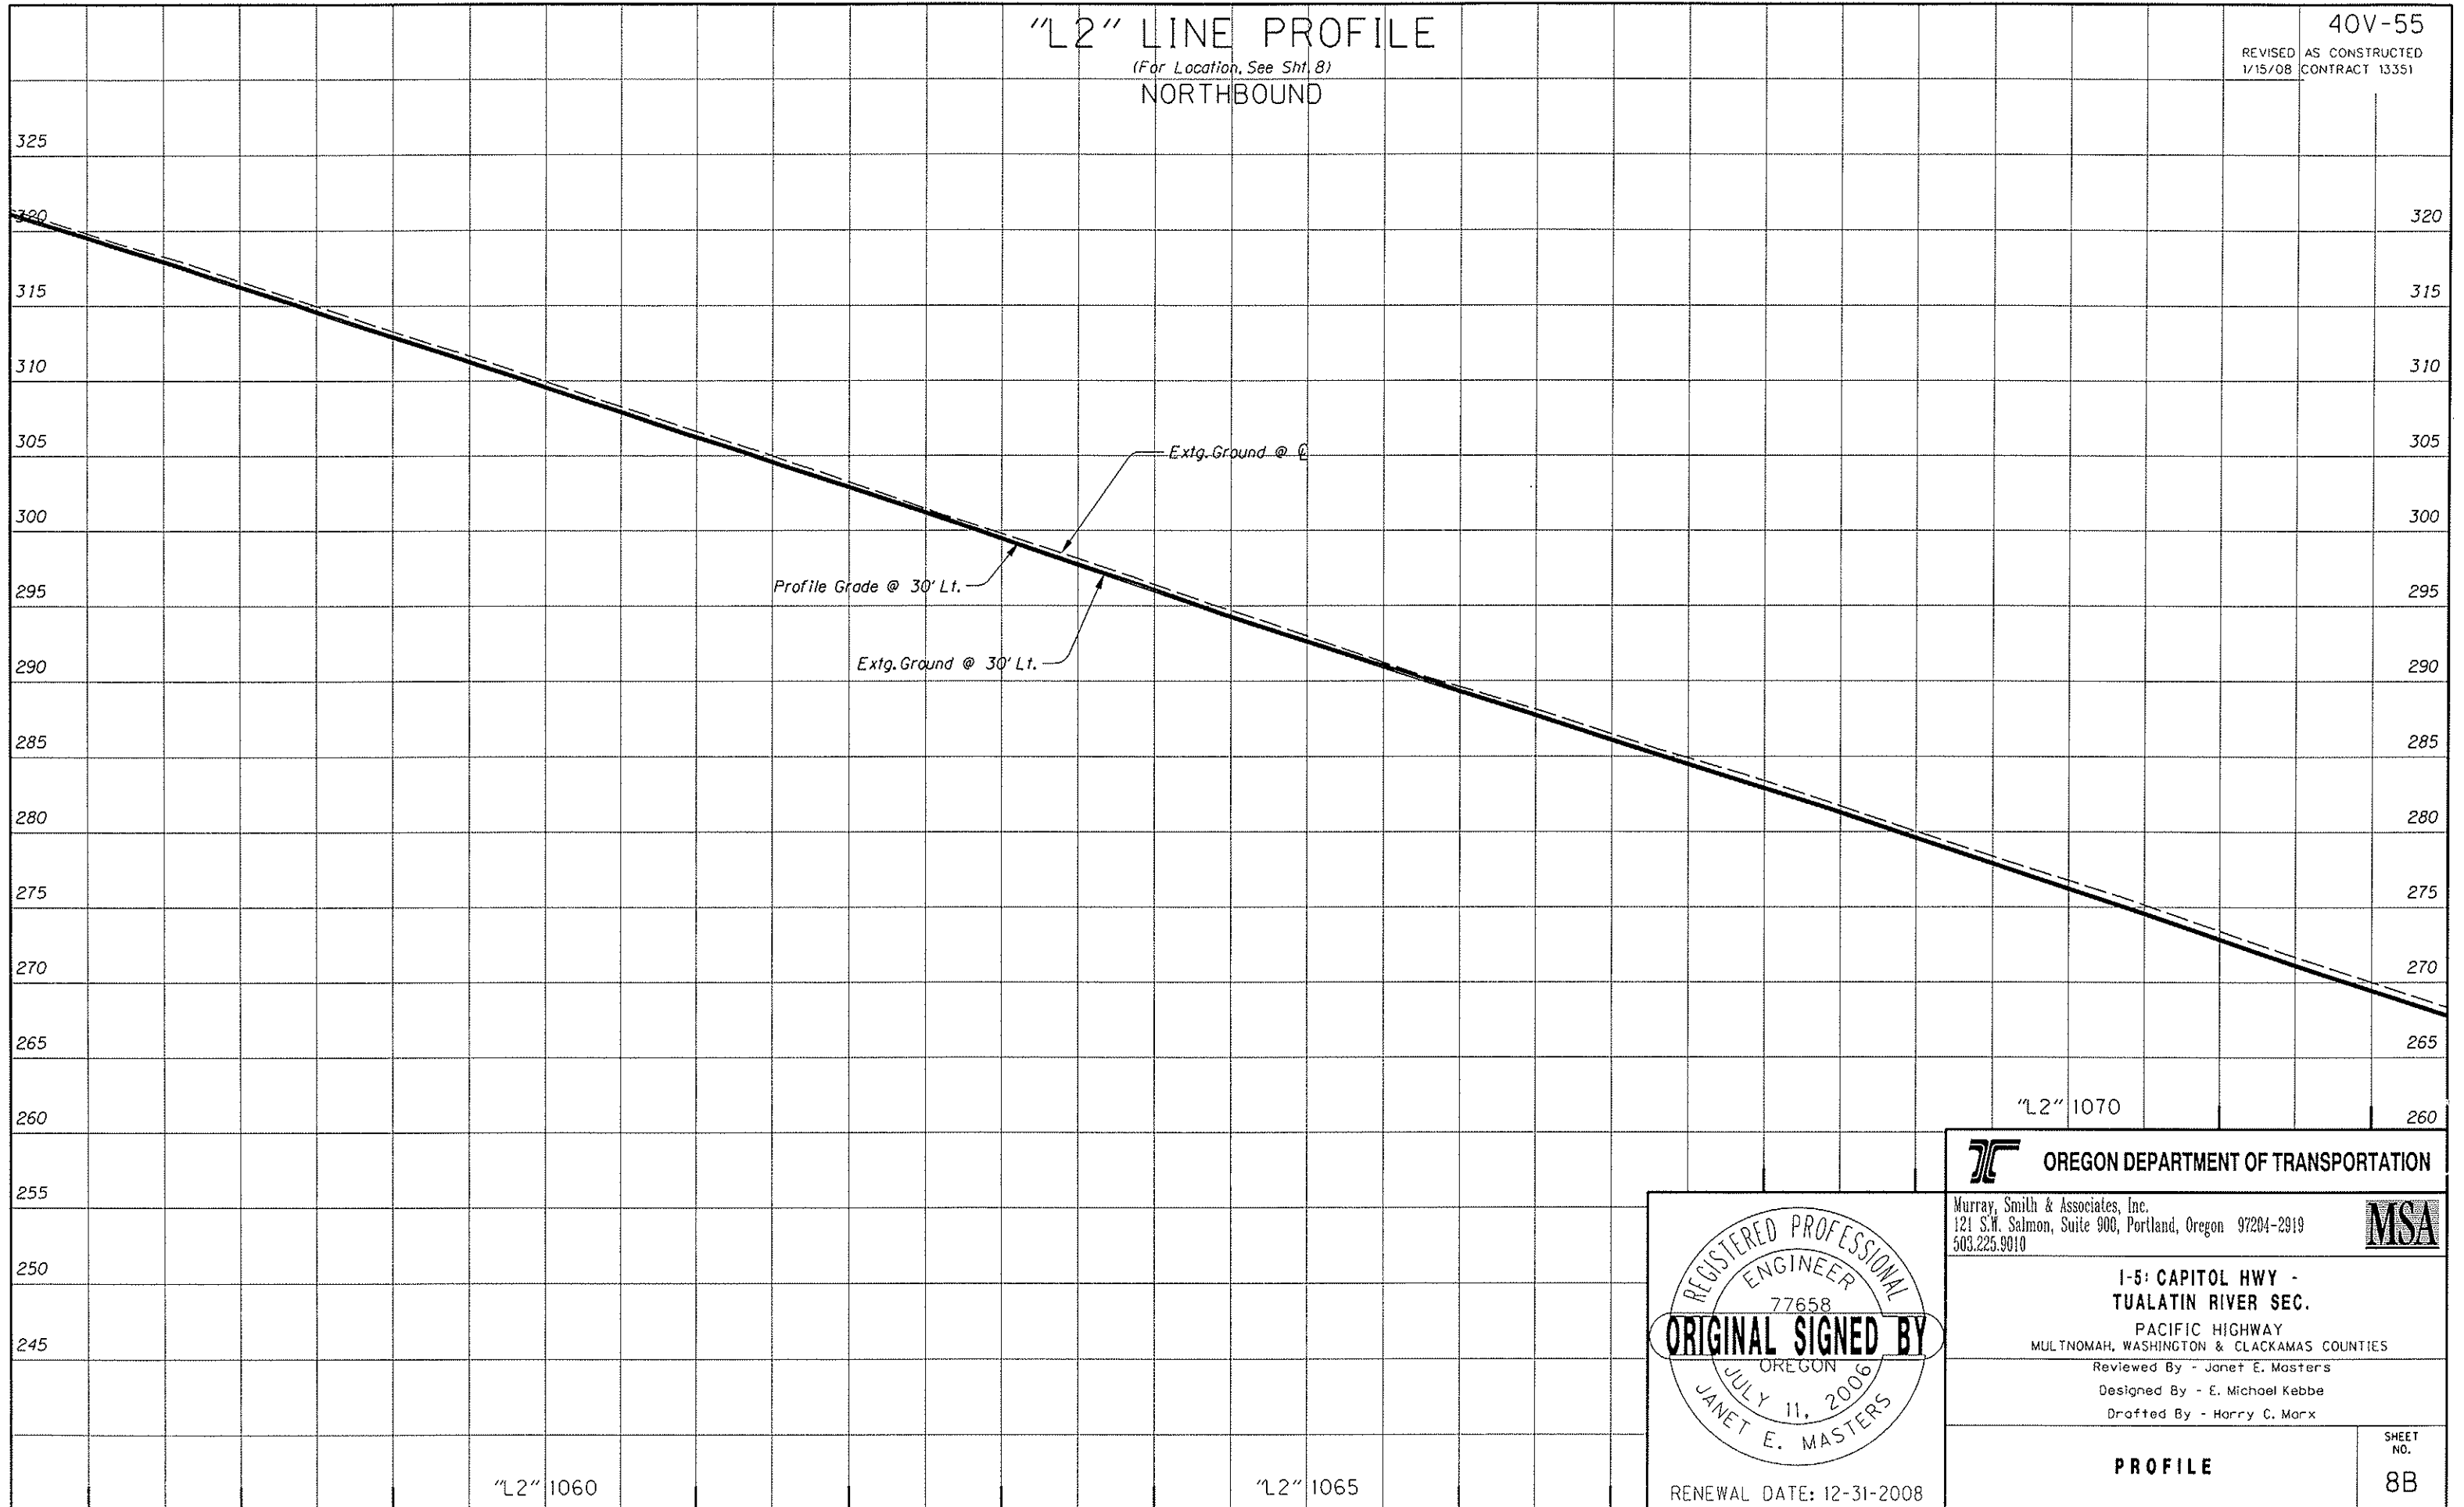


<b>OREGON DEPARTMENT OF TRANSPORTATION</b>	
Murray, Smith & Associates, Inc. 121 S.W. Salmon, Suite 900, Portland, Oregon 97204-2919 503.225.9010	
<b>1-5: CAPITOL HWY - TUALATIN RIVER SEC.</b> PACIFIC HIGHWAY MULTNOMAH, WASHINGTON & CLACKAMAS COUNTIES	
Reviewed By - Janet E. Masters Designed By - E. Michael Kebbe Drafted By - Harry C. Marx	
<b>PROFILE</b>	SHEET NO. <b>8B</b>

"L2" LINE PROFILE  
 (For Location, See Sht. 8)  
 SOUTHBOUND

40V-55

REVISED AS CONSTRUCTED  
 1/15/08 CONTRACT 13351

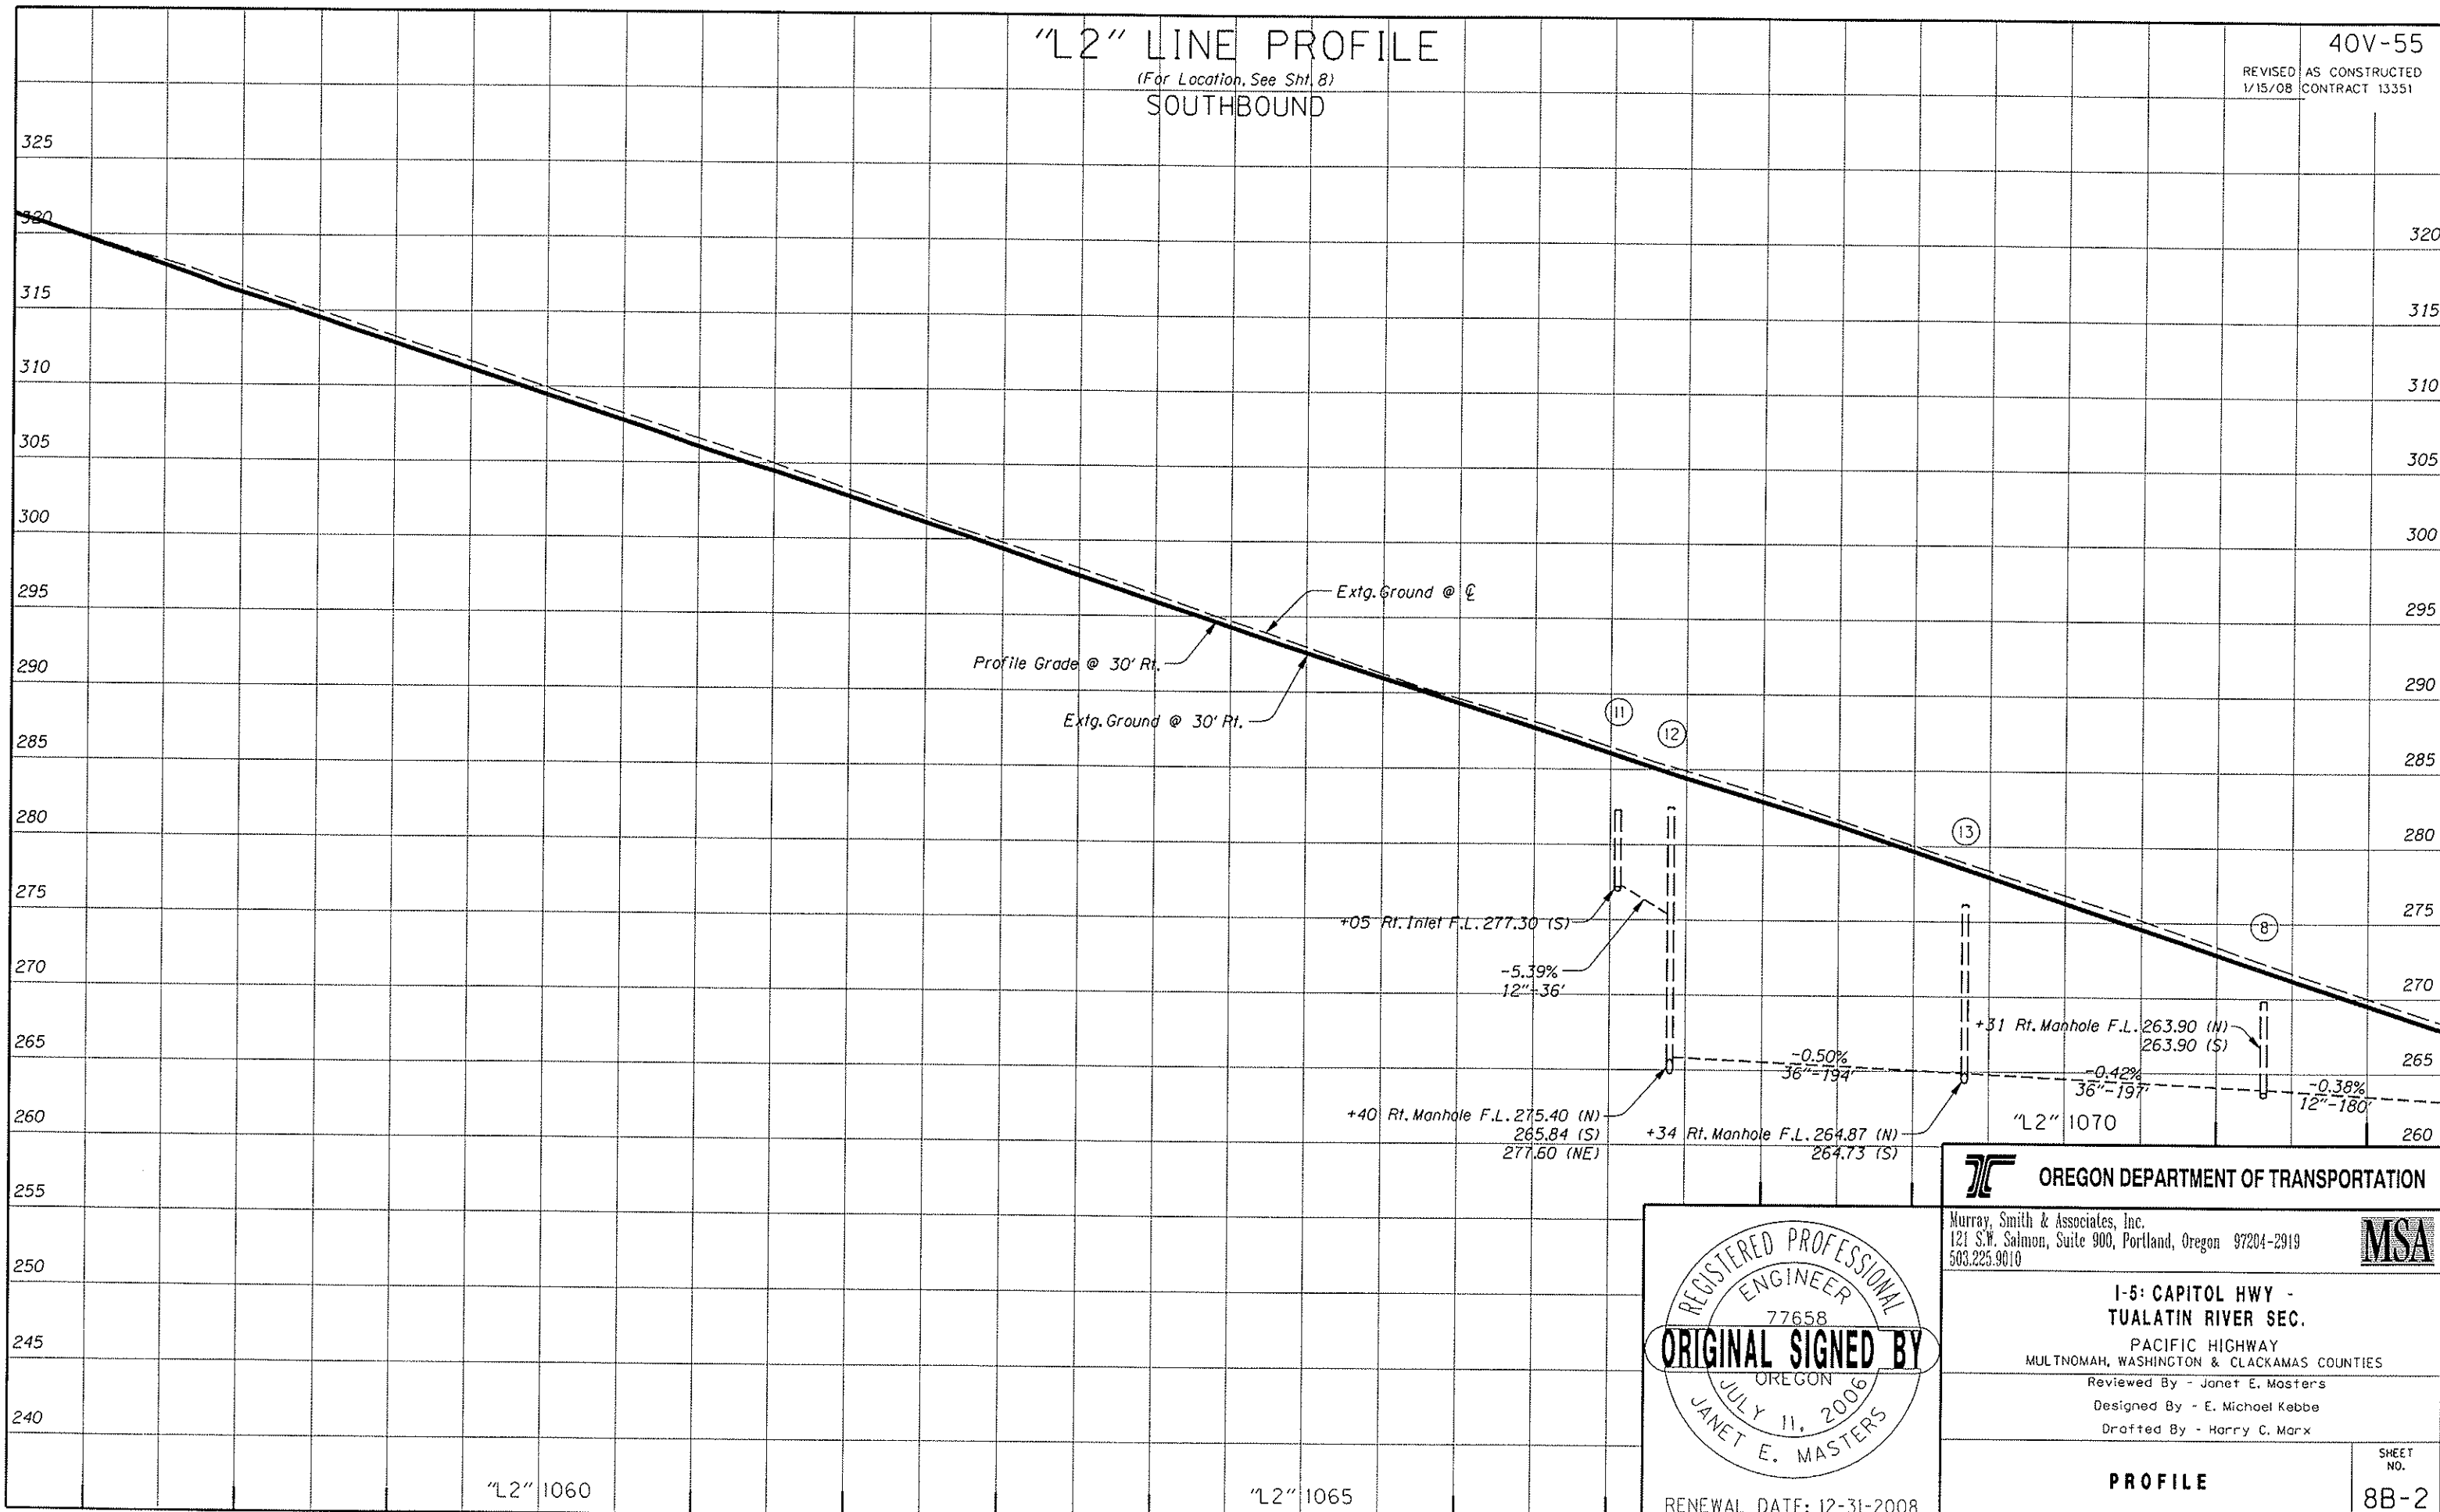

REGISTERED PROFESSIONAL  
 ENGINEER  
 77658  
**ORIGINAL SIGNED BY**  
 OREGON  
 JULY 11, 2006  
 JANET E. MASTERS

**OREGON DEPARTMENT OF TRANSPORTATION**

Murray, Smith & Associates, Inc.  
 121 S.W. Salmon, Suite 900, Portland, Oregon 97204-2919  
 503.225.9610

**1-5: CAPITOL HWY - TUALATIN RIVER SEC.**  
 PACIFIC HIGHWAY  
 MULTNOMAH, WASHINGTON & CLACKAMAS COUNTIES  
 Reviewed By - Janet E. Masters  
 Designed By - E. Michael Kebbe  
 Drafted By - Harry C. Marx

**PROFILE**


SHEET NO.  
**8B-2**



S. TIGARD INTERCHANGE

40V-55

REVISED AS CONSTRUCTED  
1/15/08 CONTRACT 13351

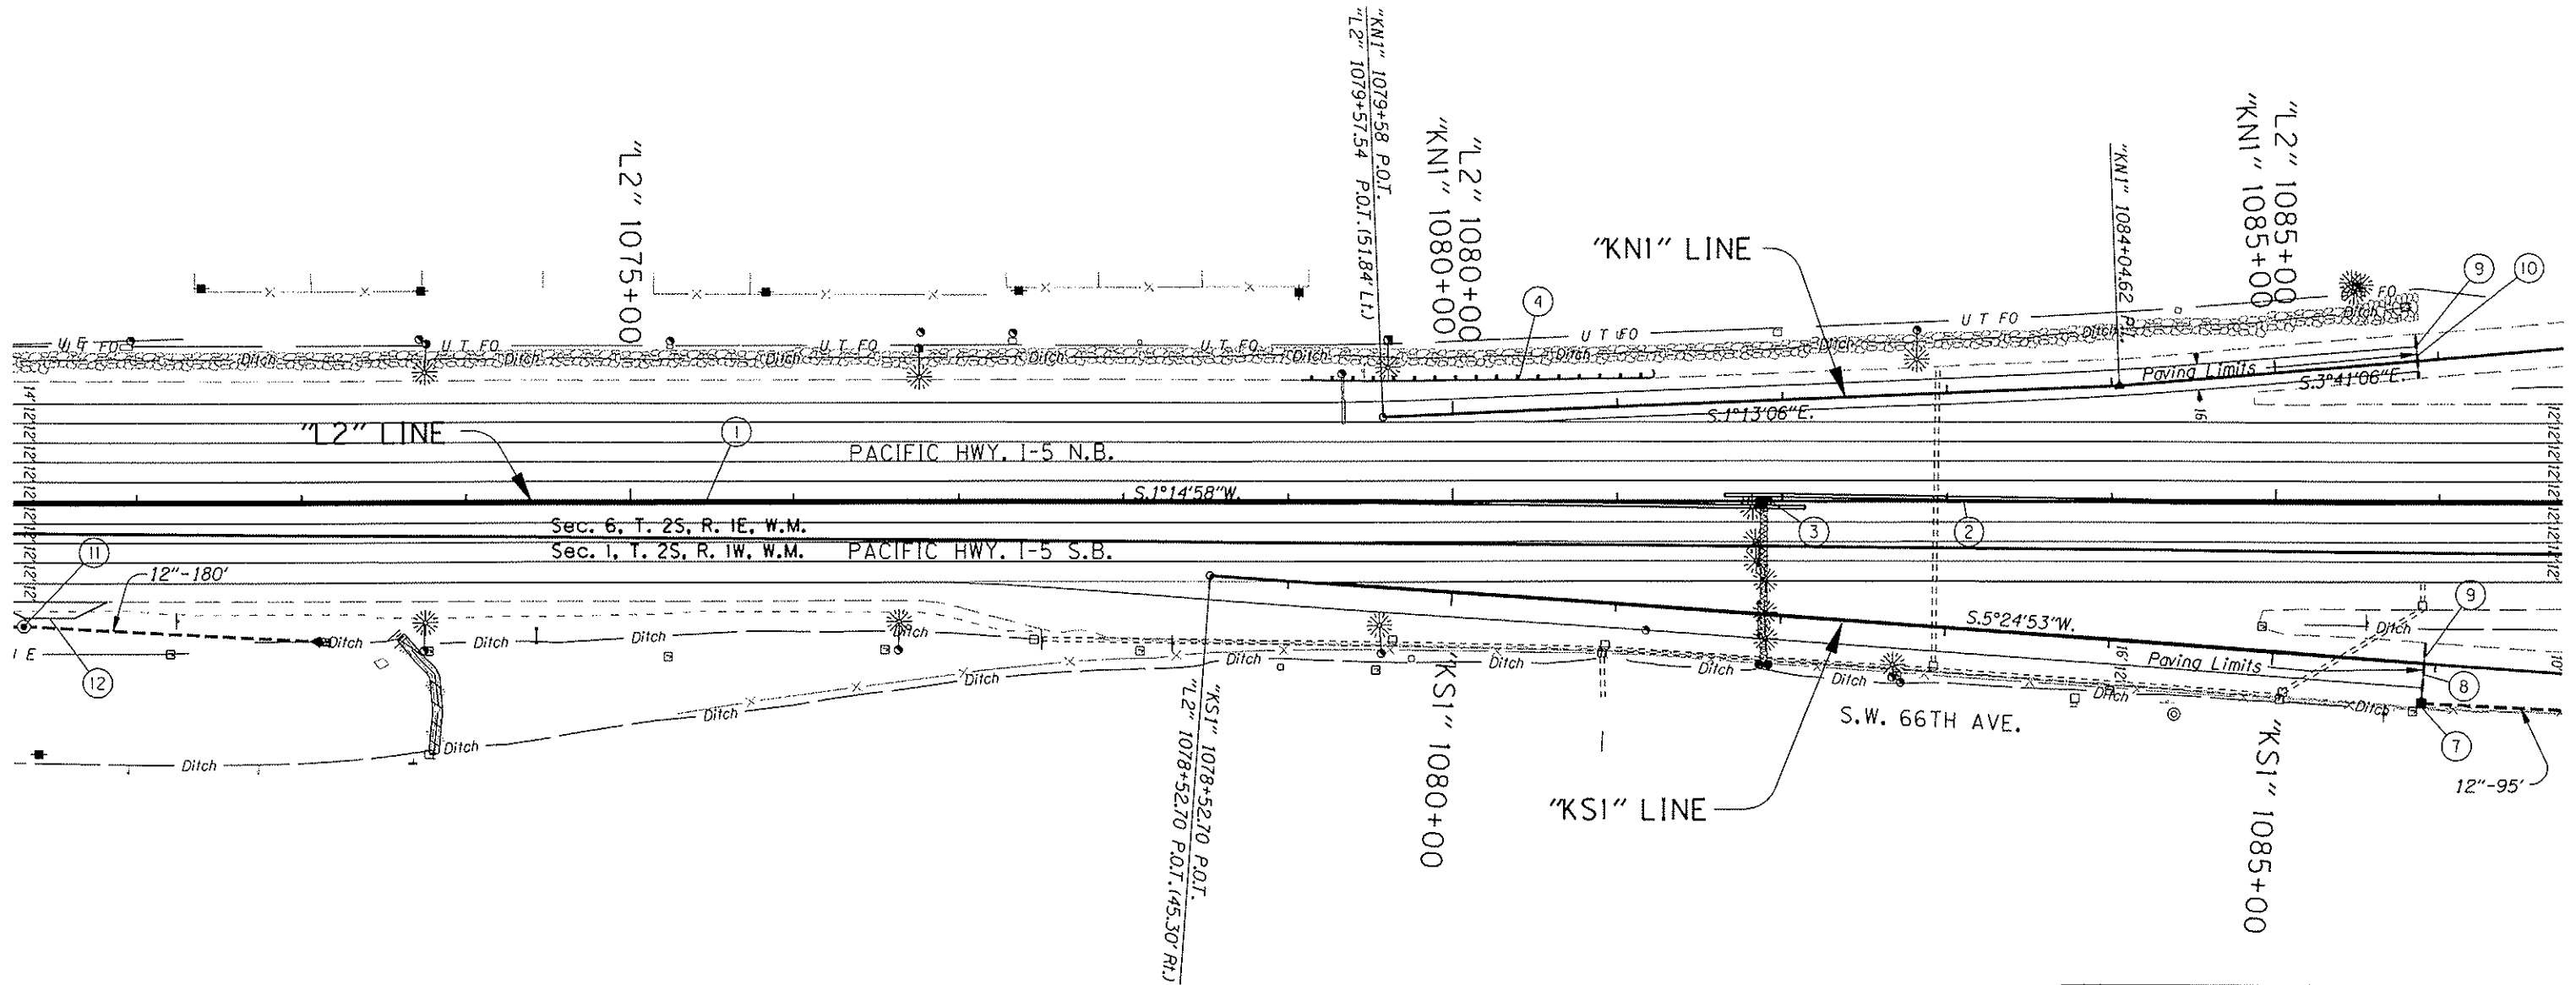


No Work Zone Shown Thus:



OREGON DEPARTMENT OF TRANSPORTATION	
Murray, Smith & Associates, Inc. 121 S.W. Salmon, Suite 900, Portland, Oregon 97204-2919 503.225.9010	
<b>I-5: CAPITOL HWY - TUALATIN RIVER SEC.</b> PACIFIC HIGHWAY MULTNOMAH, WASHINGTON & CLACKAMAS COUNTIES	
Reviewed By - Gabriel E. Crop Designed By - Jeremiah D. Hess Drafted By - Susan K. Wentz	
<b>ALIGNMENT &amp; GENERAL CONSTRUCTION</b>	SHEET NO. <b>9</b>


- ① See Sht. 8A, Note 2  
Const. Reflectorized Tall Conc. Median Barrier  
Anchor Barrier To Roadway Using Vertical Anchor Rods
- ② Sta. "L2" 1081+65 To Sta. "L2" 1101+40  
Const. Reflectorized Tall Conc. Median Barrier - 1975'  
Anchor Barrier To Roadway Using Vertical Anchor Rods
- ③ Overlap Barrier Around Extg. Obstacle  
(For Details, See Sht. 2B-11)
- ④ Sta. "L2" 1079+08 To Sta. "KN1" 1081+21, Lt.  
Const. Guardrail - 175' (Type 2A)  
Const. Anchor (Type 1 Mod)  
Inst. End Piece (Type B)  
Const. Guardrail Terminal, Non-Flared  
W=1, E=0  
(See Drg. Nos. RD400, RD405, RD410, RD415, RD420 & RD450)
  
- ⑦ Sta. "L2" 1085+90, Rt.  
Const. Type "G-2" Inlet  
Inst. 12" Sew. Pipe - 93'  
5' Depth  
Connect To Extg. Inlet (N)  
Connect To Extg. Perf. Pipe  
Const. Open Grade HMA Inlet Mod.
- ⑧ Inst. Wearing Surface Drain - 40'  
Option "A" Outlet To Inlet
- ⑨ Transition To Extg. Pymt.
- ⑩ Inst. Wearing Surface Drain - 25'  
Option "B" Outlet To Ditch
- ⚠ ⑪ See Sht. 8A, Note 8  
Const. 72" Dia. Manhole  
Inst. 12" Sew. Pipe  
10' Depth  
Const. Paved End Slope  
Const. Loose Riprap (Class 50) - 2 C.Y.  
Inst. Drainage Geotextile, Type 2 - 7 Sq. Yd.  
(For Details, See Shts. GJ-4 & GJ-5)
- ⑫ See Sht. 8A, Note 14  
Const. Conc. Maintenance Pad

Rev. No.	Description	Date	Engineer
⚠	Addenda #1 - Format Note #11	2/26/07	JDH

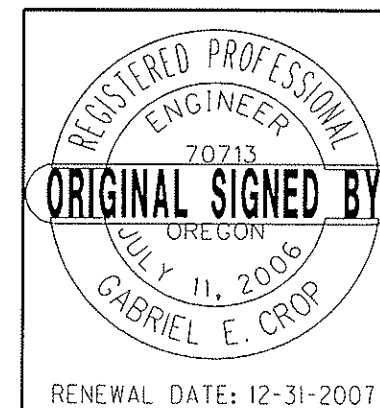


RENEWAL DATE: 12-31-2007

<b>OREGON DEPARTMENT OF TRANSPORTATION</b>	
Murray, Smith & Associates, Inc. 121 S.W. Salmon, Suite 900, Portland, Oregon 97204-2919 503.225.9010	
<b>MSA</b>	
<b>I-5: CAPITOL HWY - TUALATIN RIVER SEC.</b>	
PACIFIC HIGHWAY MULTNOMAH, WASHINGTON & CLACKAMAS COUNTIES	
Reviewed By - Gabriel E. Crop Designed By - Jeremiah D. Hess Drafted By - Susan K. Wentz	
<b>GENERAL CONSTRUCTION</b>	SHEET NO. <b>9A</b>

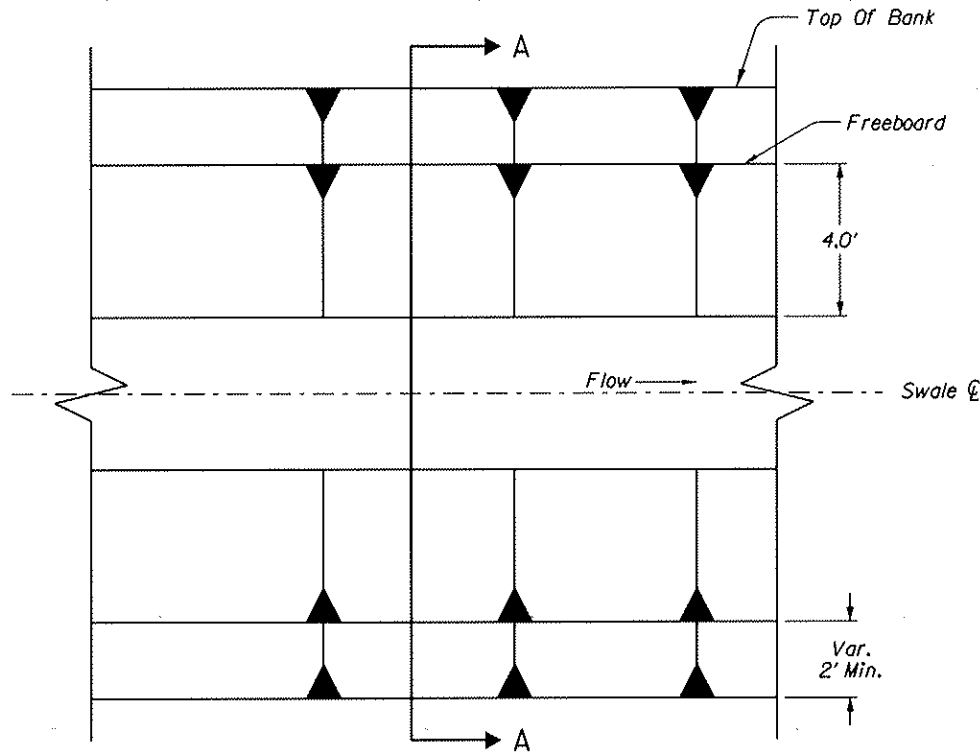


PLAN  
GENERAL SWALE LAYOUT

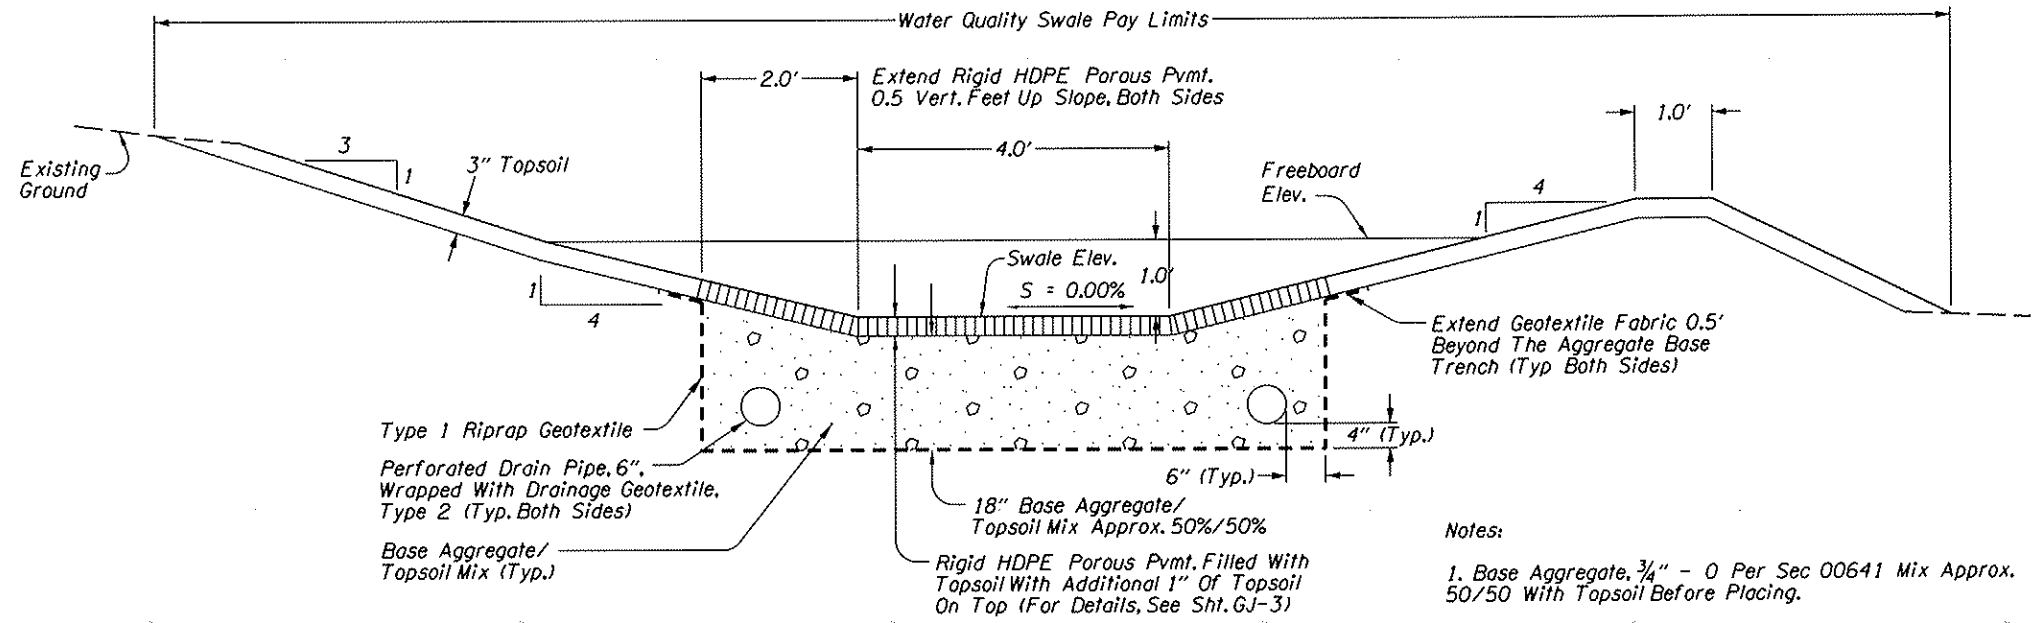


SECTION A-A  
SWALE SOIL STRUCTURE  
NTS

Notes:

- 1. Base Aggregate, 3/4" - 0 Per Sec 00641 Mix Approx. 50/50 With Topsoil Before Placing.

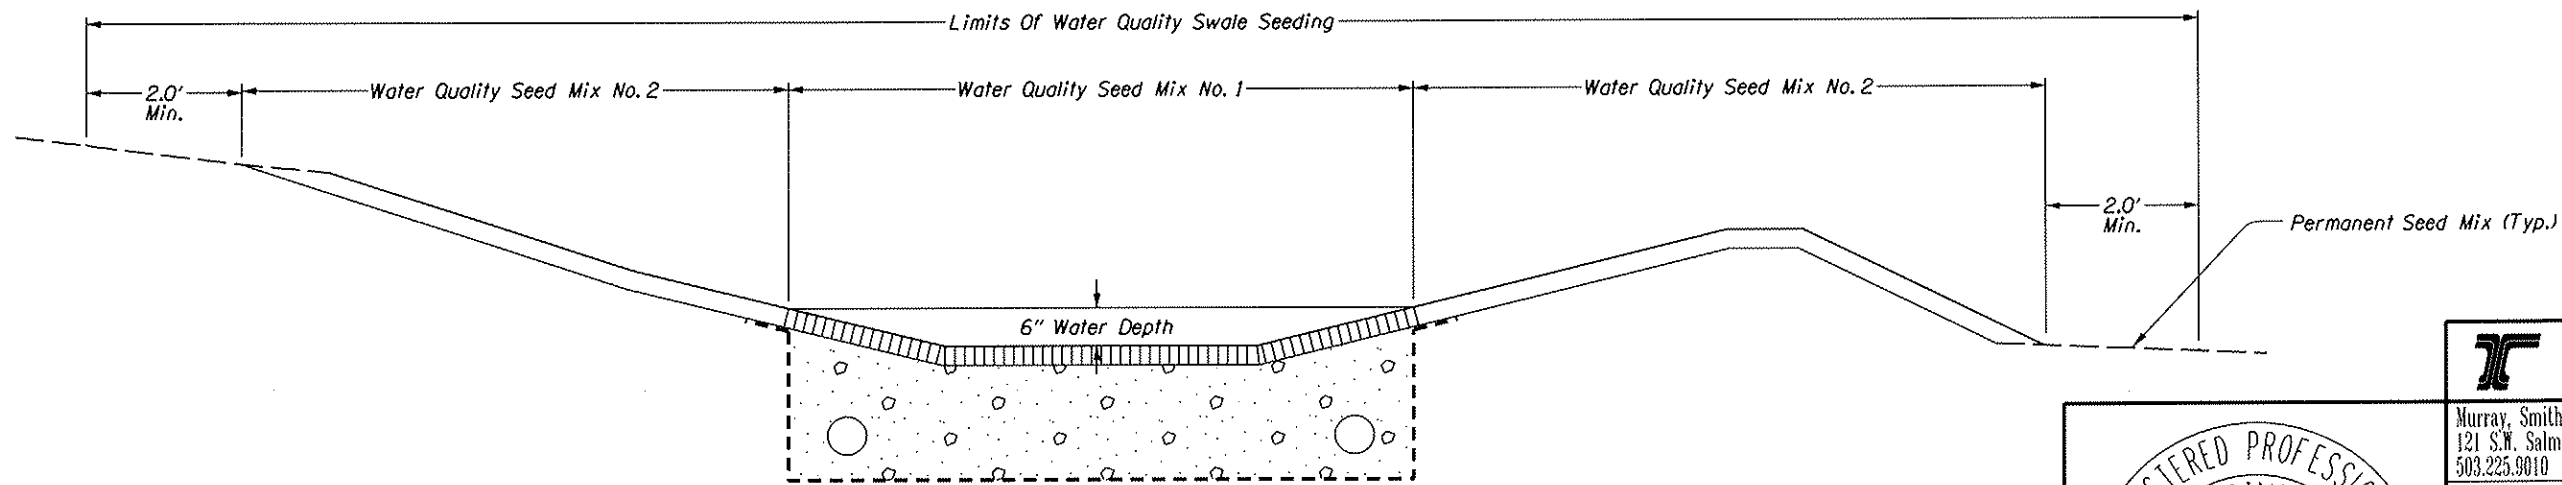

SECTION A-A  
SWALE SEEDING LIMITS  
(For Seed Mix Details, See Specs.)

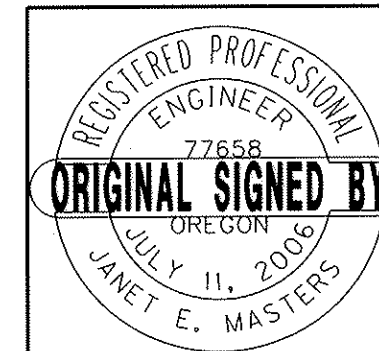

RENEWAL DATE: 12-31-2008

**OREGON DEPARTMENT OF TRANSPORTATION**

Murray, Smith & Associates, Inc.  
121 S.W. Salmon, Suite 900, Portland, Oregon 97204-2919  
503.225.9010



**1-5: CAPITOL HWY -  
TUALATIN RIVER SEC.**

PACIFIC HIGHWAY  
MULTNOMAH, WASHINGTON & CLACKAMAS COUNTIES

Reviewed By - Janet E. Masters

Designed By - Brendan V. O'Sullivan

Drafted By - Harry C. Marx

**WATER QUALITY DETAILS**


SHEET  
NO.

GJ


SWALE FLOW SPREADER  
NTS

Flow Spreader Table


Station	Top Of Weir Board Elev.
"SW1" 1+00	293.67 ft.
"SW1" 2+00	290.87 ft.
"SW1" 3+00	288.07 ft.
"SW1" 3+28	287.28 ft.
"SW1" 4+50	283.87 ft.

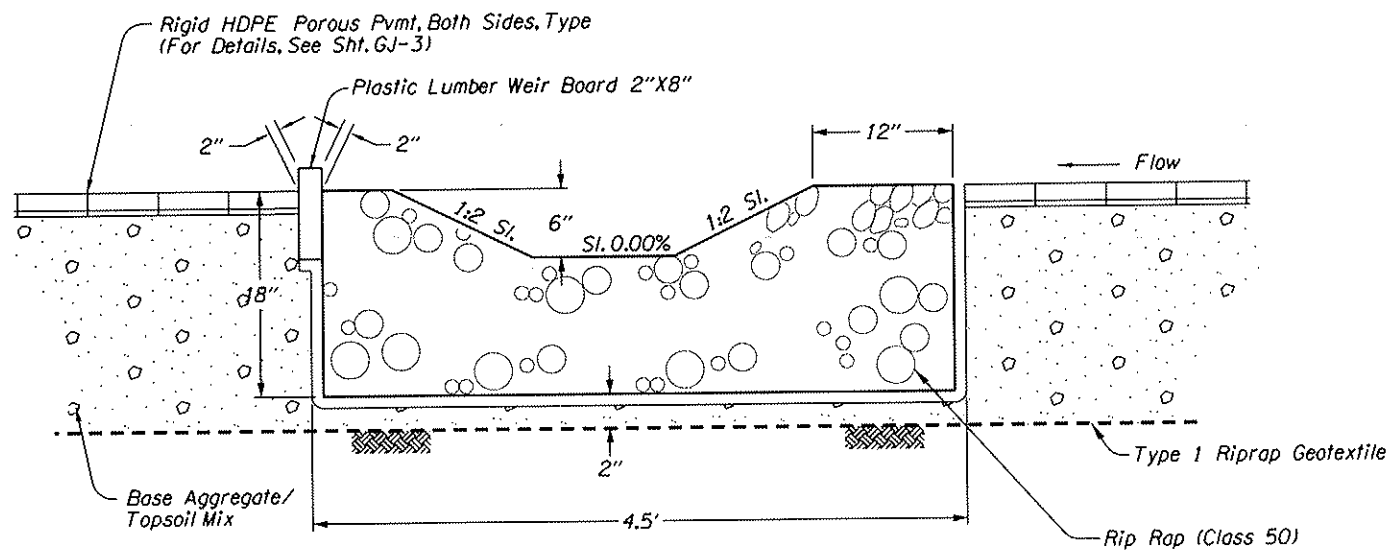


SECTION B-B

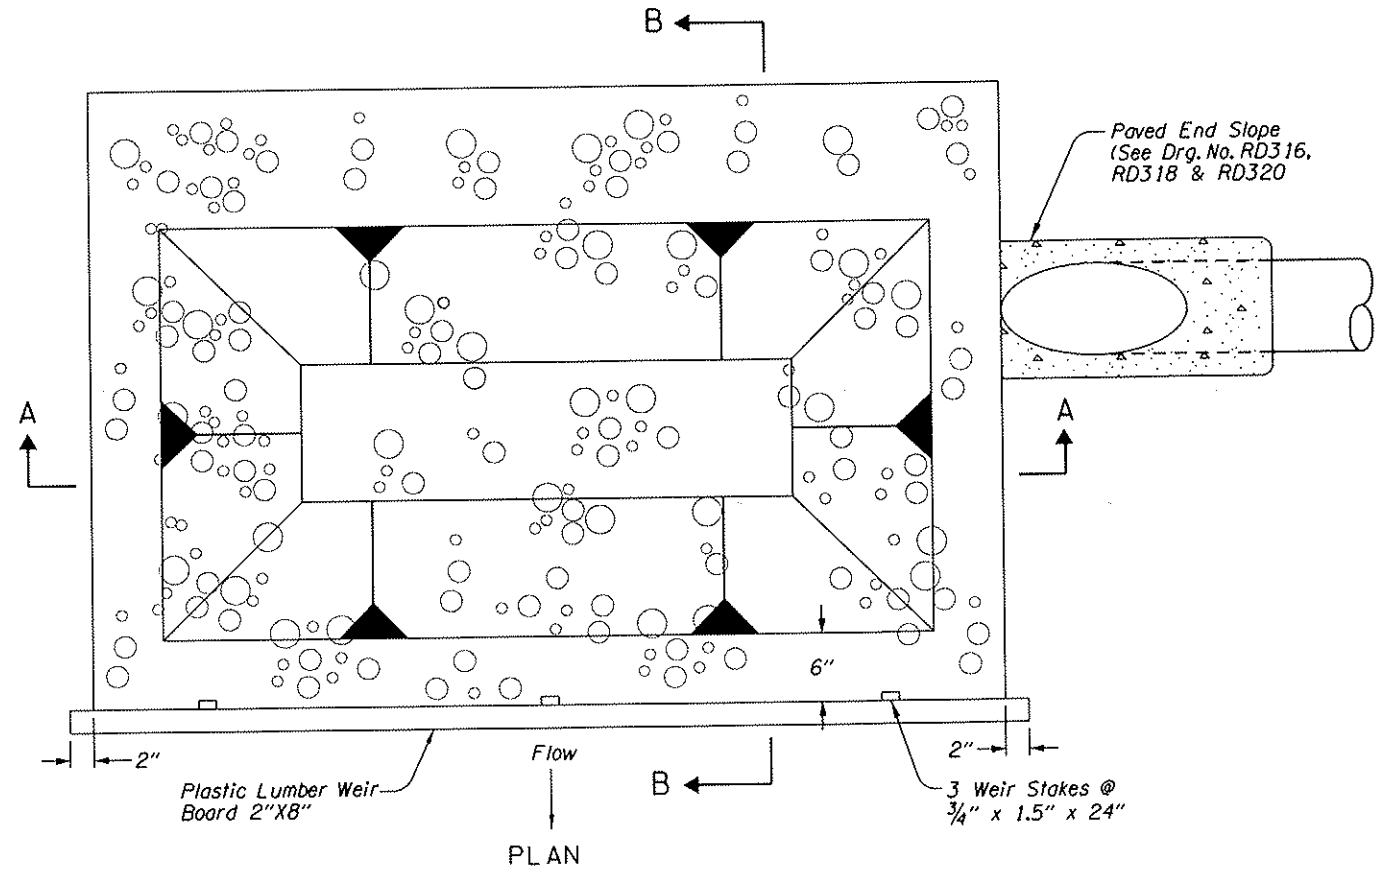

PLAN

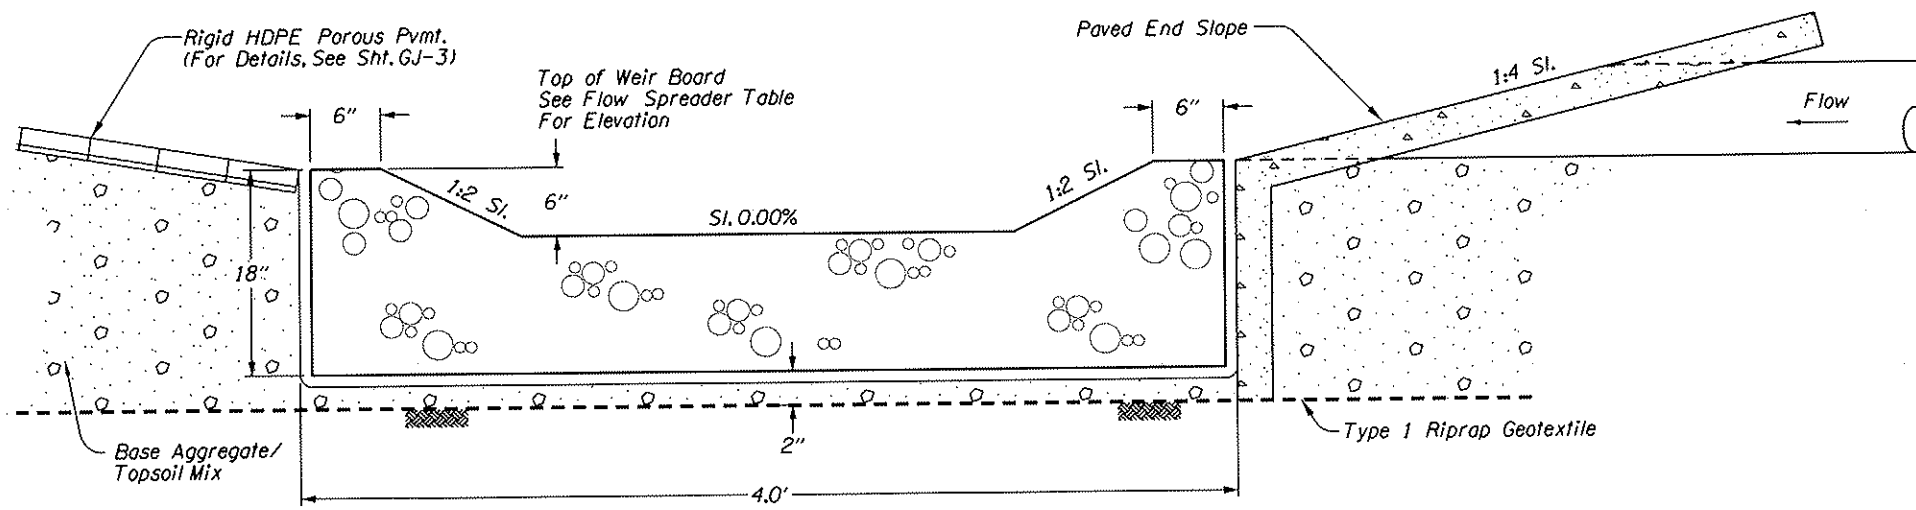

SECTION A-A

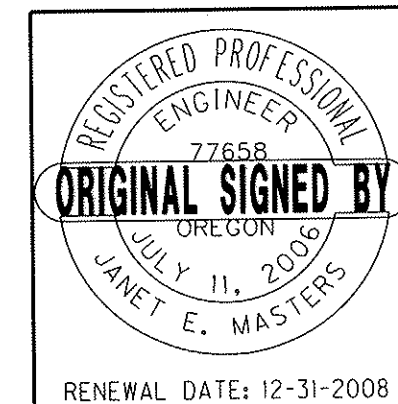


Murray, Smith & Associates, Inc. 121 S.W. Salmon, Suite 900, Portland, Oregon 97204-2919 503.225.9010	
<b>1-5: CAPITOL HWY - TUALATIN RIVER SEC.</b> PACIFIC HIGHWAY MULTNOMAH, WASHINGTON & CLACKAMAS COUNTIES Reviewed By - Janet E. Masters Designed By - Brendan V. O'Sullivan Drafted By - Harry C. Marx	
<b>WATER QUALITY DETAILS</b>	SHEET NO. <b>GJ-2</b>

RIGID HDPE POROUS PAVEMENT DETAILS


40V-55

REVISED AS CONSTRUCTED  
1/15/08 CONTRACT 13351

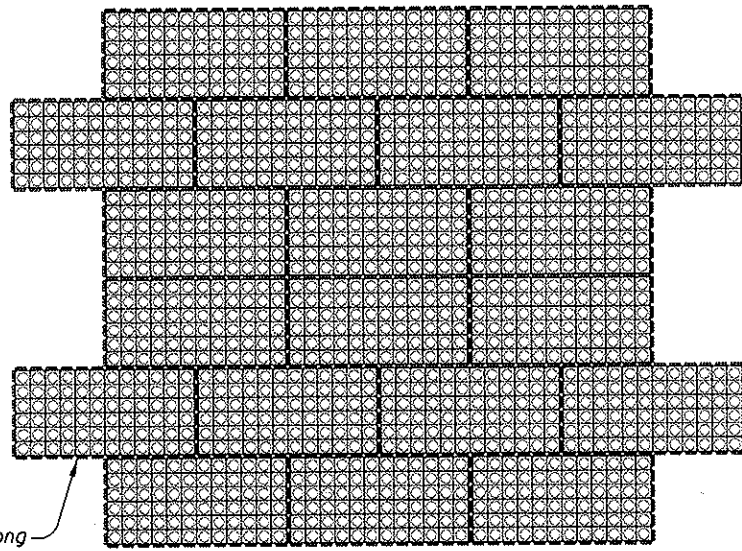


Cut Sections In Half Along  
Outer Edges Of Porous  
Pavement System

LAYOUT OPTION A

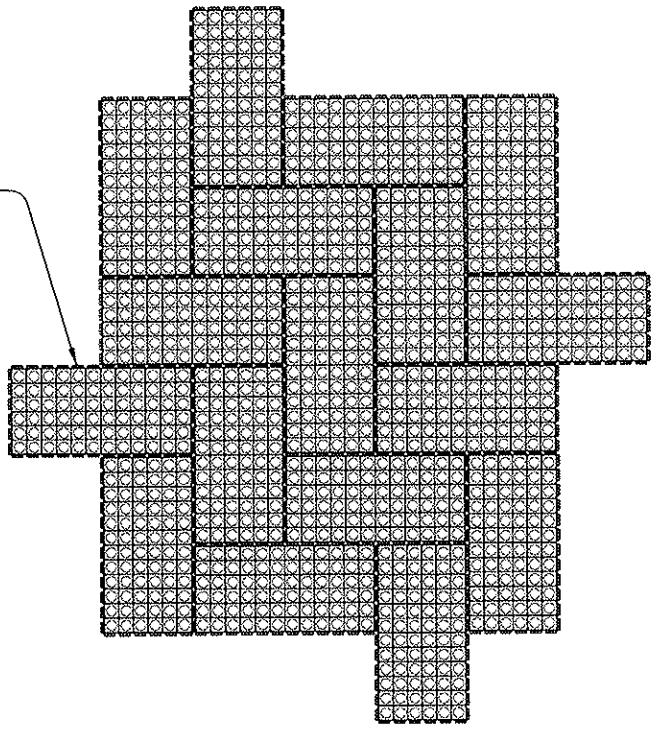

Cut Sections In Half Along  
Outer Edges Of Porous  
Pavement System


LAYOUT OPTION B

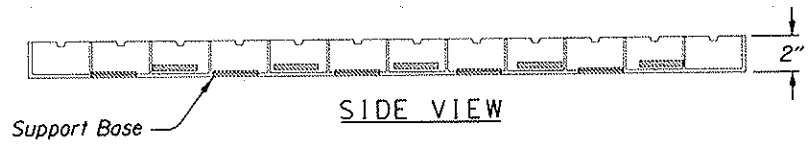


SIDE VIEW



END VIEW

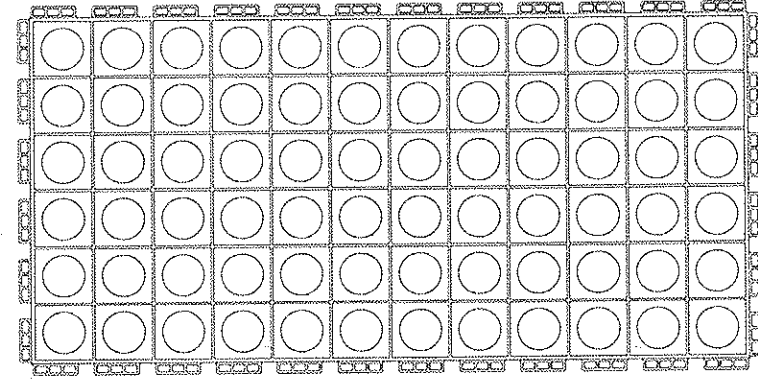

TOP VIEW

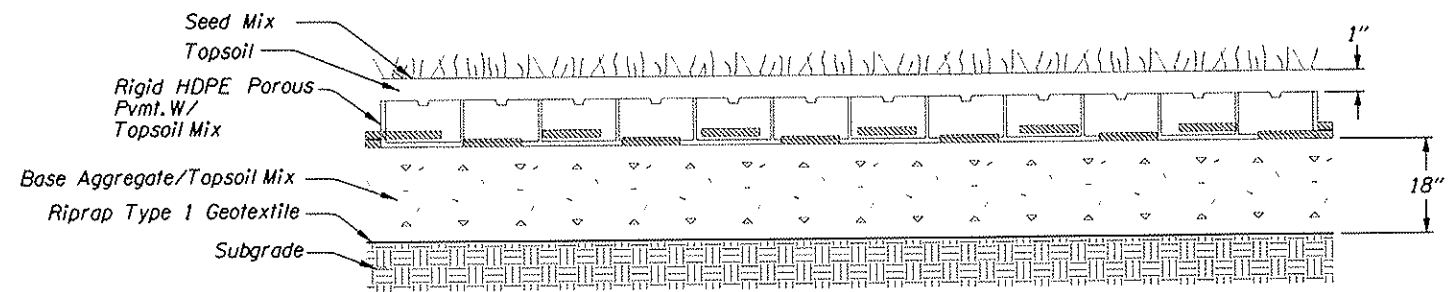

TYPICAL CROSS SECTION



RENEWAL DATE: 12-31-2008

**OREGON DEPARTMENT OF TRANSPORTATION**

Murray, Smith & Associates, Inc.  
121 S.W. Salmon, Suite 900, Portland, Oregon 97204-2919  
503.225.9010



**I-5: CAPITOL HWY - TUALATIN RIVER SEC.**

PACIFIC HIGHWAY  
MULTNOMAH, WASHINGTON & CLACKAMAS COUNTIES

Reviewed By - Janet E. Masters


Designed By - Brendon V. O'Sullivan

Drafted By - Harry C. Marx

**WATER QUALITY DETAILS**


SHEET NO.  
**GJ-3**

WATER QUALITY SWALE TYPICAL SECTIONS

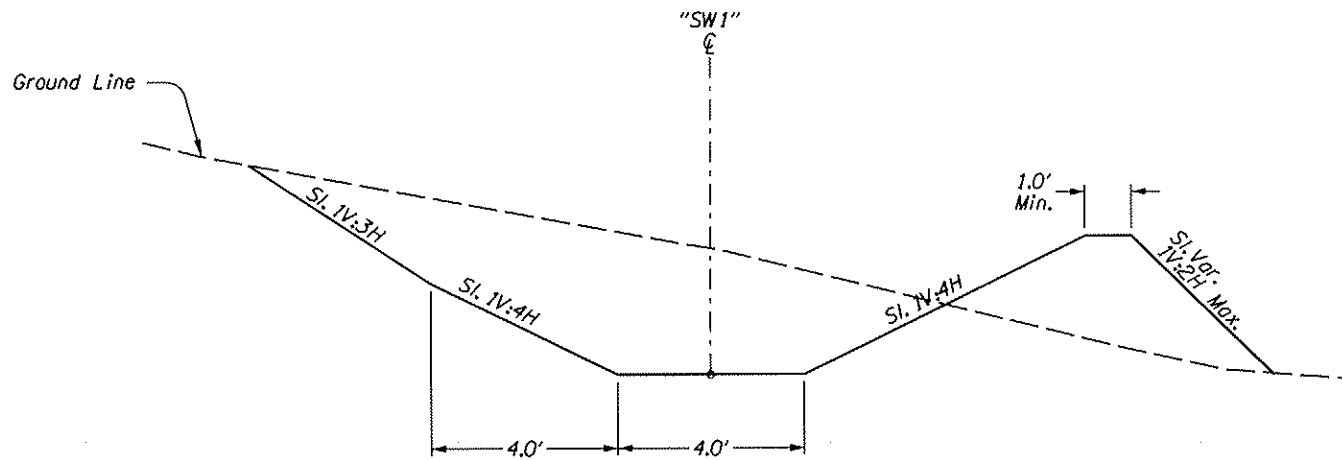

STA. "SW1" 1+00 To STA. "SW1" 5+00  
WATER QUALITY SWALE TYPICAL SECTION

72" MANHOLE COVER  
(For Details Not Shown, See Std. Drg. No. RD346)

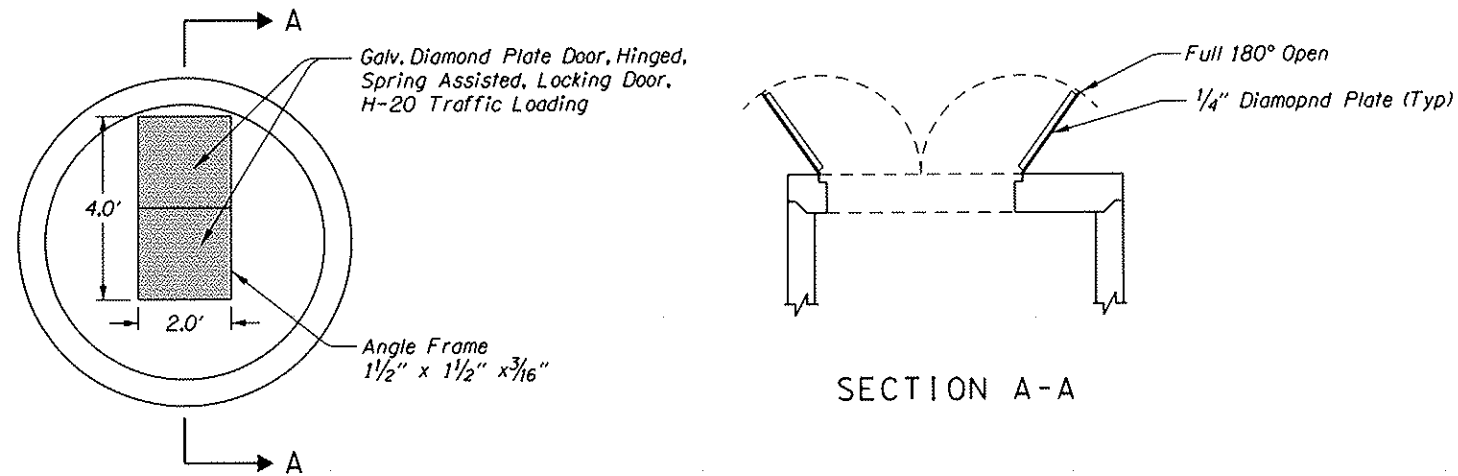


MANHOLE TOP SLAB PLAN


SECTION A-A

40V-55

REVISED AS CONSTRUCTED  
1/15/08 CONTRACT 13351

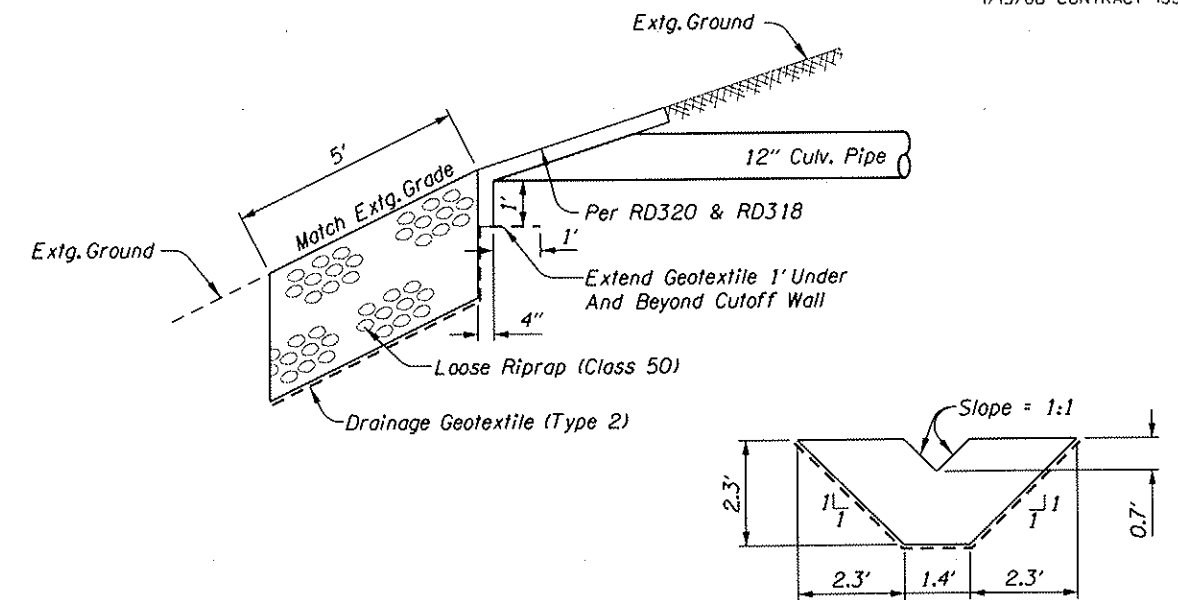

SECTION A-A

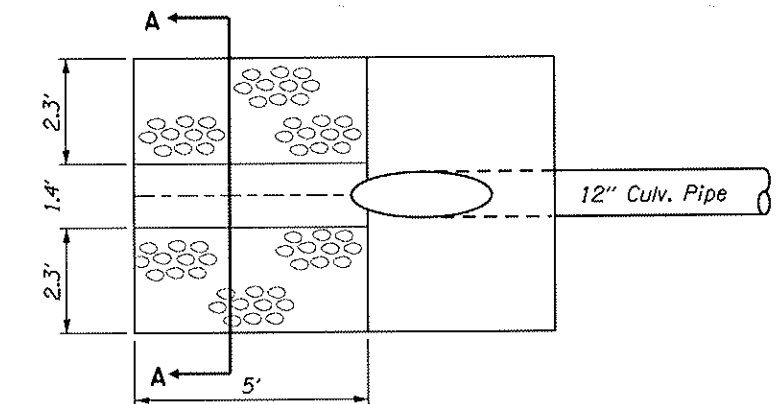

PLAN  
OUTLET PROTECTION  
Type 5

(For Details Not shown, See Drgs. No. RD318 & RD320)

**OREGON DEPARTMENT OF TRANSPORTATION**

Murray, Smith & Associates, Inc.  
121 S.W. Salmon, Suite 900, Portland, Oregon 97204-2919  
503.225.9010




**I-5: CAPITOL HWY -  
TUALATIN RIVER SEC.**

PACIFIC HIGHWAY  
MULTNOMAH, WASHINGTON & CLACKAMAS COUNTIES

Reviewed By - Janet E. Masters

Designed By - Brendan V. O'Sullivan

Drafted By - Harry C. Marx

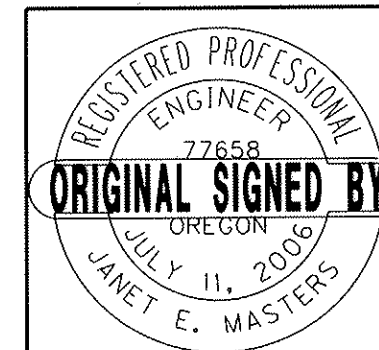

RENEWAL DATE: 12-31-2008

**WATER QUALITY DETAILS**


SHEET  
NO.  
GJ-4

72" MANHOLE @ STA. "L2" 1071+31  
(For Details Not Shown, See Std. Drg. No. RD346)


40V-55

REVISED AS CONSTRUCTED  
1/15/08 CONTRACT 13351


NTS

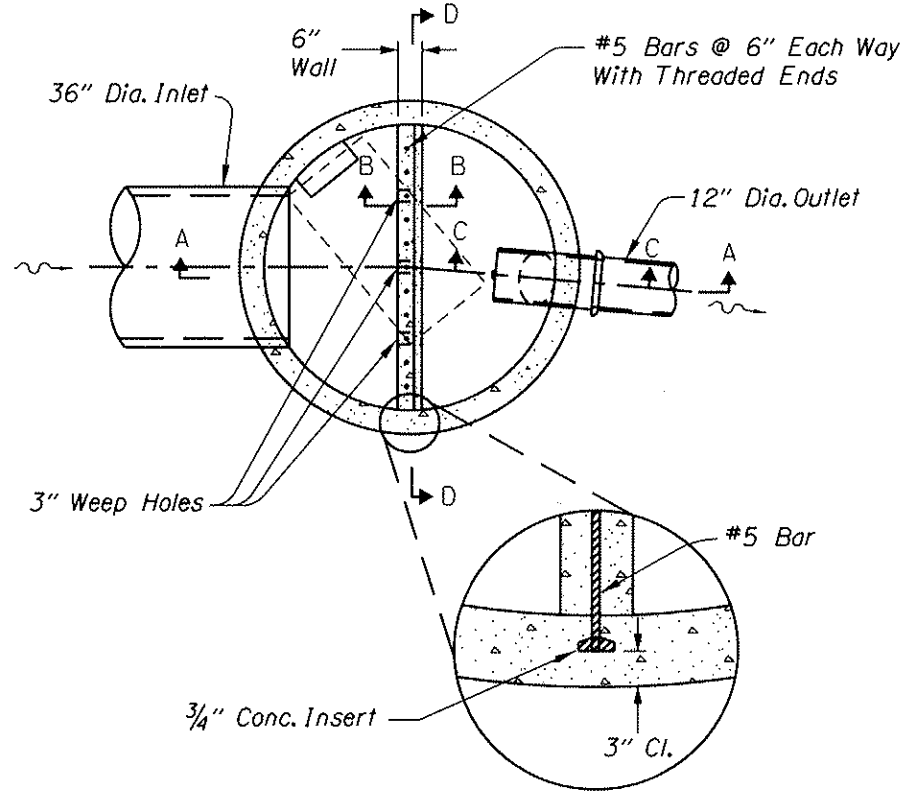


PLAN

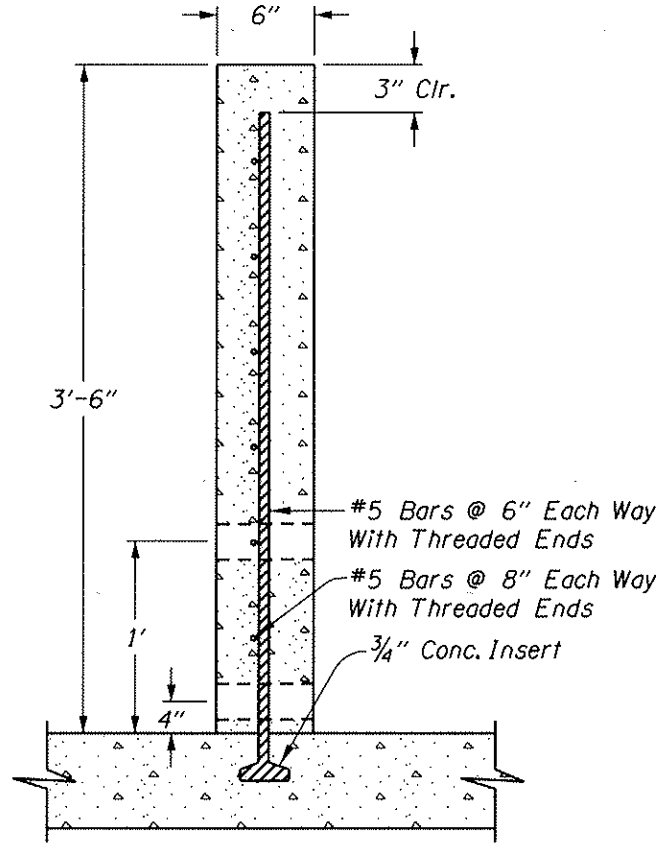


SECTION B-B

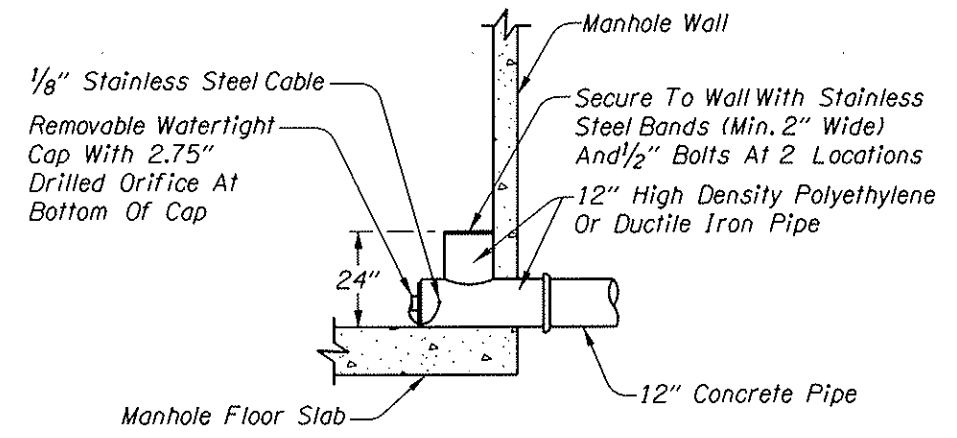

SECTION C-C

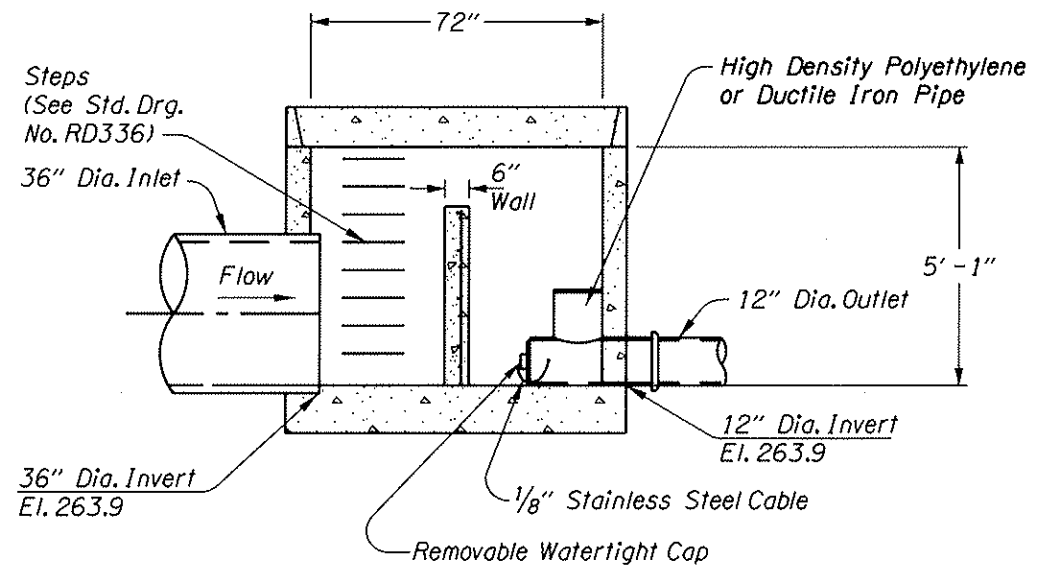

SECTION A-A

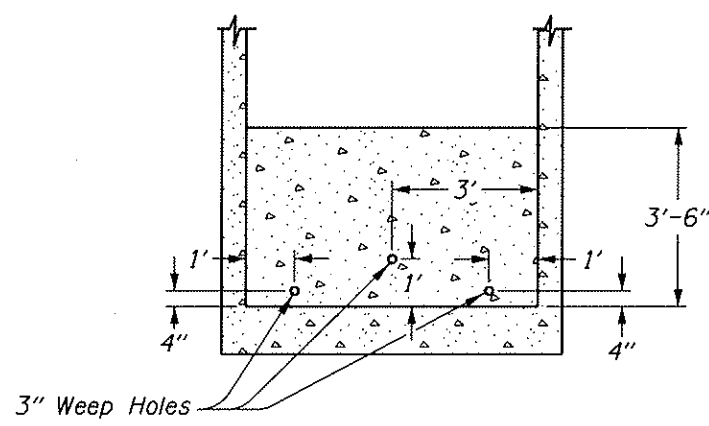


SECTION D-D

GENERAL NOTES:

All Bars Shall Be Placed 2" Clear Of The Nearest Face Of Concrete Unless Shown Otherwise.

Hardware, Fasteners And Anchors To Be Stainless Steel.

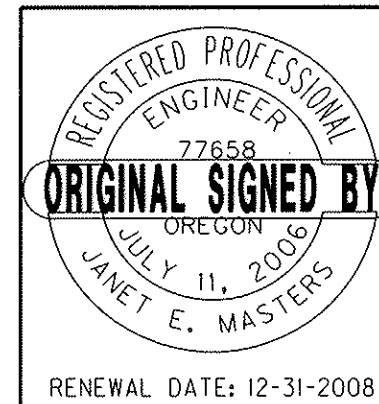


<b>OREGON DEPARTMENT OF TRANSPORTATION</b>	
Murray, Smith & Associates, Inc. 121 S.W. Salmon, Suite 900, Portland, Oregon 97204-2919 503.225.9010	
<b>1-5: CAPITOL HWY - TUALATIN RIVER SEC.</b>	
PACIFIC HIGHWAY MULTNOMAH, WASHINGTON & CLACKAMAS COUNTIES	
Reviewed By - Janet E. Masters Designed By - Brendan V. O'Sullivan Drafted By - Harry C. Marx	
<b>WATER QUALITY DETAILS</b>	SHEET NO. <b>GJ-5</b>


72" MANHOLE @ STA. "L2" 1069+34  
 (For Details Not Shown, See Std. Drg. No. RD346)  
 NTS

40V-55


REVISED AS CONSTRUCTED  
 1/15/08 CONTRACT 13351

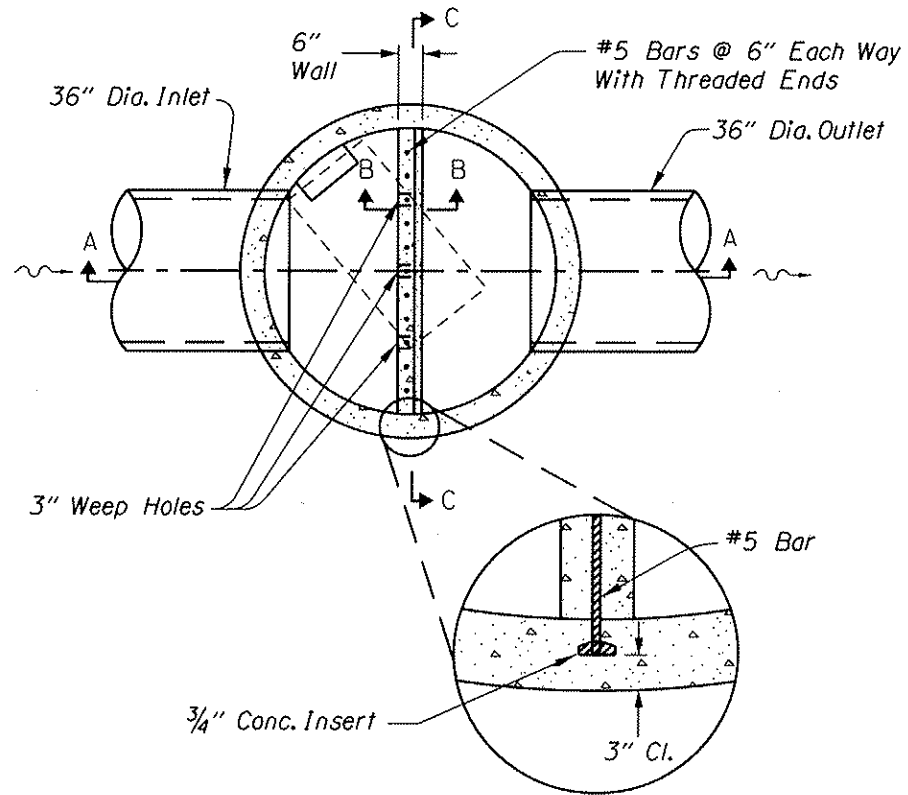


PLAN

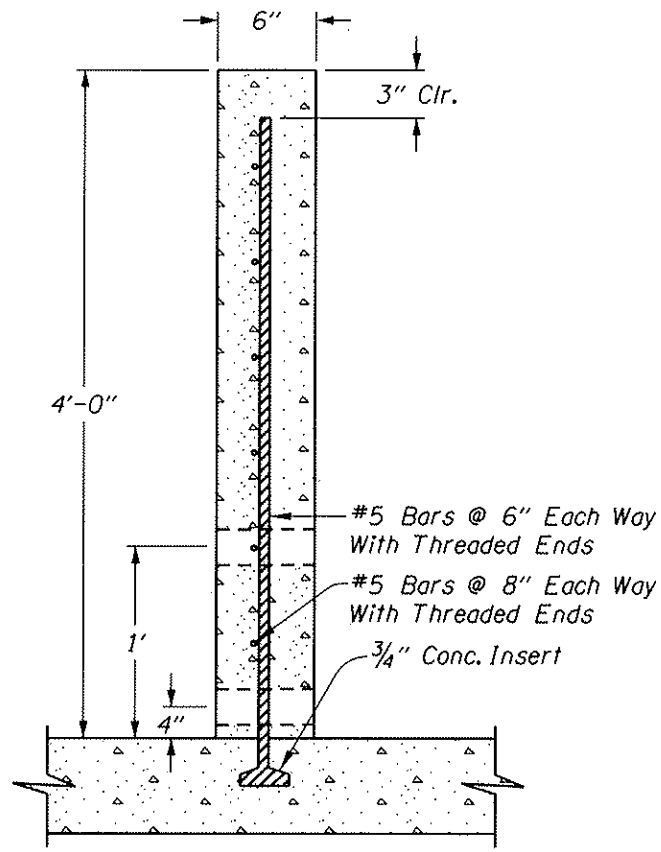

SECTION B-B

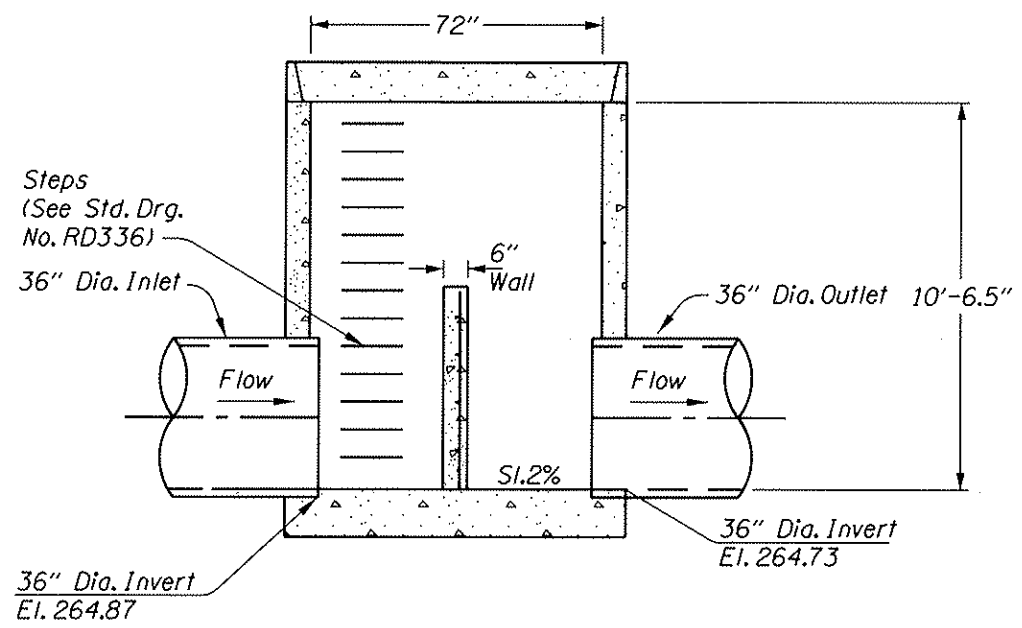

SECTION A-A

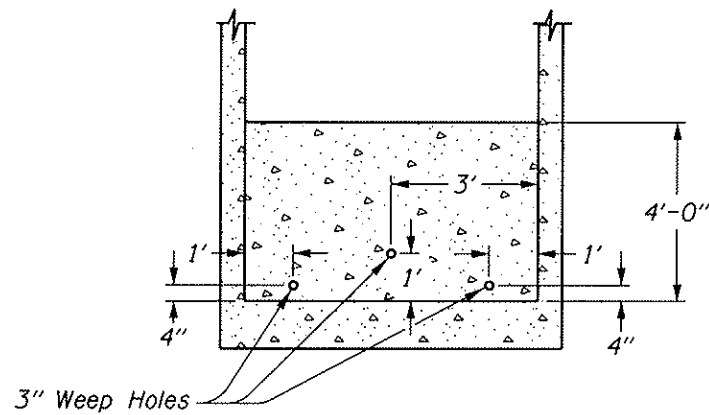

SECTION C-C


GENERAL NOTES:

All Bars Shall Be Placed 2" Clear Of The Nearest Face Of Concrete Unless Shown Otherwise.



<b>OREGON DEPARTMENT OF TRANSPORTATION</b>	
Murray, Smith & Associates, Inc. 121 S.W. Salmon, Suite 900, Portland, Oregon 97204-2919 503.225.9010	
<b>I-5: CAPITOL HWY - TUALATIN RIVER SEC.</b>	
PACIFIC HIGHWAY MULTNOMAH, WASHINGTON & CLACKAMAS COUNTIES	
Reviewed By - Janet E. Masters Designed By - Brendan V. O'Sullivan Drafted By - Harry C. Marx	
<b>WATER QUALITY DETAILS</b>	SHEET NO. <b>GJ-6</b>



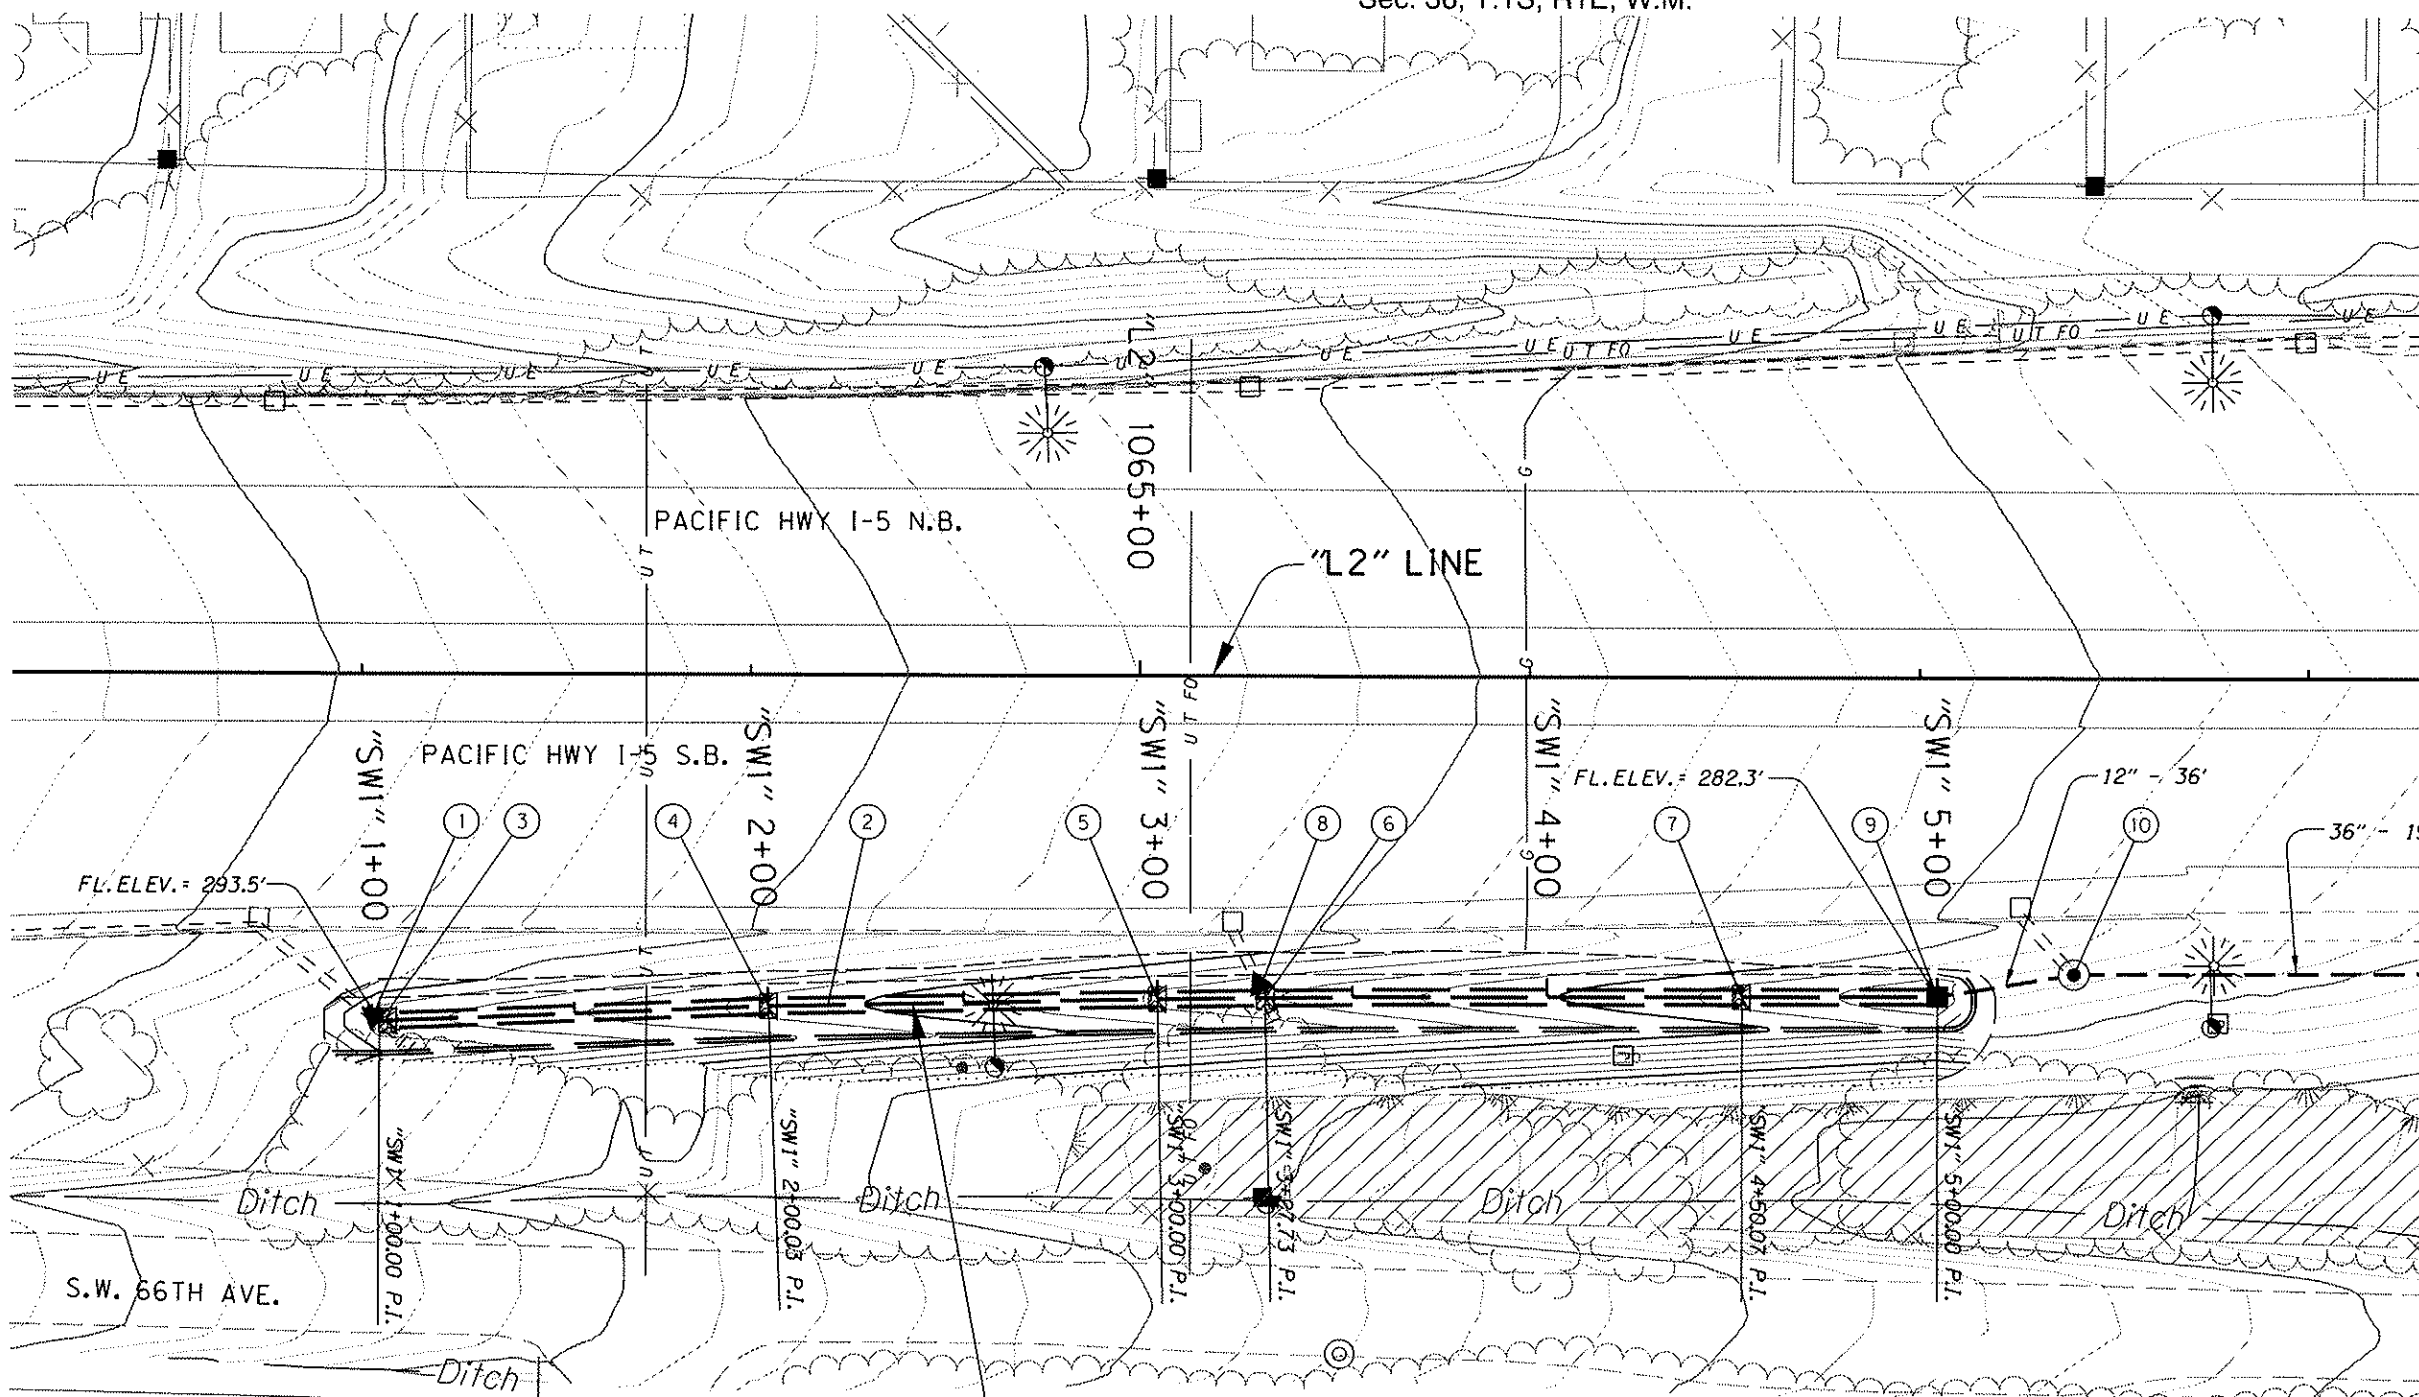

- ① See Sht. 8A, Note 9  
Remove Pipe  
Const. Paved End Slope  
(For Details, See Sht. GJ-2)
- ② Sta. "SW1" 1+00 To Sta. "SW1" 5+00  
Const. Water Quality Swale - 400'  
Porous Pvmf. - 3200 Sq. Ft.  
Riprap, Type 1 Geotextile - 540 Sq. Yd.  
Base Aggregate - 160 Tons  
Exc. - 92 Cu. Yd.  
(For Details, See Shts. GJ, GJ-3, & GJ-4)
- ③ Sta. "SW1" 1+00  
Const. Swale Flow Spreader  
Riprap, Class 50 - 1 Cu. Yd.  
(For Details, See Sht. GJ-2)
- ④ Sta. "SW1" 2+00  
Const. Swale Flow Spreader  
Riprap, Class 50 - 1 Cu. Yd.  
(For Details, See Sht. GJ-2)
- ⑤ Sta. "SW1" 3+00  
Const. Swale Flow Spreader  
Riprap, Class 50 - 1 Cu. Yd.  
(For Details, See Sht. GJ-2)
- ⑥ Sta. "SW1" 3+28  
Const. Swale Flow Spreader  
Riprap, Class 50 - 1 Cu. Yd.  
(For Details, See Sht. GJ-2)
- ⑦ Sta. "SW1" 4+50  
Const. Swale Flow Spreader  
Riprap, Class 50 - 1 Cu. Yd.  
(For Details, See Sht. GJ-2)
- ⑧ See Sht. 8A, Note 10  
Const. Paved End Slope  
(For Details, See Sht. GJ-2)
- ⑨ See Sht. 8A, Note 11  
Const. Type "D" Inlet
- ⑩ See Sht. 8A, Note 12  
Const. Manhole 72" Dia.  
Inst. 36" Sew. Pipe

**OREGON DEPARTMENT OF TRANSPORTATION**

Murray, Smith & Associates, Inc.  
121 S.W. Salmon, Suite 900, Portland, Oregon 97204-2919  
503.225.9010



**I-5: CAPITOL HWY - TUALATIN RIVER SEC.**

PACIFIC HIGHWAY  
MULTNOMAH, WASHINGTON & CLACKAMAS COUNTIES

Reviewed By - Janet E. Masters  
Designed By - Brendan V. O'Sullivan  
Drafted By - Harry C. Marx





RENEWAL DATE: 12-31-2008

**WATER QUALITY PLAN**

SHEET NO.  
**GJ-7**

- ① See Sht. 8A, Note 8  
Const. Manhole 72" Dia.  
Inst. 12" Sew. Pipe  
Const. Paved End Slope  
(For Details, See Shts. GJ-4 & GJ-5)
- ② See Sht. 8A, Note 13  
Const. Manhole 72" Dia.  
Inst. 36" Sew. Pipe  
(For Details, See Shts. GJ-4 & GJ-6)

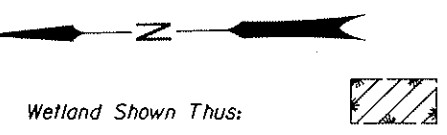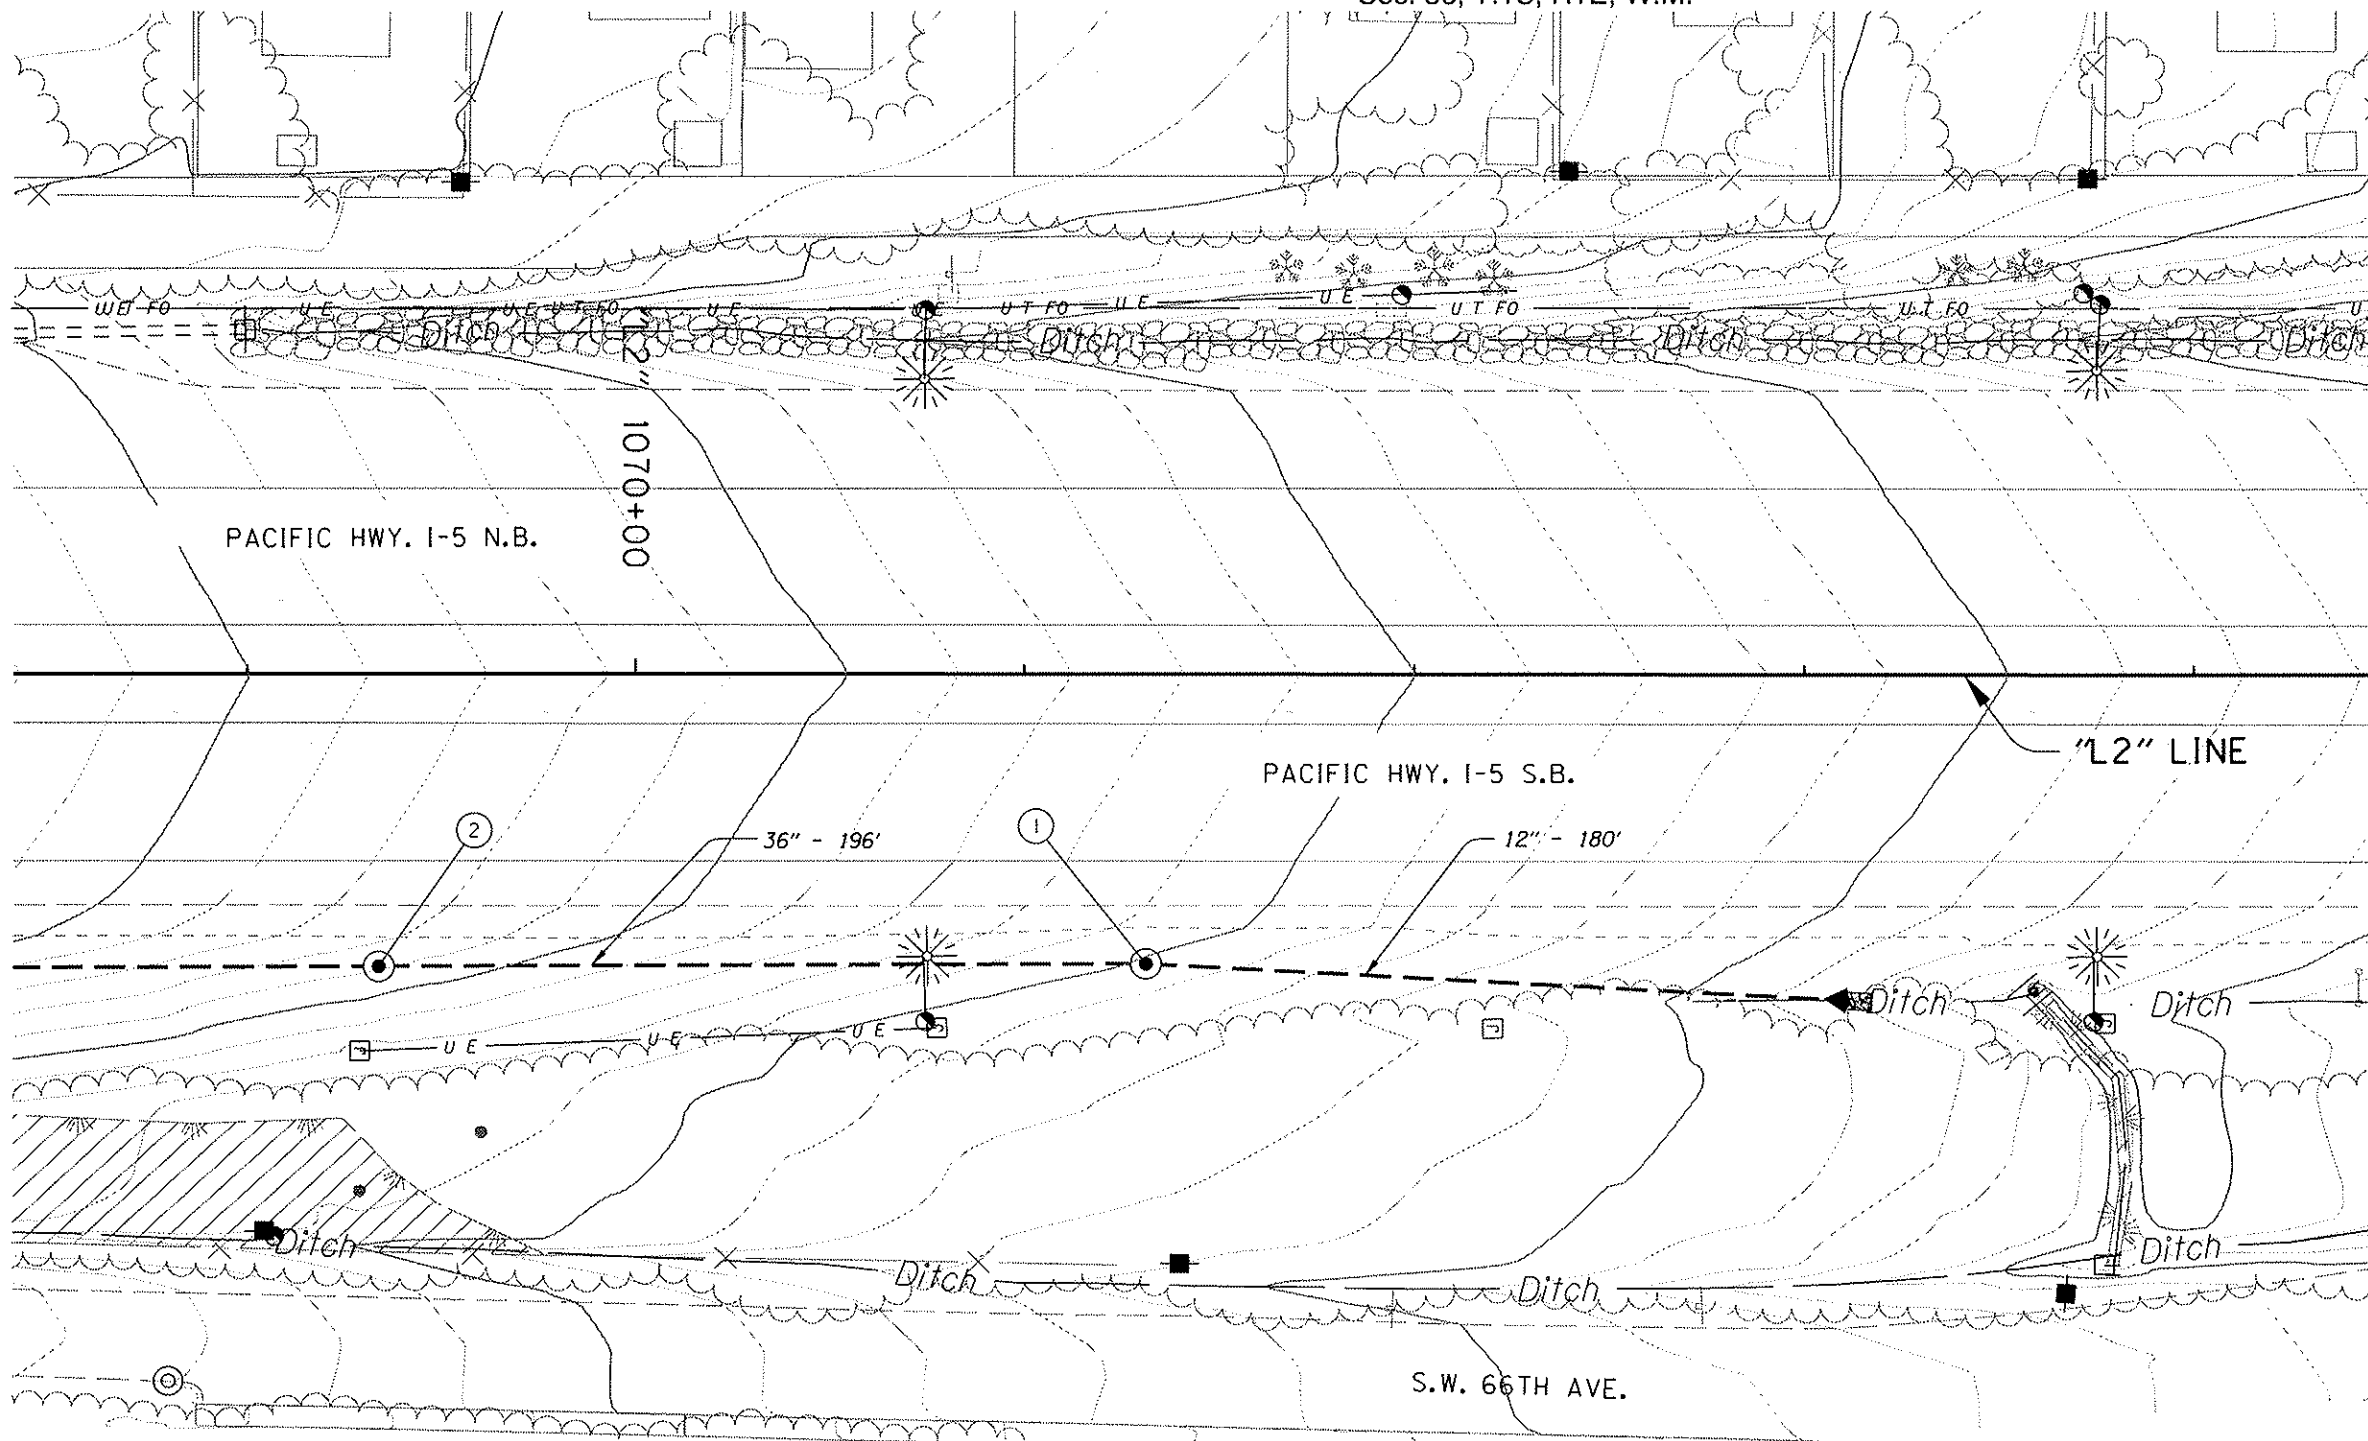

REGISTERED PROFESSIONAL  
ENGINEER  
77658  
**ORIGINAL SIGNED BY**  
JANET E. MASTERS  
JULY 11, 2006  
RENEWAL DATE: 12-31-2008

 OREGON DEPARTMENT OF TRANSPORTATION

Murray, Smith & Associates, Inc.  
121 S.W. Salmon, Suite 900, Portland, Oregon 97204-2919  
503.225.9010 

**I-5: CAPITOL HWY - TUALATIN RIVER SEC.**  
PACIFIC HIGHWAY  
MULTNOMAH, WASHINGTON & CLACKAMAS COUNTIES

Reviewed By - Janet E. Masters  
Designed By - Brendan V. O'Sullivan  
Drafted By - Harry C. Marx


**WATER QUALITY PLAN**  
SHEET NO. GJ-8

# "SW1" LINE -PROFILE

(For Location, See Sht. GJ-7)

40V-55

REVISED AS CONSTRUCTED  
1/15/08 CONTRACT 13351

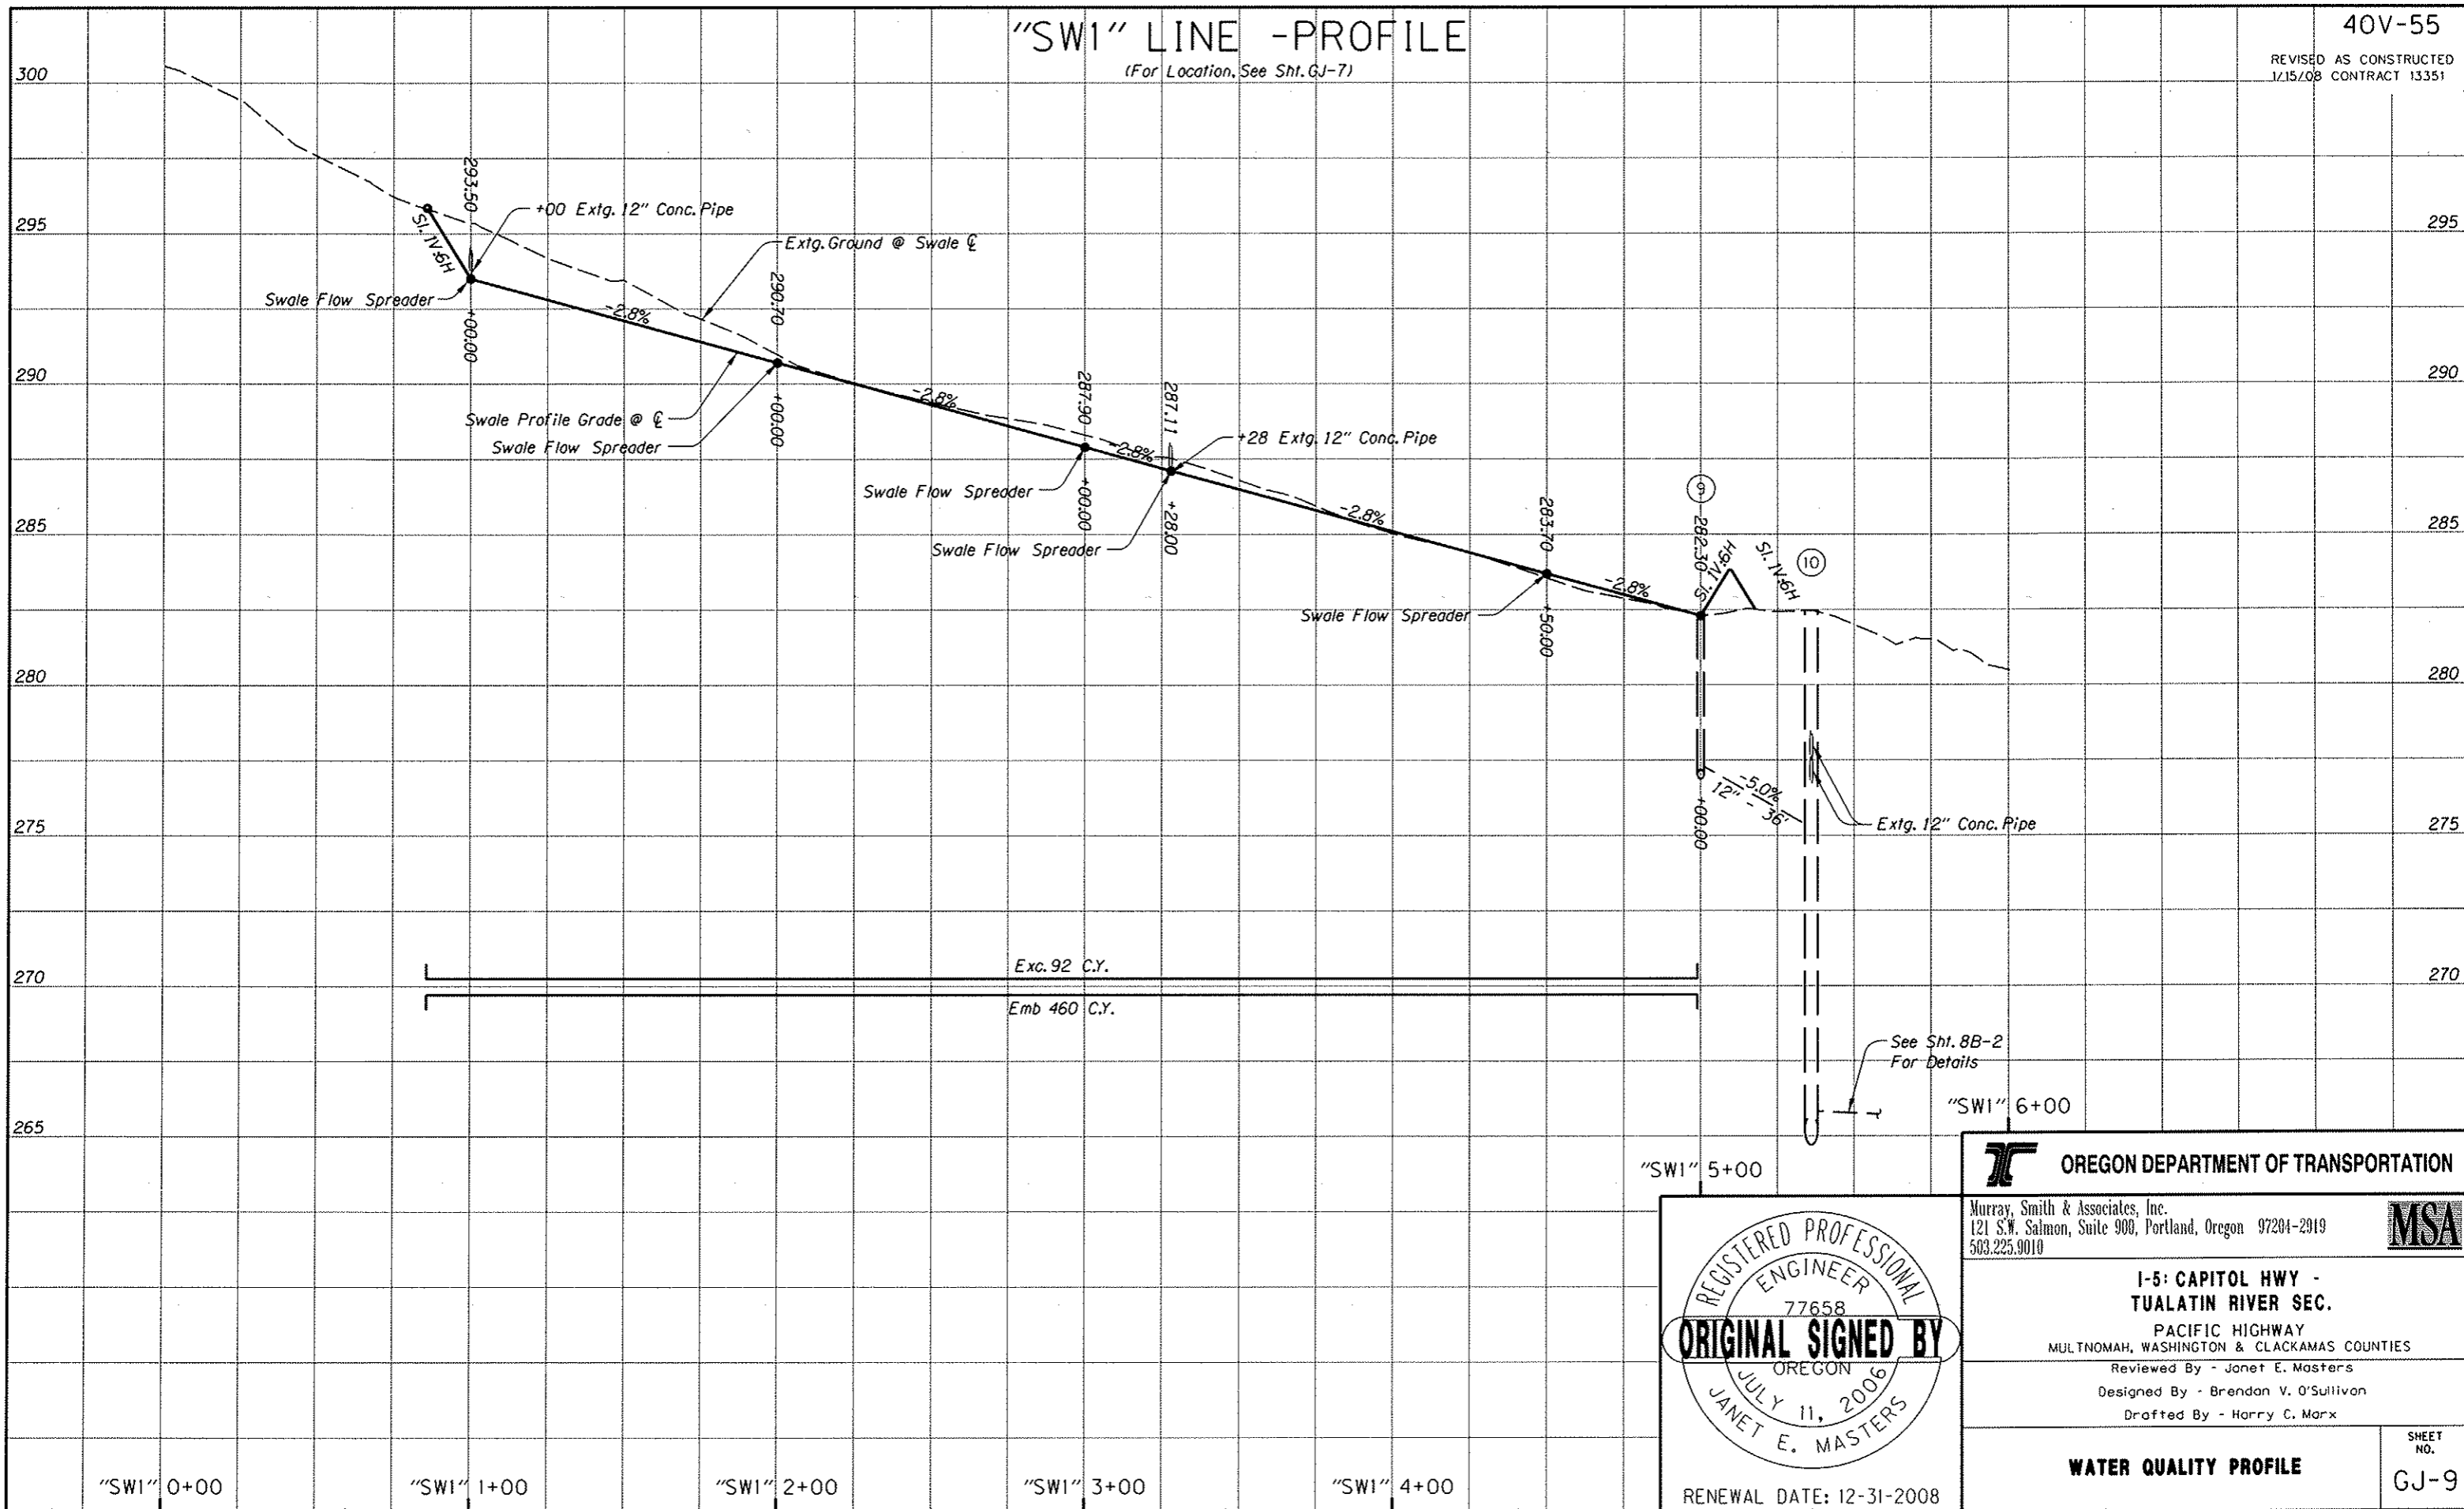

REGISTERED PROFESSIONAL  
ENGINEER  
77658  
ORIGINAL SIGNED BY  
OREGON  
JULY 11, 2006  
JANET E. MASTERS  
RENEWAL DATE: 12-31-2008

**OREGON DEPARTMENT OF TRANSPORTATION**

Murray, Smith & Associates, Inc.  
121 S.W. Salmon, Suite 900, Portland, Oregon 97204-2919  
503.225.9010

**MSA**

**I-5: CAPITOL HWY - TUALATIN RIVER SEC.**  
PACIFIC HIGHWAY  
MULTNOMAH, WASHINGTON & CLACKAMAS COUNTIES  
Reviewed By - Janet E. Masters  
Designed By - Brendan V. O'Sullivan  
Drafted By - Harry C. Marx

**WATER QUALITY PROFILE**

SHEET NO. GJ-9