

OPERATION & MAINTENANCE MANUAL

DFI No. D00072

Facility Type: Detention Tank/Pipe
Facility



JULY, 2011

INDEX

1. IDENTIFICATION..... 1

2. FACILITY CONTACT INFORMATION..... 1

3. CONSTRUCTION..... 1

4. STORM DRAIN SYSTEM AND FACILITY OVERVIEW 1

5. FACILITY HAZ MAT SPILL FEATURE(S)..... 4

6. AUXILIARY OUTLET (HIGH FLOW BYPASS)..... 4

7. MAINTENANCE REQUIREMENTS..... 5

8. WASTE MATERIAL HANDLING..... 5

APPENDIX A: Operational Plan and Profile Drawing(s)

APPENDIX B: ODOT Project Plan Sheets

1. Identification

Drainage Facility ID (DFI): **D00072**
Facility Type: Detention Tank/Pipe
Construction Drawings: (V-File Number) 40V-055
Location: District: 2B (Old 2A)
Highway No.: 001
Mile Post: 292.66/292.73 (beg/end)
Description: This facility is located on the west side of southbound Interstate-5 (hwy 001) just south of water quality biofiltration swale (D00071). Access would be from the right shoulder area of I-5 (hwy 001).

2. Facility Contact Information

Contact the Engineer of Record, Region Technical Center, or Geo-Environmental's Senior Hydraulics Engineer for:

- Operational clarification
- Maintenance clarification
- Repair or restoration assistance

Engineering Contacts:

Region Technical Center Hydro Unit Manager

Or

Geo-Environmental Senior Hydraulics Engineer (503) 986-3365.

3. Construction

Engineer of Record: Consultant Designer – Murray Smith and Associates, Janet Masters, (503) 225-9010
Facility construction: 2008
Contractor: Morse Bros., Inc. DBA Knife River, Tangent, OR

4. Storm Drain System and Facility Overview

A detention facility is a special storage feature designed to detain stormwater runoff, purposing to reduce or mitigate the increases in discharge, resulting from development. Some are designed to additionally treat the stormwater runoff and improve the quality of runoff, emanating

from highway pavement areas. However, detention facilities are primarily designed to control the quantity of runoff in order to store and gradually release or attenuate stormwater runoff via a control structure or release mechanism, then releasing it slowly over a more extended period of time.

This detention facility consists of two 36-inch diameter pipe segments totaling 400 feet and joined together by a 72-inch manhole. The facility lies along the right shoulder of the southbound lanes of Interstate-5. This facility and the adjacent swale collects sheet flow drainage from a series of inlets placed alongside the travel lanes. The stormwater drainage is treated in a water quality treatment swale (D00071) before being routed into the detention facility. The detention pipe facility helps control the rate of flow being released to the downstream system, resulting from peak flow heavy rainfall events.

The northern-most structure is a 72-inch, 20-foot deep manhole. The manhole that joins the two 36-inch diameter pipe segments together is approximately 10 feet deep and contains a 4-foot high weir wall (See Section C-C of the Operational Plans). Stormwater is then conveyed to the last structure in the facility, at the southern most point; that is, a 72-inch diameter flow control manhole. This structure is 10 feet deep and contains a flow control assembly comprised of a 3.5-foot high by 6-inch thick weir with 3-inch weep holes (See Section D-D of the Operational Plans). After detention, the stormwater is routed through a 12-inch storm pipe to the outlet (Point D) and out to a ditch, paralleling the highway.

A. Maintenance equipment access:

The facility can be accessed for maintenance along the entire length via Interstate-5. Photo 1 includes a concrete maintenance pad which is intended for maintenance vehicles. These pads are located at each manhole.

B. Heavy equipment access into facility:

- Allowed (no limitations)
- Allowed (with limitations)
- Not allowed

C. Special Features:

- Amended Soils
- Porous Pavers
- Liners
- Underdrains



Photo 1: 20-foot deep inlet manhole at upstream end of detention tank/pipe facility.



Photo 2: 72-inch diameter manhole (Point B) midway between two each 36-inch detention tank/pipes. This manhole contains a 4-foot high baffle.



Photo 3: Outlet control structure (Point C) for 36-inch diameter detention tank/pipes. Flows exit system through riser pipe.

5. Facility Haz Mat Spill Feature(s)

The detention tank/pipe can be used to store a volume of liquid by blocking the 12-inch diameter outlet pipe located at the outlet of the detention tank/pipe. This pipe is noted as point D in Section A-A of the Operational Plans.

6. Auxiliary Outlet (High Flow Bypass)

Auxiliary Outlets are provided if the primary outlet control structure can not safely pass the projected high flows. Broad-crested spillway weirs and over flow risers are the two most common auxiliary outlets used in stormwater facility design. The auxiliary outlet feature is either a part of the facility or an additional storm drain feature/structure.

The auxiliary outlet feature for this facility is:

Designed into facility

The auxiliary outlets are designed into the system's flow control manholes and high flow weirs. See manholes at Points B and C.

Other, as noted below

7. Maintenance Requirements

Routine maintenance table for non-proprietary stormwater treatment and storage/detention facilities have been incorporated into ODOT's Maintenance Guide. These tables summarize the maintenance requirements for ponds, swales, filter strips, bioslopes, and detention tanks and vaults. Special maintenance requirements in addition to the routine requirements are noted below when applicable.

The ODOT Maintenance Guide can be viewed at the following website:

<http://www.oregon.gov/ODOT/HWY/OOM/MGuide.shtml>

Maintenance requirements for proprietary structures, such as underground water quality manholes and/or vaults with filter media are noted in Appendix C when applicable.

The following stormwater facility maintenance table (See ODOT Maintenance Guide) should be used to maintain the facility outlined in this Operation and Maintenance Manual or follow the Maintenance requirements outlined in Appendix C when proprietary structure is selected below:

- Table 1 (general maintenance)
- Table 2 (stormwater ponds)
- Table 3 (water quality or biofiltration swales)
- Table 4 (water quality filter strips)
- Table 5 (water quality bioslopes)
- Table 6 (detention tank)
- Table 7 (detention vault)
- Appendix C (proprietary structure)
- Special Maintenance requirements:

Note: Special maintenance Requirements Require Concurrence from ODOT SR Hydraulics Engineer.

8. Waste Material Handling

Material removed from the facility is defined as waste by DEQ. Refer to the roadwaste section of the ODOT Maintenance Yard Environmental Management System (EMS) Policy and Procedures Manual for disposal options: <http://egov.oregon.gov/ODOT/HWY/OOM/EMS.shtml>



Contact any of the following for more detailed information about management of waste materials found on site:

ODOT Clean Water Unit	(503) 986-3008
ODOT Statewide Hazmat Coordinator	(503) 229-5129
ODOT Region Hazmat Coordinator	(503) 731-8304
ODEQ Northwest Region Office	(503) 229-5263


Appendix A

Content:

- **Operational Plan and Profile Drawing(s)**

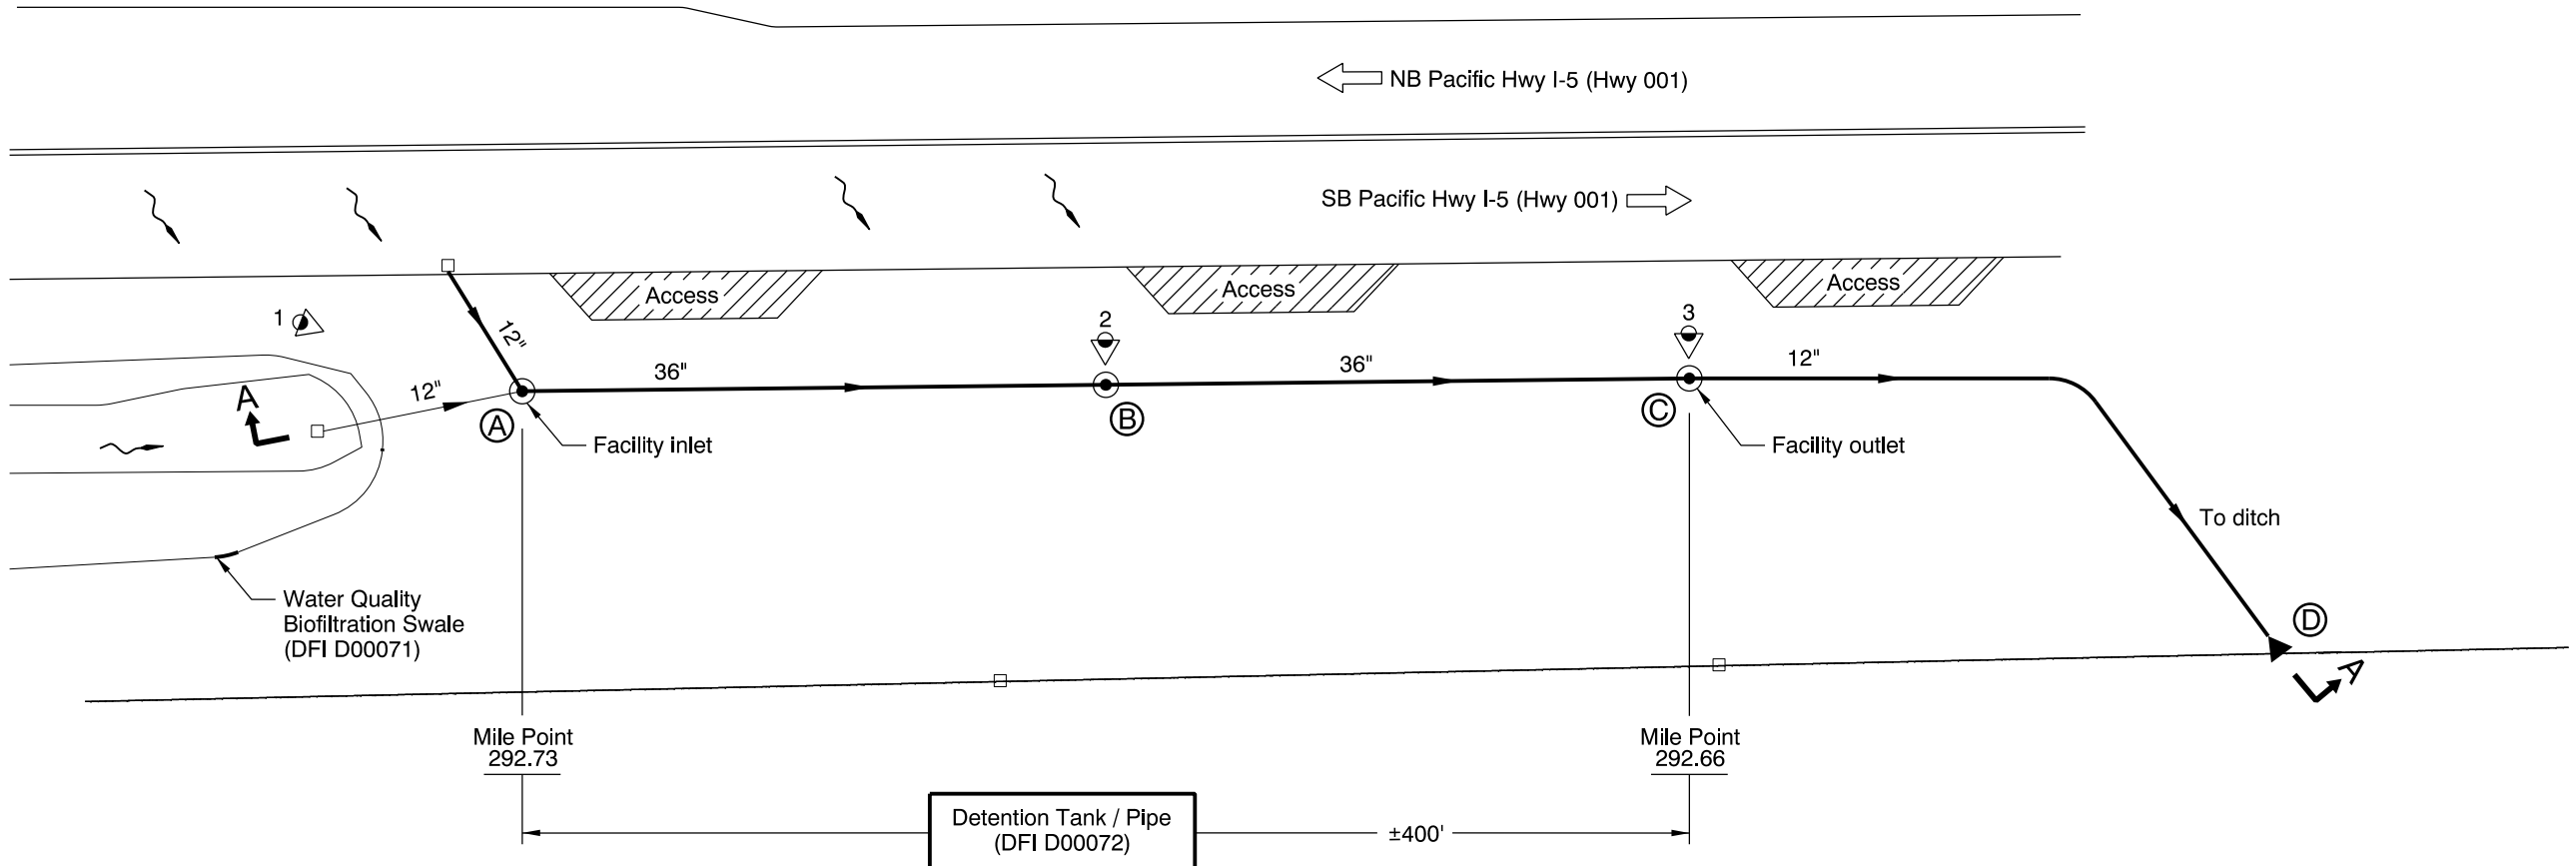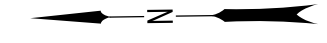

PLAN
N.T.S.

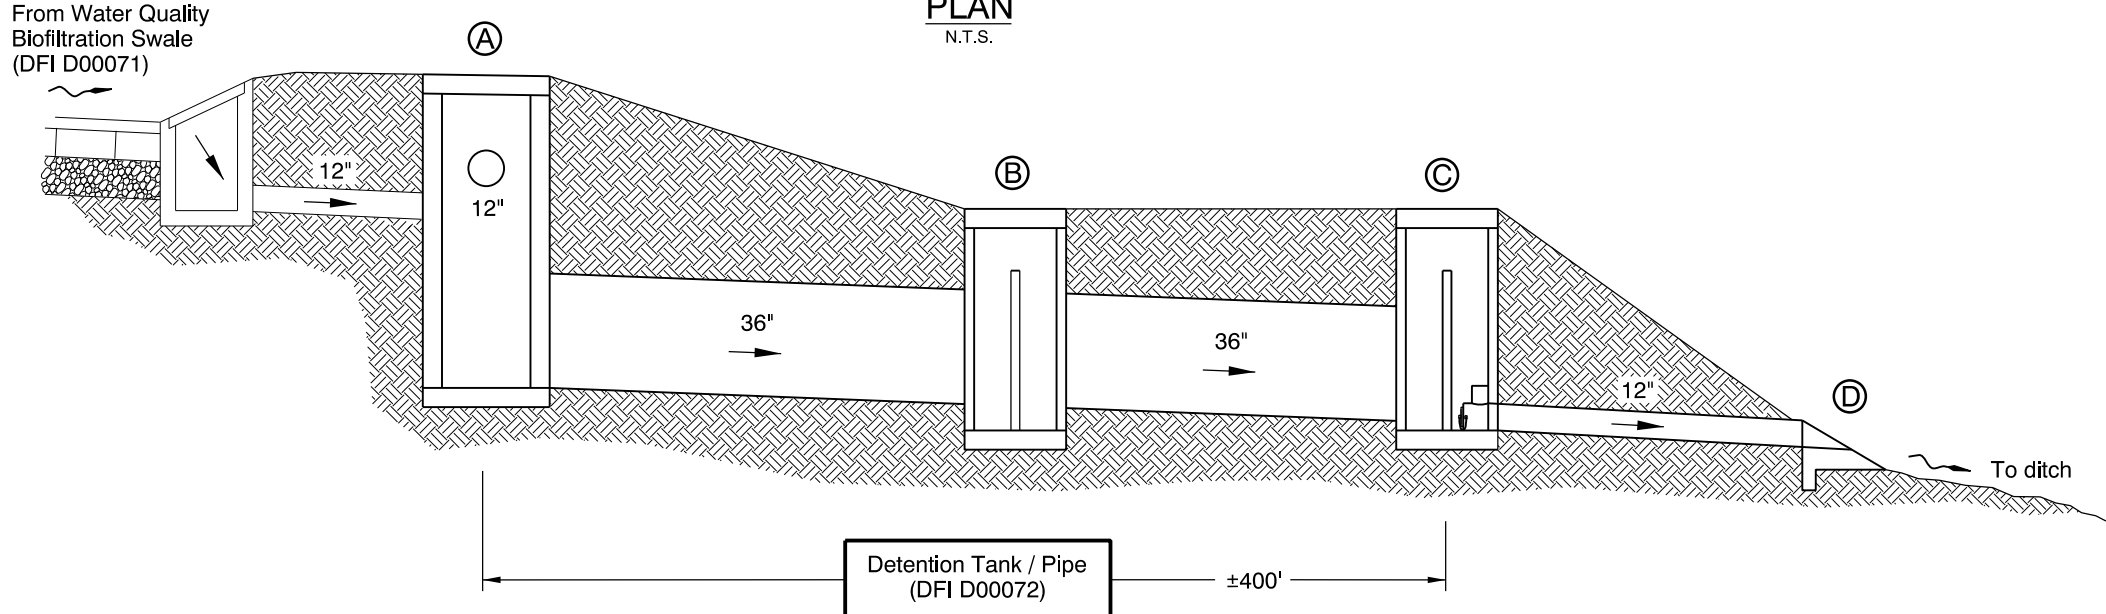

SECTION A-A
N.T.S.


- LEGEND:**
- Photo Location / Direction
 - 72" Manhole, 20' deep
 - 72" Flow Control Manhole, 10' deep
 - 72" Flow Control Manhole, 10' deep
 - Outlet / Paved End Slope
 - Manhole
 - Inlet
 - Traffic Flow/Direction
 - Storm Pipe (Facility)
 - Storm Pipe
 - Conveyance Direction
 - Pavement / Facility Flow Path

Sht. 1 of 2


OREGON DEPARTMENT OF TRANSPORTATION

Prepared By: Bob Knorr
 Drafted By: Y. Garzenelli


DFI D00072
MAINTENANCE DISTRICT 2B HWY 001
DETENTION TANK/PIPE
 PACIFIC HWY MP 292.66-292.73
 MULTNOMAH, WASHINGTON & CLACKAMAS COUNTIES

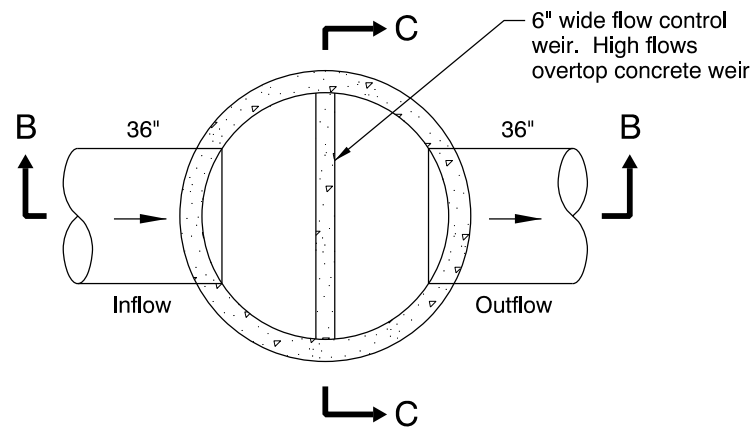


PLAN

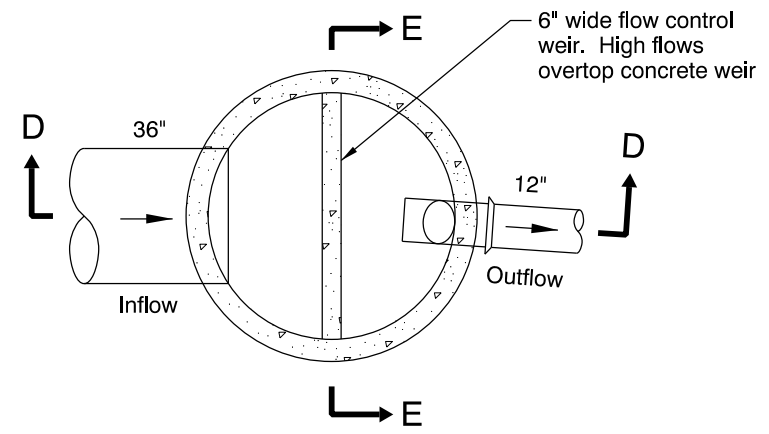


PLAN

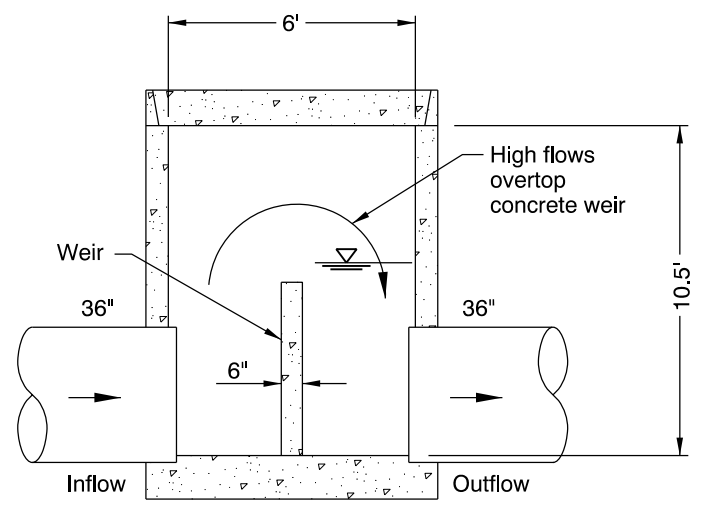


SECTION B-B

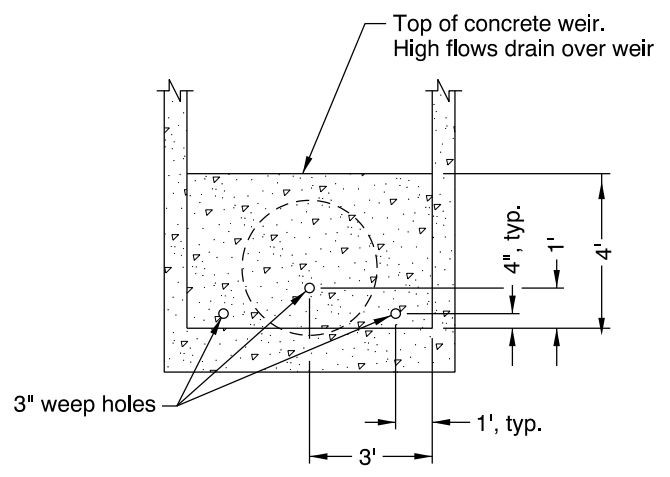

SECTION C-C

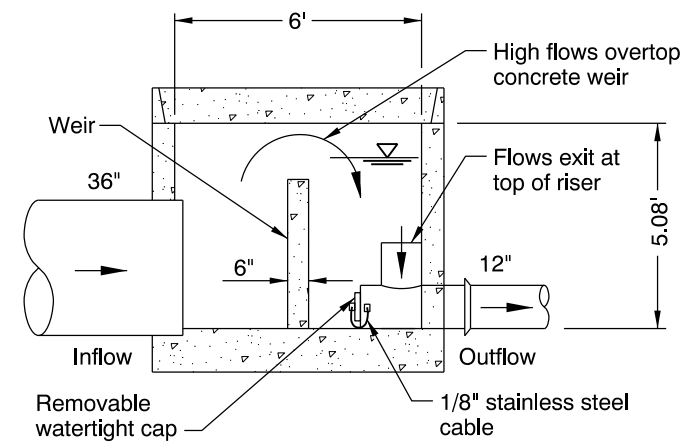

SECTION D-D

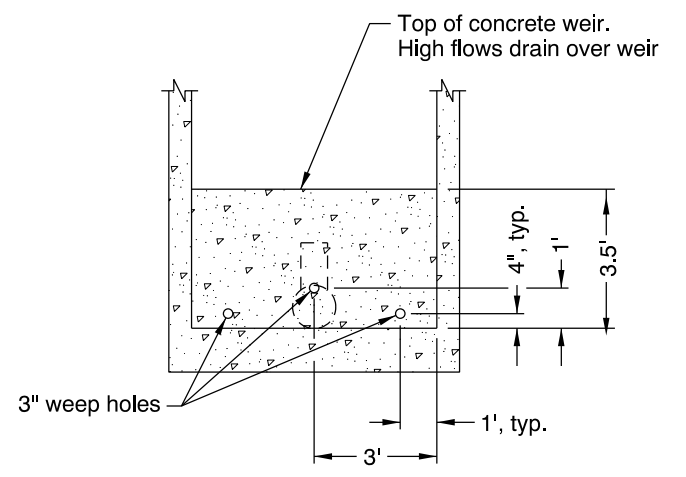

SECTION E-E

FLOW CONTROL MANHOLE DETAILS AT POINT B
N.T.S.

FLOW CONTROL MANHOLE DETAILS AT POINT C
N.T.S.

Prepared By: Bob Knorr
Drafted By: Y. Garzenelli

DFI D00072
MAINTENANCE DISTRICT 2B HWY 001
DETENTION TANK/PIPE
PACIFIC HWY MP 292.66-292.73
MULTNOMAH, WASHINGTON & CLACKAMAS COUNTIES

Appendix B

Content:

- **ODOT Project Plan Sheets**
 - *Cover/Title Sheet*
 - *Water Quality/Detention Plan Sheets*
 - *Other Details*

STATE OF OREGON
 DEPARTMENT OF TRANSPORTATION
 PLANS FOR PROPOSED PROJECT


GRADING, DRAINAGE, STRUCTURES, PAVING & SIGNALS

**I-5: CAPITOL HWY -
 TUALATIN RIVER SEC.**

PACIFIC HIGHWAY

MULTNOMAH, WASHINGTON & CLACKAMAS COUNTIES

MARCH 2007

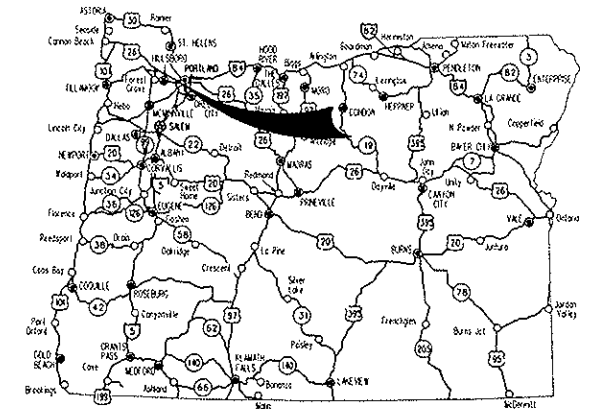

Overall Length Of Project - 4.51 Miles

ATTENTION:
 Oregon Law Requires You To Follow Rules Adopted By The Oregon Utility Notification Center. Those Rules Are Set Forth In OAR 952-001-0010 Through OAR 952-001-0090. You May Obtain Copies Of The Rules By Calling The Center. (Note: The Telephone Number For The Oregon Utility Center Is (503) 232-1987.)




INDEX OF SHEETS	
SHEET NO.	DESCRIPTION
1	Title Sheet
1A	Index Of Sheets Cont'd.

REVISED AS CONSTRUCTED
 1/15/08 CONTRACT 13351
 PROJ. MGR. BILL EDMUNSON

**IM-S001 (243)
 BEGINNING OF CONTRACT
 STA. "L2" 989+45 (M.P. 294.25)**

**IM-S001 (243)
 BEGINNING OF PAVING
 STA. "L2" 990+52 (M.P. 294.19)**

**IM-S001 (243)
 END OF PROJECT
 STA. "LN2" 1226+00 (M.P. 289.74)
 STA. "LS2" 1226+00**

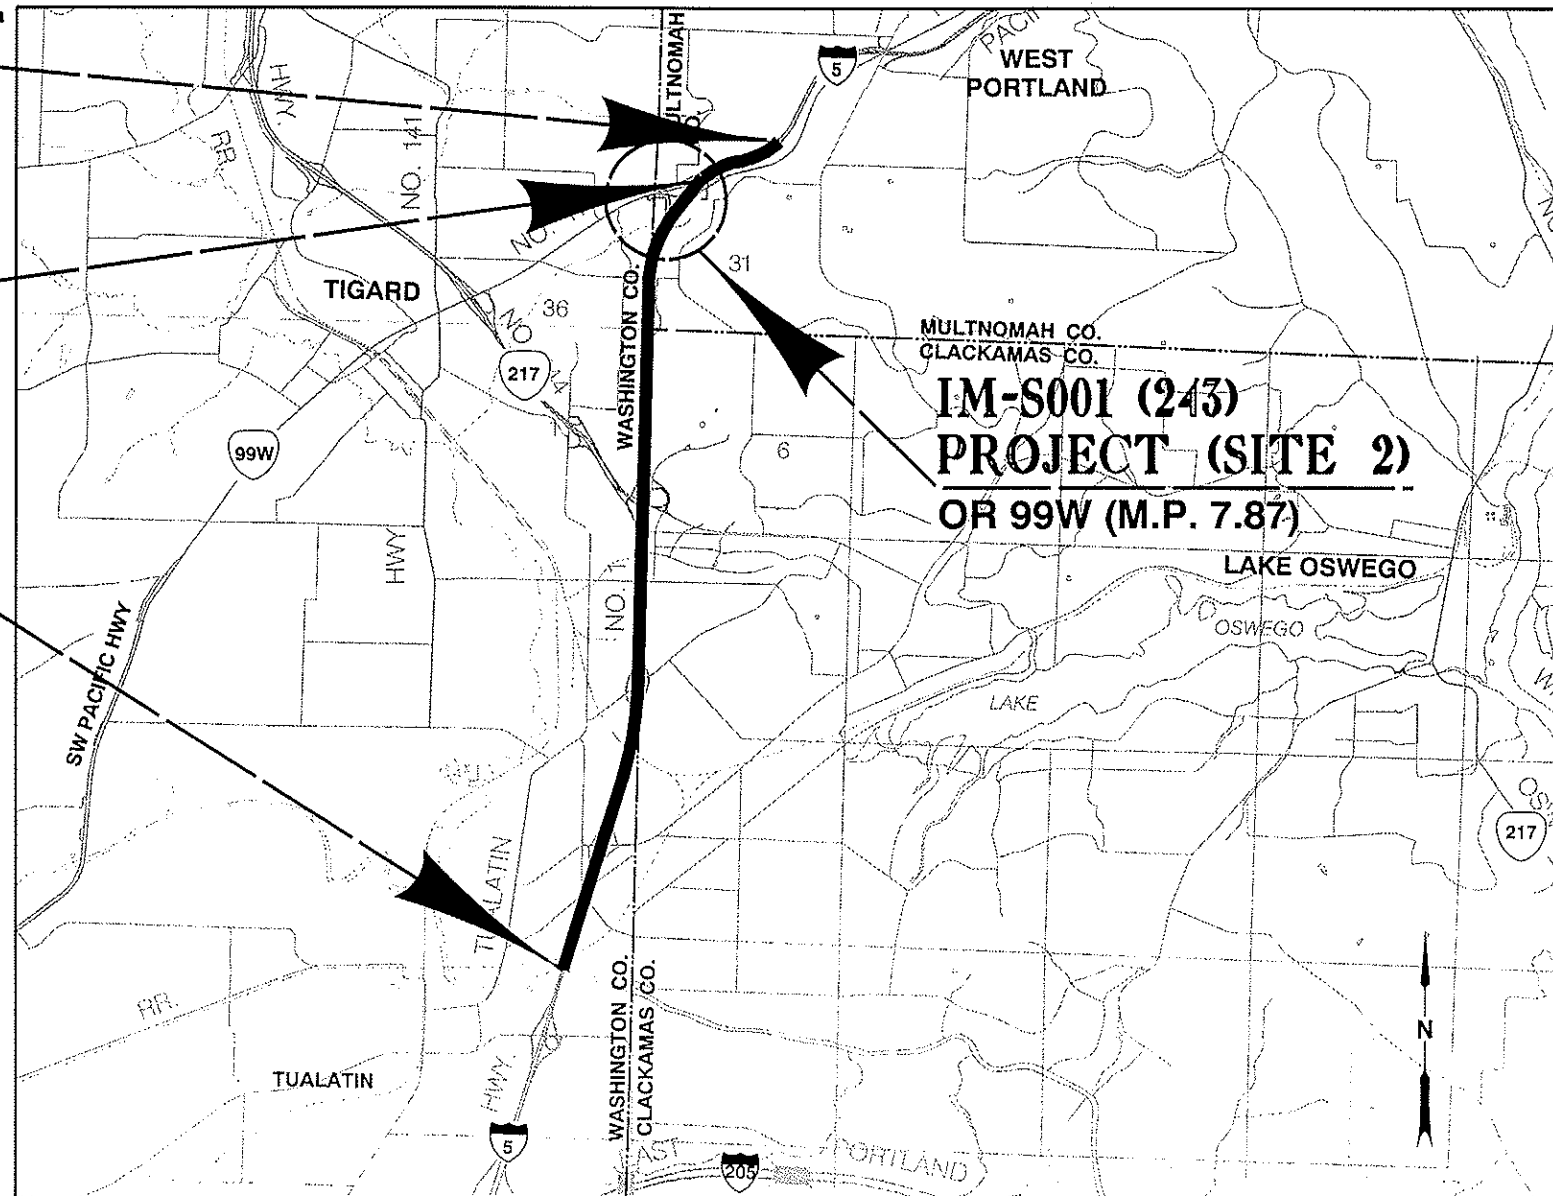

**IM-S001 (243)
 PROJECT (SITE 2)
 OR 99W (M.P. 7.87)**

RECORD DRAWINGS
 THIS DRAWING IS FOR RECORD PURPOSES ONLY, AND HAS BEEN PREPARED BASED IN PART ON INFORMATION PROVIDED BY OTHERS RELATIVE TO REPORTED CONSTRUCTED CONDITIONS, WHILE THIS INFORMATION IS BELIEVED TO BE RELIABLE, MURRAY, SMITH & ASSOCIATES, INC. MAKES NO ASSURANCES, STATED OR IMPLIED, AS TO THE ACCURACY OF THIS DRAWING. THOSE RELYING ON THIS RECORD DRAWING FOR ANY PURPOSE ARE ADVISED TO OBTAIN INDEPENDENT VERIFICATION OF ITS ACCURACY, CONTRACT MODIFICATION INFORMATION, FABRICATOR'S SHOP DRAWINGS AND OTHER PROJECT SUBMITTAL INFORMATION PROVIDED BY THE CONTRACTOR WHICH FURTHER CLARIFY DETAILS OF CONSTRUCTION MAY BE ON FILE. SEE ORIGINAL CONTRACT DRAWINGS FOR ENGINEER'S SEAL AND SIGNATURES.
 VERSION 4.0 12-9-97

OREGON TRANSPORTATION COMMISSION

Stuart Foster CHAIRMAN
 Gail L. Achterman COMMISSIONER
 Mike Nelson COMMISSIONER
 Randall Papé COMMISSIONER
 Janice J. Wilson COMMISSIONER
 Matthew L. Garrett DIRECTOR OF TRANSPORTATION

PLANS PREPARED FOR
 ODOT
 BY:
 Murray, Smith & Associates, Inc.

REGISTERED PROFESSIONAL
 ENGINEER
 16,589
ORIGINAL SIGNED BY
 OREGON
 JULY 20, 1993
 TROY L. BOWERS
 Expires Dec. 31, 2007

OREGON DEPARTMENT OF TRANSPORTATION
 CONCURRENCE

CHIEF ENGINEER _____ DATE _____

**1-5: CAPITOL HWY -
 TUALATIN RIVER SEC.**
 PACIFIC HIGHWAY
 MULTNOMAH, WASHINGTON & CLACKAMAS COUNTIES

FEDERAL HIGHWAY ADMINISTRATION	PROJECT NUMBER	SHEET NO.
OREGON DIVISION	IM-S001 (243)	1


T. 2S., R. 1E., R 1W., W.M.



HAINES ST. INTERCHANGE

40V-55

REVISED AS CONSTRUCTED
1/15/08 CONTRACT 13351

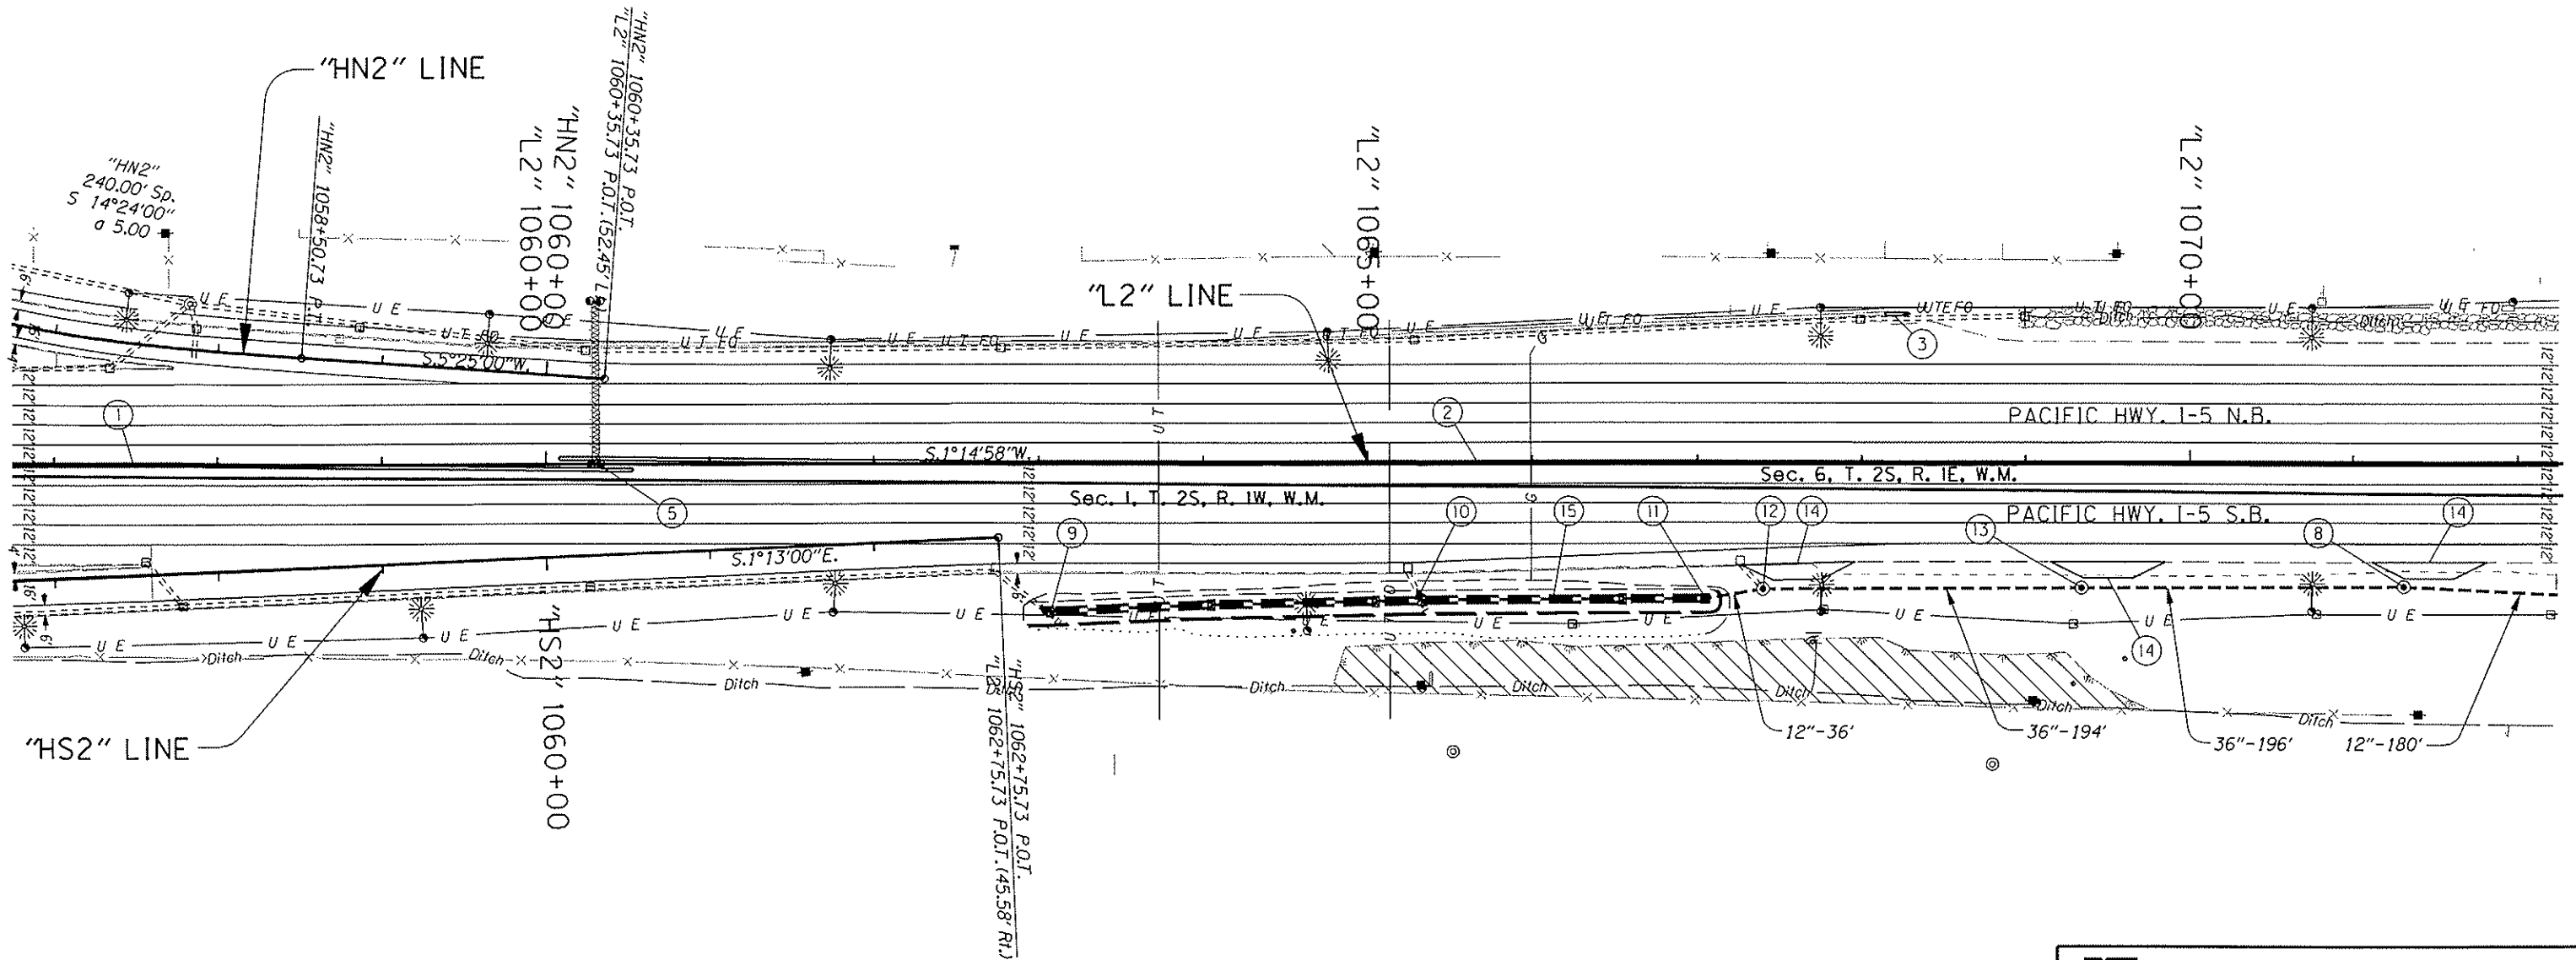

"HS2" LINE

"HN2" LINE

"L2" LINE


PACIFIC HWY. I-5 N.B.

PACIFIC HWY. I-5 S.B.

Sec. 1, T. 2S, R. 1W, W.M.

Sec. 6, T. 2S, R. 1E, W.M.

No Work Zone Shown Thus:

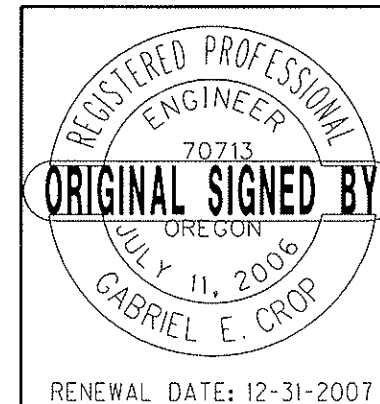

RENEWAL DATE: 12-31-2007

OREGON DEPARTMENT OF TRANSPORTATION

Murray, Smith & Associates, Inc.
121 S.W. Salmon, Suite 900, Portland, Oregon 97204-2919
503.225.9010



I-5: CAPITOL HWY -
TUALATIN RIVER SEC.

PACIFIC HIGHWAY
MULTNOMAH, WASHINGTON & CLACKAMAS COUNTIES

Reviewed By - Gabriel E. Crop

Designed By - E. Michael Kebbe

Drafted By - Susan K. Wentz

ALIGNMENT & GENERAL CONSTRUCTION

SHEET
NO.
8

① See Sht. 6A, Note 7
Const. Reflectorized Tall Conc. Median Barrier
Anchor Barrier To Roadway Using Vertical Anchor Rods

② Sta. "L2" 1060+08 To Sta. "L2" 1082+14
Const. Reflectorized Tall Conc. Median Barrier - 2200'
Anchor Barrier To Roadway Using Vertical Anchor Rods

③ Sta. "L2" 1067+95, Lt.
Remove Extg. Earth Mound - 60 C.Y.
Inst. Impact Attenuator
(For Details, See Sht. 2B-13)

⑤ Overlap Barrier Around Extg. Obstacle
(For Details, See Sht. 2B-11)

⑧ Sta. "L2" 1071+31 - 76' Rt.
Const. Manhole 72" Dia.
Rim Elev. = 269.83 +/-
Inst. 12" Sew. Pipe - 180'
10' Depth
(See Drg. Nos. RD316 & RD318)
(For Details, See Shts. GJ-4 & GJ-5)

⑨ Sta. "L2" 1063+05 - 90' Rt.
Remove Extg. 12" Pipe - 10'
Const. Paved End Slope
(See Drg. No. RD320)
(For Details, See Sht. GJ-2)

⑩ Sta. "L2" 1065+32 - 84' Rt.
Remove Extg. 12" Pipe - 4'
Const. Paved End Slope
(For Details, See Sht. GJ-2)


⑪ Sta. "L2" 1067+05 - 79' Rt.
Const. Type "D" Inlet
Inst. 12" Sew. Pipe - 36'
10' Depth
(See Drg. No. RD370)

⑫ Sta. "L2" 1067+40 - 75' Rt.
Const. Manhole 72" Dia.
Rim Elev. = 282.20 +/-
Connect To Extg. 12" Sew. Pipe (NE)
Inst. 36" Storm Sew. Pipe - 194'
20' Depth
(For Details, See Sht. GJ-4)

⑬ Sta. 1069+34 - 75' Rt.
Const. Manhole 72" Dia.
Rim Elev. = 276.10 +/-
Inst. 36" Sew. Pipe - 197'
10' Depth
Connect To Proposed Manhole (N)
(For Details, Shts. GJ-4 & GJ-6)

⑭ Const. Conc. Maintenance Pad - 3
(See Drg. No. TM434)

⑮ Const. Water Quality Swale
(For Drg. Nos., See Sht. 1A)

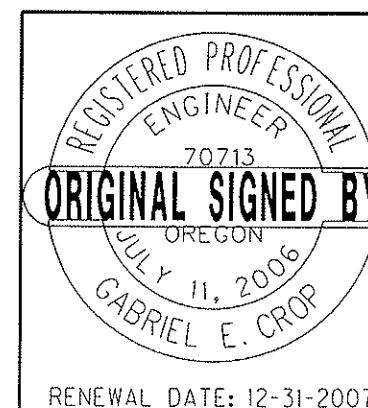

OREGON DEPARTMENT OF TRANSPORTATION

Murray, Smith & Associates, Inc.
121 S.W. Salmon, Suite 900, Portland, Oregon 97204-2919
503.225.9010



**I-5: CAPITOL HWY -
TUALATIN RIVER SEC.**

PACIFIC HIGHWAY
MULTNOMAH, WASHINGTON & CLACKAMAS COUNTIES

Reviewed By - Gabriel E. Crop

Designed By - E. Michael Kebbe

Drafted By - Susan K. Wentz



GENERAL CONSTRUCTION

SHEET
NO.

8A

"L2" LINE PROFILE
 (For Location, See Sht. 8)
 NORTHBOUND

40V-55
 REVISED AS CONSTRUCTED
 1/15/08 CONTRACT 13351

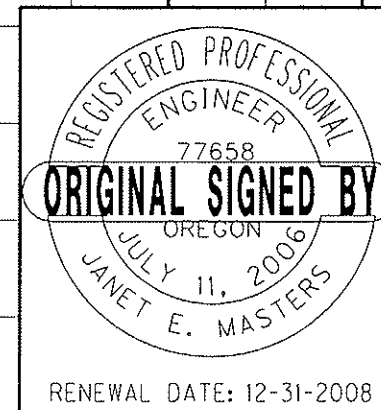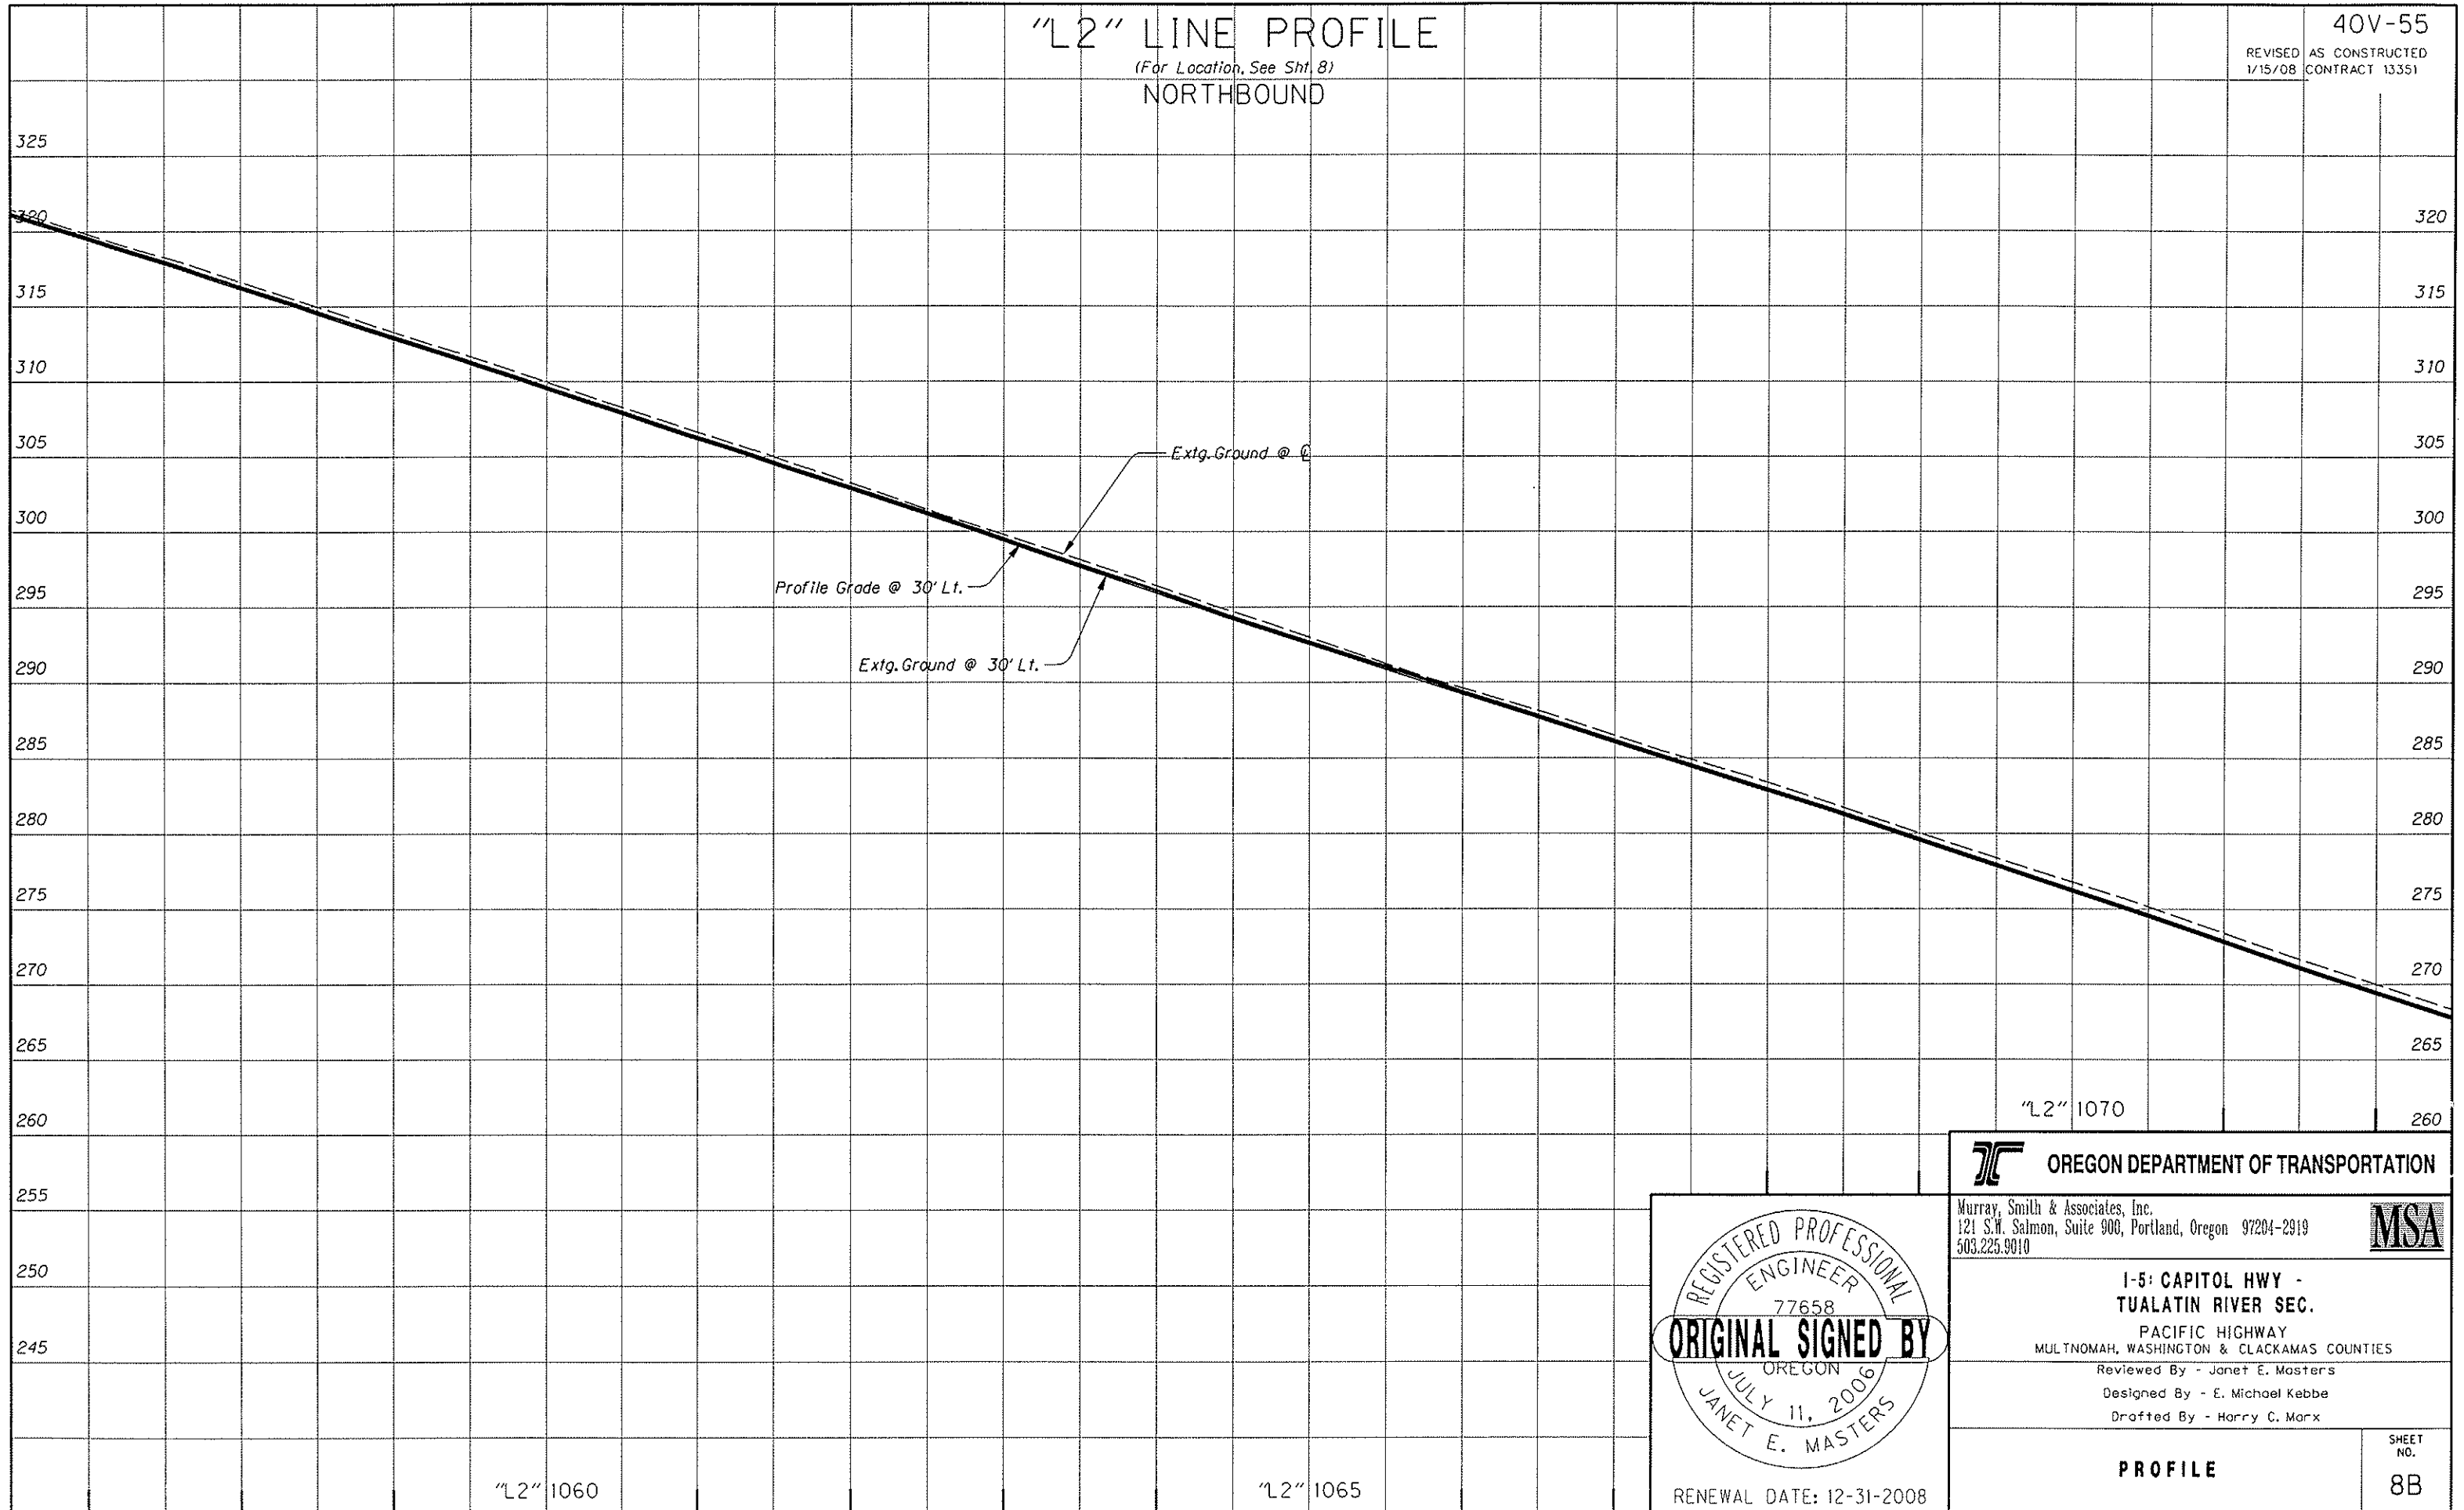


OREGON DEPARTMENT OF TRANSPORTATION	
Murray, Smith & Associates, Inc. 121 S.W. Salmon, Suite 900, Portland, Oregon 97204-2919 503.225.9010	
1-5: CAPITOL HWY - TUALATIN RIVER SEC. PACIFIC HIGHWAY MULTNOMAH, WASHINGTON & CLACKAMAS COUNTIES	
Reviewed By - Janet E. Masters Designed By - E. Michael Kebbe Drafted By - Harry C. Marx	
PROFILE	SHEET NO. 8B

"L2" LINE PROFILE
 (For Location, See Sht. 8)
 SOUTHBOUND

40V-55

REVISED AS CONSTRUCTED
 1/15/08 CONTRACT 13351

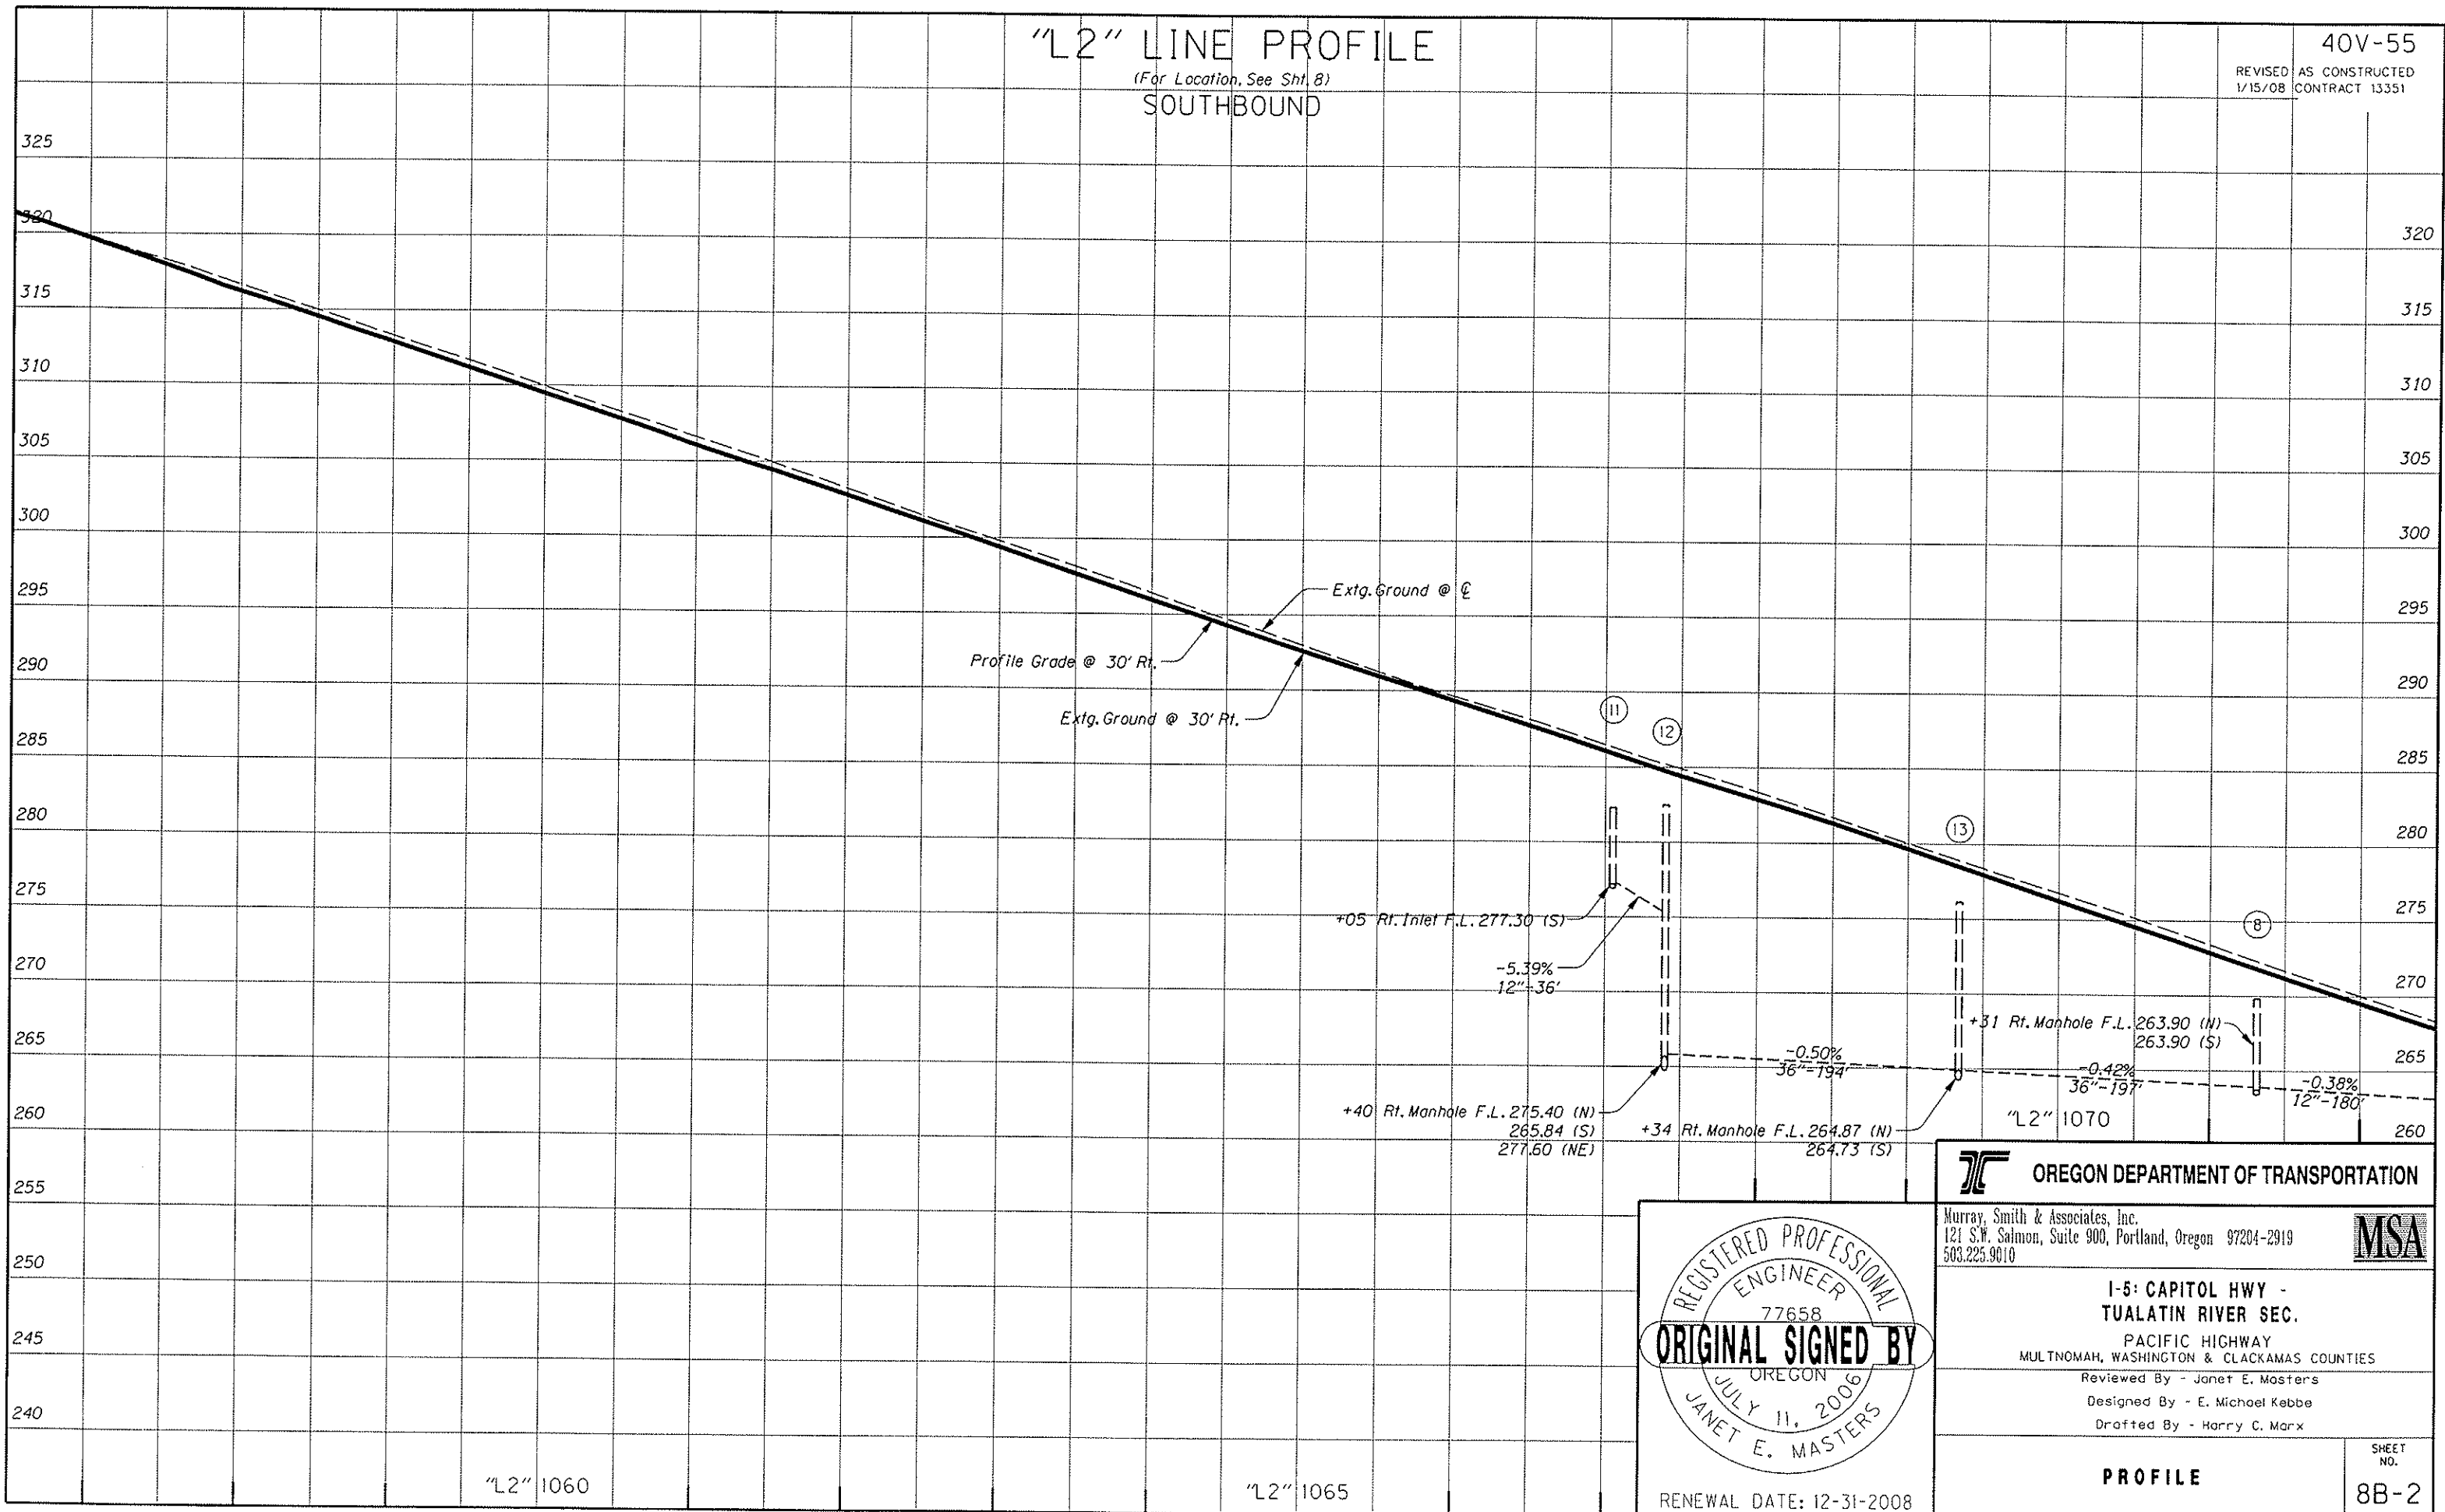

REGISTERED PROFESSIONAL
 ENGINEER
 77658
ORIGINAL SIGNED BY
 OREGON
 JULY 11, 2006
 JANET E. MASTERS
 RENEWAL DATE: 12-31-2008

OREGON DEPARTMENT OF TRANSPORTATION

Murray, Smith & Associates, Inc.
 121 S.W. Salmon, Suite 900, Portland, Oregon 97204-2919
 503.225.9610



**I-5: CAPITOL HWY -
 TUALATIN RIVER SEC.**
 PACIFIC HIGHWAY
 MULTNOMAH, WASHINGTON & CLACKAMAS COUNTIES
 Reviewed By - Janet E. Masters
 Designed By - E. Michael Kebbe
 Drafted By - Harry C. Marx

PROFILE
 SHEET NO.
8B-2


"L2" 1060

"L2" 1065


S. TIGARD INTERCHANGE

40V-55

REVISED AS CONSTRUCTED
1/15/08 CONTRACT 13351

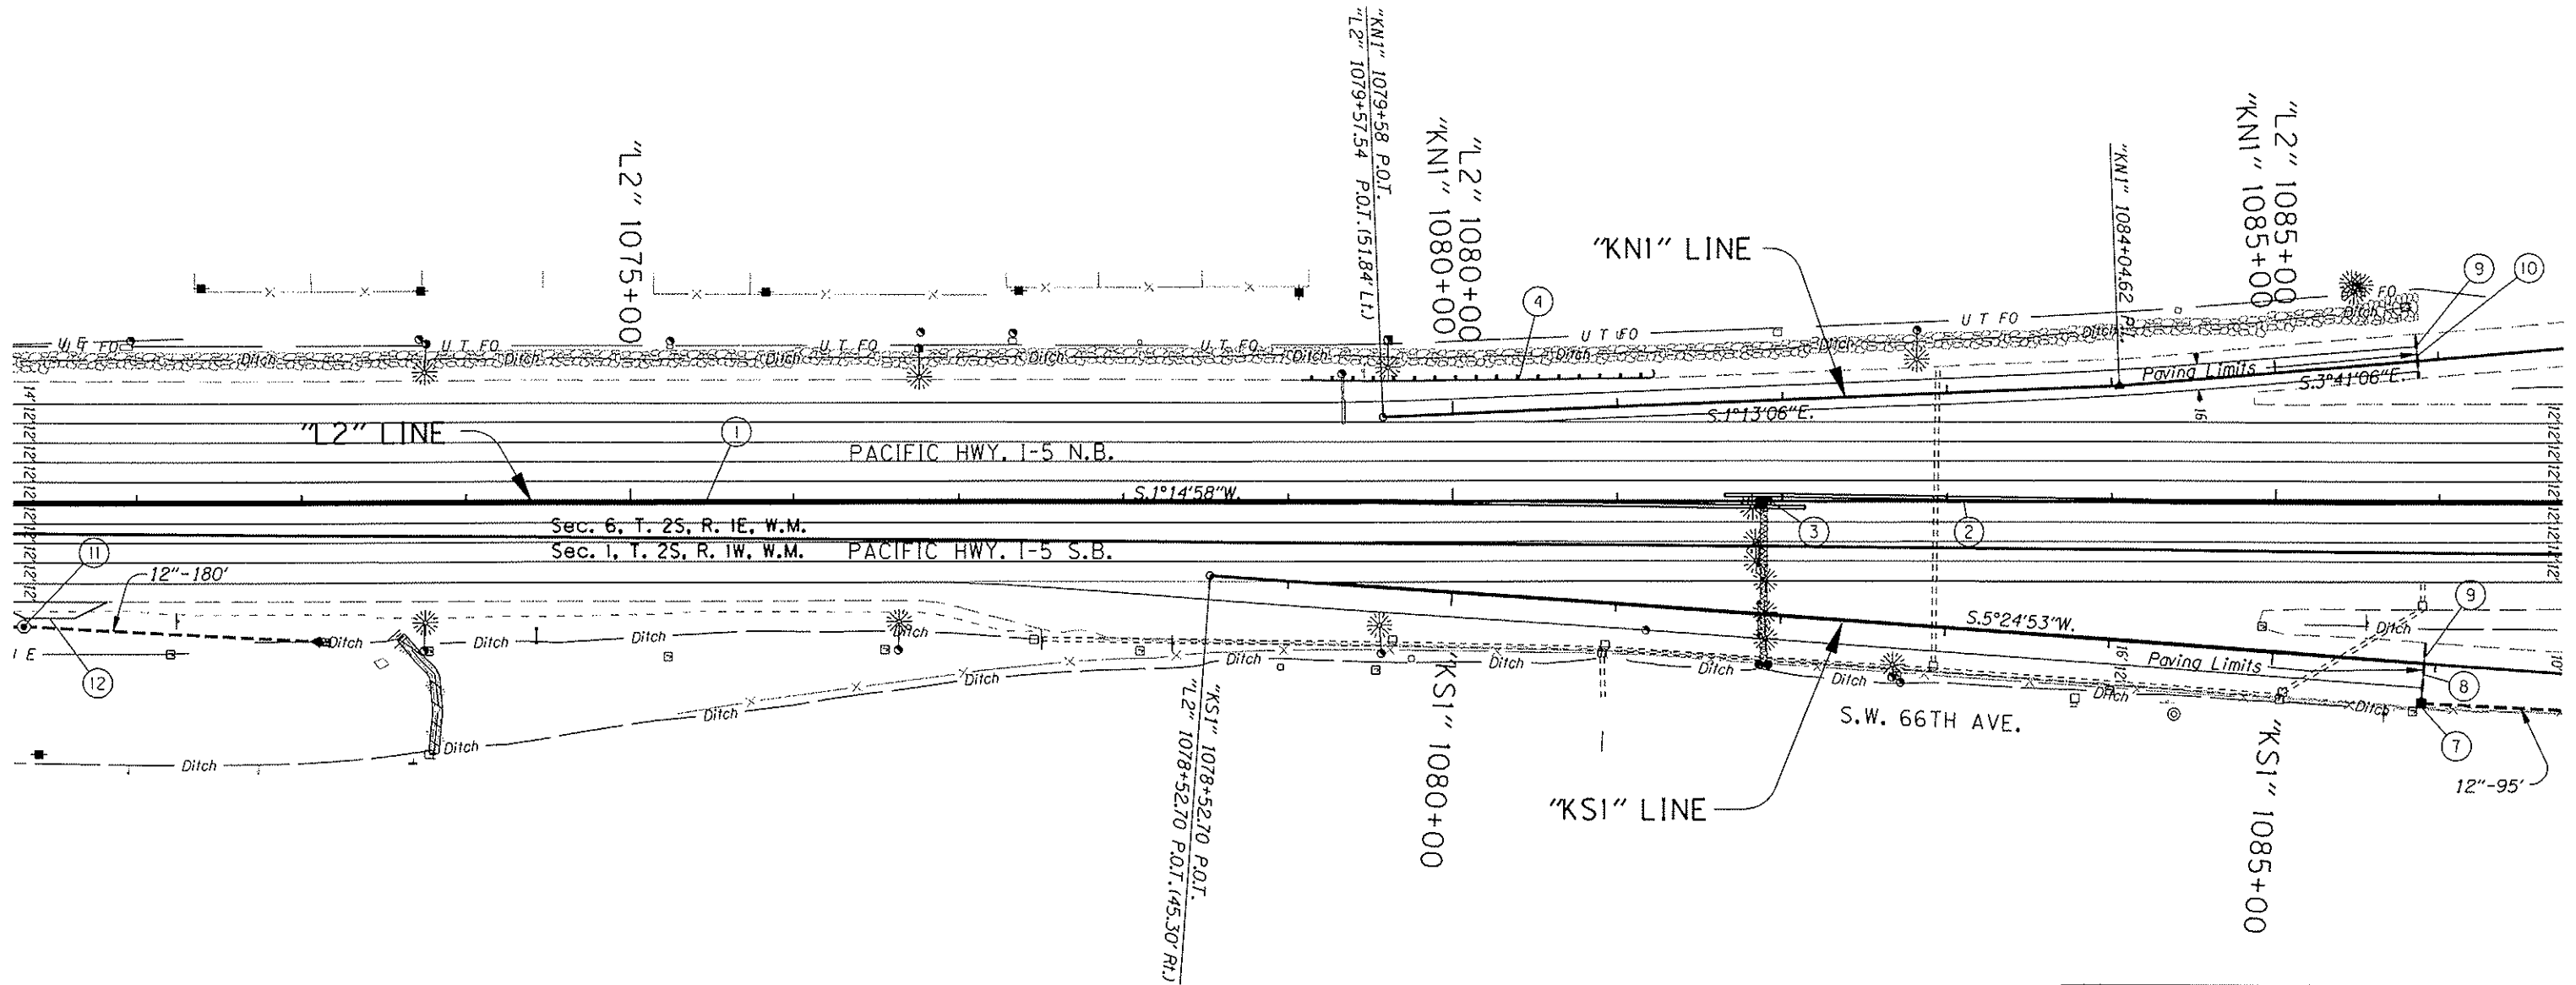


 OREGON DEPARTMENT OF TRANSPORTATION

Murray, Smith & Associates, Inc.
121 S.W. Salmon, Suite 900, Portland, Oregon 97204-2919
503.225.9010 

I-5: CAPITOL HWY - TUALATIN RIVER SEC.
PACIFIC HIGHWAY
MULTNOMAH, WASHINGTON & CLACKAMAS COUNTIES
Reviewed By - Gabriel E. Crop
Designed By - Jeremiah D. Hess
Drafted By - Susan K. Wentz



ALIGNMENT & GENERAL CONSTRUCTION SHEET NO. **9**

No Work Zone Shown Thus: 

- ① See Sht. 8A, Note 2
Const. Reflectorized Tall Conc. Median Barrier
Anchor Barrier To Roadway Using Vertical Anchor Rods
- ② Sta. "L2" 1081+65 To Sta. "L2" 1101+40
Const. Reflectorized Tall Conc. Median Barrier - 1975'
Anchor Barrier To Roadway Using Vertical Anchor Rods
- ③ Overlap Barrier Around Extg. Obstacle
(For Details, See Sht. 2B-11)
- ④ Sta. "L2" 1079+08 To Sta. "KN1" 1081+21, Lt.
Const. Guardrail - 175' (Type 2A)
Const. Anchor (Type 1 Mod)
Inst. End Piece (Type B)
Const. Guardrail Terminal, Non-Flared
W=1, E=0
(See Drg. Nos. RD400, RD405, RD410, RD415, RD420 & RD450)

- ⑦ Sta. "L2" 1085+90, Rt.
Const. Type "G-2" Inlet
Inst. 12" Sew. Pipe - 93'
5' Depth
Connect To Extg. Inlet (N)
Connect To Extg. Perf. Pipe
Const. Open Grade HMAC Inlet Mod.

- ⑧ Inst. Wearing Surface Drain - 40'
Option "A" Outlet To Inlet


- ⑨ Transition To Extg. Pymt.

- ⑩ Inst. Wearing Surface Drain - 25'
Option "B" Outlet To Ditch

- ⚠ ⑪ See Sht. 8A, Note 8
Const. 72" Dia. Manhole
Inst. 12" Sew. Pipe
10' Depth
Const. Paved End Slope
Const. Loose Riprap (Class 50) - 2 C.Y.
Inst. Drainage Geotextile, Type 2 - 7 Sq. Yd.
(For Details, See Shts. GJ-4 & GJ-5)

- ⑫ See Sht. 8A, Note 14
Const. Conc. Maintenance Pad

Rev. No.	Description	Date	Engineer
⚠	Addenda #1 - Format Note #11	2/26/07	JDH

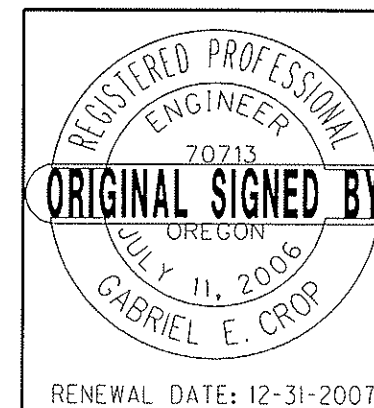

OREGON DEPARTMENT OF TRANSPORTATION

Murray, Smith & Associates, Inc.
121 S.W. Salmon, Suite 900, Portland, Oregon 97204-2919
503.225.9010



**I-5: CAPITOL HWY -
TUALATIN RIVER SEC.**
PACIFIC HIGHWAY
MULTNOMAH, WASHINGTON & CLACKAMAS COUNTIES


Reviewed By - Gabriel E. Crop
Designed By - Jeremiah D. Hess
Drafted By - Susan K. Wentz

GENERAL CONSTRUCTION

SHEET NO.
9A


RENEWAL DATE: 12-31-2007

WATER QUALITY SWALE TYPICAL SECTIONS

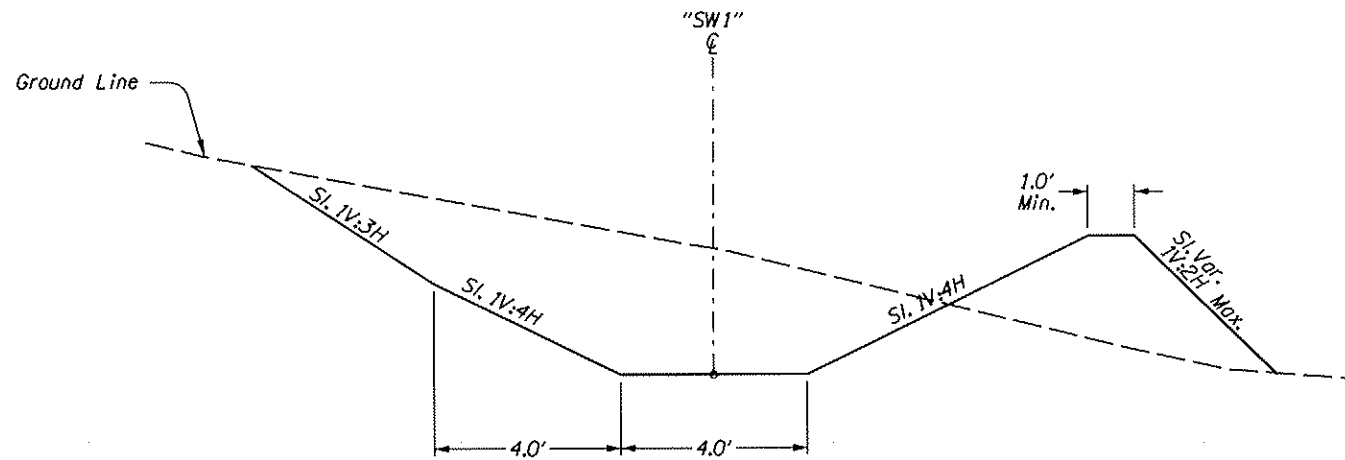

STA. "SW1" 1+00 To STA. "SW1" 5+00
WATER QUALITY SWALE TYPICAL SECTION

72" MANHOLE COVER
(For Details Not Shown, See Std. Drg. No. RD346)

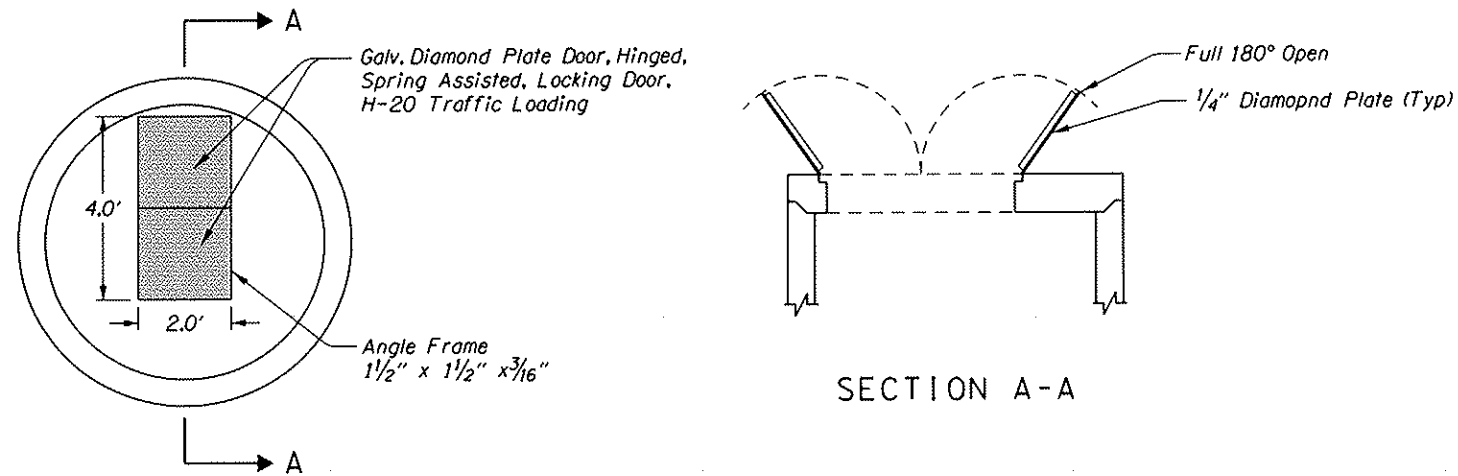


MANHOLE TOP SLAB PLAN


SECTION A-A

40V-55

REVISED AS CONSTRUCTED
1/15/08 CONTRACT 13351

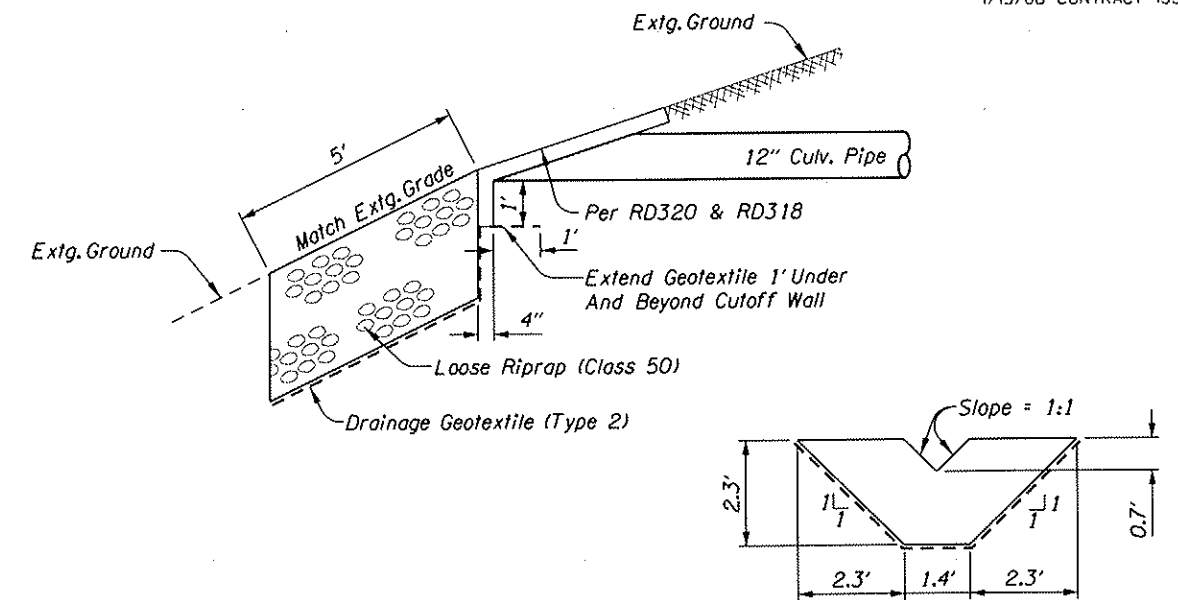

SECTION A-A

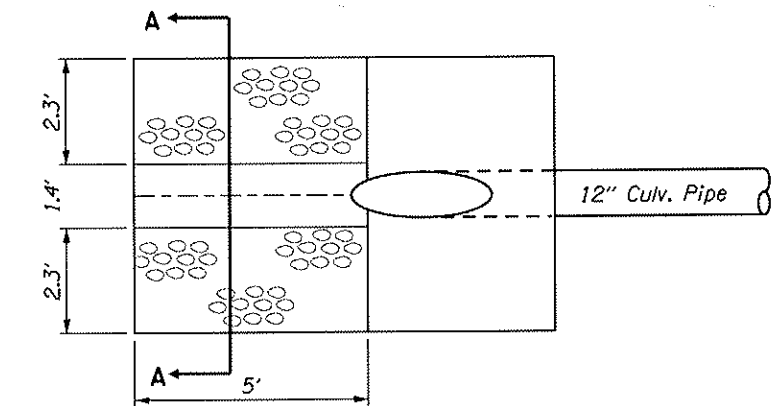

PLAN
OUTLET PROTECTION
Type 5

(For Details Not shown, See Drgs. No. RD318 & RD320)



OREGON DEPARTMENT OF TRANSPORTATION

Murray, Smith & Associates, Inc.
121 S.W. Salmon, Suite 900, Portland, Oregon 97204-2919
503.225.9010



I-5: CAPITOL HWY - TUALATIN RIVER SEC.

PACIFIC HIGHWAY
MULTNOMAH, WASHINGTON & CLACKAMAS COUNTIES

Reviewed By - Janet E. Masters

Designed By - Brendan V. O'Sullivan

Drafted By - Harry C. Marx

WATER QUALITY DETAILS


SHEET NO.
GJ-4

72" MANHOLE @ STA. "L2" 1071+31
(For Details Not Shown, See Std. Drg. No. RD346)


40V-55

REVISED AS CONSTRUCTED
1/15/08 CONTRACT 13351


NTS

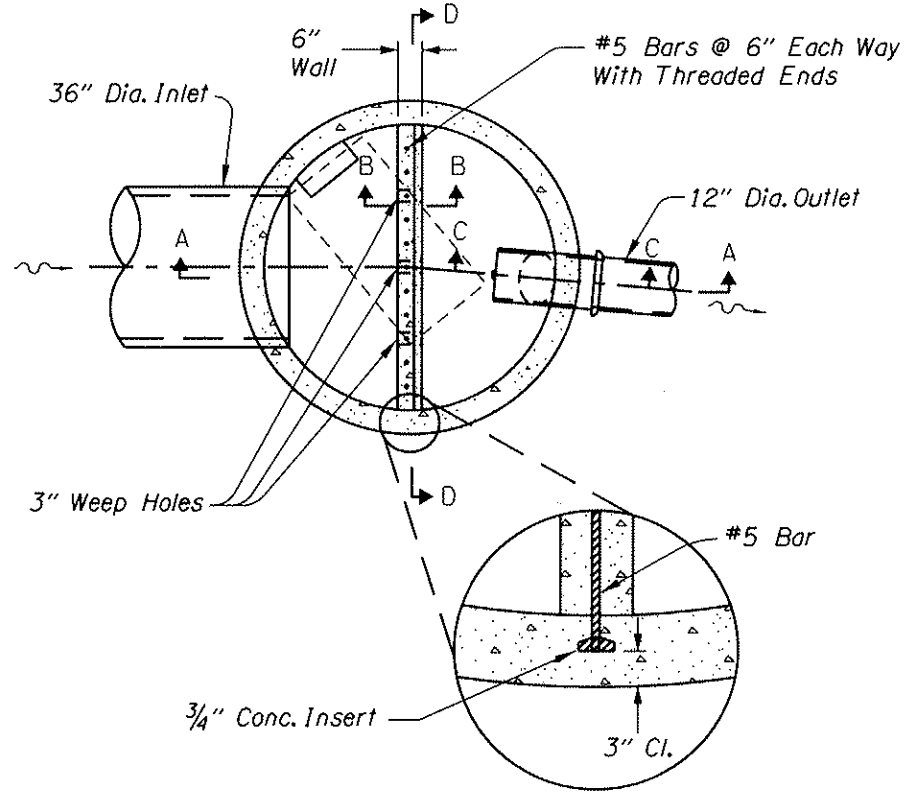


PLAN

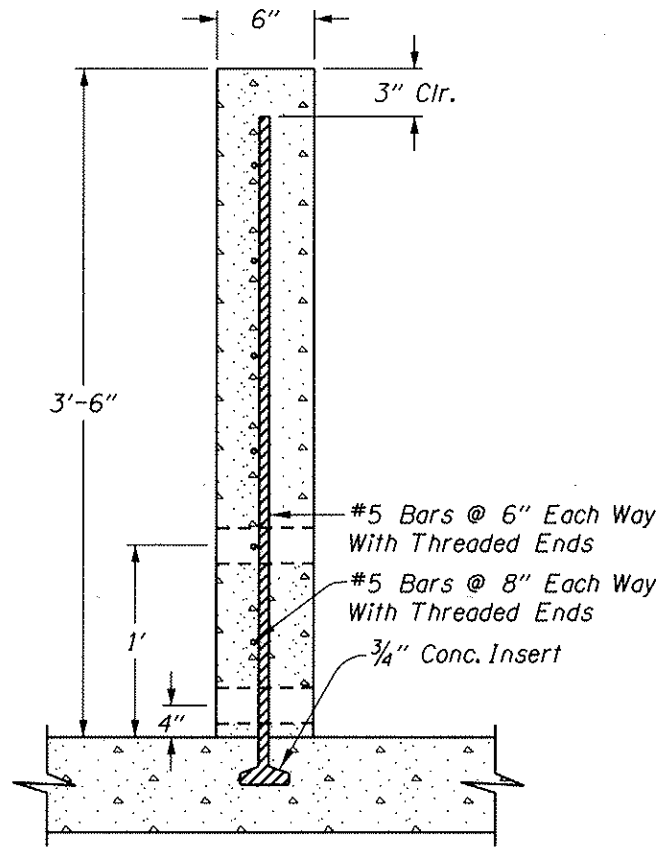


SECTION B-B

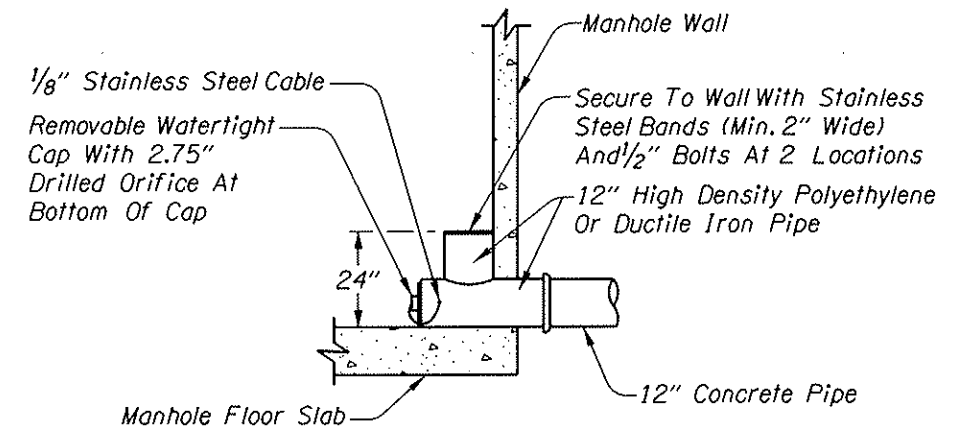

SECTION C-C

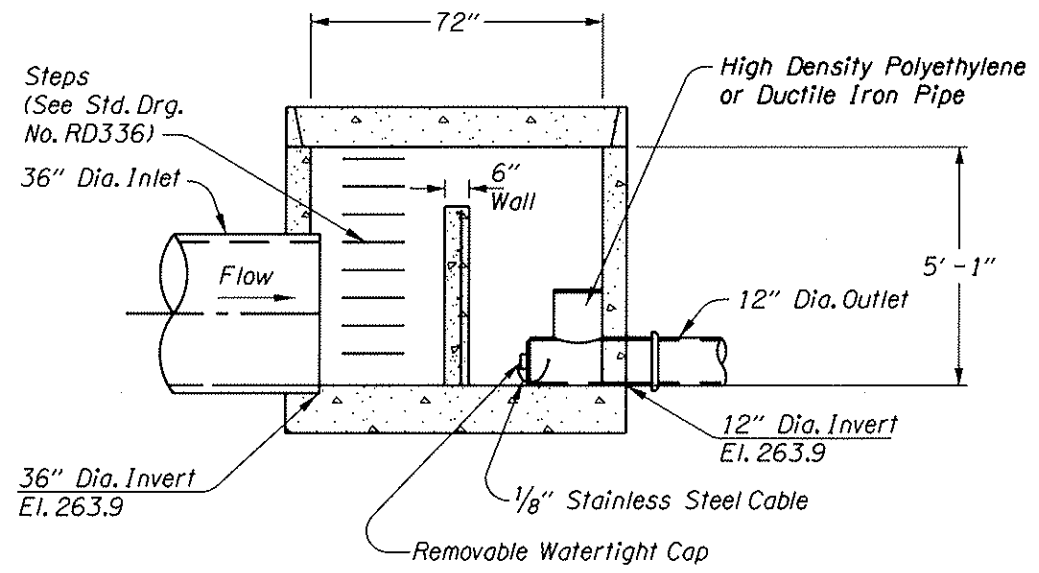

SECTION A-A

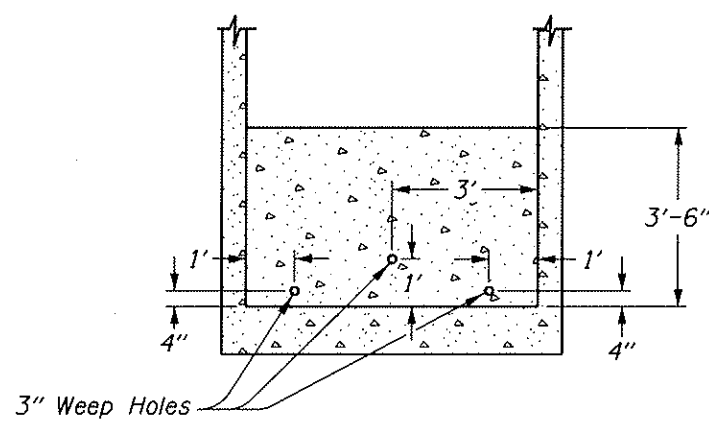

SECTION D-D

GENERAL NOTES:

All Bars Shall Be Placed 2" Clear Of The Nearest Face Of Concrete Unless Shown Otherwise.

Hardware, Fasteners And Anchors To Be Stainless Steel.




OREGON DEPARTMENT OF TRANSPORTATION	
Murray, Smith & Associates, Inc. 121 S.W. Salmon, Suite 900, Portland, Oregon 97204-2919 503.225.9010	
1-5: CAPITOL HWY - TUALATIN RIVER SEC.	
PACIFIC HIGHWAY MULTNOMAH, WASHINGTON & CLACKAMAS COUNTIES	
Reviewed By - Janet E. Masters Designed By - Brendan V. O'Sullivan Drafted By - Harry C. Marx	
WATER QUALITY DETAILS	SHEET NO. GJ-5

72" MANHOLE @ STA. "L2" 1069+34
 (For Details Not Shown, See Std. Drg. No. RD346)


40V-55

REVISED AS CONSTRUCTED
 1/15/08 CONTRACT 13351


NTS

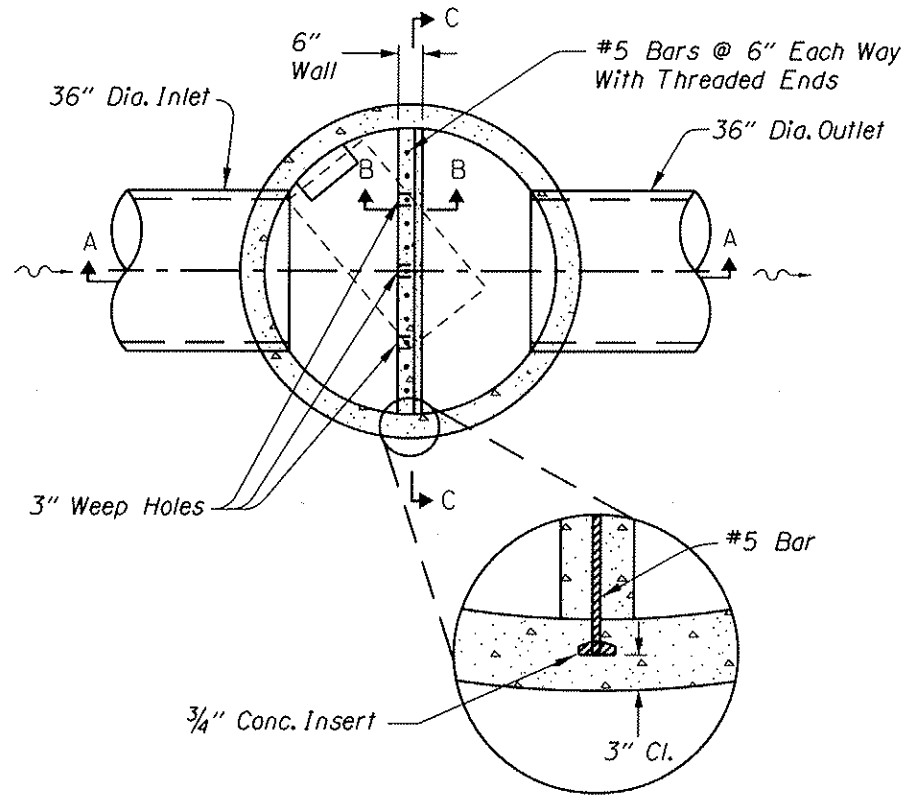


PLAN

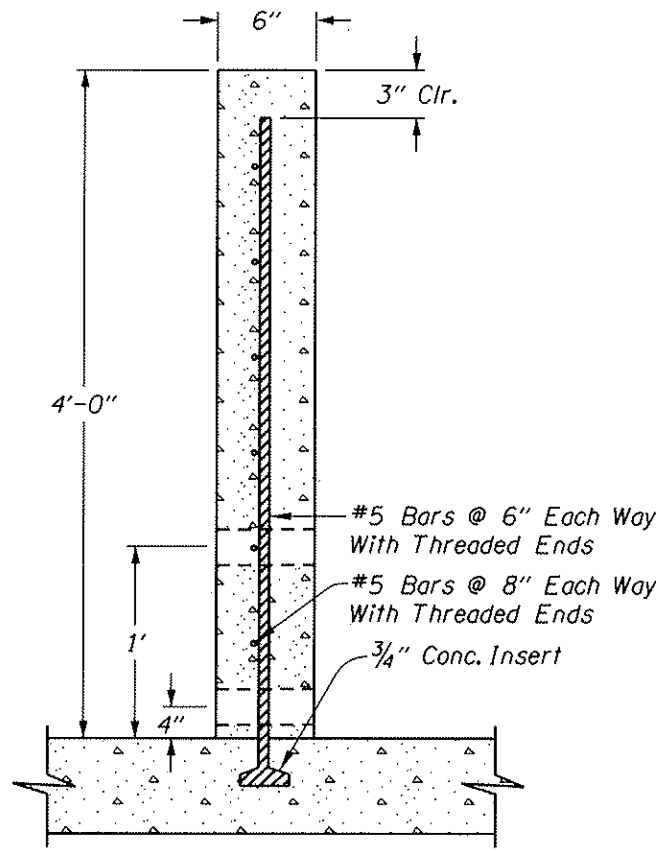

SECTION B-B

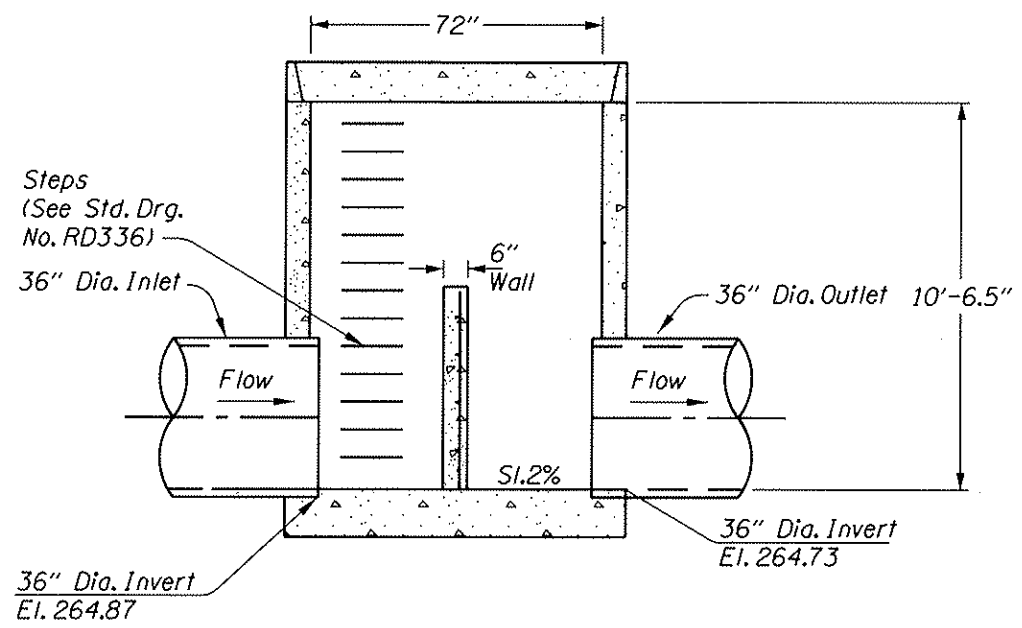

SECTION A-A

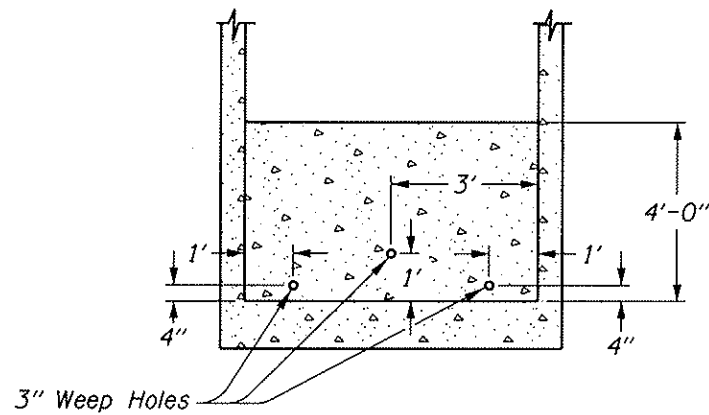


SECTION C-C

GENERAL NOTES:

All Bars Shall Be Placed 2" Clear Of The Nearest Face Of Concrete Unless Shown Otherwise.



OREGON DEPARTMENT OF TRANSPORTATION	
Murray, Smith & Associates, Inc. 121 S.W. Salmon, Suite 900, Portland, Oregon 97204-2919 503.225.9010	
I-5: CAPITOL HWY - TUALATIN RIVER SEC.	
PACIFIC HIGHWAY MULTNOMAH, WASHINGTON & CLACKAMAS COUNTIES	
Reviewed By - Janet E. Masters Designed By - Brendan V. O'Sullivan Drafted By - Harry C. Marx	
WATER QUALITY DETAILS	SHEET NO. GJ-6

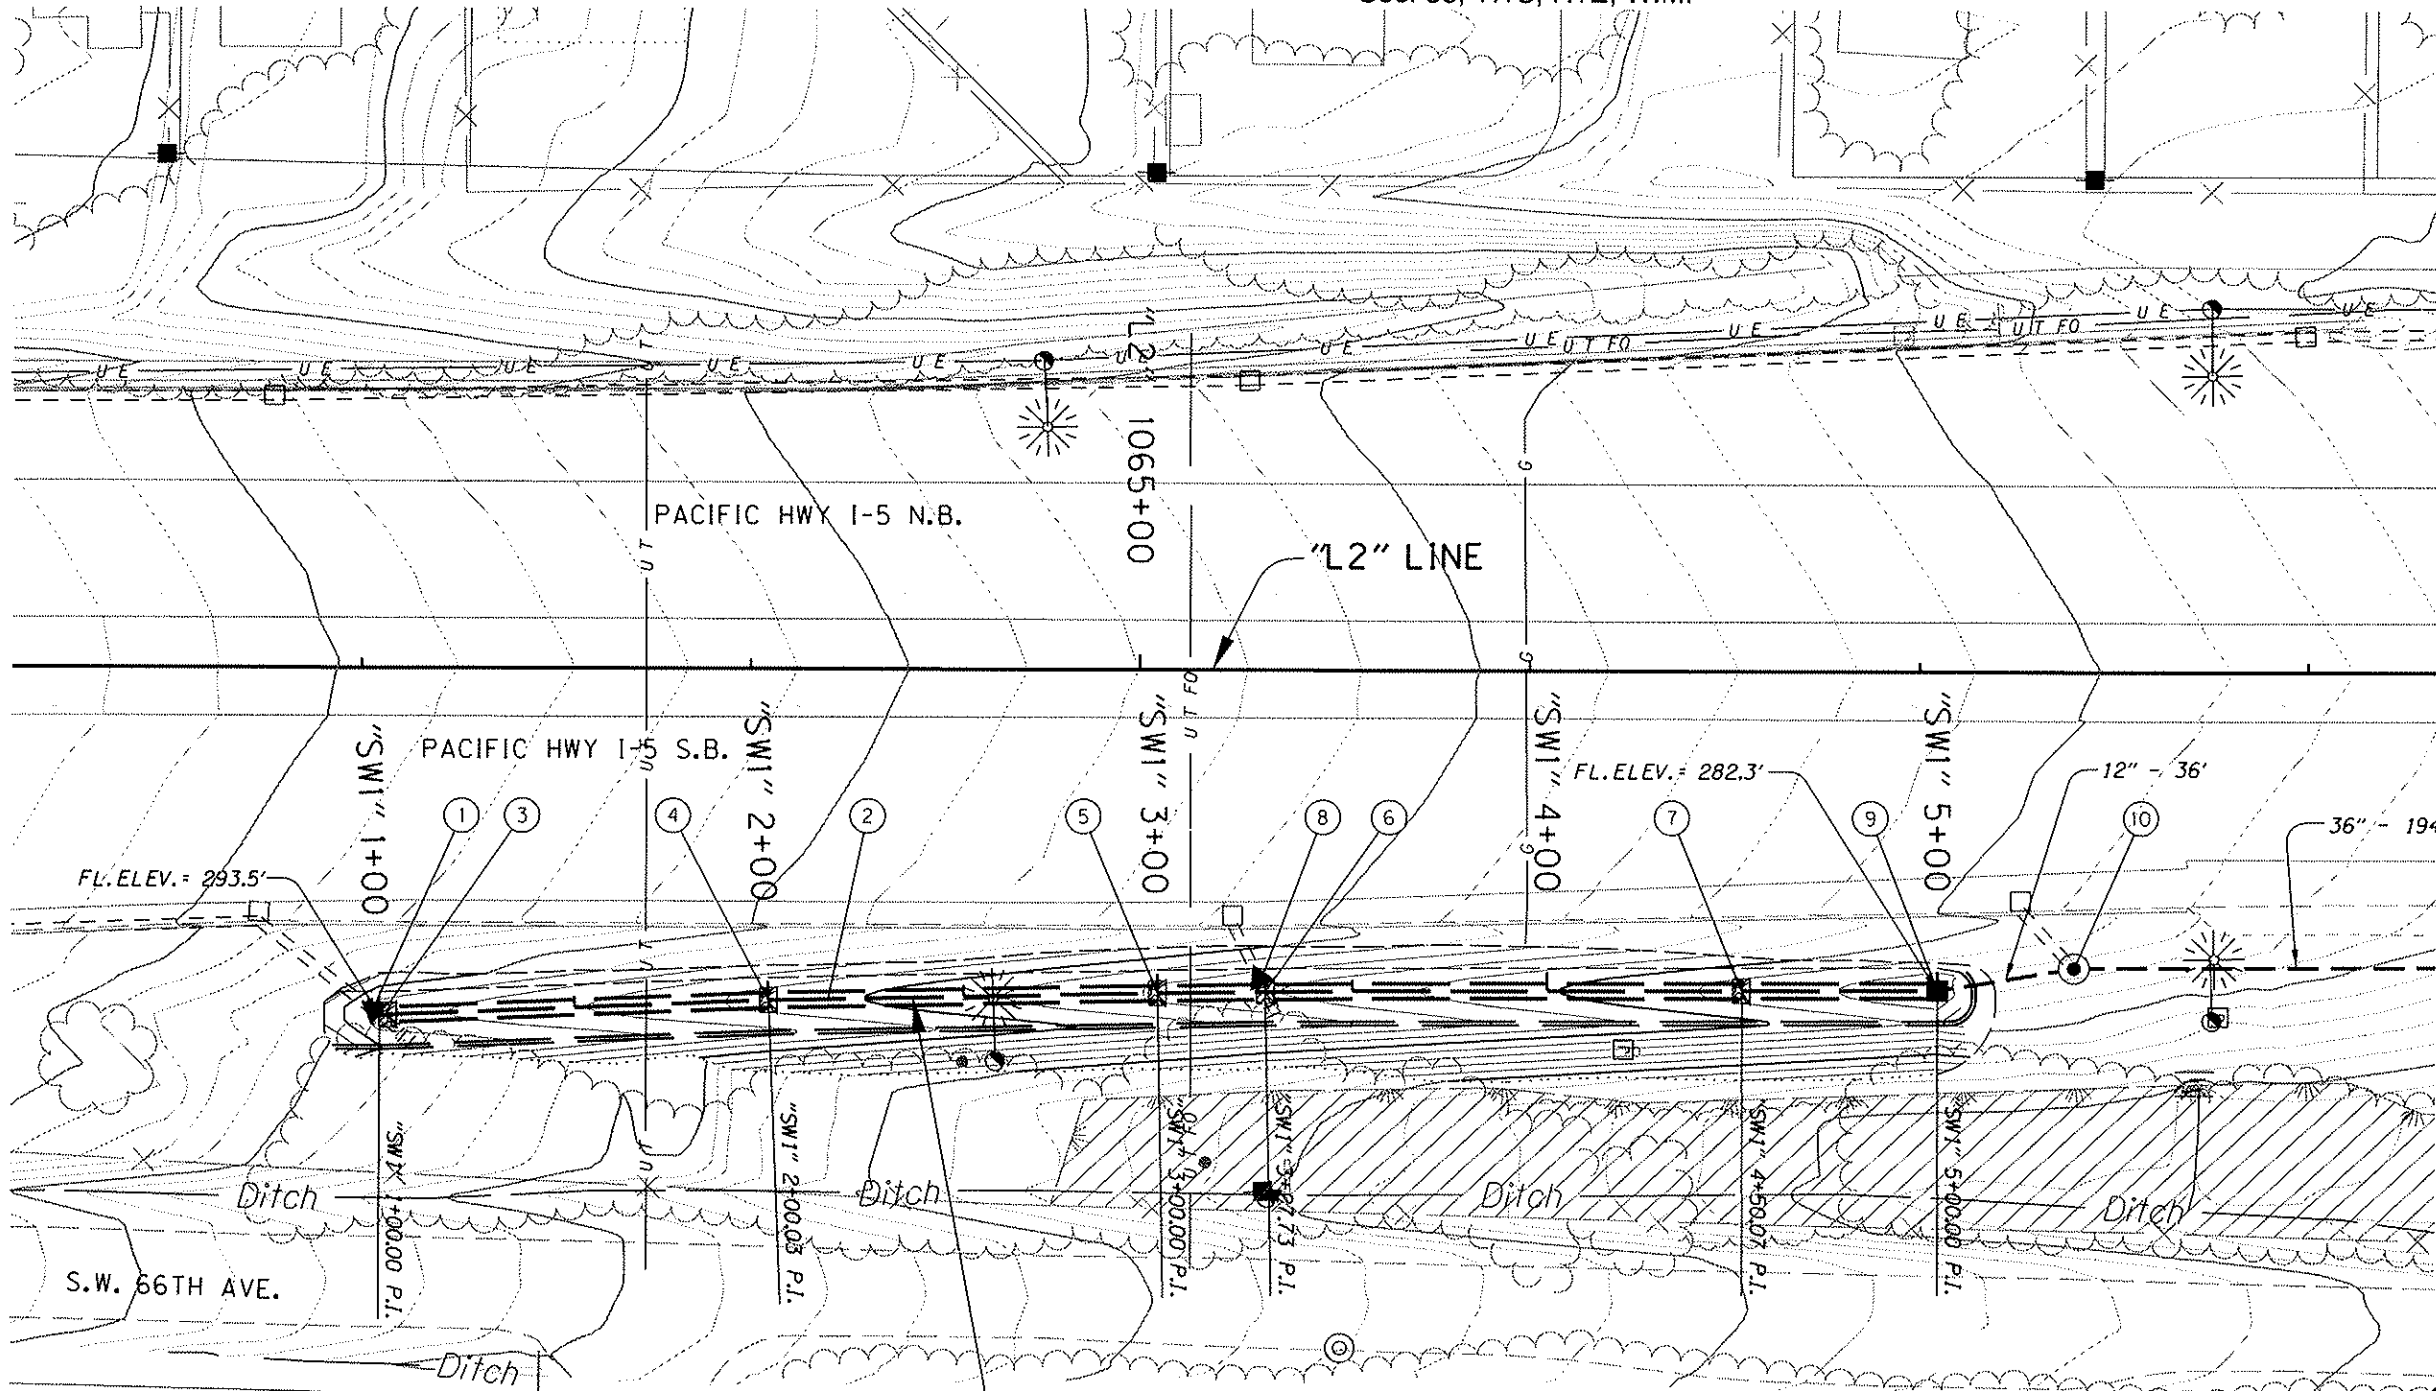

- ① See Sht. 8A, Note 9
Remove Pipe
Const. Paved End Slope
(For Details, See Sht. GJ-2)
- ② Sta. "SW1" 1+00 To Sta. "SW1" 5+00
Const. Water Quality Swale - 400'
Porous Pvmf. - 3200 Sq. Ft.
Riprap, Type 1 Geotextile - 540 Sq. Yd.
Base Aggregate - 160 Tons
Exc. - 92 Cu. Yd.
(For Details, See Shts. GJ, GJ-3, & GJ-4)
- ③ Sta. "SW1" 1+00
Const. Swale Flow Spreader
Riprap, Class 50 - 1 Cu. Yd.
(For Details, See Sht. GJ-2)
- ④ Sta. "SW1" 2+00
Const. Swale Flow Spreader
Riprap, Class 50 - 1 Cu. Yd.
(For Details, See Sht. GJ-2)
- ⑤ Sta. "SW1" 3+00
Const. Swale Flow Spreader
Riprap, Class 50 - 1 Cu. Yd.
(For Details, See Sht. GJ-2)
- ⑥ Sta. "SW1" 3+28
Const. Swale Flow Spreader
Riprap, Class 50 - 1 Cu. Yd.
(For Details, See Sht. GJ-2)
- ⑦ Sta. "SW1" 4+50
Const. Swale Flow Spreader
Riprap, Class 50 - 1 Cu. Yd.
(For Details, See Sht. GJ-2)
- ⑧ See Sht. 8A, Note 10
Const. Paved End Slope
(For Details, See Sht. GJ-2)
- ⑨ See Sht. 8A, Note 11
Const. Type "D" Inlet
- ⑩ See Sht. 8A, Note 12
Const. Manhole 72" Dia.
Inst. 36" Sew. Pipe

FL. ELEV. = 293.5'

FL. ELEV. = 282.3'

12" - 36"

36" - 194"

"SW1" 1+00

"SW1" 2+00

"SW1" 3+00

"SW1" 4+00

"SW1" 5+00

"SW1" 1+00.00 P.I.

"SW1" 2+00.00 P.I.

"SW1" 3+00.00 P.I.

"SW1" 4+50.00 P.I.

"SW1" 5+00.00 P.I.

Ditch

Ditch


Ditch

Ditch


S.W. 66TH AVE.

S.W. FRANKLIN ST.

"SWI" LINE
(For Profile, See Sht. GJ-9)

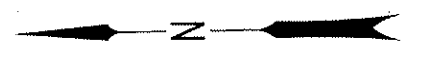

Wetland Shown Thus:

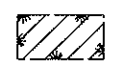

RENEWAL DATE: 12-31-2008

OREGON DEPARTMENT OF TRANSPORTATION

Murray, Smith & Associates, Inc.
121 S.W. Salmon, Suite 900, Portland, Oregon 97204-2919
503.225.9010



I-5: CAPITOL HWY - TUALATIN RIVER SEC.


PACIFIC HIGHWAY
MULTNOMAH, WASHINGTON & CLACKAMAS COUNTIES


Reviewed By - Janet E. Masters
Designed By - Brendan V. O'Sullivan
Drafted By - Harry C. Marx

WATER QUALITY PLAN

SHEET NO.
GJ-7

- ① See Sht. 8A, Note 8
Const. Manhole 72" Dia.
Inst. 12" Sew. Pipe
Const. Paved End Slope
(For Details, See Shts. GJ-4 & GJ-5)
- ② See Sht. 8A, Note 13
Const. Manhole 72" Dia.
Inst. 36" Sew. Pipe
(For Details, See Shts. GJ-4 & GJ-6)

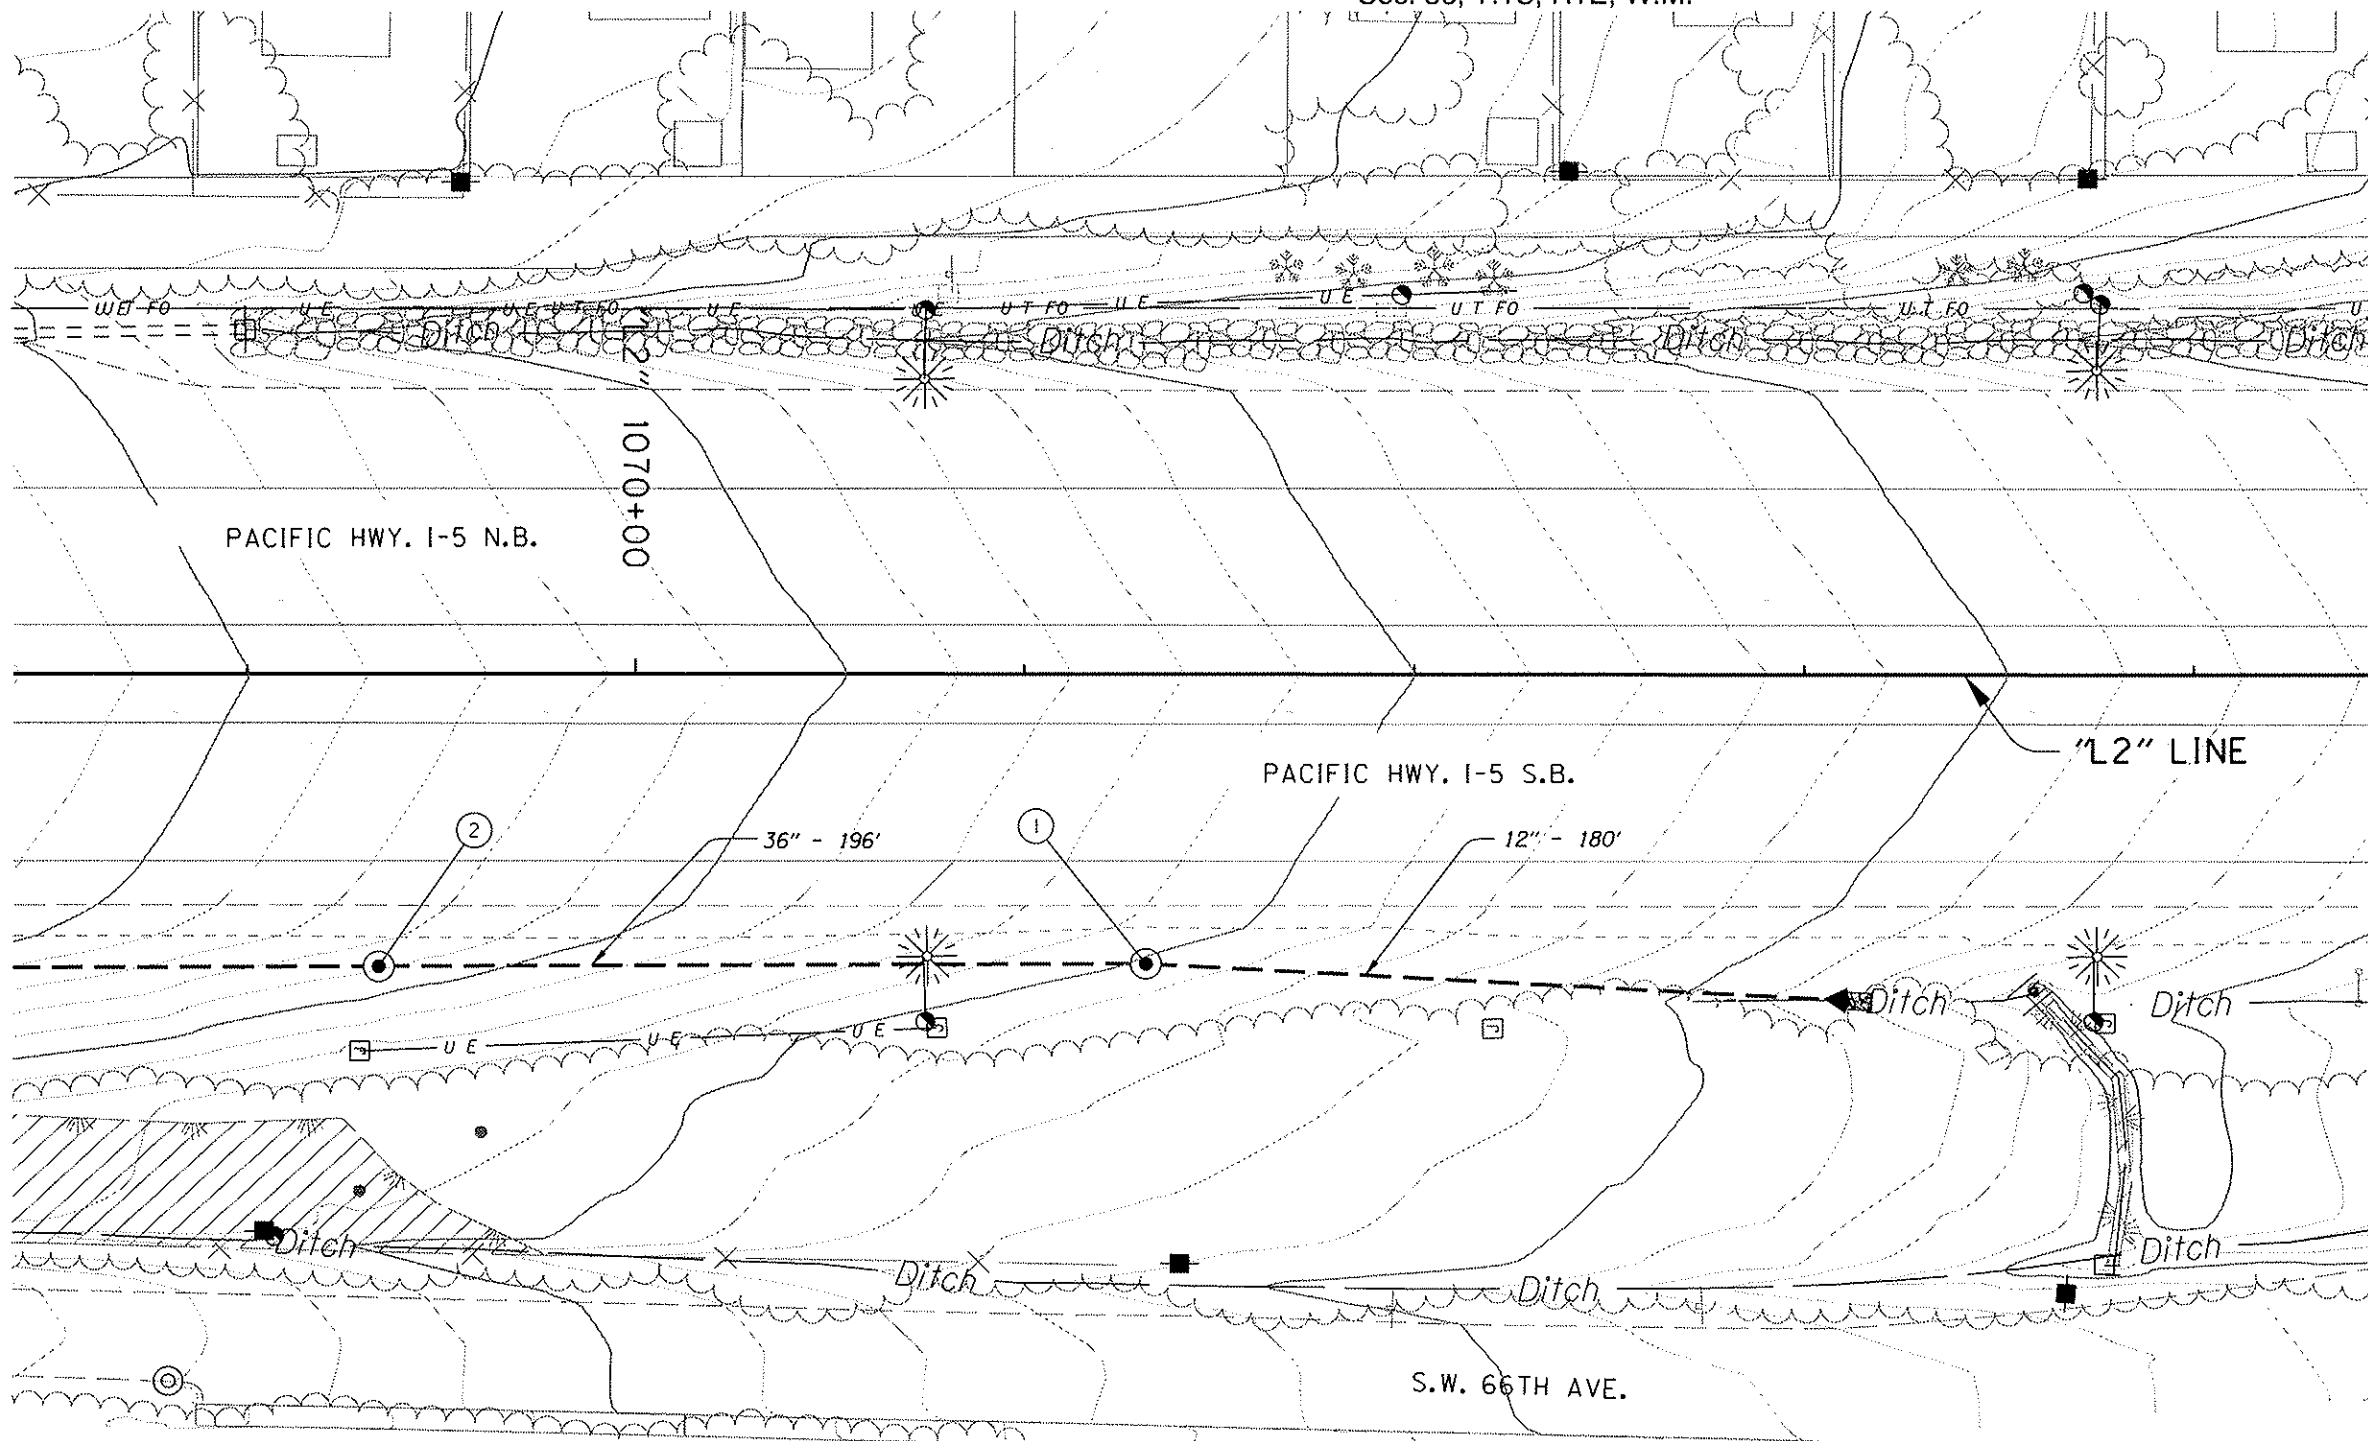

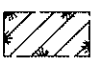Wetland Shown Thus: 

REGISTERED PROFESSIONAL
ENGINEER
77658
ORIGINAL SIGNED BY
JANET E. MASTERS
JULY 11, 2006
RENEWAL DATE: 12-31-2008

 OREGON DEPARTMENT OF TRANSPORTATION

Murray, Smith & Associates, Inc.
121 S.W. Salmon, Suite 900, Portland, Oregon 97204-2919
503.225.9010 

I-5: CAPITOL HWY - TUALATIN RIVER SEC.
PACIFIC HIGHWAY
MULTNOMAH, WASHINGTON & CLACKAMAS COUNTIES
Reviewed By - Janet E. Masters
Designed By - Brendan V. O'Sullivan
Drafted By - Harry C. Marx


WATER QUALITY PLAN
SHEET NO. GJ-8

"SW1" LINE -PROFILE

(For Location, See Sht. GJ-7)

40V-55

REVISED AS CONSTRUCTED
1/15/08 CONTRACT 13351

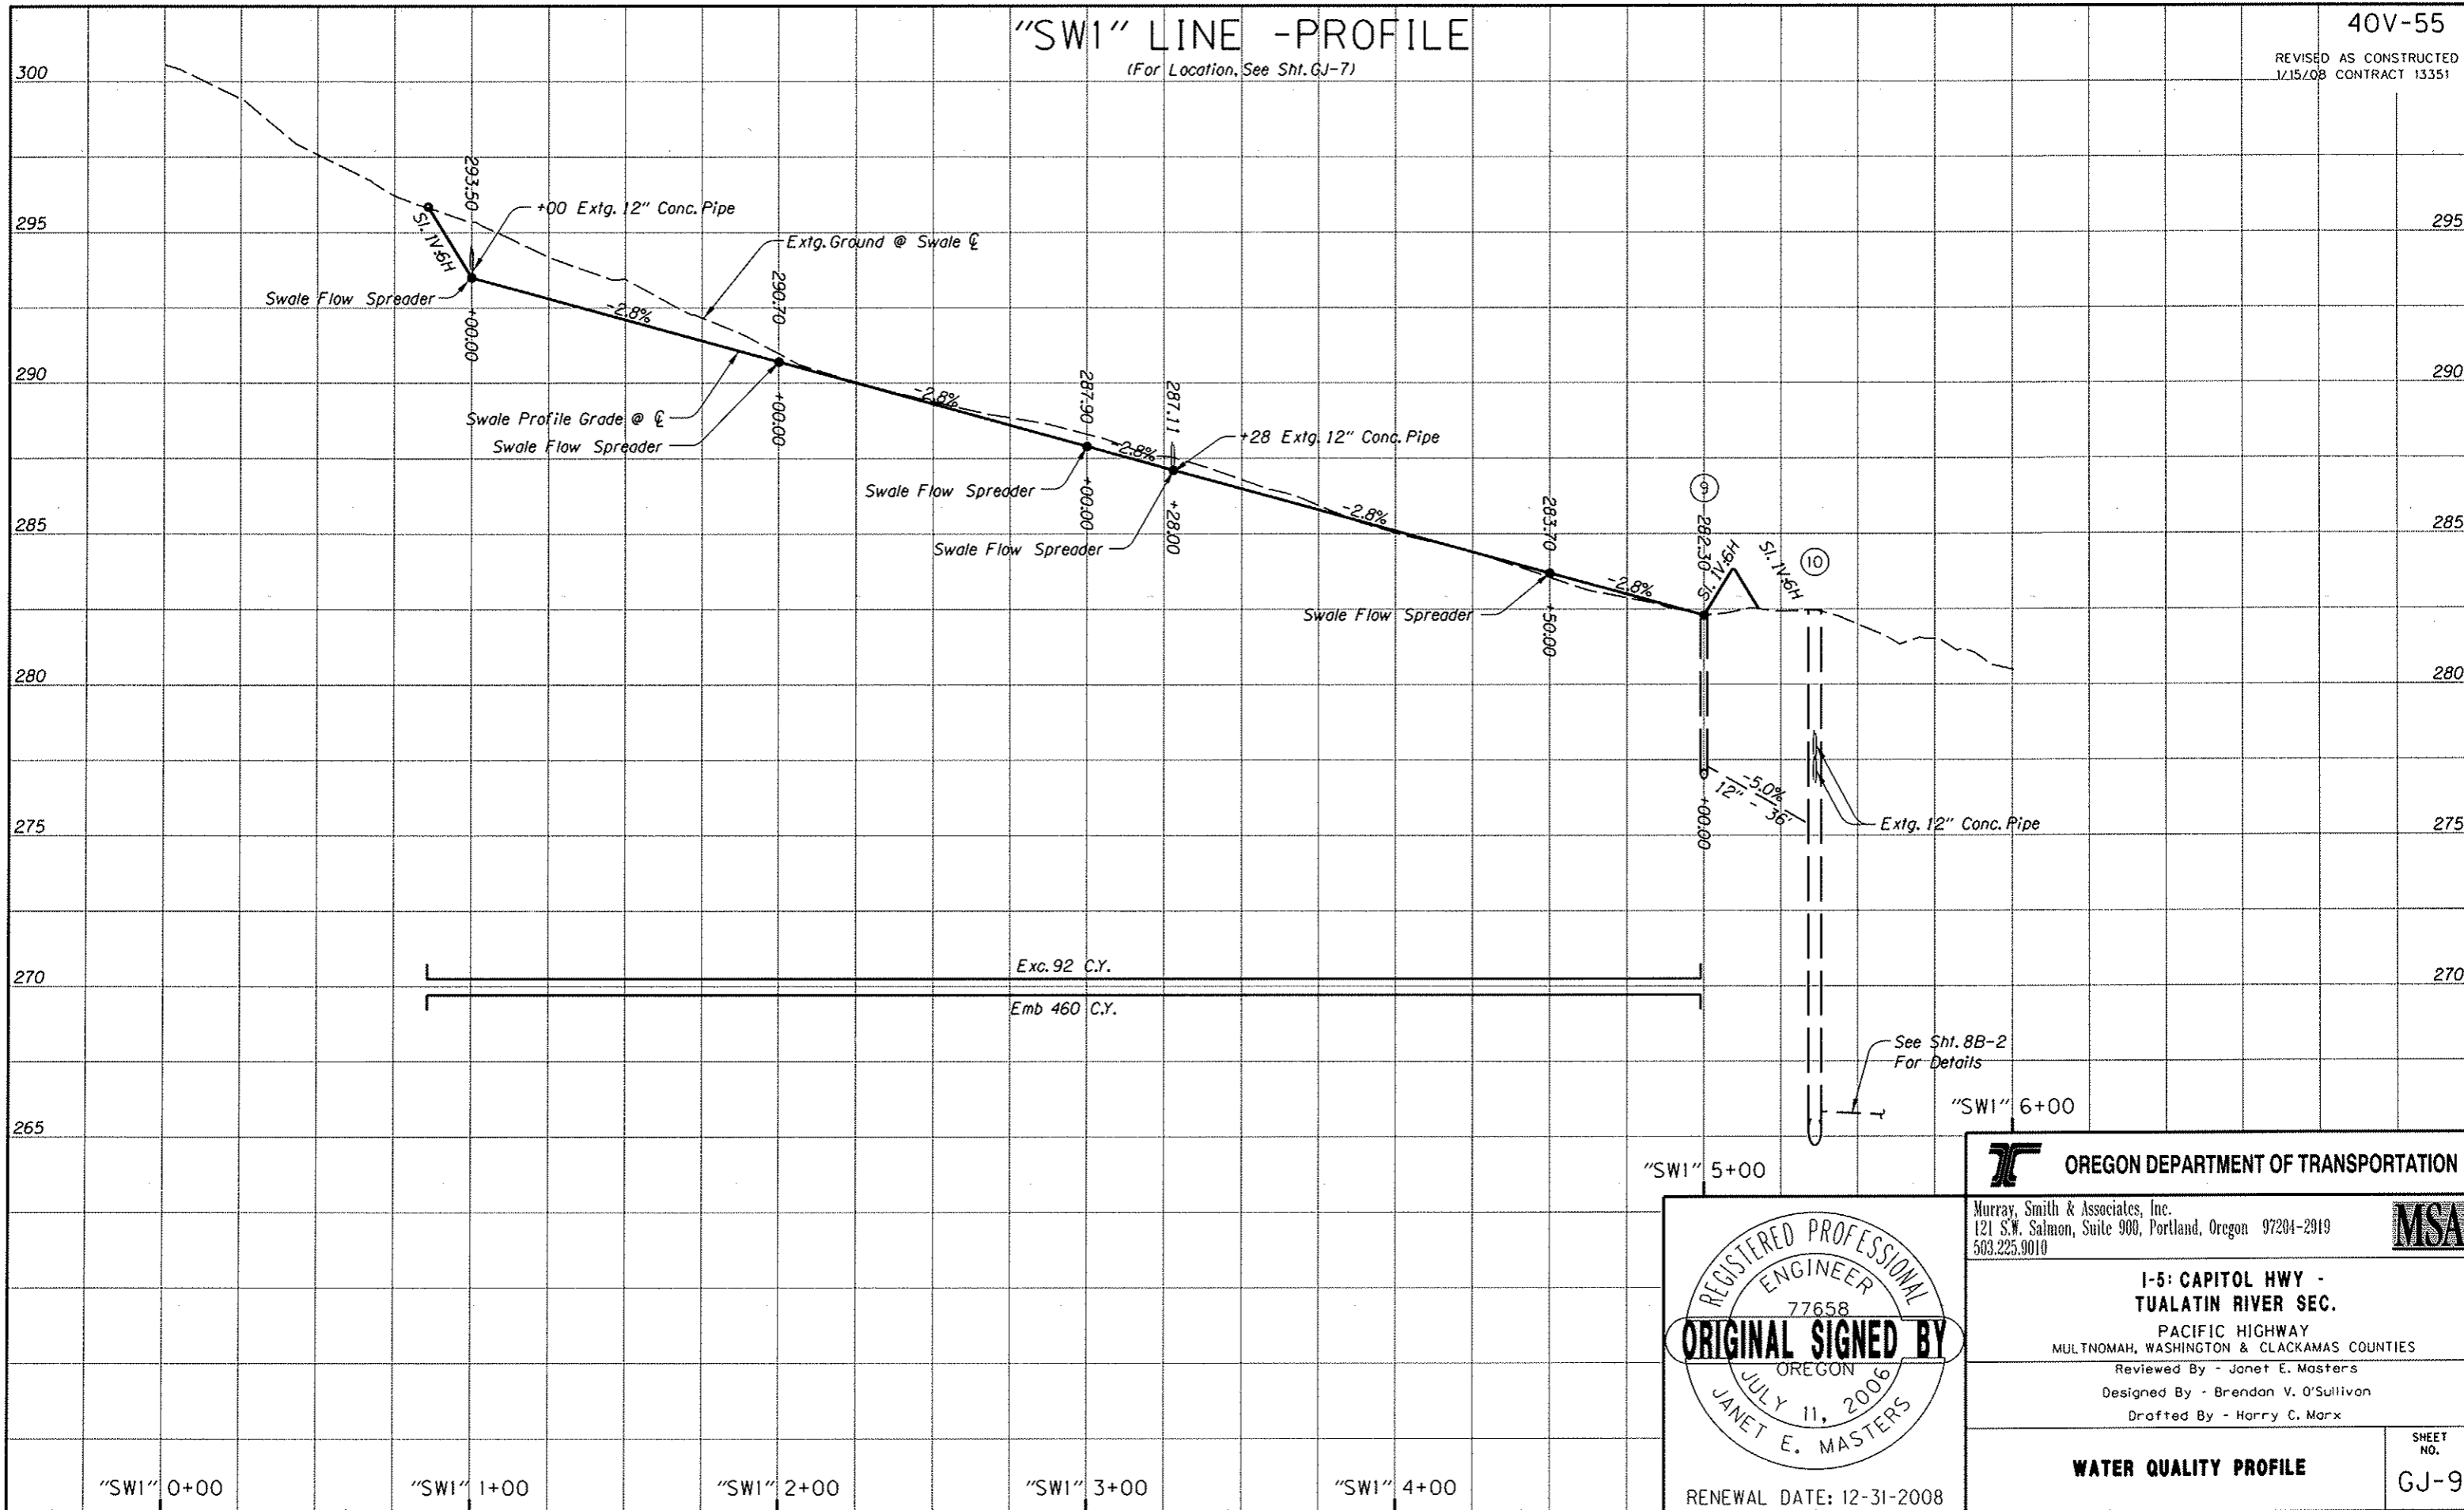

REGISTERED PROFESSIONAL
ENGINEER
77658
ORIGINAL SIGNED BY
OREGON
JULY 11, 2006
JANET E. MASTERS
RENEWAL DATE: 12-31-2008

OREGON DEPARTMENT OF TRANSPORTATION	
Murray, Smith & Associates, Inc. 121 S.W. Salmon, Suite 900, Portland, Oregon 97204-2919 503.225.9010	
1-5: CAPITOL HWY - TUALATIN RIVER SEC.	
PACIFIC HIGHWAY MULTNOMAH, WASHINGTON & CLACKAMAS COUNTIES	
Reviewed By - Janet E. Masters Designed By - Brendan V. O'Sullivan Drafted By - Harry C. Marx	
WATER QUALITY PROFILE	SHEET NO. GJ-9