

OPERATION & MAINTENANCE MANUAL

DFI No. D00110

**Facility Type: Water Quality Extended
Detention Dry Pond**



AUGUST, 2011

INDEX

1. IDENTIFICATION..... 1

2. FACILITY CONTACT INFORMATION..... 1

3. CONSTRUCTION..... 1

4. STORM DRAIN SYSTEM AND FACILITY OVERVIEW 1

5. FACILITY HAZ MAT SPILL FEATURE(S)..... 4

6. AUXILIARY OUTLET (HIGH FLOW BYPASS)..... 4

7. MAINTENANCE REQUIREMENTS..... 4

8. WASTE MATERIAL HANDLING..... 5

APPENDIX A: Operational Plan and Profile Drawing(s)

APPENDIX B: ODOT Project Plan Sheets

1. Identification

Drainage Facility ID (DFI): **D00110**
Facility Type: Water Quality Extended Detention Dry Pond
Construction Drawings: (V-File Number) 29V-50
Location: District: 2B (Old 2A)
Highway No.: 029
Mile Post: 0.68 (beg./end)
Description: This facility is located at the northwest corner of S.W. Canyon Rd - OR8 (Hwy 29) and SW Benz Park Drive.

2. Facility Contact Information

Contact the Engineer of Record, Region Technical Center, or Geo-Environmental's Senior Hydraulics Engineer for:

- Operational clarification
- Maintenance clarification
- Repair or restoration assistance

Engineering Contacts:

Region Technical Center Hydro Unit Manager

Or

Geo-Environmental Senior Hydraulics Engineer (503) 986-3365.

3. Construction

Engineer of Record: ODOT Designer – Region 2 Tech. Center, Elaine Kuehn, John Marks, 503-986-2990

Facility construction: October 1997
Contractor: N/A

4. Storm Drain System and Facility Overview

A water quality extended detention dry pond is a basin that is designed to detain stormwater for a sufficient time to allow particles and attached pollutants to settle. The outlet control structure limits the rate of runoff

leaving the pond by using an orifice. These facilities are designed to completely drain over a 48 hour period. The size of these facilities depends on the location and the amount of contributing impervious area.

This facility is located at the northwest corner of S.W. Canyon Rd - OR8 (Hwy 29) and SW Benz Park Drive in southwest Portland, Oregon.

A high-low split flow manhole is located northeast of the pond and is used to bypass the low flows for water quality treatment into the pond. The high flows are directed into the conveyance line on S.W. Canyon Rd -US8 (Hwy 29) and do not receive treatment. The facility consists of water quality storage, freeboard storage, a 12-inch inlet pipe, and an outlet control structure.

Untreated lower stormwater flows are first directed to a water quality manhole for pretreatment. After the water quality manhole the flow is directed into the pond. Treated water from this pond discharges into an 18-inch diameter conveyance system within S.W. Canyon Rd.

The drainage basin area for the extended dry pond includes S.W. Canyon Rd northeast of the pond towards US26 (Hwy 047).

A. Maintenance equipment access:

Access to the facility can be obtained from S.W. Benz Park; see Point E and F on the Operational Plan and Photo 2. As a side note: The current access into the facility is the emergency spillway—the designed access is vegetated over.

B. Heavy equipment access into facility:

- Allowed (no limitations)
- Allowed (with limitations)
- Not allowed

C. Special Features:

- Amended Soils
- Porous Pavers
- Liners
- Underdrains



Photo 1: Outlet control structure for extended dry detention pond facility. Primary inlet appears plugged and is in need of maintenance.



Photo 2: Extended dry detention pond. Vegetation surrounds the perimeter. Outlet structure is located to the right. Foreground shows the access from S.W. Benz Park Dr.

5. Facility Haz Mat Spill Feature(s)

The water quality extended dry detention pond can be used to store a volume of liquid by blocking the 18-inch diameter outlet pipe located at the outlet control structure. This pipe is noted as Point B on the Operational Plan, Appendix A. Covering the inlet grates with sandbags or a steel plate may help accomplish this task.

6. Auxiliary Outlet (High Flow Bypass)

Auxiliary Outlets are provided if the primary outlet control structure can not safely pass the projected high flows. Broad-crested spillway weirs and over flow risers are the two most common auxiliary outlets used in stormwater treatment facility design. The auxiliary outlet feature is either a part of the facility or an additional storm drain feature/structure.

The auxiliary outlet feature for this facility is:

Designed into facility

A secondary auxiliary inlet/outlet grated catch basin has been designed as part of the facility's outlet control structure, and acts as an emergency overflow in the event the primary outlet control device is plugged.

Before flows ever reach the higher level of the secondary inlet/outlet device, however, they are typically released through a primary inlet/outlet grated catch basin located below the secondary device. If runoff should ever exceed the water quality event, where flows normally are directed to the lower primary outlet, the pond level will rise and flows will be released through the secondary auxiliary inlet/outlet device located just above the primary outlet.

Other, as noted below

7. Maintenance Requirements

Routine maintenance tables for non-proprietary stormwater treatment and storage/detention facilities have been incorporated into ODOT's Maintenance Guide. These tables summarize the maintenance requirements for ponds, swales, filter strips, bioslopes, and detention tanks and vaults. Special maintenance requirements in addition to the routine requirements are noted below when applicable.

The ODOT Maintenance Guide can be viewed at the following website:

<http://www.oregon.gov/ODOT/HWY/OOM/MGuide.shtml>

Maintenance requirements for proprietary structures, such as underground water quality manholes and/or vaults with filter media are noted in Appendix C when applicable.

The following stormwater facility maintenance table (See ODOT Maintenance Guide) should be used to maintain the facility outlined in this Operation and Maintenance Manual or follow the Maintenance requirements outlined in Appendix C when proprietary structure is selected below:

- Table 1 (general maintenance)
- Table 2 (stormwater ponds)
- Table 3 (water quality or biofiltration swales)
- Table 4 (water quality filter strips)
- Table 5 (water quality bioslopes)
- Table 6 (detention tank)
- Table 7 (detention vault)
- Appendix C (proprietary structure)
- Special Maintenance requirements:

Note: Special maintenance Requirements Require Concurrence from ODOT SR Hydraulics Engineer.

8. Waste Material Handling

Material removed from the facility is defined as waste by DEQ. Refer to the roadwaste section of the ODOT Maintenance Yard Environmental Management System (EMS) Policy and Procedures Manual for disposal options: <http://egov.oregon.gov/ODOT/HWY/OOM/EMS.shtml>


Contact any of the following for more detailed information about management of waste materials found on site:

ODOT Clean Water Unit	(503) 986-3008
ODOT Statewide Hazmat Coordinator	(503) 229-5129
ODOT Region Hazmat Coordinator	(503) 731-8304
ODEQ Northwest Region Office	(503) 229-5263


Appendix A

Content:


- **Operational Plan and Profile Drawing(s)**

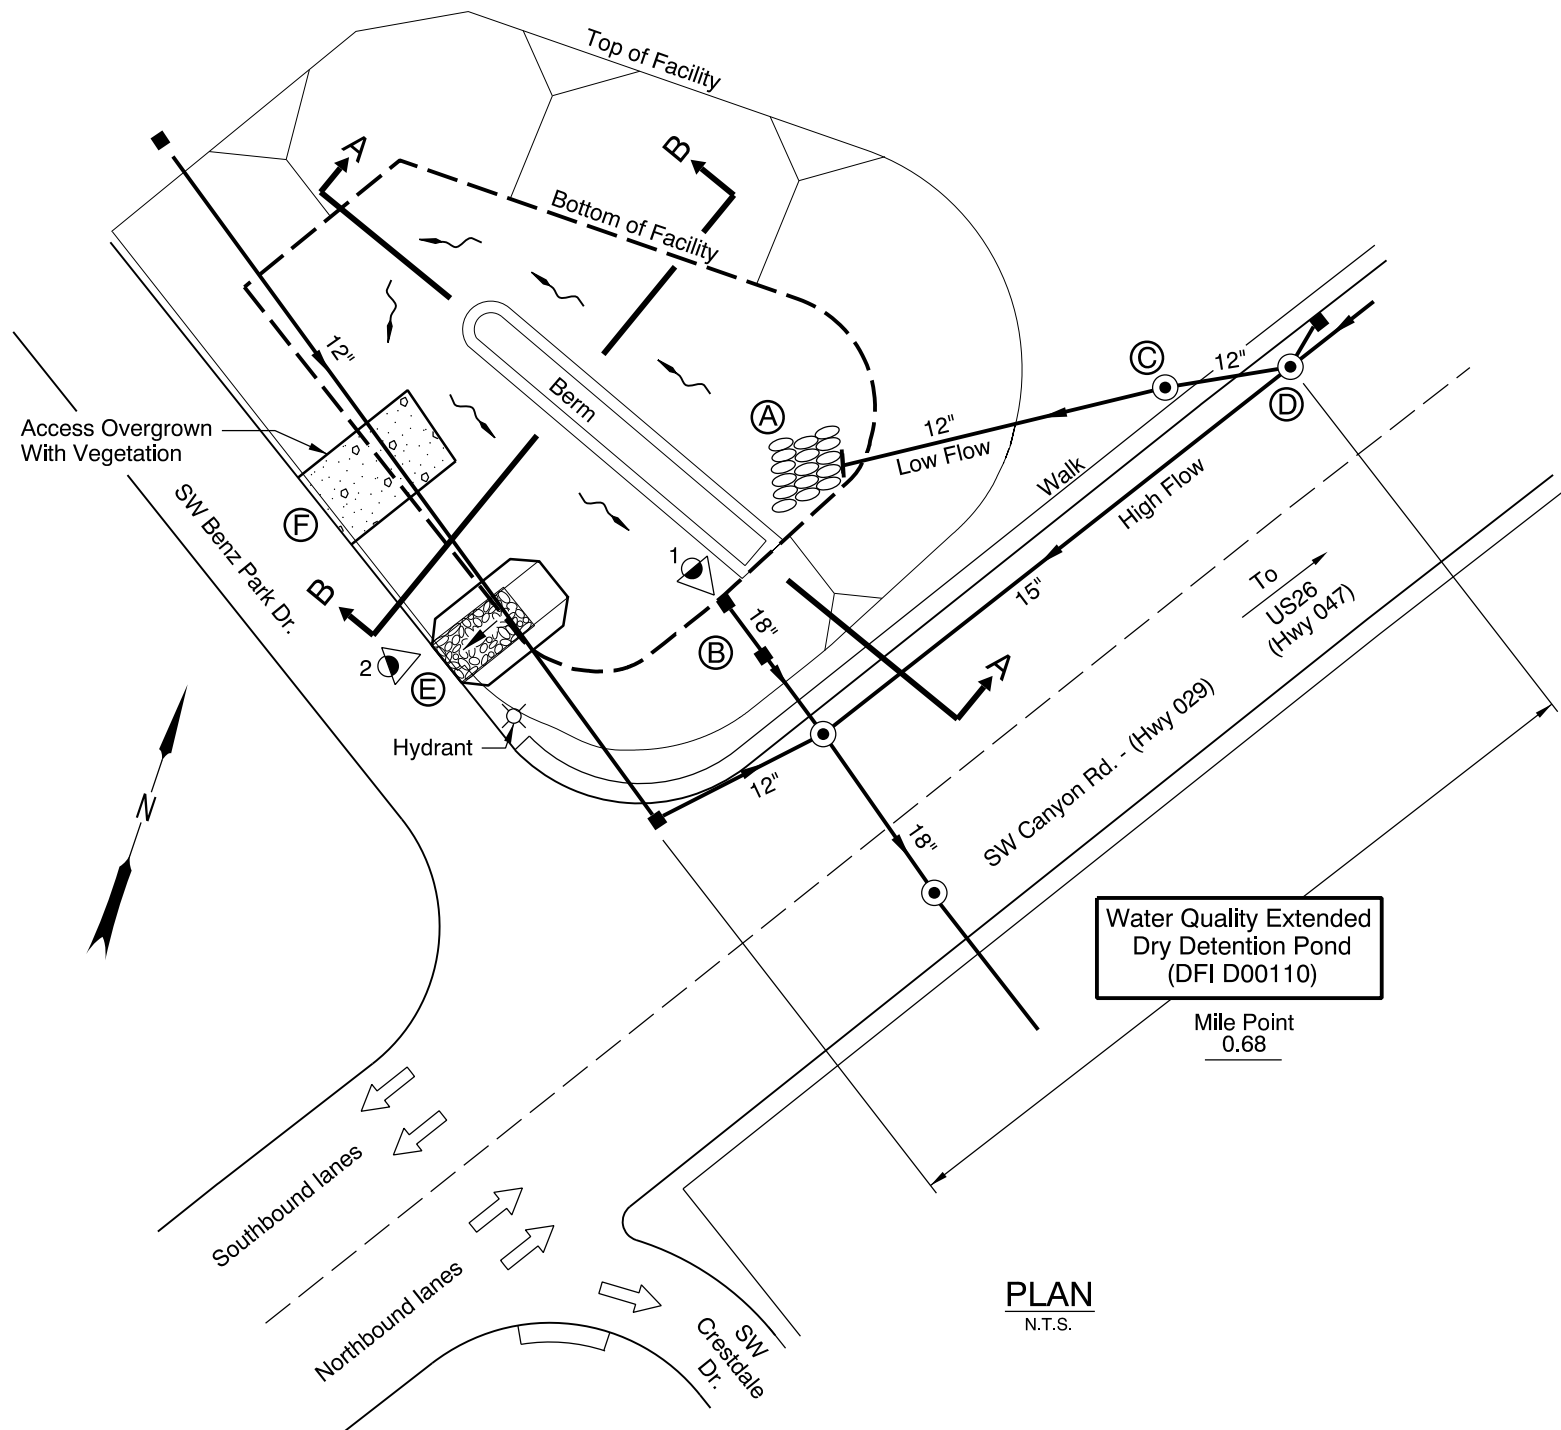

PLAN
N.T.S.

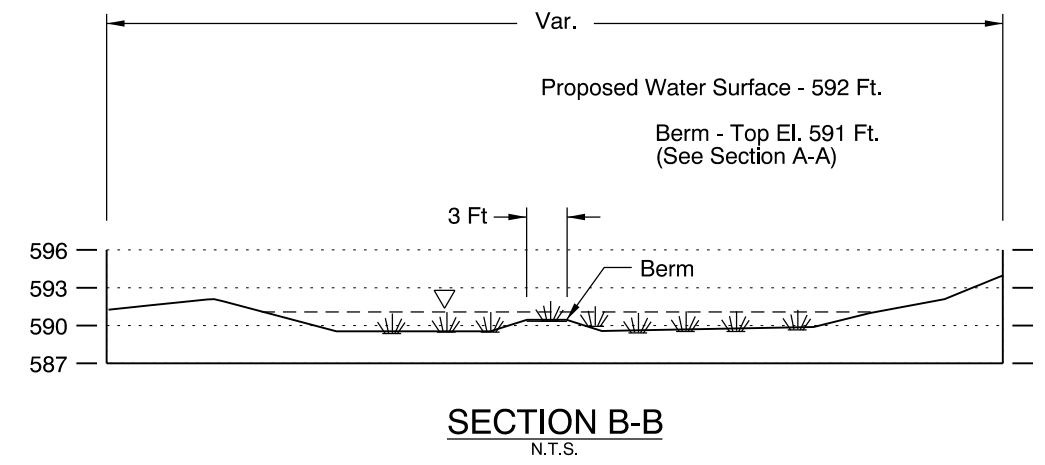

SECTION B-B
N.T.S.

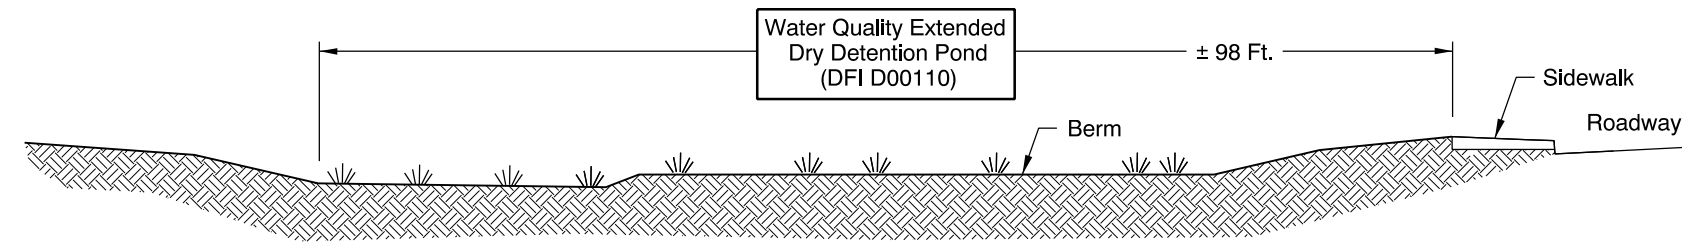

SECTION A-A
N.T.S.

LEGEND:

- ◁ Photo Location / Direction
- ⊙ Inlet, 12" Dia.
- ⊙ Outlet Control Structure
- ⊙ Pollution Control Manhole
- ⊙ High/Low Split Flow Manhole
- ⊙ Spillway
- ⊙ Access Road
- ⊙ and ⊙ Manhole
- and □ Inlet
- Storm Pipe (Facility)
- Storm Pipe
- Conveyance Direction
- ~ Pavement / Facility Flow Path


Sht. 1 of 2

OREGON DEPARTMENT OF TRANSPORTATION

Prepared By:
Bob Knorr


Drafted By:
Jim Holeman

DFI D00110
MAINTENANCE DISTRICT 2B HWY 29
WATER QUALITY EXTENDED DRY DETENTION POND
TUALATIN VALLEY HWY 29 MP 0.68
WASHINGTON COUNTY

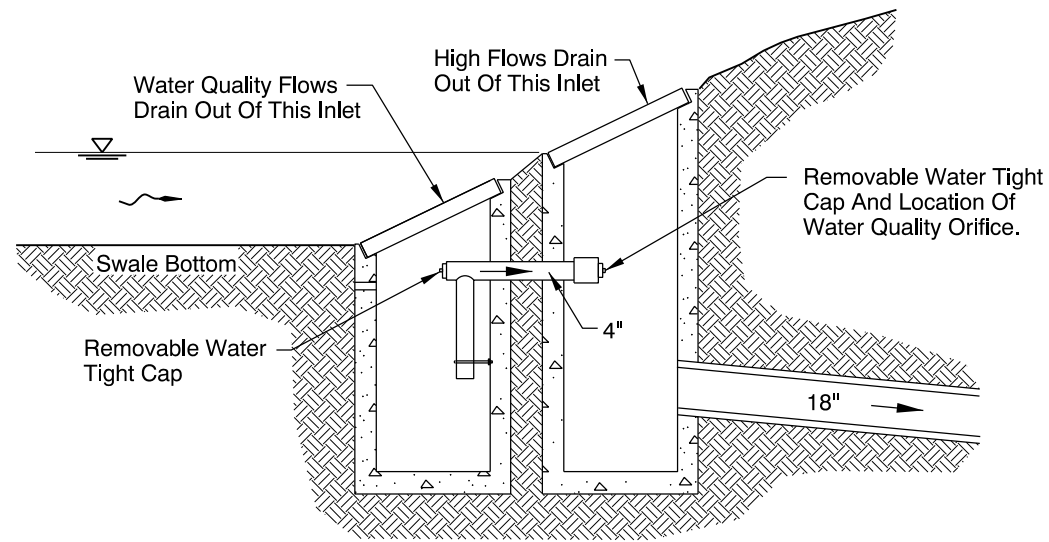

OUTLET CONTROL STRUCTURE DETAIL AT POINT ③

N.T.S.

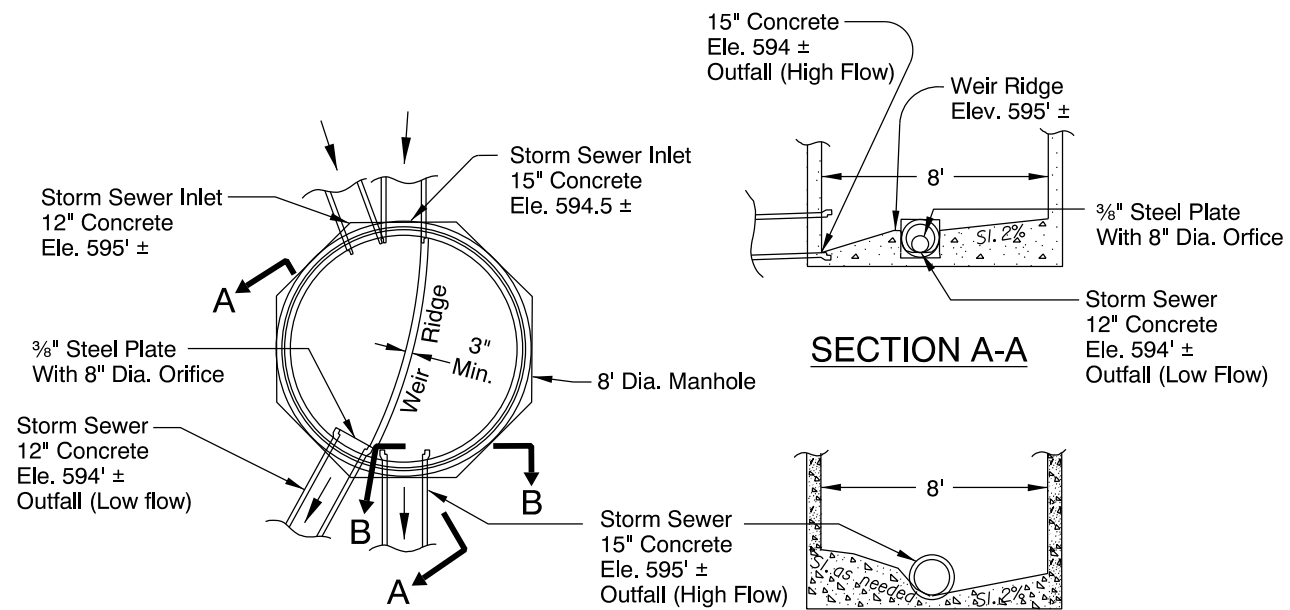

PLAN

SECTION B-B

SPLIT FLOW MANHOLE DETAIL AT POINT ④

N.T.S.

Sht. 2 of 2

 OREGON DEPARTMENT OF TRANSPORTATION

Prepared By:
Bob Knorr

Drafted By:
Jim Holeman

DFI D00110
MAINTENANCE DISTRICT 2B HWY 29
WATER QUALITY EXTENDED DRY DETENTION POND
TUALATIN VALLEY HWY 29 MP 0.68
WASHINGTON COUNTY

Appendix B

Content:

- **ODOT Project Plan Sheets**
 - *Cover/Title Sheet*
 - *Water Quality/Detention Plan Sheets*
 - *Other Details*


INDEX OF SHEETS	
SHEET NO.	DESCRIPTION
1	Title Sheet
1A	Index Of Sheets Cont'd.
1A-2	Index Of Sheets Cont'd.
1A-3	Standard Drawing Nos.
1B	Signature Sheet
1C	Sheet Layout
2, 2A,	
2A-2 Thru	Typical Sections
2A-20 Incl.	
2B Thru	Details
2B-22 Incl.	
2C Thru	Traffic Control Plans
2C-103 Incl.	
2D	Disposal Site
2E Thru	Water Quality Plans
2E-8 Incl.	
2F Thru	Erosion Control Plans
2F-17 Incl.	
2G Thru	Pipe Data
2G-10 Incl.	
2H Thru	Summary
2H-14 Incl.	
3	All Construction Items & Notes, RW
3A	Profile
4	Alignment
4-RW	Right of Way
4A, 4A-2	General Construction Plans
4B, 4B-2	Drainage Plans
4C	Alignment
4C-RW	Right of Way
4D, 4D-2	General Construction Plans
4E, 4E-2	Drainage Plans
4F	Alignment
4F-RW	Right of Way
4G, 4G-2	General Construction Plans
4H, 4H-2, 4I	Drainage Plans
4J-RW	Right of Way
4K, 4L, 4M, 4N,	Profiles
4P, 4Q, 4R, 4S,	
4T, 4U, 4V, 4W	
5	Alignment
5-RW	Right of Way
5A, 5A-2	General Construction Plans
5B, 5B-2	Drainage Plans
5C, 5D, 5E,	Profiles
5F, 5G	
6	Alignment
6-RW	Right of Way
6A, 6A-2	General Construction Plans
6B, 6B-2	Drainage Plans
6C, 6D, 6E,	Profiles
6F, 6G, 6H	
7	Alignment
7-RW	Right of Way
7A, 7A-2	General Construction Plans
7B, 7B-2	Drainage Plans

STATE OF OREGON
DEPARTMENT OF TRANSPORTATION

PLANS FOR PROPOSED PROJECT

GRADING, STRUCTURES, PAVING, SIGNING, ILLUMINATION, SIGNALS,
LANDSCAPING, UTILITY RELOCATIONS, & DEBRIS FILL REMOVAL

**CAMELOT INTCHGE. -
SYLVAN INTCHGE. (PHASE 1) SEC.
SUNSET HIGHWAY
MULTNOMAH & WASHINGTON COUNTIES
OCTOBER 1997**

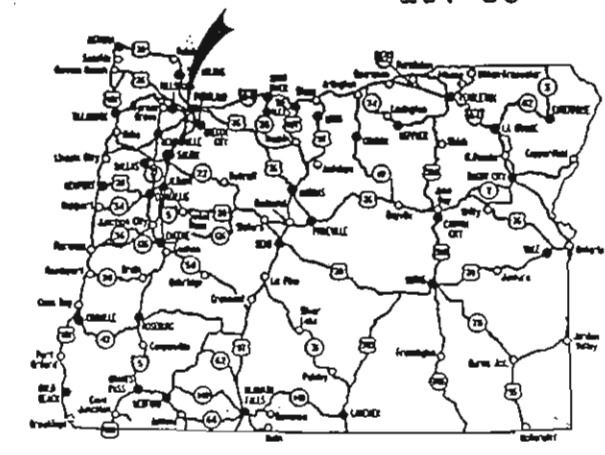


Overall Length Of Project - 1.545 km (0.96 Mile)

"AS CONSTRUCTED"
D. J. Edmundson
Project Manager
JAN 17 02
Date

ATTENTION :
Oregon Law Requires You To Follow Rules
Adopted By The Oregon Utility Notification Center.
Those Rules Are Set Forth In OAR 952-001-0010 Through
OAR 952-001-0090. You May Obtain Copies Of The Rules From The Center.

LET'S ALL
WORK TOGETHER
TO MAKE THIS
JOB SAFE

09-SEP-95

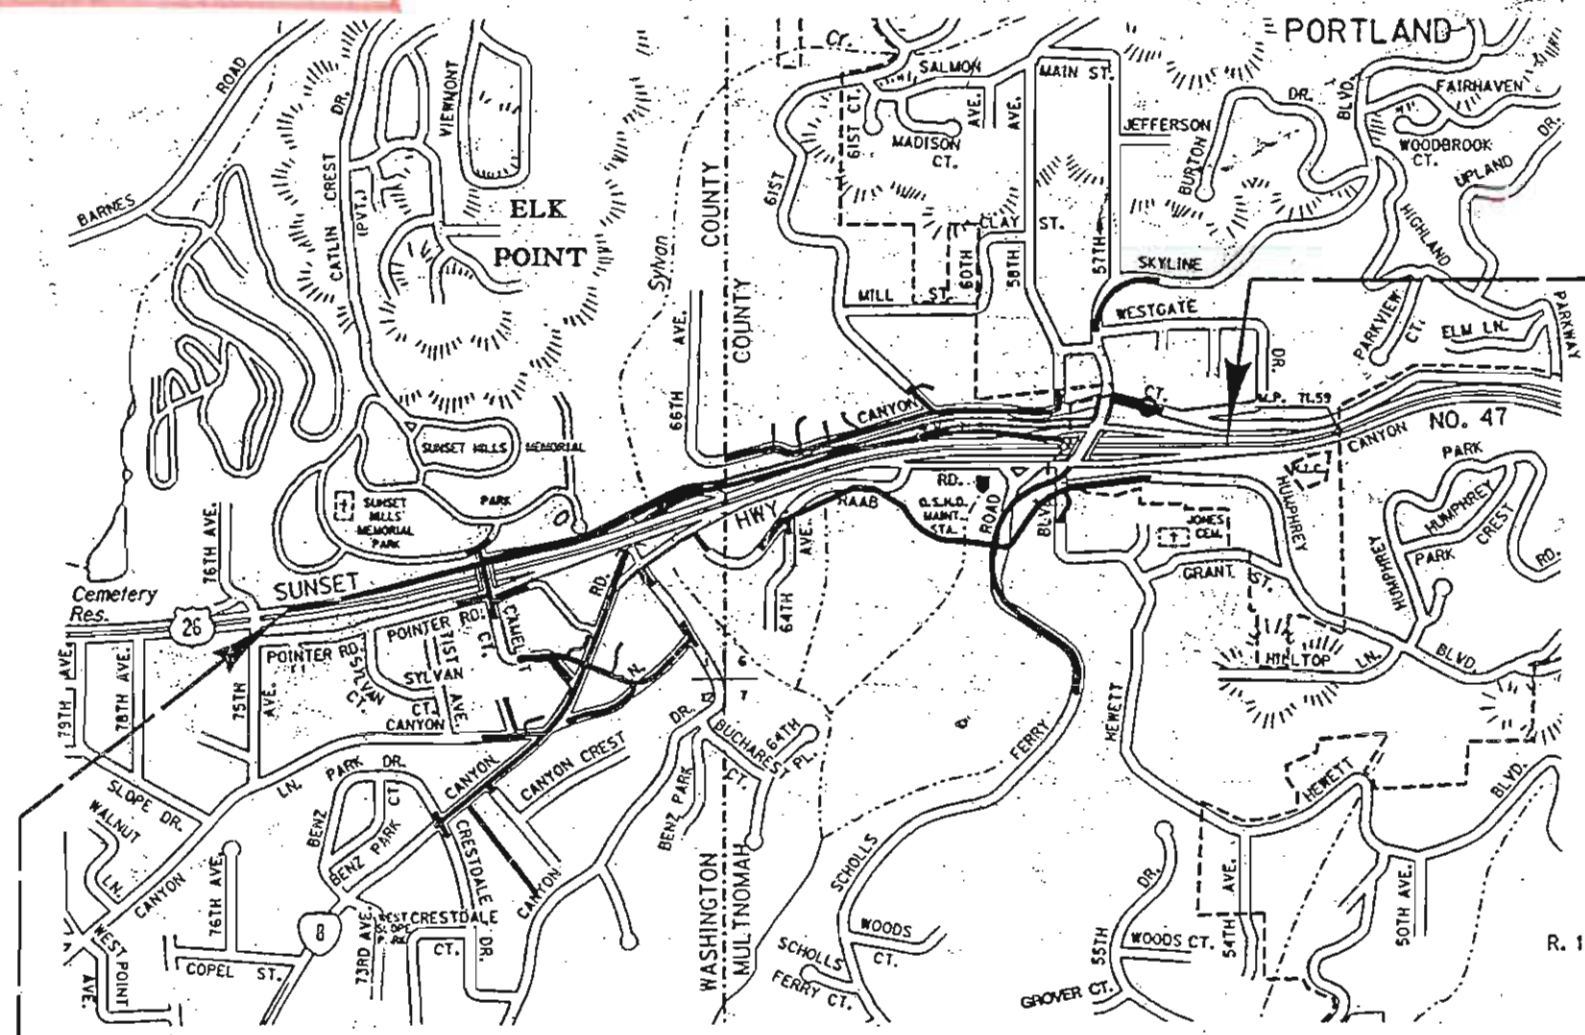

**STP-MASTP-S047(23)
END OF PROJECT
STA. "L" 100 + 864.334 (M.P. 71.41)**

OREGON TRANSPORTATION COMMISSION
 Harry H. Hewitt CHAIRMAN
 Susan Brody VICE CHAIRMAN
 Steven H. Corey COMMISSIONER
 Stuart Foster COMMISSIONER
 John Russell COMMISSIONER
 Grace Crunican DIRECTOR OF TRANSPORTATION



Thomas D. Luay
TECHNICAL SERVICES MANAGING ENGINEER

T. I. S.,
R. I. W., I. E., W. M.

**STP-MASTP-S047(23)
BEGINNING OF PROJECT
STA. "L" 99 + 319.000 (M.P. 70.45)**

CAMELOT INTCHGE. - SYLVAN INTCHGE. (PHASE 1) SEC. SUNSET HIGHWAY MULTNOMAH & WASHINGTON COUNTIES		SHEET NO. 1
FEDERAL HIGHWAY ADMINISTRATION	PROJECT NUMBER STP-S047(23)	
REGION 10	OREGON DIVISION	


DRAINAGE DETAIL

29V-50



BENZ PARK OUTFALL FROM STA "CR" ~~50+046.87, 20.13 LT.~~ ~~50+047.04, 19.66 LT.~~ (Benz Park Water Quality Facility)

(See Plan Shts. 4H, 4J And Profile Sht. 4S)

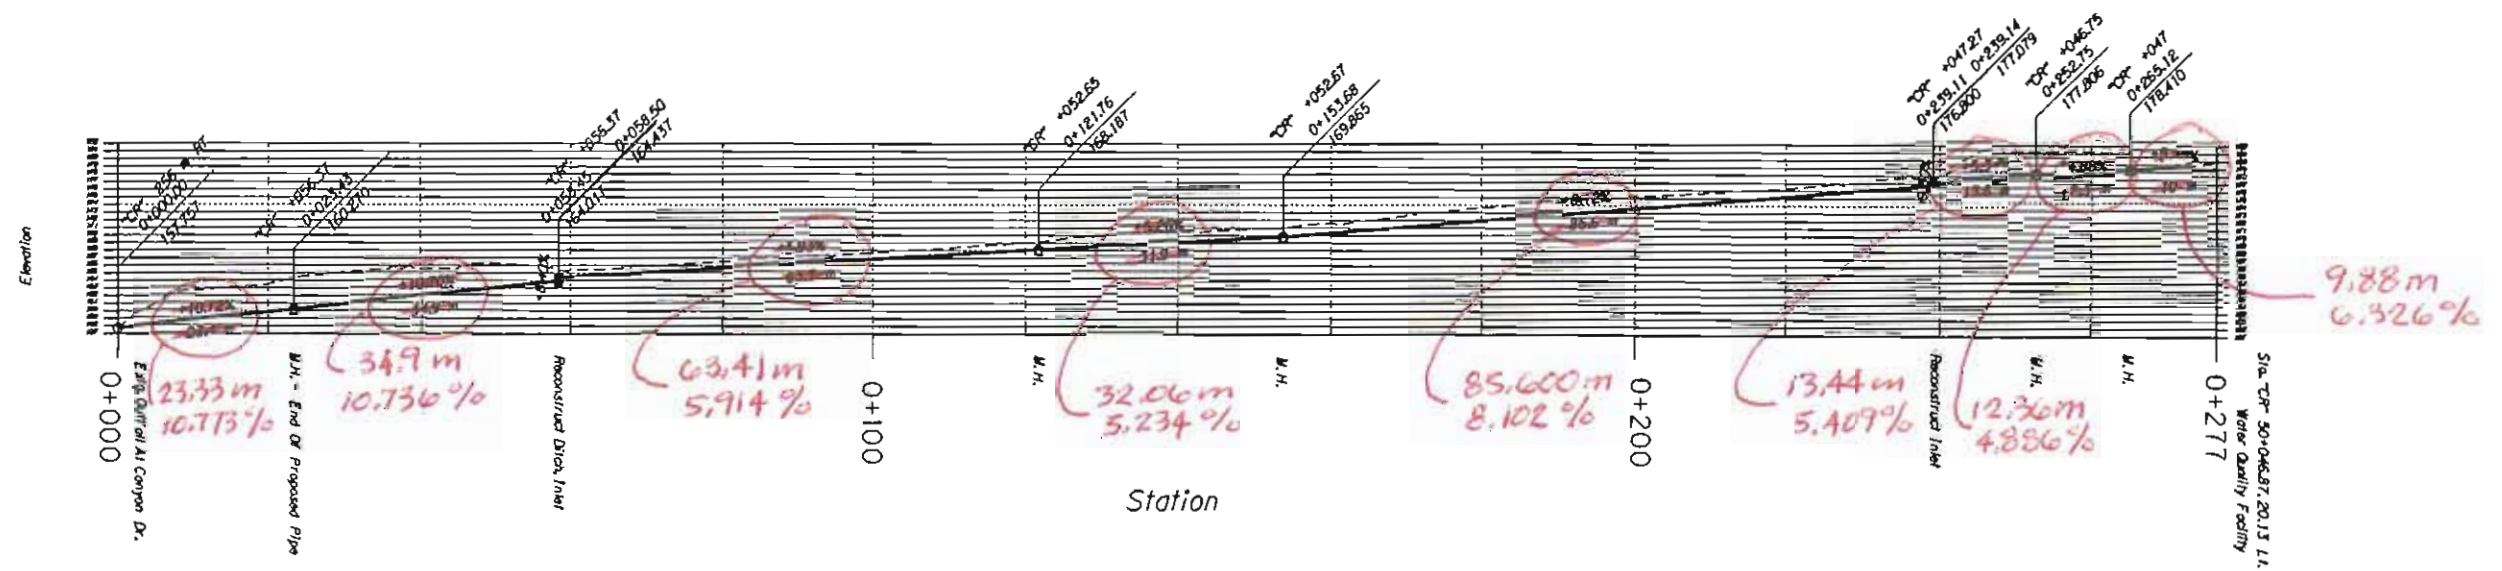

"AS CONSTRUCTED"
Bill Johnson
Project Manager
JAN 17 2012
Date


CAMELOT INTCHGE. - SYLVAN INTCHGE. (PHASE 1) SEC. SUNSET HIGHWAY MULTNOMAH & WASHINGTON COUNTIES		
FEDERAL HIGHWAY ADMINISTRATION	PROJECT NUMBER	SHEET NO.
REGION 10	OREGON DIVISION	2B-18

C:\PROJECTS\060718\060718.DWG

07-SEP-1997 22:56

WATER QUALITY TREATMENT FACILITY DETAILS - BENZ PARK

29V-50

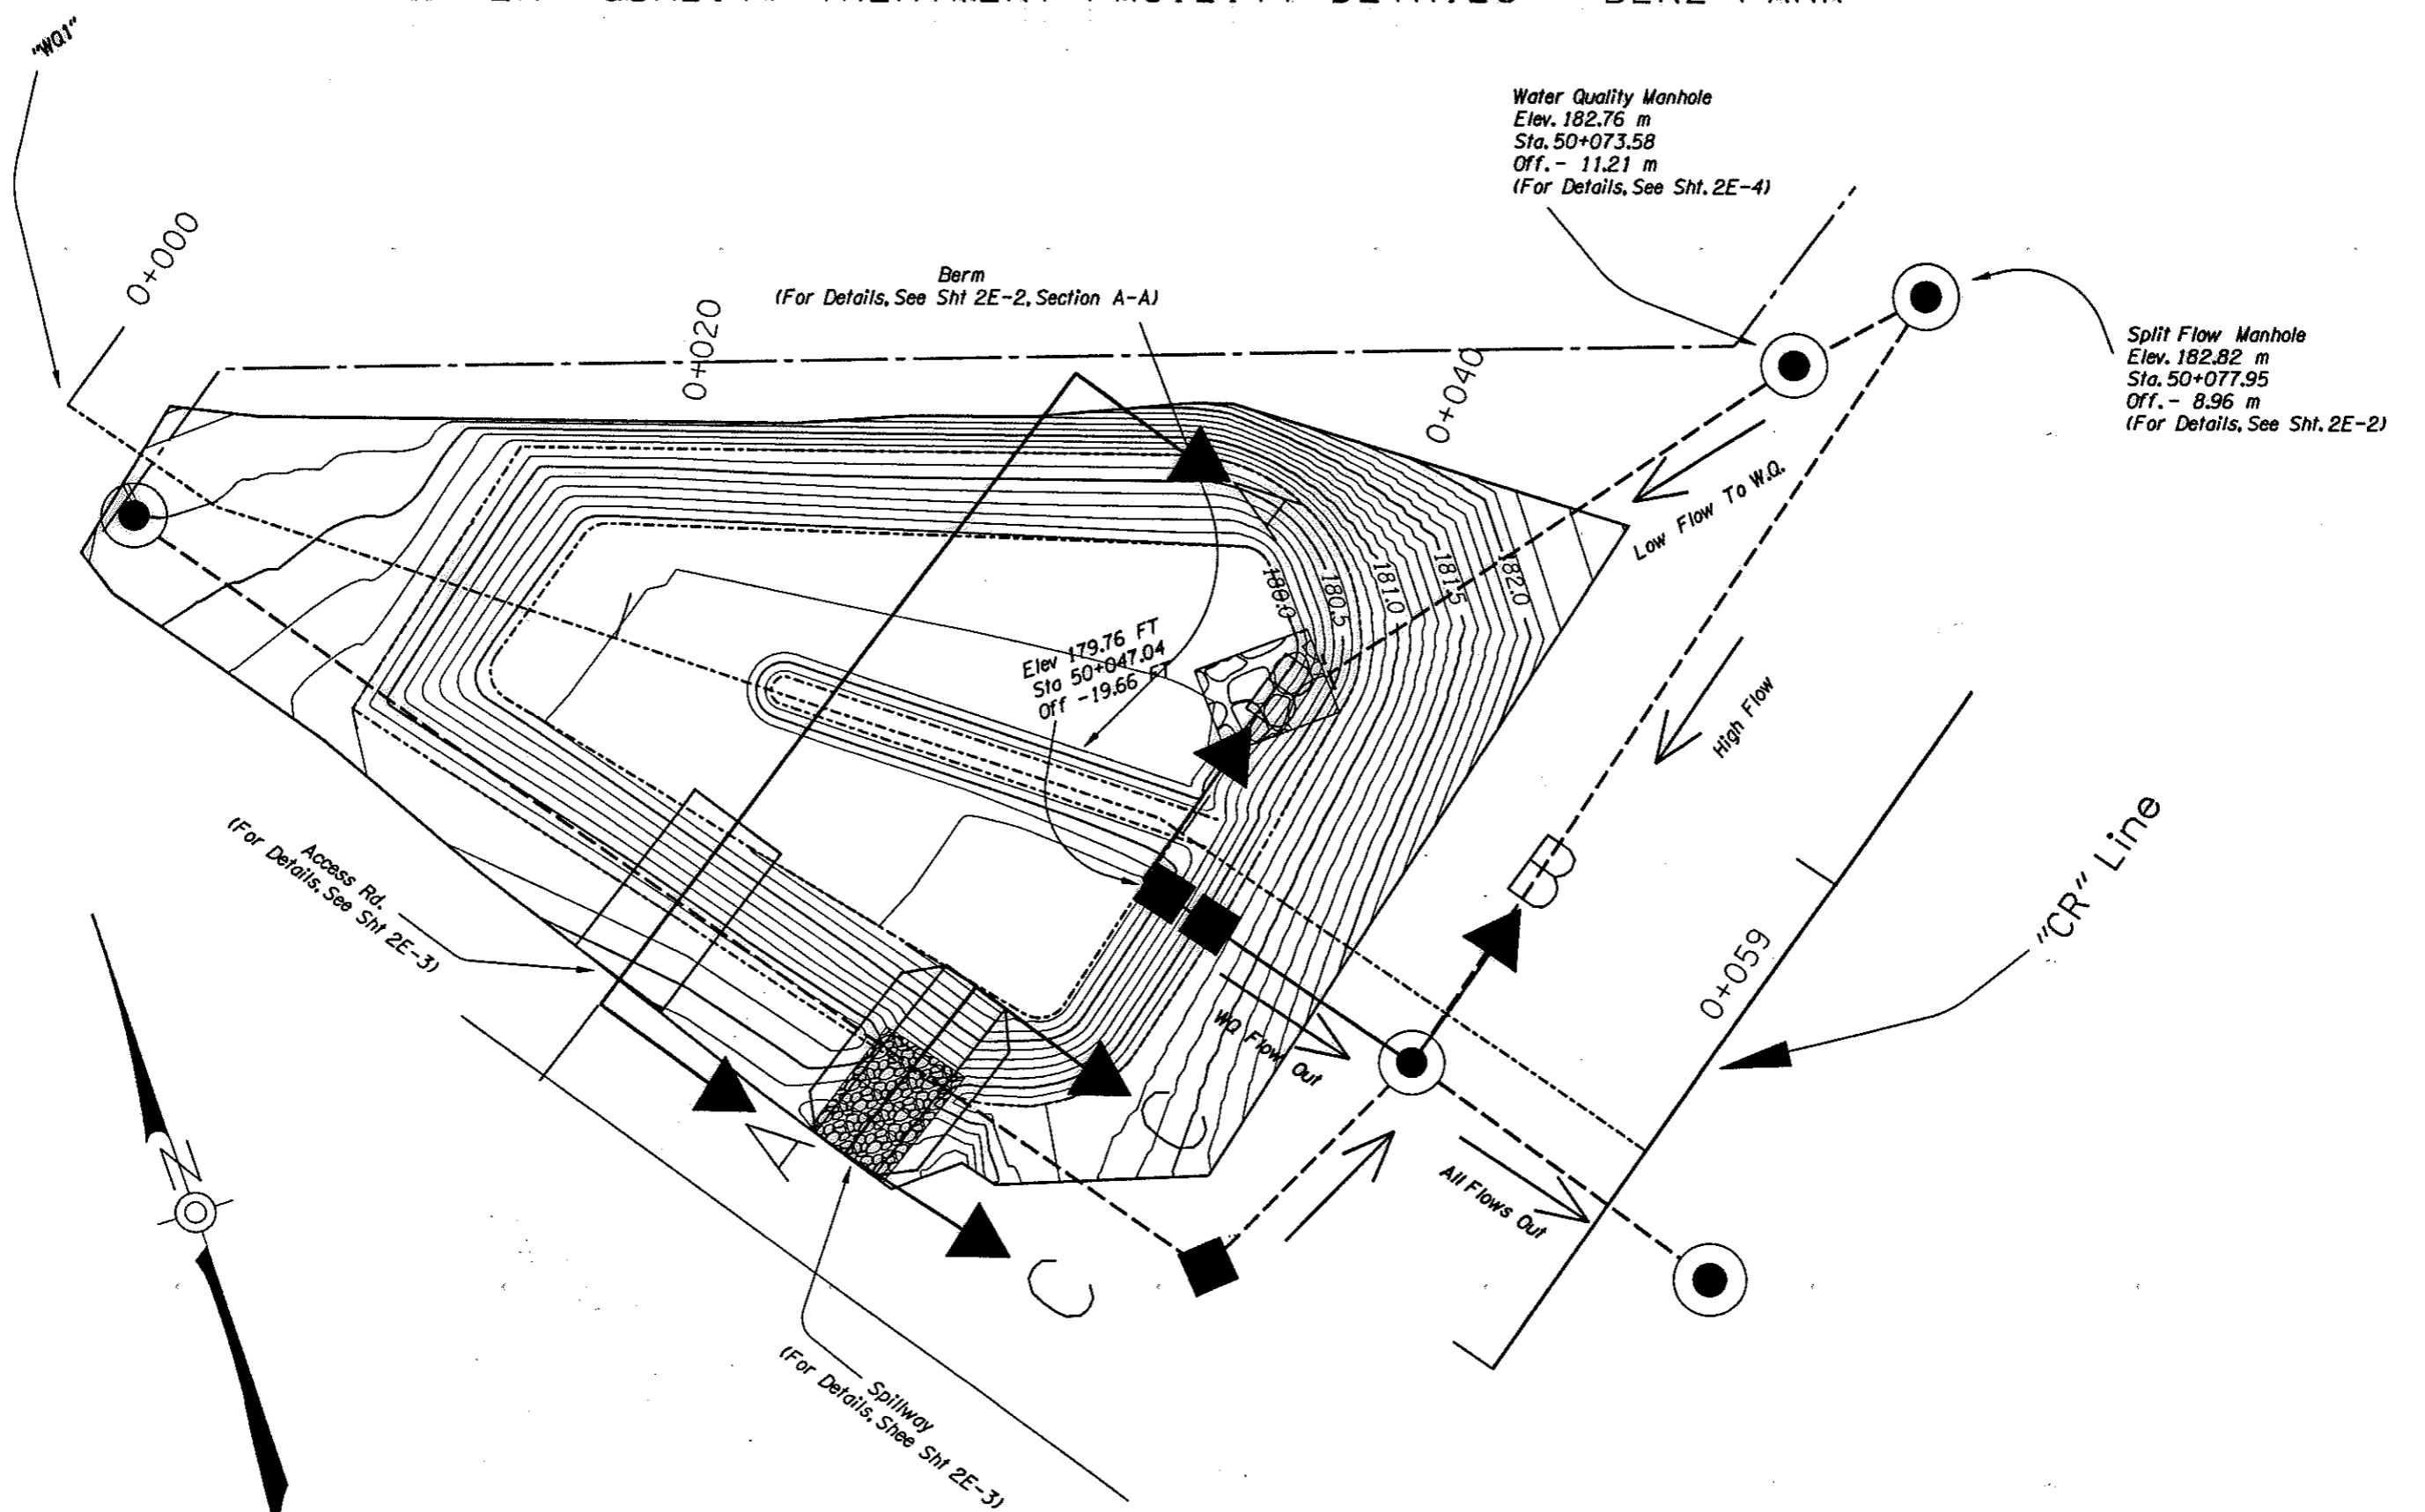



C:\SR\0505\INTCHG\CAMELOT\0507\Draws\0507T.dwg
 20-AUG-1997 11:50

VIEW 2


WATER QUALITY DETAILS		CAMELOT INTCHGE. - SYLVAN INTCHGE. (PHASE 1) SEC. SUNSET HIGHWAY MULTNOMAH & WASHINGTON COUNTIES		
	 Elaine Kuehn - Designer		FEDERAL HIGHWAY ADMINISTRATION	PROJECT NUMBER
	 Elaine Kuehn - Drafter		REGION 10	OREGON DIVISION

WATER QUALITY TREATMENT FACILITY DETAILS - BENZ PARK

29V-50

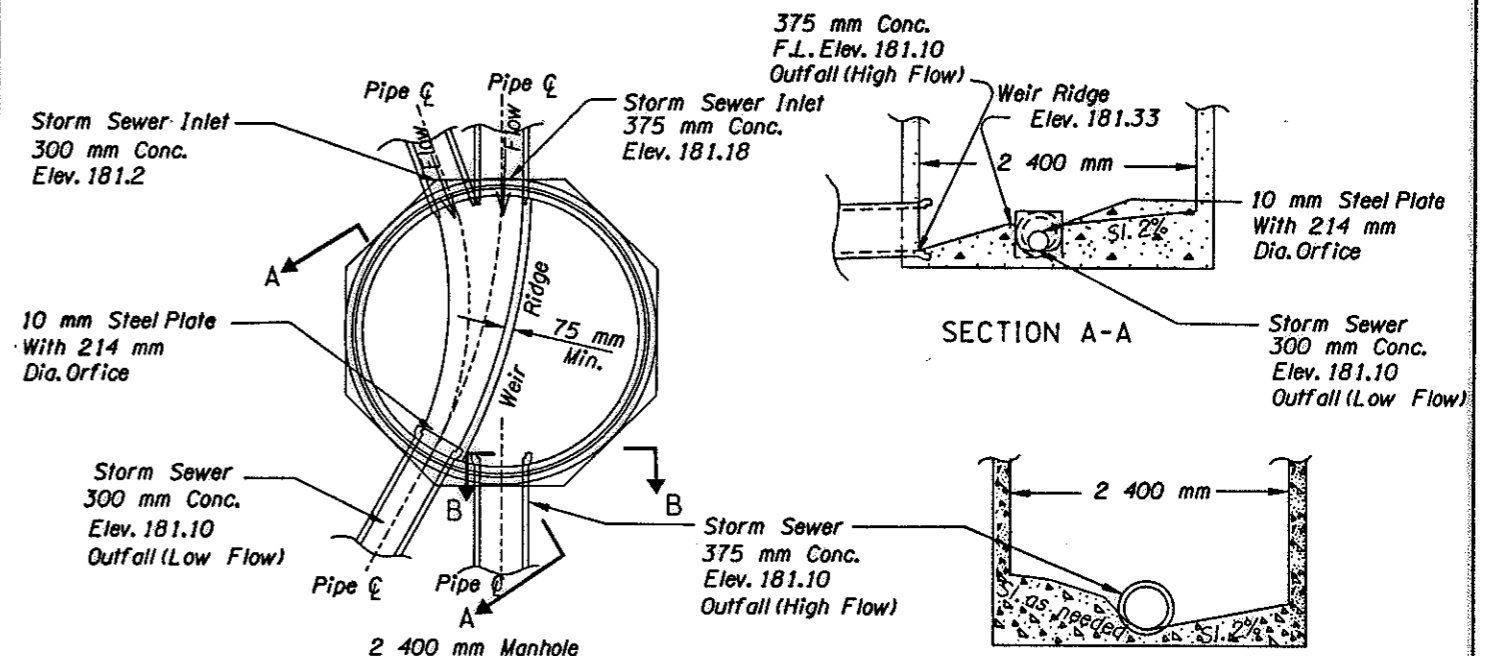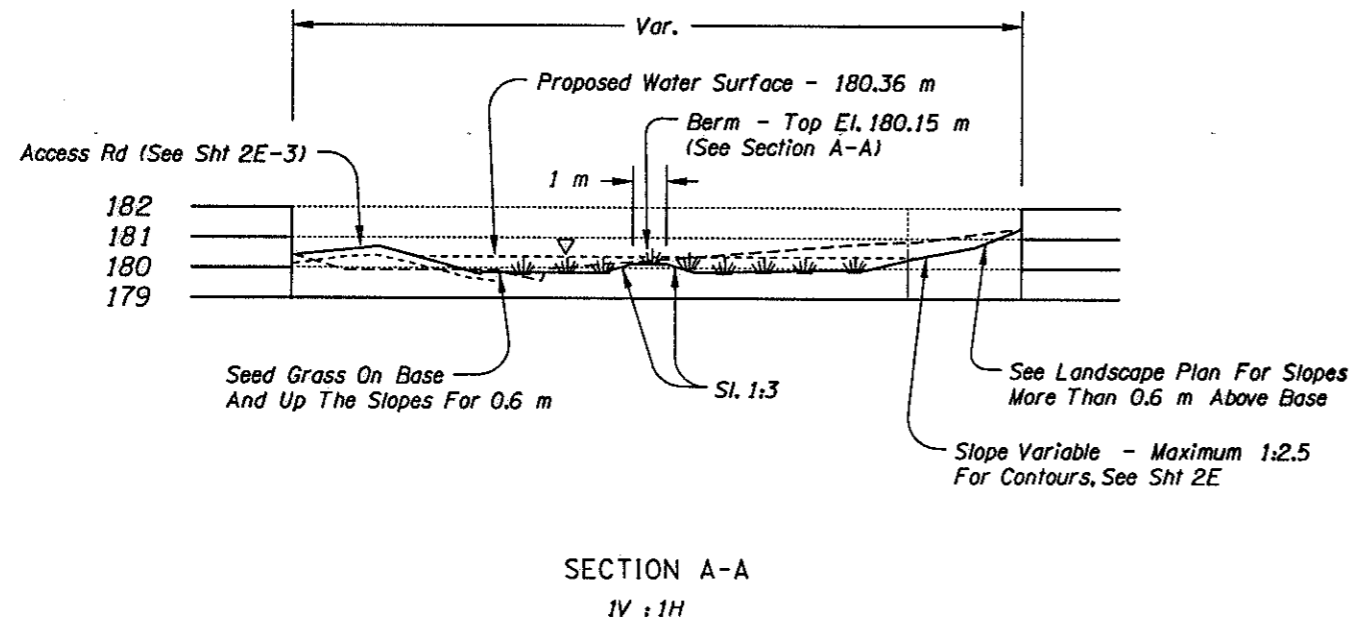

SPLIT FLOW MANHOLE
 "CR" Sta. 50+077.95, 8.96 Lt.
 (For Details Not Shown, See Drg. Nos. RD324, RD330 & RD333)

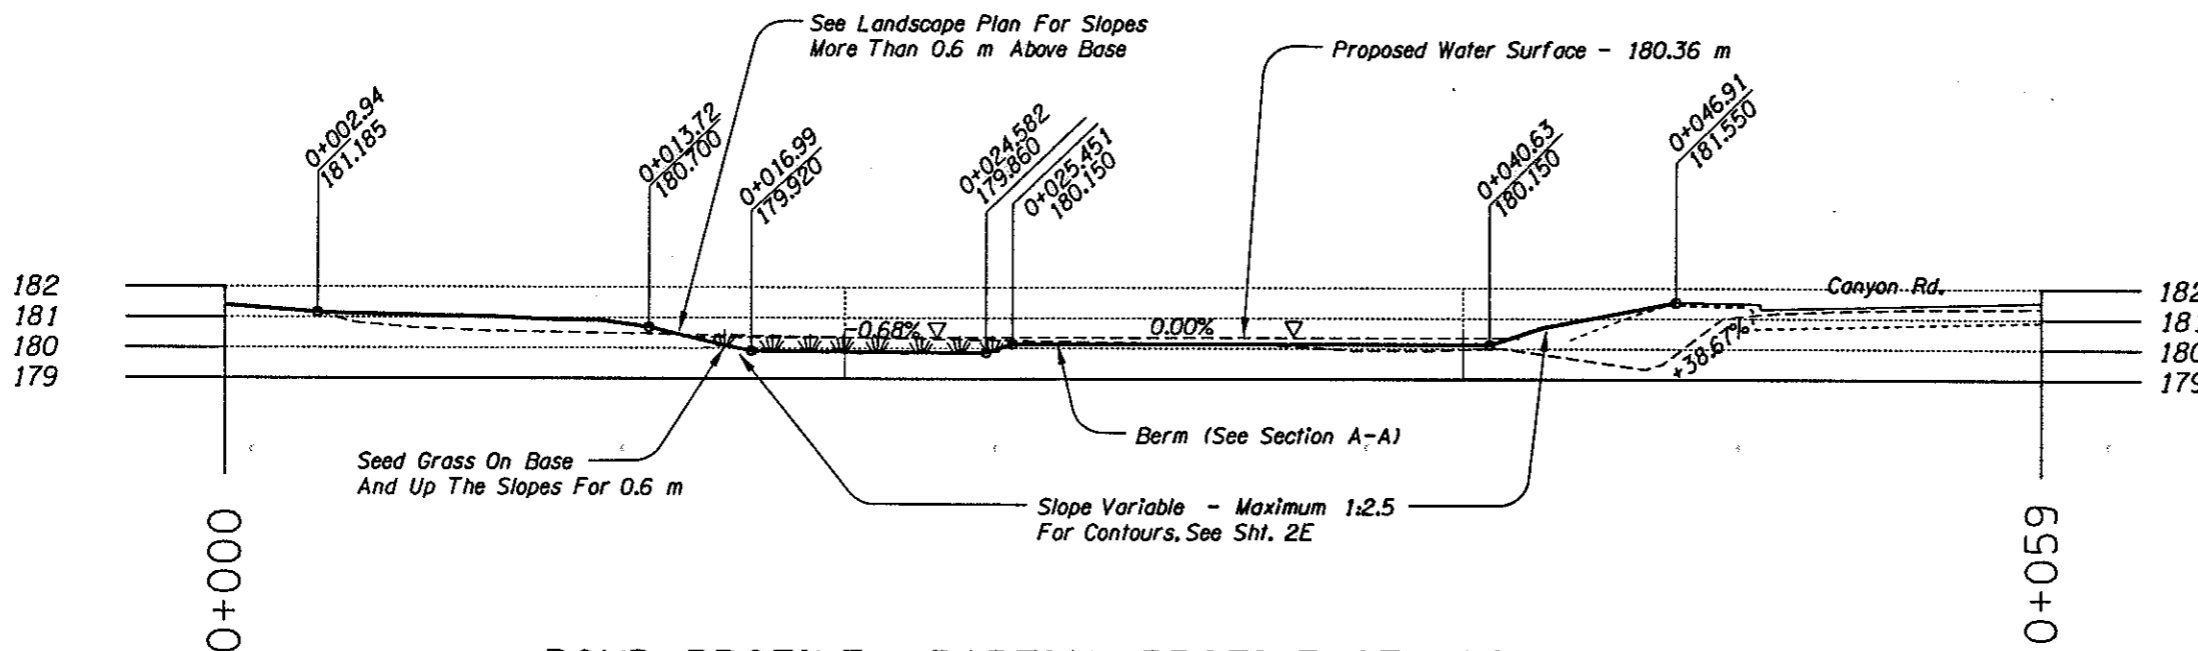

POND PROFILE : PARTIAL PROFILE OF "WQ1"

(Annotation Shows Major Transition Points In Profile For Information;
 Pond Should Be Constructed Based On Contours Shown On Sht. 2-E)

IV : 1H


CAMELOT INTCHGE. - SYLVAN INTCHGE. (PHASE 1) SEC. SUNSET HIGHWAY MULTNOMAH & WASHINGTON COUNTIES		
FEDERAL HIGHWAY ADMINISTRATION	PROJECT NUMBER	SHEET NO.
REGION 10	OREGON DIVISION	2E-2

C:\PROJECT\SUNSET\PHASE1\080712.dwg


07-SEP-1997 21:53

WATER QUALITY TREATMENT FACILITY DETAILS - BENZ PARK


29V-50

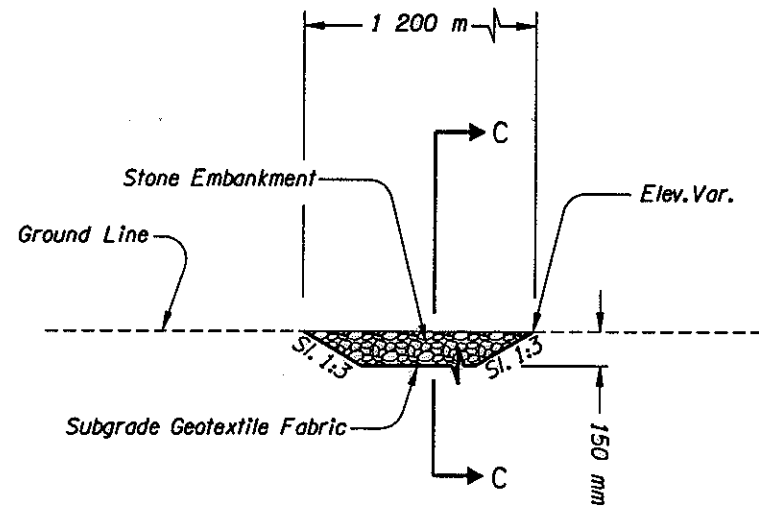


SPILLWAY

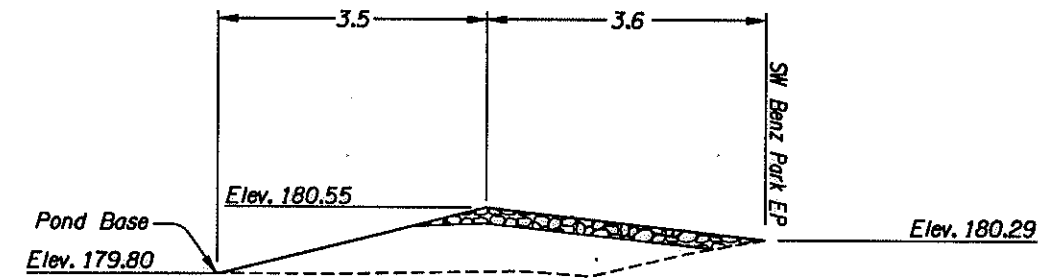

SECTION C-C
(For Location, See Sht. 2E)

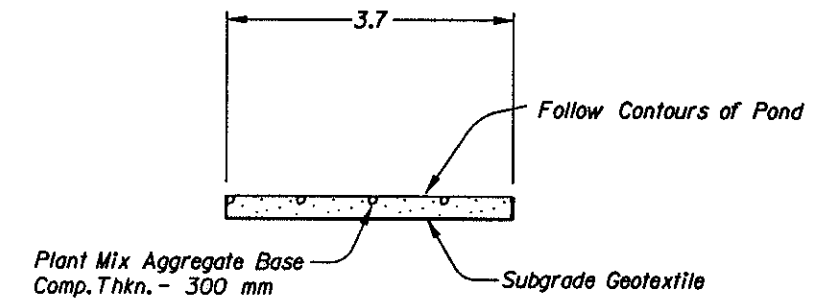

WATER QUALITY ACCESS ROAD

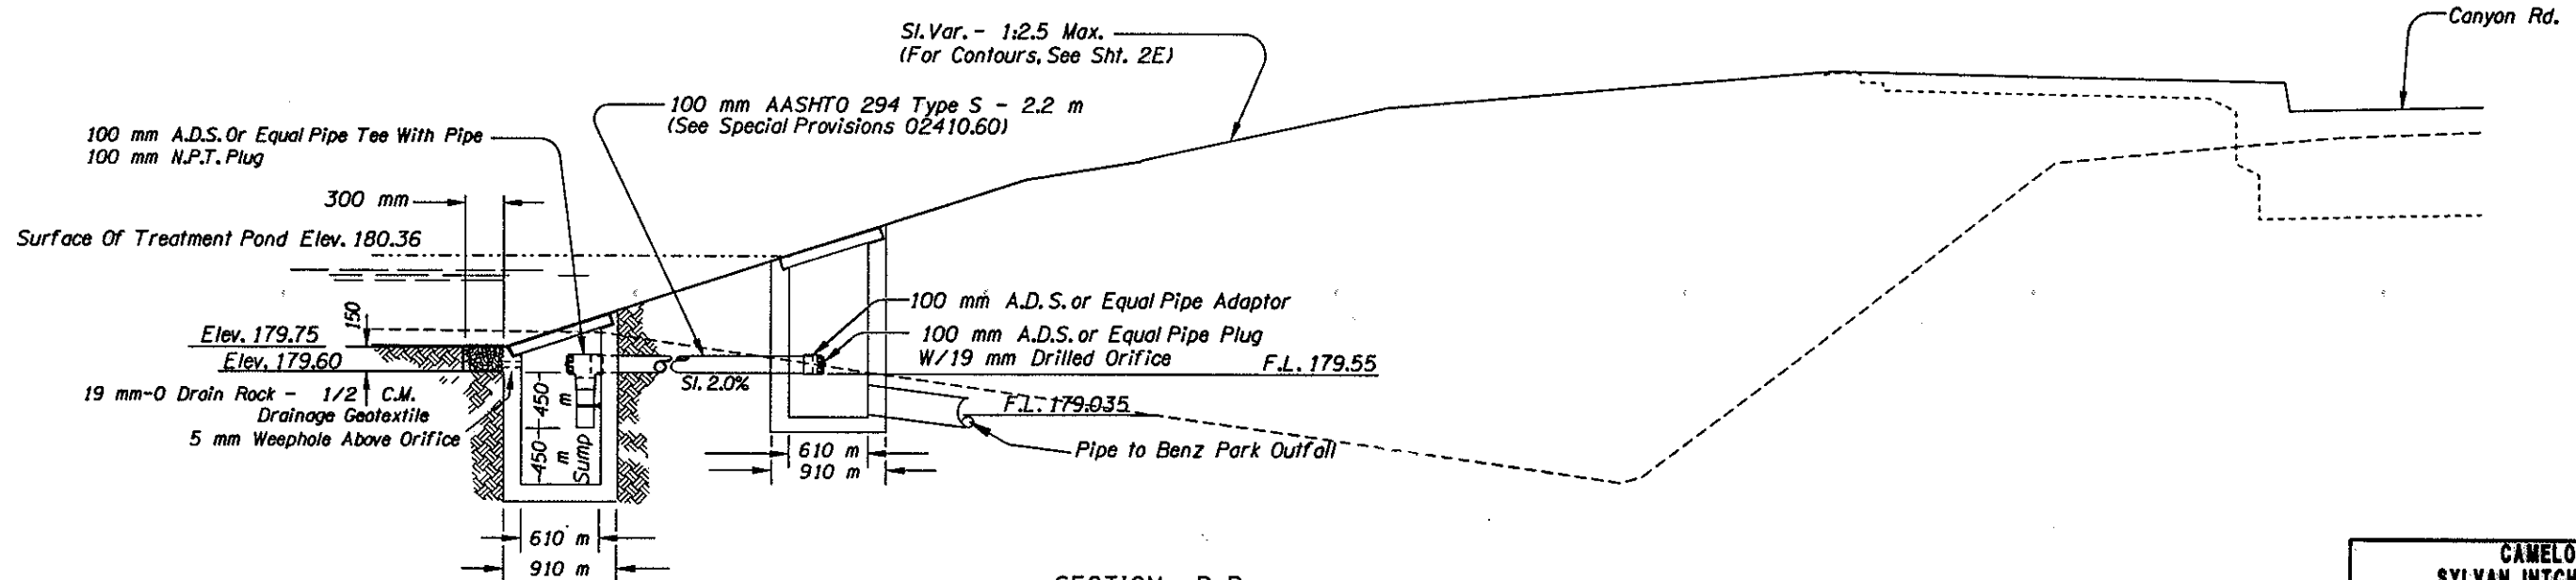

SECTION B-B


POND OUTLET STRUCTURE
(See USA Standard Drg. 150)

CAMELOT INTCHGE. - SYLVAN INTCHGE. (PHASE 1) SEC. SUNSET HIGHWAY MULTNOMAH & WASHINGTON COUNTIES		
FEDERAL HIGHWAY ADMINISTRATION	PROJECT NUMBER	SHEET NO.
REGION 10	OREGON DIVISION	2E-3


C:\USVA\PROJECT\SUB007\MAN\SUB007\02.dwg 07-SEP-1997 21:53

WATER QUALITY MANHOLE - BENZ PARK

"CR" STA. 50+073.58 11.21, LT.

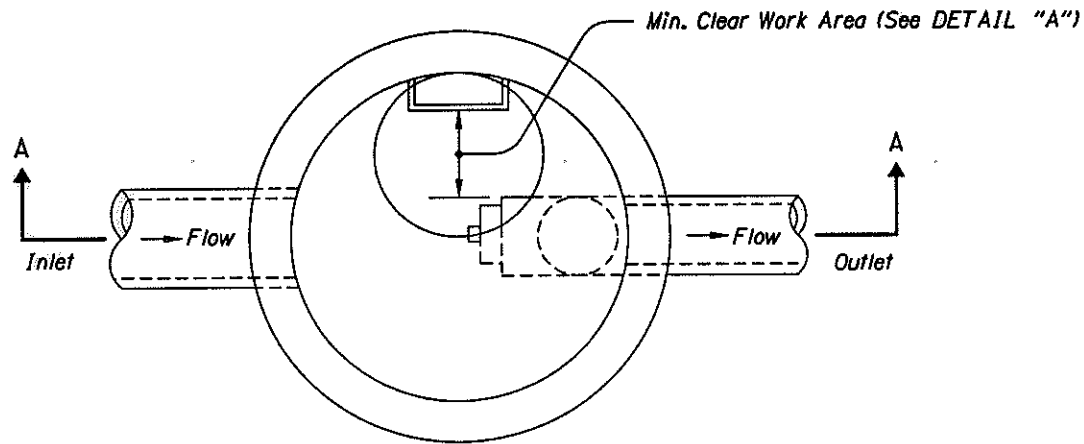


PLAN

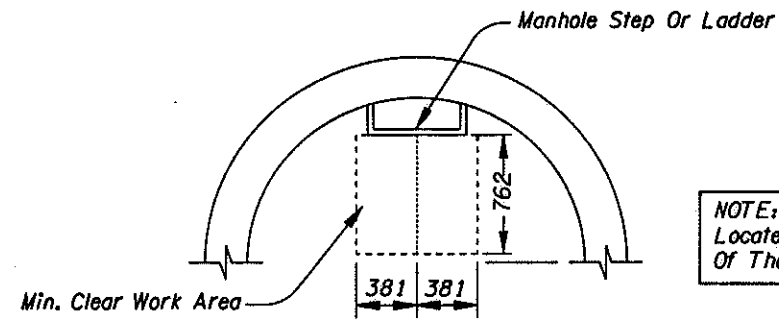

DETAIL "A"

NOTE:
Locate Pipes, Etc. So That No Portion Of Them Are Within Min. Clear Work Area

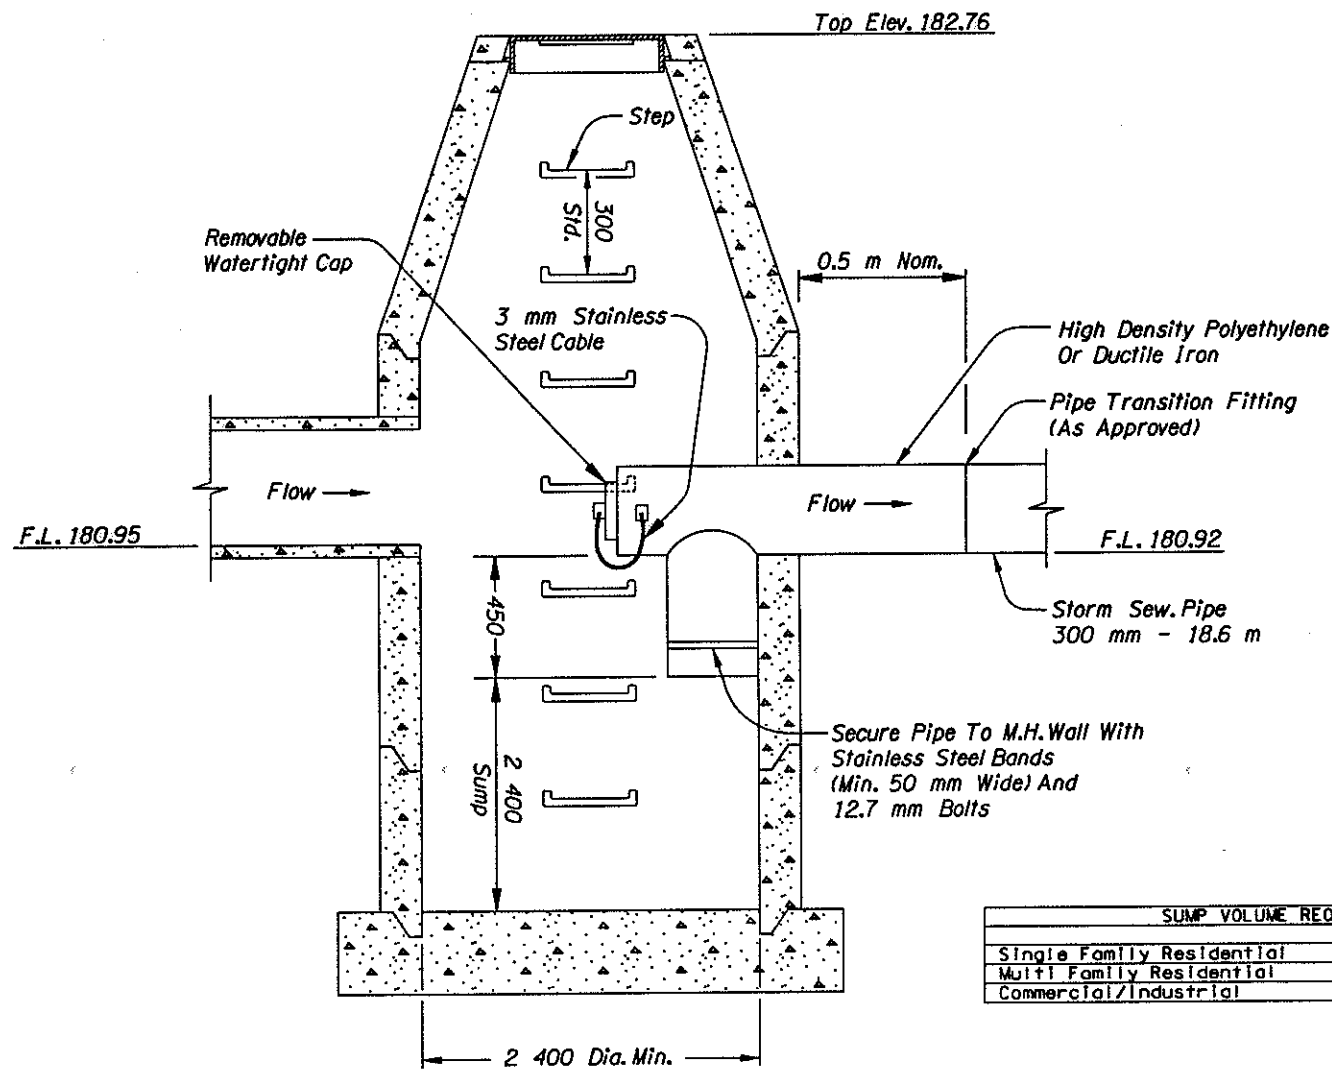

SECTION A-A
(For Details Not Shown, See Manhole Standard Drawings)
(For Location, See Sht. 2E)

- NOTES:**
1. Hardware, Fasteners And Anchors To Be Stainless Steel; Use 3 mm Stainless Steel Cable
 2. See Pipe Data Sheet And Plan Sheets For Pipe Sizes.
 3. See Pipe Data Sheet And Plan Sheets For Manhole Sizes.
 4. See Pipe Data Sheet And Plan Sheets For Sump Depth.
 5. Manhole And Base Per Manhole Standard Drawings.
 6. Hardware, Fasteners, Anchors, Fittings, Appurtenances, Labor And Equipment Is Incidental To Water Quality Manhole Item.


SUMP VOLUME REQUIREMENTS	
Single Family Residential	0.245 m ³ /hectare
Multi Family Residential	1.539 m ³ /hectare
Commercial/Industrial	6.577 m ³ /hectare

NOTE:
1. All Dimensions Are Shown In Millimeters Unless Otherwise Noted

CAMELOT INTCHGE. - SYLVAN INTCHGE. (PHASE 1) SEC. SUNSET HIGHWAY MULTNOMAH & WASHINGTON COUNTIES		
FEDERAL HIGHWAY ADMINISTRATION	PROJECT NUMBER	SHEET NO.
REGION 10	OREGON DIVISION	2E-4

CAUSE PROJECT SUBMIT PANSUB00172.dwg

01-SEP-1997 21:53

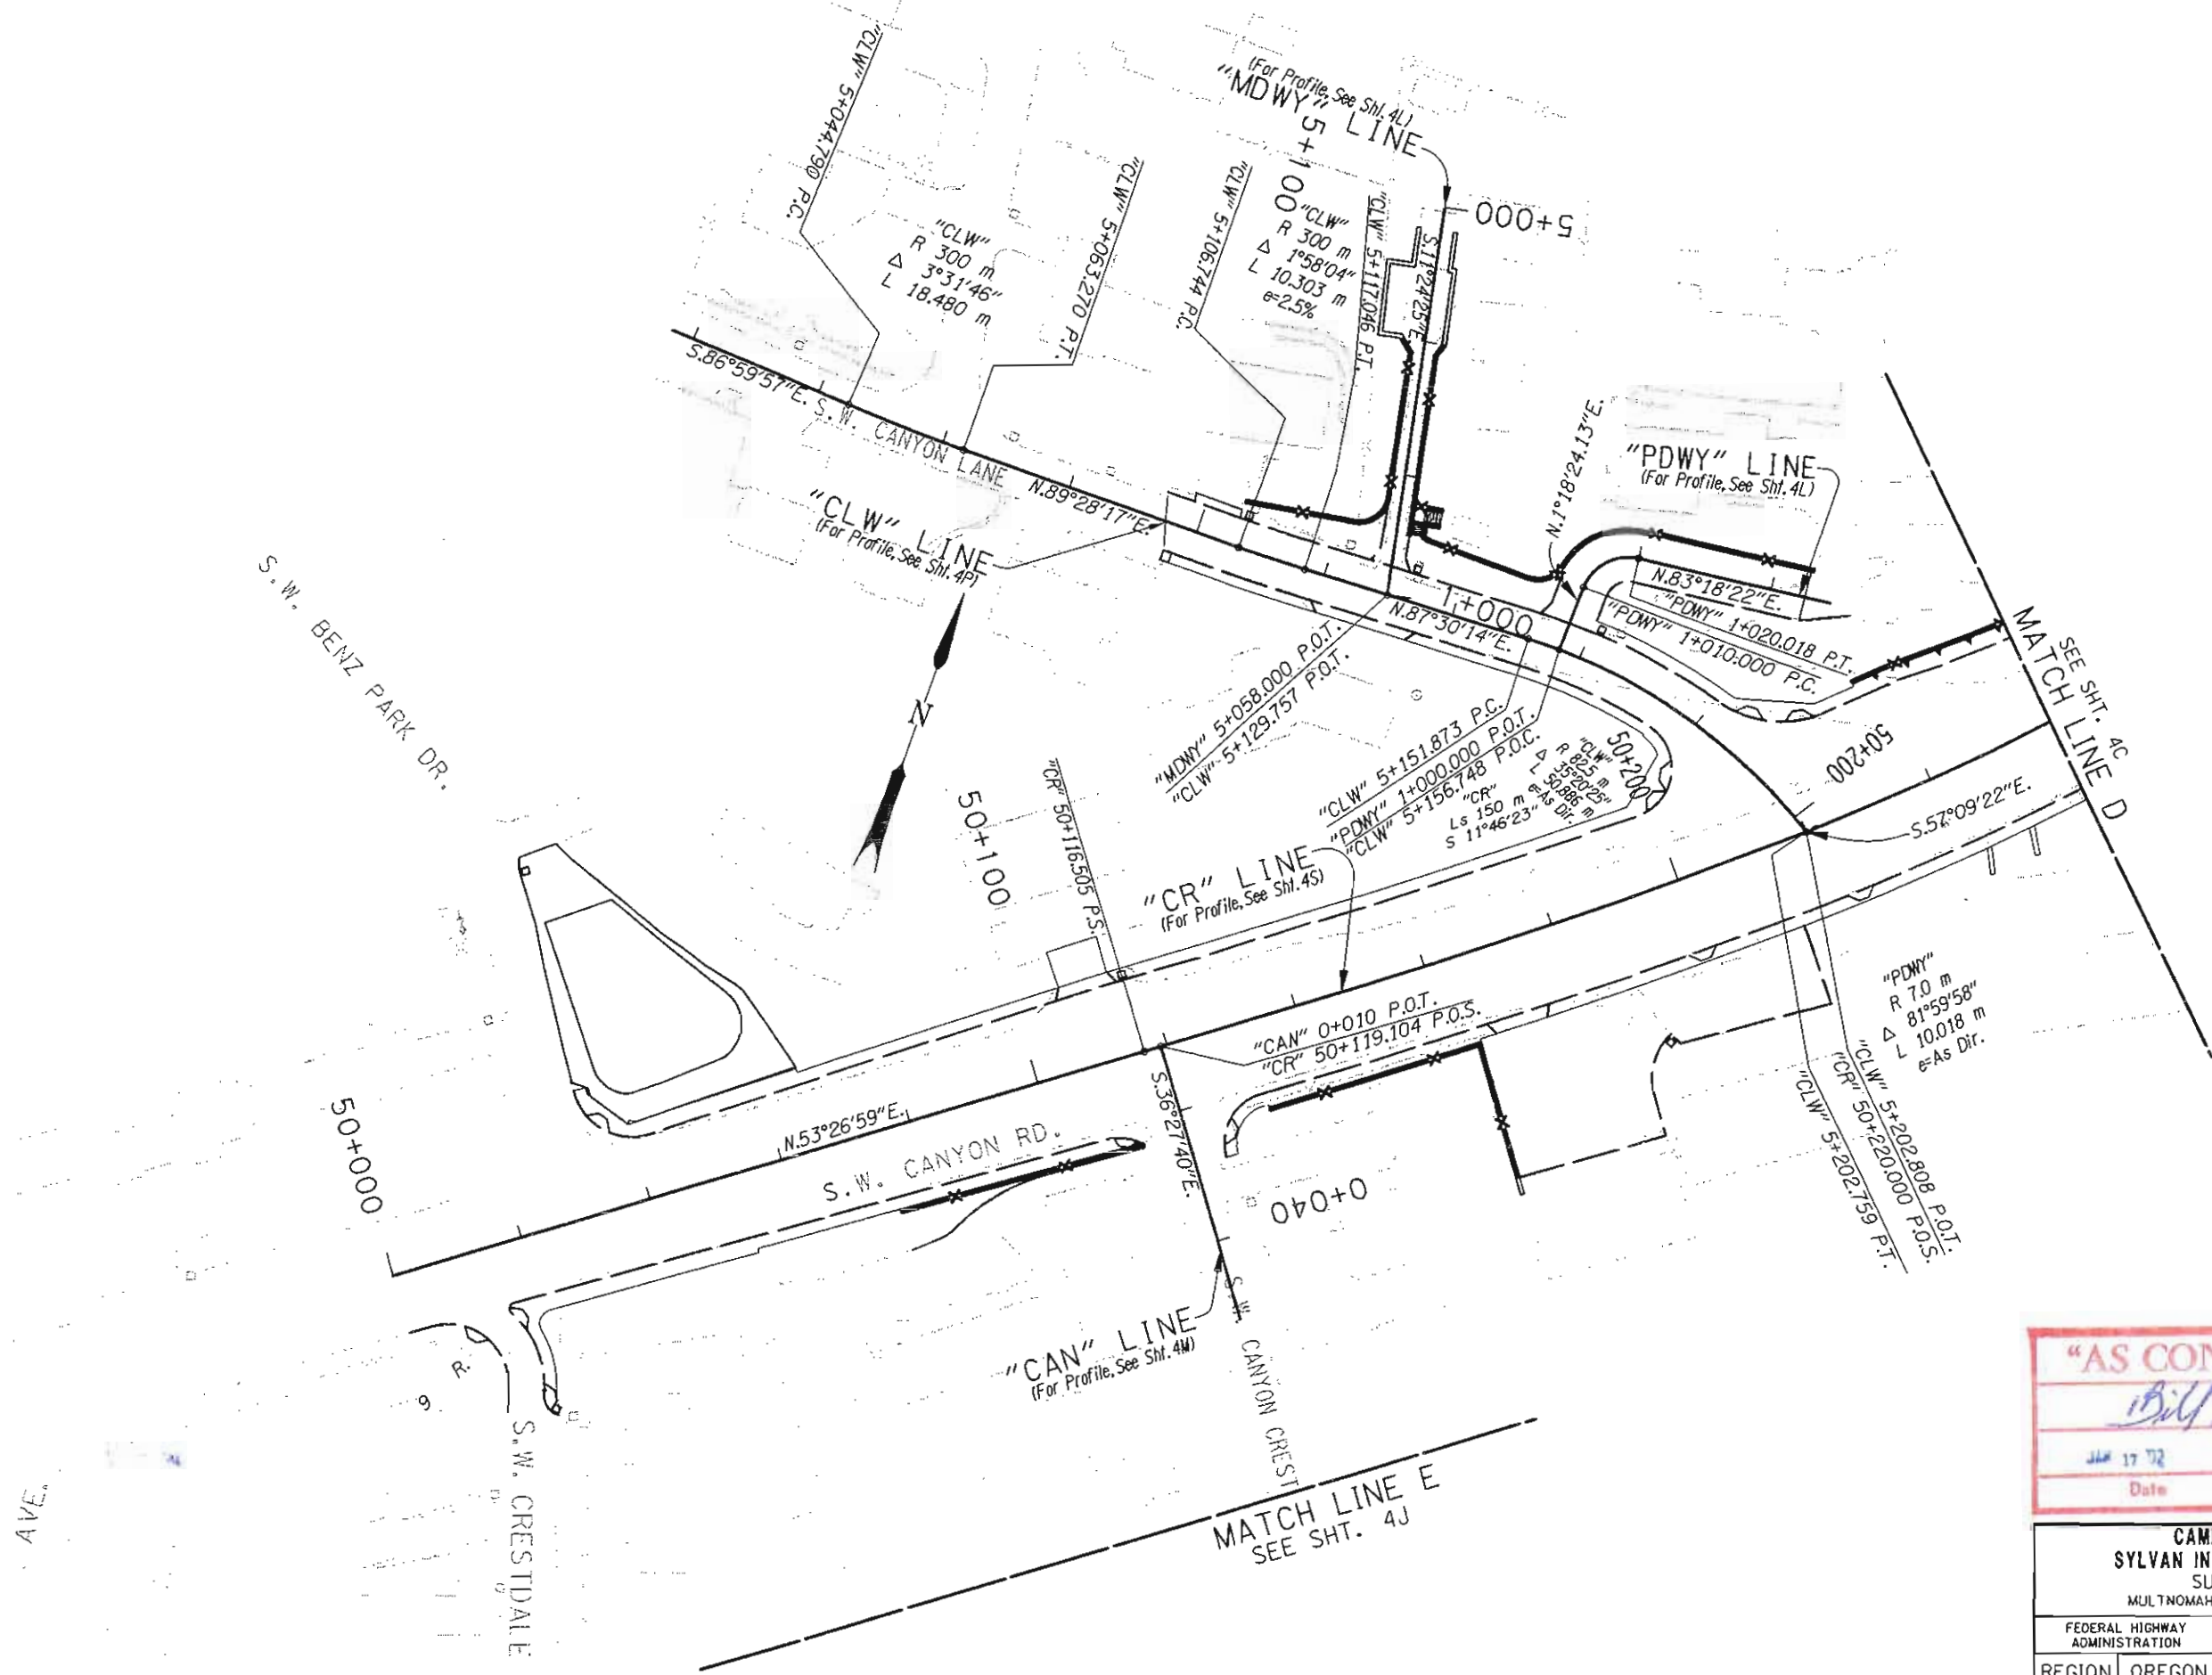


"AS CONSTRUCTED"
Bill Edmanson
 Project Manager
 Date: JUN 17 72

CAMELOT INTCHGE. - SYLVAN INTCHGE. (PHASE 1) SEC. SUNSET HIGHWAY MULTNOMAH & WASHINGTON COUNTIES		
FEDERAL HIGHWAY ADMINISTRATION	PROJECT NUMBER	SHEET NO.
REGION 10	OREGON DIVISION	4F

C:\AS\PROJECTS\SUBCON\plans\060817\02.plt

08-SEP-1997 11:56

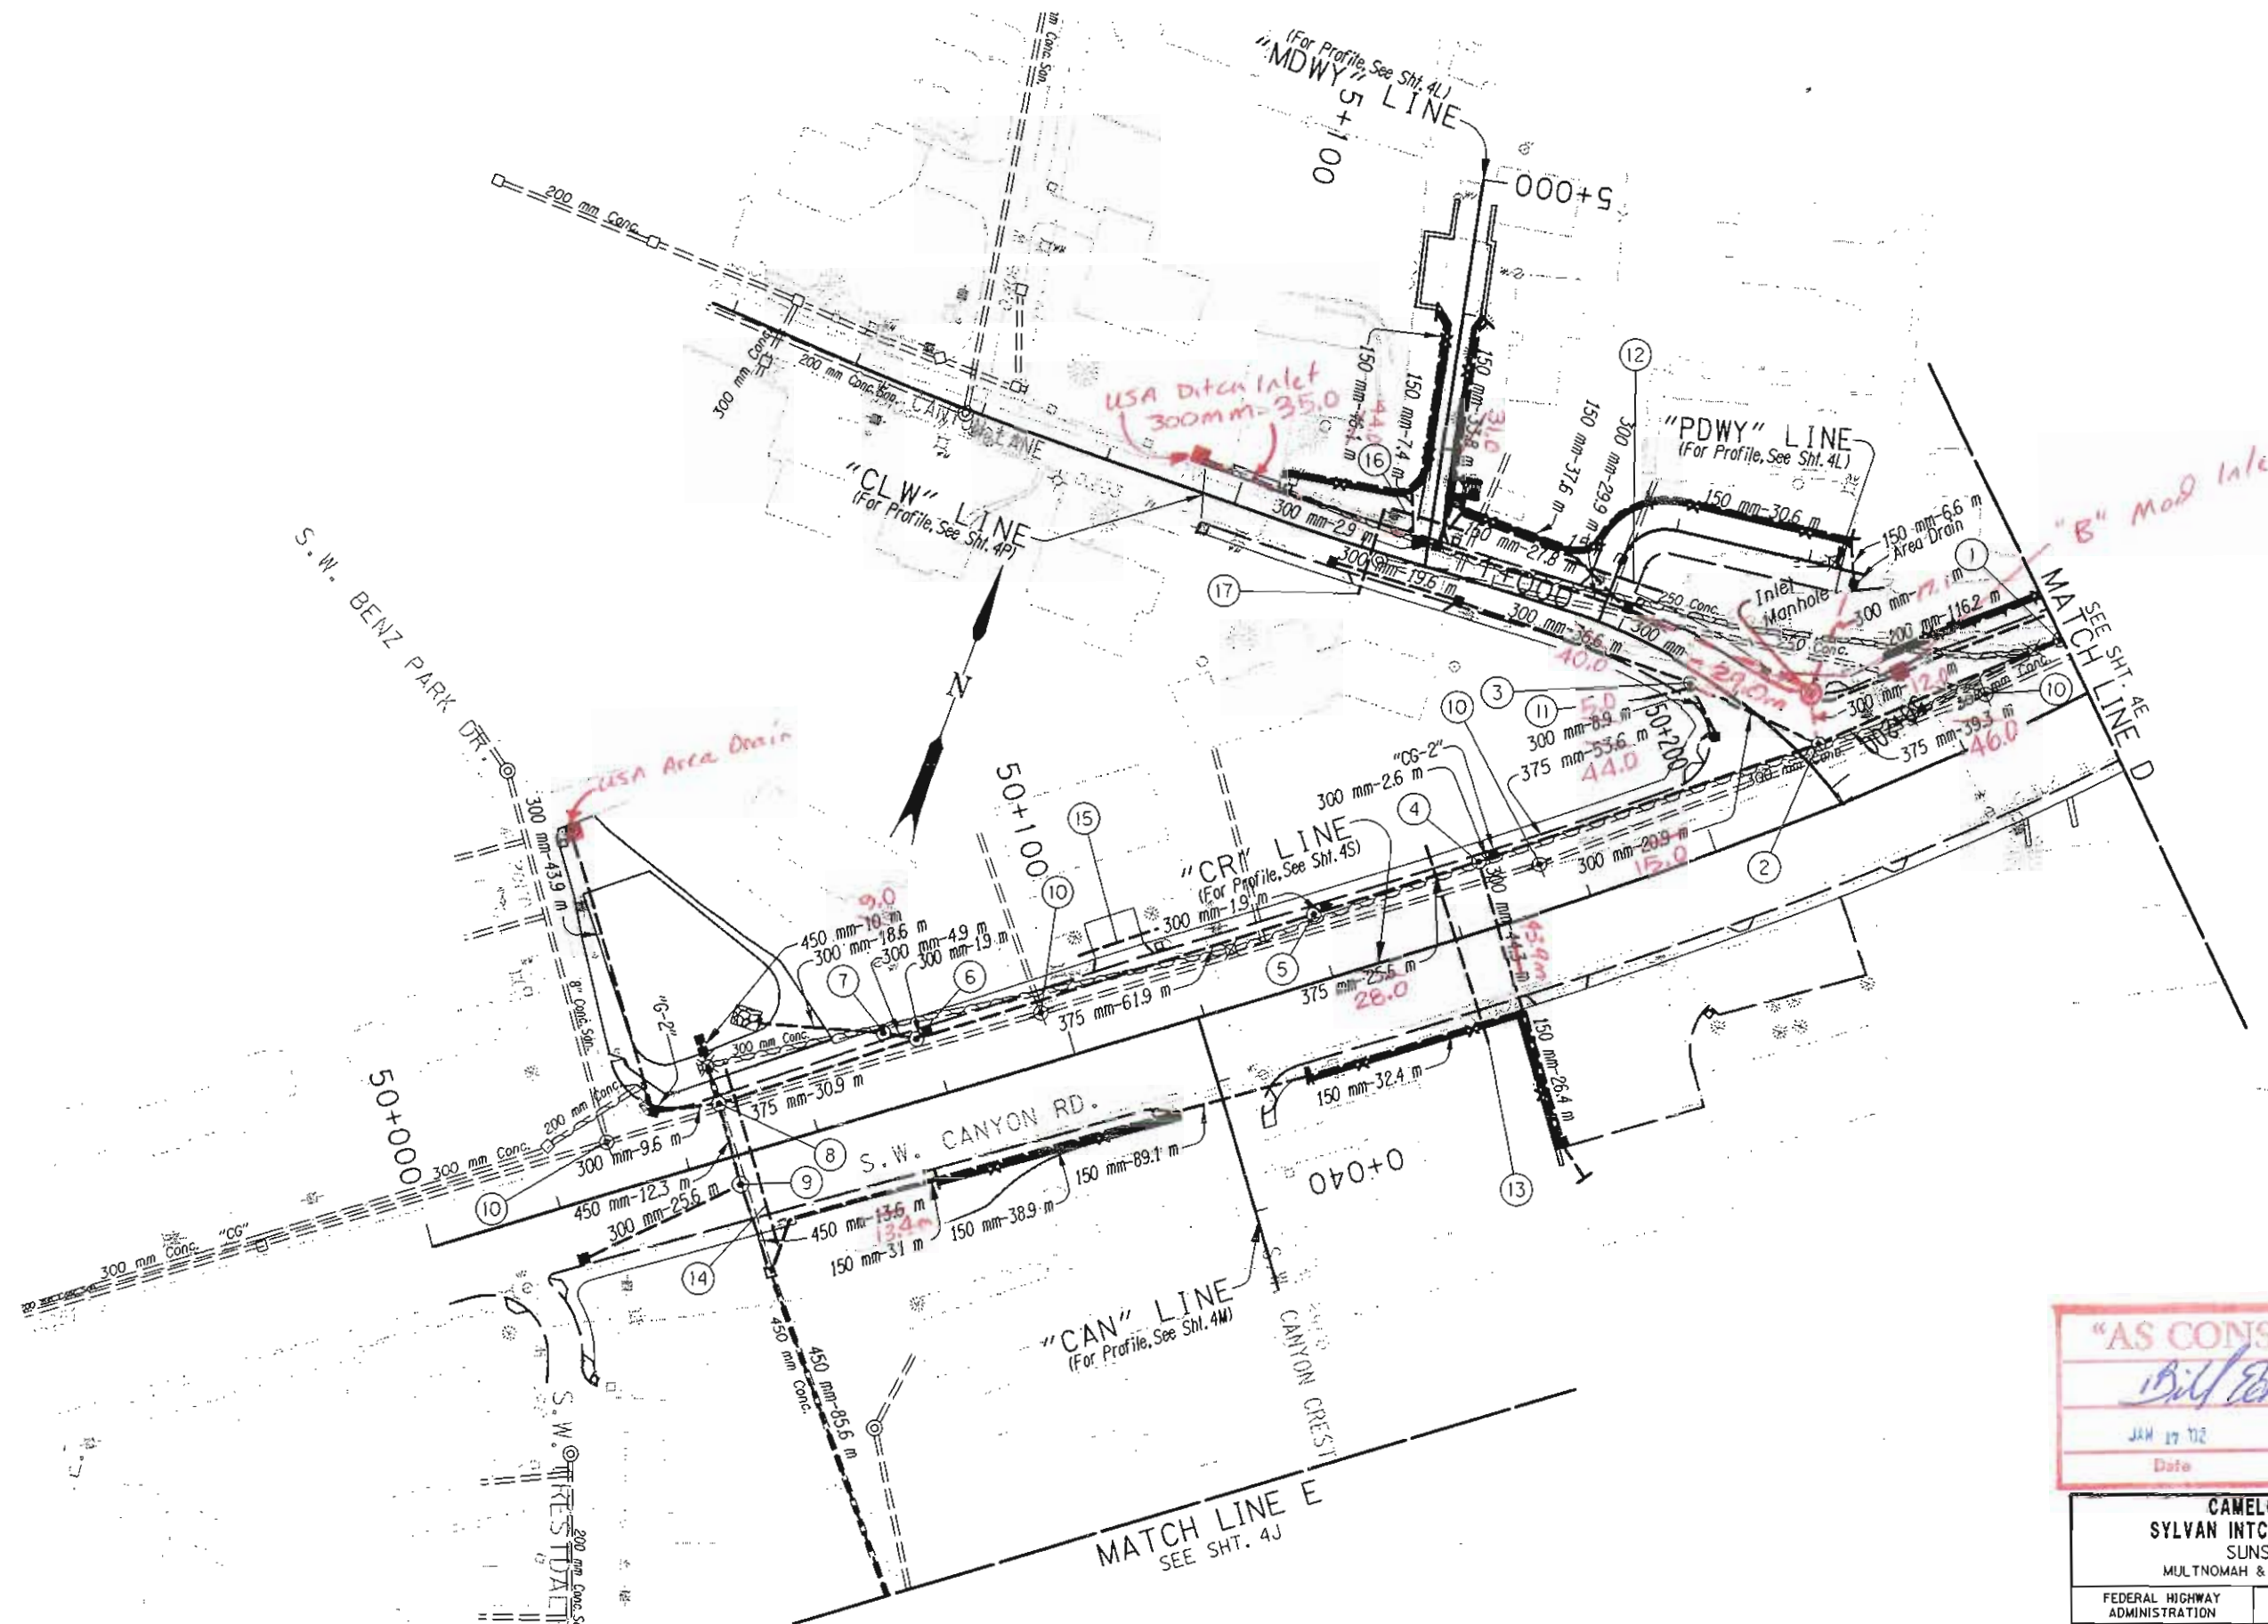

BRIDGE DETAILS CHECKED
C:\PROJECTS\SUBCON\plans\0807142\17
08-SEP-1997 11:31

"AS CONSTRUCTED"
Bill Edmondson
 Project Manager
 JAN 17 1992
 Date

CAMELOT INTCHGE. - SYLVAN INTCHGE. (PHASE 1) SEC. SUNSET HIGHWAY MULTNOMAH & WASHINGTON COUNTIES		
FEDERAL HIGHWAY ADMINISTRATION	PROJECT NUMBER	SHEET NO.
REGION 10	OREGON DIVISION	4H

Abandon Pipe Shown Thus : [symbol]



① Sta. "CR" 50+260.9 m Lt.
 Remove Inlet
 Const. Manhole
 Const. Type "G-2" Inlet - 2
 Inst. 300 mm Sew. Pipe - 5.3 m
 Inst. 375 mm Sew. Pipe - 75.9 m
 Tr. Exc. - 98 m³
 Rock Tr. Exc. - 30 m³

② Sta. "CR" 50+220.960 m Lt. *50+213.16, 9.85 m Lt.*
 Remove Extg. Sew. Pipe - 72.1 m
 Remove Inlet - 2
 Const. Drop Manhole
 Const. U.S.A. Oversize Curb Inlet Manhole
 Const. U.S.A. Area Drain & Gate Type 11 Mod. (Sump)
 Const. U.S.A. Type "CG-1" Inlet - 3
 Const. Type "B" Mod. Inlet - 2
 Const. Wall Gutter Drains - 4
 Inst. 150 mm Drain Pipe - 153.1 m *191*
~~Inst. 150 mm Poly Sew. Pipe - 41.8 m~~
~~Inst. 200 mm Drain Pipe - 116.2 m (OK)~~
 Inst. 300 mm Sew. Pipe - 108.9 m *90M*
 Inst. 375 mm Sew. Pipe - 39.3 m *46M*
 Tr. Exc. - 74 m³
 Rock Tr. Exc. - 149 m³
 (For Details, See Sht. 2B-2)
 (See U.S.A. Drg. Nos. 140A-ST, 140B-ST, 150-ST, 220-ST, 230-ST & 240-SA)
 Const. USA Ditch Inlet TYP 2

③ Sta. "CLW" 5+173.50.2 m Rt.
 Const. U.S.A. Manhole
 Const. U.S.A. Type "CG-1" Inlet - 2
 Const. U.S.A. Type "CG-2" Inlet
 Inst. 300 mm Sew. Pipe - 85.1 m *115*
 Tr. Exc. - 67 m³
 (See U.S.A. Drg. Nos. 010-ST, 160-ST & 170-ST)

④ Sta. "CR" 50+165.76, 10.04 m Lt. *+167.97, 10.11 m Lt.*
 Remove Extg. Pipe - 53.6 m
 Const. Manhole
 Const. Type "CG-2" Inlet
 Const. Trapped Catch Basin
 Inst. 150 mm Drain Pipe - 26.4 m *56*
 Inst. 300 mm Sew. Pipe - 46.9 m *46.5 m*
 Inst. 375 mm Sew. Pipe - 53.6 m *44.0*
 Tr. Exc. - 152 m³
 Rock Tr. Exc. - 69 m³
 (For Details, See Sht. 2B-17)

⑤ Sta. "CR" 50+140.9.30 m Lt.
 Remove Extg. Sew. Pipe - 25.6 m
 Const. Manhole
 Const. Type "CG-2" Inlet
 Inst. 300 mm Sew. Pipe - 7.9 m *3.0*
 Inst. 375 mm Sew. Pipe - 25.6 m *28.0*
 Tr. Exc. - 54 m³

⑥ Sta. "CR" 50+077.95, 8.96 m Lt.
 Remove Extg. Sew. Pipe - 61.9 m
 Remove Inlet
 Const. Type "CG-2" Inlet
 Const. Type "B" Manhole With Flow Splitter (2 400 mm)
 Inst. 300 mm Sew. Pipe - 1.9 m
 Inst. 375 mm Sew. Pipe - 61.9 m
 Tr. Exc. - 108 m³
 (For Details, See Sht. 2E-2)

⑦ Sta. "CR" 50+073.58, 11.21 m Lt.
 Remove Extg. Sew. Pipe - 32.0 m
 Const. Extended Dry Detention Pond
 Const. U.S.A. Water Quality Manhole (2 400 mm)
 Inst. 300 mm Sew. Pipe - 23.5 m
 Const. Loose Riprap (Class 100) - 12 m³
 Const. Filter Blanket (100 mm - 0 mm) - 1 m³
 Inst. Drain Riprap Geotextile (Type 1) - 12 m²
 Inst. Subgrade Geotextile - 40 m²
 Inst. Plant Mix Aggr. Subbase - 9 m³
 Water Quality Seed Mix - 300 m²
 Stone Emb. - 2 m³
 Tr. Exc. - 28 m³
 (For Details, See Shts. 2E Thru 2E-4)
 (See U.S.A. Org. No. 100-ST)

⑧ Sta. "CR" 50+047.8.10 m Lt.
 Remove Inlet
 Remove Extg. Sew. Pipe - 6.4 m
 Const. Manhole *2E 1*
 Const. Type "G-2" Inlet
 Const. Type "D" Mod. Inlet - 2
 Inst. 300 mm Sew. Pipe - 53.5 m
 Inst. 375 mm Sew. Pipe - 30.9 m
 Inst. 450 mm Sew. Pipe - 70. m *9.0*
 Tr. Exc. - 127 m³
 (For Details, See Sht. 2B-18)
 (See U.S.A. Drg. No. 150-ST)
 Const. USA Area Dr.

⑨ Sta. "CR" 50+046.75, 4.26 m Rt.
 Remove Extg. Sew. Pipe - 12.3 m
 Const. Manhole
 Const. Type "G-2" Inlet
 Inst. 300 mm Sew. Pipe - 25.6 m
 Inst. 450 mm Sew. Pipe - 12.3 m
 Under Pymt. - 37.8 m
 Tr. Exc. - 88 m³
 (For Details, See Sht. 2B-18)
 INST. 150MM DRAIN PIPE - 75M

⑩ Adjust Manhole - 4
 (For Details, See Sht. 2B)

⑪ Inst. 150 mm PVC Conduit - 25.5 m

⑫ Inst. 150 mm PVC Conduit - 15.7m

⑬ Inst. 150 mm PVC Conduit - ~~31.3~~ m *28*

⑭ Inst. 150 mm PVC Conduit - ~~28.2~~ m *24*

⑮ Inst. 150 mm PVC Conduit - 12.4 m

⑯ Inst. 150 mm PVC Conduit - ~~73.2~~ m *12*

⑰ Inst. 150 mm PVC Conduit - 13.2 m

"AS CONSTRUCTED"
Bill Edmanson
 Project Manager
 Date


CAMELOT INTCHGE. - SYLVAN INTCHGE. (PHASE 1) SEC. SUNSET HIGHWAY MULTNOMAH & WASHINGTON COUNTIES		
FEDERAL HIGHWAY ADMINISTRATION	PROJECT NUMBER	SHEET NO.
REGION 10	OREGON DIVISION	4H-2

To Face Sht. 4H

C:\NVP\PROJECT\S06001\plans\S06001T29V2
 07-SEP-1997 23:37

"CRY" LINE
(See Sht. 4F)

29V-50

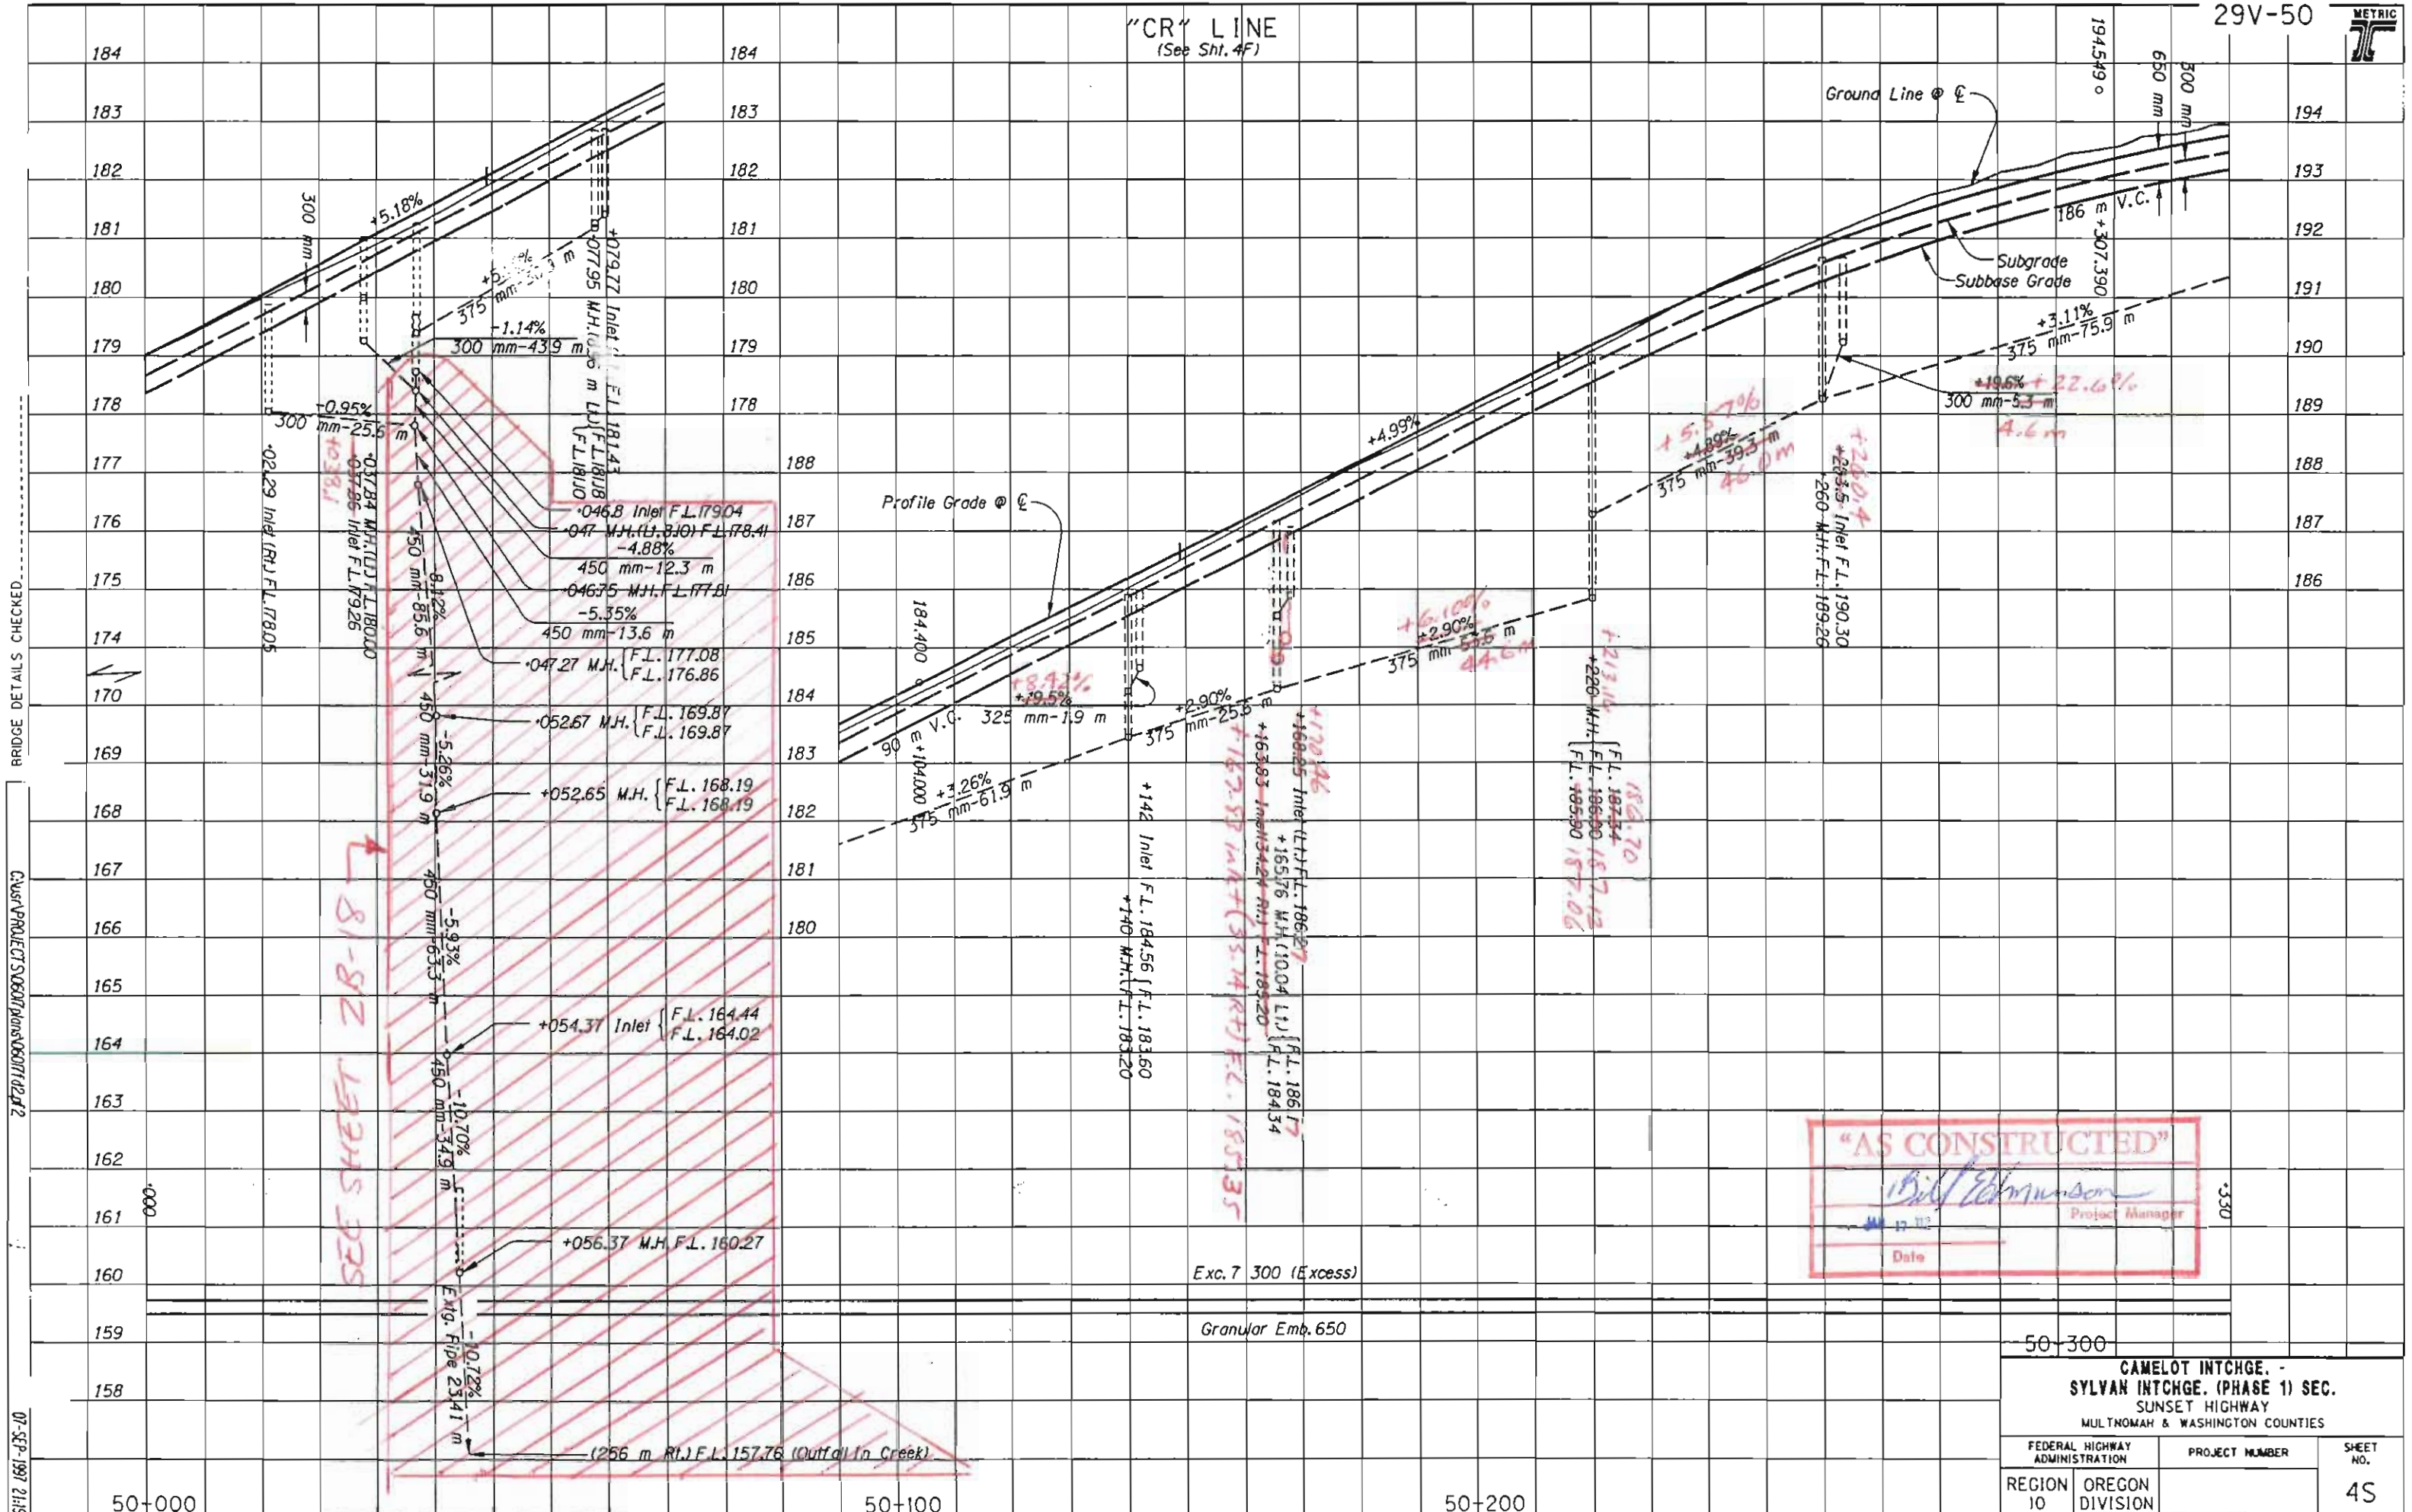

"AS CONSTRUCTED"

Bill Johnson
Project Manager

Date

50-300		
CAMELOT INTCHGE. - SYLVAN INTCHGE. (PHASE 1) SEC. SUNSET HIGHWAY MULTNOMAH & WASHINGTON COUNTIES		
FEDERAL HIGHWAY ADMINISTRATION	PROJECT NUMBER	SHEET NO.
REGION 10	OREGON DIVISION	45

BRIDGE DETAILS CHECKED

C:\PROJECT\SUBSOIL\PLANS\SUBSOIL\29V-50.DWG

07-SEP-1997 21:19