

OPERATION & MAINTENANCE MANUAL

DFI No. : D00112

Facility Type: Water Quality Biofiltration
Swale



MARCH, 2011

INDEX

1. IDENTIFICATION..... 1

2. FACILITY CONTACT INFORMATION..... 1

3. CONSTRUCTION..... 1

4. STORM DRAIN SYSTEM AND FACILITY OVERVIEW 2

5. FACILITY HAZ MAT SPILL FEATURE(S)..... 2

6. AUXILIARY OUTLET (HIGH FLOW BYPASS)..... 5

7. MAINTENANCE REQUIREMENTS..... 6

8. WASTE MATERIAL HANDLING..... 6

APPENDIX A: Operational Plan and Profile Drawing(s)

APPENDIX B: ODOT Project Plan Sheets

1. Identification

Drainage Facility ID (DFI): **D00112**
Facility Type: Water Quality Biofiltration Swale
Construction Drawings: (V-File Number) 29V-50/33V-100
Location: District: 2B (Old 2A)
Highway No.: 047
Mile Post: 70.85 / 70.85 (beg./end)
Description: This facility is located on the north side of the westbound on-ramp to US26 (Hwy 47) just north of the US08 (Hwy 29, Canyon Road) Interchange. Access can be obtained from the westbound on-ramp.

2. Facility Contact Information

Contact the Engineer of Record, Region Technical Center, or Geo-Environmental's Senior Hydraulics Engineer for:

- Operational clarification
- Maintenance clarification
- Repair or restoration assistance

Engineering Contacts:

Region Technical Center Hydro Unit Manager

Or

Geo-Environmental Senior Hydraulics Engineer (503) 986-3365.

3. Construction

Engineer of Record: ODOT Designer – Region 2 Tech. Center, John Marks, P.E., 503-986-2990

Facility construction: 1997

Contractor: N/A

4. Storm Drain System and Facility Overview

A water quality swale is a flat-bottomed open channel designed to treat stormwater runoff from highway pavement areas. This type of facility is lined with grass. Treatment by trapping sedimentation occurs when stormwater runoff flows through the grass.

The swale is located on the north side of the westbound on-ramp to US 26 (Hwy 047) at the Canyon Road Interchange. The swale is at a low spot in the topography where it drains into a natural drainage corridor (unnamed ditch) which is directed under US 26 (Hwy 047) through a 36-inch culvert to the south side. This location lies under a bridge for the light rail line.

The drainage area for the swale includes the westbound on-ramp to US 26 (Hwy 047) and additional travel lanes of westbound US 26; see the Operational Plan, Appendix A. The stormwater is treated by flowing through the swale which is approximately 130 feet in length. The swale bottom is lined with an erosion control product called "GeoWeb" which is a cellular confinement system.

The swale is considered an offline system with a high-low split-flow manhole located upstream of the facility; see Point A on the Operational Plan. The flow splitter is used to bypass the water quality flows into the facility and convey the high flows through a separate conveyance system that discharges into an unnamed ditch. The high flows do not receive treatment. . After the flow splitter, the water is pretreated through a pollution control manhole (Point C). The stormwater is then directed through a 12-inch storm pipe into the 130 foot long swale where it is treated. After treatment, the water is directed into the same unnamed ditch and conveyed across US 26 (Hwy 047) through a 36-inch culvert.

The swale location appears to add additional maintenance due to vegetation and trash debris. The facility was observed as substantially overgrown. Additionally, significant trash accumulation has developed within the facility area.

For further information and details regarding the system refer to Appendix A of the Operational Plan and Appendix B for the Construction Project Plan sheets.

A. Maintenance equipment access:

The facility can be accessed for maintenance at the westbound on-ramp to US 26 (Hwy 047). Photo 1 includes a photo of the access gate.

B. Heavy equipment access into facility:

- Allowed (no limitations)
- Allowed (with limitations)
- Not allowed

C. Special Features:

- Amended Soils
- Porous Pavers
- Liners – Geoweb erosion control system.
- Underdrains

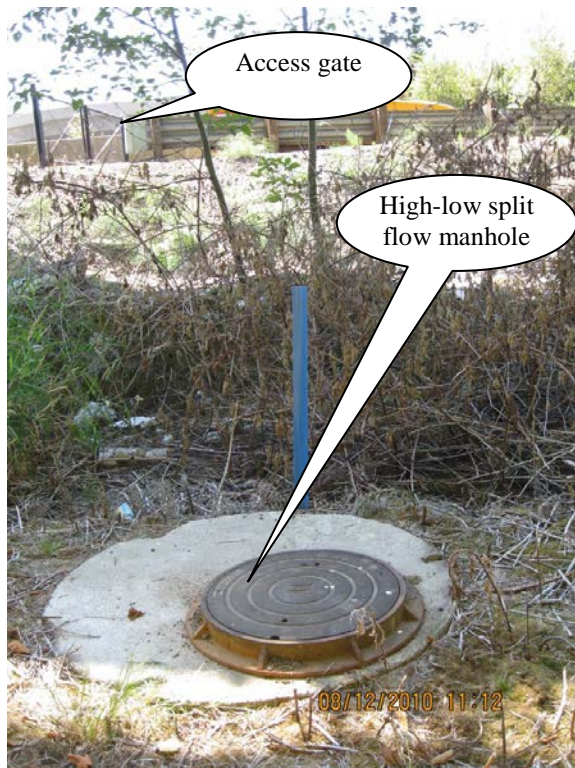


Photo 1: High-low split flow manhole looking towards the south. Access gate is located in the background.



Photo 2: High-Low split flow manhole.



Photo 3: A photo of the water quality swale with significant vegetation and overgrowth.



Photo 4: Drainage area looking towards the east on the westbound on-ramp to US 26 (Hwy 047). Overhead is the light rail line.

5. Facility Haz Mat Spill Feature(s)

The water quality biofiltration swale can be used to store a volume of liquid by blocking the rock-lined ditch located at the outlet of the swale facility. The outlet is noted as Point D on the Operational Plan, Appendix A. The use of sandbags stacked to create a berm at that location will assist in the containment of the liquid.

6. Auxiliary Outlet (High Flow Bypass)

Auxiliary Outlets are provided if the primary outlet control structure can not safely pass the projected high flows. Broad-crested spillway weirs and over flow risers are the two most common auxiliary outlets used in stormwater treatment facility design. The auxiliary outlet feature is either a part of the facility or an additional storm drain feature/structure.

The auxiliary outlet feature for this facility is:

Designed into facility

Other, as noted below

This swale does not contain an auxiliary outlet or overflow as there is no outlet control device for this swale. All treated stormwater enters the 36-inch diameter culvert.

7. Maintenance Requirements

Routine maintenance table for non-proprietary stormwater treatment and storage/detention facilities have been incorporated into ODOT's Maintenance Guide. These tables summarize the maintenance requirements for ponds, swales, filter strips, bioslopes, and detention tanks and vaults. Special maintenance requirements in addition to the routine requirements are noted below when applicable.

The ODOT Maintenance Guide can be viewed at the following website:

<http://www.oregon.gov/ODOT/HWY/OOM/MGuide.shtml>

Maintenance requirements for proprietary structures, such as underground water quality manholes and/or vaults with filter media are noted in Appendix C when applicable.

The following stormwater facility maintenance table (See ODOT Maintenance Guide) should be used to maintain the facility outlined in this Operation and Maintenance Manual or follow the Maintenance requirements outlined in Appendix C when proprietary structure is selected below:

- Table 1 (general maintenance)
- Table 2 (stormwater ponds)
- Table 3 (water quality or biofiltration swales)
- Table 4 (water quality filter strips)
- Table 5 (water quality bioslopes)
- Table 6 (detention tank)
- Table 7 (detention vault)
- Appendix C (proprietary structure)
- Special Maintenance requirements:

Note: Special maintenance Requirements Require Concurrence from ODOT SR Hydraulics Engineer.

8. Waste Material Handling

Material removed from the facility is defined as waste by DEQ. Refer to the roadwaste section of the ODOT Maintenance Yard Environmental Management System (EMS) Policy and Procedures Manual for disposal options: <http://egov.oregon.gov/ODOT/HWY/OOM/EMS.shtml>


Contact any of the following for more detailed information about management of waste materials found on site:

ODOT Clean Water Unit	(503) 986-3008
ODOT Statewide Hazmat Coordinator	(503) 229-5129
ODOT Region Hazmat Coordinator	(503) 731-8290
ODEQ Northwest Region Office	(503) 229-5263


Appendix A

Content:

- **Operational Plan and Profile Drawing(s)**

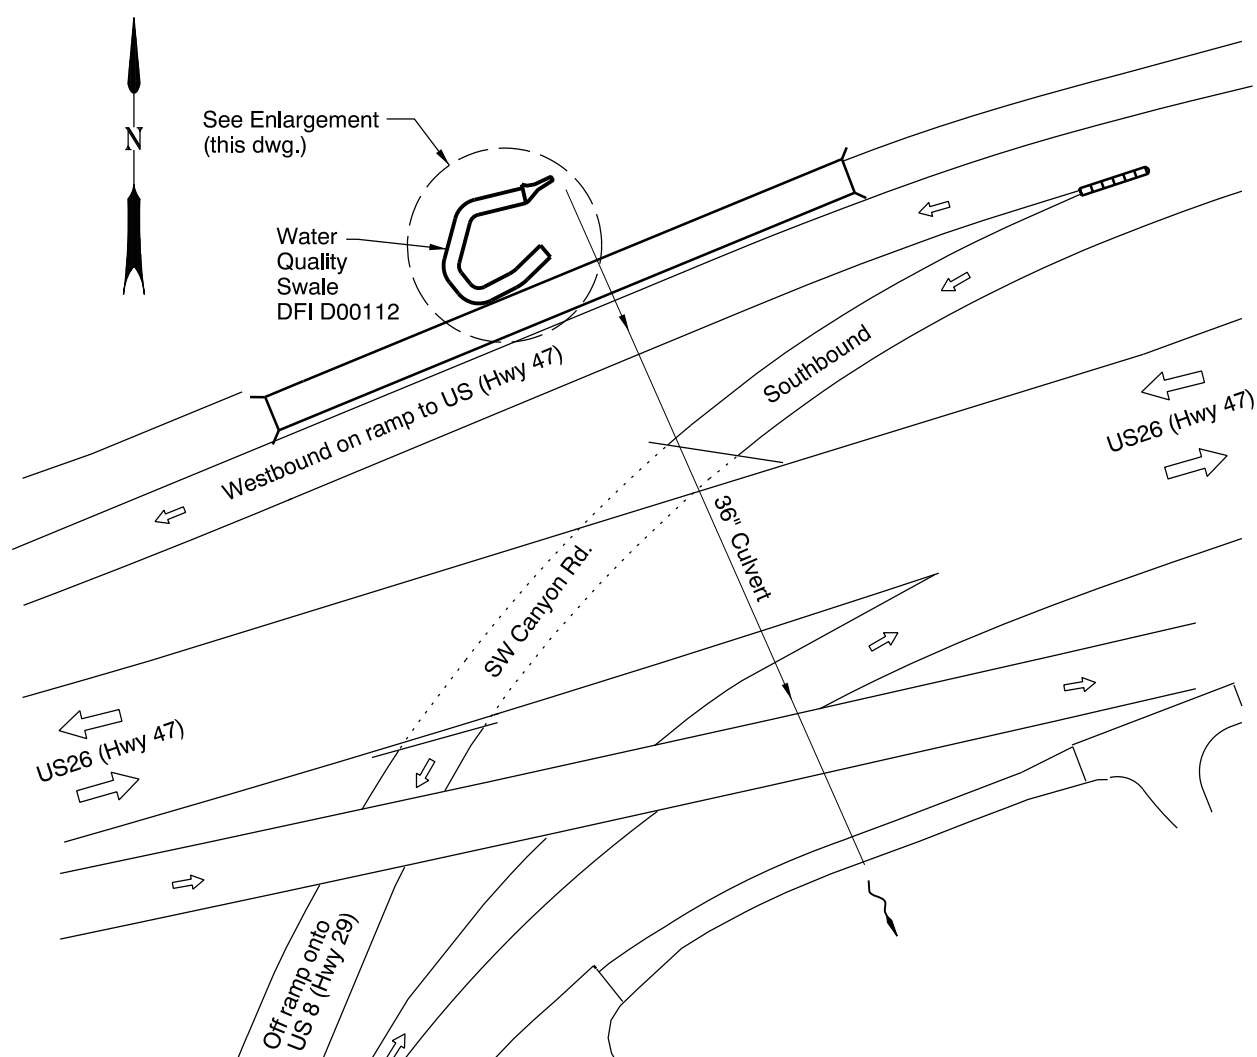


PLAN
N.T.S.

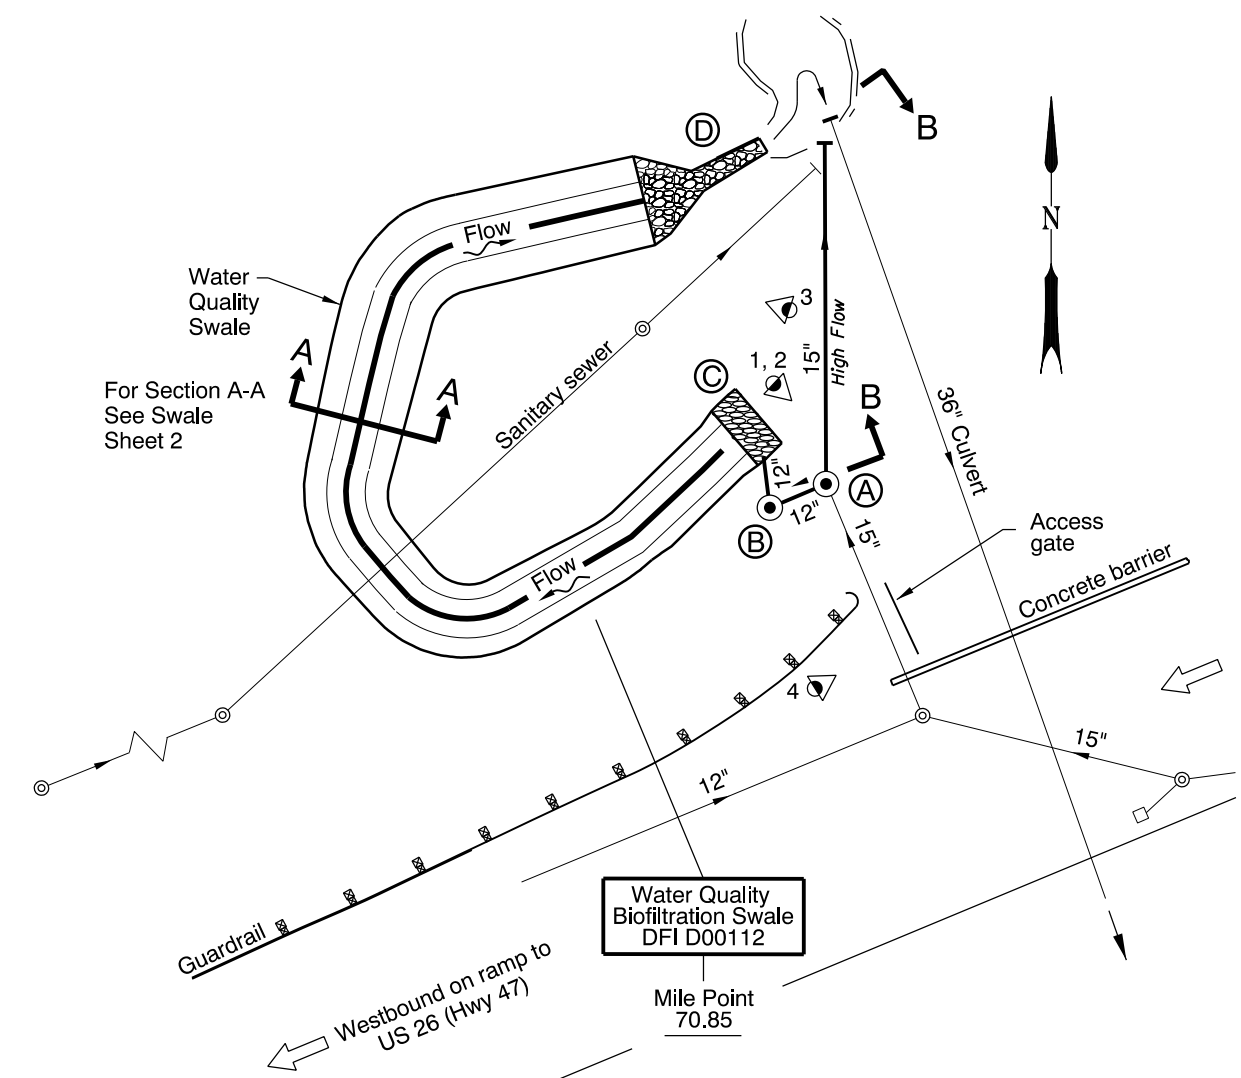

ENLARGEMENT
PLAN: Water Quality Swale
N.T.S.

- LEGEND:**
- Photo Location / Direction
 - High-Low Split Flow Manhole
 - Pollution Control Manhole
 - Swale Inlet/Flow Spreader
 - Rocklined Ditch / Facility Outlet
 - Manhole
 - Inlet
 - Storm Pipe (Facility)
 - Storm Pipe
 - Conveyance Direction
 - Pavement / Facility Flow Path

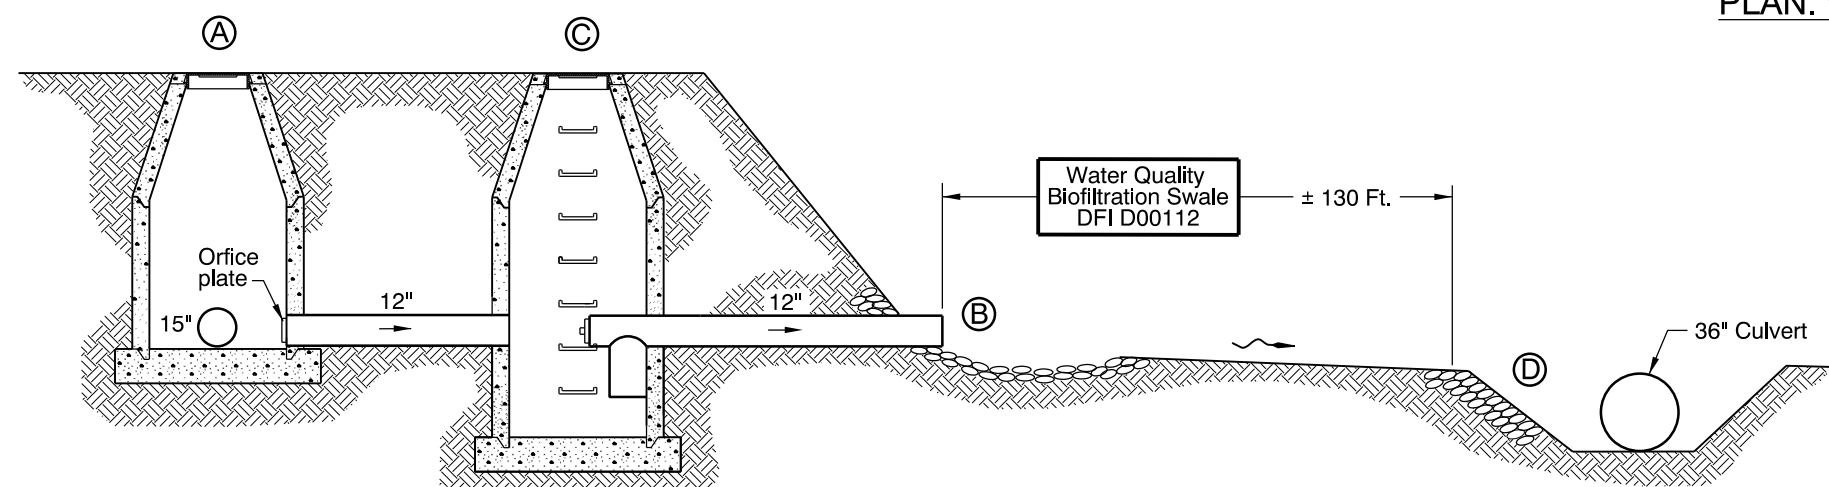

SECTION B-B
N.T.S.


Sht. 1 of 2

OREGON DEPARTMENT OF TRANSPORTATION

Prepared By:
Bob Knorr


Drafted By:
Gene Leon

DFI D00112
MAINTENANCE DISTRICT 2B HWY 47
WATER QUALITY BIOFILTRATION SWALE
SUNSET HWY 47 MP 70.85
WASHINGTON COUNTY

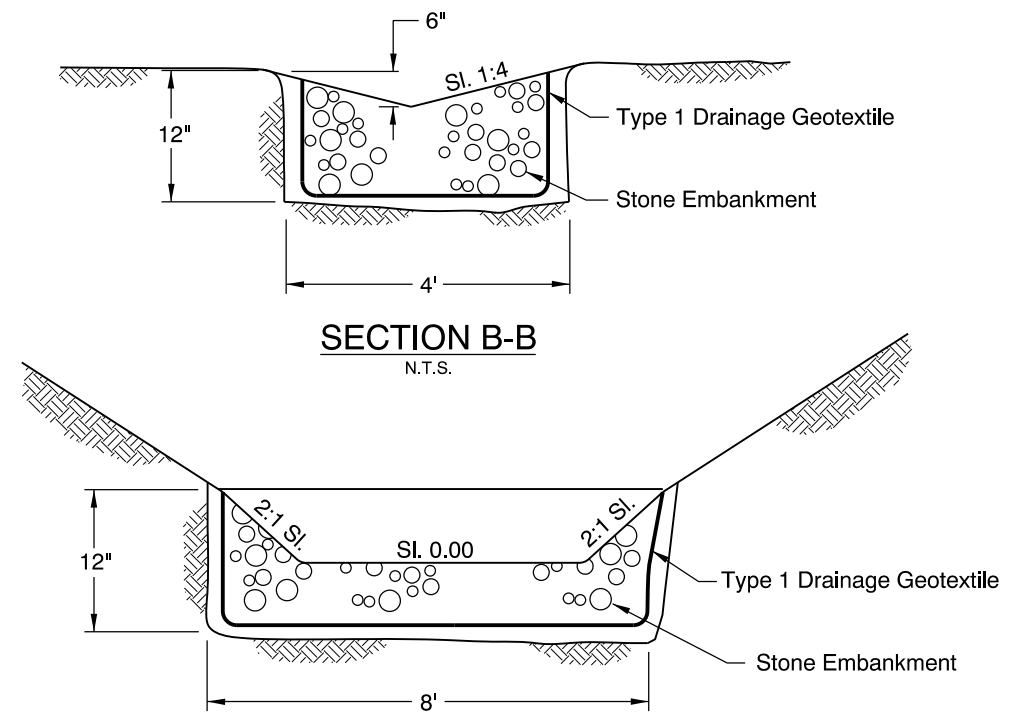


SECTION B-B
N.T.S.

SECTION A-A
N.T.S.

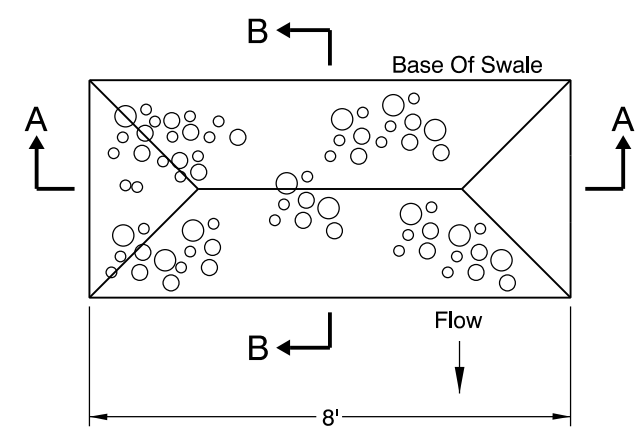

PLAN
N.T.S.

FLOW SPREADER AT POINT ©

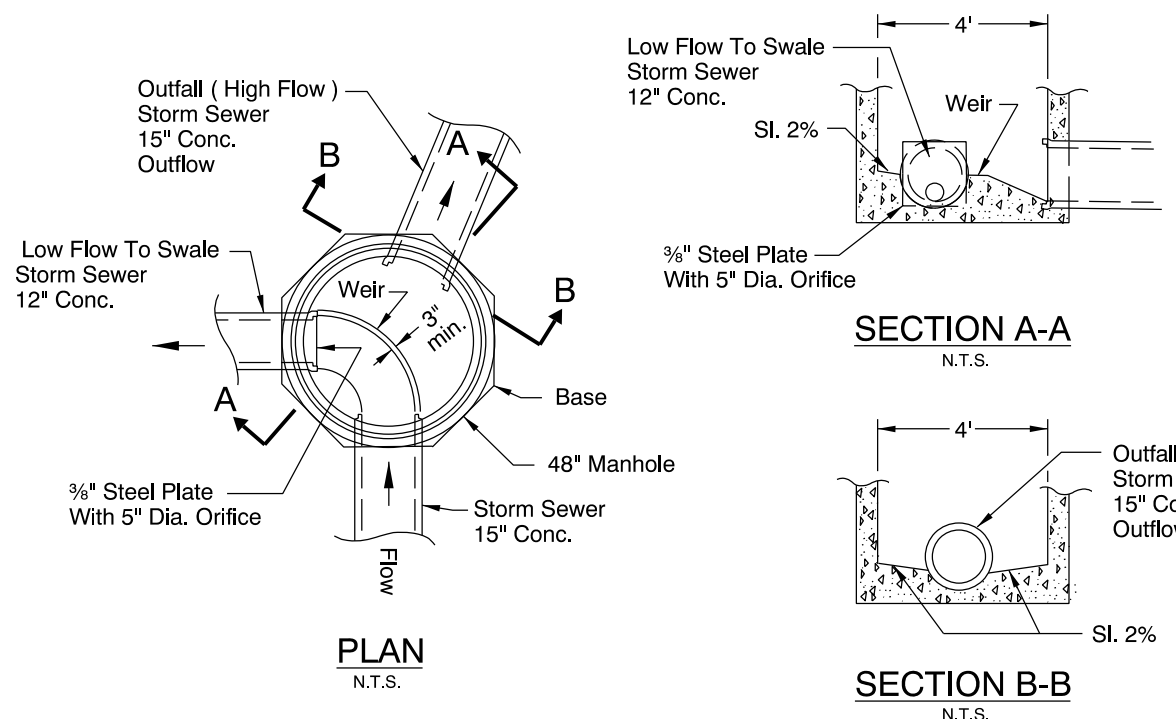


PLAN
N.T.S.

SECTION A-A
N.T.S.

SECTION B-B
N.T.S.

HIGH/LOW SPLIT FLOW MANHOLE AT POINT A

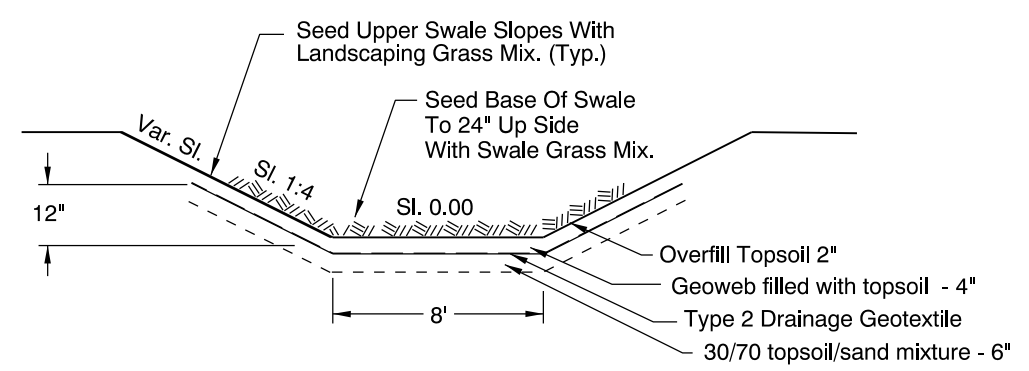

SECTION A-A
N.T.S.

SWALE

Sht. 2 of 2

OREGON DEPARTMENT OF TRANSPORTATION

Prepared By:
Bob Knorr

Drafted By:
Gene Leon

DFI D00112
MAINTENANCE DISTRICT 2B HWY 47
WATER QUALITY BIOFILTRATION SWALE
SUNSET HWY 47 MP 70.85
WASHINGTON COUNTY

Appendix B

Content:

- **ODOT Project Plan Sheets**
 - *Cover/Title Sheet*
 - *Water Quality/Detention Plan Sheets*
 - *Other Details*


INDEX OF SHEETS	
SHEET NO.	DESCRIPTION
1	Title Sheet
1A	Index Of Sheets Cont'd.
1A-2	Index Of Sheets Cont'd.
1A-3	Standard Drawing Nos.
1B	Signature Sheet
1C	Sheet Layout
2, 2A,	
2A-2 Thru	Typical Sections
2A-20 Incl.	
2B Thru	Details
2B-22 Incl.	
2C Thru	Traffic Control Plans
2C-103 Incl.	
2D	Disposal Site
2E Thru	Water Quality Plans
2E-8 Incl.	
2F Thru	Erosion Control Plans
2F-17 Incl.	
2G Thru	Pipe Data
2G-10 Incl.	
2H Thru	Summary
2H-14 Incl.	
3	All Construction Items & Notes, RW
3A	Profile
4	Alignment
4-RW	Right of Way
4A, 4A-2	General Construction Plans
4B, 4B-2	Drainage Plans
4C	Alignment
4C-RW	Right of Way
4D, 4D-2	General Construction Plans
4E, 4E-2	Drainage Plans
4F	Alignment
4F-RW	Right of Way
4G, 4G-2	General Construction Plans
4H, 4H-2, 4I	Drainage Plans
4J-RW	Right of Way
4K, 4L, 4M, 4N,	Profiles
4P, 4Q, 4R, 4S,	
4T, 4U, 4V, 4W	
5	Alignment
5-RW	Right of Way
5A, 5A-2	General Construction Plans
5B, 5B-2	Drainage Plans
5C, 5D, 5E,	Profiles
5F, 5G	
6	Alignment
6-RW	Right of Way
6A, 6A-2	General Construction Plans
6B, 6B-2	Drainage Plans
6C, 6D, 6E,	Profiles
6F, 6G, 6H	
7	Alignment
7-RW	Right of Way
7A, 7A-2	General Construction Plans
7B, 7B-2	Drainage Plans

STATE OF OREGON
DEPARTMENT OF TRANSPORTATION

PLANS FOR PROPOSED PROJECT

GRADING, STRUCTURES, PAVING, SIGNING, ILLUMINATION, SIGNALS,
LANDSCAPING, UTILITY RELOCATIONS, & DEBRIS FILL REMOVAL

**CAMELOT INTCHGE. -
SYLVAN INTCHGE. (PHASE 1) SEC.
SUNSET HIGHWAY
MULTNOMAH & WASHINGTON COUNTIES
OCTOBER 1997**

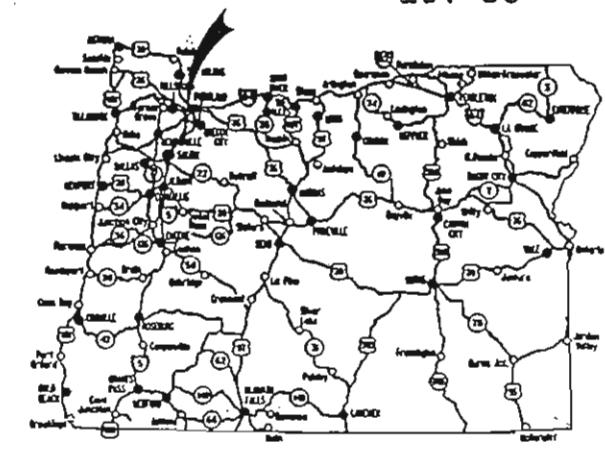


Overall Length Of Project - 1.545 km (0.96 Mile)

"AS CONSTRUCTED"
Duff Edmondson
Project Manager
JAN 17 02
Date

ATTENTION :
Oregon Law Requires You To Follow Rules
Adopted By The Oregon Utility Notification Center.
Those Rules Are Set Forth In OAR 952-001-0010 Through
OAR 952-001-0090. You May Obtain Copies Of The Rules From The Center.

LET'S ALL
WORK TOGETHER
TO MAKE THIS
JOB SAFE

09-SEP-95

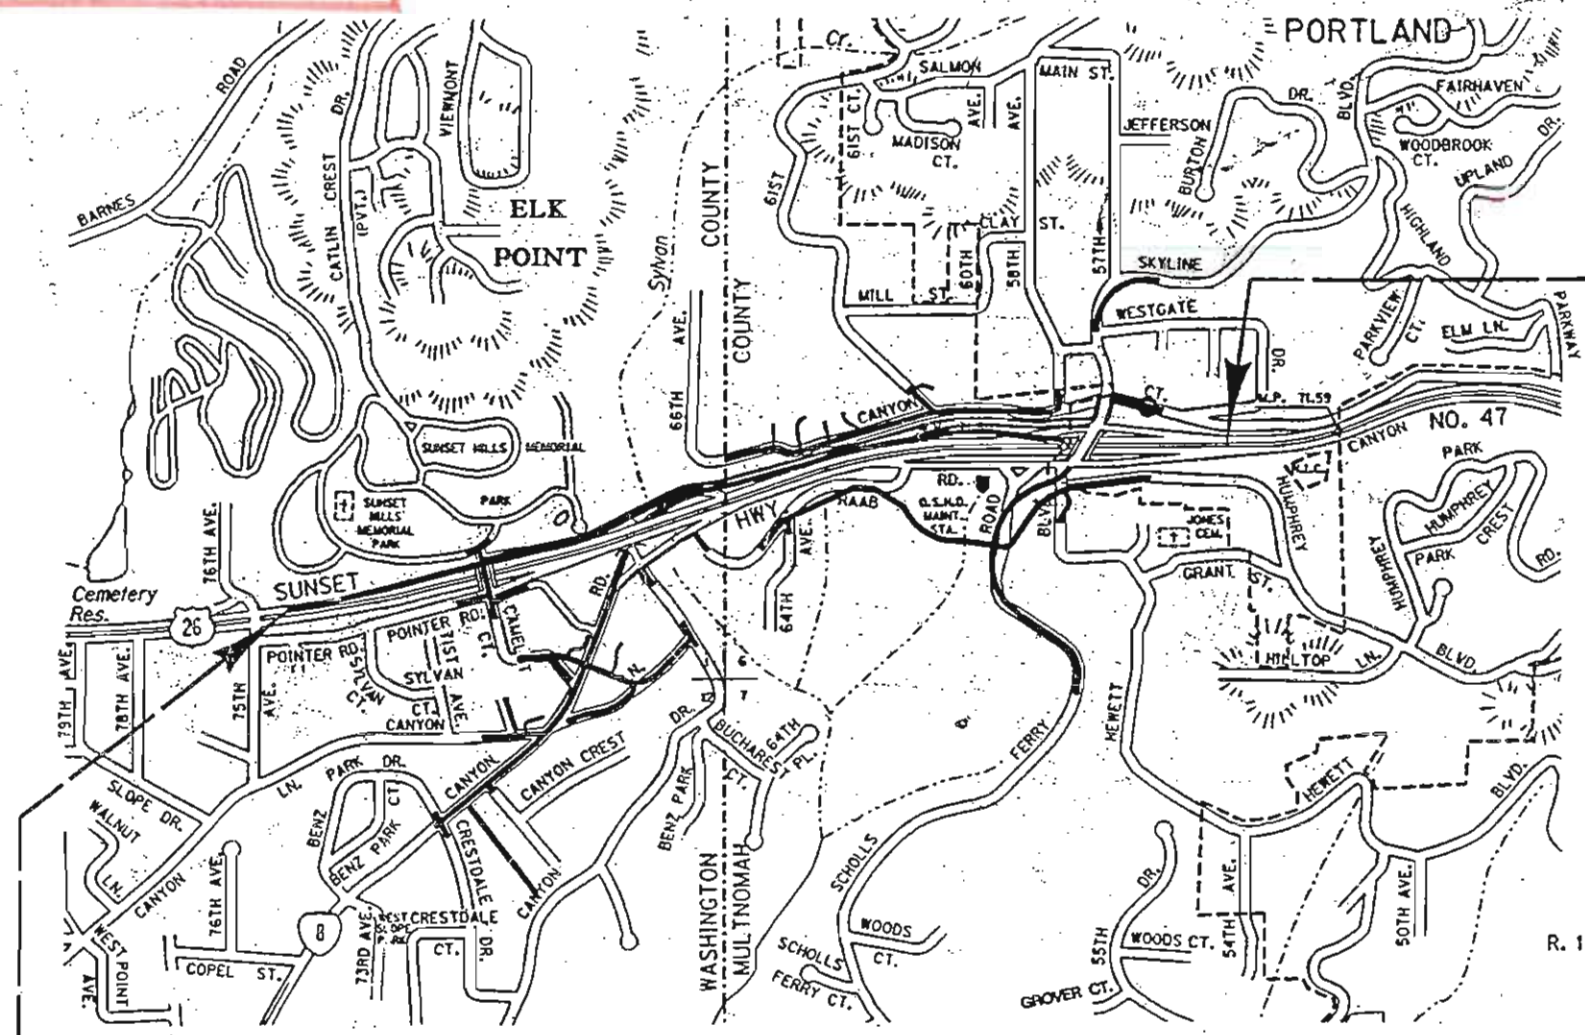

**STP-MASTP-S047(23)
END OF PROJECT
STA. "L" 100 + 864.334 (M.P. 71.41)**

OREGON TRANSPORTATION COMMISSION
 Harry H. Hewitt CHAIRMAN
 Susan Brody VICE CHAIRMAN
 Steven H. Corey COMMISSIONER
 Stuart Foster COMMISSIONER
 John Russell COMMISSIONER
 Grace Crunican DIRECTOR OF TRANSPORTATION



Thomas D. Luay
TECHNICAL SERVICES MANAGING ENGINEER

T. I. S.,
R. I. W., I. E., W. M.

**STP-MASTP-S047(23)
BEGINNING OF PROJECT
STA. "L" 99 + 319.000 (M.P. 70.45)**

CAMELOT INTCHGE. - SYLVAN INTCHGE. (PHASE 1) SEC. SUNSET HIGHWAY MULTNOMAH & WASHINGTON COUNTIES		FEDERAL HIGHWAY ADMINISTRATION	PROJECT NUMBER	SHEET NO.
REGION 10	OREGON DIVISION	STP-S047(23)	1	


WATER QUALITY TREATMENT FACILITY APPROACH GRADING & PAVING

29V-50



(For Location, See Sht. 5A-2, Note 33)


- ① Delete The Thrie Beam Rail To Standard Guard Rail Transition Element (For Details, See Drg. No. RD570)
- ② At Transition Parabola Use Double Element Thrie Beam Guard Rail With 0.953 m Post Spacing (See Drg. No. RD430 For Parabola Post Offsets)
- ③ Const. Type 4 Guard Rail With 1.905 m Post Spacing Provide Type 1 Mod. Anchor At End Of Parabola (See Drg. No. RD400)

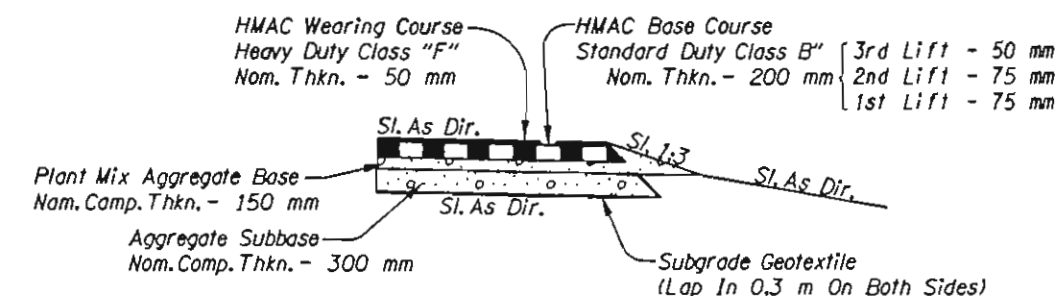

APPROACH SURFACING

HMAC Heavy Duty Class "F" = 6 Mg
 HMAC Standard Duty Class "B" = 27 Mg
 Plant Mix Aggregate Base = 19 Mg
 Aggregate Subbase = 38 Mg

APPROXIMATE SURFACING QUANTITIES

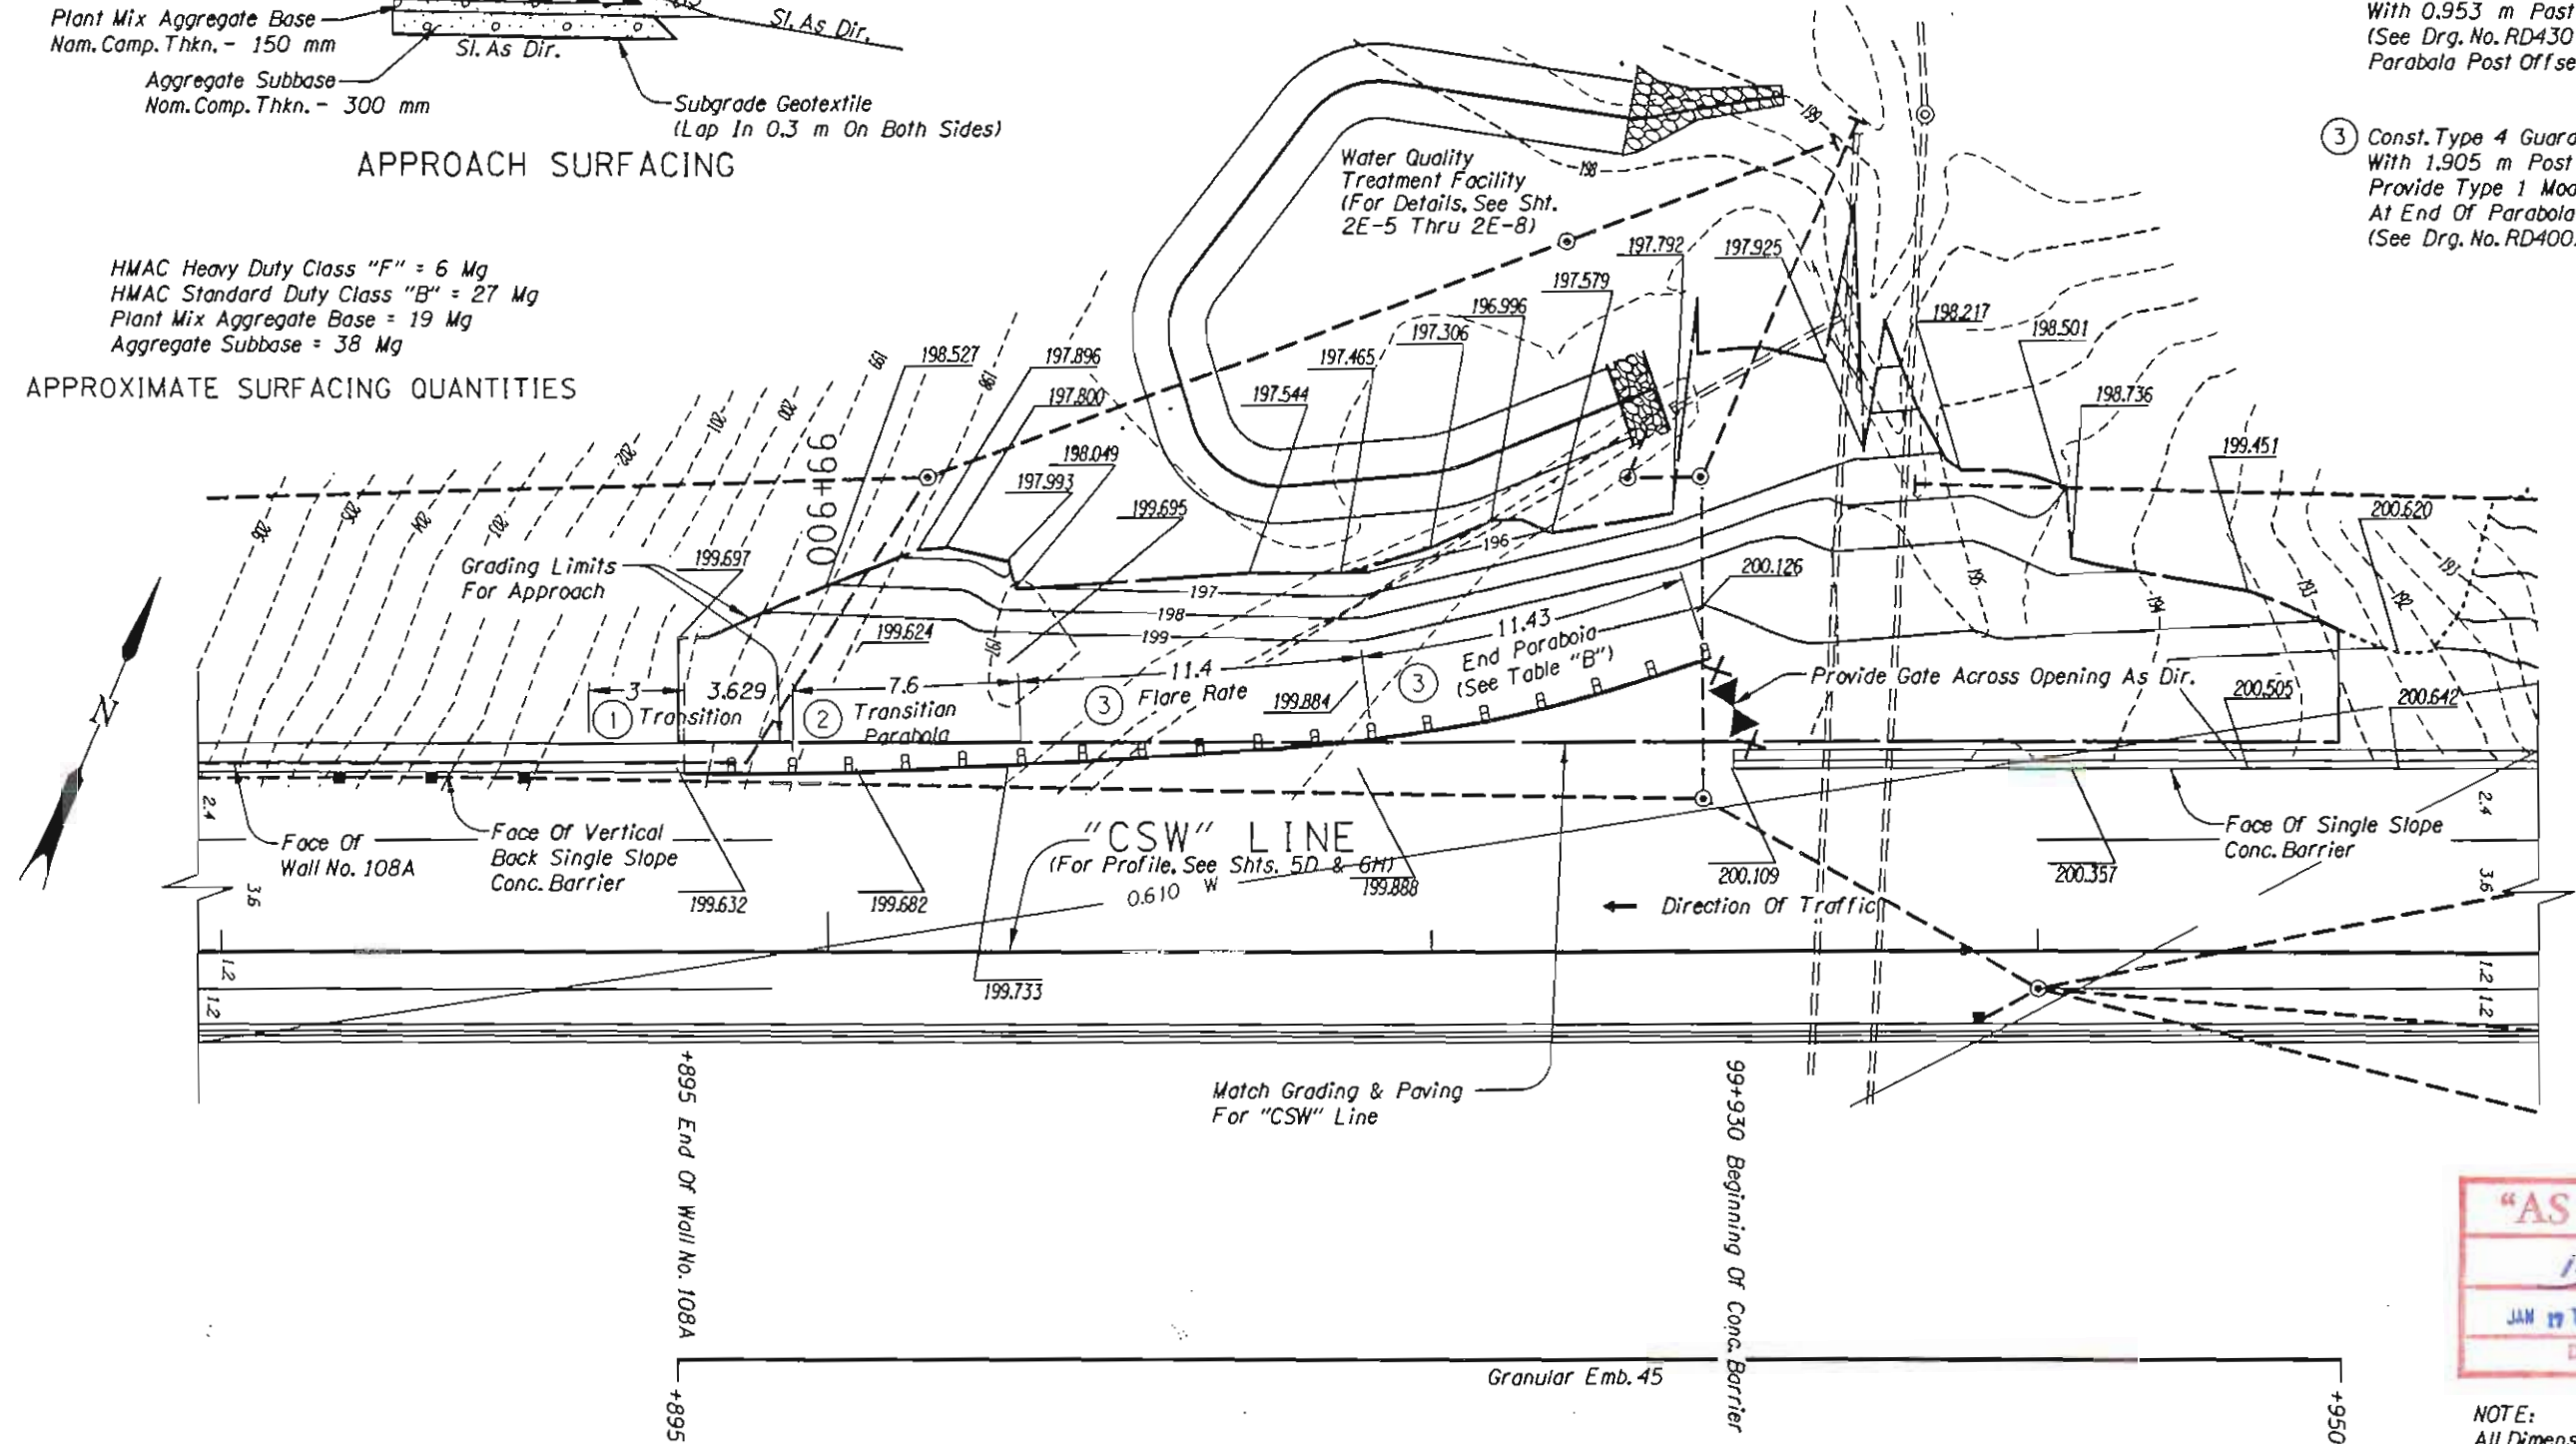

"AS CONSTRUCTED"
Bill Johnson
 Project Manager
 JAN 17 2008
 Date

NOTE:
 All Dimensions Are Shown In Meters
 Unless Otherwise Noted.

TABLE "B"

		END OF PARABOLA					
		P1	P2	P3	P4	P5	P6
X		1.905	3.810	5.715	7.620	9.525	11.430
Y		0.034	0.137	0.308	0.546	0.850	1.219


Extg. Contours, Shown Thus : 123
 Design Contours, Shown Thus : 123
 Finish Grade Elevations (Top Of Asphalt Concrete), Shown Thus : 123.456 F.G.

CAMELOT INTCHGE. - SYLVAN INTCHGE. (PHASE 1) SEC. SUNSET HIGHWAY MULTNOMAH & WASHINGTON COUNTIES		
FEDERAL HIGHWAY ADMINISTRATION	PROJECT NUMBER	SHEET NO.
REGION 10	OREGON DIVISION	2B-13


BRIDGE DETAILS CHECKED
 C:\PROJECT\SUBOT\108A\SUBOT\108A.DWG
 01-SEP-1997 21:55

WATER QUALITY TREATMENT FACILITY DETAILS - BENZ PARK


29V-50

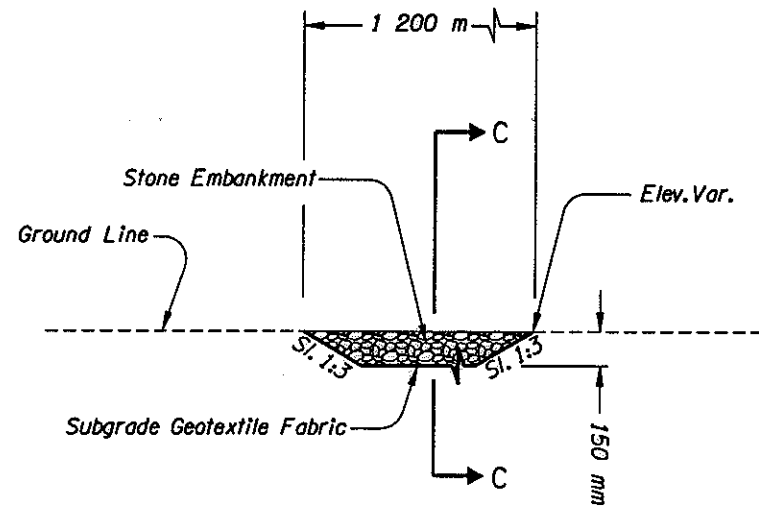


SPILLWAY

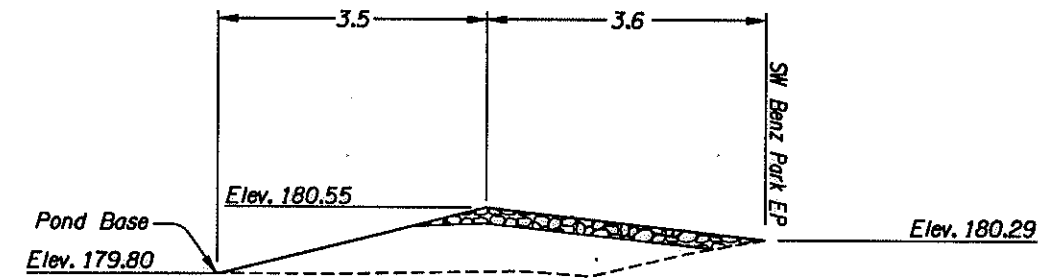

SECTION C-C
(For Location, See Sht. 2E)

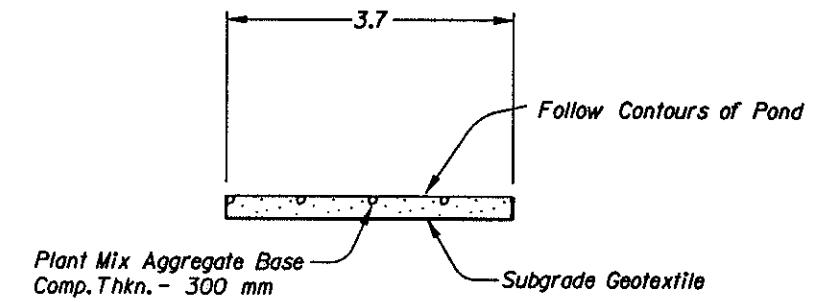

WATER QUALITY ACCESS ROAD

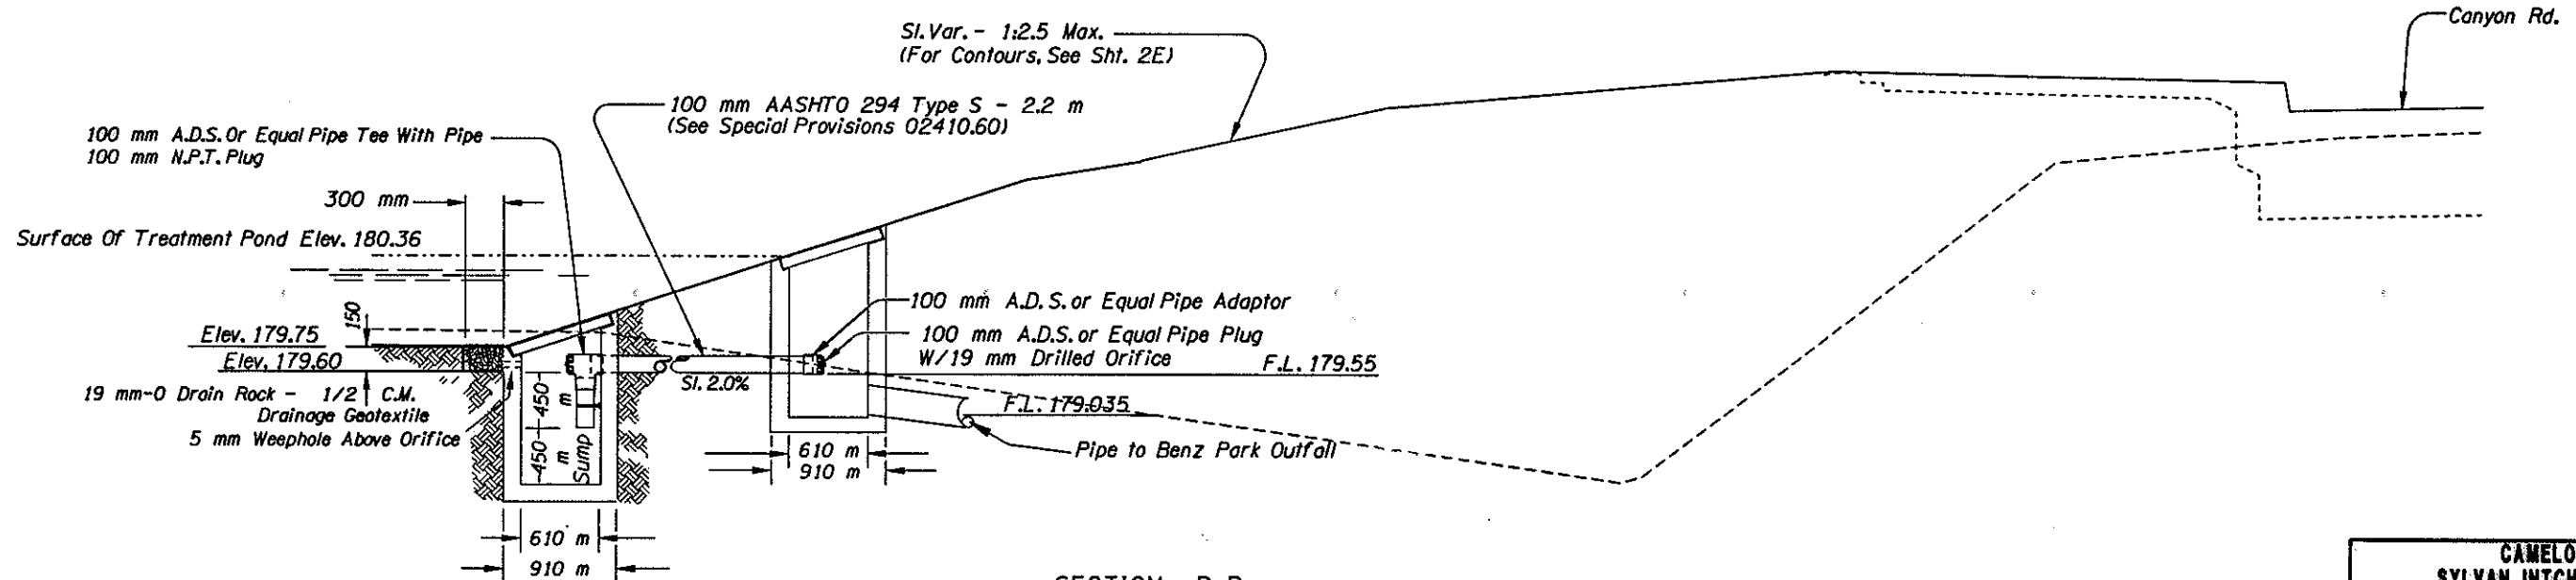

SECTION B-B


POND OUTLET STRUCTURE
(See USA Standard Drg. 150)

CAMELOT INTCHGE. - SYLVAN INTCHGE. (PHASE 1) SEC. SUNSET HIGHWAY MULTNOMAH & WASHINGTON COUNTIES		
FEDERAL HIGHWAY ADMINISTRATION	PROJECT NUMBER	SHEET NO.
REGION 10	OREGON DIVISION	2E-3

C:\USVA\PROJECT\SUB007\MAN\SUB007\02.dwg 07-SEP-1997 21:53

WATER QUALITY TREATMENT FACILITY DETAILS - SWALE

29V-50

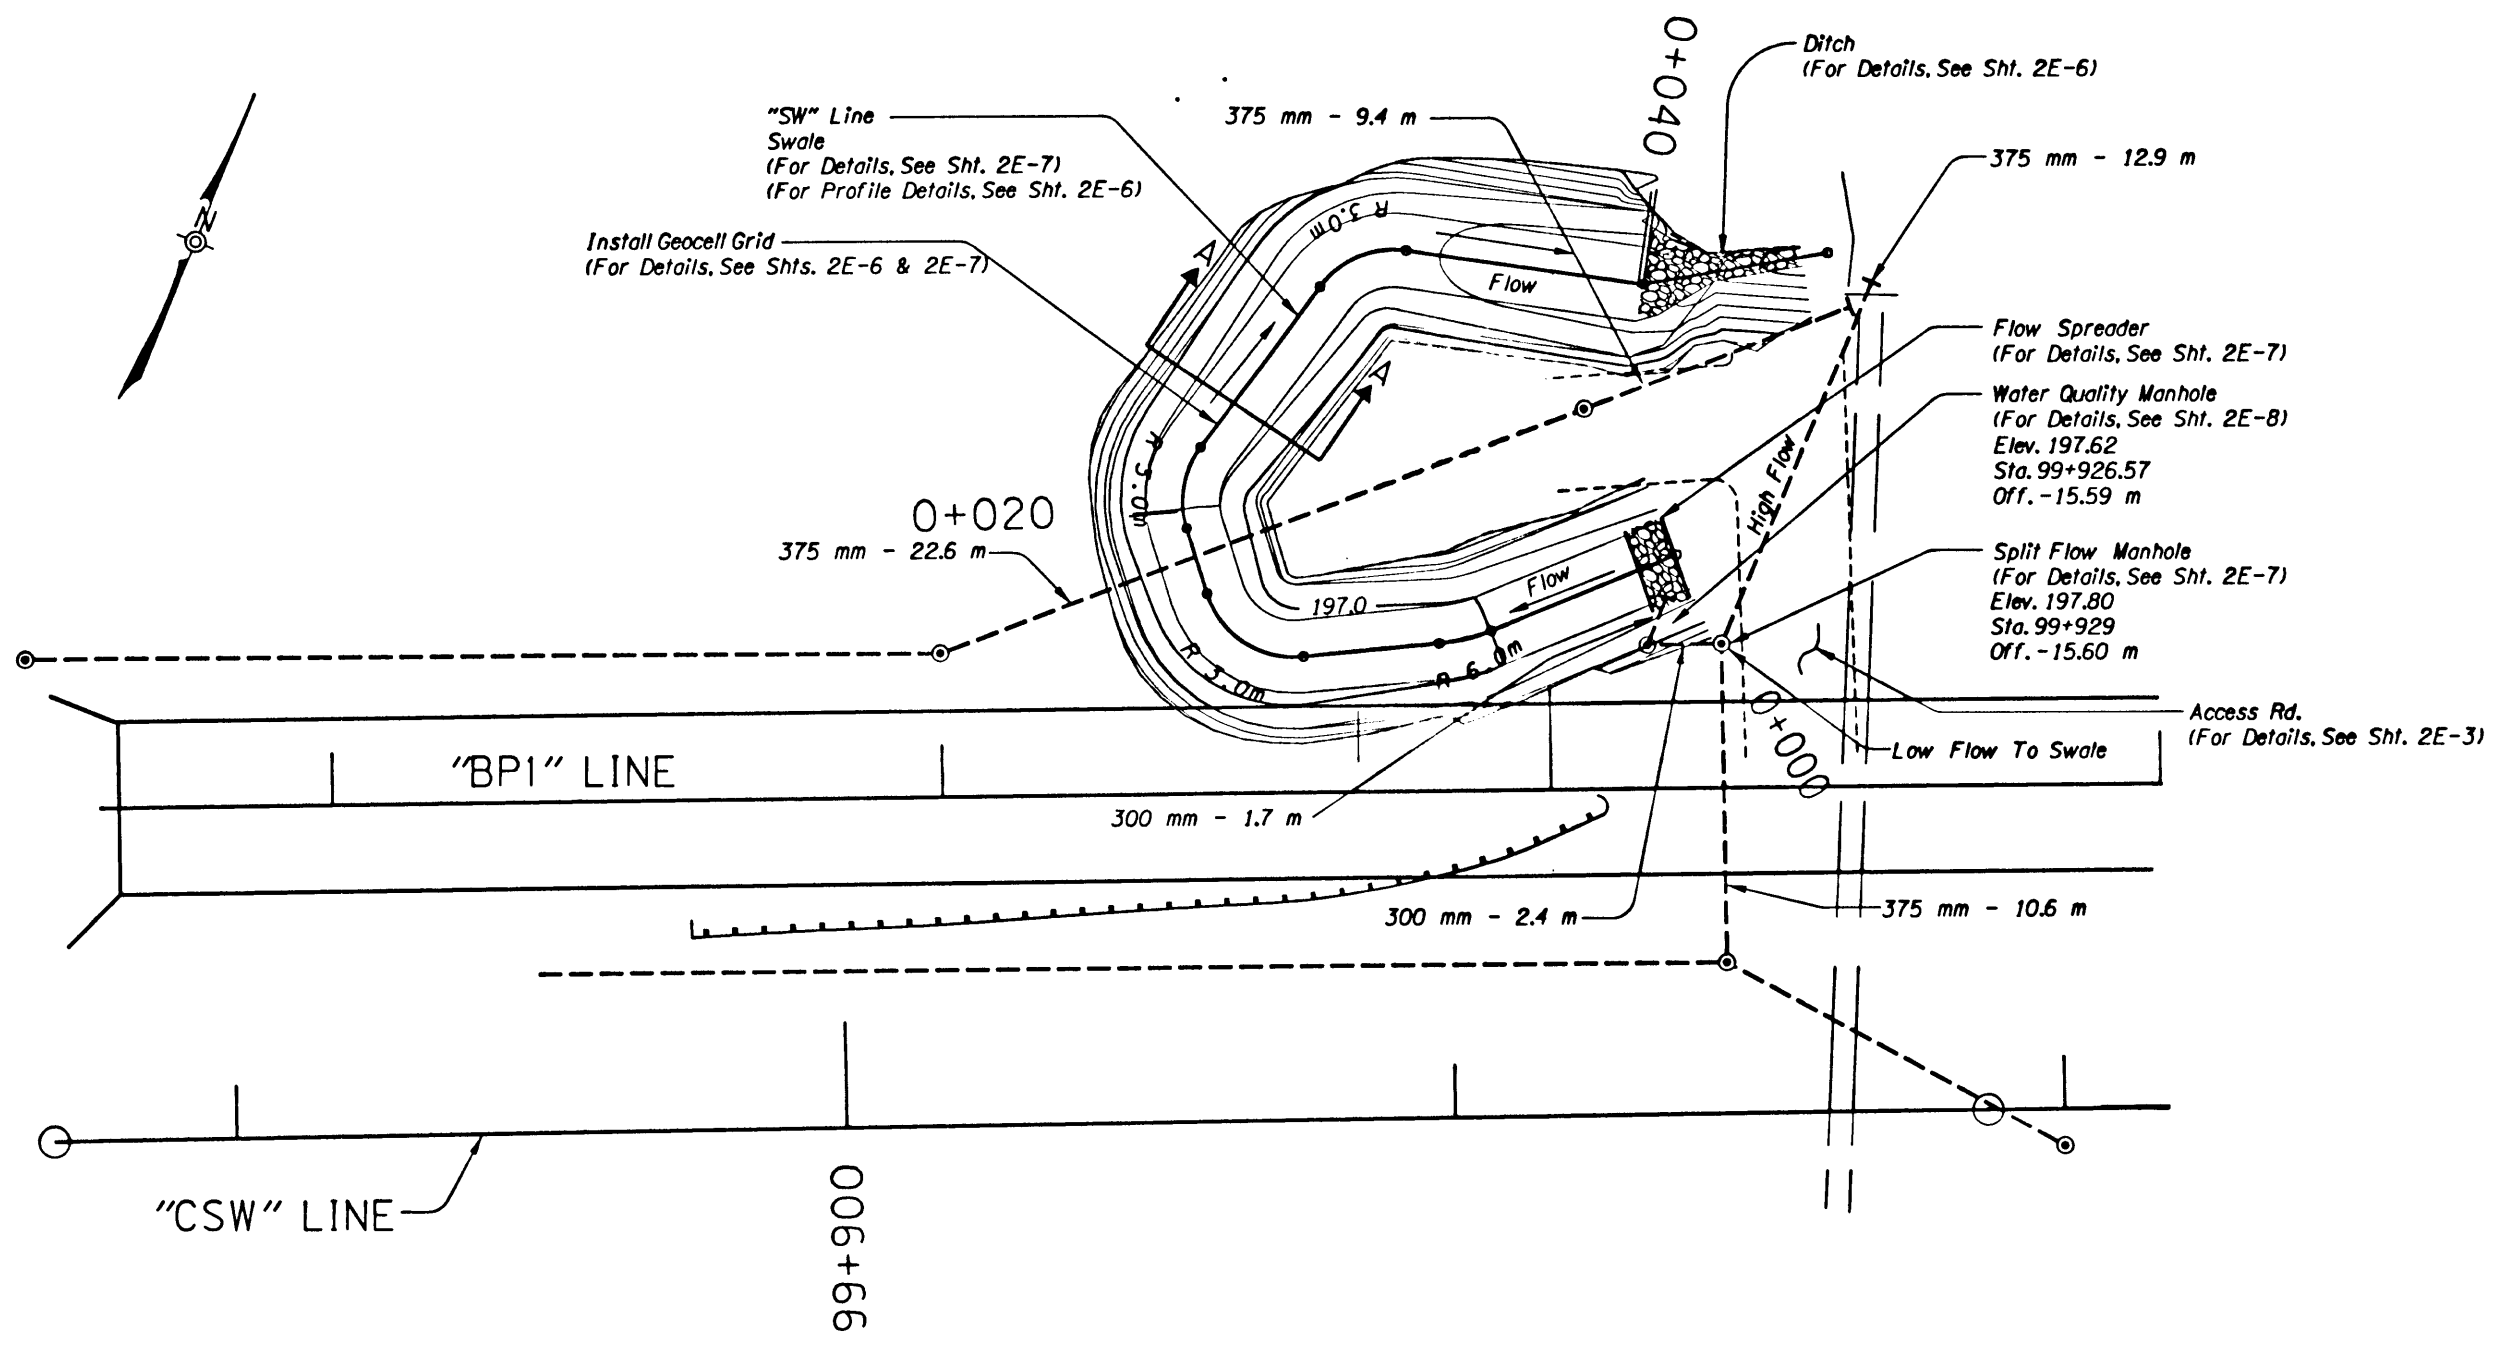


WATER QUALITY FACILITY APPROACH
(For Details, See Sht. 2B-13)

CAMELOT INTCHGE. - SYLVAN INTCHGE. (PHASE 1) SEC. SUNSET HIGHWAY MULTNOMAH & WASHINGTON COUNTIES		
FEDERAL HIGHWAY ADMINISTRATION	PROJECT NUMBER	SHEET NO.
REGION 10	OREGON DIVISION	2E-5

BRIDGE DETAILS CHECKED
 CIVIL PROJECT SUPERVISOR
 10-SEP-1991 2:14 PM
 VIEW 2


WATER QUALITY TREATMENT FACILITY DETAILS - SWALE

29V-50

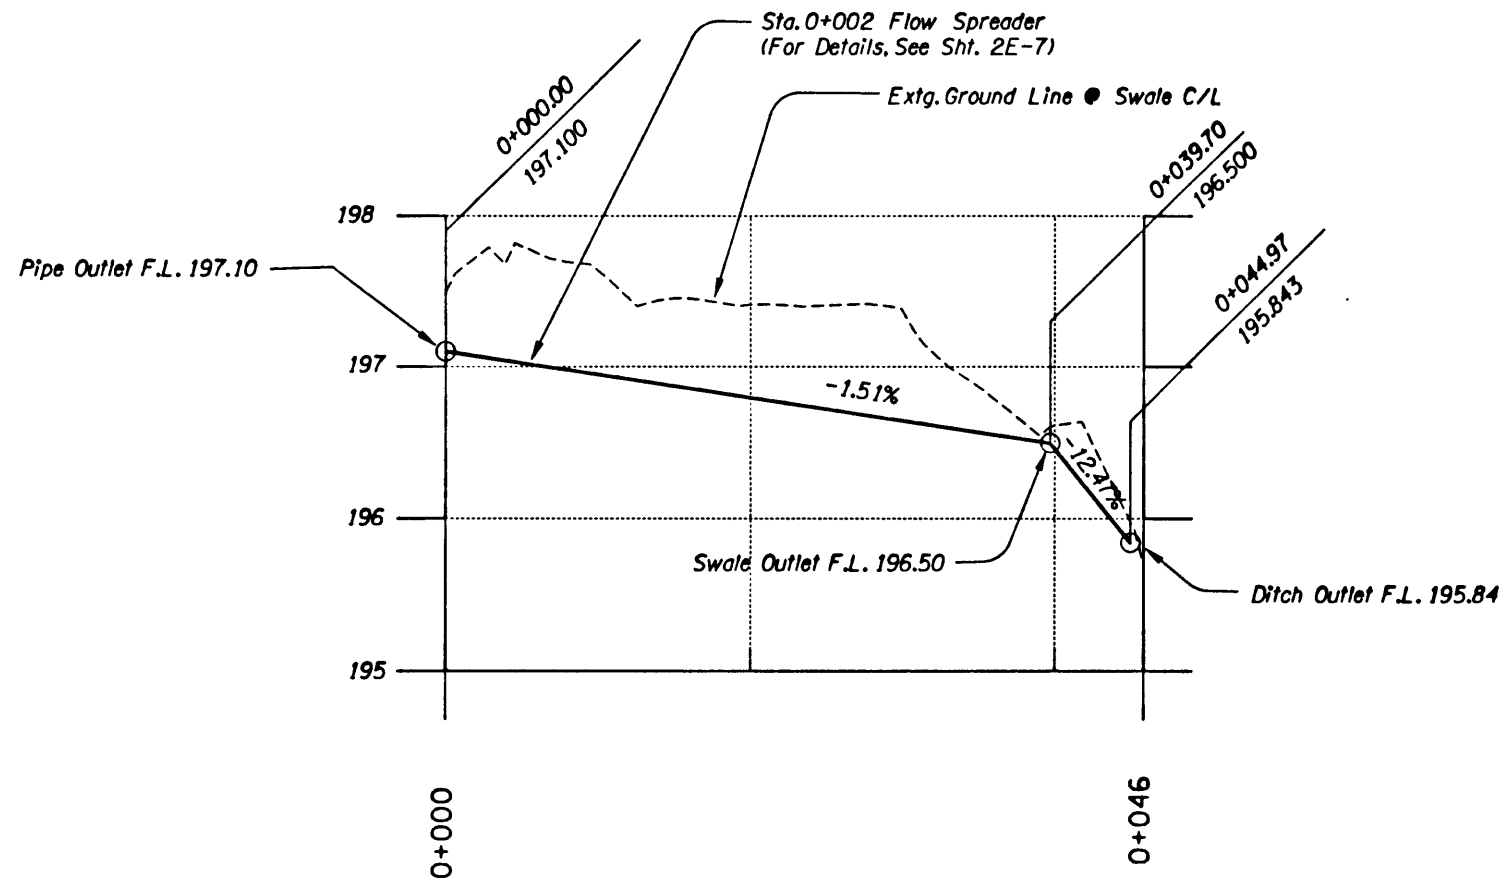


(For Swale Location, See Sht. 2E-5)

"SW" LINE
SWALE AT SYLVAN CULVERT

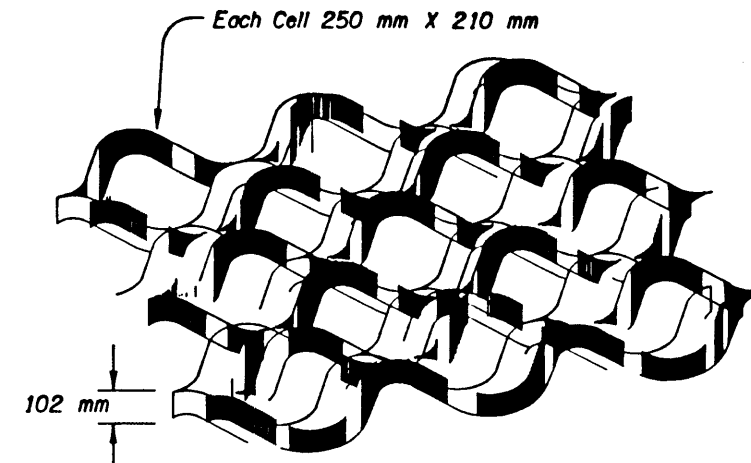

POLYETHYLENE GEOCELL GRID DETAIL

Perforated Geoweb Or Equal

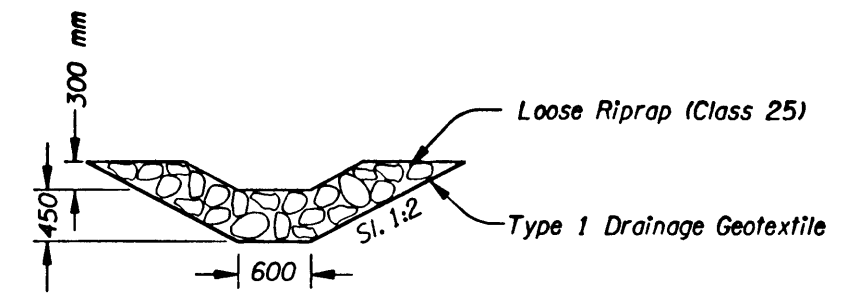

DITCH

CHECK PROJECT SUBMITTALS FOR DESIGN



07-SEP-1997 2154

VIEW 4


CAMELOT INTCHGE. - SYLVAN INTCHGE. (PHASE 1) SEC. SUNSET HIGHWAY MULTNOMAH & WASHINGTON COUNTIES		
FEDERAL HIGHWAY ADMINISTRATION	PROJECT NUMBER	SHEET NO.
REGION 10	OREGON DIVISION	2E-6

WATER QUALITY TREATMENT FACILITY DETAILS - SWALE


29V-50

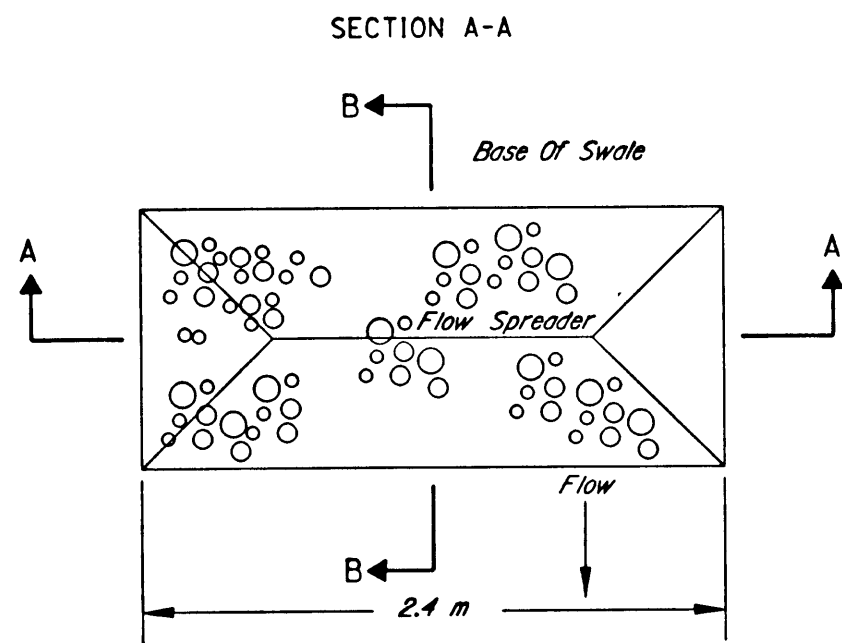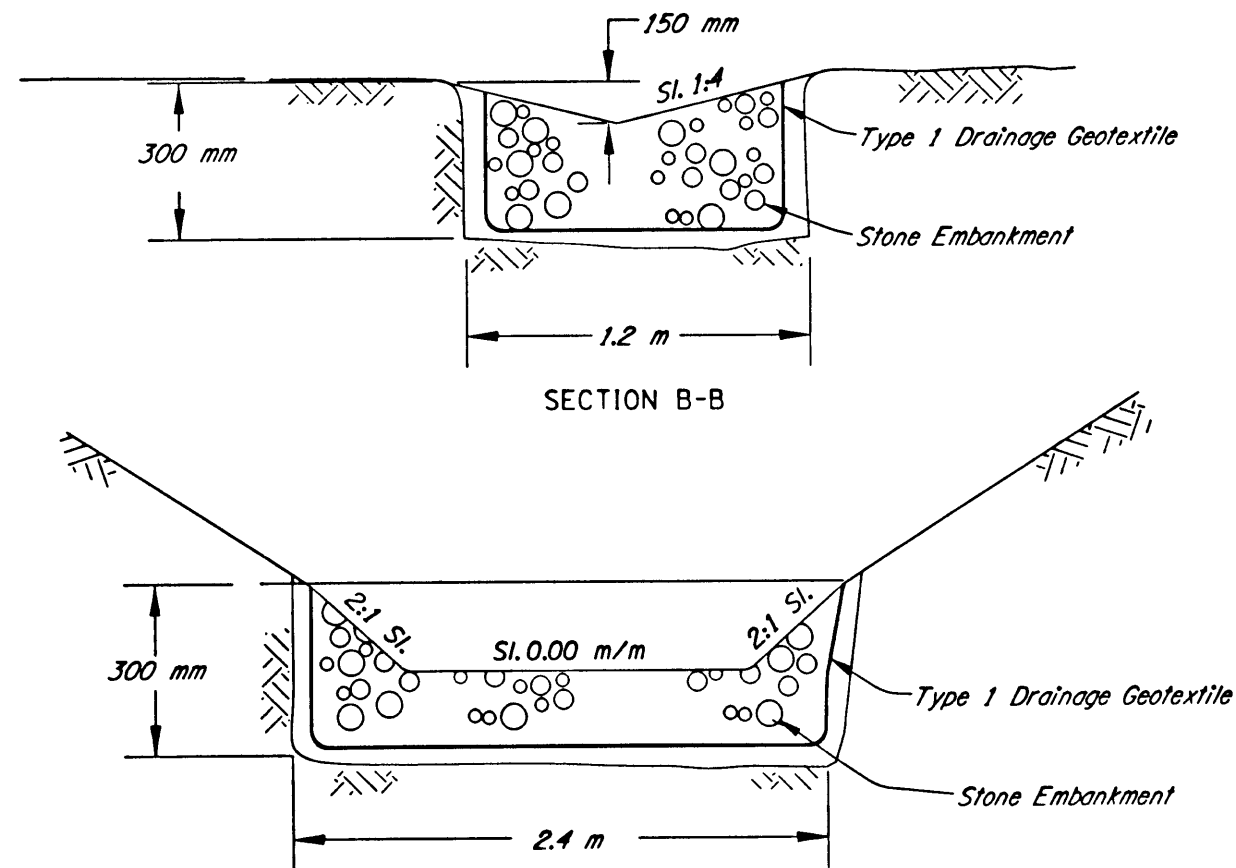

FLOW SPREADER

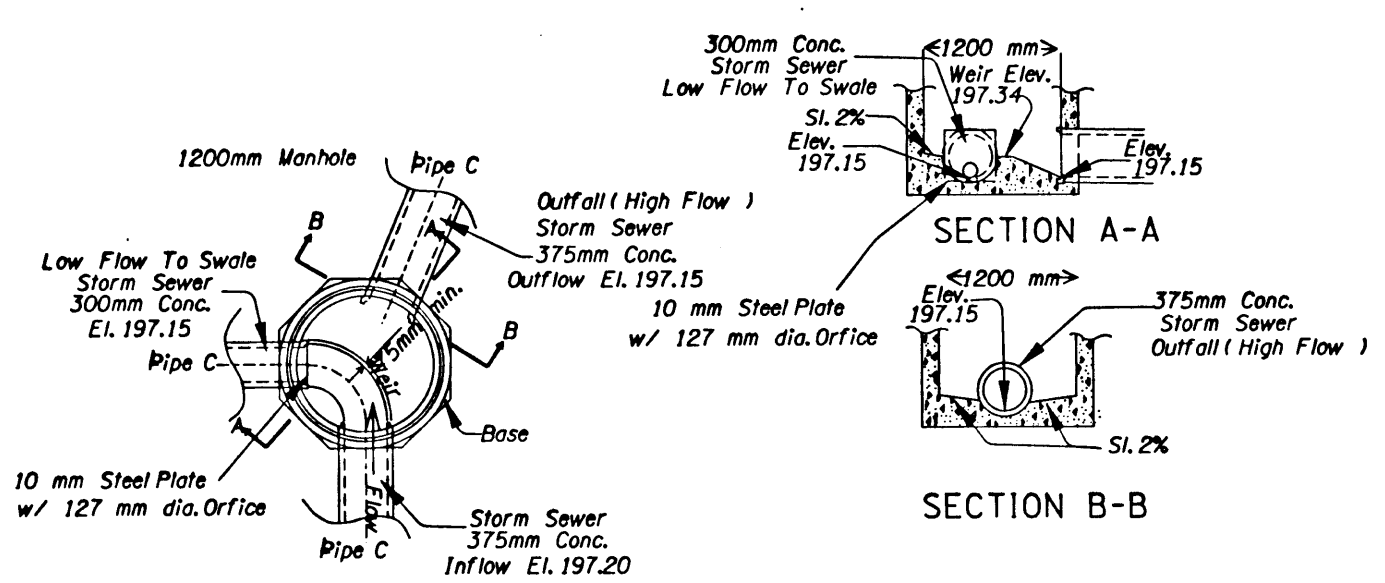

SPLIT FLOW MANHOLE
 "CSW" Sta. 99+929.00 15.60 LT
 (For Details Not Shown, See Drg. No. RD327, RD330, RD333)

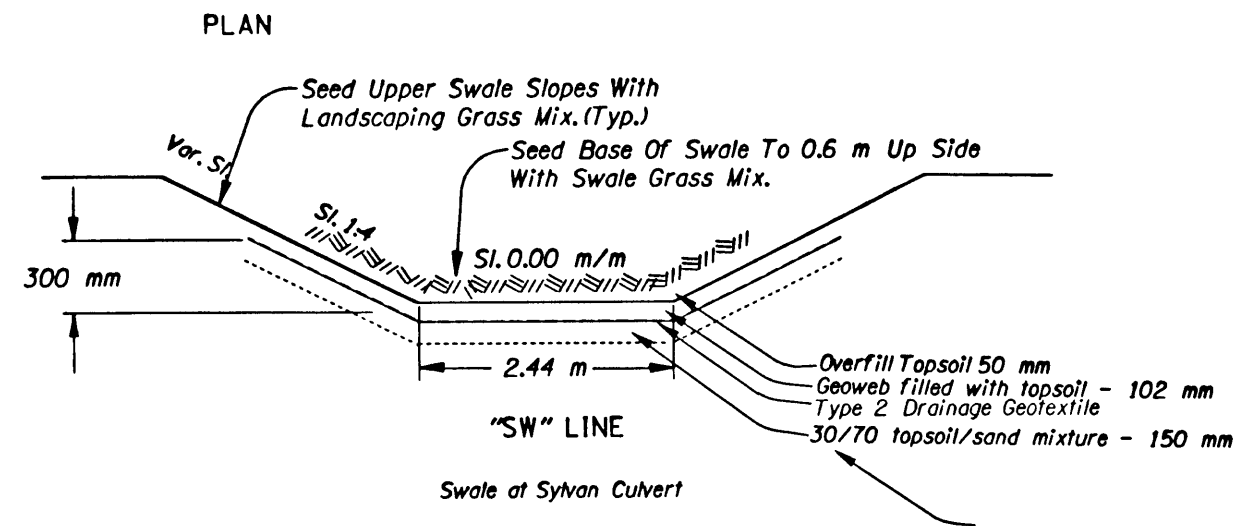

SECTION A-A

SWALE

CAMELOT INTCHGE. - SYLVAN INTCHGE. (PHASE 1) SEC. SUNSET HIGHWAY MULTNOMAH & WASHINGTON COUNTIES		
FEDERAL HIGHWAY ADMINISTRATION	PROJECT NUMBER	SHEET NO.
REGION 10	OREGON DIVISION	2E-7

C:\PROJECT\SUNSET\plan\080112.dwg


01-SEP-1991 2:14

WATER QUALITY MANHOLE - SWALE


29V-50



(All Dimensions Are In mm Unless Otherwise Noted)
"CSW" Sta. 99+926.57, 15.59 Lt.

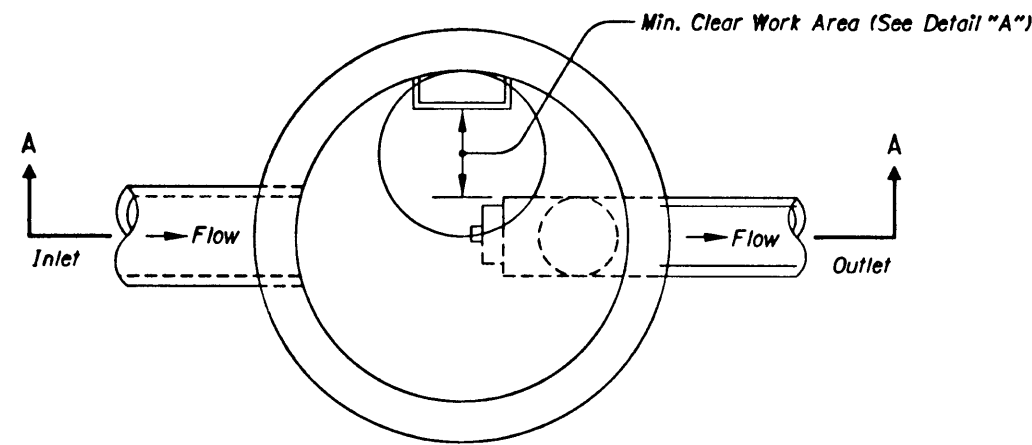


PLAN

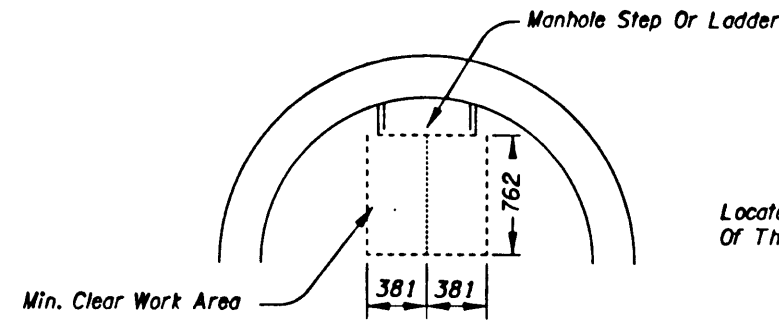

DETAIL "A"

Locate Pipes, Etc. So That No Portion
Of Them Are Within Min. Clear Work Area

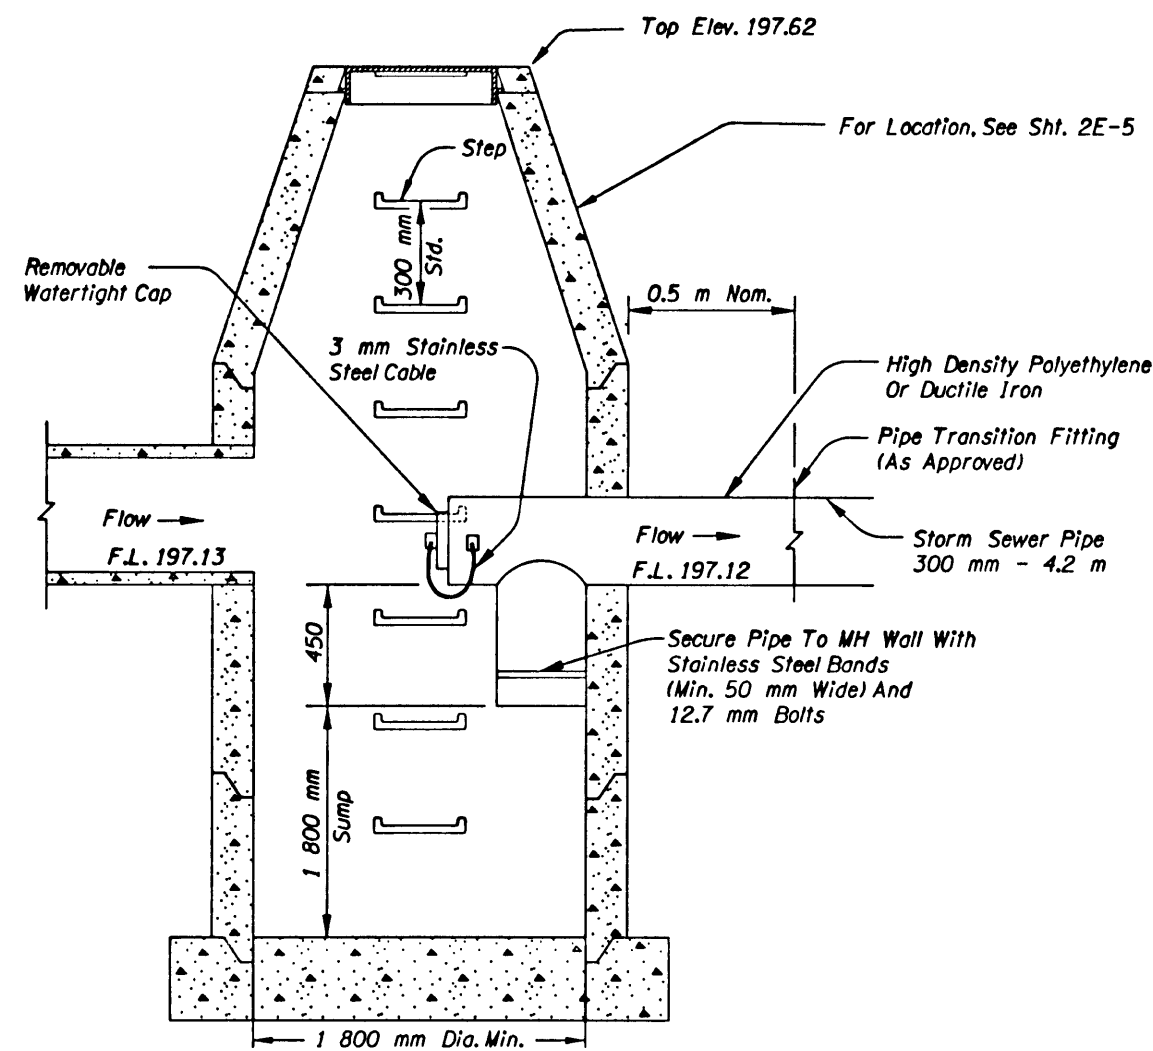

SECTION A-A

(For Details Not Shown, See Manhole Standard Drawings)

NOTES:

1. Hardware, Fasteners And Anchors To Be Stainless Steel; Use 3 mm Stainless Steel Cable
2. See Pipe Data Sheet And Plan Sheets For Pipe Size(s).
3. See Pipe Data Sheet And Plan Sheets For Manhole Size(s).
4. See Pipe Data Sheet And Plan Sheets For Sump Depth.
5. Manhole And Base Per Manhole Standard Drawings.
6. Hardware, Fasteners, Anchors, Fittings, Appurtenances, Labor And Equipment Is Incidental To Water Quality Manhole Item.


SUMP VOLUME REQUIREMENTS

Single Family Residential	.245 m ³ /hectare
Multi Family Residential	1.539 m ³ /hectare
Commercial/Industrial	6.577 m ³ /hectare

CAMELOT INTCHGE. - SYLVAN INTCHGE. (PHASE 1) SEC. SUNSET HIGHWAY MULTNOMAH & WASHINGTON COUNTIES		
FEDERAL HIGHWAY ADMINISTRATION	PROJECT NUMBER	SHEET NO.
REGION 10	OREGON DIVISION	2E-8

CAMELOT PROJECT SUBMITTAL DRAWING

01-SEP-1991 2154

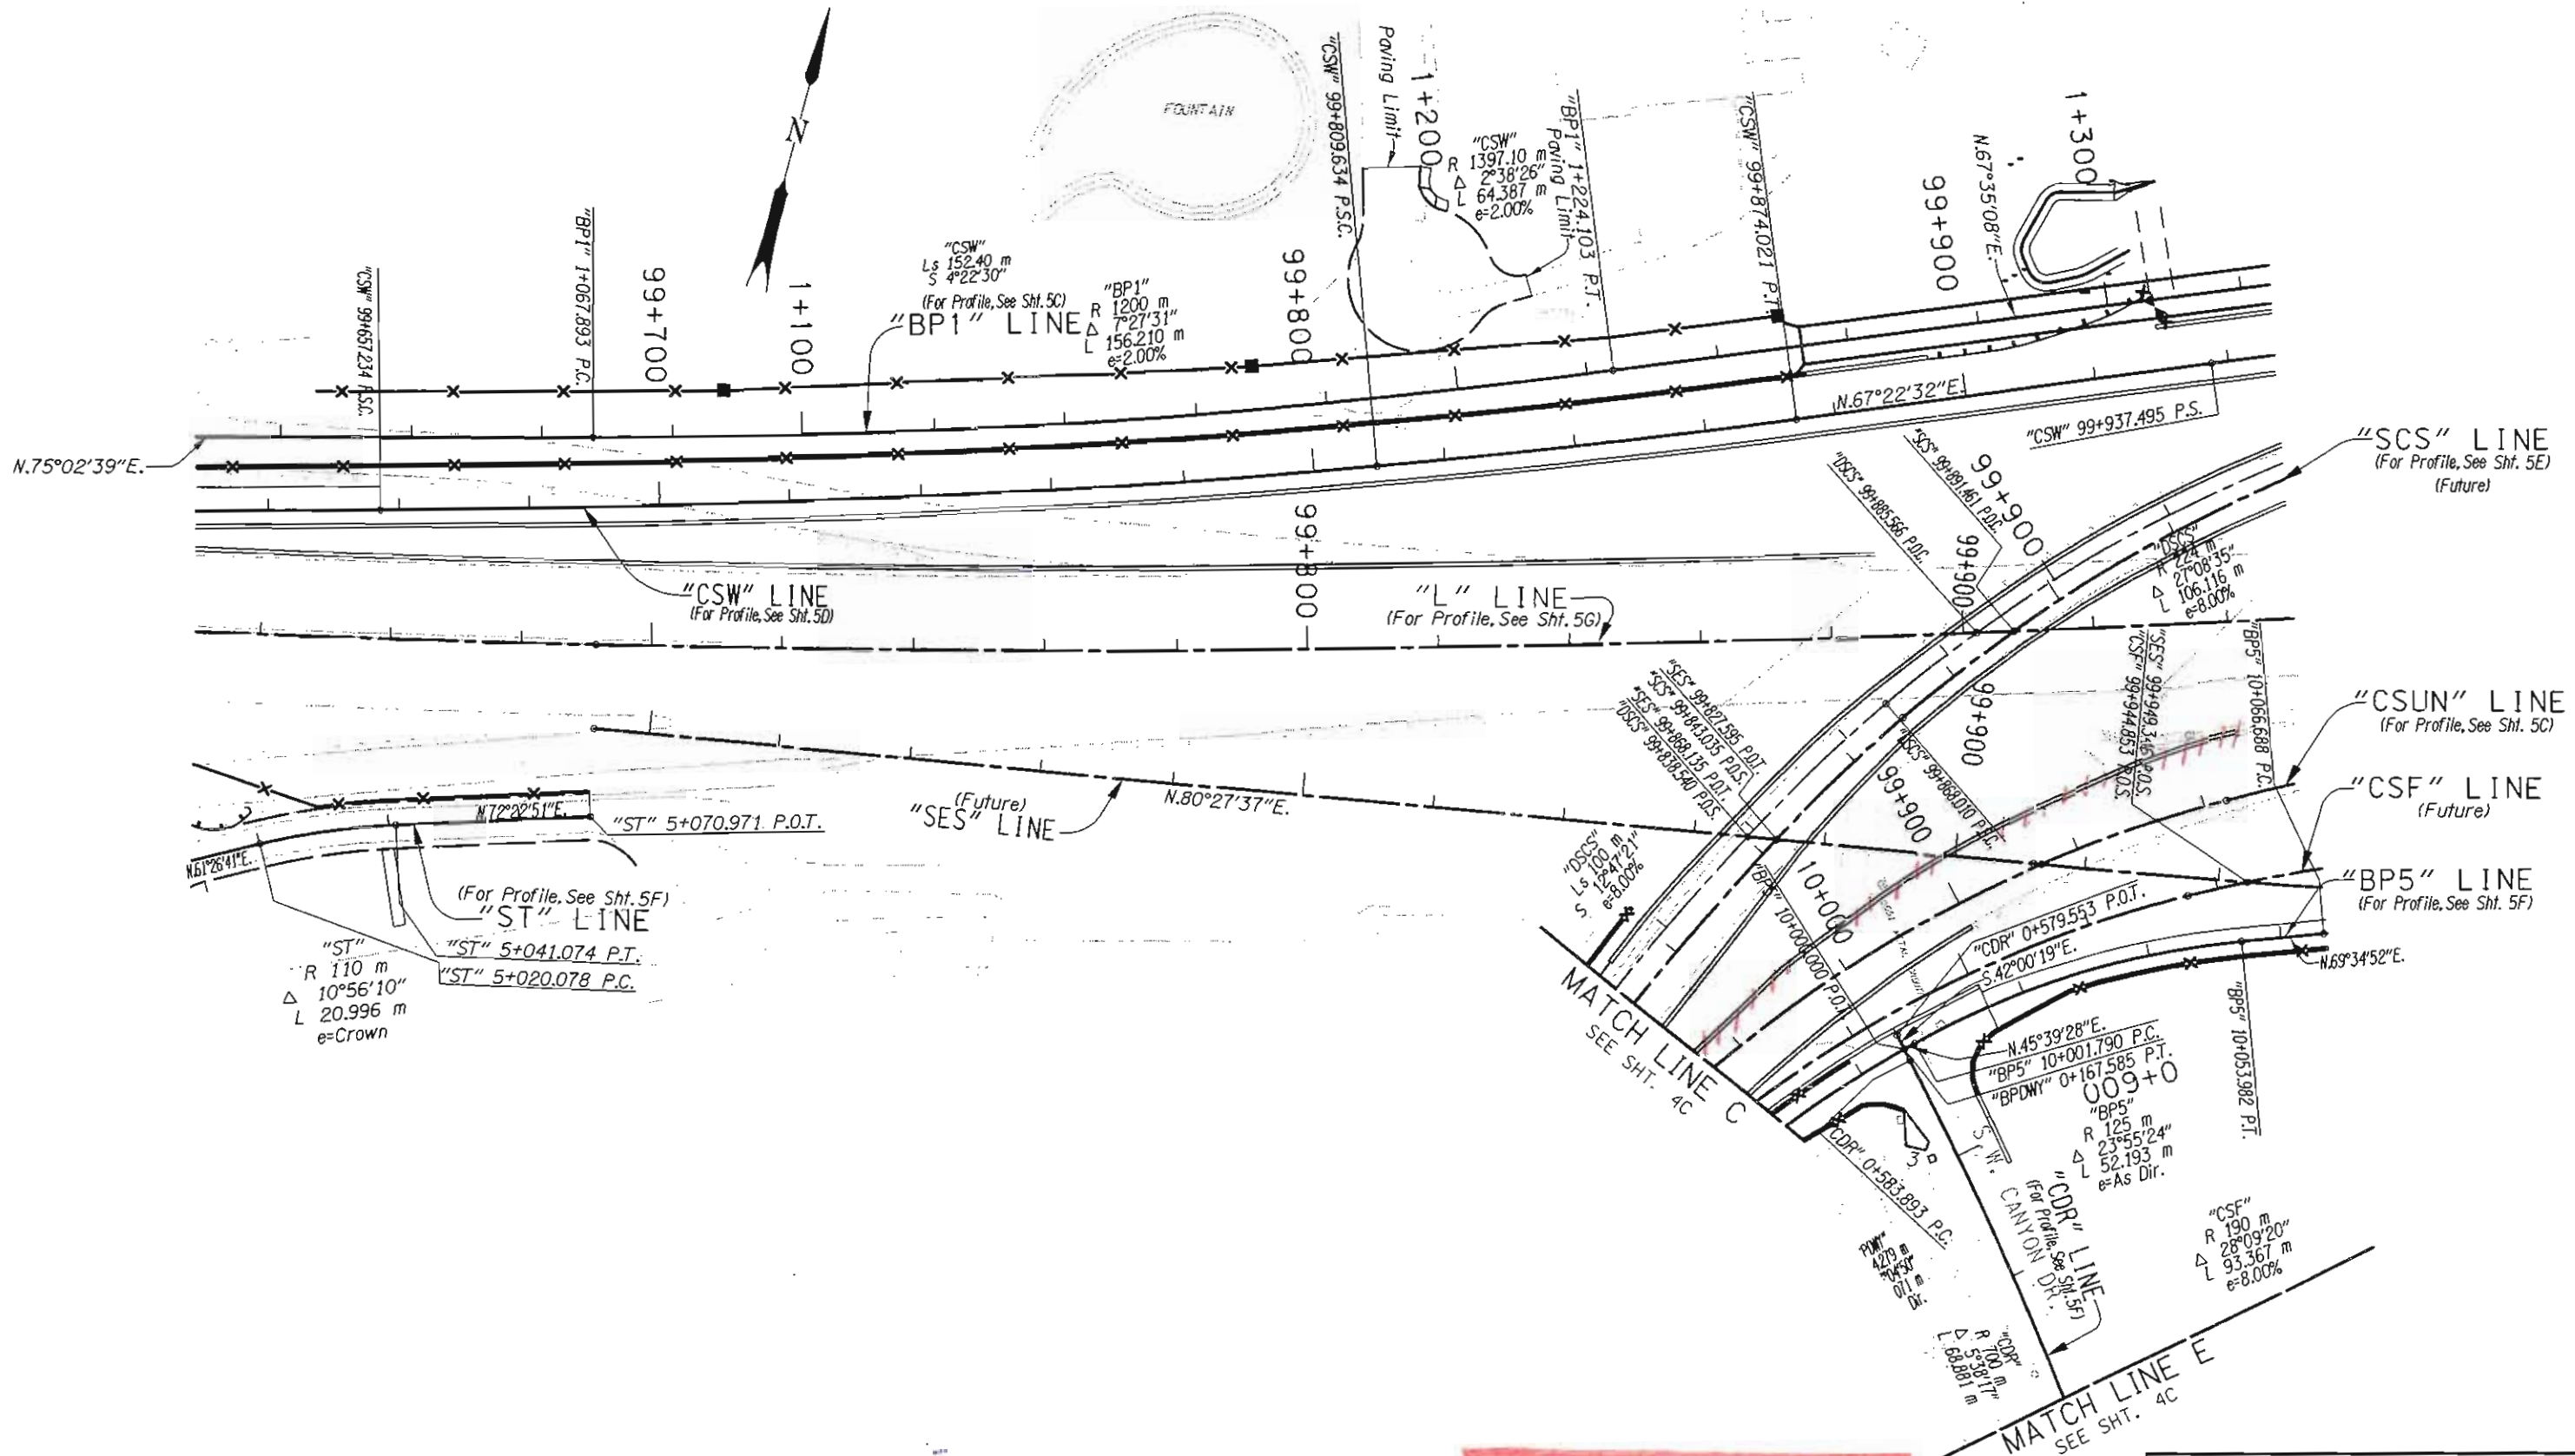

BRIDGE DETAILS CHECKED

C:\WP\PROJECTS\2000\17\PLAN\29V-50\17.P2

08-SEP-1997 11:17

VIEW 5

"AS CONSTRUCTED"

 Project Manager
 Date: JAN 17 02

CAMELOT INTCHGE. - SYLVAN INTCHGE. (PHASE 1) SEC. SUNSET HIGHWAY MULTNOMAH & WASHINGTON COUNTIES		
FEDERAL HIGHWAY ADMINISTRATION	PROJECT NUMBER	SHEET NO.
REGION 10	OREGON DIVISION	5



BRIDGE DETAILS CHECKED

CIVIL PROJECT SUPERVISOR/NOV/07/12/12

07-SEP-1997 23:37

- ① Remove Guard Rail
- ② See Sht. 4A-2, Note 3
Const. Retaining Wall No. 108A
- ③ Bridge No. 18210
Sta. "BP1" 1+257.147 To Sta. "BP1" 1+351.947
Const. Structure - 94.8 m
(See Drg. Nos. 55179 Thru 55192)
- ④ See Sht. 3, Note 1
Const. Single Slope Conc. Barrier
- ⑤ Const. Asph. Conc. Appr. - 2
- ⑥ Const. Type "T" Cul-De-Sac
(For Details, See Sht. 2B-19)
- ⑦ Const. Type "CIRCULAR" Cul-De-Sac
(For Details, See Sht. 2B-15)
- ⑧ Sta. "DSCS" 99+821 To Sta. "DSCS" 100+001, Lt.
Const. Single Slope Conc. Barrier - 180 m
- ⑨ Const. Type "C" Curb
- ⑩ See Sht. 4D-2 Note 4D
Const. Single Slope
Conc. Barrier - 180 m
- ⑪ Const. Sidewalk Ramp
- ⑫ Const. Retaining Wall #123 To
Standard Conc. Barrier Transition - 3.81 m
(For Details, See Sht. 2B-22)
- ⑫A Const. Conc. Barrier Terminal - 7.62 m
(See Drg. No. RD510)
- ⑬ See Sht. 4A-2, Note 14
Const. Single Slope Conc. Barrier
- ⑬A Place Leading End Behind
Sidewalk For Protection
- ⑭ See Sht. 4D-2, Note 24
Const. Single Slope Conc. Barrier
- ⑭A Const. Guard Rail Connection To
Single Slope Conc. Barrier
(See Drg. No. RD570)
- ⑮ Sta. "CSW" 99+930 To Sta. "SWC" 100+640.5
Const. Single Slope Conc. Barrier - 710.5 m
- ⑯ See Sht. 4A-2, Note 19
Const. Single Slope Conc. Barrier
- ⑰ See Sht. 4D-2, Note 24
Const. Single Slope Conc. Barrier
- ⑱ Const. P.C. Conc. Sidewalk
1.8 m Wide, 11.5 m Long
Match Extg. Sidewalk Width
Nom. Thkn. - 100 mm
Provide Aggregate Leveling Course
Nom. Comp. Thkn. - 50 mm
Slope As Directed
- ⑲ Inst. Removable Bollard
(For Details, See Sht. 2B-3)
- ⑳ Const. Type CL-4R Fence
- ㉑ See Sht. 4A-2, Note 18
Const. Wrought Iron Fence
(For Details, See Landscaping Plans)
- ㉒ Inst. Multiple Mailbox Support
- ㉓ See Sht. 4D-2, Note 22
Const. Single Slope Conc. Barrier
- ㉔ See Sht. 4D-2, Note 6
Const. Retaining Wall No. 124
- ㉕ See Sht. 4D-2, Note 5
Const. Retaining Wall No. 107
- ㉖ Bridge No. 18415
Sta. "CDR" 0+593.024 To Sta. "BP5" 10+102.979
Const. Retaining Wall No. 123
(See Drg. Nos. 55284 Thru 55289)
- ㉗ See Sht. 4D-2, Note 26
Const. Type CL-4 Fence
- ㉘ See Sht. 4D-2, Note 27
Const. Standard Pedestrian Rail
- ㉙ See Sht. 4D-2, Note 35
Const. Type CL-4R Fence
- ㉚ See Sht. 4A-2, Note 15
Const. Type CL-4 Fence
- ㉛ Const. Standard Pedestrian Rail
(See Drg. No. BR250)
- ㉜ Sta. "DSCS" 99+810.5 To Sta. "DSCS" 99+821
Const. Type "C" Curb To
Single Slope Conc. Barrier Transition
(See Drg. No. RD580)
- ㉝ Const. Water Quality Treatment Facility Appr.
(For Details, See Sht. 2B-13)
- ㉞ Const. Water Quality Treatment Facility
(For Details, See Shts. 2E-5 Thru 2E-8)
- ~~㉟ See Sht. 4D-2, Note 39
Const. Single Slope Conc. Barrier~~
- ㊱ See Sht. 4A-2, Note 21
Const. Guard Rail
- ㊲ Const. Monolithic Curb & Sidewalk
Match Extg. Sidewalk Width


"AS CONSTRUCTED"

Bill Edmondson
Project Manager

JAN 17 02
Date

To Face Sht. 5A

CAMELOT INTCHGE. - SYLVAN INTCHGE. (PHASE 1) SEC. SUNSET HIGHWAY MULTNOMAH & WASHINGTON COUNTIES		
FEDERAL HIGHWAY ADMINISTRATION	PROJECT NUMBER	SHEET NO.
REGION 10	OREGON DIVISION	5A-2

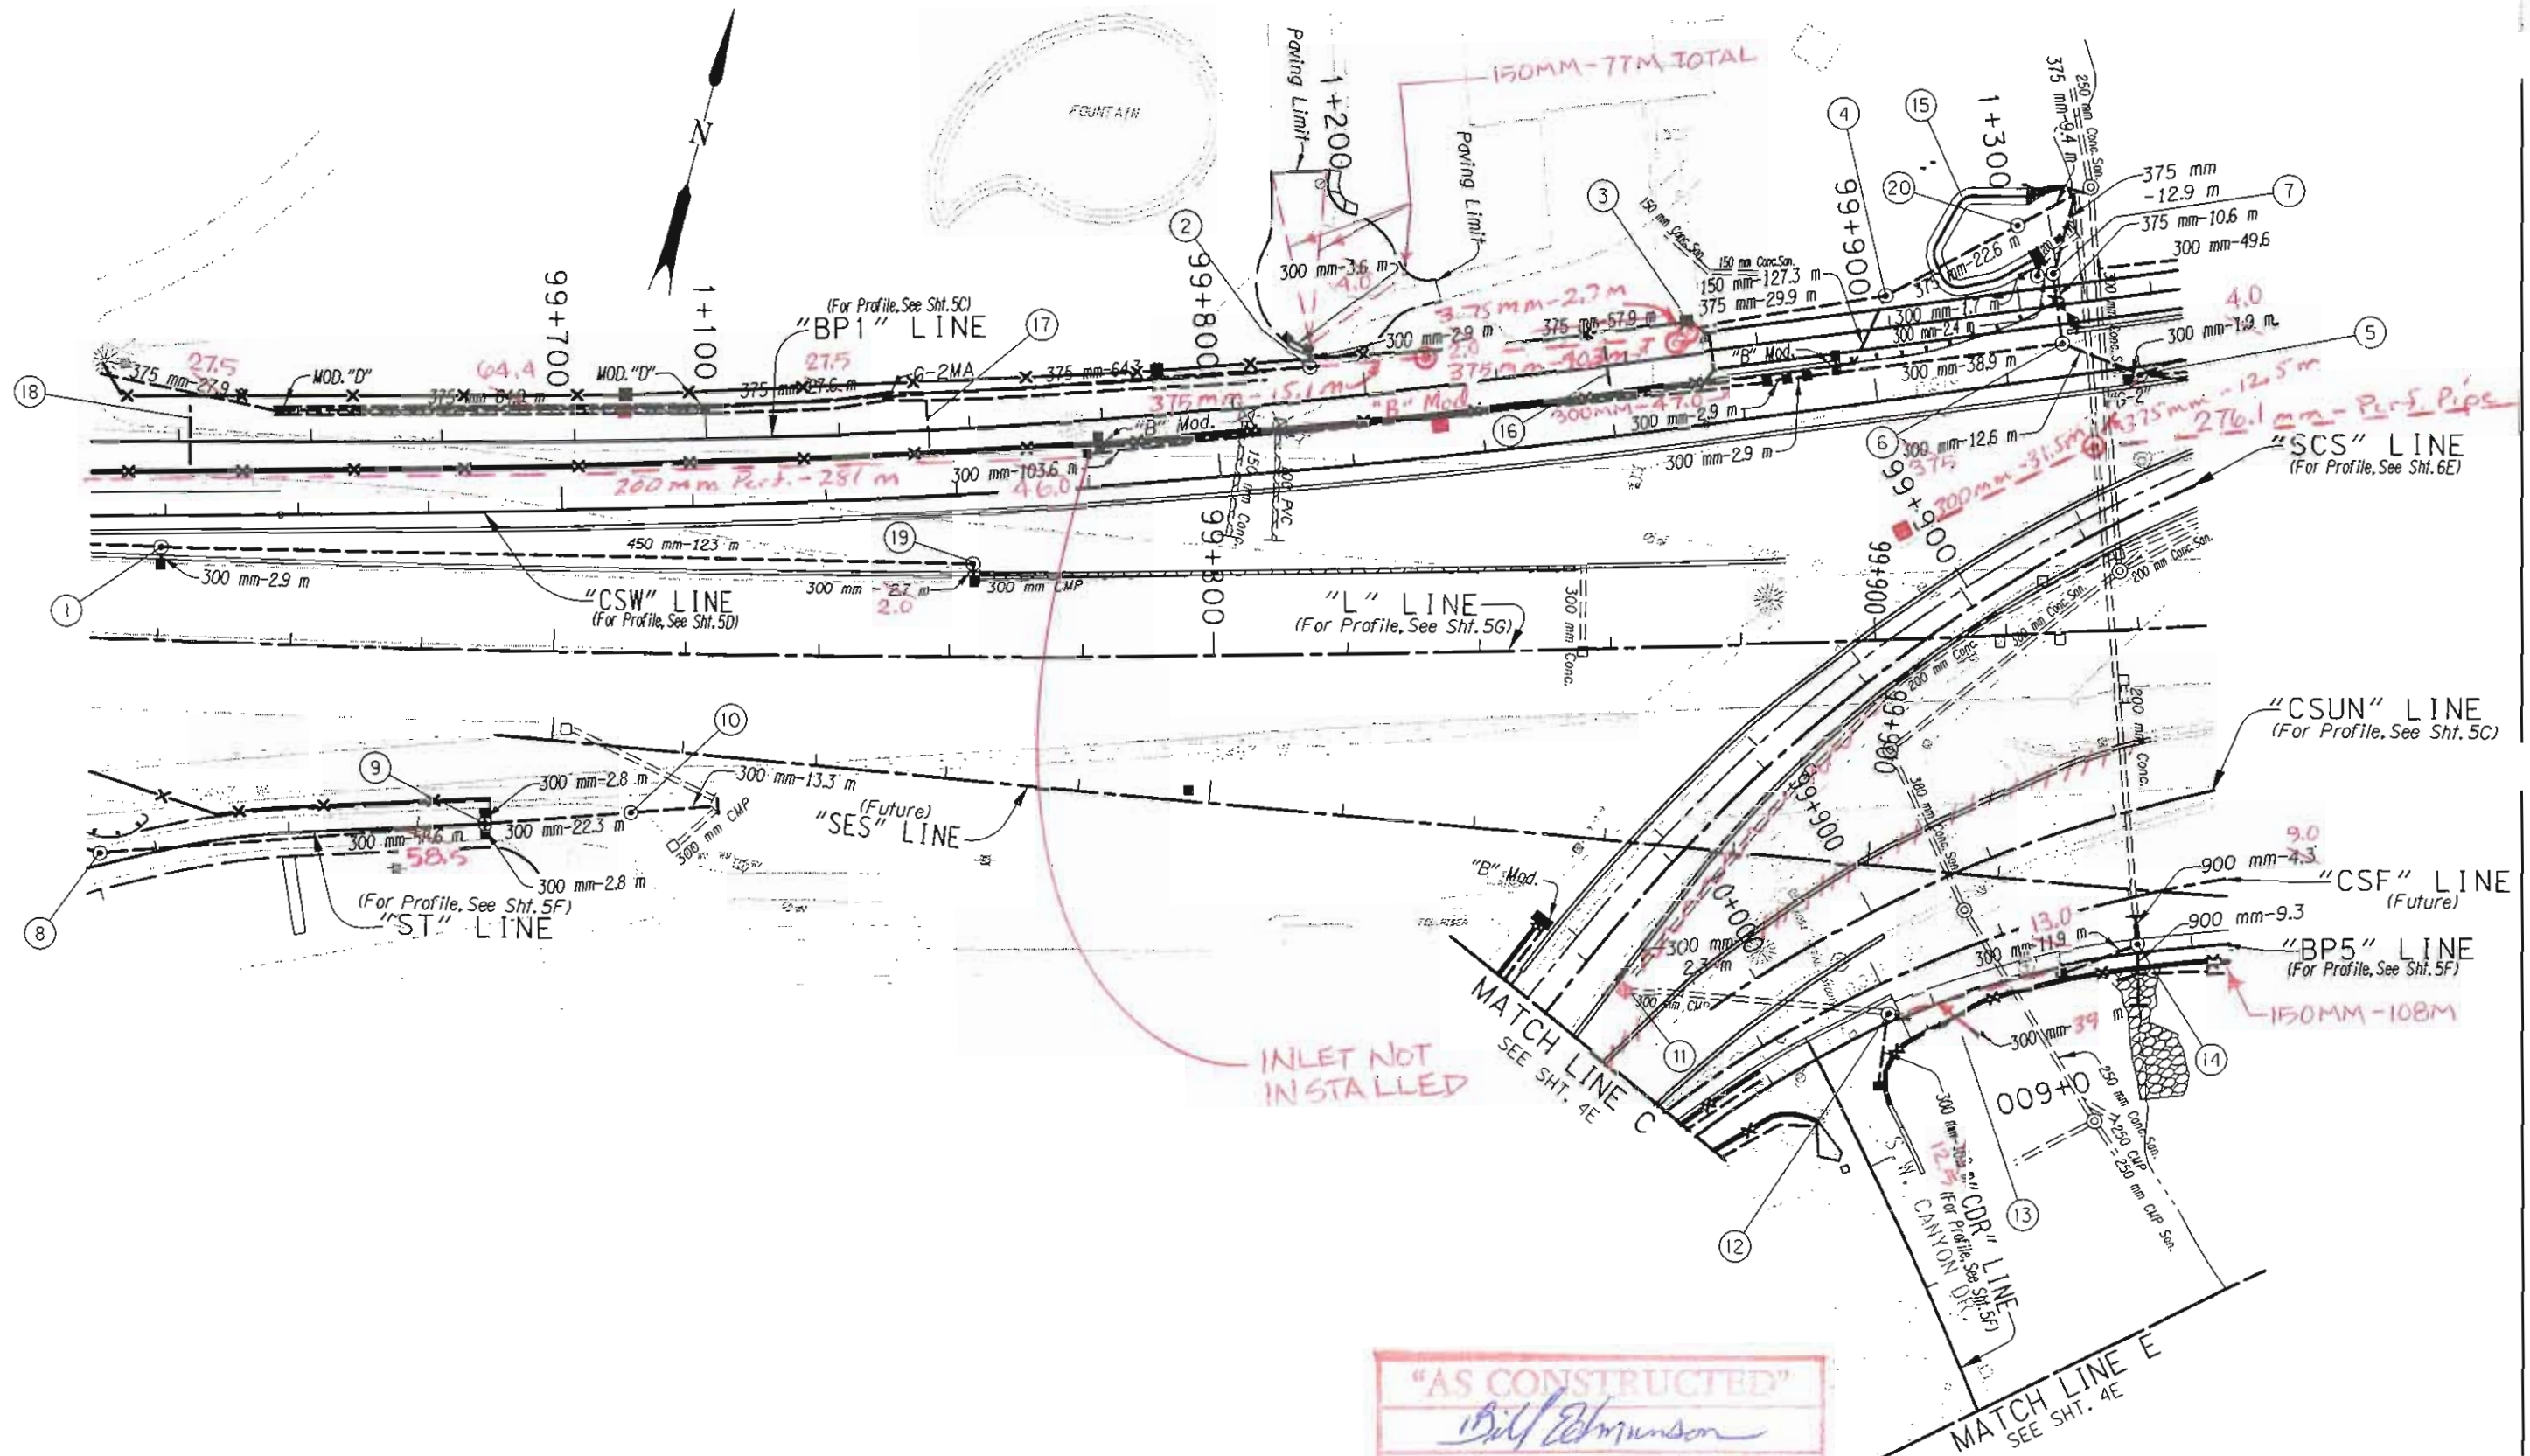

"AS CONSTRUCTED"
Bill Johnson
 Project Manager
 JAN 17 02
 Date

Abandon Pipe Shown Thus :

CAMELOT INTCHGE. - SYLVAN INTCHGE. (PHASE 1) SEC. SUNSET HIGHWAY MULTNOMAH & WASHINGTON COUNTIES		
FEDERAL HIGHWAY ADMINISTRATION	PROJECT NUMBER	SHEET NO.
REGION 10	OREGON DIVISION	5B

BRIDGE DETAILS CHECKED

CLASH PROJECTS SUBMIT PLANS 08/07/12

08-SEP-1997 11:31



1 See Sht. 4B-2, Note 5

2 Sta. "BP1" 1+192.5 m Lt.
Const. Ditch (As Dir. By Engineer)
Const. Manhole
Const. Type "D" Mod. Inlet - 2
Const. Type "G-2MA" Inlet - 2
Const. U.S.A. Type "CG-1" Inlet - 2
Inst. 300 mm Sew. Pipe - 6.5 m
Inst. 375 mm Sew. Pipe - 184.7 m
Const. Loose Riprap (Class 25) - 45 m³
Tr. Exc. - 307 m³
(See Drg. No. RD336)
(See U.S.A. Drg. Nos. 140A-ST, 140B-ST, & 150-ST)

150MM DRAIN PIPE - 77M
CG-2 - 2

3 Sta. "BP1" 1+250.38 m Lt. 2.5
Const. Manhole - 3
Inst. 375 mm Sew. Pipe - 57.9 m 57.0M
Tr. Exc. - 273 m³ 476m³
Sta. "BP1" 1+207.4.04 Lt.
Sta. "BP1" 1+247.40 Lt.

4 Sta. "BP1" 1+280.5 m Lt.
Const. U.S.A. Water Quality Manhole (1 500 mm)
Const. Wall Gutter Drain - 2
Const. Type "B" Mod. Inlet - 2
Inst. 150 mm Drain Pipe - 127.3 m
Inst. 375 mm Sew. Pipe - 29.9 m
Tr. Exc. - 124 m³
Rock Tr. Exc. - 54 m³
(For Details, See Sht. 2B-12)
(See U.S.A. Drg. Nos. 060-ST, 060A-ST & 100-ST)
(See Drg. Nos. RD330 & 55306)

5 Sta. "CSW" 99+940.120 m Rt.
Const. Manhole With Bolt Down Cover - Split Flow
Const. Type "G-2" Inlet
Const. Wall Gutter Drain - 3
Const. Type "B" Mod. Inlet - 2
Inst. 150 mm Drain Pipe - 188.4 m
Inst. 300 mm Drain Pipe - 734.6 m 494.0
Inst. 300 mm Sew. Pipe - 55.5 m 4.0
Inst. 300 mm Poly Sew. Pipe - 30.7 m
Tr. Exc. - 87 m³
(For Details, See Sht. 2B)
(See Drg. No. 55306)
Inst. 375mm Sew Pipe - 13.0 m

6 Sta. "CSW" 99+929.5 m Lt.
Const. Manhole With Bolt Down Cover
Const. Type "G-2" Inlet - 4
Inst. 300 mm Sew. Pipe - 160.9 m 138.0
Tr. Exc. - 78 m³
Rock Tr. Exc. - 115 m³
(For Details, See Sht. 2B)

Const Type "B" Mod. Inlet
Inst. 300mm Drain Pipe - 376.0M

7 Sta. "CSW" 99+929.15.60 m Lt.
Const. Split Flow Manhole
Inst. 375 mm Sew. Pipe - 23.5 m
Tr. Exc. - 30 m³
(For Details, See Sht. 2E-7)
INST. 300MM SEW. PIPE - 2M

8 See Sht. 4B-2, Note 7

9 Sta. "ST" 5+070
Const. U.S.A. Manhole
Const. U.S.A. Type "CG-1" Inlet - 2
Inst. 300 mm Sew. Pipe - 64.2 m
Tr. Exc. - 51 m³
(See U.S.A. Drg. Nos. 010-ST, 140A-ST, 140B-ST & 150-ST)

10 Sta. "SES" 99+713.9.85 m Rt.
Const. Water Quality Manhole (1 500 mm)
Inst. 300 mm Sew. Pipe - 35.6 m
Under Pymt. - 22.3 m
Tr. Exc. - 26 m³
(For Details, See Sht. 2B-12)
(See Drg. No. RD330)

11 Sta. "DSCS" 99+819.02, 10.44 m Rt.
Remove Inlet
Const. Type "B" Manhole
Connect To Extg. Pipe
Const. Type "G-2" Inlet
Inst. 300 mm Sew. Pipe - 2.3 m
Tr. Exc. - 1 m³

12 Sta. "CDR" 0+580.72, 12.74 m Lt.
Const. U.S.A. Water Quality Manhole (1 500 mm)
Connect To Extg. Pipe
Const. Type "G-2" Inlet
Inst. 300 mm Sew. Pipe - 18.9 m 13.0
Tr. Exc. - 7 m³
(For Details, See Sht. 2B-12)
(See U.S.A. Drg. No. 100-ST)
(See Drg. No. RD330)

13 Sta. "BP5" 10+022.03, 4.59 m Rt.
Const. U.S.A. Manhole
Inst. 300 mm Sew. Pipe - 39.5 m
Tr. Exc. - 59 m³

14 Sta. "BP5" 10+051.72, 1.30 m Lt.
Const. Energy Dissipation Manhole
Const. Type "G-1" Inlet
Inst. 300 mm Sew. Pipe - 11.0 m 52 m
Inst. 900 mm Sew. Pipe - 73.6 m 18.0M
Const. Loose Riprap (Class 350) - 53 m³
Const. Loose Riprap (Class 1000) - 75 m³
Const. Stone Embankment 193 m³
Inst. Type 2 Riprap Geotextile - 42 m²
Inst. Willow Cuttings - 225
Tr. Exc. - 46 m³
(For Details, See Shts. 2B-10 & 2B-11)
(See Drg. No. RD336)

15 Sta. "CSW" 99+926.57, 15.59 m Lt.
Const. U.S.A. Water Quality Manhole
Const. Water Quality Swale
Inst. 300 mm Sew. Pipe - 4.1 m
Inst. Drainage Geotextile (Type 1) - 35 m²
Const. Stone Embankment - 6 m³
Const. Loose Riprap (Class 25) - 4 m³
Const. Geocell Grid - 120 m²
Inst. Plant Mix Aggr. Base - 61 m³
Inst. Subgrade Geotextile - 95 m²
Inst. Water Quality Seed Mix - 250 m²
Topsoil Sand (30/70) - 18 m³
Topsoil - 18 m³
Tr. Exc. - 5 m³
(For Details, See Shts. 2E-5 Thru 2E-8)
(See U.S.A. Drg. No. 100-ST)

16 See Sht. 4B-2, Note 8

17 Inst. 150 mm PVC Conduit - 7.2 m

18 Inst. 150 mm PVC Conduit - 8.2 m

19 Sta. "L" 99+763.59, 14.15 m Lt.
Const. Manhole
Const. Type "G-2" Inlet
Const. Trapped Catch Basin
Inst. 300 mm Sew. Pipe - 2.7 m 2.0
Rock Tr. Exc. - 2 m³
INST. 450MM SEW. PIPE - 123M

20 Sta. "BP1" 1+301.24, 12.65 m Lt.
Const. Manhole
Inst. 375 mm Sew. Pipe - 32 m
Tr. Exc. - 41.8 m³

21 Sta. "W108A" 0+280
Const. Asphalt
Gutter Drain
Inst. 200 mm
Perf. Pipe - 202 m
(For Details see sht. 55306)

22 Sta. "CSW" 99+932.05, 10.54 Rt.
Const. Manhole (1800mm)
Const. "D" Mod Inlet
Inst. 300 mm Sew. Pipe - 31.5 m
Connect Extg. 900 mm Sew.

"AS CONSTRUCTED"
Bill Edmundson
Project Manager
JAN 17 12
Date


last. 375 mm - 12.5
last 300mm Drain - 276.1m

CAMELOT INTCHGE. - SYLVAN INTCHGE. (PHASE 1) SEC. SUNSET HIGHWAY MULTNOMAH & WASHINGTON COUNTIES		
FEDERAL HIGHWAY ADMINISTRATION	PROJECT NUMBER	SHEET NO.
REGION 10	OREGON DIVISION	5B-2

To Face Sht. 5B

C:\PROJECT\SS0017\SS0017\0212

02-SEP-12 11:23:27

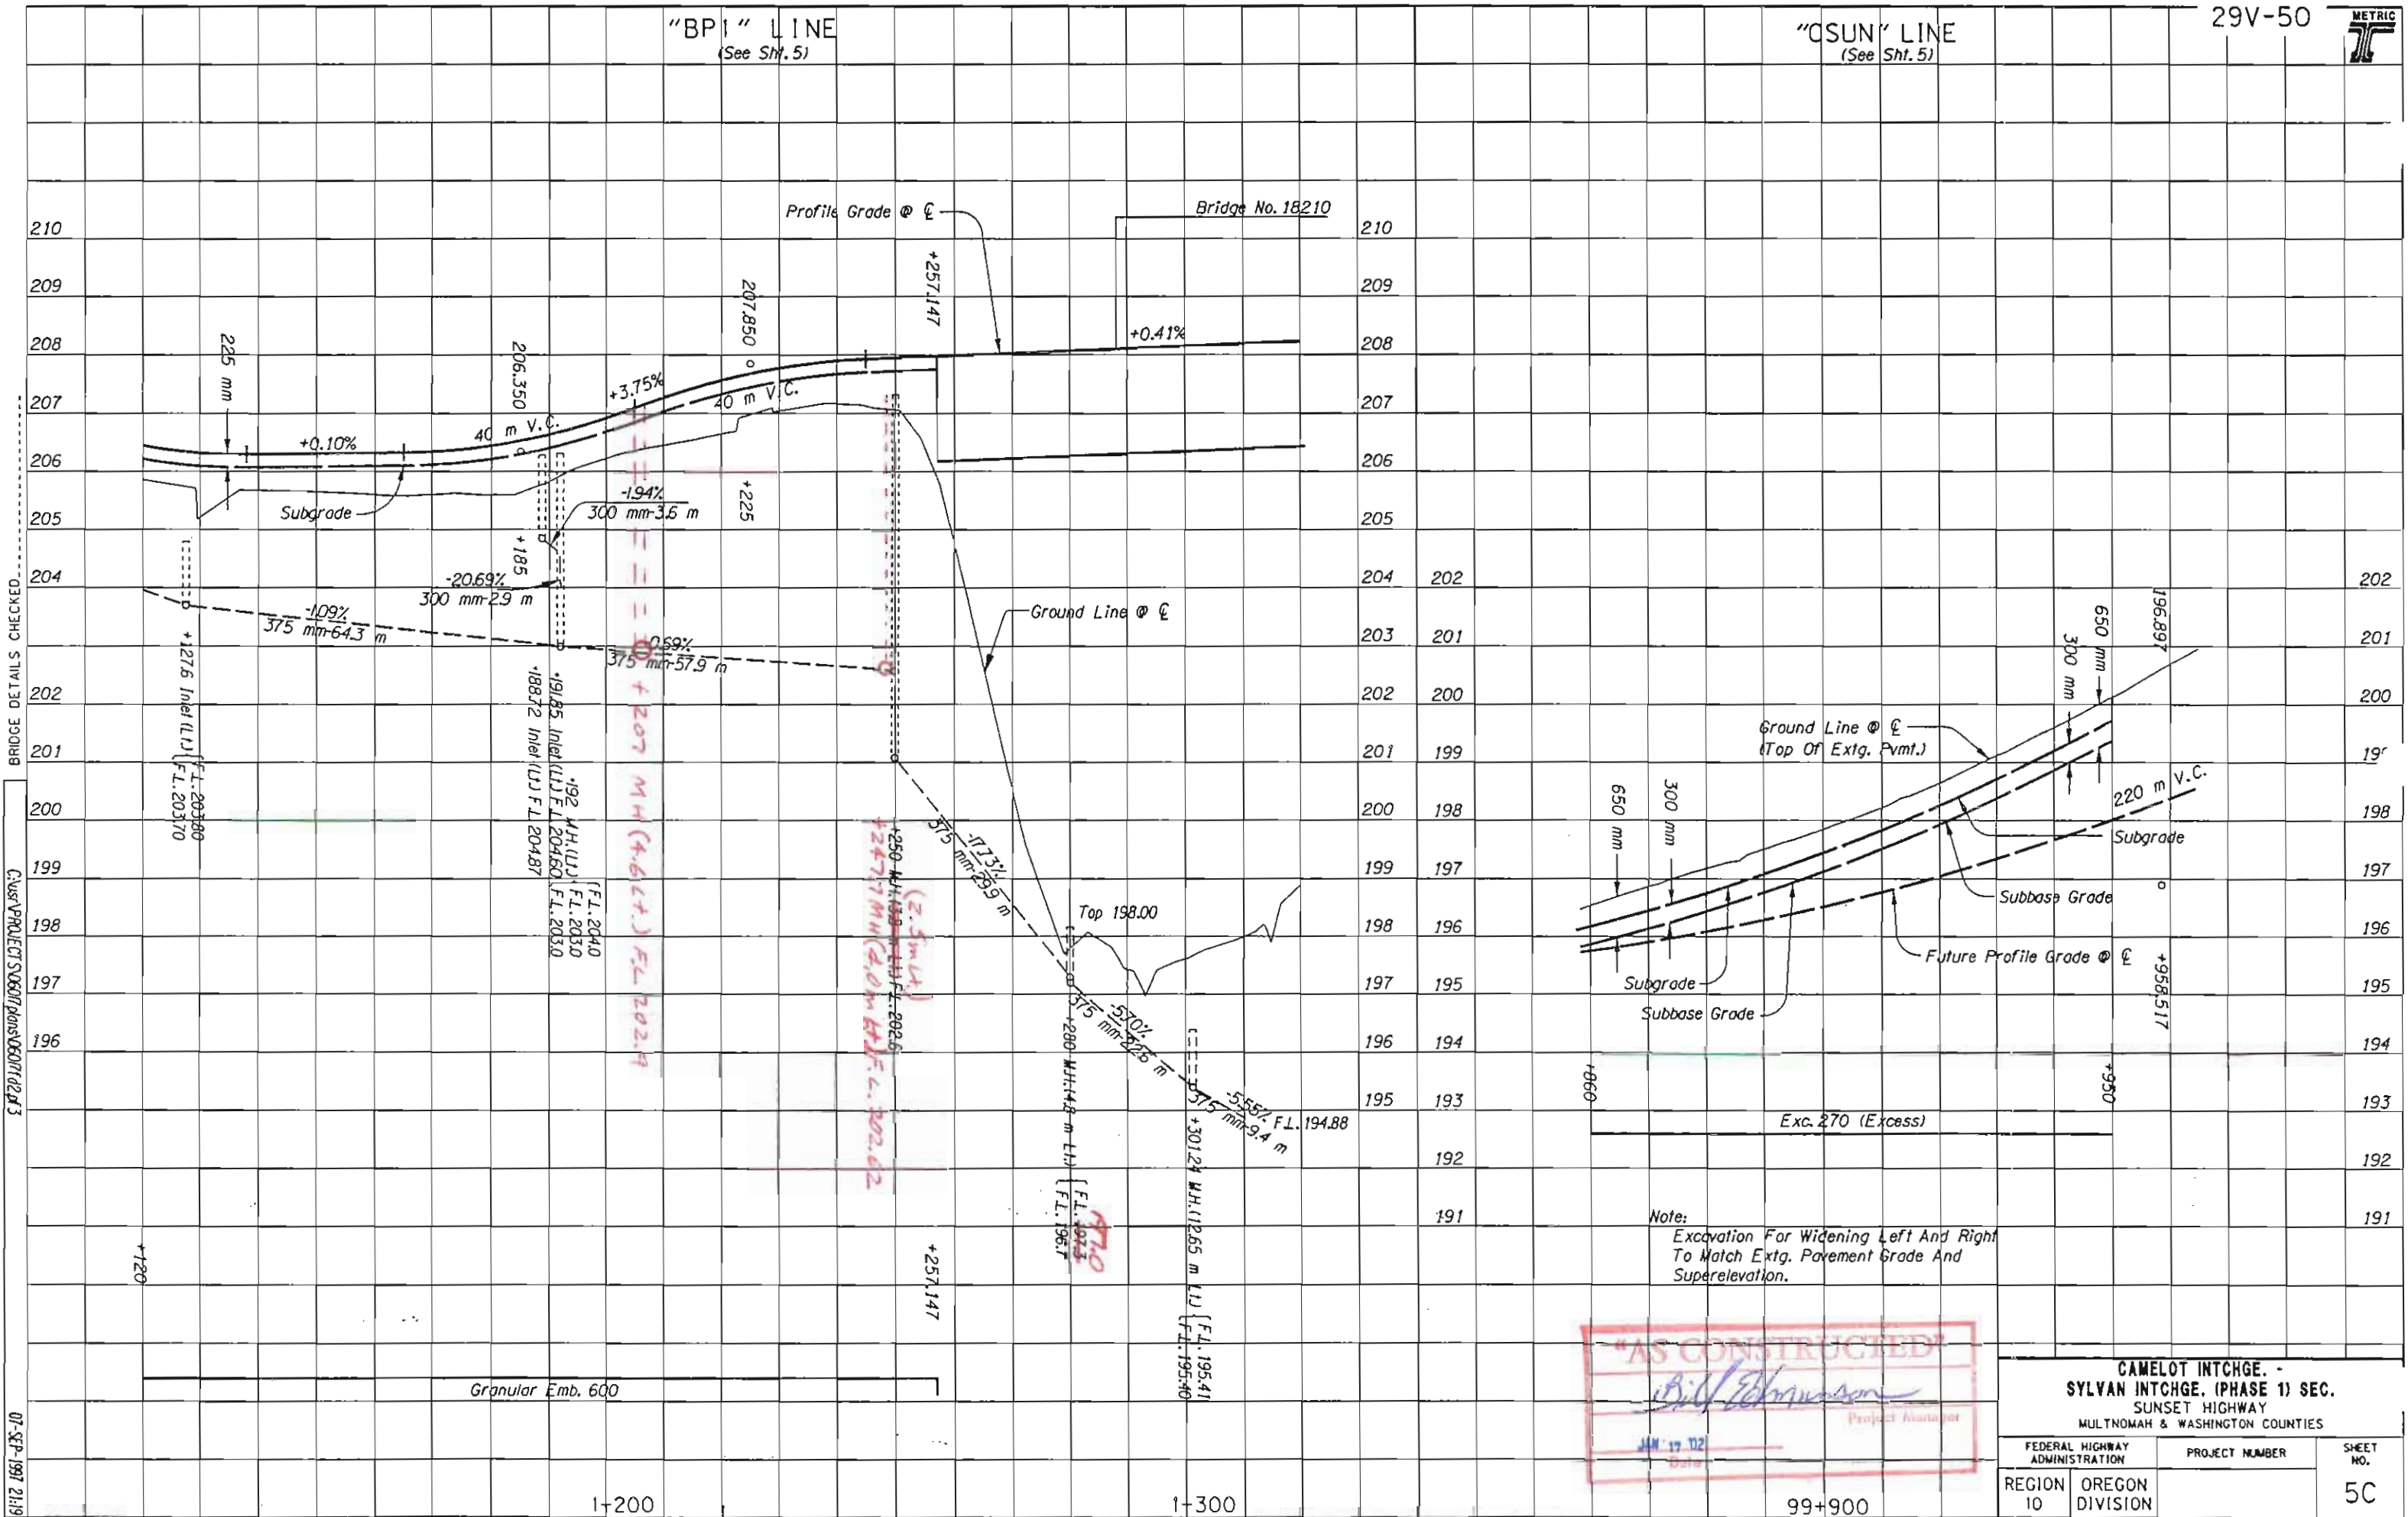

BRIDGE DETAILS CHECKED.

C:\PROJECT\SUB07\plans\080717\2119

07-SEP-1997 2:19

"AS CONSTRUCTED"
Bill Edmonson
 Project Manager
 Date: JAN 17 02

CAMELOT INTCHGE. - SYLVAN INTCHGE. (PHASE 1) SEC. SUNSET HIGHWAY MULTNOMAH & WASHINGTON COUNTIES		
FEDERAL HIGHWAY ADMINISTRATION	PROJECT NUMBER	SHEET NO.
REGION 10	OREGON DIVISION	5C

99+900

"CSW" LINE
(See Sht. 5)

29V-50



210
209
208
210
209
208
BRIDGE DETAILS CHECKED

CSW PROJECT SUBMITTALS 08/07/12 12:13

01-SEP-1997 21:19

VIEW 3

Ground Line @ ϕ

Profile Grade @ ϕ

Subgrade
Subbase Grade

Subgrade
Subbase Grade

Outfall Pipe To Creek F.L. 195.00

204.207
700 mm
300 mm
160 m V.C.
+695
+713.000

3.44%
-2.03%
300 mm - 103.6 m
93.0 m

229 m V.C.
197.400
300 mm
300 mm - 12.6 m
300 mm - 38.9 m

375 mm - 12.5 m
300 mm - 276.4 m

+887 Inlet (7.1) F.L. 197.87
+884 Inlet (5.7) F.L. 197.97
+929 M.H. (1.5) F.L. 197.05
+929 M.H. (5.0) F.L. 197.50
+929 M.H. (10.6) F.L. 197.50
+929 M.H. (15.6) F.L. 197.05
+929 M.H. (20.6) F.L. 197.50
+929 M.H. (25.6) F.L. 197.05
+929 M.H. (30.6) F.L. 197.50
+929 M.H. (35.6) F.L. 197.05
+929 M.H. (40.6) F.L. 197.50
+929 M.H. (45.6) F.L. 197.05
+929 M.H. (50.6) F.L. 197.50
+929 M.H. (55.6) F.L. 197.05
+929 M.H. (60.6) F.L. 197.50
+929 M.H. (65.6) F.L. 197.05
+929 M.H. (70.6) F.L. 197.50
+929 M.H. (75.6) F.L. 197.05
+929 M.H. (80.6) F.L. 197.50
+929 M.H. (85.6) F.L. 197.05
+929 M.H. (90.6) F.L. 197.50
+929 M.H. (95.6) F.L. 197.05
+929 M.H. (100.6) F.L. 197.50

Exc. 6 400 (Excess)

"AS CONSTRUCTED"
Bill Edmondson
Project Manager
JAN 11 12
Date

Granular Emb.


CAMELOT INTCHGE. -
SYLVAN INTCHGE. (PHASE 1) SEC.
SUNSET HIGHWAY
MULTNOMAH & WASHINGTON COUNTIES

FEDERAL HIGHWAY ADMINISTRATION		PROJECT NUMBER	SHEET NO.
REGION 10	OREGON DIVISION		50

99-700

99-800

99-900

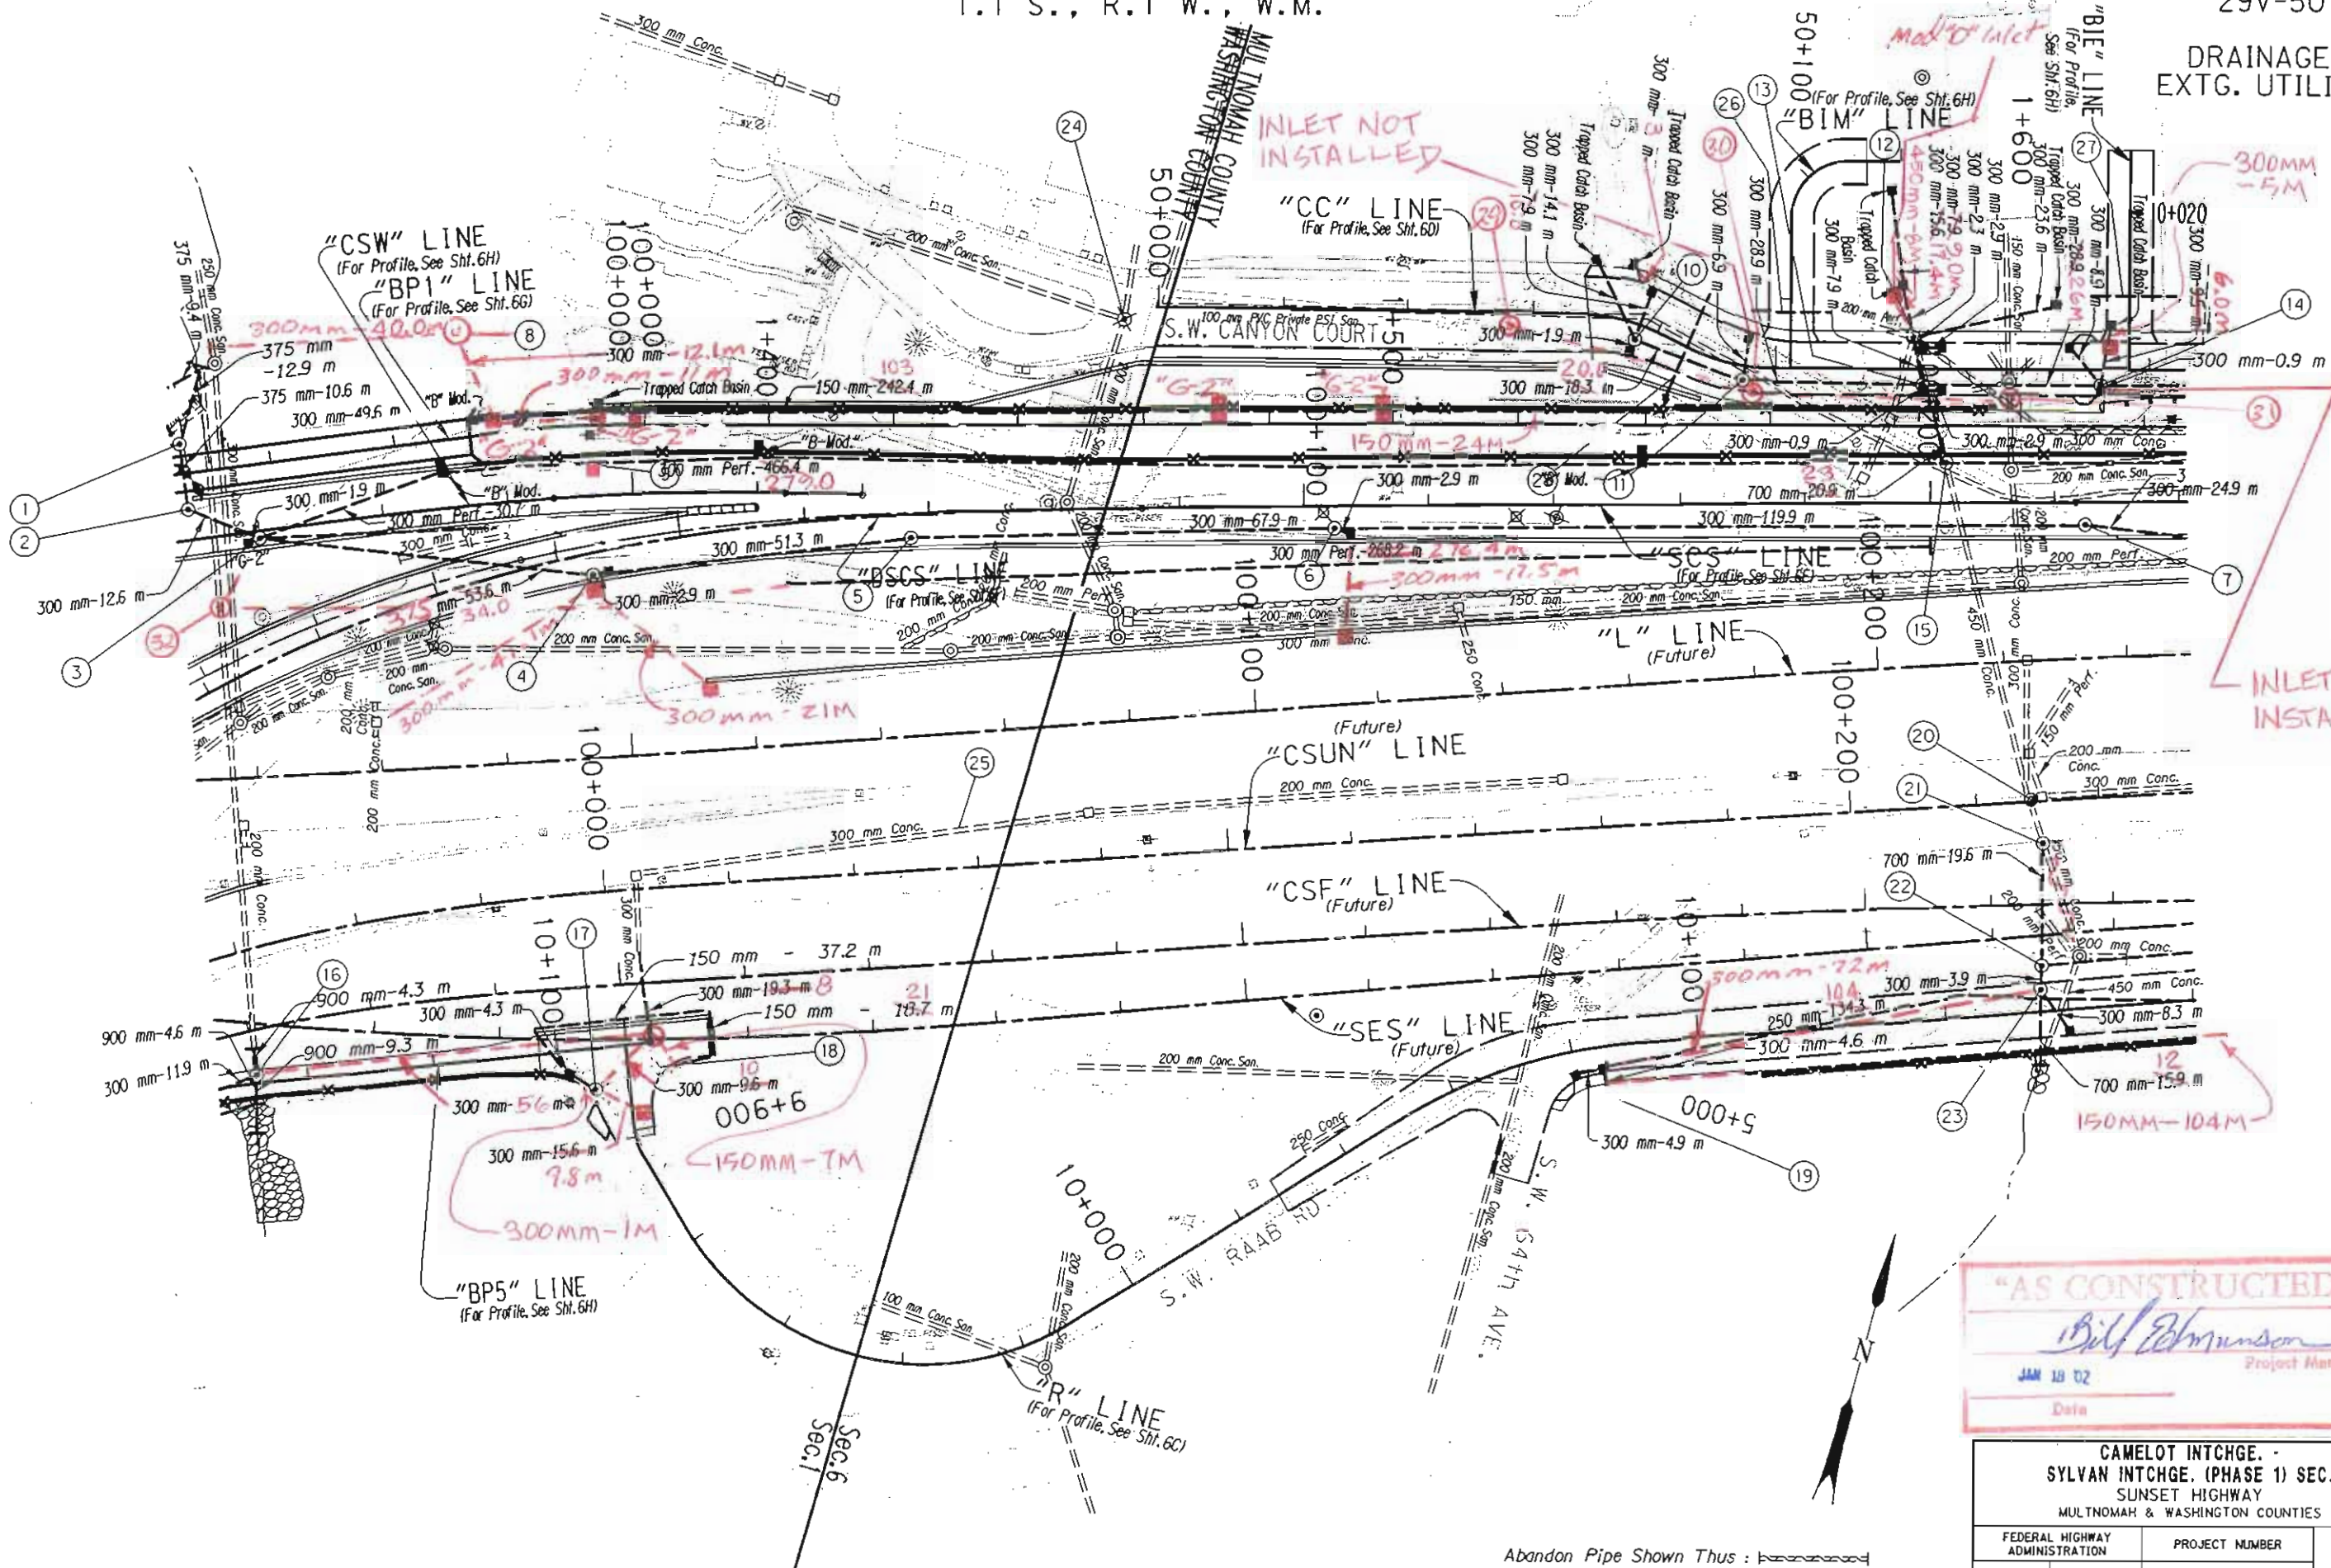

BRIDGE DETAILS CHECKED

CAUSE PROJECT SUBMITTALS 08/07/14/2/17

08-SEP-1997 11:31

"AS CONSTRUCTED"
Bill Edmondson
 Project Manager
 JAN 18 02
 Date

CAMELOT INTCHGE. - SYLVAN INTCHGE. (PHASE 1) SEC. SUNSET HIGHWAY MULTNOMAH & WASHINGTON COUNTIES		
FEDERAL HIGHWAY ADMINISTRATION	PROJECT NUMBER	SHEET NO.
REGION 10	OREGON DIVISION	6B

Abandon Pipe Shown Thus :



- 29 Sta. "CC" 50+060, 4.3 m Rt
Const. San. MH
Inst. 200mm PVC - 65.7 m
- 30 Sta "CC" 50+096.42, 4.13 m Rt.
Const. Inside Drop San. MH.
Inst. 200mm PVC - 34.9 m
- 31 Sta. "CC" 50+137.4, 5.33 m Rt.
Extg COP MH # 8
Inst 200mm Class 50 - 41.3 m
(Connect to Extg MH)
(see Sheet P2)
- 32 see Sheet SB Note 22

- 1 See Sht. 5B-2, Note 7
- 2 See Sht. 5B-2, Note 6
- 3 See Sht. 5B-2, Note 5

- 4 Sta. "DSCS" 99+984.98, 4.82 m Rt.
Const. Type "B" Manhole w/ 0.6m Sump
Const. Type "CG-2" Inlet
Inst. 300 mm Sew. Pipe - 54.2 m 66.0M
Tr. Exc. - 2 m³ 98 m³
Rock Tr. Exc. - 51 m³
(See Drg. Nos. RD324 & RD327)
- 5 Sta. "DSCS" 100+037.4 m Rt.
Const. Manhole With Bolt Down Cover
Inst. 300 mm Sew. Pipe - 57.9 m 51.0
Rock Tr. Exc. - 76 m³
(For Details, See Sht. 2B)

- 6 Sta. "DSCS" 100+105, 3.60 m Rt.
Const. Manhole With Bolt Down Cover
Const. Type "G-2" Inlet - 2
Inst. 300 mm Sew. Pipe - 122.8 m 82.0
Tr. Exc. - 61 m³
Rock Tr. Exc. - 93 m³
(For Details, See Sht. 2B)

- 7 Sta. "DSCS" 100+225, 3.60 m Rt.
Const. Manhole With Bolt Down Cover
Inst. 300 mm Sew. Pipe - 24.9 m 120.0M
Tr. Exc. - 35 m³
(For Details, See Sht. 2B)

- 8 Sta. "BP1" 1+362, 3.80 m Lt.
Const. Drop Manhole "Inside"
Const. Type "G-2" Inlet - 4
Const. Trapped Catch Basin
Const. Wall Gutter Drains - 4 3
Inst. 150 mm Drain Pipe - 242.4 m 244.0
~~Inst. 150 mm Poly Sew. Pipe - 7.5 m 6.6 m~~
Inst. 300 mm Sew. Pipe - 69.5 m 52.0
Tr. Exc. - 170 m³
(For Details, See Shts. 2B-2 & 2B-17)
CONST. TYPE B (MOD) INLET - 3

- 9 Sta. "BP1" 1+358, 3.80 m Rt.
Const. Manhole
Const. Type "G-2" Inlet - 2
Inst. 300 mm Sew. Pipe - 5.5 m
Tr. Exc. - 4 m³
(For Details, See Sht. 55306)
(See Drg. No. RD303)

- 10 Sta. "CC" 50+077, 2.53 m Rt.
Const. C.O.P. Manhole
Const. Trapped Catch Basin - 2
Const. Type "CG-2" Inlet - 2
Inst. 300 mm Sew. Pipe - 29.5 m 17.0
Tr. Exc. - 26 m³
(For Details, See Sht. 2B-17)
(See C.O.P. Drg. Nos. 4-06-1 & 4-06-3)
Const. Type "G-2" Inlet

- 11 Sta. "CC" 50+095, 2.53 m Rt.
Const. C.O.P. Manhole
~~Const. Type "CG-2" Inlet~~
Inst. 300 mm Sew. Pipe - 25.2 m 26.9 m
Tr. Exc. - 35 m³
(See Drg. Nos. 4-06-1 & 4-06-3)

- 12 Sta. "CC" 50+122, 5.10 m Lt.
Const. C.O.P. HDPE Inside Drop Manhole
(Energy Dissipation)
Const. Trapped Catch Basin - 3 2
Const. Type "CG-2" Inlet - 2 3
Inst. 300 mm Sew. Pipe - 69.2 m 43
Under Pymt. - 15.6 m
Tr. Exc. - 90 m³
(For Details, See Shts. 2B-9, 2B-10 & 2B-17)
(See Drg. No. RD336)

- 13 Sta. "CC" 50+123, 5.0, 2. m Rt.
Const. C.O.P. Drop Manhole
Const. Type "CG-2" Inlet - 2
Inst. 300 mm Sew. Pipe - 61.5 m 13.0M
Tr. Exc. - 106 m³
(See C.O.P. Drg. Nos. 4-06-1 & 4-27-2)

- 14 Sta. "CC" 50+152, 3.0, 2.53 m Rt.
Const. C.O.P. Manhole
Const. Type "G-2" Inlet
Const. Type "CG-2" Inlet
Const. Trapped Catch Basin
Inst. 300 mm Sew. Pipe - 60.6 m 40.0M
Tr. Exc. - 77 m³
(For Details, See Sht. 2B-17)

- 15 Sta. "DSCS" 100+202.53, 6.50 m Lt.
Const. Drop Manhole With Bolt Down Cover
Remove 450 mm Sew. Pipe - 20.9 m
Inst. 700 mm HDPE Sew. Pipe - 20.9 m 23
Tr. Exc. - 155 m³
(For Details, See Shts. 2B & 2B-2)

- 16 See Sht. 5B-2, Note 14

- 17 Sta. "R" 9+892.81, 5.23 m Rt.
Const. U.S.A. Manhole, CONST. G-2 INLET
Const. U.S.A. Area Drain & Grate Type II - 2
Inst. 150 mm Drain Pipe - 37.2 m
Inst. 300 mm Sew. Pipe - 93.4 m 11.0M
Tr. Exc. - 154 m³
(See U.S.A. Drg. No. 010-ST)

- 18 Sta. "R" 9+890.30, 4.09 m Lt.
Const. U.S.A. Manhole
Inst. 150 mm Drain Pipe - 78.2 m 17M
Inst. 300 mm Sew. Pipe - 19.3 m 64.0M
Connect To Extg. Pipe
Repair 300 mm Pipe (As Dir.)
Tr. Exc. - 31 m³
INST. 100MM DRAIN PIPE - 21M

- 19 Sta. "R" 10+084.51, 7.84 m Rt.
Const. C.O.P. Drop Manhole
Const. Type "CG-2" Inlet - 2
Inst. 150 mm Drain Pipe - 128.7 m 104
Inst. 250 mm Drain Pipe - 134.3
Inst. 300 mm Sew. Pipe - 78.4 m 26.9 m
Tr. Exc. - 340 m³
(See C.O.P. Drg. No. 4-27-2)

- 20 Sta. "CSUN" 100+228.88, 0.31 m Lt.
Reconst. Manhole

- 21 Sta. "CSUN" 100+230.16, 6.84 m Rt.
Const. Drop Manhole With Bolt Down Cover
Tr. Exc. - 80 m³
(For Details, See Shts. 2B & 2B-2)

- 22 Sta. "SES" 100+227.59 4.85 m Rt.
Const. Drop Manhole With Bolt Down Cover
(Energy Dissipation)
Inst. 300 mm Sew. Pipe - 81.2 m 73M
Inst. 700 mm HDPE Sew. Pipe - 35.5 m
Inst. Willow Cuttings - 72
Const. Loose Riprap (Class 350) - 24 m³
Tr. Exc. - 302 m³
Rock Tr. Exc. - 5 m³
(For Details, See Shts. 2B, 2B-2, 2B-7,
2B-9 & 2B-10)
INST. 450MM SEW. PIPE - 5M

- 23 Sta. "R" 10+155.60, 3.50 m Lt.
Const. C.O.P. Manhole
Const. Type "CG-2" Inlet
Inst. 300 mm Sew. Pipe - 8.3 m
Tr. Exc. - 8 m³
(See C.O.P. Drg. No. 4-06-1)

- 24 Adjust Manhole
(For Details, See Sht. 2B)

- 25 Repair Pipe (As Dir.)

- 26 Inst. 150 mm PVC Conduit - 12.8 m

- 27 Inst. 150 mm PVC Conduit - 13.4 m

- 28 Inst. 150 mm PVC Conduit - 17.2 m

"AS CONSTRUCTED"

Bill Edmondson
Project Manager

JAN 10 02
Date

CAMELOT INTCHGE. - SYLVAN INTCHGE. (PHASE 1) SEC. SUNSET HIGHWAY MULTNOMAH & WASHINGTON COUNTIES		
FEDERAL HIGHWAY ADMINISTRATION	PROJECT NUMBER	SHEET NO.
REGION 10	OREGON DIVISION	6B-2

To Face Sht. 6B

CHS PROJECT S:\0500\Drawings\29V-50\122A2

01-SEP-1997 2:57


INDEX OF SHEETS	
SHEET NO.	DESCRIPTION
1	Title Sheet
1A	Index Of Sheets
1A-2	Index Of Sheets Cont'd.
1A-3	Standard Drawing Nos.
2, 2A Thru 2A-18 Incl.	Typical Sections
2B Thru 2B-11 Incl.	Details
2C Thru 2C-8 Incl.	Traffic Control Plans
2CA-1 Thru 2CA-27 Incl.	Traffic Control Plans - Pointer Road Work Area
2CB-1 Thru 2CB-22 Incl.	Traffic Control Plans - South Side Work Area
2CC-1 Thru 2CC-61 Incl.	Traffic Control Plans - Sylvan Work Area
2D Thru 2D-9 Incl.	Water Quality Plans
2E Thru 2E-15 Incl.	Erosion Control Plans
2F	Hazardous Material Remediation Plans
2G Thru 2G-6 Incl.	Pipe Data
3	Alignment & All Construction
4	Alignment
4A	Right Of Way
4B, 4B-2	General Construction Plans
4C, 4C-2	Drainage Plans
4D, 4E	Profiles
5	Alignment
5A	Right Of Way
5B, 5B-2	General Construction Plans
5C	Drainage Plan
5D, 5E	Profiles
6	Alignment
6A	Right Of Way
6B, 6B-2	General Construction Plans
6C	Detour Plan
6D, 6D-2	Drainage Plans
6E, 6F, 6G, 6H, 6J	Profiles
7	Alignment
7A	Right Of Way
7B, 7B-2	General Construction Plans
7C	Detour Plan
7D, 7D-2	Drainage Plans
7E, 7F, 7G, 7H	Profiles
8	Alignment
8A	Right Of Way
8B, 8B-2	General Construction Plans
8C, 8C-2	Drainage Plans
8D, 8E, 8F	Profiles
9	Alignment
9A	Right Of Way
9B, 9B-2	General Construction Plans
9C	Detour Plan
9D, 9D-2	Drainage Plans

STATE OF OREGON
DEPARTMENT OF TRANSPORTATION

PLANS FOR PROPOSED PROJECT
GRADING, STRUCTURES, PAVING, SIGNING, ILLUMINATION,
SIGNALS, ROADSIDE DEVELOPMENT & UTILITY RELOCATIONS

**CAMELOT INTCHGE. -
SYLVAN INTCHGE. (PHASE 2) SEC.**

**SUNSET HIGHWAY
MULTNOMAH & WASHINGTON COUNTIES
OCTOBER 2000**

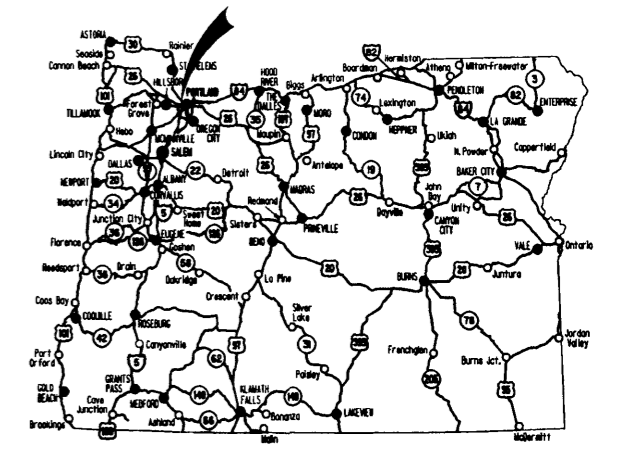


Overall Length Of Project - 2.013 km (1.25 Miles)

ATTENTION :
Oregon Law Requires You To Follow Rules
Adopted By The Oregon Utility Notification Center.
Those Rules Are Set Forth In OAR 952-001-0010 Through
OAR 952-001-0090. You May Obtain Copies Of The Rules From The Center,
Or Answers To Questions About The Rules By Calling (503) 232-1987.



**BEGIN. OF CONTRACT
STA. "L" 98 + 700.801 (M.P. 70.06)**

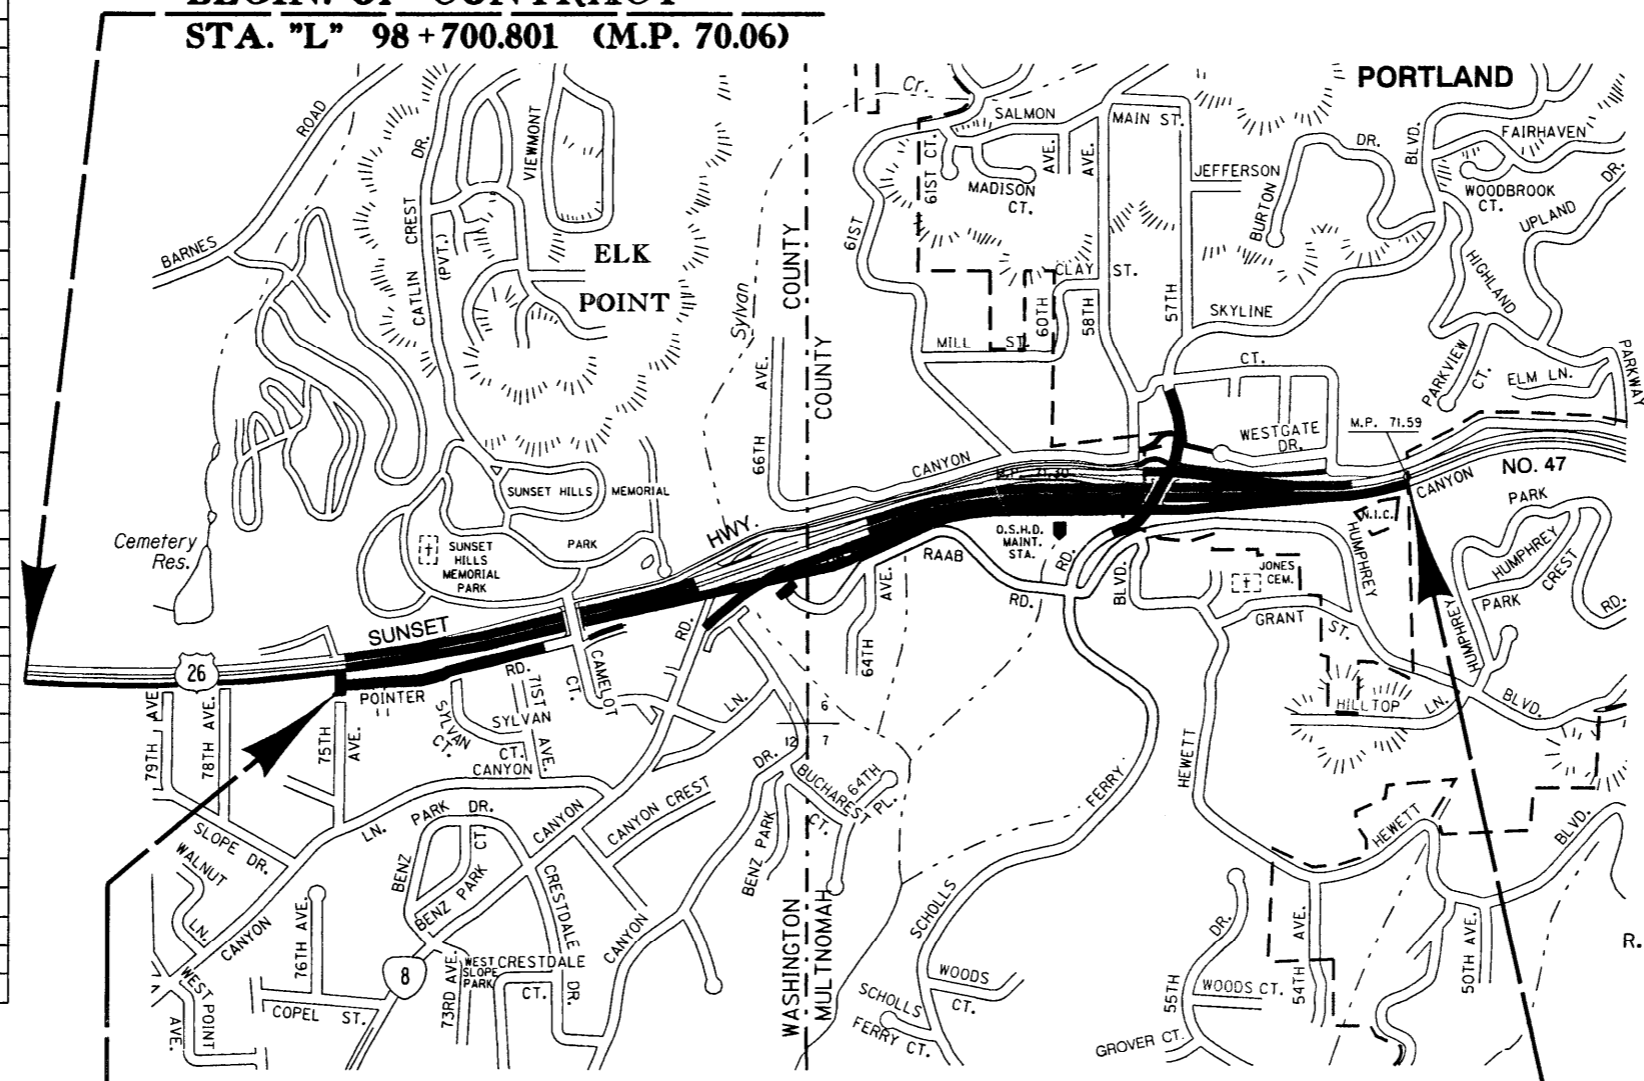

T. 1 S.,
R. 1 W., 1 E., W.M.

- OREGON TRANSPORTATION COMMISSION
- Henry H. Hewitt CHAIRMAN
 - Susan Brody VICE CHAIRMAN
 - Steven H. Corey COMMISSIONER
 - Stuart Foster COMMISSIONER
 - John Russell COMMISSIONER
 - Grace Crunican DIRECTOR OF TRANSPORTATION



Jeffrey Scheick
TECHNICAL SERVICES MANAGING ENGINEER


**NH-MGS-S047(32)
BEGINNING OF PROJECT
STA. "L" 99 + 197.000 (M.P. 70.37)**

**END OF PROJECT NH-MGS-S047(32)
STA. "L" 101 + 210 (M.P. 71.62)**



FEDERAL HIGHWAY ADMINISTRATION	PROJECT NUMBER	SHEET NO.
OREGON DIVISION	NH-MGS-S047-(32)	1

03-AUG-2000 11:04 c:\usr\proj\sect5\080099.d\mef

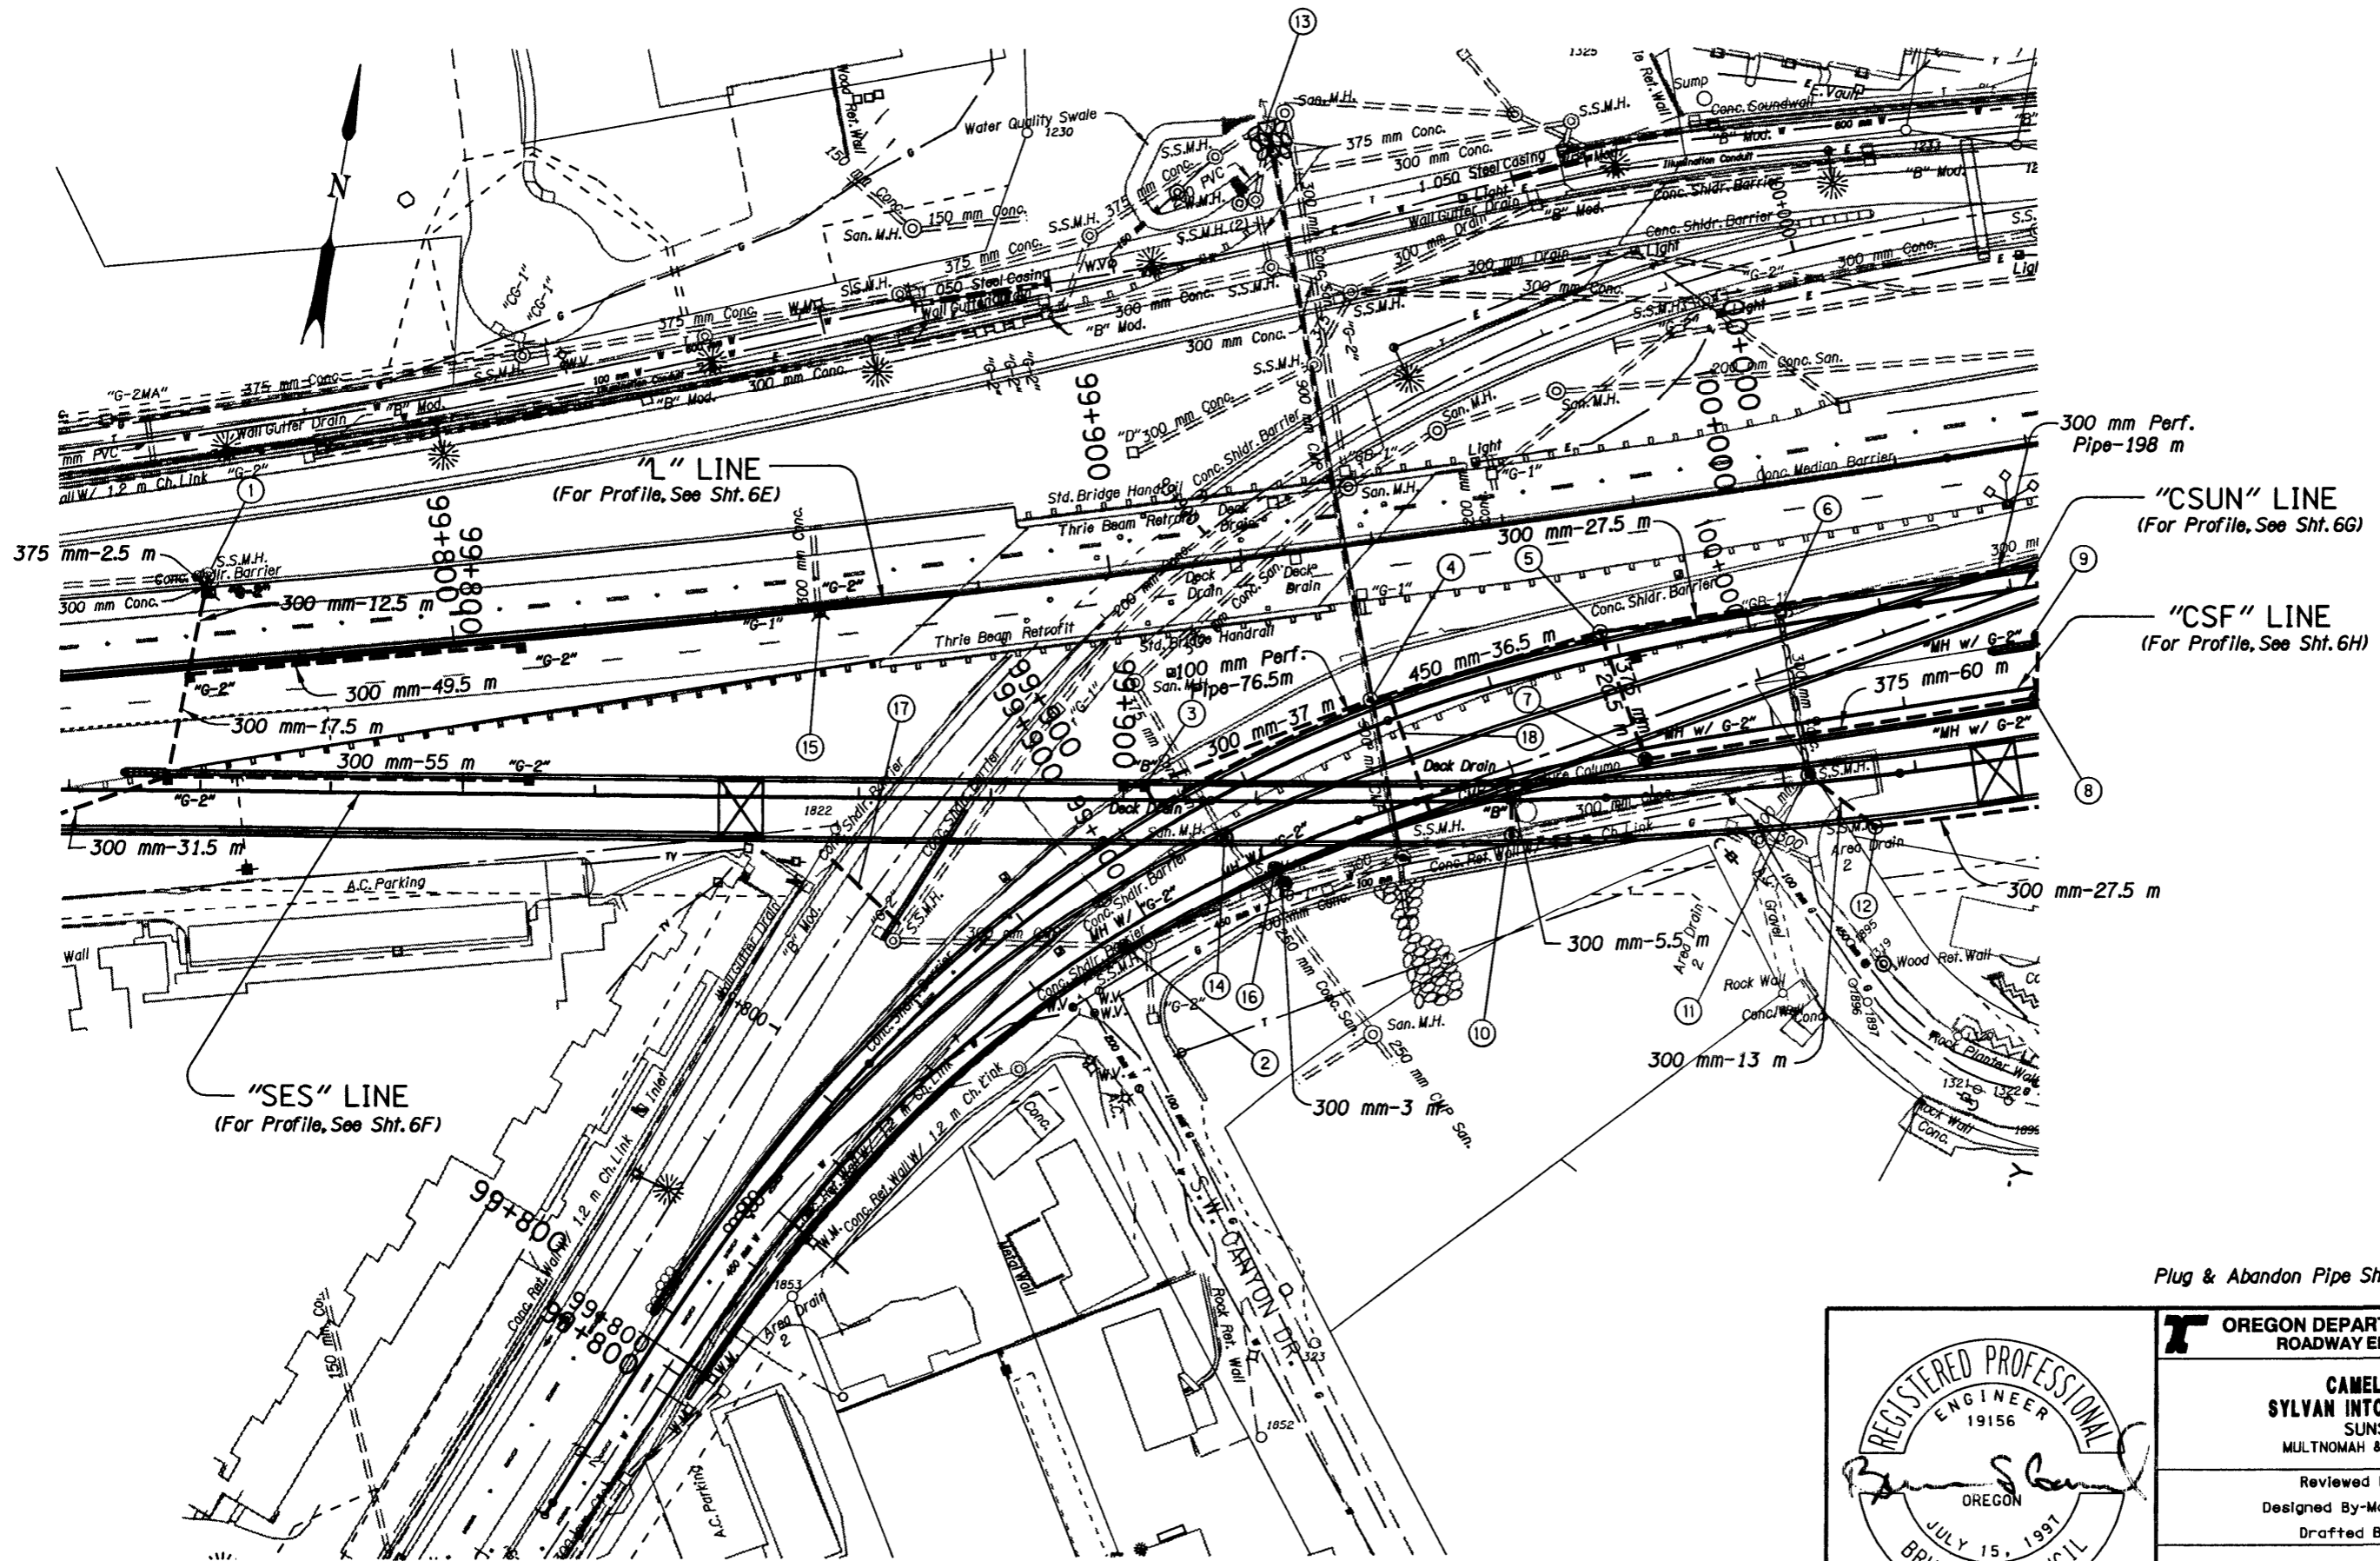

24-AUG-2000 14:05 D:\user\proj\sect\08009\08009\44_F\trial\08009.dwg

Plug & Abandon Pipe Shown Thus:



OREGON DEPARTMENT OF TRANSPORTATION ROADWAY ENGINEERING SECTION	
CAMELOT INTCHGE. - SYLVAN INTCHGE. (PHASE 2) SEC. SUNSET HIGHWAY MULTNOMAH & WASHINGTON COUNTIES	
Reviewed By-Bruce S. Council Designed By-Magnolia Bartley-Lam Han Drafted By-Martin G. Casillas	
DRAINAGE & UTILITIES	
SHEET NO.	6D

NOTE: Field Verify With The Engr. All Locations Of Drainage Structures & Pipes.

24-AUG-2000 14:12

D:\usr\proj\edits\08009\08009.kd.F\hd\08009r.rtf

① Sta. "SES" 99+725.6, 8.1 m Rt.
 Remove Extg. Inlet - 2
 Const. Type "BP" Manhole, Conn. Extg. Pipes
 Const. Type "G-2" Inlet - 5
 Inst. 375 mm Sew. Pipe - 2.5 m
 Inst. 300 mm Sew. Pipe - 166 m
 Inst. 25 mm Preformed Expansion Joint
 @ Wall Connection
 Tr. Exc. - 76 m³
 Under Pvmt. - 79 m

② Sta. "CSF" 99+895, Rt.
 300 mm Sew. Pipe - In Place
 Remove - 1.2 m
 Const. Manhole With Type "G-2" Inlet
 (See Drg. No. RD333)

③ Sta. "SES" 99+903.3, 2.11 m Lt.
 Const. Type "B" Inlet
 Conn. Deck Drain
 Const. Subsurface Drain Outlet
 Inst. 100 mm Perf. Pipe - 76.5 m
 Drainage Geotextile Type "1" - 36 m²
 (For Bridge No. 18647, See Sht. 1A)

④ Sta. "L" 99+936.33, 23.92 m Rt.
 900 mm Sew. Pipe - In Place
 Remove - 1.8 m
 Const. Drop Manhole Over
 Extg. 900 mm Pipe - 1.8 m Dia.
 Inst. 300 mm Sew. Pipe - 37 m
 Inst. 450 mm Sew. Pipe - 36.5 m
 Tr. Exc. - 280 m³
 (For Details, See Sht. 2B-6)
 (See Drg. Nos. RD324 & RD330)

⑤ Sta. "L" 99+972, 18.5 m Rt.
 Const. Drop Manhole
 Inst. 375 mm Sew. Pipe - 20.5 m
 Inst. 300 mm Sew. Pipe - 27.5 m
 Inst. 300 mm Perf. Pipe - 198 m
 Drainage Geotextile Type "1" - 36 m²
 Const. Subsurface Drain Outlet
 Tr. Exc. - 84 m³
 (For Details, See Sht. 2B-6)

⑥ Sta. "CSUN" 100+005, Lt.
 Cap Inlet

⑦ Sta. "CSF" 99+980, 1.6 m Rt.
 Const. Manhole With Type "G-2" Inlet
 Inst. 375 mm Sew. Pipe - 60 m
 Tr. Exc. - 101 m³

⑧ See Sht. 7D-2, Note 2

⑨ See Sht. 7D-2, Note 1

⑩ Sta. "BP5" 10+069, 1.4 m Lt.
 300 mm Sew. Pipe - In Place
 Remove - 1.2 m
 Const. Manhole Over Extg. 300 mm Pipe
 Const. Type "B" Inlet
 Inst. 300 mm Sew. Pipe - 5.5 m
 Under Pvmt. - 1 m
 Conn. Deck Drain
 Tr. Exc. - 5 m³
 (For Bridge No. 18647, See Sht. 1A)

⑪ Sta. "BP5" 10+114.75, 1.8 m Lt.
 Inst. 300 mm Sew. Pipe - 13 m
 Under Pvmt. - 6.7 m
 Reconst. Manhole
 Tr. Exc. - 29.2 m³

⑫ Sta. "SES" 100+013, 7.6 m Rt.
 Const. Manhole
 Inst. 300 mm Sew. Pipe - 27.5 m
 Tr. Exc. - 120 m³

⑬ Sta. "SCS" 99+938, 47 m Lt
 Extg. 900 mm In-Place
 Saw Cut & Remove Pipe - 2 m
 Inst. Cure-In-Place-Pipe Lining
 Nom. Thkn. - 22 mm
 Inst. Metal Flare End Section At Pipe Inlet
 Place Loose Riprap (Class 200) - 28 m³
 Inst. Type "1" Riprap Geotextile - 40 m²
 (For Details, See Sht. 2B-8)


⑭ Sta. "CSF" 99+916, Lt.
 Adjust Manhole, Use Method "B"
 (For Details, See Sht. 2B)

⑮ Sta. "L" 99+855.6, Lt.
 Remove Extg. Inlet
 Const. Type "G-2" Inlet
 Conn. To Extg. Pipe

⑯ Sta. "CSF" 99+921, 2.1 m Rt.
 Const. Manhole With Type "G-2" Inlet
 Inst. 300 mm Sew. Pipe - 3 m
 Reconst. Extg. Manhole
 Tr. Exc. - 1 m³


⑰ Sta. "CSUN" 99+865.38, 19 m Lt.
 Inst. 150 mm PVC Conduit - 14.5 m

⑱ Sta. "BP5" 10+069, 1.4 m Lt.
 Inst. 150 mm PVC Conduit - 20.5 m

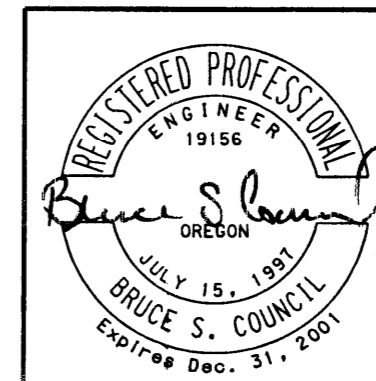

OREGON DEPARTMENT OF TRANSPORTATION ROADWAY ENGINEERING SECTION	
CAMELOT INTCHGE. - SYLVAN INTCHGE. (PHASE 2) SEC. SUNSET HIGHWAY MULTNOMAH & WASHINGTON COUNTIES	
Reviewed By - Bruce Council Designed By - Magnolia Bartley Drafted By - Heather Gonsior	
DRAINAGE NOTES	SHEET NO. 6D-2


"SES" LINE

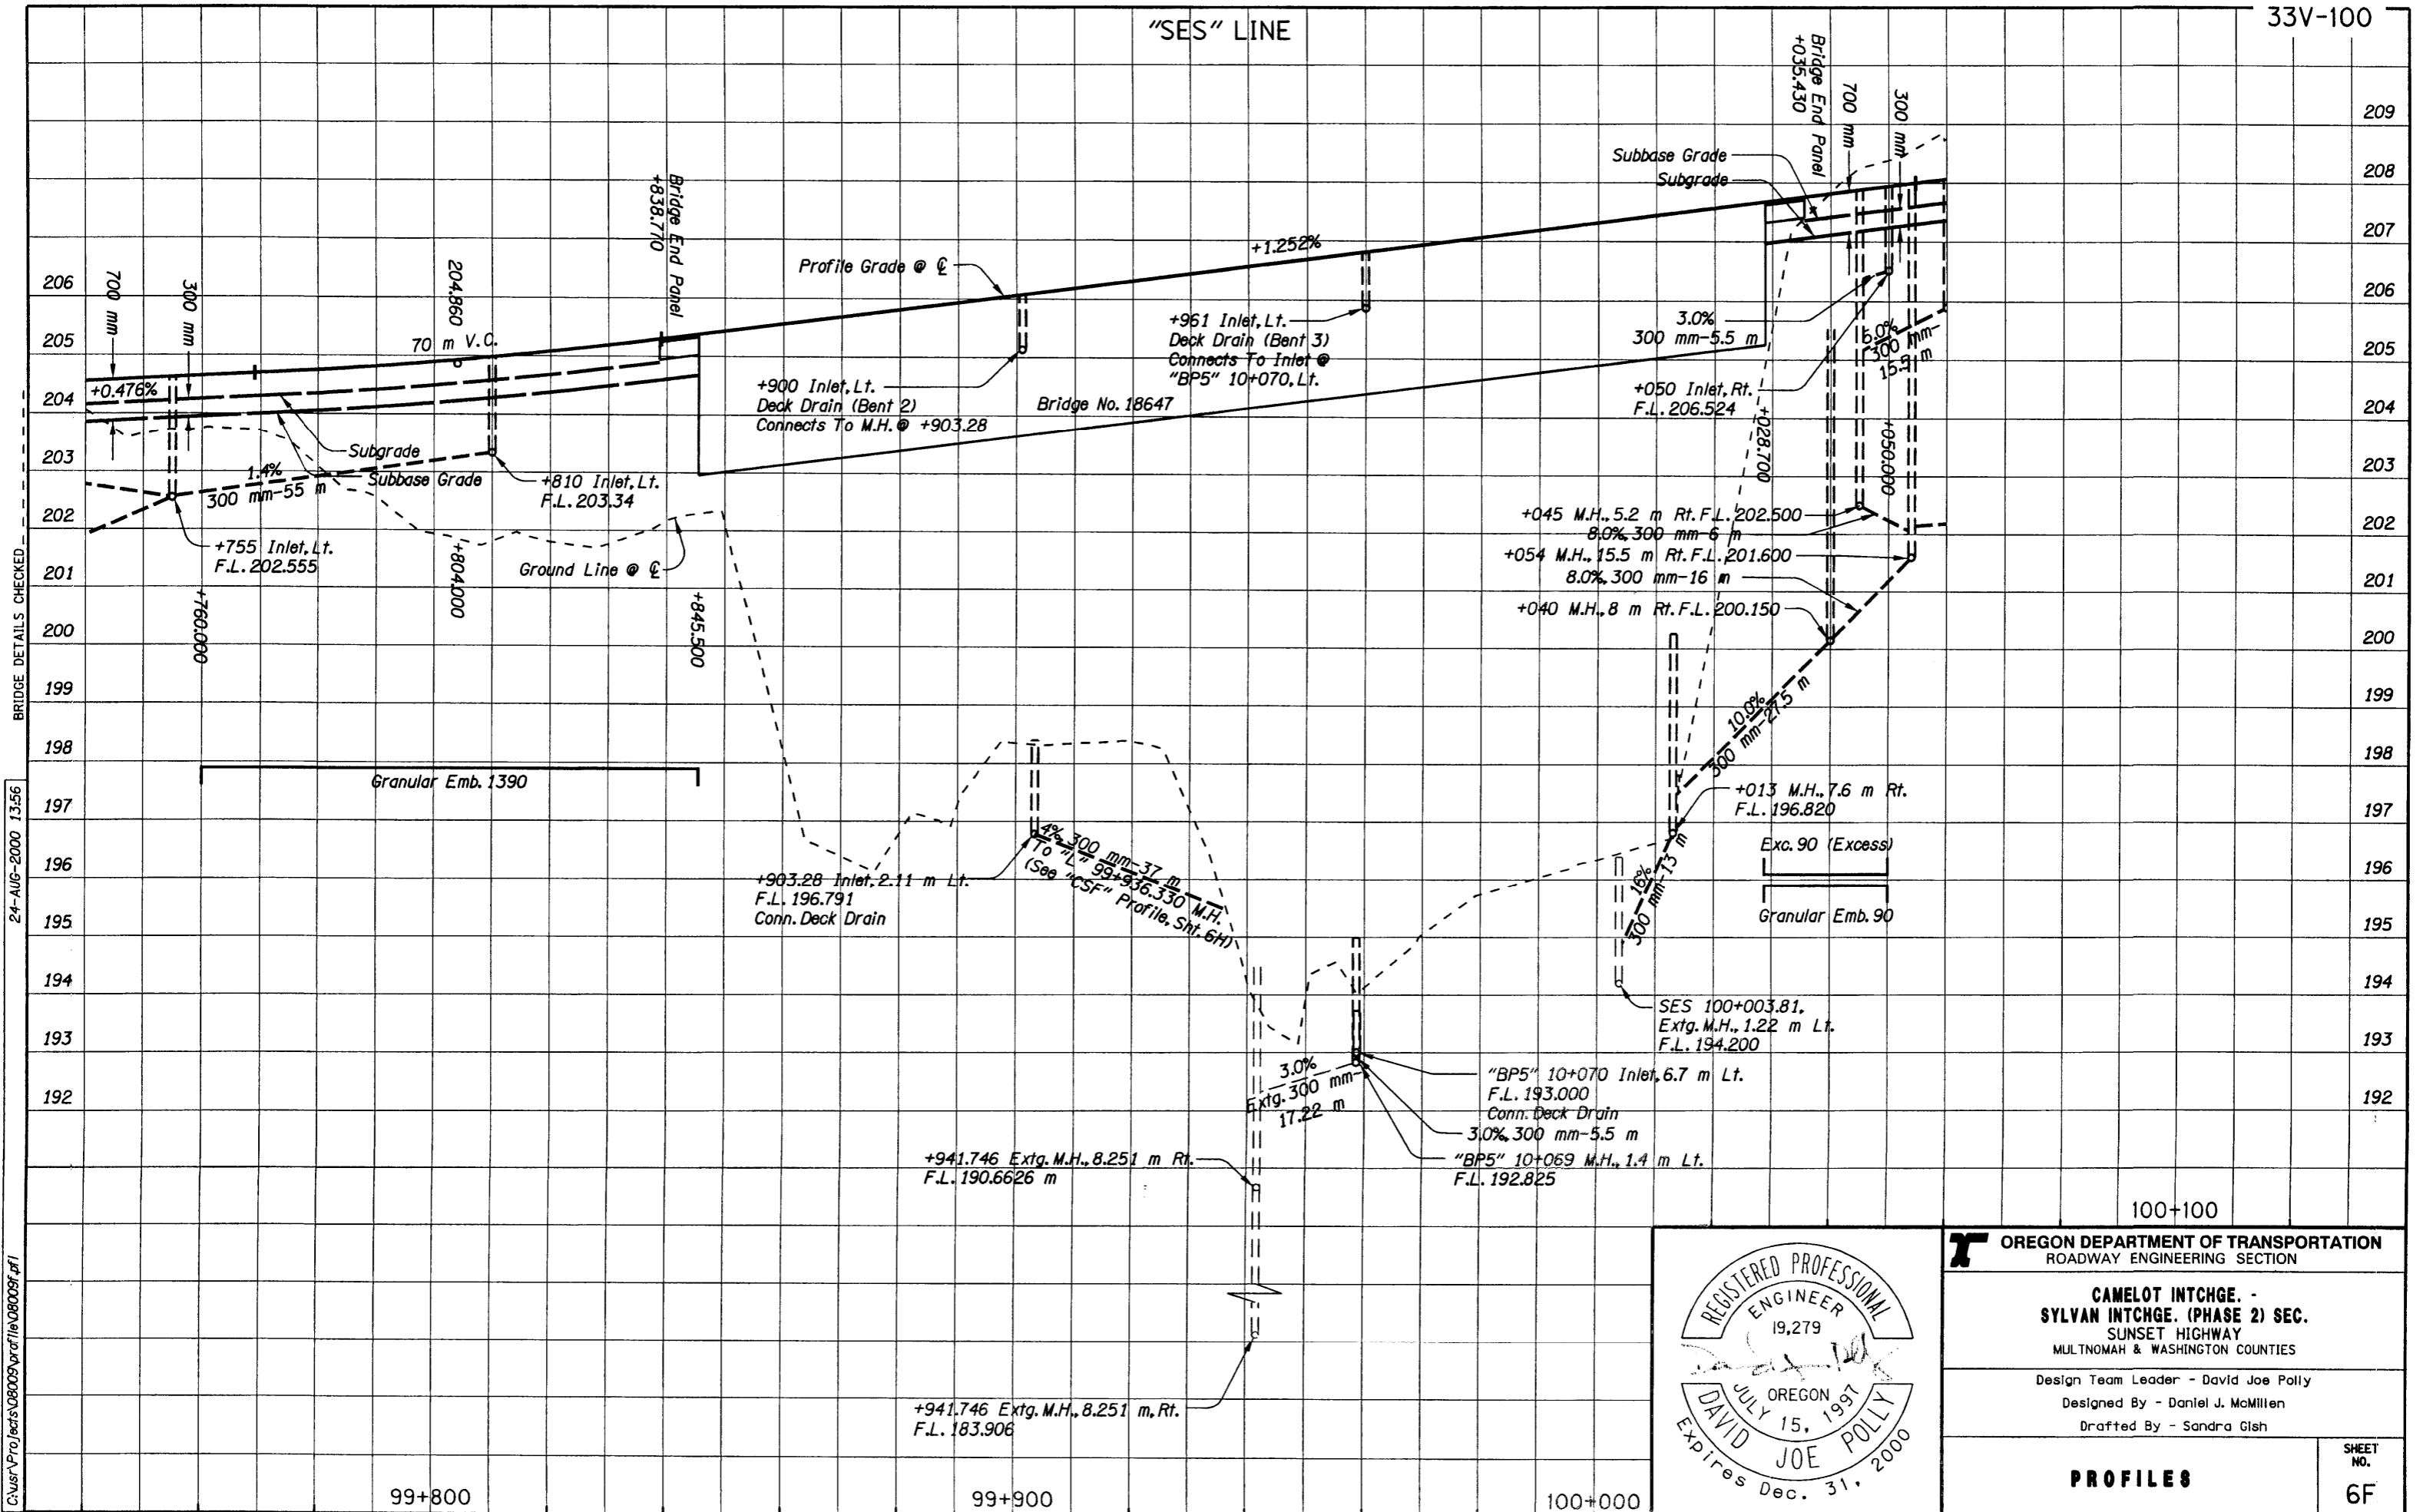

BRIDGE DETAILS CHECKED

24-AUG-2000 13:56

C:\user\Projects\08009\p\ref\le\08009r.dfl

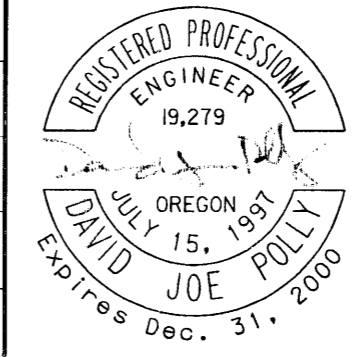

OREGON DEPARTMENT OF TRANSPORTATION
ROADWAY ENGINEERING SECTION

CAMELOT INTCHGE. - SYLVAN INTCHGE. (PHASE 2) SEC.
SUNSET HIGHWAY
MULTNOMAH & WASHINGTON COUNTIES

Design Team Leader - David Joe Polly
Designed By - Daniel J. McMillen
Drafted By - Sandra Gish

PROFILES

SHEET NO. **6F**