

OPERATION & MAINTENANCE MANUAL

DFI No.: D000114

**Facility Type: Water Quality Extended
Det. Dry Pond**



MARCH, 2011

INDEX

1. IDENTIFICATION..... 1

2. FACILITY CONTACT INFORMATION..... 1

3. CONSTRUCTION..... 1

4. STORM DRAIN SYSTEM AND FACILITY OVERVIEW 2

5. FACILITY HAZ MAT SPILL FEATURE(S)..... 5

6. AUXILIARY OUTLET (HIGH FLOW BYPASS)..... 5

7. MAINTENANCE REQUIREMENTS..... 6

8. WASTE MATERIAL HANDLING..... 6

APPENDIX A: Operational Plan and Profile Drawing(s)

APPENDIX B: ODOT Project Plan Sheets

1. Identification

Drainage Facility ID (DFI): **D00114**
Facility Type: Water Quality Extended Det. Dry Pond
Construction Drawings: (V-File Number) 36V-116
Location: District: 2B (Old 2A)
Highway No.: 144
Mile Post: 4.3 (beg./end)
Description: This facility is located between the off-ramp for US217 (Hwy 144) to the east and Scholls Ferry Road to the west.

2. Facility Contact Information

Contact the Engineer of Record, Region Technical Center, or Geo-Environmental's Senior Hydraulics Engineer for:

- Operational clarification
- Maintenance clarification
- Repair or restoration assistance

Engineering Contacts:

Region Technical Center Hydro Unit Manager

Or

Geo-Environmental Senior Hydraulics Engineer (503) 986-3365.

3. Construction

Engineer of Record: ODOT Designer – Region 1 Tech. Center,
Timothy P. Fredette, 503-731-8340.

Facility construction: 2004
Contractor: All Concrete Specialties, Inc.

4. Storm Drain System and Facility Overview

A water quality extended det. dry pond is a water quality treatment facility designed to treat the stormwater by controlling the release rate of the facility. The outlet control facility for the pond restricts the flow to allow for the particulates and attached pollutants to settle. This facility is designed to handle only the smaller water quality flows. The extended det. dry pond temporarily stores the water quality storm volume and releases the water over a 48 hour period. Suspended solids are removed by settling during this detention period.

The facility is located just west of the Washington Square Mall between the off-ramp for US217 (Hwy 144) and Scholls Ferry Road. This facility serves the roadway drainage via sheet flow from the off-ramp within the immediate vicinity and a portion of the drainage from Scholls Ferry Road. There are no inlet pipes into the water quality extended det. dry pond.

This facility consists of two separate treatment areas that discharge into outlet control structures (Point A and Point B as shown in the Operational Plan in Appendix A and the Project Plan Sheets). The grade breakline separates the facility into two separate treatment areas where flow within the north portion is directed towards the north and the south portion is directed towards the south. The outlet control structure (Point A) for the north treatment area ties into a 12-inch concrete storm pipe that connects to an existing storm conveyance system to the north. The outlet control structure (Point B) for the south treatment area directs water into a 12-inch outlet which discharges into a ditch.

The facility is a grass lined facility with HDPE porous pavers lining the bottom of the pond(s). The facility is groomed in conjunction with the adjacent grass landscaping areas.

A. Maintenance equipment access:

The facility can be accessed from the off ramp of US217 (Hwy 144).

B. Heavy equipment access into facility:

- Allowed (no limitations)
- Allowed (with limitations)
- Not allowed

C. Special Features:

- Amended Soils
- Porous Pavers – HDPE Porous Pavers
- Liners

□ Underdrains

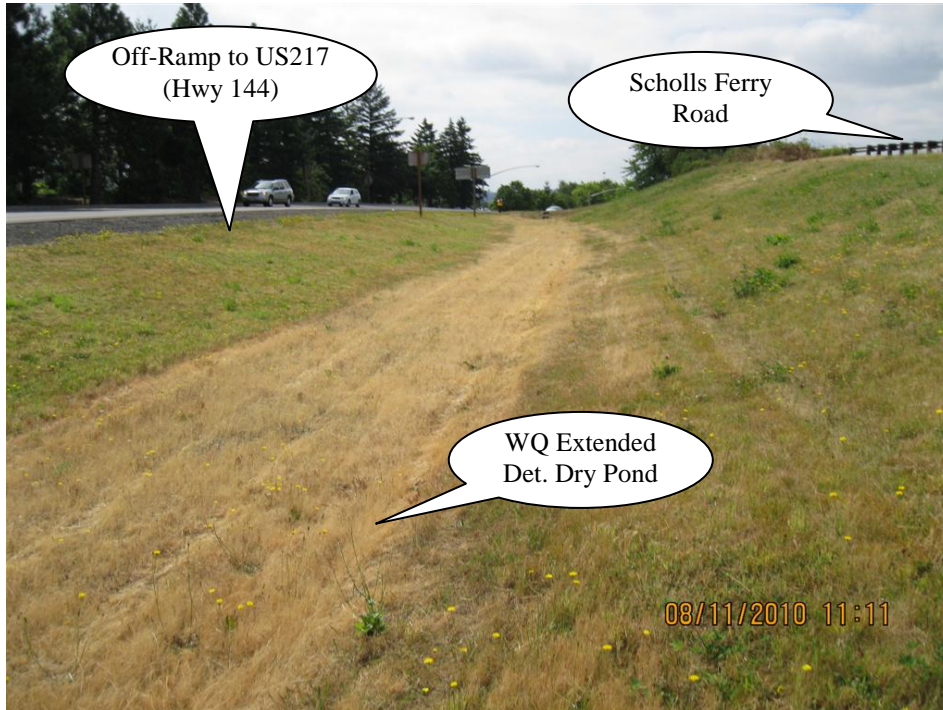


Photo 1: WQ extended det. dry pond looking towards the south.



Photo 2: South outlet control structure, Point B, looking towards the south.



Photo 3: South outlet control structure, Point B, for the south treatment area.

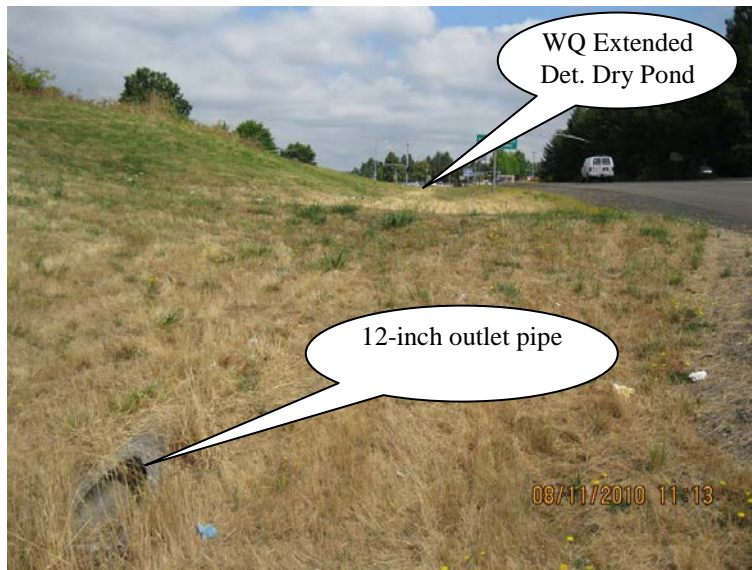


Photo 4: 12-inch outlet pipe discharging from control structure, Point B. Photo is looking to the north.



Photo 5: North outlet control structure, Point A, looking north.

5. Facility Haz Mat Spill Feature(s)

The extended det. dry pond can be used to store a volume of liquid by blocking either one of the outlet control structures with either a plate or sandbags. See Figures 3 and 5 and the Operational Plan.

6. Auxiliary Outlet (High Flow Bypass)

Auxiliary Outlets are provided if the primary outlet control structure can not safely pass the projected high flows. Broad-crested spillway weirs and over flow risers are the two most common auxiliary outlets used in stormwater treatment facility design. The auxiliary outlet feature is either a part of the facility or an additional storm drain feature/structure.

The auxiliary outlet feature for this facility is:

Designed into facility – This facility is an online facility where all runoff is directed into the extended det. dry pond. If the flow exceeds the water quality flow then the second ditch inlet grate is used where runoff is allowed to enter 12-inch storm pipes on both the north and south ends of the facility.

Other, as noted below

7. Maintenance Requirements

Routine maintenance table for non-proprietary stormwater treatment and storage/detention facilities have been incorporated into ODOT's Maintenance Guide. These tables summarize the maintenance requirements for ponds, swales, filter strips, bioslopes, and detention tanks and vaults. Special maintenance requirements in addition to the routine requirements are noted below when applicable.

The ODOT Maintenance Guide can be viewed at the following website:

<http://www.oregon.gov/ODOT/HWY/OOM/MGuide.shtml>

Maintenance requirements for proprietary structures, such as underground water quality manholes and/or vaults with filter media are noted in Appendix C when applicable.

The following stormwater facility maintenance table (See ODOT Maintenance Guide) should be used to maintain the facility outlined in this Operation and Maintenance Manual or follow the Maintenance requirements outlined in Appendix C when proprietary structure is selected below:

- Table 1 (general maintenance)
- Table 2 (stormwater ponds)
- Table 3 (water quality biofiltration swales)
- Table 4 (water quality filter strips)
- Table 5 (water quality bioslopes)
- Table 6 (detention tank)
- Table 7 (detention vault)
- Appendix C (proprietary structure)
- Special Maintenance requirements:

Note: Special maintenance Requirements Require Concurrence from ODOT SR Hydraulics Engineer.

8. Waste Material Handling

Material removed from the facility is defined as waste by DEQ. Refer to the roadwaste section of the ODOT Maintenance Yard Environmental Management System (EMS) Policy and Procedures Manual for disposal options: <http://egov.oregon.gov/ODOT/HWY/OOM/EMS.shtml>


Contact any of the following for more detailed information about management of waste materials found on site:

| | |
|-----------------------------------|----------------|
| ODOT Clean Water Unit | (503) 986-3008 |
| ODOT Statewide Hazmat Coordinator | (503) 229-5129 |
| ODOT Region Hazmat Coordinator | (503) 731-8304 |
| ODEQ Northwest Region Office | (503) 229-5263 |


Appendix A

Content:


- **Operational Plan and Profile Drawing(s)**

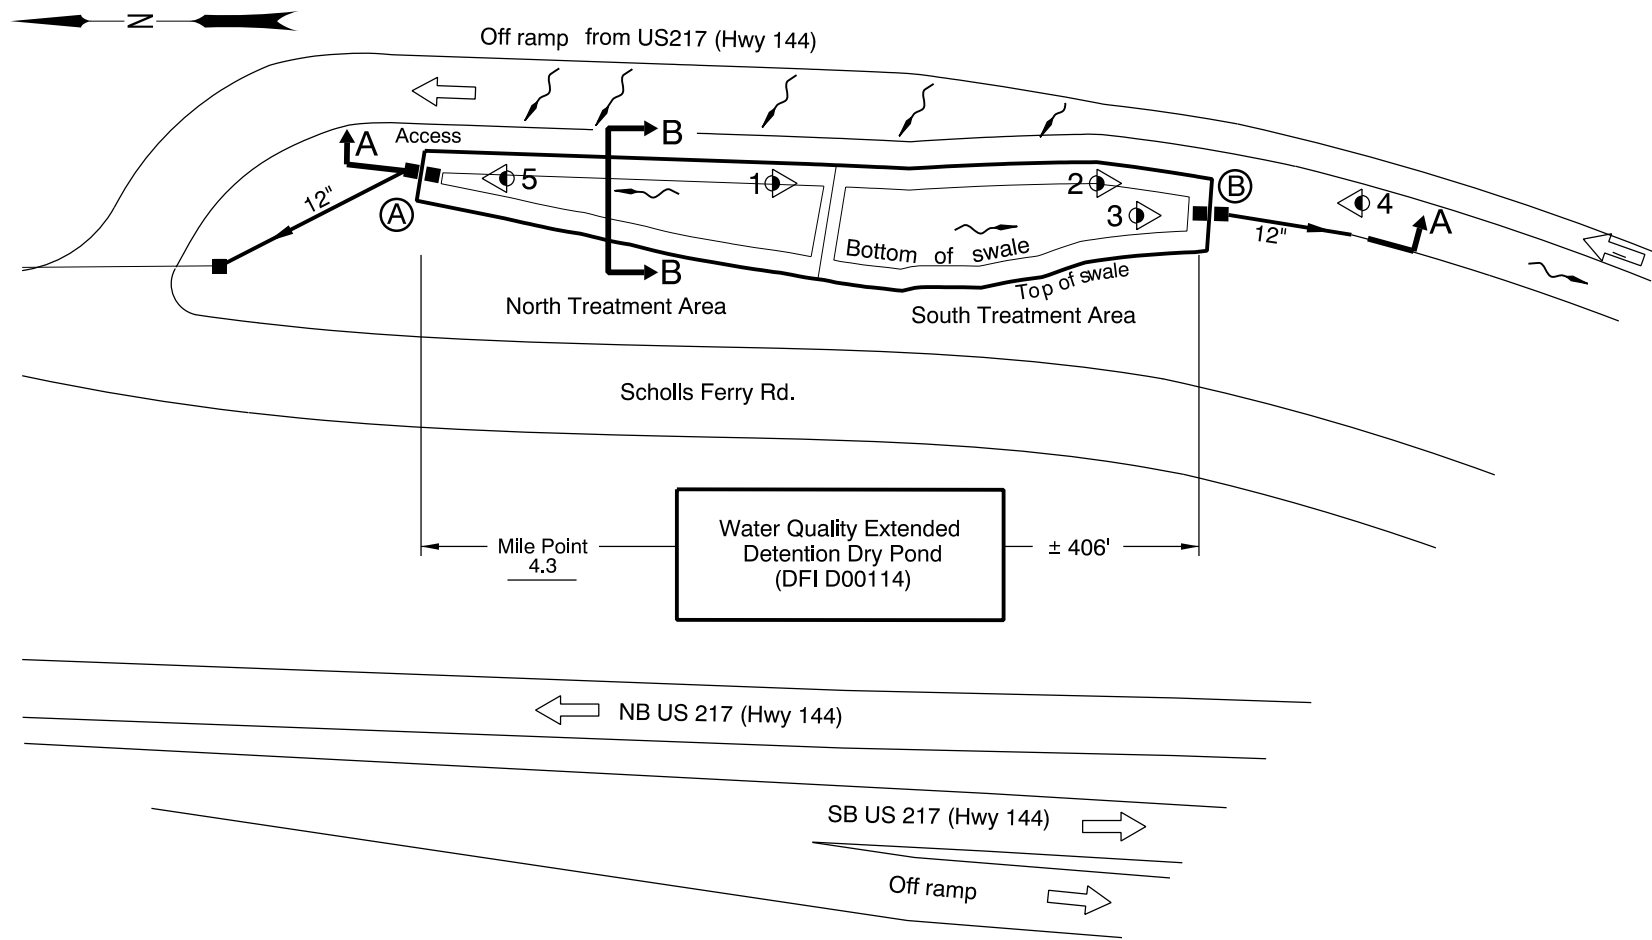


PLAN
N.T.S.

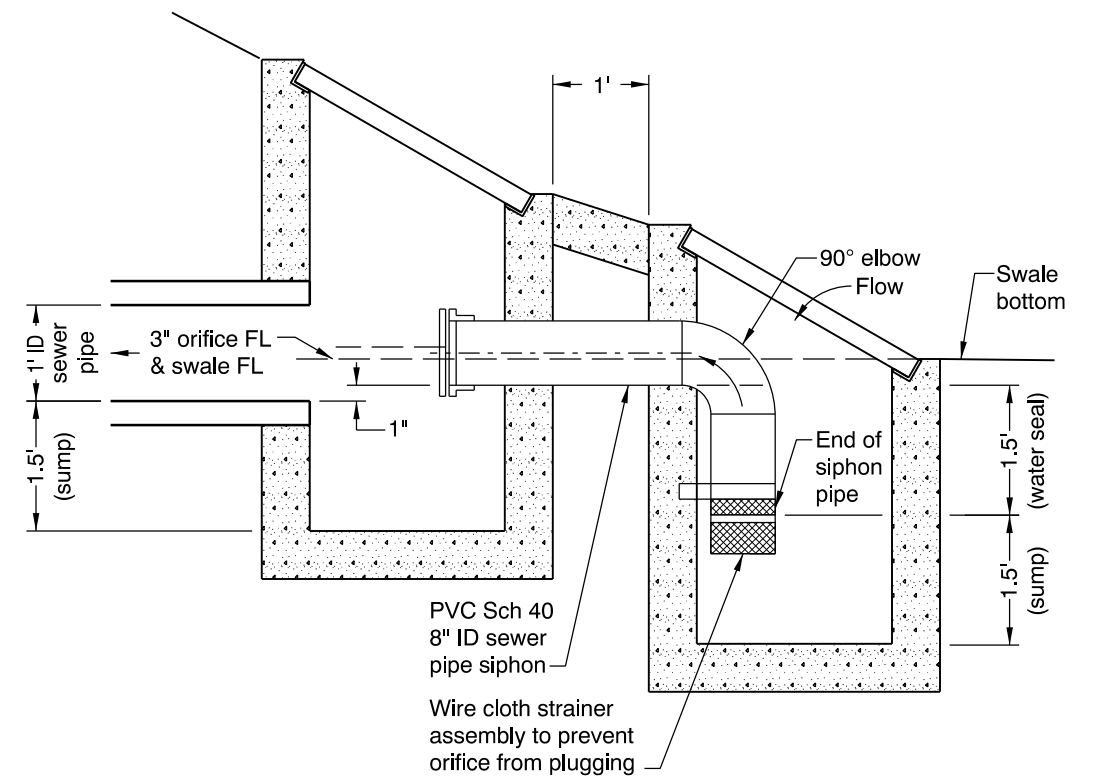

OUTLET CONTROL STRUCTURE
DETAIL AT POINTS A & B
N.T.S.

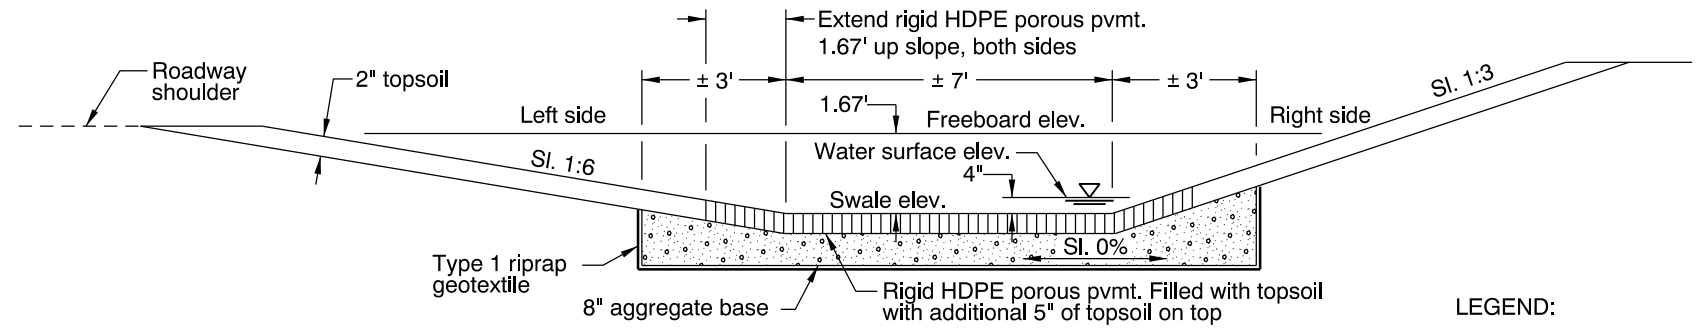

SECTION B-B
N.T.S.

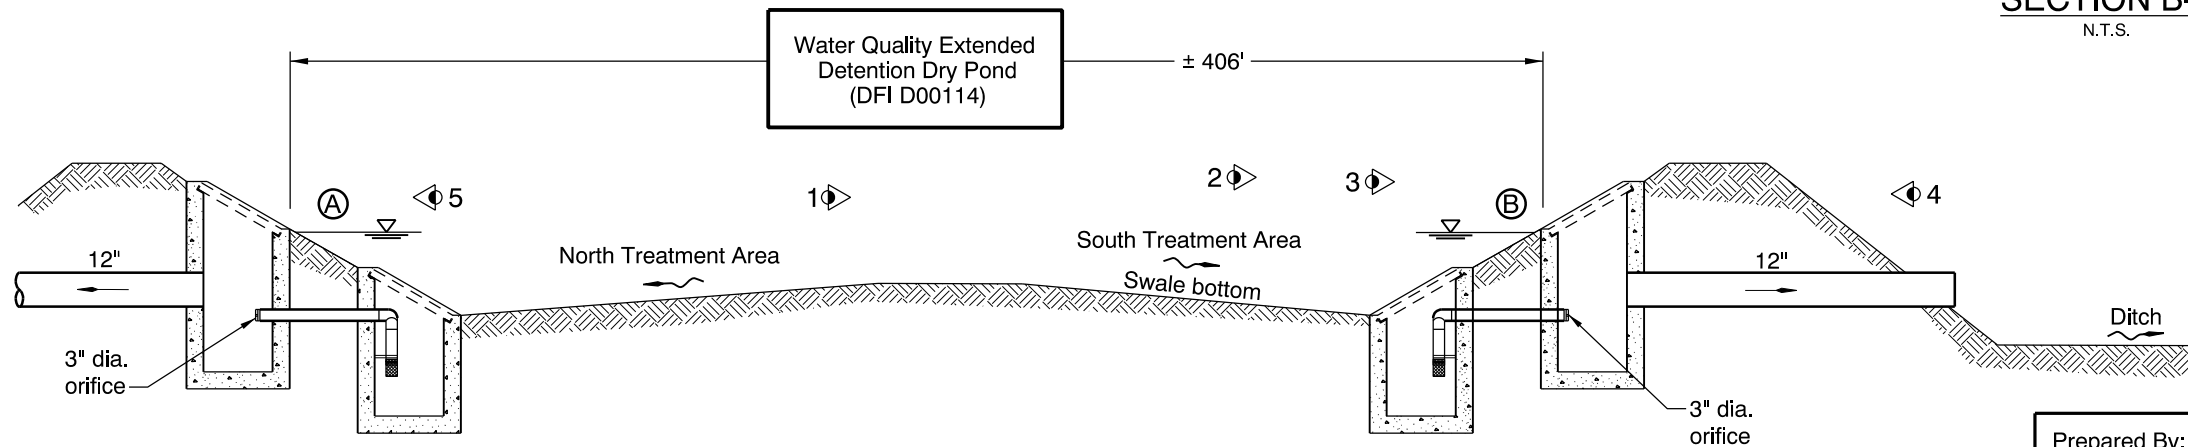

SECTION A-A
N.T.S.

LEGEND:

- ◊ Photo Location / Direction
- Ⓐ Outlet Control Structure, North
- Ⓑ Outlet Control Structure, South
- and ○ Manhole
- and □ Inlet
- Storm Pipe (Facility)
- Storm Pipe
- Conveyance Direction
- ↗ Pavement / Facility Flow Path
- ← Traffic direction/flow

Sht. 1 of 1

Prepared By: Bob Knorr

Drafted By: Jim Holeman/OBEC

OREGON DEPARTMENT OF TRANSPORTATION

DFI D00114

MAINTENANCE DISTRICT 2B HWY 144

WATER QUALITY EXTENDED DETENTION DRY POND

BEAVERTON-TIGARD HWY MP 4.3

WASHINGTON COUNTY

Appendix B

Content:

- **ODOT Project Plan Sheets**
 - *Cover/Title Sheet*
 - *Water Quality/Detention Plan Sheets*
 - *Other Details*

| INDEX OF SHEETS | |
|------------------------|--|
| SHEET NO. | DESCRIPTION |
| 1 | Title Sheet |
| 1A | Index of Sheets Cont'd. & Standard Drg. Nos. |
| 2, 2A Thru 2A-3 Incl. | Typical Sections |
| 2B, 2B-2 | Details |
| 2C Thru 2C-4 Incl. | Traffic Control Plans |
| 2D, 2D-2 | Pipe Data |
| 3 | Alignment |
| 3A | General Construction |
| 3B | Drainage & Utilities |
| 4 | Alignment |
| 4A | General Construction |
| 4B | Profile |
| GL/O/HYDRO | |
| GHA-1 | Erosion Control Plan |
| GHJ-1 | Water Quality Plan |
| GHJ-2 Thru GHJ-4 Incl. | Water Quality Details |

| DRAWING NO. | DESCRIPTION |
|-------------|--|
| 61996 | RETAINING WALL (BRIDGE NO. 19617) Bridge #19617 Drawing |

| SHEET NO. | DESCRIPTION |
|----------------------|--|
| ST-1 Thru ST-3 Incl. | PERMANENT PAVEMENT MARKINGS Striping Plan |

PROJECT

STA. "Hall" 9 + 060
STA. "SF" 9 + 147

BEGINNING OF PROJECT

X-STP-S000(190)
STA. "E3" 10 + 008 (M.P. 4.80 - OR217)

END OF PROJECT

X-STP-S000(190)
STA. "E3" 10 + 200 (M.P. 4.67 - OR217)

STATE OF OREGON
DEPARTMENT OF TRANSPORTATION

PLANS FOR PROPOSED PROJECT

GRADING, DRAINAGE, STRUCTURES, PAVING, SIGNING, & SIGNAL

BEAVERTON/TUALATIN HWY. & TIGARD HWY. AT SCHOLLS


BEAVERTON/TUALATIN & SCHOLLS HWYS. & BEAVERTON - TIGARD HWY.

WASHINGTON COUNTY
SEPTEMBER 2003

RECEIVED
ODOT CREW 1802
OCT 27 2003

PROJECT MANAGER


"AS CONSTRUCTED"
Bill Johnson
Project Manager
NOV 18 2004
Data COURSE

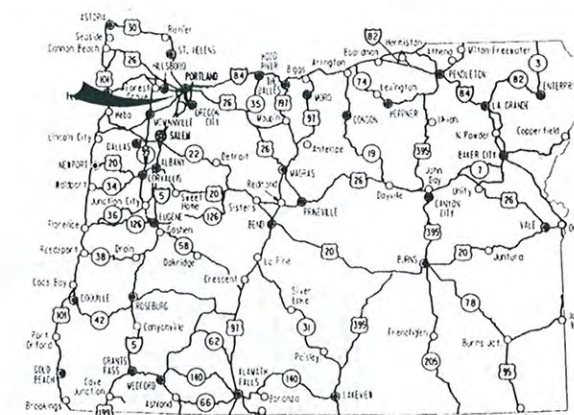

Approx. Overall Length Of Hwy. 141 Project - 209.89 m (688.62 Ft.)
Approx. Overall Length Of Ramp Project - 0.21 km (0.13 Mile)

ATTENTION :
Oregon Law Requires You To Follow Rules Adopted By The Oregon Utility Notification Center. Those Rules Are Set Forth In OAR 952-001-0010 Through OAR 952-001-0090. You May Obtain Copies Of The Rules By Calling The Center. (Note: the Telephone Number for the Oregon Utility Center Is (503) 232-1987).

LET'S ALL
WORK TOGETHER
TO MAKE THIS
JOB SAFE

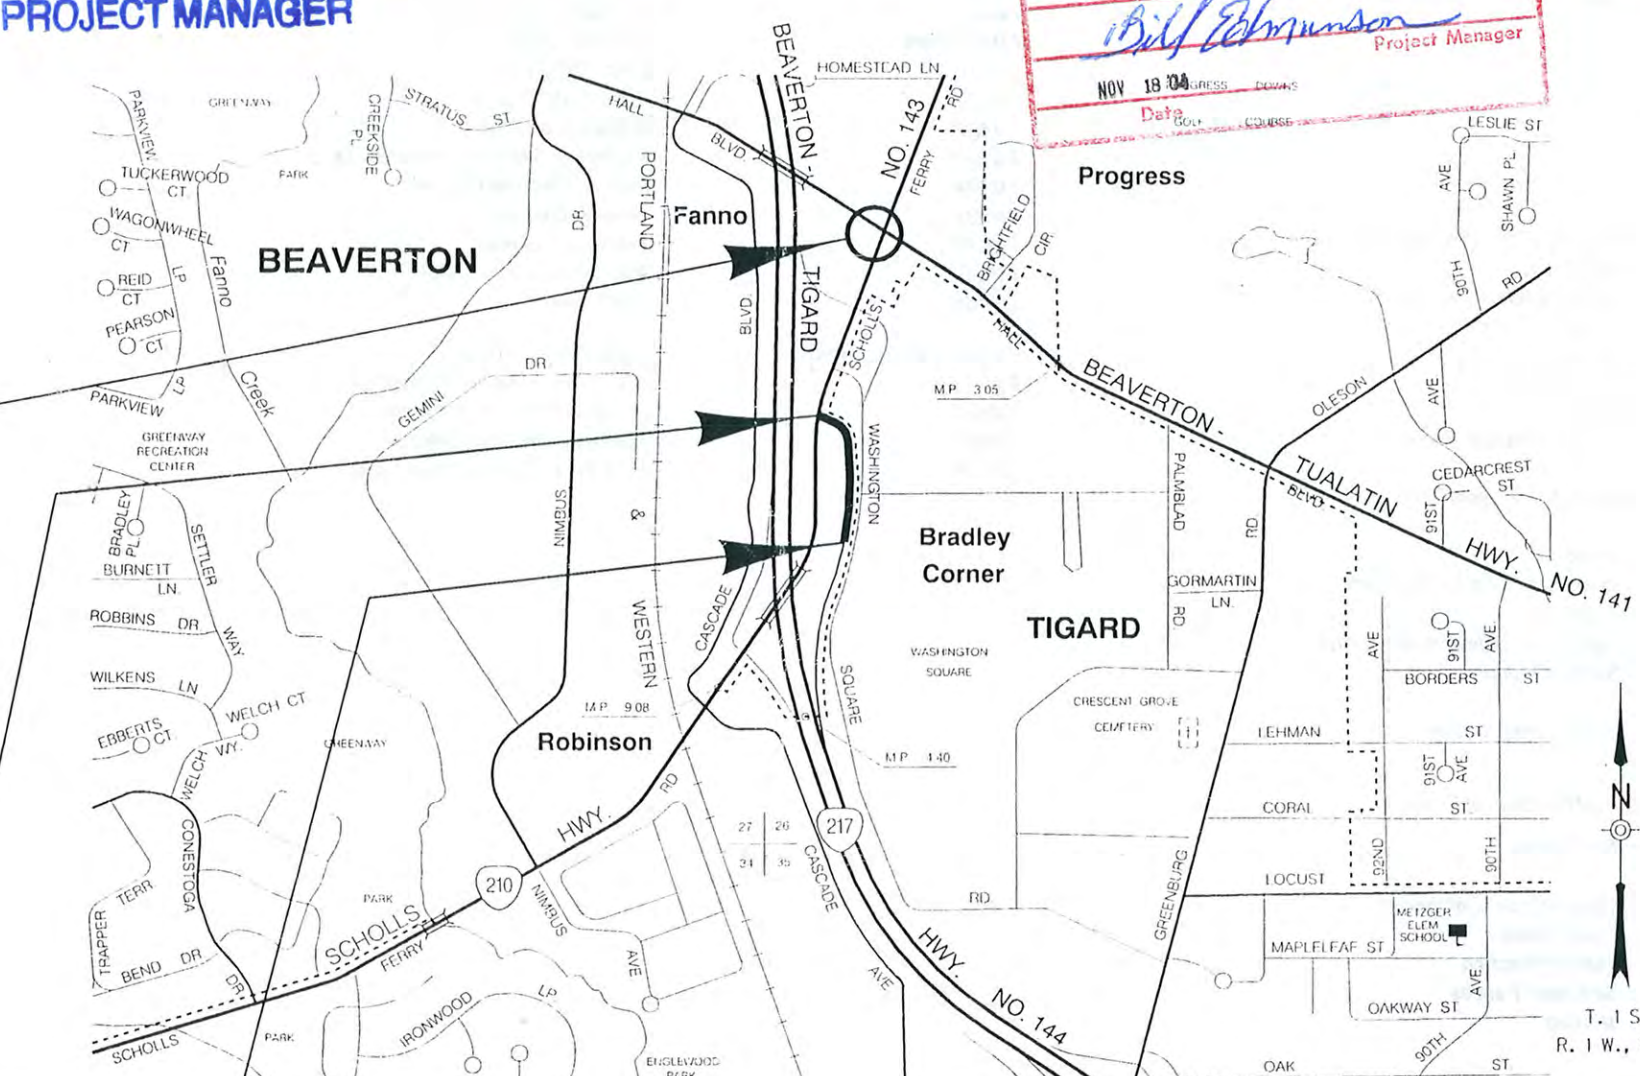

- OREGON TRANSPORTATION COMMISSION
- Steven H. Corey CHAIRMAN
 - Gail L. Achterman COMMISSIONER
 - Stuart Foster COMMISSIONER
 - Randall Papé COMMISSIONER
 - John Russell COMMISSIONER
 - Bruce A. Warner DIRECTOR OF TRANSPORTATION






Catherine M. Nelson
TECHNICAL SERVICES MANAGING ENGINEER

BEAVERTON/TUALATIN HWY & TIGARD HWY AT SCHOLLS
BEAVERTON/TUALATIN & SCHOLLS HWYS. & BEAVERTON - TIGARD HWY.
WASHINGTON COUNTY


| | | |
|--------------------------------|-----------------|-----------|
| FEDERAL HIGHWAY ADMINISTRATION | PROJECT NUMBER | SHEET NO. |
| OREGON DIVISION | X-STP-S000(190) | 1 |



Sec. 26, T. 1S, R. 1W, W.M.

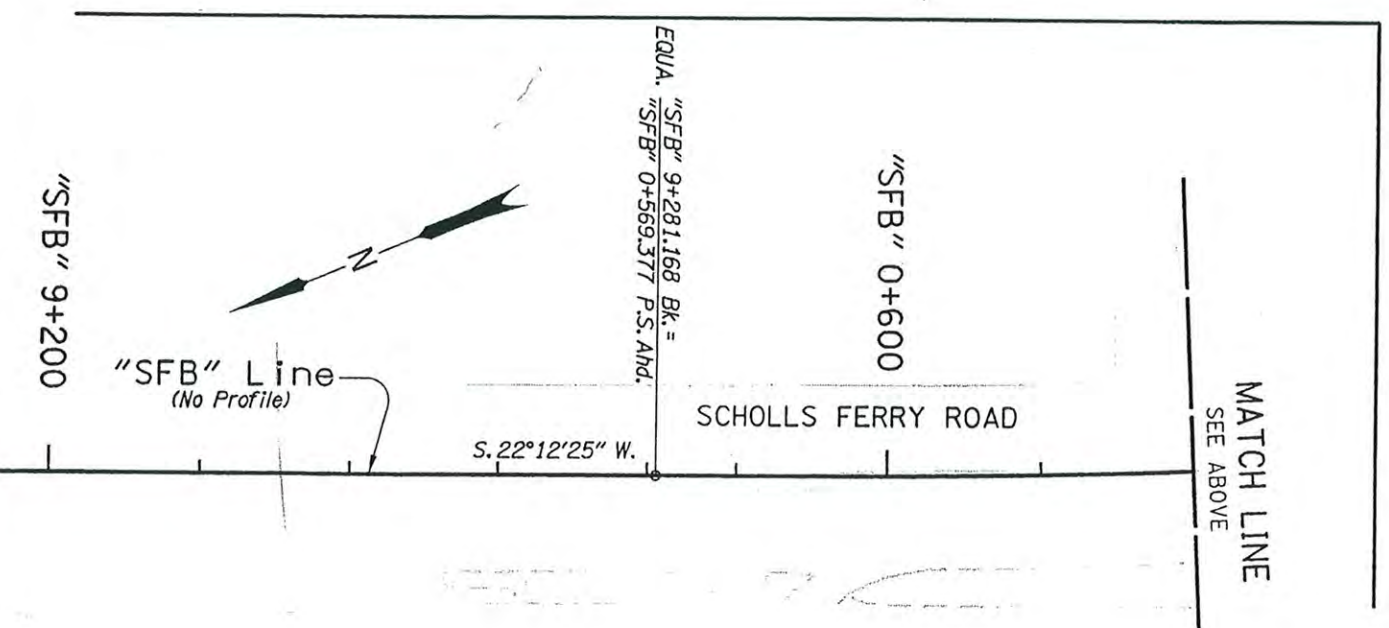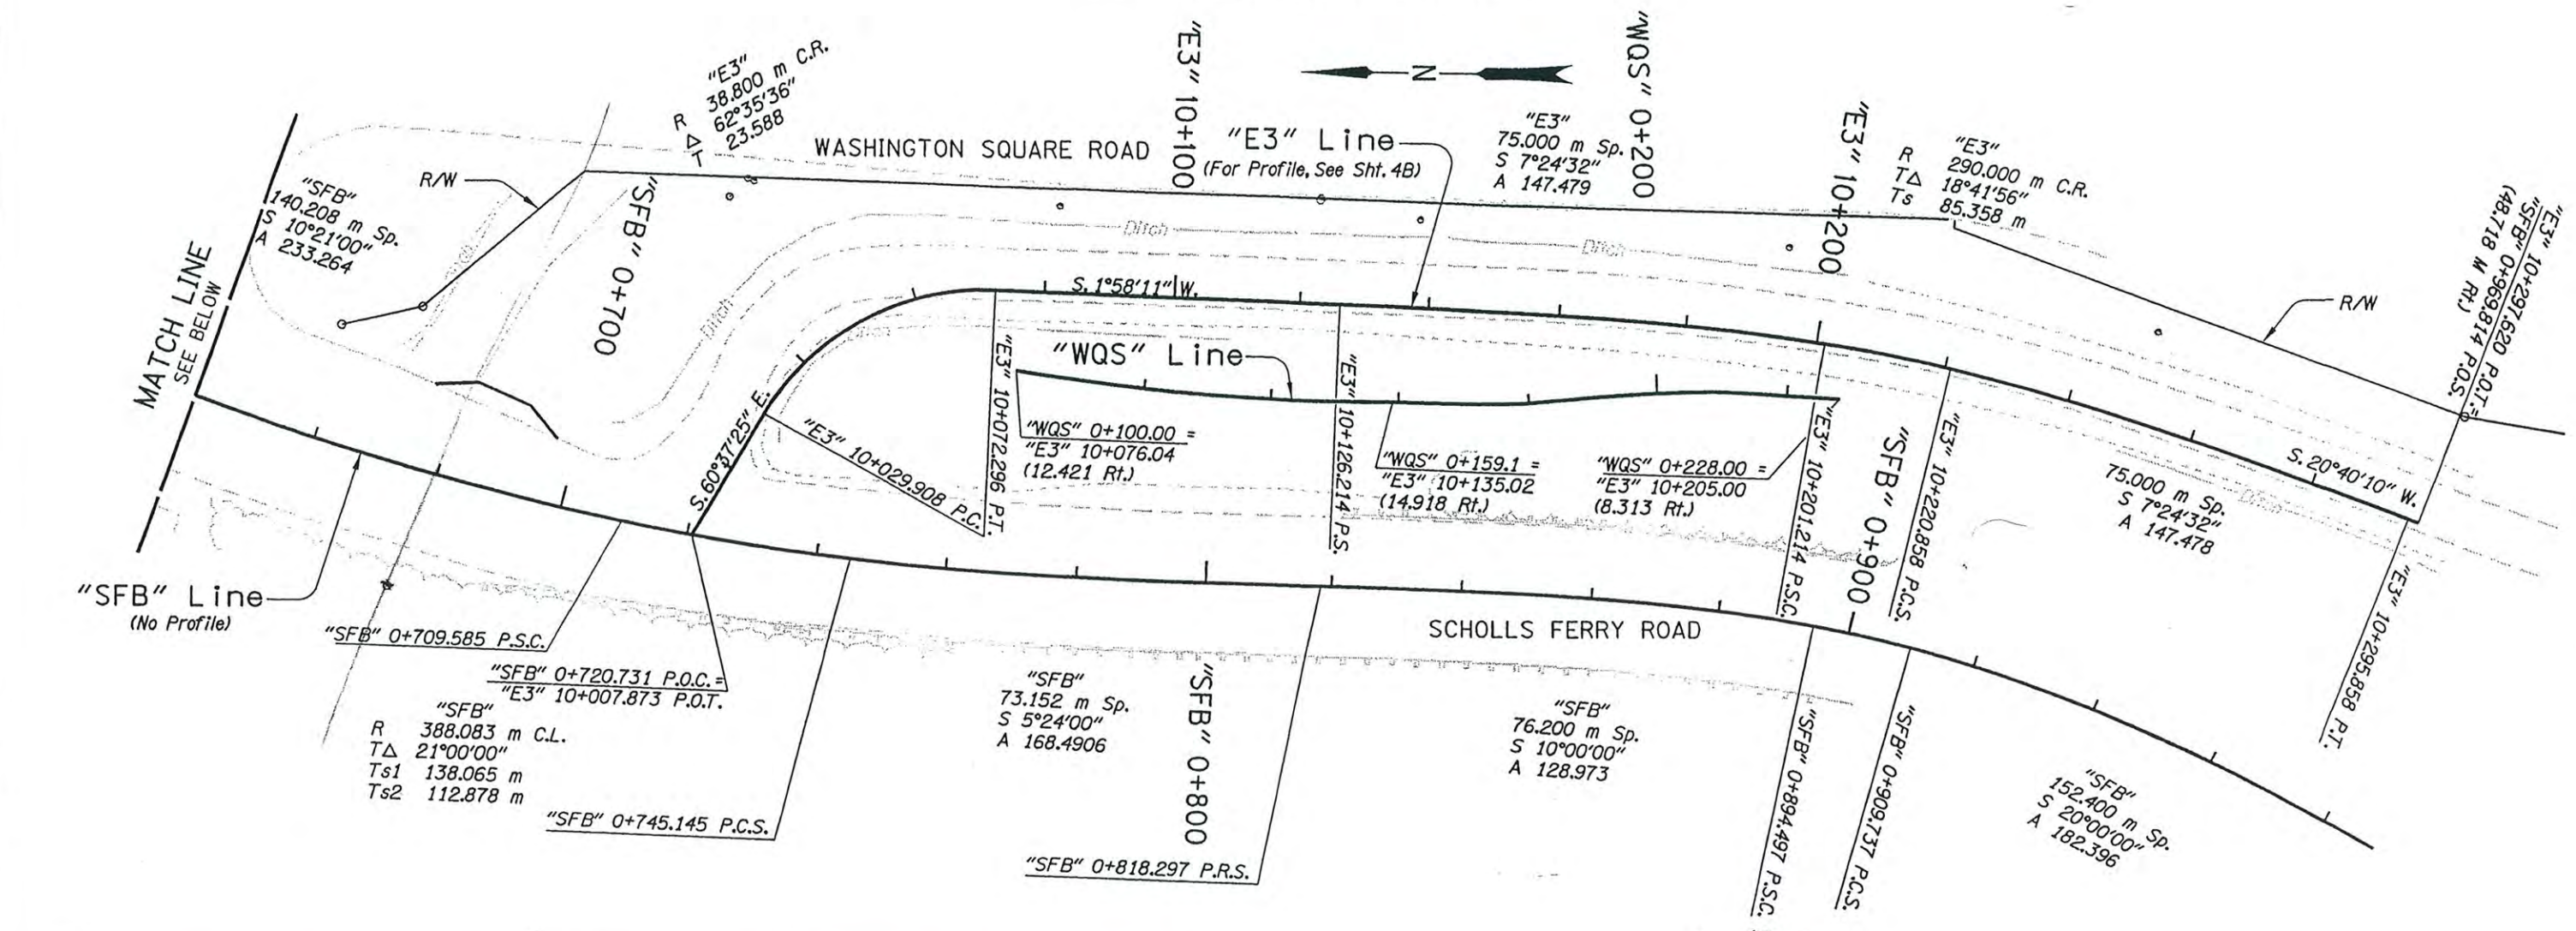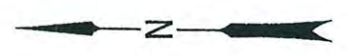


"AS CONSTRUCTED"
Bill Johnson
 Project Manager
 FEB 28 09
 Date

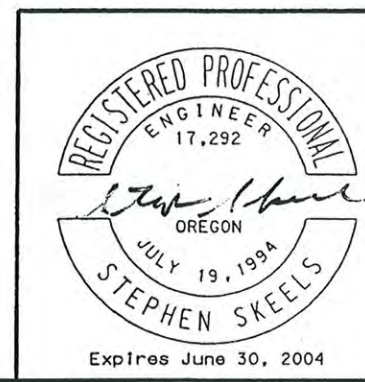

| | |
|---|-----------------------|
| OREGON DEPARTMENT OF TRANSPORTATION ROADWAY ENGINEERING SECTION BEAVERTON/TUALATIN & TIGARD HWY. AT SCHOLLS (BEAVERTON) SECS. BEAVERTON/TUALATIN & SCHOLLS HWYS. & BEAVERTON - TIGARD HWY. WASHINGTON COUNTY | |
| Project Leader - Sandy R. VanBemmel Designed By - Stephen G. Skeels Drafted By - Martin G. Casillas | |
| ALIGNMENT | SHEET NO. 4 |



14-JUL-2003 13:30

"AS CONSTRUCTED"
Bill Edmondson
 Project Manager
 FEB 25 '05
 Date

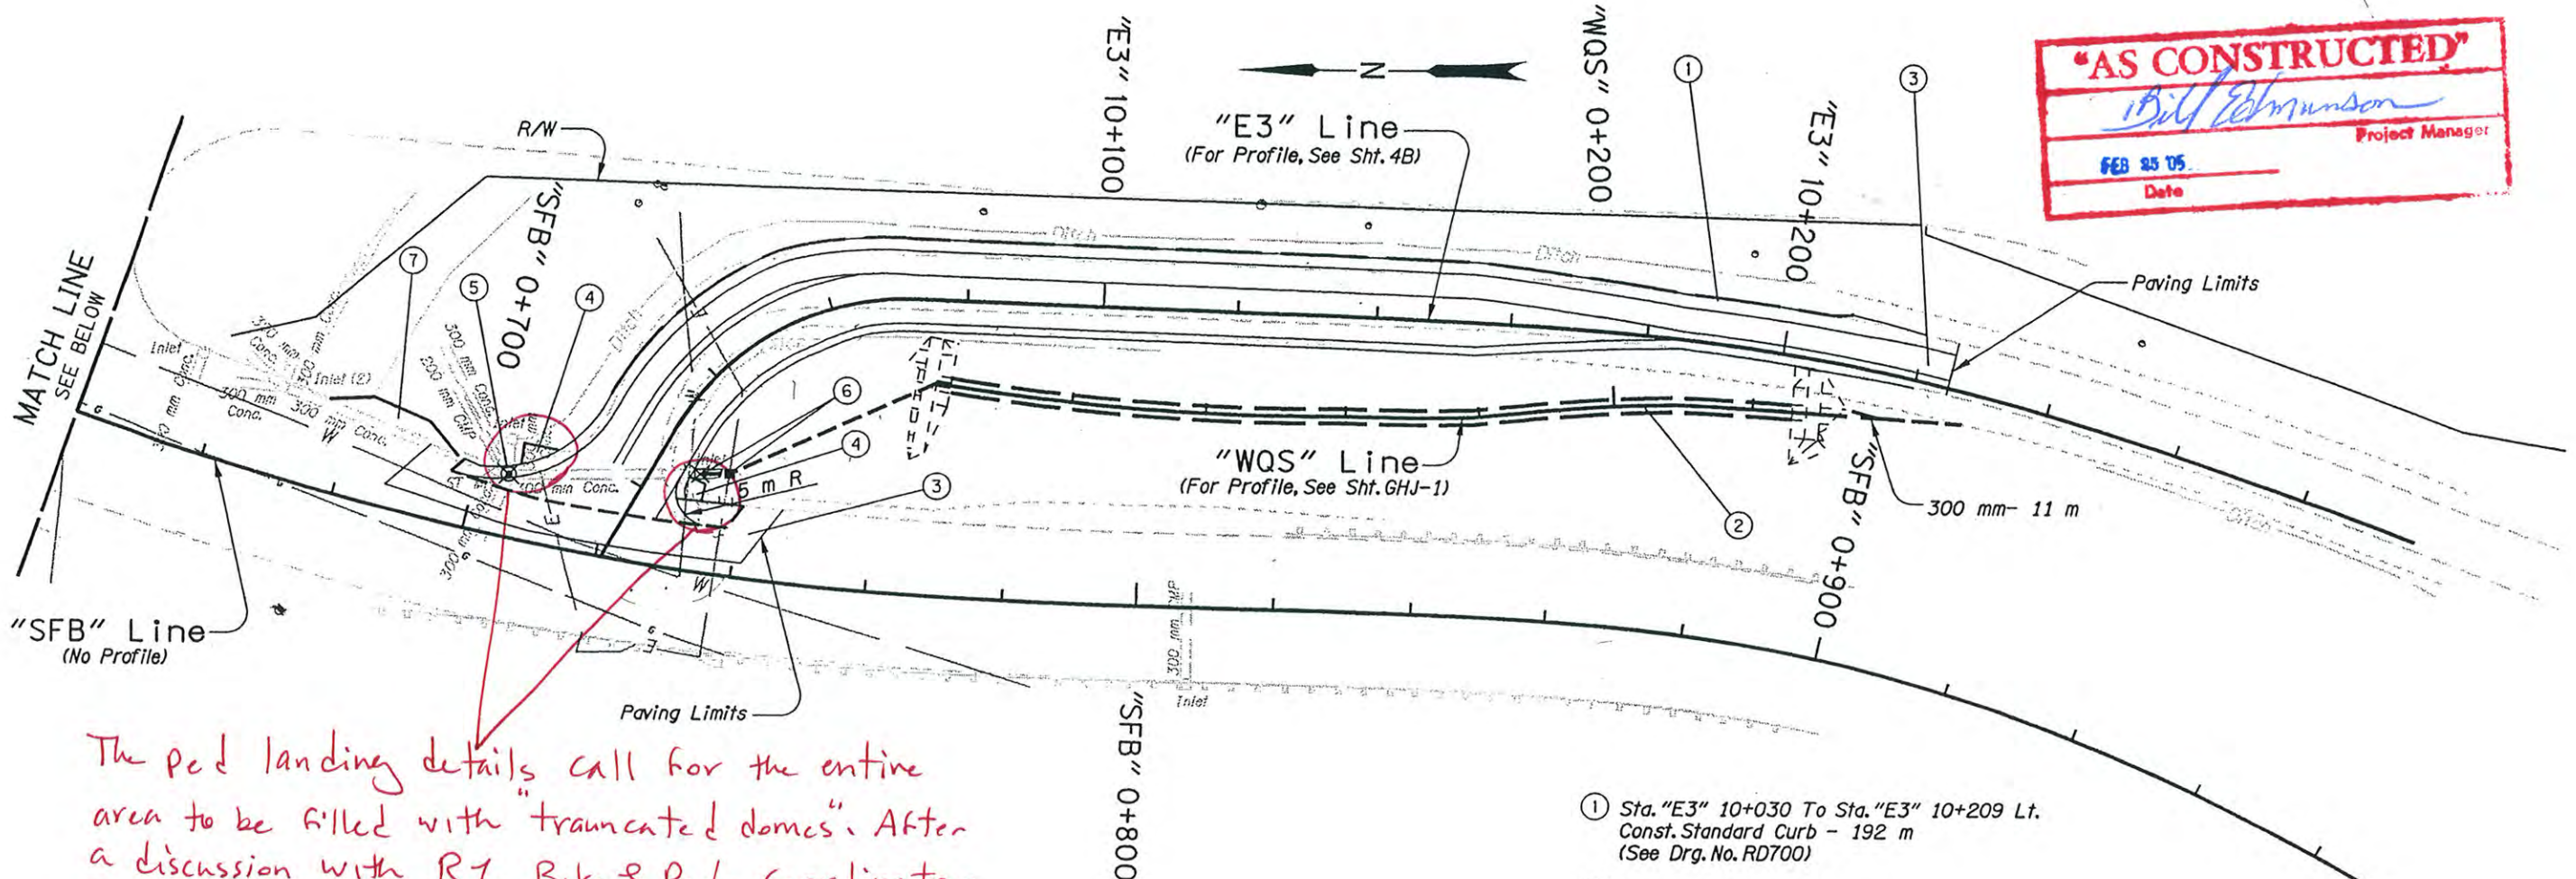

The ped landing details call for the entire area to be filled with "truncated domes". After a discussion with RI Bike & Peds Coordinator Basil Christopher, we decided to install one dome on each side.

- ① Sta. "E3" 10+030 To Sta. "E3" 10+209 Lt. Const. Standard Curb - 192 m (See Drg. No. RD700)
 - ② Const. Water Quality Swale (For Details, See Shts. GHJ-1 Thru GHJ-4)
 - ③ Grind & Inlay (For Details, See Sht. 2B-2)
 - ④ Const. Pedestrian Landing - 2 (For Details, See Sht. 2B-2)
 - ⑤ Adjust Manhole (See Drg. No. RD360)
 - ⑥ Remove Inlet Const. Type "G-2MA" Inlet Inst. 300 mm Sewer Pipe - 5 m Conn. To Extg. Pipe (See Drg. No. RD364) - INLET
 - ⑦ Const. Maintenance Pad (See Drg. No. TM434)
 - ⑧ Sta. "SFB" 9+280.0 To "SFB" 0+590.1 Const. Type "B" Traffic Separator - 14.3 m² Match Extg. (See Drg. No. RD705)
- All Dimensions Are In Meters (m)
 Unless Otherwise Noted.

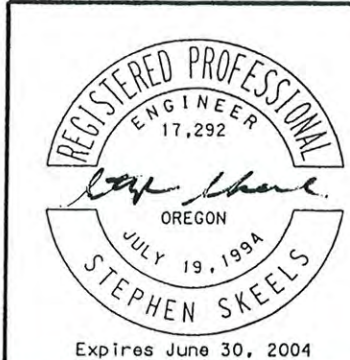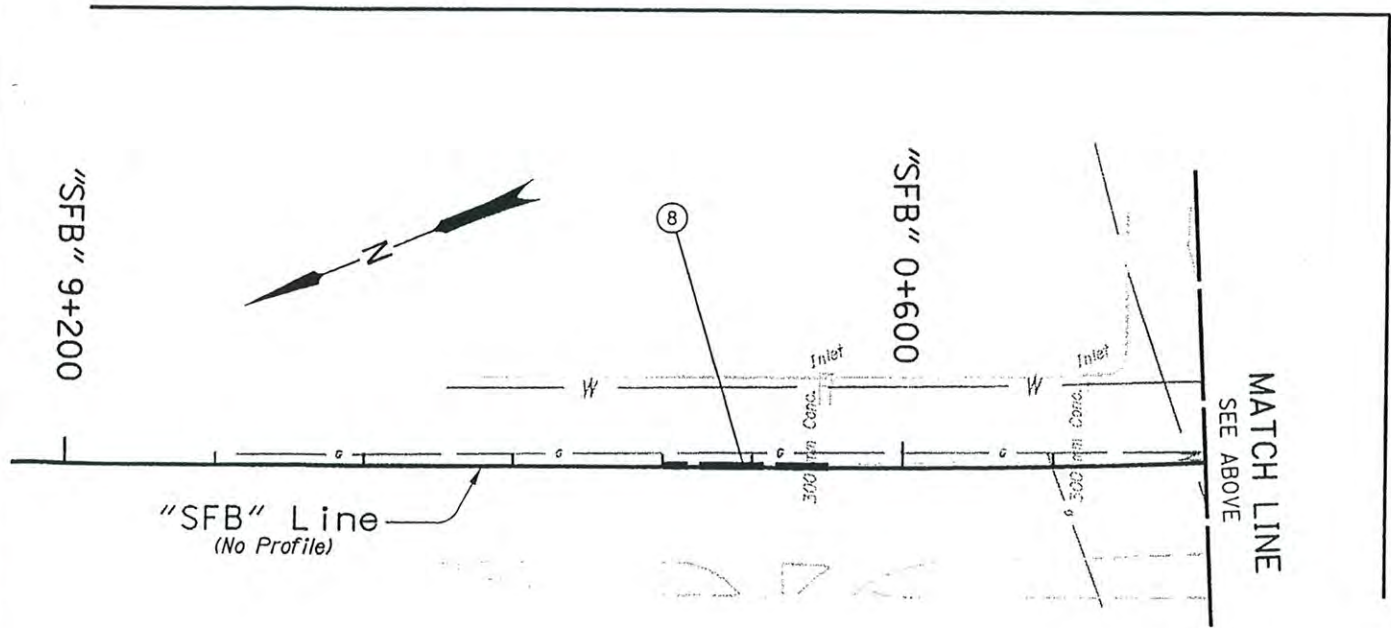

OREGON DEPARTMENT OF TRANSPORTATION
 ROADWAY ENGINEERING SECTION
BEAVERTON/TUALATIN & TIGARD HWY. AT SCHOLLS (BEAVERTON) SECS.
 BEAVERTON/TUALATIN & SCHOLLS HWYS. & BEAVERTON - TIGARD HWY. WASHINGTON COUNTY
 Project Leader - Sandy R. VanBommel
 Designed By - Stephen G. Skeels
 Drafted By - Martin G. Casillas

GENERAL CONSTRUCTION

SHEET NO. **4A**


14-JUL-2003 13:30

U:\VIST-VTO\jessv\101\scollis\06018\scollis\060101.dwg, pl

"E3" Line

STA. 10+008.000
BEGINNING OF PROJECT


"AS CONSTRUCTED"
Bill Edmanson
Project Manager
FEB 25 03
Date

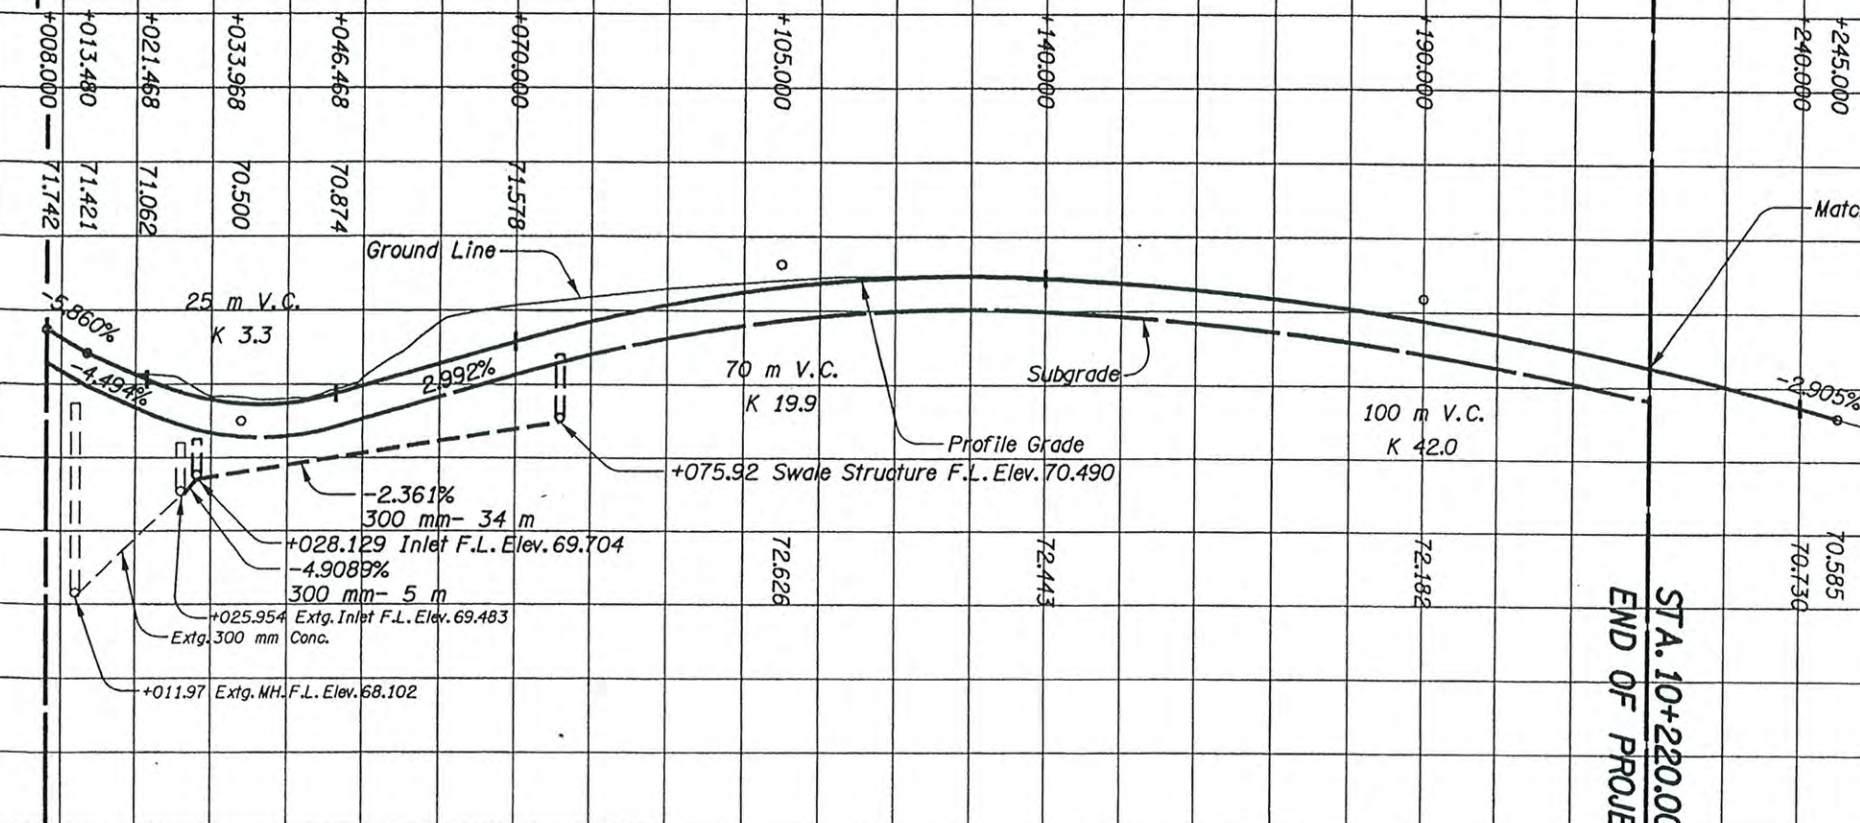

STA. 10+220.000
END OF PROJECT

| Earthwork Volumes (cubic meters): | | |
|-----------------------------------|-----------|----------|
| Total | Stage I | Stage II |
| C 3359 | C 2760 | C 599 |
| F 544 | F 446 | F 98 |
| Net +2815 | Net +2314 | Net +501 |

Superelevation Rate Chart

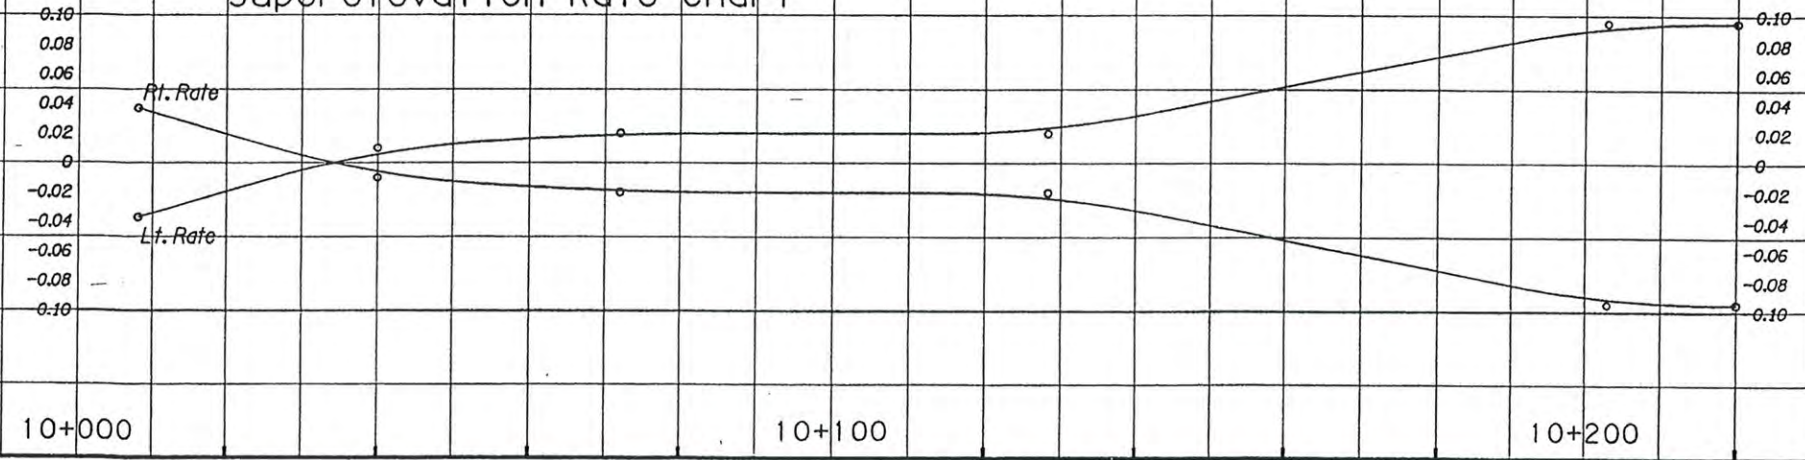

10+300
All Dimensions Are In Meters (m)
Unless Otherwise Noted.




OREGON DEPARTMENT OF TRANSPORTATION
ROADWAY ENGINEERING SECTION
**BEAVERTON/TUALATIN & TIGARD HWY.
AT SCHOLLS (BEAVERTON) SECS.**
BEAVERTON/TUALATIN & SCHOLLS HWYS. &
BEAVERTON - TIGARD HWY.
WASHINGTON COUNTY
Project Leader - Sandy R. VanBemmel
Designed By - Stephen G. Skeels
Drafted By - Martin G. Casillas


PROFILE

SHEET NO.
4B

14-JUL-2003 13:27
U:\usr\vro\jestr\v\j\ur\schollis\06\060101\060101.dfl

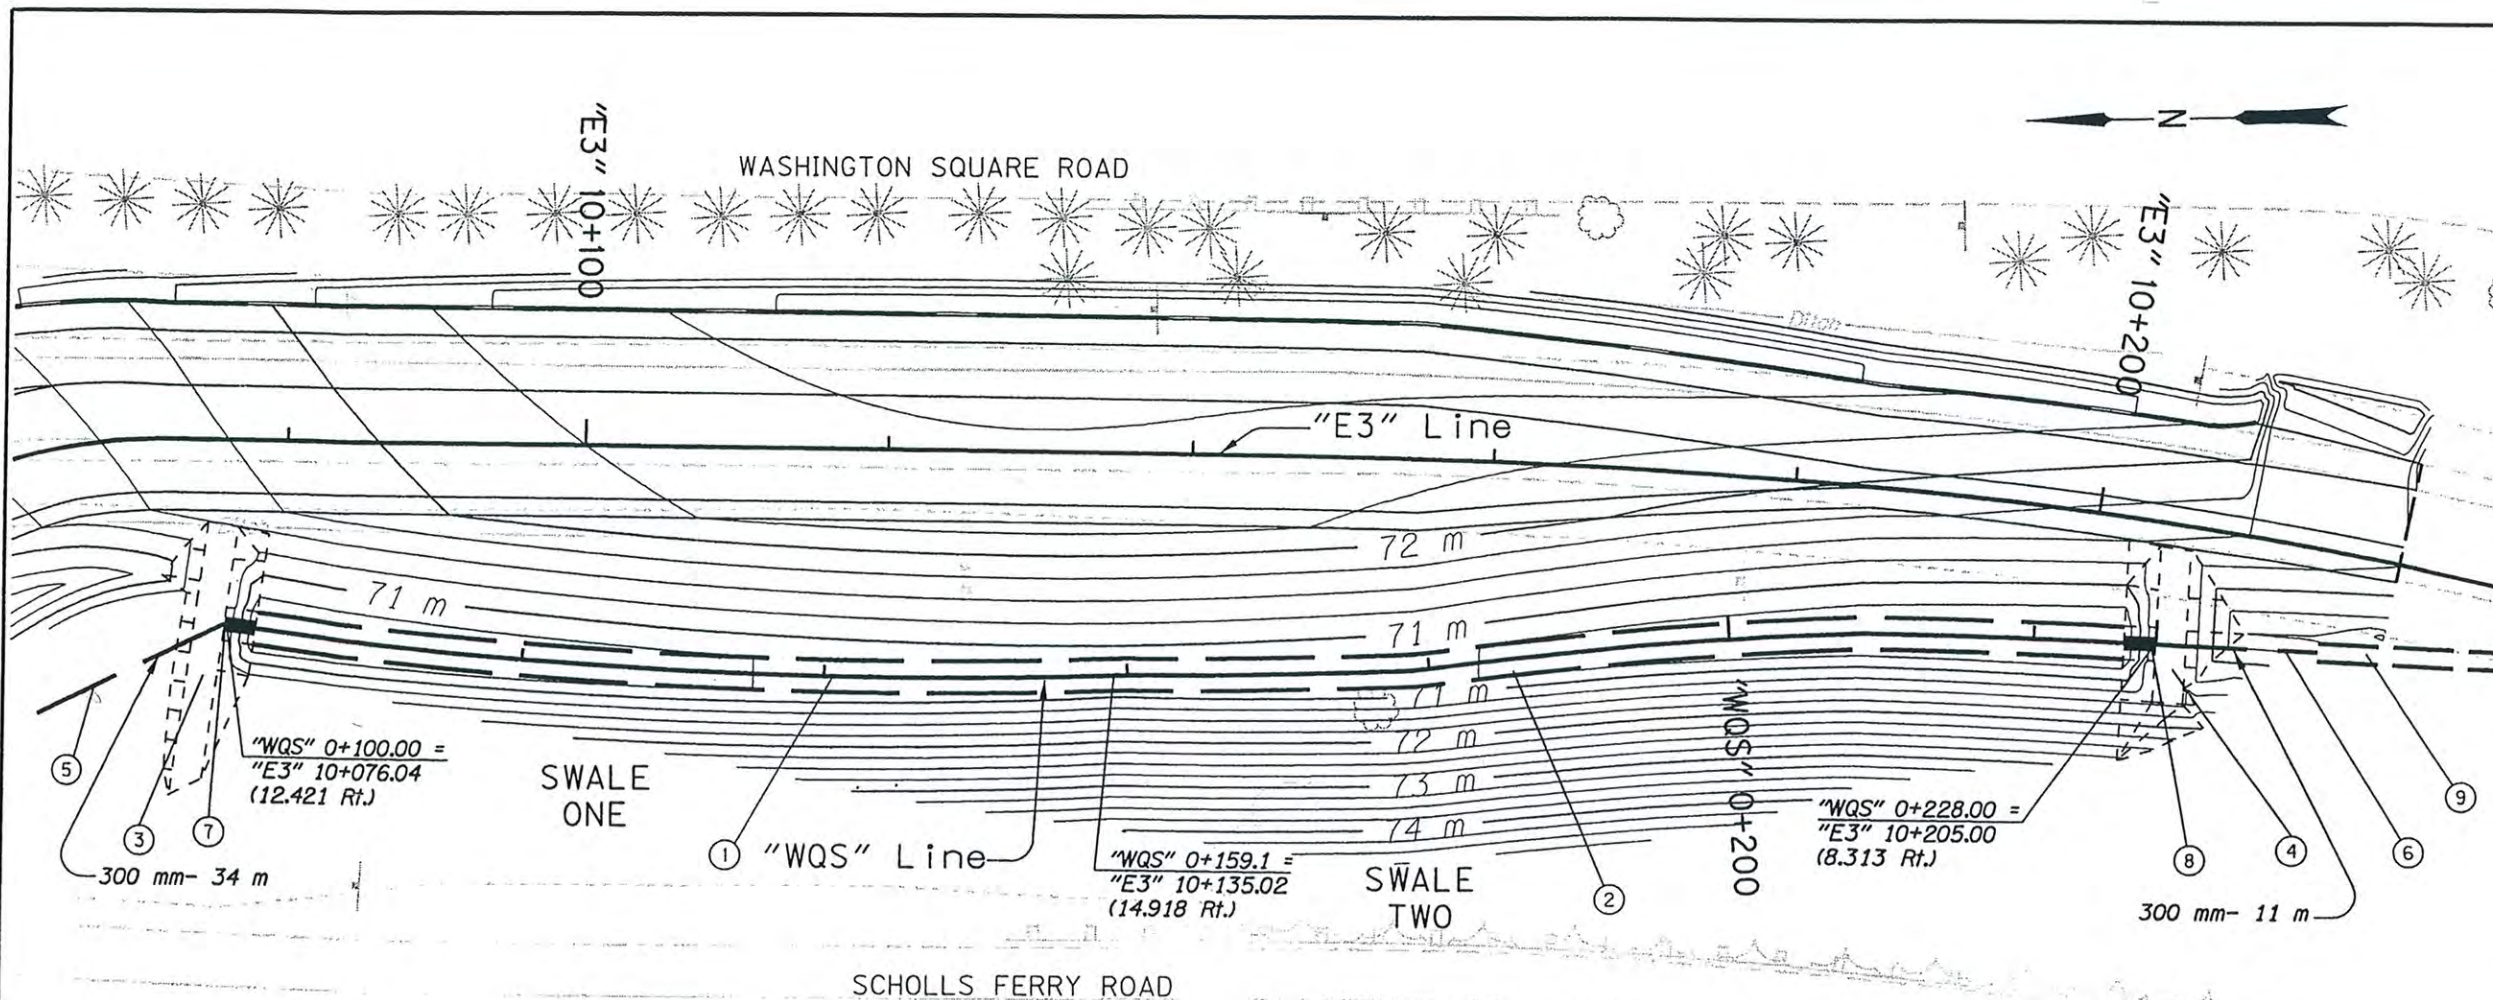


- ① Const. Swale "ONE"
To Line And Grade As Shown In Plans,
Typicals, And Profiles
Earthwork In Roadway Quantities
(For Details, See Shfts. GHJ-2, GHJ-3 & GHJ-4)
- ② Const. Swale "TWO"
To Line And Grade As Shown In Plans,
Typicals, And Profiles
Earthwork In Roadway Quantities
(For Details, See Shfts. GHJ-2, GHJ-3 & GHJ-4)
- ③ Const. Closure Berm For Swale "ONE"
Earthwork In Roadway Quantities
(For Details, See Sht. GHJ-3)
- ④ Const. Closure Berm For Swale "TWO"
Earthwork In Roadway Quantities
(For Details, See Sht. GHJ-3)
- ⑤ Sta "E3" 10+058.94, 9.168 Rt = "P1" 0+000
Inst. 300 mm Sew. Pipe - 34 m
1.5 m Depth
Outfall FL = 69.704 m
- ⑥ Sta "E3" 10+215.80, 7.012 Rt = "P2" 0+000
Inst. 300 mm Sew. Pipe - 11 m
1.5 m Depth
Outfall FL = 70.227 m
- ⑦ Sta. "E3" 10+075.92, 12.421 Rt.
Const. Swale Outlet Structure, FL= 70.490 m
(For Details, See Sht. GHJ-4)
- ⑧ Sta. "E3" 10+205, 8.313 Rt
Const. Swale Outlet Structure, FL= 70.444 m
(For Details, See Sht. GHJ-4)
- ⑨ Sta. "E3" 10+228.28, 4.992 Rt = "D" 0+000
Const. "V" Ditch - 12.5 m
Ditch Slopes - 1V:4H
Outfall El. = 69.973
Ditch Exc. = 5 m³

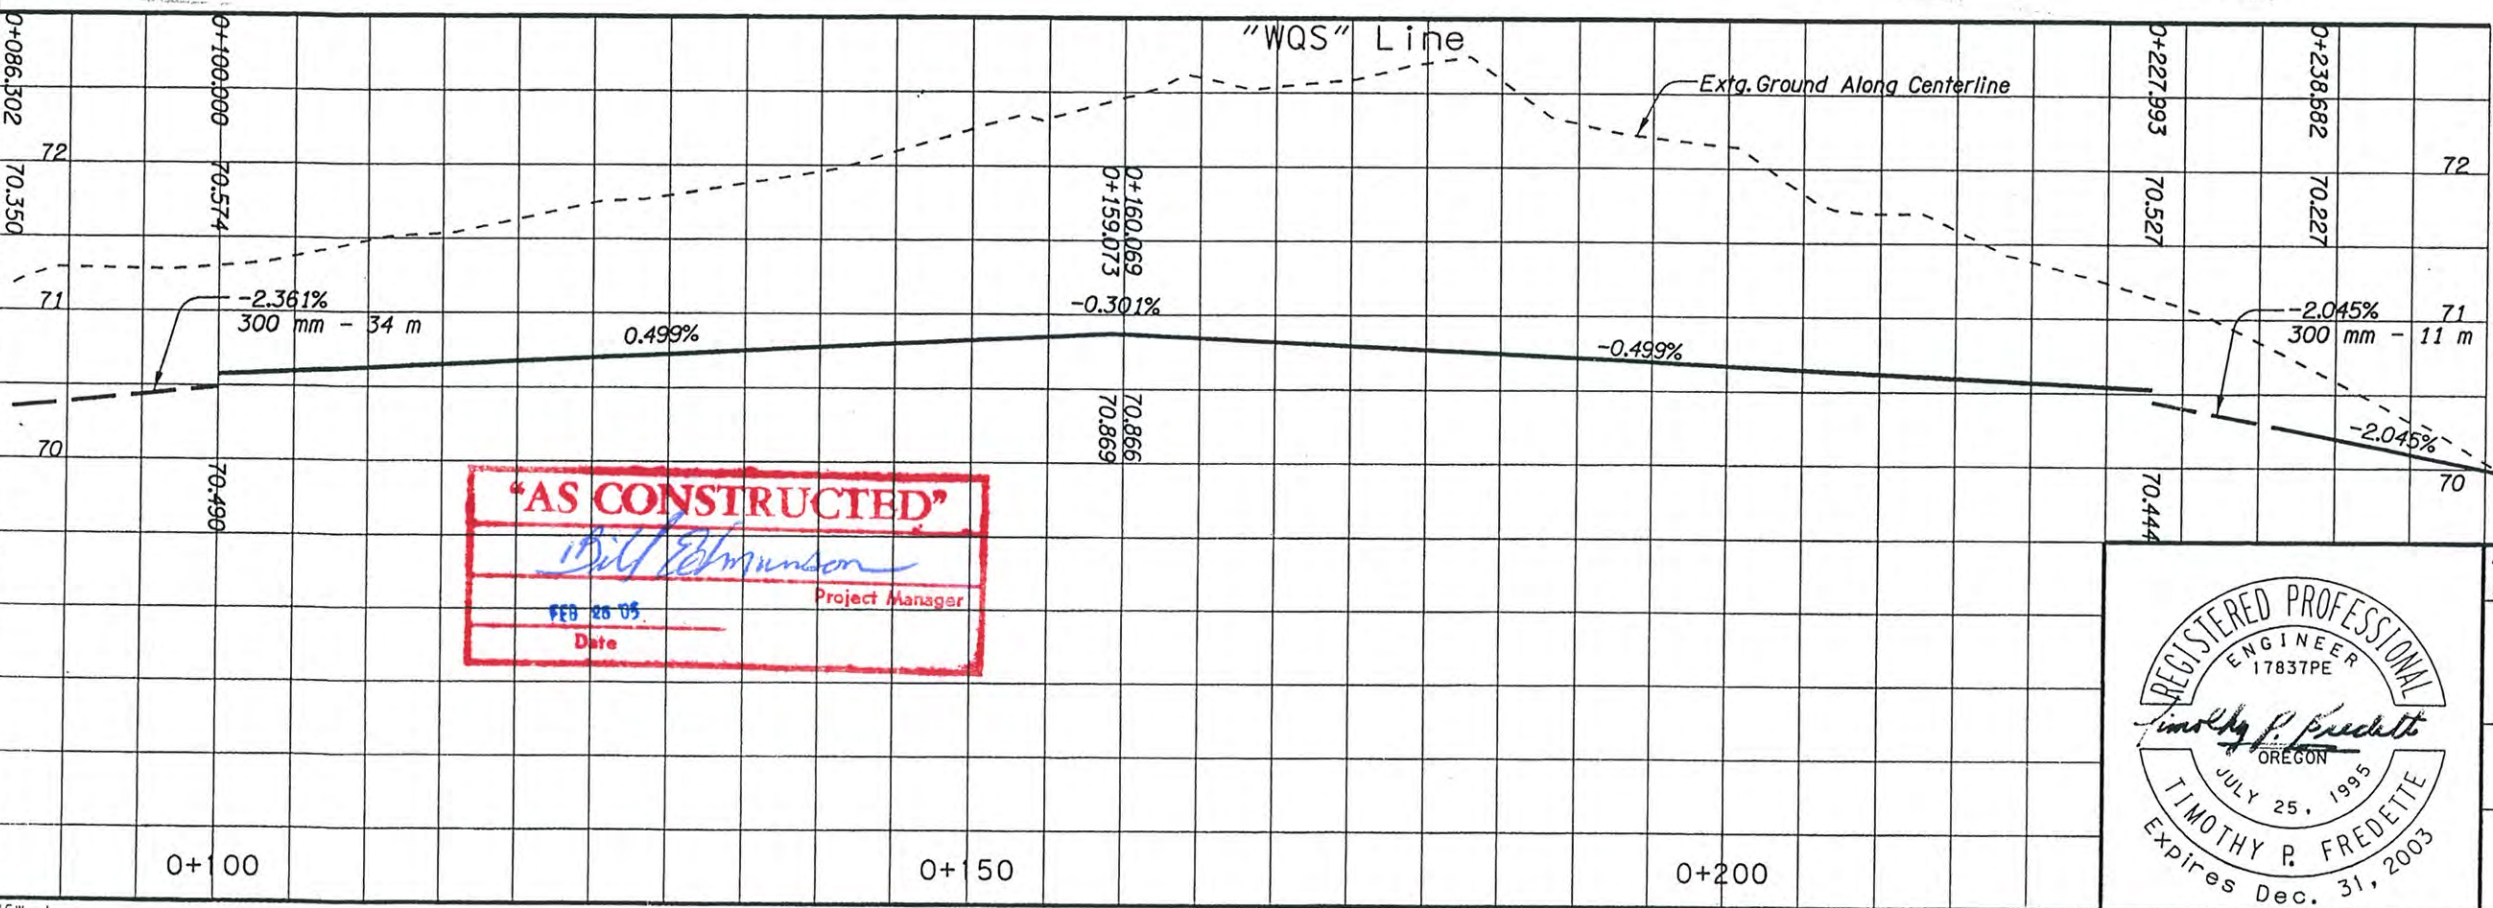

AS CONSTRUCTED

Bill Johnson
Project Manager

FEB 26 05
Date

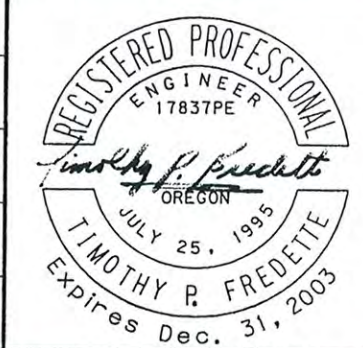

OREGON DEPARTMENT OF TRANSPORTATION
GEO / HYDRO SECTION

**BEAVERTON/TUALATIN & TIGARD HWY.
AT SCHOLLS (BEAVERTON) SECS.**
BEAVERTON/TUALATIN & SCHOLLS HWYS. &
BEAVERTON - TIGARD HWY.
WASHINGTON COUNTY



Project Leader - Sandy R. VanBommel
Designed By - Timothy P. Fredette
Drafted By - Martin G. Casillas

WATER QUALITY PLAN

SHEET NO.
GHJ-1


All Dimensions Are In Meters (m)
Unless Otherwise Noted.

C:\usr\Projects\3107\Scholls\06010\Scholls\WQ\06010\wppl

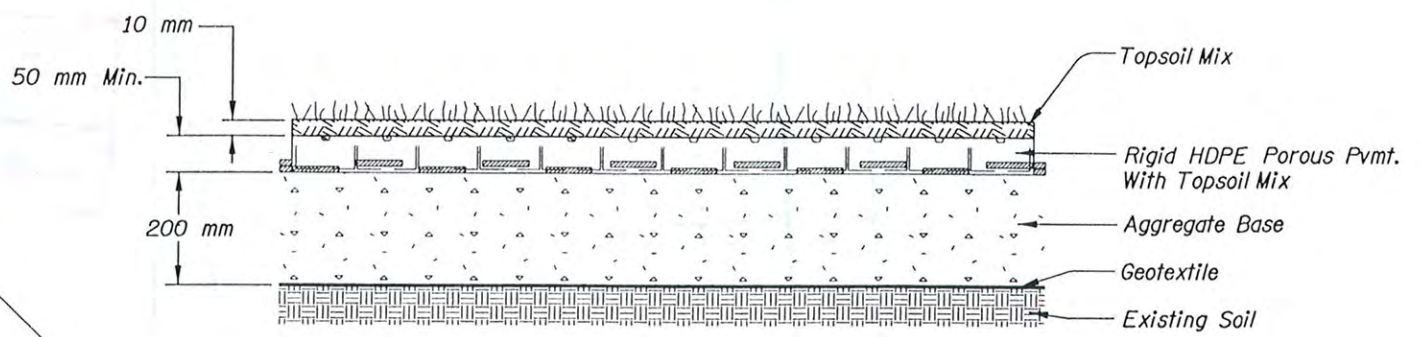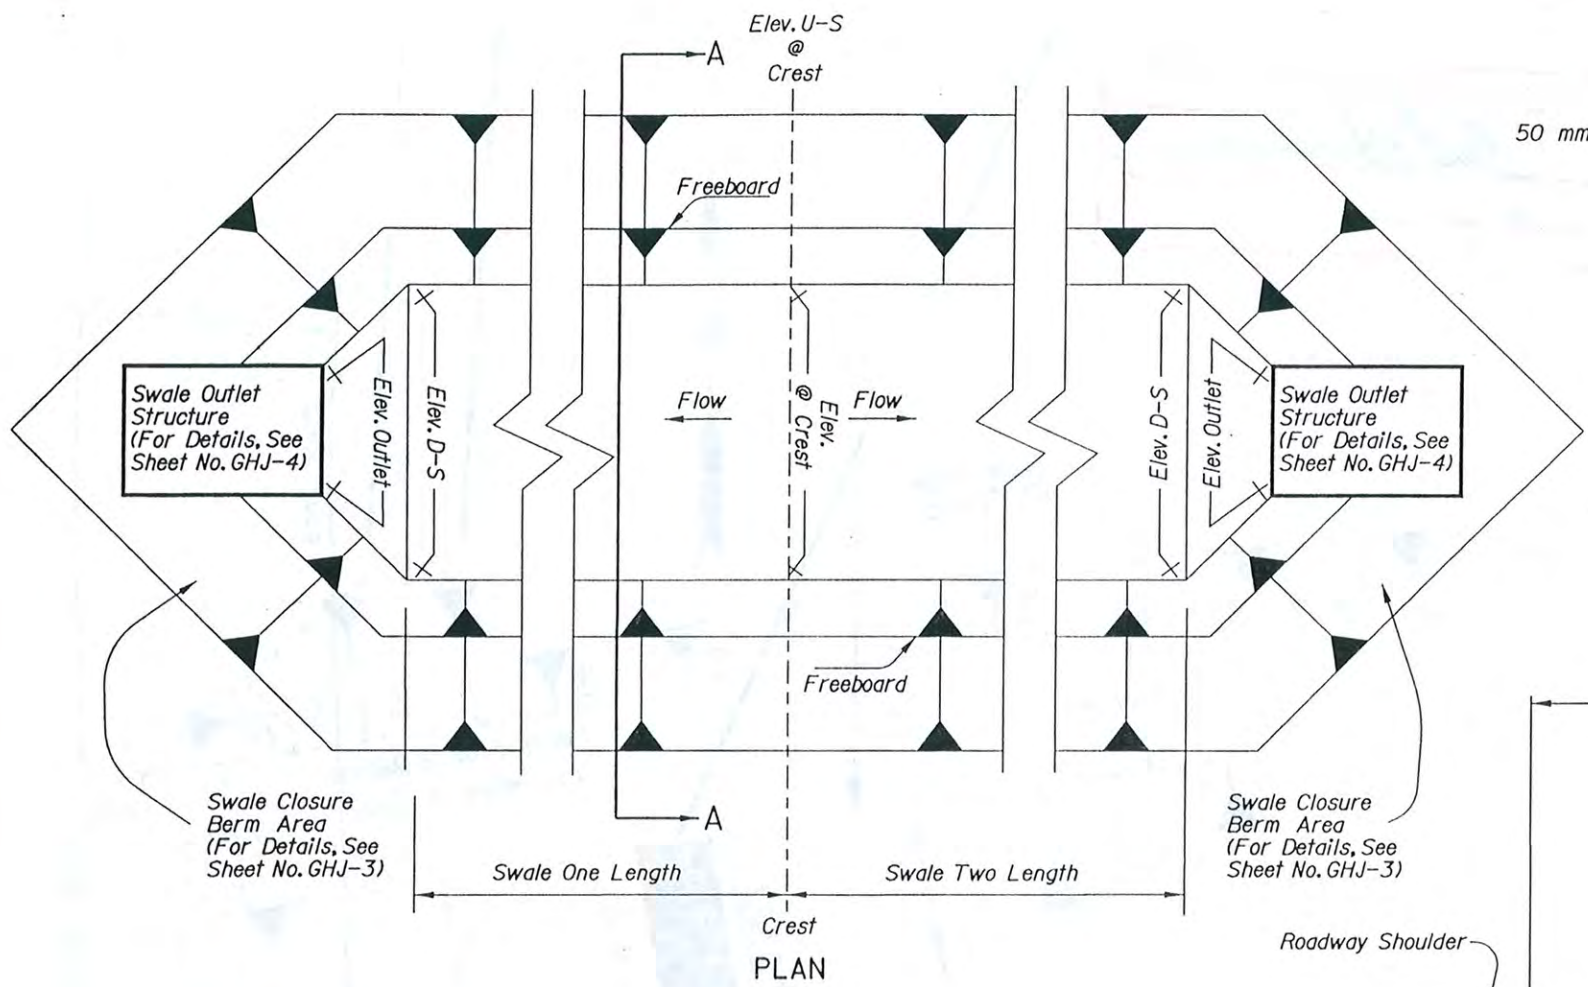

COMPONENTS

"AS CONSTRUCTED"
Bill Edmanson
 Project Manager
 NOV 18 '04
 Date

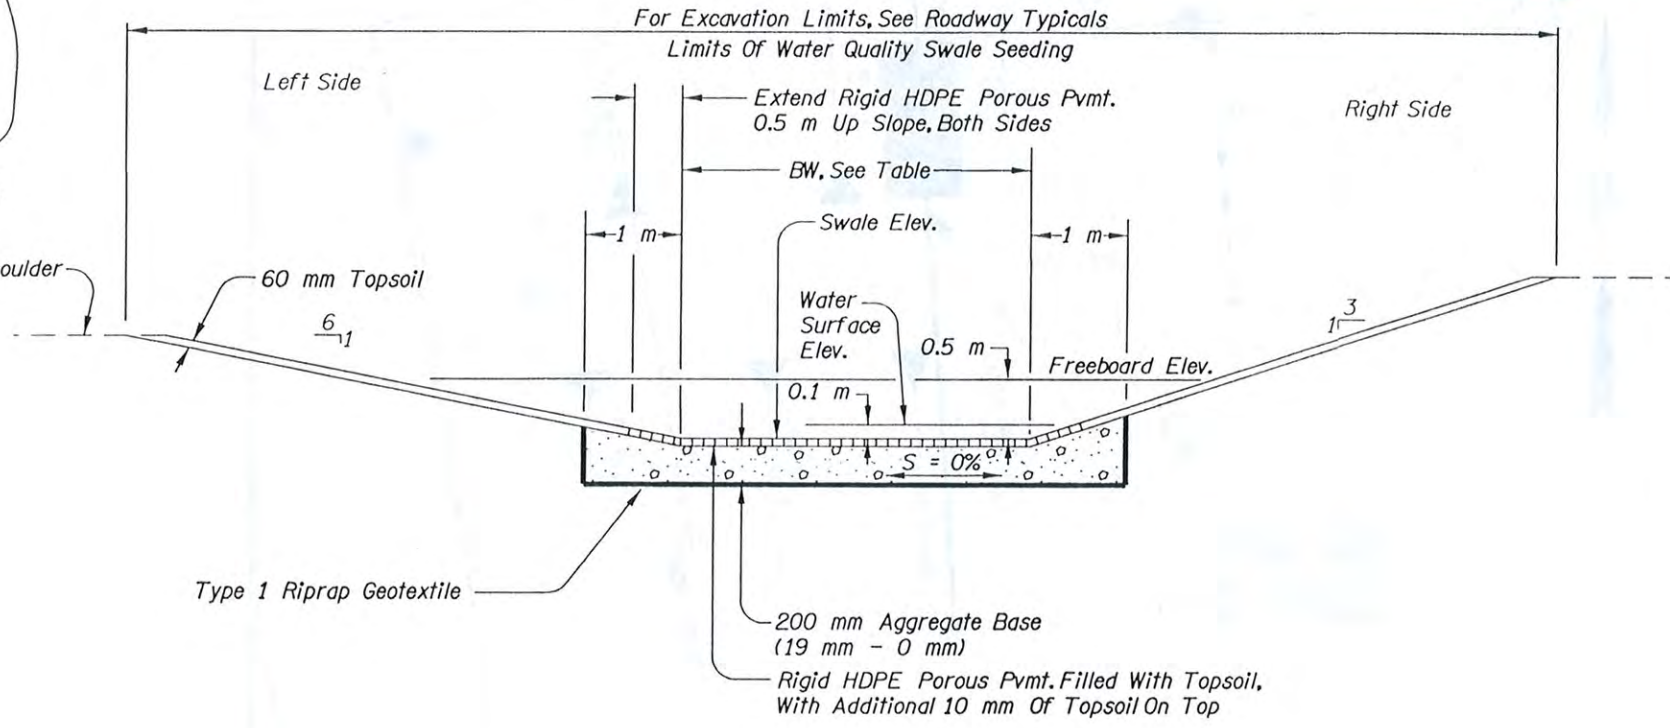


SECTION A-A

| Swale ID | Length | BW | Elev. U-S | Elev. D-S | Elev. Outlet | Side Slopes | |
|----------|--------|--------|-----------|-----------|--------------|-------------|------------|
| | | | | | | Left Side | Right Side |
| One | 57 m | 2.25 m | 70.869 m | 70.574 m | 70.490 m | 1:6 | 1:3 |
| Two | 66.8 m | 2.25 m | 70.869 m | 70.527 m | 70.444 m | 1:6 | 1:3 |

- Notes:
- 1) Aggregate Base: 19.0 mm - 0
 - 2) Bottom Of Aggregate Is Level In X-section And Extends 0.5 m Past Ends Of Rigid HDPE Porous Pvm.
 - 3) Swale Elevation Shown On Profile Is At Top Of Topsoil Above Rigid HDPE Porous Pvm.
 - 4) If Rock Is Encountered, Maintain Slopes And Soil Structure Up To Freeboard Elevation As Shown. Above Freeboard, Slopes May Assume Stable Slope For Rock Formation.

All Dimensions Are In Meters (m)
 Unless Otherwise Noted.

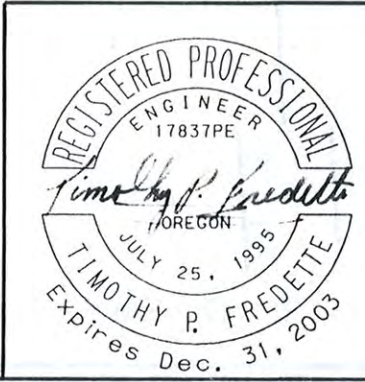

OREGON DEPARTMENT OF TRANSPORTATION
 GEO / HYDRO SECTION

**BEAVERTON/TUALATIN & TIGARD HWY.
 AT SCHOLLS (BEAVERTON) SECS.**
 BEAVERTON/TUALATIN & SCHOLLS HWYS. &
 BEAVERTON - TIGARD HWY.
 WASHINGTON COUNTY


Project Leader - Sandy R. VanBemmel
 Designed By - Timothy P. Fredette
 Drafted By - Martin C. Casillas

WATER QUALITY DETAILS


SHEET NO. GHJ-2

18-JUL-2003 10:05 C:\usr\Projects\3107\Scholls\0610\Scholls\WQ\0610\01.wqd

"AS CONSTRUCTED"
Bill Edmunson
 Project Manager
 NOV 18 '04
 Date

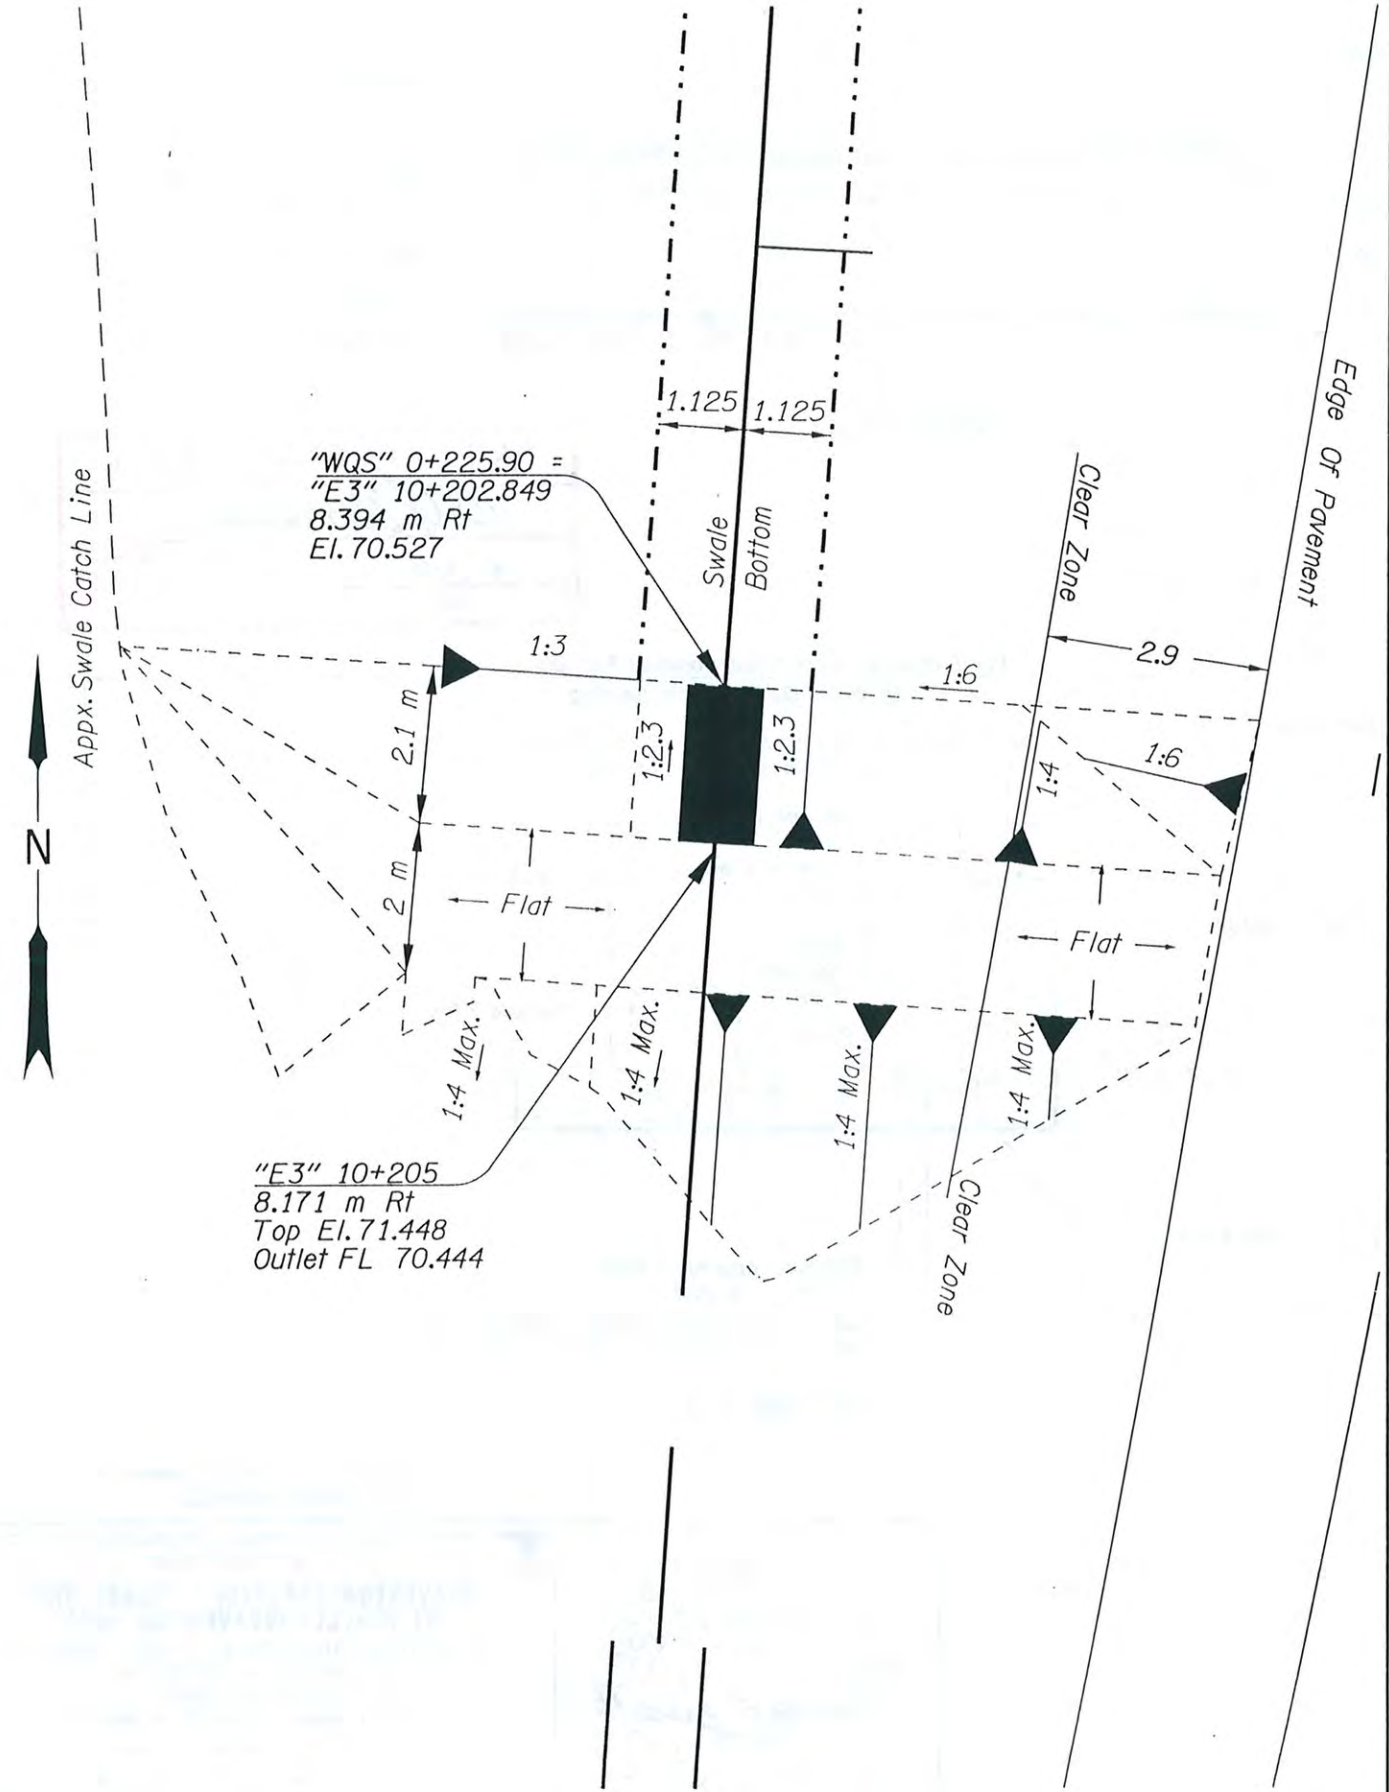

CLOSURE BERM FOR SWALE "TWO"

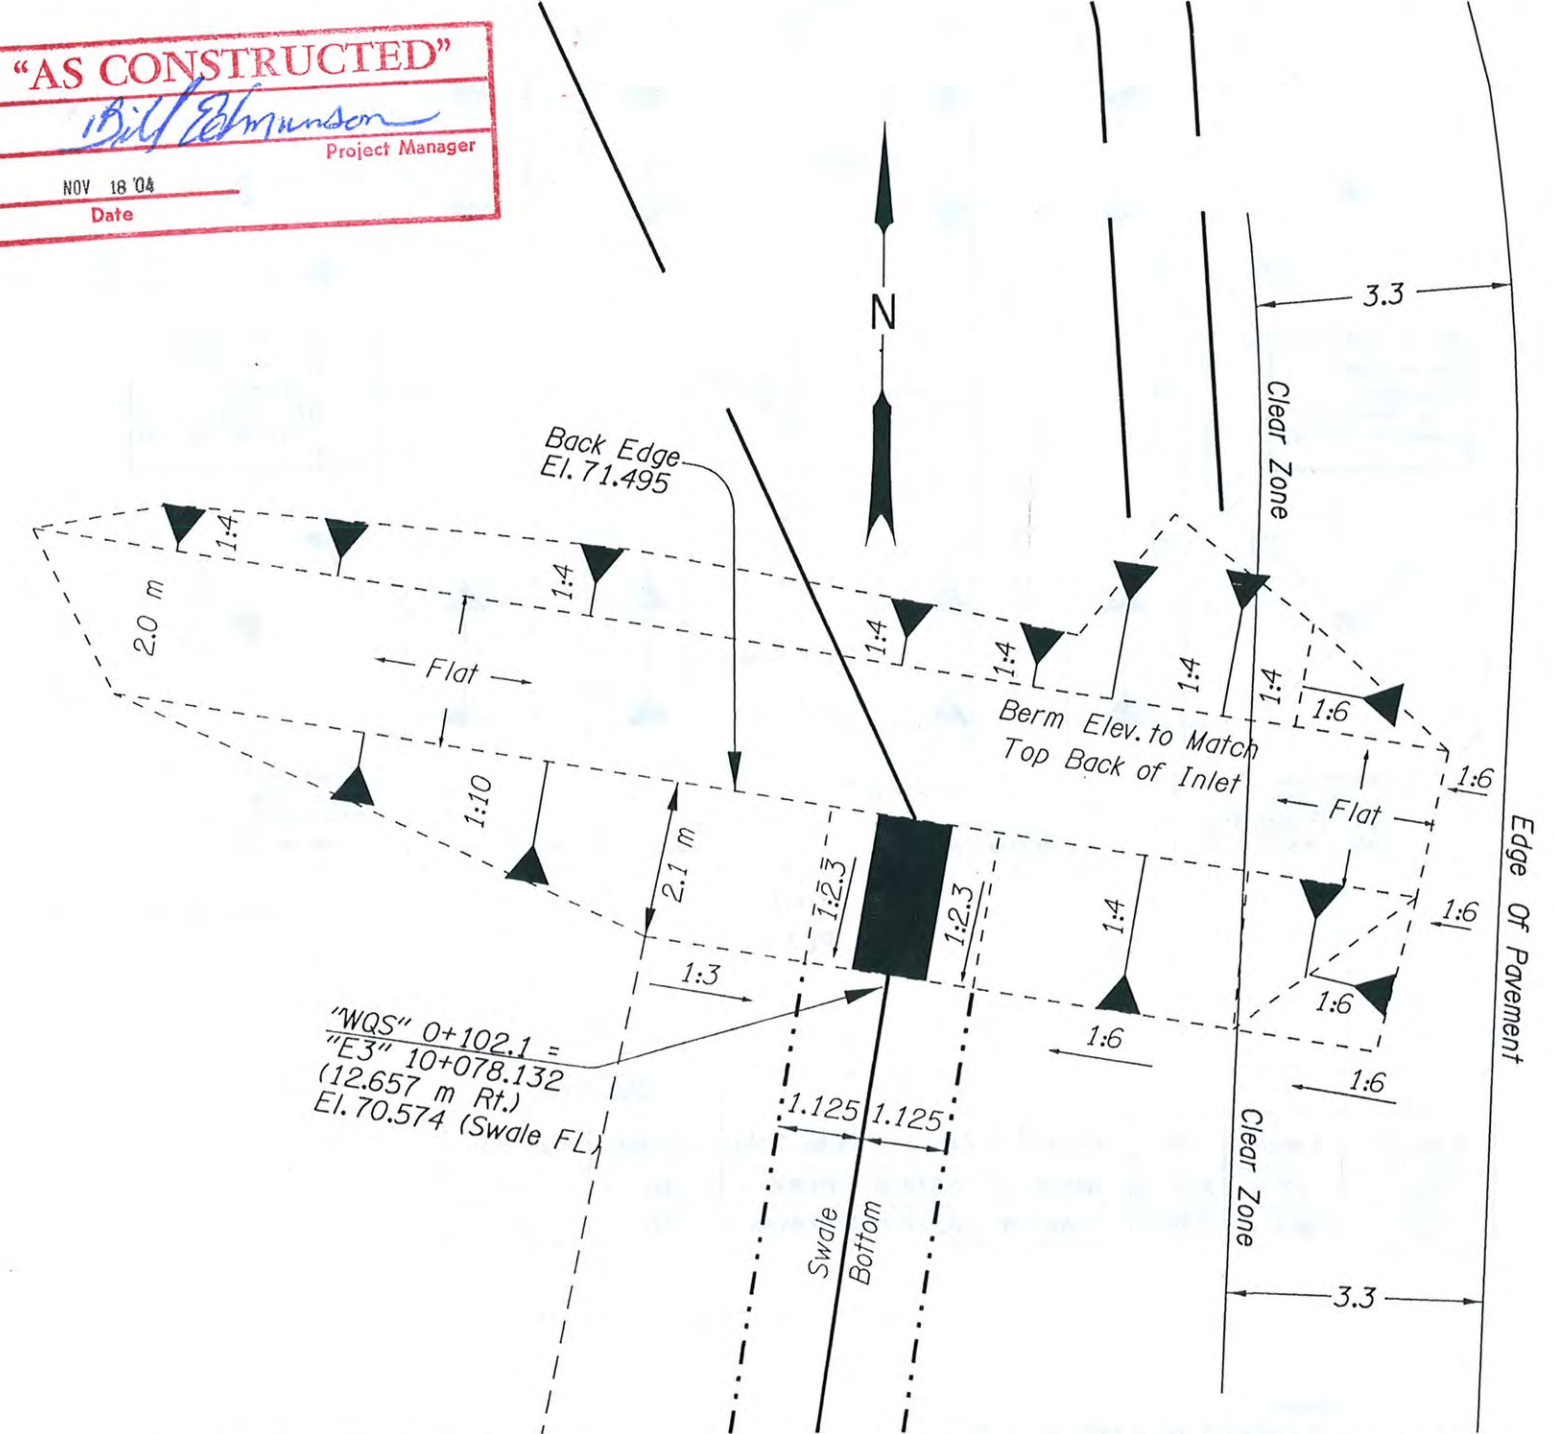

CLOSURE BERM FOR SWALE "ONE"

All Dimensions Are In Meters (m) Unless Otherwise Noted.

C:\usr\Pro\feats\13\17\Scholl\10\010\Scholl\10\06\010\wqz.dtl 16-JUL-2003 10:08



OREGON DEPARTMENT OF TRANSPORTATION
 GEO / HYDRO SECTION


BEAVERTON/TUALATIN & TIGARD HWY. AT SCHOLLS (BEAVERTON) SECS.
 BEAVERTON/TUALATIN & SCHOLLS HWYS. & BEAVERTON - TIGARD HWY. WASHINGTON COUNTY

Project Leader - Sandy R. VanBommel
 Designed By - Timothy P. Fredette
 Drafted By - Martin G. Casillas

WATER QUALITY DETAILS


SHEET NO. GHJ-3

"AS CONSTRUCTED"
Bill Johnson
 Project Manager
 NOV 18 '04
 Date

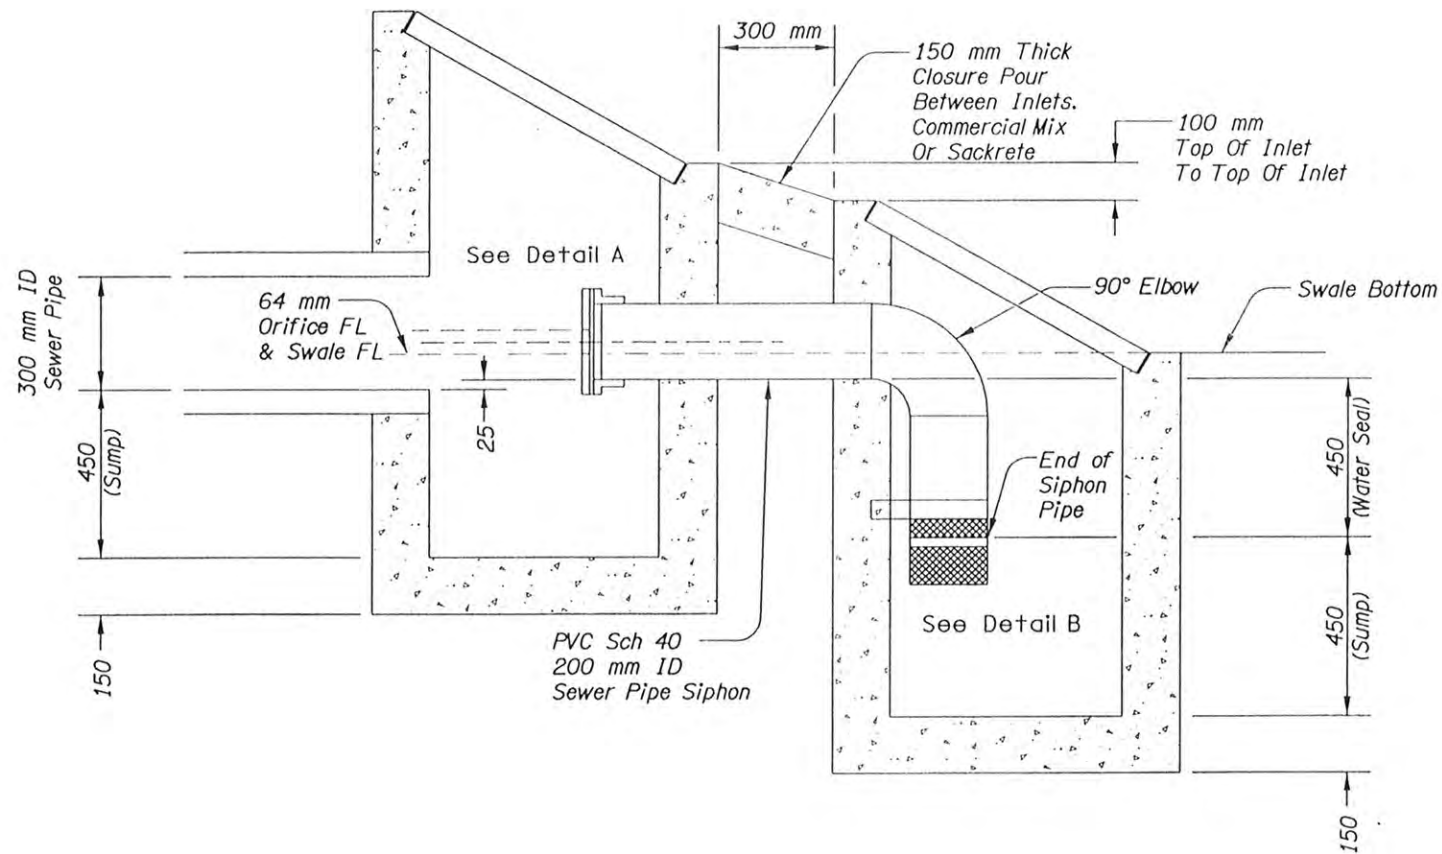


(For Details Not Shown, See Drawing No. RD336)

**SWALE OUTLET STRUCTURES
TYPE "D" SPECIAL INLETS**

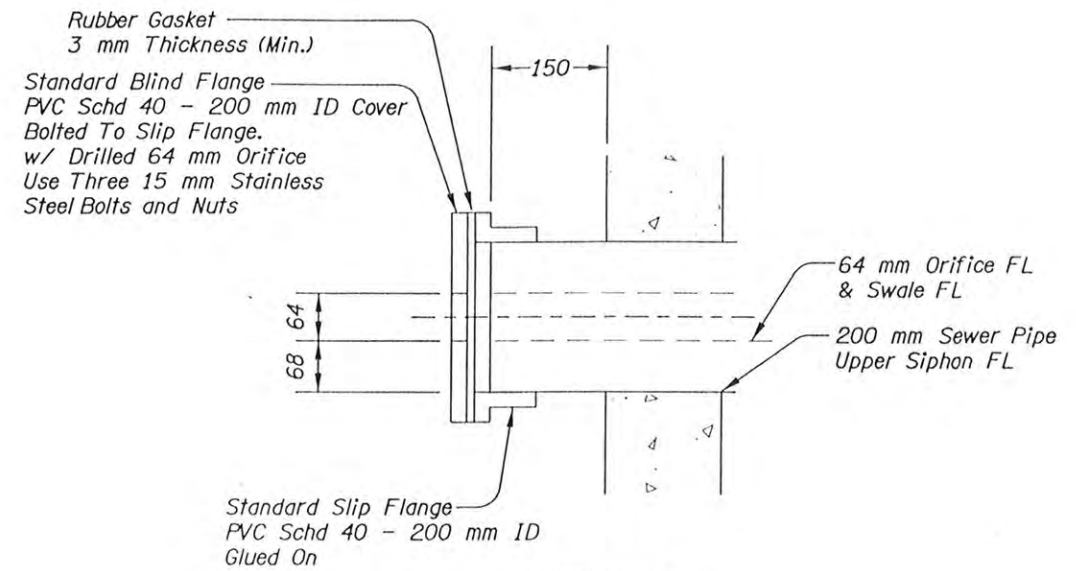

DETAIL A

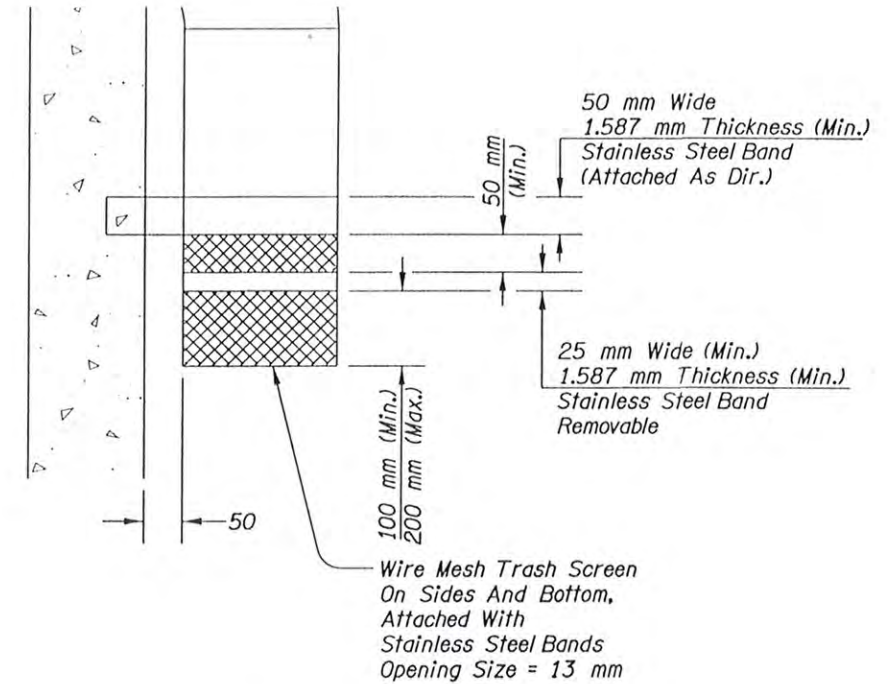

DETAIL B

All Dimensions Are In Millimeters (mm)
Unless Otherwise Noted.

| | |
|------------------------------|--|
| | OREGON DEPARTMENT OF TRANSPORTATION GEO / HYDRO SECTION |
| | BEAVERTON/TUALATIN & TIGARD HWY. AT SCHOLLS (BEAVERTON) SECS. BEAVERTON/TUALATIN & SCHOLLS HWYS. & BEAVERTON - TIGARD HWY. WASHINGTON COUNTY |
| | Project Leader - Sandy R. VanBommel Designed By - Timothy P. Fredette Drafted By - Martin G. Casillas |
| WATER QUALITY DETAILS | |
| SHEET NO. GHJ-4 | |