

OPERATION & MAINTENANCE MANUAL

DFI No. : D00125

**Facility Type: Detention Pond/Water
Quality Biofiltration Swale Combo**



June, 2011

INDEX

1. IDENTIFICATION..... 1

2. FACILITY CONTACT INFORMATION..... 1

3. CONSTRUCTION..... 1

4. STORM DRAIN SYSTEM AND FACILITY OVERVIEW 2

5. FACILITY HAZ MAT SPILL FEATURE(S)..... 6

6. AUXILIARY OUTLET (HIGH FLOW BYPASS)..... 6

7. MAINTENANCE REQUIREMENTS..... 6

8. WASTE MATERIAL HANDLING..... 7

APPENDIX A: Operational Plan and Profile Drawing(s)

APPENDIX B: ODOT Project Plan Sheets

1. Identification

Drainage Facility ID (DFI): **D00125**
Facility Type: Detention Pond/Water Quality Biofiltration Swale Combo
Construction Drawings: (V-File Number) 40V-057
Location: District: 2B (Old 2A)
Highway No.: 029
Mile Post: 16.18; 16.22 (beg./end)
Description: This facility is located west of the intersection of Tualatin Valley Hwy 29 (OR-8) and N. 20th Ave in Cornelius, Oregon. Facility entry is obtained from an access road, running north-south between the N. Adair and E. Baseline Streets.

2. Facility Contact Information

Contact the Engineer of Record, Region Technical Center, or Geo-Environmental's Senior Hydraulics Engineer for:

- Operational clarification
- Maintenance clarification
- Repair or restoration assistance

Engineering Contacts:

Region Technical Center Hydro Unit Manager

Or

Geo-Environmental Senior Hydraulics Engineer (503) 986-3365.

3. Construction

Engineer of Record: Consultant Designer – Otak, Pamela Wiedemann,
(360)-737-9613
Facility construction: 2006
Contractor: N/A

4. Storm Drain System and Facility Overview

A detention pond/water quality biofiltration swale combo (referred to from this point forward as a pond/swale combo) combines the forms and functions of a water quality swale and a detention pond. In a pond/swale combo, the biofiltration swale is situated within the bottom confines of the detention facility. The facility provides water quality treatment of the smaller storm events and detention of the larger storm events.

The biofiltration swale is designed as if it was a separate facility and consists of a grassy-lined facility with a flat trapezoidal cross section and gradual slope. Treatment is provided through sedimentation and filtration processes. If amended soils are present, additional treatment is obtained through infiltration through the amended soil media.

When the flows exceed the water quality flows, the pond/swale combo facility begins to provide detention. Detention is required to reduce or mitigate the increases in discharge, resulting from development. The facility is designed to store and gradually release (or attenuate) stormwater runoff via a control structure or release mechanism, then releasing it slowly over a more extended period of time. The flow control mechanism for this facility involves a 4-inch orifice surrounded by a wirecloth strainer assembly. When flows exceed the water quality design flow, the orifice restricts the flow causing the water to backup within the facility.

This facility contains a water quality biofiltration swale (Photo 1, Point C in the Operational Plan in Appendix A) that lies adjacent to and feeds a detention pond (Point B, Photo 1). It is located just west of the 20th Avenue and Hwy 29 (East Baseline Street, OR-8) intersection. Access is obtained from Baseline Street (Hwy 29) or Adair Street (Hwy 29) through an access road (Photo 4).

The swale (Photo 2) is approximately 100-feet long with a bottom width of 2-feet. The detention pond is also 100-feet in length. Water flows into the swale from a series of inlets along Adair Street (Hwy 29) into a sediment trap and headwall structure (Point D, Photo 3). The facility also receives sheet flow from both Baseline and Adair Street. After treatment through the swale, water flows enters the detention pond (Photo 4). The water then flows through the 24-inch detention pond outlet (Point F) and continues into a nearby stormwater piping system.

A. Maintenance equipment access:

The facility is located in between two branches of Highway 29 at the start of the City of Cornelius's one-way grid system (east side); namely the North Adair and the East Baseline Street segments. Access is obtained

through a maintenance access road west of the swale from Adair Street (Hwy 29) or E. Baseline Street (Hwy 29). There are removable bollards at each end of the access road that allows vehicle access.

B. Heavy equipment access into facility:

- Allowed (no limitations)
- Allowed (with limitations)
- Not allowed

C. Special Features:

- Amended Soils
- Porous Pavers
- Liners
- Underdrains



Photo 1: Detention Pond/ WQ Swale Combo Looking East



Photo 2: Swale Bottom Looking East



Photo 3: Swale Inlet Looking West



Photo 4: Detention Pond Looking East



Photo 4: Maintenance Access Road Looking South

5. Facility Haz Mat Spill Feature(s)

This detention pond/ water quality biofiltration swale combo can be used to store a volume of liquid by blocking the 24-inch diameter outlet pipe located at the outlet of the detention pond (Photo 4). This pipe is noted as point F in the operational plan in appendix A

6. Auxiliary Outlet (High Flow Bypass)

Auxiliary Outlets are provided if the primary outlet control structure can not safely pass the projected high flows. Broad-crested spillway weirs and over flow risers are the two most common auxiliary outlets used in stormwater treatment facility design. The auxiliary outlet feature is either a part of the facility or an additional storm drain feature/structure.

The auxiliary outlet feature for this facility is:

Designed into facility

There is a flow control manhole (Point G, Operational Plans, Appendix A) that is located just south of the 24-inch outlet to the detention pond. In the event of high flows, the water would overtop the high flow riser and flow to the southeast out of the 24-inch outlet pipe into the stormwater system.

Other, as noted below

7. Maintenance Requirements

Routine maintenance table for non-proprietary stormwater treatment and storage/detention facilities have been incorporated into ODOT's Maintenance Guide. These tables summarize the maintenance requirements for ponds, swales, filter strips, bioslopes, and detention tanks and vaults. Special maintenance requirements in addition to the routine requirements are noted below when applicable.

The ODOT Maintenance Guide can be viewed at the following website:

<http://www.oregon.gov/ODOT/HWY/OOM/MGuide.shtml>

Maintenance requirements for proprietary structures, such as underground water quality manholes and/or vaults with filter media are noted in Appendix C when applicable.

The following stormwater facility maintenance table (See ODOT Maintenance Guide) should be used to maintain the facility outlined in this Operation and Maintenance Manual or follow the Maintenance

requirements outlined in Appendix C when proprietary structure is selected below:

Mark as Required and always include Table 1:

- Table 1 (general maintenance)
- Table 2 (stormwater ponds)
- Table 3 (water quality biofiltration swales)
- Table 4 (water quality filter strips)
- Table 5 (water quality bioslopes)
- Table 6 (detention tank)
- Table 7 (detention vault)
- Appendix C (proprietary structure)
- Special Maintenance requirements:

Note: Special maintenance Requirements Require Concurrence from ODOT SR Hydraulics Engineer.

8. Waste Material Handling

Material removed from the facility is defined as waste by DEQ. Refer to the roadwaste section of the ODOT Maintenance Yard Environmental Management System (EMS) Policy and Procedures Manual for disposal options: <http://egov.oregon.gov/ODOT/HWY/OOM/EMS.shtml>


Contact any of the following for more detailed information about management of waste materials found on site:

ODOT Clean Water Unit	(503) 986-3008
ODOT Statewide Hazmat Coordinator	(503) 229-5129
ODOT Region Hazmat Coordinator	(503) 731-8304
ODEQ Northwest Region Office	(503) 229-5263

Appendix A


Content:

- **Operational Plan and Profile Drawing(s)**

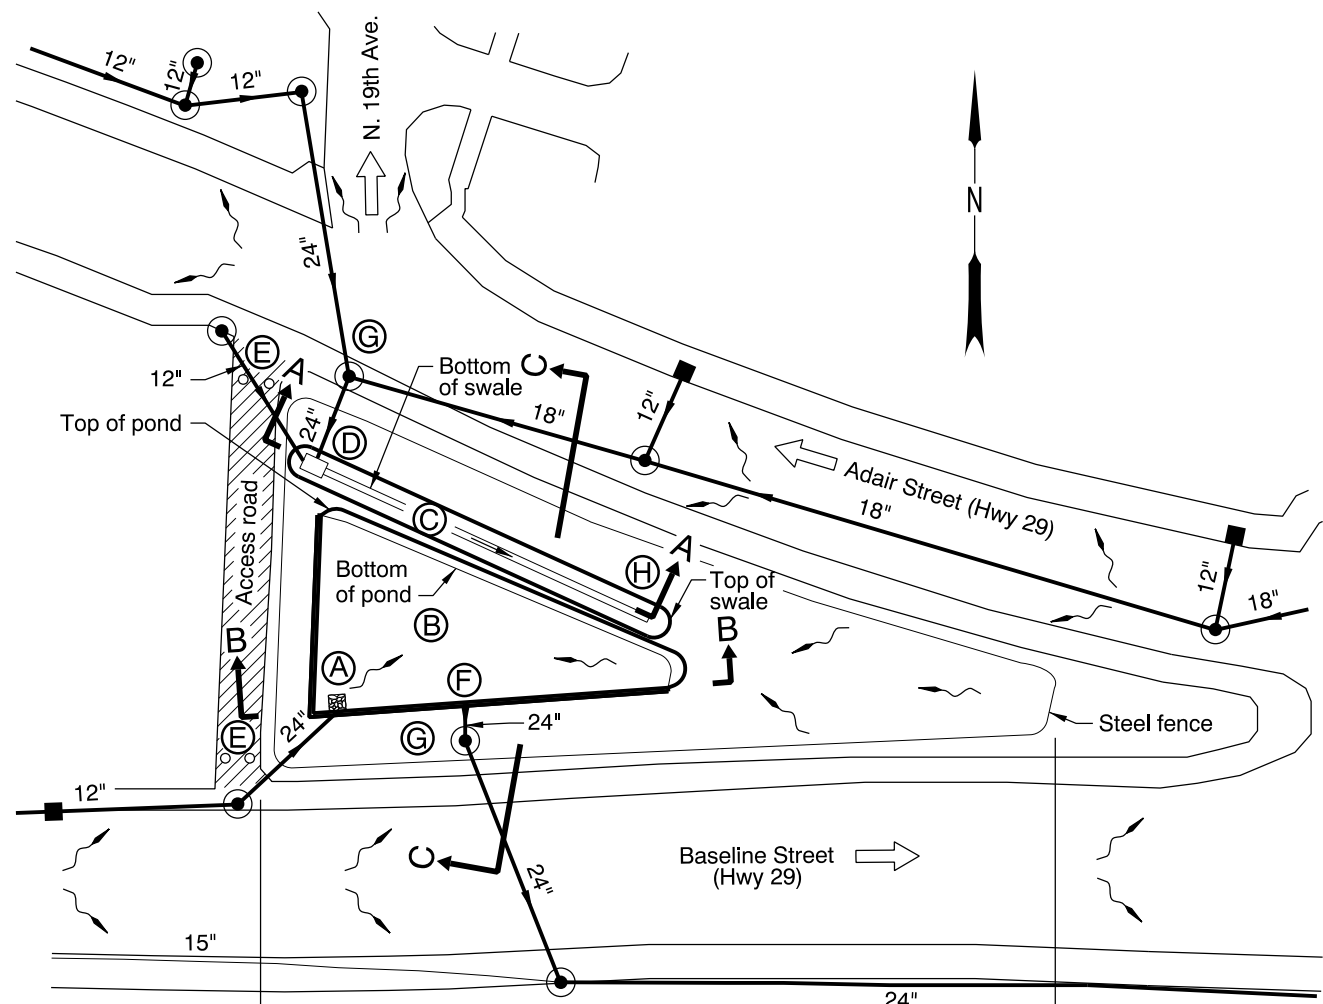


Detention Pond/Water Quality Biofiltration Swale Combo (DFI D00125) ±100 ft

PLAN
N.T.S.

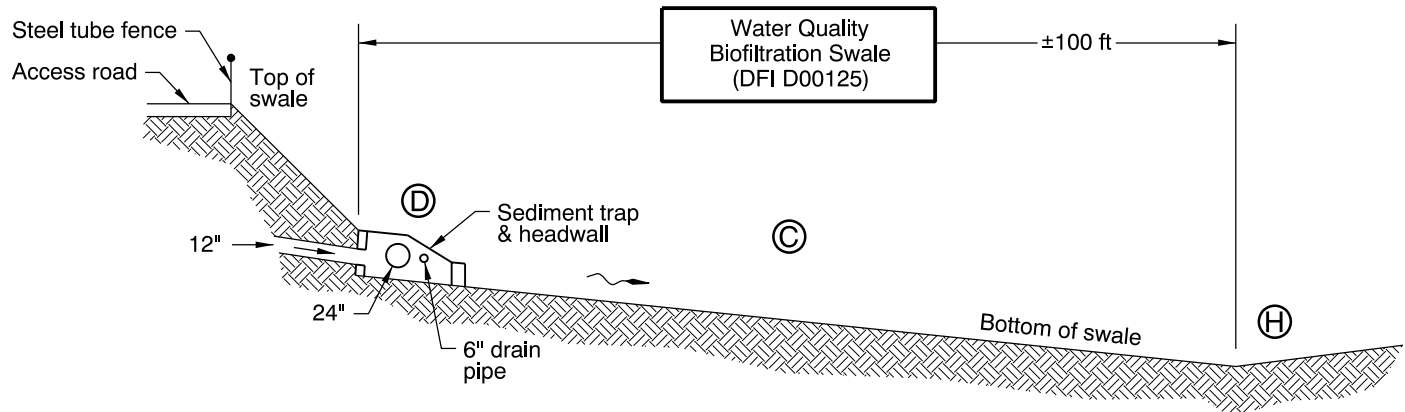


SECTION A-A
N.T.S.

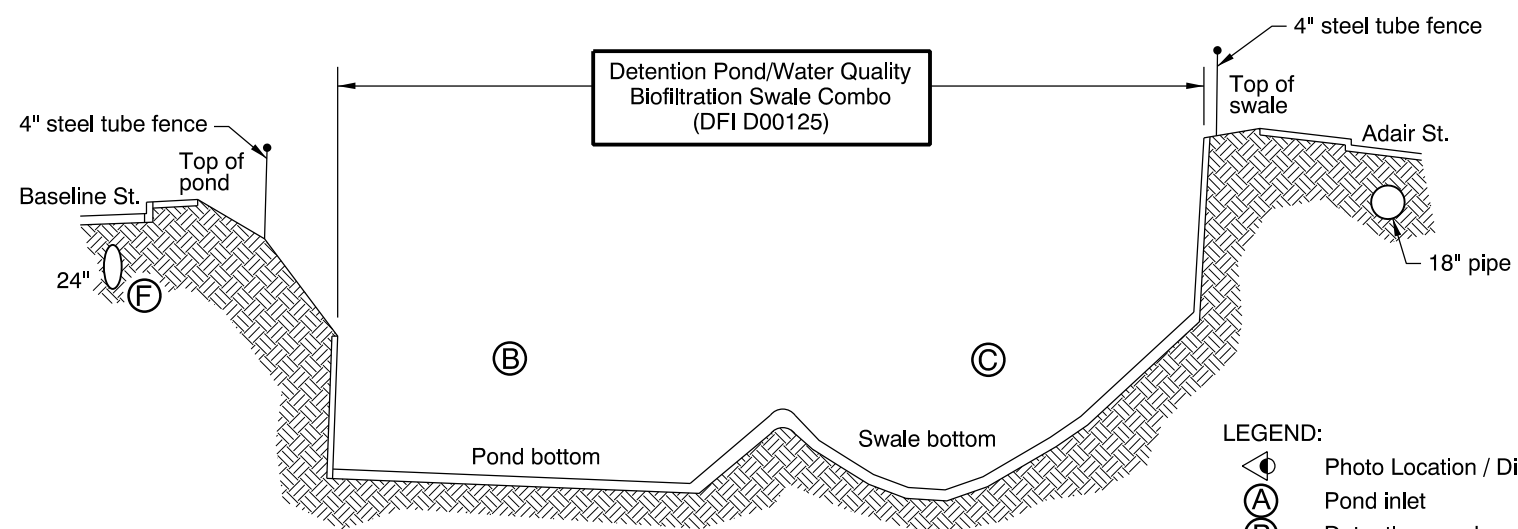

SECTION C-C
N.T.S.

- LEGEND:**
- Photo Location / Direction
 - Pond inlet
 - Detention pond
 - Swale
 - Swale inlet
 - Removeable bollards
 - Pond outlet
 - Flow control manhole
 - Swale outlet
 - Access
 - Manhole
 - Inlet
 - Traffic direction / Flow
 - Storm Pipe (Facility)
 - Storm Pipe
 - Conveyance Direction
 - Pavement / Facility Flow Path

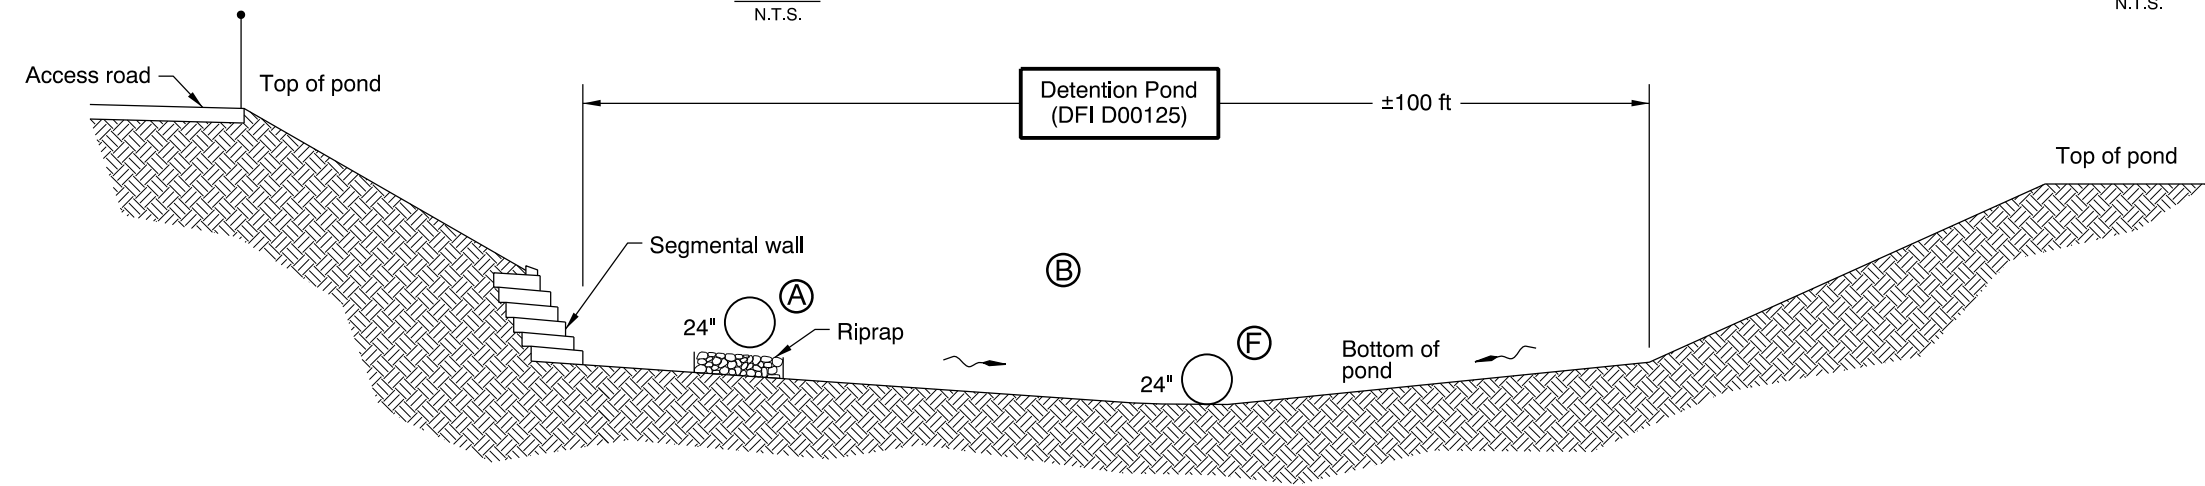


SECTION B-B
N.T.S.

Sheet 1 of 2


OREGON DEPARTMENT OF TRANSPORTATION

Prepared By: Craig Fox
 Drafted By: Y. Garzenelli

DFI D00125
MAINTENANCE DISTRICT 2B HWY 29
DETENTION POND/WQ SWALE
 TUALATIN VALLEY MP 16.18-16.22
 WASHINGTON COUNTY

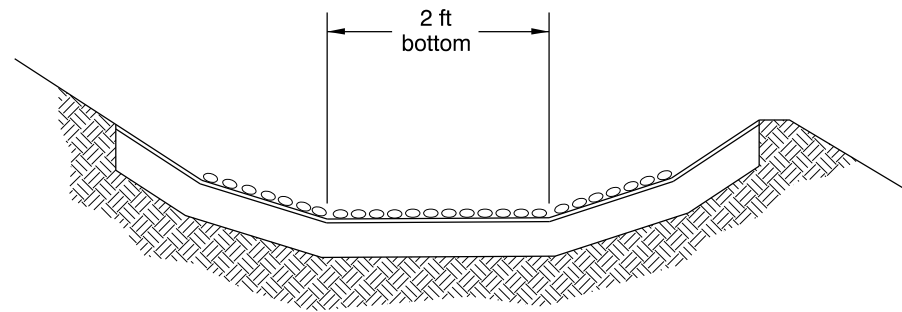

VEGETATED SWALE
N.T.S.

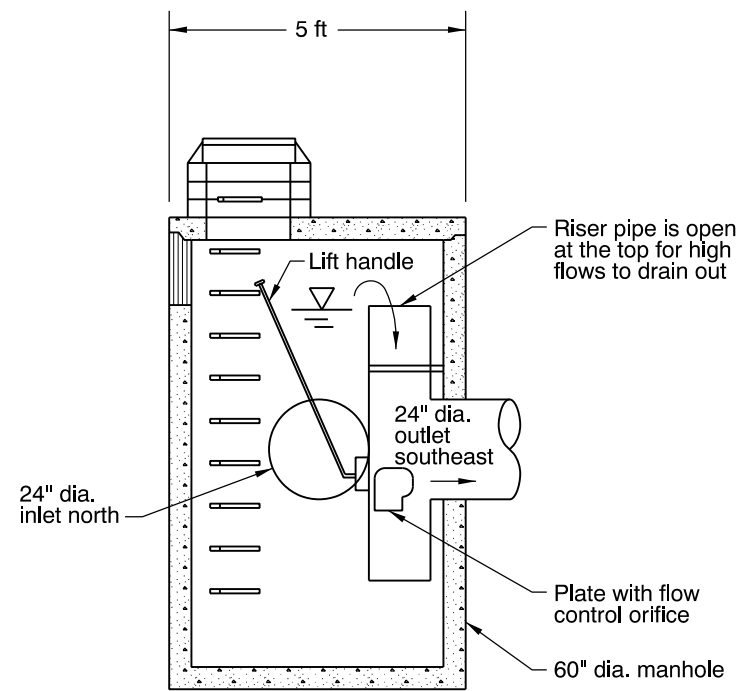

FLOW CONTROL MANHOLE DETAIL AT POINT ©
N.T.S.

Sheet 2 of 2

 OREGON DEPARTMENT OF TRANSPORTATION

Prepared By: Craig Fox

Drafted By: Y. Garzenelli

DFI D00125
MAINTENANCE DISTRICT 2B HWY 29
DETENTION POND/WQ SWALE
TUALATIN VALLEY MP 16.18-16.22
WASHINGTON COUNTY


Appendix B

Content:

- **ODOT Project Plan Sheets**
 - *Cover/Title Sheet*
 - *Water Quality/Detention Plan Sheets*
 - *Other Details*


WASHINGTON COUNTY
DEPARTMENT OF LAND USE AND TRANSPORTATION

PLANS FOR PROPOSED PROJECT

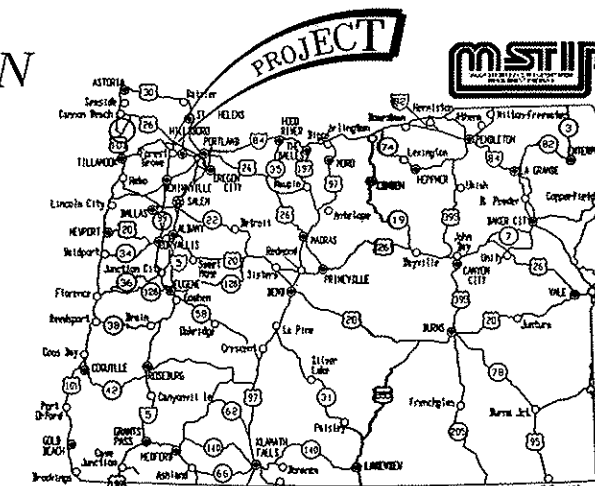

PROJECT NUMBER
100017

WASHINGTON COUNTY
DEPARTMENT OF
LAND USE AND
TRANSPORTATION

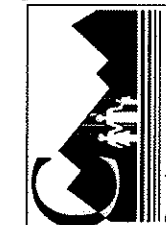


GENERAL INDEX OF SHEETS

SHEET NO.	SHEET TITLE	DESCRIPTION
1-6	1, 1A, 1A-2, 1B, 1C, 1D	COVER, INDEX, LEGEND, SHY. LAYOUT, STR. TABLE
7-11	2, 2A, 2A-2, 2A-3, 2A-4	TYPICAL SECTIONS
DETAILS		
12-15	2B THRU 2B-4	ROADWAY DETAILS
16	2B-5	MISC. DETAILS
17-19	2B-6 THRU 2B-8	DRAINAGE DETAILS
20	2B-9	WATER AND SANITARY DETAILS
21-23	2B-10 THRU 2B-12	SANITARY DETAILS
24-26	2B-13 THRU 2B-15	JWC WATERLINE DETAILS
27	2B-16	W.O. SWALE AND DETENTION POND CONSTRUCTION
28-29	2B-17, 2B-18	W.O. SWALE AND DETENTION POND DETAILS
30-32	2B-19 THRU 2B-21	DRIVEWAY DETAILS
33	2B-22	DRIVEWAY, SIDEWALK, MEDIAN DETAILS
34	2B-23	MEDIAN DETAILS
35	2B-24	INTERSECTION DETAIL
36-37	2B-25, 2B-26	POTHOLE INFO DETAILS
38-51	2C THRU 2C-14	TRAFFIC CONTROL PLAN AND DETAILS
52-53	2D THRU 2D-2	EROSION CONTROL DETAILS
54	2D-3	EROSION CONTROL NOTES AND LEGEND
55-58	2D-4 THRU 2D-7	EROSION CONTROL PLANS
59-60	2E, 2E-2	PIPE DATA SHEET
61-62	2F, 2F-2	SURVEY CONTROL
CONSTRUCTION PLANS		
63-85	3 THRU 13	CONSTRUCTION NOTES
84-86	3A THRU 13A	CONSTRUCTION PLANS AND PROFILES
87	14	11TH AVE. RR CROSSING CLOSURE PLAN
ROADSIDE DEVELOPMENT		
88-89	R1, R2	PLANTING DETAILS
90	R3	W.O. SWALE AND DETENTION POND PLANTING PLAN
91-92	R4, R5	PLANTING SCHEDULE
93-96	R6 THRU R9	PLANTING PLANS
97-99	R10 THRU R12	IRRIGATION DETAILS
100-103	R13 THRU R16	IRRIGATION PLANS
TRAFFIC ILLUMINATION/INTERCONNECTION		
104-107	1-1 THRU 1-14	ILLUMINATION AND INTERCONNECTION PLANS
TRAFFIC SIGNING/STRIPING		
108-111	1-51 THRU 1-54	SIGNING AND STRIPING PLANS
112	1-55	STRIPING DETAILS
113-114	1-56, 1-57	SIGNING LEGEND
115	1-58	SIGN AND POST DATA TABLE
TRAFFIC SIGNALIZATION		
116	1-11	LEGEND AND PHASING DIAGRAM
117	1-12	S 20TH AVE & BASELINE ST SIGNAL PLAN
118	1-13	S 20TH AVE & BASELINE ST DETECTOR PLAN
119	1-14	N 19TH AVE & ADAIR ST SIGNAL REMOVAL PLAN
120	1-15	RAILROAD PREEMPTION PLAN
121	1-16	POLE ENTRANCE CHART & ORIENTATION DETAIL
122	1-17	FRED MEYER ACCESS & TV HWY DETECTOR MODIFICATION PLAN
WATERLINE AND SANITARY SEWER		
123-139	U1 THRU U9	CONSTRUCTION NOTES
124-140	U1A THRU U9A	CONSTRUCTION PLANS AND PROFILES

GRADING, DRAINAGE, PAVING, SIGNALS, SIGNING
ILLUMINATION, ROADSIDE DEVELOPMENT, AND UTILITIES

N. 19TH AVENUE AND S. 20TH AVENUE
REALIGNMENT

TUALATIN VALLEY HWY (M.P. 15.94 + M.P. 16.13)
ALPINE STREET TO 500 FEET SOUTH
OF DAVIS STREET

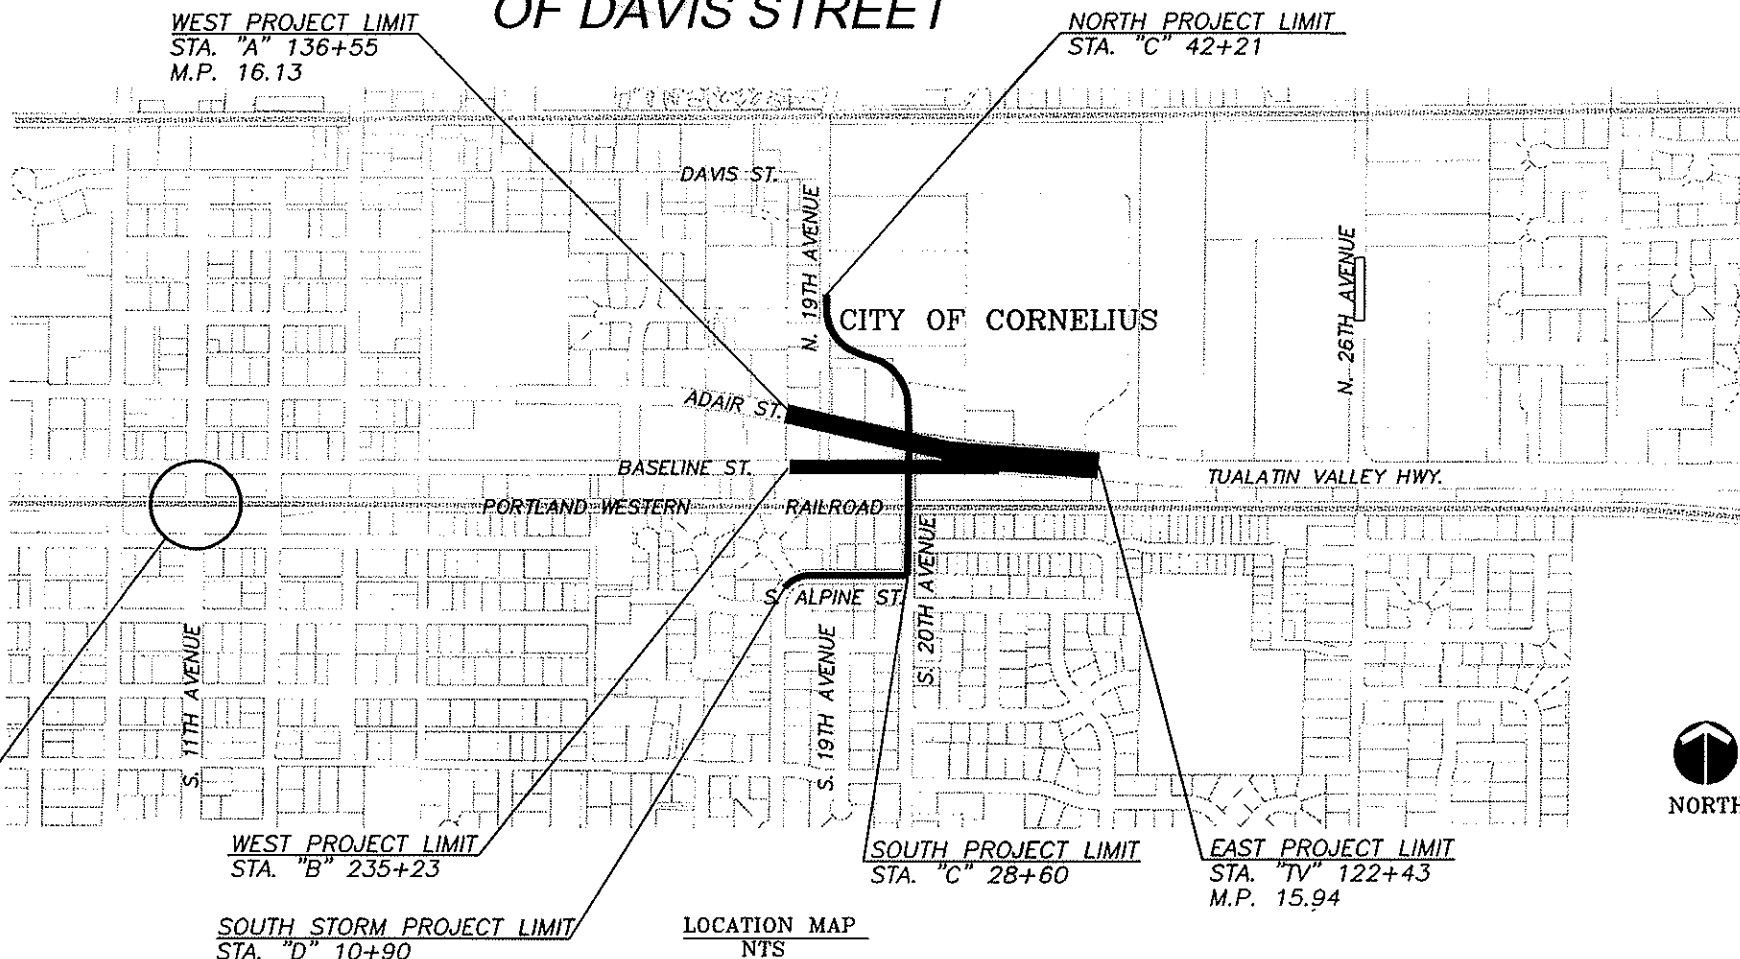

11TH AVE. RAILROAD
CROSSING CLOSURE



LOCATES
(48 HOUR NOTICE REQUIRED PRIOR TO EXCAVATION)

ONE CALL SYSTEM - 246-6699

THE CONTRACTOR, IN LOCATING AND PROTECTING
UNDERGROUND UTILITIES, MUST COMPLY WITH THE
REGULATIONS OF O.R.S. 757.541 TO 757.571

ATTENTION: Oregon law requires you to follow rules adopted by the
Oregon Utility Notification Center. Those rules are set forth in OAR
952-001-0010 through OAR 952-001-0090. You may obtain copies
of the rules by calling the center. (Note: the telephone number for
the Oregon Utility Notification Center is (503) 232-1987)


These As-built Plans were compiled from survey data, data
collected from others, and periodic observation during
construction. These plans are an accurate record of public
improvements to the best of my information, knowledge and
belief.

By: *Cam Wilson*
Date: 11-2-06

"As Constructed"
DATE 11/6/06 BY

otak
Incorporated
700 Washington Street
Suite 401
Vancouver, WA 98660-3139
Phone: (360) 737-9613
FAX: (360) 737-9651

BY	DATE
DRWN: GE/SC	7/05
DSGN: SW/JN	7/05
CHKD: PW	7/05

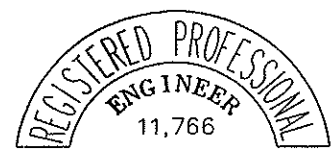

EXPIRES: 6/30/08

SHEET TITLE: 1 SHEET NO. OF 140

DWG: NO. REVISIONS

N. 19TH AND S. 20TH AVE REALIGNMENT
INCLUDING BASELINE ST, ADAIR ST, AND T.V. HWY
WASHINGTON COUNTY AND CITY OF CORNELIUS
TITLE SHEET

W.Q. SWALE AND DETENTION POND CONSTRUCTION

PROJECT NUMBER
100017



WASHINGTON COUNTY
DEPARTMENT OF
LAND USE AND
TRANSPORTATION



DWG:
NO. REVISIONS


"As Constructed"
DATE 11/16/06 BY [Signature]
N. 19TH AND S. 20TH AVE REALIGNMENT
INCLUDING BASELINE ST, ADAIR ST, AND T.V. HWY
WASHINGTON COUNTY AND CITY OF CORNELIUS
W.Q. SWALE AND DETENTION
POND CONSTRUCTION

BY	DATE
DRWN: JGN	7/05
DSGN: JGN	7/05
CHKD: PKW	7/05




EXPIRES: 6/30/08

SHEET TITLE: 2B-16 SHEET NO. 27 OF 140

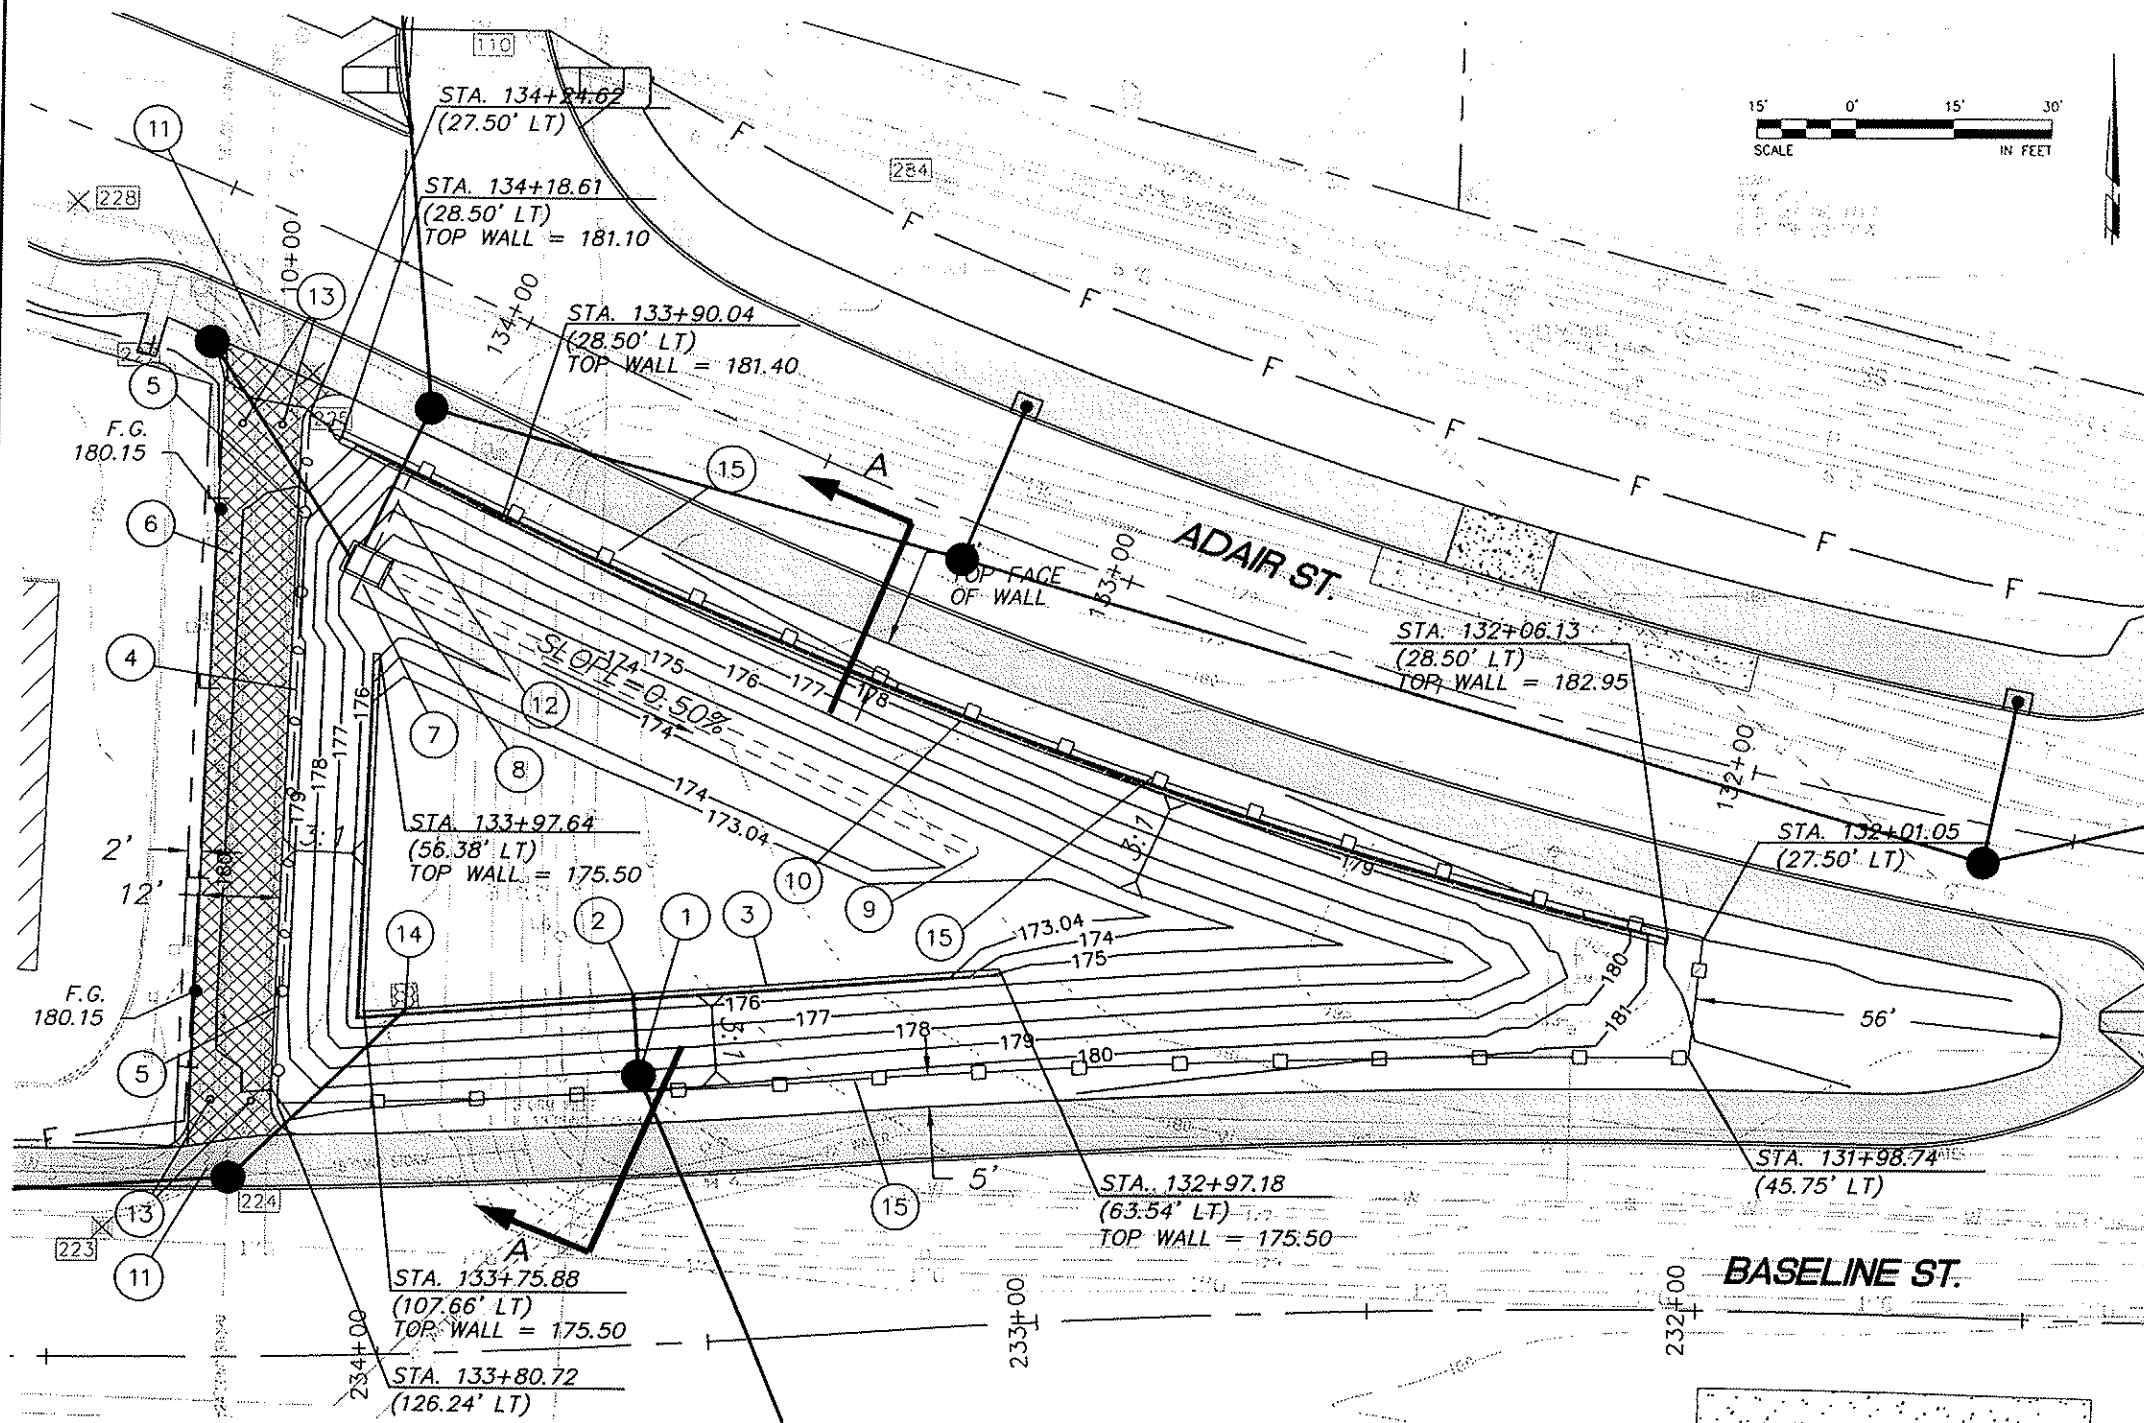

- 1 STA 133+37.92, 99.41' LT CONSTRUCT FLOW CONTROL STRUCTURE "A" (60" DIA. MANHOLE) FOR DETAILS SEE SHEET 2B-17.
- 2 24" DIA. POND OUTLET PIPE. INSTALL FLUSH WITH WALL (IE=173.04). CONVENTIONAL SEGMENTAL WALL SHALL INCLUDE PIPE HEADWALL PER MANUFACTURERS REQUIREMENTS.
- 3 CONSTRUCT CONVENTIONAL SEGMENTAL WALL A. EXPOSED WALL FACE HEIGHT 2.5'. TOP OF THE WALL ELEV. 175.50 SEE DETAIL SHEET 2B-18
- 4 INSTALL CL-4 CHAIN-LINK FENCE WITH BLACK VINYL CLAD FABRIC ALONG EAST SIDE OF POND ACCESS ROAD (85 LF TOTAL).
- 5 INSTALL 12' CHAIN-LINK ROLL GATE.
- 6 CONSTRUCT 12' WIDE ACCESS ROAD SEE SHEET 2B-18 FOR TYPICAL SECTION.
- 7 CONSTRUCT SEDIMENT TRAP AND HEADWALL PER DETAIL SHEET 2B-17.
- 8 STA 134+02.3, 44.7' LT BEGIN VEGETATED SWALE CONSTRUCTION (ELEV.=173.54). SEE SWALE SECTION DETAIL ON SHEET 2B-17.
- 9 STA 133+07.1, 47.8' LT END 100' SWALE CONSTRUCTION (ELEV.=173.04).
- 10 CONSTRUCT CONVENTIONAL SEGMENTAL WALL "B". EXPOSED WALL FACE HEIGHT 3.3'. SEE DETAIL SHEET 2B-18
- 11 12' LENGTH OF THICKENED (6") CONCRETE SIDEWALK SECTION AND MOUNTABLE CURB. CENTER ON POND ACCESS ROAD.
- 12 CONNECT 6" DIA. WALL DRAIN TO HEADWALL. SEE SEDIMENT TRAP AND HEADWALL DETAIL, SHEET 2B-17
- 13 INSTALL REMOVABLE BOLLARDS PER DETAIL ON SHEET 2B-18. SPACE 6' O.C. AT EACH END OF POND ACCESS ROAD.
- 14 24" DIA. POND INLET PIPE. INSTALL FLUSH WITH WALL (IE=173.04). CONSTRUCT RIPRAP BASIN 4'X4'X1' LIGHT LOOSE RIPRAP CLASS 50 PER DETAIL ON SHEET 2B-17. CONVENTIONAL SEGMENTAL WALL SHALL INCLUDE PIPE HEADWALL PER MANUFACTURERS REQUIREMENTS.
- 15 INSTALL 4' HEIGHT BLACK STEEL TUBE FENCE PER DETAIL SHEET 2B-18 (465 LF TOTAL)
- 16 SEE SHEET R3 FOR PLANTING PLAN


- LEGEND:**
- 176 --- EXISTING CONTOUR
 - 170 --- PROPOSED CONTOUR
 - o-o- 4' CHAIN-LINK FENCE, BLACK VINYL CLAD
 - 4' BLACK STEEL TUBE FENCE
 - CONVENTIONAL SEGMENTAL
 - OUTFALL PROTECTION
 - F.G. FINISH GRADE

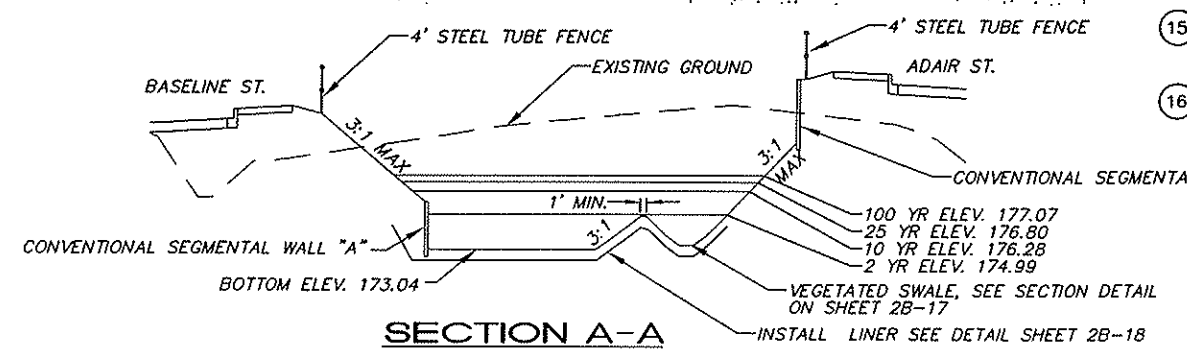






W.Q. SWALE AND DETENTION POND DETAILS

NOTES:

1. FINISHED GRADES TRANSITIONING TO SWALE SIDE SLOPES SHALL BE 2.5H:1V MAXIMUM UNLESS RETAINING WALLS OR OTHER SOIL PROTECTION/STABILIZATION METHODS ARE PROVIDED AS SHOWN ON PLAN.
2. GRASS SEED OR PLANT COVER AT SWALES SHALL BE PER LANDSCAPE PLANS, DETAILS, AND/OR SPECIFICATIONS.

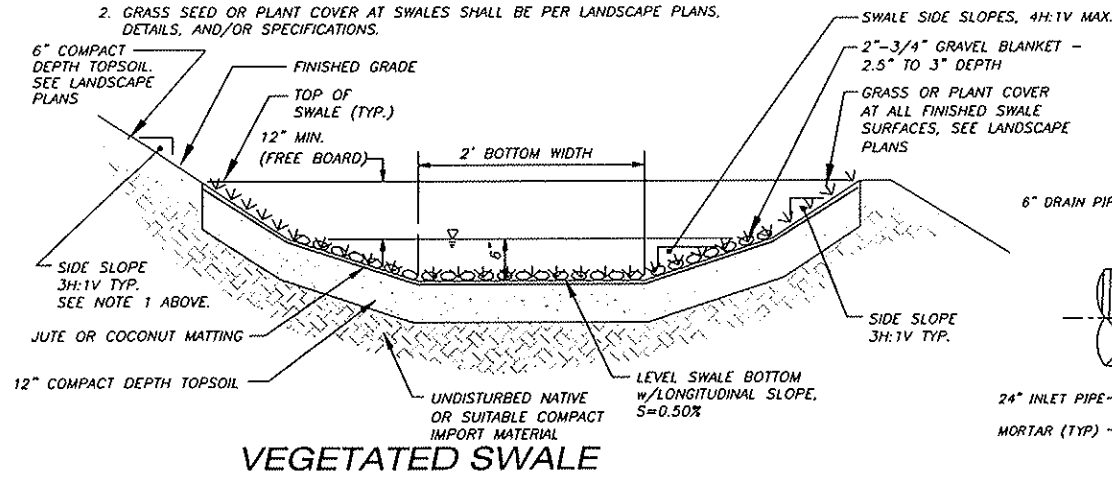

NOTE: ALL CONCRETE SHALL BE 3000 PSI

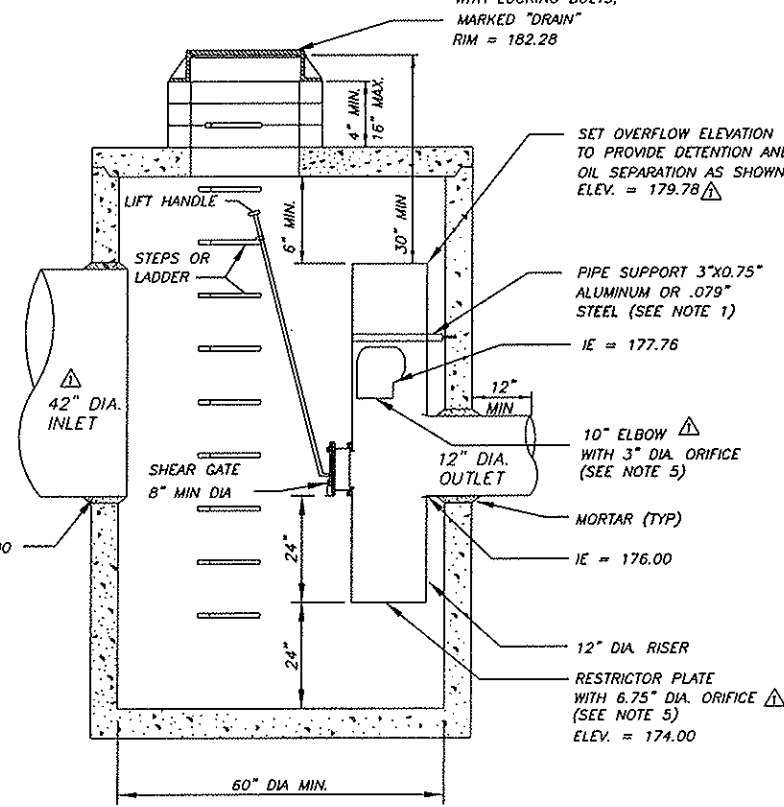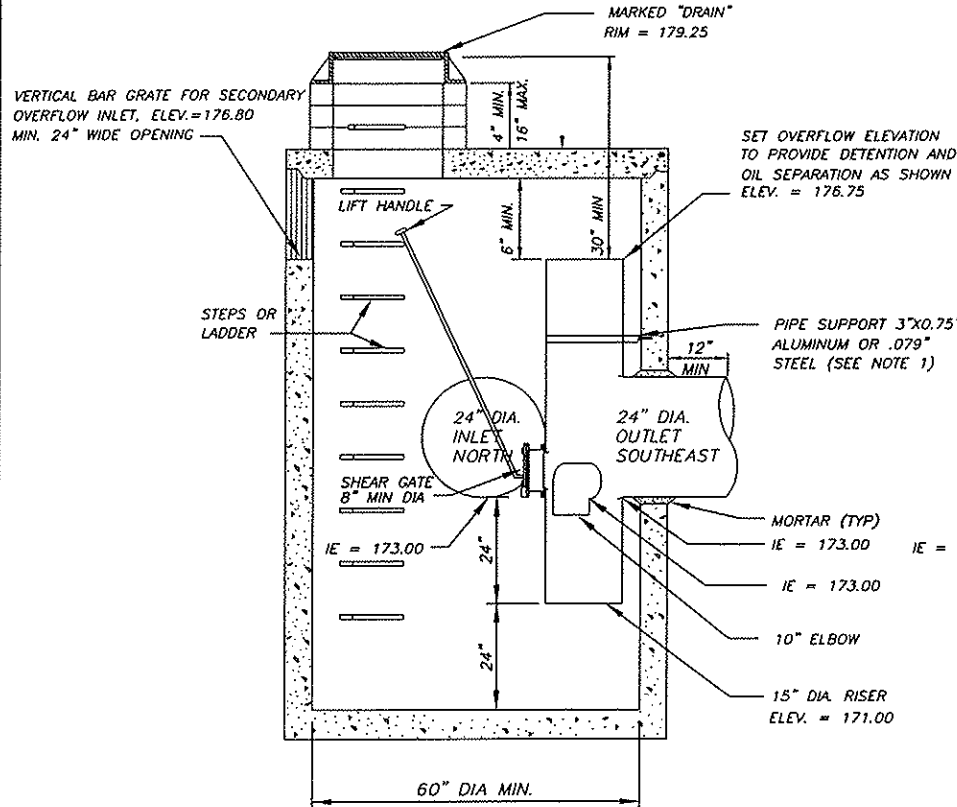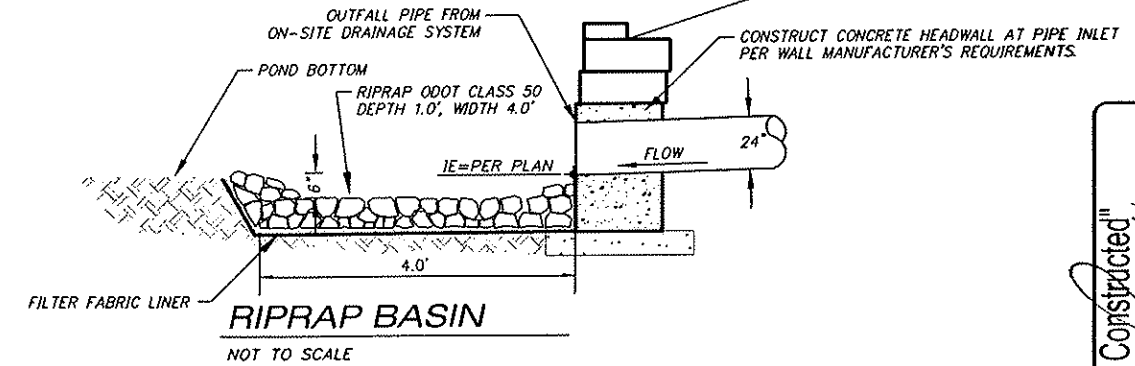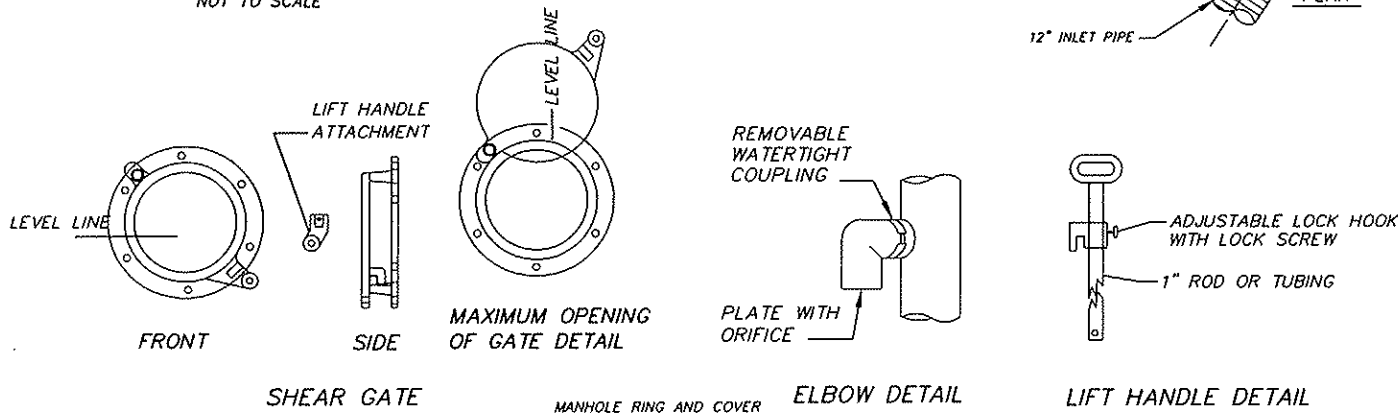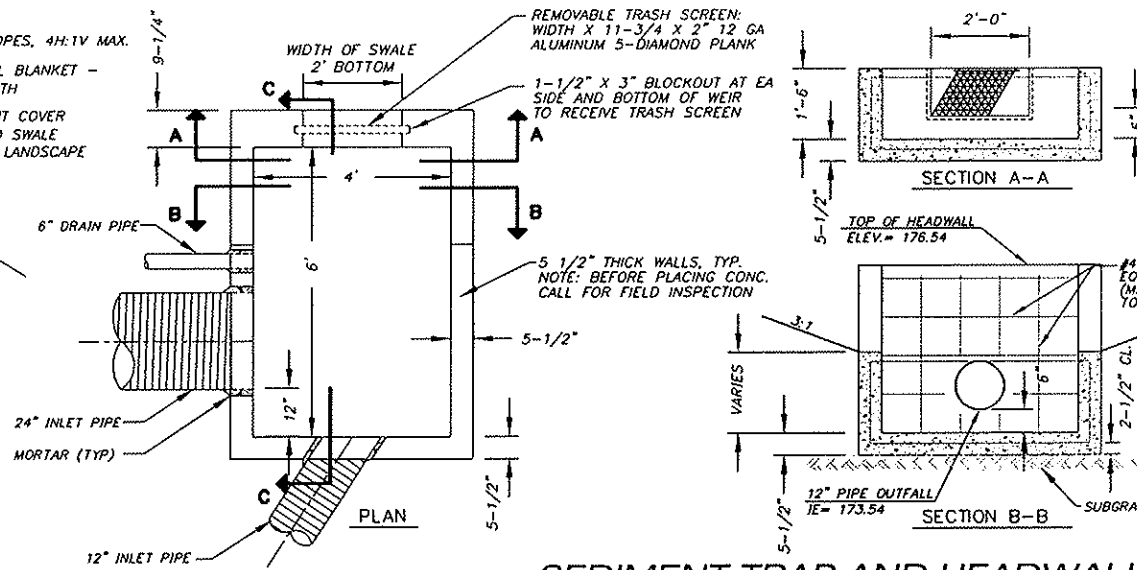

OUTLET CONTROL STRUCTURE NOTES:

1. PIPE SUPPORTS AND RESTRICTOR/SEPARATOR SHALL BE CONSTRUCTED OF THE SAME MATERIAL AND BE ANCHORED AT A MAXIMUM SPACING OF 36". ATTACH PIPE SUPPORTS TO MANHOLE WITH 5/8" STAINLESS STEEL EXPANSION BOLTS OR EMBED SUPPORTS INTO MANHOLE WALL 2".
2. THE FLOW RESTRICTOR/SEPARATOR SHALL BE FABRICATED FROM ONE OF THE FOLLOWING MATERIALS:
0.60" CORRUGATED ALUMINUM ALLOY DRAIN PIPE
0.64" CORRUGATED GALVANIZED OR ALUMINIZED STEEL DRAIN PIPE
0.60" ALUMINUM ALLOY FLAT SHEET, IN ACCORDANCE WITH ASTM B 209M, 5052 H32 OR EPS
GALVANIZED STEEL SHALL HAVE TREATMENT 1.
3. FRAME AND LADDER OR STEPS ARE TO BE OFFSET SO THAT:
SHEAR GATE IS VISIBLE FROM THE TOP
CLIMB-DOWN SPACE IS CLEAR OF RISER AND GATE
FRAME IS CLEAR OF CURB.
4. MULTI-ORIFICE ELBOWS MAY BE LOCATED AS SHOWN OR ALL ON ONE SIDE OF RISER TO ASSURE LADDER CLEARANCE.
5. RESTRICTOR PLATE SHALL BE INSTALLED AS SHOWN WITH ORIFICE OPENINGS TO BE CUT ROUND AND SMOOTH.
6. SHEAR GATE SHALL BE MADE OF ALUMINUM ALLOY IN ACCORDANCE WITH ASTM B 26M AND ASTM B 275, DESIGNATION 2632A OR CAST IRON IN ACCORDANCE WITH ASTM A 48, CLASS 30B. LIFT HANDLE MAY BE SOLID ROD OR HOLLOW TUBING WITH ADJUSTABLE HOOK AS REQUIRED. NEOPRENE RUBBER GASKET REQUIRED BETWEEN RISER MOUNTING FLANGE AND GATE FLANGE. MATING SURFACES OF LID AND BODY SHALL BE MACHINED FOR PROPER FIT. FLANGE MOUNTING BOLTS SHALL BE 3/8" DIAMETER STAINLESS STEEL.
7. SHEAR GATE MAXIMUM OPENING SHALL BE CONTROLLED BY LIMITED HINGE MOVEMENT, STOP TAB OR SOME OTHER DEVICE.
8. ALTERNATE SHEAR GATE DESIGNS ARE ACCEPTABLE, IF MATERIAL SPECIFICATIONS ARE MET AND FLANGE BOLT PATTERN MATCHES.



PROJECT NUMBER
100017

WASHINGTON COUNTY
DEPARTMENT OF
LAND USE AND
TRANSPORTATION




DWG: NO. REVISIONS
REVISED 12-12-05

"As Constructed"
DATE 11/6/06 BY [Signature]
N. 19TH AND S. 20TH AVE REALIGNMENT
INCLUDING BASELINE ST, ADAIR ST, AND T.V. HWY
WASHINGTON COUNTY AND CITY OF CORNELIUS
W.Q. SWALE AND DETENTION POND DETAILS

otak
Incorporated
700 Washington Street
Suite 401
Vancouver, WA 98660-3139
Phone: (360) 757-9819
FAX: (360) 757-9851


BY	DATE
DRWN: JGN	7/05
DSGN: JGN	7/05
CHKD: PKW	7/05

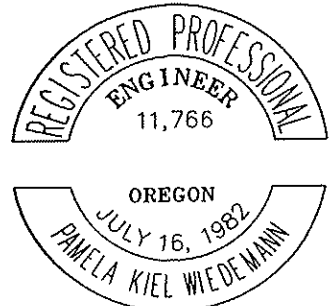


EXPIRES: 6/30/08

SHEET TITLE: **2B-17**
SHEET NO.: **28** OF 140


W.Q. SWALE AND DETENTION POND DETAILS

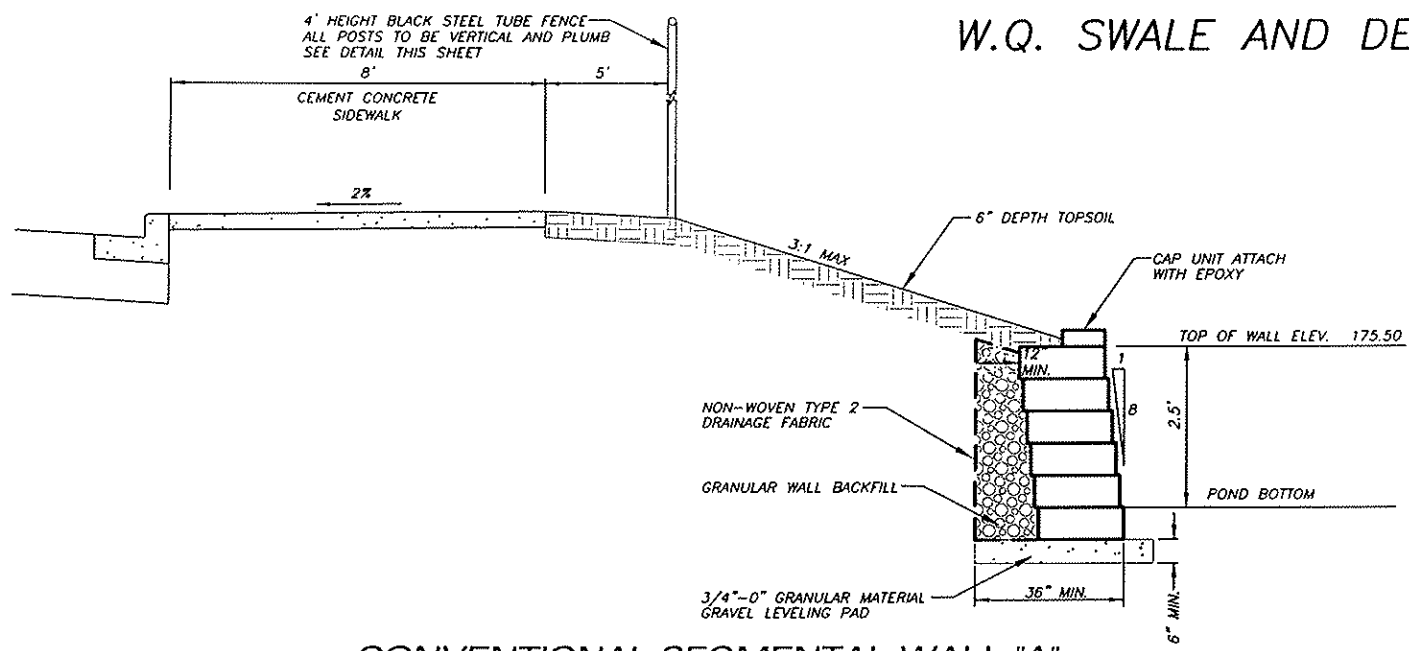


CONVENTIONAL SEGMENTAL WALL "A"
NOT TO SCALE

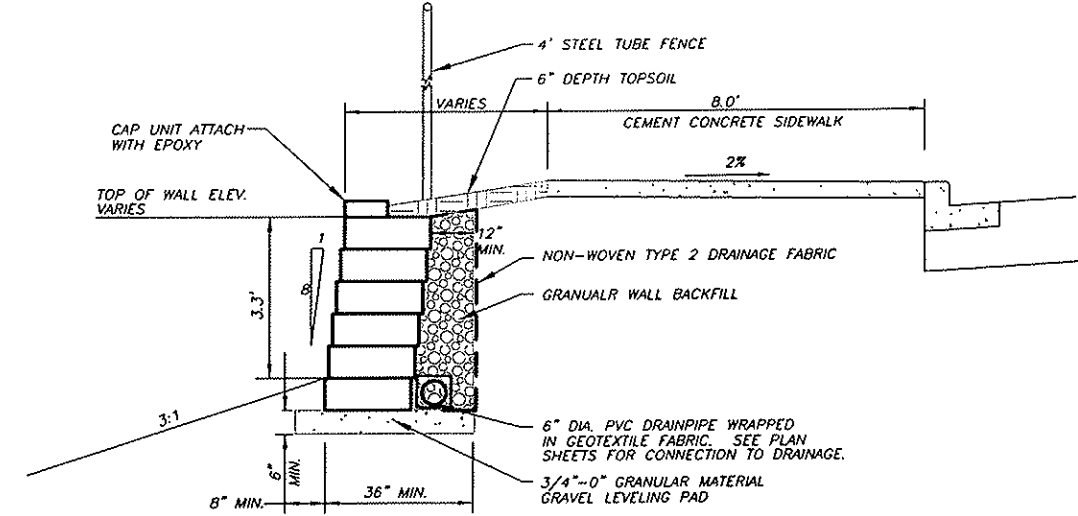


CONVENTIONAL SEGMENTAL WALL "B"
NOT TO SCALE

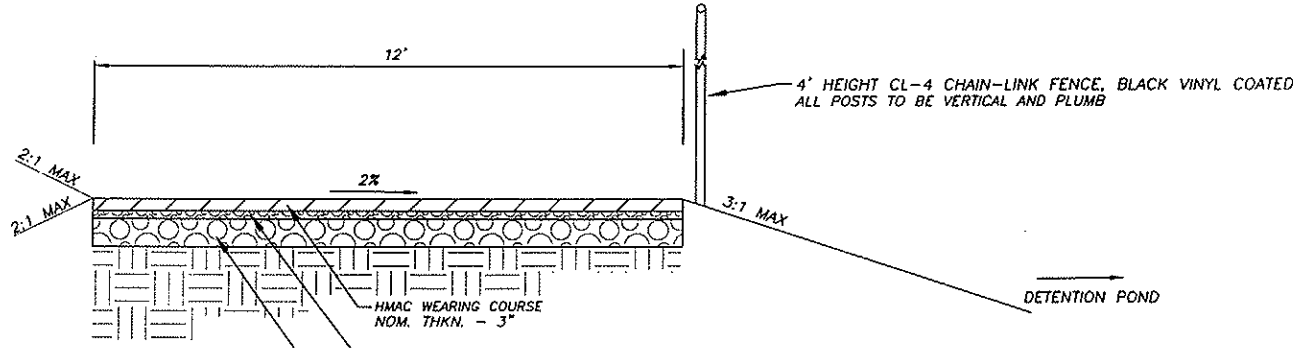

POND ACCESS ROAD
NOT TO SCALE

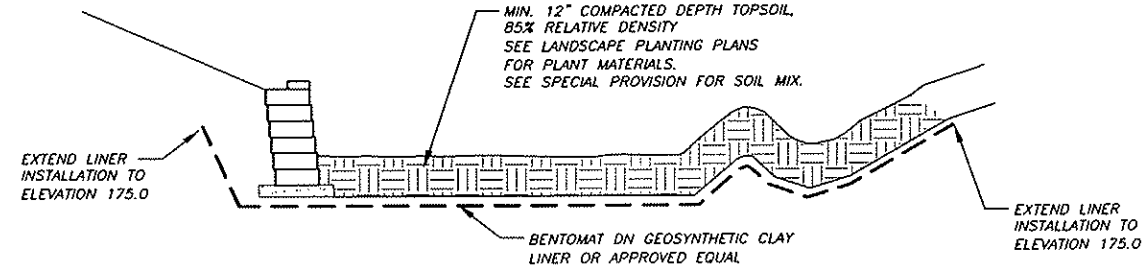


POND LINER
NOT TO SCALE

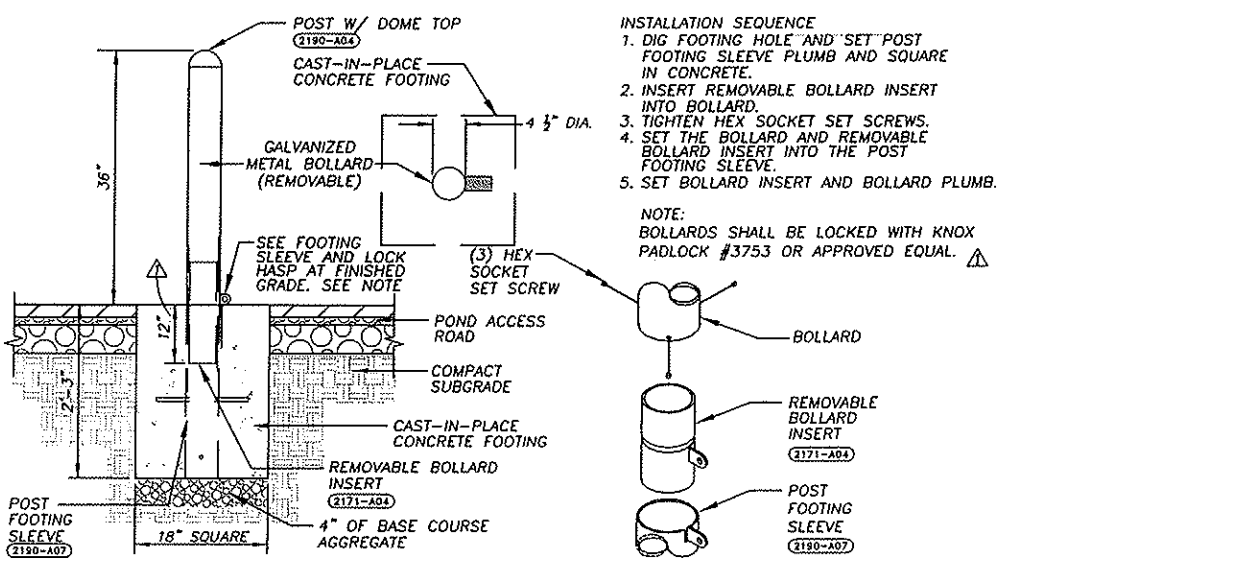

- INSTALLATION SEQUENCE**
1. DIG FOOTING HOLE AND SET POST FOOTING SLEEVE PLUMB AND SQUARE IN CONCRETE.
 2. INSERT REMOVABLE BOLLARD INSERT INTO BOLLARD.
 3. TIGHTEN HEX SOCKET SET SCREWS.
 4. SET THE BOLLARD AND REMOVABLE BOLLARD INSERT INTO THE POST FOOTING SLEEVE.
 5. SET BOLLARD INSERT AND BOLLARD PLUMB.

NOTE: BOLLARDS SHALL BE LOCKED WITH KNOX PADLOCK #3753 OR APPROVED EQUAL. ⚠

REMOVABLE BOLLARDS
NOT TO SCALE

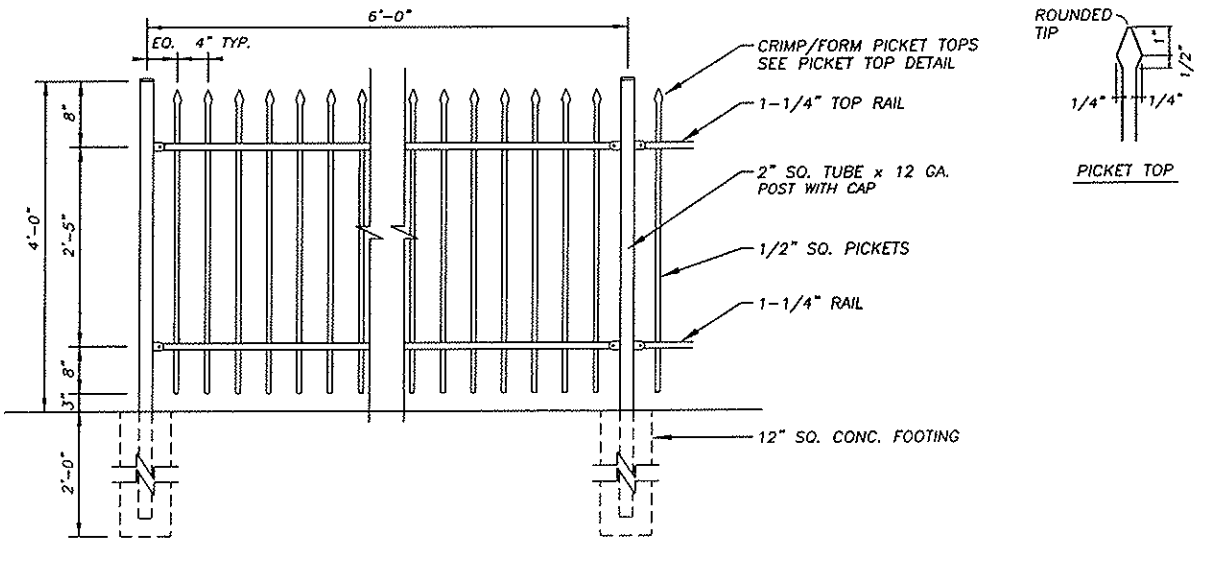

4' BLACK TUBE STEEL FENCE
NOT TO SCALE



PROJECT NUMBER
100017

WASHINGTON COUNTY
OREGON
DEPARTMENT OF
LAND USE AND
TRANSPORTATION



DWG: NO. REVISIONS

1	REVISED 8-2-05
---	----------------


"As Constructed"
DATE 11/6/06 BY [Signature]

N. 19TH AND S. 20TH AVE REALIGNMENT
INCLUDING BASELINE ST, ADAIR ST, AND T.V. HWY
WASHINGTON COUNTY AND CITY OF CORNELIUS

W.Q. SWALE AND DETENTION POND DETAILS

otak
Incorporated
700 Washington Street
Suite 401
Vancouver, WA 98660-3139
Phone: (360) 737-9813
FAX: (360) 737-9851


BY	DATE
DRWN: GE	7/05
DSGN: JGN	7/05
CHKD: PKW	7/05

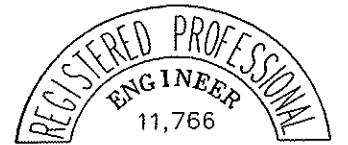

EXPIRES: 6/30/08

PROJECT NUMBER
100017

WASHINGTON COUNTY
DEPARTMENT OF
LAND USE AND
TRANSPORTATION

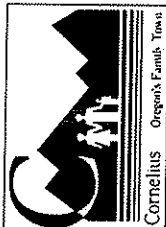

DWG. NO.	REVISIONS
Δ	REVISED 8-11-05

N. 19TH AND S. 20TH AVE REALIGNMENT
INCLUDING BASELINE ST, ADAIR ST, AND T.V. HWY
WASHINGTON COUNTY AND CITY OF CORNELIUS
CONSTRUCTION NOTES

DATE	BY
DRWN: 7/05	GE
DSGN: 7/05	SW/JN
CHKD: 7/05	PW

"As Constructed"
DATE 11/6/06 BY [Signature]



Incorporated
700 Washington Street
Suite 401
Vancouver, WA 98660-3139
Phone: (360) 737-9813
FAX: (360) 737-9851

CONSTRUCTION NOTES

THIS SHEET FACES SHEET 8A

- ① CONSTRUCT STANDARD CURB
"E" = 7" EXPOSURE
SEE DETAIL SHEET 2B
- ② CONSTRUCT P.C. CONC. SIDEWALK
SEE DETAIL SHEET 2B-2
- ③ NOTE NOT USED
- ④ NOTE NOT USED
- ⑤ SAWCUT EXISTING PAVEMENT
- ⑥ COLD PLANE PAVEMENT REMOVAL AND HMAC
OVERLAY (2" DEPTH)
- ⑦ STA 234+22.65, 27.98' RT
REMOVE EXISTING MANHOLE AND
CONSTRUCT NEW MANHOLE
- ⑧ STA 233+58.42, 42.07' RT
FLOW CONTROL MANHOLE "A"
(60" DIA.)
SEE SHEET 2B-17
- ⑨ STA 233+58.66, 54.93' RT
24" STORM OUTLET
IE=173.04
- ⑩ STA 233+35.31, 26.47' LT
CONSTRUCT MANHOLE (60" DIA.)
- ⑪ STA 234+95.35, 18.00' LT
CONST TYPE "CG-2" INLET
RIM=179.57
IE=175.39 (12" SE)
SEE DETAIL SHEET 2B-7
- ⑫ STA 234+77.84, 26.00' RT
CONST TYPE "CG-2" INLET
RIM=179.31
IE=176.31 (12" E)
SEE DETAIL SHEET 2B-7
- ⑬ STA. 234+92.63, 20.49' LT
REMOVE EXISTING STORM MANHOLE AND
CONSTRUCT NEW STORM MANHOLE
- ⑭ RELOCATE EXISTING UTILITY POLE
(BY OTHERS)
- ⑮ STA 235+22.85, 22.2'RT±
END CURB TAPER
MATCH EXISTING CURB AND SIDEWALK
- ⑯ STA 234+79.91, 26.00 RT
BEGIN CURB TAPER
- ⑰ NOTE NOT USED
- ⑱ RELOCATE GAS TEST STATION (BY OTHERS)
- ⑲ RELOCATE EXISTING JOINT WATER COMMISSION
CORROSION TEST STATION AND BLOW OFF ASSEMBLY
TO BACK OF SIDEWALK. SEE UTILITY PLANS AND
SHEET 2B-14 FOR DETAILS.
- ⑳ CONSTRUCT HMAC SIDEWALK RAMP
- ㉑ REMOVE AND INSTALL NEW MAILBOX SUPPORT
PER DETAIL SHEET 2B-5.
- ㉒ REMOVE AND SALVAGE EXISTING CITY OF CORNELIUS
SIGN POLES. POLES AND ACCESSORIES SHALL BE
DELIVERED TO CITY FOR STORAGE. CONTRACTOR TO
COORDINATE WITH ENGINEER, TO DETERMINE STORAGE
LOCATION.
- ㉓ ADJUST EXISTING WATER VALVE BOX
- ㉔ REMOVE EXISTING FENCE WITHIN EASEMENT AS
DIRECTED
- ㉕ STA 236+77, 20'± LT
EXISTING 12" STORM LINE TO BE REMOVED DURING
CONSTRUCTION OF NEW SANITARY SEWER MAIN PER
SHEET U7. REPLACE WITH NEW 12" STORM LINE
AND CONNECT TO EXISTING LINE.
- ㉖ RELOCATE EXISTING ELECTRICAL SERVICE, IRRIGATION
VALVE, AND LIGHT. SEE NOTE 38, SHEET 9.
- ㉗ STA 233+94.60, 53.81' RT
24" STORM INLET
IE=173.04
- ㉘ PROTECT EXISTING JUNCTION BOX
- ㉙ STA 234+14.5 TO 234+35.0, RT
TAPER SIDEWALK WIDTH FROM 8.5' TO 6.5'
- ㉚ REMOVE WATER SERVICE, METER TO BE SALVAGED
AND RETURNED TO CITY.
- ㉛ RECONSTRUCT EXISTING SEGMENTAL WALL AS
DIRECTED BY ENGINEER.
- ㉜ 12' THICKENED (6") CONCRETE SIDEWALK SECTION
AND MOUNTABLE CURB CENTERED ON POND
ACCESS ROAD.

LEGEND:

- RIGHT-OF-WAY
- PUBLIC UTILITY EASEMENT
- TEMP. CONSTRUCTION EASEMENT
- c ----- CUT SLOPE
- f ----- FILL SLOPE


REMOVE EXTG. INLET OR MANHOLE SHOWN THUS:

REMOVE EXTG. PIPE SHOWN THUS:

AC DRIVEWAY

"B" LINE CURVE TABLE

 L=163.39 R=1500.00 Δ=6'14'27"
 L=147.01 R=1500.00 Δ=5'36'56"


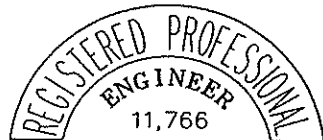


EXPIRES: 6/30/08

SHEET TITLE: 8 SHEET NO.: 73 OF 140

GENERAL NOTES

- SEE SHEET 1D FOR EXISTING STRUCTURE INFORMATION.
- SEE 'TS' SHEETS FOR SIGNING RELOCATIONS. SEE 'U' SHEETS FOR WATER AND SEWER INFORMATION.

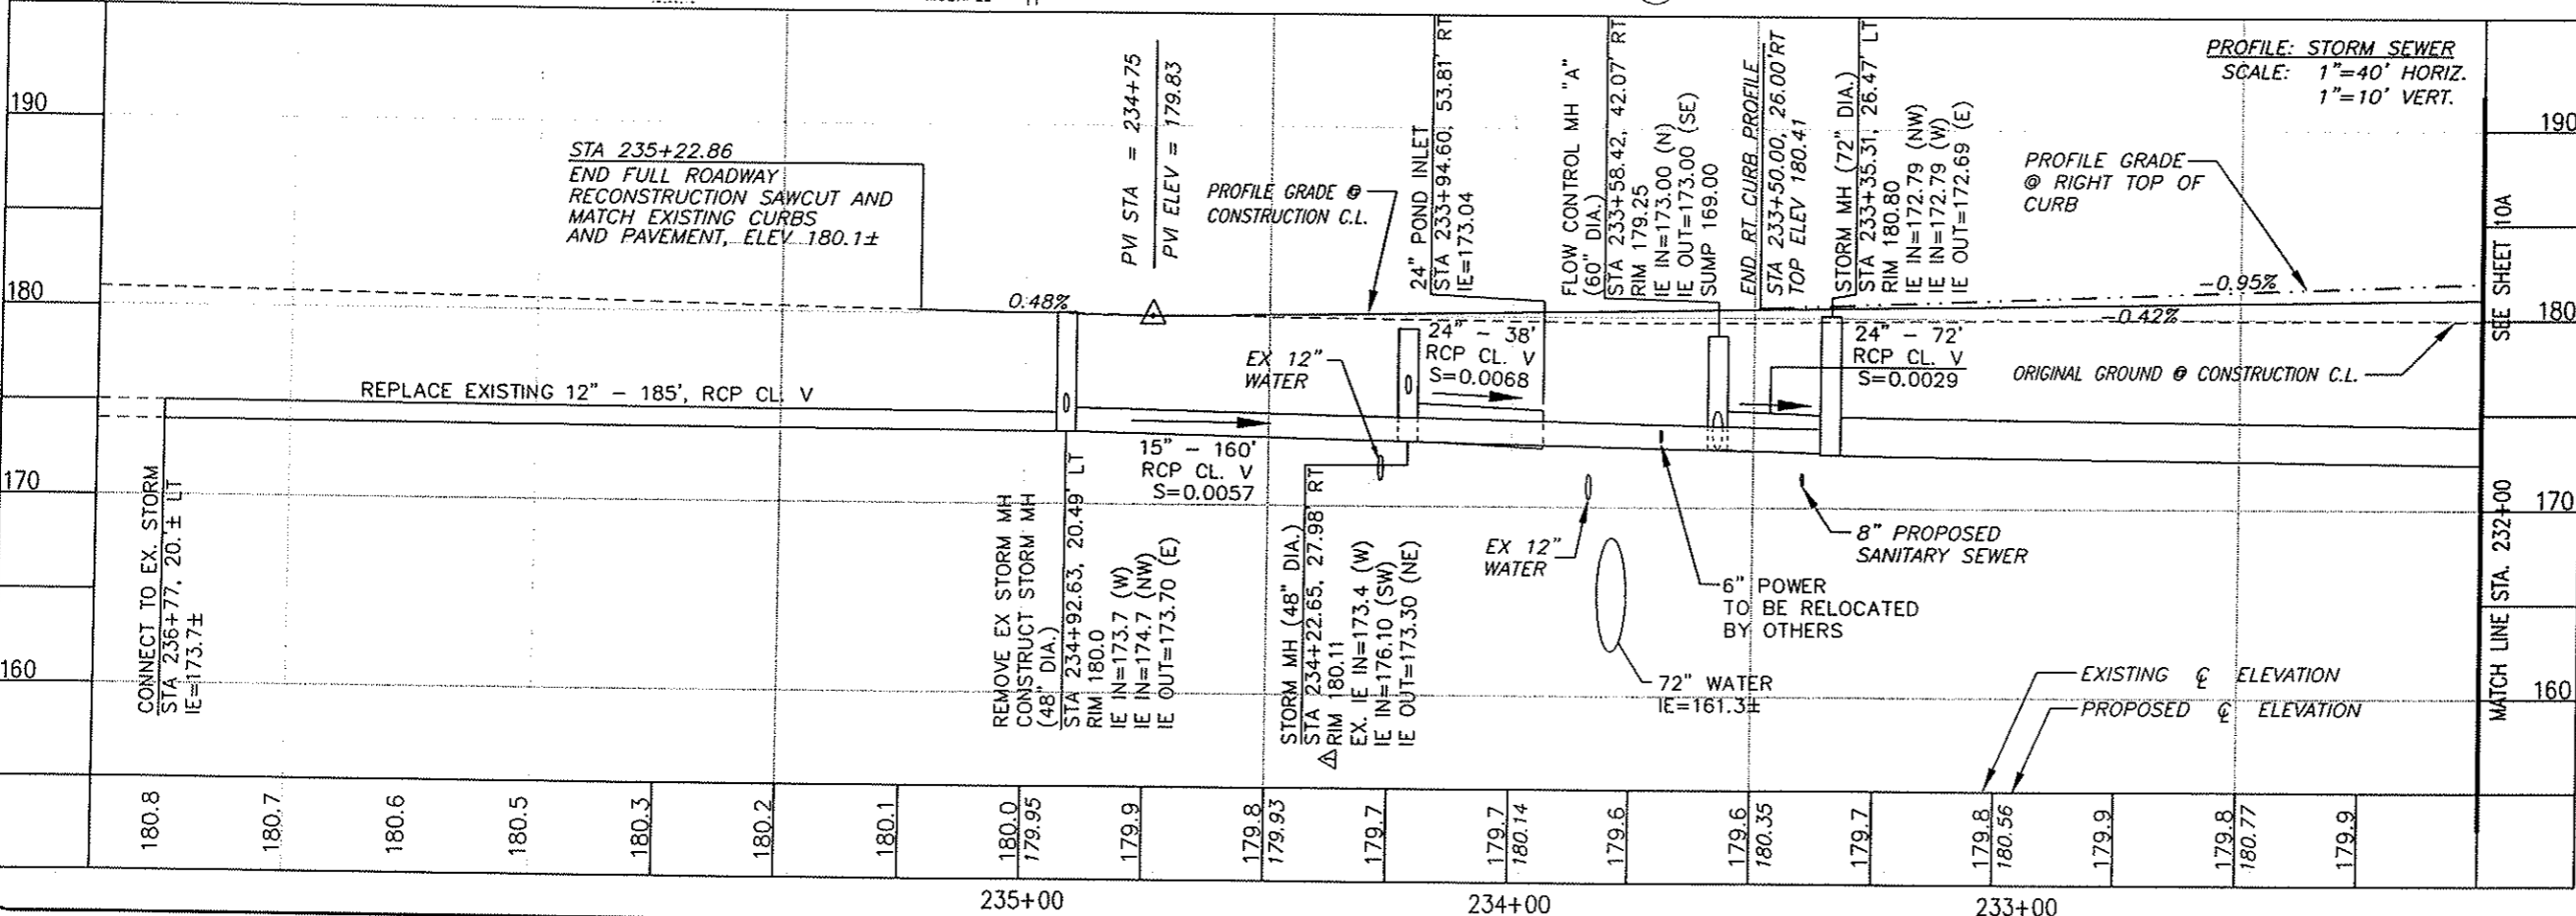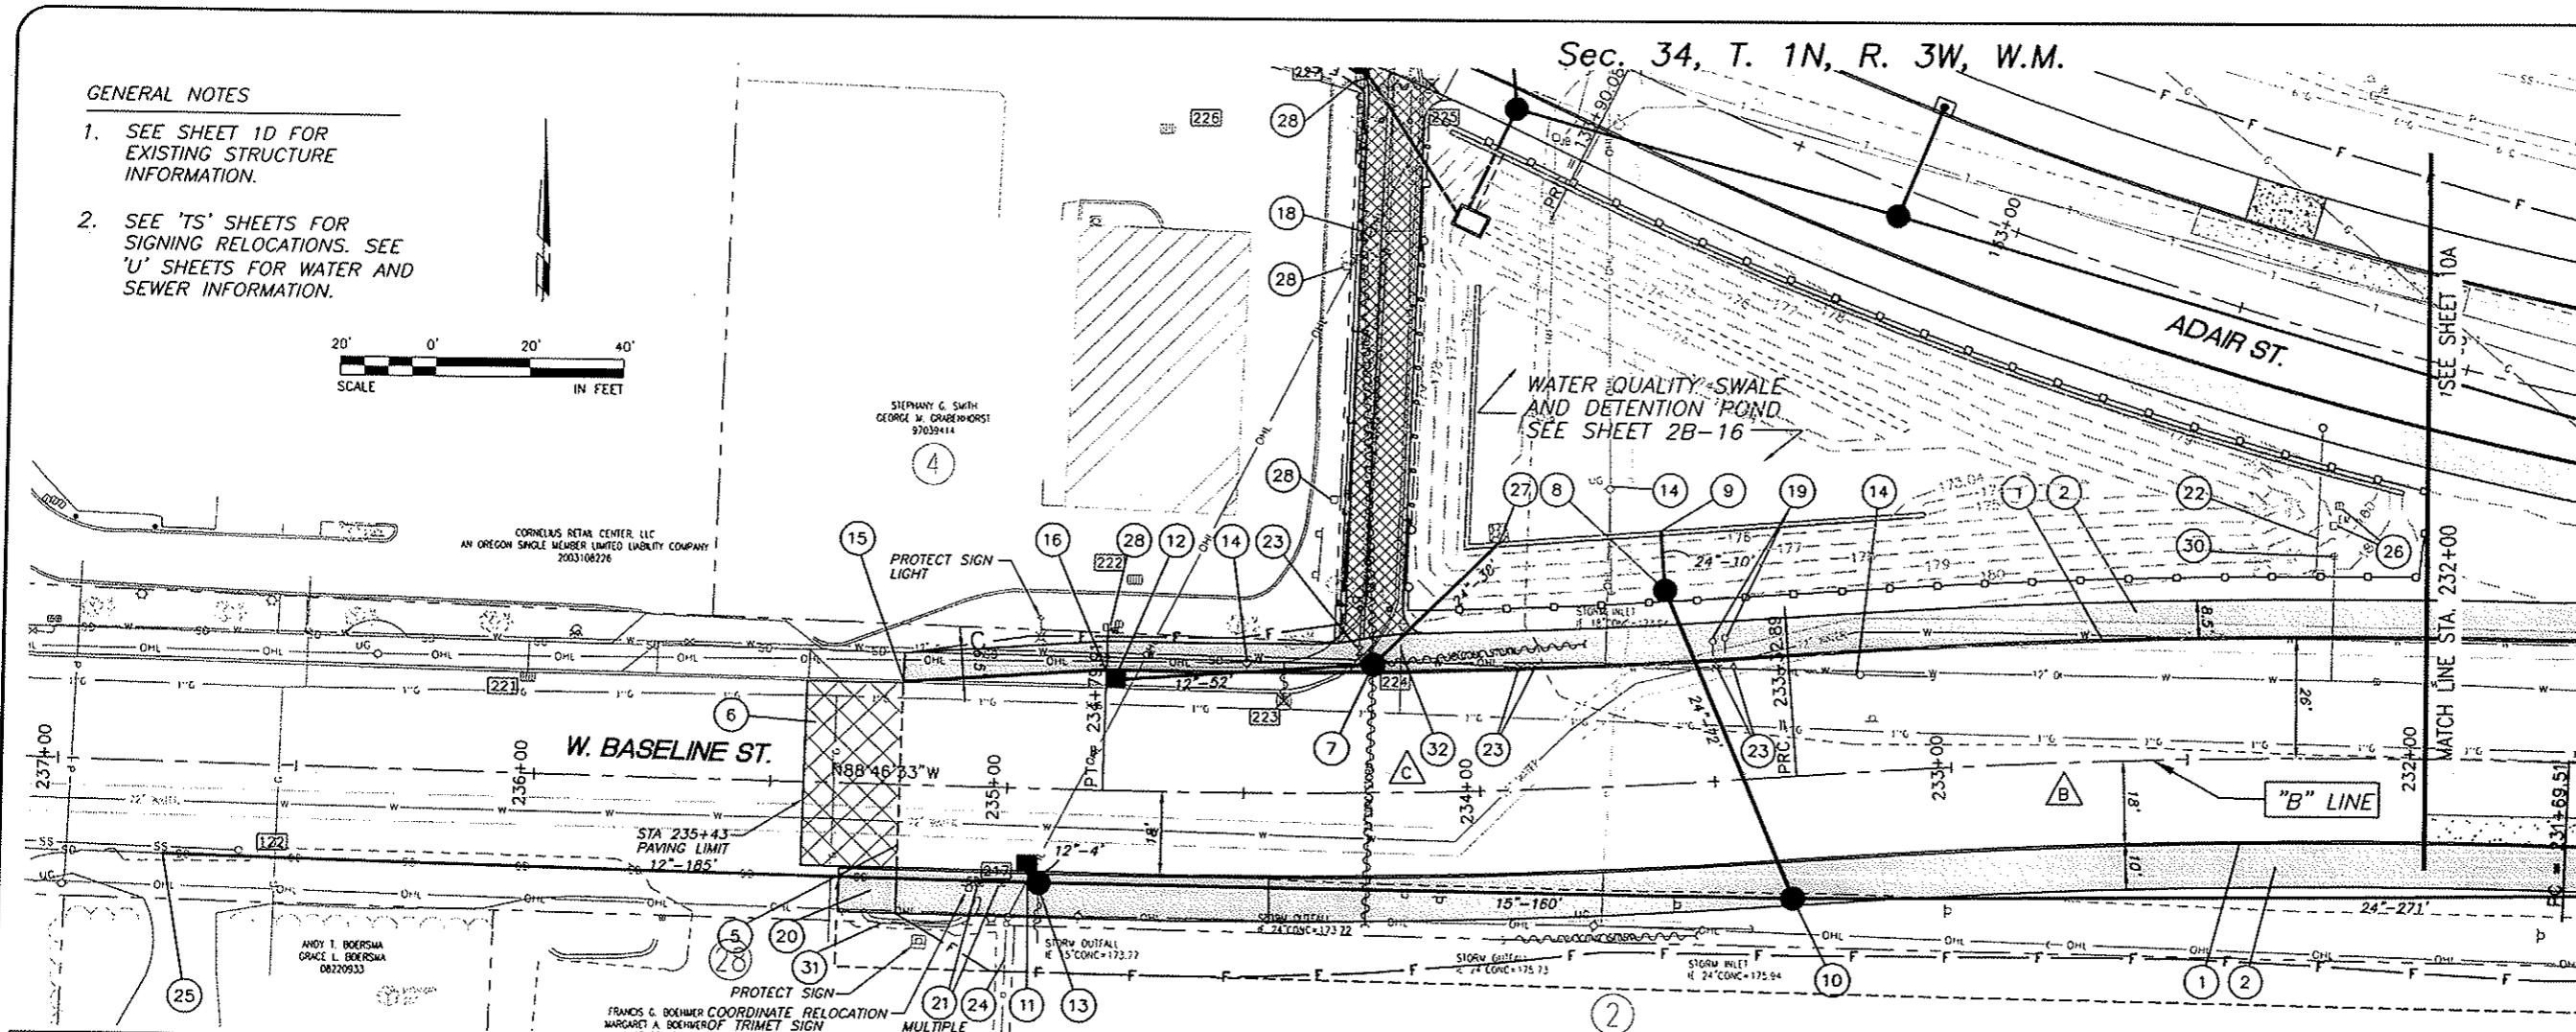

Sec. 34, T. 1N, R. 3W, W.M.

ADAIR ST.

W. BASELINE ST.


"B" LINE

PROFILE: STORM SEWER
SCALE: 1"=40' HORIZ.
1"=10' VERT.



PROJECT NUMBER
100017

WASHINGTON COUNTY
DEPARTMENT OF
LAND USE AND
TRANSPORTATION

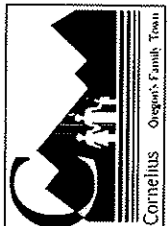

DWG: NO. REVISIONS

1	REVISED 8-11-05
---	-----------------


"As Constructed"
DATE 11/6/06 BY [Signature]
N. 19TH AND S. 20TH AVE REALIGNMENT
INCLUDING BASELINE ST, ADAIR ST, AND T.V. HWY
WASHINGTON COUNTY AND CITY OF CORNELIUS

PLAN AND PROFILE

BY	DATE
DRWN: GE	7/05
DSCN: SW/JN	7/05
CHKD: PW	7/05



Incorporated
700 Washington Street
Suite 401
Vancouver, WA 98660-3139
Phone: (360) 737-9813
FAX: (360) 737-9851

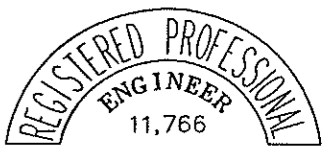


EXPIRES: 6/30/08

SHEET TITLE: 8A SHEET NO. 74 OF 140

PROJECT NUMBER
100017

WASHINGTON COUNTY
DEPARTMENT OF
LAND USE AND
TRANSPORTATION

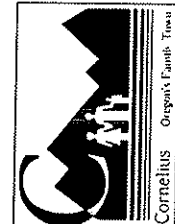

DWG. NO.	REVISIONS
Δ	REVISED 8/17/05
Δ	REVISED 10/27/05

N. 19TH AND S. 20TH AVE REALIGNMENT
INCLUDING BASELINE ST, ADAIR ST, AND T.V. HWY
WASHINGTON COUNTY AND CITY OF CORNELIUS
CONSTRUCTION NOTES

DATE	BY
DRWN: 7/05	GE
DSGN: 7/05	SW/JN
CHKD: 7/05	PW

"As Constructed"
DATE 11/6/06 BY [Signature]

otak
Incorporated
700 Washington Street
Suite 401
Vancouver, WA 98660-3139
Phone: (360) 737-9613
FAX: (360) 737-9651



EXPIRES: 6/30/08

SHEET TITLE SHEET NO.
9 75 OF 140

CONSTRUCTION NOTES

THIS SHEET FACES SHEET 9A

- 1 CONSTRUCT STANDARD CONCRETE CURB "E"=7" EXPOSURE SEE DETAIL SHEET 2B
- 2 CONSTRUCT P.C. CONC. SIDEWALK SEE DETAIL SHEET 2B-2
- 3 CONSTRUCT SIDEWALK RAMP SEE DETAIL SHEET 2B-3
- 4 CONSTRUCT CONCRETE DRIVEWAY APPROACH, REINFORCED OPTION "N" SEE DETAIL SHEET 2B-2.
- 5 SAWCUT EXISTING PAVEMENT
- 6 COLD PLANE PAVEMENT REMOVAL AND HMAC OVERLAY (2" DEPTH)
- 7 STA 134+43.10, 23.19' LT REMOVE EXISTING MANHOLE AND CONSTRUCT NEW MANHOLE CONNECT EXISTING PIPE NW
- 8 STA 134+07.77, 18.50' LT CONSTRUCT MANHOLE
- 9 STA 133+25.00, 6.00' LT Δ CONSTRUCT 48" DIA. FLAT TOP MANHOLE
- 10 STA 134+02.32, 44.21' LT POND SEDIMENT TRAP AND HEADWALL SEE DETAIL SHEET 2B-17
- 11 STA 134+78.51, 35.96' RT CONSTRUCT FLAT TOP MANHOLE
- 12 STA 134+34.09, 55.59' RT CONNECT TO EXISTING MANHOLE IE=175.26 (12" SW) REMOVE PIPES TO NORTH AND WEST AND PLUG PIPE OPENINGS
- 13 STA 136+63.00, 30.94' RT CONST TYPE "D" INLET RIM=177.55 IE=176.01 (12" E) SEE DETAIL SHEET 2B-6
- 14 STA 133+25.00, 18.00' RT CONST TYPE "CG-3" INLET W/ ALTERNATE TOP SECTION TOP LID ELEV.=182.22 IE=177.64 (12" S) Δ SEE DETAIL SHEET 2B-6
- 15 STA "A" 134+46.08, 50.64' RT = STA "E" 10+56.18, 3.73' LT CONSTRUCT 60" DIA. FLAT TOP MANHOLE
- 16 STA 134+79.35, 44.40' RT CONST TYPE "G-2" INLET RIM=178.0 IE=175.55 (12" S) SEE DETAIL SHEET 2B-7
- 17 REMOVE EXISTING TREE
- 18 RELOCATE EXISTING JUNCTION BOX (BY OTHERS)
- 19 CONSTRUCT 5-1/2" THICK CONCRETE BUS SHELTER PAD FROM STA 132+40 TO 132+55. SEE SHEET R4 FOR SCORING DETAIL
- 20 RELOCATE EXISTING WATER METER
- 21 REMOVE AND SALVAGE EXISTING CITY OF CORNELIUS SIGN POLES. POLES AND ACCESSORIES SHALL BE DELIVERED TO CITY FOR STORAGE. CONTRACTOR TO COORDINATE WITH ENGINEER, TO DETERMINE STORAGE LOCATION.
- 22 REMOVE WATER SERVICE. METER TO BE SALVAGED AND RETURNED TO THE CITY.
- 23 STA 135+63.50 END FULL ROADWAY RECONSTRUCTION SAWCUT AND MATCH EXISTING CURB 20.0'± LT AND PAVEMENT
- 24 STA 136+54.82, 18.0'RT END CONSTRUCTION
- 25 PROPOSED N. 19TH AVE. STREET IMPROVEMENTS BY OTHERS (N.I.C.)
- 26 RELOCATE EXISTING UTILITY POLE (BY OTHERS)
- 27 EXISTING INLET TO BE REMOVED BY OTHERS. Δ
- 28 REMOVE EXISTING CURB AND SIDEWALK
- 29 ADJUST EXISTING GAS VALVE BOX TO FINISH GRADE
- 30 12' WIDE THICKENED (6") CONCRETE SIDEWALK SECTION AND MOUNTABLE CURB CENTERED ON POND ACCESS ROAD
- 31 UTILITY POLE TO REMAIN. REMOVE STREET LIGHT (BY OTHERS)
- 32 ADJUST MANHOLE LID TO FINISH GRADE
- 33 REMOVE EXISTING ROADWAY TO ORIGINAL GROUND
- 34 CONSTRUCT HMAC SIDEWALK RAMP PER DETAIL RD600, SHEET 2B-3.
- 35 SEE T-CUT DETAIL SHEET 2A-2.
- 36 CONSTRUCT 6' WIDE PLAIN CONCRETE PAVEMENT BUS PAD, 8" THICK SECTION FROM STA 132+05.00 TO STA 132+65.00 SEE DETAIL SHEET 2A-4
- 37 CONSTRUCT CONCRETE TRANSITION SECTION AT EACH END OF PLAIN CONCRETE PAVEMENT BUS PAD. SEE DETAIL SHEET 2A-4
- 38 RELOCATE CITY OWNED ELECTRICAL SERVICE AND LIGHT AS DIRECTED. COORDINATE METER RELOCATION WITH PGE. EXISTING IRRIGATION EQUIPMENT TO BE ABANDONED OR REMOVED AS DIRECTED. RELOCATED ELECTRICAL SERVICE AND METER TO BE CONNECTED TO NEW IRRIGATION CONTROLLER.
- 39 PROTECT EXISTING CONCRETE PAD, FENCE, AND PAY PHONE.

LEGEND:

- RIGHT-OF-WAY
- PUBLIC UTILITY EASEMENT
- TEMP. CONSTRUCTION EASEMENT
- c ----- CUT SLOPE
- f ----- FILL SLOPE

REMOVE EXTG. INLET OR MANHOLE SHOWN THUS:

REMOVE EXTG. PIPE SHOWN THUS:

AC DRIVEWAY

CURB RETURN TABLE

CURVE	STATION/OFFSET	SYMBOL Δ / 4	T.O.C. ELEV.
1 Δ = 53°54'16" R = 60.00' L = 56.45'	BCR 133+69.03, 18.00'RT	A	182.05
		B	181.93
		C	181.69
	ECR 134+17.49, 42.09'RT	D	181.35
		E	181.0±
2 Δ = 135°11'02" R = 1.00' L = 2.36' Δ = 25°08'06" R = 36.00' L = 15.79'	BCR 134+29.81, 18.00'RT	F	181.82
		G	181.85
	PRC 134+29.12, 19.71'RT	H	181.80
		I	181.40
	ECR 134+37.33, 32.93'RT	J	181.0±

"A" LINE CURVE TABLE

 L=349.73 R=900.00 Δ=22°15'53"
 L=237.40 R=1150.00 Δ=11°49'41"
 L=128.42 R=2864.79 Δ=2°34'06"

LEFT CURB TAPER CURVE TABLE

CURVE	STATION/OFFSET
 Δ = 32°19'31" R = 20.00' L = 11.28'	PCC 134+50.00, 14.00'LT BEGIN TAPER
 Δ = 31°15'34" R = 20.00' L = 10.91'	PRC 134+60.86, 17.05'LT
	PRC 134+60.86, 17.05'LT
	PCC 134+71.39, 20.00'LT END TAPER

DRIVEWAY RECONSTRUCTION TABLE


STATION	TYPE	EXTG. SURFACE	FINISHED SURFACE	THROAT WIDTH	LENGTH	ESTIMATED PAVED AREA
135+94 "A"	COMMERCIAL	N/A	A.C.	32'	22	80 S.Y.

Sec. 34, T. 1N, R. 3W, W.M.


PROJECT NUMBER
100017



WASHINGTON COUNTY
DEPARTMENT OF
LAND USE AND
TRANSPORTATION

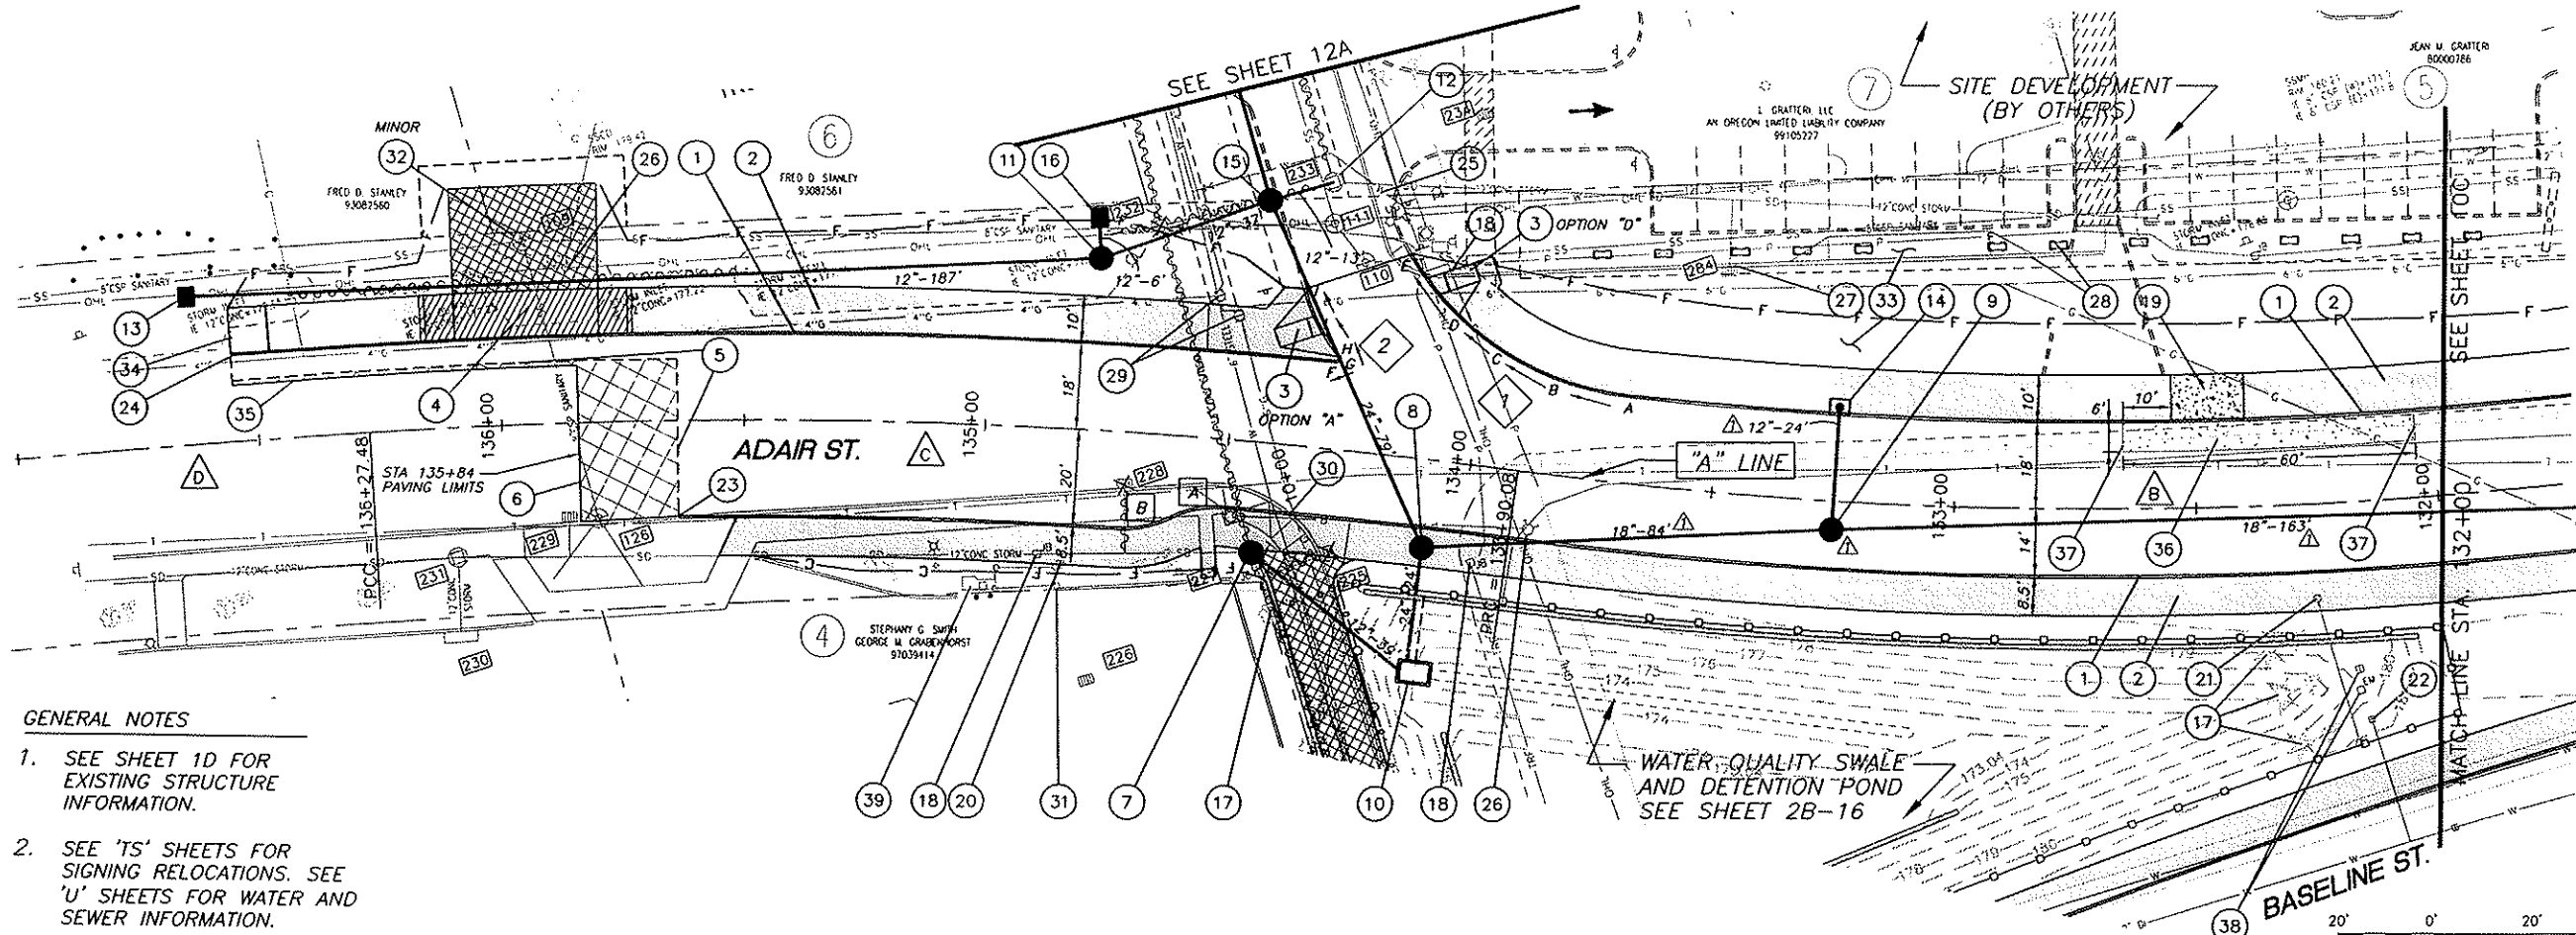

- GENERAL NOTES**
- SEE SHEET 1D FOR EXISTING STRUCTURE INFORMATION.
 - SEE 'TS' SHEETS FOR SIGNING RELOCATIONS. SEE 'U' SHEETS FOR WATER AND SEWER INFORMATION.

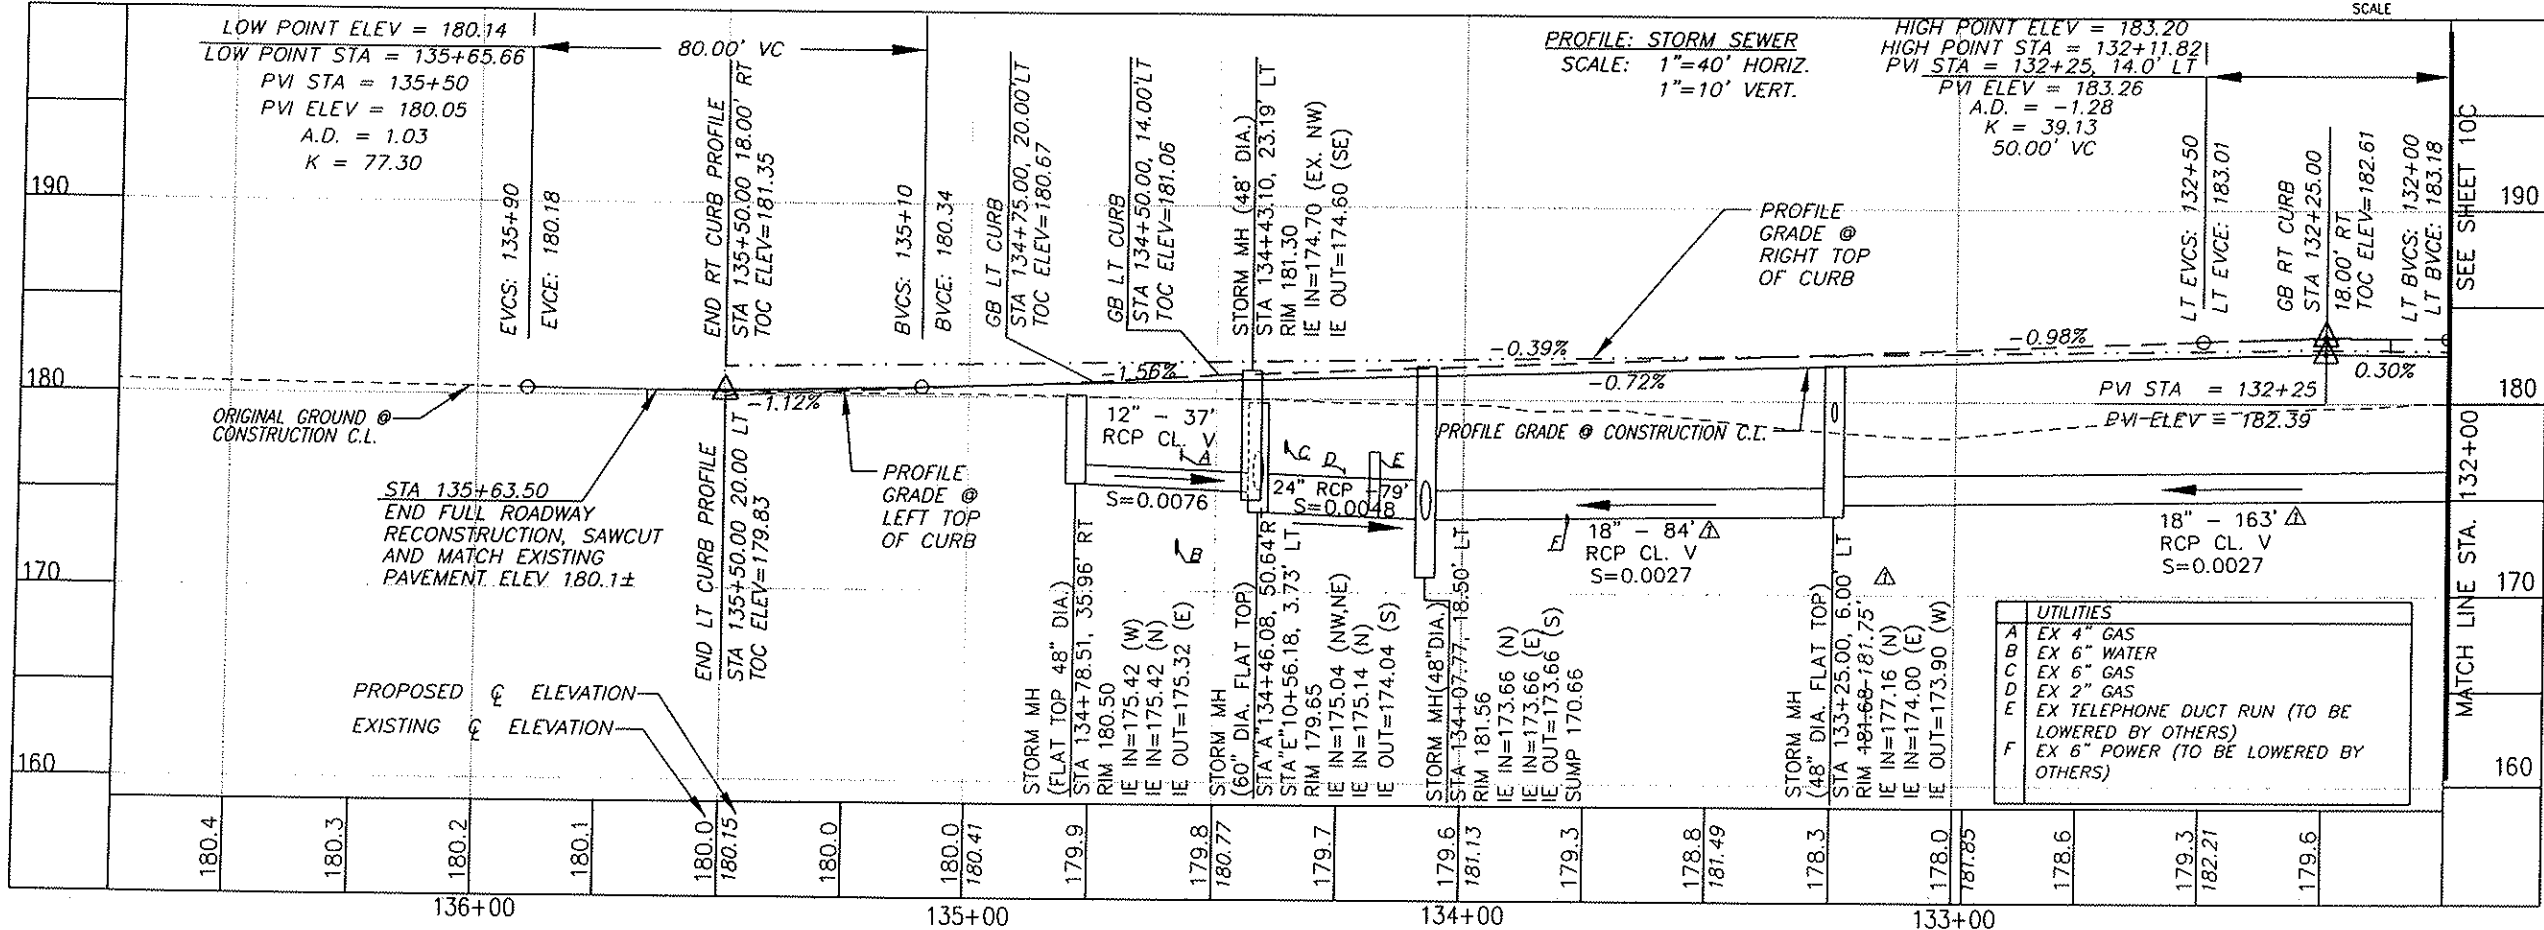

otak
 Incorporated
 700 Washington Street
 Suite 401
 Vancouver, WA 98660-3139
 Phone: (360) 737-9613
 FAX: (360) 737-9651

REGISTERED PROFESSIONAL ENGINEER
 11,766
 OREGON
 JULY 16, 1982
 PAMELA KIEL WIEDEMANN


EXPIRES: 6/30/08
 SHEET TITLE: 9A
 SHEET NO.: 76 OF 140

"As Constructed"
 DATE 11/16/06
 N. 19TH AND S. 20TH AVE REALIGNMENT
 INCLUDING BASELINE ST, ADAIR ST, AND T.V. HWY
 WASHINGTON COUNTY AND CITY OF CORNELIUS
 PLAN AND PROFILE

DRWN:	BY	DATE
GE	GE	7/05
DSGN:	BY	DATE
SWJN	SWJN	7/05
CHKD:	BY	DATE
PW	PW	7/05

PROJECT NUMBER
100017

WASHINGTON COUNTY
DEPARTMENT OF
LAND USE AND
TRANSPORTATION

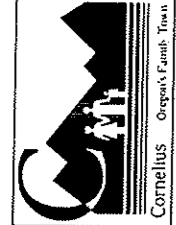

DWG: NO. REVISIONS
REVISED 12-6-05

N. 19TH AND S. 20TH AVE REALIGNMENT
INCLUDING BASELINE ST, ADAIR ST, AND T.V. HWY
WASHINGTON COUNTY, AND CITY OF CORNELIUS

CONSTRUCTION NOTES

"As Constructed"
DATE 11/6/06 BY J. M. [Signature]



DATE	BY
DRWN: 7/05	GE
DSGN: 7/05	SW/JN
CHKD: 7/05	PW

Incorporated
700 Washington Street
Suite 401
Vancouver, WA 98660-3139
Phone: (360) 737-9613
FAX: (360) 737-9651



EXPIRES: 6/30/08

SHEET TITLE SHEET NO.
10 77 OF 140

CONSTRUCTION NOTES

THIS SHEET FACES SHEET 10A

- ① CONSTRUCT STANDARD CURB "E"=7" EXPOSURE SEE DETAIL SHEET 2B
- ② CONSTRUCT P.C. CONC. SIDEWALK SEE DETAIL SHEET 2B-2
- ③ CONSTRUCT SIDEWALK RAMP SEE DETAIL SHEET 2B-3
- ④ NOTE NOT USED
- ⑤ NOTE NOT USED
- ⑥ NOTE NOT USED
- ⑦ STA "B" 230+61.68, 13.00' LT
STA "C" 33+47.18, 7.52' RT
CONSTRUCT MANHOLE
- ⑧ STA 230+07.68, 25.68' LT
FLOW CONTROL MANHOLE "B" (60" DIA.)
RIM=182.28
IE IN=178.00 (12" N)
IE IN=176.00 (36" E)
SEE SHEET 2B-17
- ⑨ CONSTRUCT 5-1/2" THICK CONCRETE BUS SHELTER PAD FROM STA 231+49 TO STA 231+64
SEE SHEET R4 FOR SCORING DETAIL
- ⑩ JWC WATER VAULTS TO BE ADJUSTED PER SHEET U5 AND U5A.
- ⑪ STA 228+05.38, 18.00' LT
END CURB TAPER
SEE CURVE DATA ON SHEET 11
- ⑫ STA 32+97, 24.00 LT/RT
END STANDARD CURB
BEGIN CURB AND GUTTER
TRANSITION FROM 7" TO 6" CURB
BETWEEN STA 32+97 TO 33+07
SEE DETAIL SHEET 2B
- ⑬ NOTE NOT USED
- ⑭ ADJUST EXISTING WATER VALVE BOX TO FINISH GRADE.
- ⑮ CONSTRUCT PLANTED MEDIAN ISLAND. SEE PLAN DETAIL SHEET 2B-23, SEE SECTION DETAIL SHEET 2A-3, SEE LANDSCAPE PLAN SHEET R9.
- ⑯ STA 230+08.07, 18.00' RT
CONST TYPE "CG-3" INLET
W/ ALTERNATE TOP SECTION
TOP LID ELEV.=182.16
IE=178.12 (12" E, S)
SEE DETAIL SHEET 2B-6
- ⑰ STA 229+99.01, 18.00' RT
CONST TYPE "CG-3" INLET
W/ ALTERNATE TOP SECTION
TOP LID ELEV.=182.22
IE=178.22 (12" W)
SEE DETAIL SHEET 2B-6
- ⑱ CONSTRUCT CONCRETE MEDIAN ISLAND
SEE PLAN DETAIL SHEET 2B-23, SEE SECTION DETAIL SHEET 2A-3.

- ⑲ CONSTRUCT 6' WIDE PLAIN CONCRETE PAVEMENT BUS PAD, 8" THICK SECTION FROM STA 231+39.00 TO STA 231+99.00
- ⑳ CONSTRUCT CONCRETE TRANSITION SECTION AT EACH END OF PLAIN CONCRETE PAVEMENT BUS PAD.
- ㉑ CONTRACTOR TO COORDINATE WITH DEVELOPER OF RETAIL SITE TO ALLOW TEMPORARY CONSTRUCTION ACCESS AT THIS LOCATION IF PERMITTED BY ODOT.
- ㉒ PROTECT EXISTING UTILITY POLE TO REMAIN. LIGHT TO BE REMOVED BY OTHERS.

LEGEND:

- RIGHT-OF-WAY
- PUBLIC UTILITY EASEMENT
- TEMP. CONSTRUCTION EASEMENT
- c- CUT SLOPE
- f- FILL SLOPE

REMOVE EXTG. INLET OR MANHOLE SHOWN THUS:

REMOVE EXTG. PIPE SHOWN THUS:

AC DRIVEWAY



CURB RETURN TABLE

CURVE	STATION/OFFSET	SYMBOL Δ / 4	T.O.C. ELEV.
1 Δ = 89°50'59" R = 35.00' L = 54.89'	BCR 231+28.10, 18.00' LT	A	181.49
		B	181.59
		C	181.28
		D	181.05
	ECR 33+07.35, 24.00' LT	E	180.89
2 Δ = 90°09'01" R = 35.00' L = 55.07'	BCR 33+07.04, 24.00' RT	F	180.88
		G	181.11
		H	181.52
		I	181.93
	ECR 230+10.10, 18.00' LT	J	182.13
3 Δ = 30°03'22" R = 75.00' L = 39.34'	BCR 231+74.22, 26.00' RT	K	182.08
		L	182.19
		M	182.34
		N	182.47
	PCC 231+36.77, 36.20' RT	O	182.54
4 Δ = 141°12'13" R = 13.00' L = 32.04'	PCC 231+36.77, 36.20' RT	O	182.54
		P	182.62
		Q	182.78
		R	182.94
	ECR 131+44.11, 14.00' LT	S	183.01

"B" LINE
CURVE TABLE

A
L=8.67 R=3500.00 Δ=00°08'31"
B
L=163.39 R=1500.00 Δ=6°14'27"

W.Q. SWALE AND DETENTION POND PLANTING PLAN

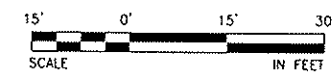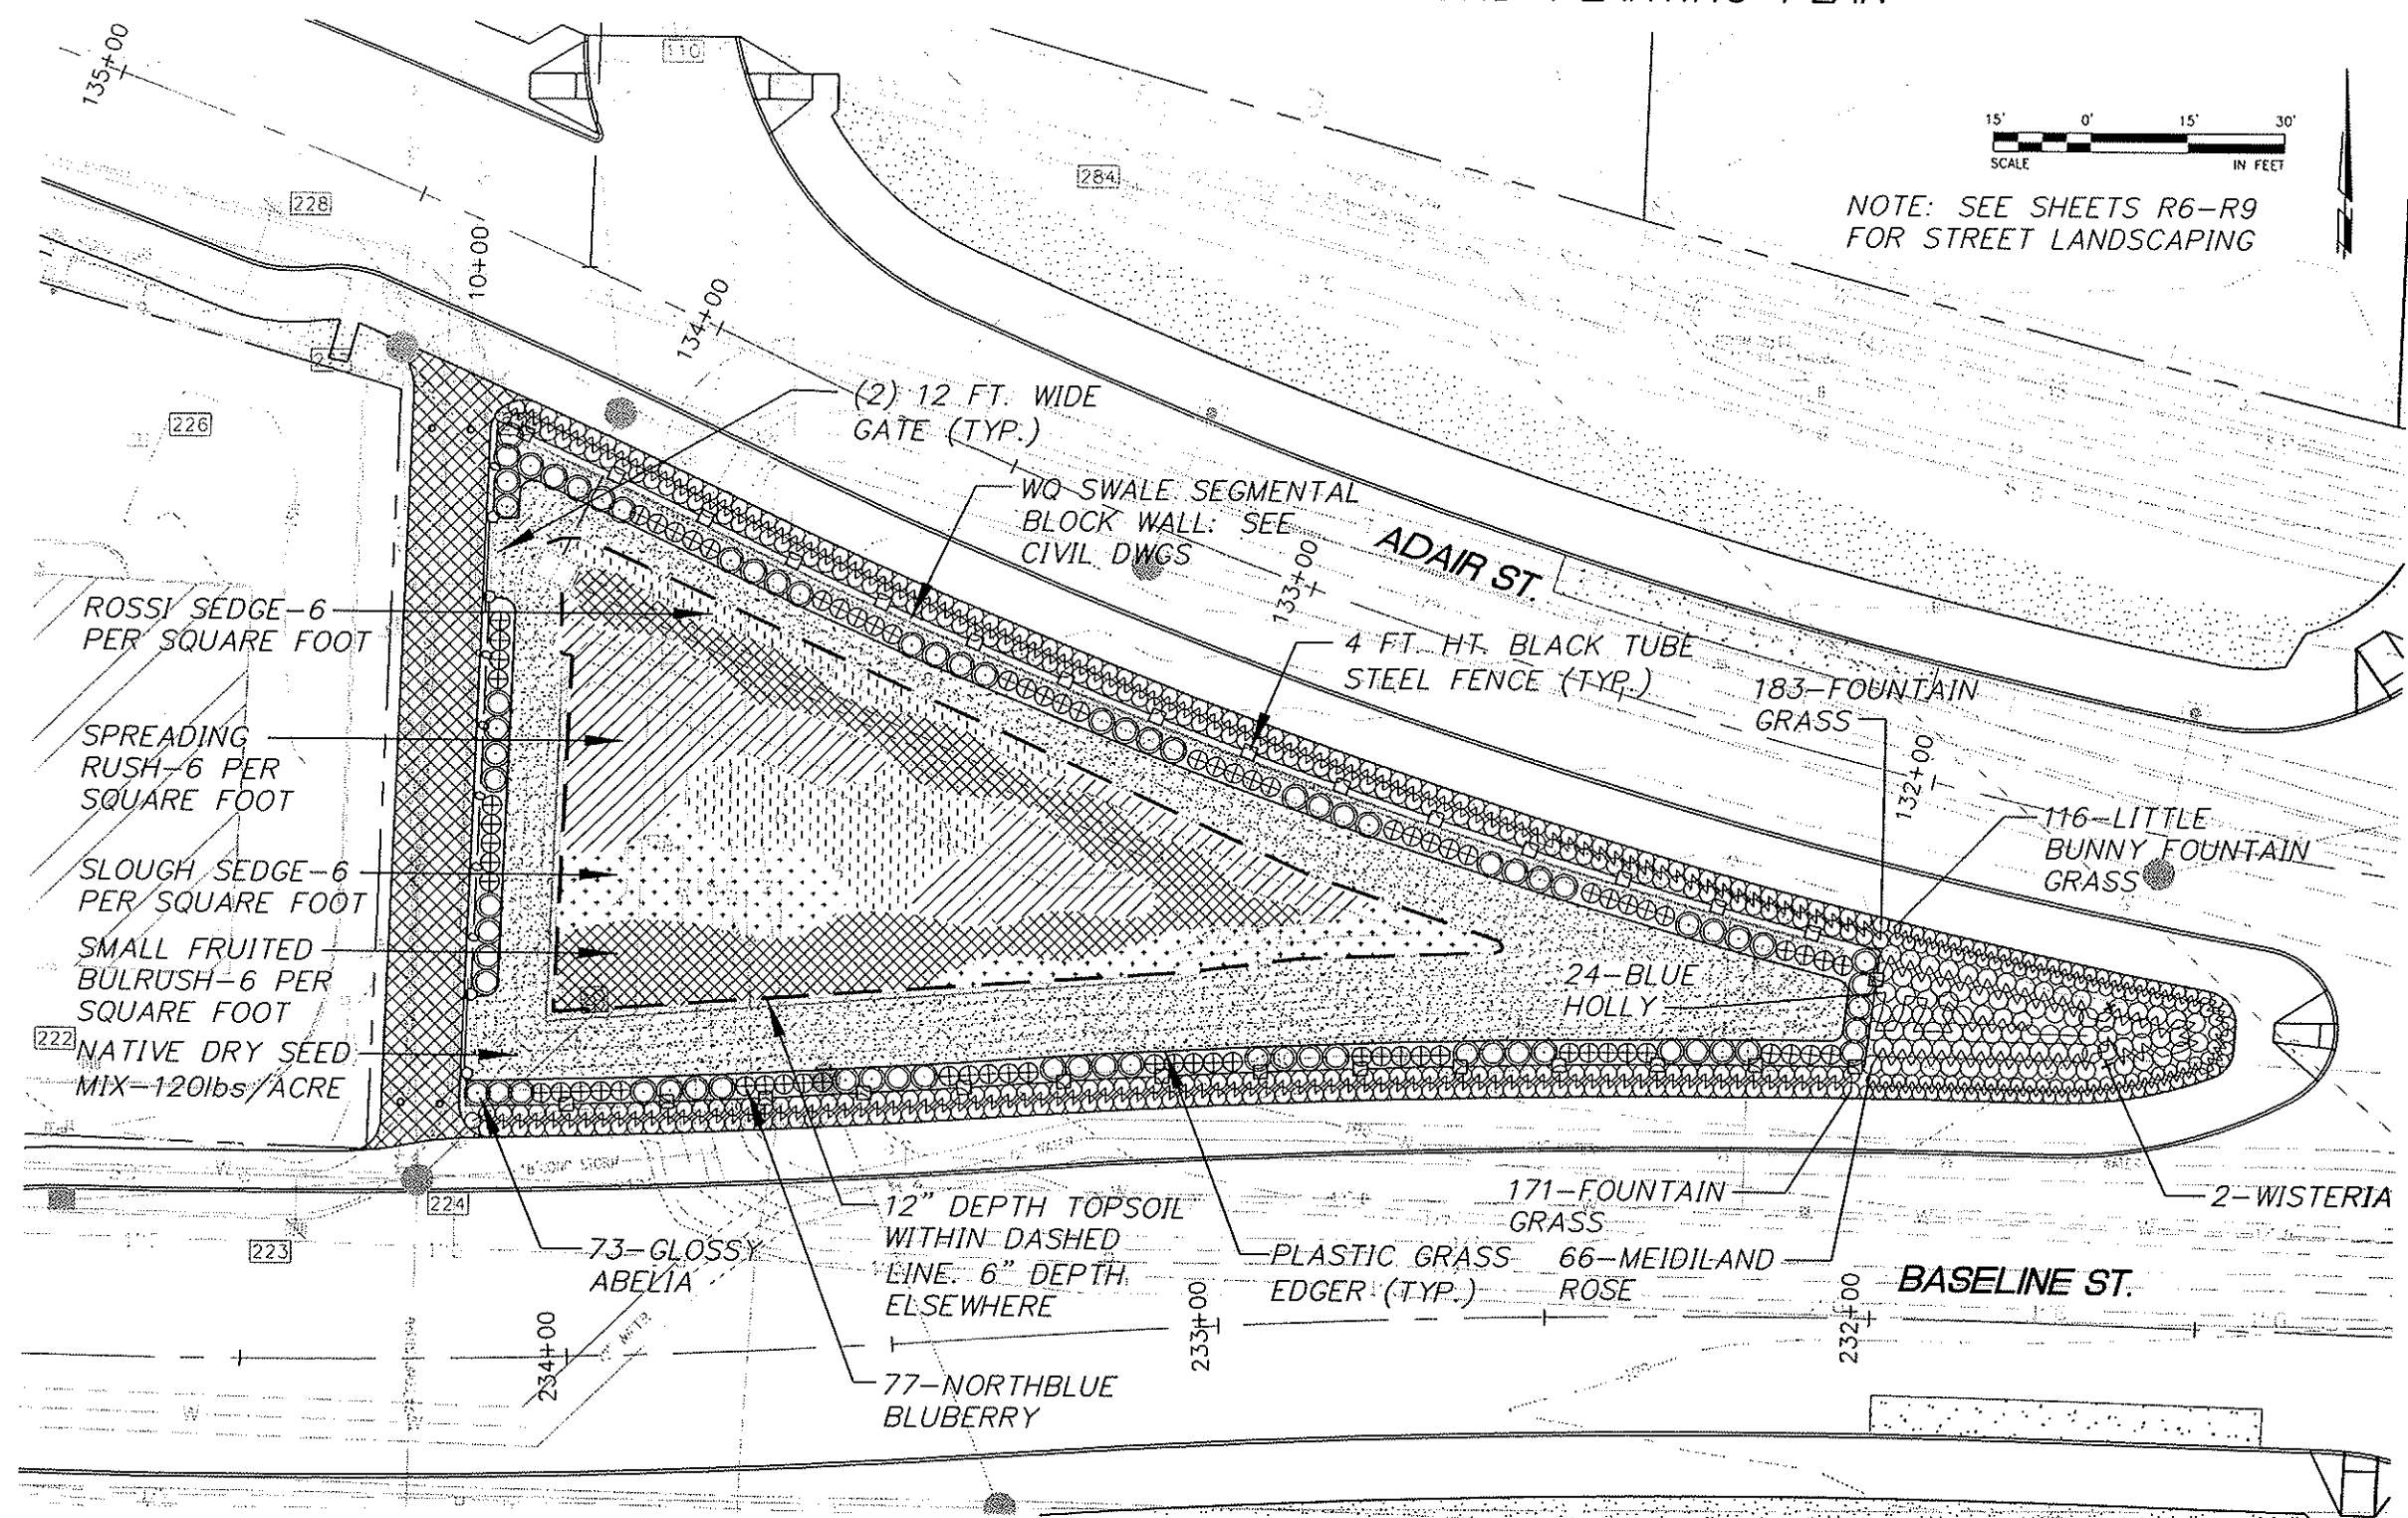

NOTE: SEE SHEETS R6-R9 FOR STREET LANDSCAPING

- ROSSI SEDGE-6 PER SQUARE FOOT
- SPREADING RUSH-6 PER SQUARE FOOT
- SLOUGH SEDGE-6 PER SQUARE FOOT
- SMALL FRUITED BULRUSH-6 PER SQUARE FOOT
- NATIVE DRY SEED MIX-120lbs/ACRE

LEGEND:


- EXISTING CONTOUR
- - - PROPOSED CONTOUR
- 0 — 4' HT. SECURITY FENCE
- ▨ MODULAR BLOCK WALL

NOTE: SEE SHEET R4 AND R5 FOR PLANT SCHEDULE



PROJECT NUMBER
100017

WASHINGTON COUNTY
DEPARTMENT OF
LAND USE AND
TRANSPORTATION

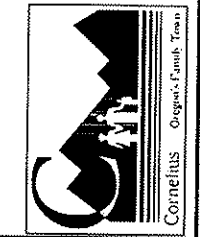

DWG. NO.	REVISIONS

"As Constructed"
DATE 11/6/06 BY [Signature]

N. 19TH AND S. 20TH AVE REALIGNMENT
INCLUDING BASELINE ST, ADAIR ST, AND T.V. HWY
WASHINGTON COUNTY AND CITY OF CORNELIUS
W.Q. SWALE AND DETENTION POND PLANTING PLAN

otak
Incorporated
700 Washington Street
Suite 401
Vancouver, WA 98660-3139
Phone: (360) 737-9813
FAX: (360) 737-9651

	BY	DATE
DRWN:	DH	7/05
DSGN:	DH	7/05
CHKD:	PKW	7/05

REGISTERED
263
DAVID D. HAYNES
OREGON
LANDSCAPE ARCHITECT

WATER QUALITY SWALE AND DETENTION POND

PLANT SCHEDULE

WATER QUALITY SWALE



PROJECT NUMBER
100017

WASHINGTON COUNTY
DEPARTMENT OF
LAND USE AND
TRANSPORTATION



SYM	BOTANICAL NAME	COMMON NAME	SIZE & DESCRIP	SPACING	GRADE & CLASS	TOTAL
⊙	Shrubs: Abelia grandiflora 'Sherwoodii'	'Sherwood Glossy Abelia	5 Gal. Container	As Shown	2.2.3 Type 2	73
⊕	Northblue Blueberry	Northblue Blueberry	5 Gal. Container	"	8.2.6	77
	Emergent Wetland Plants: - Scirpus microcarpus	- Small-Fruited Bulrush	6 in. ht., 9 cu. in. - Styro-bloc Plugs	6 per s.f.	12.1.3	5,150
	- Juncus patens	- Spreading Rush	"	"	"	9,490
	- Carex obnupta	- Slough Sedge	"	"	"	6,250
	- Carex rossi	- Rossi Sedge	"	"	"	5,770
	Native Dry Seed Mix: above elev. 175.00; - Festuca arundinacea 'Nana': 40% - Lolium perenne: 30% - Festuca rubra: 25% - Agrostis capillaris: 5%	- Dwarf Tall Fescue - Dwarf Perennial Ryegrass - Creeping Red Fescue - Colonial Bentgrass	Area = 0.14 AC. Application Rate = 120 lbs per acre	- - - -	- - - -	- - - -

DWG. NO.	REVISIONS


"As Constructed"
DATE 11/6/06 BY [Signature]

N. 19TH AND S. 20TH AVE REALIGNMENT
INCLUDING BASELINE ST, ADAIR ST, AND T.V. HWY
WASHINGTON COUNTY AND CITY OF CORNELIUS

PLANT SCHEDULE

otak
Incorporated
700 Washington Street
Suite 401
Vancouver, WA 98660-2139
Phone: (360) 737-9613
FAX: (360) 737-9651

BY	DATE
DRWN: DH	7/05
DSGN: DH	7/05
CHKD: PKW	7/05

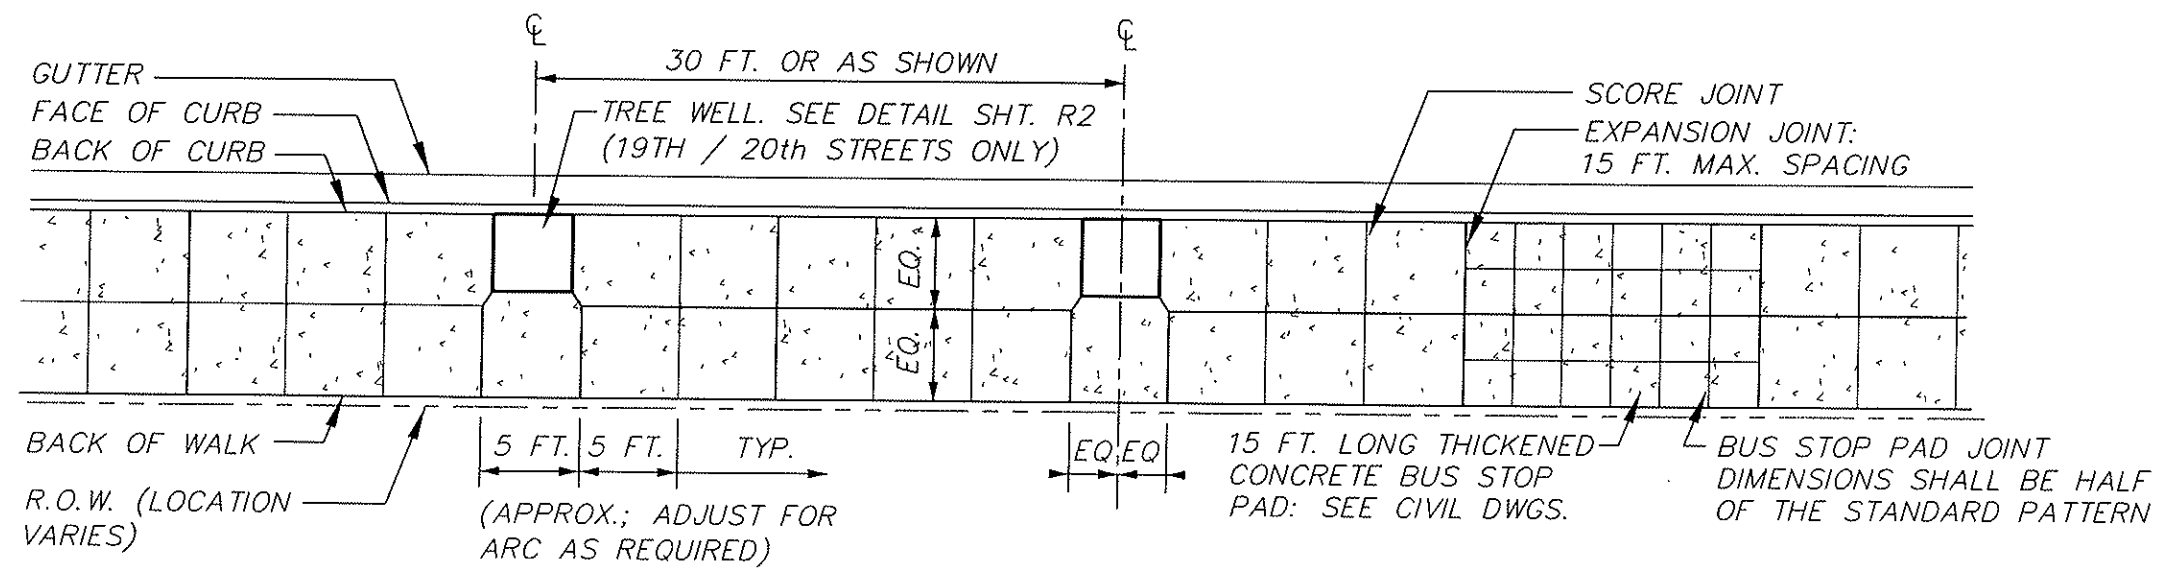

SIDEWALK JOINT DETAIL - NOTE: TREE WELLS ON 19th / 20th STREETS ONLY
SCALE: 1"=10'

REGISTERED
263
DAVID D. HAYNES
OREGON
LANDSCAPE ARCHITECT

Sec. 3, T. 1S, R. 3W, W.M.
 Sec. 34, T. 1N, R. 3W, W.M.



PROJECT NUMBER
 100017

WASHINGTON COUNTY
 OREGON
 DEPARTMENT OF
 LAND USE AND
 TRANSPORTATION



DWG. NO.	REVISIONS

"As Constructed"
 DATE 11/6/06 BY [Signature]
 N. 19TH AND S. 20TH AVE REALIGNMENT
 INCLUDING BASELINE ST, ADAIR ST, AND T.V. HWY
 WASHINGTON COUNTY AND CITY OF CORNELIUS

WATER PLAN


	BY	DATE
DRWN:	GE	7/05
DSGN:	GE	7/05
CHKD:	PW	7/05

otak
 Incorporated
 700 Washington Street
 Suite 401
 Vancouver, WA 98660-3139
 Phone: (360) 737-5813
 FAX: (360) 737-0651



EXPIRES: 6/30/08

SHEET TITLE: U4A SHEET NO. 130 OF 140

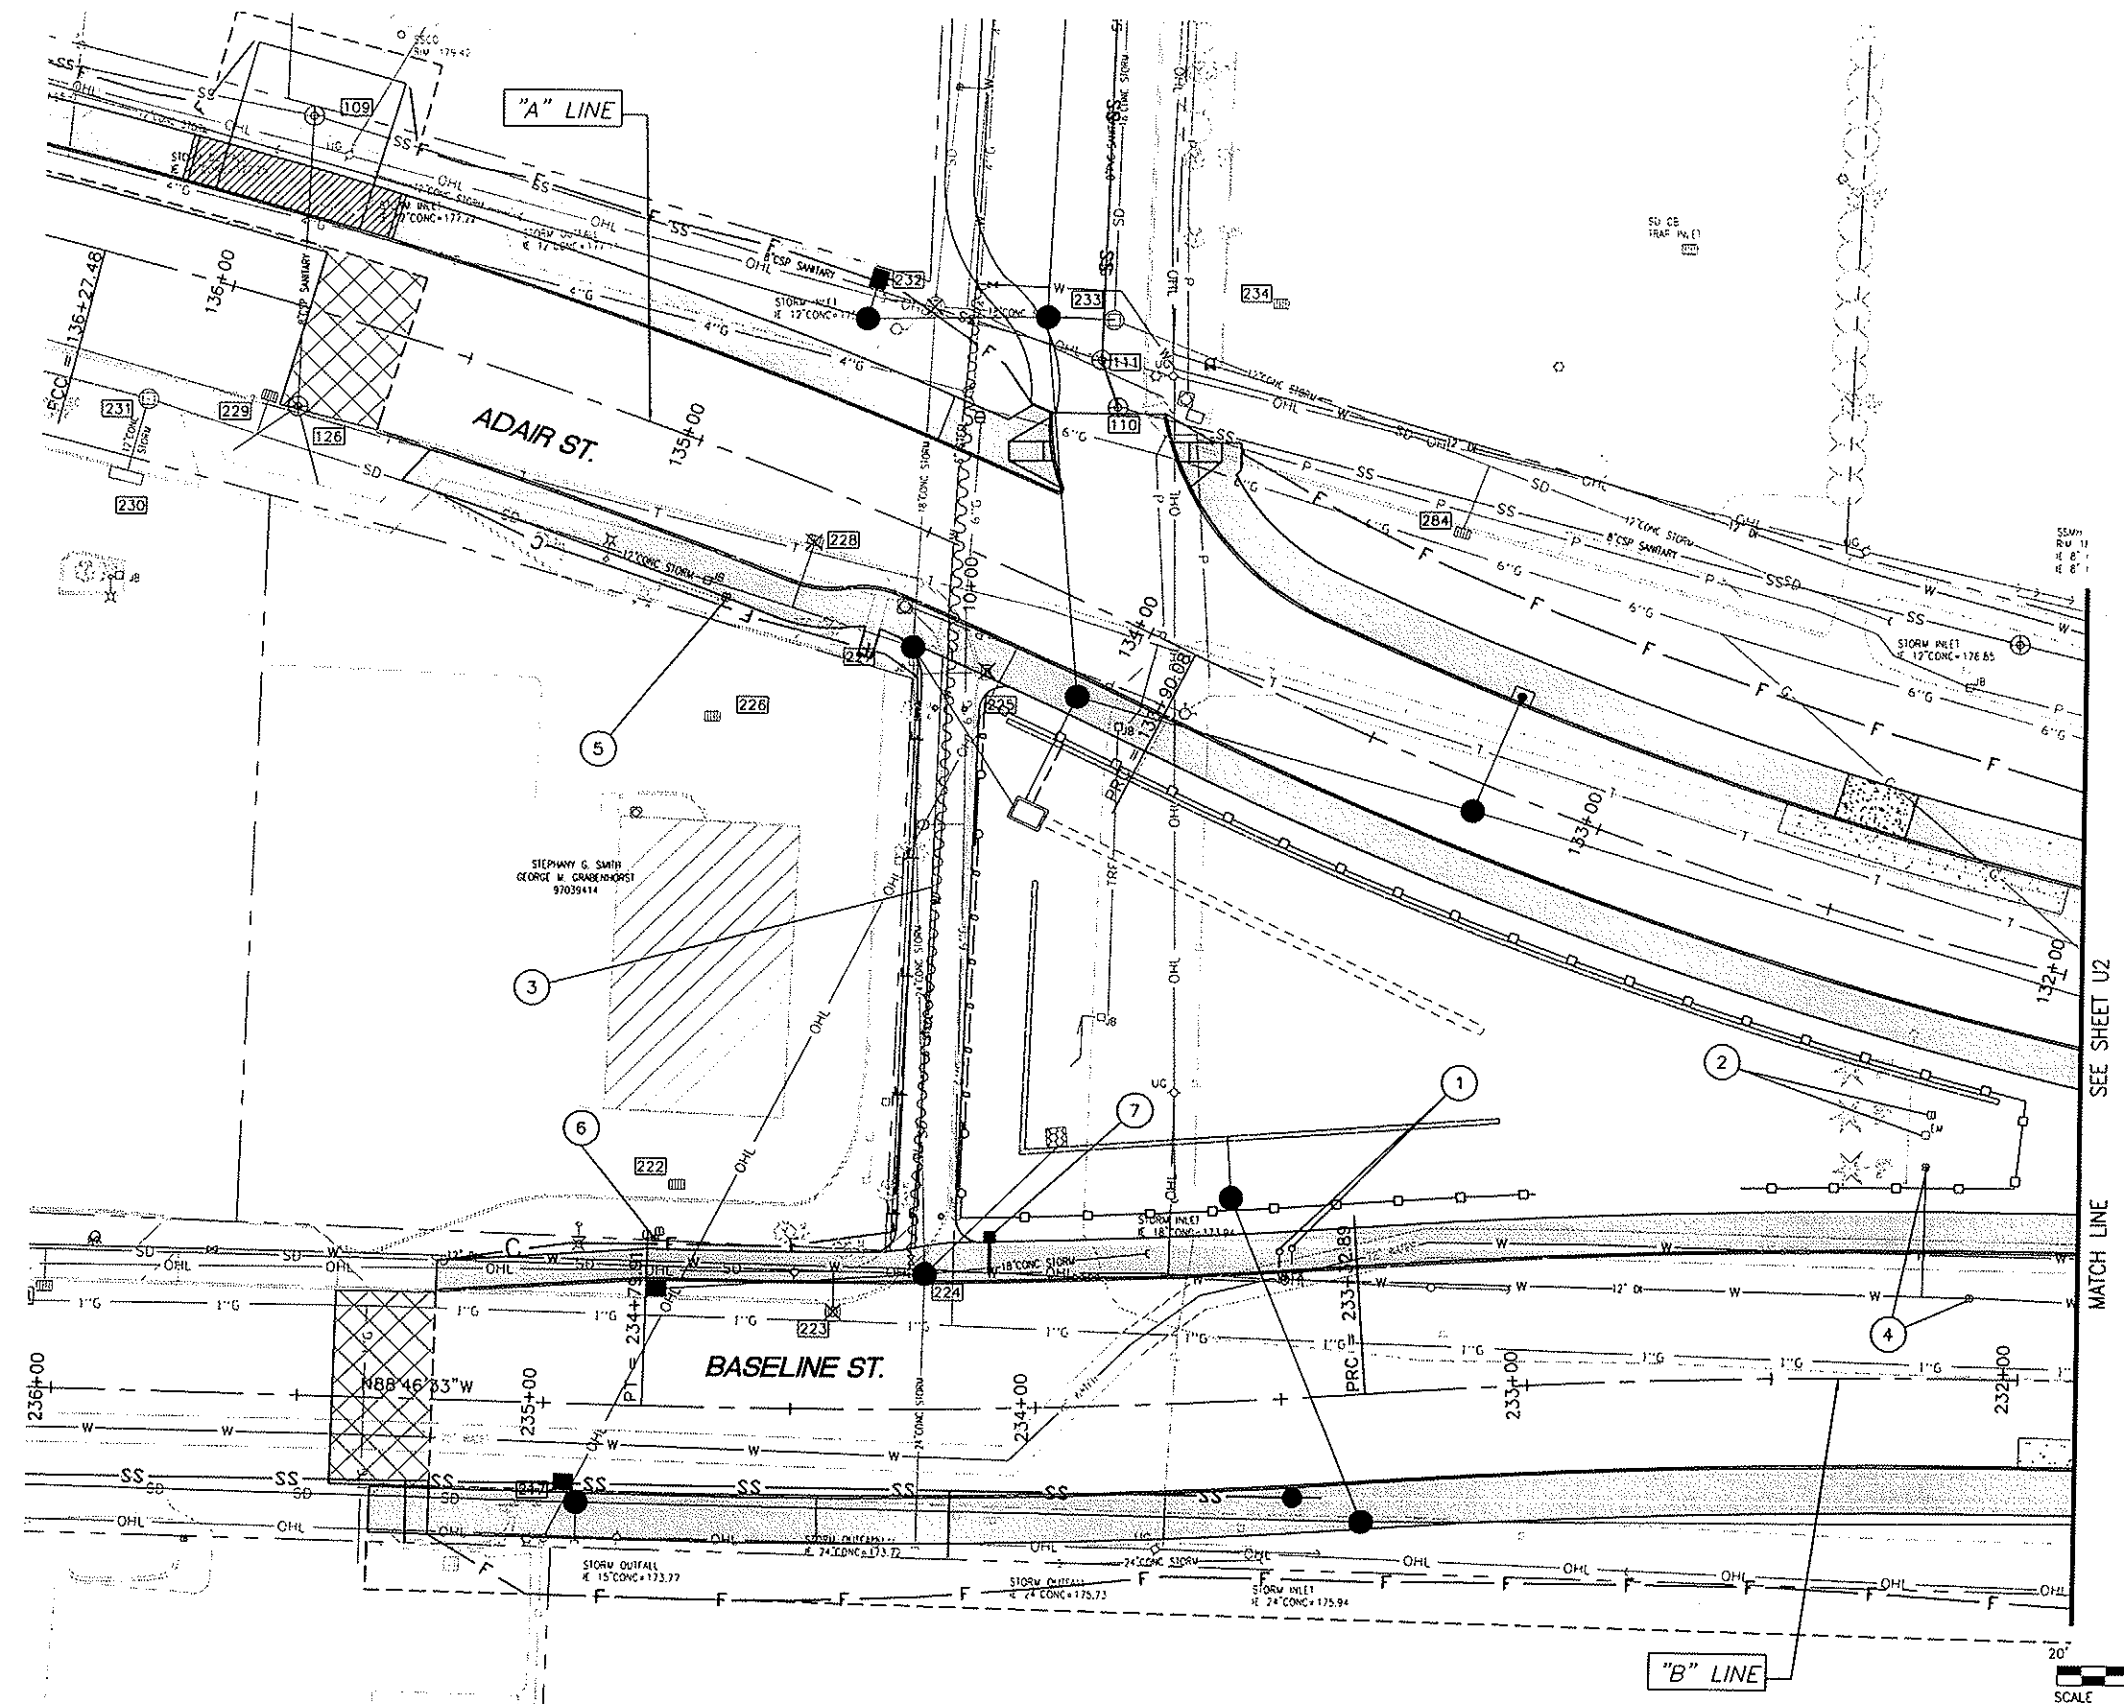

- GENERAL NOTES**
- ALL WATERLINE JOINTS AND FITTINGS SHALL BE RESTRAINED.
 - SEE SHEET 1D FOR EXISTING STRUCTURE INFORMATION.
 - SEE SHEET 2B-9 FOR COC WATER SYSTEM DETAILS.





CONSTRUCTION NOTES


THIS SHEET FACES SHEET U5A

LEGEND:


- RIGHT-OF-WAY
- PUBLIC UTILITY EASEMENT
- TEMP. CONSTRUCTION EASEMENT
- c- CUT SLOPE
- f- FILL SLOPE

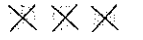REMOVE EXTG. INLET OR MANHOLE SHOWN THUS: 

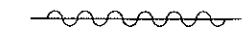REMOVE EXTG. PIPE SHOWN THUS: 

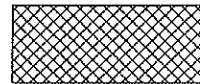
 AC DRIVEWAY

- ① STA 129+80, 44' RT±
REMOVE AND RELOCATE EXISTING FIRE HYDRANT.
SEE DETAIL "K," THIS SHEET.
- ② STA 126+96, 40' RT±
FURNISH AND INSTALL 1-FH ASSEMBLY, PER DETAIL
"L," THIS SHEET.
- ③ STA 128+67, 26' LT±
REMOVE AND REPLACE VAULT LID. SEE DETAIL "D"
SHEET 2B-15.
- ④ RELOCATE JWC AIR RELEASE AND AIR VACUUM VALVE
ASSEMBLY VAULT TO MEDIAN. SEE DETAIL "C" THIS
SHEET AND SHEET 2B-13.
- ⑤ STA 227+99, 30' LT±
RESET EXISTING FH ASSEMBLY BEHIND WALK, PER
COC DETAIL NO WA-4, SHEET 2B-9.
- ⑥ PROTECT EXISTING METER BOX.
- ⑦ PROTECT EXISTING METER VALVE.
- ⑧ PROTECT EXISTING BLOWOFF ASSEMBLY.
- ⑨ PROTECT EXISTING IRRIGATION CONTROL VALVES.

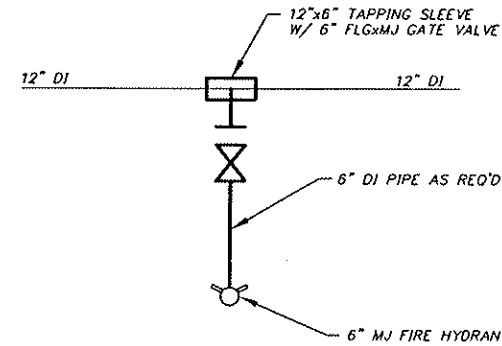


NOTE: ALL MJ FITTINGS SHALL BE RESTRAINED

DETAIL "L"
N.T.S.

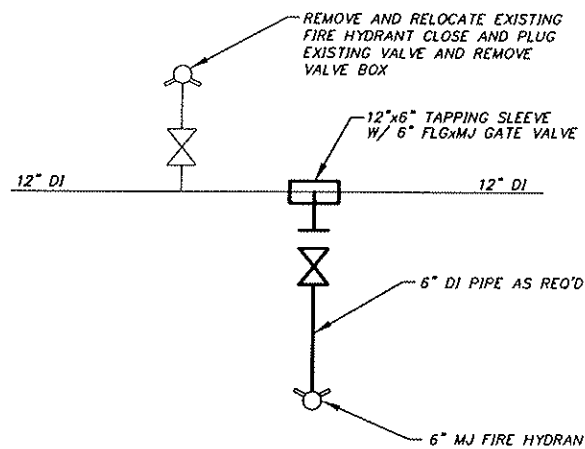

NOTE: ALL MJ FITTINGS SHALL BE RESTRAINED

DETAIL "K"
N.T.S.

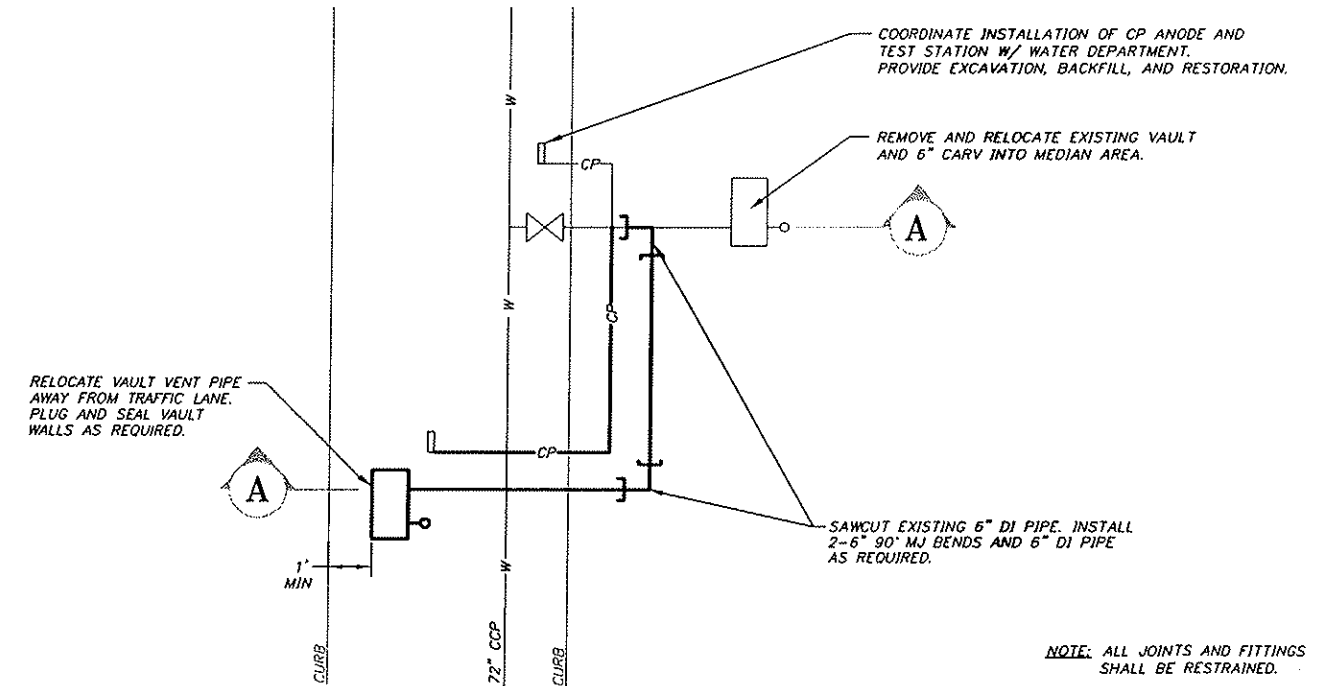


NOTE: ALL JOINTS AND FITTINGS SHALL BE RESTRAINED.
MAINTAIN 1% SLOPE ON 6" DI PIPE FROM GATE VALVE TO 6" CARV.

SECTION 'A-A' (SEE SHEET 2B-13)

DETAIL "C"
N.T.S.

PROJECT NUMBER
100017

WASHINGTON COUNTY
DEPARTMENT OF
LAND USE AND
TRANSPORTATION

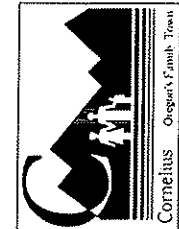

DWG. NO.	REVISIONS

N. 19TH AND S. 20TH AVE REALIGNMENT
INCLUDING BASELINE ST, ADAIR ST, AND T.V. HWY
WASHINGTON COUNTY AND CITY OF CORNELIUS


WATER PLAN NOTES

"As Constructed"
DATE 11/6/06 BY [Signature]



Incorporated
700 Washington Street
Suite 401
Vancouver, WA 98680-3139
Phone: (360) 737-9813
FAX: (360) 737-9851

DATE	BY
DRWN: 7/05	GE
DSGN: 7/05	GE
CHKD: 7/05	PW

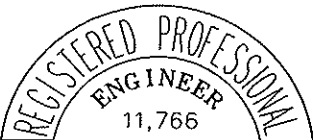

EXPIRES: 6/30/08

SHEET TITLE: U5 SHEET NO.: 131 OF 140