

OPERATION & MAINTENANCE MANUAL

DFI No. : D00131

**Facility Type: Detention Pond/Water
Quality Biofiltration Swale Combo**



JUNE, 2011

INDEX

1. IDENTIFICATION..... 1

2. FACILITY CONTACT INFORMATION..... 1

3. CONSTRUCTION..... 1

4. STORM DRAIN SYSTEM AND FACILITY OVERVIEW 2

5. FACILITY HAZ MAT SPILL FEATURE(S)..... 4

6. AUXILIARY OUTLET (HIGH FLOW BYPASS)..... 6

7. MAINTENANCE REQUIREMENTS..... 6

8. WASTE MATERIAL HANDLING..... 7

APPENDIX A: Operational Plan and Profile Drawing(s)

APPENDIX B: ODOT Project Plan Sheets

1. Identification

Drainage Facility ID (DFI): **D00131**

Facility Type: Detention pond/water quality biofiltration swale combo

Construction Drawings: (V-File Number) 39V-058

Location: District: 2B (Old 2A)
Highway No.: 064
Mile Post: 6.21/6.29(beg./end)

Description: This facility is located in the median of I-205 (Hwy 64) just west of the 10th Street Interchange near West Linn, Oregon. Access is obtained from the shoulder areas of I-205 (Hwy 64).

2. Facility Contact Information

Contact the Engineer of Record, Region Technical Center, or Geo-Environmental's Senior Hydraulics Engineer for:

- Operational clarification
- Maintenance clarification
- Repair or restoration assistance

Engineering Contacts:

Region Technical Center Hydro Unit Manager

Or

Geo-Environmental Senior Hydraulics Engineer (503) 986-3365.

3. Construction

Engineer of Record: Consultant Designer – OBEC Consultant Engineers, Jerome D. Lane, 503-589-4100

Facility construction: 2006
Contractor: Oregon Mainline Paving, LLC

4. Storm Drain System and Facility Overview

A detention pond/water quality biofiltration swale combo (referred to from this point forward as a pond/swale combo) combines the forms and functions of a water quality swale and a detention pond. In a pond/swale combo, the biofiltration swale is situated within the bottom confines of the detention facility. The facility provides water quality treatment of the smaller storm events and detention of the larger storm events.

The biofiltration swale is designed as if it was a separate facility and consists of a grassy-lined facility with a flat trapezoidal cross section and gradual slope. Treatment is provided through sedimentation and filtration processes. If amended soils are present, additional treatment is obtained through infiltration through the amended soil media.

When the flows exceed the water quality flows, the pond/swale combo facility begins to provide detention. Detention is required to reduce or mitigate the increases in discharge, resulting from development. The facility is designed to store and gradually release (or attenuate) stormwater runoff via a control structure or release mechanism, then releasing it slowly over a more extended period of time. The flow control mechanism for this facility involves a 4-inch orifice surrounded by a wirecloth strainer assembly. When flows exceed the water quality design flow, the orifice restricts the flow causing the water to backup within the facility.

This particular facility is located in the median area of I-205 (Hwy 64), just west of the I-205 (Hwy 64) and 10th Street Interchange near West Linn, Oregon. An access driveway is located along the left shoulder of northbound I-205 (Hwy 64), approximately 1/10th mile prior to the 10th Street Interchange.

Highway runoff in the form of sheet flow is conveyed to the facility. Stormwater is both treated and detained in the facility as necessary while it flows eastward toward an outlet control structure before being redirected to the south via a 15-inch pipe. The water is finally conveyed to an outfall and a nearby waterway adjacent to the northbound off ramp; see Point C, on the Operational Plan, Appendix A. The outlet control structure itself (Point B on the Operational Plans) contains a 3-inch orifice which controls the flow of water, being released from the facility – and detains higher flows unable to pass through the orifice until the peak rainfall/flow event passes.

A. Maintenance equipment access:

An access driveway and parking area is located along the left shoulder of northbound I-205 (Hwy 64), approximately 1/10th mile prior to the 10th Street overpass.

B. Heavy equipment access into facility:

- Allowed (no limitations)
- Allowed (with limitations)
- Not allowed

C. Special Features:

- Amended Soils
- Porous Pavers
- Liners
- Underdrains

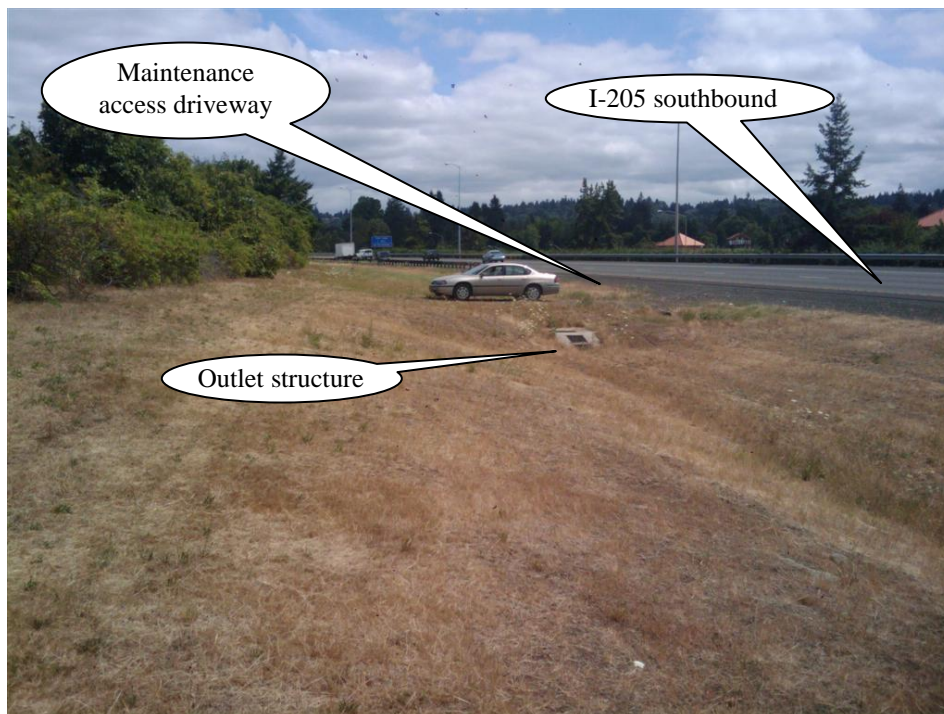


Photo 1: Looking east at the facility outlet and access driveway.



Photo 2: Looking west toward the facility entrance and northbound I-205.

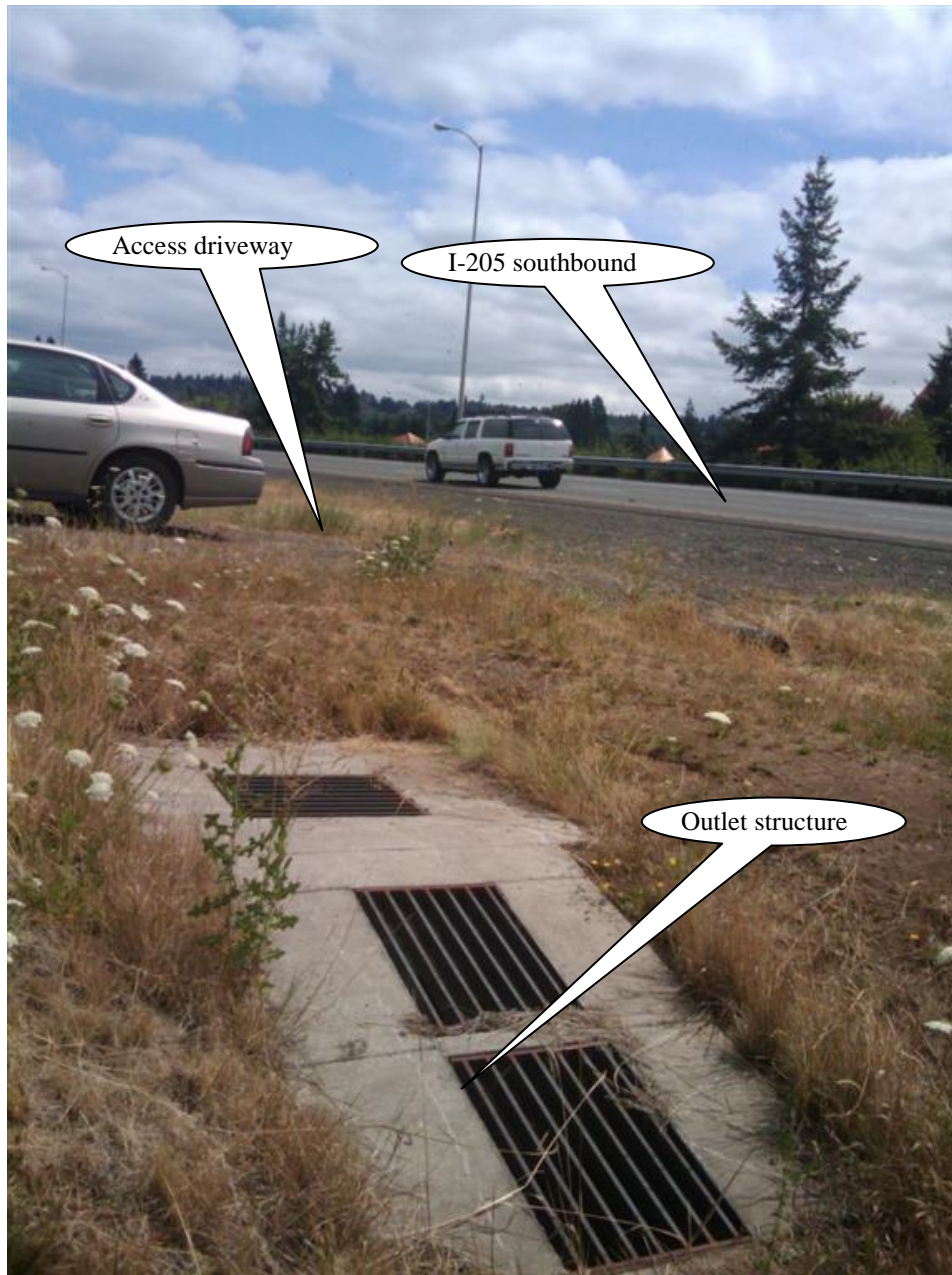


Photo 3: Looking east at the outlet structure and access driveway.

5. Facility Haz Mat Spill Feature(s)

The detention pond/water quality biofiltration swale combo can be used to store a volume of liquid by blocking the 15-inch diameter outlet pipe located at the outlet of the detention pond/water quality swale combo. This pipe is noted as Point C on Operational Plan in Appendix A.

6. Auxiliary Outlet (High Flow Bypass)

Auxiliary Outlets are provided if the primary outlet control structure can not safely pass the projected high flows. Broad-crested spillway weirs and over flow risers are the two most common auxiliary outlets used in stormwater treatment facility design. The auxiliary outlet feature is either a part of the facility or an additional storm drain feature/structure.

The auxiliary outlet feature for this facility is:

Designed into facility

The outlet control structure has a pair of grated inlets positioned above the main inlet, so that in the case of high flows, during a peak rainfall event, water will flow into either of the upper grated inlet/outlets and exit out of a 15-inch outlet pipe found within the main structure (Point B on the Operational Plan).

Other, as noted below

7. Maintenance Requirements

Routine maintenance table for non-proprietary stormwater treatment and storage/detention facilities have been incorporated into ODOT's Maintenance Guide. These tables summarize the maintenance requirements for ponds, swales, filter strips, bioslopes, and detention tanks and vaults. Special maintenance requirements in addition to the routine requirements are noted below when applicable.

The ODOT Maintenance Guide can be viewed at the following website:
<http://www.oregon.gov/ODOT/HWY/OOM/MGuide.shtml>

Maintenance requirements for proprietary structures, such as underground water quality manholes and/or vaults with filter media are noted in Appendix C when applicable.

The following stormwater facility maintenance table (See ODOT Maintenance Guide) should be used to maintain the facility outlined in this Operation and Maintenance Manual or follow the Maintenance requirements outlined in Appendix C when proprietary structure is selected below:

- Table 1 (general maintenance)
- Table 2 (stormwater ponds)
- Table 3 (water quality biofiltration swales)
- Table 4 (water quality filter strips)
- Table 5 (water quality bioslopes)
- Table 6 (detention tank)

- Table 7 (detention vault)
- Appendix C (proprietary structure)
- Special Maintenance requirements:

Note: Special maintenance Requirements Require Concurrence from ODOT SR Hydraulics Engineer.

8. Waste Material Handling

Material removed from the facility is defined as waste by DEQ. Refer to the roadwaste section of the ODOT Maintenance Yard Environmental Management System (EMS) Policy and Procedures Manual for disposal options: <http://egov.oregon.gov/ODOT/HWY/OOM/EMS.shtml>


Contact any of the following for more detailed information about management of waste materials found on site:

ODOT Clean Water Unit	(503) 986-3008
ODOT Statewide Hazmat Coordinator	(503) 229-5129
ODOT Region Hazmat Coordinator	(503) 731-8304
ODEQ Northwest Region Office	(503) 229-5263

Appendix A

Content:

- **Operational Plan and Profile Drawing(s)**

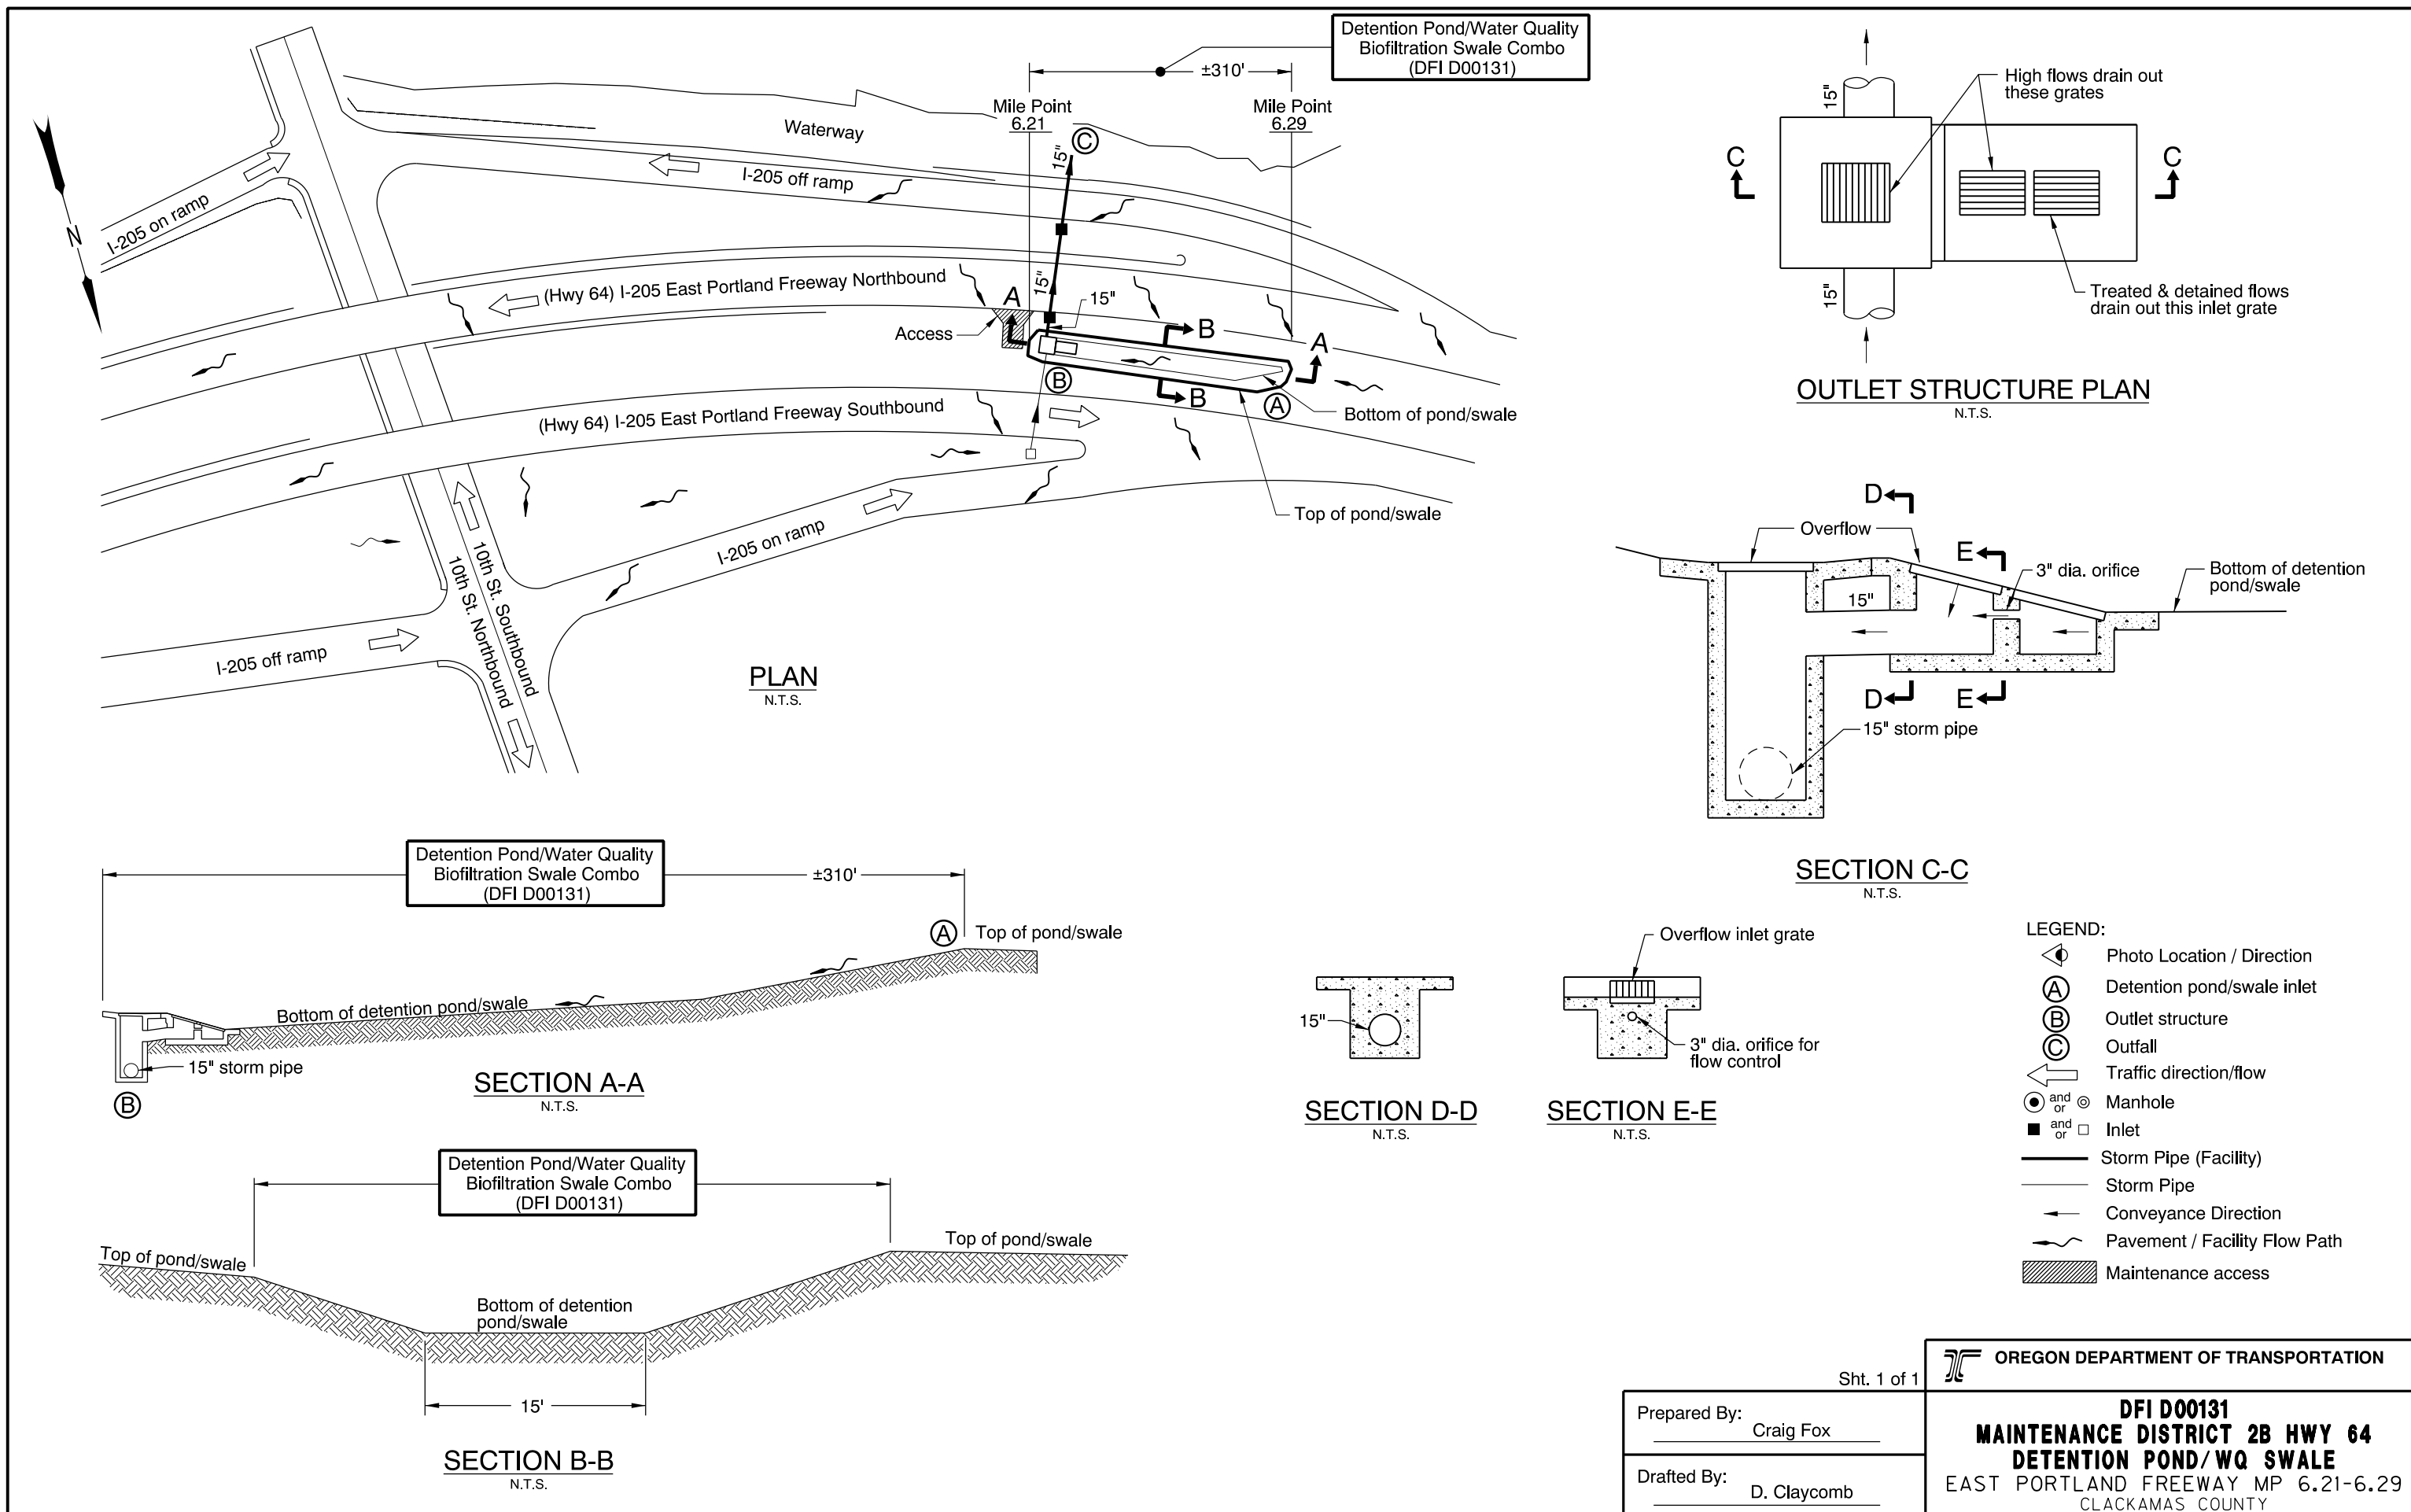

Detention Pond/Water Quality Biofiltration Swale Combo (DFI D00131)

OUTLET STRUCTURE PLAN

N.T.S.

SECTION C-C

N.T.S.

SECTION A-A

N.T.S.

Detention Pond/Water Quality Biofiltration Swale Combo (DFI D00131)

SECTION B-B

N.T.S.

SECTION D-D

N.T.S.

SECTION E-E

N.T.S.

- LEGEND:**
- Photo Location / Direction
 - Detention pond/swale inlet
 - Outlet structure
 - Outfall
 - Traffic direction/flow
 - Manhole
 - Inlet
 - Storm Pipe (Facility)
 - Storm Pipe
 - Conveyance Direction
 - Pavement / Facility Flow Path
 - Maintenance access

Sht. 1 of 1

OREGON DEPARTMENT OF TRANSPORTATION

Prepared By: Craig Fox

Drafted By: D. Claycomb

DFI D00131
MAINTENANCE DISTRICT 2B HWY 64
DETENTION POND/WQ SWALE
 EAST PORTLAND FREEWAY MP 6.21-6.29
 CLACKAMAS COUNTY

Appendix B


Content:

- **ODOT Project Plan Sheets**
 - *Cover/Title Sheet*
 - *Water Quality/Detention Plan Sheets*
 - *Other Details*

INDEX OF SHEETS	
SHEET NO.	DESCRIPTION
1	Title Sheet
1A, 1B	Index Of Sheets Cont'd.
1C	Std. Drg. Nos.

STATE OF OREGON
 DEPARTMENT OF TRANSPORTATION
 PLANS FOR PROPOSED PROJECT
GRADING, DRAINAGE, STRUCTURES, PAVING, SIGNING & ILLUMINATION

**I-205: WILLAMETTE RIVER BR. -
 PACIFIC HWY. (UNIT 3) SEC.
 EAST PORTLAND FREEWAY
 CLACKAMAS & WASHINGTON COUNTIES
 APRIL 2006**

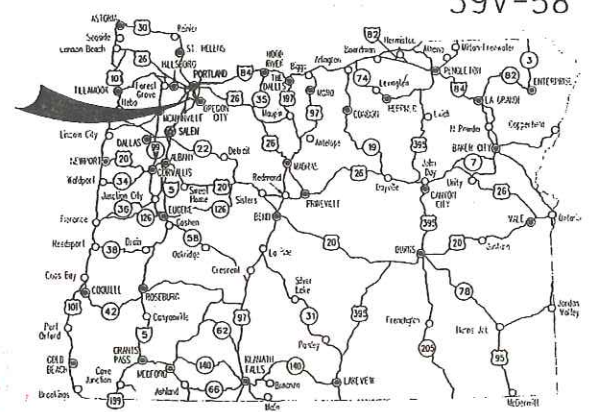


Overall Length Of Project - 8.90 Miles

"AS CONSTRUCTED"
Matthew Nelson
 Date 6/26/09 Project Mgr

ATTENTION:
 Oregon Law Requires You To Follow Rules Adopted By The Oregon Utility Notification Center. Those Rules Are Set Forth In OAR 952-001-0010 Through OAR 952-001-0090. You May Obtain Copies Of The Rules By Calling The Center. (Note: The Telephone Number For The Oregon Utility Center Is (503) 232-1987.)

**END OF PROJECT IM-OTIA-S064(032)
 STA. "LS2" 1231+71.15 (M.P. -0.10)**

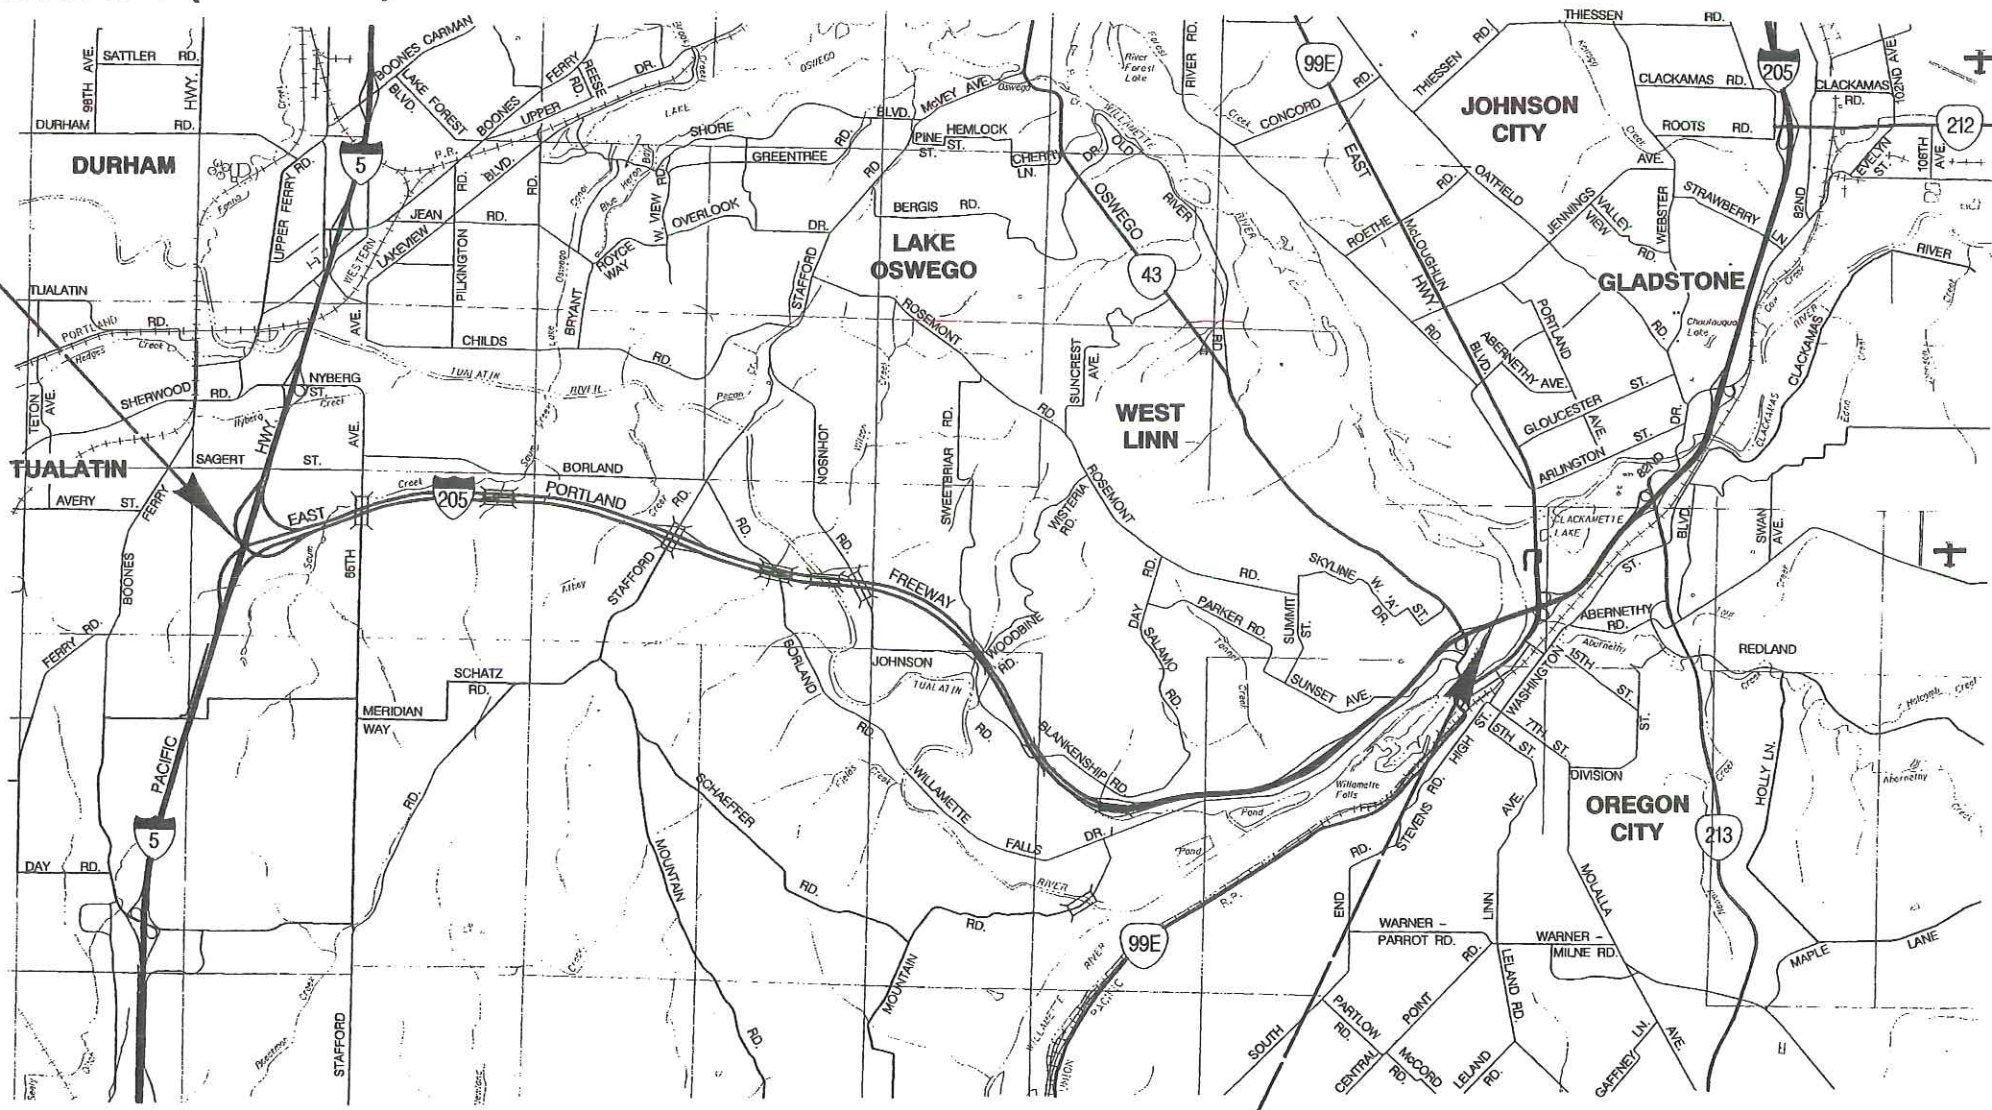

LET'S ALL
 WORK TOGETHER
 TO MAKE THIS
 JOB SAFE

- OREGON TRANSPORTATION COMMISSION**
- Stuart Foster CHAIRMAN
 - Gail L. Achterman COMMISSIONER
 - Mike Nelson COMMISSIONER
 - Randall Papé COMMISSIONER
 - Janice J. Wilson COMMISSIONER
 - Matthew Garrett DIRECTOR OF TRANSPORTATION



EXPIRES: 12/31/07

LAWRENCE H. FOX
 OBEC CONSULTING ENGINEERS - PROJECT MANAGER

OREGON DEPARTMENT OF TRANSPORTATION
 CONCURRENCE
Harold E. Suley 2/23/06
 TECHNICAL SERVICES MANAGING ENGINEER DATE

**I-205: WILLAMETTE RIVER BR. -
 PACIFIC HWY. (UNIT 3) SEC.
 EAST PORTLAND FREEWAY
 CLACKAMAS & WASHINGTON COUNTIES**


FEDERAL HIGHWAY ADMINISTRATION	PROJECT NUMBER	SHEET NO.
OREGON DIVISION	IM-OTIA-S064(032)	1



T. 2 S., R. 1 W.,
 R. 1 E. & R. 2 E., W.M.

**BEGINNING OF PROJECT IM-OTIA-S064(032)
 STA. "L" 735+41.85 (M.P. 8.80)**

Sec. 35, T.2 S., R. 1 E., W.M. (WEST LINN)

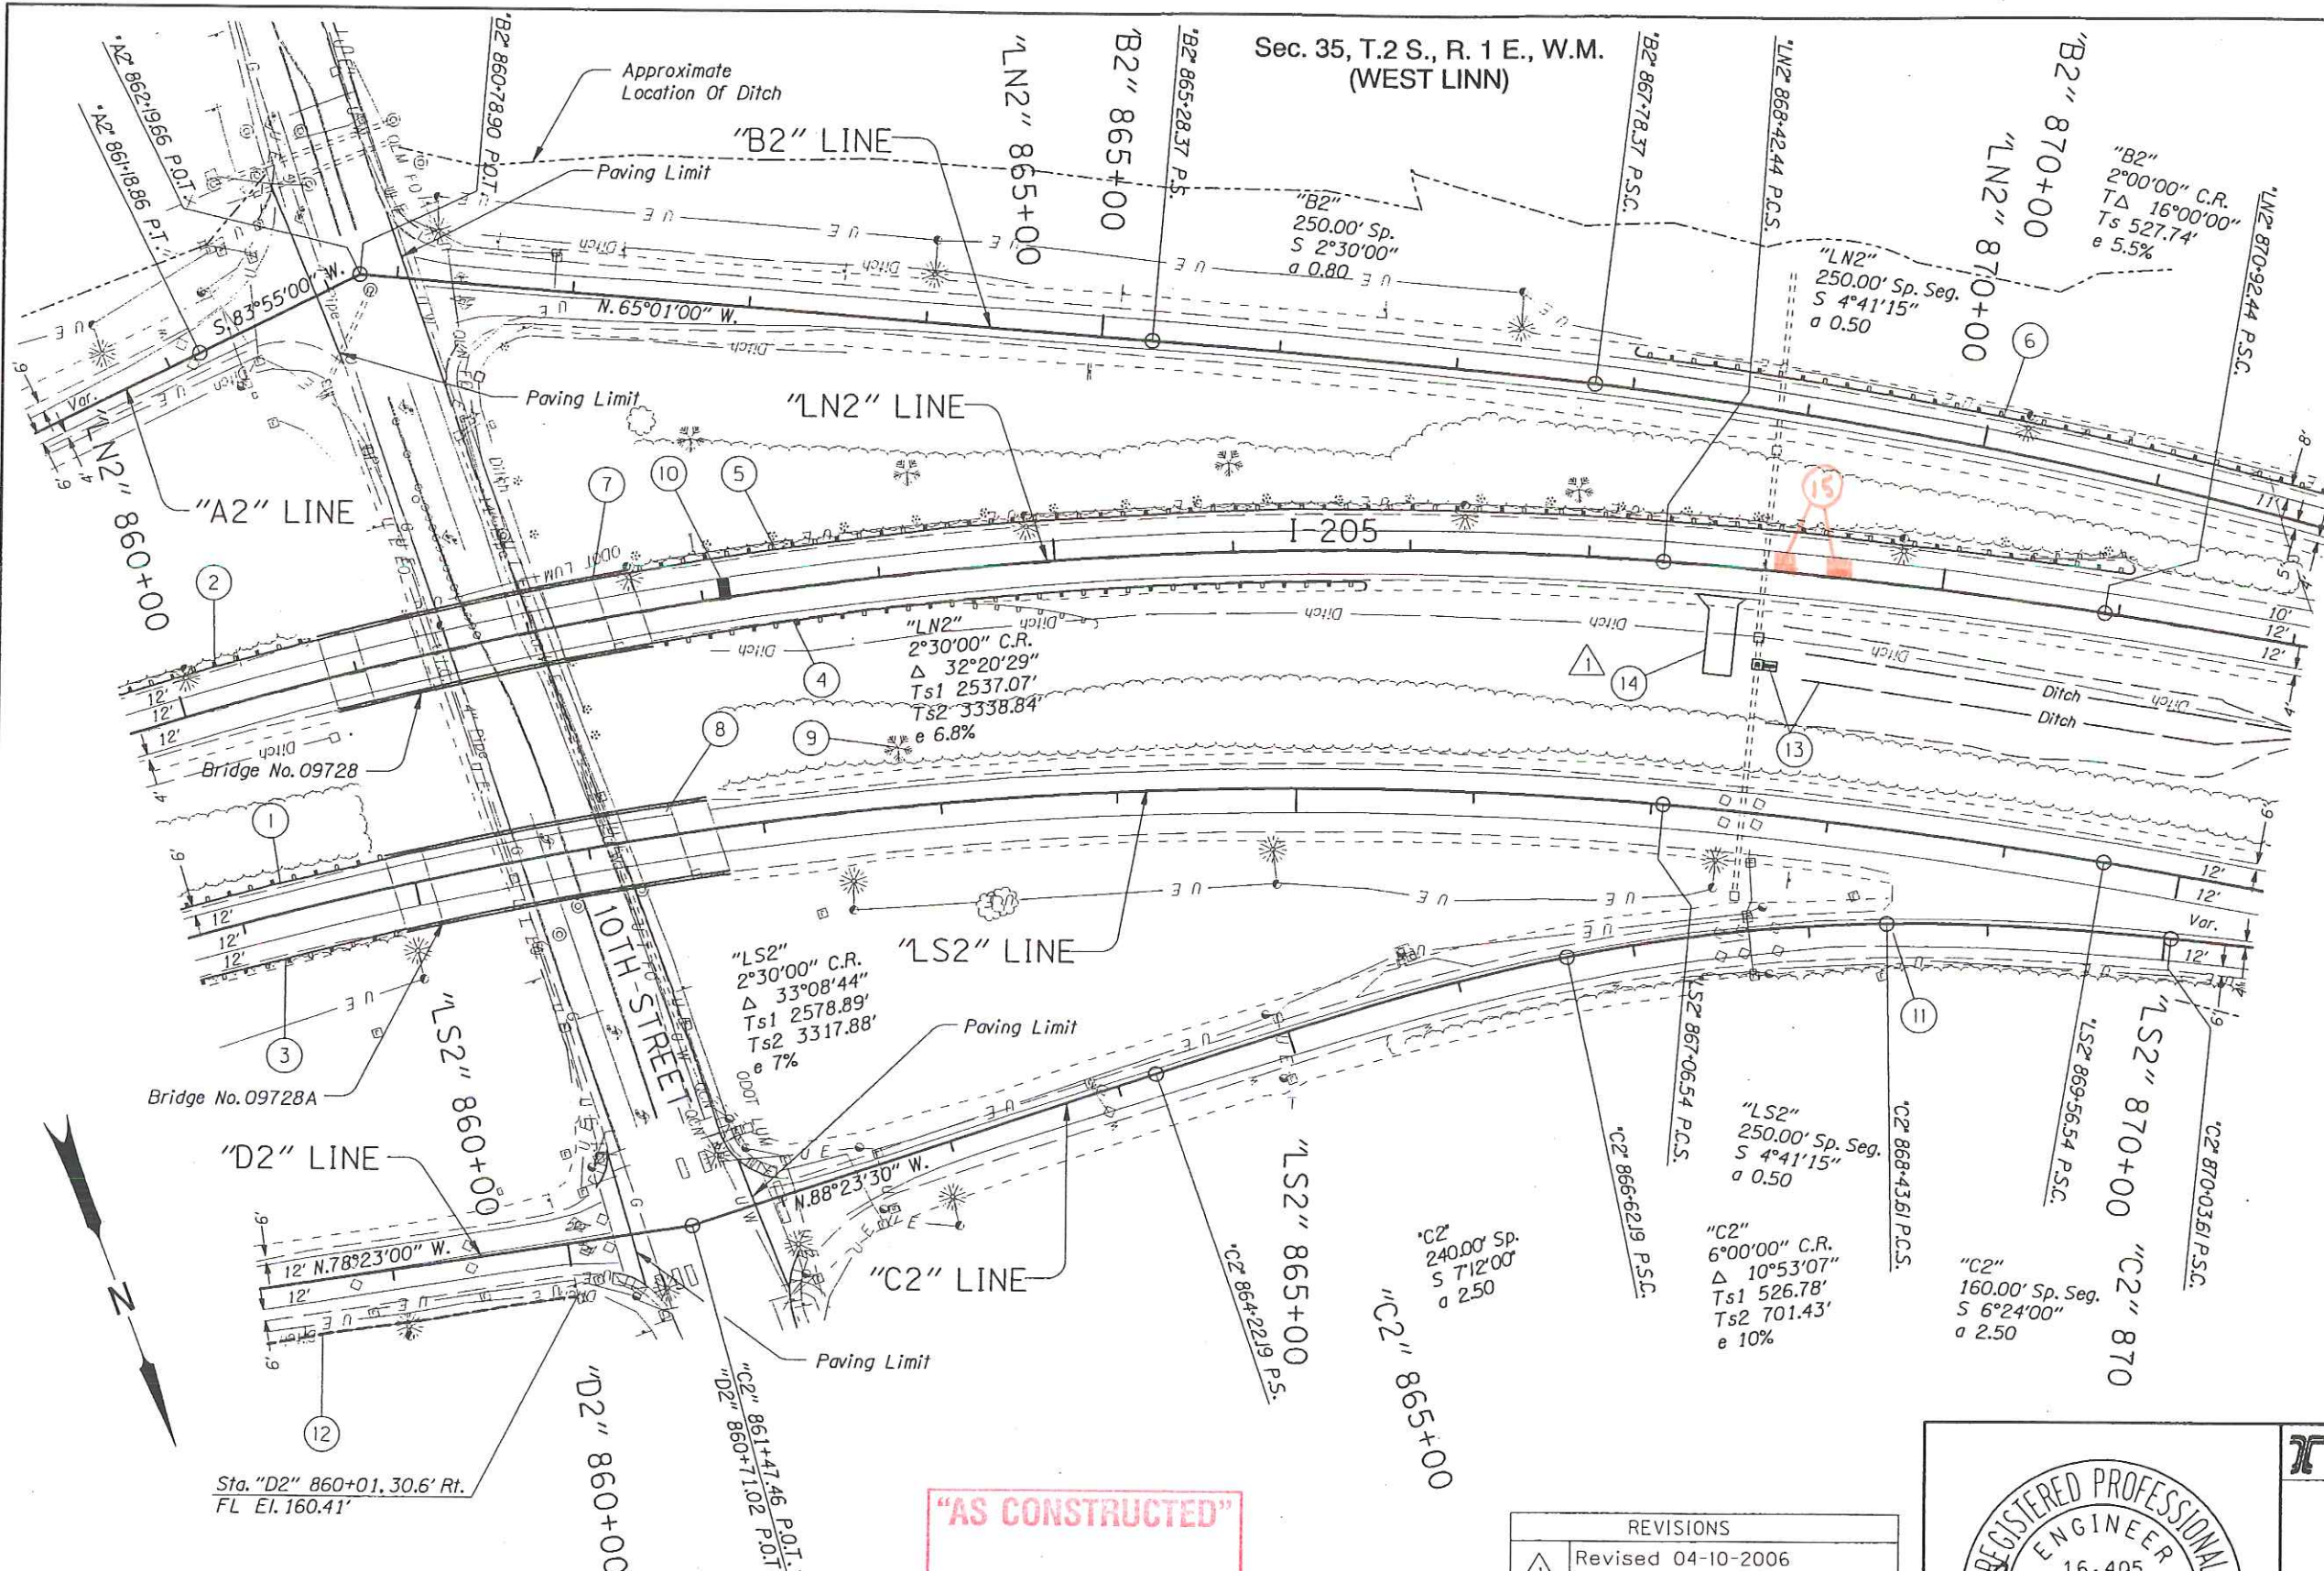

LEGEND
 Terminal Expansion Joint Repair Shown Thus:

"AS CONSTRUCTED"
Mark Boy
 Date 6/24/09 Project Mngr

REVISIONS	
	Revised 04-10-2006 Added Maintenance Pad



OREGON DEPARTMENT OF TRANSPORTATION
ROADWAY ENGINEERING SECTION

I-205: WILLAMETTE RIVER BR. - PACIFIC HWY. (UNIT 3) SEC.
 EAST PORTLAND FREEWAY
 CLACKAMAS & WASHINGTON COUNTIES

Design Team Leader - Brian Bierwagen
 Designed By - Jim Phillips
 Drafted By - Ron Ricks

ALIGNMENT AND GENERAL CONSTRUCTION

NO. 14

Parametrix

- ① See Sht. 5A, Note 3
Remove Extg. Guardrail
Const. Guardrail (Type 2A)
Const. Guardrail - 12.5' (Type 3)
Const. Guardrail To Bridge Rail Transition
(See Drg. No. BR203)
- ② See Sht. 13, Note 3
Remove Extg. Guardrail
Const. Guardrail (Type 2A)
Const. Bridge Rail To Guardrail Connection
(See Drg. No. BR236)
- ③ See Sht. 13, Note 4
Remove Extg. Guardrail
Const. Guardrail (Type 2A)
Const. Guardrail - 12.5' (Type 3)
Const. Guardrail To Bridge Rail Transition
- ④ Sta. "LN2" 862+68 To Sta. "LN2" 866+73, Rt.
Remove Extg. Guardrail - 254'
Const. Guardrail - 325' (Type 2A)
Const. Guardrail - 12.5' (Type 3)
Const. Guardrail To Bridge Rail Transition
Const. Guardrail Terminal, Non-Flared (50')
Flare Rate=0, W=1', E=0
- ⑤ Sta. "LN2" 862+61 To Sta. "LN2" 871+04, Lt.
Remove Extg. Guardrail - 843'
Const. Guardrail - 762.5' (Type 2A)
Const. Guardrail - 12.5' (Type 3)
Const. Guardrail To Bridge Rail Transition
Const. Guardrail Terminal, Non-Flared (50')
Flare Rate=0, W=1', E=0
- ⑥ Sta. "B2" 868+00 To Sta. "B2" 877+50, Lt.
Remove Extg. Guardrail - 950'
Const. Guardrail - 900' (Type 2A)
Const. Anchor (Type 1 Mod)
Inst. End Piece (Type B)
- ① Bridge No. 09728
Sta. "LN2" 860+83 To Sta. "LN2" 862+61
Remove Extg. Bridge Rail - 368'
Const. Type "F" Bridge Rail - 368'
(For Drg. Nos., See Sht. 1A)
(See Drg. Nos. BR200, BR203, and BR236)
- ⑧ Bridge No. 09728A
Sta. "LS2" 859+88 To Sta. "LS2" 861+72
Remove Extg. Bridge Rail - 376'
Const. Type "F" Bridge Rail - 376'
(For Drg. Nos., See Sht. 1A)
- ⑨ Sta. "LS2" 862+75, 42', Lt.
Remove Extg. 12" Dia. Tree
- ② ⑩ Sta. "LN2" 863+10 To Sta. "LN2" 863+16, Lt.
Terminal Expansion Joint Repair - 12'
(For Details, See Shts. 2B-23 and 2B-24)
- ⑪ Sta. "C2" 868+44, Rt.
Const. Open Grade HMAC
Wearing Surface Drain (Option B) - 24'
- ⑫ See Sht. 13, Note 9
Inst. 8" Perf. Drain Pipe
- ② ⑬ Const. Bio-Swale/Detention Pond B
Ditch Exc. - 800 Cu.Yd.
Inst. Outlet Structure
(For Details, See Sht. 6J-11)

- ③ ⑭ Sta. "LN2" 868+78, Rt.
Const. Aggr. Maintenance Pad (45')
Embankment - 22 Cu.Yd.
Aggregate - 54 Tons
(For Details, See Sht. 2B-26)

⑮ Continuously Reinf. Conc.
Pvmt. Repair

"AS CONSTRUCTED"

Mark Beer


Date 6/26/09 Project Mngr

REVISIONS	
①	Revised 03-23-2006 Changed Std. Drg. Callout In Note
②	Revised 04-10-2006 Revised Note
③	Revised 04-10-2006 Added Maintenance Pad

REGISTERED PROFESSIONAL
ENGINEER
16,405
BRIAN NEIL BIERWAGEN
DECEMBER 31, 1995
OREGON
16-06
EXPIRES: 12/31/07

OREGON DEPARTMENT OF TRANSPORTATION ROADWAY ENGINEERING SECTION	
1-205: WILLAMETTE RIVER BR. - PACIFIC HWY. (UNIT 3) SEC. EAST PORTLAND FREEWAY CLACKAMAS & WASHINGTON COUNTIES	
Design Team Leader - Brian Bierwagen Designed By - Jim Phillips Drafted By - Ron Ricks	
CONSTRUCTION NOTES	SHEET NO. 14 A

Parametrix

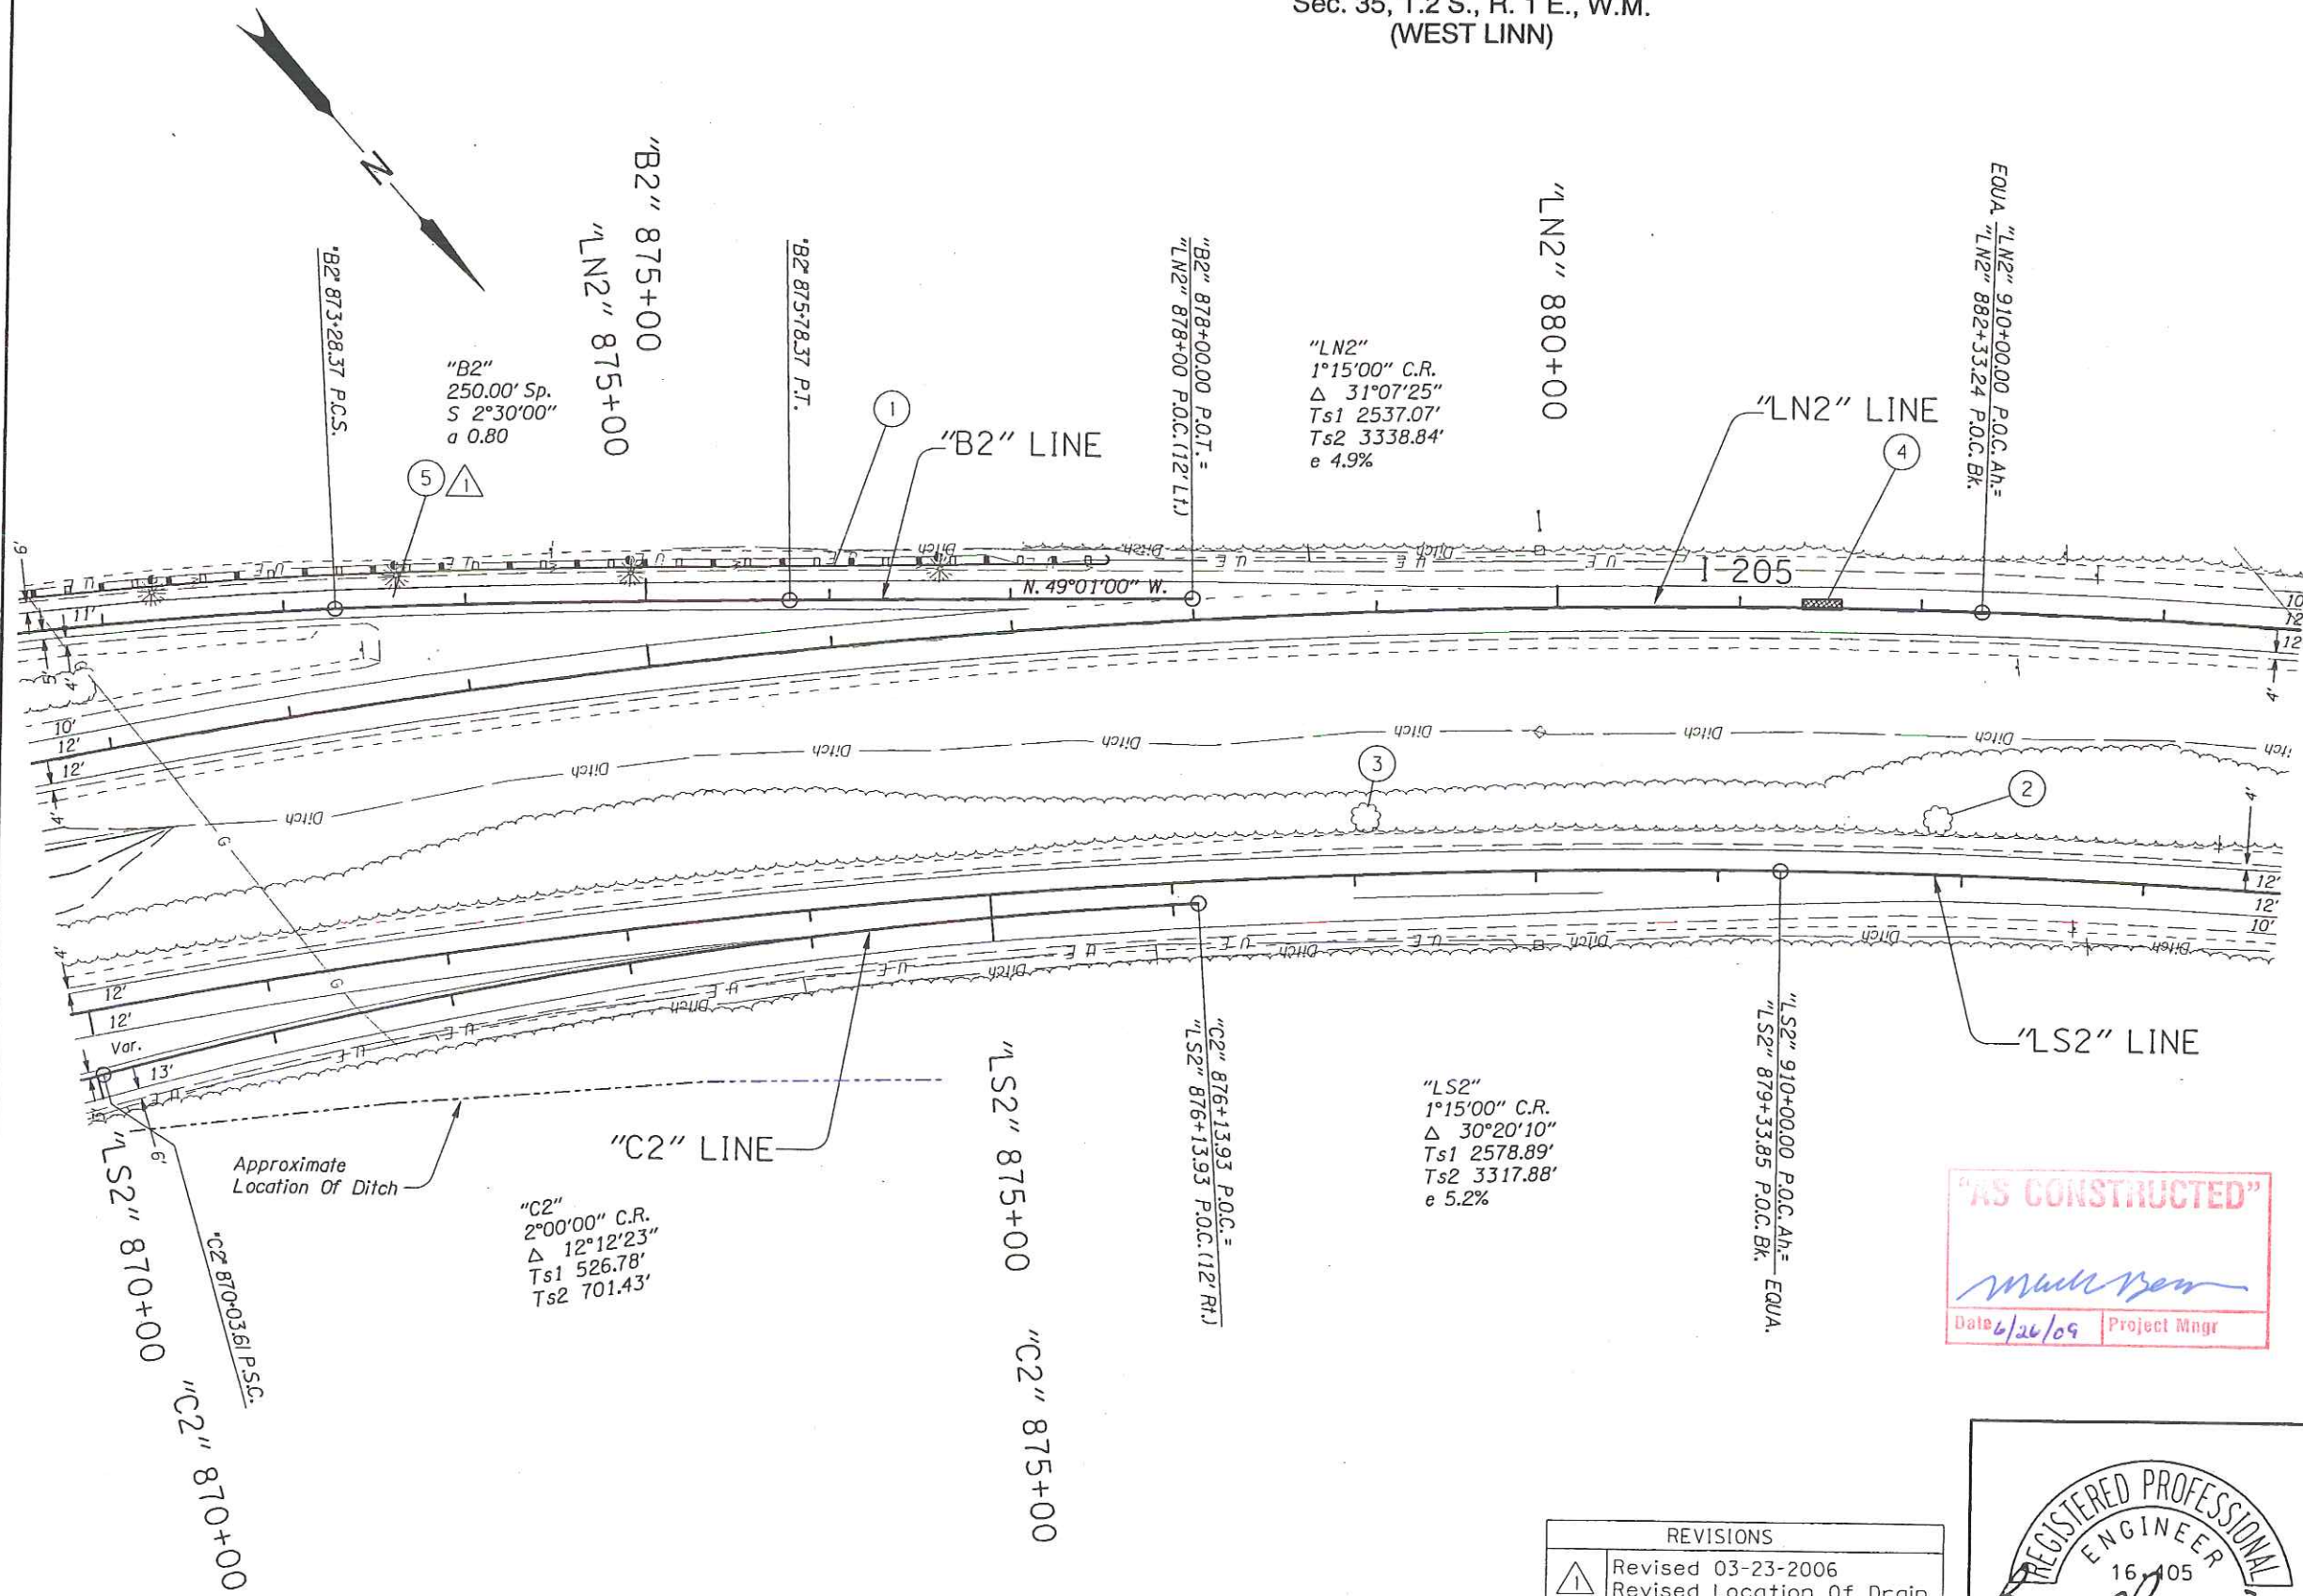

- ① See Sht. 14A, Note 6
Remove Extg. Guardrail
Const. Guardrail (Type 2A)
Const. Guardrail Terminal, Non-Flared (50')
Flare Rate=0, W=1', E=0
- ② Sta. "LS2" 910+75, 41', Lt.
Remove Extg. 12" Dia. Tree
- ③ Sta. "LS2" 877+00, 38', Lt.
Remove Extg. 12" Dia. Tree
- ④ Continuously Reinf. Conc.
Pvmt. Repair - 15 Sq. Yd.
(For Details, See Shts. 2B-18, 2B-19, and 2B-20)
- ⑤ Sta. "B2" 873+60 Lt.
Const. Open Grade HMA
Wearing Surface Drain (Option B) - 24'

"LN2"
1°15'00" C.R.
Δ 31°07'25"
Ts1 2537.07'
Ts2 3338.84'
e 4.9%

"LS2"
1°15'00" C.R.
Δ 30°20'10"
Ts1 2578.89'
Ts2 3317.88'
e 5.2%

"B2"
250.00' Sp.
S 2°30'00"
a 0.80

"C2"
2°00'00" C.R.
Δ 12°12'23"
Ts1 526.78'
Ts2 701.43'

"AS CONSTRUCTED"
Muller
Date 6/26/09 Project Mngr

LEGEND
Continuously Reinf.
Conc. Pvmt. Repair Shown Thus: [Pattern]


REVISIONS	
①	Revised 03-23-2006 Revised Location Of Drain

REGISTERED PROFESSIONAL
ENGINEER
16105
Brian Bierwag
BRIAN NEIL BIERWAGEN
DECEMBER 31, 1995
3/17/06
EXPIRES: 12/31/07


OREGON DEPARTMENT OF TRANSPORTATION
ROADWAY ENGINEERING SECTION
1-205: WILLAMETTE RIVER BR. -
PACIFIC HWY. (UNIT 3) SEC.
EAST PORTLAND FREEWAY
CLACKAMAS & WASHINGTON COUNTIES
Design Team Leader - Brian Bierwag
Designed By - Jim Phillips
Drafted By - Ron Ricks

**ALIGNMENT AND
GENERAL CONSTRUCTION**
SHEET NO. 15

Parametrix

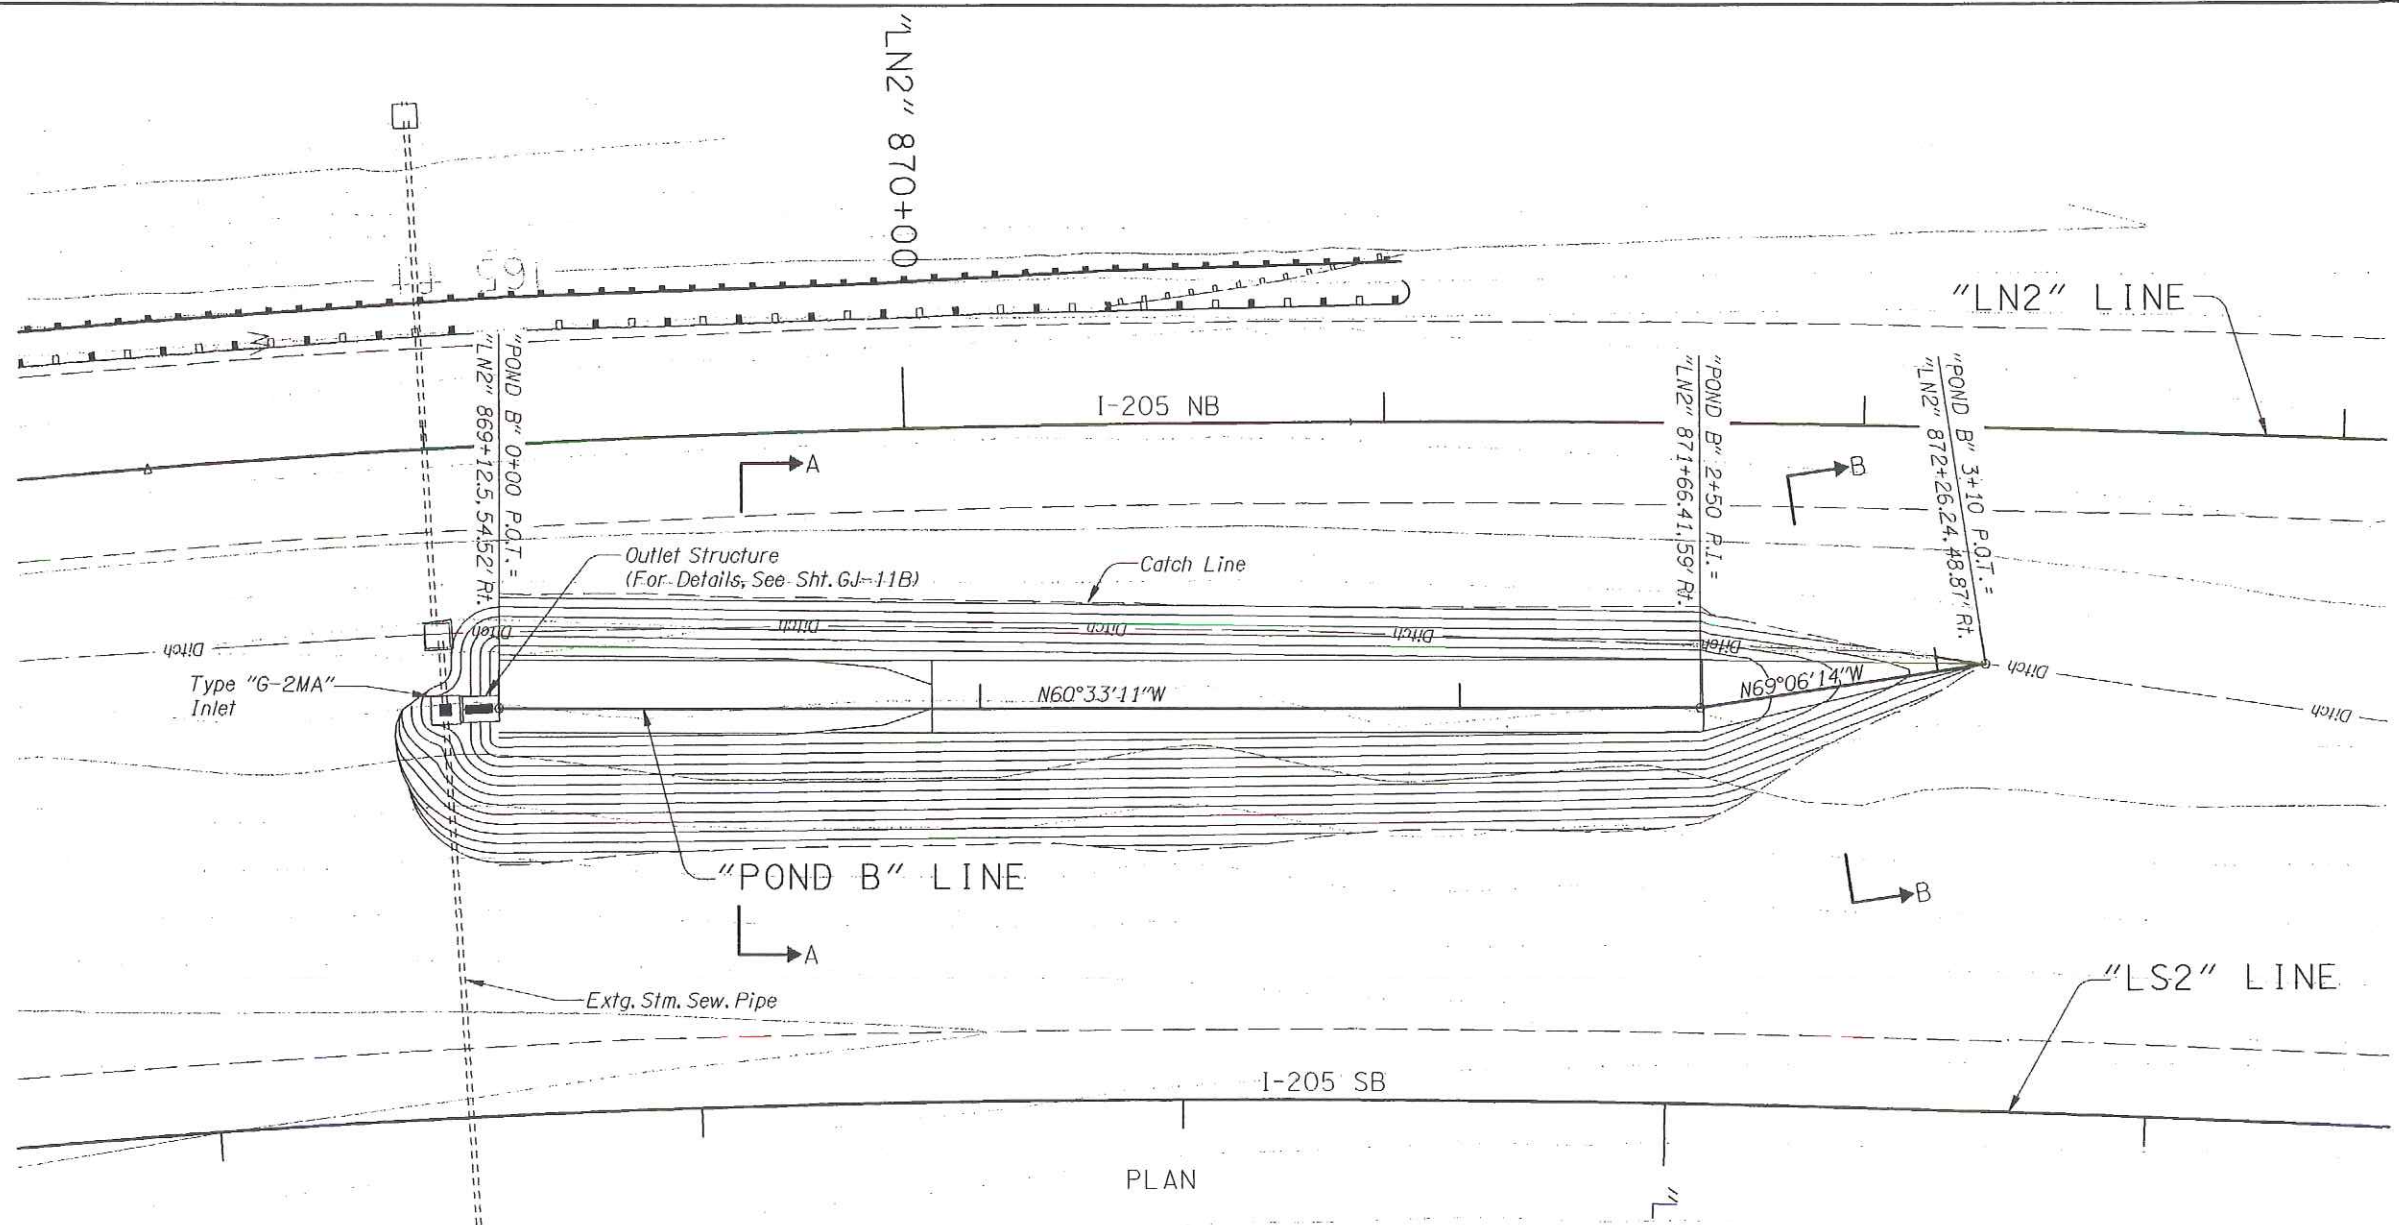

PLAN

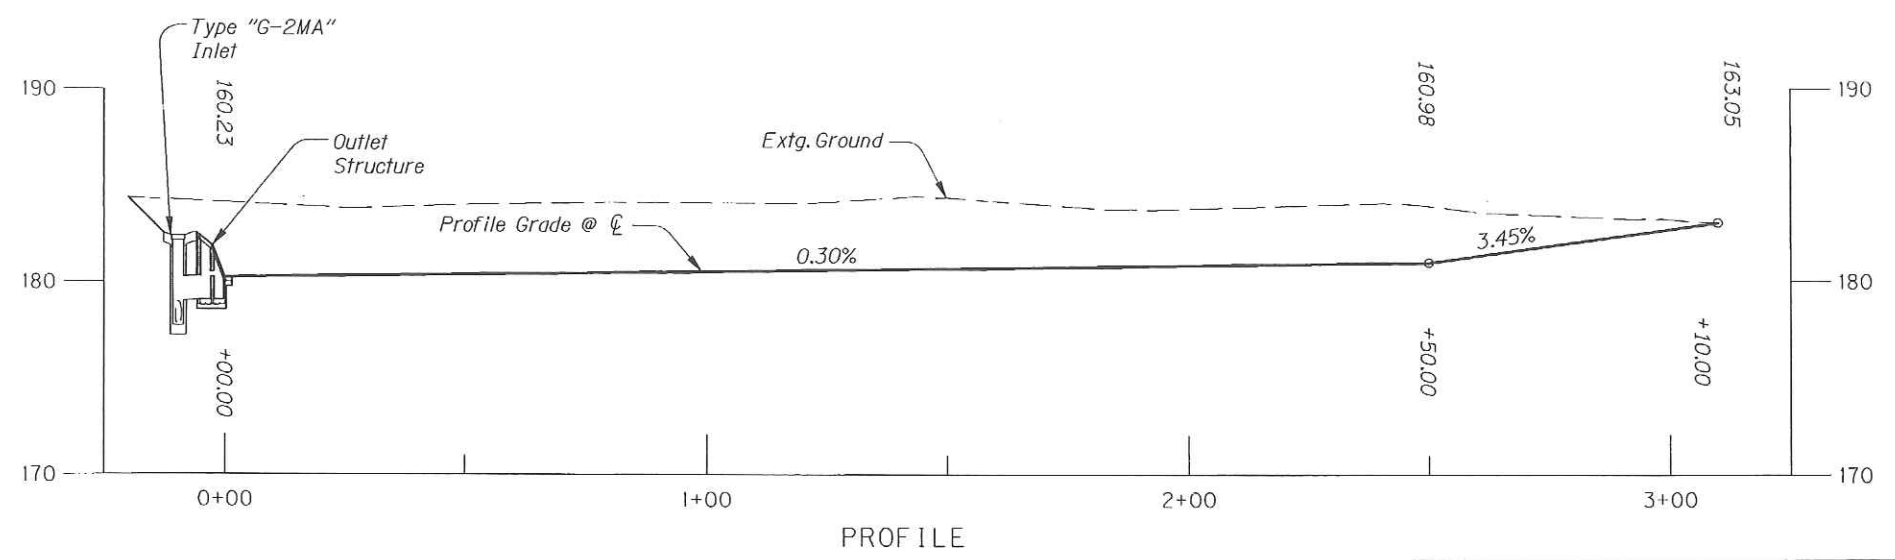

PROFILE

"AS CONSTRUCTED"
Mathew Bunde
 Date 6/26/09 Project Mgr



NOTE:
 For Sections Not Shown,
 See Sht. GJ-11A.
 For Outlet Structure Details,
 See Sht. GJ-11B.



EXPIRES: 12/31/06

OREGON DEPARTMENT OF TRANSPORTATION ROADWAY ENGINEERING SECTION	
I-205: WILLAMETTE RIVER BR. - PACIFIC HWY. (UNIT 3) SEC. EAST PORTLAND FREEWAY CLACKAMAS & WASHINGTON COUNTIES	
Design Team Leader - Jerry Lane Designed By - James Kent Drafted By - Mathew Bunde	
POND B PLAN AND PROFILE	SHEET NO. GJ-11

CONSULTING ENGINEERS
 Corporate Office: 820 COUNTRY CLUB ROAD, SUITE 100B EUGENE, OREGON 97401-8089
 2225 MISSION STREET SE, SUITE 100 SALEM, OREGON 97302-1295
 1335 POPLAR DRIVE, MEDFORD, OREGON 97504-5207

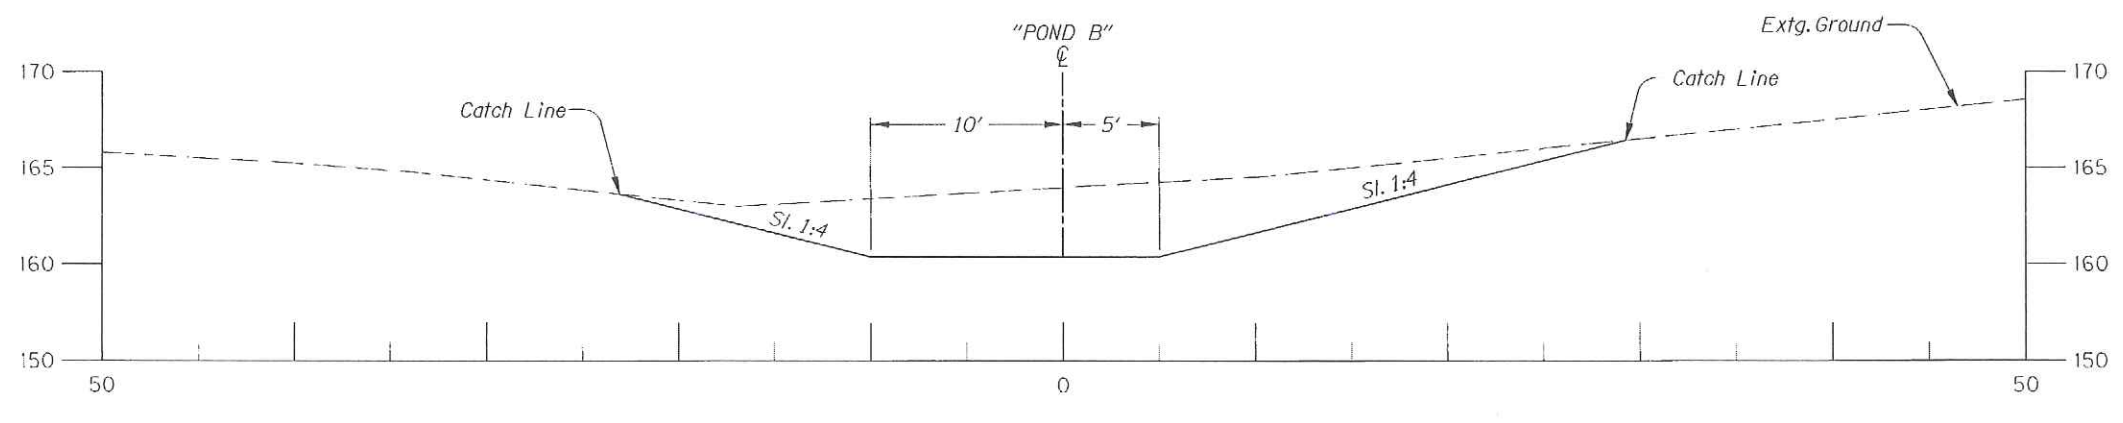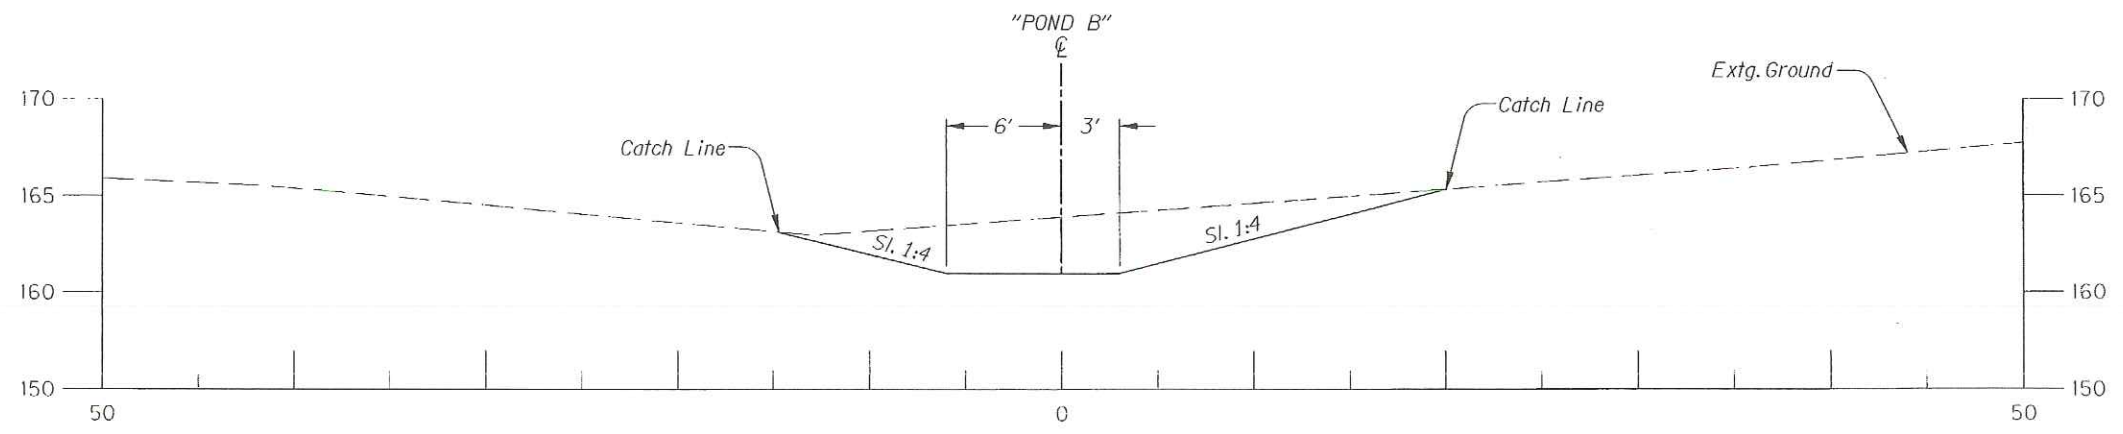

"AS CONSTRUCTED"
Mark Bunde
 Date 6/26/09 Project Mngr

REGISTERED PROFESSIONAL
 ENGINEER
 12295
Jerome D. Lane
 OREGON
 JULY 5, 1983
 JEROME D. LANE
 EXPIRES: 12/31/06

OREGON DEPARTMENT OF TRANSPORTATION
 ROADWAY ENGINEERING SECTION


I-205: WILLAMETTE RIVER BR. -
 PACIFIC HWY. (UNIT 3) SEC.
 EAST PORTLAND FREEWAY
 CLACKAMAS & WASHINGTON COUNTIES

Design Team Leader - Jerry Lane
 Designed By - James Kent
 Drafted By - Mathew Bunde

POND B
CROSS SECTIONS

SHEET NO.
GJ-11A

OBEC CONSULTING ENGINEERS
 Corporate Office: 520 COUNTRY CLUB ROAD, SUITE 1000 EUGENE, OREGON 97401-4089
 2235 MISSION STREET SE, SUITE 100 SALEM, OREGON 97302-1295
 1335 POPLAR DRIVE MEDFORD, OREGON 97504-5207
 www.obec.com

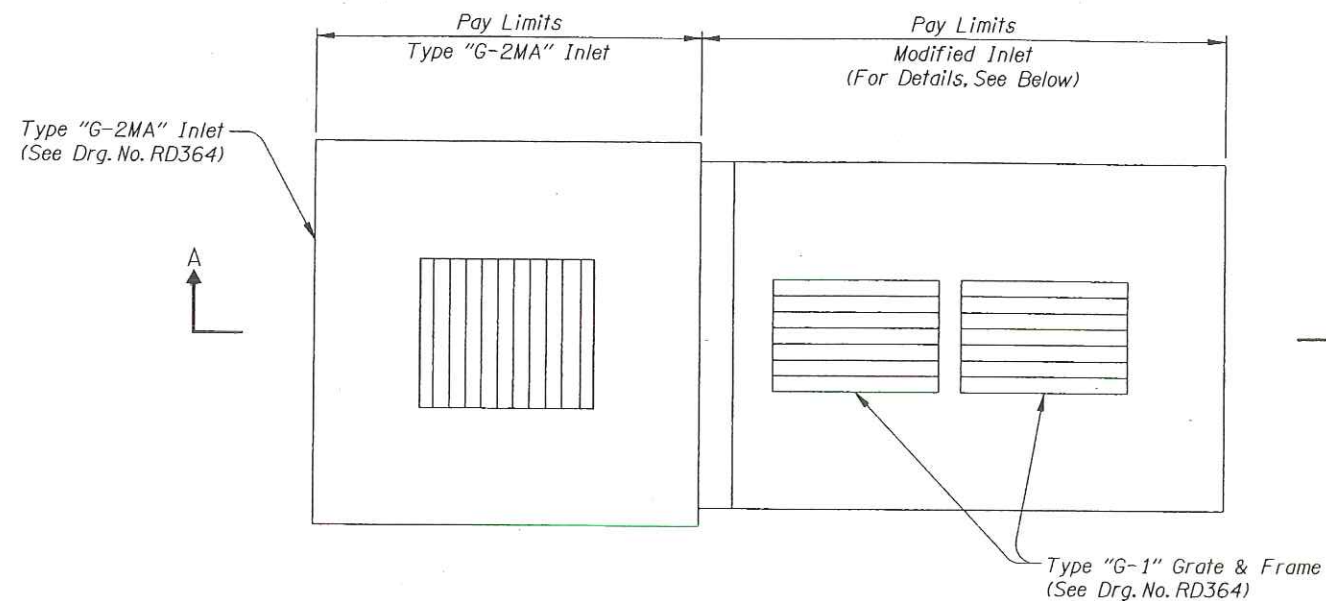

PLAN

GENERAL NOTES:

All Material And Workmanship Shall Conform To The 2002 Oregon Standard Specifications For Construction.

All Reinforcement Steel Shall Conform To Astm Specification A615, Grade 60 Or A706.

The Following Splice Lengths Shall Be Used,

Bar Size	3	4	5	6	7	8	9	10	11	
Splice Length	Uncoated	1'-0"	1'-4"	1'-8"	2'-0"	2'-8"	3'-6"	4'-4"	5'-7"	6'-9"
	Epoxy Coated	1'-5"	1'-10"	2'-4"	2'-10"	3'-9"	4'-11"	6'-1"	7'-10"	9'-6"


All Bars Shall Be Placed 2" Clear Of The Nearest Face Of Concrete Unless Shown Otherwise.

Concrete Shall Be Commercial Grade Concrete ODOT Section 00440.


"AS CONSTRUCTED"

Math Bunde

Date 6/26/07 Project Mngr

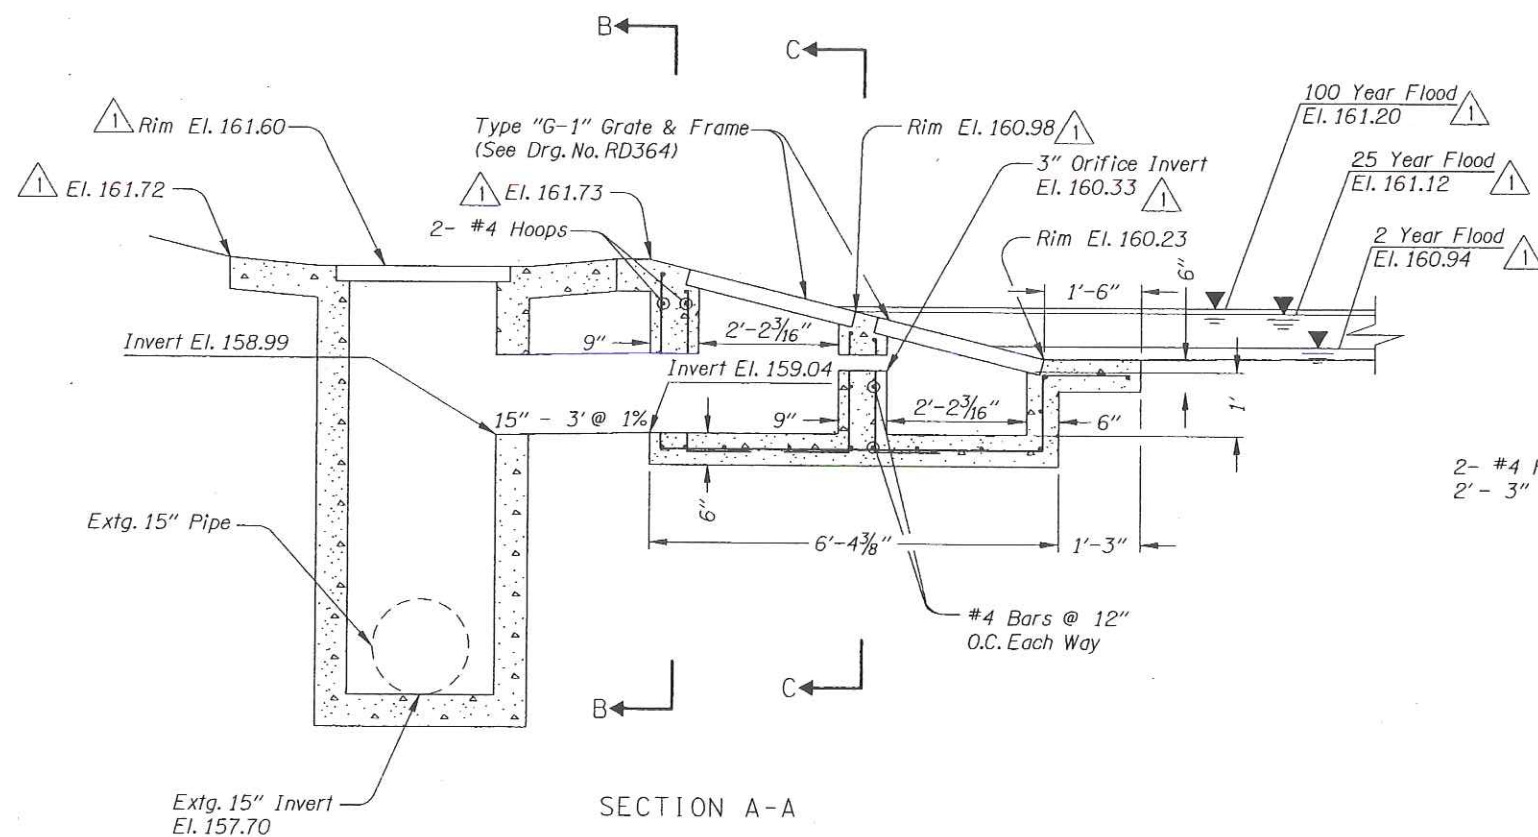

SECTION A-A
OUTLET STRUCTURE

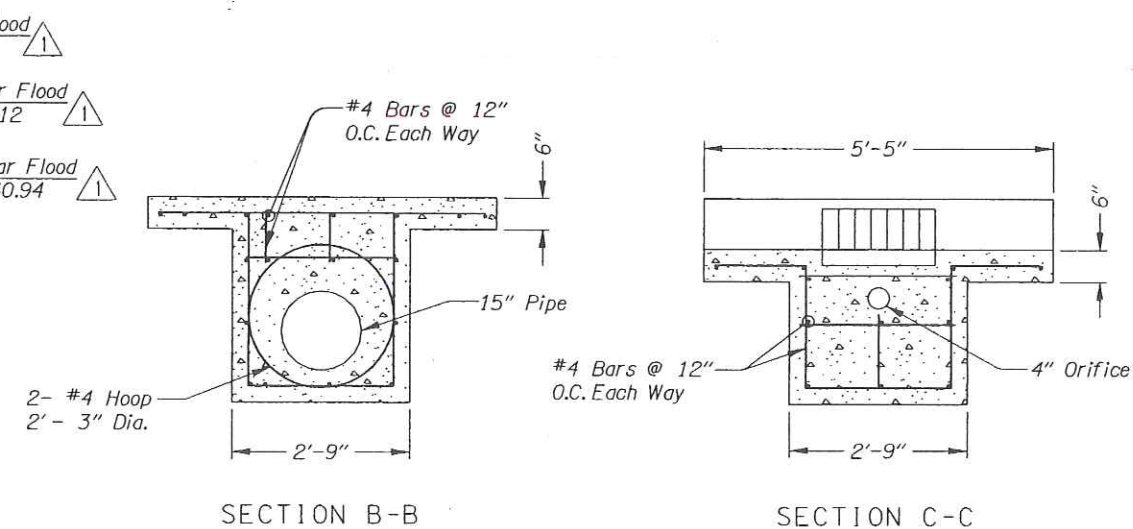

SECTION B-B

SECTION C-C

REVISIONS	
1	Revised 03-23-2006 Revised Elevations



OREGON DEPARTMENT OF TRANSPORTATION
ROADWAY ENGINEERING SECTION

I-205: WILLAMETTE RIVER BR. -
PACIFIC HWY. (UNIT 3) SEC.
EAST PORTLAND FREEWAY
CLACKAMAS & WASHINGTON COUNTIES

Design Team Leader - Jerry Lane
Designed By - James Kent
Drafted By - Mathew Bunde

POND B
DETAILS

SHEET NO.
GJ-11B