

OPERATION & MAINTENANCE MANUAL

DFI No. : D00133

**Facility Type: Detention Pond/Water
Quality Biofiltration Swale Combo**



JULY, 2011

INDEX

1. IDENTIFICATION..... 1

2. FACILITY CONTACT INFORMATION..... 1

3. CONSTRUCTION..... 1

4. STORM DRAIN SYSTEM AND FACILITY OVERVIEW 2

5. FACILITY HAZ MAT SPILL FEATURE(S)..... 5

6. AUXILIARY OUTLET (HIGH FLOW BYPASS)..... 5

7. MAINTENANCE REQUIREMENTS..... 5

8. WASTE MATERIAL HANDLING..... 6

APPENDIX A: Operational Plan and Profile Drawing(s)

APPENDIX B: ODOT Project Plan Sheets

1. Identification

Drainage Facility ID (DFI): D00133
Facility Type: Detention Pond/Water Quality Biofiltration Swale Combo
Construction Drawings: (V-File Number) 39V-058
Location: District: 2B (Old 2A)
Highway No.: 064
Mile Post: 2.15/2.24 (beg./end)
Description: This facility is located just east of Prosperity Park Road in the grassy median between the northbound and southbound lanes of the East Portland Freeway (I-205, Hwy 064). Access may be obtained from the unobstructed shoulder off the northbound lanes of I-205 (Hwy 064.)

2. Facility Contact Information

Contact the Engineer of Record, Region Technical Center, or Geo-Environmental's Senior Hydraulics Engineer for:

- Operational clarification
- Maintenance clarification
- Repair or restoration assistance

Engineering Contacts:

Region Technical Center Hydro Unit Manager

Or

Geo-Environmental Senior Hydraulics Engineer (503) 986-3365.

3. Construction

Engineer of Record: Consultant Designer – OBEC Consulting Engineers
Jerome D. Lane, P.E., (503) 589-4100
Facility construction: 2006
Contractor: Oregon Mainline Paving, LLC

4. Storm Drain System and Facility Overview

A detention pond/water quality biofiltration swale combo (referred to from this point forward as a pond/swale combo) combines the forms and functions of a water quality swale and a detention pond. In a pond/swale combo, the biofiltration swale is situated within the bottom confines of the detention facility. The facility provides water quality treatment of the smaller storm events and detention of the larger storm events.

The biofiltration swale is designed as if it was a separate facility and consists of a grassy-lined facility with a flat trapezoidal cross section and gradual slope. Treatment is provided through sedimentation and filtration processes. If amended soils are present, additional treatment is obtained through infiltration through the amended soil media.

When the flows exceed the water quality flows, the pond/swale combo facility begins to provide detention. Detention is required to reduce or mitigate the increases in discharge, resulting from development. The facility is designed to store and gradually release (or attenuate) stormwater runoff via a control structure or release mechanism, then releasing it slowly over a more extended period of time. The flow control mechanism for this facility involves a 4-inch orifice surrounded by a wirecloth strainer assembly. When flows exceed the water quality design flow, the orifice restricts the flow causing the water to backup within the facility.

This detention pond/water quality biofiltration swale combo is located just east of Prosperity Park Road in the grassy median between the northbound and southbound lanes of the East Portland Freeway (I-205, Hwy 064). The facility is approximately 475 feet in length from east to west. Access may be obtained from the unobstructed shoulder off the northbound lanes (Photo 1).

This facility receives stormwater runoff as sheet flow from adjacent portions of both the northbound and southbound lanes of I-205 (Hwy 064.) Within the facility, stormwater move from east to west. Water leaves the pond/swale combo at an outlet structure at the facility's northwestern end (Point B on the Operational Plan in Appendix A).

The outlet structure consists of a lower outlet and a pair of upper outlets (Point B). Treatment flows and detained water enter the lower outlet, are discharged into a 3-inch diameter pipe, conveyed to the upper outlets, discharged into a 15-inch diameter conveyance pipe and subsequently discharged into a 54-inch diameter conveyance pipe buried alongside Prosperity Park Road (Point C). From there, the water is conveyed either north or south where the pipe outfalls to separate ditches.

- A. Maintenance equipment access:
Personnel and vehicular access may be obtained from the unobstructed shoulder off the northbound lanes of I-205 (Hwy 064) (Photo 1).
- B. Heavy equipment access into facility:
- Allowed (no limitations)
 - Allowed (with limitations)
 - Not allowed
- C. Special Features:
- Amended Soils
 - Porous Pavers
 - Liners
 - Underdrains



Photo 1: Overview of the facility. Photo taken facing east. Vehicular access from unobstructed shoulder of northbound lanes of I-205 (Hwy 064.)

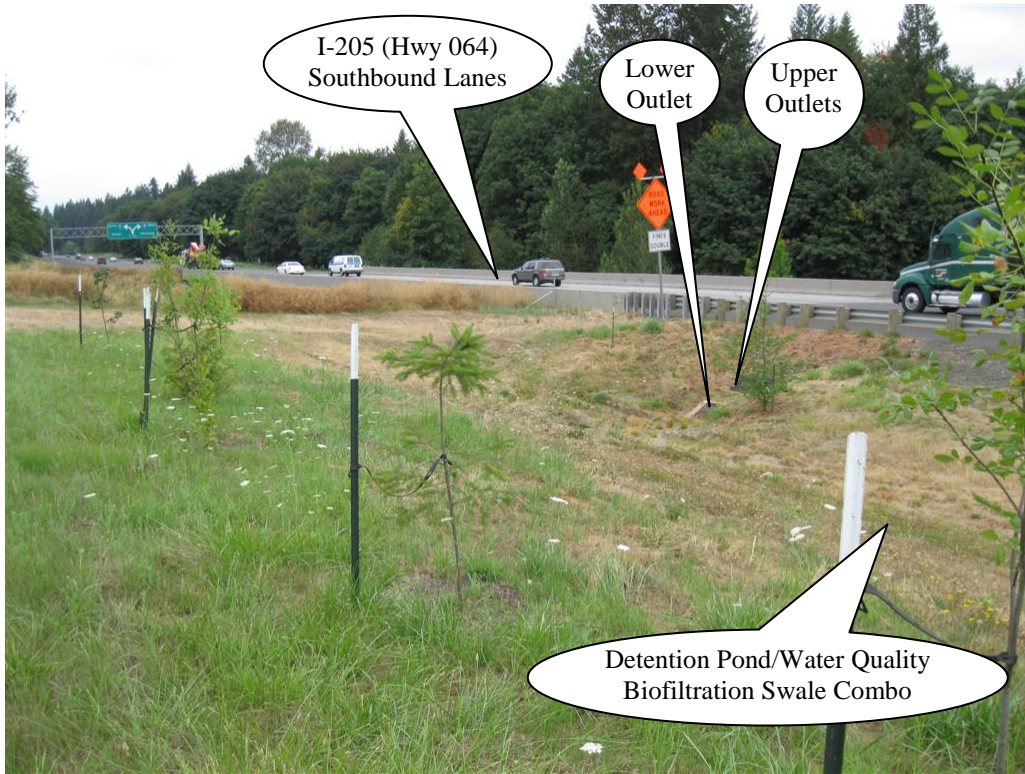


Photo 2: Overview of the facility. Photo taken facing west.



Photo 3: Facility outlet structures

5. Facility Haz Mat Spill Feature(s)

The pond/swale combo can be used to store a volume of liquid if its outlet structures are blocked. The outlet structures for this facility are noted as Point B on the Operational Plan (Photo 3). They can be blocked using metal plates or sandbags.

6. Auxiliary Outlet (High Flow Bypass)

Auxiliary Outlets are provided if the primary outlet control structure cannot safely pass the projected high flows. Broad-crested spillway weirs and over flow risers are the two most common auxiliary outlets used in stormwater treatment facility design. The auxiliary outlet feature is either a part of the facility or an additional storm drain feature/structure.

The auxiliary outlet feature for this facility is:

Designed into facility:

The auxiliary outlet for this facility is designed into the outlet structure at the northwest end of the facility (Point B). The outlet structure consists of a lower outlet connected by a 3-inch diameter pipe to a pair of upper outlets (Photo 3). A 15-inch diameter pipe conveys discharged water from the upper outlets to a 54-inch diameter conveyance pipe buried alongside Prosperity Park Road (Point C). Whereas treatment and detention flows are discharged from the lower outlet to the upper outlets, before leaving this facility, high flows bypass the lower outlet and exit from the upper outlets.

Other, as noted below:

7. Maintenance Requirements

Routine maintenance table for non-proprietary stormwater treatment and storage/detention facilities have been incorporated into ODOT's Maintenance Guide. These tables summarize the maintenance requirements for ponds, swales, filter strips, bioslopes, and detention tanks and vaults. Special maintenance requirements in addition to the routine requirements are noted below when applicable.

The ODOT Maintenance Guide can be viewed at the following website:

<http://www.oregon.gov/ODOT/HWY/OOM/MGuide.shtml>

Maintenance requirements for proprietary structures, such as underground water quality manholes and/or vaults with filter media are noted in Appendix C when applicable.

The following stormwater facility maintenance table (See ODOT Maintenance Guide) should be used to maintain the facility outlined in this Operation and Maintenance Manual or follow the Maintenance requirements outlined in Appendix C when proprietary structure is selected below:

- Table 1 (general maintenance)
- Table 2 (stormwater ponds)
- Table 3 (water quality biofiltration swales)
- Table 4 (water quality filter strips)
- Table 5 (water quality bioslopes)
- Table 6 (detention tank)
- Table 7 (detention vault)
- Appendix C (proprietary structure)
- Special Maintenance requirements:

Note: Special maintenance Requirements Require Concurrence from ODOT Senior Hydraulics Engineer.

8. Waste Material Handling

Material removed from the facility is defined as waste by DEQ. Refer to the roadwaste section of the ODOT Maintenance Yard Environmental Management System (EMS) Policy and Procedures Manual for disposal options: <http://egov.oregon.gov/ODOT/HWY/OOM/EMS.shtml>


Contact any of the following for more detailed information about management of waste materials found on site:

ODOT Clean Water Unit	(503) 986-3008
ODOT Statewide Hazmat Coordinator	(503) 229-5129
ODOT Region Hazmat Coordinator	(503) 731-8304
ODEQ Northwest Region Office	(503) 229-5263


Appendix A

Content:


- **Operational Plan and Profile Drawing(s)**

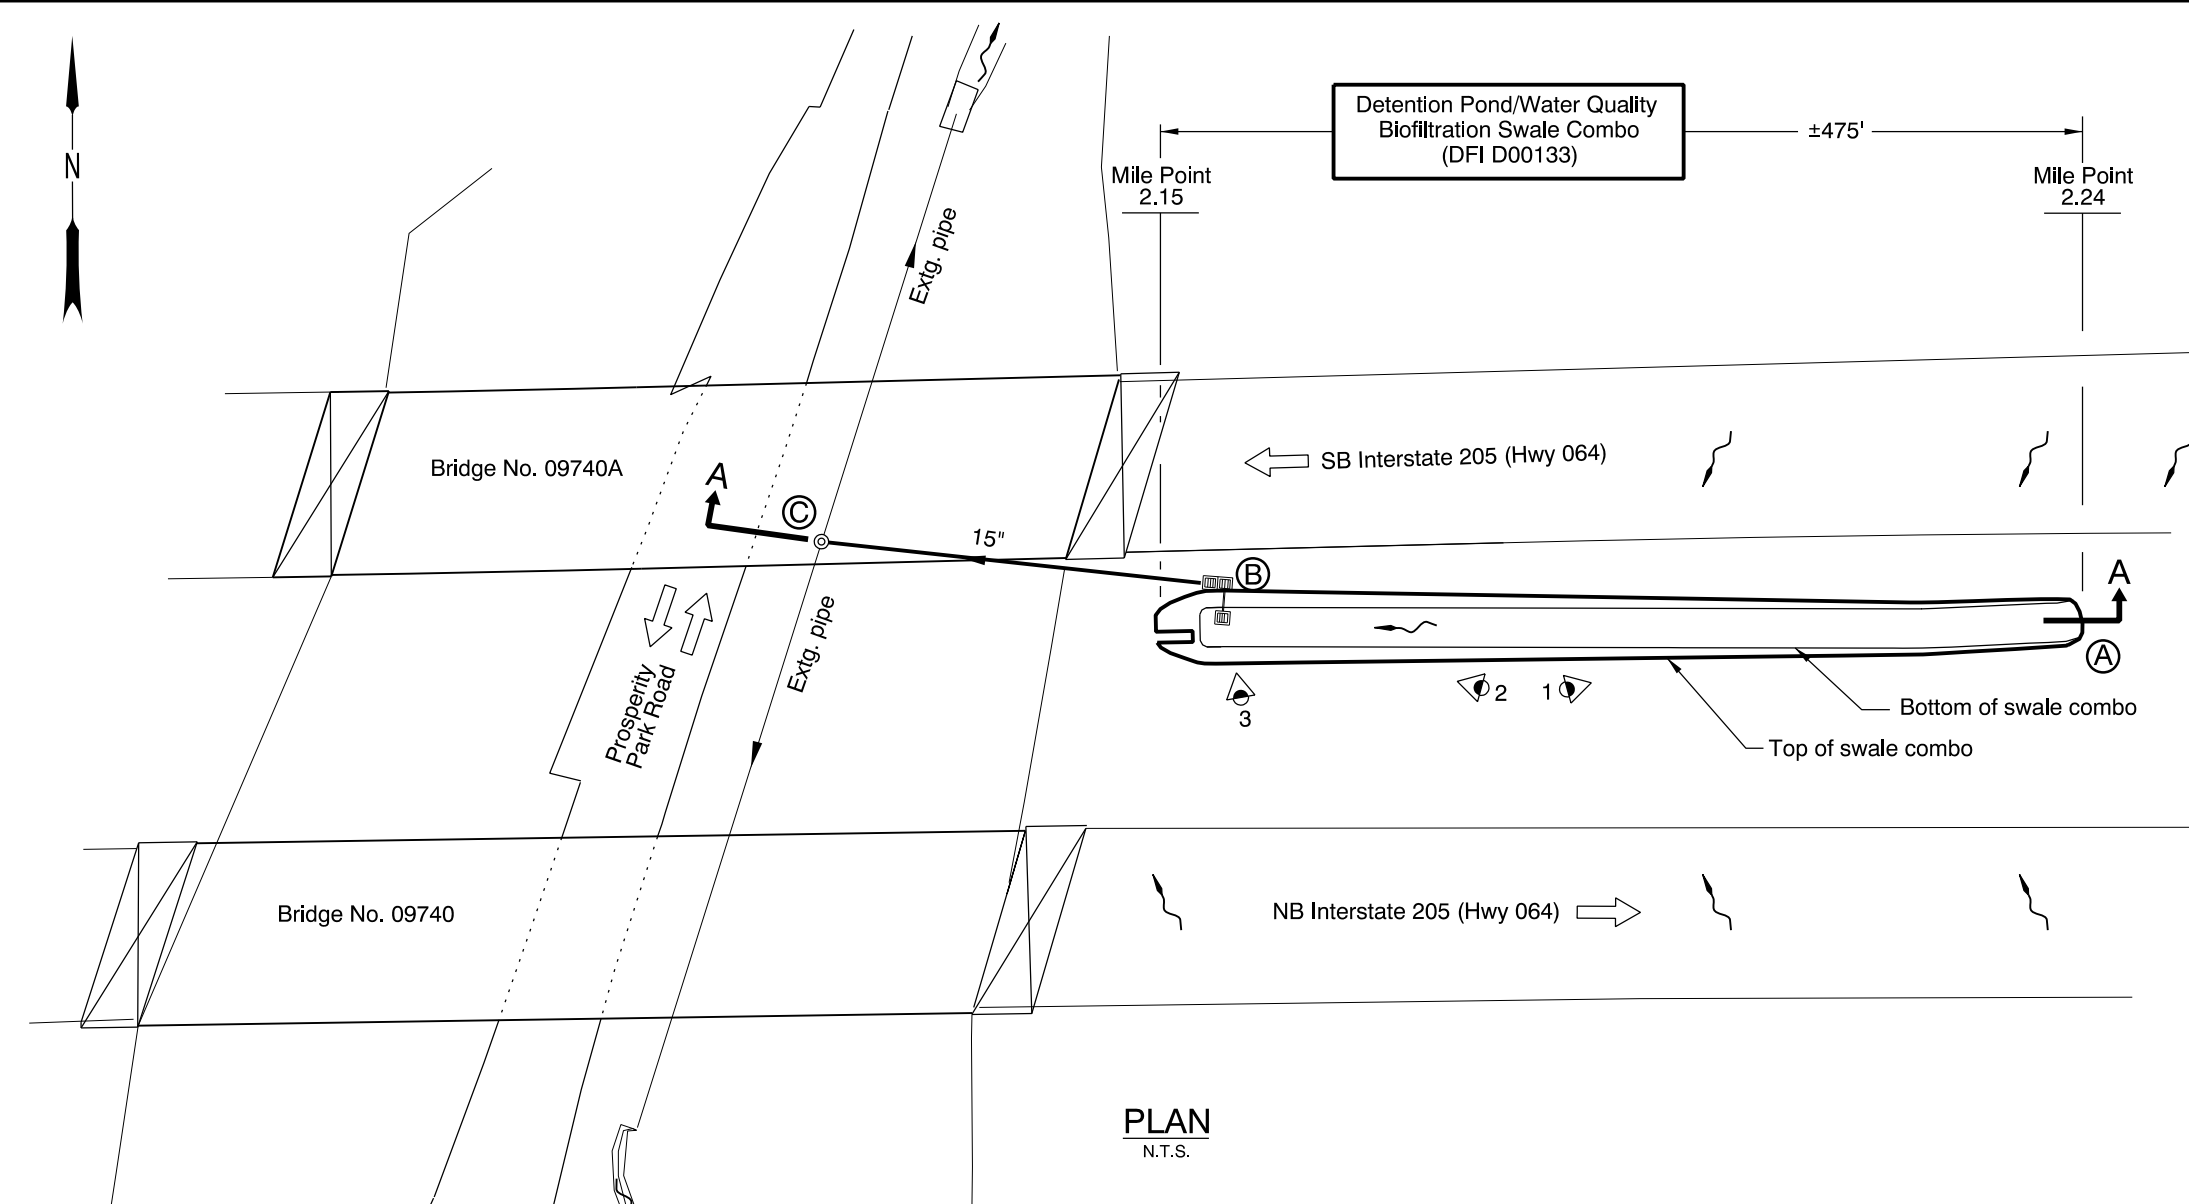

PLAN
N.T.S.

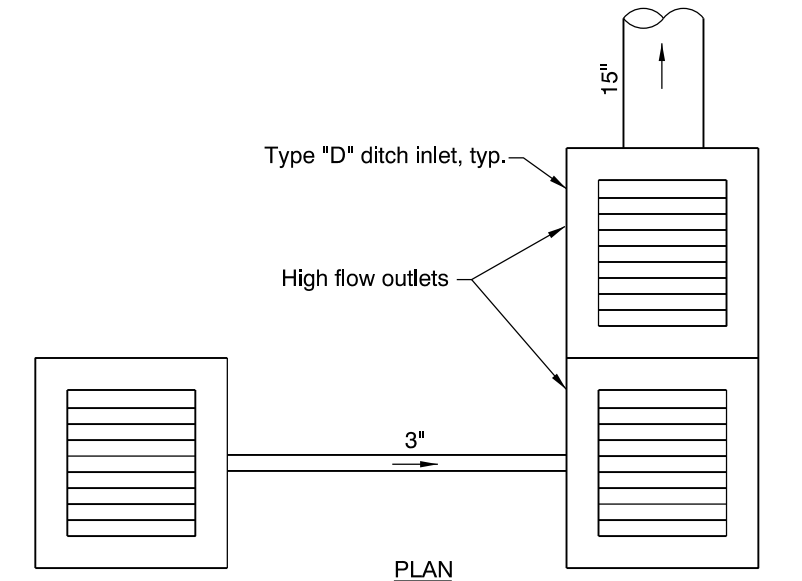


PLAN

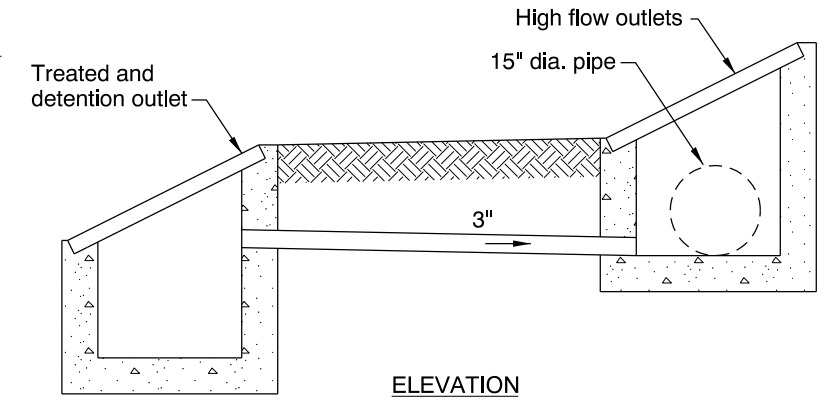

ELEVATION

OUTLET STRUCTURE FOR DETENTION/WATER QUALITY BIOFILTRATION SWALE COMBO AT POINT B
N.T.S.

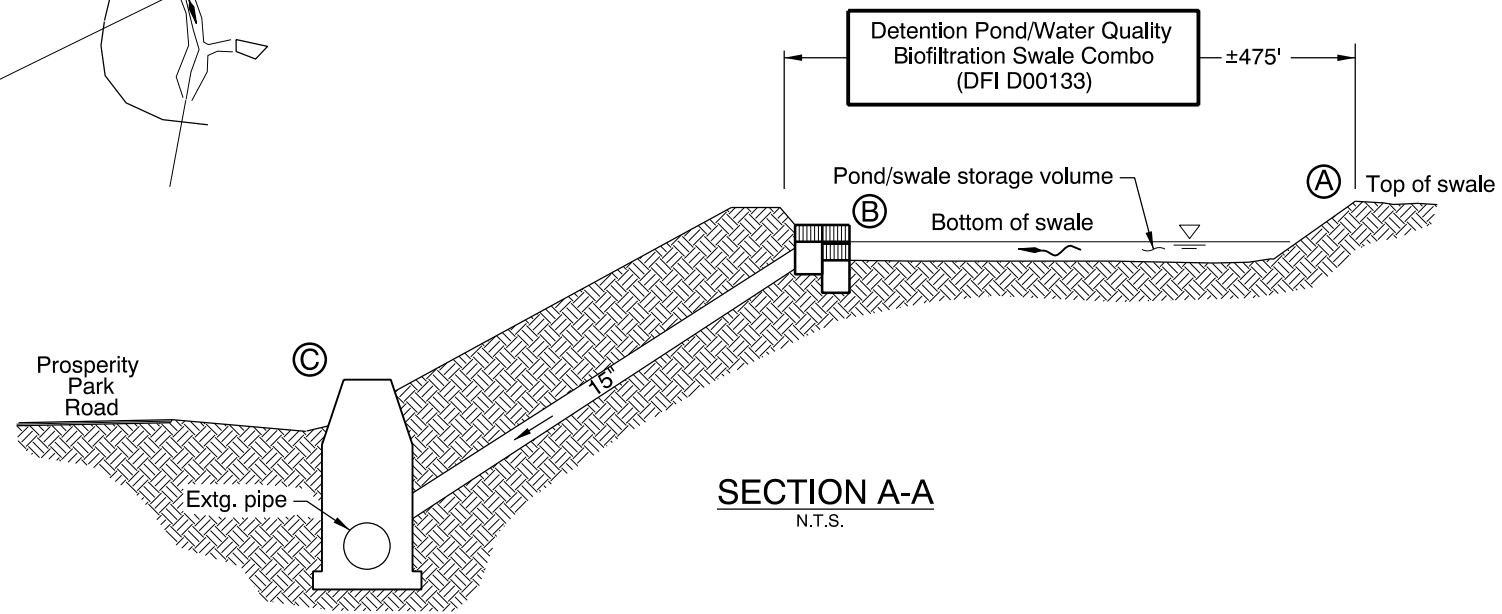

SECTION A-A
N.T.S.

LEGEND:

- ◁ Photograph location / direction
- ⊙ or ⊗ Manhole
- Ⓐ Start of Facility DFI 00133
- Ⓑ Outlet structure
- Ⓒ Facility Connection to Existing Stormwater Conveyance Line
- or □ Inlet
- Storm Pipe (Facility)
- Storm Pipe
- ← Conveyance Direction
- ~ Pavement / Facility Flow Path

Sht. 1 of 1

OREGON DEPARTMENT OF TRANSPORTATION

Prepared By: Wynnee Hu
Drafted By: Rodney Schultz

DFI D00133
MAINTENANCE DISTRICT 2B HWY 064
DETENTION POND/WQ SWALE COMBO
EAST PORTLAND FREEWAY MP 2.24 - 2.15
CLACKAMAS COUNTY

Appendix B


Content:

- **ODOT Project Plan Sheets**
 - *Cover/Title Sheet*
 - *Water Quality/Detention Plan Sheets*
 - *Other Details*

INDEX OF SHEETS	
SHEET NO.	DESCRIPTION
1	Title Sheet
1A, 1B	Index Of Sheets Cont'd.
1C	Std. Drg. Nos.

STATE OF OREGON
 DEPARTMENT OF TRANSPORTATION
 PLANS FOR PROPOSED PROJECT
GRADING, DRAINAGE, STRUCTURES, PAVING, SIGNING & ILLUMINATION

**I-205: WILLAMETTE RIVER BR. -
 PACIFIC HWY. (UNIT 3) SEC.
 EAST PORTLAND FREEWAY
 CLACKAMAS & WASHINGTON COUNTIES
 APRIL 2006**

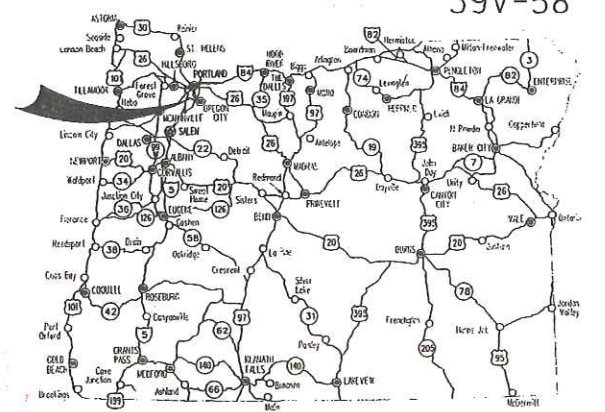


Overall Length Of Project - 8.90 Miles

"AS CONSTRUCTED"
Matthew Nelson
 Date 6/26/09 Project Mgr

ATTENTION:
 Oregon Law Requires You To Follow Rules Adopted By The Oregon Utility Notification Center. Those Rules Are Set Forth In OAR 952-001-0010 Through OAR 952-001-0090. You May Obtain Copies Of The Rules By Calling The Center. (Note: The Telephone Number For The Oregon Utility Center Is (503) 232-1987.)

**END OF PROJECT IM-OTIA-S064(032)
 STA. "LS2" 1231+71.15 (M.P. -0.10)**

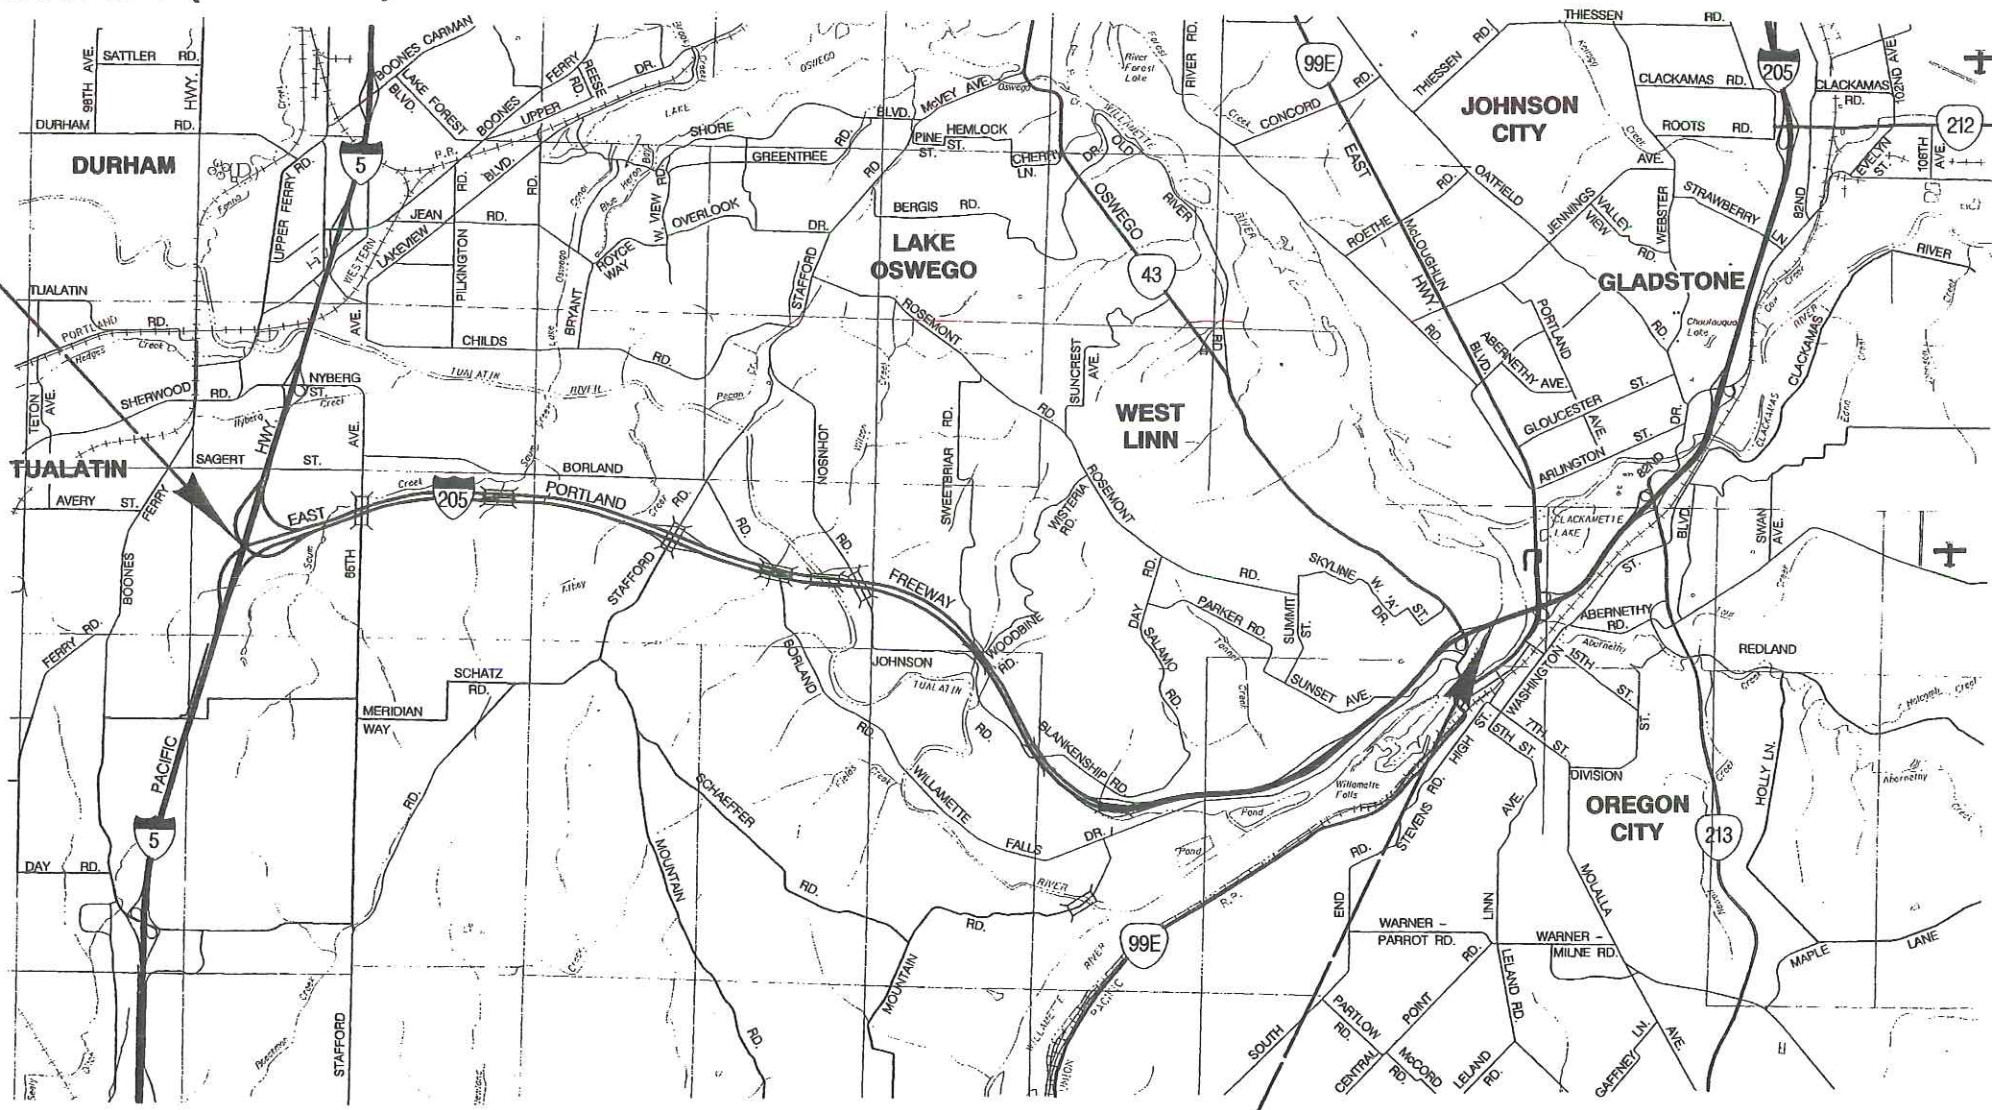

LET'S ALL
 WORK TOGETHER
 TO MAKE THIS
 JOB SAFE

- OREGON TRANSPORTATION COMMISSION**
- | | |
|-------------------|----------------------------|
| Stuart Foster | CHAIRMAN |
| Gail L. Achterman | COMMISSIONER |
| Mike Nelson | COMMISSIONER |
| Randall Papé | COMMISSIONER |
| Janice J. Wilson | COMMISSIONER |
| Matthew Garrett | DIRECTOR OF TRANSPORTATION |



EXPIRES: 12/31/07

LAWRENCE H. FOX
 OBEC CONSULTING ENGINEERS - PROJECT MANAGER

OREGON DEPARTMENT OF TRANSPORTATION
 CONCURRENCE
Harold E. Sealey 2/23/06
 TECHNICAL SERVICES MANAGING ENGINEER DATE


**I-205: WILLAMETTE RIVER BR. -
 PACIFIC HWY. (UNIT 3) SEC.
 EAST PORTLAND FREEWAY
 CLACKAMAS & WASHINGTON COUNTIES**

FEDERAL HIGHWAY ADMINISTRATION	PROJECT NUMBER	SHEET NO.
OREGON DIVISION	IM-OTIA-S064(032)	1



T. 2 S., R. 1 W.,
 R. 1 E. & R. 2 E., W.M.

**BEGINNING OF PROJECT IM-OTIA-S064(032)
 STA. "L" 735+41.85 (M.P. 8.80)**

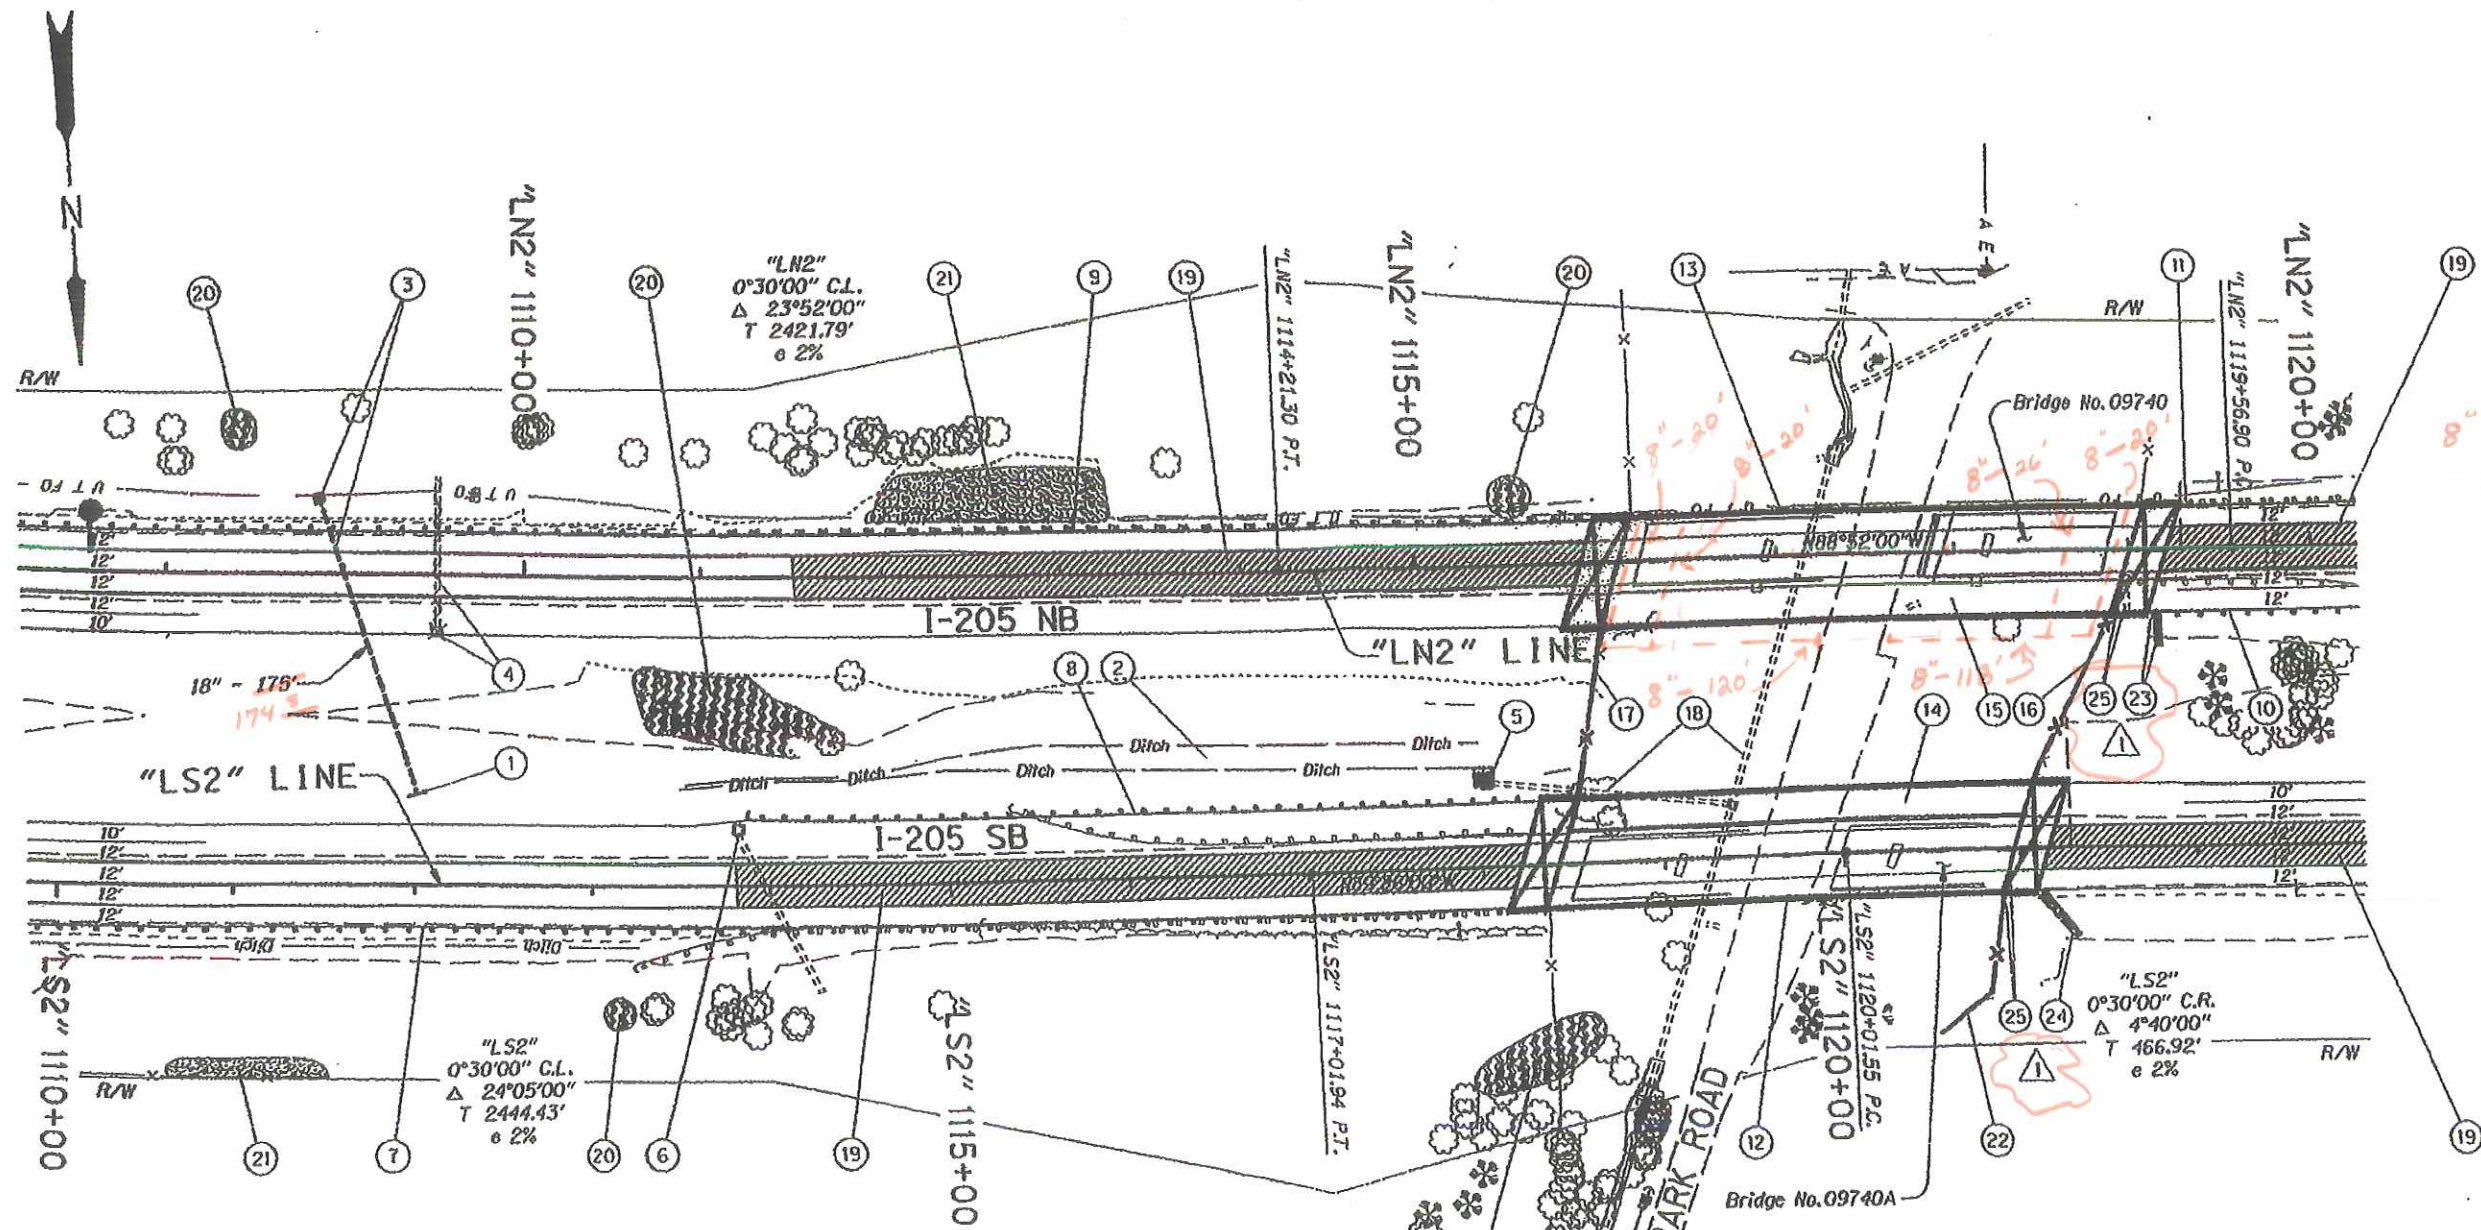

"AS CONSTRUCTED"
Mark Bar
 Date 4/24/09 Project Mngr

RECEIVED
 AUG - 2 2006

LEGEND

Abandon Extg. Pipe Shown Thus:	
Remove Extg. Surfacing Shown Thus:	
Type "A" Weed Control Shown Thus:	
Type "B" Weed Control Shown Thus:	

REVISIONS

	Revised 07-20-2006 Revised Drainage
--	--

REGISTERED PROFESSIONAL ENGINEER
 12295
Jerome D. Lane
 OREGON
 JULY 5, 1983
 JEROME D. LANE
 EXPIRES: 12/31/06

OREGON DEPARTMENT OF TRANSPORTATION
 ROADWAY ENGINEERING SECTION
 I-205 WILLAMETTE RIVER BR. -
 PACIFIC HWY. (UNIT 3) SEC.
 EAST PORTLAND FREEWAY
 CLATSOPAS & WASHINGTON COUNTIES
 Design Team Leader - Jerry Lane
 Designed By - Tom Metcalf
 Drafted By - Serban Dinca

ALIGNMENT AND GENERAL CONSTRUCTION

SHEET NO. 32

- ① Sta. "LS2" 1112+00.52' Lt.
Const. Paved End Slope
F.L. 194.00
(See Drg. Nos. RD300, RD316,
RD318, RD322, RD324 & RD326)
- ② Const. Bio-Swale/Detention Pond 3
Dt. Exc. - 2830 Cu.Yd.
▲ (For Details, See Sht. GJ-4)
- ③ Sta. "LN2" 1108+92.45' Lt.
Const. Type "G2-MA" Inlet
Inst. 18" Sew. Pipe - 175' 74 5
10' Depth
Tunneling, Boring And Jacking - 90'
- ④ Sta. "LN2" 1109+50.4, 52.5' Rt.
Remove Inlet
Abandon Extg. 15" Sew. Pipe - 88'
Fill Abandoned Pipe
- ⑤ Sta. "LS2" 1118+04.1, 47.1' Lt.
Remove Inlet
Const. Outlet Structure
Over Pipe
(For Details, See Sht. GJ-4B)
- ⑥ Cap Extg. Inlet
- ⑦ See Sht. 31. Note 5
Remove Extg. Guardrail - 490'
Const. Guardrail (Type 2A)
Const. Guardrail - 12.5' (Type 3)
Extra For 8' Guardrail Posts - 90'
Const. Guardrail To Bridge Rail Transition
- ⑧ Remove Extg. Guardrail - 295'
Const. Guardrail - 362.5' (Type 2A)
Const. Guardrail - 12.5' (Type 3)
Extra For 8' Guardrail Posts - 15'
Const. Guardrail To Bridge Rail Transition
Const. Guardrail Terminal, Non-Flared (50')
Flare Rate=0, W=1', E=2'
- ⑨ See Sht. 31 Note 6
Remove Extg. Guardrail - 490'
Const. Guardrail (Type 2A)
Const. Guardrail To Bridge Connection
Extra For 8' Guardrail Posts - 95'
- ⑩ Remove Extg. Guardrail - 170'
Const. Guardrail - 4962.5' (Type 2A)
Const. Guardrail - 12.5' (Type 3)
Const. Guardrail To Bridge Rail Transition
- ⑪ Remove Extg. Guardrail - 185'
Const. Guardrail - 387.5 (Type 2A)
Const. Guardrail - 12.5' (Type 3)
Const. Guardrail To Bridge Rail Transition


- ⑫ Br. No. 09740A
Sta. "LS2" 1118+13.7 To Sta. "LS2" 1121+08.5, Rt.
Remove Extg. Bridge Rail - 294.8'
Const. Type "F" Bridge Rail - 294.8'
(For Drg. Nos., See Sht. 1A)
- ⑬ Br. No. 09740
Sta. "LN2" 1115+98.3 To Sta. "LN2" 1119+28.1, Lt.
Remove Extg. Bridge Rail - 329.8'
Const. Type "F" Bridge Rail - 329.8'
(For Drg. Nos., See Sht. 1A)
- ⑭ Br. No. 09740A
Widen Structure - 253'
Rdwy. Width 60'
And Reinf. Panel At Bridge Ends
(For Drg. Nos., See Sht. 1A)
- ⑮ Br. No. 09740
Widen Structure - 288'
Rdwy. Width 60'
And Reinf. Panel At Bridge Ends
(For Drg. Nos., See Sht. 1A)
- ⑯ Sta. "LN2" 1115+85 To Sta. "LN2" 1116+00. Rt.
Remove Type 2 Fence - 135'
Const. Type 2 Fence - 95'
- ⑰ Sta. "LN2" 1118+40 To Sta. "LN2" 1118+88, Rt.
Remove Type 2 Fence - 150'
Const. Type 2 Fence - 105'
- ⑱ Protect Extg. Pipe
- ⑲ Remove Continuously
Reinf. Conc. Pymt. - 4590 Sq. Yd.
- ⑳ Type "A" Weed Control
- ㉑ Type "B" Weed Control
- ㉒ Sta. "LS2" 1120+50 To Sta. "LS2" 1120+89, Rt.
Remove Type 2 Fence - 95'
Const. Type 2 Fence - 95'
- ▲ ㉓ Sta. "LN2" 1119+08.87 To "LN2" 1119+13.87
Const. Asph. Drainage Curb - 5'
Const. Riprap Lined Ditch - 20'
"V" Bottom, 1:2 Slopes, 1' Deep
Dt. Exc. - 2 Cu. Yd.
Loose Riprap (Class 100) - 2 Cu. Yd.
- ▲ ㉔ Sta. "LS2" 1121+08.81, Rt.
Const. Riprap Lined Ditch - 35'
"V" Bottom, 1:2 Slopes, 1' Deep
Dt. Exc. - 3 Cu. Yd.
Loose Riprap (Class 100) - 3 Cu. Yd.
- ▲ ㉕ Remove Extg. Inlet - 2
Remove Extg. Conc. Pipe

"AS CONSTRUCTED"

Munk Noun

Date 6/26/09 Project Mngr


REVISIONS	
▲ 1	Revised 04-10-2006 Revised Note
▲ 2	Revised 07-20-2006 Added Note

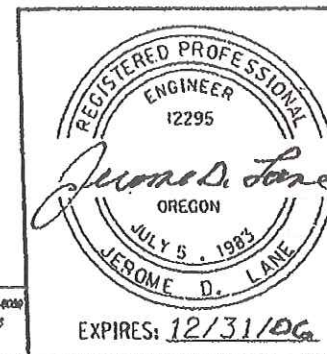

OREGON DEPARTMENT OF TRANSPORTATION ROADWAY ENGINEERING SECTION	
1-205: WILLAMETTE RIVER BR. - PACIFIC HWY. (UNIT 3) SEC. EAST PORTLAND FREEWAY CLACKAMAS & WASHINGTON COUNTIES	
Design Team Leader - Jerry Lane Designed By - Tom Metcalf Drafted By - Mathew Bunde	
CONSTRUCTION NOTES	SHEET NO. 32A

Corporate Office: 800 COUNTRY CLUB ROAD, SUITE 1000 EUGENE, OREGON 97401-8000
600 NISSON STREET SE, SUITE 200 SILENA, OREGON 97136-1202
1000 POPLAR DRIVE ANDERSON, OREGON 97004-5007

"LN2" LINE

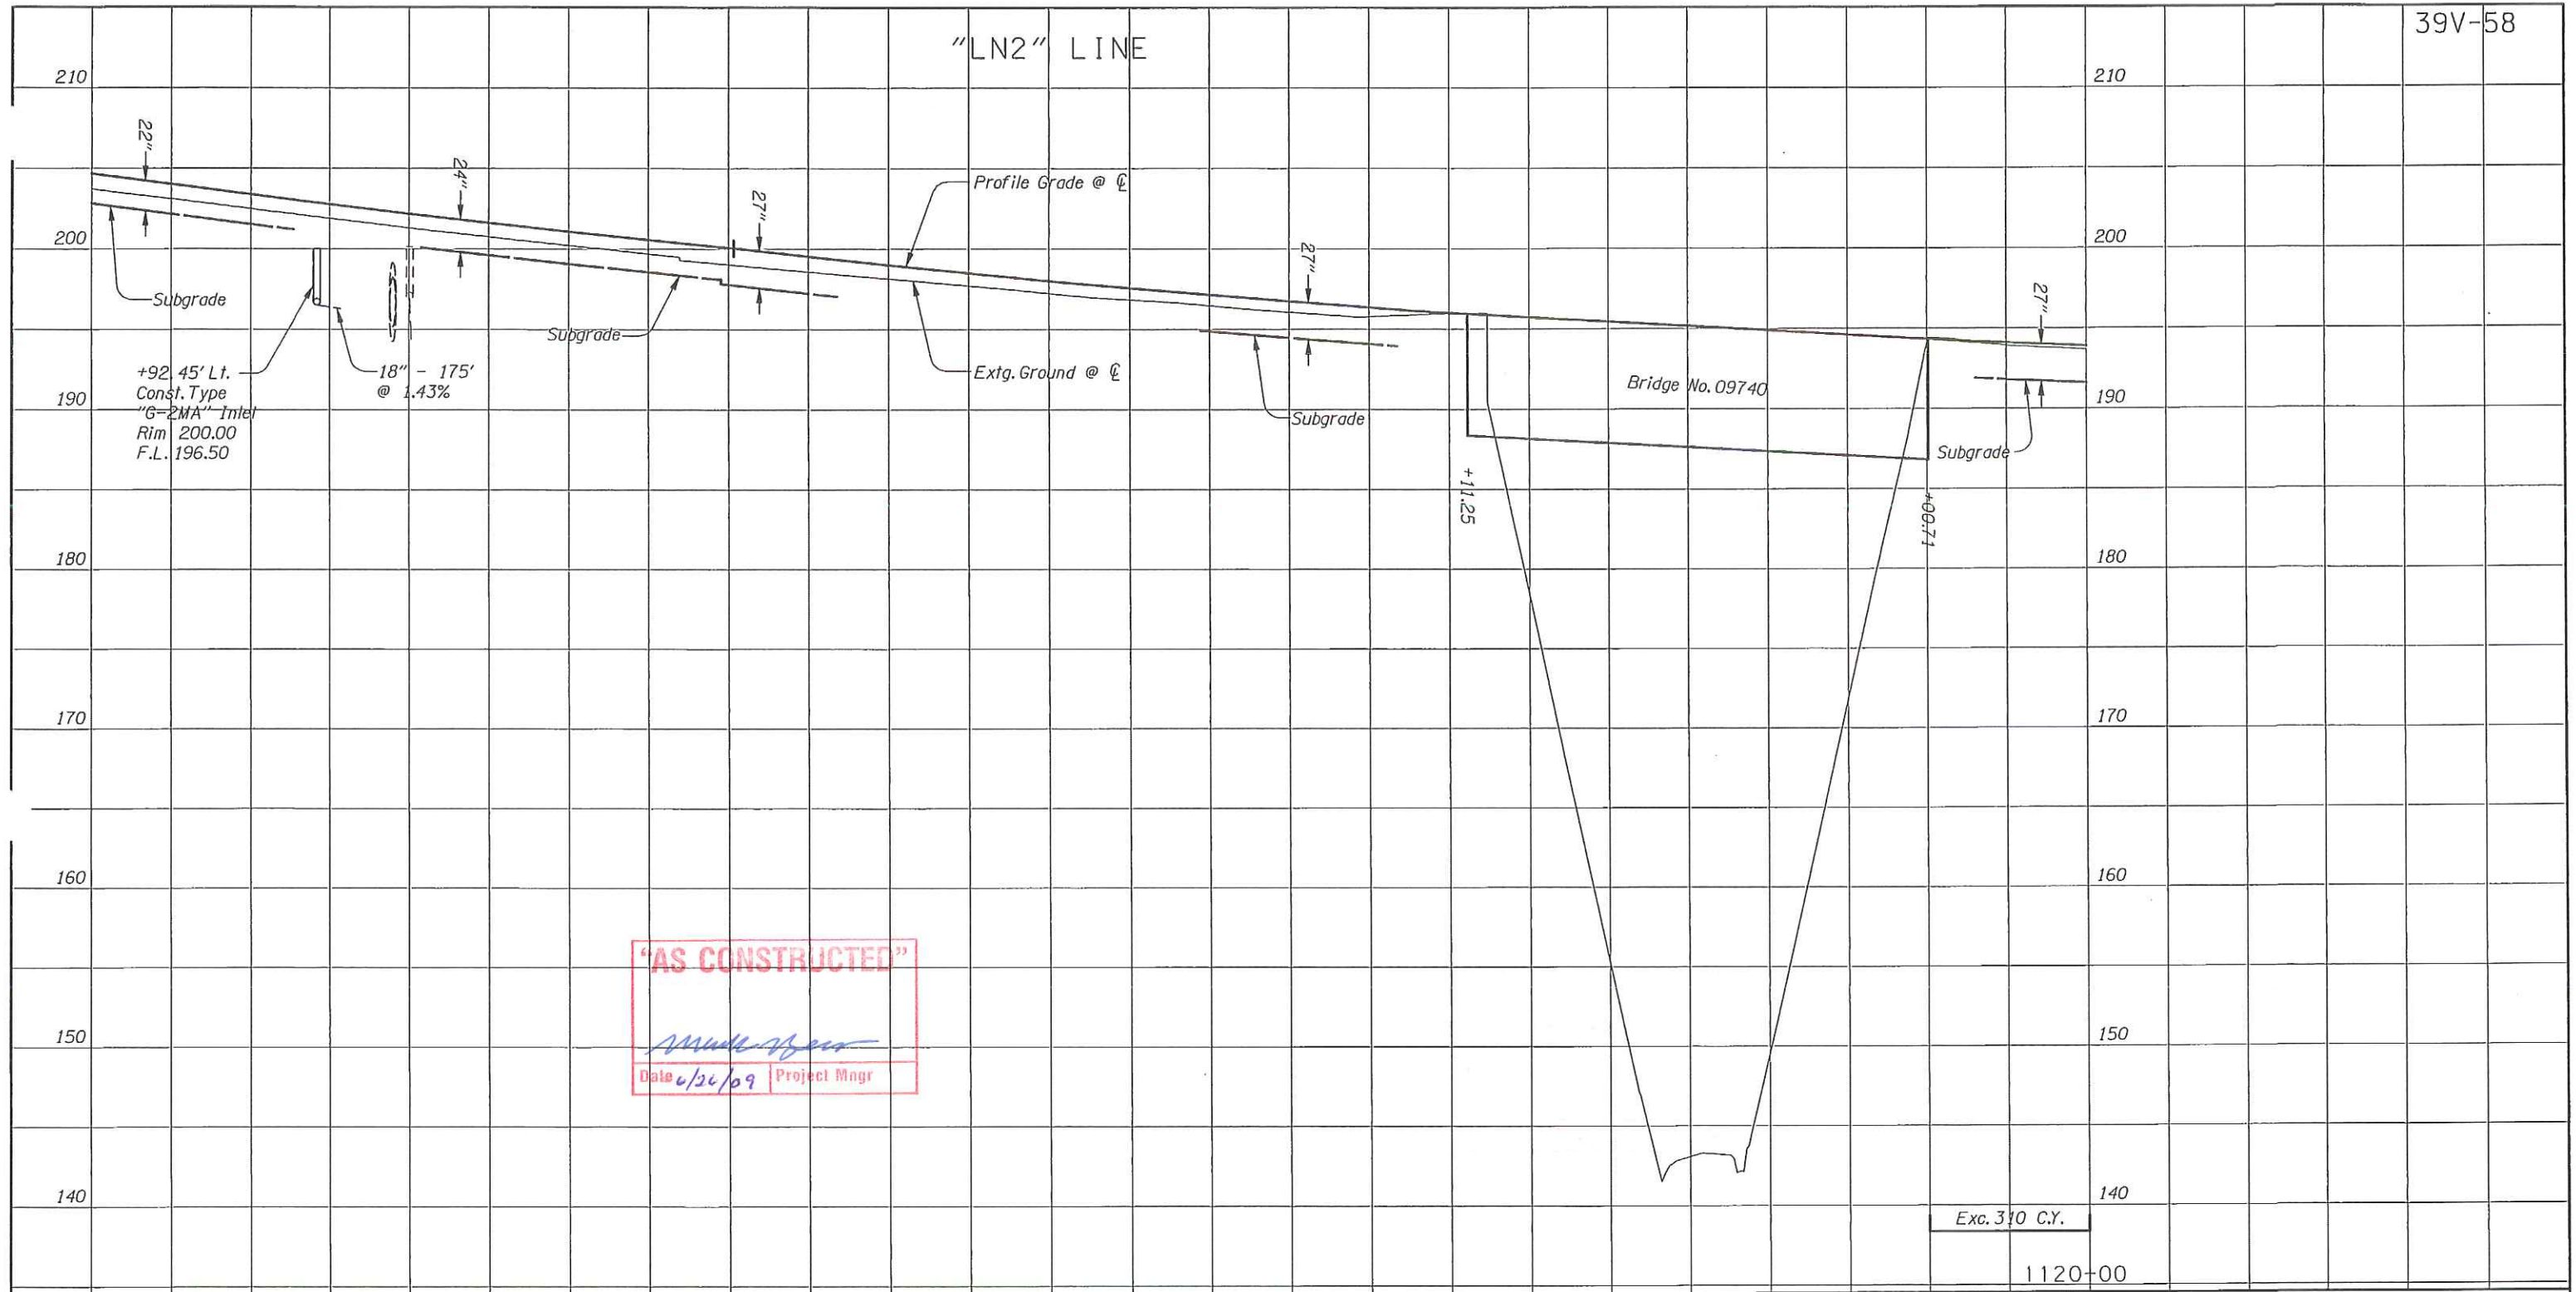


AS CONSTRUCTED
M. D. Lane
 Date 6/26/09 Project Mngr

Exc. 1750 C.Y.

Emb. 1560 C.Y.

Exc. 370 C.Y.

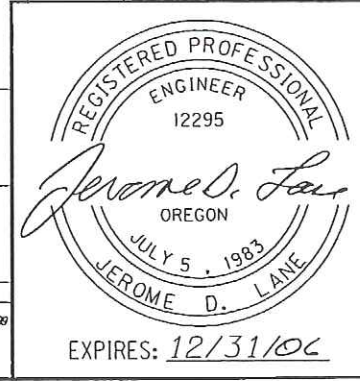

OREGON DEPARTMENT OF TRANSPORTATION
 ROADWAY ENGINEERING SECTION

I-205: WILLAMETTE RIVER BR. -
 PACIFIC HWY. (UNIT 3) SEC.
 EAST PORTLAND FREEWAY
 CLACKAMAS & WASHINGTON COUNTIES

Design Team Leader - Jerry Lane
 Designed By - Tom Metcalf
 Drafted By - Serban Dinca

PROFILE


SHEET NO. 32B

1-15-00



Corporate Office: 920 COUNTRY CLUB ROAD, SUITE 1000 EUGENE, OREGON 97401-6000
 2225 MISSION STREET SE, SUITE 100 SALEM, OREGON 97302-1295
 1335 POPLAR DRIVE MEDFORD, OREGON 97504-6207

"LS2" LINE

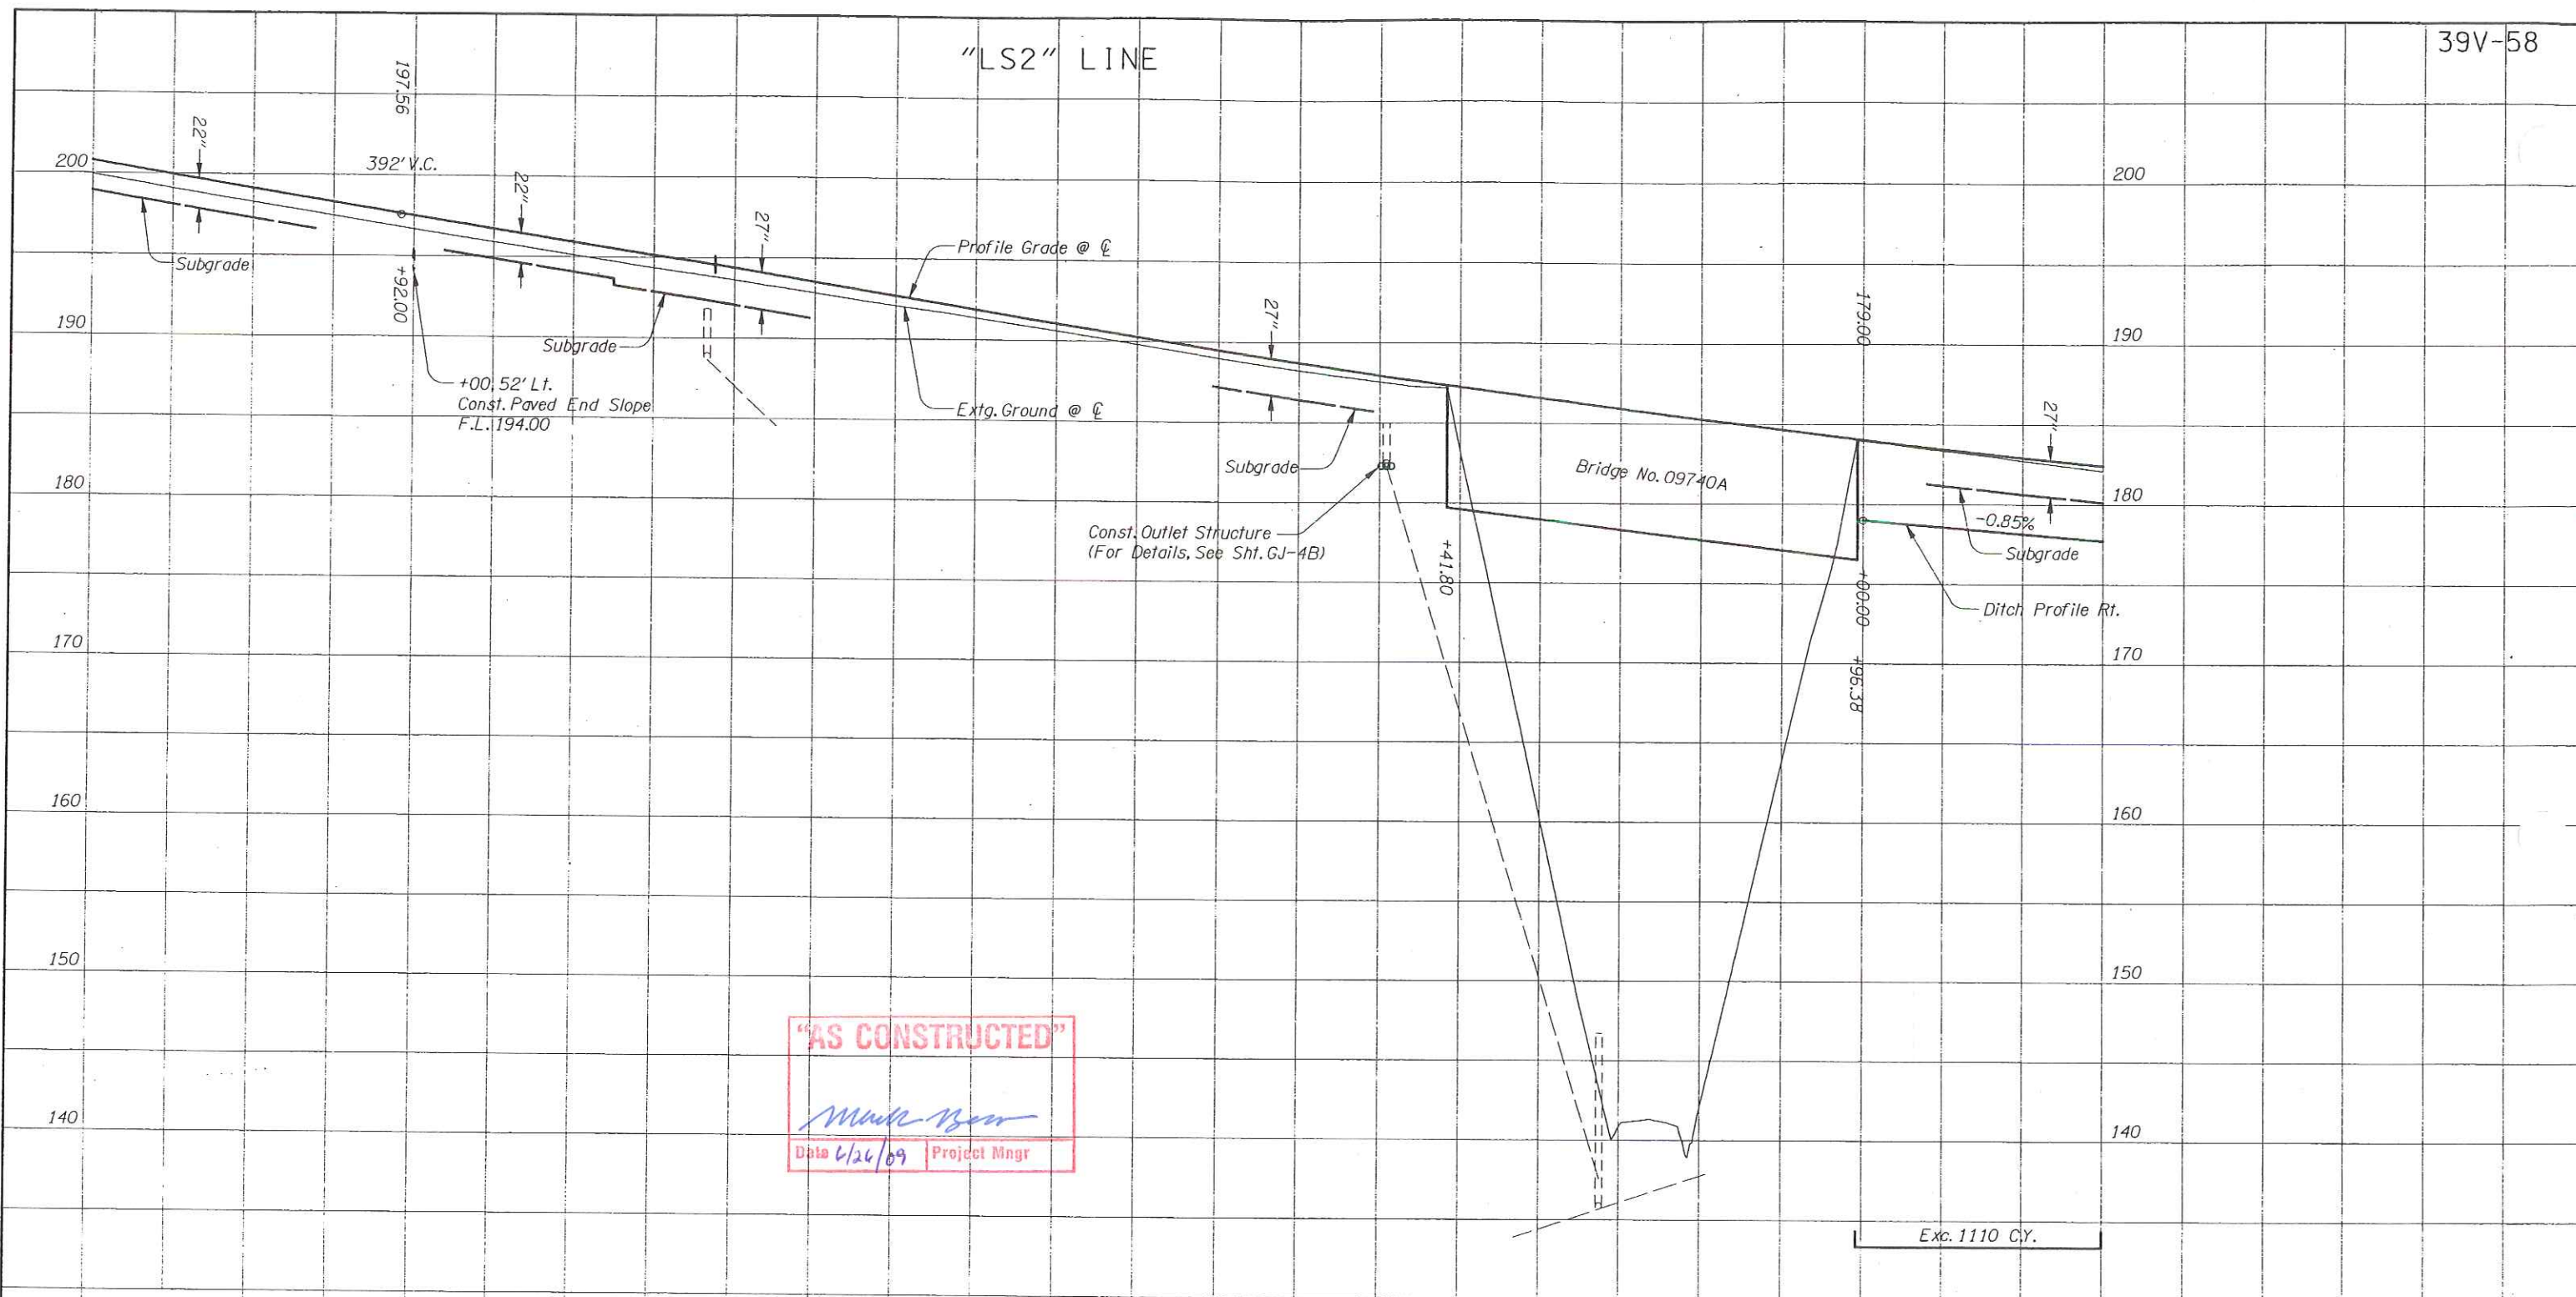

AS CONSTRUCTED


M. M. M. M.
Date 6/24/09 Project Mngr

Exc. 1110 C.Y.

Exc. 3350 C.Y.

Emb. 360 C.Y.

REVISIONS	
1	Revised 04-10-2006 Revised Quantity

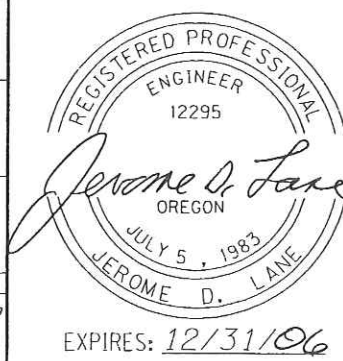

OREGON DEPARTMENT OF TRANSPORTATION
ROADWAY ENGINEERING SECTION

I-205: WILLAMETTE RIVER BR. -
PACIFIC HWY. (UNIT 3) SEC.
EAST PORTLAND FREEWAY
CLACKAMAS & WASHINGTON COUNTIES

Design Team Leader - Jerry Lane
Designed By - Tom Metcalf
Drafted By - Serban Dinca

PROFILE

SHEET NO.

32C



1110+00

1115+00

1120+00



Corporate Office: 820 COUNTRY CLUB ROAD, SUITE 100B EUGENE, OREGON 97401-8089
2225 MISSION STREET SE, SUITE 100 SALEM, OREGON 97302-1296
1335 POPLAR DRIVE MEDFORD, OREGON 97504-5207

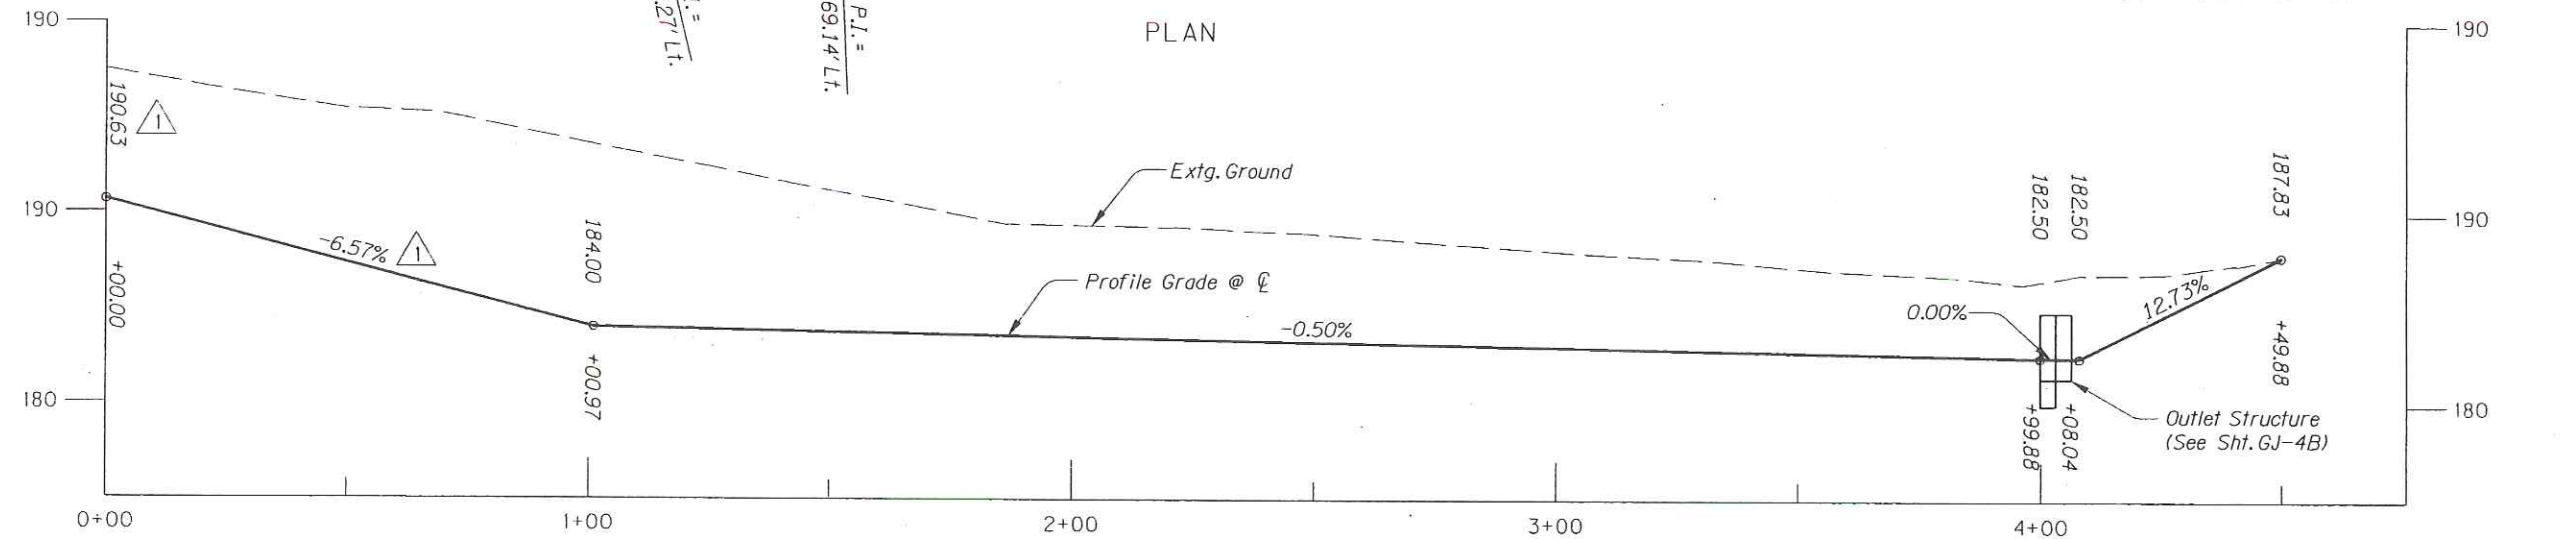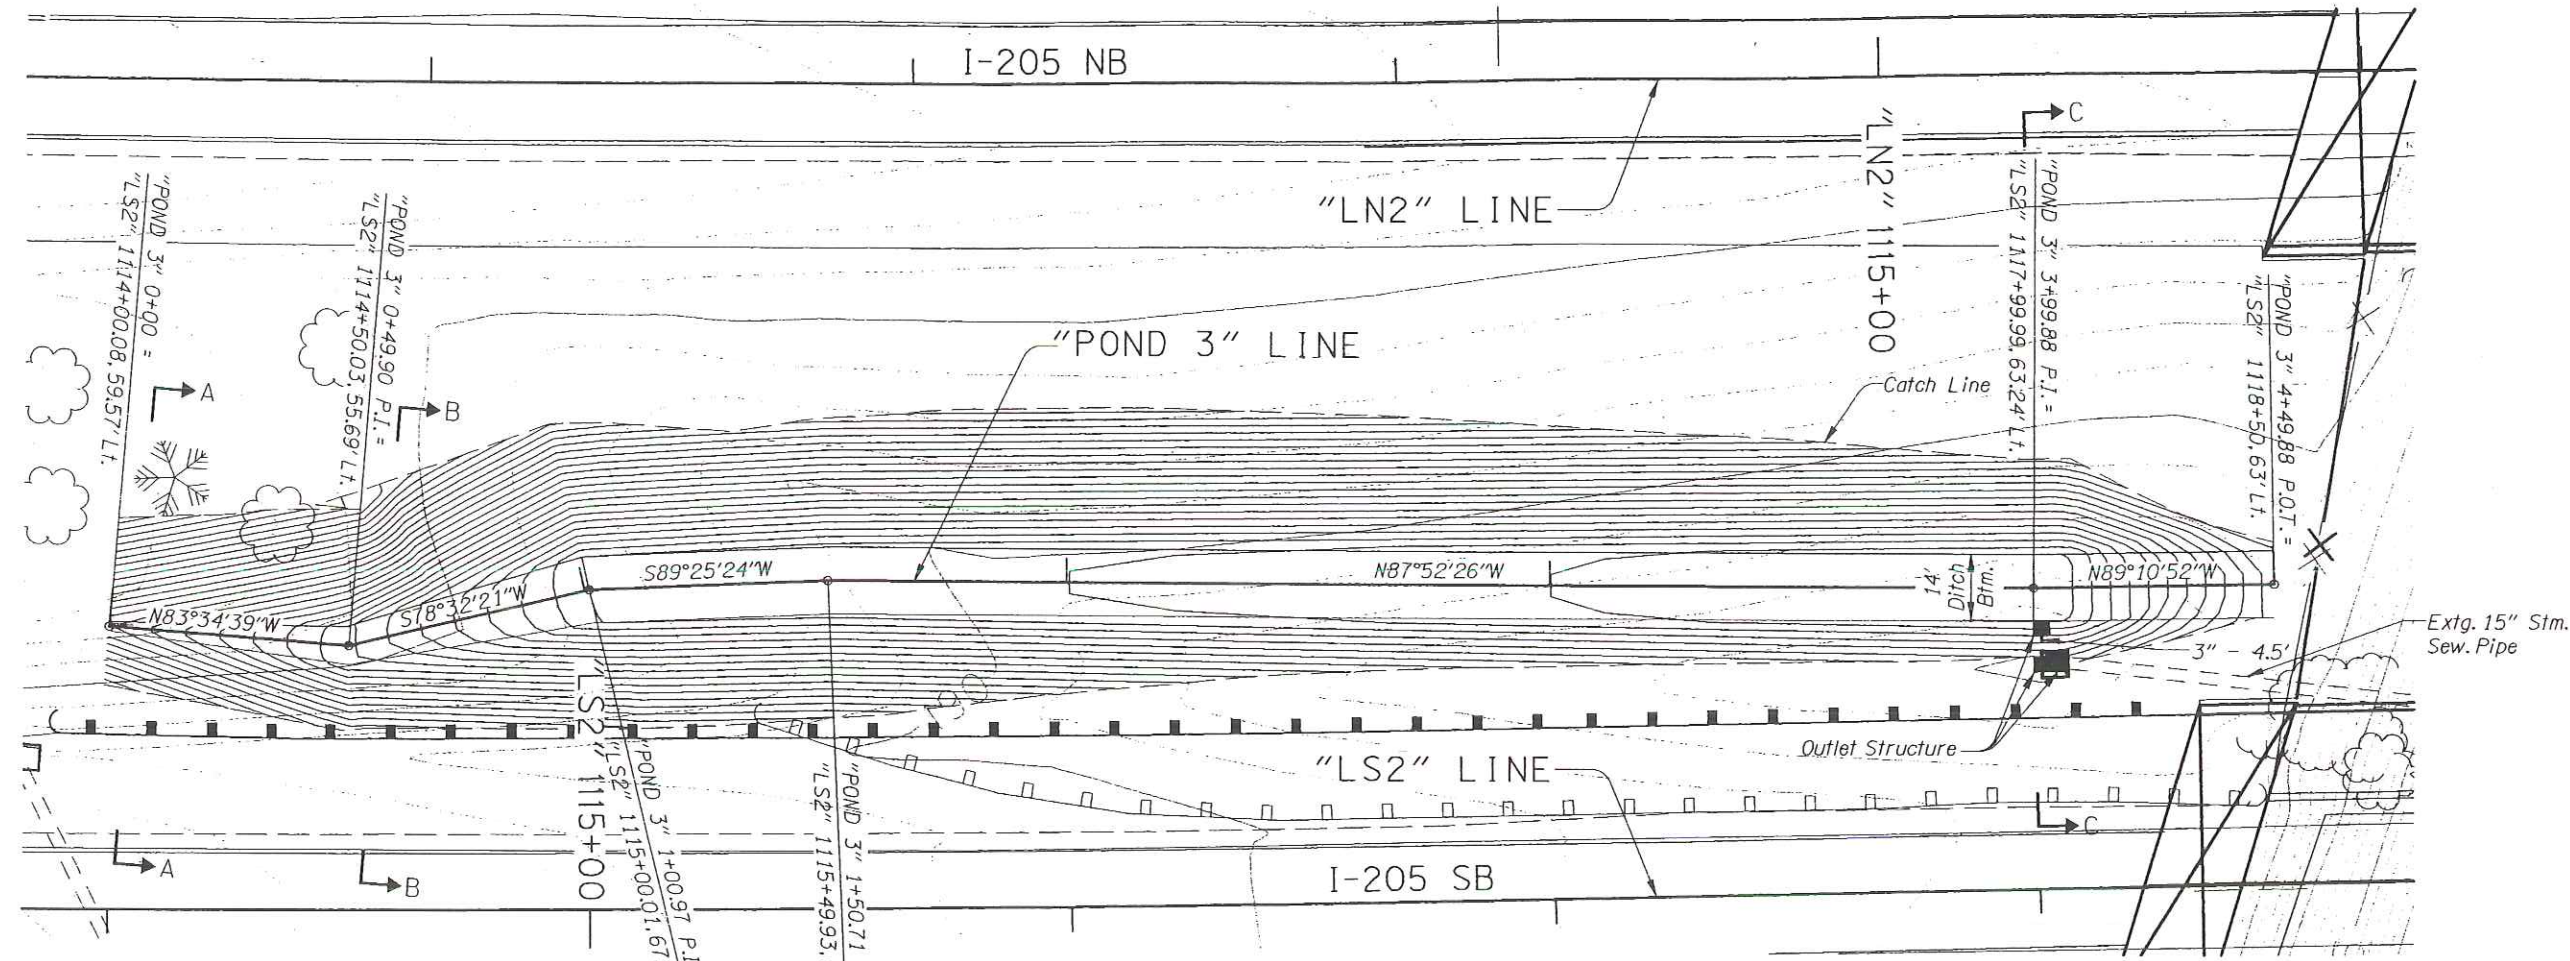

PROFILE
(See Sht. 32, Notes 2 & 5)

"AS CONSTRUCTED"
Mark Beers
 Date 6/26/09 Project Mngr

NOTE:
 For Sections Not Shown,
 See Sht. GJ-4A.
 For Outlet Structure Details,
 See Sht. GJ-4B.

REVISIONS	
⚠	Revised 04-10-2006 Revised Profile

REGISTERED PROFESSIONAL
 ENGINEER
 12295
Jerome D. Lane
 OREGON
 JULY 5, 1983
 JEROME D. LANE
 EXPIRES: 12/31/06


OREGON DEPARTMENT OF TRANSPORTATION
 ROADWAY ENGINEERING SECTION

**I-205: WILLAMETTE RIVER BR. -
 PACIFIC HWY. (UNIT 3) SEC.**
 EAST PORTLAND FREEWAY
 CLACKAMAS & WASHINGTON COUNTIES


Design Team Leader - Jerry Lane
 Designed By - James Kent
 Drafted By - Yoshi Ishii

**POND 3
 PLAN AND PROFILE**


SHEET NO. GJ-4

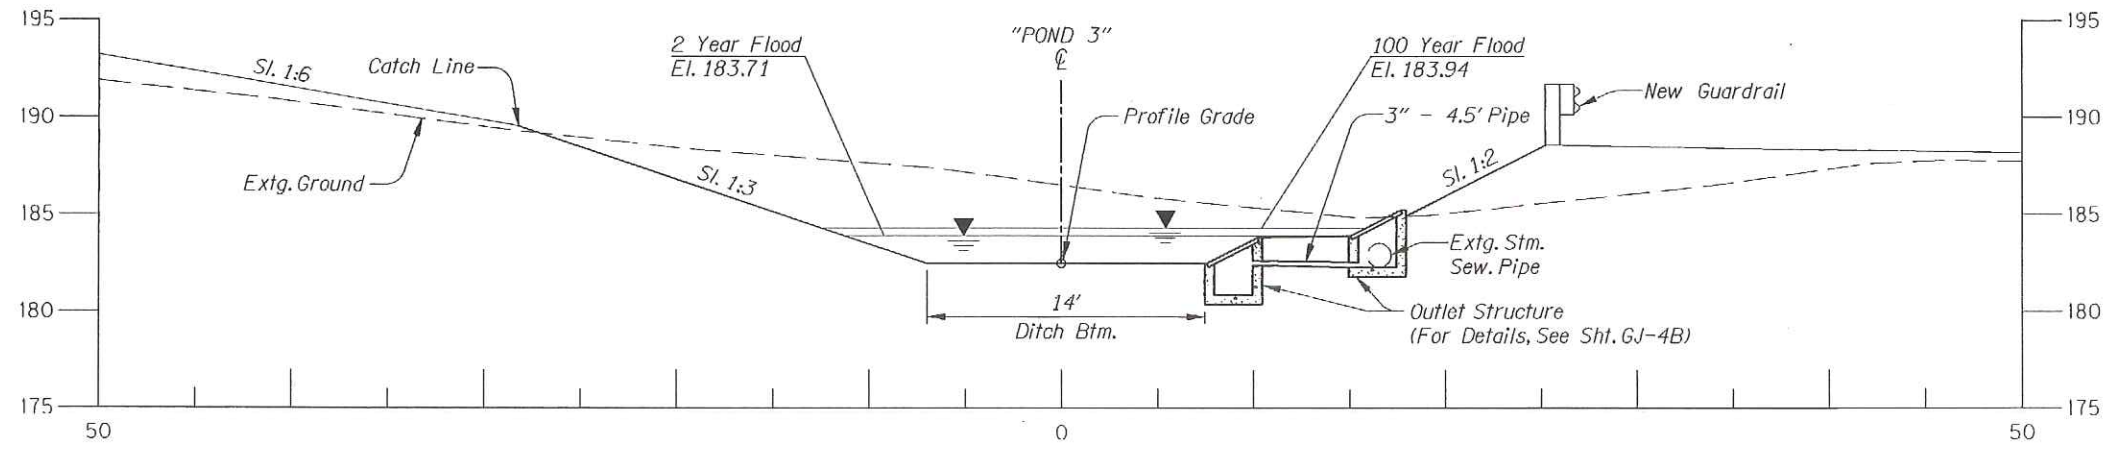

SECTION C-C

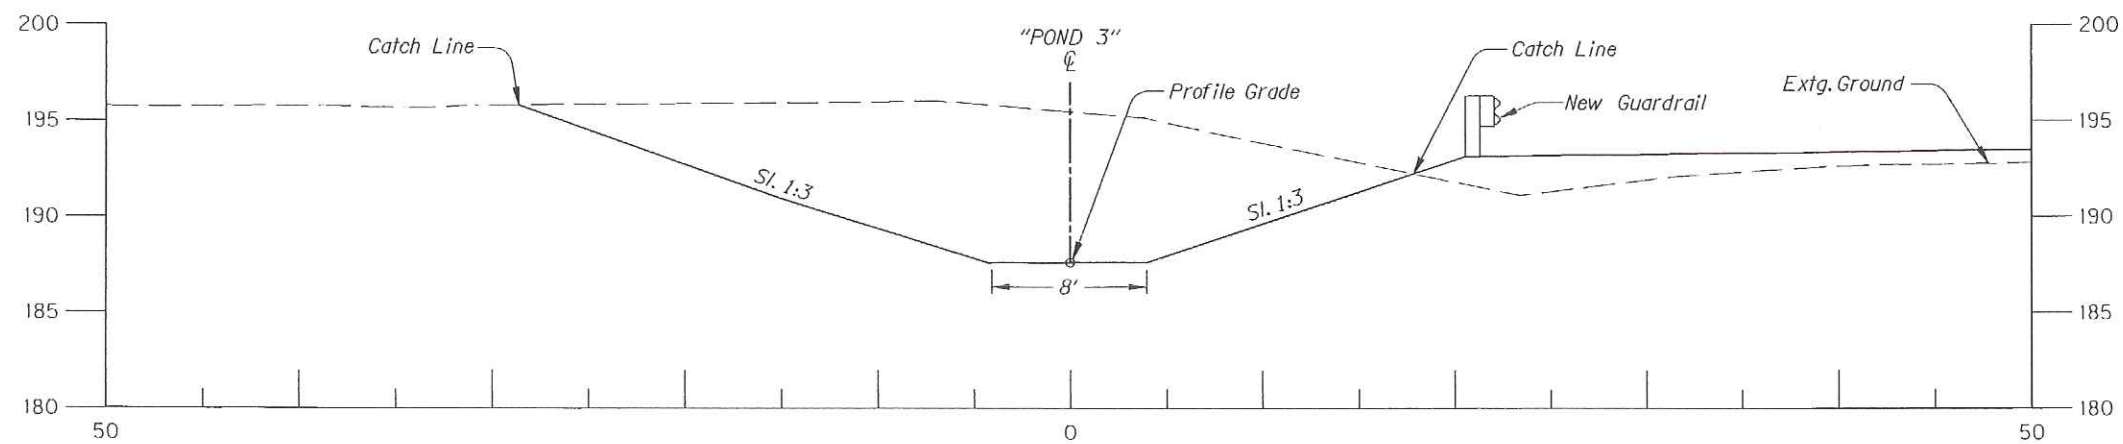

SECTION B-B

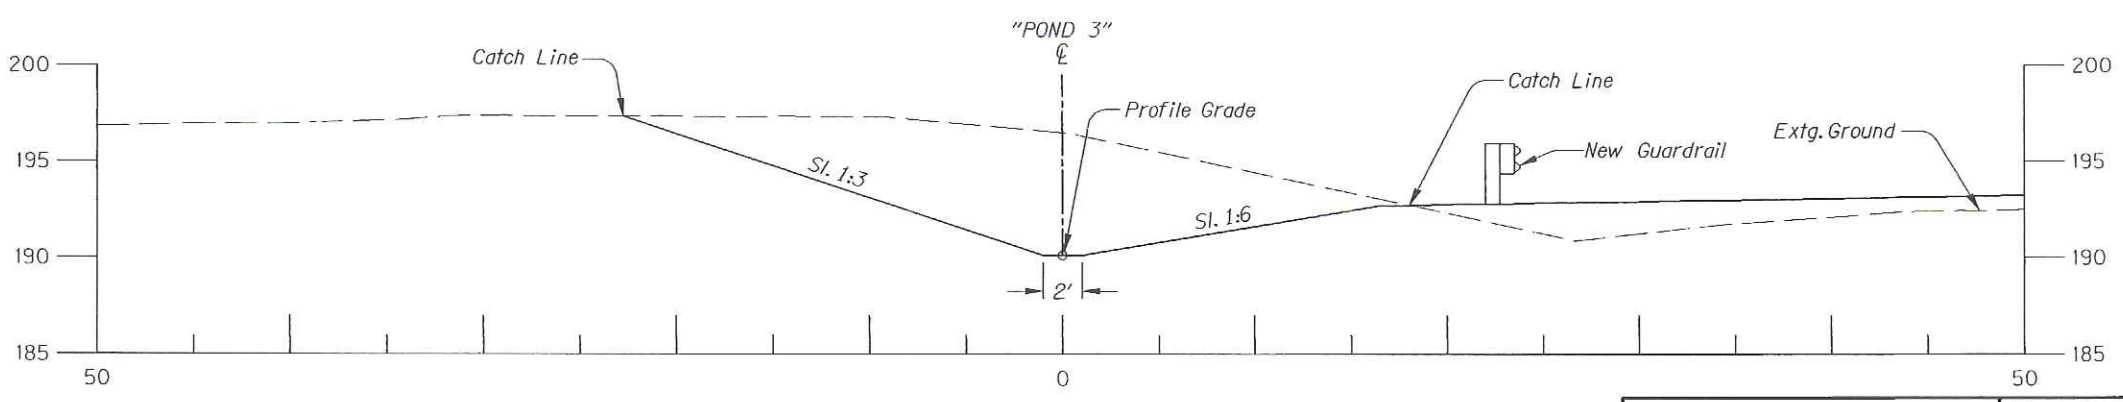


SECTION A-A

"AS CONSTRUCTED"
Mathew Bunde
 Date 4/26/09 Project Mngr


REGISTERED PROFESSIONAL
 ENGINEER
 12295
Jerome D. Lane
 OREGON
 JULY 5, 1983
 JEROME D. LANE
 EXPIRES: 12/31/06

OREGON DEPARTMENT OF TRANSPORTATION
ROADWAY ENGINEERING SECTION
I-205: WILLAMETTE RIVER BR. -
PACIFIC HWY. (UNIT 3) SEC.
 EAST PORTLAND FREEWAY
 CLACKAMAS & WASHINGTON COUNTIES
 Design Team Leader - Jerry Lane
 Designed By - James Kent
 Drafted By - Mathew Bunde
POND 3
CROSS SECTIONS
 SHEET NO. GJ-4A

CONSULTING ENGINEERS
 Corporate Office: 920 COUNTRY CLUB ROAD, SUITE 100B EUGENE, OREGON 97401-6289
 2235 MISSION STREET SE, SUITE 100 SALEM, OREGON 97302-1295
 1335 POPLAR DRIVE MEDFORD, OREGON 97504-5207

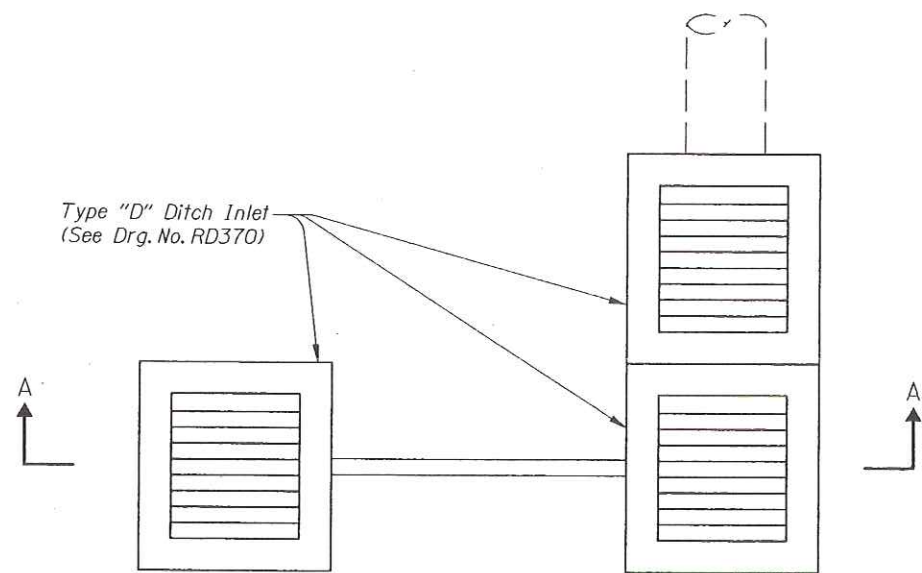

PLAN

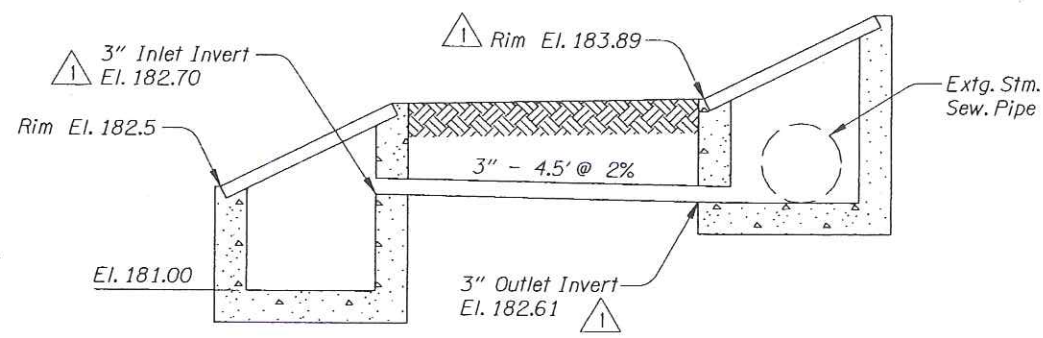

SECTION A-A

OUTLET STRUCTURE

"AS CONSTRUCTED"
Mark Bunde
 Date 6/26/09 Project Mngr

REVISIONS	
1	Revised 03-23-2006 Revised Elevations

OBEC CONSULTING ENGINEERS
 Corporate Office: 520 COUNTRY CLUB ROAD, SUITE 100B EUGENE, OREGON 97401-0089
 2235 MISSION STREET SE, SUITE 100 SALEM, OREGON 97302-1295
 1335 POPLAR DRIVE MEDFORD, OREGON 97504-5207

REGISTERED PROFESSIONAL ENGINEER
 12295
Jerome D. Lane
 OREGON
 JULY 5, 1983
 JEROME D. LANE
 EXPIRES: 12/31/06

OREGON DEPARTMENT OF TRANSPORTATION
 ROADWAY ENGINEERING SECTION

I-205: WILLAMETTE RIVER BR. -
 PACIFIC HWY. (UNIT 3) SEC.
 EAST PORTLAND FREEWAY
 CLACKAMAS & WASHINGTON COUNTIES

Design Team Leader - Jerry Lane
 Designed By - James Kent
 Drafted By - Mathew Bunde

POND 3
DETAILS

SHEET NO.
GJ-4B