

# OPERATION & MAINTENANCE MANUAL

## WATER QUALITY BIOFILTRATION SWALE

Manual prepared: July 2017

DFI No. D00162



Figure 1: DFI No. D00162, looking North

## 1. Identification

Drainage Facility ID (DFI): D00162  
Facility Type: Water Quality Biofiltration Swale  
Construction Drawings: (V-File Numbers) 39V-070  
Location: District: 2B  
Highway No.: 140  
Mile Post: 4.00 to 3.85

## 2. Manual Purpose

The purpose of this manual is to outline inspection needs and summarize maintenance actions.

## 3. Facility Location

The location map below details the facility location. The highway, mile points, side streets, access location, and stormwater flow direction is noted on the map.

Flow direction: North

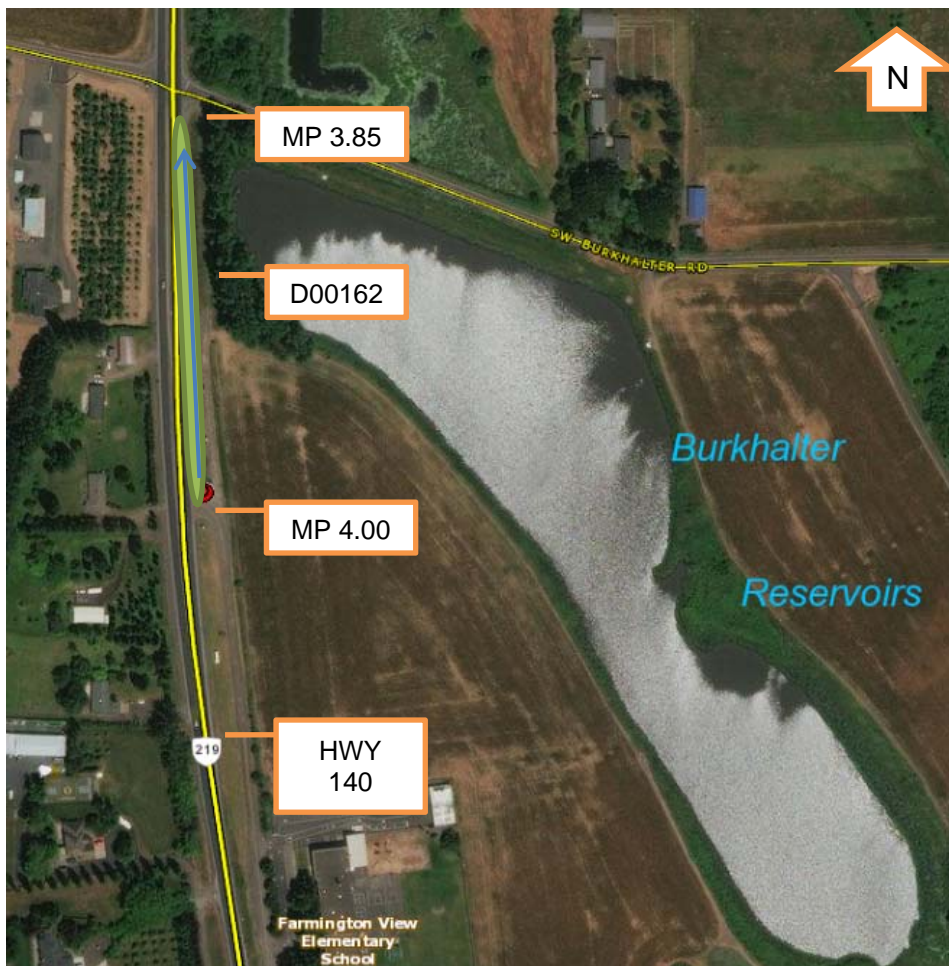



Figure 2: Facility location

#### 4. Facility Summary

The length and width of a swale is based on the bottom dimensions.

The bottom length and bottom width of the swale is:

Bottom Length (feet)	Bottom Width (feet)
510	6

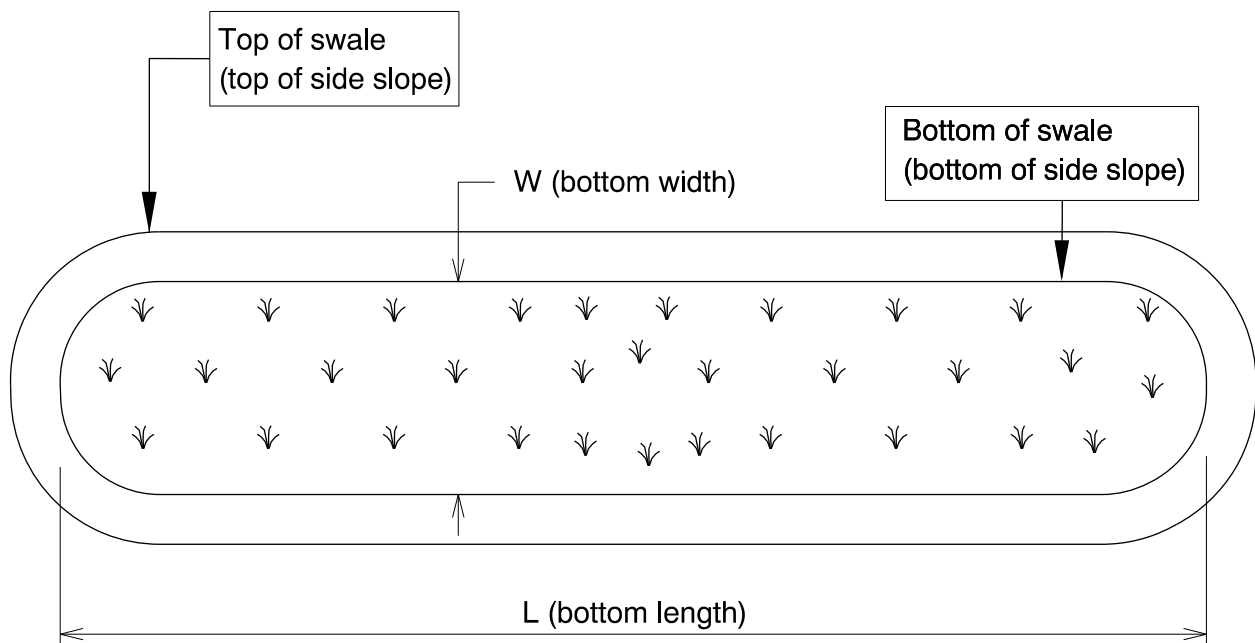


The depth of the swale is the vertical distance measured from the bottom of the swale to the top. The slope of the swale sides is presented by a vertical distance (rise) followed by the horizontal distance (run).

Depth and side slopes:

<b>Depth (feet)</b>
<b>Varies</b>

<b>Side slope</b>	
<b>Rise (feet)</b>	<b>1</b>
<b>Run (feet)</b>	<b>4</b>

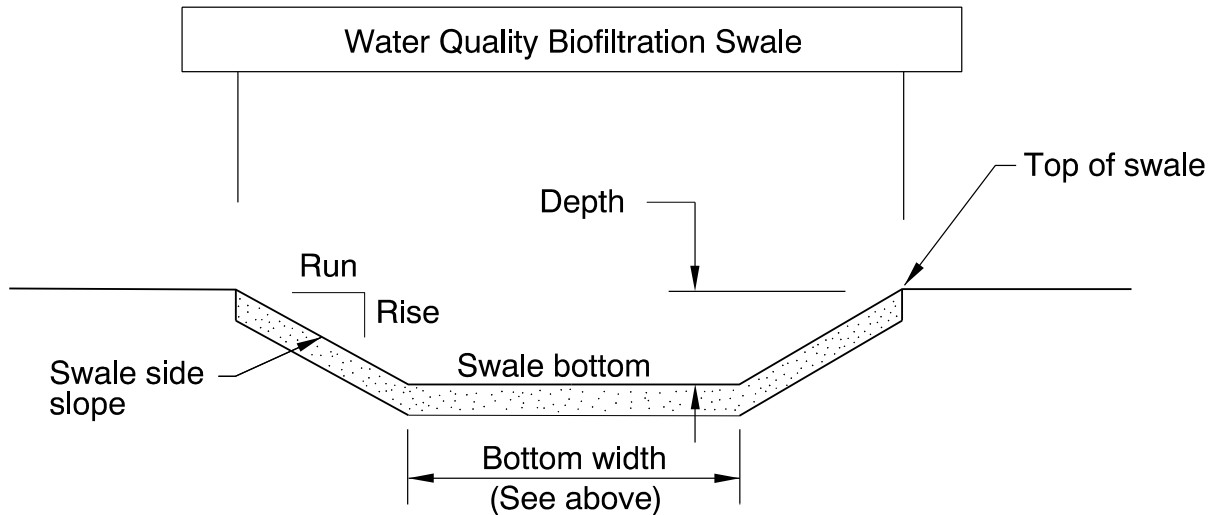

Site Specific Information: This facility has ten “water quality check slots” which are pockets of granular drain rock that are placed in the bottom of the swale. See site specific operational plan in Appendix A of this document.

## 5. Facility Access

Maintenance access to the swale:

<input type="checkbox"/> Roadside pad	<input checked="" type="checkbox"/> Roadside shoulder
<input type="checkbox"/> Access road with Gate	<input type="checkbox"/> Access road without Gate



Figure 3: Swale facility with shoulder access, looking South

## 6. Operational Components / Maintenance Items

### Classification

This facility is classified as an:

<input checked="" type="checkbox"/> On-line Swale	<input type="checkbox"/> Off-line Swale
A swale that does not include a high flow bypass component; flow drains into and through the facility	A swale that treats low/small flows and diverts high flows using a bypass component

**Bypass Component**

This facility includes a high flow bypass component:

<input checked="" type="checkbox"/> No	<input type="checkbox"/> Yes
There is no bypass component. High flows drain into and through the facility	There is a bypass component. Only low/small flows drain into the swale. High flows are diverted around the swale using a bypass component

### Operational Components

A swale has many components that assist with treatment, conveyance, and reducing flow velocity to minimize erosion. The components in use can vary depending if the facility was designed to operate on-line or off-line. The table below titled “Swale Components” has been provided to highlight the applicable components for this facility. The component is in use when the box contains an “x” (e.g.  ).

How a swale operates, typical footprint configuration, and component definitions and details are outlined in the Standard Operation Manual for Water Quality Biofiltration Swales (implemented March 2017). A link to the Manual is attached to the feature marker in TransGIS.

### Operational Plan

The applicable standard operational plan for this facility is:

<input checked="" type="checkbox"/> Operational Plan A	<input type="checkbox"/> Operational Plan C
<input type="checkbox"/> Operational Plan B	
A standard operational plan illustrates the general facility footprint configuration and explains the purpose of each facility component. Operational plans (A,B,C) are provided in the Standard Operation Manual.	

See Appendix A of this O& M Manual for site specific operational plan.

### Maintenance Items

Operational components marked in the “Swale Components” table should be inspected and maintained according to Section 7. Each swale component is defined and detailed in the Standard Operation Manual using the associated “ID” number noted below.

<b>Swale Components</b>		<b>ID #</b>
<b>Manholes/Structures</b>		
Pre-treatment manhole	<input type="checkbox"/>	<b>S1</b>
Weir type flow splitter/flow splitter manhole	<input type="checkbox"/>	<b>S2</b>
Orifice type flow splitter/flow splitter manhole	<input type="checkbox"/>	<b>S3</b>
Standard manhole	<input type="checkbox"/>	<b>S4</b>
<b>Swale Inlet</b>		
Pavement sheet flow	<input checked="" type="checkbox"/>	<b>S5</b>
Storm drain inlet pipe(s)	<input checked="" type="checkbox"/>	<b>S6</b>
Open channel inlet	<input type="checkbox"/>	<b>S7</b>
Riprap pad	<input type="checkbox"/>	<b>S8</b>
<b>Ground Cover</b>		
Grass bottom	<input checked="" type="checkbox"/>	<b>S9</b>
Grass side slopes	<input checked="" type="checkbox"/>	<b>S10</b>
Granular drain rock	<input checked="" type="checkbox"/>	<b>S11</b>
Plantings	<input type="checkbox"/>	<b>S12</b>
<b>Underground Components</b>		
Geotextile fabric	<input checked="" type="checkbox"/>	<b>S13</b>
Water quality mix	<input type="checkbox"/>	<b>S14</b>
Perforated pipe	<input type="checkbox"/>	<b>S15</b>
Porous pavers (access grid)	<input type="checkbox"/>	<b>S16</b>
<b>Flow Spreader</b>		
Rock basin (used at inlet)	<input type="checkbox"/>	<b>S17</b>
Anchored board (midpoint of swale or every 50 feet along swale bottom)	<input type="checkbox"/>	<b>S18</b>
Other: Rock check dams	<input checked="" type="checkbox"/>	<b>S19</b>
<b>Swale Outlet</b>		
Catch basin with grate	<input type="checkbox"/>	<b>S20</b>
Storm drain outlet pipe	<input type="checkbox"/>	<b>S21</b>
Open channel outlet	<input checked="" type="checkbox"/>	<b>S22</b>
Auxiliary Outlet	<input type="checkbox"/>	<b>S23</b>
<b>Outfall Type</b>		
Waterbody (Creek/Lake/Ocean)	<input type="checkbox"/> <b>C</b>	<b>S24</b>
	<input type="checkbox"/> <b>L</b>	
	<input type="checkbox"/> <b>O</b>	
Ditch	<input checked="" type="checkbox"/>	<b>S25</b>
Storm drain system	<input type="checkbox"/>	<b>S26</b>
<b>Outfall Components</b>		
Riprap pad	<input type="checkbox"/>	<b>S27</b>
Riprap bank protection	<input type="checkbox"/>	<b>S28</b>

## 7. Maintenance

### Maintenance Frequency/Maintain Records

- a. Inspect annually. Preferably prior to the rainy season.
- b. Clean and maintain as necessary. Refer to the Activity 125 in the Maintenance Guide for conditions when maintenance is needed.
- c. Keep a record of inspections, maintenance, and repairs.

### Maintenance Guide/Maintenance Actions

The Maintenance Guide outlines the standard maintenance actions for water quality and detention facilities under Activity 125.

There are standard maintenance tables for standard ODOT designs. The maintenance tables describe the following (a) conditions when maintenance is needed (b) recommended maintenance to correct the condition. Use the following tables to maintain ODOT swales:

- Table 1 (General Maintenance): Contains general maintenance and inspection guidelines that are applicable to all ODOT water quality and detention facilities
- Tables 3 (Maintenance of Water Quality or Biofiltration Swales): Contains maintenance information for swales

The ODOT Maintenance Guide can be viewed at the following website:

<http://www.oregon.gov/ODOT/HWY/OOM/pages/mguide.aspx>

## 8. Limitations

Access grid installed:

<input checked="" type="checkbox"/> <b>No</b>	<input type="checkbox"/> <b>Yes</b>
<b>There are (light, med., heavy) duty porous pavers installed in this swale</b>	

Swales are designed to allow equipment access along the bottom. If an access grid is **NOT** installed, vehicles entering the swale can create depressions (tire ruts), damage vegetation, or damage structural components (e.g. flow spreaders). These conditions may result in poor treatment and drainage performance.

Equipment wheels should be kept on the tops and side slopes. Mower arms may be run along the swale bottom.



## 9. Waste Material Handling

Material removed from the facility is defined as waste by the Department of Environmental Quality (DEQ). Refer to the road waste section of the ODOT Maintenance Yard Environmental Management System (EMS) Policy and Procedures Manual for disposal options:

<http://www.oregon.gov/ODOT/HWY/OOM/pages/ems.aspx>






Contact any of the following for more detailed information about management of waste materials found on site:

ODOT Clean Water Unit	(503) 986-3008
ODOT Statewide Hazmat Coordinator	(503) 229-5129
ODOT Region Hazmat Coordinator	(503) 986-2647
ODEQ Northwest Region Office	(503) 229-5263

## Appendix A

### Contents:

- **Site Specific Operational Plan**

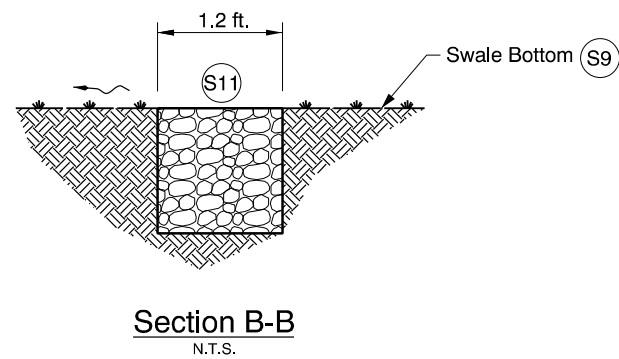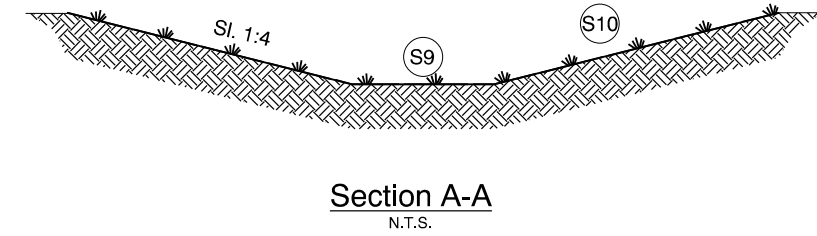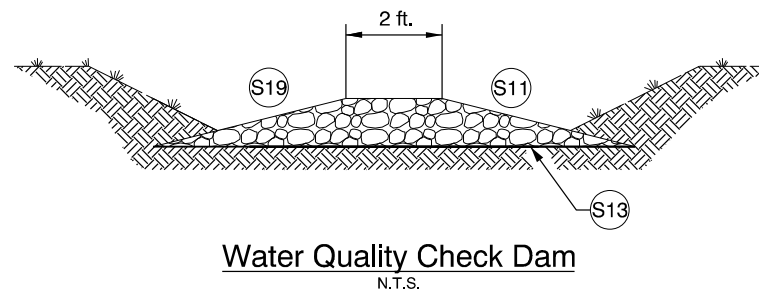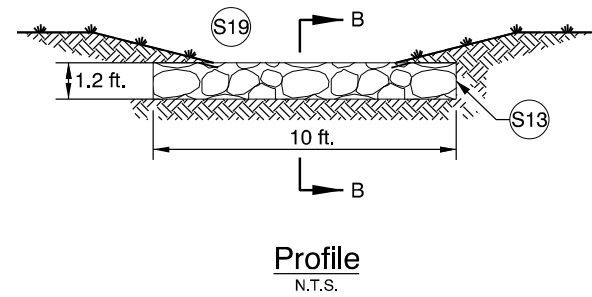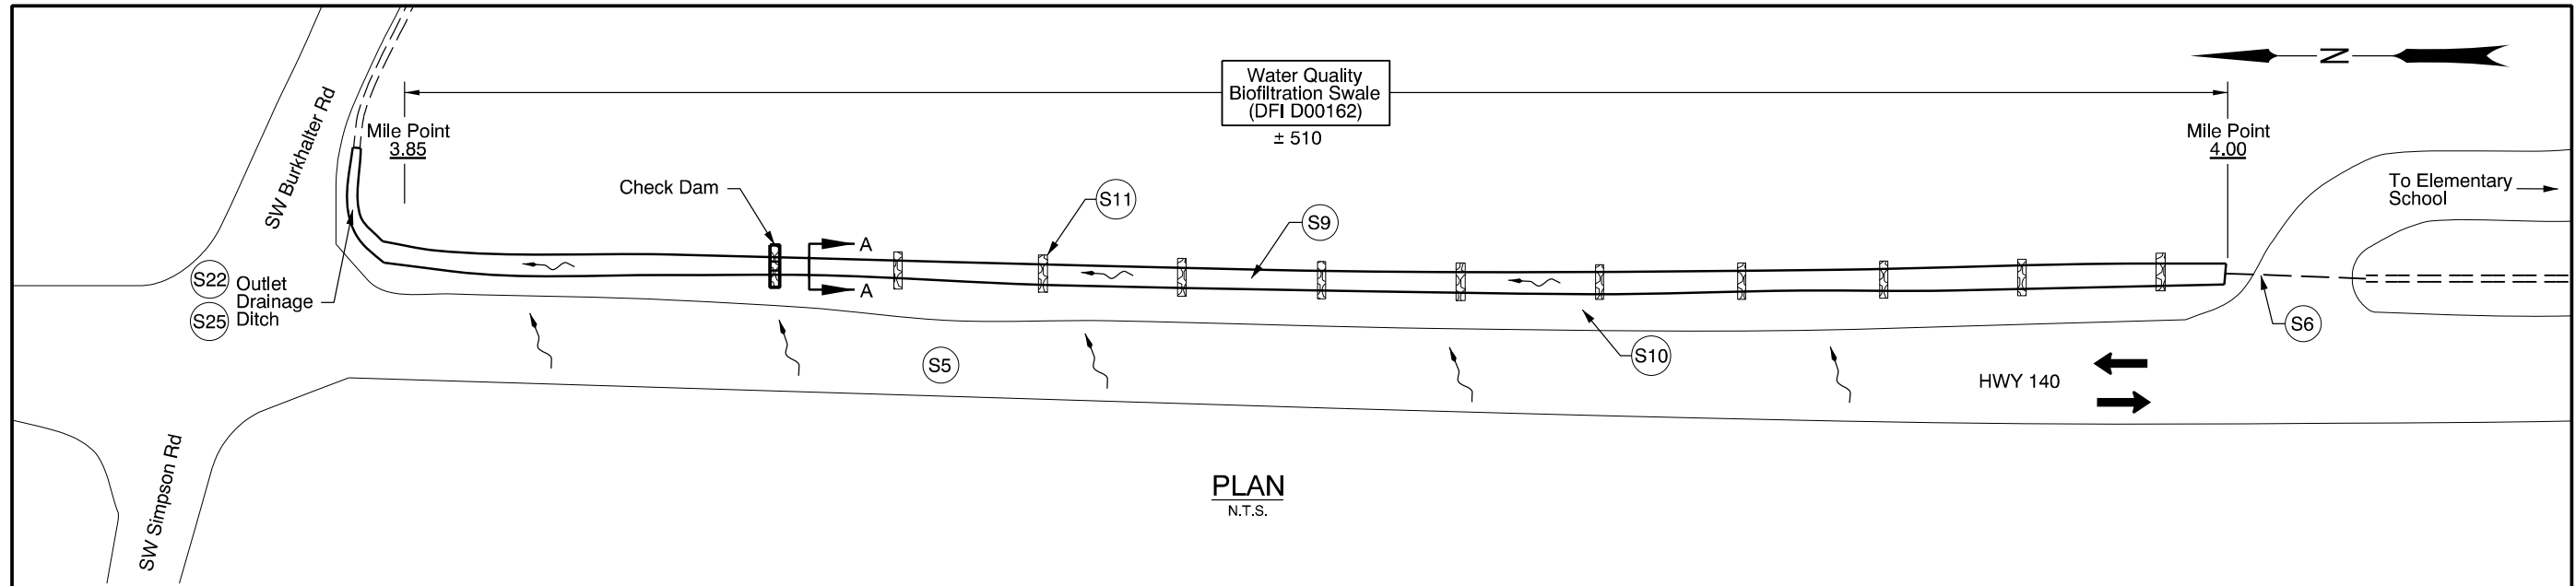

- LEGEND**
- Water Quality Check Slot
  - Stormwater Flow Path
  - 16" Inlet Culvert
  - Traffic Direction
  - Table 1: Facility Components

OREGON DEPARTMENT OF TRANSPORTATION

Prepared By:  
Brooklyn Scholz

Drafted By:  
Brooklyn Scholz


**DFI D00162**  
**MAINTENANCE DISTRICT 2B HWY 140**  
**WATER QUALITY BIOFILTRATION SWALE**  
HIGHWAY MP 4.00, 3.85  
WASHINGTON

## Appendix B

### Contents:


- ODOT Project Plan Sheets

Sec. 24, T. 1S, R. 3W, W.M.

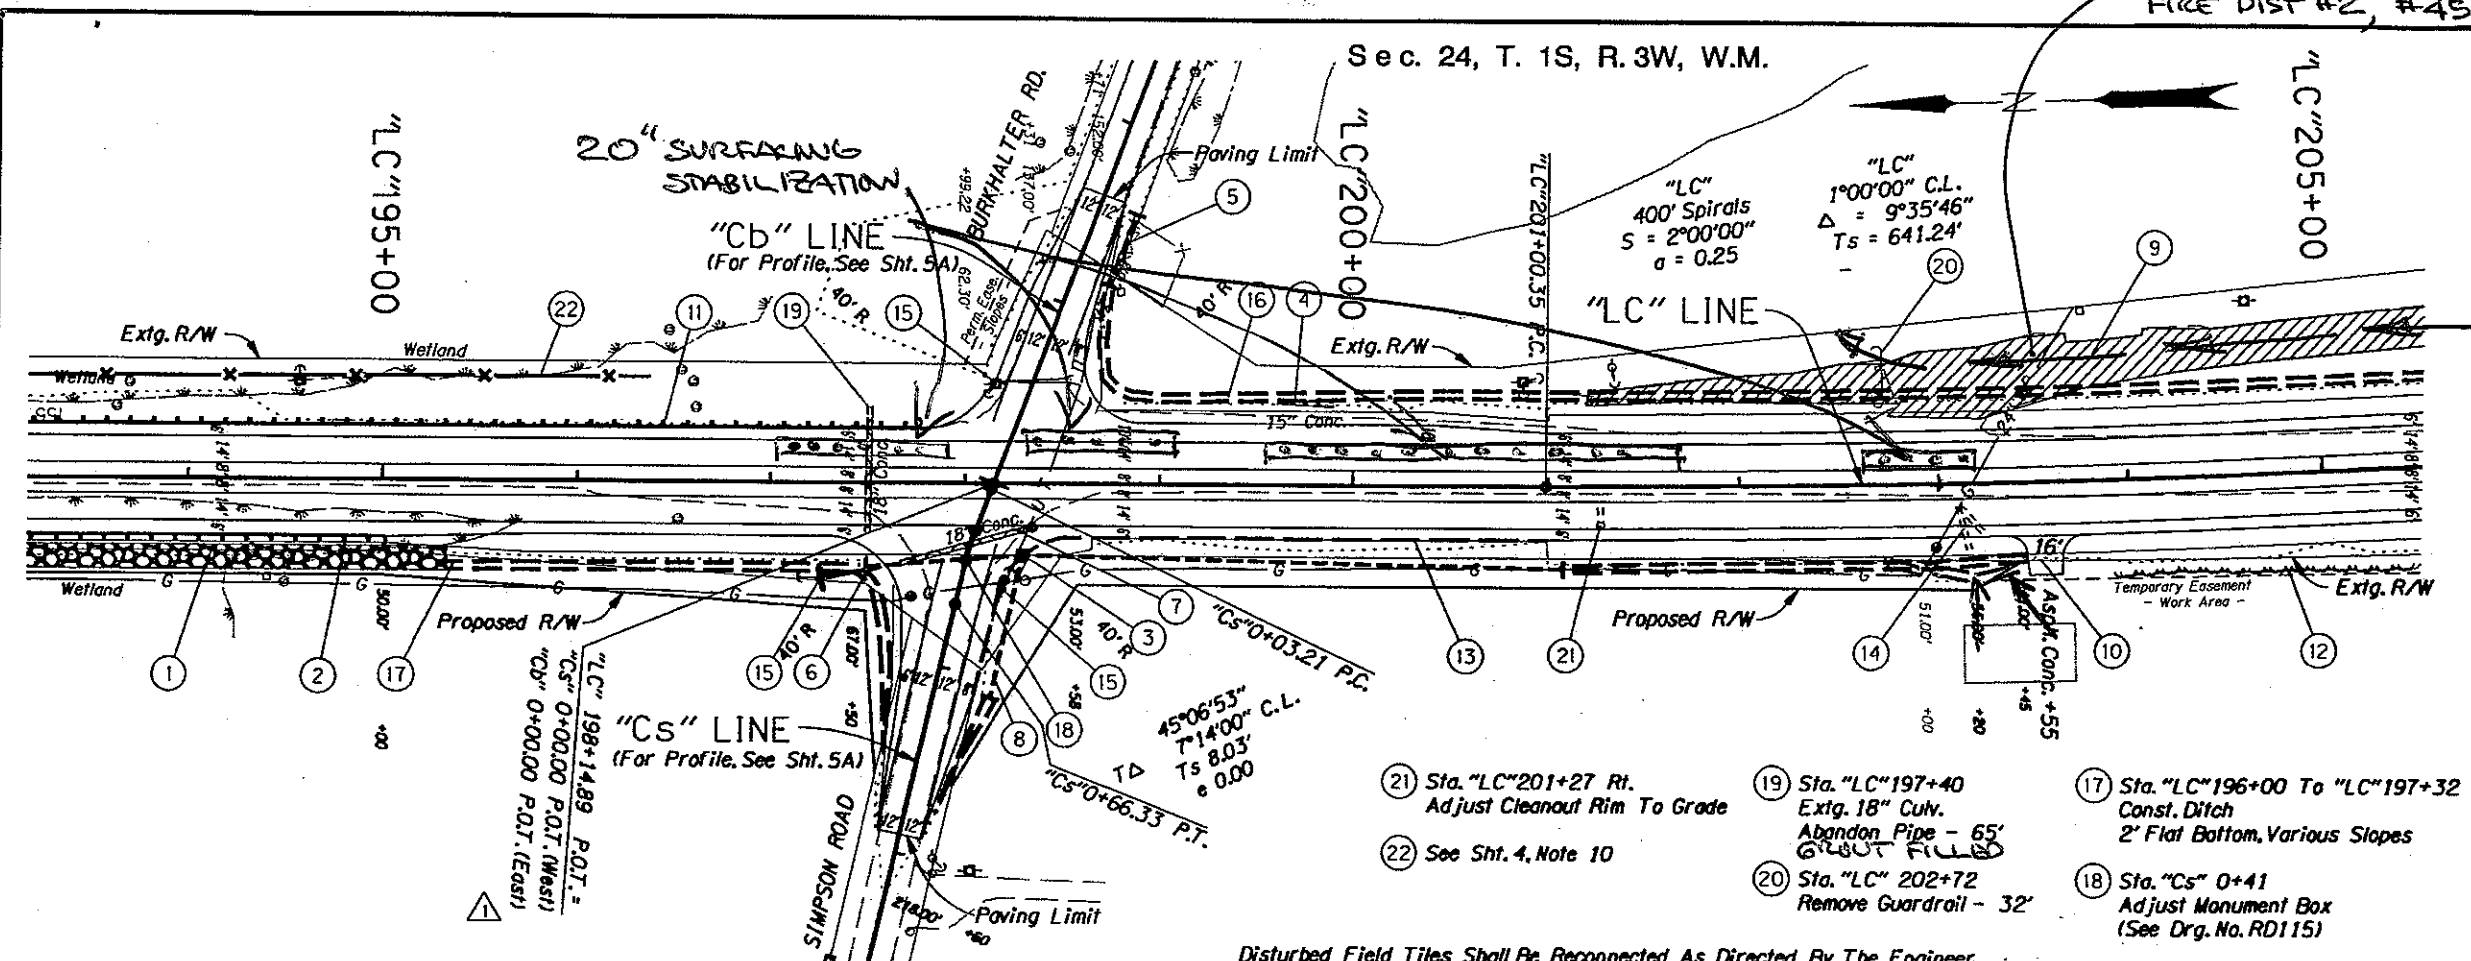


- ① See Sht. 4, Note 3
  - ② See Sht. 4, Note 5
  - ③ Sta. "LC" 198+30 Rt. Const. Type "CG-2" Inlet Inst. 15" Culvert Pipe - 275- 271' 5' Depth (See Drg. No. RD366)
  - ④ Sta. "LC" 197+64 Lt. Remove Culv. Pipe - 29'
  - ⑤ Remove 12" Pipe - 39' Inst. 18" Ductile Iron Pipe - 40- 45.3' 5' Depth
  - ⑥ Sta. "LC" 197+52 Rt. Inst. 18" Culv. Pipe - 80- 101' 5' Depth
  - ⑦ Sta. "LC" 197+85 Rt. Remove Culv. - 70' ABANDON IN PLACE
  - ⑧ Sta. "LC" 198+18 Rt. Inst. 15" Culv. Pipe - 84- 78' 5' Depth
  - ⑨ Sta. "LC" 201+16 To Sta. "LC" 206+79 Removal Of Surfacing, ADD AGG, BASE RD. Place 6" To 8" Selected Topsoil Material
  - ⑩ Sta. "LC" 203+55, Rt. Const. Appr. (See Drg. No. RD115)
  - ⑪ See Sht. 4, Note 1
  - ⑫ Sta. "LC" 203+95 To Sta. "LC" 206+48 Protect Existing Arborvitae
  - ⑬ Const. Mountable Curb (See Drg. No. RD700)
  - ⑭ Sta. "LC" 203+13 Rt. Remove Pipe, LOWERED DITCH 1' TO RECONNECT DRAINS
  - ⑮ Relocate Utility Pole - 3 (By Others)
  - ⑯ Sta. "LC" 198+73 To Sta. 206+30 Sta. "Cb" 0+58 To "Cb" 1+00 Const. Ditch 6" Flat Bottom, 1:4 Slopes
- Stone Embankment Shown Thus:
- Pavement Removal Shown Thus:
- Abandon Pipe Shown Thus:

Disturbed Field Tiles Shall Be Reconnected As Directed By The Engineer

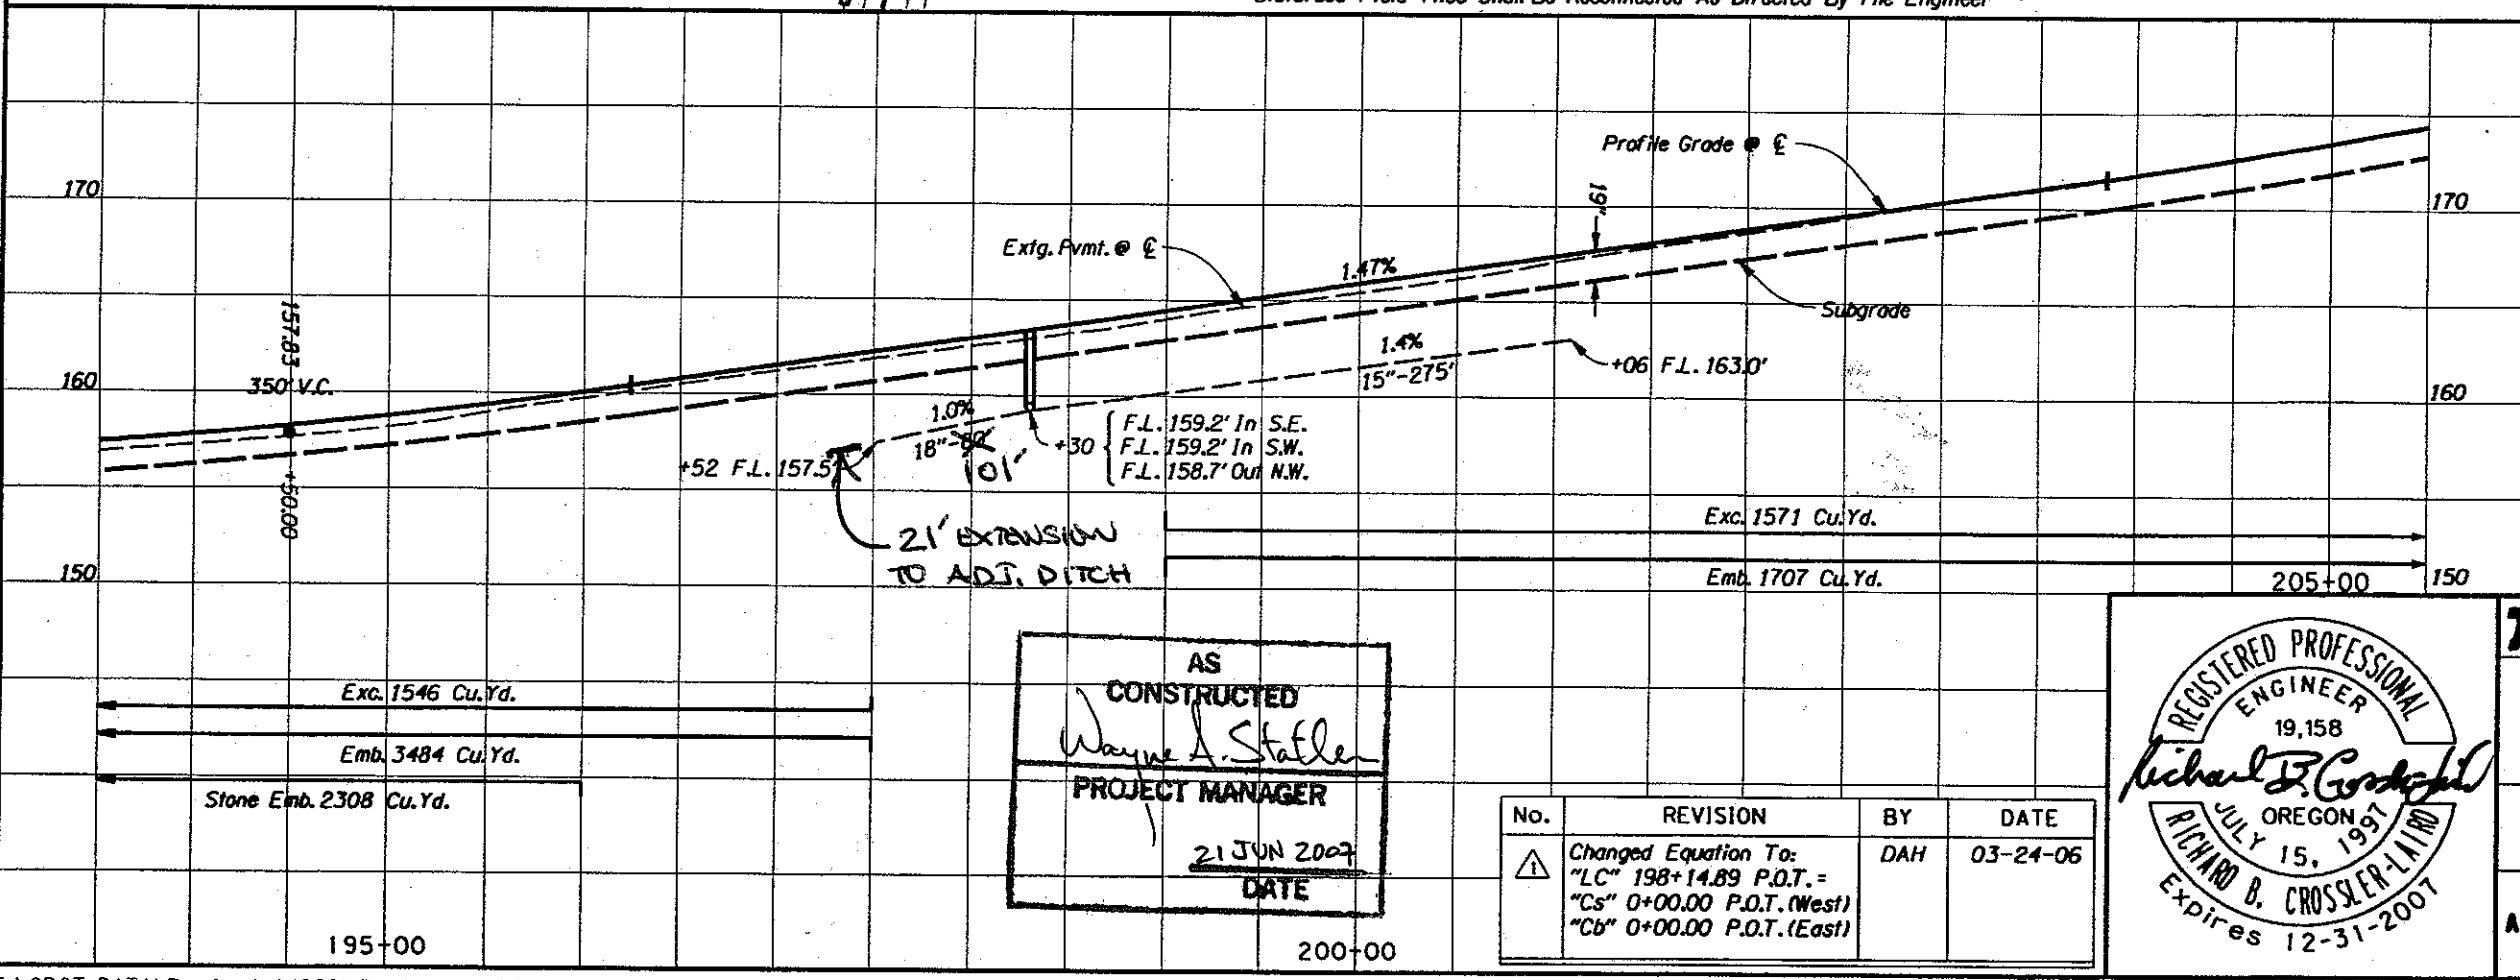

AS  
CONSTRUCTED  
*Wayne A. Staller*  
PROJECT MANAGER  
21 JUN 2007  
DATE

No.	REVISION	BY	DATE
①	Changed Equation To: "LC" 198+14.89 P.O.T. = "Cs" 0+00.00 P.O.T. (West) "Cb" 0+00.00 P.O.T. (East)	DAH	03-24-06

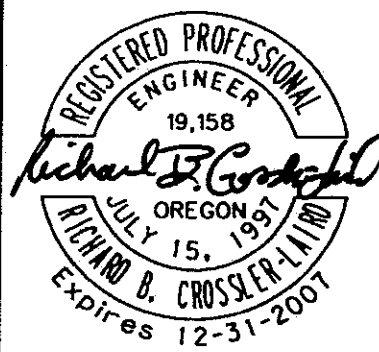


**OREGON DEPARTMENT OF TRANSPORTATION**  
ROADWAY ENGINEERING SECTION

**OR219: HILLSBORO - SILVERTON HIGHWAY**  
AT BURKHALTER RD. / SIMPSON RD.  
HILLSBORO - SILVERTON HIGHWAY  
WASHINGTON COUNTY

Project Leader - Sandy Van Bommel  
Designed By - John M Marshall  
Drafted By - David Haase


**ALIGNMENT & GENERAL CONSTRUCTION**

SHEET NO. **5**

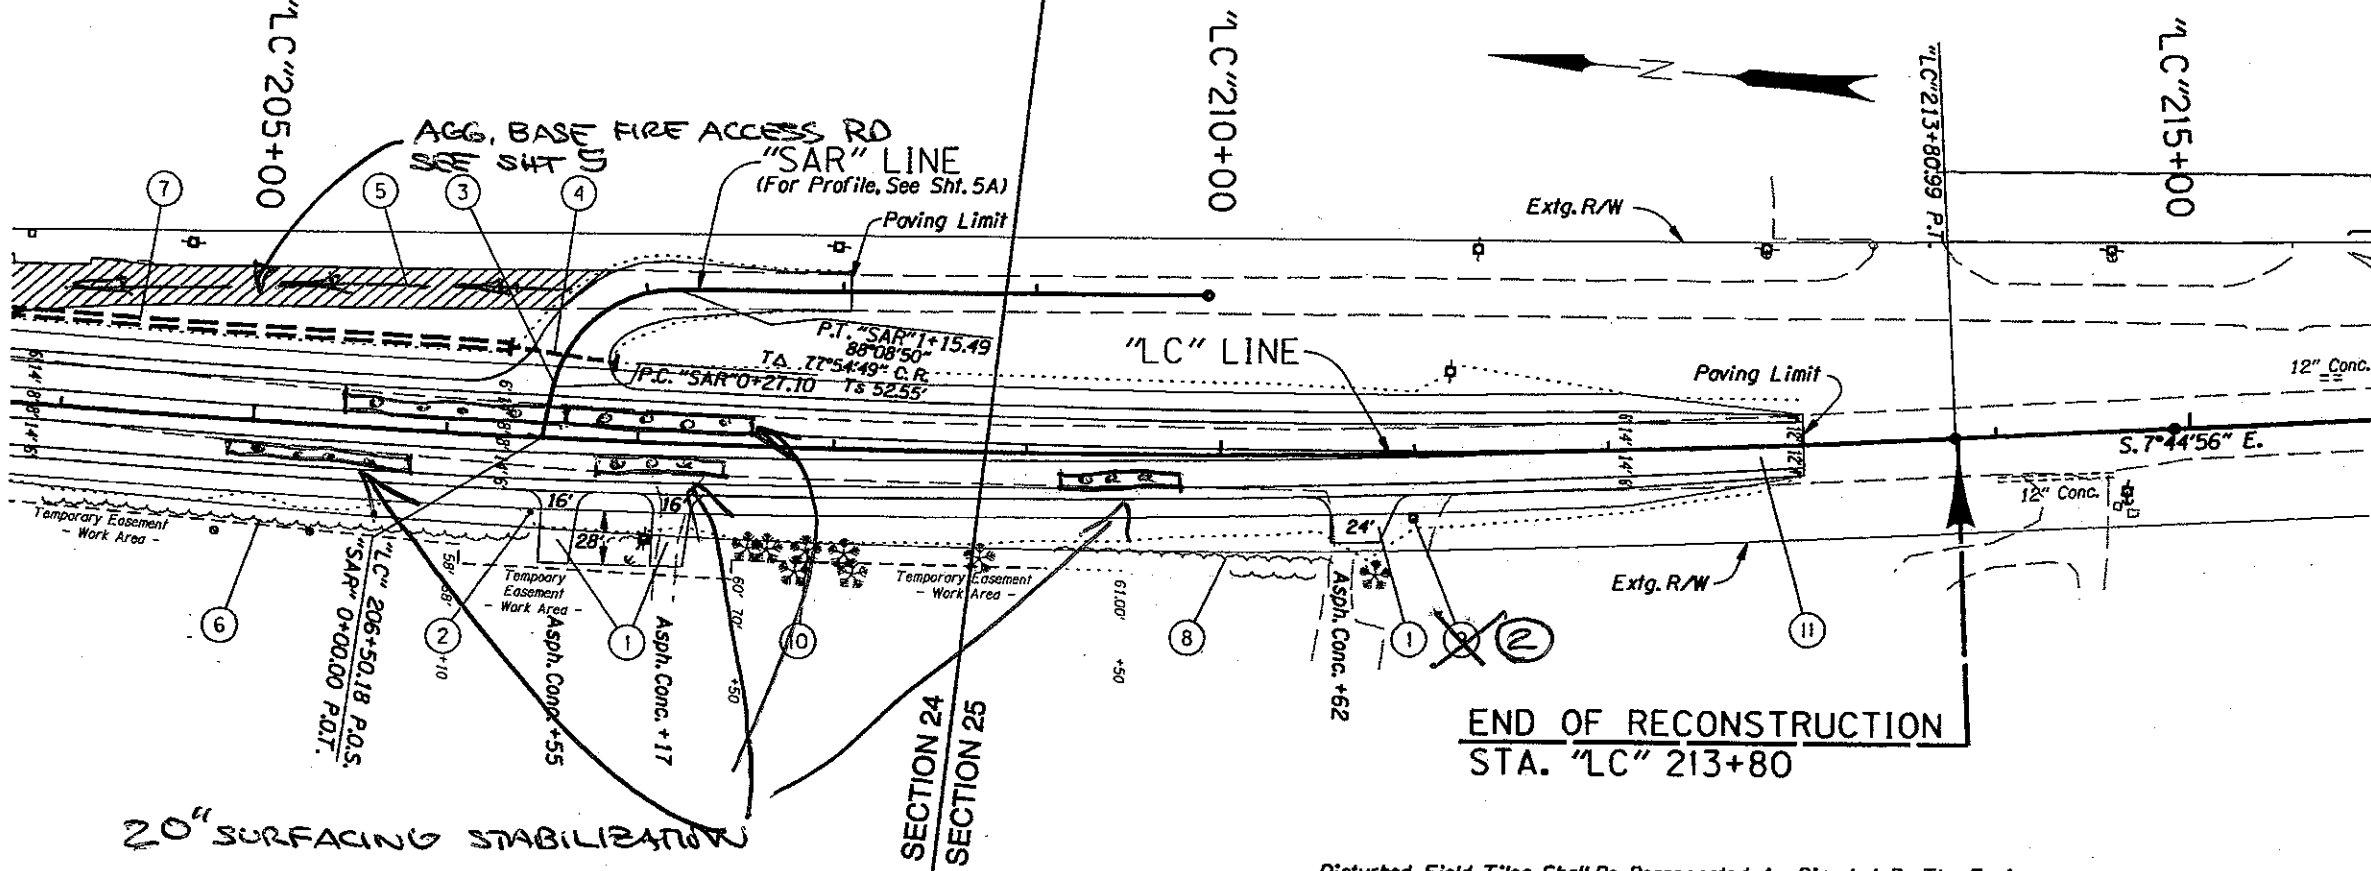

- ① Const. Appr. - 3  
(See Drg. No. RD715)
- ② Const. Single Mailbox Support, 2 EA  
(See Drg. No. RD100)
- ⚠ ③ Sta. "LC" 206+50 Lt.  
Const. Access Road  
(For Details, See Sht. 2A-6)
- ④ Sta. "LC" 206+35 Lt.  
Inst. 15" Ductile Iron Pipe - 5'-7 7/8'  
5' Depth
- ⑤ See Sht. 5, Note 9
- ⑥ See Sht. 5, Note 12
- ⑦ See Sht. 5, Note 16
- ⑧ Sta. "LC" 209+15 To Sta. "LC" 210+50  
Protect Existing Arborvitae
- ⑨ Const. Multiple Mailbox Support  
(See Drg. No. RD100)
- ⑩ Sta. "LC" 207+50 To Sta. "LC" 208+00  
Protect Extg. Trees
- ⑪ Sta. "LC" 212+00 To Sta. "LC" 213+00  
Cold Plane Pmnt. Removal  
(For Details, See Sht. 2B)

Disturbed Field Tiles Shall Be Reconnected As Directed By The Engineer

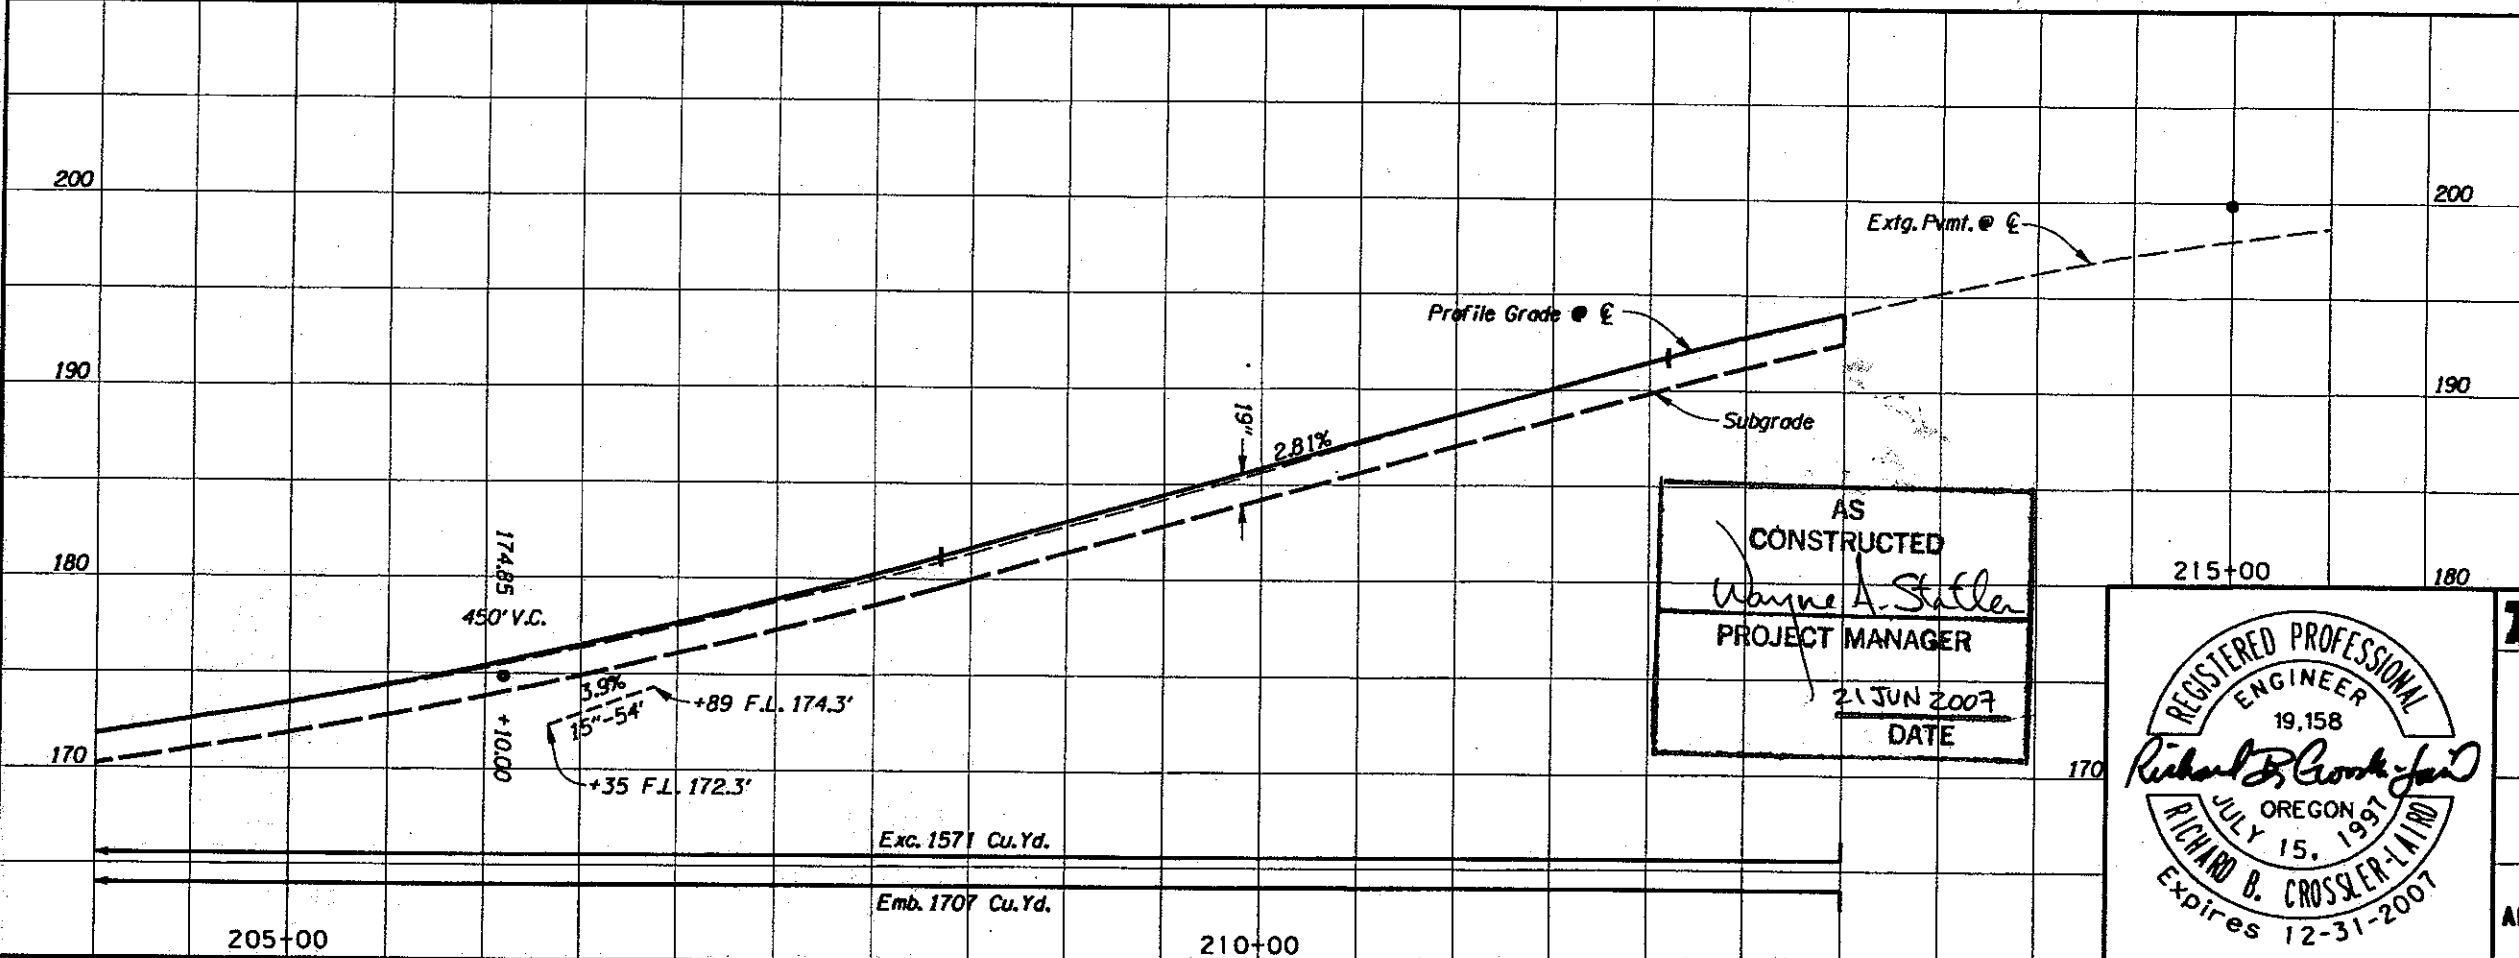


Pavement Removal Shown Thus:

Abandon Pipe Shown Thus:

No.	REVISION	BY	DATE
⚠	Changed Note 3 Sht. 2A-4 To 2A-6.	DAH	03-24-06

AS CONSTRUCTED  
 Wayne A. Staller  
 PROJECT MANAGER  
 21 JUN 2007  
 DATE

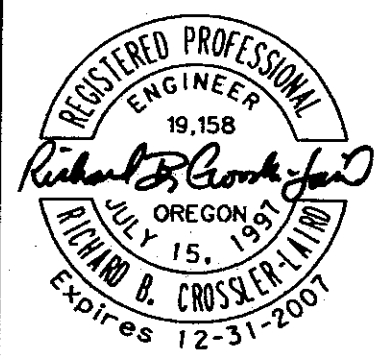


OREGON DEPARTMENT OF TRANSPORTATION  
 ROADWAY ENGINEERING SECTION

OR219: HILLSBORO - SILVERTON HIGHWAY  
 AT BURKHALTER RD. / SIMPSON RD.  
 HILLSBORO - SILVERTON HIGHWAY  
 WASHINGTON COUNTY

Project Leader - Sandy Van Bommel  
 Designed By - John M Marshall  
 Drafted By - David Haase


ALIGNMENT & GENERAL CONSTRUCTION  
 SHEET NO. 6

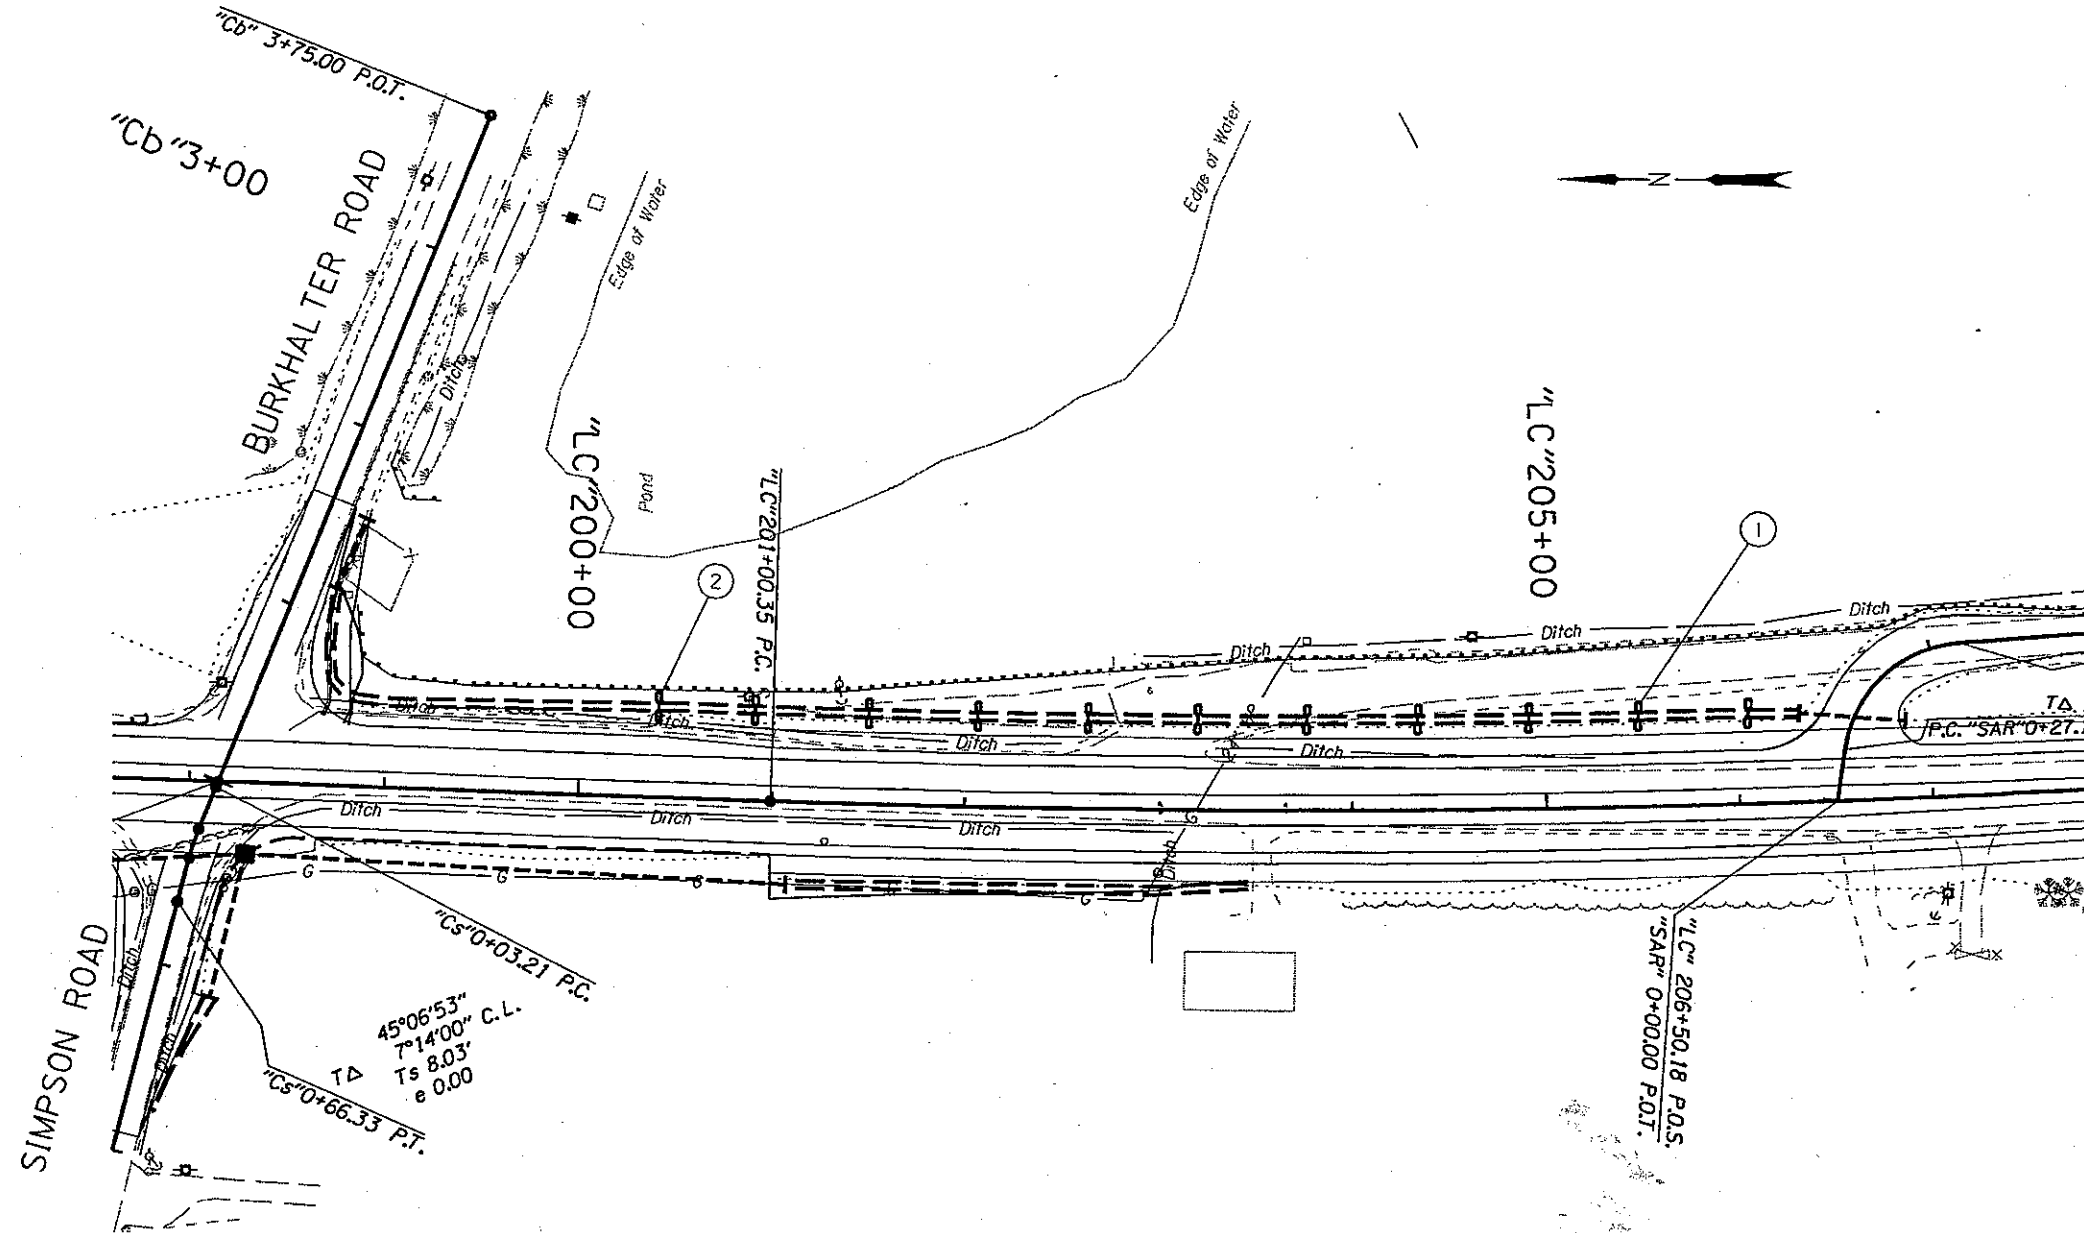


- ① Sta. "LC" 200+90 To 206+00, Lt.  
Const. Water Quality Check Slots - 10  
(For Details, See Sheet GJ-2)
- ② Sta. "LC" 200+40, Lt.  
Const. Water Quality Check Dam - 1  
(For Details, See Sheet GJ-2)

AS  
CONSTRUCTED  
*Wayne A. Sattler*  
PROJECT MANAGER  
  
21 JUN 2007  
DATE

All Dimensions Are Shown In Feet.  
Unless Otherwise Noted.

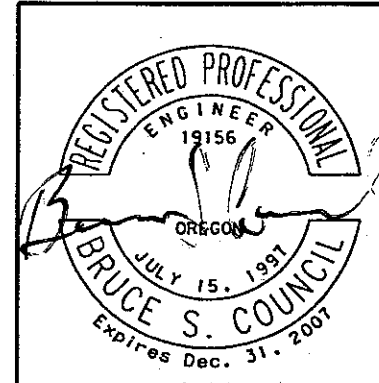


<b>OREGON DEPARTMENT OF TRANSPORTATION</b> REGION 1 GEO/HYDRO UNIT	
<b>OR219: HILLSBORO - SILVERTON HIGHWAY</b> AT BURKHALTER RD. / SIMPSON RD. HILLSBORO - SILVERTON HIGHWAY WASHINGTON COUNTY	
Project Leader - Sandy Van Bommel Designed By - Bruce S. Council Drafted By - Bruce S. Council / Charlotte Gerken	
<b>WATER QUALITY PLAN</b>	SHEET NO. <b>GJ</b>

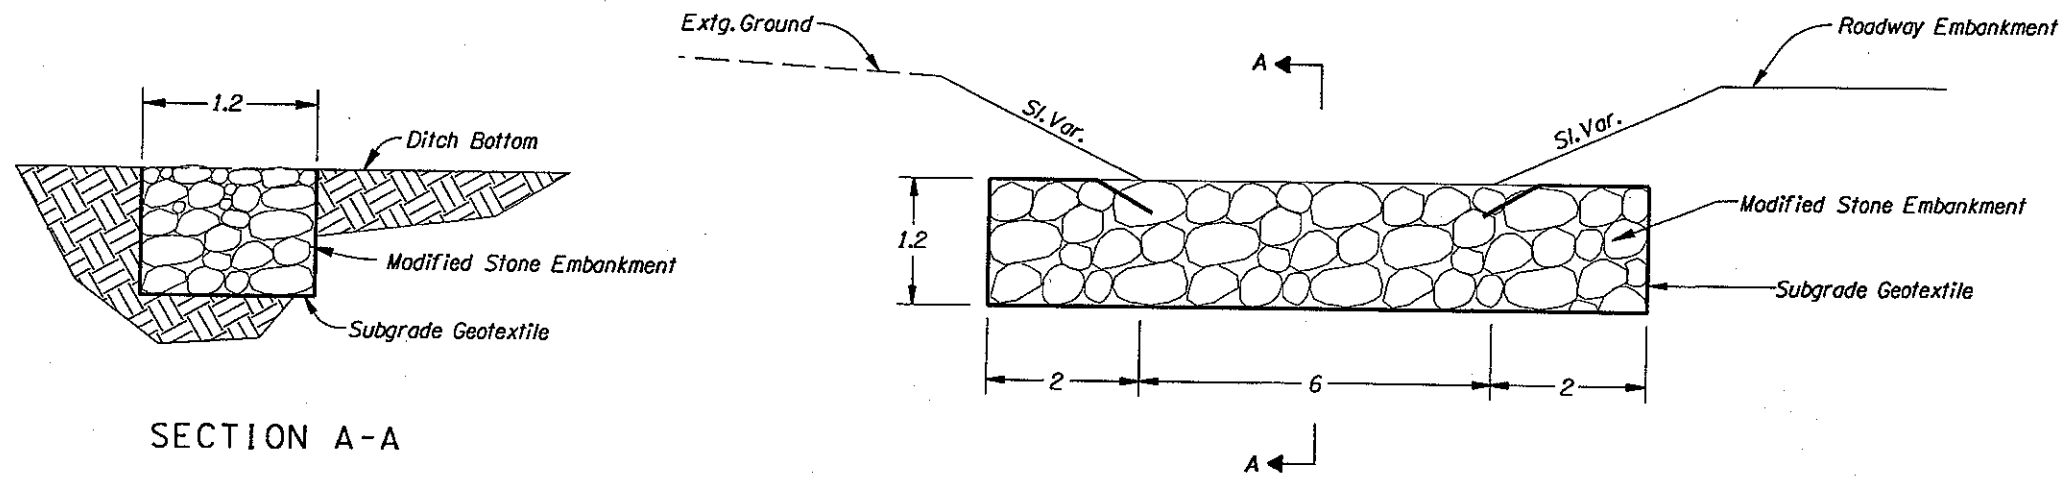

SECTION A-A

STA. "LC" 200+90 To STA. "LC" 206+00 Lt.


WATER QUALITY CHECK SLOT  
FLAT BOTTOM DITCH

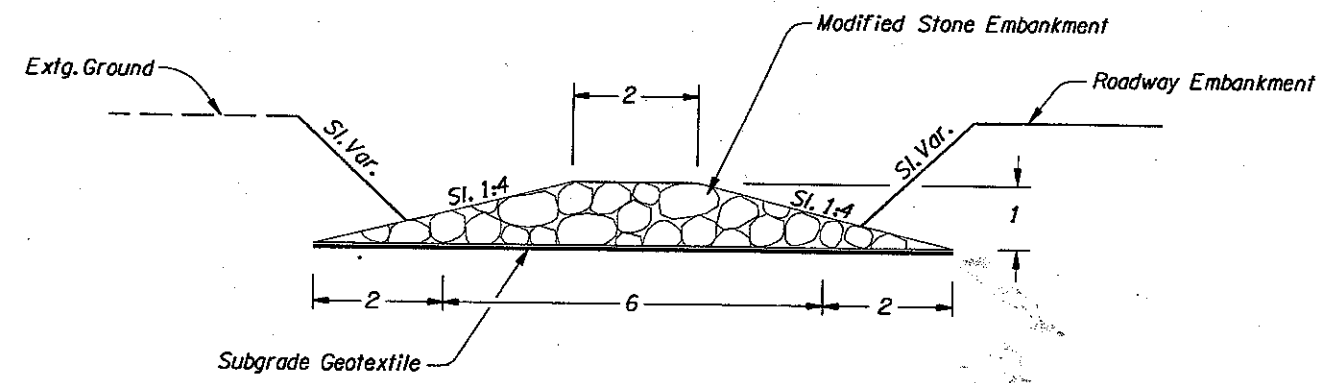

STA. "LC" 200+40, Lt.  
WATER QUALITY CHECK DAM  
FLAT BOTTOM DITCH

AS  
CONSTRUCTED  
*Wayne A. Staller*  
PROJECT MANAGER  
21 JUN 2007  
DATE

All Dimensions Are Shown In Feet,  
Unless Otherwise Noted.

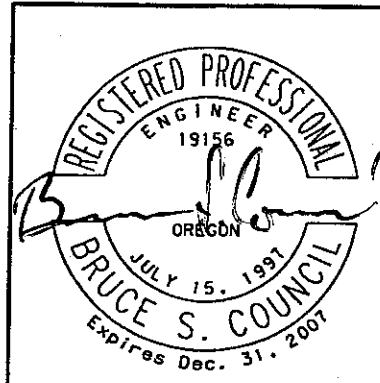

OREGON DEPARTMENT OF TRANSPORTATION  
REGION 1 GEO/HYDRO UNIT

OR219: HILLSBORO - SILVERTON HIGHWAY  
AT BURKHALTER RD. / SIMPSON RD.  
HILLSBORO - SILVERTON HIGHWAY  
WASHINGTON COUNTY

Project Leader - Sandy Van Bommel  
Designed By - Bruce S. Council  
Drafted By - Bruce S. Council / Charlotte Gerken

WATER QUALITY PLAN

SHEET NO.  
GJ-2