

OPERATION & MAINTENANCE MANUAL

DFI No.: D00163

**Facility Type: Detention Pond/Water
Quality Biofiltration Swale Combo**



JULY, 2011

1. Identification

Drainage Facility ID (DFI): **DFI D00163**

Facility Type: Detention Pond/Water Quality Biofiltration Swale Combo

Construction Drawings: (V-File Number) 37V-023

Location: District: 01 (Old 2A)
Highway No.: 092
Mile Post: 21.23/21.25 (beg./end)

Description: This facility is west of the Lower Columbia River Highway (US30 / Hwy 092) and south of the intersection of US30 and Scappoose-Vernonia Road. Access is obtained from a maintenance access road off the southbound lanes of US30.

2. Facility Contact Information

Contact the Engineer of Record, Region Technical Center, or Geo-Environmental's Senior Hydraulics Engineer for:

- Operational clarification
- Maintenance clarification
- Repair or restoration assistance

Engineering Contacts:

Region Technical Center Hydro Unit Manager

Or

Geo-Environmental Senior Hydraulics Engineer (503) 986-3365.

3. Construction

Engineer of Record: ODOT Designer – Region 1 Tech. Center,
Timothy P. Fredette, P.E., (503) 731-8340

Facility Construction: 2004
Contractor: Eagle-Elsner, Inc.

4. Storm Drain System and Facility Overview

A detention pond/water quality biofiltration swale combo (referred to from this point forward as a pond/swale combo) combines the forms and functions of a water quality swale and a detention pond. In a pond/swale combo, the biofiltration swale is situated within the bottom confines of the detention facility. The facility provides water quality treatment of the smaller storm events and detention of the larger storm events.

The biofiltration swale is designed as if it was a separate facility and consists of a grassy-lined facility with a flat trapezoidal cross section and gradual slope. Treatment is provided through sedimentation and filtration processes. If amended soils are present, additional treatment is obtained through infiltration through the amended soil media.

When the flows exceed the water quality flows, the pond/swale combo facility begins to provide detention. Detention is required to reduce or mitigate the increases in discharge, resulting from development. The facility is designed to store and gradually release (or attenuate) stormwater runoff via a control structure or release mechanism, then releasing it slowly over a more extended period of time. The flow control mechanism for this facility involves a 4-inch orifice surrounded by a wirecloth strainer assembly. When flows exceed the water quality design flow, the orifice restricts the flow causing the water to backup within the facility.

This particular facility is located southwest of the intersection of Scappoose-Vernonia Road and US30 (Hwy 092). Access to this facility is obtained from a maintenance access road off the southbound lanes of US30 (Hwy 092) (**Point D on Operational Plan in Appendix A; Photo 3**).

The contributing drainage area consists of the southbound lanes of US30 (Hwy 092), extending 450 feet south of the intersection. All runoff collected by the associated drainage system is directed to the detention pond/swale facility. Therefore, the detention pond/swale facility can be described as “online.” The drainage system does not include offline bypasses.

The detention pond/swale facility is approximately 82-feet in length from north to south, and its bottom width is 8-feet. The facility is lined with HDPE porous pavers and grass.

Stormwater enters the detention pond/swale facility from a 15-inch pipe and outfalls onto riprap located at the facility’s southern end (**Point A; Photo 1**). After treatment, water exits the detention pond/swale facility through the outlet structures at the facility’s northern end (**Point B; Photo 5**). Treated water enters the outlet structures through the lower ditch inlet.

The water exits the lower ditch inlet via an 8-inch diameter siphon pipe. From the siphon pipe, the water is discharged through a 2-inch diameter orifice into the higher ditch inlet. From the higher ditch inlet the water is discharged into a 15-inch storm pipe, which ties into an 18-inch CMP storm pipe at a manhole (**Point C**). Subsequently, the water is conveyed westward by storm pipes to a stormwater outfall.

A. Maintenance equipment access:

Access to this swale facility is obtained from a maintenance access road off the southbound lanes of US30 (Hwy 092) (**Point D; Photo 3**).

B. Heavy equipment access into facility:

- Allowed (no limitations)
- Allowed (with limitations)
- Not allowed

C. Special Features:

- Amended Soils
- Porous Pavers – HDPE Porous Pavers
- Liners
- Underdrains



Photo 1: 15-inch storm pipe outfall serving as swale inlet at south end of swale (**Point A**).



Photo 2: Water quality biofiltration swale. Photo taken facing north toward the swale outlet.



Photo 3: Maintenance access road (**Point D**). Photo taken facing north.



Photo 4: Water quality biofiltration swale. Photo taken facing south.

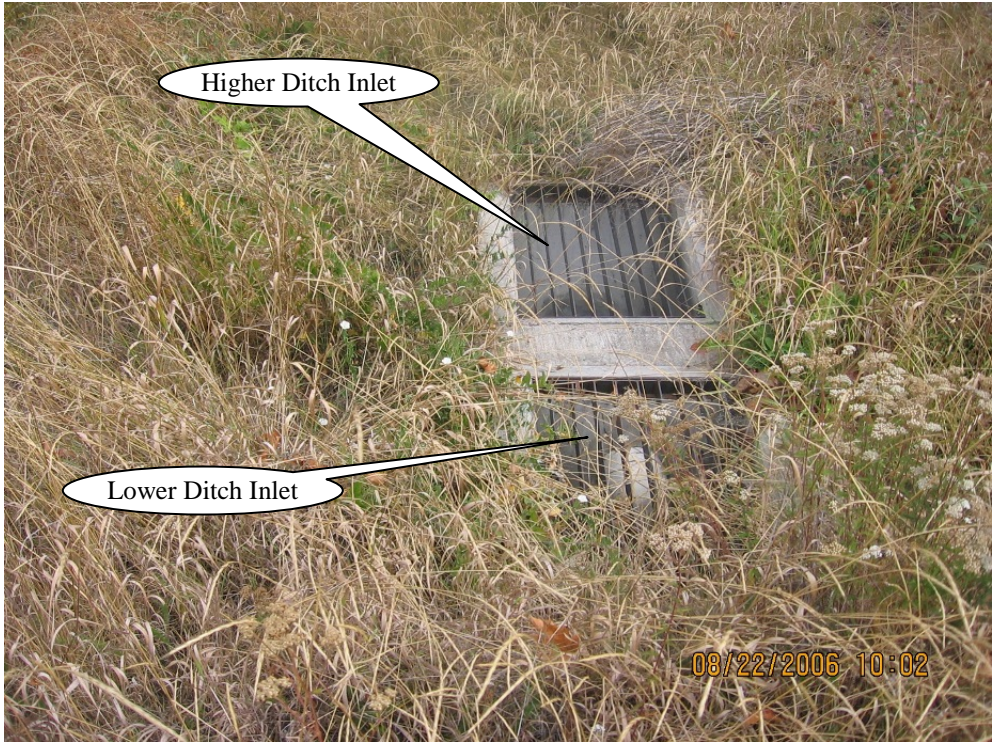


Photo 5: Outlet structures at water quality biofiltration swale outlet (**Point B**).

5. Facility Haz Mat Spill Feature(s)

The detention pond/water quality biofiltration swale combination facility can be used to store a volume of liquid by using plates or sandbags to block either the inlet grates or the higher ditch inlet's 15-inch diameter pipe located at the outlet structures (**Point B; Photo 5**).

6. Auxiliary Outlet (High Flow Bypass)

Auxiliary outlets are provided if the primary outlet control structure cannot safely pass the projected high flows. Broad-crested spillway weirs and over flow risers are the two most common auxiliary outlets used in stormwater treatment facility design. The auxiliary outlet feature is either a part of the facility or an additional storm drain feature/structure.

The auxiliary outlet feature for this facility is:

Designed into facility – This swale is an online facility where both the treatment and the high flows are directed into the swale. If runoff exceeds the capacity of the swale, the excess volume bypasses the lower inlet, the siphon pipe and the orifice. And, the excess volume exits the swale via the higher inlet of the swale outlet structures (**Point B; Photo 5**).

Other, as noted below

7. Maintenance Requirements

Routine maintenance table for non-proprietary stormwater treatment and storage/detention facilities have been incorporated into ODOT's Maintenance Guide. These tables summarize the maintenance requirements for ponds, swales, filter strips, bioslopes, and detention tanks and vaults. Special maintenance requirements in addition to the routine requirements are noted below when applicable.

The ODOT Maintenance Guide can be viewed at the following website:

<http://www.oregon.gov/ODOT/HWY/OOM/MGuide.shtml>

Maintenance requirements for proprietary structures, such as underground water quality manholes and/or vaults with filter media are noted in Appendix C when applicable.

The following stormwater facility maintenance table (See ODOT Maintenance Guide) should be used to maintain the facility outlined in this Operation and Maintenance Manual or follow the Maintenance requirements outlined in Appendix C when proprietary structure is selected below:

- Table 1 (general maintenance)
- Table 2 (stormwater ponds)
- Table 3 (water quality biofiltration swales)
- Table 4 (water quality filter strips)
- Table 5 (water quality bioslopes)
- Table 6 (detention tank)
- Table 7 (detention vault)
- Appendix C (proprietary structure)
- Special Maintenance requirements:

Note: Special maintenance Requirements Require Concurrence from ODOT SR Hydraulics Engineer.

8. Waste Material Handling

Material removed from the facility is defined as waste by DEQ. Refer to the roadwaste section of the ODOT Maintenance Yard Environmental Management System (EMS) Policy and Procedures Manual for disposal options: <http://egov.oregon.gov/ODOT/HWY/OOM/EMS.shtml>


Contact any of the following for more detailed information about management of waste materials found on site:

ODOT Clean Water Unit	(503) 986-3008
ODOT Statewide Hazmat Coordinator	(503) 229-5129
ODOT Region Hazmat Coordinator	(503) 731-8304
ODEQ Northwest Region Office	(503) 229-5263


Appendix A

Content:


- **Operational Plan and Profile Drawing(s)**

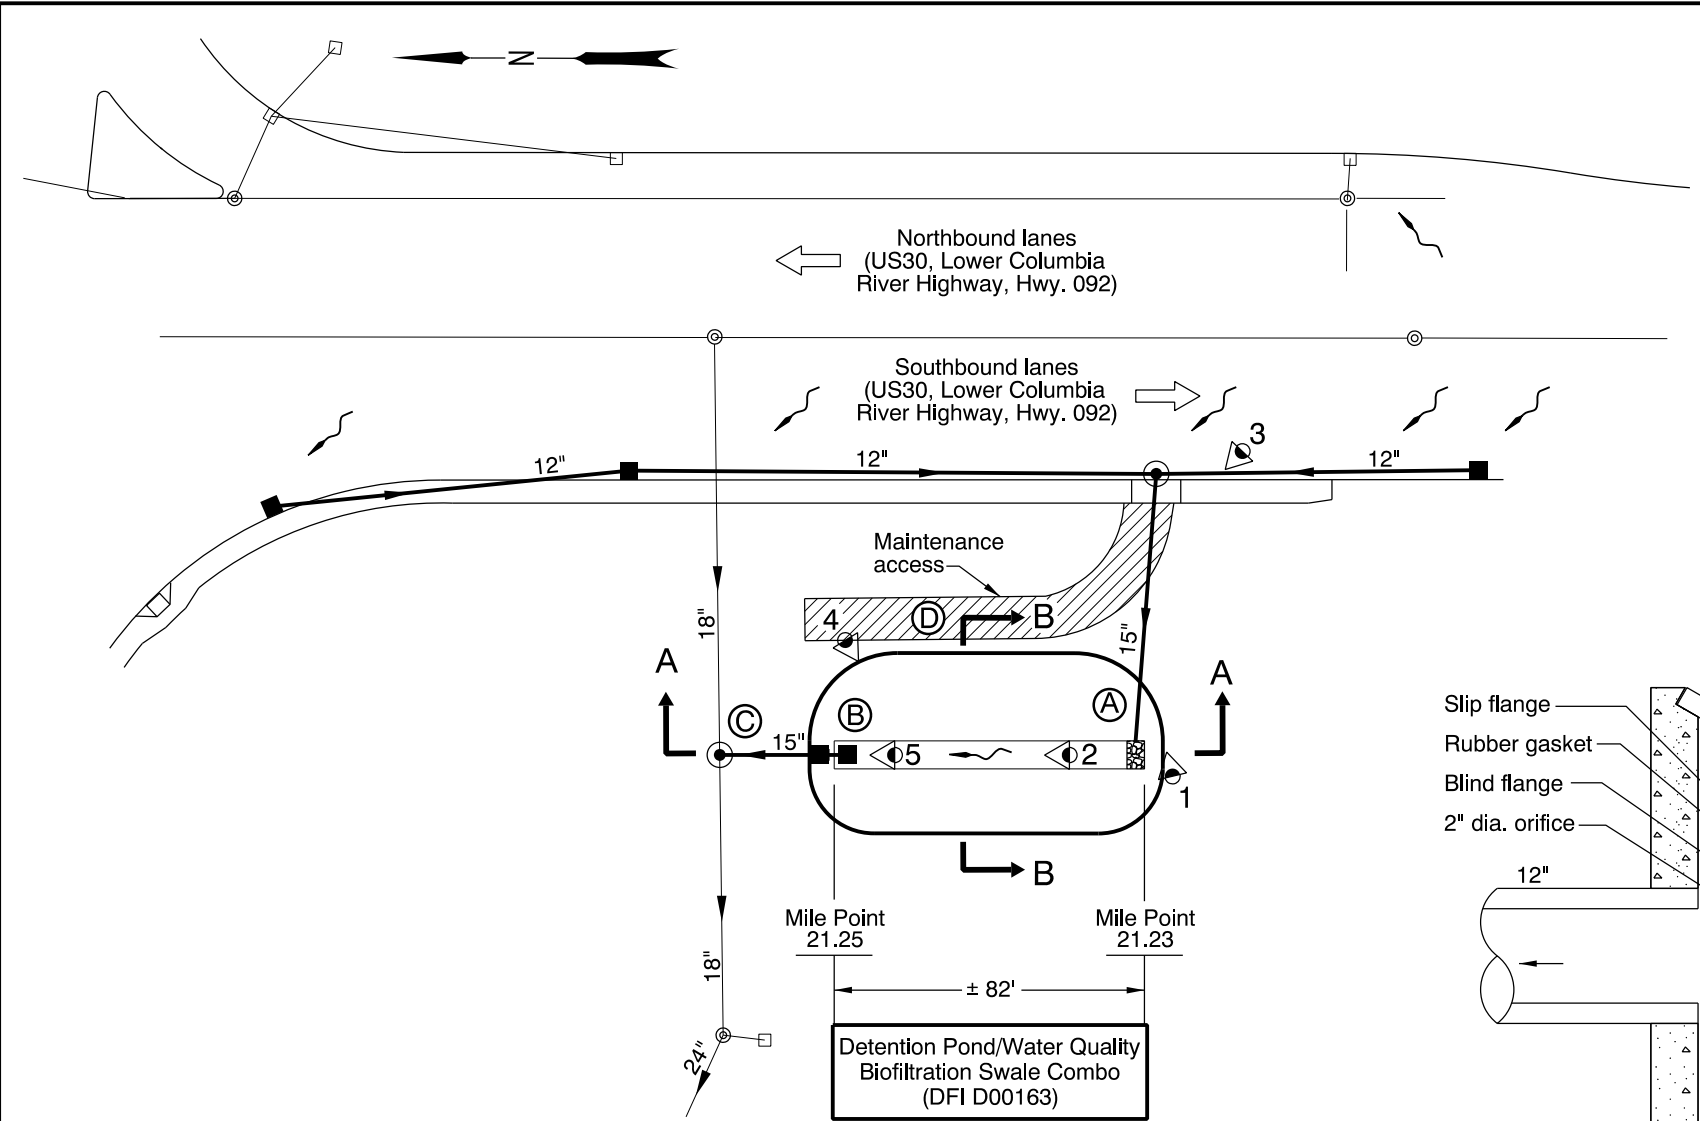

PLAN
N.T.S.

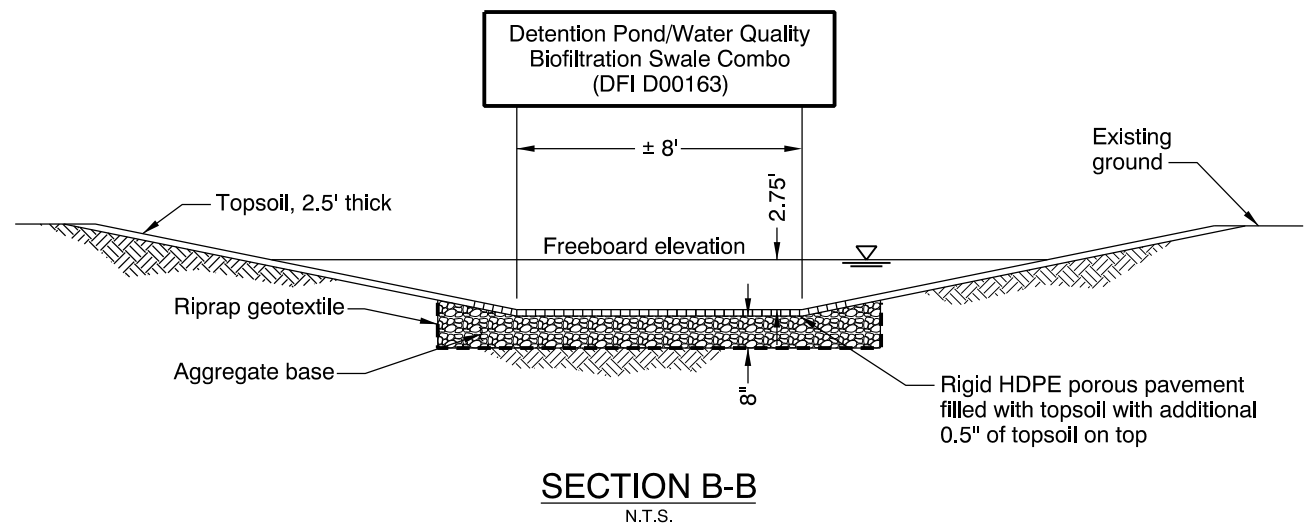


SECTION B-B
N.T.S.

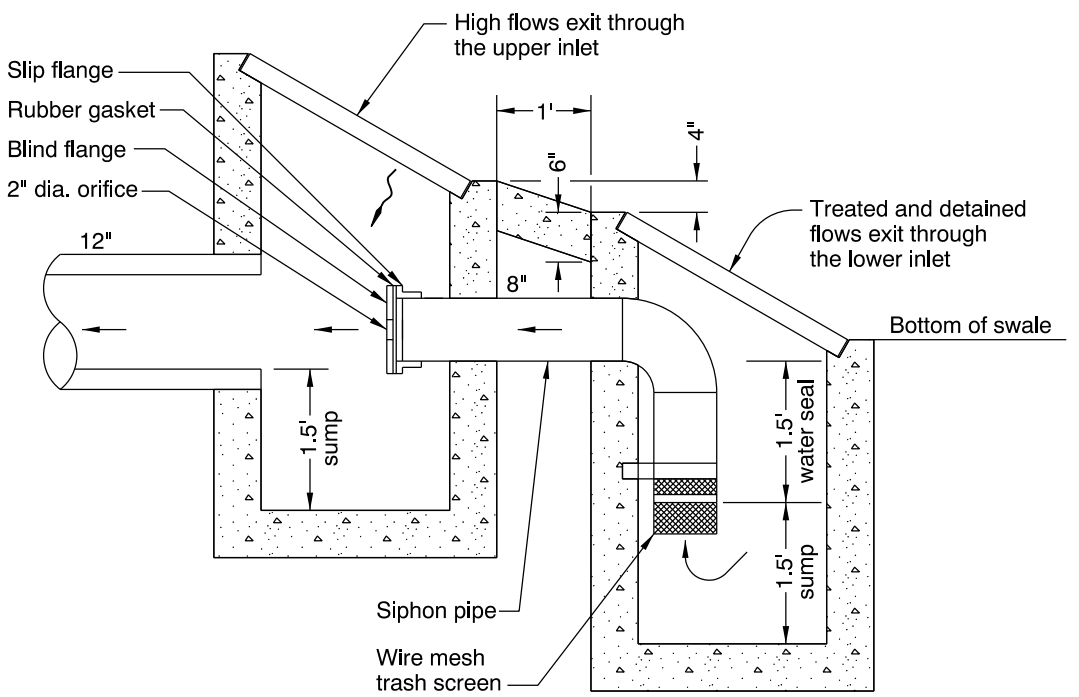

**SWALE OUTLET STRUCTURES FOR
DETENTION POND / WATER QUALITY
BIOFILTRATION SWALE AT POINT (B)**
N.T.S.

- LEGEND:**
- ◁ Photo Location / Direction
 - Ⓐ Pipe Outfall at Swale Inlet with Riprap Flow Spreader
 - Ⓑ Swale Outlet Structure
 - Ⓒ Manhole Connecting Facility to Conveyance Line
 - Ⓓ Maintenance Access Rd.
 - ⊙ and ⊗ Manhole
 - and □ Inlet
 - ← Traffic Flow / Direction
 - Storm Pipe (Facility)
 - Storm Pipe
 - Conveyance Direction
 - ~ Pavement / Facility Flow Path
 - ▒ Riprap
 - ▨ Maintenance Access

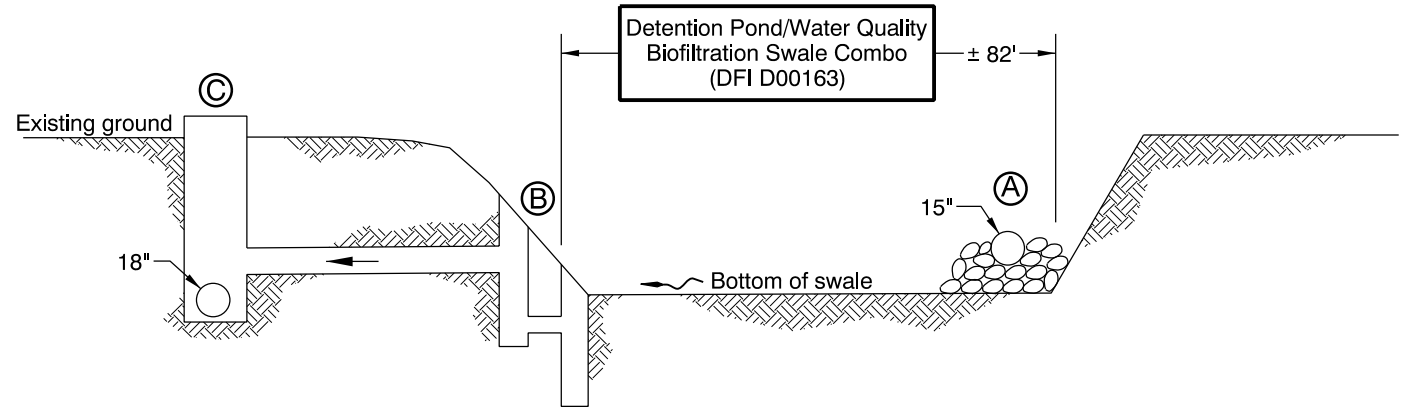

SECTION A-A
N.T.S.

Sht. 1 of 1

OREGON DEPARTMENT OF TRANSPORTATION

Prepared By: Wynee Hu
Drafted By: S. Wolfer

DFI D00163
MAINTENANCE DISTRICT 1 HWY 092
DETENTION POND/WQ SWALE COMBO
LOWER COLUMBIA R HWY MP 21.23-21.25
COLUMBIA COUNTY

Appendix B

Content:


- **ODOT Project Plan Sheets**
 - *Cover/Title Sheet*
 - *Water Quality/Detention Plan Sheets*
 - *Other Details*

STATE OF OREGON
 DEPARTMENT OF TRANSPORTATION
 PLANS FOR PROPOSED PROJECT

GRADING, DRAINAGE, PAVING, SIGNING,
 SIGNALS, & ROADSIDE DEVELOPMENT

REVISED AS CONSTRUCTED
 12-15-04 CONTRACT 12964
 PROJ. MGR. MARJORIE J. WEST

Marjorie West

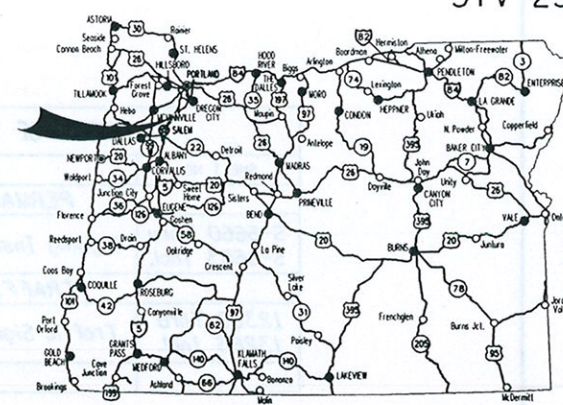

Overall Length Of Project - 0.70 km (0.43 Miles)


INDEX OF SHEETS	
SHEET NO.	DESCRIPTION
1	Title Sheet
1A	Index of Sheets, Con't.
2, 2A Thru 2A-4 Incl.	Typical Sections
2B Thru 2B-4 Incl.	Details
2C	Traffic Control Details
2C-2 Thru 2C-9 Incl.	Traffic Control Plans
2D	Pipe Data Sheet
3	Alignment
3A	General Construction
3B	Construction Notes
3C	Drainage & Utilities
3D	Profile
3E	Waterline & Utilities
4	Alignment
4A	General Construction
4B	Drainage & Utilities
PERMANENT PAVEMENT MARKINGS	
ST-1, ST-2	Striping Plans
ROADSIDE DEVELOPMENT	
R1, R2	Plant List
R3	Plant Details
R4, R5	Planting Plan
GEO/HYDRO	
GHA-1, GHA-2	Erosion Control
GHG-1	Temporary Water Management Details
GHH-1	Streambank Stabilization
GHI-1	Water Quality Plan
GHI-2 Thru GHI-4 Incl.	Water Quality Details
GHI-5	Details

**US30: LOWER COLUMBIA RIVER HIGHWAY
 AT SCAPPOOSE - VERNONIA ROAD**

LOWER COLUMBIA RIVER HIGHWAY

COLUMBIA COUNTY
 FEBRUARY 2004

ATTENTION:
 Oregon Law Requires You To Follow Rules
 Adopted By The Oregon Utility Notification Center.
 Those Rules Are Set Forth In OAR 952-001-0010 Through OAR 952-001-0090.
 You May Obtain Copies Of The Rules By Calling The Center. (Note: The
 Telephone Number For The Oregon Utility Center Is (503) 232-1987.)

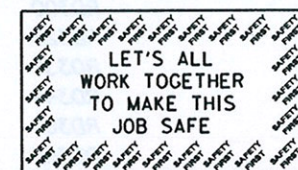


- OREGON TRANSPORTATION COMMISSION**
- Stuart Foster CHAIRMAN
 - Gail L. Achterman COMMISSIONER
 - Michael Nelson COMMISSIONER
 - Randall Papé COMMISSIONER
 - John Russell COMMISSIONER
 - Bruce A. Warner DIRECTOR OF TRANSPORTATION



Catherine M. Nelson
 STATE HIGHWAY ENGINEER

**US30: LOWER COLUMBIA RIVER HIGHWAY
 AT SCAPPOOSE - VERNONIA ROAD
 LOWER COLUMBIA RIVER HIGHWAY
 COLUMBIA COUNTY**

FEDERAL HIGHWAY ADMINISTRATION	PROJECT NUMBER	SHEET NO.
REGION 10	OREGON DIVISION X-NH-S092(16)	1

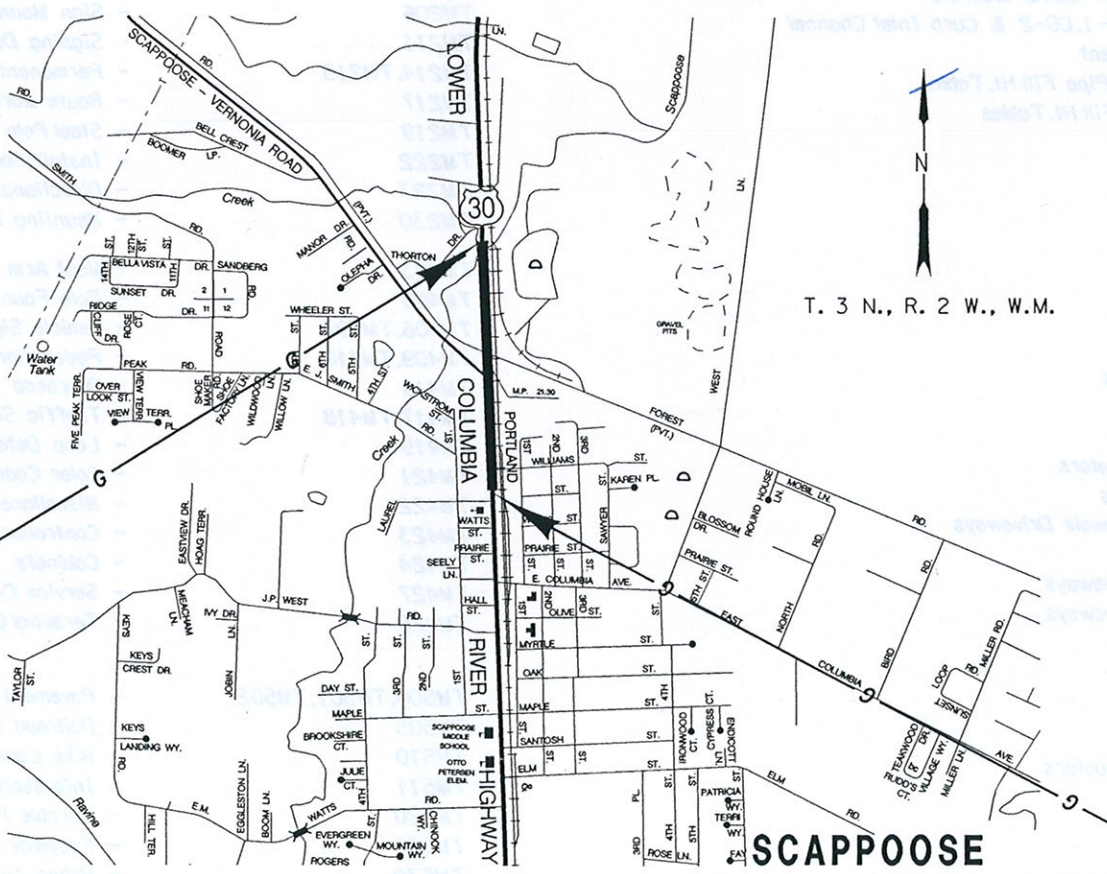

BEGINNING OF PROJECT
 STA. "LC" 34 + 620 (M.P. 21.48)

END OF PROJECT
 STA. "LC" 35 + 305 (M.P. 21.05)



THIS IS THE FILE NAME LOCATION projects\Scappoose\10733r\1.tsin


Sec. 12, T. 3N, R. 2W, W.M.
CITY OF SCAPPOOSE

REVISED AS CONSTRUCTED
12-15-04 CONTRACT 12964

Majic West

BEGINNING OF PROJECT X-NH-S092(16)
STA. "LC" 34+620

END OF CONTRACT
STA. "C" 0+280.7

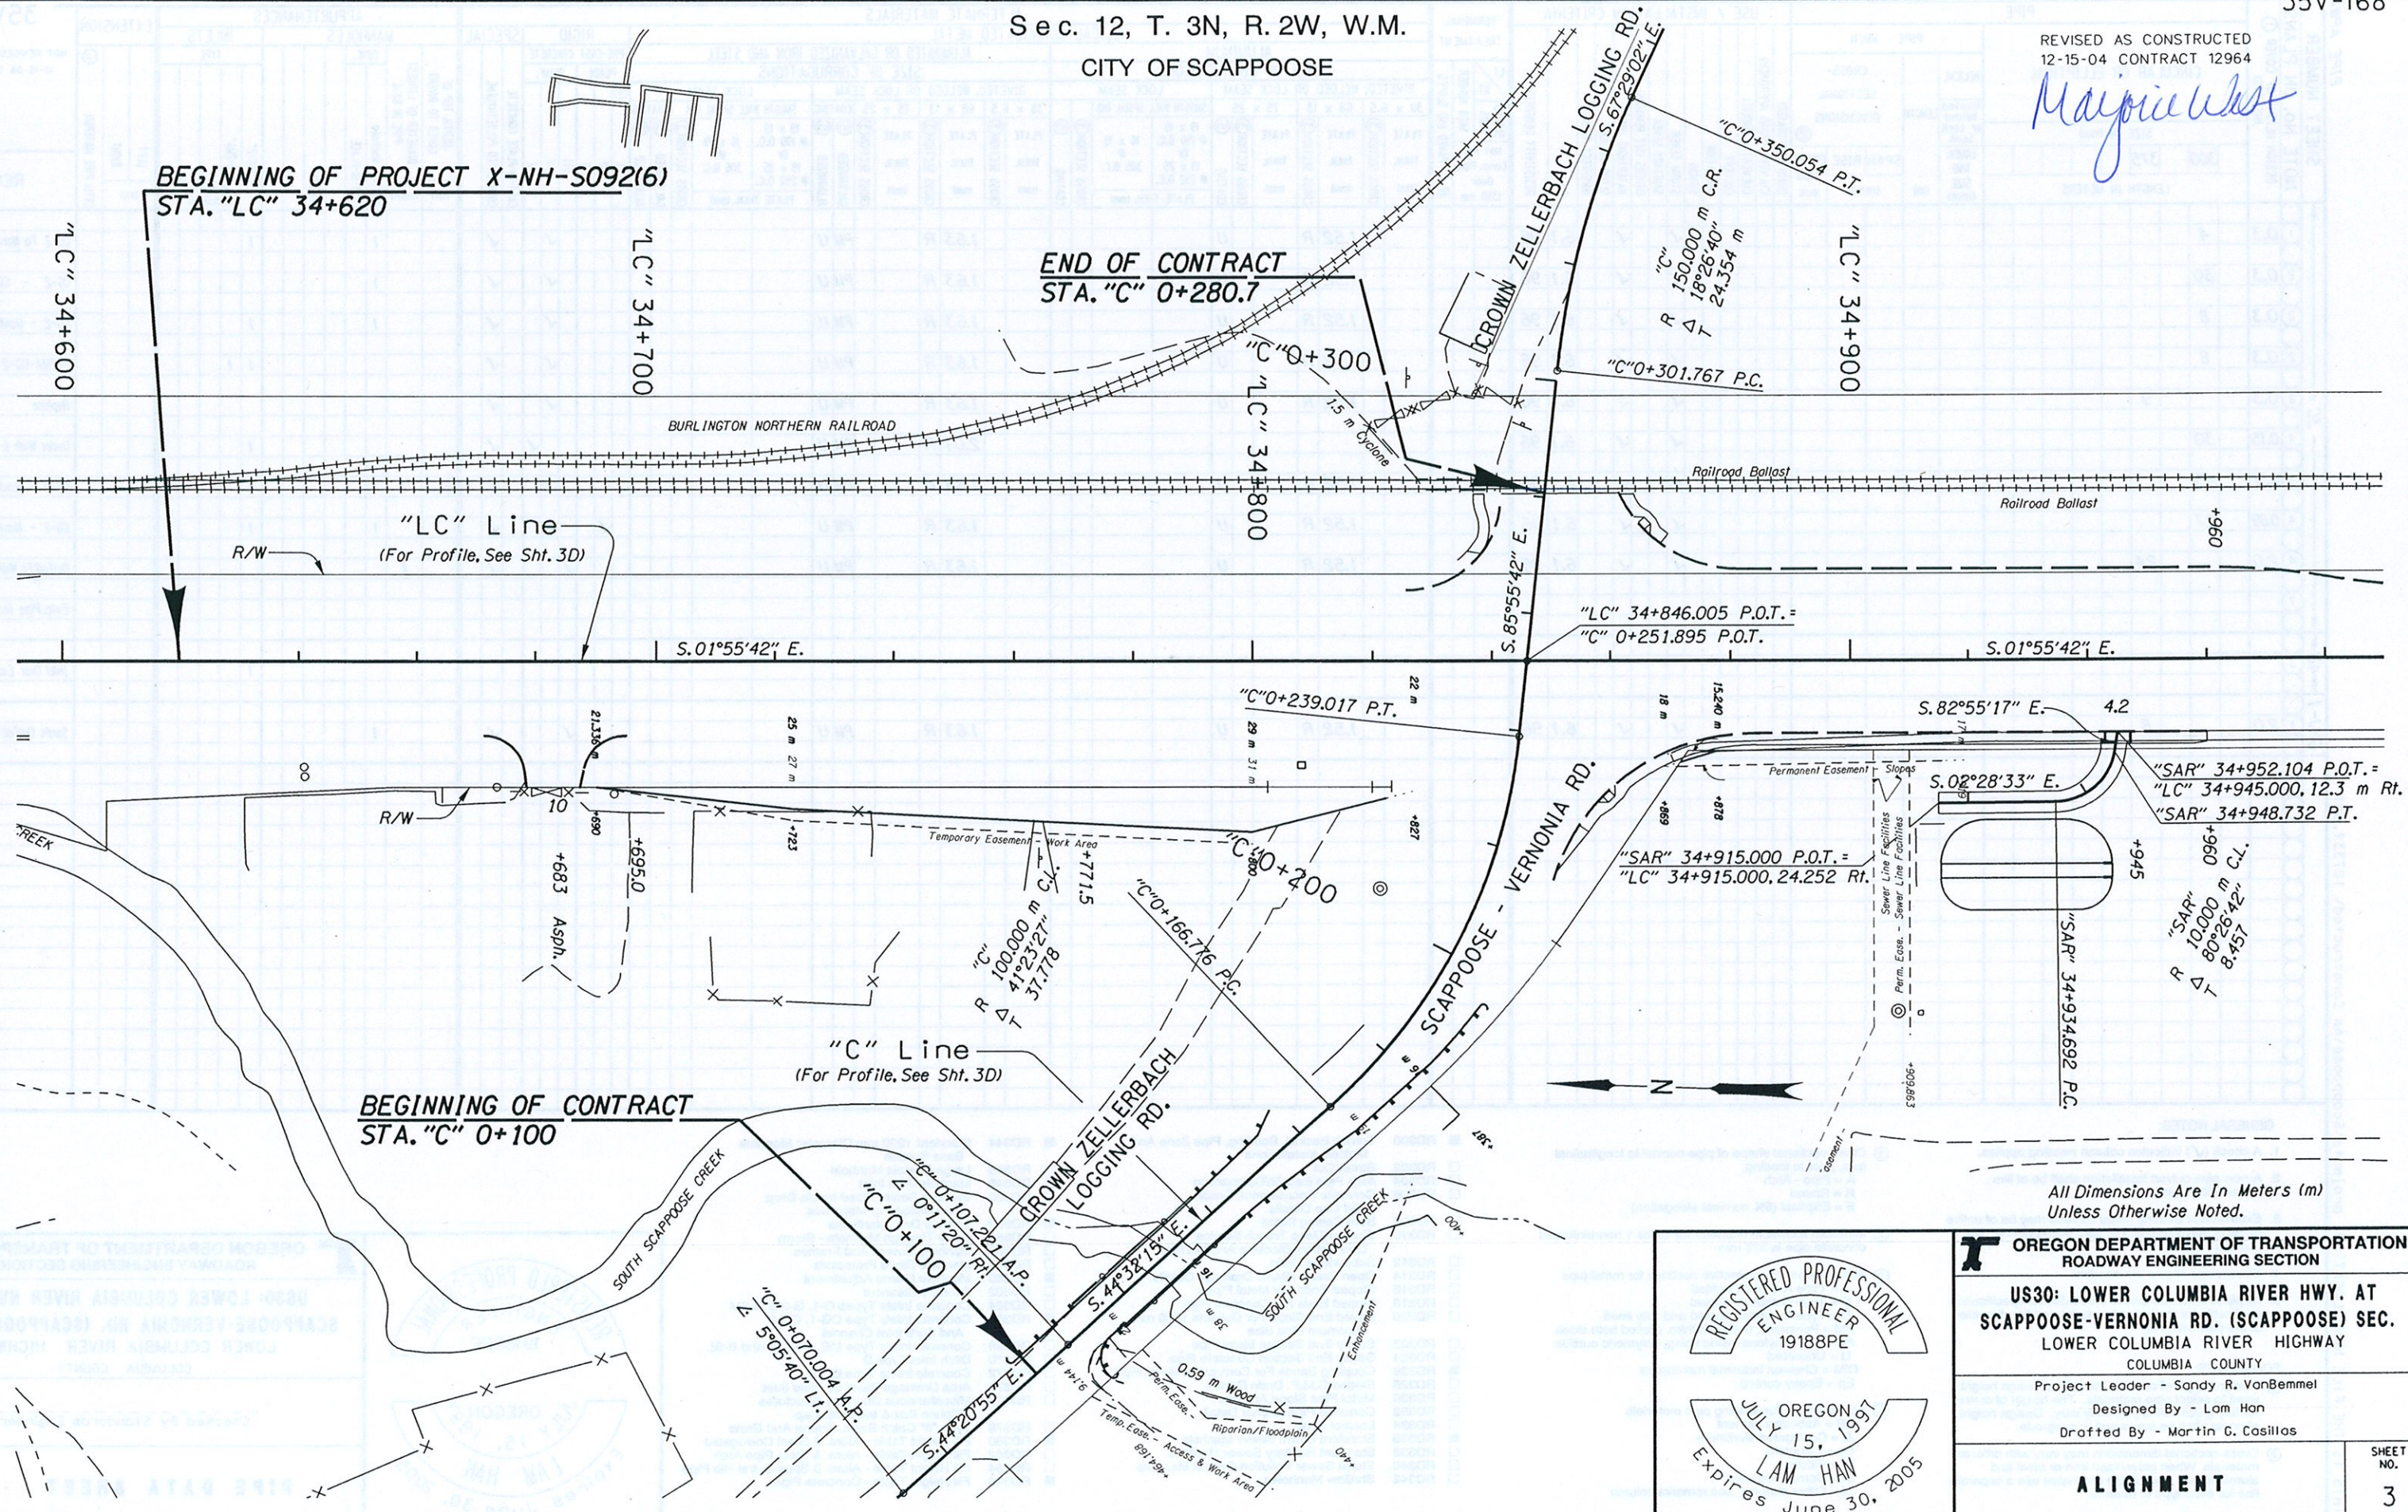

THIS IS THE FILE NAME LOCATION projects\Scappoose\As Constructed\ 10733f.plt

All Dimensions Are In Meters (m)
Unless Otherwise Noted.



REGISTERED PROFESSIONAL
ENGINEER
19188PE

JULY 15, 1991
OREGON
LAM HAN
Expires June 30, 2005

OREGON DEPARTMENT OF TRANSPORTATION ROADWAY ENGINEERING SECTION	
US30: LOWER COLUMBIA RIVER HWY. AT SCAPPOOSE-VERNONIA RD. (SCAPPOOSE) SEC. LOWER COLUMBIA RIVER HIGHWAY COLUMBIA COUNTY	
Project Leader - Sandy R. VanBemmel Designed By - Lam Han Drafted By - Martin G. Casillas	
ALIGNMENT	SHEET NO. 3

REVISED AS CONSTRUCTED
12-15-04 CONTRACT 12964

Magnus

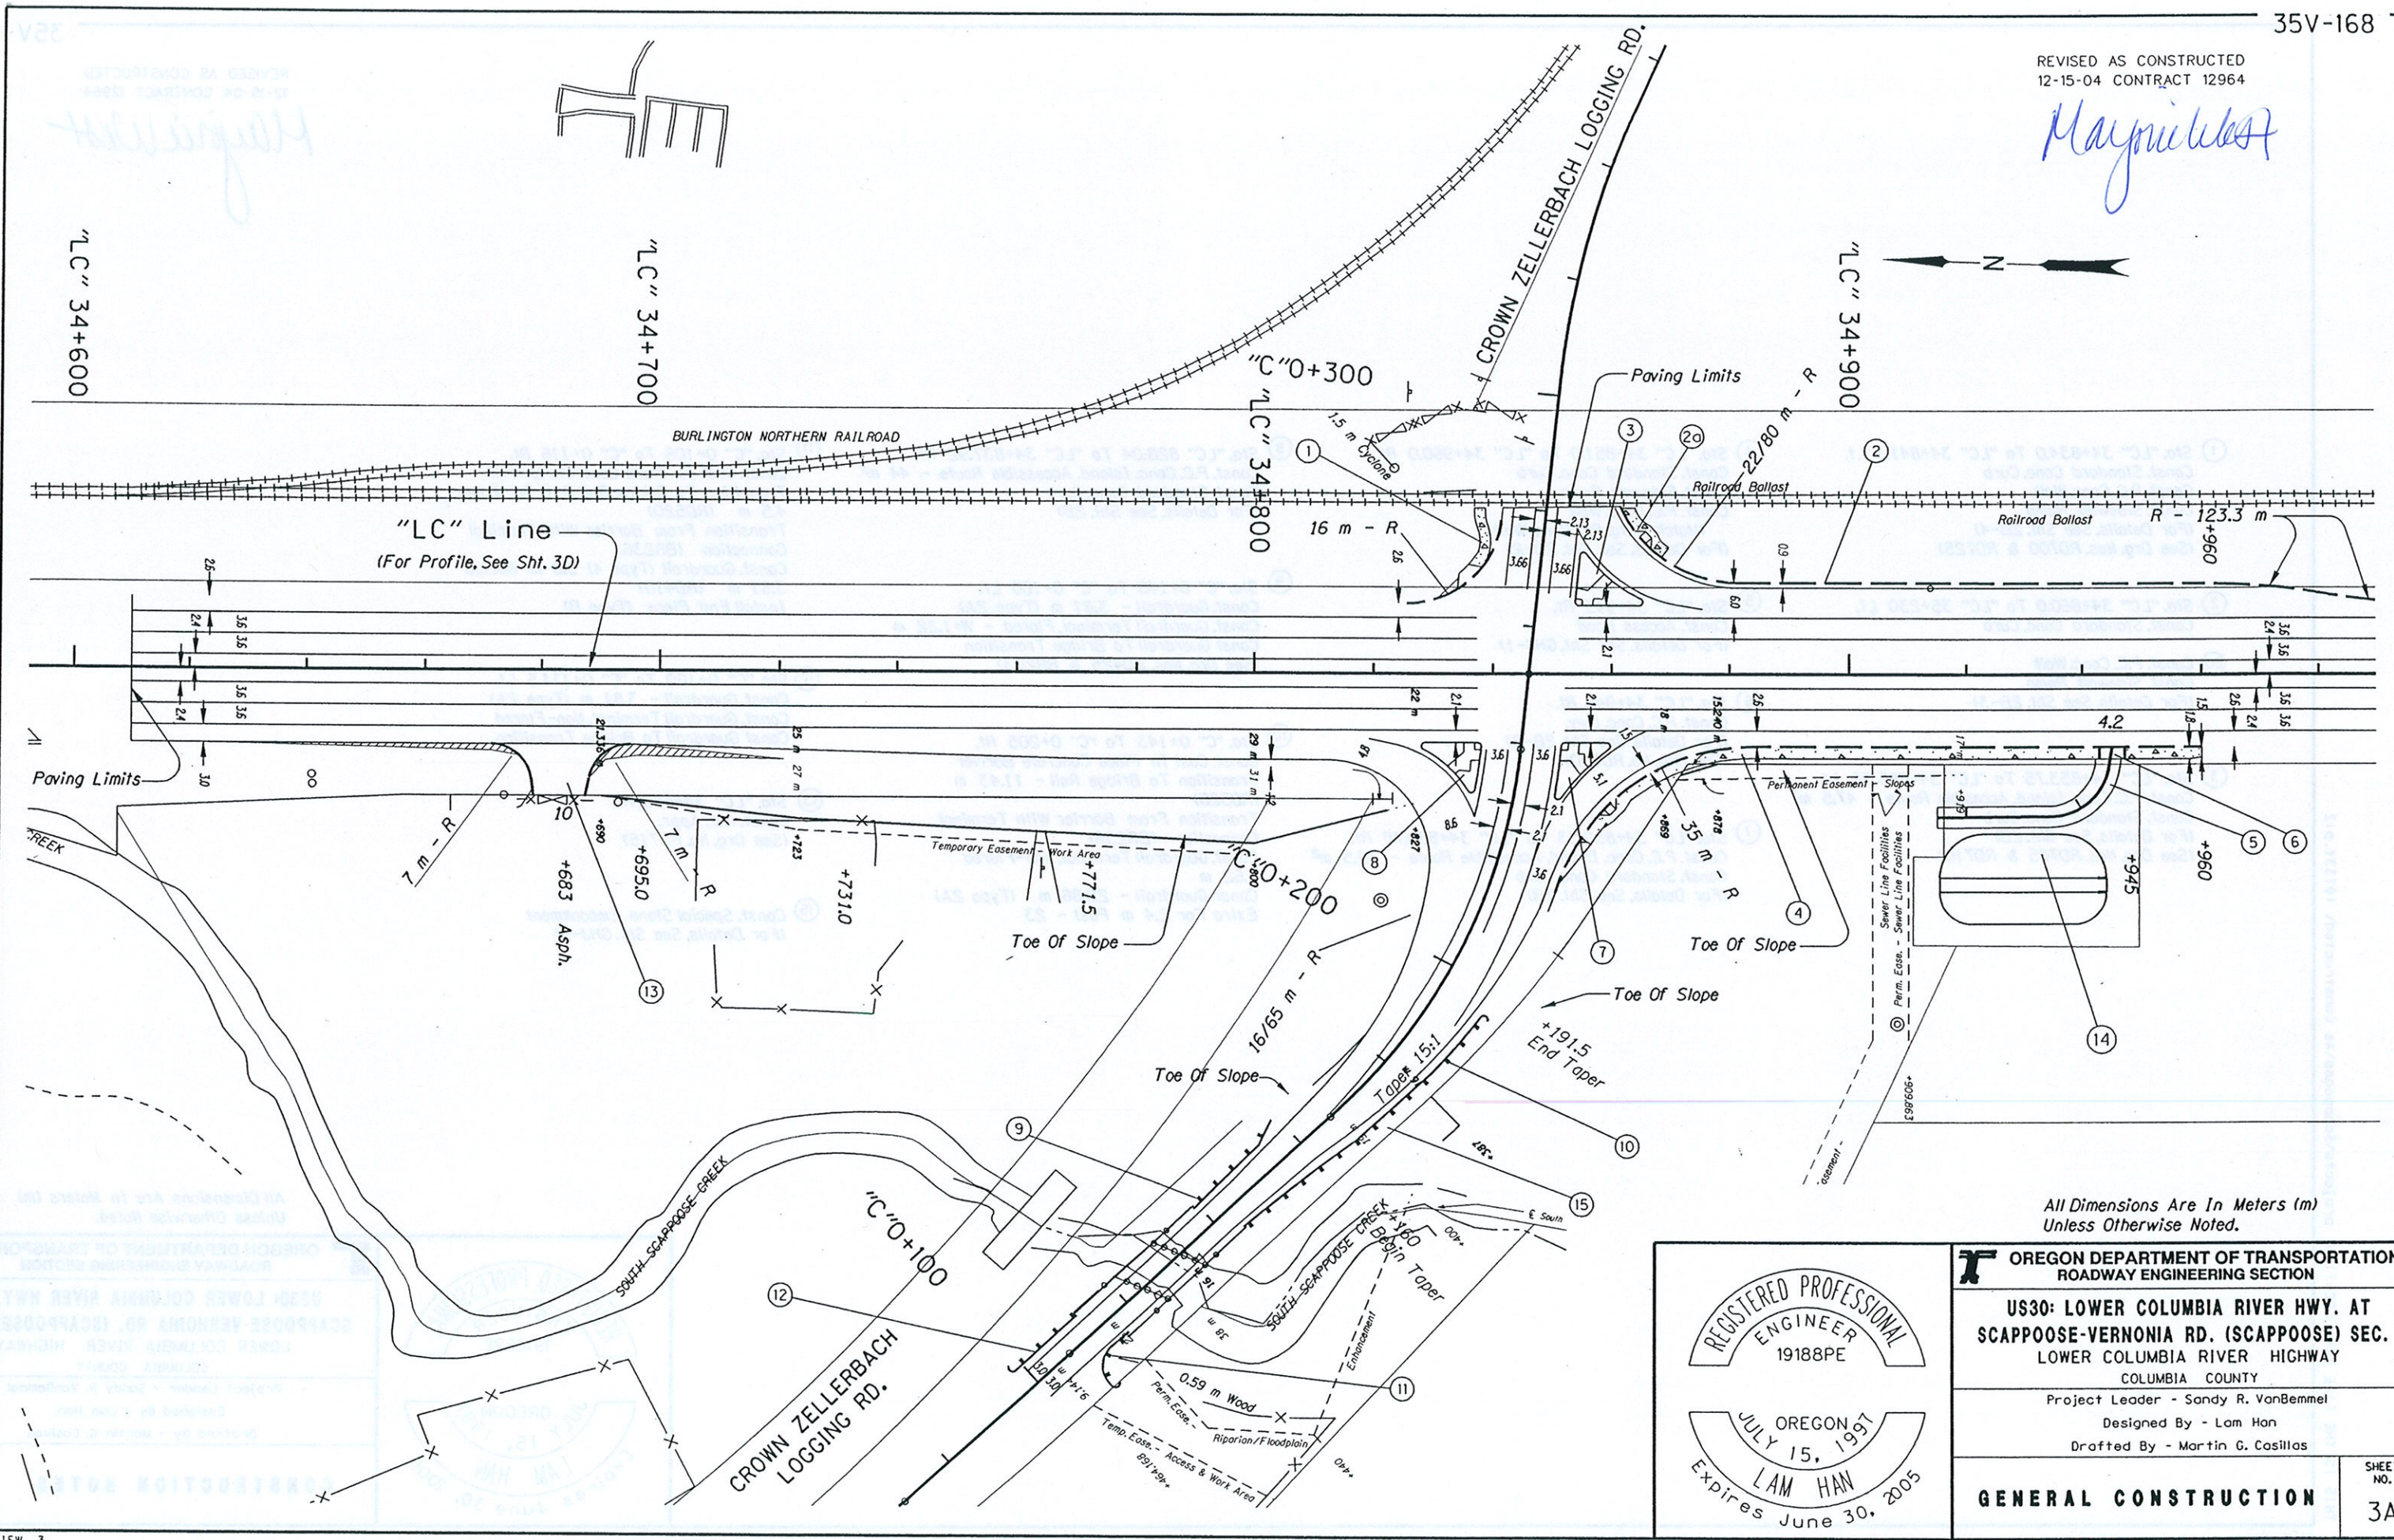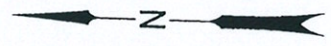

THIS IS THE FILE NAME LOCATION projects\Scappoose\As Constructed\ 107333.f.p12

All Dimensions Are In Meters (m)
Unless Otherwise Noted.

REGISTERED PROFESSIONAL
ENGINEER
19188PE

JULY 15, 1997
OREGON
LAM HAN
Expires June 30, 2005

OREGON DEPARTMENT OF TRANSPORTATION
ROADWAY ENGINEERING SECTION

US30: LOWER COLUMBIA RIVER HWY. AT
SCAPPOOSE-VERNONIA RD. (SCAPPOOSE) SEC.
LOWER COLUMBIA RIVER HIGHWAY
COLUMBIA COUNTY

Project Leader - Sandy R. VanBemmel
Designed By - Lam Han
Drafted By - Martin G. Casillas

GENERAL CONSTRUCTION

SHEET NO.
3A

REVISED AS CONSTRUCTED
12-15-04 CONTRACT 12964

Majorie West

① Sta. "LC" 34+834.0 To "LC" 34+841.1 Lt.
Const. Standard Conc. Curb
Const. P.C. Conc. Walk
Const. Sidewalk Ramp
(For Details, See Sht. 2B-4)
(See Drg. Nos. RD700 & RD725)

④ Sta. "LC" 34+851.0 To "LC" 34+960.0 Rt.
Const. Standard Conc. Curb
Const. Sidewalk Ramp
Const. P.C. Conc. Walk
(Match Extg. P.C. Conc. Walk)
(For Details, See Sht. 2B-2)

⑧ Sta. "LC" 828.04 To "LC" 34+837.92 Rt.
Const. P.C. Conc. Island, Accessible Route - 44 m²
Const. Standard Conc. Curb
(For Details, See Sht. 2B)

⑪ Sta. "C" 0+106 To "C" 0+116 Rt.
Const. Cast In Place Concrete Barrier
Transition To Bridge Rail @ a 9:1 Taper
4.5 m (RD520)
Transition From Barrier With Terminal
Connection (BR236)
Const. Guardrail (Type 4) 3.0 m Radius
3.81 m (RD410)
Install End Piece (Type B)

② Sta. "LC" 34+860.0 To "LC" 35+230 Lt.
Const. Standard Conc. Curb

⑤ Sta. "LC" 34+945 Rt.
Const. Access Road
(For Details, See Sht. GHJ-1)

⑨ Sta. "C" 0+140 To "C" 0+160 Lt.
Const. Guardrail - 3.81 m (Type 2A)
Const. Guardrail Terminal, Flared - W=1.22 m
Const. Guardrail To Bridge Transition
(See Drg. Nos. RD425 & BR203)

⑫ Sta. "C" 0+100 To "C" 0+111.5 Lt.
Const. Guardrail - 3.81 m (Type 2A)
Const. Guardrail Terminal, Non-Flared
Const. Guardrail To Bridge Transition

②① Const. P.C. Conc. Walk
Const. Sidewalk Ramp
(For Details, See Sht. 2B-3)

⑥ Sta. "LC" 34+945, Rt.
Const. P.C. Conc. Dwy.
(For Details, See Sht. 2B-2)
(See Drg. No. RD730)

⑩ Sta. "C" 0+143 To "C" 0+205 Rt.
Const. Cast In Place Concrete Barrier
Transition To Bridge Rail - 11.43 m
(RD520)
Transition From Barrier With Terminal
Connection (BR236)
Const. Guardrail Terminal, Non-Flared
7.62 m
Const. Guardrail - 22.86 m (Type 2A)
Extra For 2.4 m Post - 23

⑬ Sta. "LC" 34+683, Rt.
Const. A.C. Appr.
(See Drg. No. RD715)


③ Sta. "LC" 34+853.75 To "LC" 34+865.32 Lt.
Const. P.C. Conc. Island, Accessible Route - 47.5 m²
Const. Standard Conc. Curb
(For Details, See Sht. 2B)
(See Drg. Nos. RD705 & RD710)

⑦ Sta. "LC" 34+850.33 To "LC" 34+859.78 Rt.
Const. P.C. Conc. Island, Accessible Route - 38.5 m²
Const. Standard Conc. Curb
(For Details, See Sht. 2B)

⑮ Const. Special Stone Embankment
(For Details, See Sht. GHJ-5)

All Dimensions Are In Meters (m)
Unless Otherwise Noted.

THIS IS THE FILE NAME LOCATION projects\Scappoose\As Constructed\ 10733f.plt

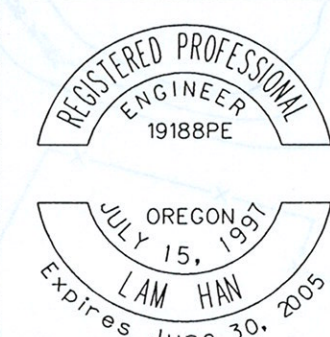

OREGON DEPARTMENT OF TRANSPORTATION ROADWAY ENGINEERING SECTION	
US30: LOWER COLUMBIA RIVER HWY. AT SCAPPOOSE-VERNONIA RD. (SCAPPOOSE) SEC. LOWER COLUMBIA RIVER HIGHWAY COLUMBIA COUNTY	
Project Leader - Sandy R. VanBemmel Designed By - Lam Han Drafted By - Martin G. Casillas	
CONSTRUCTION NOTES	SHEET NO. 3B

REVISED AS CONSTRUCTED
12-15-04 CONTRACT 12964

Major West
N

① Sta. "LC" 34+961 Lt.
Const. Manhole In-Place
Const. Type "CG-2" Inlet
Inst. 300 mm Sewer Pipe - 4 m
1.5 m Depth
(See Drg. Nos., RD336 & RD366)


② Sta. "LC" 34+857.3 To "LC" 34+898.9 Lt.
Const. Manhole Over Extg. Pipe
Const. Type "CG-2" Inlet - 2
Const. Type "G-2MA" Inlet
Inst. 300 mm Sewer Pipe - 46 m
Inst. 375 mm Sewer Pipe - 9 m
1.5 m Depth

④ Sta. "LC" 34+869.8 To "LC" 34+972.3 Rt.
Const. Manhole
Const. Type "CG-2" Inlet - 3
Inst. 300 mm Sewer Pipe - 102 m
1.5 m Depth
Inst. 375 mm Sewer Pipe - 24 m
1.5 m Depth


⑥ Const. Water Quality Swale
(For Details, See Water Quality Shts.)

⑦ Sta. "LC" 34+820 Lt.
Const. Pipe End Slope

⑧ Relocate Utility Pole
1.2 m Behind Guardrail
(By Others)

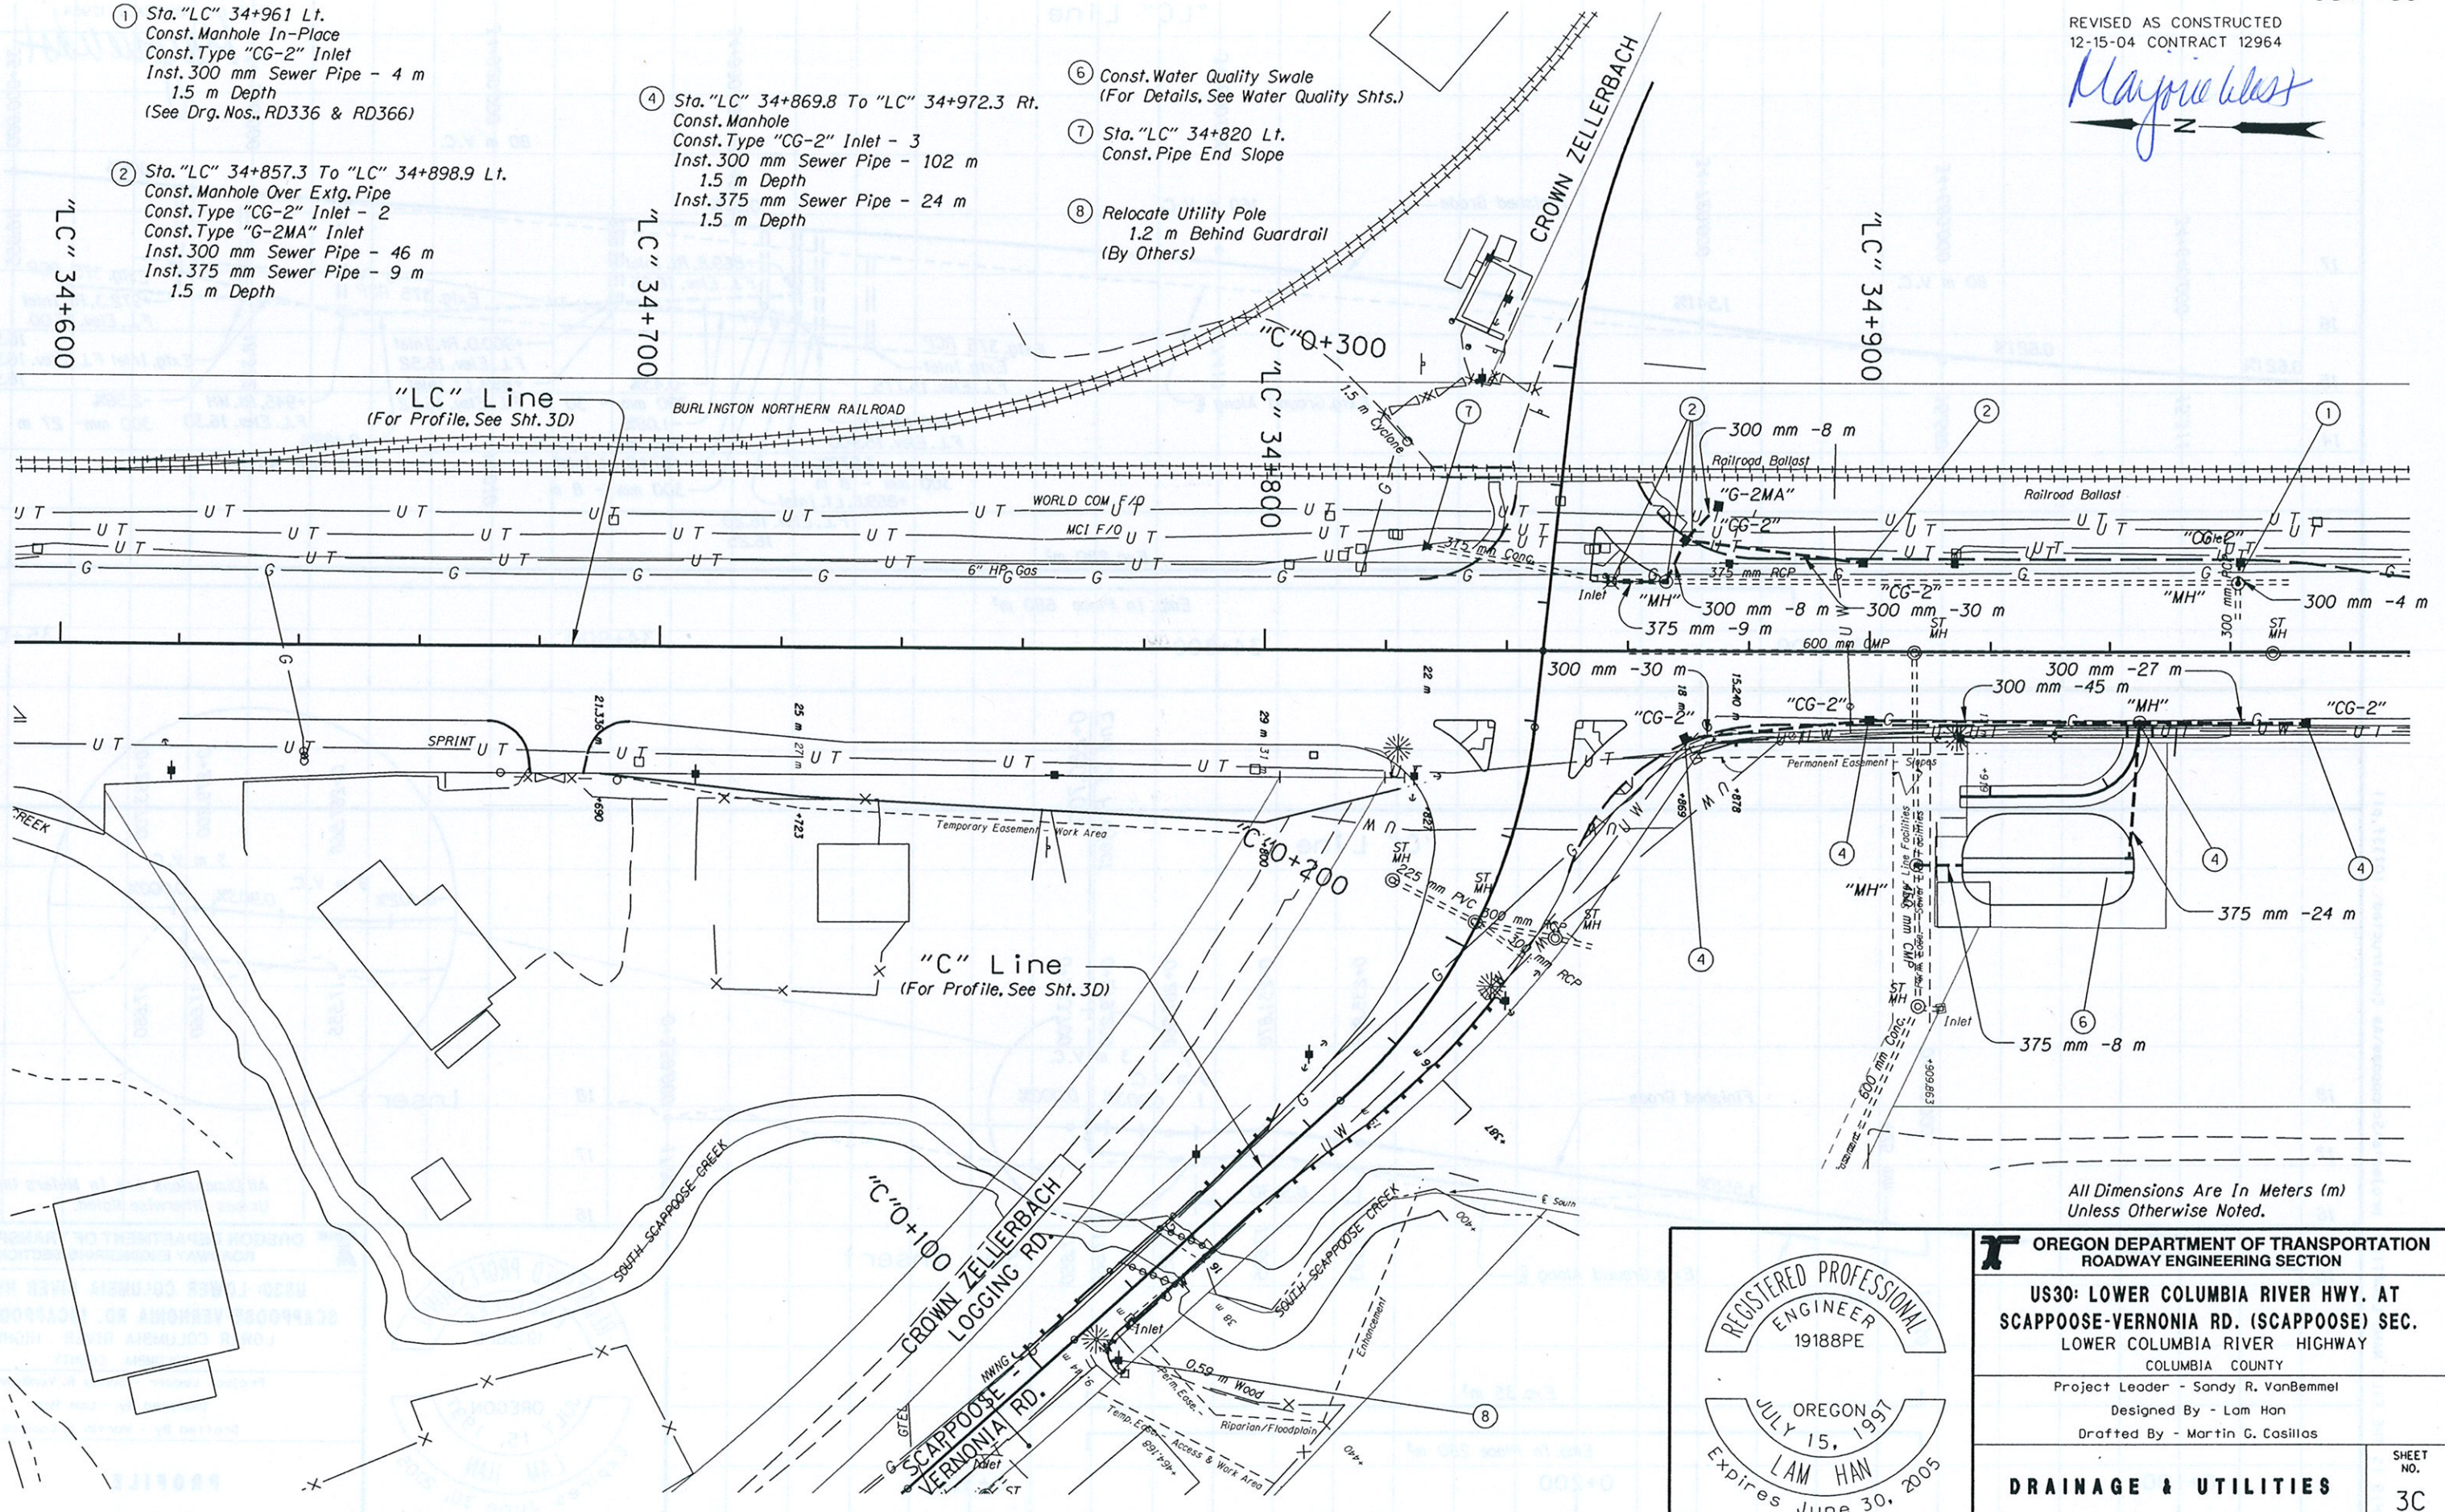




All Dimensions Are In Meters (m)
Unless Otherwise Noted.

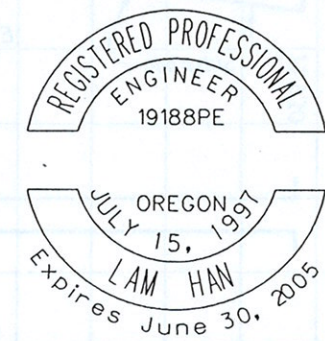


OREGON DEPARTMENT OF TRANSPORTATION ROADWAY ENGINEERING SECTION	
US30: LOWER COLUMBIA RIVER HWY. AT SCAPPOOSE-VERNONIA RD. (SCAPPOOSE) SEC. LOWER COLUMBIA RIVER HIGHWAY COLUMBIA COUNTY	
Project Leader - Sandy R. VanBemmel Designed By - Lam Han Drafted By - Martin C. Cosillas	
DRAINAGE & UTILITIES	SHEET NO. 3C

THIS IS THE FILE NAME LOCATION projects\scappoose\As Constructed\ 10733f.plt

Handwritten signature: Maypuech

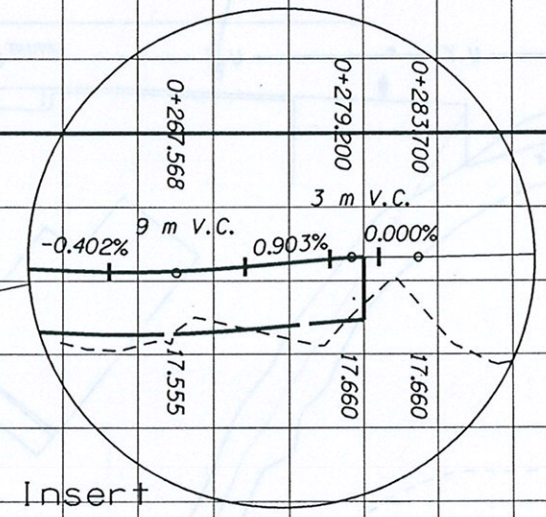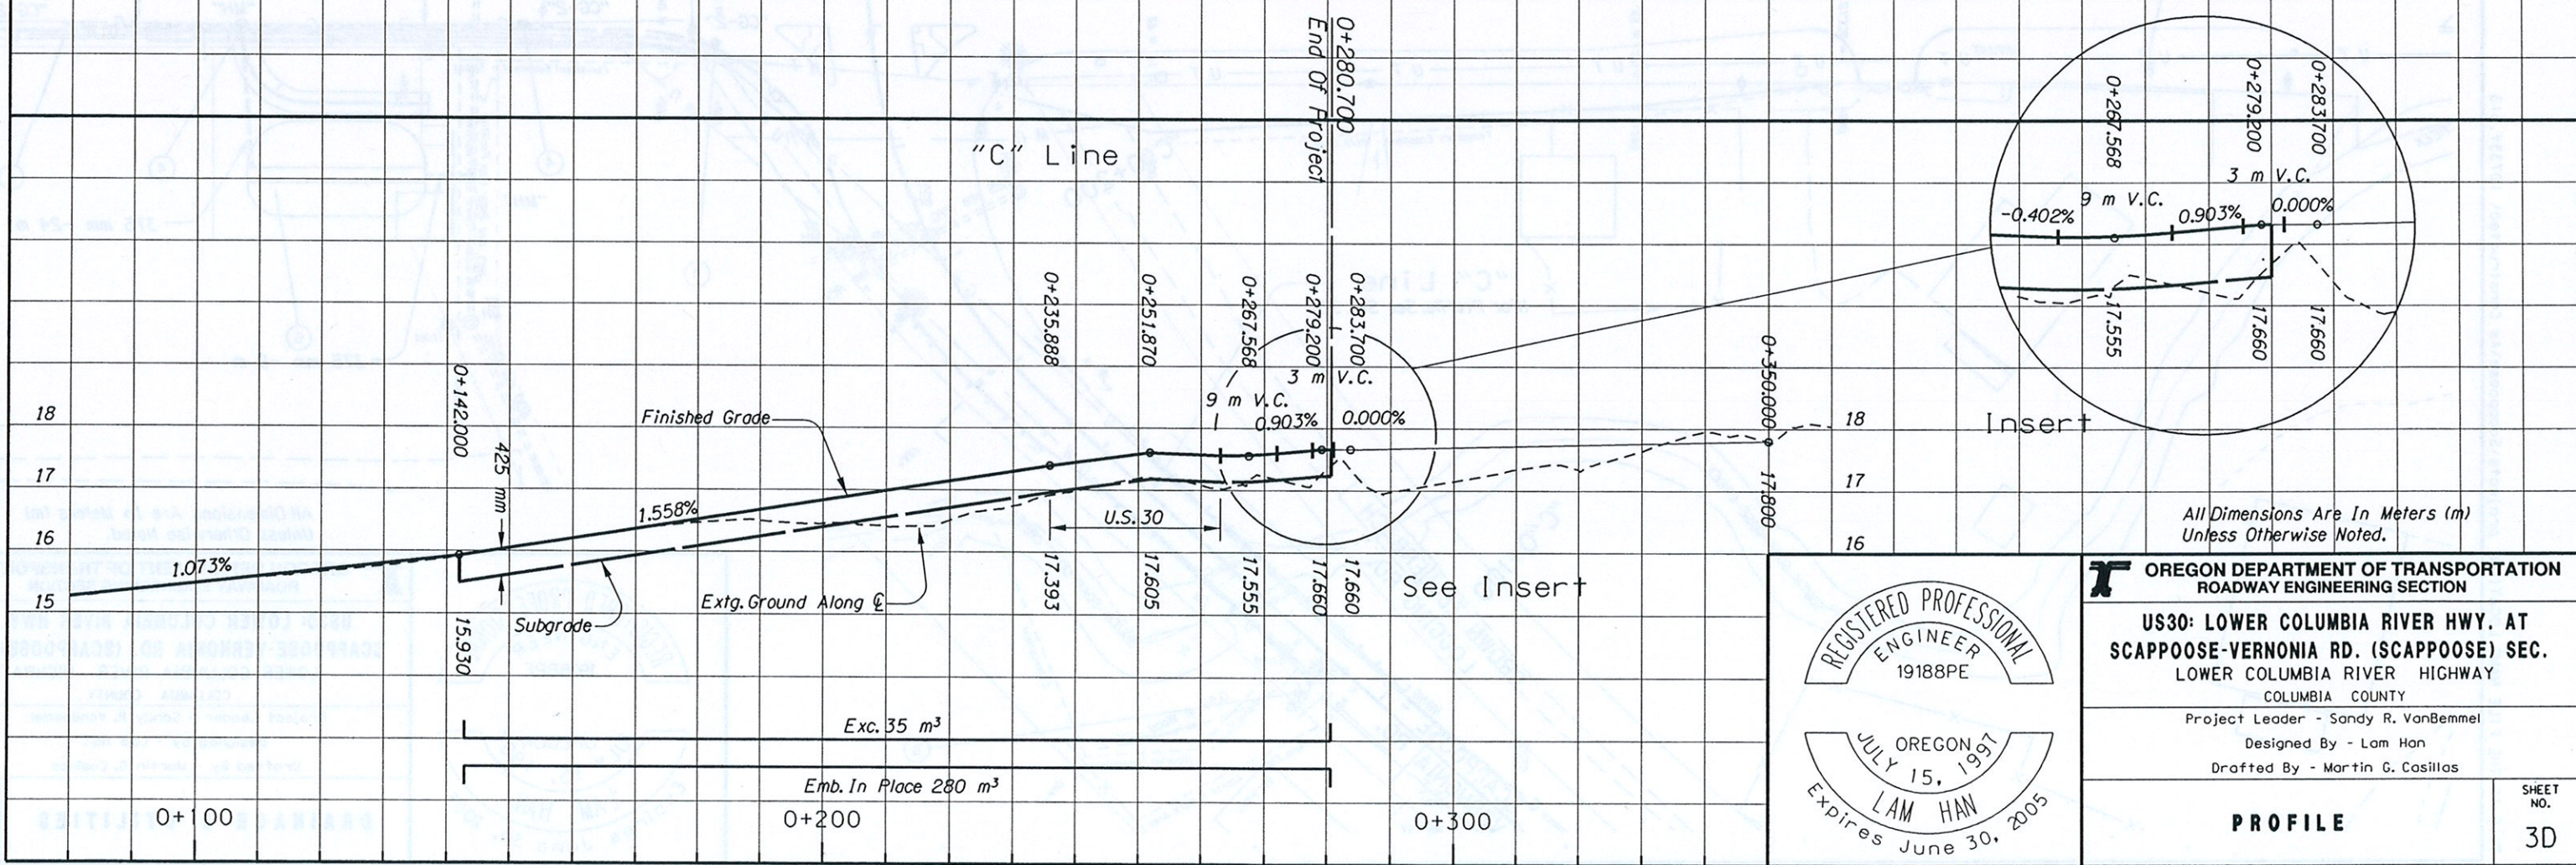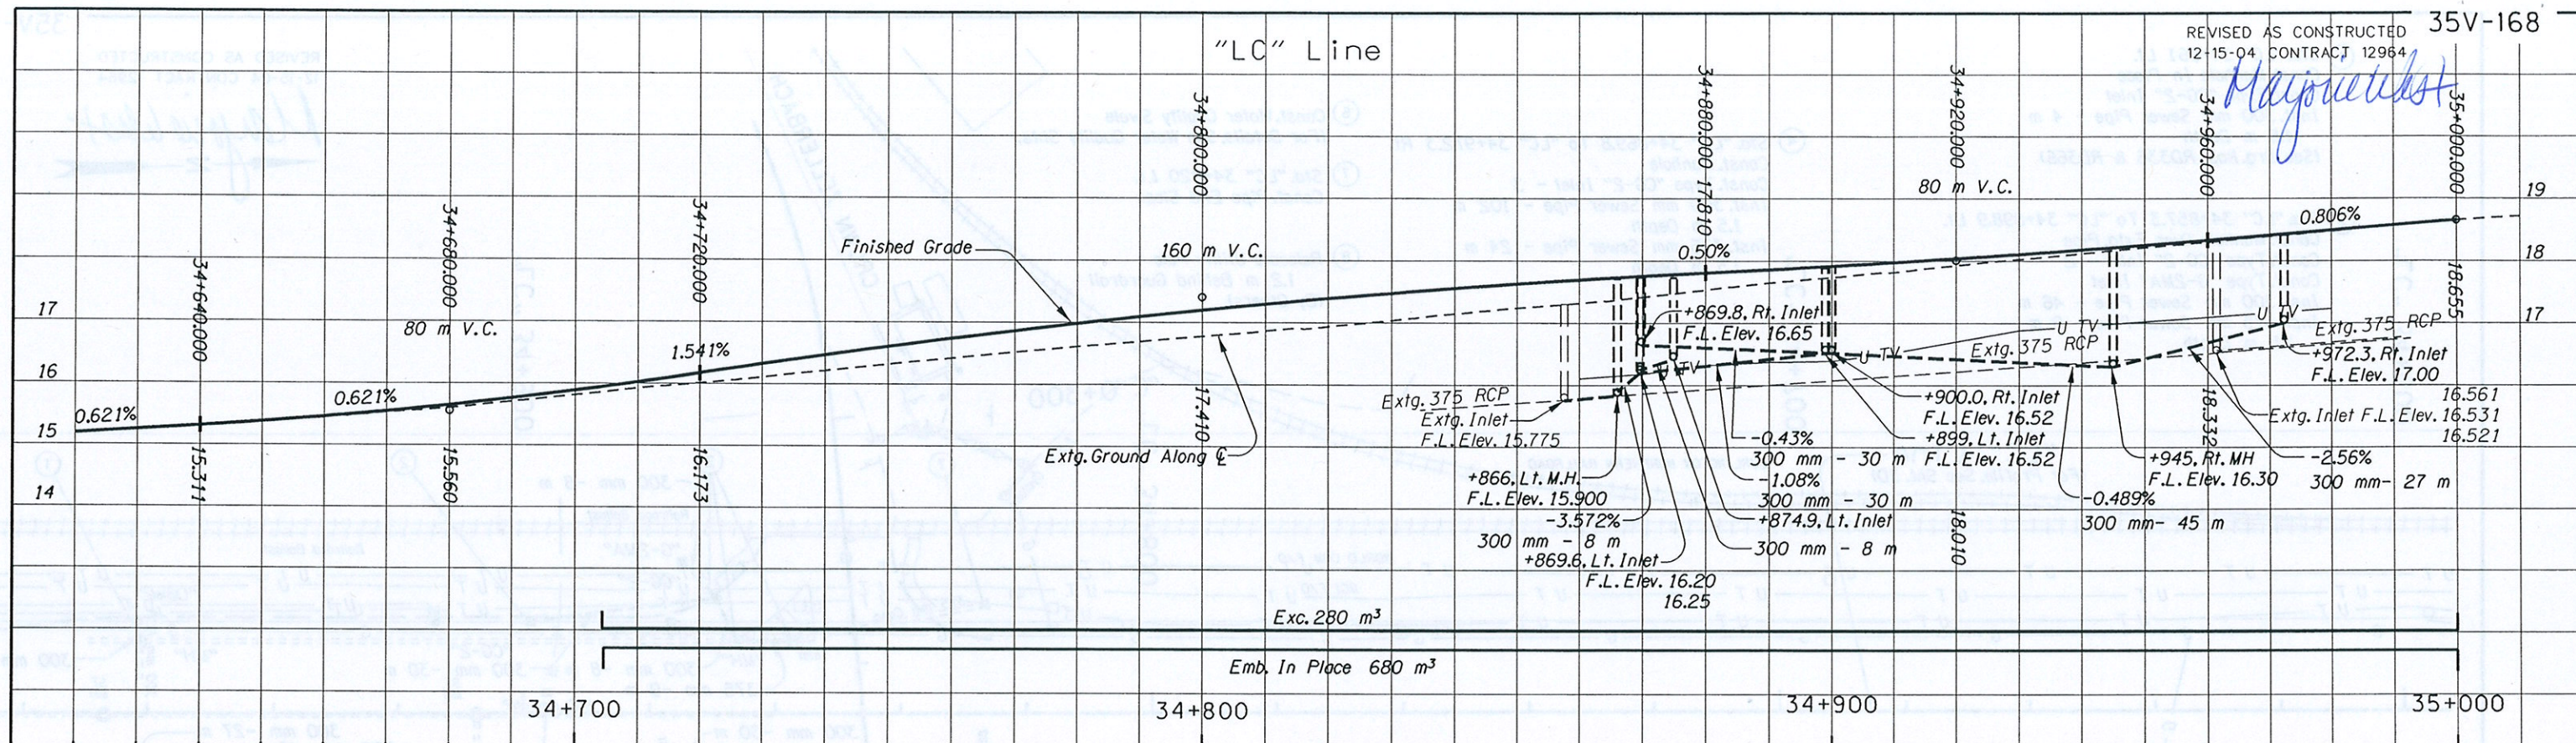

All Dimensions Are In Meters (m)
Unless Otherwise Noted.

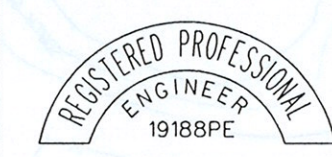

OREGON DEPARTMENT OF TRANSPORTATION
ROADWAY ENGINEERING SECTION

US30: LOWER COLUMBIA RIVER HWY. AT SCAPPOOSE-VERNONIA RD. (SCAPPOOSE) SEC.
LOWER COLUMBIA RIVER HIGHWAY
COLUMBIA COUNTY

Project Leader - Sandy R. VanBemmel
Designed By - Lam Han
Drafted By - Martin G. Casillas

PROFILE

SHEET NO. 3D

THIS IS THE FILE NAME LOCATION projects\Scappoose\As Constructed\10733f.plt



May 2004
REVISED AS CONSTRUCTED
12-15-04 CONTRACT 12964

ALL JOINTS ENCASED IN CTB
CHANGE PVC TO DUCTILE IRON

- ① "C" Sta: 0+228.23, 6.5m Rt. 380mm x 300mm [15"x12"] Tee
- ② 300 mm (12") PVC Gate Valve And Valve Box Per ODOT Std Dwg. RD258
- ③ Temporary Blow Off Assembly See ODOT Std. Dwg. RD262
- ④ 380 mm (12") PVC Gate Valve And Valve Box Per ODOT Std Dwg. RD258
- ⑤ "LC" Sta: 34+850, 24.8m Rt. 380mm x 300mm [15"x12"] Tee
- ⑥ "LC" Sta: 34+860.84, 25m Rt 45° Bend
- ⑦ Connect to Existing 200mm [8"] CI Water Line With Wet Tap. Field Verify Location And Depth
- ⑧ 200mm [8"] PVC Gate Valve And Valve Box Per ODOT Std Dwg. RD258 And Reducer



NOTE:
For Trench Details, See ODOT Std Dwg. RD300

Addendum No. 1 by AHR 12/05/03

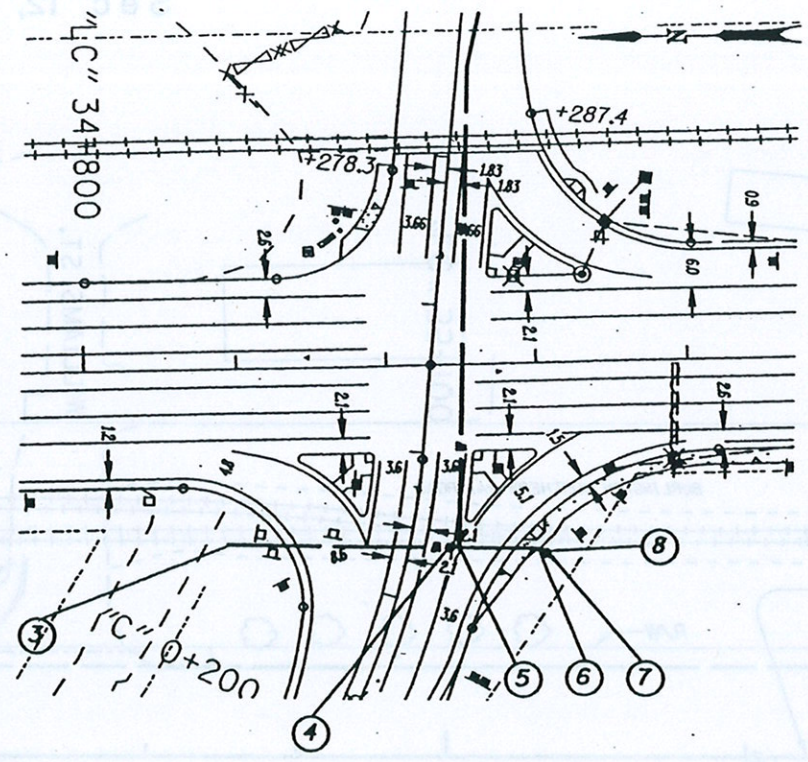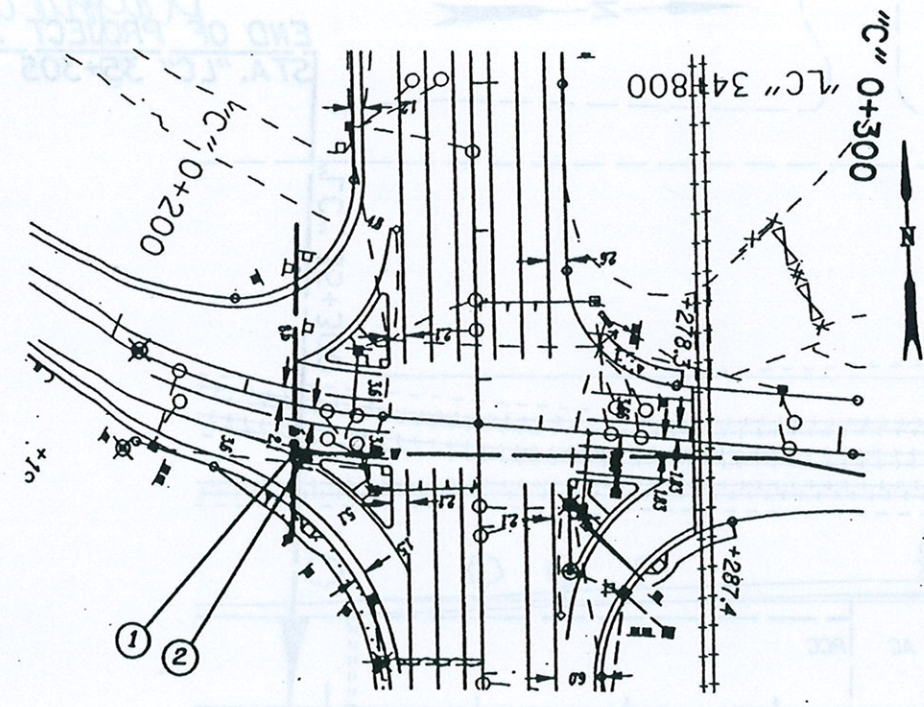

12/05/2003 01:39:40 PM

h:\12031-Scappoose\Crown_Zellerbach\13-1-Elec-Dwgs-CADD\CAD-Dwg\100%\001-3E.dgn

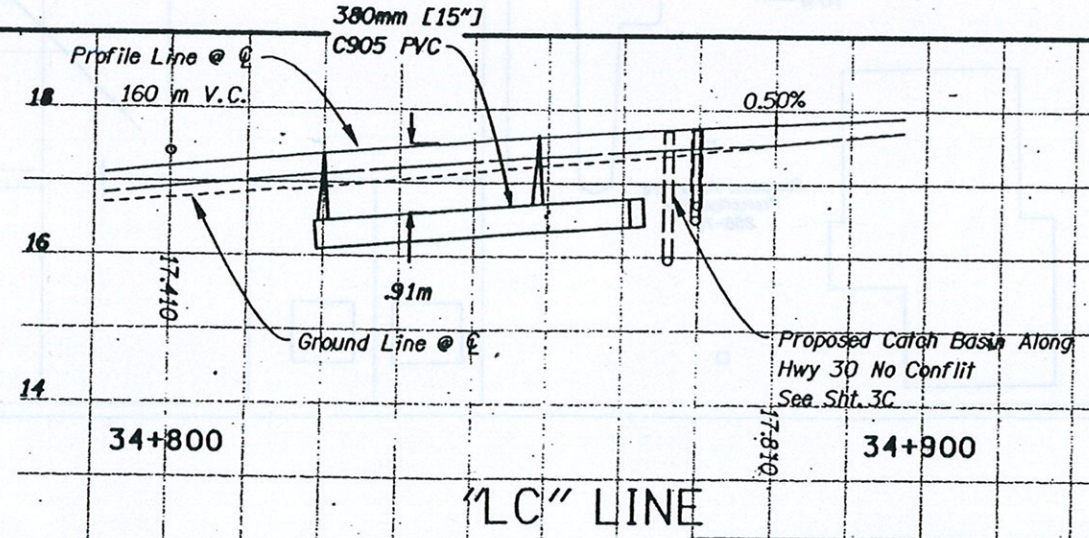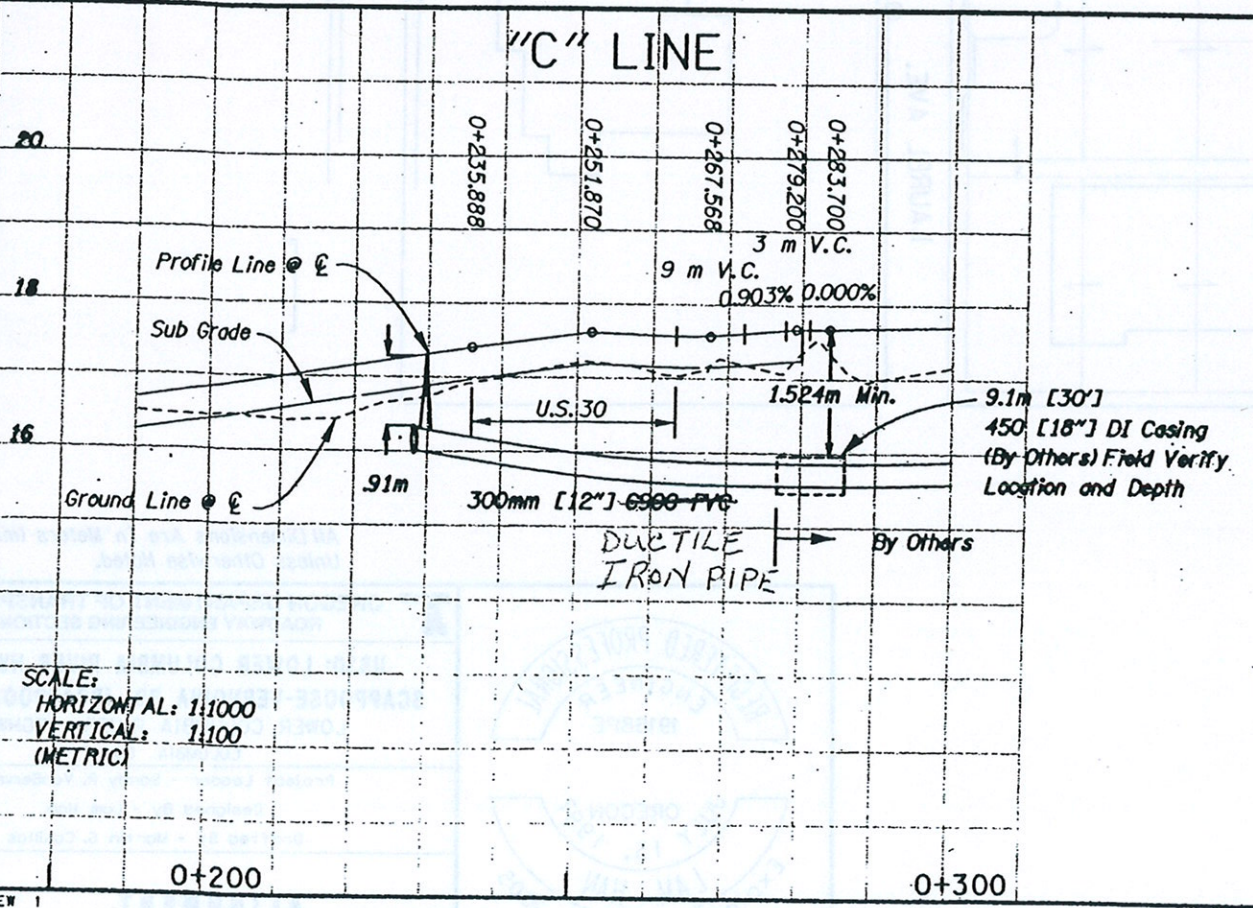

SCALE:
HORIZONTAL: 1:1000
VERTICAL: 1:100
(METRIC)



EXP. DATE: 12/31/04

HR HDR Engineering, Inc.
 US 30: LOWER COLUMBIA RIVER HWY. AT
 SCAPPOOSE - YERMONIA RD. (SCAPPOOSE) SEC.
 LOWER COLUMBIA RIVER HIGHWAY
 COLUMBIA COUNTY

Design Team Leader - Kirk Hampson
Designed By - Scott Hale
Drafted By - Scott Hale and Paul Waggoner


WATERLINE & UTILITIES

SHEET NO.
3E



REVISED AS CONSTRUCTED
12-15-04 CONTRACT 12964

Mayoralist


- ① Sta. "L" 34+909.25, 35.7 m Rt.
Const. Manhole
F.L. = 12.87 m
Inst. 450 mm Sew. Pipe - 7.5 m
- ② Sta. "L" 34+912.83, 35.8 m Rt. = "WQ" 0+131.75 To
"L" 34+947.15, 35.8 m Rt. = "WQ" 0+097.43
Const. Water Quality Swale
Inlet Pipe F.L. = 13.26 m
Outlet Pipe F.L. = 12.975 m
(For Details, See Shts. GHJ-2, GHJ-3 & GHJ-4)
- ③ Const. Access Road
- ④ Sta. "L" 34+908.1, 60.7 m Rt.
Const. Manhole Large, 1.8 m
F.L. = 12.53 m
Inst. 450 mm Sew. Pipe - 25 m

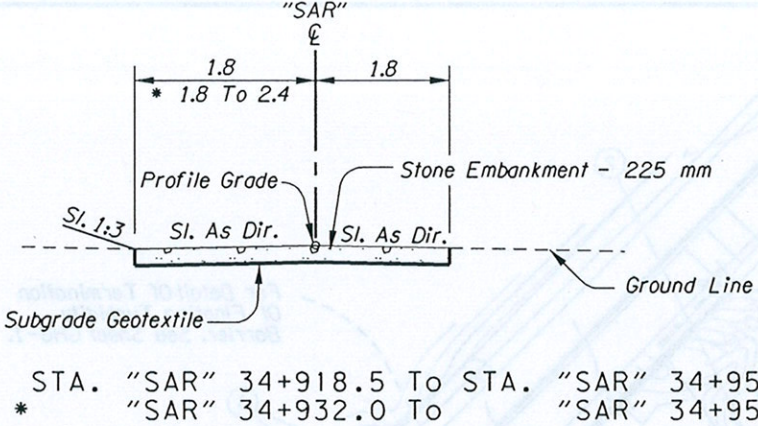

STA. "SAR" 34+918.5 To STA. "SAR" 34+950.0
* "SAR" 34+932.0 To "SAR" 34+950.0

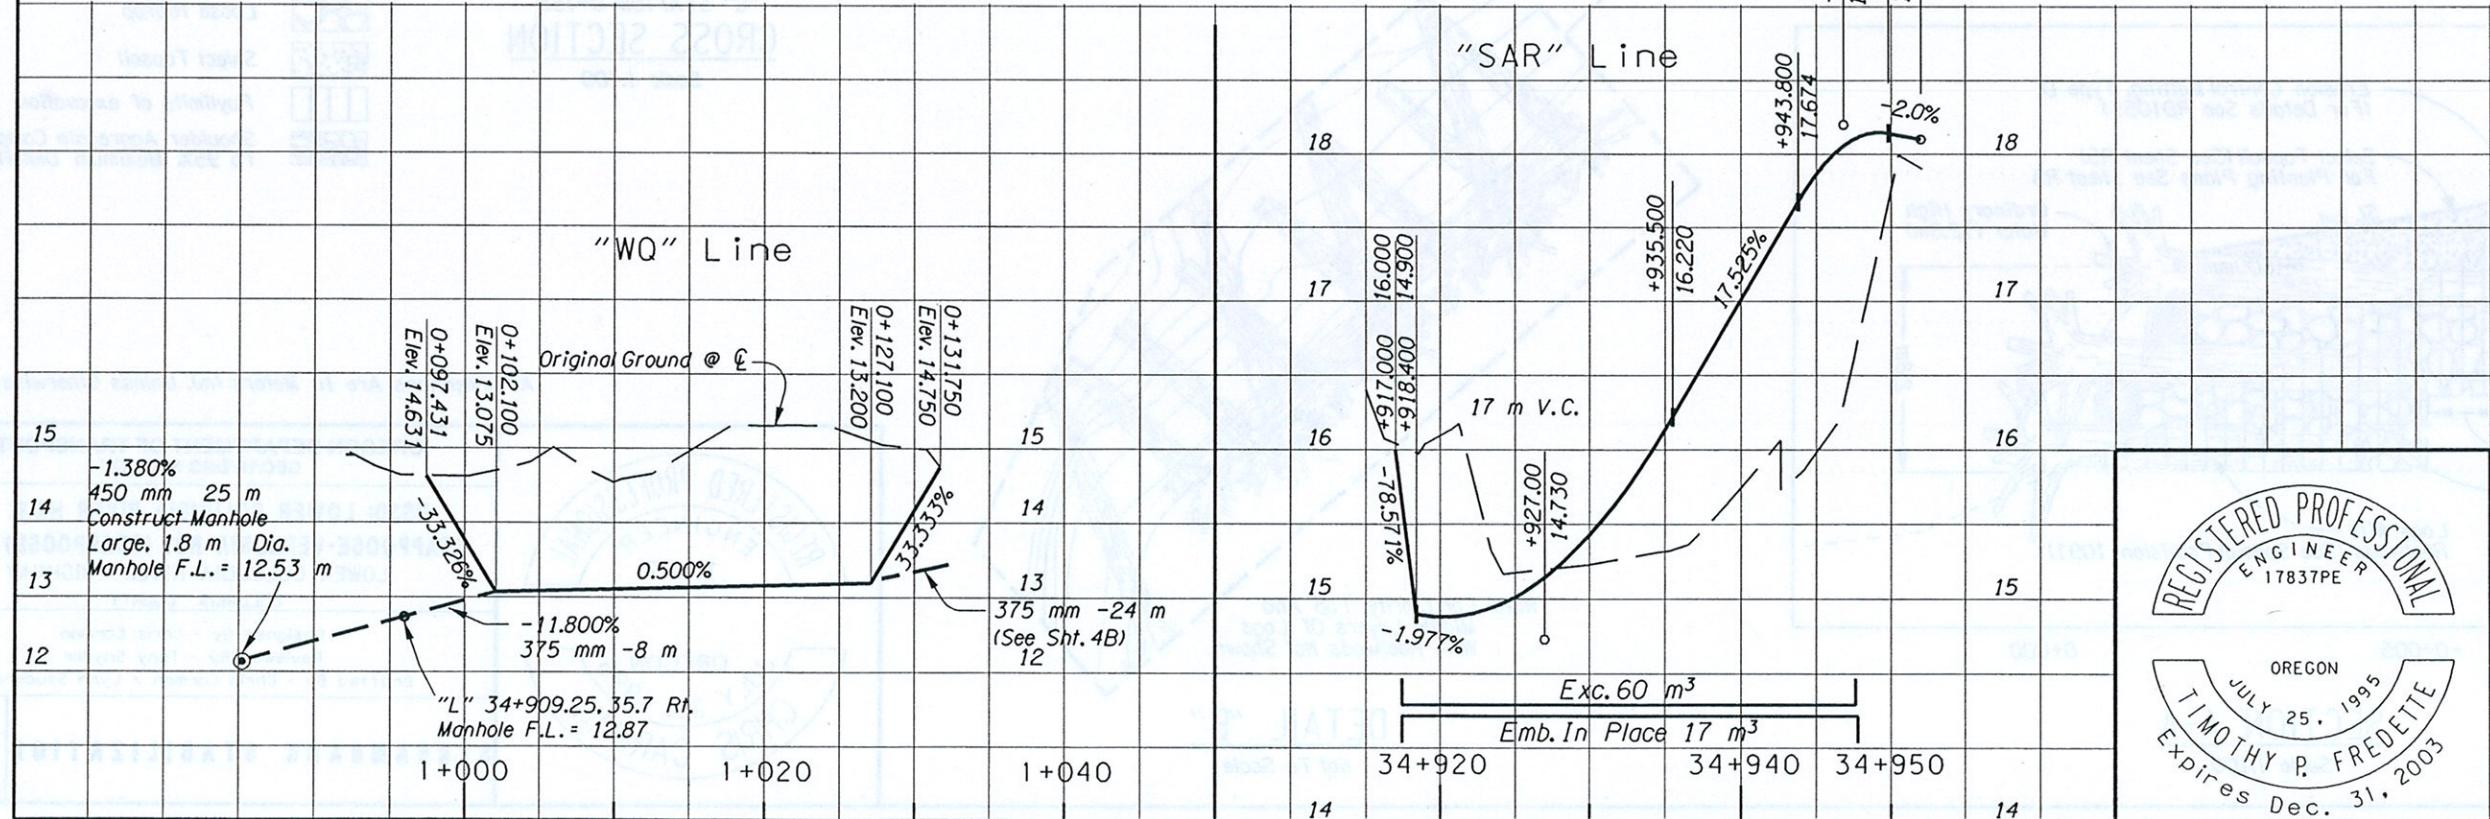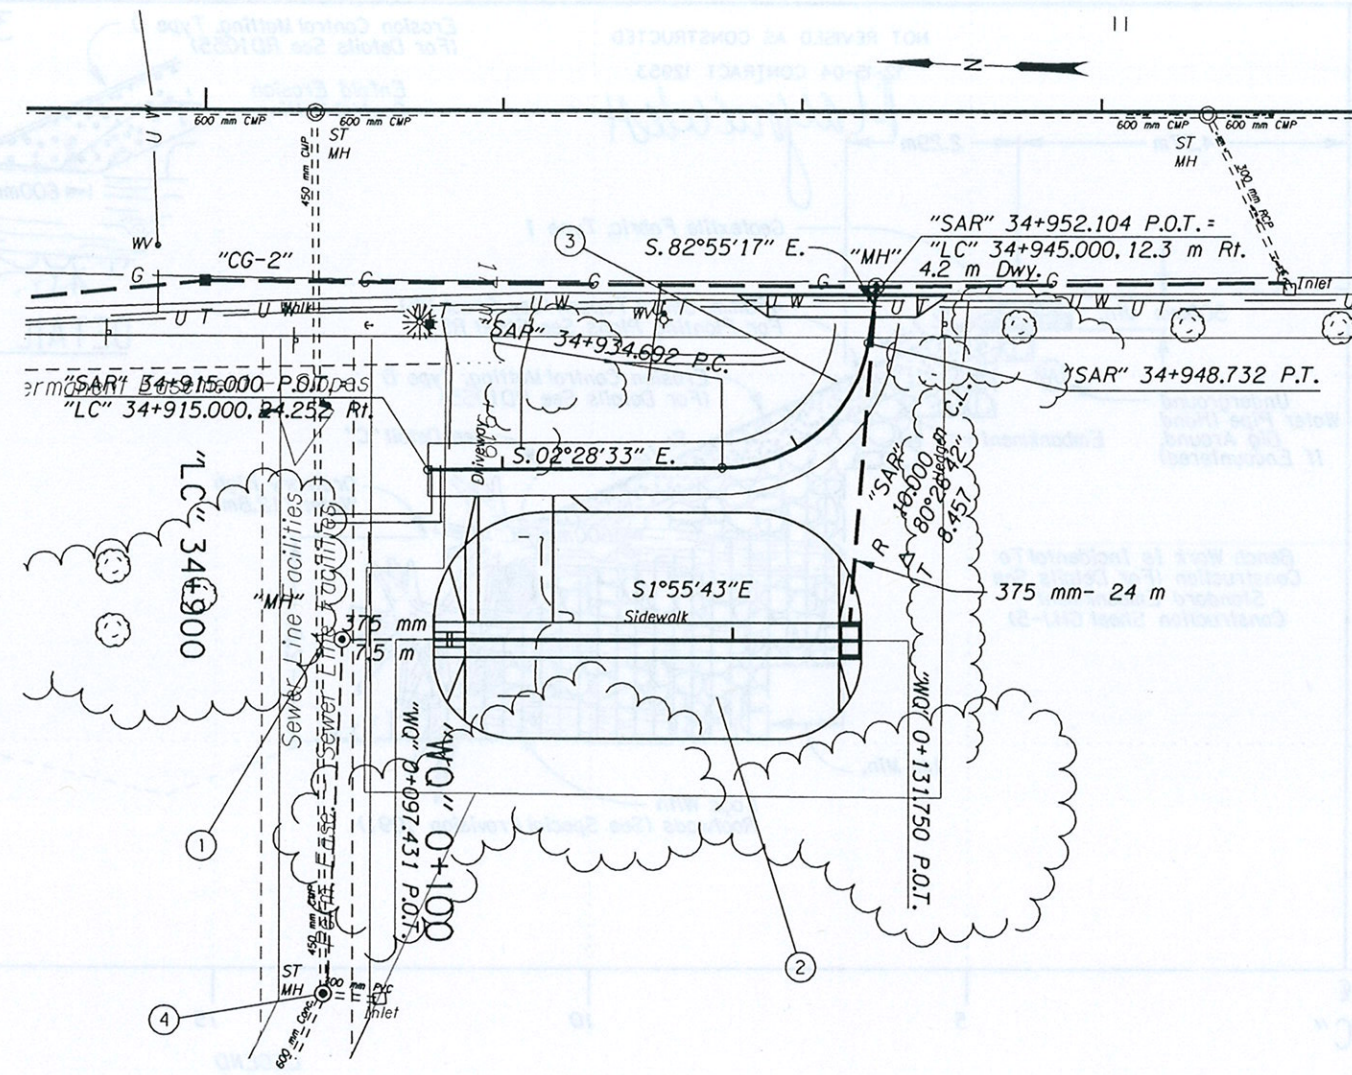

All Dimensions Are In Meters (m)
Unless Otherwise Noted.

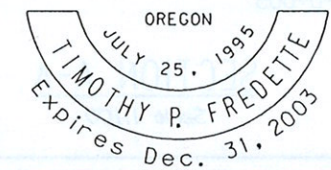



OREGON DEPARTMENT OF TRANSPORTATION
GEO / HYDRO SECTION

US30: LOWER COLUMBIA RIVER HWY. AT
SCAPPOOSE-VERNONIA RD. (SCAPPOOSE) SEC.
LOWER COLUMBIA RIVER HIGHWAY
COLUMBIA COUNTY


Project Leader - Bret N. Richards
Designed By - Timothy P. Fredette
Drafted By - Martin G. Casillas

WATER QUALITY PLAN
SHEET NO. GHJ-1

THIS IS THE FILE NAME LOCATION projects\Scappoose\As Constructed\ 10733wq.p11

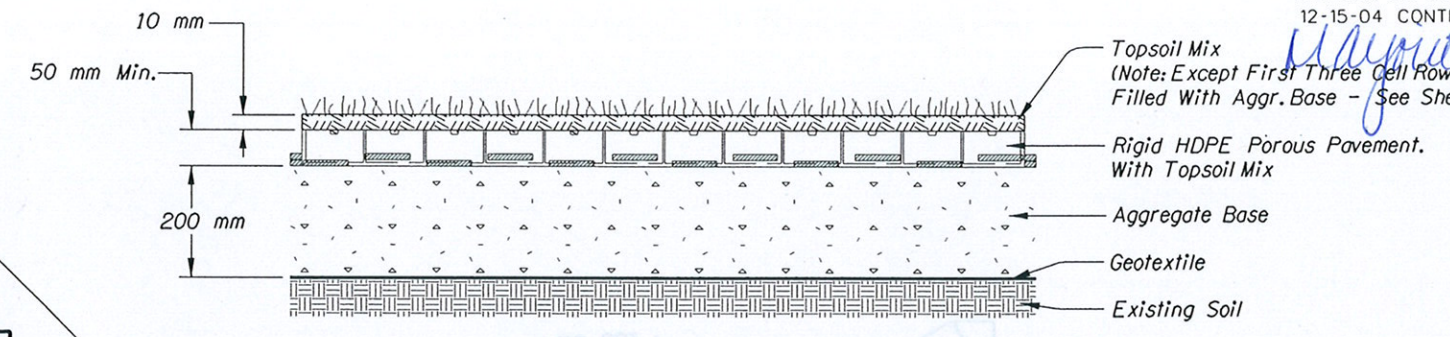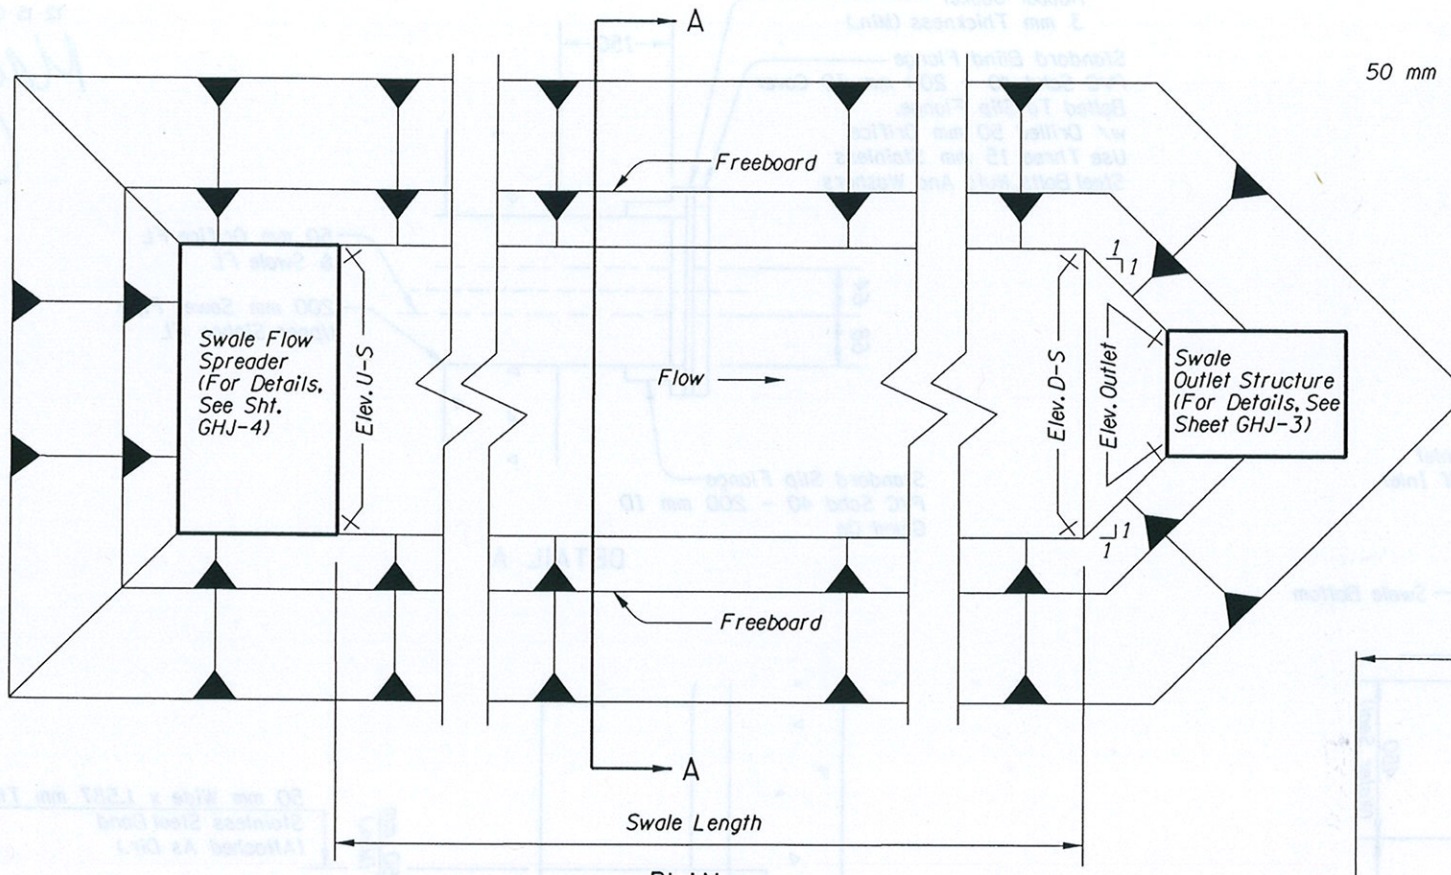

RIGID HDPE POROUS PAVEMENT

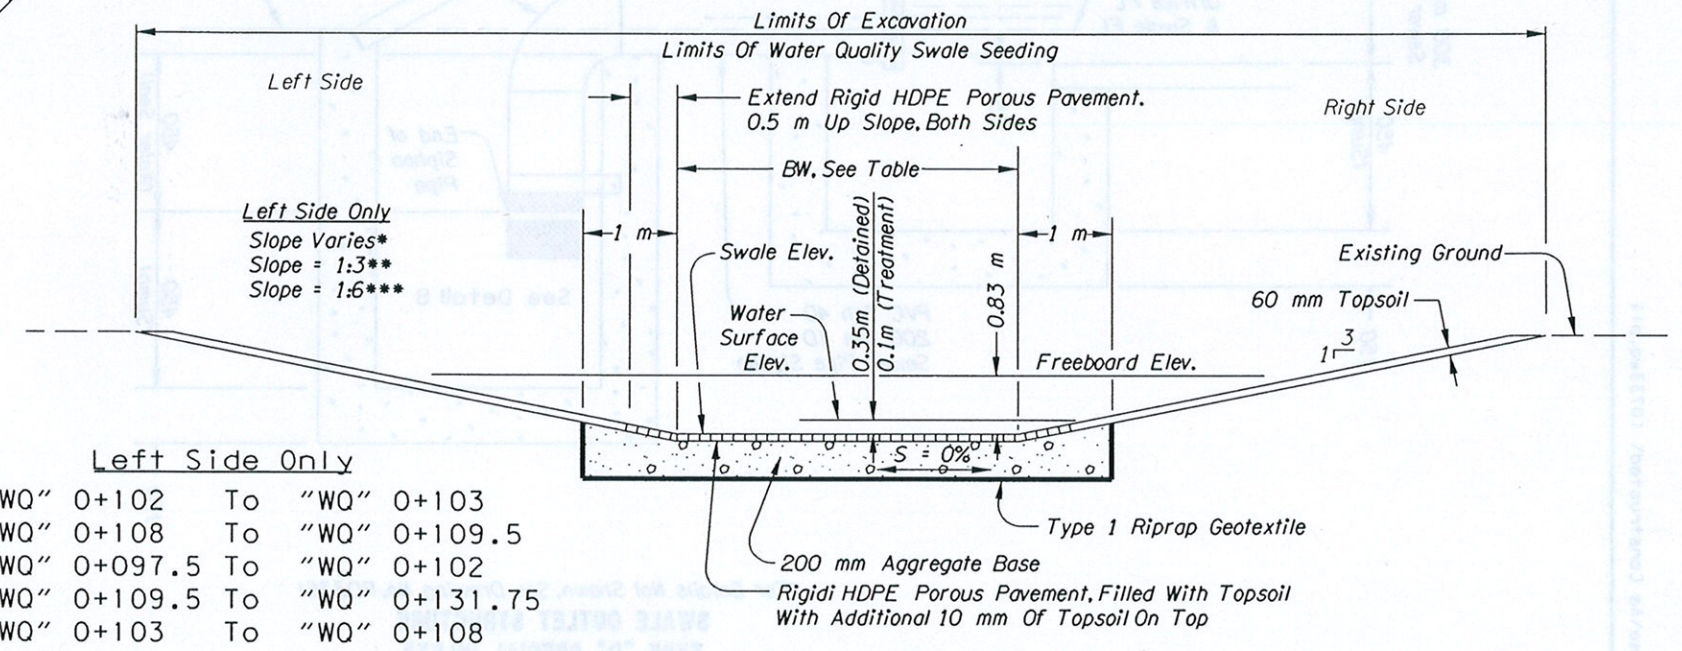


- Left Side Only
- * "WQ" 0+102 To "WQ" 0+103
 - ** "WQ" 0+108 To "WQ" 0+109.5
 - ** "WQ" 0+097.5 To "WQ" 0+102
 - ** "WQ" 0+109.5 To "WQ" 0+131.75
 - *** "WQ" 0+103 To "WQ" 0+108

Swale ID	Length	BW	Elev. U-S	Elev. D-S	Elev. Outlet	Side Slopes	
						Left Side	Right Side
A	25 m	2.4 m	13.200 m	13.075 m	12.975 m	1:3 to 1:6	1:3

- Notes:
- 1) Aggregate Base: 19.0 mm - 0
 - 2) Bottom Of Aggregate Is Level And Extends To 0.5 m Beyond Ends Of Rigid HDPE Porous Pavement.
 - 3) Swale Elevation Shown On Profile Is At Top Of Topsoil Above Rigid HDPE Porous Pavement.
 - 4) If Rock Is Encountered, Maintain Slopes And Soil Structure Up To Freeboard Elevation As Shown. Above Freeboard, Slopes May Assume Stable Slope For Rock Formation.

SECTION A-A

All Dimensions Are In Millimeters (mm) Unless Otherwise Noted.

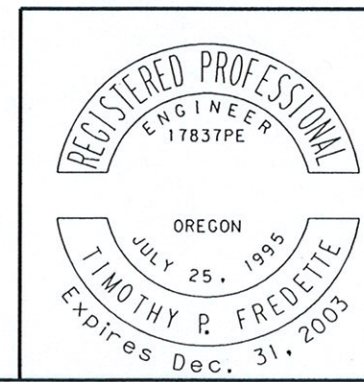

OREGON DEPARTMENT OF TRANSPORTATION
GEO/HYDRO SECTION

US30: LOWER COLUMBIA RIVER HWY. AT SCAPPOOSE-VERNONIA RD. (SCAPPOOSE) SEC. LOWER COLUMBIA RIVER HIGHWAY
COLUMBIA COUNTY


Project Leader - Bret N. Richards
Designed By - Timothy P. Fredette
Drafted By - Martin G. Casillas

WATER QUALITY DETAILS

SHEET NO. GHJ-2


THIS IS THE FILE NAME LOCATION projects\Scappoose\As Constructed\ 10733wq.p11

Majors West

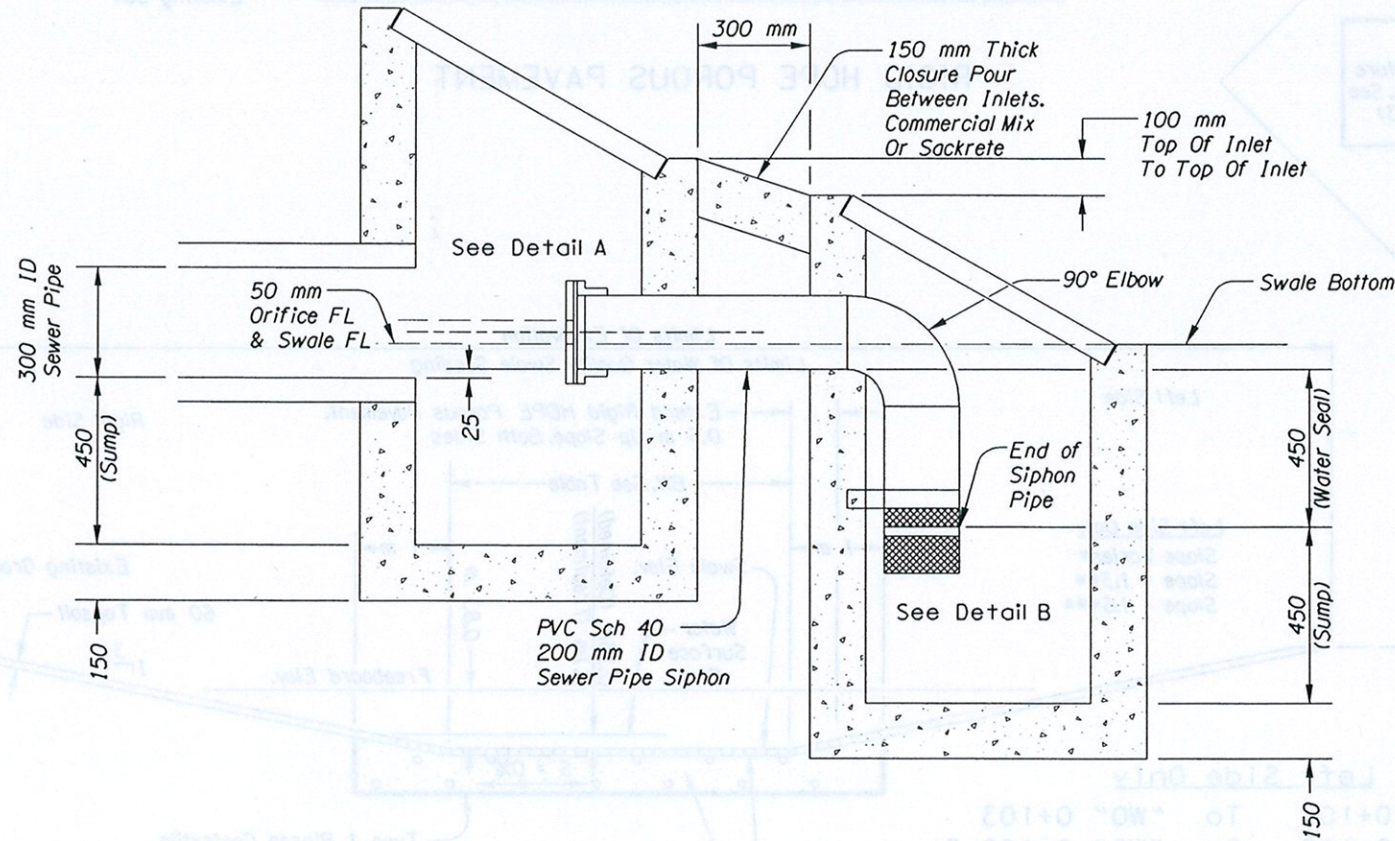


(For Details Not Shown, See Drawing No. RD336)

**SWALE OUTLET STRUCTURE
TYPE "D" SPECIAL INLETS**

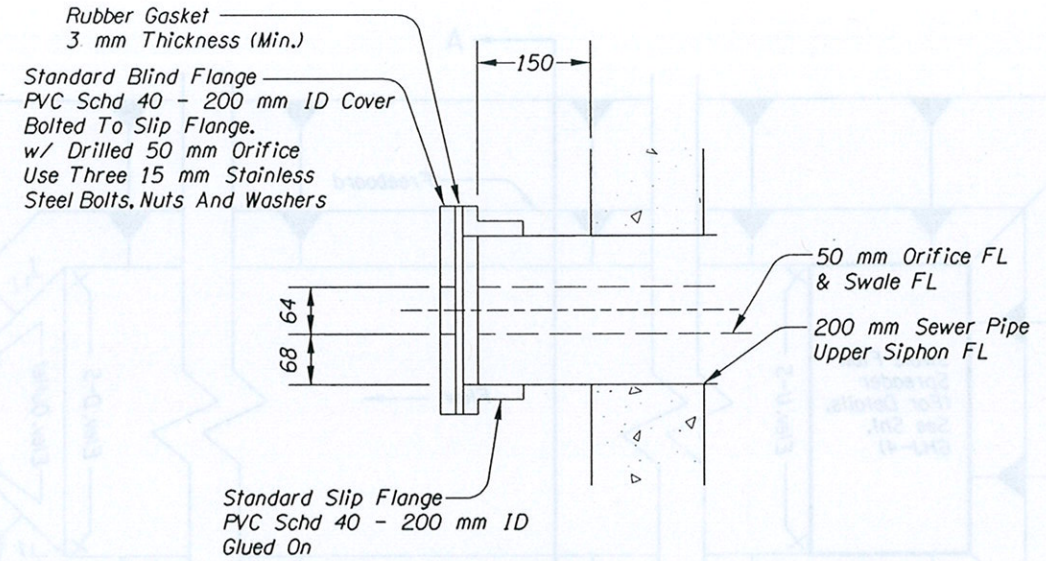

DETAIL A

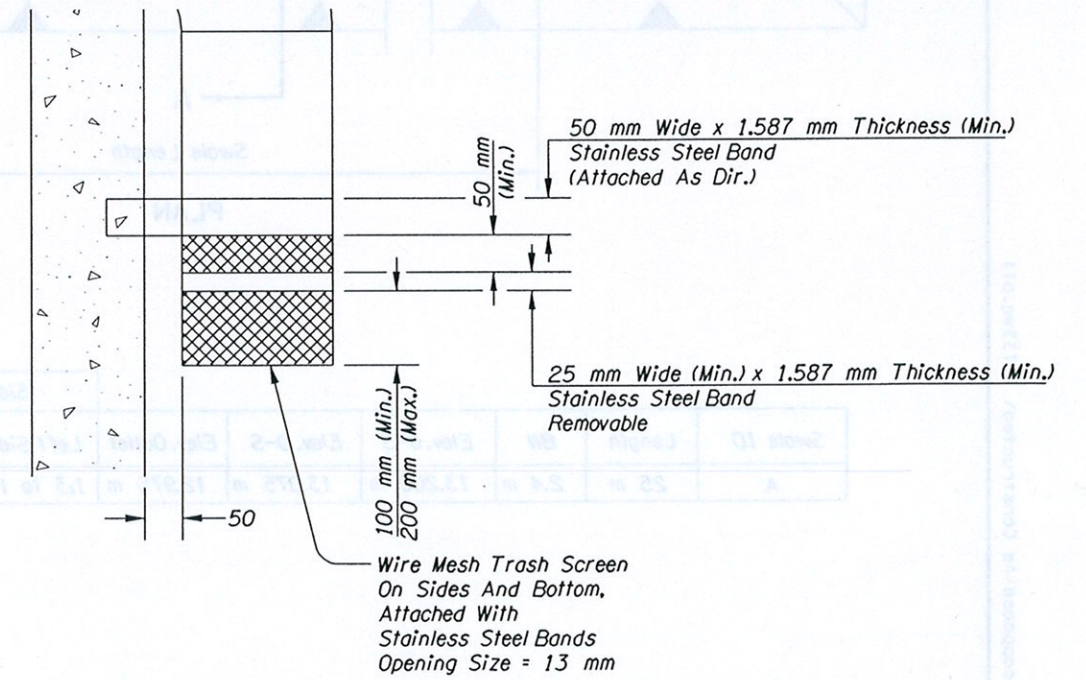

DETAIL B

All Dimensions Are In Millimeters (mm)
Unless Otherwise Noted.

THIS IS THE FILE NAME LOCATION projects\Scappoose\As Constructed\ 10733wq.p11

12/15/04

	OREGON DEPARTMENT OF TRANSPORTATION GEO / HYDRO SECTION
	US30: LOWER COLUMBIA RIVER HWY. AT SCAPPOOSE-VERNONIA RD. (SCAPPOOSE) SEC. LOWER COLUMBIA RIVER HIGHWAY COLUMBIA COUNTY
Project Leader - Bret N. Richards Designed By - Timothy P. Fredette Drafted By - Martin G. Casillas	WATER QUALITY DETAILS
	SHEET NO. GHJ-3

Mayouck




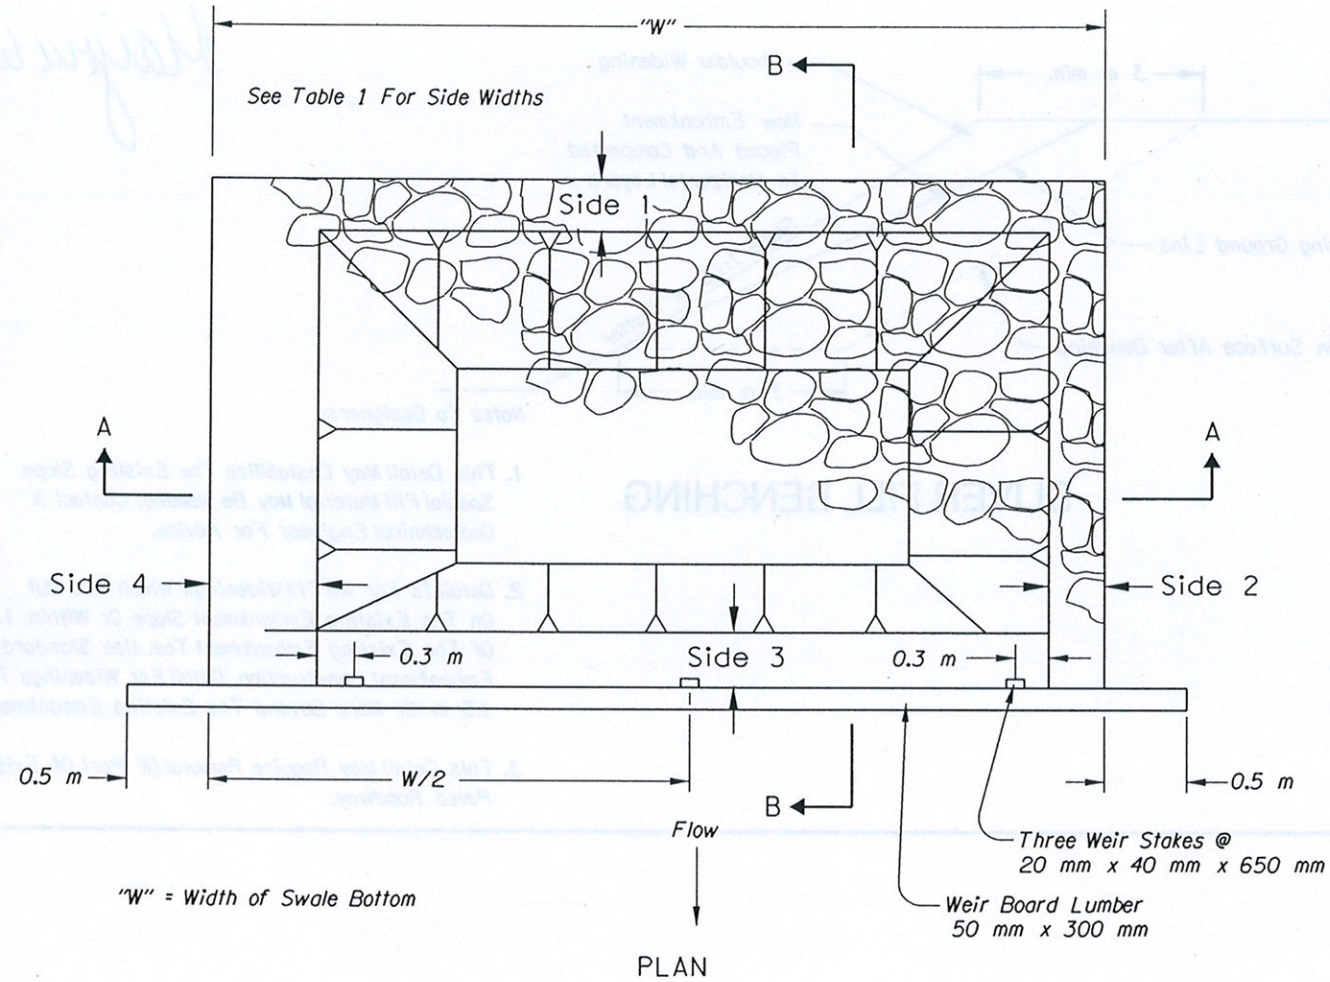



Table 1

Swale	Side Widths (mm)				Pipe Outfall Side	"W"	Top of Weir Board Elev.
	1	2	3	4			
A	150	150	150	300	#4	2.4 m	13.26 m

SWALE FLOW SPREADER

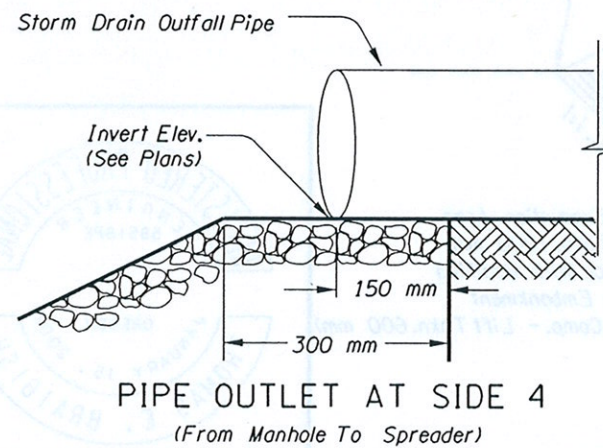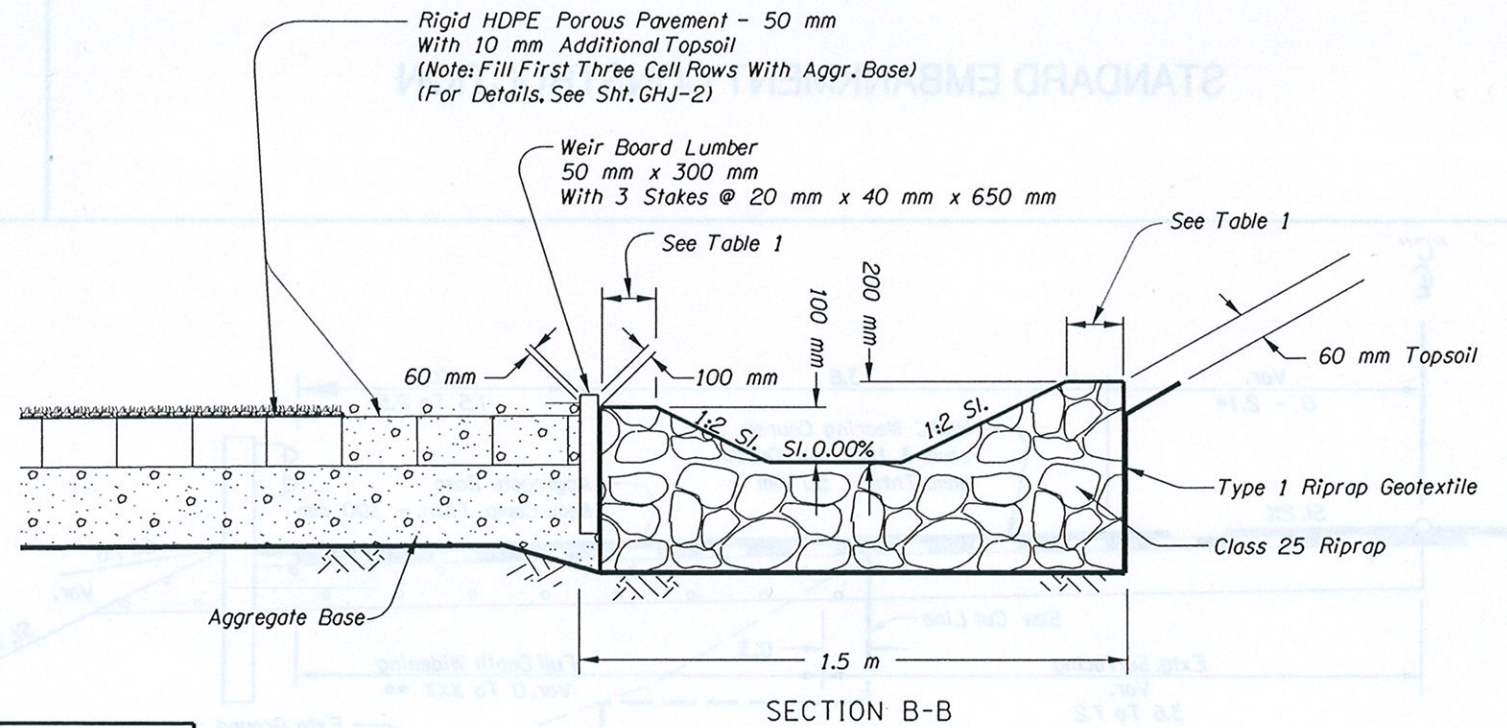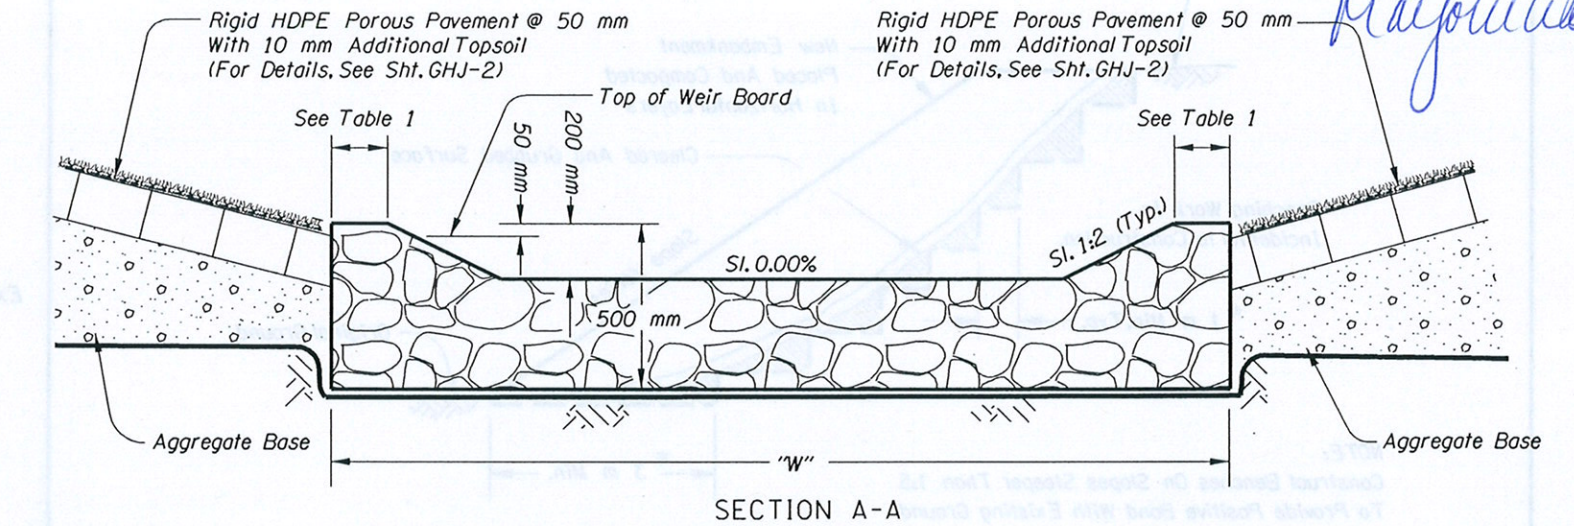

All Dimensions Are In Millimeters (mm) Unless Otherwise Noted.

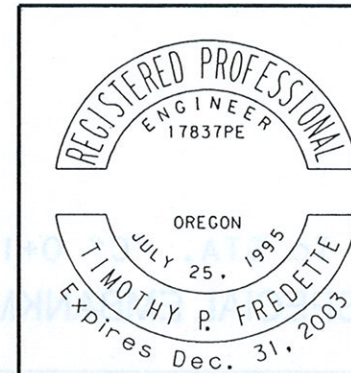

OREGON DEPARTMENT OF TRANSPORTATION
GEO / HYDRO SECTION

US30: LOWER COLUMBIA RIVER HWY. AT SCAPPOOSE-VERNONIA RD. (SCAPPOOSE) SEC. LOWER COLUMBIA RIVER HIGHWAY COLUMBIA COUNTY

Project Leader - Bref N. Richards
Designed By - Timothy P. Fredette
Drafted By - Martin G. Casillas

WATER QUALITY DETAILS

SHEET NO. GHJ-4