

OPERATION & MAINTENANCE MANUAL

DFI No. : D00172

Facility Type: Detention Tank/Pipe



JUNE, 2011

INDEX

1. IDENTIFICATION 3

2. FACILITY CONTACT INFORMATION 3

3. CONSTRUCTION..... 3

4. STORM DRAIN SYSTEM AND FACILITY OVERVIEW 4

5. FACILITY HAZ MAT SPILL FEATURE(S)..... 6

6. AUXILIARY OUTLET (HIGH FLOW BYPASS)..... 6

7. MAINTENANCE REQUIREMENTS..... 7

8. WASTE MATERIAL HANDLING..... 7

APPENDIX A: Operational Plan and Profile Drawing(s)

APPENDIX B: ODOT Project Plan Sheets

1. Identification

Drainage Facility ID (DFI): **D00172**
Facility Type: Detention Tank/Pipe
Construction Drawings: (V-File Number) 39V-058
Location: District: 2B (Old 2A)
Highway No.: 064
Mile Post: 1.90; 1.92 (beg./end)
Description: This facility is located on the right shoulder of southbound I-205 (Hwy 064) west of Prosperity Park Road. Access to the facility can be obtained from the southbound travel lanes.

2. Facility Contact Information

Contact the Engineer of Record, Region Technical Center, or Geo-Environmental's Senior Hydraulics Engineer for:

- Operational clarification
- Maintenance clarification
- Repair or restoration assistance

Engineering Contacts:

Region Technical Center Hydro Unit Manager

Or

Geo-Environmental Senior Hydraulics Engineer (503) 986-3365.

3. Construction

Engineer of Record: Consultant Designer – OBEC, Jerome Lane, P.E.
(503) 589-4100

Facility construction: 2006
Contractor: Oregon Mainline Paving, LLC Construction
Company

4. Storm Drain System and Facility Overview

A detention facility is designed to control the quantity of runoff, by reducing the peak discharge and only detaining runoff for some short period of time. These facilities are designed to store and gradually release or attenuate stormwater runoff via a control structure or release mechanism, and completely drain after the design storm has passed. The most common detention facilities include:

- Dry ponds - these are depressed storage areas that store runoff during wet weather and are dry the rest of the time. Usually they are earthen depressions.
- Tanks - these are underground storage facilities that are typically constructed from large diameter pipe.
- Vaults - these are enclosed underground storage facilities. They are typically constructed from reinforced concrete.

This detention tank is located just west of Prosperity Park Road. The facility treats sheet flow storm water runoff from both the north and southbound travel lanes of I-205 (Hwy 064).

Runoff from northbound I-205 and an adjacent grass median are directed to the detention system after receiving initial treatment by flowing through a water quality manhole (D00147). Southbound I-205 runoff is conveyed into the detention tank/pipe by way of a ditch inlet. Runoff from each of these sources is all tied together by the manhole, the inlet, and an 18-inch diameter pipe before flowing into the remaining system. The facility, itself, consists of three 100-foot long, 72-inch diameter detention pipes, used to detain the stormwater runoff (see point D in Operational Plan, Appendix A). After detainment, the water quality flows are discharged through the outlet vault for flow control, and out of the facility through a 24-inch pipe (see point G in Operational Plan).

The inlet vault (point E Operational Plans, Appendix A) serves the facility as an access point for maintenance

A. Maintenance equipment access:

Access to the facility is attainable along the right shoulder of the southbound I-205 travel lane. The facility is equipped with an inlet vault (point E Operational Plans, Appendix A), which serves as a direct access point into the facility for maintenance (see point E in Operational Plans, Appendix A).

B. Heavy equipment access into facility:

- Allowed (no limitations)
- Allowed (with limitations)

Not allowed

C. Special Features:

Amended Soils

Porous Pavers

Liners

Underdrains



Photo 1: Detention Tank/Pipe along I-205 (Hwy 064) Southbound.



Photo 2: Water quality manhole (D00147), located south of the detention facility.

5. Facility Haz Mat Spill Feature(s)

The detention tank/pipe can be used to store a volume of liquid by blocking the 24-inch diameter outlet pipe located inside of the outlet vault of the detention tank/pipe system. This pipe is noted as point G in Operational Plans, Appendix A.

6. Auxiliary Outlet (High Flow Bypass)

Auxiliary Outlets are provided if the primary outlet control structure can not safely pass the projected high flows. Broad-crested spillway weirs and over flow risers are the two most common auxiliary outlets used in stormwater facility design. The auxiliary outlet feature is either a part of the facility or an additional storm drain feature/structure.

The auxiliary outlet feature for this facility is:

Designed into facility

Other, as noted below

No auxiliary outlet facility exists in this system.

7. Maintenance Requirements

Routine maintenance table for non-proprietary stormwater treatment and storage/detention facilities have been incorporated into ODOT's Maintenance Guide. These tables summarize the maintenance requirements for ponds, swales, filter strips, bioslopes, and detention tanks and vaults. Special maintenance requirements in addition to the routine requirements are noted below when applicable.

The ODOT Maintenance Guide can be viewed at the following website:

<http://www.oregon.gov/ODOT/HWY/OOM/MGuide.shtml>

Maintenance requirements for proprietary structures, such as underground water quality manholes and/or vaults with filter media are noted in Appendix C when applicable.

The following stormwater facility maintenance table (See ODOT Maintenance Guide) should be used to maintain the facility outlined in this Operation and Maintenance Manual or follow the Maintenance requirements outlined in Appendix C when proprietary structure is selected below:

- Table 1 (general maintenance)
- Table 2 (stormwater ponds)
- Table 3 (water quality biofiltration swales)
- Table 4 (water quality filter strips)
- Table 5 (water quality bioslopes)
- Table 6 (detention tank)
- Table 7 (detention vault)
- Appendix C (proprietary structure)
- Special Maintenance requirements:

Note: Special maintenance Requirements Require Concurrence from ODOT SR Hydraulics Engineer.

8. Waste Material Handling

Material removed from the facility is defined as waste by DEQ. Refer to the roadwaste section of the ODOT Maintenance Yard Environmental Management System (EMS) Policy and Procedures Manual for disposal options: <http://egov.oregon.gov/ODOT/HWY/OOM/EMS.shtml>

Contact any of the following for more detailed information about management of waste materials found on site:

ODOT Clean Water Unit


(503) 986-3008

ODOT Statewide Hazmat Coordinator (503) 229-5129
ODOT Region Hazmat Coordinator (503) 731-8304
ODEQ Northwest Region Office (503) 229-5263


Appendix A

Content:


- **Operational Plan and Profile Drawing(s)**

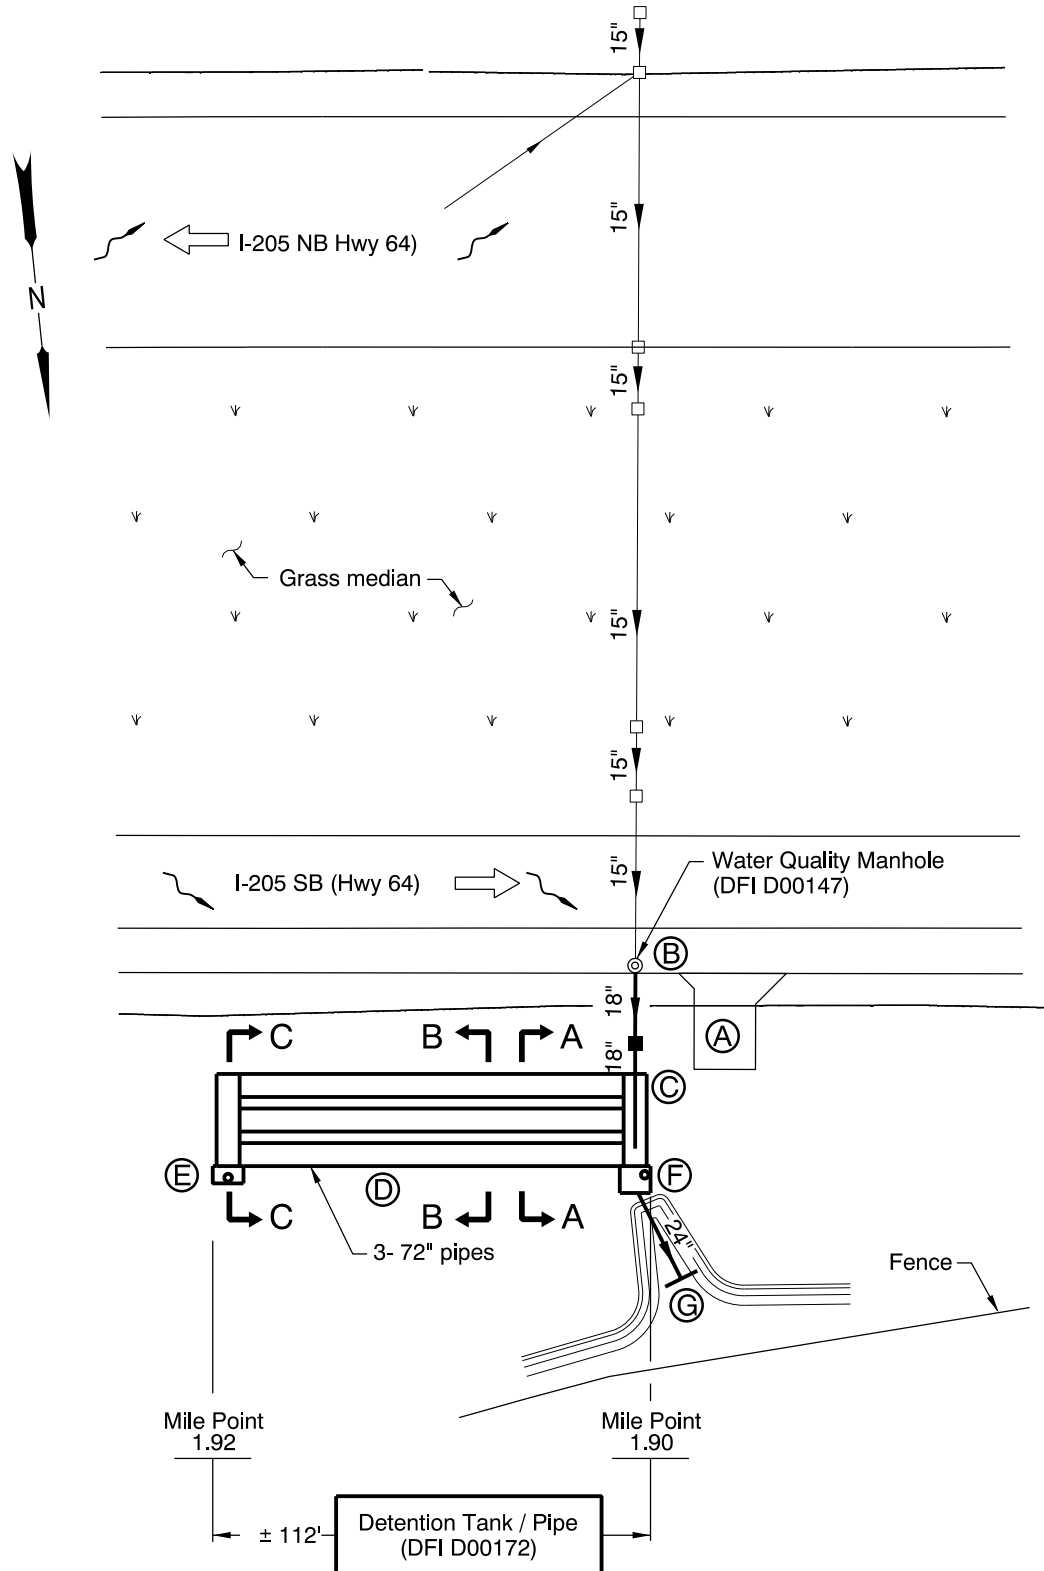


PLAN
N.T.S.

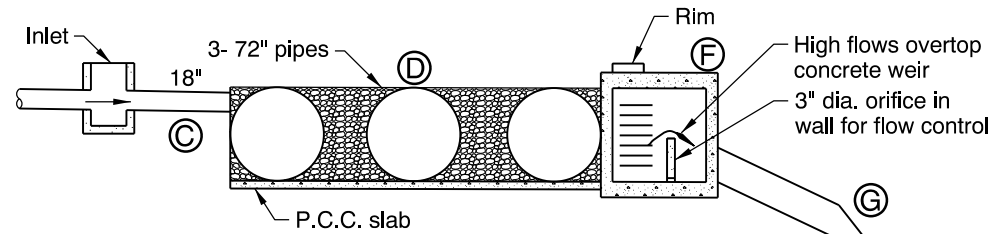


SECTION A-A
N.T.S.

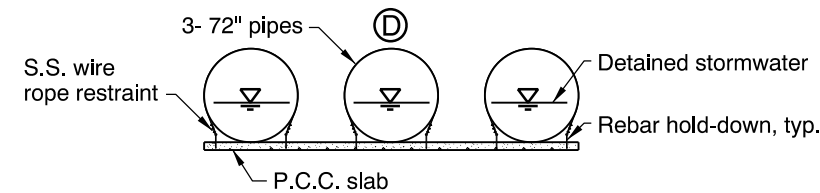

SECTION B-B
N.T.S.

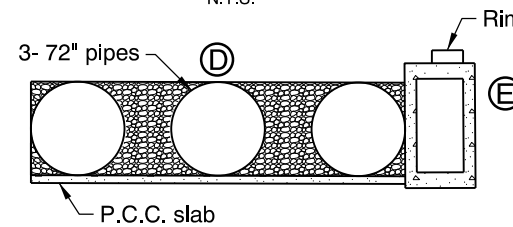

SECTION C-C
N.T.S.

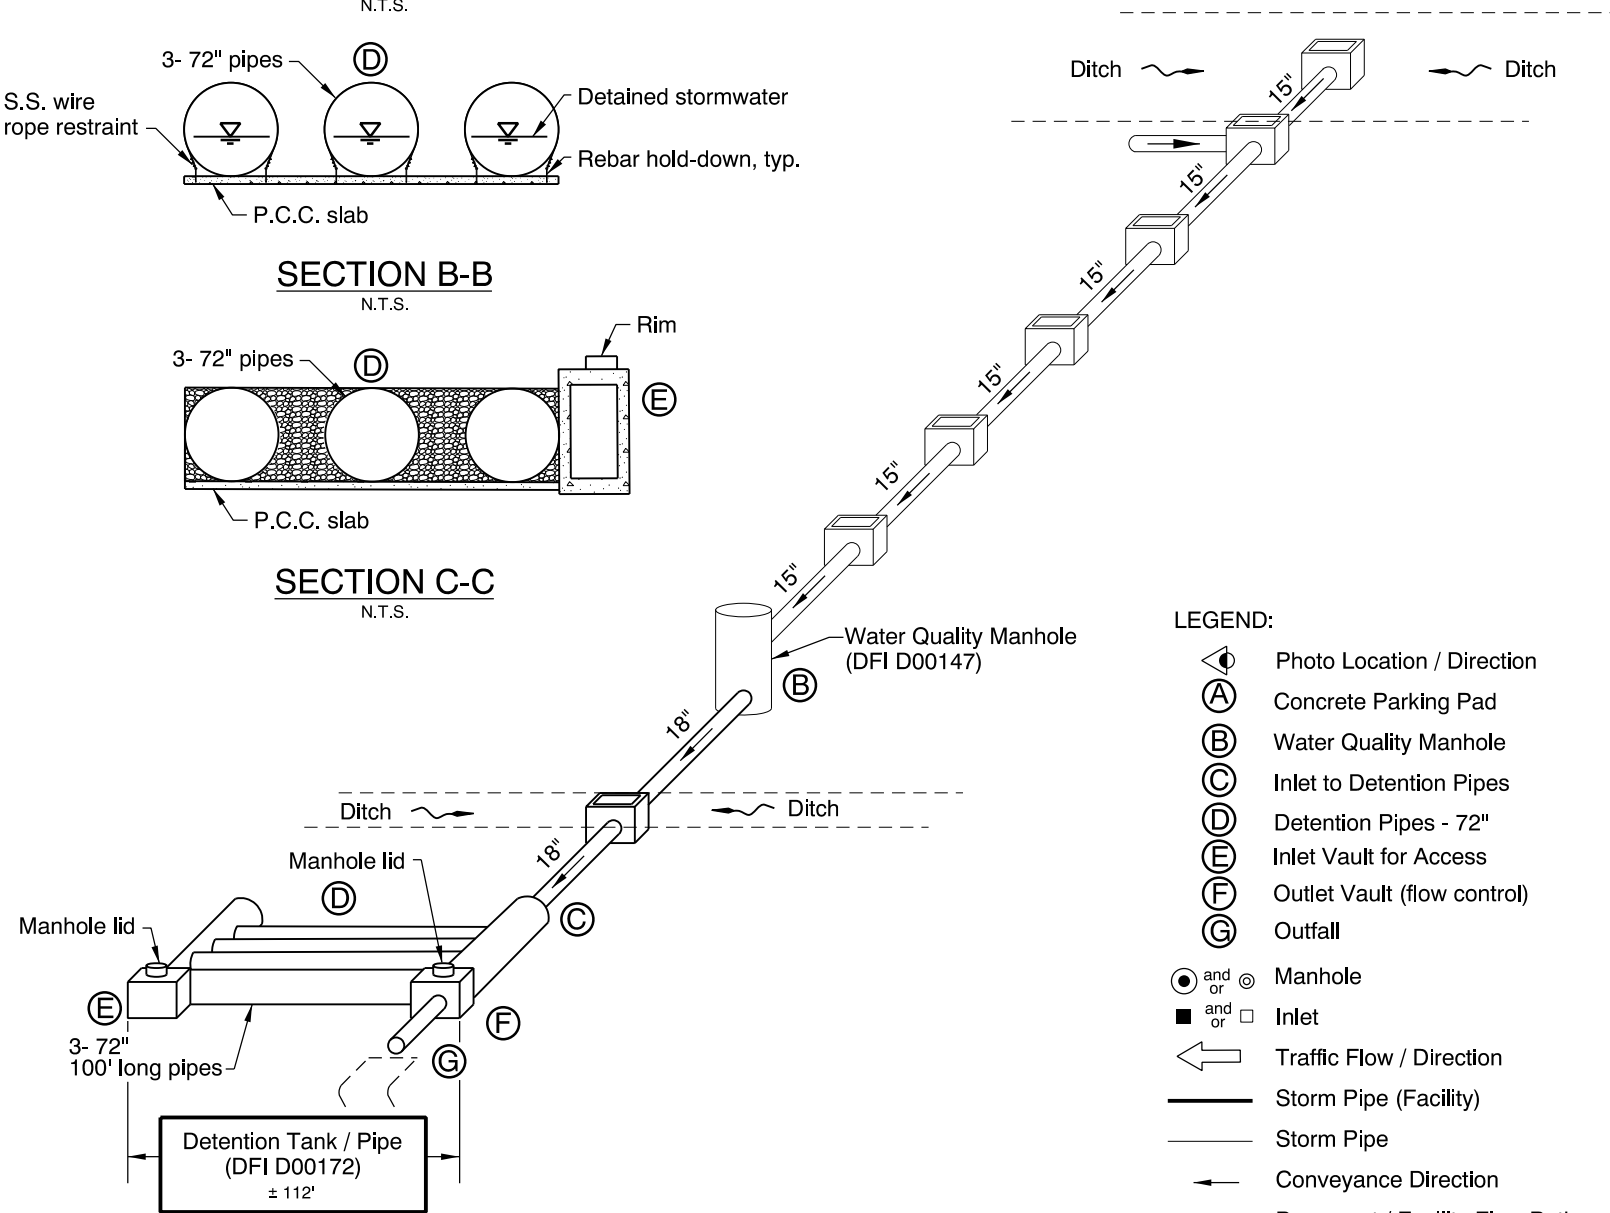

SCHEMATIC OF PIPE DRAINAGE SYSTEM
N.T.S.

- LEGEND:**
- ⊙ or ⊗ Photo Location / Direction
 - Ⓐ Concrete Parking Pad
 - Ⓑ Water Quality Manhole
 - Ⓒ Inlet to Detention Pipes
 - Ⓓ Detention Pipes - 72"
 - Ⓔ Inlet Vault for Access
 - Ⓕ Outlet Vault (flow control)
 - Ⓖ Outfall
 - ⊙ or ⊗ Manhole
 - or □ Inlet
 - ← Traffic Flow / Direction
 - Storm Pipe (Facility)
 - Storm Pipe
 - Conveyance Direction
 - ~ Pavement / Facility Flow Path
 - ⊠ Inlet (Schematic View)

Sht. 1 of 1

OREGON DEPARTMENT OF TRANSPORTATION

Prepared By: Wynee Hu

Drafted By: Rodney Schultz

DFI D00172
MAINTENANCE DISTRICT 2B HWY 64
DETENTION TANK/PIPE
EAST PORTLAND FREEWAY MP 1.90-1.92
CLACKMAS COUNTY

Appendix B


Content:

- **ODOT Project Plan Sheets**
 - *Cover/Title Sheet*
 - *Water Quality/Detention Plan Sheets*
 - *Other Details*

INDEX OF SHEETS	
SHEET NO.	DESCRIPTION
1	Title Sheet
1A, 1B	Index Of Sheets Cont'd.
1C	Std. Drg. Nos.

STATE OF OREGON
 DEPARTMENT OF TRANSPORTATION
 PLANS FOR PROPOSED PROJECT
GRADING, DRAINAGE, STRUCTURES, PAVING, SIGNING & ILLUMINATION

**I-205: WILLAMETTE RIVER BR. -
 PACIFIC HWY. (UNIT 3) SEC.
 EAST PORTLAND FREEWAY
 CLACKAMAS & WASHINGTON COUNTIES
 APRIL 2006**

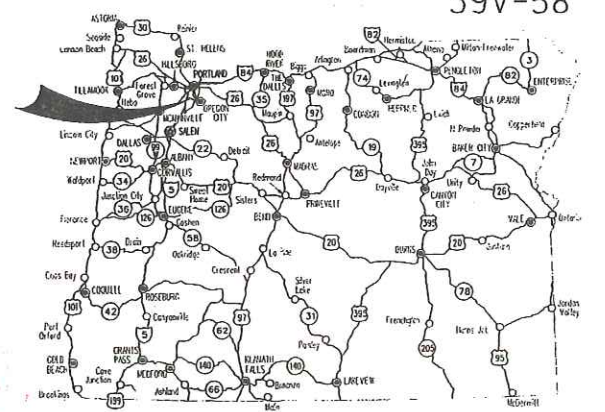


Overall Length Of Project - 8.90 Miles

"AS CONSTRUCTED"
Matthew Nelson
 Date 6/26/09 Project Mgr

ATTENTION:
 Oregon Law Requires You To Follow Rules Adopted By The Oregon Utility Notification Center. Those Rules Are Set Forth In OAR 952-001-0010 Through OAR 952-001-0090. You May Obtain Copies Of The Rules By Calling The Center. (Note: The Telephone Number For The Oregon Utility Center Is (503) 232-1987.)

**END OF PROJECT IM-OTIA-S064(032)
 STA. "LS2" 1231+71.15 (M.P. -0.10)**

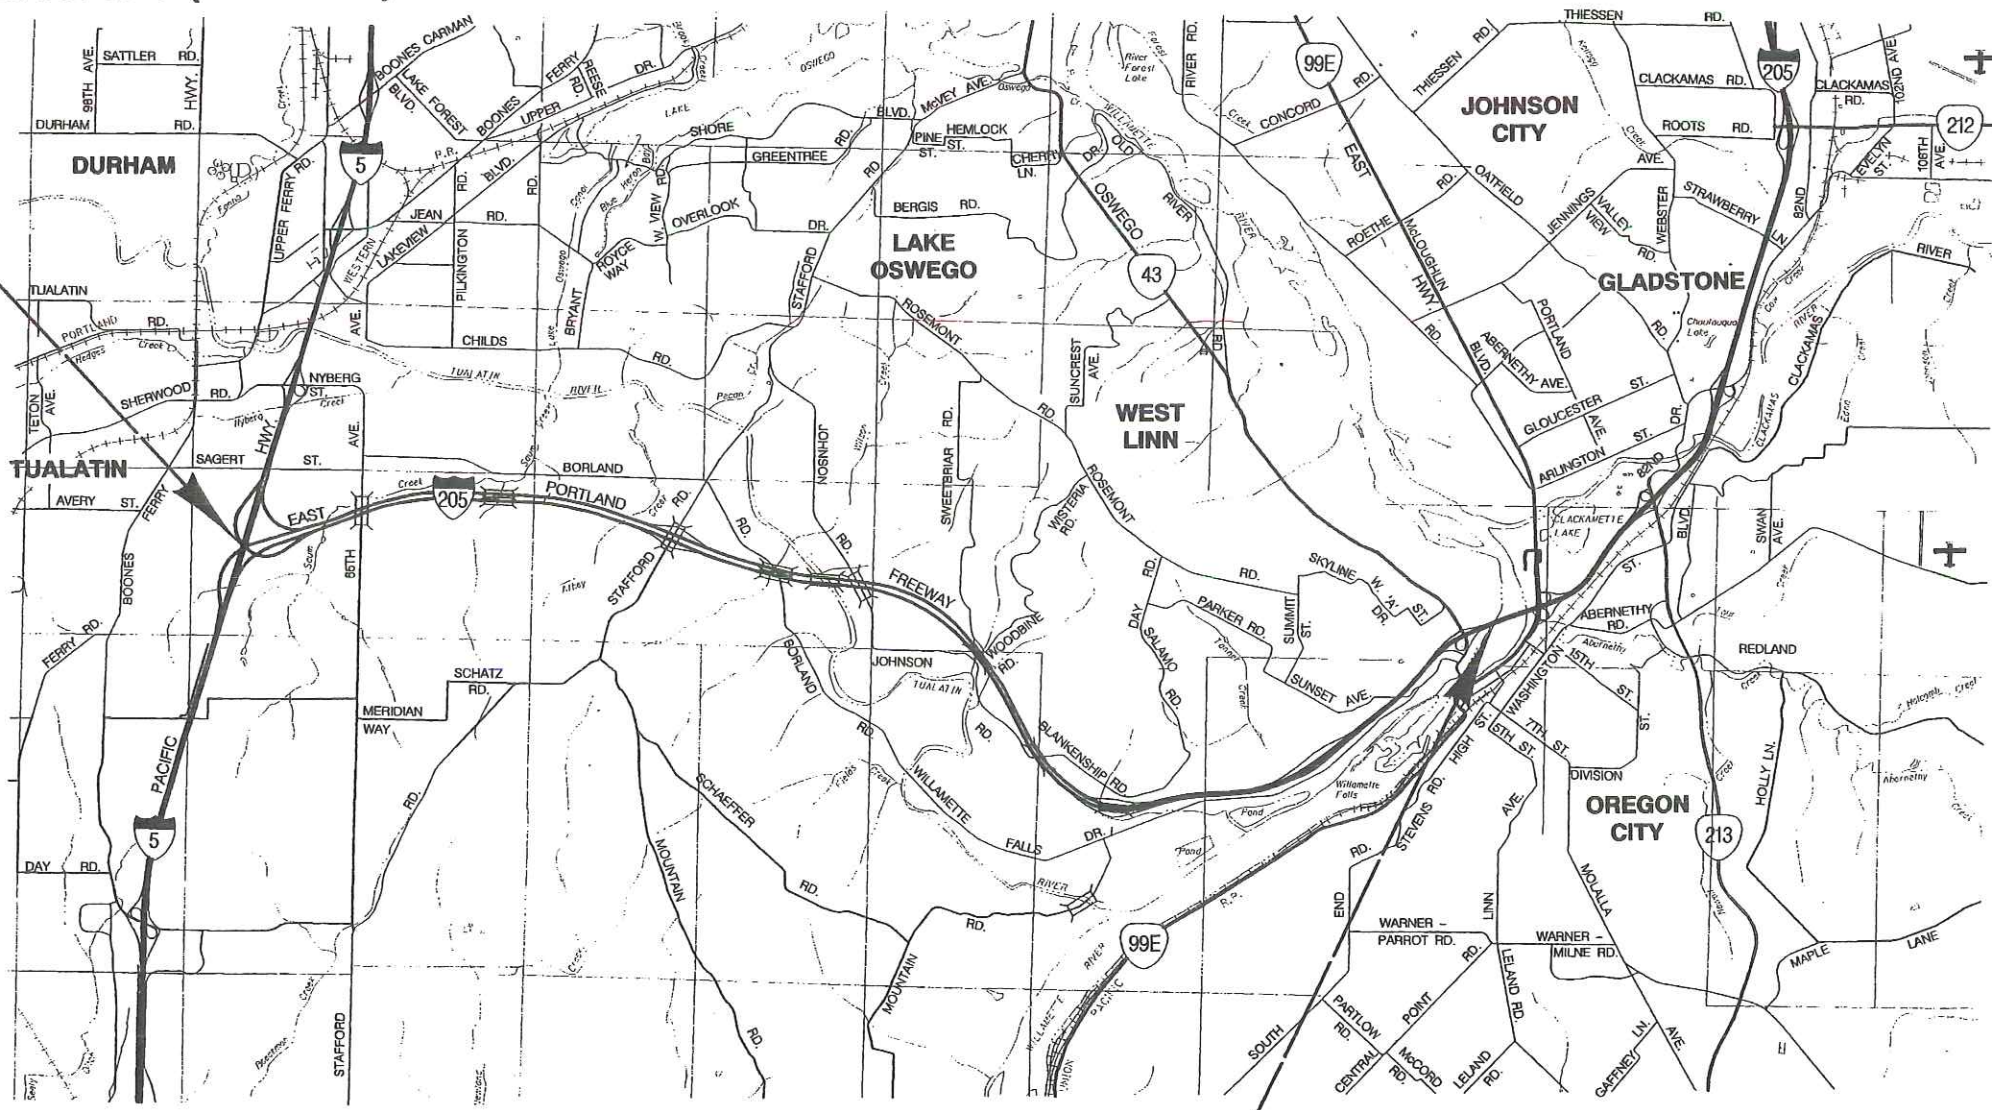

LET'S ALL
 WORK TOGETHER
 TO MAKE THIS
 JOB SAFE

- OREGON TRANSPORTATION COMMISSION**
- | | |
|-------------------|----------------------------|
| Stuart Foster | CHAIRMAN |
| Gail L. Achterman | COMMISSIONER |
| Mike Nelson | COMMISSIONER |
| Randall Papé | COMMISSIONER |
| Janice J. Wilson | COMMISSIONER |
| Matthew Garrett | DIRECTOR OF TRANSPORTATION |



EXPIRES: 12/31/07

LAWRENCE H. FOX
 OBEC CONSULTING ENGINEERS - PROJECT MANAGER

OREGON DEPARTMENT OF TRANSPORTATION
 CONCURRENCE
Harold E. Sealey 2/23/06
 TECHNICAL SERVICES MANAGING ENGINEER DATE


**I-205: WILLAMETTE RIVER BR. -
 PACIFIC HWY. (UNIT 3) SEC.
 EAST PORTLAND FREEWAY
 CLACKAMAS & WASHINGTON COUNTIES**

FEDERAL HIGHWAY ADMINISTRATION	PROJECT NUMBER	SHEET NO.
OREGON DIVISION	IM-OTIA-S064(032)	1




T. 2 S., R. 1 W.,
 R. 1 E. & R. 2 E., W.M.


**BEGINNING OF PROJECT IM-OTIA-S064(032)
 STA. "L" 735+41.85 (M.P. 8.80)**

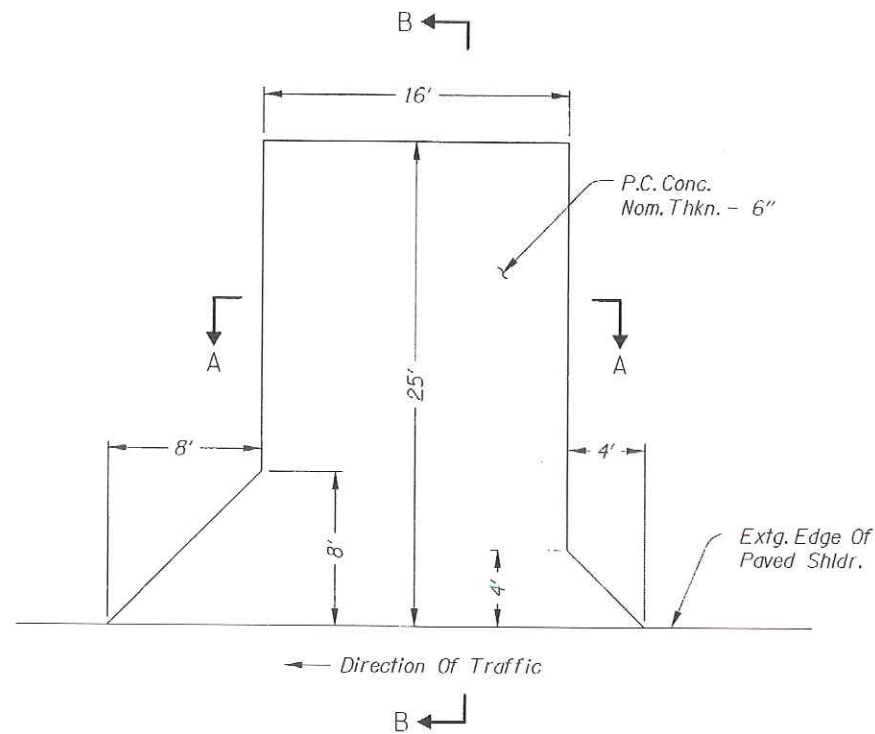


CONCRETE PARKING PAD
(For Details Not Shown, See Drg. No. RD715)

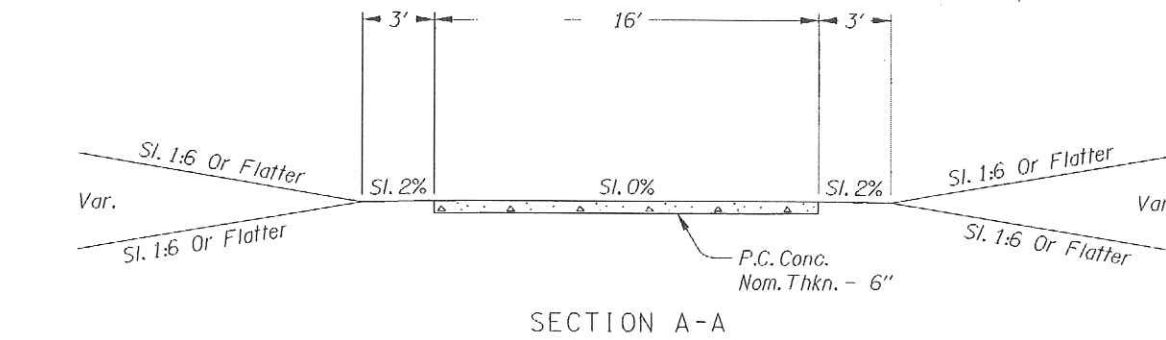


SECTION A-A

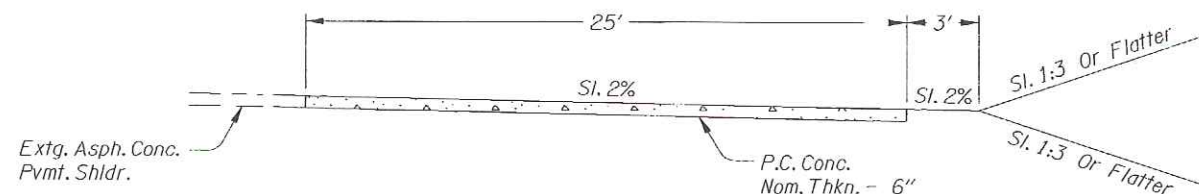

SECTION B-B

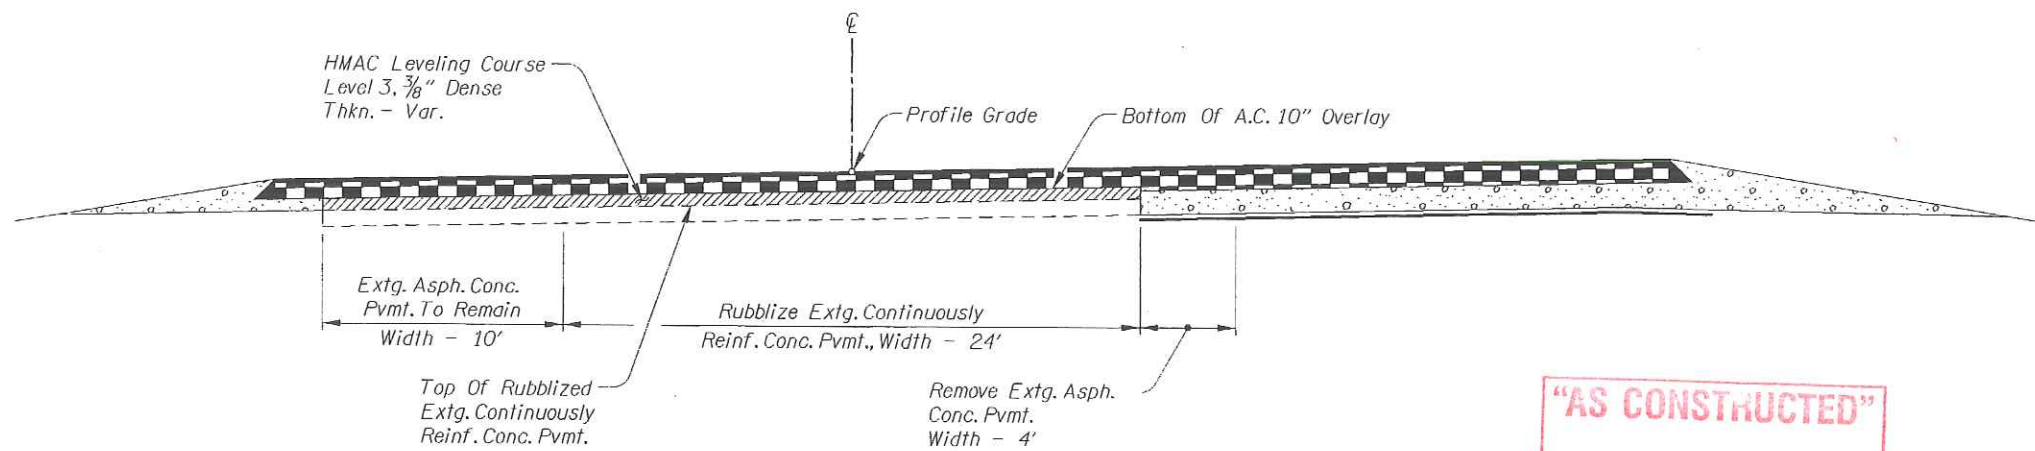

A.C. LEVELING DETAIL

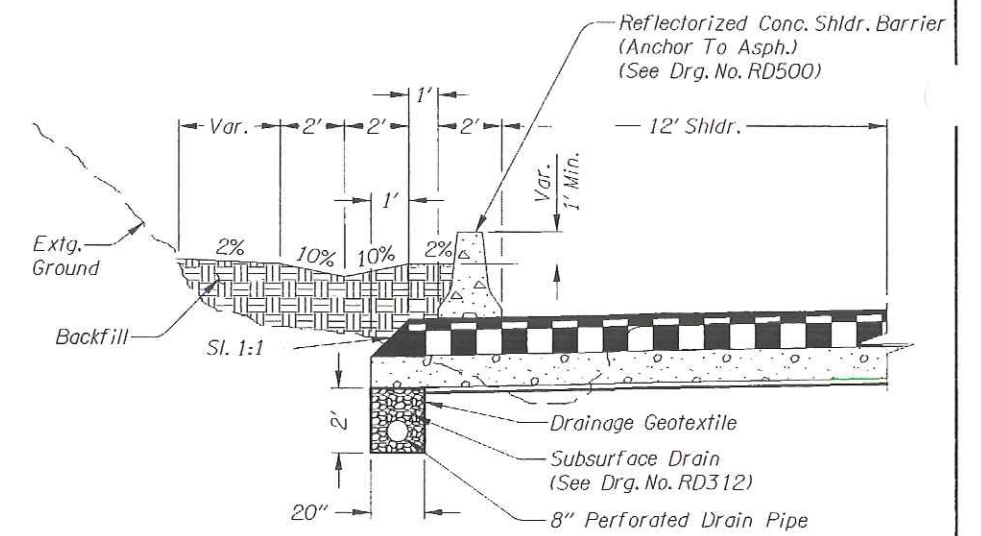

CONCRETE BARRIER RAIL DETAIL
(Sta. "LN2" 1159+50 To Sta. "LN2" 1163+00)

"AS CONSTRUCTED"
Math Bunde
Date 6/26/09 Project Mngr

NOTE:
See Typical Sections For
Surfacing Details.

REGISTERED PROFESSIONAL
ENGINEER
12295
Jerome D. Lane
OREGON
JULY 5, 1983
JEROME D. LANE
EXPIRES: 12/31/09

OREGON DEPARTMENT OF TRANSPORTATION
ROADWAY ENGINEERING SECTION


I-205: WILLAMETTE RIVER BR. -
PACIFIC HWY. (UNIT 3) SEC.
EAST PORTLAND FREEWAY
CLACKAMAS & WASHINGTON COUNTIES

Design Team Leader - Jerry Lane
Designed By - Tom Metcalf
Drafted By - Mathew Bunde

DETAILS

SHEET
NO.
2B-13

OBEC CONSULTING ENGINEERS
Corporate Office: 920 COUNTRY CLUB ROAD, SUITE 1000 EUGENE, OREGON 97401-6029
2205 MISSION STREET SE, SUITE 100 SALEM, OREGON 97302-1265
1335 POPLAR DRIVE MEDFORD, OREGON 97504-5207

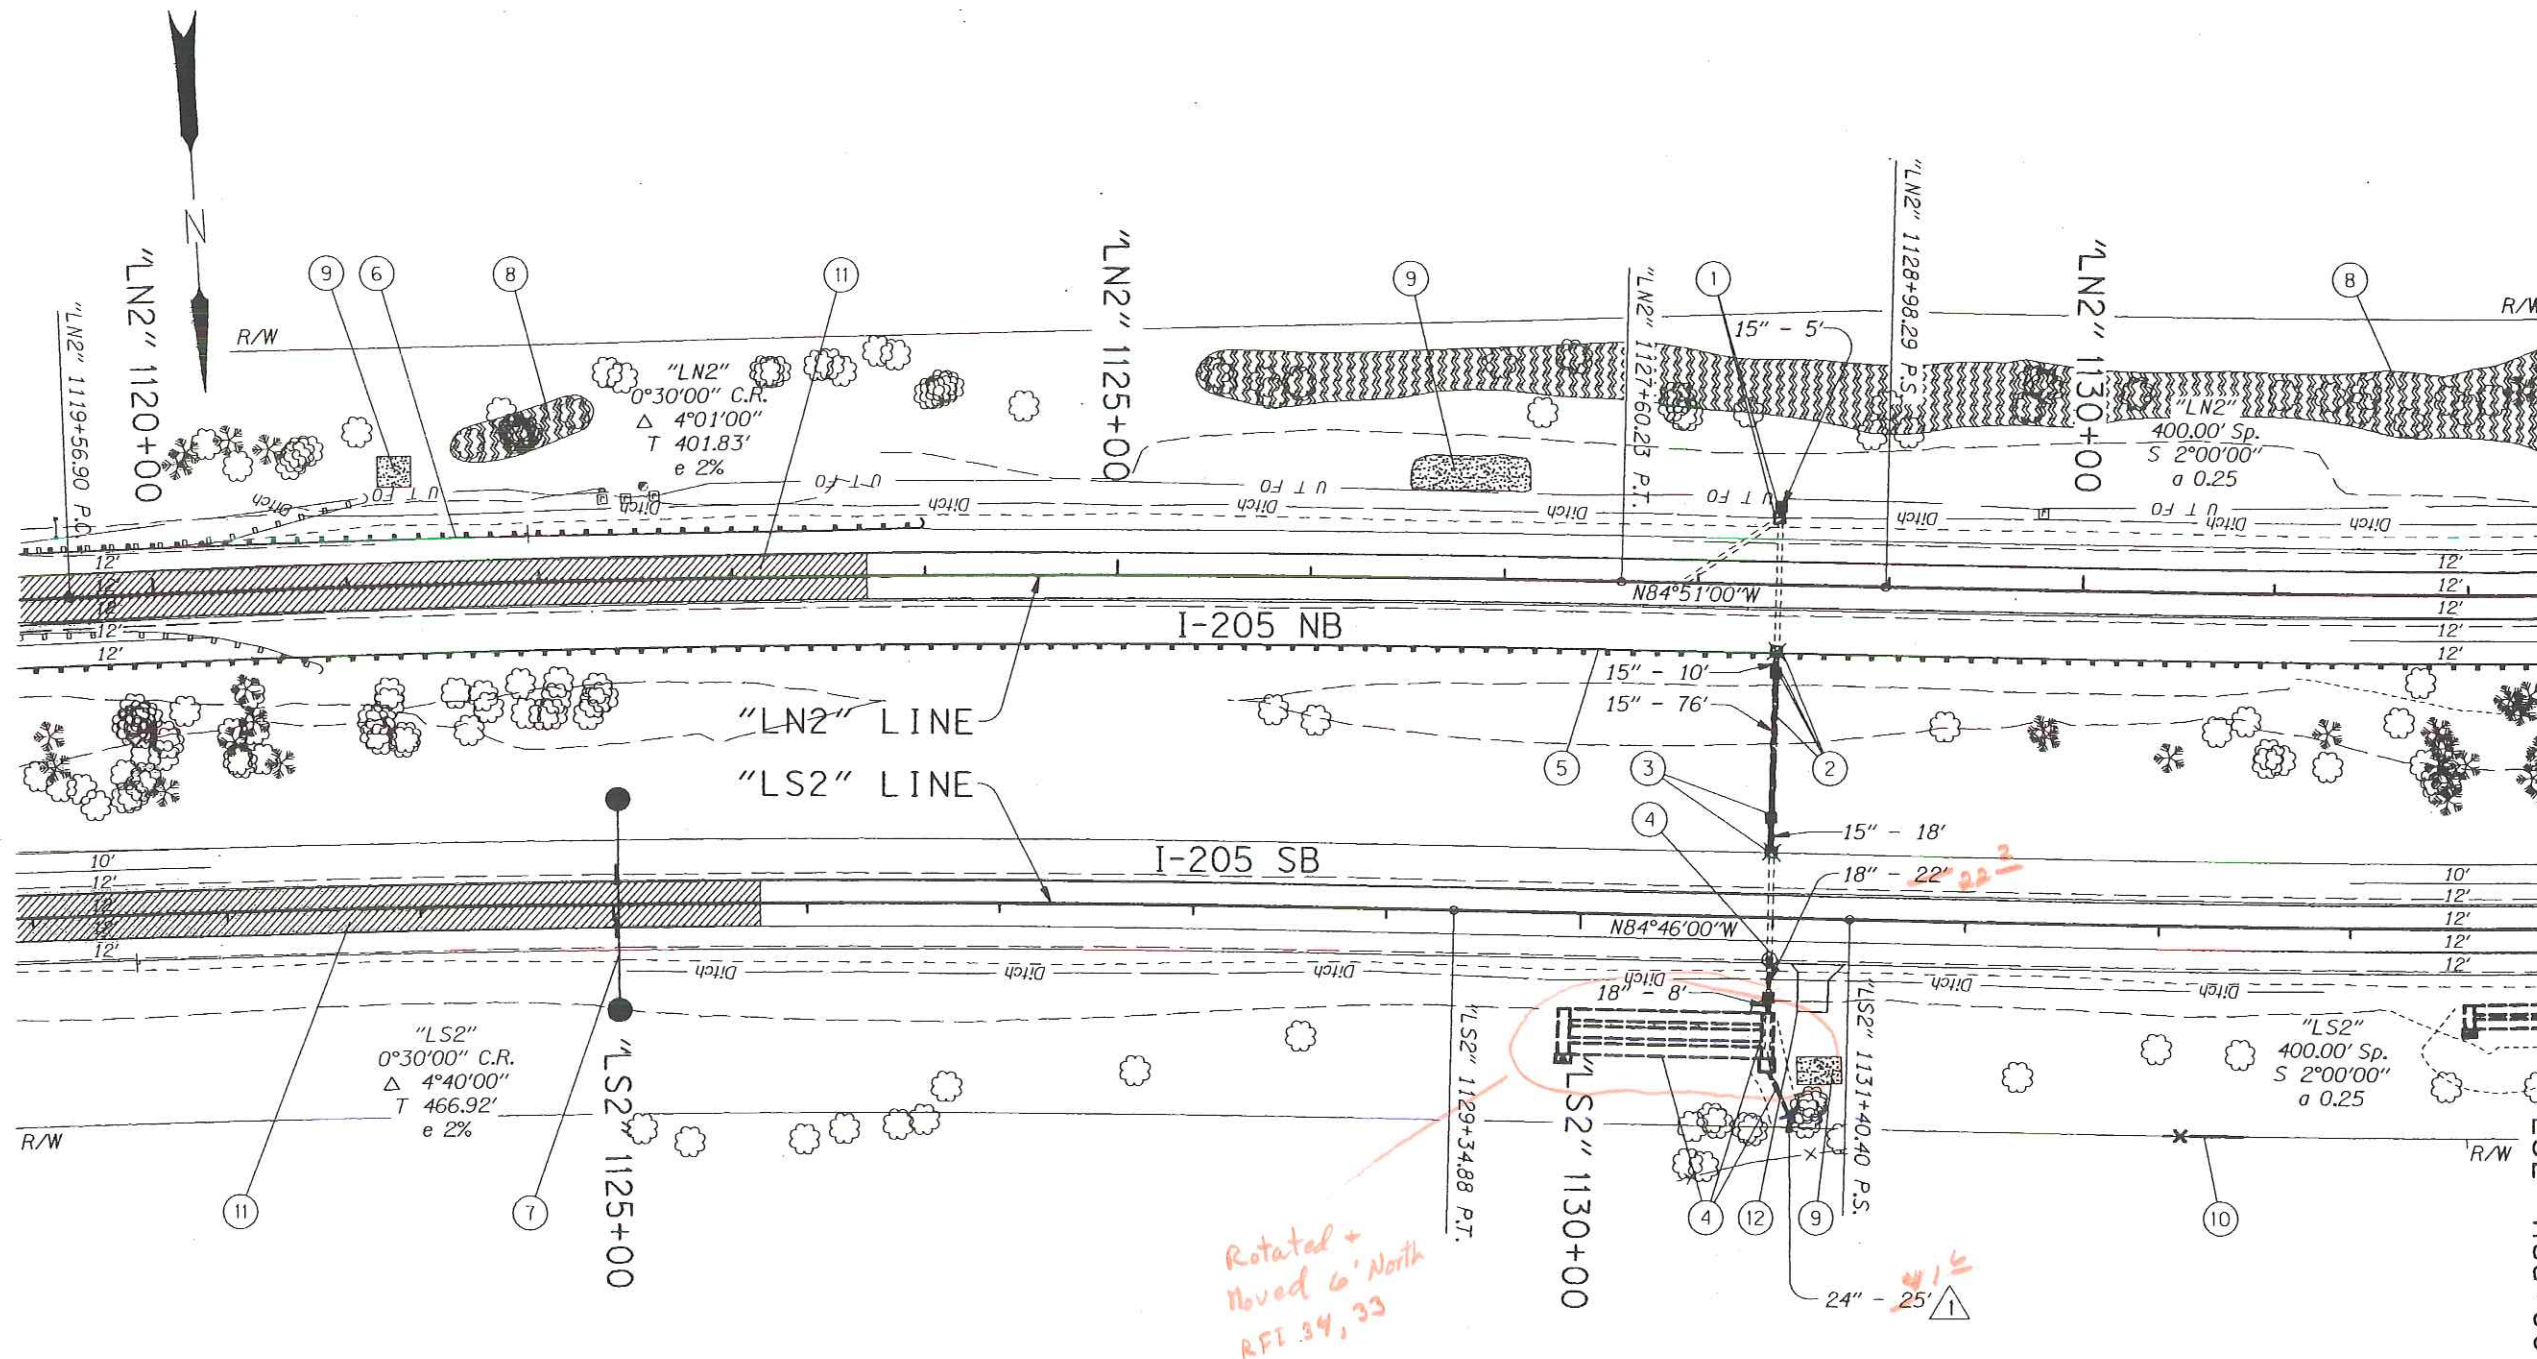

- ① Sta. "LN2" 1128+41.9, 40.1' Lt.
Cap Extg. Inlet
Const. Type "G-2MA" Inlet
Extend 15" Sew. Pipe - 5' Lt.
5' Depth
- ② Sta. "LN2" 1128+41.9, 46.3' Rt.
Remove Extg. Pipe
Cap Extg. Inlet
Const. Type "G-2MA" Inlet
Inst. 15" Sew. Pipe - 76'
Inst. 15" Sew. Pipe - 10'
10' Depth
- ③ Sta. "LS2" 1130+98, 52.5' Lt.
Cap Extg. Inlet
Const. Type "G-2MA" Inlet
Extend 15" Sew. Pipe - 18' Lt.
5' Depth
- ④ Sta. "LS2" 1130+98.6, 44.2' Rt.
Const. Type "G-2MA" Inlet
Inst. 18" Sew. Pipe - 30'
5' Depth
Const. Water Quality Manhole
Inst. 24" Sew. Pipe - 25'
5' Depth
Const. Underground Detention Facility #2
(For Details, See Sht. GJ-5)
- ⑤ See Sht. 32A, Note 10
Remove Extg. Guardrail
Const. Guardrail (Type 2A)
- ⑥ See Sht. 32A, Note 11
Remove Extg. Guardrail
Const. Guardrail (Type 2A)
Const. Guardrail Terminal, Non-Flared (50')
Flare Rate=0, W=1', E=0
- ⑦ Sta. "LS2" 1125+00
Const. Sign Bridge
(For Drg. Nos., See Sht. 1A)
- ⑧ Type "A" Weed Control
- ⑨ Type "B" Weed Control
- ⑩ Sta. "LS2" 1133+00 To
Sta. "LS2" 1133+45, Rt.
Remove Type 2 Fence - 45'
Const. Type 2 Fence - 45'
- ⑪ See Sht. 32A, Note 19
- ⑫ Sta. "LS2" 1131+20, Rt.
Const. Conc. Parking Pad - 50 Sq. Yd.
(For Details, See Sht. 2B-13)

Rotated +
Moved 6' North
RFI 34, 33

"AS CONSTRUCTED"
Mark Bevan
Date 6/26/09 Project Mngr

LEGEND

Remove Extg. Pipe Shown Thus:	
Remove Extg. Surfacing Shown Thus:	
Type "A" Weed Control Shown Thus:	
Type "B" Weed Control Shown Thus:	

REVISIONS

	Revised 04-10-2006
	Revised Drainage



**OREGON DEPARTMENT OF TRANSPORTATION
ROADWAY ENGINEERING SECTION**

**I-205: WILLAMETTE RIVER BR. -
PACIFIC HWY. (UNIT 3) SEC.**

EAST PORTLAND FREEWAY
CLACKAMAS & WASHINGTON COUNTIES


Design Team Leader - Jerry Lane
Designed By - Tom Metcalf
Drafted By - Serban Dinca

**ALIGNMENT AND
GENERAL CONSTRUCTION**


SHEET NO. **33**

OBEC CONSULTING ENGINEERS
Corporate Office: 820 COUNTRY CLUB ROAD, SUITE 1008 EUGENE, OREGON 97401-8008
2225 MISSION STREET SE, SUITE 100 SALEM, OREGON 97302-1285
1335 POPLAR DRIVE MEDFORD, OREGON 97504-5207

"LN2" LINE

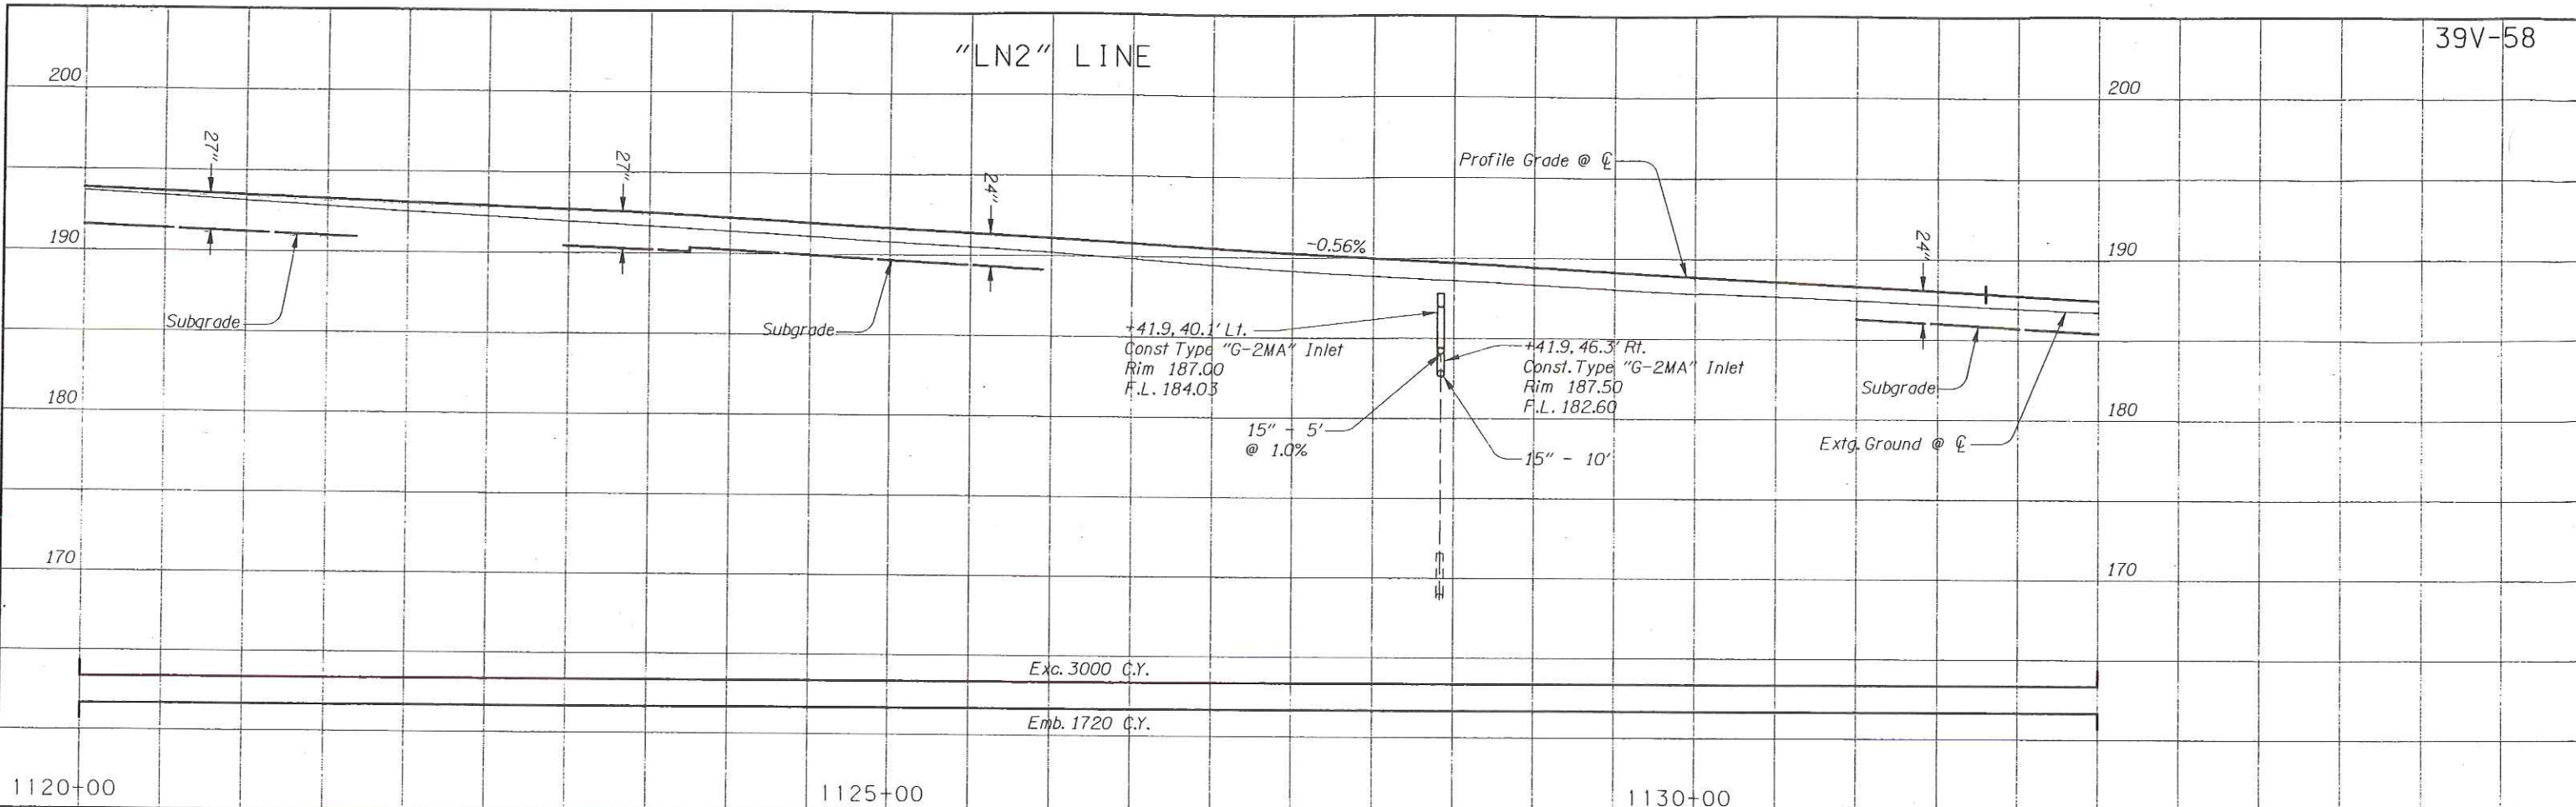

"LS2" LINE

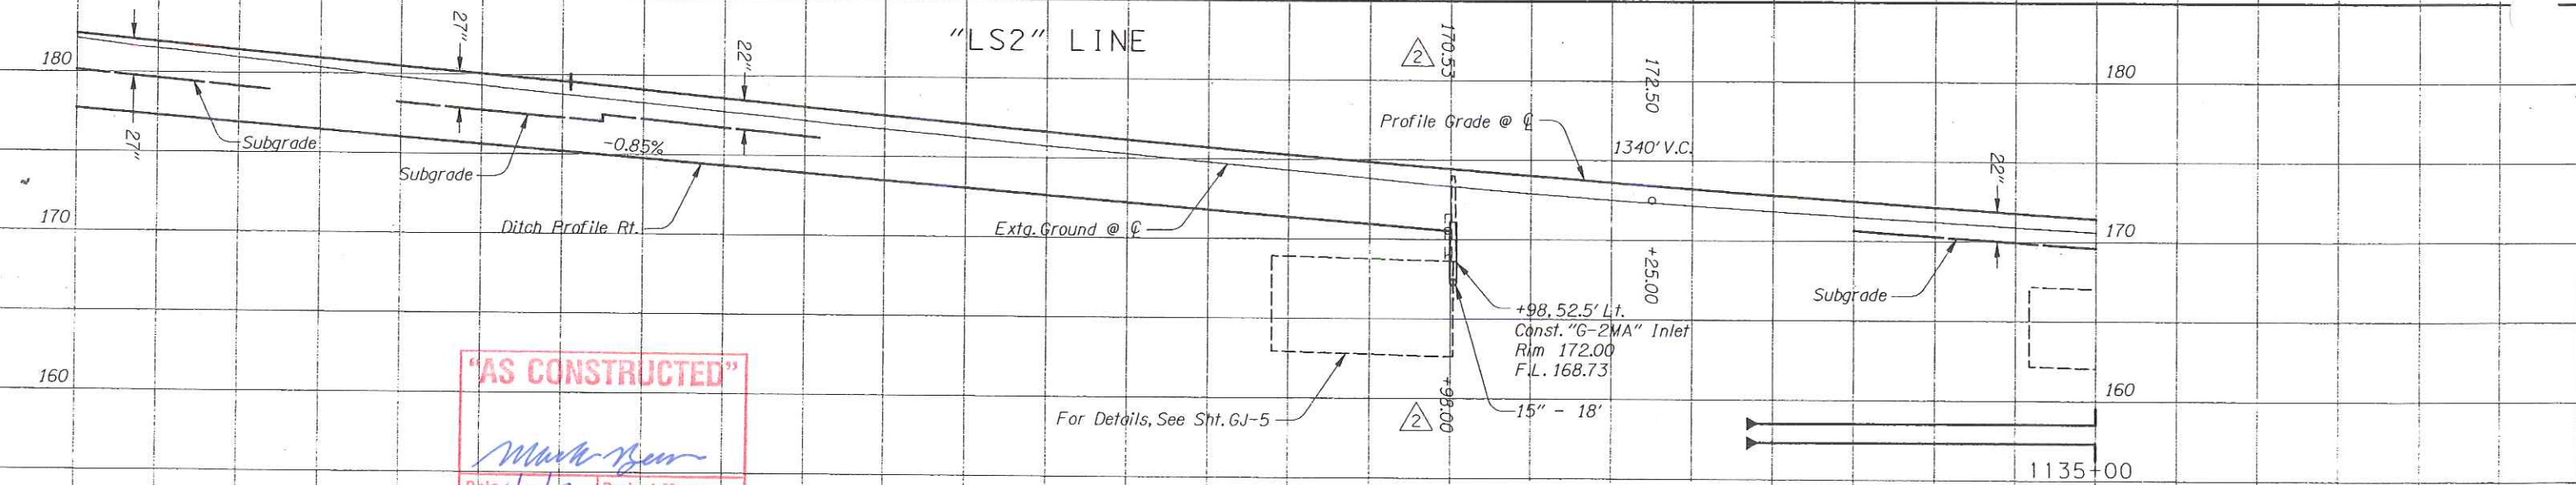

"AS CONSTRUCTED"

Mark Beer
Date 6/26/09 Project Mngr

REVISIONS	
1	Revised 04-10-2006 Revised Quantity
2	Revised 04-10-2006 Revised Drainage

REGISTERED PROFESSIONAL
ENGINEER
12295
Jerome D. Lane
OREGON
JULY 5, 1983
JEROME D. LANE
EXPIRES: 12/31/06

OREGON DEPARTMENT OF TRANSPORTATION
ROADWAY ENGINEERING SECTION

I-205: WILLAMETTE RIVER BR. -
PACIFIC HWY. (UNIT 3) SEC.
EAST PORTLAND FREEWAY
CLACKAMAS & WASHINGTON COUNTIES


Design Team Leader - Jerry Lane
Designed By - Tom Metcalf
Drafted By - Serban Dinca

PROFILES

SHEET NO. 33A


OBEC CONSULTING ENGINEERS
www.obec.com

Corporate Office: 920 COUNTRY CLUB ROAD, SUITE 100B EUGENE, OREGON 97401-8289
2225 MISSION STREET SE, SUITE 100 SALEM, OREGON 97302-1295
1335 POPLAR DRIVE MEDFORD, OREGON 97504-8207

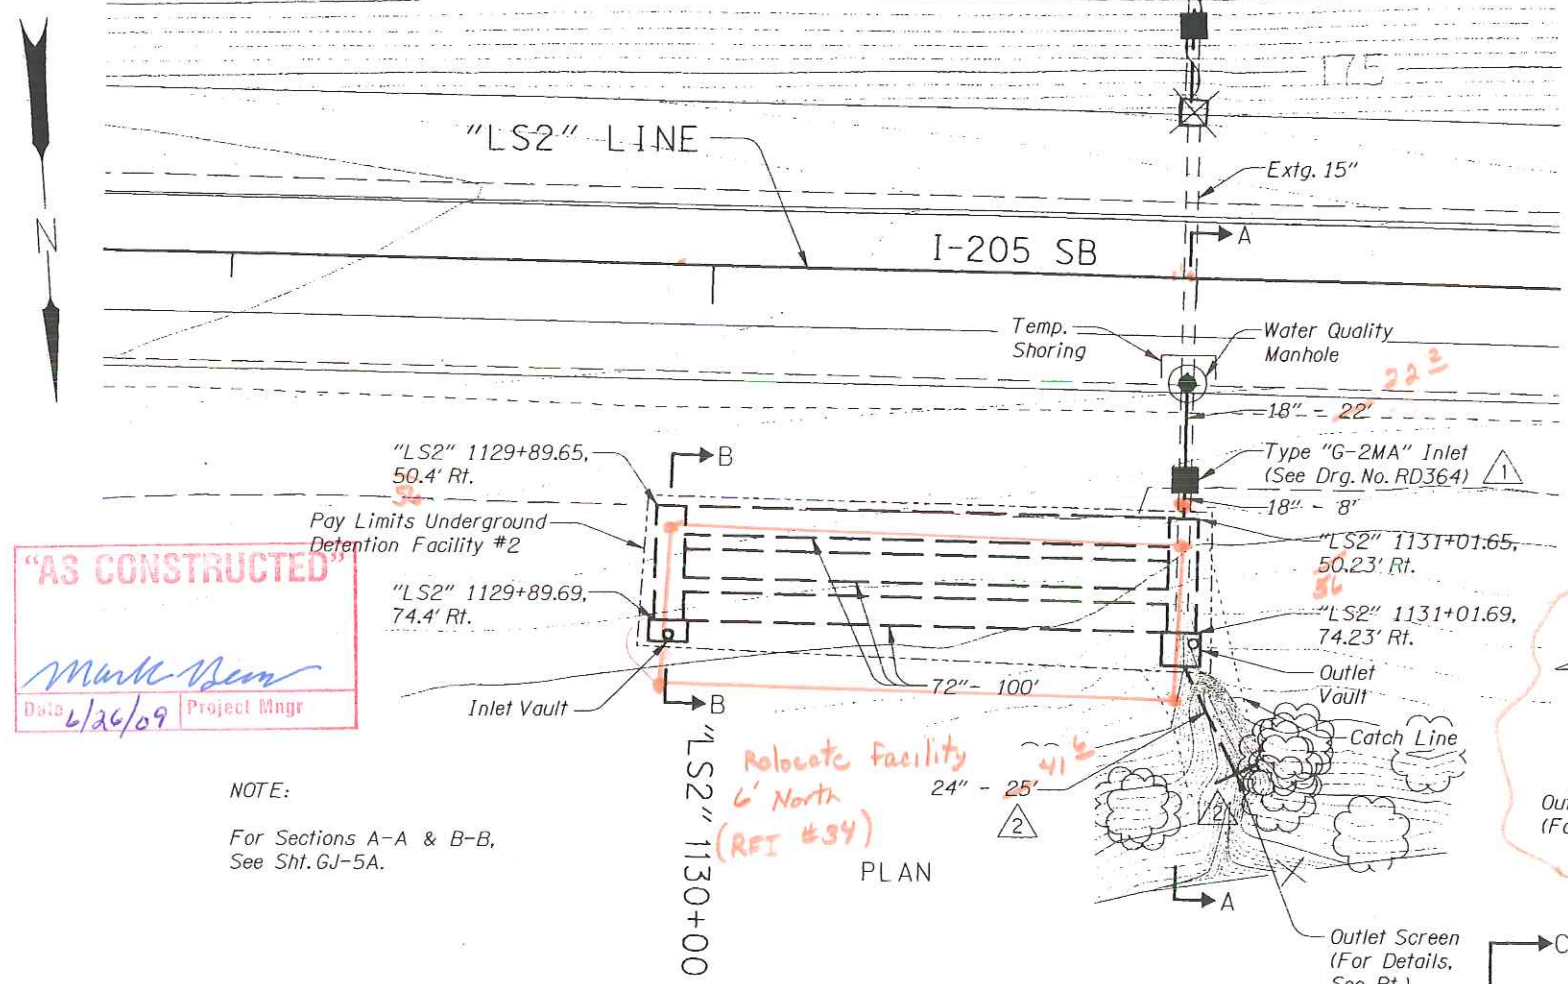


"AS CONSTRUCTED"
Mark Veen
Date 6/26/09 Project Mngr

NOTE:
For Sections A-A & B-B,
See Sht. GJ-5A.

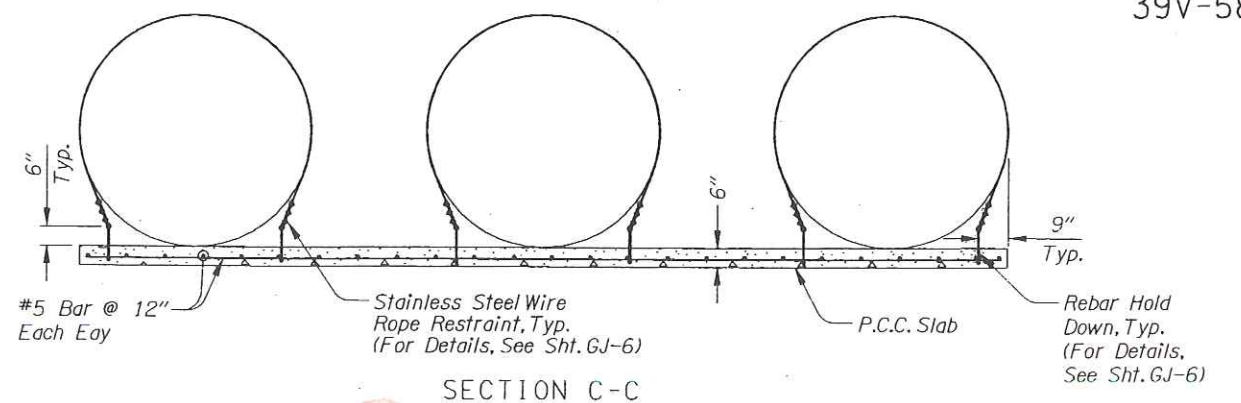


SECTION C-C

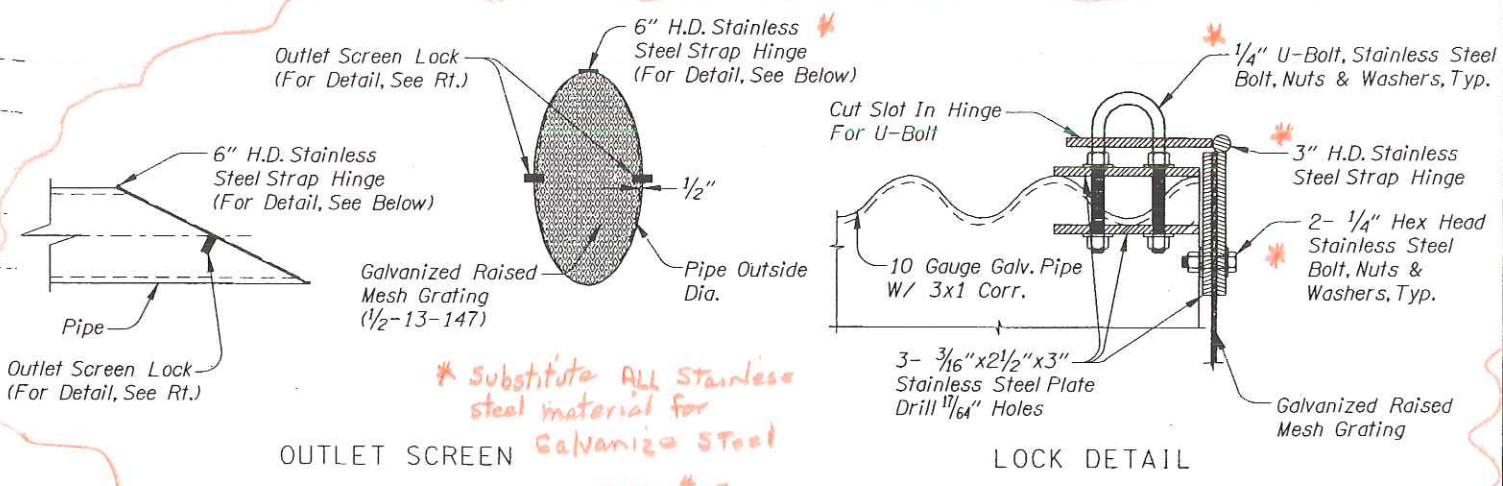


OUTLET SCREEN

LOCK DETAIL

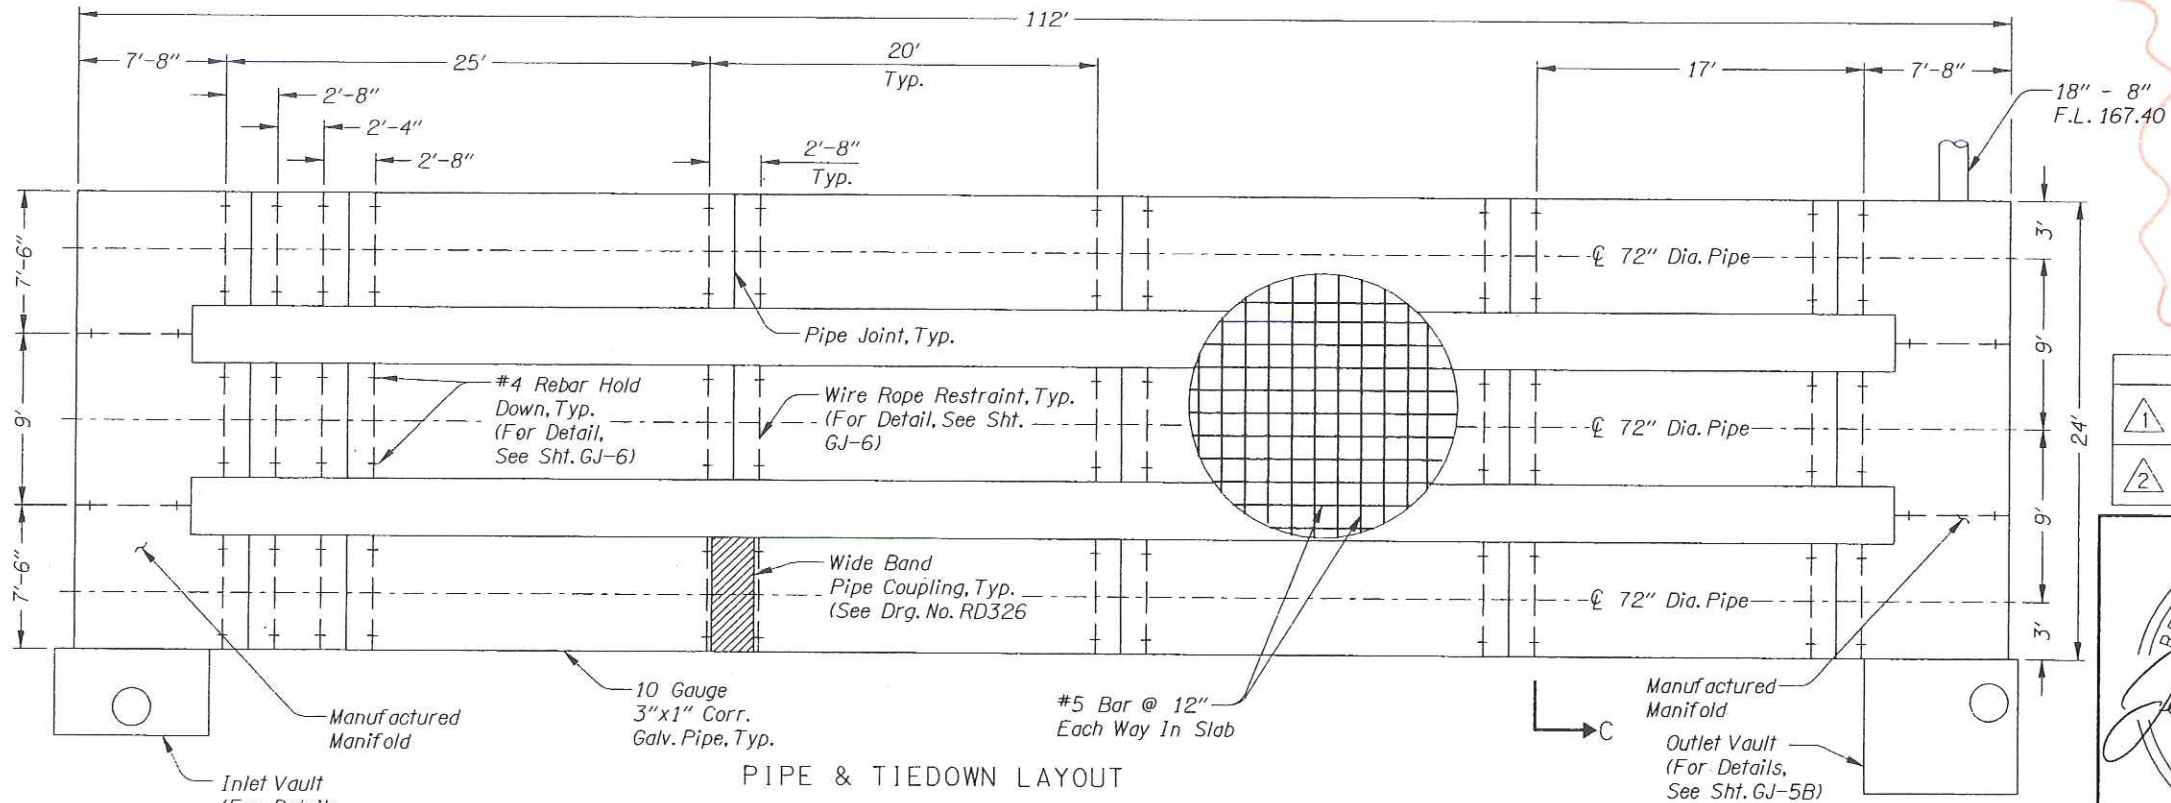

PIPE & TIEDOWN LAYOUT
UNDERGROUND DETENTION FACILITY #2
(See Sht. 33, Note 4)

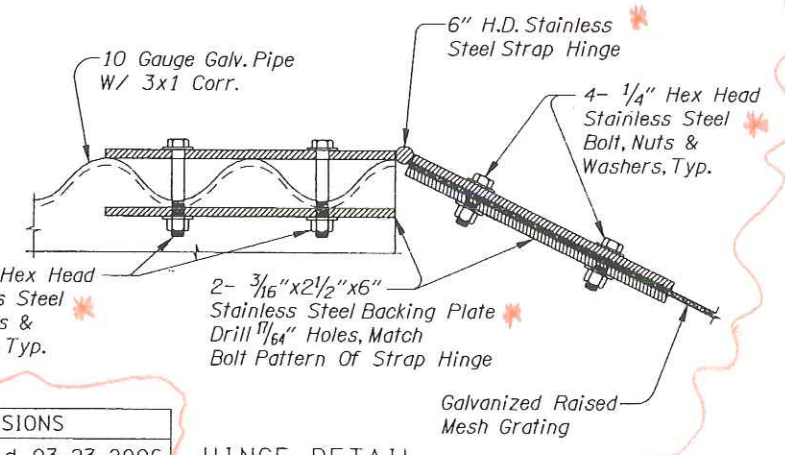

HINGE DETAIL

REVISIONS	
1	Revised 03-23-2006 Revised Note
2	Revised 04-10-2006 Revised Drainage



**OREGON DEPARTMENT OF TRANSPORTATION
ROADWAY ENGINEERING SECTION**


**I-205: WILLAMETTE RIVER BR. -
PACIFIC HWY. (UNIT 3) SEC.
EAST PORTLAND FREEWAY
CLACKAMAS & WASHINGTON COUNTIES**

Design Team Leader - Jerry Lane
Designed By - James Kent
Drafted By - Mathew Bunde


**UNDERGROUND DETENTION
FACILITY #2**

SHEET NO.
GJ-5

EXPIRES: 12/31/09

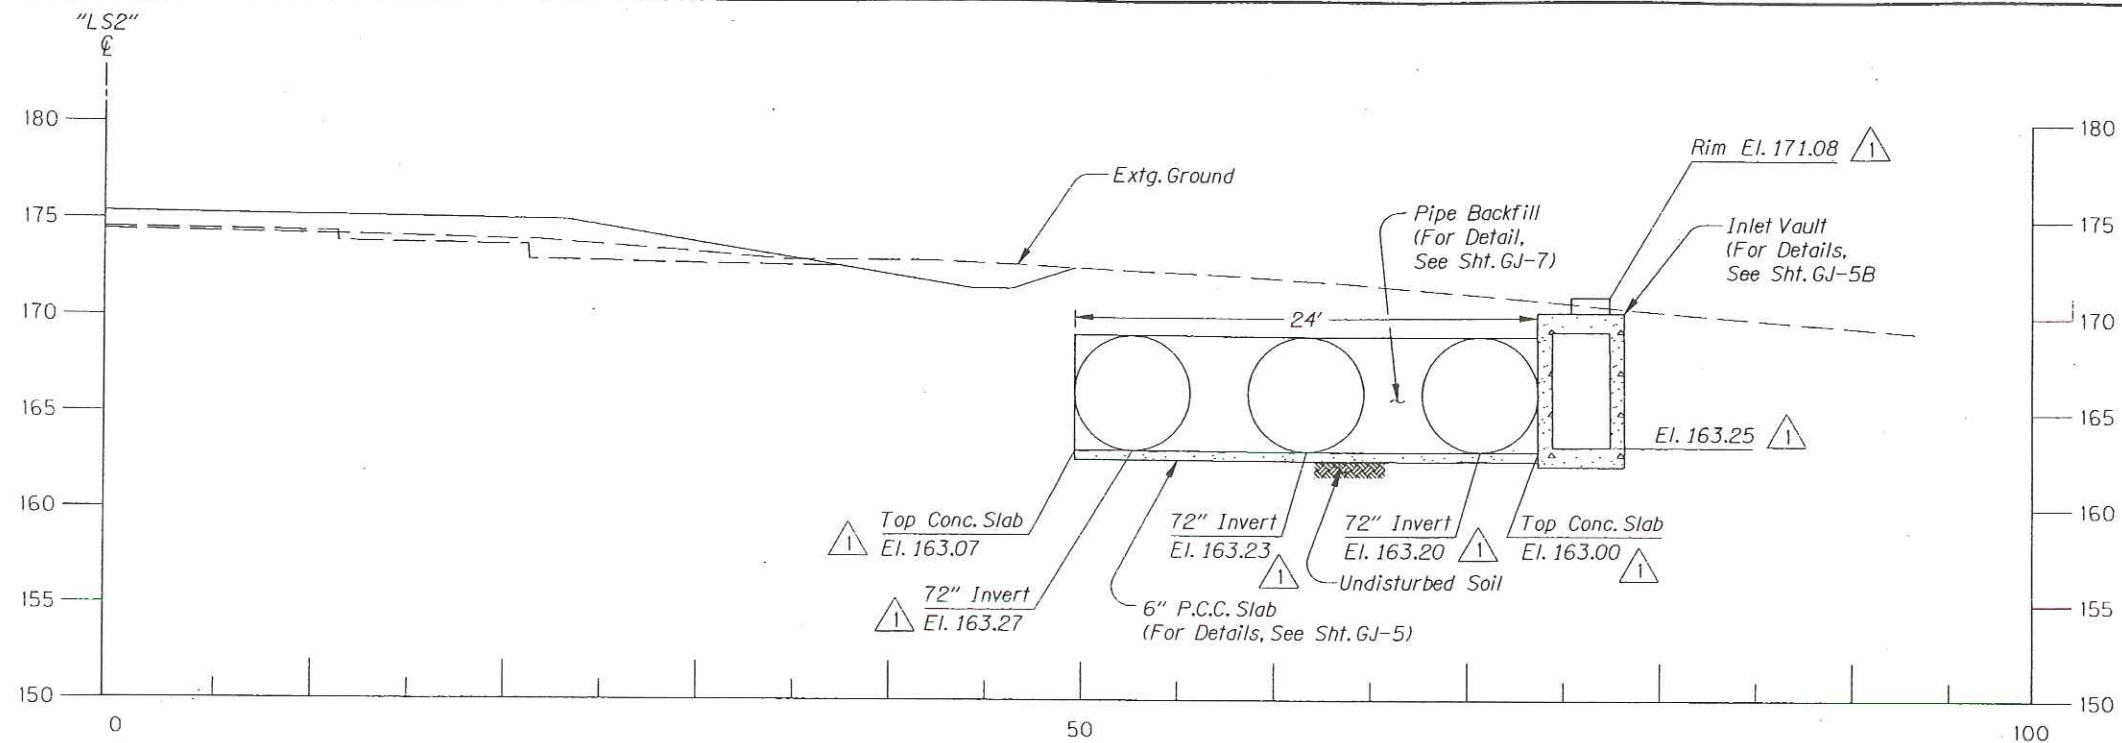

SECTION B-B

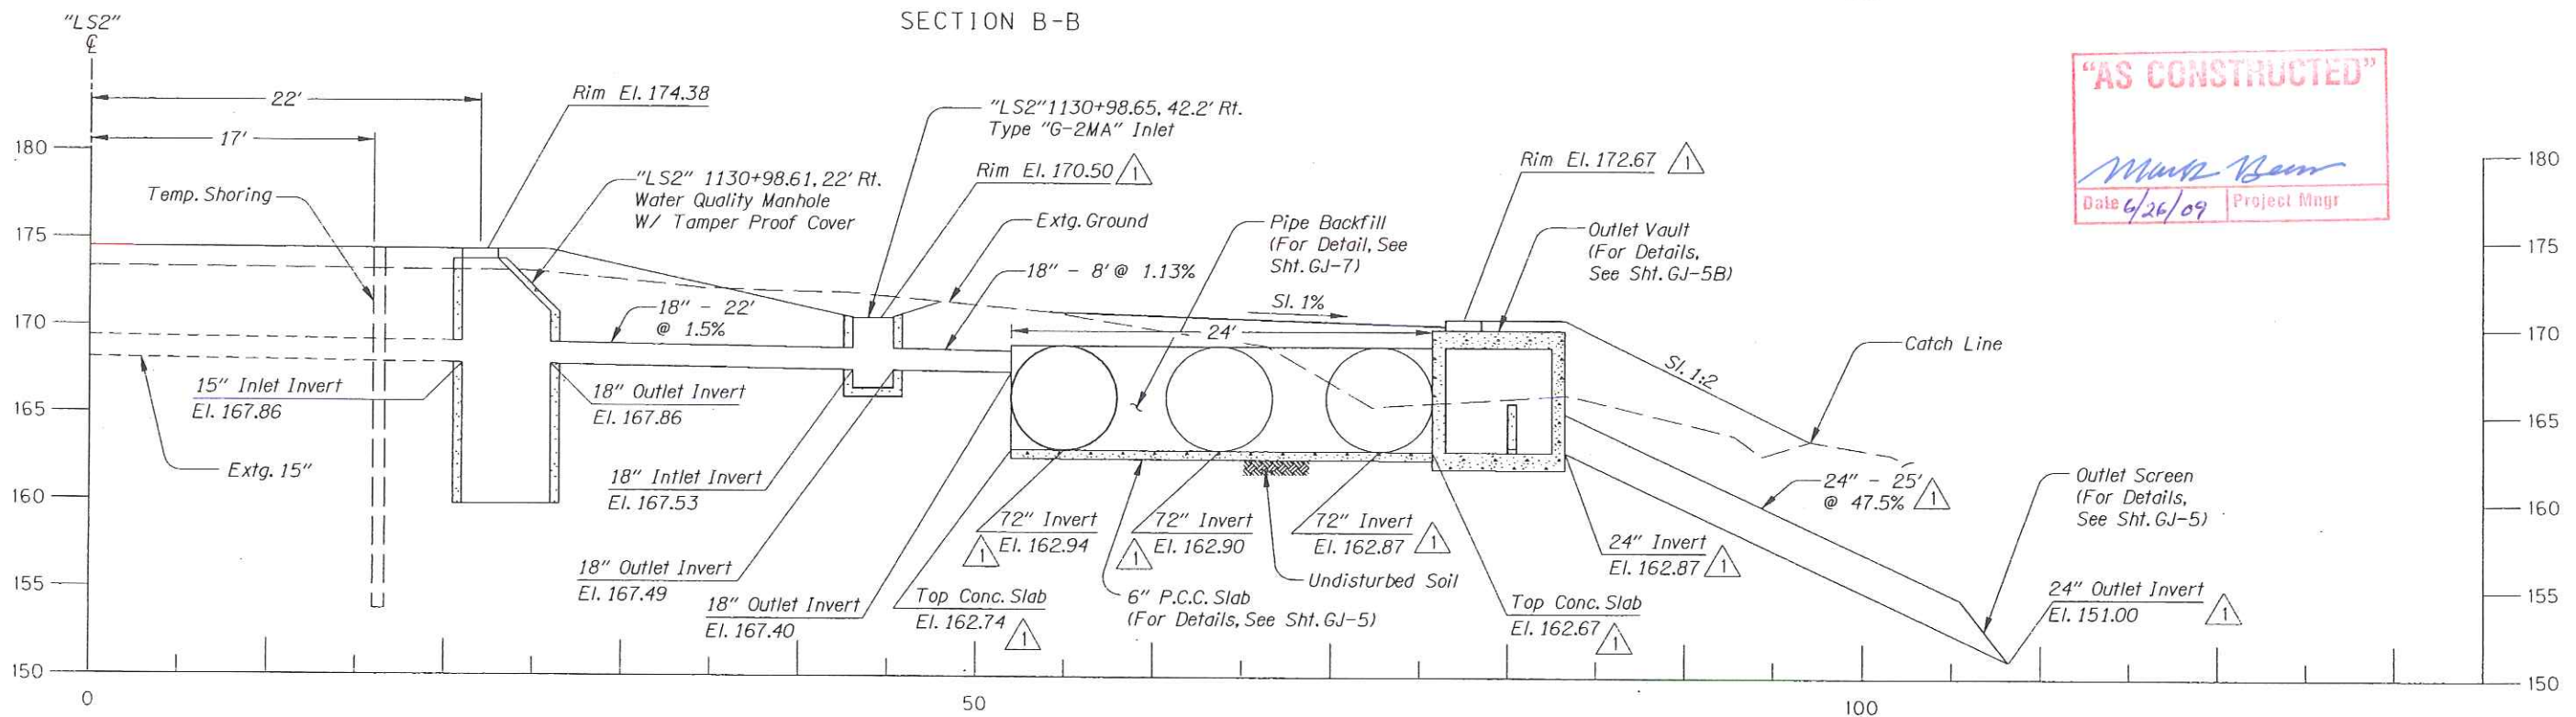

SECTION A-A

"AS CONSTRUCTED"

Mathew Bunde
Date 6/26/09 Project Mngr

REVISIONS	
1	Revised 04-10-2006
	Revised Elevations

REGISTERED PROFESSIONAL
ENGINEER
12295
Jerome D. Lane
OREGON
JULY 5, 1983
JEROME D. LANE
EXPIRES: 12/31/06

OREGON DEPARTMENT OF TRANSPORTATION
ROADWAY ENGINEERING SECTION

1-205 WILLAMETTE RIVER BR. -
PACIFIC HWY. (UNIT 3) SEC.
EAST PORTLAND FREEWAY
CLACKAMAS & WASHINGTON COUNTIES

Design Team Leader - Jerry Lane
Designed By - James Kent
Drafted By - Mathew Bunde

**UNDERGROUND DETENTION
FACILITY #2
CROSS SECTIONS**

SHEET NO.
GJ-5A

OBEC CONSULTING ENGINEERS
Corporate Office: 820 COUNTRY CLUB ROAD, SUITE 100B EUGENE, OREGON 97401-0008
2205 MISSION STREET SE, SUITE 100 SALEM, OREGON 97302-1285
1335 POPLAR DRIVE MEDFORD, OREGON 97504-5207

"AS CONSTRUCTED"
Mark Beer
 Date 4/24/09 Project Mngr

GENERAL NOTES:

All Material And Workmanship Shall Conform To The 2002 Oregon Standard Specifications For Construction.

Entry & Outlet Vaults Designed For HL-93 Live Load.

Concrete Members Designed By Load Factor Design Method.


All Reinforcement Steel Shall Conform To Astm Specification A615, Grade 60 Or A706.

The Following Splice Lengths Shall Be Used,


Bar Size	3	4	5	6	7	8	9	10	11
Splice Length Uncoated	1'-0"	1'-4"	1'-8"	2'-0"	2'-8"	3'-6"	4'-4"	5'-7"	6'-9"
Splice Length Epoxy Coated	1'-5"	1'-10"	2'-4"	2'-10"	3'-9"	4'-11"	6'-1"	7'-10"	9'-6"

All Bars Shall Be Placed 2" Clear Of The Nearest Face Of Concrete Unless Shown Otherwise.


Concrete In Box Culverts Shall Be Class 3600-1 1/2" Or 3/4"

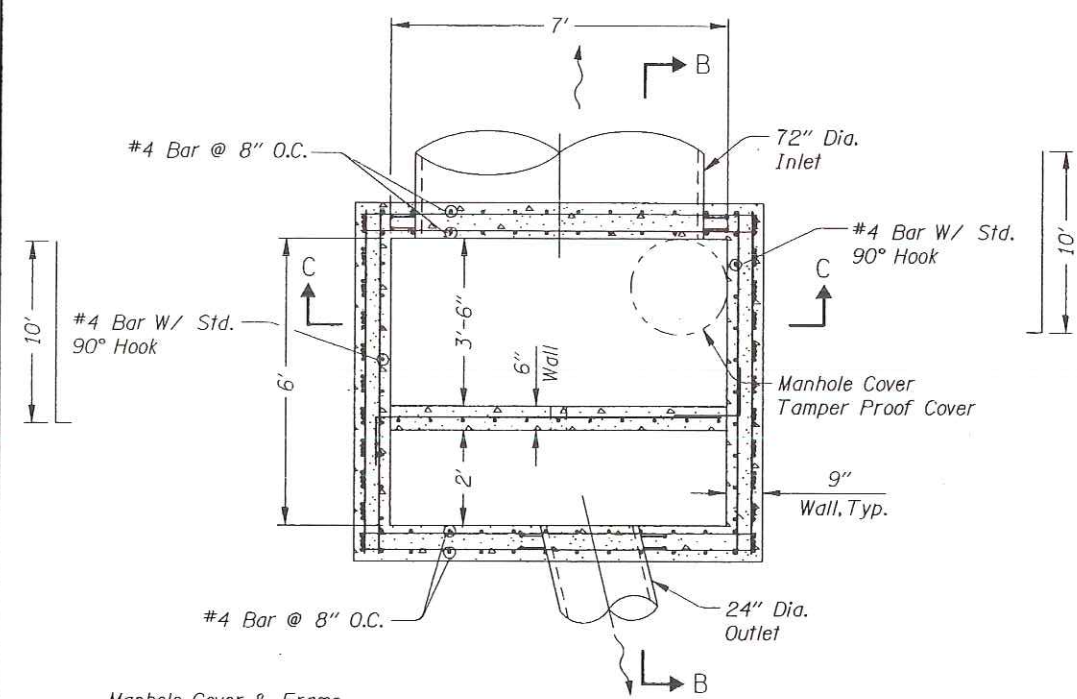


PLAN

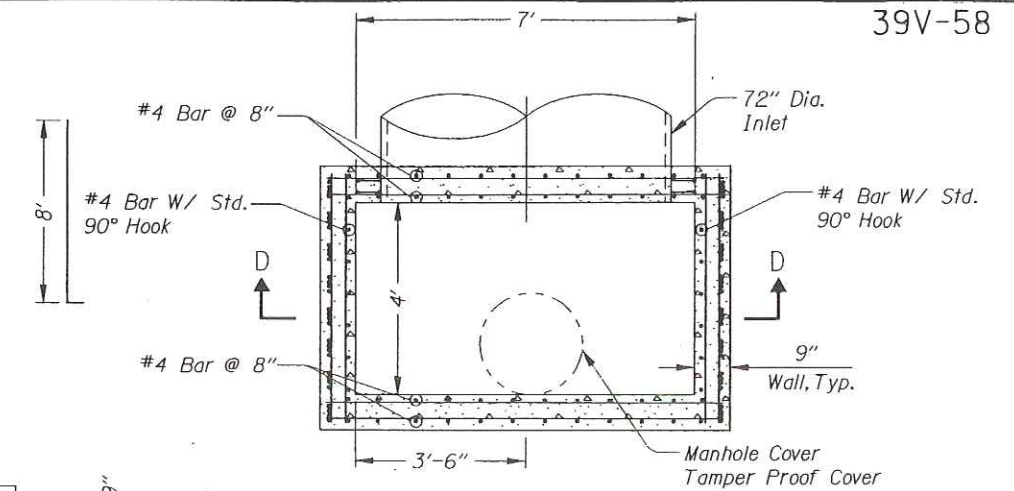


PLAN

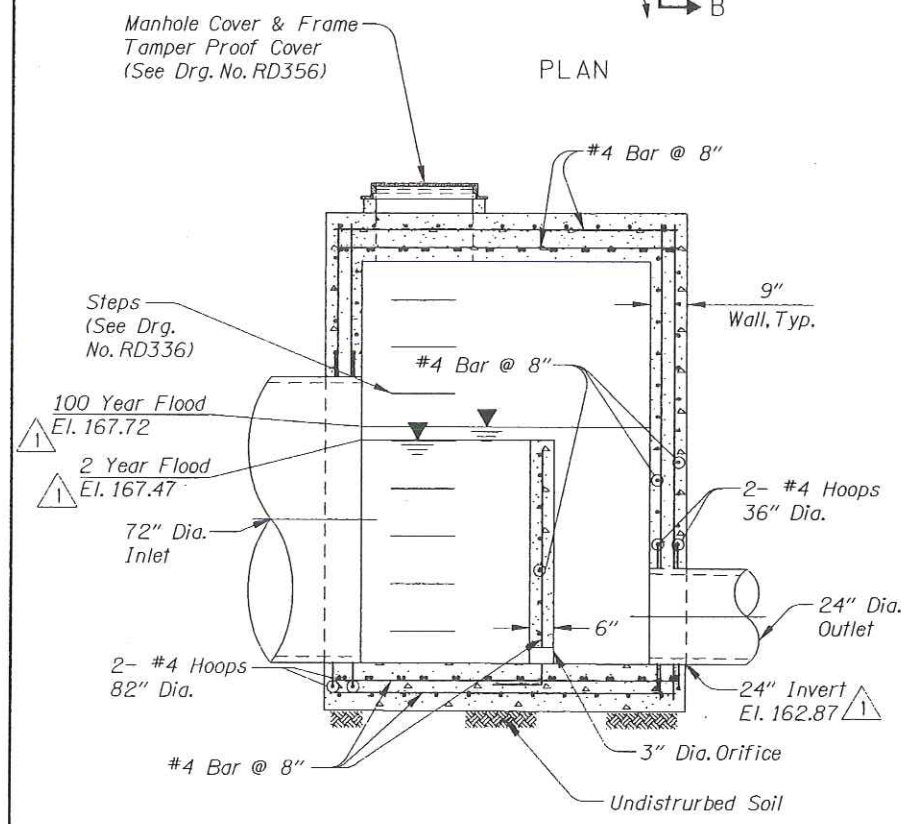

SECTION B-B

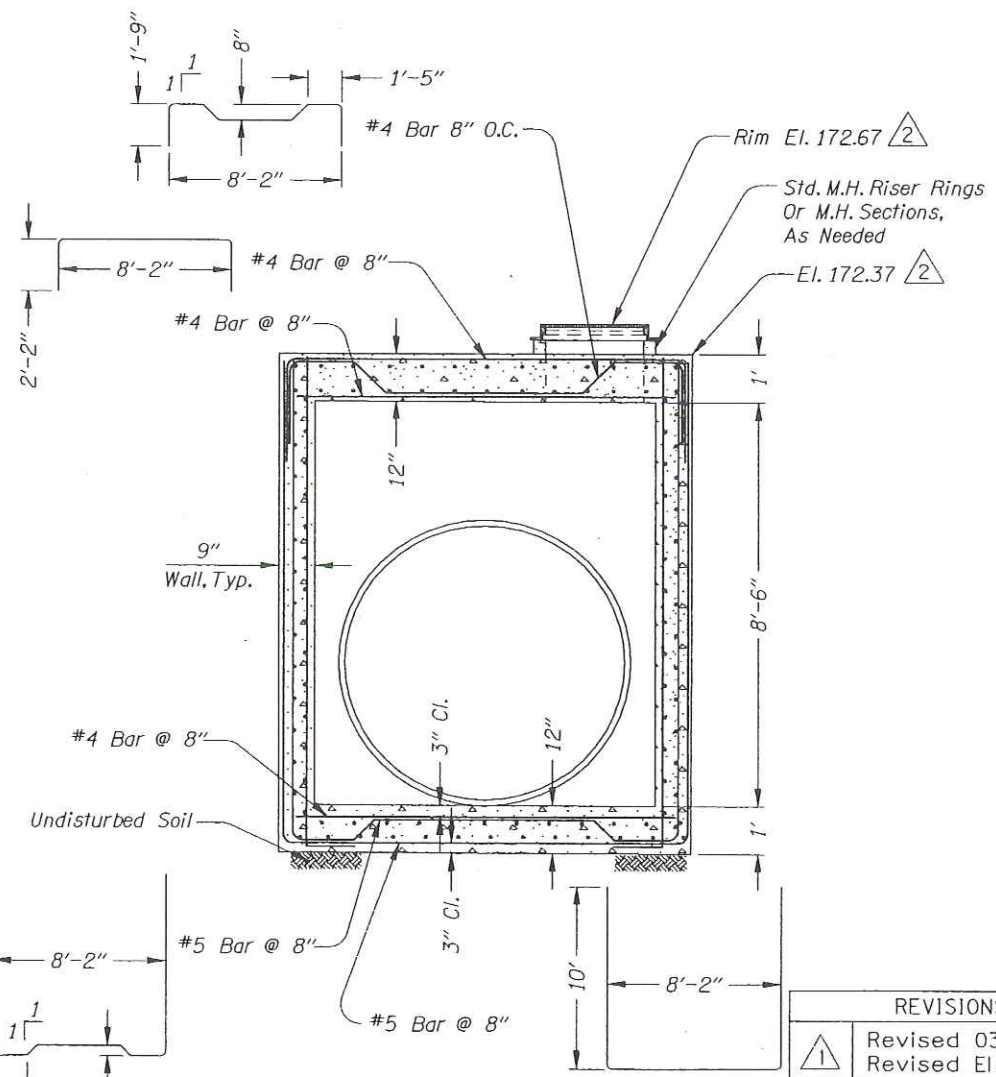


SECTION C-C

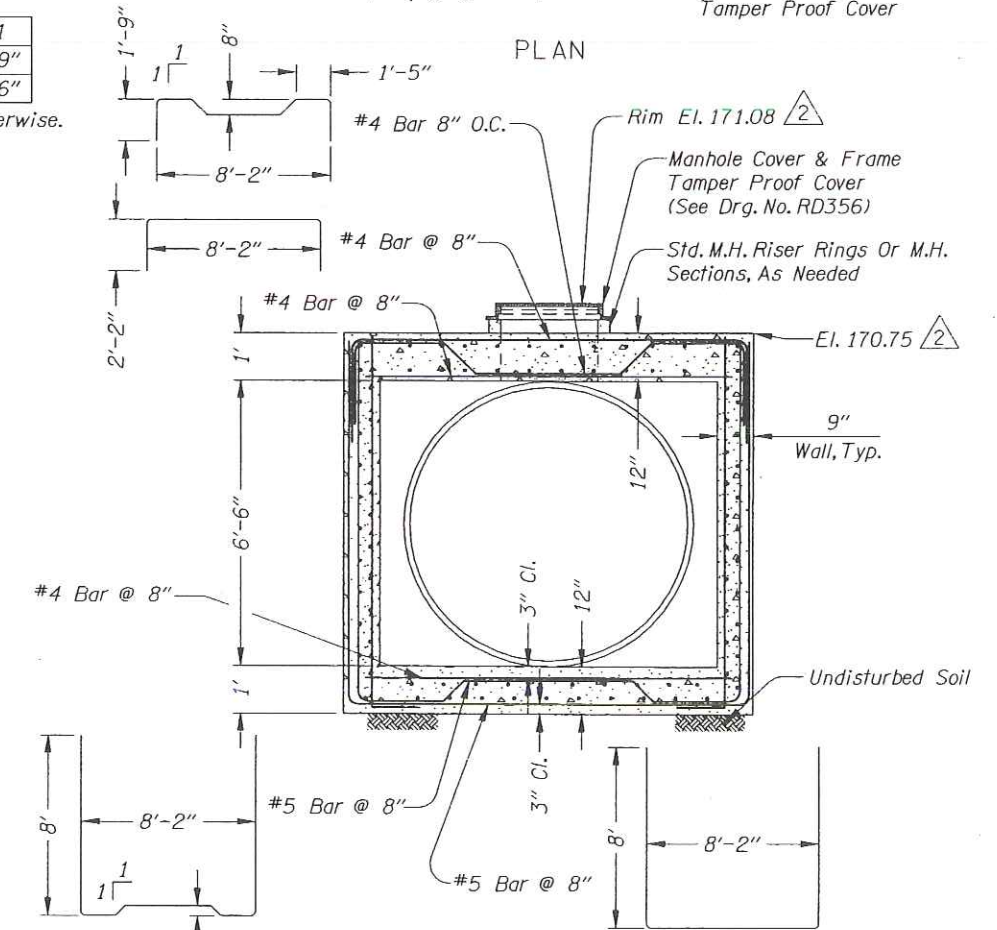


SECTION D-D

INLET VAULT

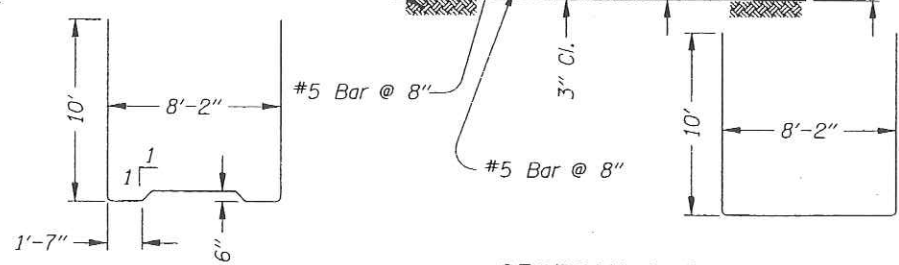

OUTLET VAULT

REVISIONS	
1	Revised 03-23-2006 Revised Elevations
2	Revised 04-10-2006 Revised Elevations

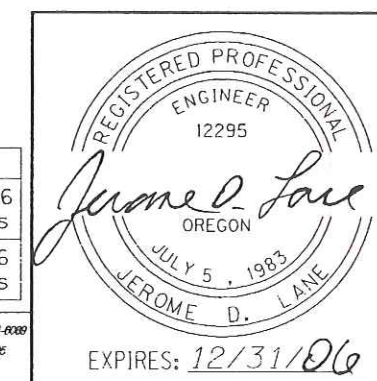

**OREGON DEPARTMENT OF TRANSPORTATION
ROADWAY ENGINEERING SECTION**

1-205: WILLAMETTE RIVER BR. -
PACIFIC HWY. (UNIT 3) SEC.
EAST PORTLAND FREEWAY
CLACKAMAS & WASHINGTON COUNTIES

Design Team Leader - Jerry Lane
Designed By - James Kent
Drafted By - Mathew Bunde

**UNDERGROUND DETENTION
FACILITY #2
DETAILS**

SHEET NO. GJ-5B