

OPERATION & MAINTENANCE MANUAL

DFI No. : D00179

Facility Type: Water Quality Biofiltration
Swale



JUNE, 2011

INDEX

1. IDENTIFICATION..... 1

2. FACILITY CONTACT INFORMATION..... 1

3. CONSTRUCTION..... 1

4. STORM DRAIN SYSTEM AND FACILITY OVERVIEW 2

5. FACILITY HAZ MAT SPILL FEATURE(S)..... 3

6. AUXILIARY OUTLET (HIGH FLOW BYPASS)..... 4

7. MAINTENANCE REQUIREMENTS..... 4

8. WASTE MATERIAL HANDLING..... 5

APPENDIX A: Operational Plan and Profile Drawing(s)

APPENDIX B: ODOT Project Plan Sheets

1. Identification

Drainage Facility ID (DFI): **D00179**
Facility Type: Water Quality Biofiltration Swale
Construction Drawings: (V-File Number) 26V-092
Location: District: 1 (Old 2A)
Highway No.: 092
Mile Post: 32.06; 32.11 (beg./end)
Description: This facility is located along the *west side Hwy. 92 adjacent to the southbound travel lane. Unobstructed access can be obtained from the right shoulder of the roadway.*

2. Facility Contact Information

Contact the Engineer of Record, Region Technical Center, or Geo-Environmental's Senior Hydraulics Engineer for:

- Operational clarification
- Maintenance clarification
- Repair or restoration assistance

Engineering Contacts:

Region Technical Center Hydro Unit Manager

Or

Geo-Environmental Senior Hydraulics Engineer (503) 986-3365.

3. Construction

Engineer of Record: Consultant Designer - W&H Pacific, William Evans, P.E., (503) 362-4675

Facility construction: 1996
Contractor: N/A

4. Storm Drain System and Facility Overview

A water quality swale is a flat-bottomed open channel designed to treat stormwater runoff from highway pavement areas. This type of facility is lined with grass. Treatment by trapping sedimentation occurs when stormwater runoff flows through the grass.

This facility is located along the west side Hwy. 92 adjacent to the southbound travel lane. Unobstructed access can be obtained from the right shoulder of the roadway. The swale was constructed as part of an existing roadside ditch. Flows from both the roadway and ditch enter the swale from the north, overtopping riprap and a small 6-inch by 3-inch concrete knee wall flow spreader. As the water flows south it is treated while it slows and spreads out within the swale before re-entering the ditch. Stormwater continues flowing south until reaching a small creek and being re-directed eastward and crossing beneath Hwy. 92 in an 18-inch culvert to an outfall at the Columbia River.

A. Maintenance equipment access:

Unobstructed access can be obtained from the right should of southbound Hwy. 92.

B. Heavy equipment access into facility:

- Allowed (no limitations)
- Allowed (with limitations)
- Not allowed

C. Special Features:

- Amended Soils
- Porous Pavers
- Liners
- Underdrains



Photo 1: A view of the riprap and small 6" x 3" concrete knee wall flow spreader.



Photo 2: Looking north at the culvert outlet to the swale located north of this point.

5. Facility Haz Mat Spill Feature(s)

The water quality biofiltration swale can possibly be used to store a volume of liquid by blocking the culvert located at the commercial driveway approach to the south of the facility. Sandbags may be one way to best accomplish this.

6. Auxiliary Outlet (High Flow Bypass)

Auxiliary Outlets are provided if the primary outlet control structure can not safely pass the projected high flows. Broad-crested spillway weirs and over flow risers are the two most common auxiliary outlets used in stormwater treatment facility design. The auxiliary outlet feature is either a part of the facility or an additional storm drain feature/structure.

The auxiliary outlet feature for this facility is:

Designed into facility

Other, as noted below

There is no auxiliary outlet feature for this facility.

7. Maintenance Requirements

Routine maintenance table for non-proprietary stormwater treatment and storage/detention facilities have been incorporated into ODOT's Maintenance Guide. These tables summarize the maintenance requirements for ponds, swales, filter strips, bioslopes, and detention tanks and vaults. Special maintenance requirements in addition to the routine requirements are noted below when applicable.

The ODOT Maintenance Guide can be viewed at the following website:

<http://www.oregon.gov/ODOT/HWY/OOM/MGuide.shtml>

Maintenance requirements for proprietary structures, such as underground water quality manholes and/or vaults with filter media are noted in Appendix C when applicable.

The following stormwater facility maintenance table (See ODOT Maintenance Guide) should be used to maintain the facility outlined in this Operation and Maintenance Manual or follow the Maintenance requirements outlined in Appendix C when proprietary structure is selected below:

- Table 1 (general maintenance)
- Table 2 (stormwater ponds)
- Table 3 (water quality biofiltration swales)
- Table 4 (water quality filter strips)
- Table 5 (water quality bioslopes)
- Table 6 (detention tank)
- Table 7 (detention vault)

- Appendix C (proprietary structure)
- Special Maintenance requirements:

Note: Special maintenance Requirements Require Concurrence from ODOT SR Hydraulics Engineer.

8. Waste Material Handling

Material removed from the facility is defined as waste by DEQ. Refer to the roadwaste section of the ODOT Maintenance Yard Environmental Management System (EMS) Policy and Procedures Manual for disposal options: <http://egov.oregon.gov/ODOT/HWY/OOM/EMS.shtml>



Contact any of the following for more detailed information about management of waste materials found on site:

ODOT Clean Water Unit	(503) 986-3008
ODOT Statewide Hazmat Coordinator	(503) 229-5129
ODOT Region Hazmat Coordinator	(503) 731-8304
ODEQ Northwest Region Office	(503) 229-5263


Appendix A

Content:


- **Operational Plan and Profile Drawing(s)**

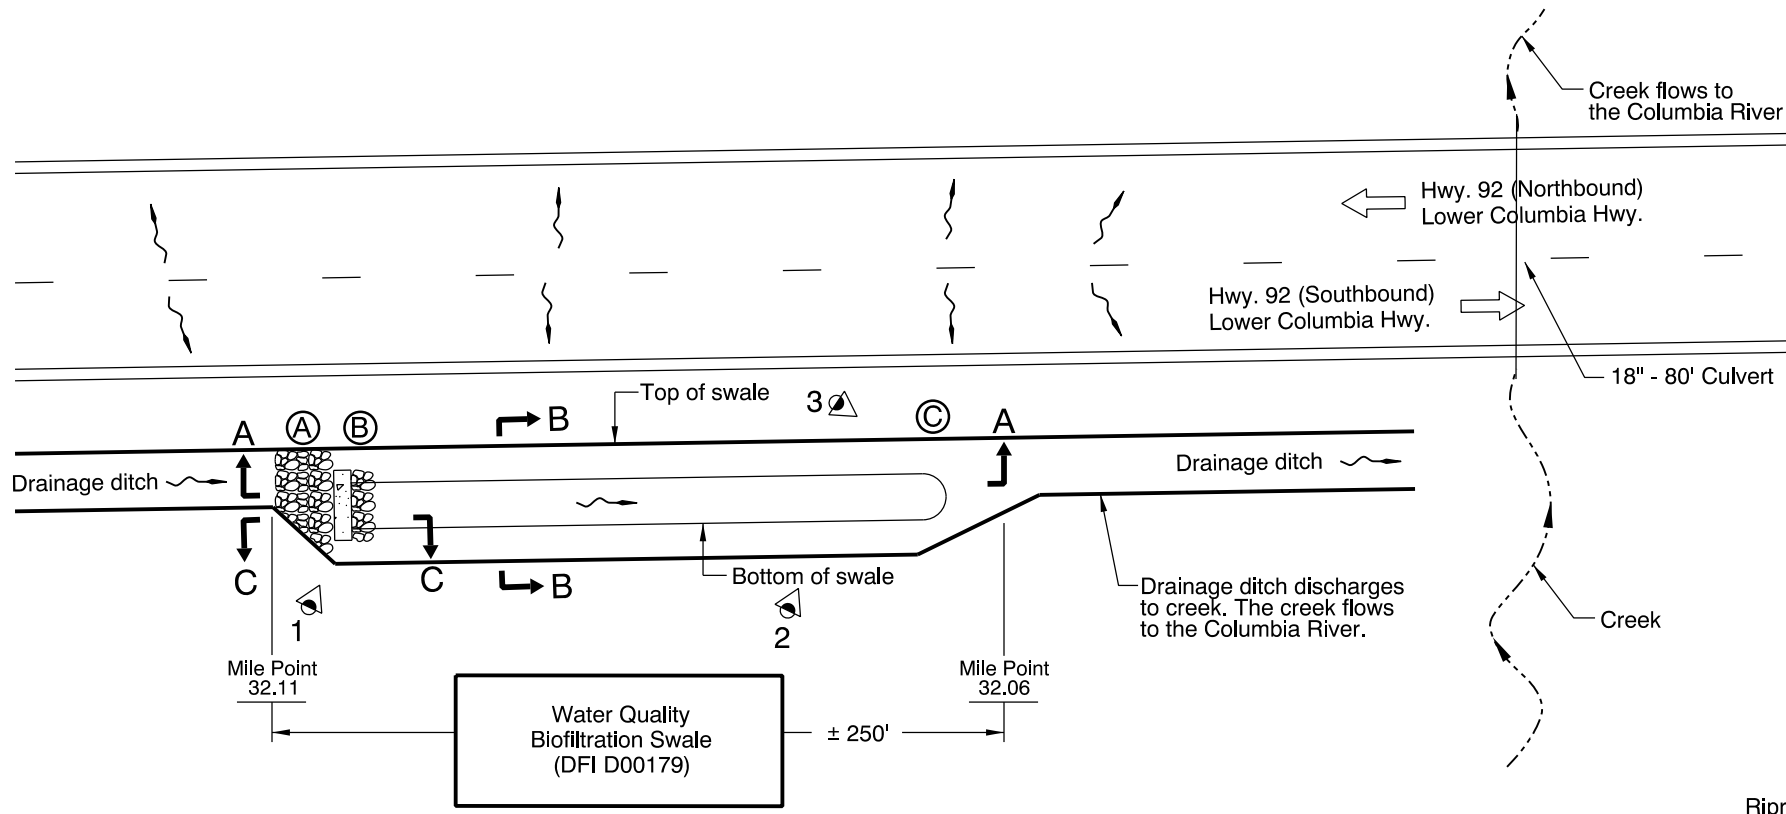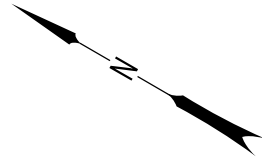


PLAN
N.T.S.

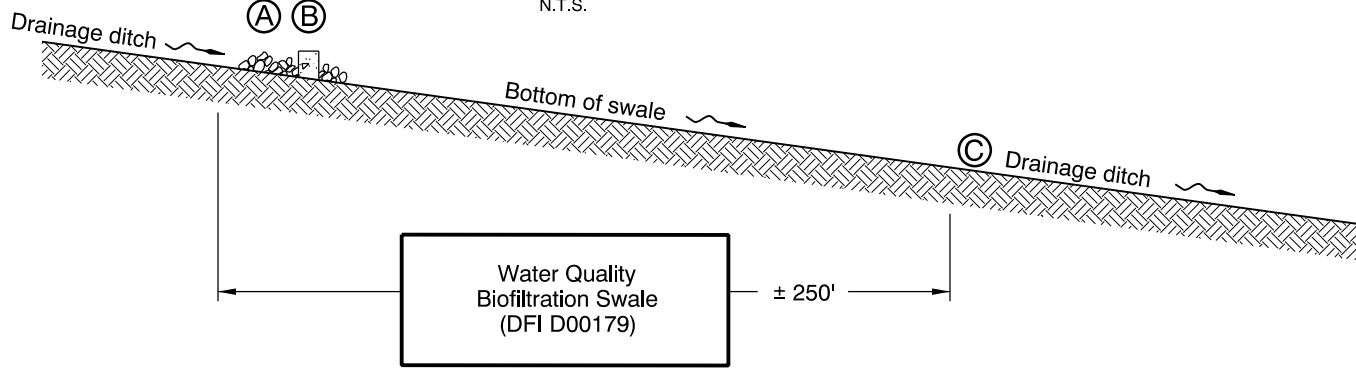

SECTION A-A
N.T.S.

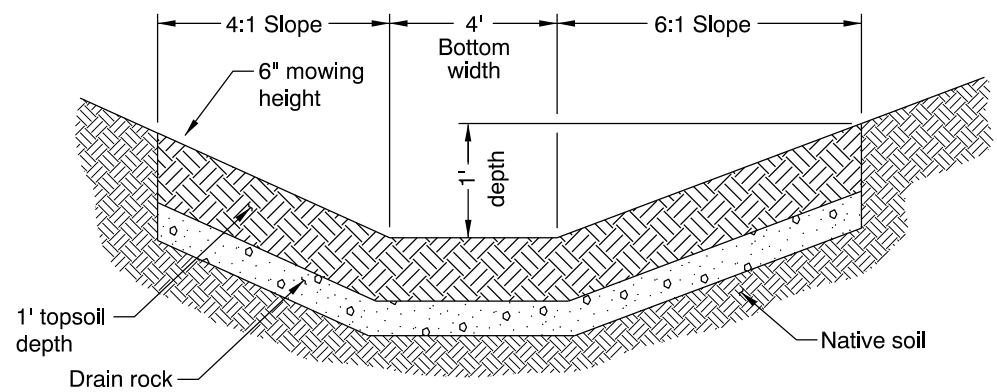

SECTION B-B
N.T.S.

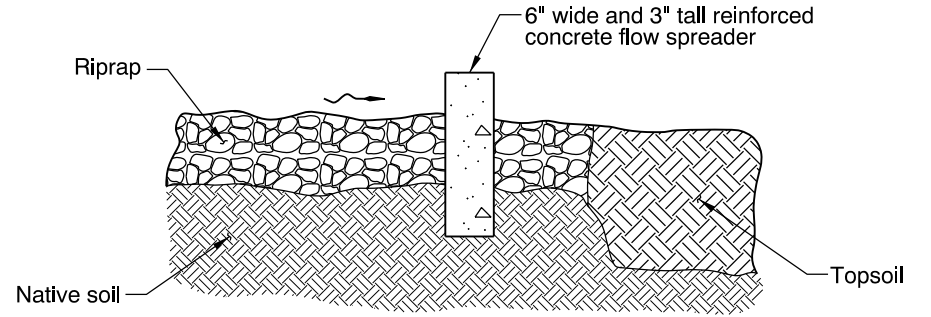

SECTION C-C
N.T.S.

- LEGEND:**
- Photo Location / Direction
 - Swale Inlet from Drainage Ditch
 - Riprap and Concrete Flow Spreader at Inlet
 - Water Quality Swale Outlet to Drainage Ditch
 - Manhole
 - Inlet
 - Storm Pipe (Facility)
 - Storm Pipe
 - Conveyance Direction
 - Pavement / Facility Flow Path
 - Traffic Direction / Flow

Sht. 1 of 1

OREGON DEPARTMENT OF TRANSPORTATION

Prepared By: Bob Knorr
 Drafted By: Bob Knorr

DFI D00179
MAINTENANCE DISTRICT 1 HWY 92
WATER QUALITY BIOFILTRATION SWALE
 COLUMBIA HIGHWAY MP 32.06-32.11
 COLUMBIA COUNTY

Appendix B

Content:

- **ODOT Project Plan Sheets**
 - *Cover/Title Sheet*
 - *Water Quality/Detention Plan Sheets*
 - *Other Details*

STATE OF OREGON
DEPARTMENT OF TRANSPORTATION


PLANS FOR PROPOSED PROJECT

REVISED AS CONSTRUCTED
10/1998 CONTRACT C11695
PROJ. MGR. _____


**GRADING, STRUCTURES, PAVING, SIGNING, SIGNALS, & LANDSCAPING
COLUMBIA CITY N.C.L. - WARREN SEC.**

COLUMBIA RIVER HIGHWAY (LOWER)

COLUMBIA COUNTY
JANUARY 1996

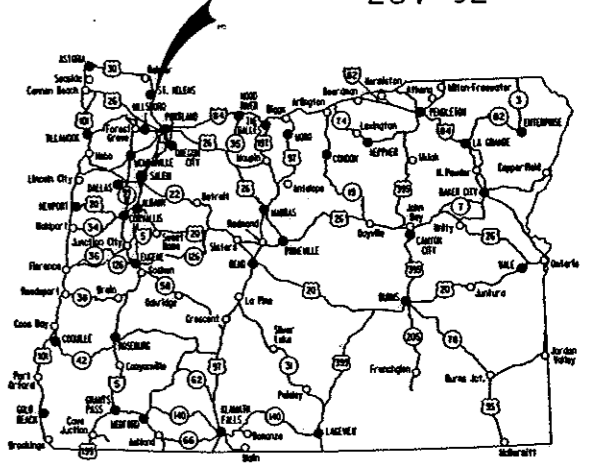

Overall Length Of Project - 7.25 Miles

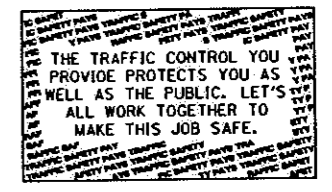

- OREGON TRANSPORTATION COMMISSION
- Henry H. Hewitt CHAIRMAN
 - Susan Brody VICE CHAIRMAN
 - Cynthia J. Ford COMMISSIONER
 - Steven H. Corey COMMISSIONER
 - Stuart Foster COMMISSIONER
 - Kenneth E. Husby INTERIM DIRECTOR OF TRANSPORTATION

PLANS PREPARED BY:



OREGON DEPARTMENT OF TRANSPORTATION
CONCURRENCE

Thomas Dulaney 11/30/95
TECHNICAL SERVICES MANAGING ENGINEER DATE

COLUMBIA CITY N.C.L. - WARREN SEC.
COLUMBIA RIVER HIGHWAY (LOWER)
COLUMBIA COUNTY


FEDERAL HIGHWAY ADMINISTRATION	PROJECT NUMBER	SHEET NO.
REGION 10	OREGON DIVISION	NH-S02W(9) 1

INDEX OF SHEETS	
SHEET NO.	DESCRIPTION
1	Title Sheet
1A	Index Of Sheets Cont'd. & Standard Drawing Nos.
2, 2A Thru 2A-6 Incl.	Typical Sections
2B Thru 2B-8 Incl., 2B-8A, 2B-9, 2B-9A, 2B-10, 2B-11, 2B-12, 2B-13 Thru 2B-16 Incl., 2B-16A, 2B-17 Thru 2B-26 Incl.	Details
2C Thru 2C-19 Incl.	Temporary Protection & Direction Of Traffic
2D Thru 2D-9 Incl.	Pipe Data
2E, 2E-2, 2E-3	Summary
3, 3A, 3B, 4, 5, 6, 7, 7A, 7B, 8, 8A, 8B, 8C, 9, 9A, 10, 10A, 10B, 11, 12, 12A, 12B, 13, 14, 14A, 14B, 14C, 15, 16, 16A, 17, 18, 19, 19A, 20, 20A, 21, 21A, 21B, 22, 22A, 22B, 23, 23A, 23B, 23C, 24, 24A, 25, 26, 26A, 26B, 27, 27A, 28, 28A, 29, 30, 30A, 30B, 30C, 31, 32, 33, 33A, 34, 35, 35A, 35B, 36,	Plans & Profiles
37, 37A, 37B	Landscaping

CONT'D. ON SHT. 1A

NH-S02W(9)
BEGINNING OF PROJECT
STA. 525 + 00 M.P. 33.02

END OF PROJECT NH-S02W(9)
STA. 906 + 50 M.P. 25.77

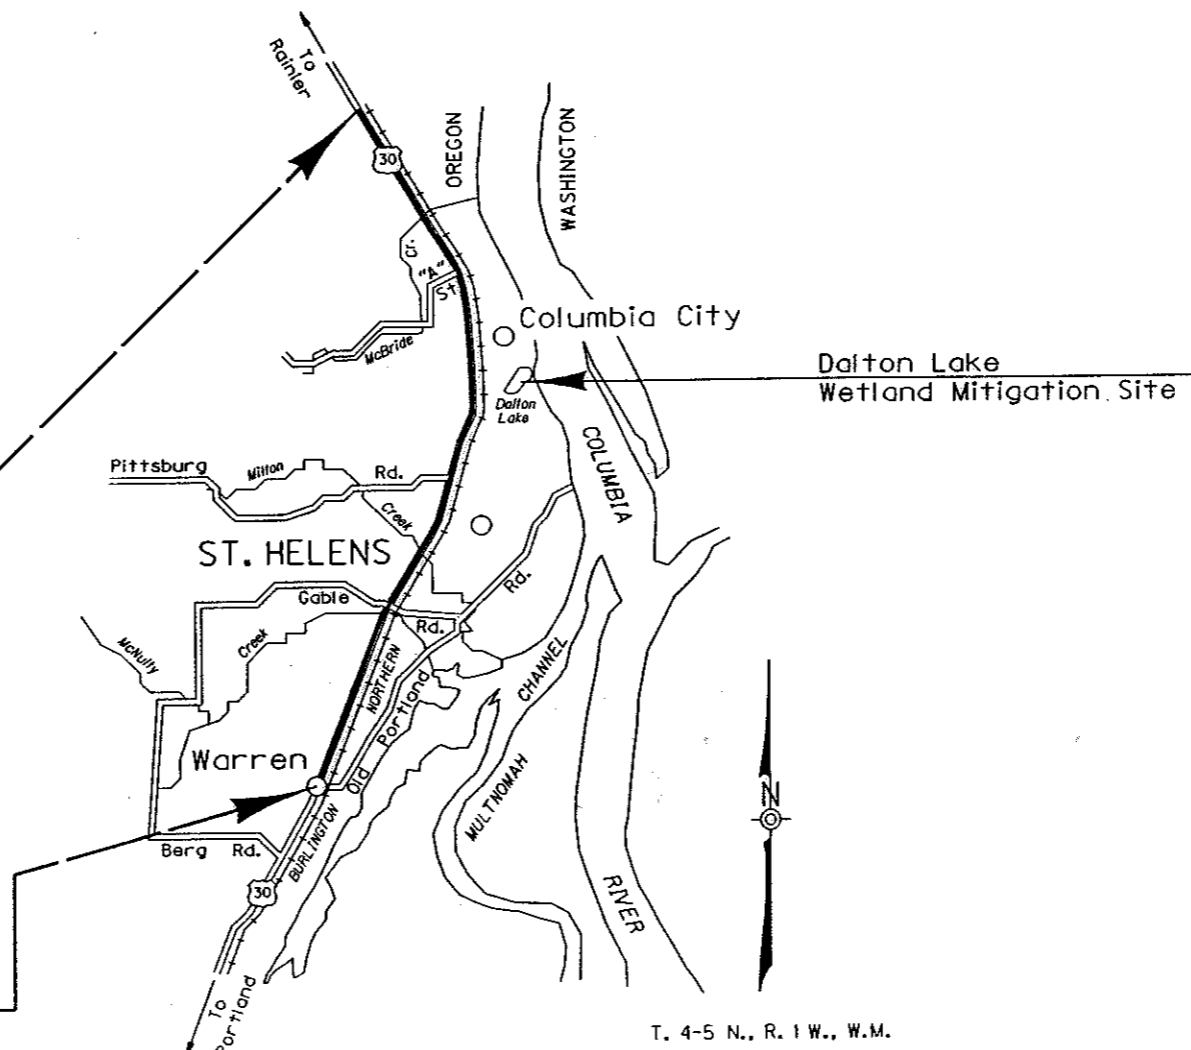

T. 4-5 N., R. 1 W., W.M.


27-NOV-1995 10:48

/usr/fd/0099/cstis1

BIO-FILTER SWALE


Bio-Filter Swale Table

Station From	Station To	Left Or Right	Slope A	Slope B	Bottom Width (Ft)	Depth (Ft)	Length (Ft)	Channel Slope (%)
573+00	575+50	Rt	6:1	4:1	4	1	250	1.83
610+50	613+50	Rt	6:1	4:1	4	1	300	1.10
615+20	618+20	Rt	6:1	1 1/2:1	4	1	300	0.57
719+70	720+90	Rt	6:1	4:1	4	1	120	1.57
720+90	722+60	Rt	6:1	4:1	4	1	170	1.33
797+90	800+08	Lt	3:1	2:1	4	1	218	0.83
839+45	-	Lt	2:1	2:1	10	1	160	3.12
856+70	860+75	Lt	4:1	4:1	4	1	405	0.75-2.0
897+37	-	Lt	3:1	3:1	6	1	290	1.20
898+50	900+75	Rt	4:1	1 1/2:1	4	1	225	0.98

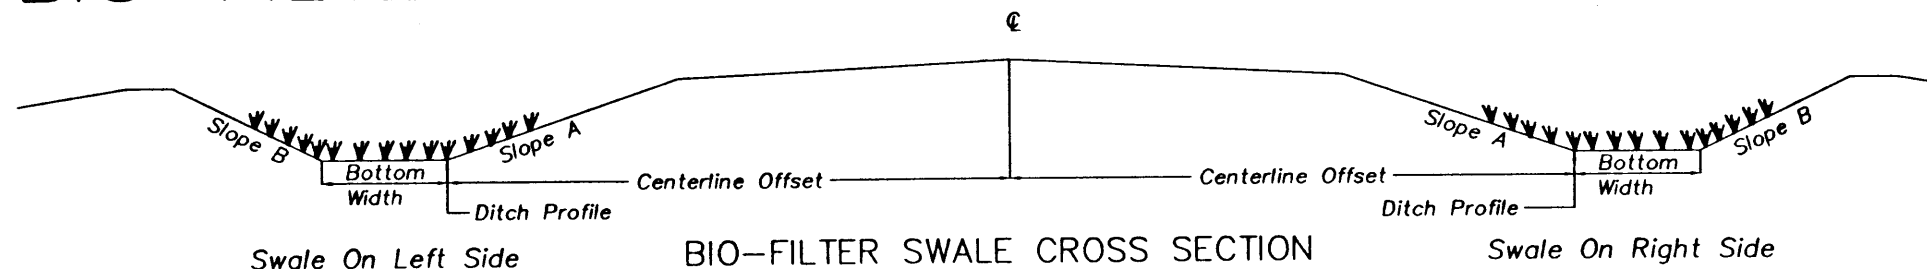


BIO-FILTER SWALE CROSS SECTION


(See Bio-Filter Swale Table For Data)

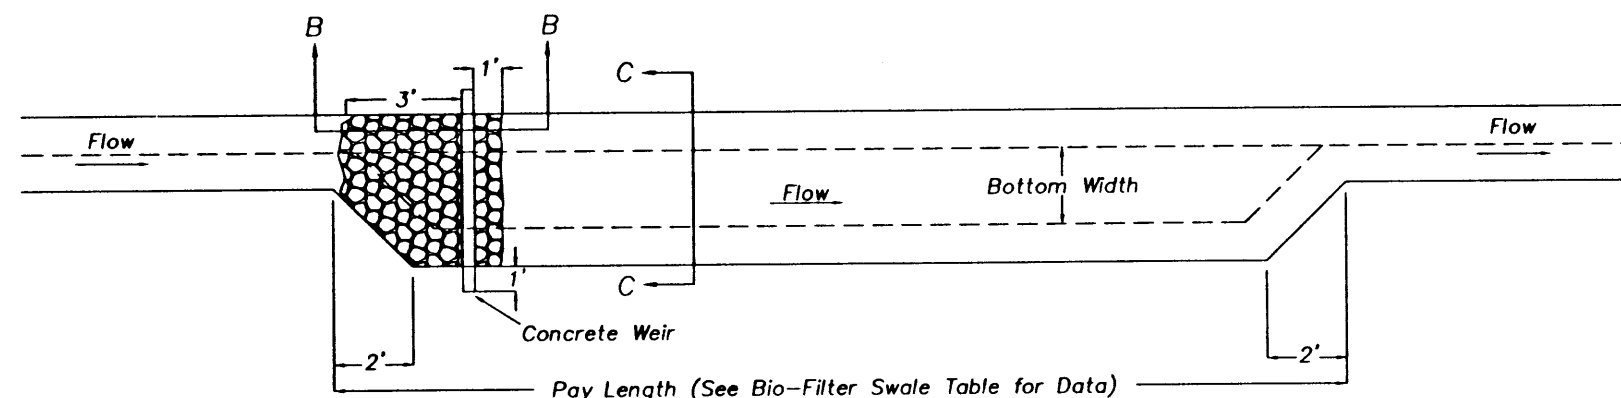


TYPICAL PLAN VIEW - BIO-FILTER SWALE

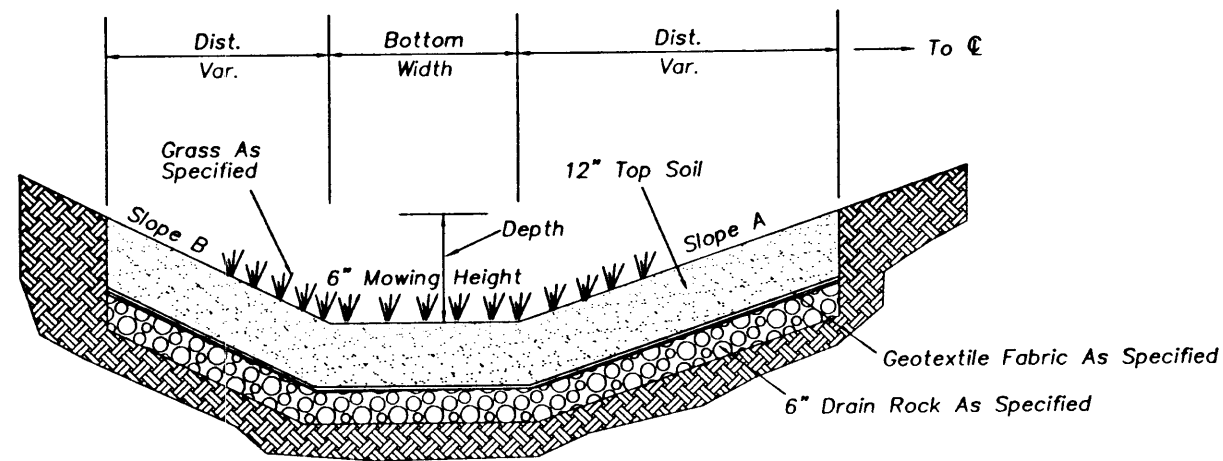

TYPICAL SECTION C-C

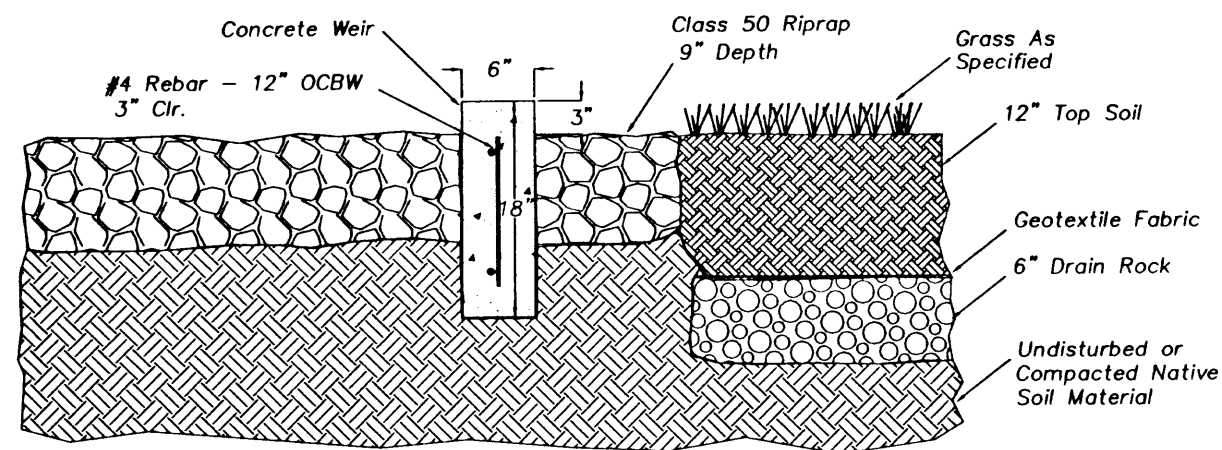

SECTION B - B

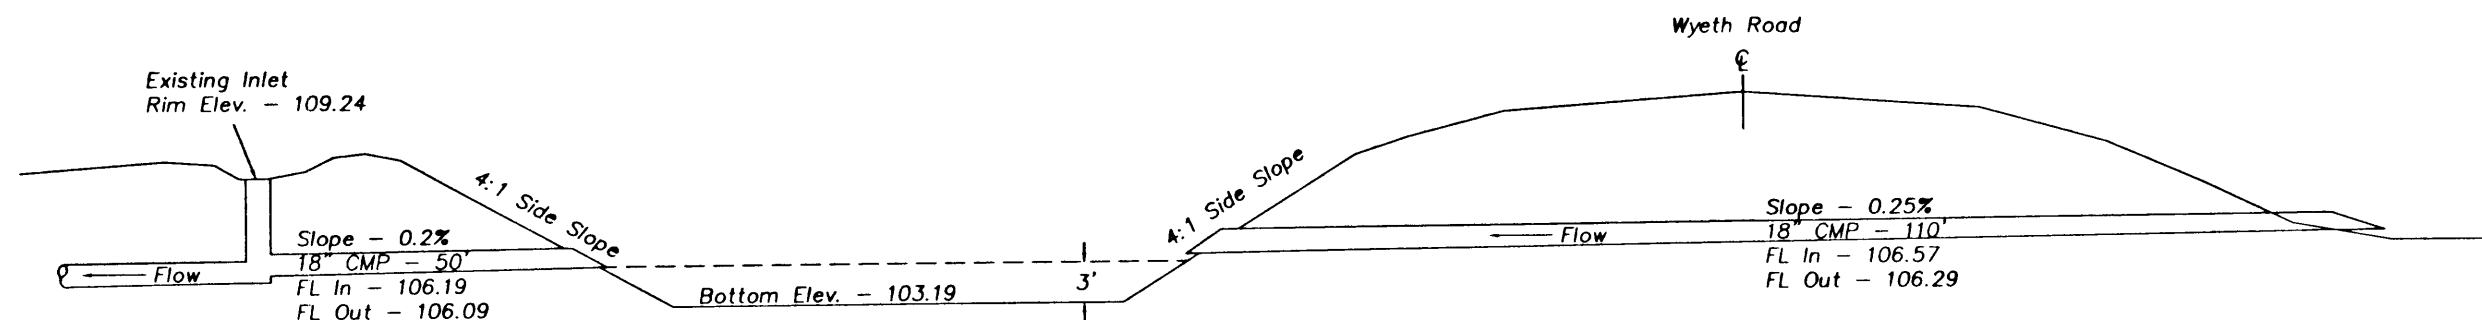

WYETH POND - SECTION A-A (FOR LOCATION SEE SHT 21)



COLUMBIA CITY N.C.L. - WARREN SEC. COLUMBIA RIVER HIGHWAY (LOWER) COLUMBIA COUNTY		
FEDERAL HIGHWAY ADMINISTRATION	PROJECT NUMBER	SHEET NO.
REGION 10	OREGON DIVISION	2B-17

2B-17.DWG 05-OCT-1995 MOM

Sec. 21, T. 5N., R. 1W., W.M.

REVISED AS CONSTRUCTED
10/98 CONTRACT 11695


- ① Sta. 576+40
Inst. 18" Culv. Pipe - 80'
Const. Paved End Slope, Lt. And Rt.
Under Pavement - 35'
Const. Loose Riprap (Class 100) - 10 C.Y.
Tr. Exc. - 40 C.Y.
- ② Extg. R.R. Xing Signals
- ③ Sta. 573+00 To Sta. 575+50, Rt.
Const. Swale - 385 S.Y.
Dt. Exc. - 195 C.Y.
(For Details, See Sheet 2B-17)
- ④ Sta. 574+00 To Sta. 580+50, Rt.
Const. Guard Rail - 575' (Type 2A)
Flare Rate 15:1 W=8.1 E=2
Inst. SRT-100 End Terminal - 2
- ⑤ Sta. 569+20 To Sta. 575+50
Lower Tel. Conduit - 630'
(For Profile, See Sheet 7B)
(For Details, See Sheet 2B-26)
- ⑦ See Sht. 6, Note 4

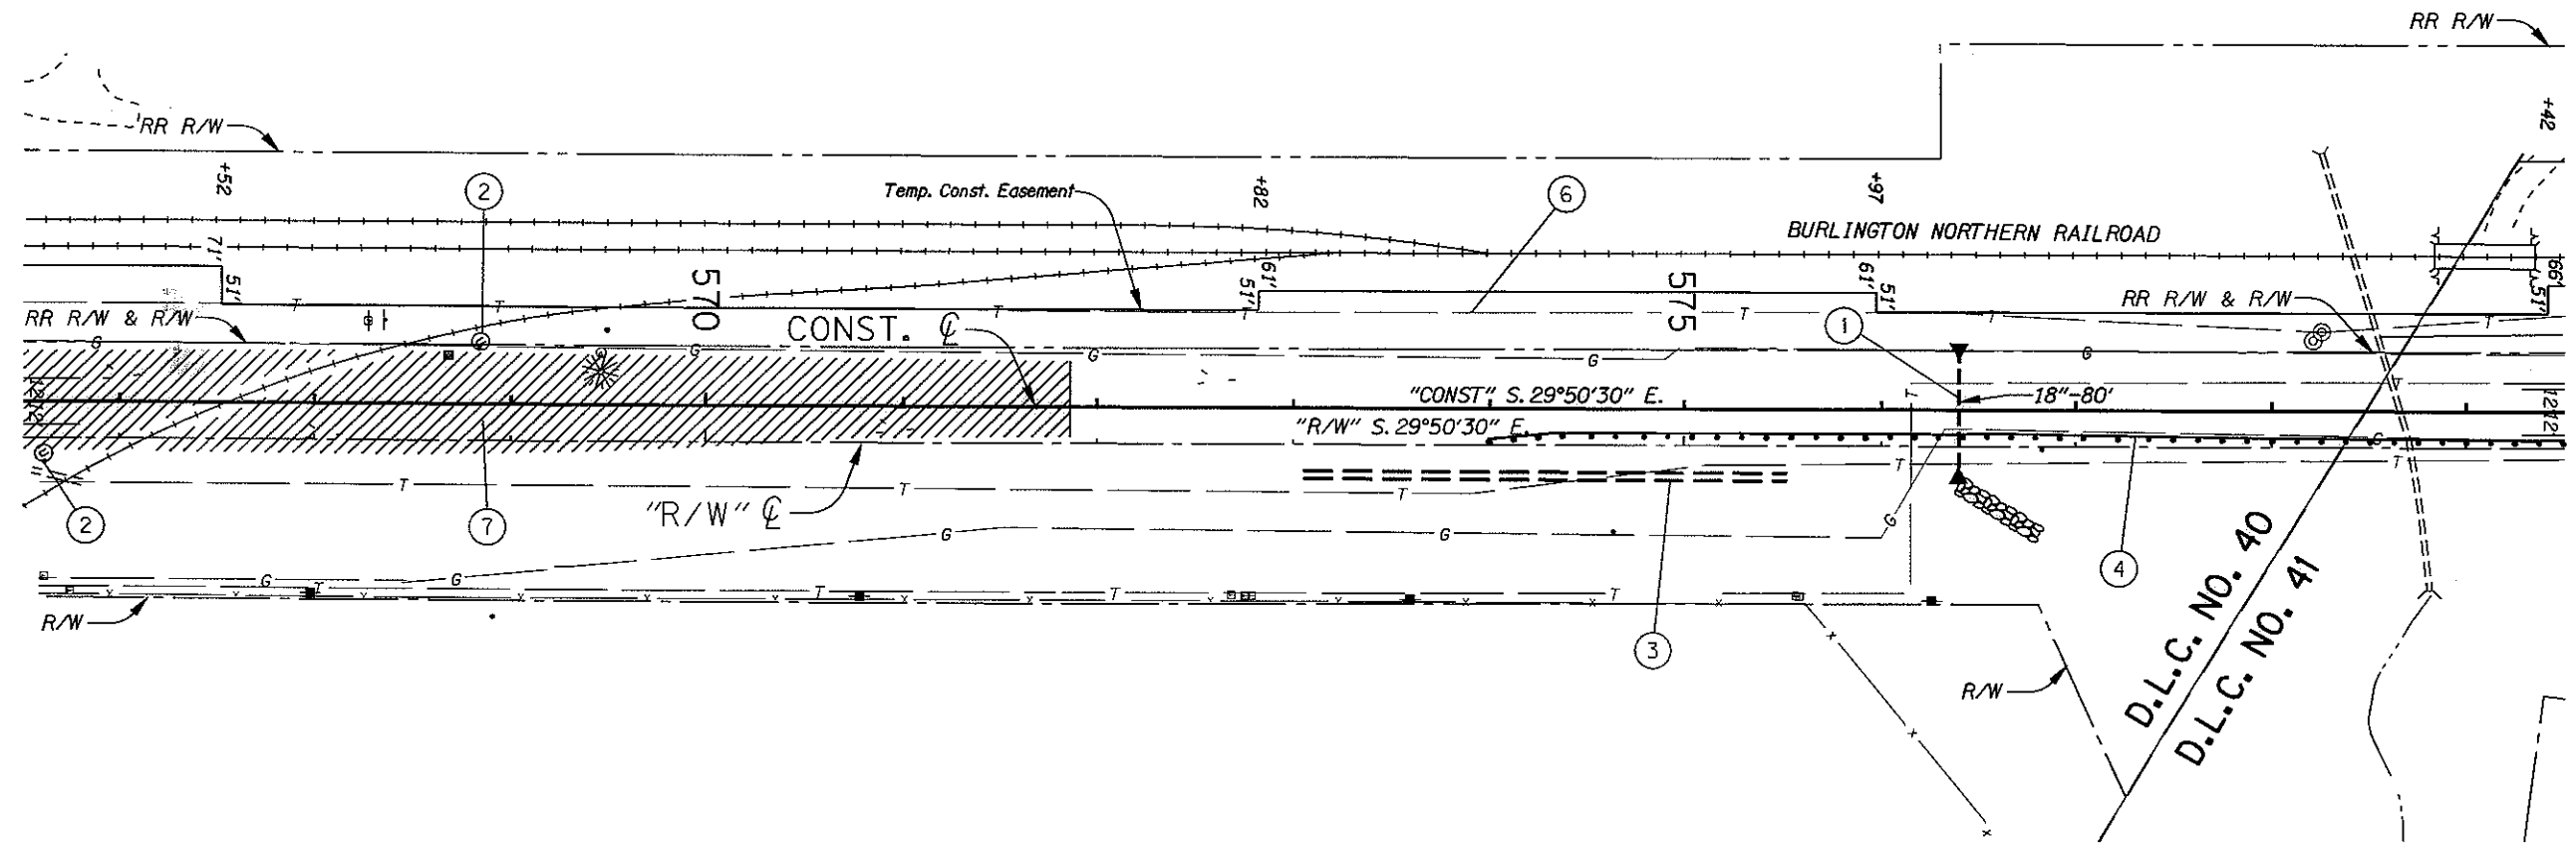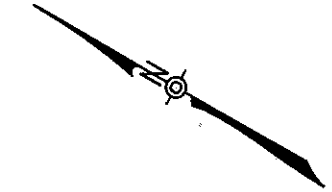

12-OCT-1995 T.J

07_PLAN.DGN

COLUMBIA CITY N.C.L. - WARREN SEC.		
COLUMBIA RIVER HIGHWAY (LOWER)		
COLUMBIA COUNTY		
FEDERAL HIGHWAY ADMINISTRATION	PROJECT NUMBER	SHEET NO.
REGION 10	OREGON DIVISION	7

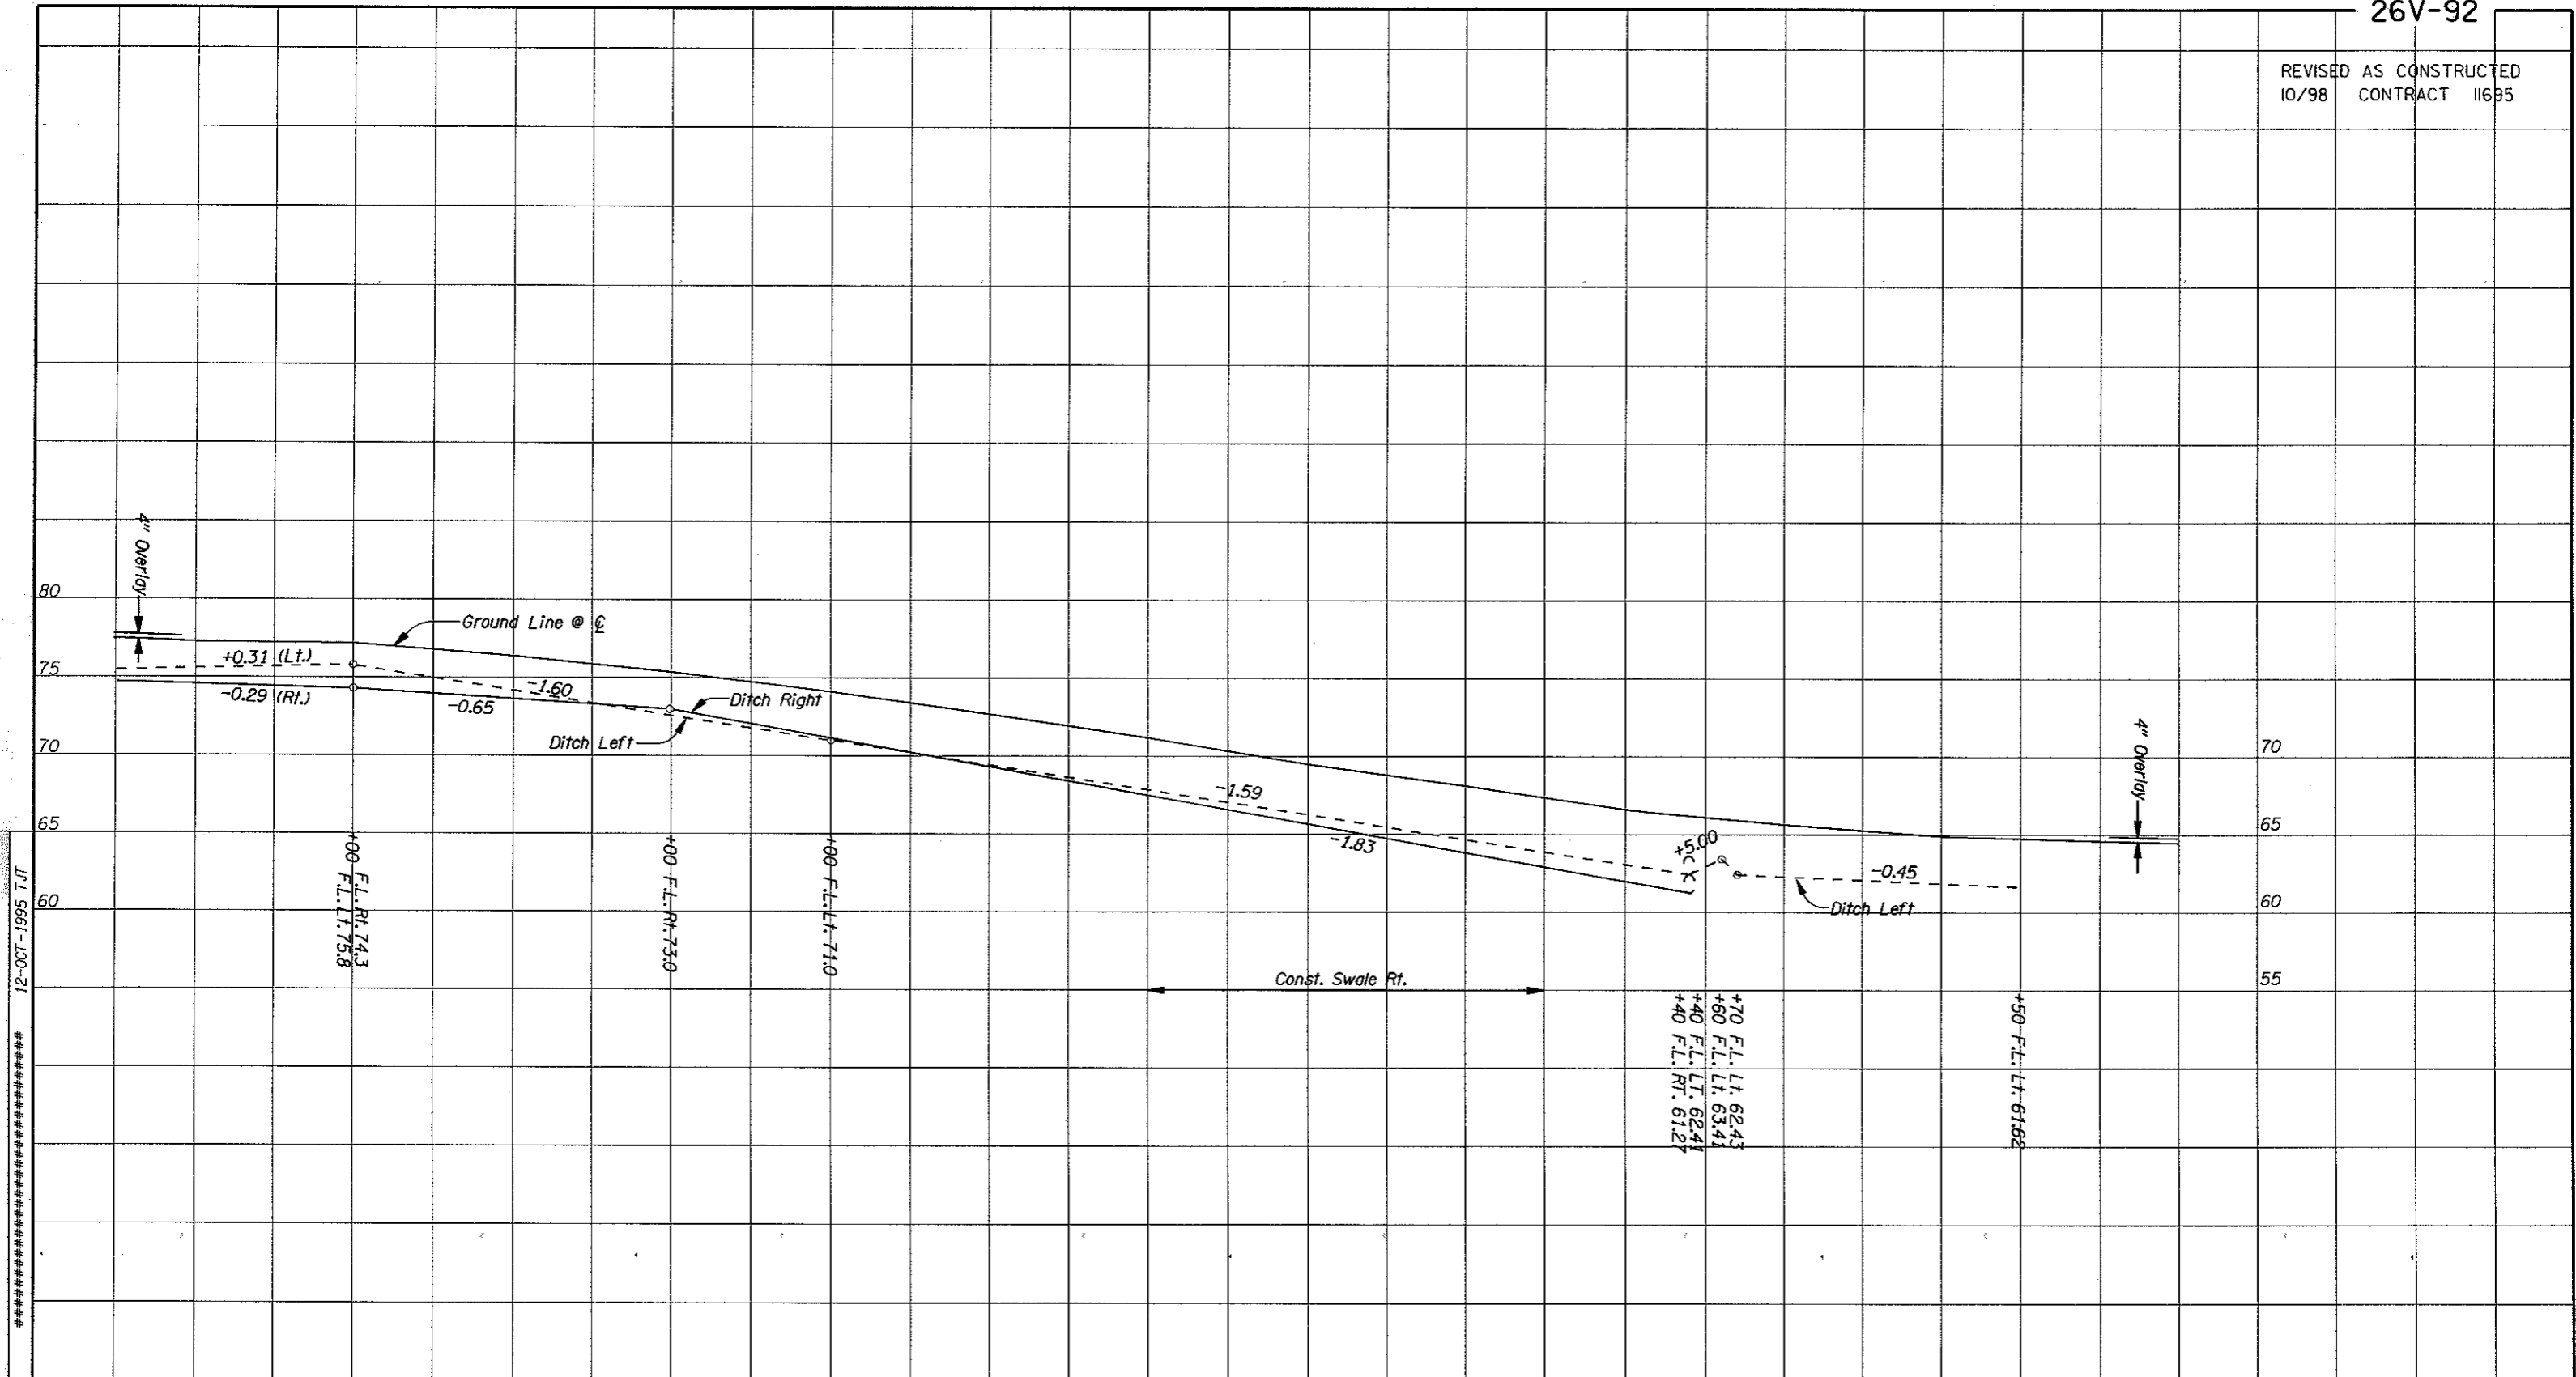

12-OCT-1995 T.JT
#####

STAGE I	Emb. 30	Exc. 660	(Right Side)
STAGE II	570	Exc. 3,540	(Left Side)
		Emb. 260	575


COLUMBIA CITY N.C.L. - WARREN SEC.
COLUMBIA RIVER HIGHWAY (LOWER)
COLUMBIA COUNTY

FEDERAL HIGHWAY ADMINISTRATION	PROJECT NUMBER	SHEET NO.
REGION 10	OREGON DIVISION	7A

M C I / A T & T C O N D U I T

REVISED AS CONSTRUCTED
10/98 CONTRACT 11695

- ① Approx. Elevation Of Extg. MCI Conduit
- ② Top Of Relocated MCI/AT&T Conduit

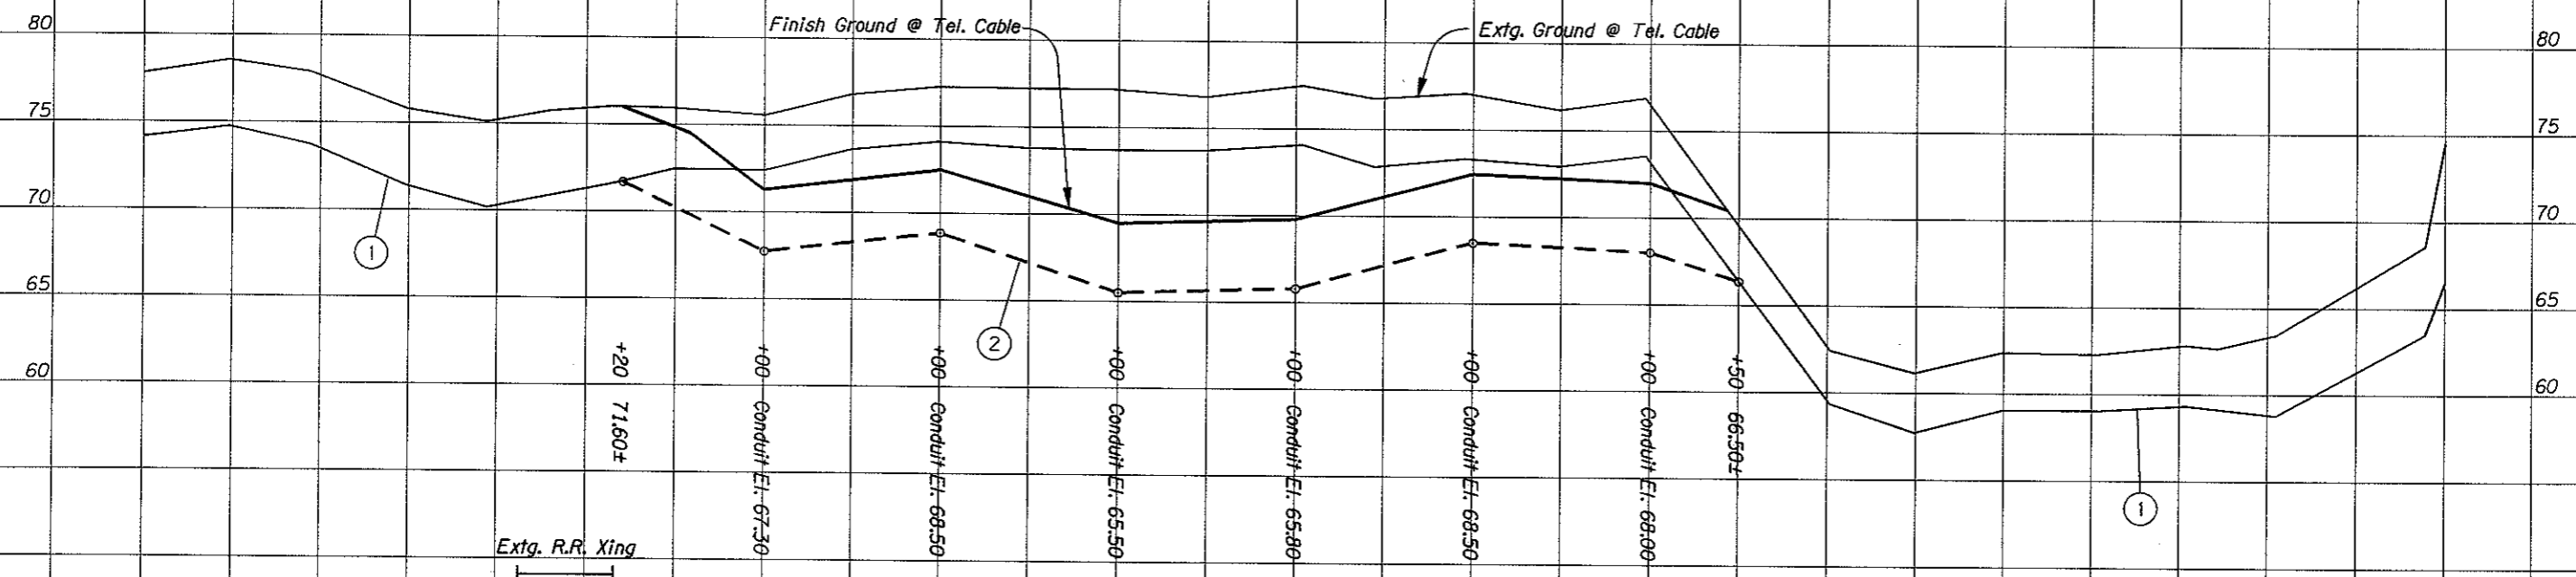

15-SEP-1995 T.JT

07B_PRO.DGN

COLUMBIA CITY N.C.L. - WARREN SEC.
COLUMBIA RIVER HIGHWAY (LOWER)
COLUMBIA COUNTY

FEDERAL HIGHWAY ADMINISTRATION		PROJECT NUMBER	SHEET NO.
REGION 10	OREGON DIVISION		7B

570

575