

# OPERATION & MAINTENANCE MANUAL

**DFI No. : D00180**

**Facility Type: Water Quality Biofiltration  
Swale**



**JUNE, 2011**

**INDEX**

**1. IDENTIFICATION..... 1**

**2. FACILITY CONTACT INFORMATION..... 1**

**3. CONSTRUCTION..... 1**

**4. STORM DRAIN SYSTEM AND FACILITY OVERVIEW ..... 2**

**5. FACILITY HAZ MAT SPILL FEATURE(S)..... 4**

**6. AUXILIARY OUTLET (HIGH FLOW BYPASS)..... 4**

**7. MAINTENANCE REQUIREMENTS..... 5**

**8. WASTE MATERIAL HANDLING..... 5**

**APPENDIX A: Operational Plan and Profile Drawing(s)**

**APPENDIX B: ODOT Project Plan Sheets**

## 1. Identification

Drainage Facility ID (DFI): **D00180**

Facility Type: Water Quality Bifiltration Swale

Construction Drawings: (V-File Number) 26V-92

Location: District: 1 (Old 2A)

Highway No.: 092

Mile Post: 31.34; 31.40 (beg./end)

Description: This facility is located along the west side Hwy. 92 adjacent to the southbound travel lane where "A"-Street and Highway 92 intersect. Unobstructed access can be obtained from the right shoulder of the roadway just north of "A"-Street.

## 2. Facility Contact Information

Contact the Engineer of Record, Region Technical Center, or Geo-Environmental's Senior Hydraulics Engineer for:

- Operational clarification
- Maintenance clarification
- Repair or restoration assistance

### Engineering Contacts:

Region Technical Center Hydro Unit Manager

Or

Geo-Environmental Senior Hydraulics Engineer (503) 986-3365.

## 3. Construction

Engineer of Record:

Consultant Designer - W&H Pacific, William Evans,  
P.E., (503) 362-4675

Facility construction: 1996

Contractor: N/A

#### 4. Storm Drain System and Facility Overview

A water quality swale is a flat-bottomed open channel designed to treat stormwater runoff from highway pavement areas. This type of facility is lined with grass. Treatment by trapping sedimentation occurs when stormwater runoff flows through the grass.

This water quality biofiltration swale is located along the west side Columbia River Highway (Hwy092) adjacent to the southbound travel lane where "A"-Street and Hwy. 92 intersect. Unobstructed access can be obtained from the right shoulder of the roadway just north of "A"-Street. The swale is approximately 300 feet in length and constructed as part of an existing roadside ditch. Flows from both the roadway and ditch enter the swale from the north, overtopping riprap and a small 6-inch by 3-inch concrete knee wall flow spreader represented by points A and C, respectively, on the Operational Plan; Appendix A.

As the water flows south it is treated while it slows and spreads out within the swale before entering a manhole with a grated-cover, serving as the facility outlet. This manhole ties two different pipes together. One of the pipes is a 24-inch culvert, conveying stormwater from a swale (D00181) located on the south side of "A"-Street. The manhole connects this pipe to the second 24-inch pipe that conveys water from both swales eastward, crossing beneath Hwy. 92, to an outfall at the Columbia River.

##### A. Maintenance equipment access:

There are no gates that surround the facility, so access is very easy. All they will have to do is pull over on the side of the road.

##### B. Heavy equipment access into facility:

- Allowed (no limitations)
- Allowed (with limitations)
- Not allowed

##### C. Special Features:

- Amended Soils
- Porous Pavers
- Liners
- Underdrains



Photo 1: A view of the riprap and small 6" x 3" concrete knee wall flow spreader.



Photo 2: Looking south toward Hwy. 92 and D00181 Swale beyond "A" Street.



Photo 3: Looking south toward "A"-Street and the facility outlet.

## 5. Facility Haz Mat Spill Feature(s)

The water quality biofiltration swale can be used to store a volume of liquid by blocking the 24 inch-diameter outlet pipe located at the manhole of the water quality biofiltration swale. This pipe is noted as point B.

## 6. Auxiliary Outlet (High Flow Bypass)

Auxiliary Outlets are provided if the primary outlet control structure can not safely pass the projected high flows. Broad-crested spillway weirs and over flow risers are the two most common auxiliary outlets used in stormwater treatment facility design. The auxiliary outlet feature is either a part of the facility or an additional storm drain feature/structure.

The auxiliary outlet feature for this facility is:

Designed into facility

Other, as noted below

There are no auxiliary outlet features for this facility.

## 7. Maintenance Requirements

Routine maintenance table for non-proprietary stormwater treatment and storage/detention facilities have been incorporated into ODOT's Maintenance Guide. These tables summarize the maintenance requirements for ponds, swales, filter strips, bioslopes, and detention tanks and vaults. Special maintenance requirements in addition to the routine requirements are noted below when applicable.

The ODOT Maintenance Guide can be viewed at the following website:

<http://www.oregon.gov/ODOT/HWY/OOM/MGuide.shtml>

Maintenance requirements for proprietary structures, such as underground water quality manholes and/or vaults with filter media are noted in Appendix C when applicable.

The following stormwater facility maintenance table (See ODOT Maintenance Guide) should be used to maintain the facility outlined in this Operation and Maintenance Manual or follow the Maintenance requirements outlined in Appendix C when proprietary structure is selected below:

- Table 1 (general maintenance)
- Table 2 (stormwater ponds)
- Table 3 (water quality biofiltration swales)
- Table 4 (water quality filter strips)
- Table 5 (water quality bioslopes)
- Table 6 (detention tank)
- Table 7 (detention vault)
- Appendix C (proprietary structure)
- Special Maintenance requirements:

Note: Special maintenance Requirements Require Concurrence from ODOT SR Hydraulics Engineer.

## 8. Waste Material Handling

Material removed from the facility is defined as waste by DEQ. Refer to the roadwaste section of the ODOT Maintenance Yard Environmental Management System (EMS) Policy and Procedures Manual for disposal options: <http://egov.oregon.gov/ODOT/HWY/OOM/EMS.shtml>

Contact any of the following for more detailed information about management of waste materials found on site:

ODOT Clean Water Unit

(503) 986-3008


ODOT Statewide Hazmat Coordinator (503) 229-5129  
ODOT Region Hazmat Coordinator (503) 731-8304  
ODEQ Northwest Region Office (503) 229-5263




# Appendix A

## Content:


- **Operational Plan and Profile Drawing(s)**

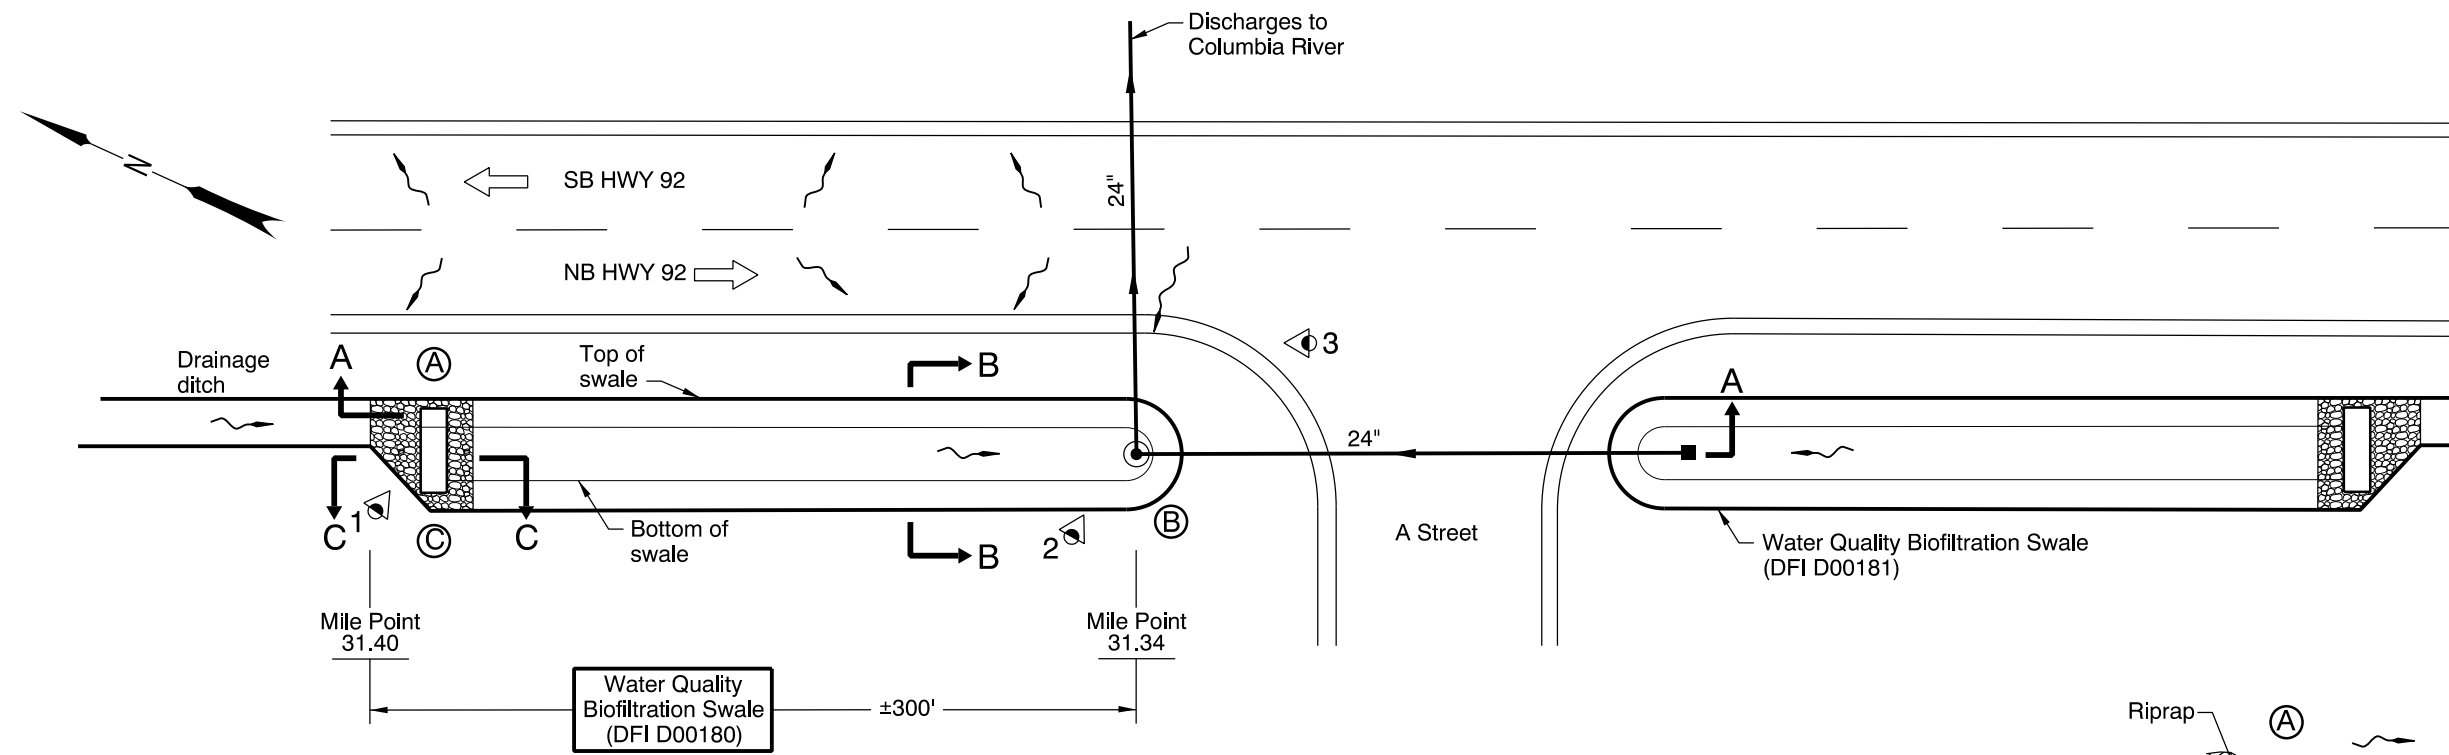


**PLAN**  
N.T.S.

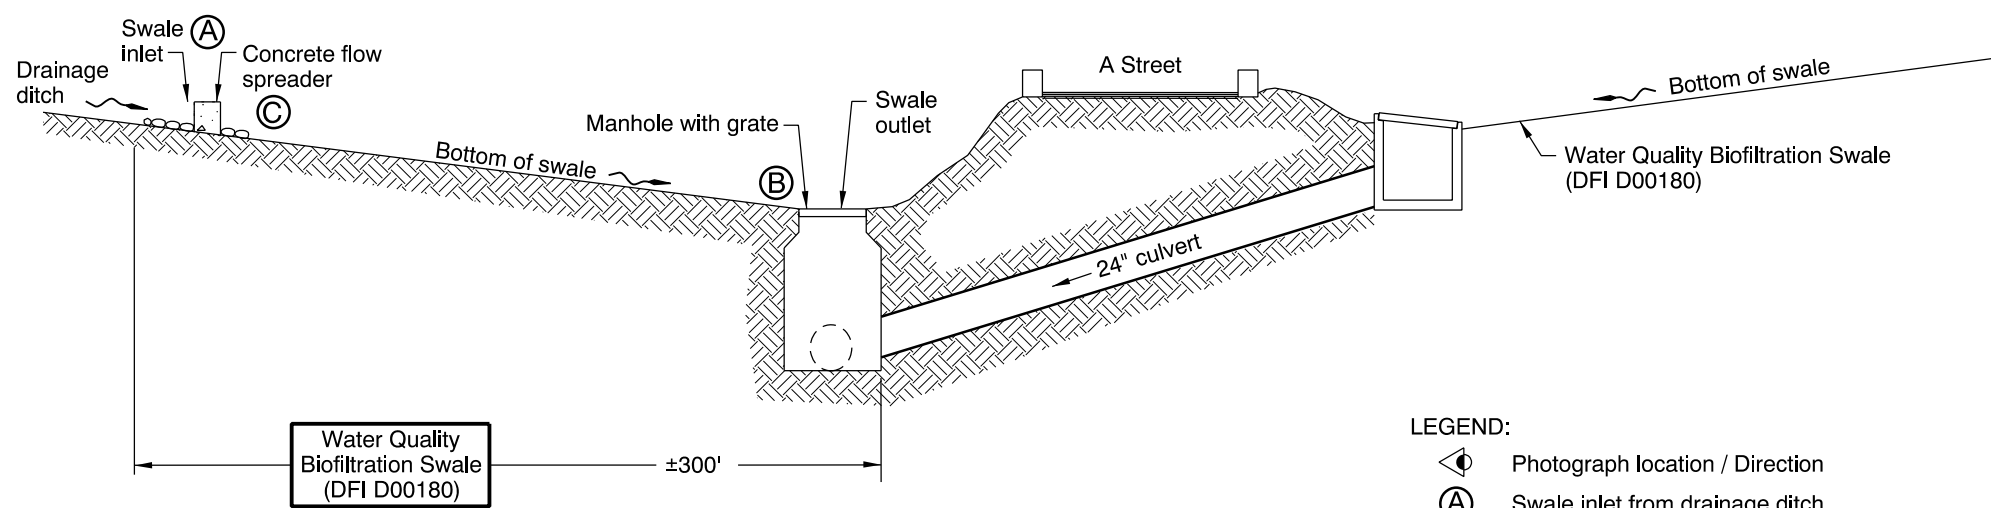

**SECTION A-A**  
N.T.S.

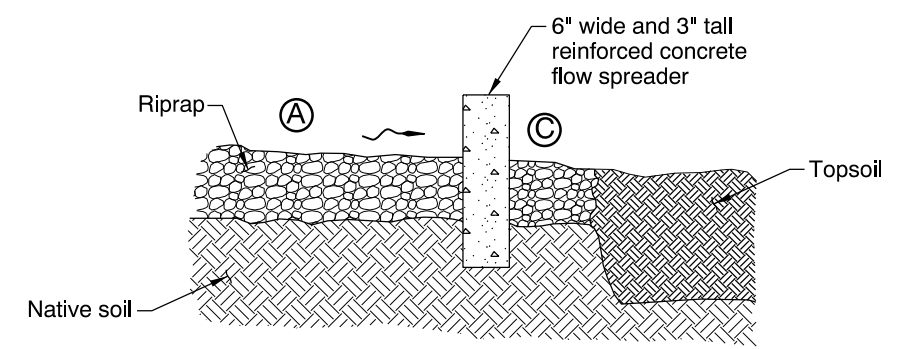

**SECTION C-C**  
N.T.S.

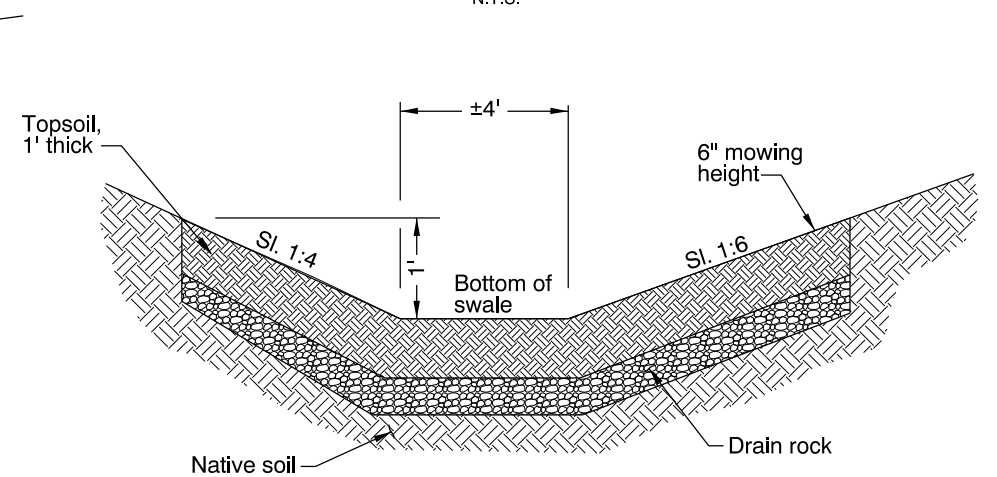

**SECTION B-B**  
N.T.S.

- LEGEND:**
- Photograph location / Direction
  - Swale inlet from drainage ditch
  - Swale outlet, manhole with grate
  - Riprap and flow spreader at inlet
  - Manhole
  - Inlet
  - Storm Pipe (Facility)
  - Storm Pipe
  - Conveyance Direction
  - Pavement / Facility Flow Path
  - Traffic Flow / Direction

Sht. 1 of 1

OREGON DEPARTMENT OF TRANSPORTATION

Prepared By: J.D. Koziol

Drafted By: Rodney Schultz

**DFI D00180**  
**MAINTENANCE DISTRICT 1 HWY 92**  
**WATER QUALITY BIOFILTRATION SWALE**  
COLUMBIA HWY MP 31.34-31.40  
COLUMBIA COUNTY

# Appendix B

## Content:


- **ODOT Project Plan Sheets**
  - *Cover/Title Sheet*
  - *Water Quality/Detention Plan Sheets*
  - *Other Details*

STATE OF OREGON  
DEPARTMENT OF TRANSPORTATION

PLANS FOR PROPOSED PROJECT

REVISED AS CONSTRUCTED  
10/1998 CONTRACT C11695  
PROJ. MGR.

GRADING, STRUCTURES, PAVING, SIGNING, SIGNALS, & LANDSCAPING  
**COLUMBIA CITY N.C.L. - WARREN SEC.**  
**COLUMBIA RIVER HIGHWAY (LOWER)**  
COLUMBIA COUNTY  
JANUARY 1996

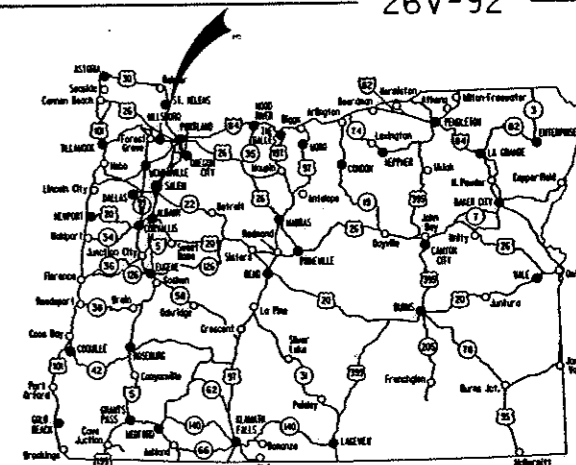

Overall Length Of Project - 7.25 Miles

INDEX OF SHEETS table with columns SHEET NO. and DESCRIPTION, listing sheets 1 through 37B and their categories like Typical Sections, Details, etc.

CONT'D. ON SHT. 1A

NH-S02W(9)


BEGINNING OF PROJECT

STA. 525 + 00 M.P. 33.02)

END OF PROJECT

NH-S02W(9)

STA. 906 + 50 M.P. 25.77)

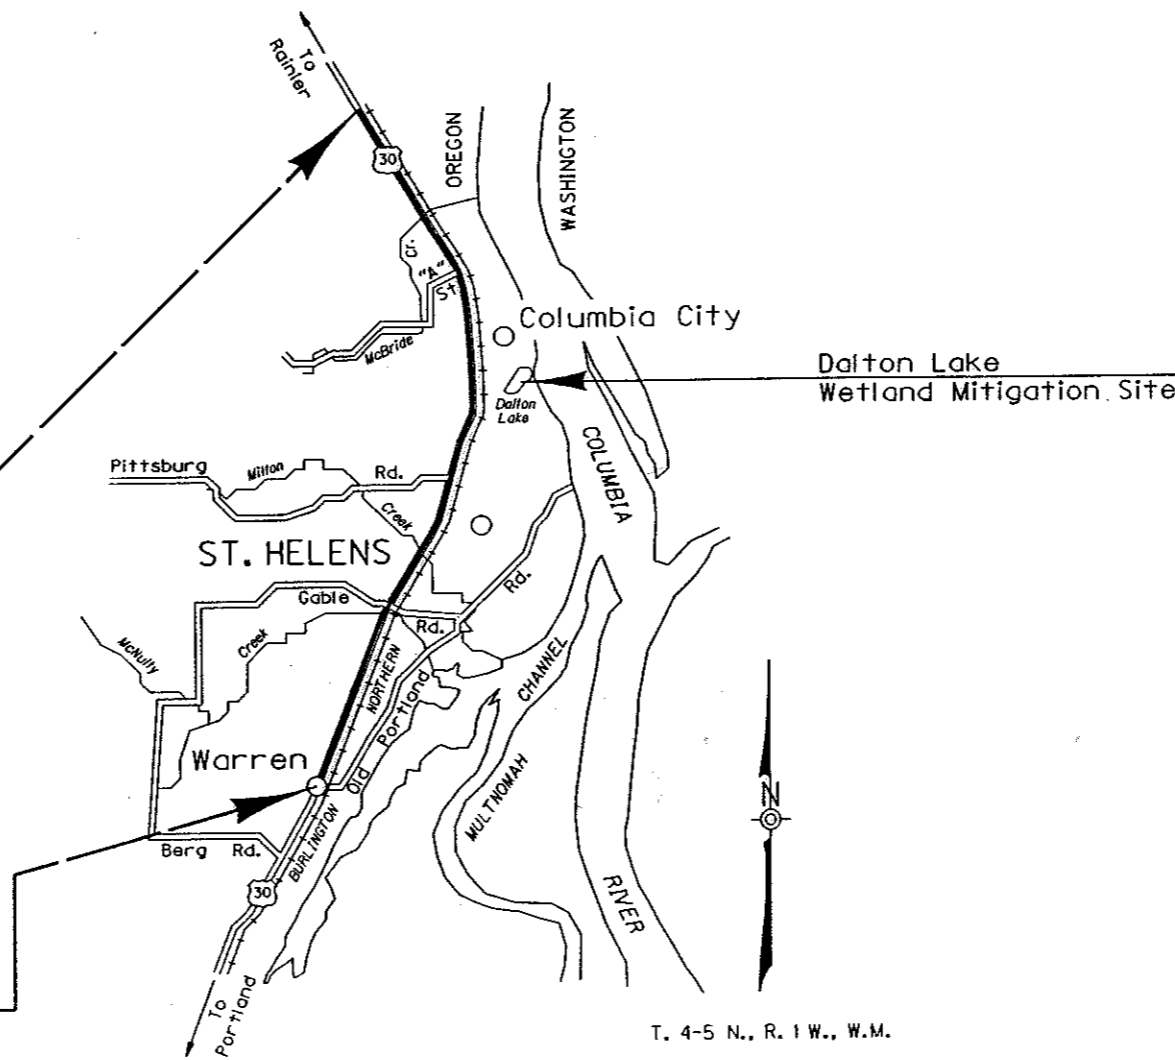

T. 4-5 N., R. 1 W., W.M.

THE TRAFFIC CONTROL YOU PROVIDE PROTECTS YOU AS WELL AS THE PUBLIC. LET'S ALL WORK TOGETHER TO MAKE THIS JOB SAFE.

OREGON TRANSPORTATION COMMISSION

- Henry H. Hewitt CHAIRMAN
Susan Brody VICE CHAIRMAN
Cynthia J. Ford COMMISSIONER
Steven H. Corey COMMISSIONER
Stuart Foster COMMISSIONER
Kenneth E. Husby INTERIM DIRECTOR OF TRANSPORTATION

PLANS PREPARED BY:



OREGON DEPARTMENT OF TRANSPORTATION CONCURRENCE

Technical Services Manager signature and date 1/30/95

COLUMBIA CITY N.C.L. - WARREN SEC.
COLUMBIA RIVER HIGHWAY (LOWER)
COLUMBIA COUNTY

Table with 3 columns: FEDERAL HIGHWAY ADMINISTRATION, PROJECT NUMBER, SHEET NO. Values: REGION 10, OREGON DIVISION, NH-S02W(9), 1






27-NOV-1995 10:48

1/29/94/0099/csl:sl

# BIO-FILTER SWALE

Bio-Filter Swale Table

Station From	Station To	Left Or Right	Slope A	Slope B	Bottom Width (Ft)	Depth (Ft)	Length (Ft)	Channel Slope (%)
573+00	575+50	Rt	6:1	4:1	4	1	250	1.83
610+50	613+50	Rt	6:1	4:1	4	1	300	1.10
615+20	618+20	Rt	6:1	1 1/2:1	4	1	300	0.57
719+70	720+90	Rt	6:1	4:1	4	1	120	1.57
720+90	722+60	Rt	6:1	4:1	4	1	170	1.33
797+90	800+08	Lt	3:1	2:1	4	1	218	0.83
839+45	-	Lt	2:1	2:1	10	1	160	3.12
856+70	860+75	Lt	4:1	4:1	4	1	405	0.75-2.0
897+37	-	Lt	3:1	3:1	6	1	290	1.20
898+50	900+75	Rt	4:1	1 1/2:1	4	1	225	0.98

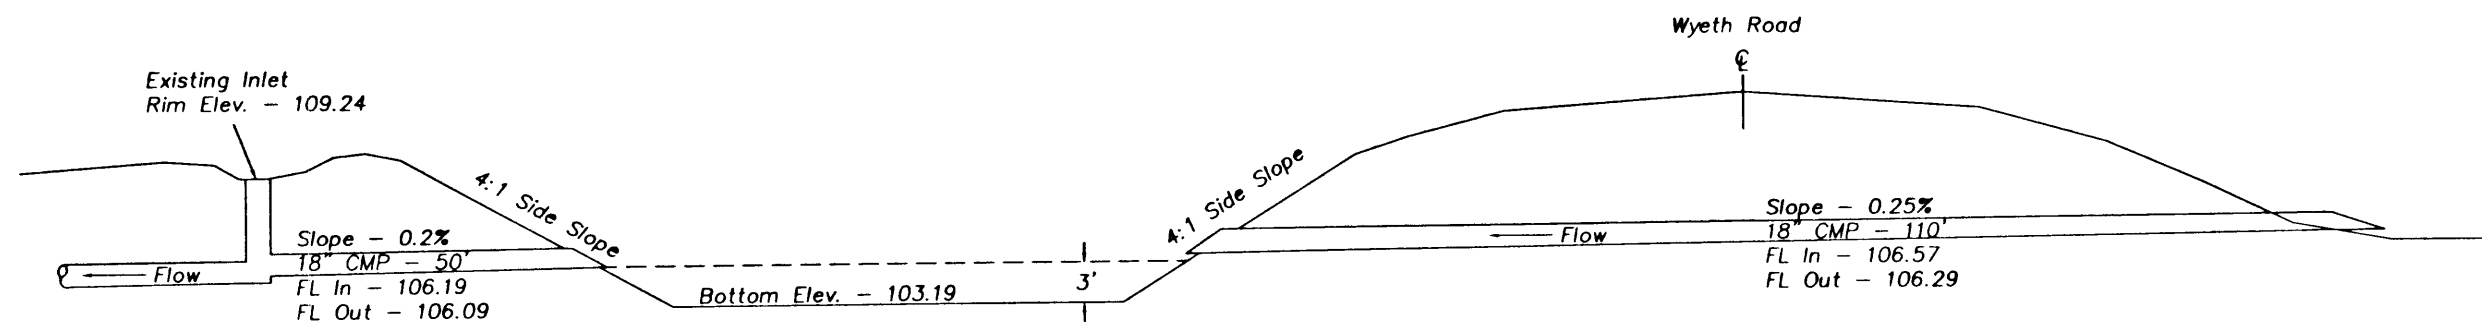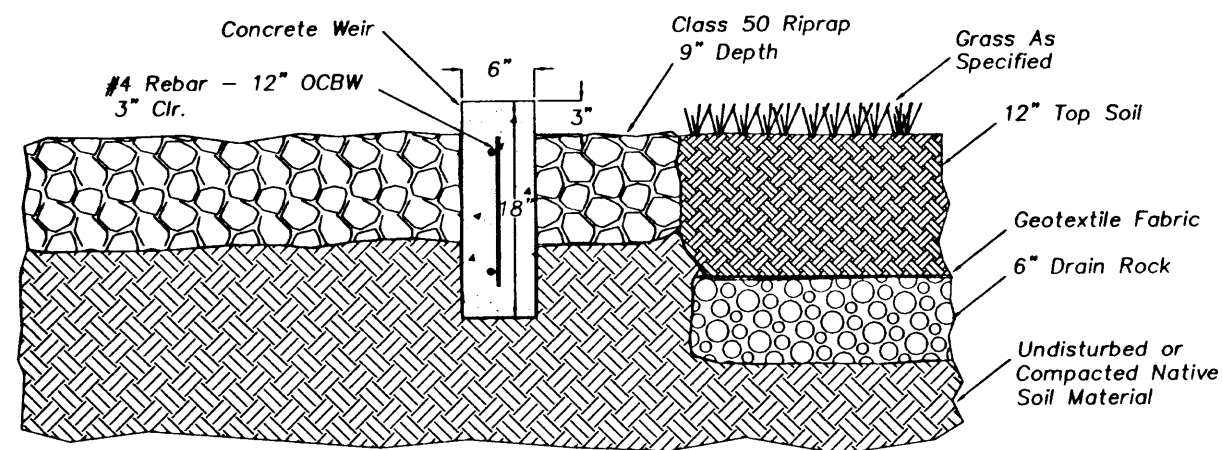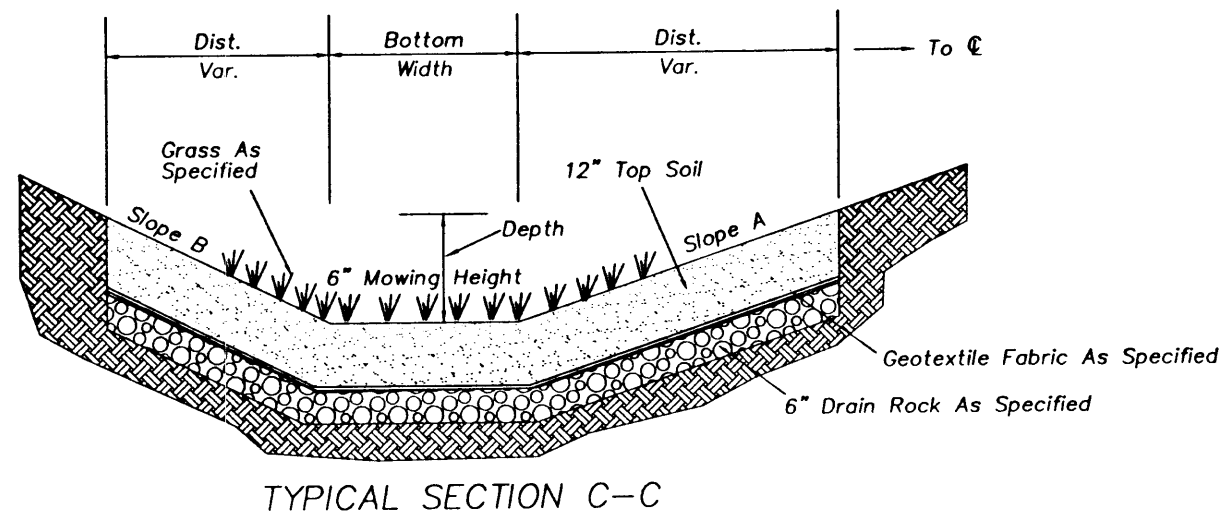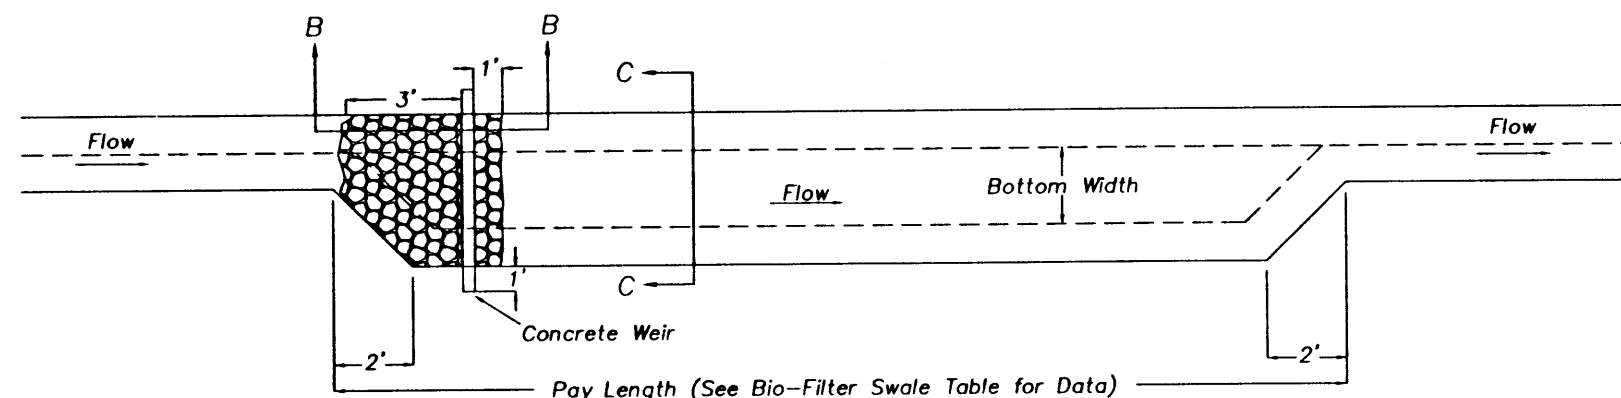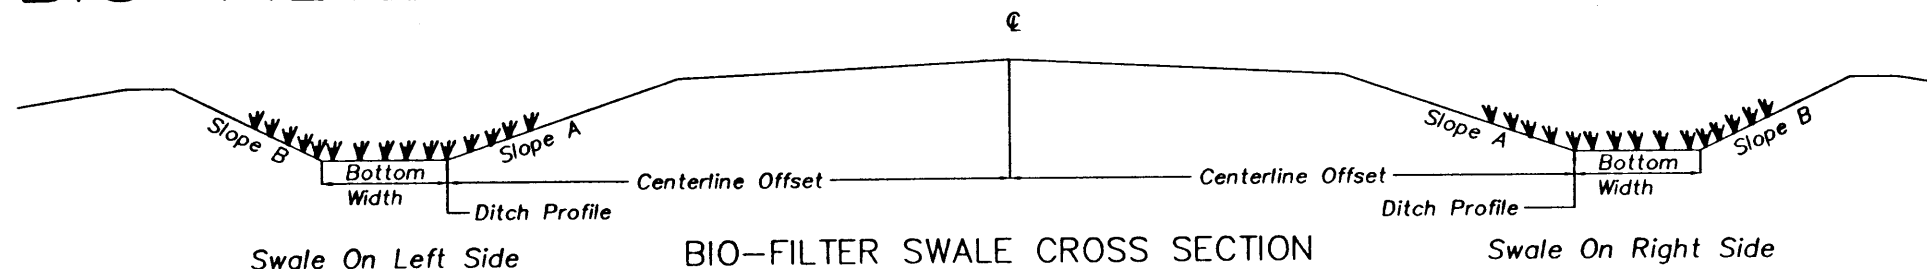


COLUMBIA CITY N.C.L. - WARREN SEC. COLUMBIA RIVER HIGHWAY (LOWER) COLUMBIA COUNTY		
FEDERAL HIGHWAY ADMINISTRATION	PROJECT NUMBER	SHEET NO.
REGION 10	OREGON DIVISION	2B-17

2B-17.DWG 05-OCT-1995 MOM

Sec. 21, T. 5N., R. 1W., W.M.


REVISED AS CONSTRUCTED  
10/98 CONTRACT 11695

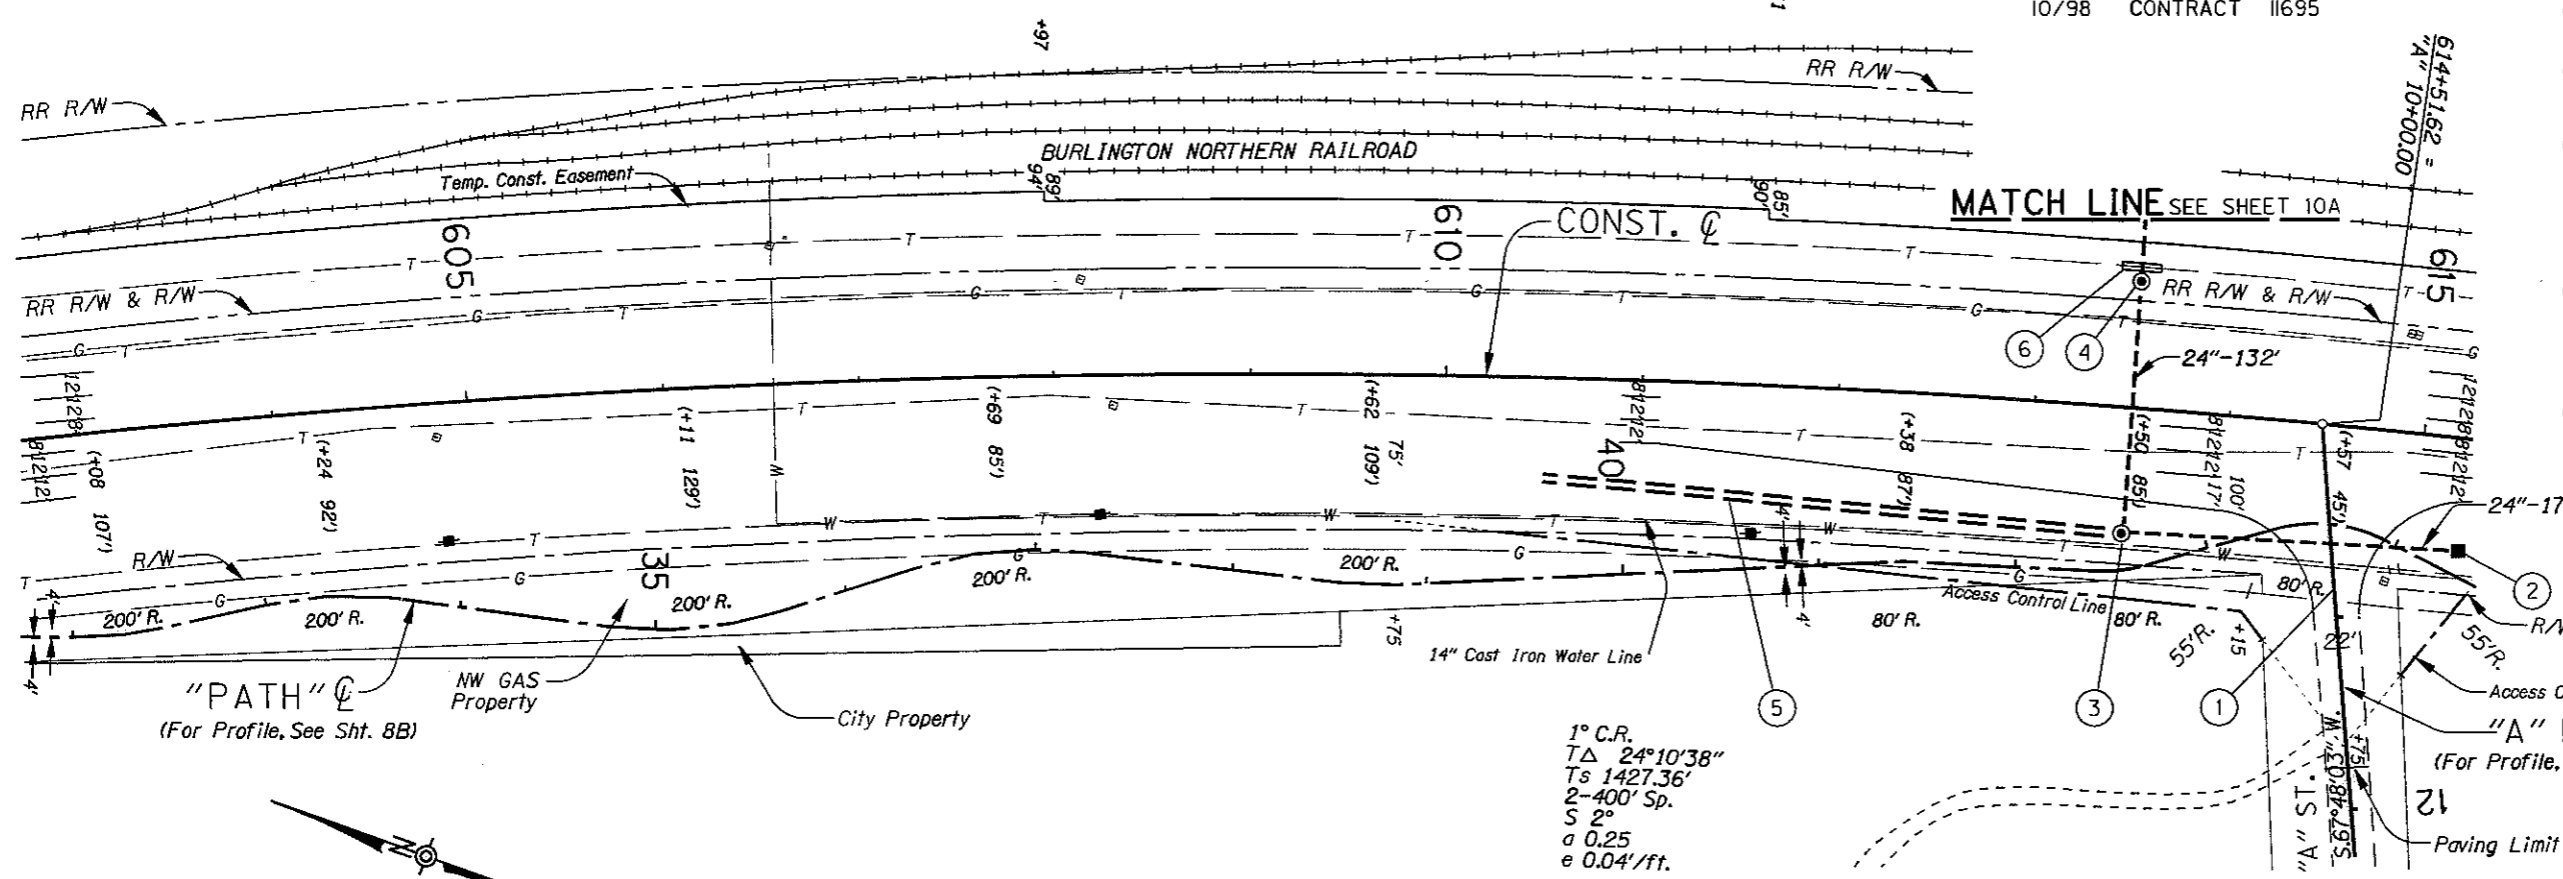

- ① Const. Road Cann.
- ② Sta. 615+20, Rt. Const. "D" Inlet
- ③ Sta. 613+50, Rt. Const. Manhole With Grate Inst. 24" Sew. Pipe - 175' Tr. Exc. - 180 C.Y. (See Drg. No. 2050)
- ④ Sta. 613+50, Lt. Const. Manhole With Grate Inst. 24" Sew. Pipe - 132' Tr. Exc. - 220 C.Y.
- ⑤ Sta. 610+50 To Sta. 613+50, Rt. Const. Swale - 465 S.Y. Dt. Exc. - 230 C.Y. (For Details, See Sheet 2B-17)
- ⑥ Sta. 613+50 Const. Canc. Cap (Type A) - 20 Lin. Ft. (For Details, See Sheet 2B-26)

1° C.R.  
TΔ 24°10'38"  
Ts 1427.36'  
2-400' Sp.  
S 2°  
a 0.25  
e 0.04'/ft.

Ped Path P.I.'s Shown Thus: (+99 111')

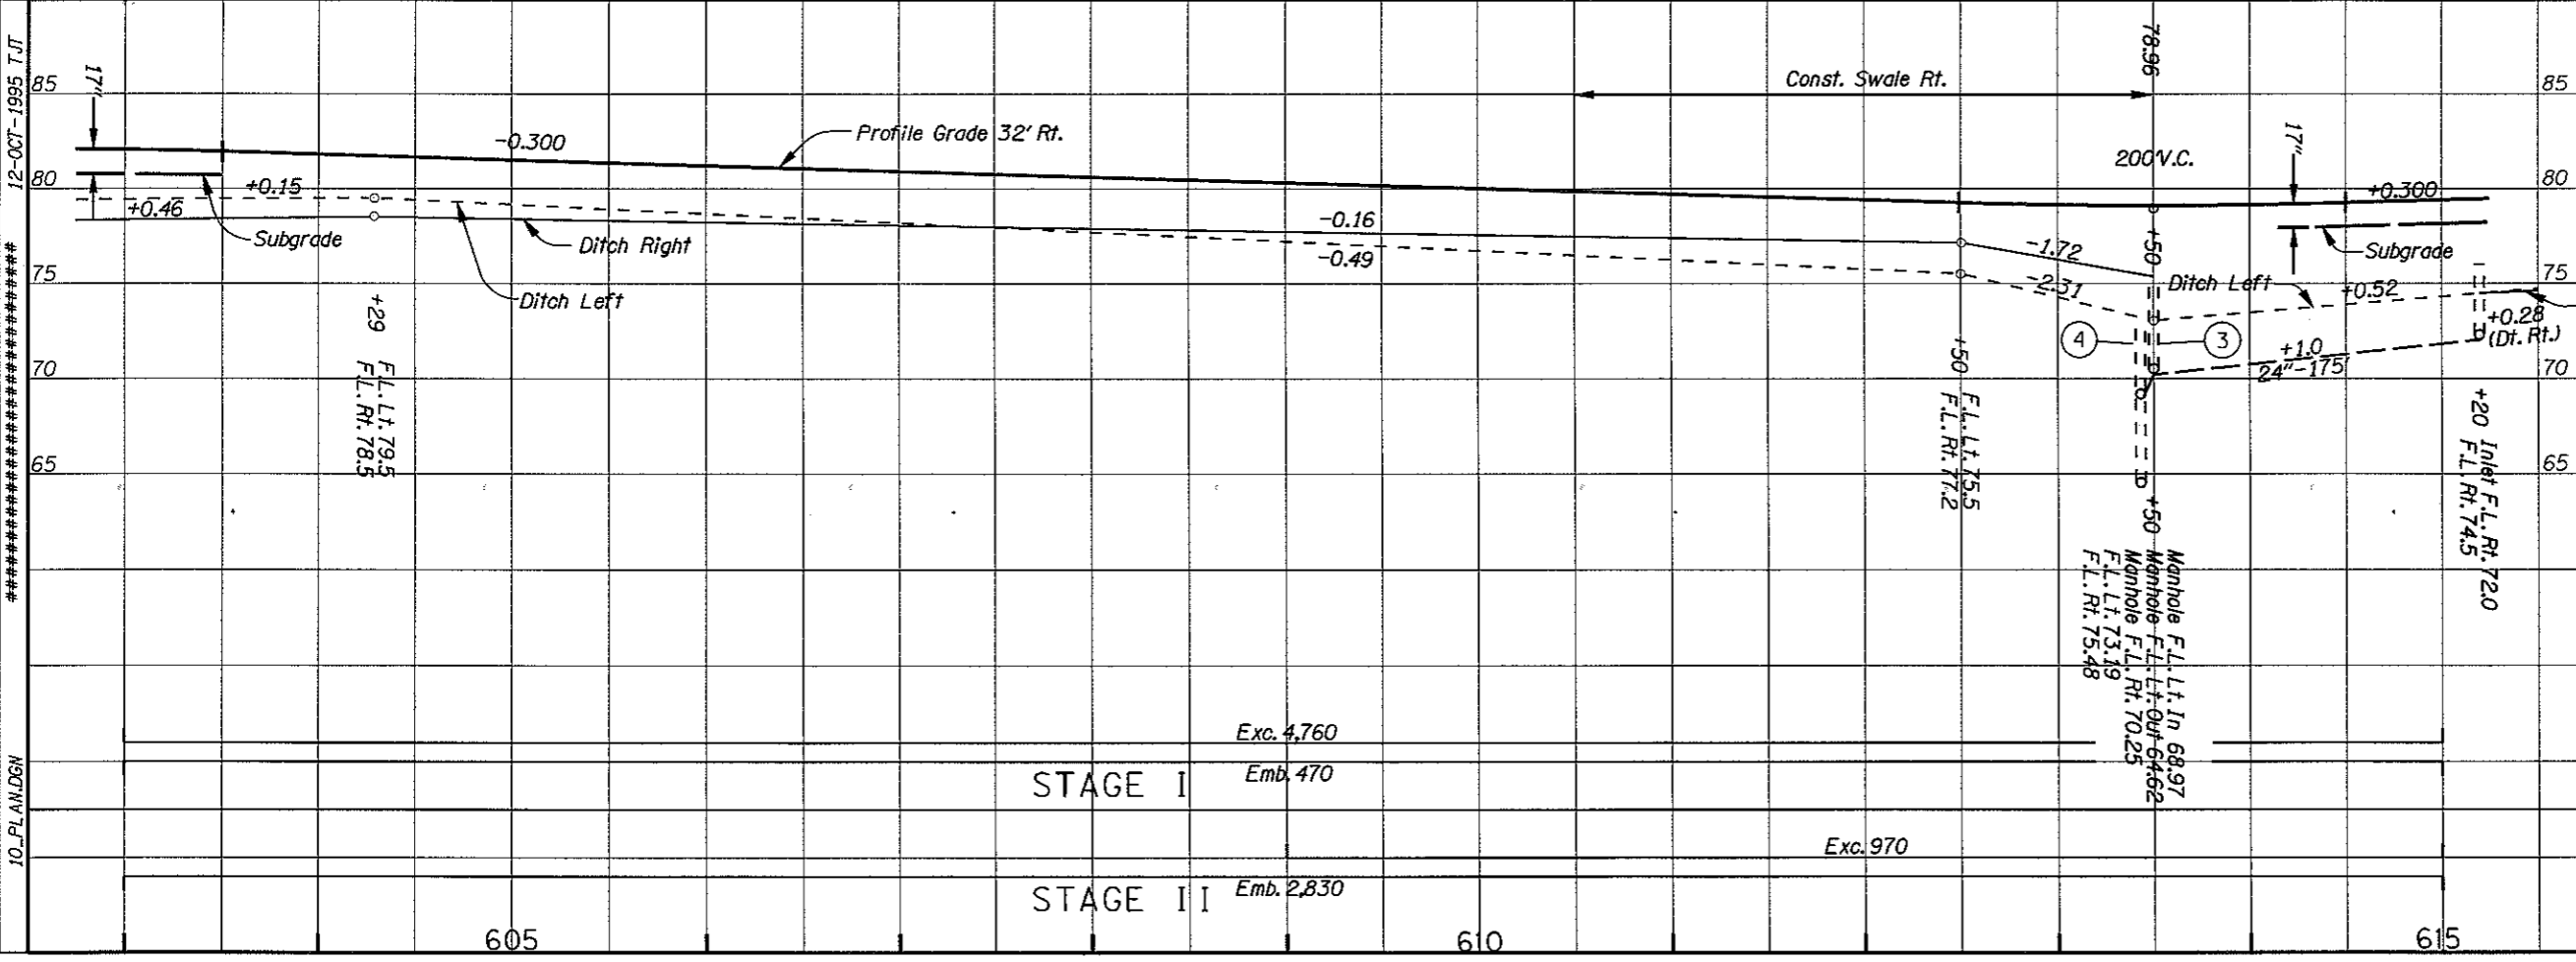

Exc. 4,760	Emb. 470
STAGE I	
Exc. 970	Emb. 2,830
STAGE II	

**COLUMBIA CITY N.C.L. - WARREN SEC.**  
COLUMBIA RIVER HIGHWAY (LOWER)  
COLUMBIA COUNTY


FEDERAL HIGHWAY ADMINISTRATION	PROJECT NUMBER	SHEET NO.
REGION 10	OREGON DIVISION	10

12-OCT-1995 T.J.T  
10\_PL\AN.DSN

Sec. 21, T. 5N., R.1W.

REVISED AS CONSTRUCTED  
10/98 CONTRACT I1695

- ② Sta. "A OUTFALL" 24+30 @  
Const. Manhole  
Inst. 24" Sew. Pipe - 365'  
Under Railroad - 148'  
Tr. Exc. - 195 C.Y.  
(For Detail, See Sheet 2B-6)
- ③ Sta. "A OUTFALL" 27+50 @  
Const. Manhole  
Inst. 24" Sew. Pipe - 320'  
Tr. Exc. - 285 C.Y.
- ④ Sta. "A OUTFALL" 28+34 @  
Const. Special Manhole  
Inst. 10" Sew. Pipe - 15'  
Inst. 18" Sew. Pipe - 100'  
Const. Loose Riprap (Class 100) - 12 C.Y.  
Const. Loose Riprap (Class 700) - 314 C.Y.  
Filter Blanket - 25 C.Y.  
Inst. Riprap Geotextile - 70 Sq.Yds.  
Tr. Exc. - 150 C.Y.  
Toe Tr. Exc. - 15 C.Y.  
(For Details, See Sheets 2B-7 & 2B-8)

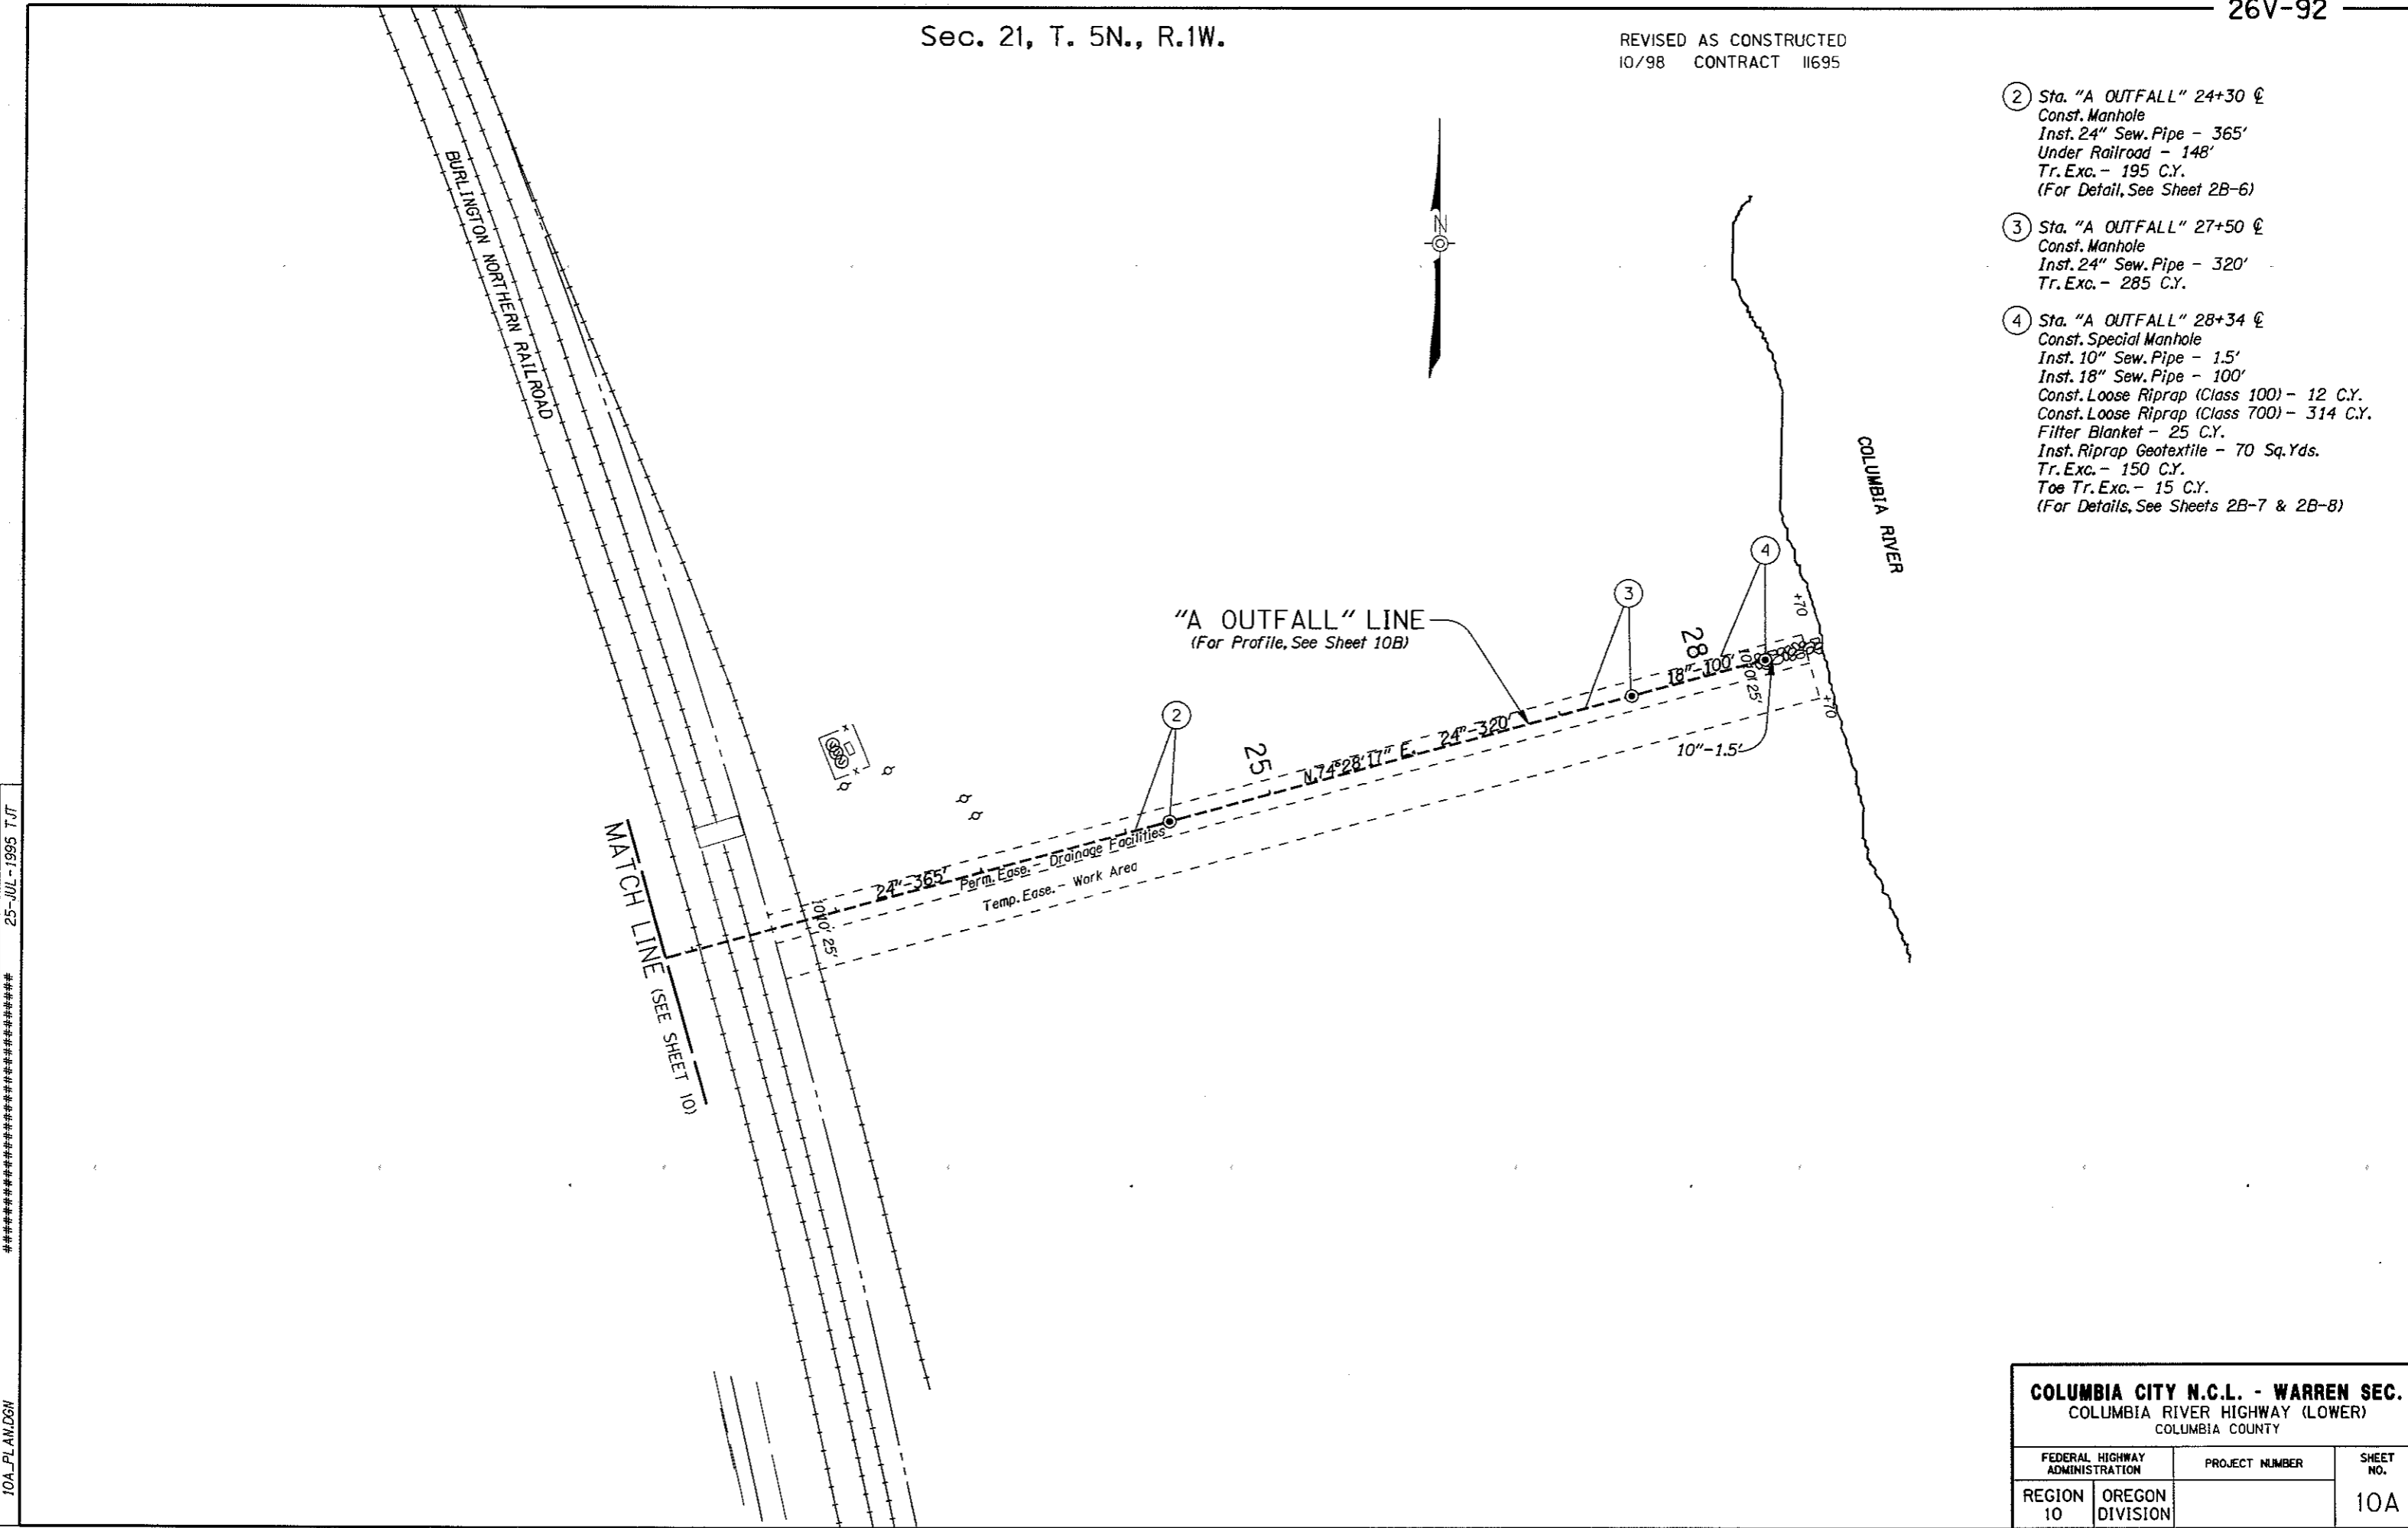

10A\_PL.AN.DGN 25-JUL-1995 T.JT \*\*\*\*\*

**COLUMBIA CITY N.C.L. - WARREN SEC.**  
COLUMBIA RIVER HIGHWAY (LOWER)  
COLUMBIA COUNTY



FEDERAL HIGHWAY ADMINISTRATION		PROJECT NUMBER	SHEET NO.
REGION 10	OREGON DIVISION		10A

REVISED AS CONSTRUCTED  
10/98 CONTRACT 11695

"A" LINE PROFILE  
(For Plan, See Sheet 10)

"A OUTFALL" LINE  
(For Plan, See Sheet 10 & 10A)

85  
80  
75  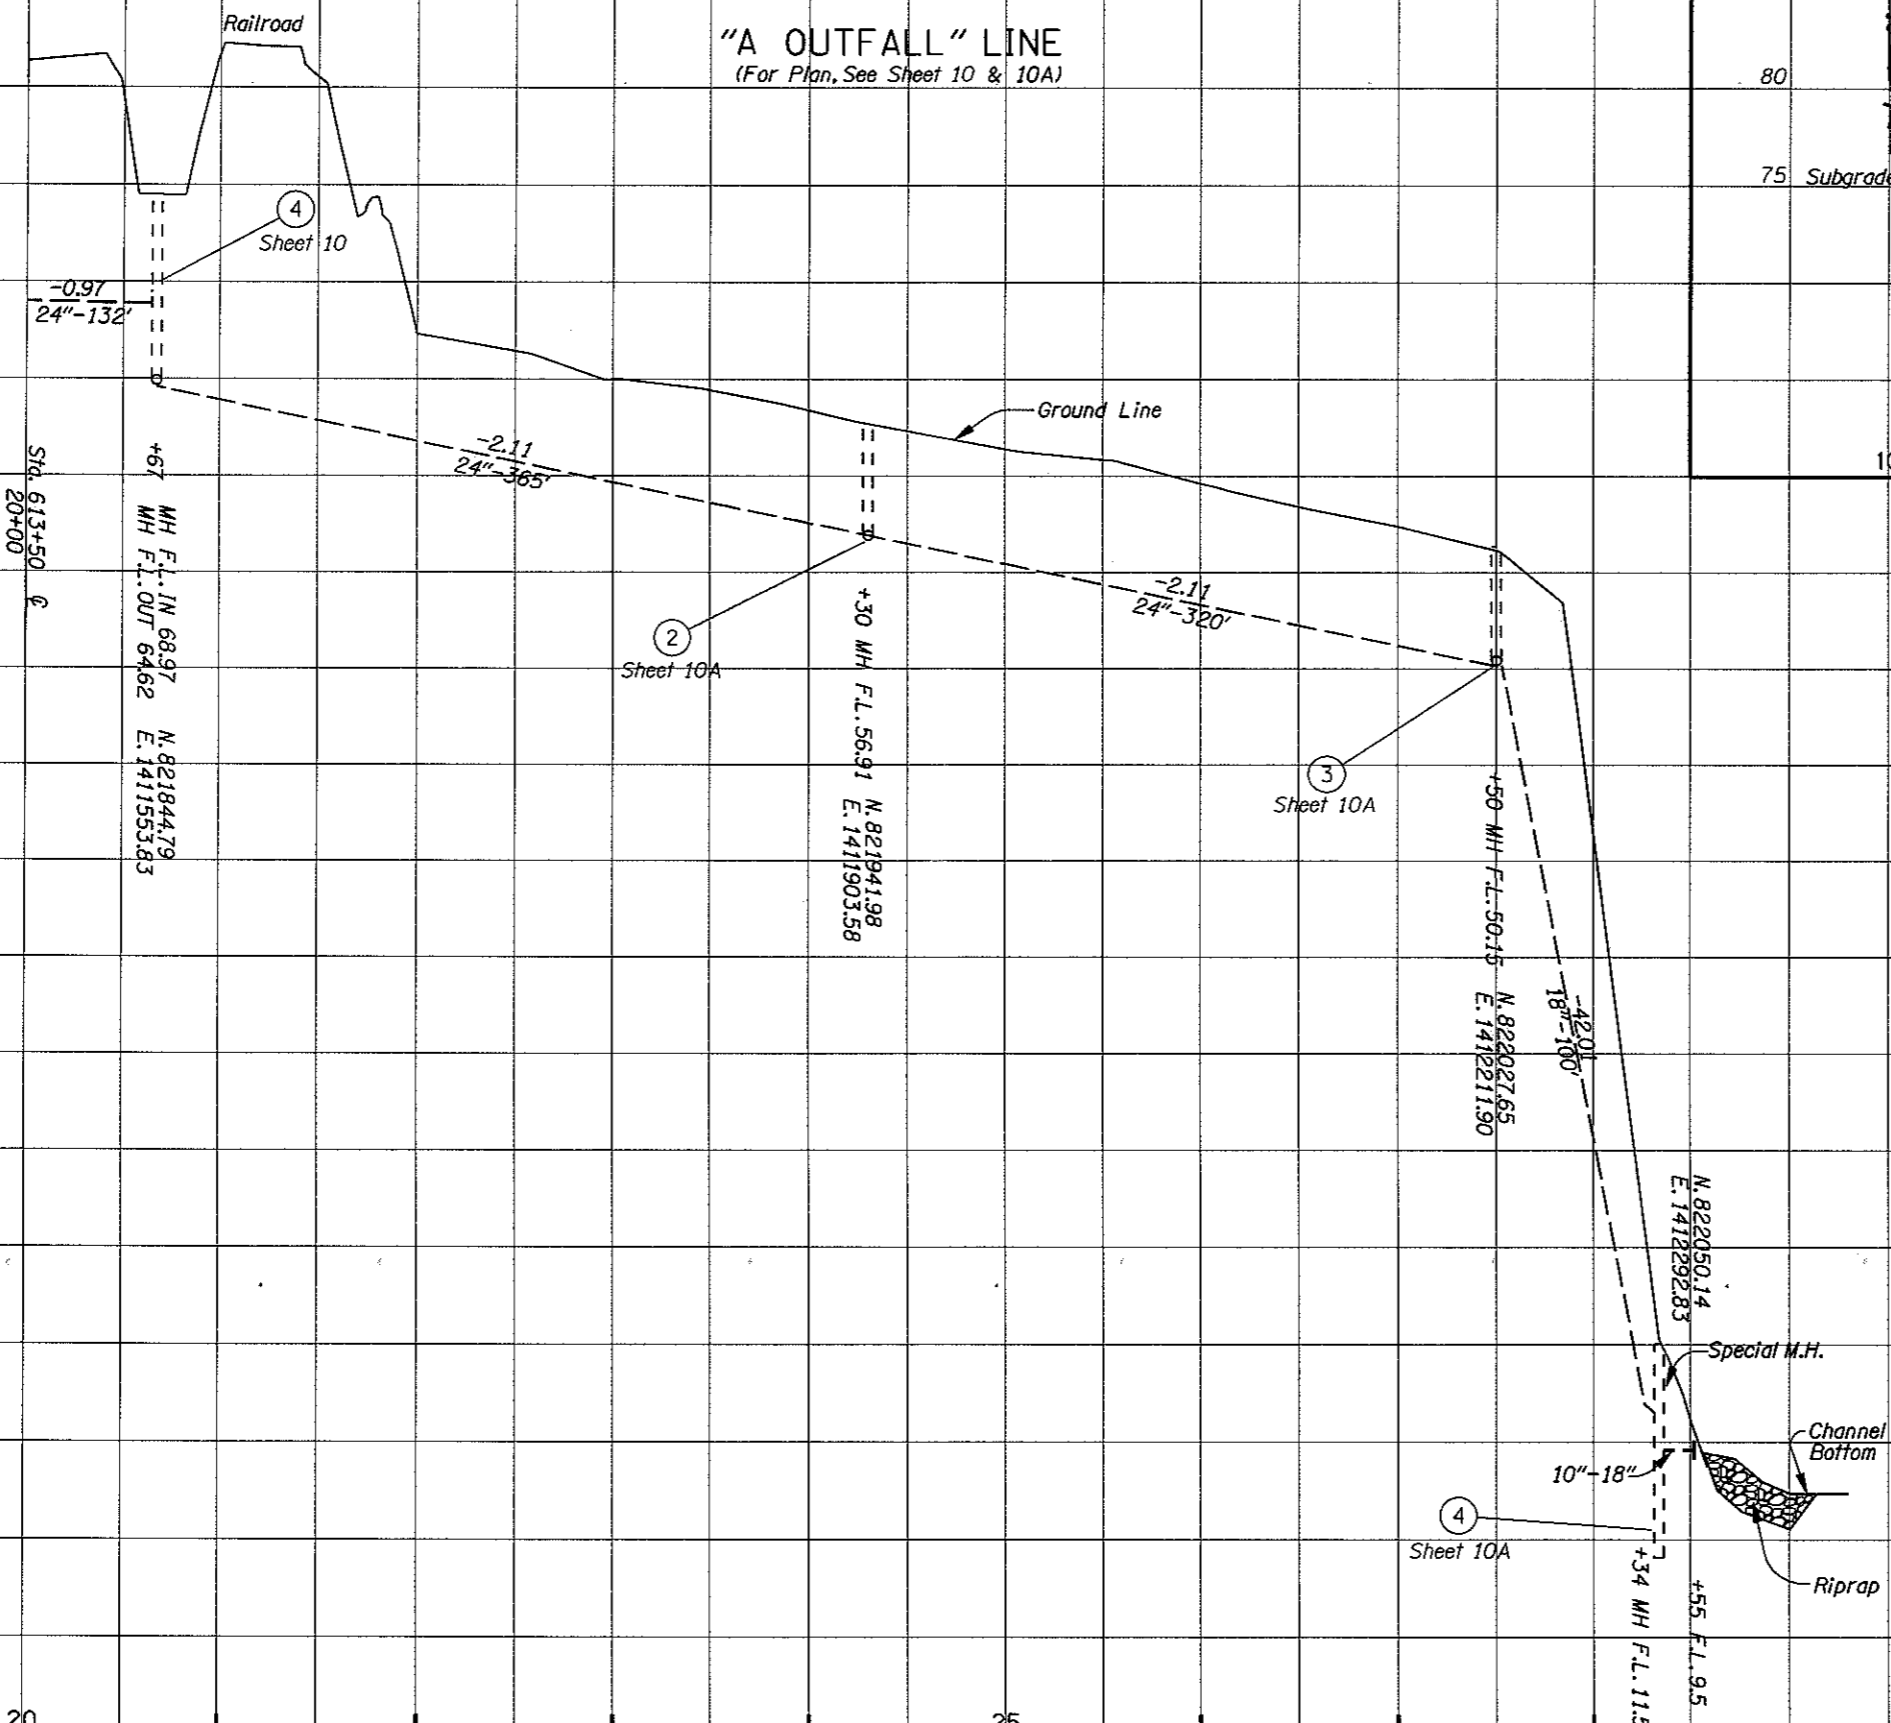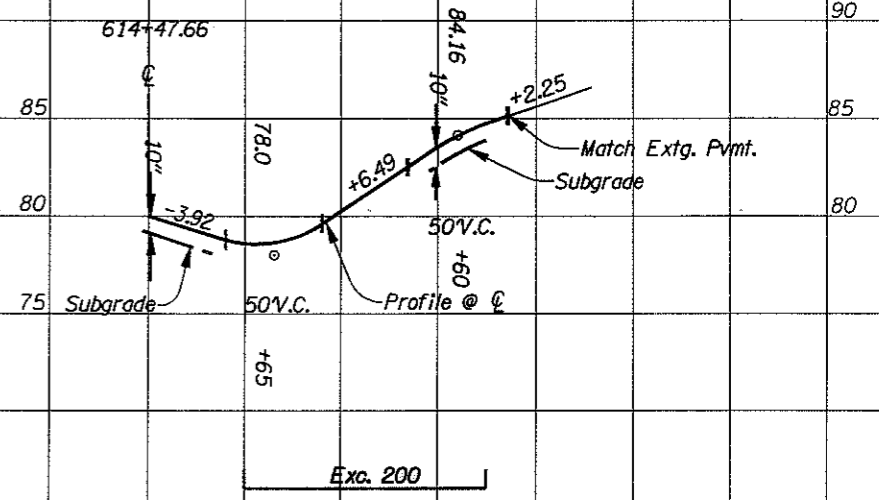
J.T. 12-OCT-1995 \*\*\*\*\* 10B\_PROD6N

COLUMBIA CITY N.C.L. - WARREN SEC.  
COLUMBIA RIVER HIGHWAY (LOWER)  
COLUMBIA COUNTY

FEDERAL HIGHWAY ADMINISTRATION		PROJECT NUMBER	SHEET NO.
REGION 10	OREGON DIVISION		10B