

OPERATION & MAINTENANCE MANUAL

DFI No. : D00182

Facility Type: Detention Pond



JUNE, 2011

1. Identification

Drainage Facility ID (DFI): **D00182**
Facility Type: Detention Pond
Construction Drawings: (V-File Number) 26V-092
Location: District: 1 (Old 2A)
Highway No.: 092
Mile Post: 28.98 (beg./end)]
Description: This facility is located northeast of the Wyeth Street and the Columbia River Highway (Hwy 092) intersection, situated east of the Burlington Northern Railroad track.

2. Facility Contact Information

Contact the Engineer of Record, Region Technical Center, or Geo-Environmental's Senior Hydraulics Engineer for:

- Operational clarification
- Maintenance clarification
- Repair or restoration assistance

Engineering Contacts:

Region Technical Center Hydro Unit Manager

Or

Geo-Environmental Senior Hydraulics Engineer (503) 986-3365.

3. Construction

Engineer of Record: Consultant Designer - W&H Pacific, William Evans, P.E., (503) 362-4675

Facility construction: 1996
Contractor: N/A

4. Storm Drain System and Facility Overview

A detention facility is designed to control the quantity of runoff, by reducing the peak discharge and only detaining runoff for some short period of time. These facilities are designed to store and gradually release or attenuate stormwater runoff via a control structure or release mechanism, and completely drain after the design storm has passed. The most common detention facilities include:

- Dry ponds - these are depressed storage areas that store runoff during wet weather and are dry the rest of the time. Usually they are earthen depressions.
- Tanks - these are underground storage facilities that are typically constructed from large diameter pipe.
- Vaults - these are enclosed underground storage facilities. They are typically constructed from reinforced concrete.

This 171-ft detention pond facility is located northeast of the Wyeth Street and the Columbia River Highway intersection, east of the Burlington Northern Railroad track.

This facility primarily receives stormwater runoff that sheet flows along both Wyeth Street and 17th Street, and flows into three catch basins located curbside along the intersection of Wyeth Street and 17th Street. The three catch basins empty into a 12-inch diameter pipe which carries the flow into the detention pond; see Point B of the Operational Plan, Appendix A. Flow is also conveyed into the detention pond through an 18-inch culvert pipe, collecting water from a drainage ditch southwest of the pond; see point A of the Operational Plan, Appendix A.

After detainment and treatment stormwater is directed from the facility outlet to a manhole northeast of the facility by way of an 18" pipe (point C on the Operational Plan). From there the flow is eventually discharged into the Columbia River.

A. Maintenance equipment access:

This detention pond is enclosed by a fence. The only access is made via the gated entrance along the west side of the facility; see point D on the Operational Plan.

B. Heavy equipment access into facility:

- Allowed (no limitations)
- Allowed (with limitations)
- Not allowed

C. Special Features:

- Amended Soils
- Porous Pavers
- Liners
- Underdrains

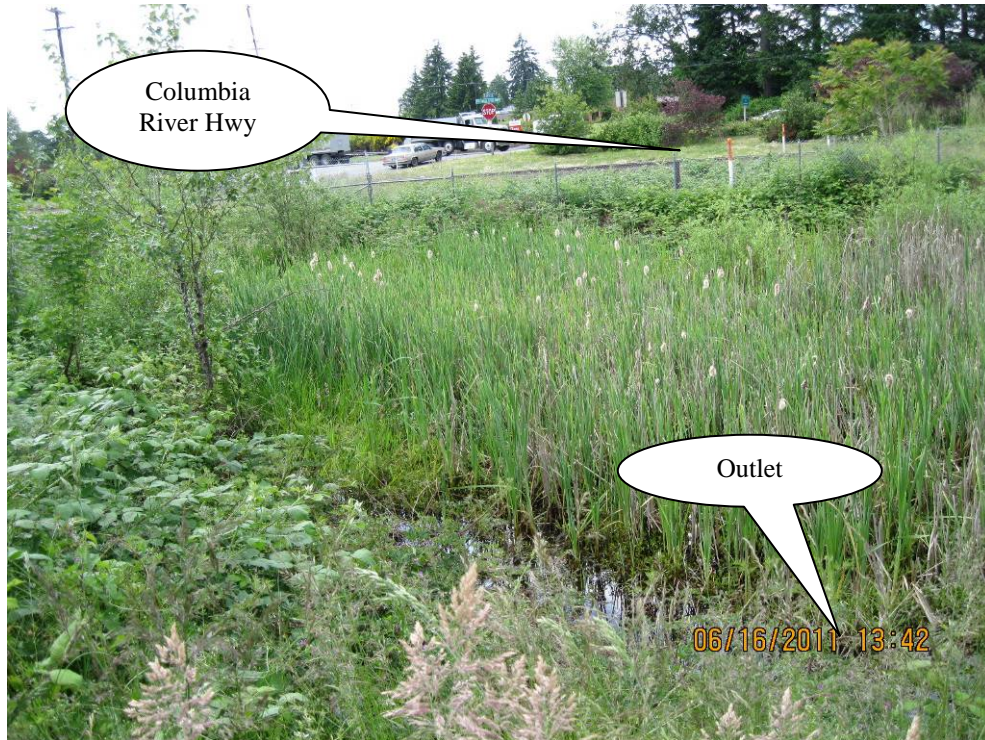


Photo 1: Detention pond view from maintenance access point (Photo 2)

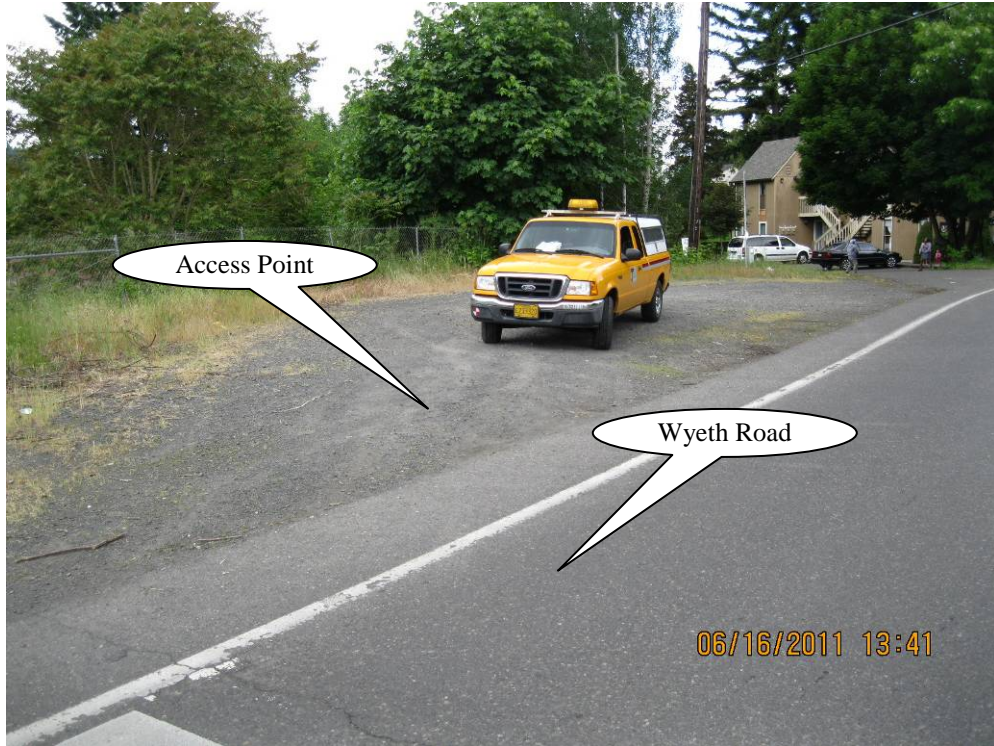


Photo 2: Maintenance vehicle access point.



Photo 3: Entrance into the gate that surrounds to detention pond. Gate is unlocked

5. Facility Haz Mat Spill Feature(s)

The detention pond can be used to store a volume of liquid by blocking the 18-inch diameter outlet pipe located at the outlet of the detention pond. This pipe is noted as point C in the Operational Plan; Appendix A.

6. Auxiliary Outlet (High Flow Bypass)

Auxiliary Outlets are provided if the primary outlet control structure can not safely pass the projected high flows. Broad-crested spillway weirs and over flow risers are the two most common auxiliary outlets used in stormwater facility design. The auxiliary outlet feature is either a part of the facility or an additional storm drain feature/structure.

The auxiliary outlet feature for this facility is:

Designed into facility

Other, as noted below

All flows exit the facility through the 18-inch outlet pipe. There are no auxiliary outlet features for this facility.

7. Maintenance Requirements

Routine maintenance tables for non-proprietary stormwater treatment and storage/detention facilities have been incorporated into ODOT's Maintenance Guide. These tables summarize the maintenance requirements for ponds, swales, filter strips, bioslopes, and detention tanks and vaults. Special maintenance requirements in addition to the routine requirements are noted below when applicable.

The ODOT Maintenance Guide can be viewed at the following website:

<http://www.oregon.gov/ODOT/HWY/OOM/MGuide.shtml>

Maintenance requirements for proprietary structures, such as underground water quality manholes and/or vaults with filter media are noted in Appendix C when applicable.

The following stormwater facility maintenance table (See ODOT Maintenance Guide) should be used to maintain the facility outlined in this Operation and Maintenance Manual or follow the Maintenance requirements outlined in Appendix C when proprietary structure is selected below:

Mark as Required and always include Table 1:

- Table 1 (general maintenance)
- Table 2 (stormwater ponds)
- Table 3 (water quality biofiltration swales)
- Table 4 (water quality filter strips)
- Table 5 (water quality bioslopes)
- Table 6 (detention tank)
- Table 7 (detention vault)
- Appendix C (proprietary structure)
- Special Maintenance requirements:

Note: Special maintenance Requirements Require Concurrence from ODOT SR Hydraulics Engineer.

8. Waste Material Handling

Material removed from the facility is defined as waste by DEQ. Refer to the roadwaste section of the ODOT Maintenance Yard Environmental Management System (EMS) Policy and Procedures Manual for disposal options: <http://egov.oregon.gov/ODOT/HWY/OOM/EMS.shtml>


Contact any of the following for more detailed information about management of waste materials found on site:

ODOT Clean Water Unit	(503) 986-3008
ODOT Statewide Hazmat Coordinator	(503) 229-5129
ODOT Region Hazmat Coordinator	(503) 731-8304
ODEQ Northwest Region Office	(503) 229-5263

Appendix A


Content:

- **Operational Plan and Profile Drawing(s)**

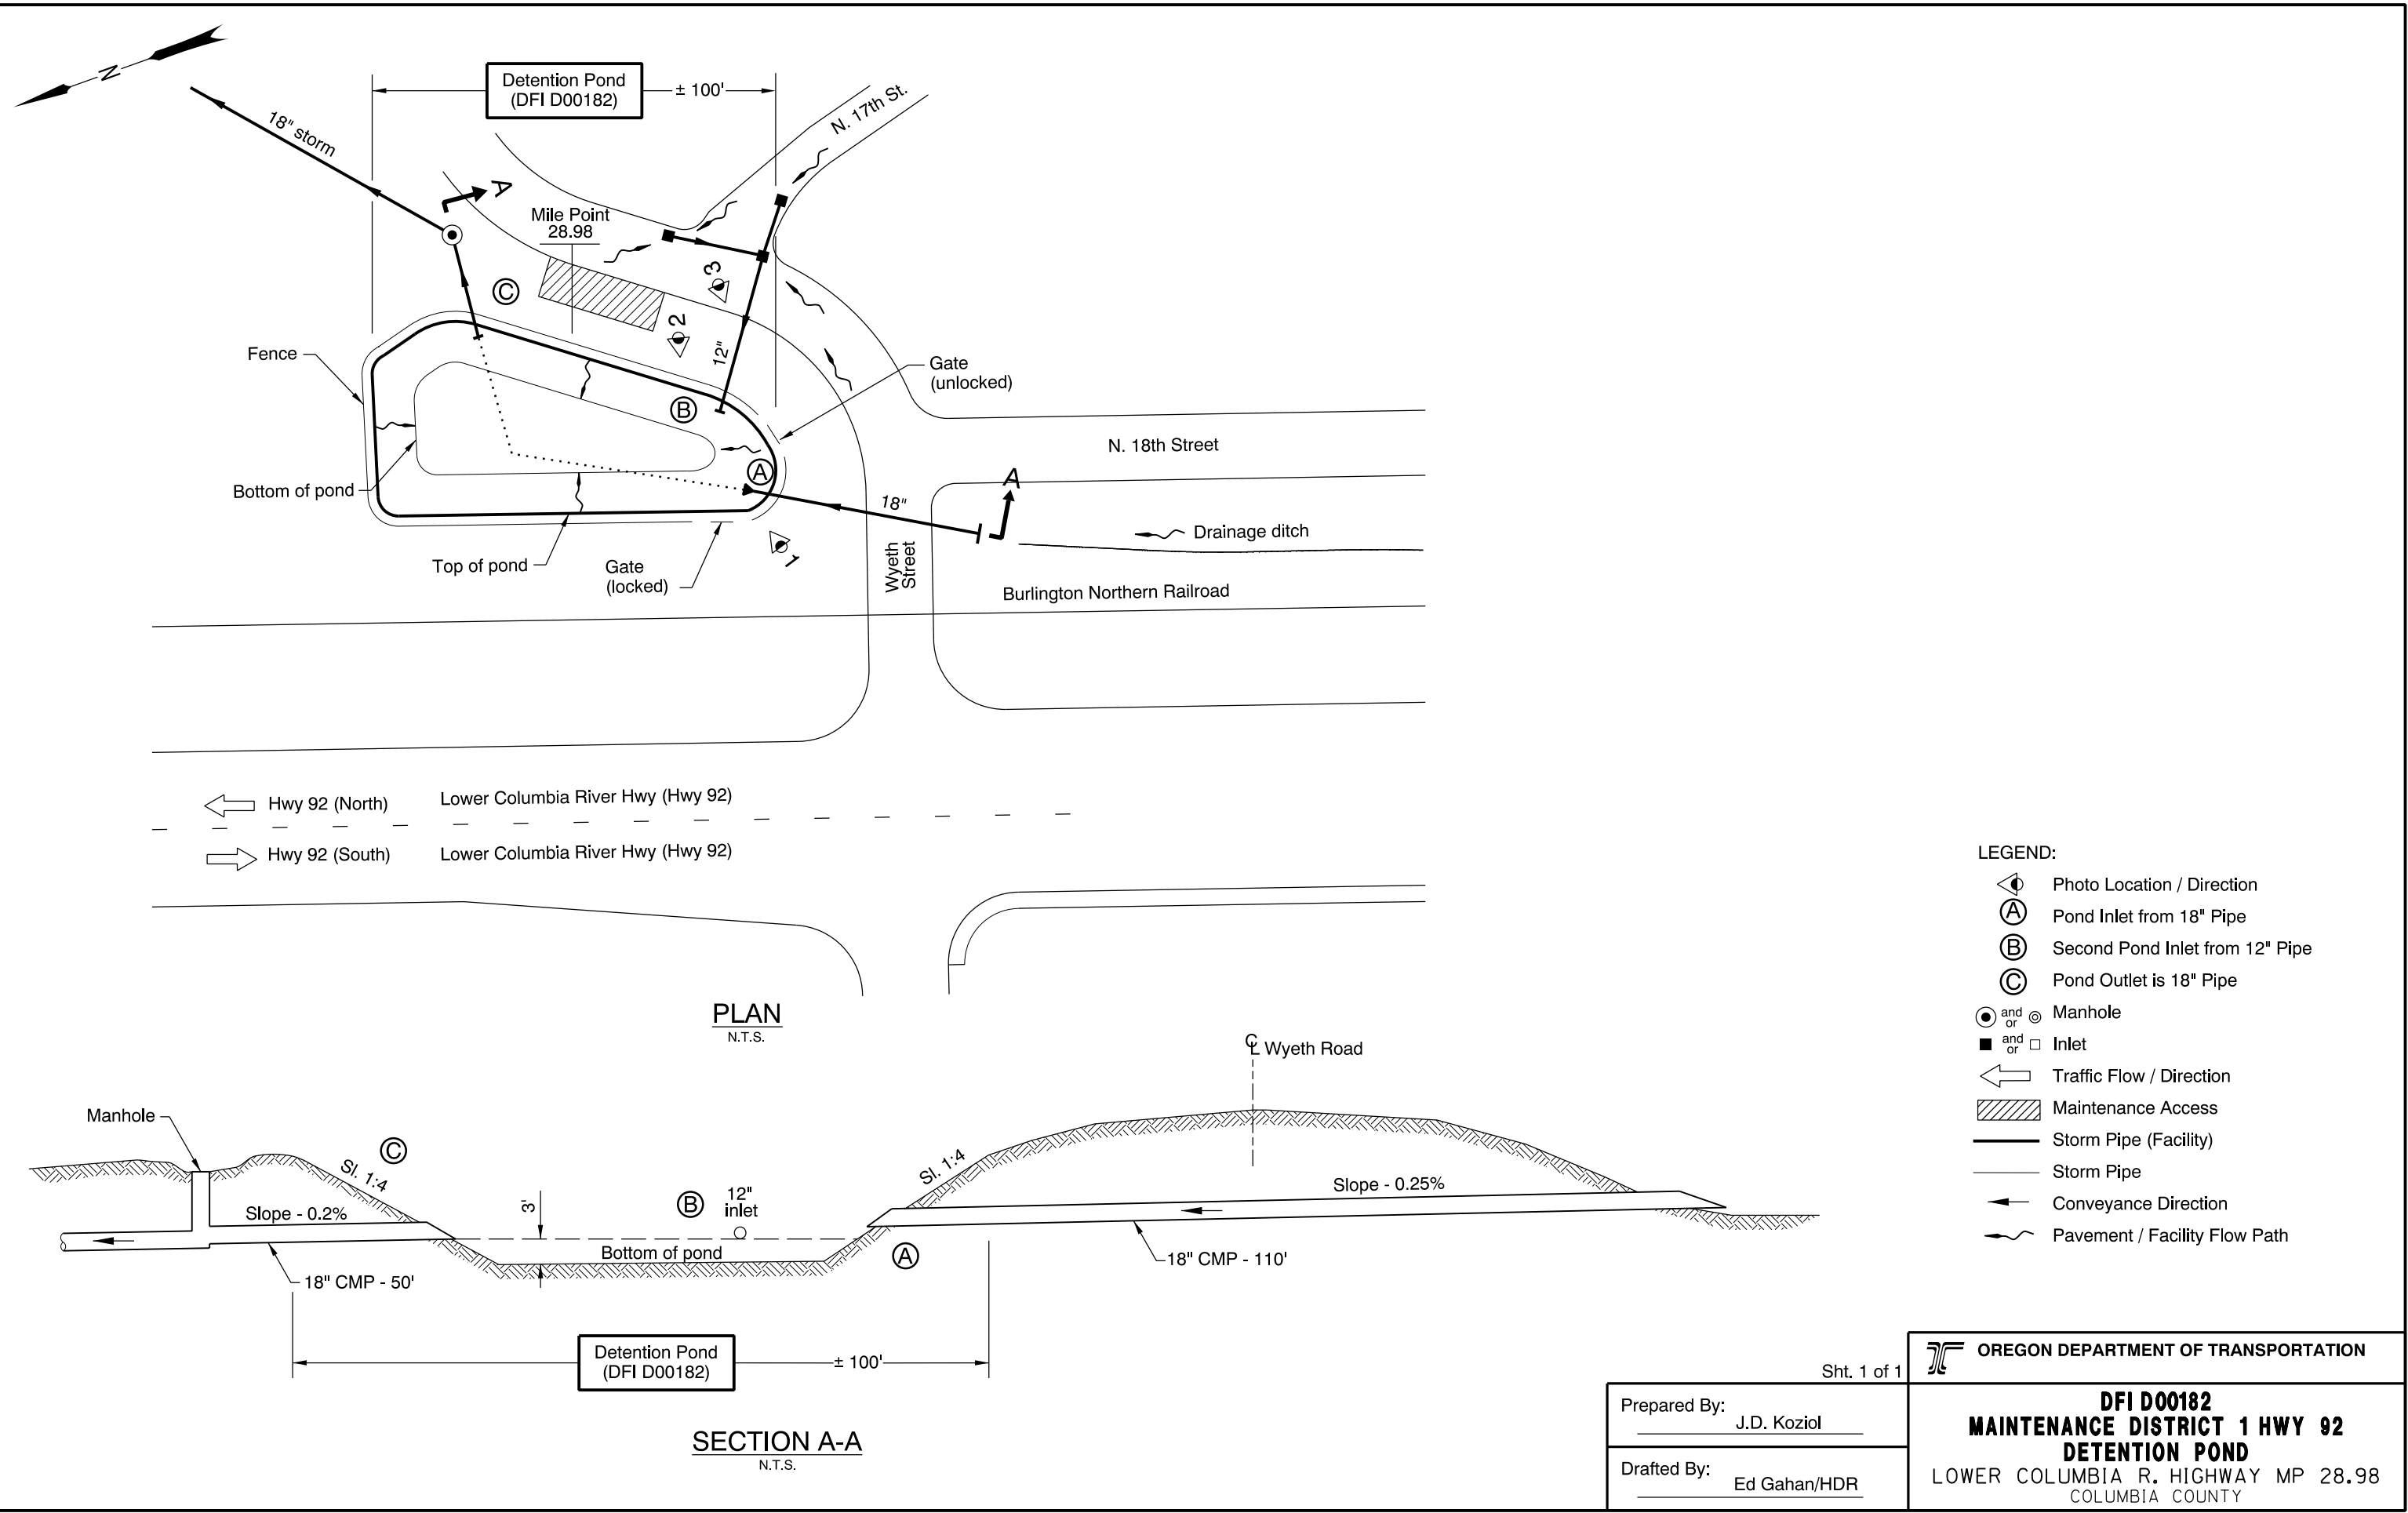

← Hwy 92 (North) Lower Columbia River Hwy (Hwy 92)
 → Hwy 92 (South) Lower Columbia River Hwy (Hwy 92)

PLAN
N.T.S.

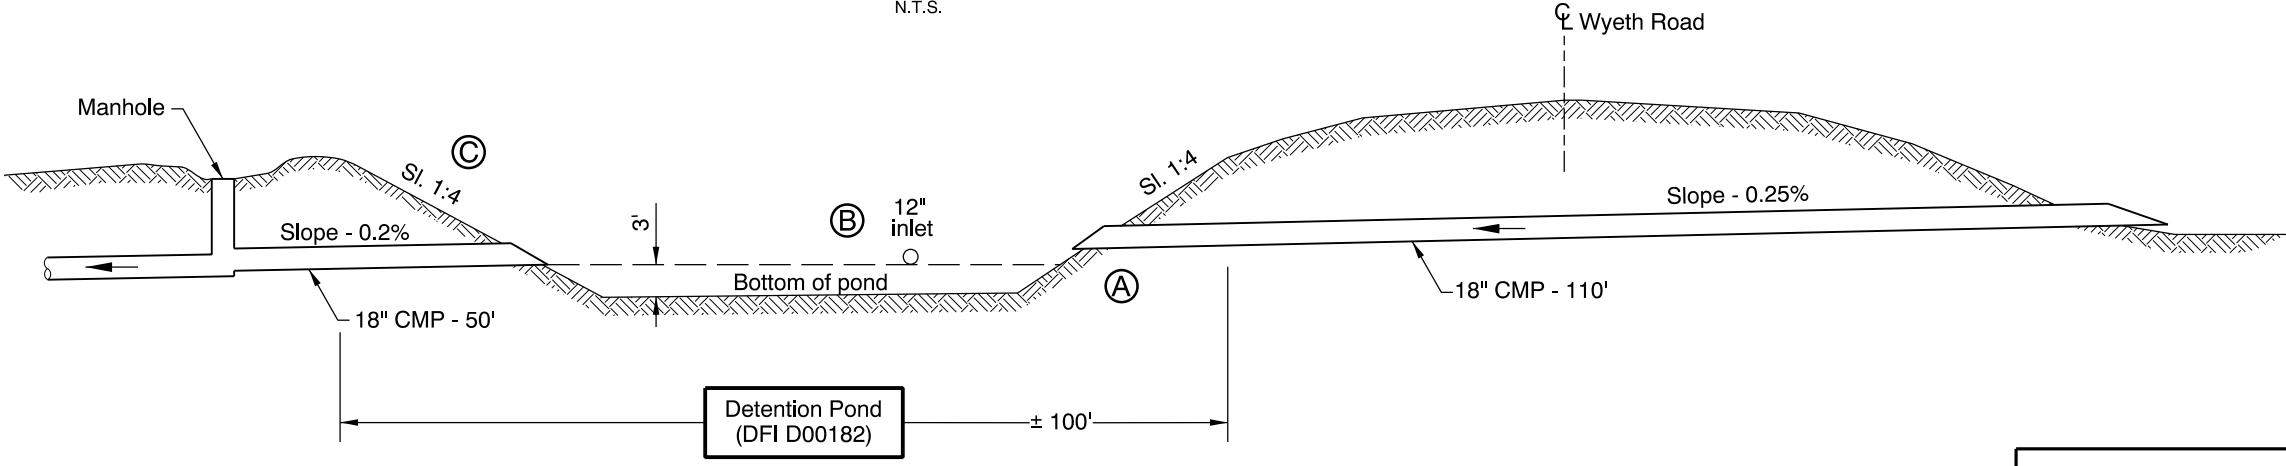

SECTION A-A
N.T.S.

- LEGEND:**
- ◁ Photo Location / Direction
 - Ⓐ Pond Inlet from 18" Pipe
 - Ⓑ Second Pond Inlet from 12" Pipe
 - Ⓒ Pond Outlet is 18" Pipe
 - ⊙ and ⊗ Manhole
 - and □ Inlet
 - ← Traffic Flow / Direction
 - ▨ Maintenance Access
 - Storm Pipe (Facility)
 - Storm Pipe
 - Conveyance Direction
 - ~ Pavement / Facility Flow Path

Sht. 1 of 1

Prepared By: J.D. Koziol	OREGON DEPARTMENT OF TRANSPORTATION DFI D00182 MAINTENANCE DISTRICT 1 HWY 92 DETENTION POND LOWER COLUMBIA R. HIGHWAY MP 28.98 COLUMBIA COUNTY

Appendix B


Content:

- **ODOT Project Plan Sheets**
 - *Cover/Title Sheet*
 - *Water Quality/Detention Plan Sheets*
 - *Other Details*

BIO-FILTER SWALE


Bio-Filter Swale Table

Station From	Station To	Left Or Right	Slope A	Slope B	Bottom Width (Ft)	Depth (Ft)	Length (Ft)	Channel Slope (%)
573+00	575+50	Rt	6:1	4:1	4	1	250	1.83
610+50	613+50	Rt	6:1	4:1	4	1	300	1.10
615+20	618+20	Rt	6:1	1 1/2:1	4	1	300	0.57
719+70	720+90	Rt	6:1	4:1	4	1	120	1.57
720+90	722+60	Rt	6:1	4:1	4	1	170	1.33
797+90	800+08	Lt	3:1	2:1	4	1	218	0.83
839+45	-	Lt	2:1	2:1	10	1	160	3.12
856+70	860+75	Lt	4:1	4:1	4	1	405	0.75-2.0
897+37	-	Lt	3:1	3:1	6	1	290	1.20
898+50	900+75	Rt	4:1	1 1/2:1	4	1	225	0.98

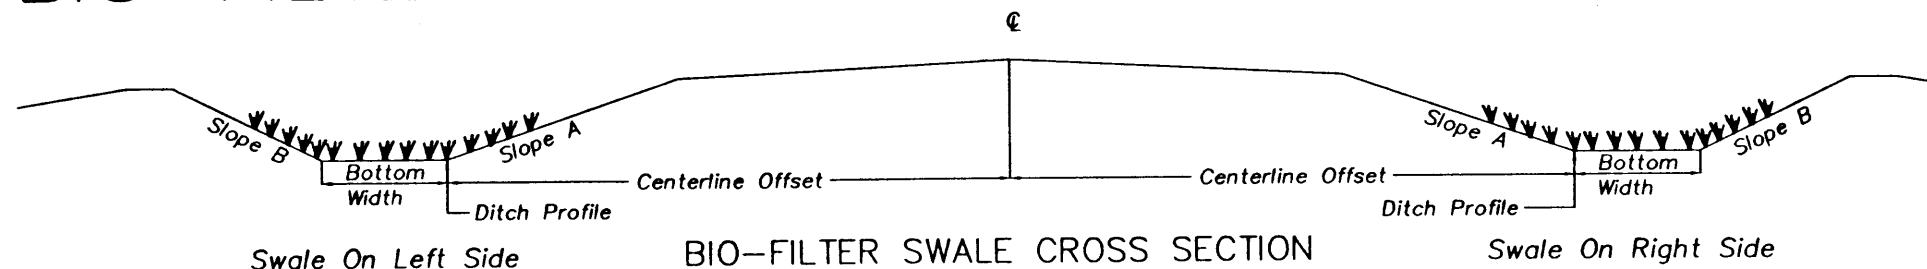


BIO-FILTER SWALE CROSS SECTION


(See Bio-Filter Swale Table For Data)

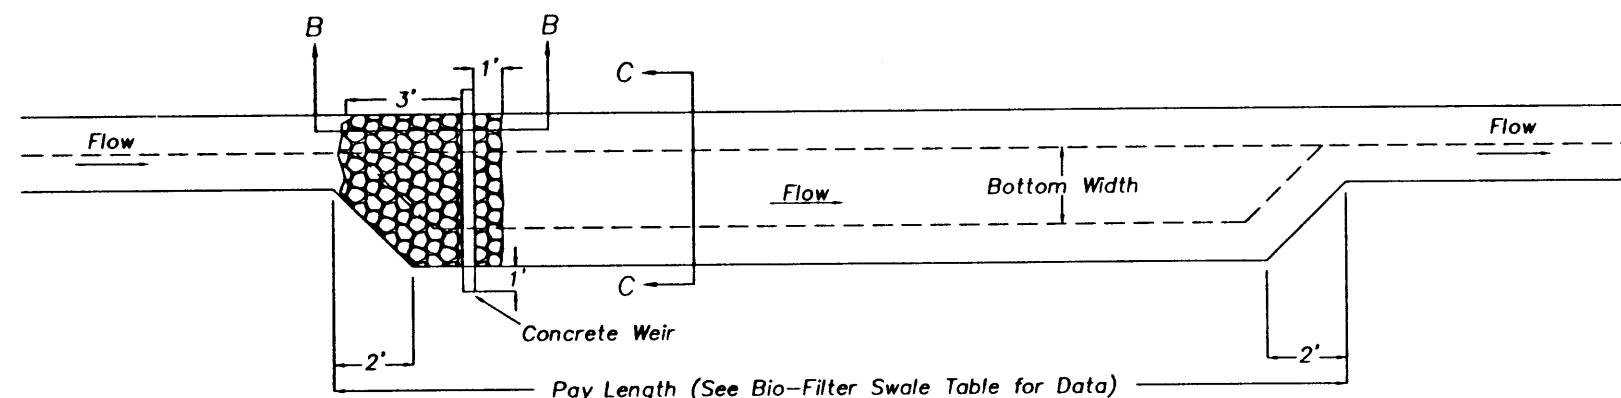


TYPICAL PLAN VIEW - BIO-FILTER SWALE

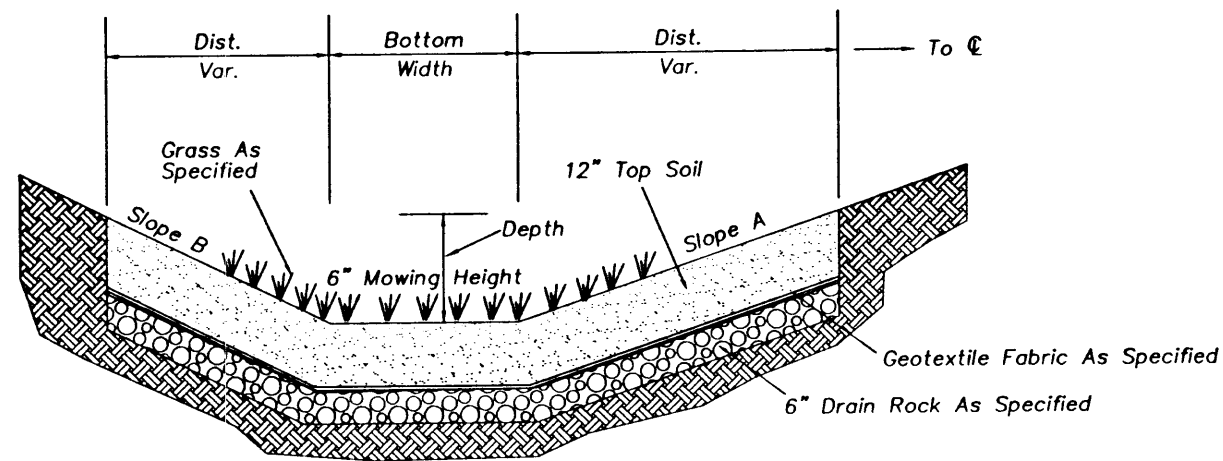

TYPICAL SECTION C-C

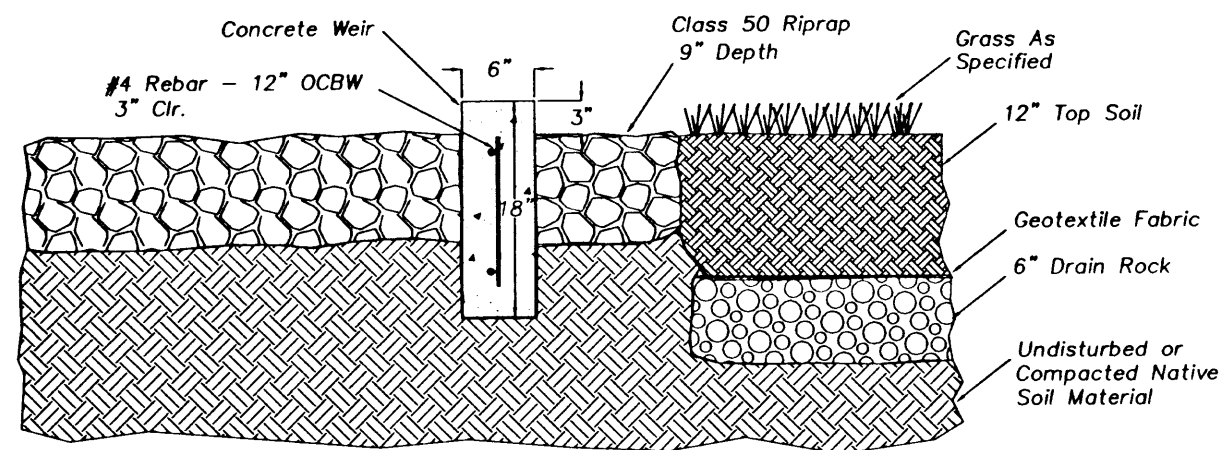


SECTION B - B

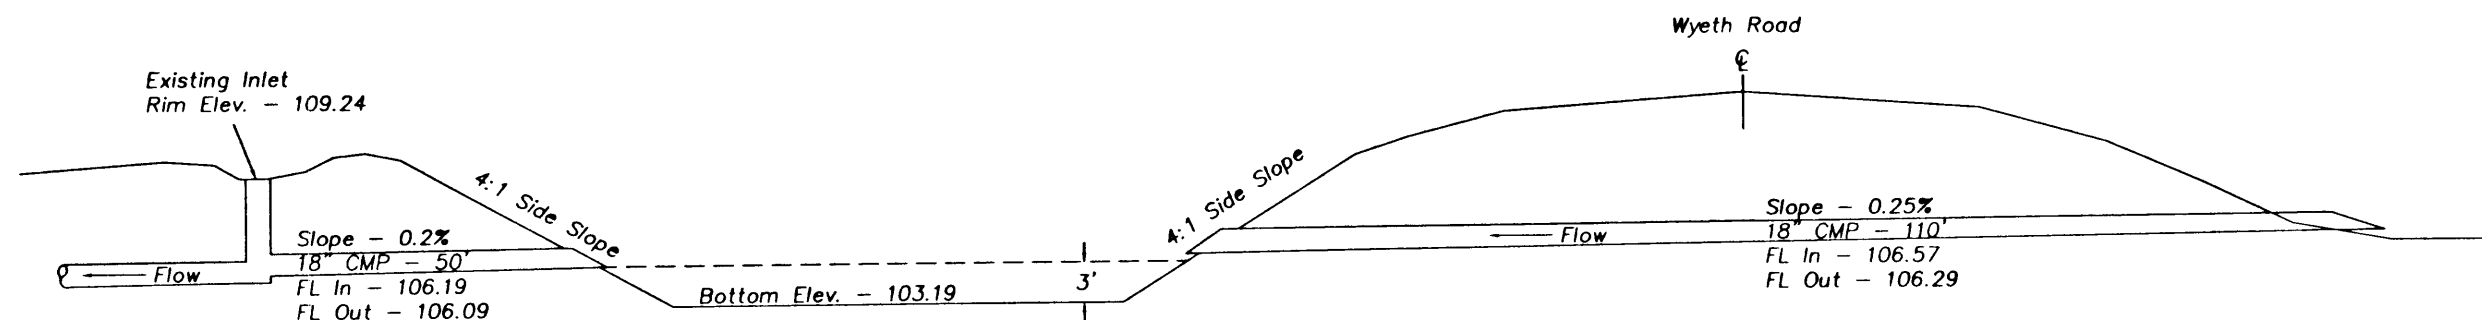

WYETH POND - SECTION A-A (FOR LOCATION SEE SHT 21)

COLUMBIA CITY N.C.L. - WARREN SEC. COLUMBIA RIVER HIGHWAY (LOWER) COLUMBIA COUNTY		
FEDERAL HIGHWAY ADMINISTRATION	PROJECT NUMBER	SHEET NO.
REGION 10	OREGON DIVISION	2B-17

2B-17.DWG 05-OCT-1995 MOM

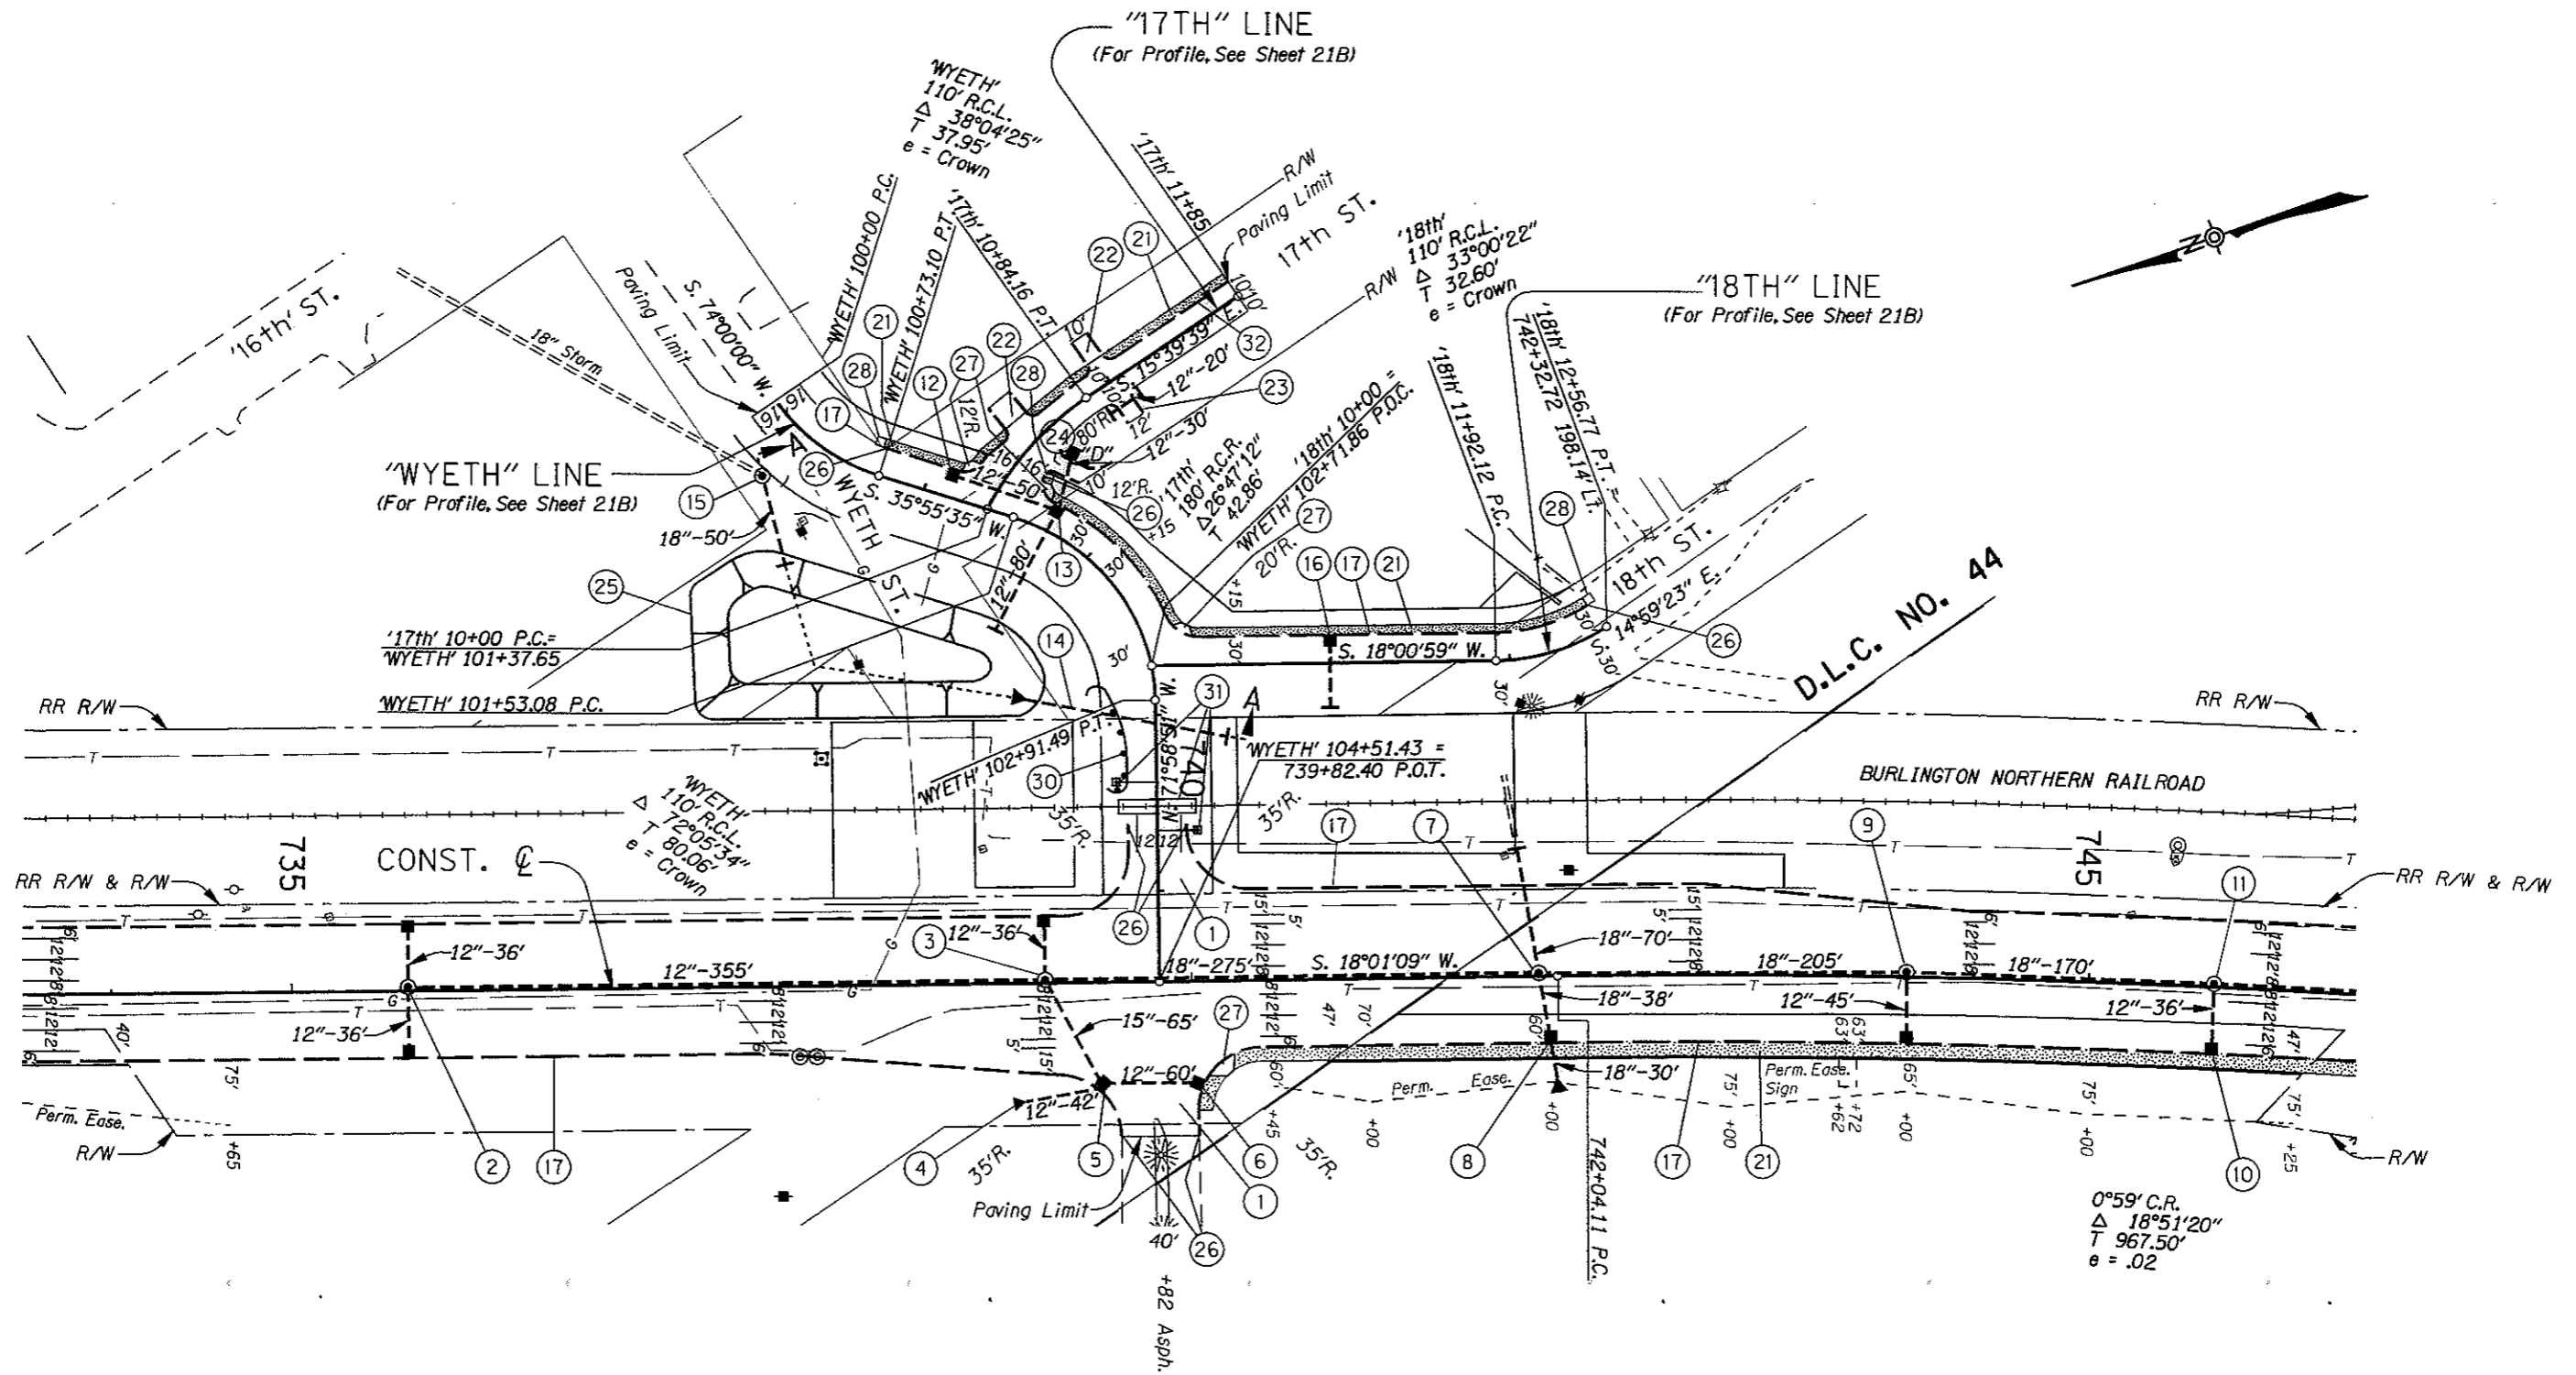

26-SEP-1995 T.JT

21.PLAN.DGN

COLUMBIA CITY N.C.L. - WARREN SEC.		
COLUMBIA RIVER HIGHWAY (LOWER)		
COLUMBIA COUNTY		
FEDERAL HIGHWAY ADMINISTRATION	PROJECT NUMBER	SHEET NO.
REGION 10	OREGON DIVISION	21



- ① Const. Road Conn. - 2
- ② Sta. 735+65, ☉
Const. Manhole
Const. Type "CG-2" Inlet - 2
Inst. 12" Sew. Pipe - 72'
Tr. Rock Exc. - 30 C.Y.
- ③ Sta. 739+20, ☉
Const. Manhole
Const. Type "CG-2" Inlet
Inst. 12" Sew. Pipe - 391'
Inst. 15" Sew. Pipe - 65'
Tr. Exc. - 60 C.Y.
Tr. Rock Exc. - 100 C.Y.
- ④ Sta. 739+05, Rt.
Const. Paved End Slope
- ⑤ Sta. 739+50, Rt.
Const. Type "CG-2" Inlet
Inst. 12" Sew. Pipe - 102'
Tr. Exc. - 20 C.Y.
- ⑥ Sta. 740+10, Rt.
Const. Type "CG-2" Inlet
- ⑦ Sta. 741+95, ☉
Const. Manhole
Inst. 18" Sew. Pipe - 383'
Conn. Outlet To Extg. Pipe
Tr. Exc. - 100 C.Y.
Tr. Rock Exc. - 123 C.Y.
- ⑧ Sta. 742+00, Rt.
Const. Type "CG-2" Inlet
Inst. 18" Sew. Pipe - 30'
Const. Paved End Slope
Tr. Rock Exc. - 10 C.Y.
- ⑨ Sta. 744+00, Rt.
Const. Manhole
Const. Type "CG-2" Inlet
Inst. 12" Sew. Pipe - 45'
Inst. 18" Sew. Pipe - 205'
Tr. Exc. - 70 C.Y.
Tr. Rock Exc. - 63 C.Y.
- ⑩ Sta. 745+70, Rt.
Const. Type "CG-2" Inlet
Inst. 12" Sew. Pipe - 36'
Tr. Rock Exc. - 15 C.Y.
- ⑪ Sta. 745+70, ☉
Const. Manhole
Inst. 18" Sew. Pipe - 170'
Tr. Exc. - 66 C.Y.
Tr. Rock Exc. - 66 C.Y.
- ⑫ Sta. "WYETH" 101+20, Lt.
Const. Type "CG-2" Inlet
Inst. 12" Sew. Pipe - 20'
Tr. Rock Exc. - 8 C.Y.
- ⑬ Sta. "WYETH" 101+70, Lt.
Const. Type "CG-2" Inlet
Const. Type "D" Inlet
Inst. 12" Sew. Pipe - 160'
Tr. Exc. - 30 C.Y.
Tr. Rock Exc. - 41 C.Y.
- ⑭ Sta. "WYETH" 103+05.
Inst. 18" Culv. Pipe - 110'
Const. Paved End Slope
Tr. Exc. - 57 C.Y.
- ⑮ Sta. "WYETH" 100+25, Rt.
Const. Manhole
Inst. 18" Culv. Pipe - 50'
Connect To Extg. Sew. Pipe
Tr. Exc. - 30 C.Y.
- ⑯ Sta. "18th" 11+00, Lt.
Const. Type "CG-2" Inlet
Inst. 12" Sew. Pipe - 40'
Tr. Exc. - 15 C.Y.
- ⑰ Const. Type "A" Curb
- ⑱ Const. P.C. Conc. Walk
(For Planting Detail, See Sheets 37, 37A & 37B)
- ⑳ Sta. "17th" 10+45, Lt.
Sta. "17th" 11+00, Lt.
Const. Appr. - 2
Tr. Exc. - 7 C.Y.
- ㉑ Sta. "17th" 11+00, Rt.
Const. Appr.
Inst. 12" Culv. Pipe - 20'
Tr. Exc. - 7 C.Y.
- ㉒ Sta. "17th" 10+45, Rt.
Const. Appr.
- ㉓ Const. Water Quality Pond
4:1 Side Slopes
Bottom Elevation = 103.19
(See Sheet 2B-17)
- ㉔ Const. Curb Ending - 7
- ㉕ Const. Sidewalk Ramp - 4
- ㉖ Const. Asph. Sidewalk Ramp - 4
(For Details, See Sheet 2B-10)
- ㉗ Const. Guard Rail - 12.5' (Type 2A)
- 12.5' (Type 3)
Flare Rate = 9:1, W=10', E=0
Inst. SRT-75 End Terminal
Const. Anchor - Type 1 Mod.
Inst. End Piece - Type B
(See Drg. No. 2115)
- ㉘ Const. Conc. R.R. Xing
Inst. R.R. Gate Signal - 2 } (By Others)
- ㉙ Const. Type "C" Curb

COLUMBIA CITY N.C.L. - WARREN SEC.
COLUMBIA RIVER HIGHWAY (LOWER)
COLUMBIA COUNTY

FEDERAL HIGHWAY ADMINISTRATION		PROJECT NUMBER	SHEET NO.
REGION 10	OREGON DIVISION		21A

21-PLAN.DGN ***** 27-SEP-1995 T.JT

REVISED AS CONSTRUCTED
10/98 CONTRACT #695

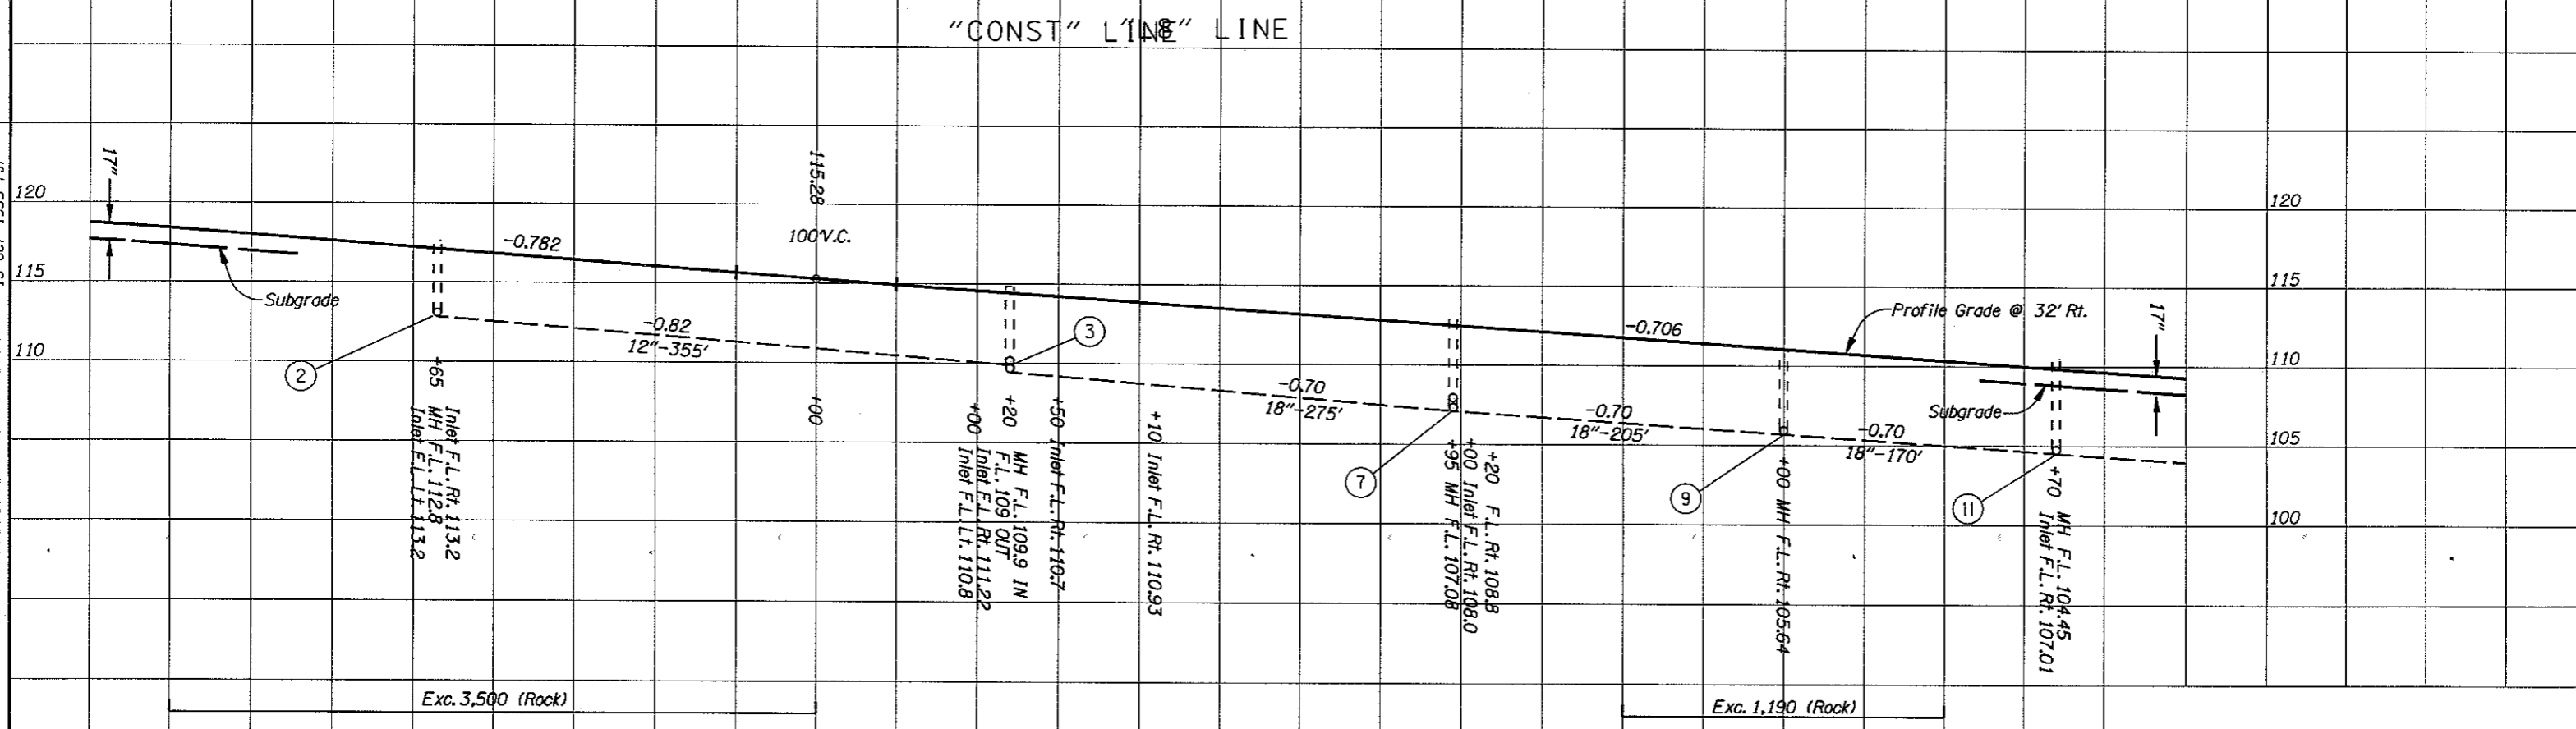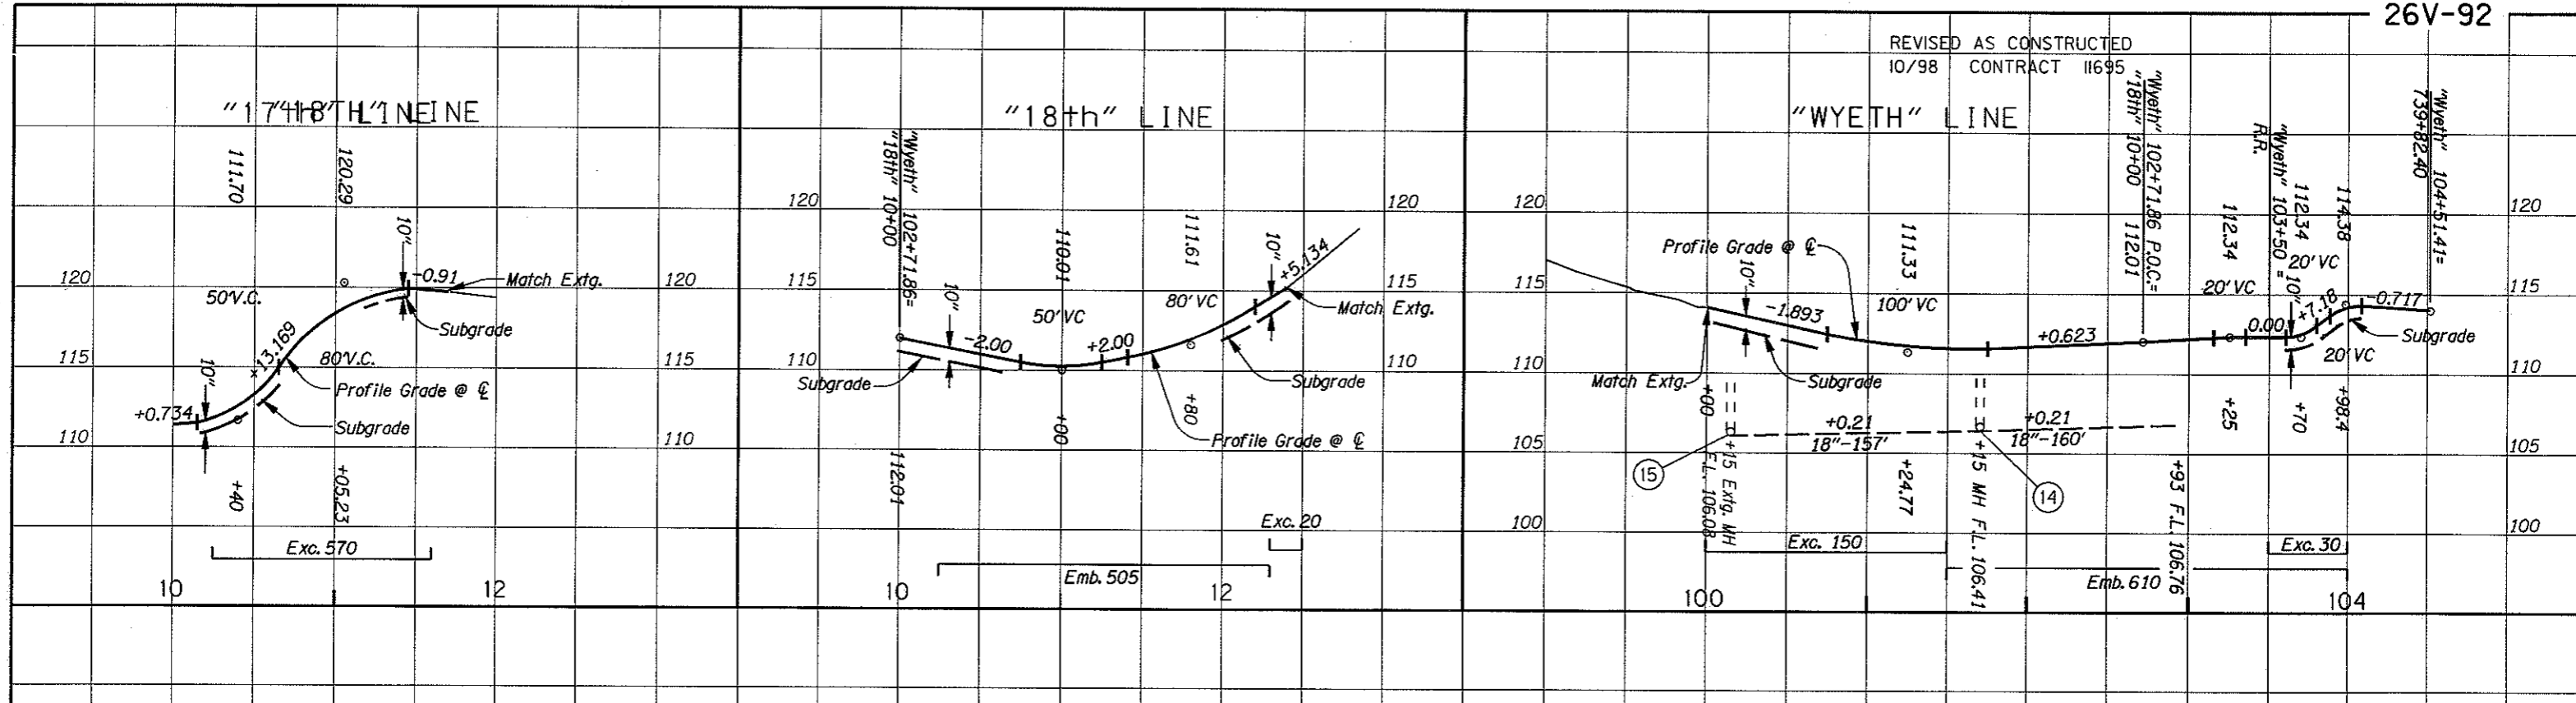

STAGE I
STAGE II

Exc. 3,500 (Rock)
Exc. 460
Emb. 2,700
Exc. 1,740
Emb. 280
Exc. 1,190 (Rock)

COLUMBIA CITY N.C.L. - WARREN SEC.		PROJECT NUMBER		SHEET NO.
COLUMBIA RIVER HIGHWAY (LOWER)		PROJECT NUMBER		
COLUMBIA COUNTY		REGION	OREGON DIVISION	21B
10	735	12	740	104

13-OCT-1995 T.JT
21B_PROLOGN