

OPERATION & MAINTENANCE MANUAL

DFI No. : D00185

**Facility Type: Water Quality Biofiltration
Swale**



JUNE, 2011

INDEX

1. IDENTIFICATION..... 1

2. FACILITY CONTACT INFORMATION..... 1

3. CONSTRUCTION..... 1

4. STORM DRAIN SYSTEM AND FACILITY OVERVIEW 2

5. FACILITY HAZ MAT SPILL FEATURE(S)..... 4

6. AUXILIARY OUTLET (HIGH FLOW BYPASS)..... 4

7. MAINTENANCE REQUIREMENTS..... 5

8. WASTE MATERIAL HANDLING..... 5

APPENDIX A: Operational Plan and Profile Drawing(s)

APPENDIX B: ODOT Project Plan Sheets

1. Identification

Drainage Facility ID (DFI): **D00185**

Facility Type: Water Quality Biofiltration Swale

Construction Drawings: (V-File Number) 26V-092

Location: District: 1 (Old 2A)

Highway No.: 092

Mile Post: 27.81; 27.85 (beg./end)

Description: This facility is located along the east side Hwy. 92 between Gable Road and Sykes Road. It is adjacent to the northbound travel lanes and railroad tracks. Unobstructed access can be obtained from the right shoulder of Hwy. 92.

2. Facility Contact Information

Contact the Engineer of Record, Region Technical Center, or Geo-Environmental's Senior Hydraulics Engineer for:

- Operational clarification
- Maintenance clarification
- Repair or restoration assistance

Engineering Contacts:

Region Technical Center Hydro Unit Manager

Or

Geo-Environmental Senior Hydraulics Engineer (503) 986-3365.

3. Construction

Engineer of Record:

Consultant Designer - W&H Pacific, William Evans,
P.E., (503) 362-4675

Facility construction: 1996

Contractor: N/A

4. Storm Drain System and Facility Overview

A water quality swale is a flat-bottomed open channel designed to treat stormwater runoff from highway pavement areas. This type of facility is lined with grass. Treatment by trapping sedimentation occurs when stormwater runoff flows through the grass.

This 220-ft water quality biofiltration swale facility is located along the east side Hwy. 92 between Gable Road and Sykes Road and adjacent to both the northbound travel lanes and railroad tracks. The swale primarily receives stormwater runoff as it sheet flows from the northbound travel lane of the Columbia River Highway (Hwy 092). The swale also treats water from other sources such as what is conveyed from the drainage ditch alignment it is a part of, and two 18-inch pipes directed from a localized storm drain system; see Points A, B and D, respectively, on the Operational Plan; Appendix A. Water, reaching the swale when flowing along the ditch, overtops a reinforced concrete flow spreader, and a layer of riprap represented by Point B. Points A and D indicate the culvert pipe inlets.

After treatment the swale directs the water quality flow into an 18-inch or larger-sized culvert pipe at the end of the swale (Point C on the Operational Plan). The culvert collects water before being redirected beneath the railroad tracks and later discharged toward the Columbia River.

A. Maintenance equipment access:

Unobstructed access can be obtained from the right shoulder of Hwy. 92.

B. Heavy equipment access into facility:

- Allowed (no limitations)
- Allowed (with limitations)
- Not allowed

C. Special Features:

- Amended Soils
- Porous Pavers
- Liners
- Underdrains



Photo 1: Looking west toward the culvert inlet at Point A –the beginning of the swale.



Photo 2: Looking west toward the culvert inlet at Point D –the middle of the swale.



Photo 3: Looking south toward the end of the swale and the facility outlet at Point C.

5. Facility Haz Mat Spill Feature(s)

The water quality biofiltration swale can be used to store a volume of liquid by blocking the 18-inch or larger-sized diameter outlet pipe serving as an outlet to the swale. This pipe is noted as point C in Operational Plan; Appendix A.

6. Auxiliary Outlet (High Flow Bypass)

Auxiliary Outlets are provided if the primary outlet control structure can not safely pass the projected high flows. Broad-crested spillway weirs and over flow risers are the two most common auxiliary outlets used in stormwater treatment facility design. The auxiliary outlet feature is either a part of the facility or an additional storm drain feature/structure.

The auxiliary outlet feature for this facility is:

Designed into facility

Other, as noted below

There are no auxiliary outlet features for this facility.

7. Maintenance Requirements

Routine maintenance table for non-proprietary stormwater treatment and storage/detention facilities have been incorporated into ODOT's Maintenance Guide. These tables summarize the maintenance requirements for ponds, swales, filter strips, bioslopes, and detention tanks and vaults. Special maintenance requirements in addition to the routine requirements are noted below when applicable.

The ODOT Maintenance Guide can be viewed at the following website:

<http://www.oregon.gov/ODOT/HWY/OOM/MGuide.shtml>

Maintenance requirements for proprietary structures, such as underground water quality manholes and/or vaults with filter media are noted in Appendix C when applicable.

The following stormwater facility maintenance table (See ODOT Maintenance Guide) should be used to maintain the facility outlined in this Operation and Maintenance Manual or follow the Maintenance requirements outlined in Appendix C when proprietary structure is selected below:

Mark as Required and always include Table 1:

- Table 1 (general maintenance)
- Table 2 (stormwater ponds)
- Table 3 (water quality biofiltration swales)
- Table 4 (water quality filter strips)
- Table 5 (water quality bioslopes)
- Table 6 (detention tank)
- Table 7 (detention vault)
- Appendix C (proprietary structure)
- Special Maintenance requirements:

Note: Special maintenance Requirements Require Concurrence from ODOT SR Hydraulics Engineer.

8. Waste Material Handling

Material removed from the facility is defined as waste by DEQ. Refer to the roadwaste section of the ODOT Maintenance Yard Environmental Management System (EMS) Policy and Procedures Manual for disposal options: <http://egov.oregon.gov/ODOT/HWY/OOM/EMS.shtml>


Contact any of the following for more detailed information about management of waste materials found on site:

ODOT Clean Water Unit	(503) 986-3008
ODOT Statewide Hazmat Coordinator	(503) 229-5129
ODOT Region Hazmat Coordinator	(503) 731-8304
ODEQ Northwest Region Office	(503) 229-5263


Appendix A

Content:


- **Operational Plan and Profile Drawing(s)**

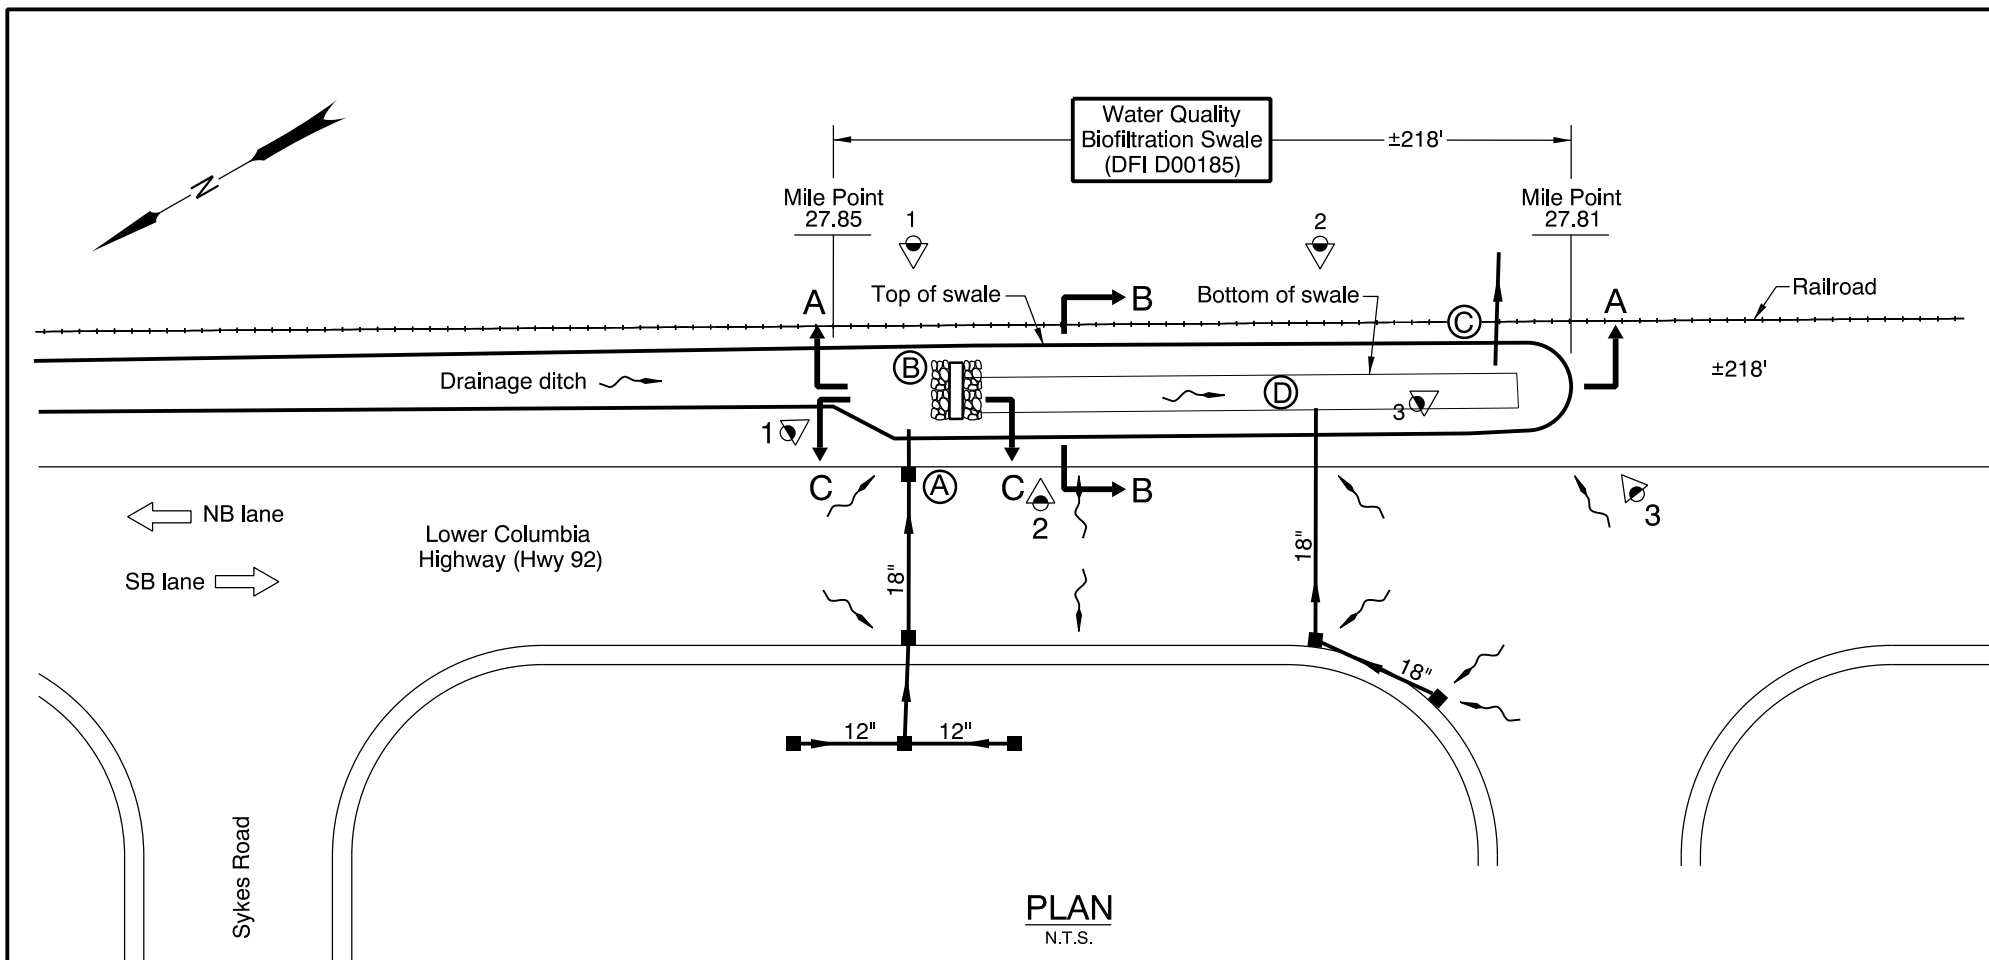


PLAN
N.T.S.

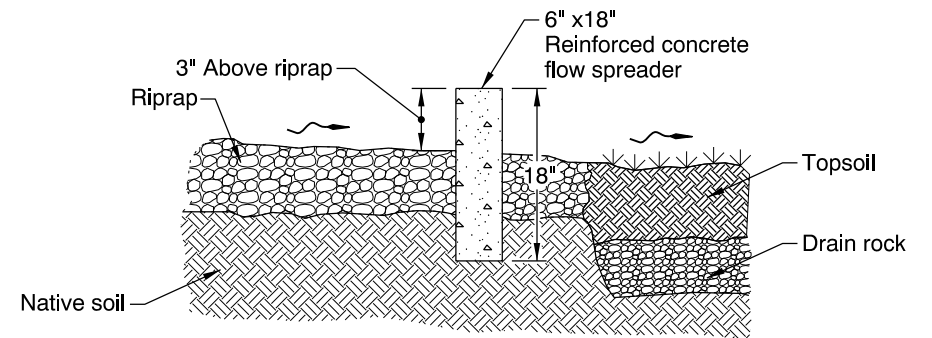

SECTION C-C
N.T.S.

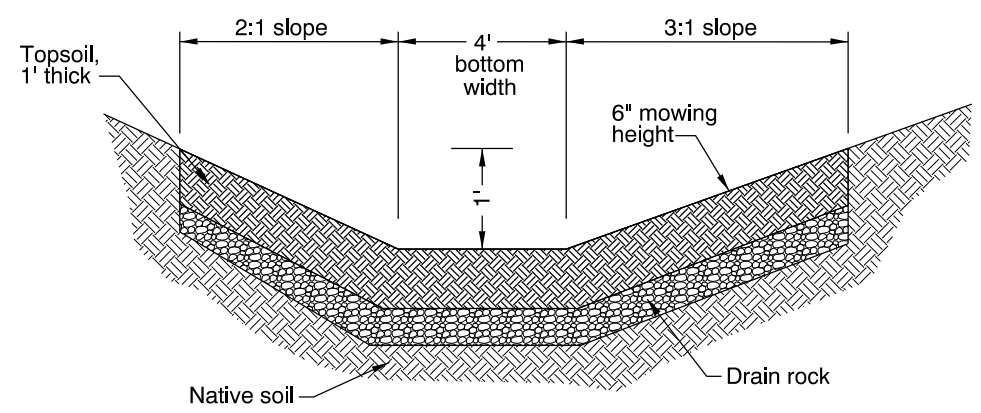

SECTION B-B
N.T.S.

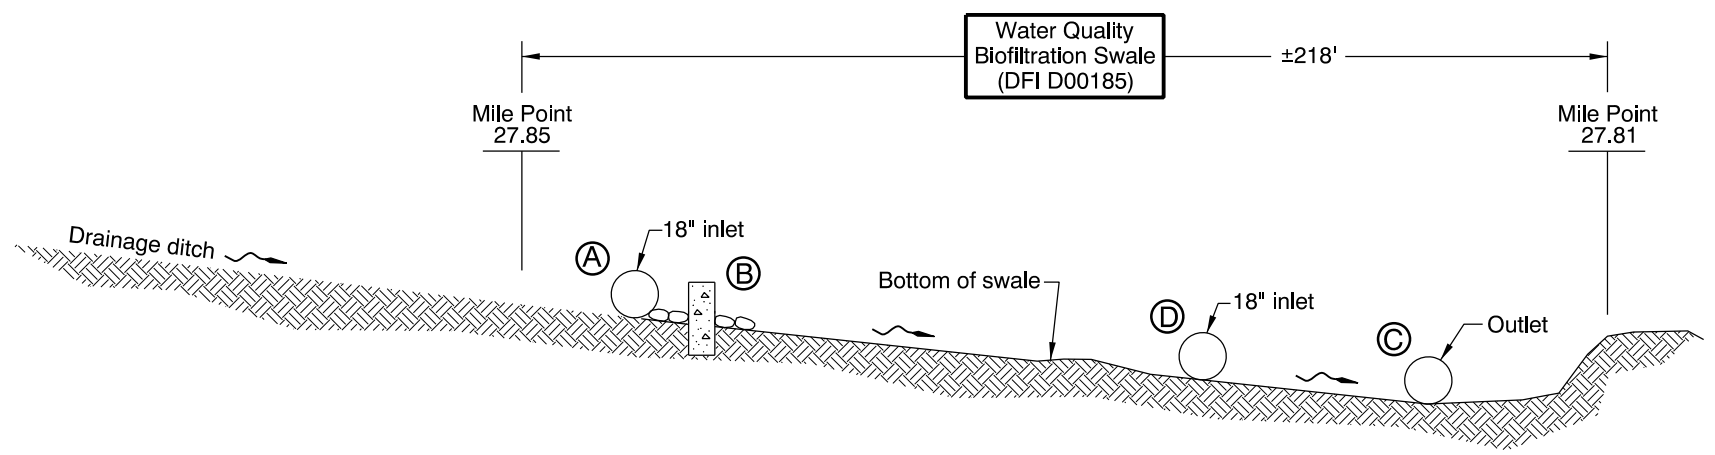

SECTION A-A
N.T.S.

- LEGEND:**
- Photo Location / Direction
 -
 - Riprap And Concrete Flow Spreader At Inlet
 - Swale Outlet; Pipe Diameter Unknown
 -
 - Manhole
 - Inlet
 - Storm Pipe (Facility)
 - Storm Pipe
 - Conveyance Direction
 - Pavement / Facility Flow Path
 - Railroad
 - Riprap

Sht. 1 of 1 OREGON DEPARTMENT OF TRANSPORTATION

Prepared By: J.D. Koziol
 Drafted By: S. Wolfer

DFI D00185
MAINTENANCE DISTRICT 1 HWY 92
WATER QUALITY BIOFILTRATION SWALE
 COLUMBIA HIGHWAY MP 27.81-27.85
 COLUMBIA COUNTY

Appendix B

Content:

- **ODOT Project Plan Sheets**
 - *Cover/Title Sheet*
 - *Water Quality/Detention Plan Sheets*
 - *Other Details*

STATE OF OREGON
DEPARTMENT OF TRANSPORTATION


PLANS FOR PROPOSED PROJECT

REVISED AS CONSTRUCTED
10/1998 CONTRACT C11695
PROJ. MGR.

GRADING, STRUCTURES, PAVING, SIGNING, SIGNALS, & LANDSCAPING
COLUMBIA CITY N.C.L. - WARREN SEC.

COLUMBIA RIVER HIGHWAY (LOWER)

COLUMBIA COUNTY
JANUARY 1996

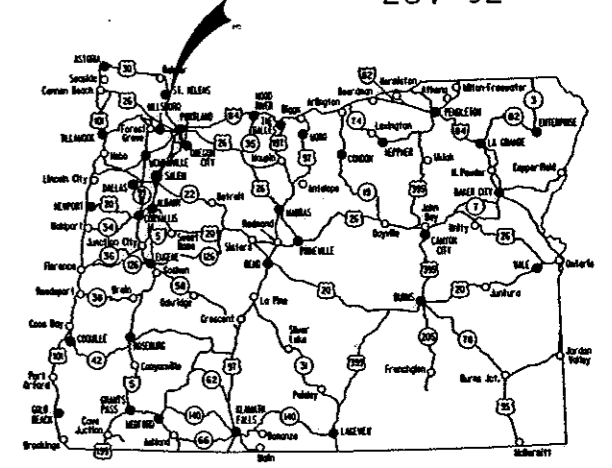

Overall Length Of Project - 7.25 Miles


DO NOT
VIOLATE
TRAFFIC CONTROL
YOU AS WELL AS THE PUBLIC. LET'S ALL WORK TOGETHER TO MAKE THIS JOB SAFE.

INDEX OF SHEETS	
SHEET NO.	DESCRIPTION
1	Title Sheet
1A	Index Of Sheets Cont'd. & Standard Drawing Nos.
2, 2A Thru 2A-6 Incl.	Typical Sections
2B Thru 2B-8 Incl., 2B-8A, 2B-9, 2B-9A, 2B-10, 2B-11, 2B-12, 2B-13 Thru 2B-16 Incl., 2B-16A, 2B-17 Thru 2B-26 Incl.	Details
2C Thru 2C-19 Incl.	Temporary Protection & Direction Of Traffic
2D Thru 2D-9 Incl.	Pipe Data
2E, 2E-2, 2E-3	Summary
3, 3A, 3B, 4, 5, 6, 7, 7A, 7B, 8, 8A, 8B, 8C, 9, 9A, 10, 10A, 10B, 11, 12, 12A, 12B, 13, 14, 14A, 14B, 14C, 15, 16, 16A, 17, 18, 19, 19A, 20, 20A, 21, 21A, 21B, 22, 22A, 22B, 23, 23A, 23B, 23C, 24, 24A, 25, 26, 26A, 26B, 27, 27A, 28, 28A, 29, 30, 30A, 30B, 30C, 31, 32, 33, 33A, 34, 35, 35A, 35B, 36, 37, 37A, 37B	Plans & Profiles
	Landscaping

CONT'D. ON SHT. 1A

NH-S02W(9)
BEGINNING OF PROJECT
STA. 525 + 00 M.P. 33.02

END OF PROJECT NH-S02W(9)
STA. 906 + 50 M.P. 25.77

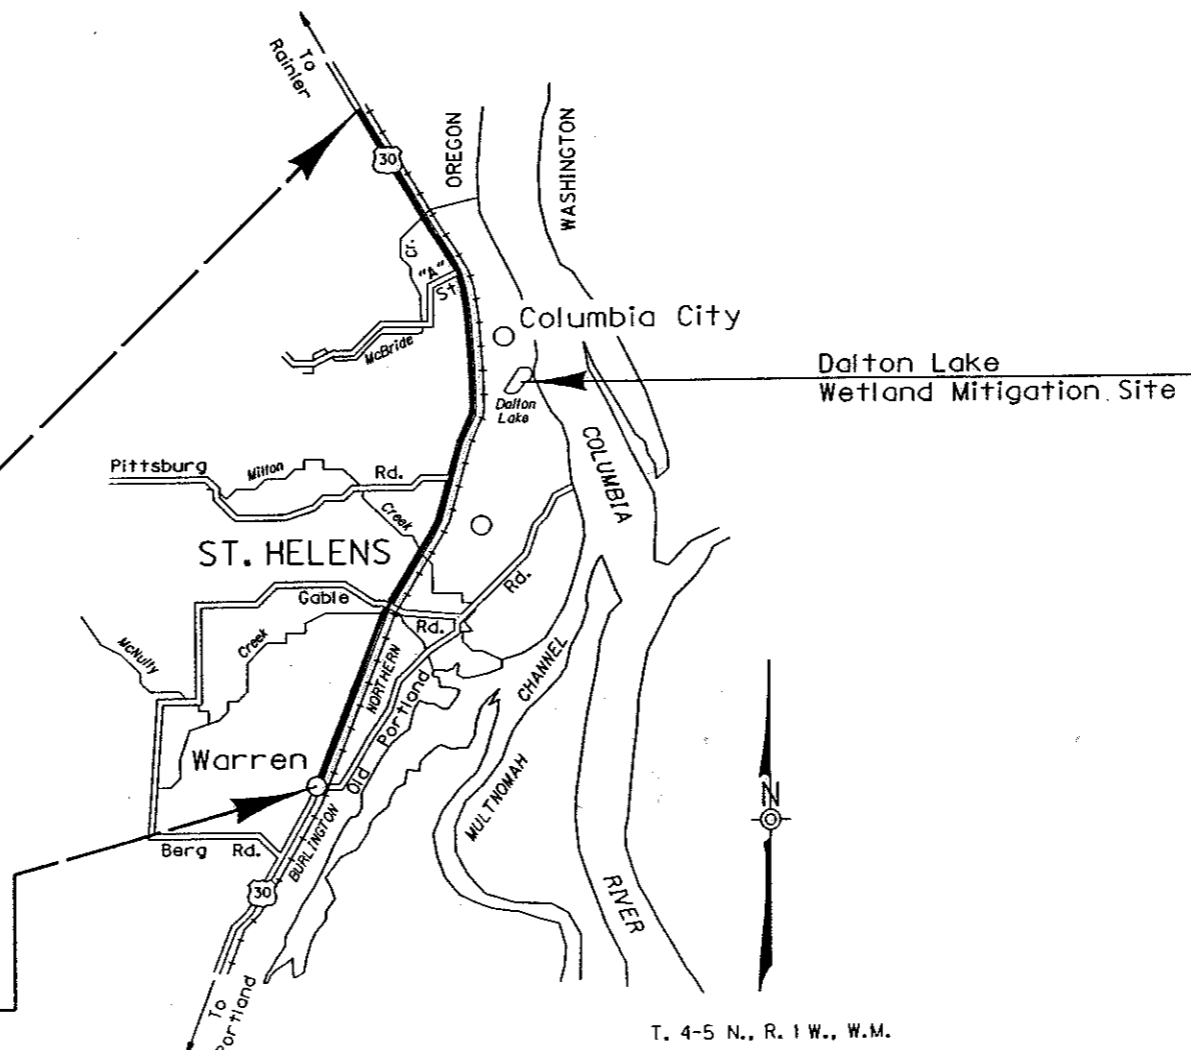

T. 4-5 N., R. 1 W., W.M.

- OREGON TRANSPORTATION COMMISSION
- Henry H. Hewitt CHAIRMAN
 - Susan Brody VICE CHAIRMAN
 - Cynthia J. Ford COMMISSIONER
 - Steven H. Corey COMMISSIONER
 - Stuart Foster COMMISSIONER
 - Kenneth E. Husby INTERIM DIRECTOR OF TRANSPORTATION

PLANS PREPARED BY:



OREGON DEPARTMENT OF TRANSPORTATION
CONCURRENCE

Thomas Dulaney 11/30/95
TECHNICAL SERVICES MANAGING ENGINEER DATE

COLUMBIA CITY N.C.L. - WARREN SEC.
COLUMBIA RIVER HIGHWAY (LOWER)
COLUMBIA COUNTY

FEDERAL HIGHWAY ADMINISTRATION	PROJECT NUMBER	SHEET NO.
REGION 10 OREGON DIVISION	NH-S02W(9)	1






27-NOV-1995 10:48

10/18/98 10:00 0099 10:48

BIO-FILTER SWALE


Bio-Filter Swale Table

Station From	Station To	Left Or Right	Slope A	Slope B	Bottom Width (Ft)	Depth (Ft)	Length (Ft)	Channel Slope (%)
573+00	575+50	Rt	6:1	4:1	4	1	250	1.83
610+50	613+50	Rt	6:1	4:1	4	1	300	1.10
615+20	618+20	Rt	6:1	1 1/2:1	4	1	300	0.57
719+70	720+90	Rt	6:1	4:1	4	1	120	1.57
720+90	722+60	Rt	6:1	4:1	4	1	170	1.33
797+90	800+08	Lt	3:1	2:1	4	1	218	0.83
839+45	-	Lt	2:1	2:1	10	1	160	3.12
856+70	860+75	Lt	4:1	4:1	4	1	405	0.75-2.0
897+37	-	Lt	3:1	3:1	6	1	290	1.20
898+50	900+75	Rt	4:1	1 1/2:1	4	1	225	0.98

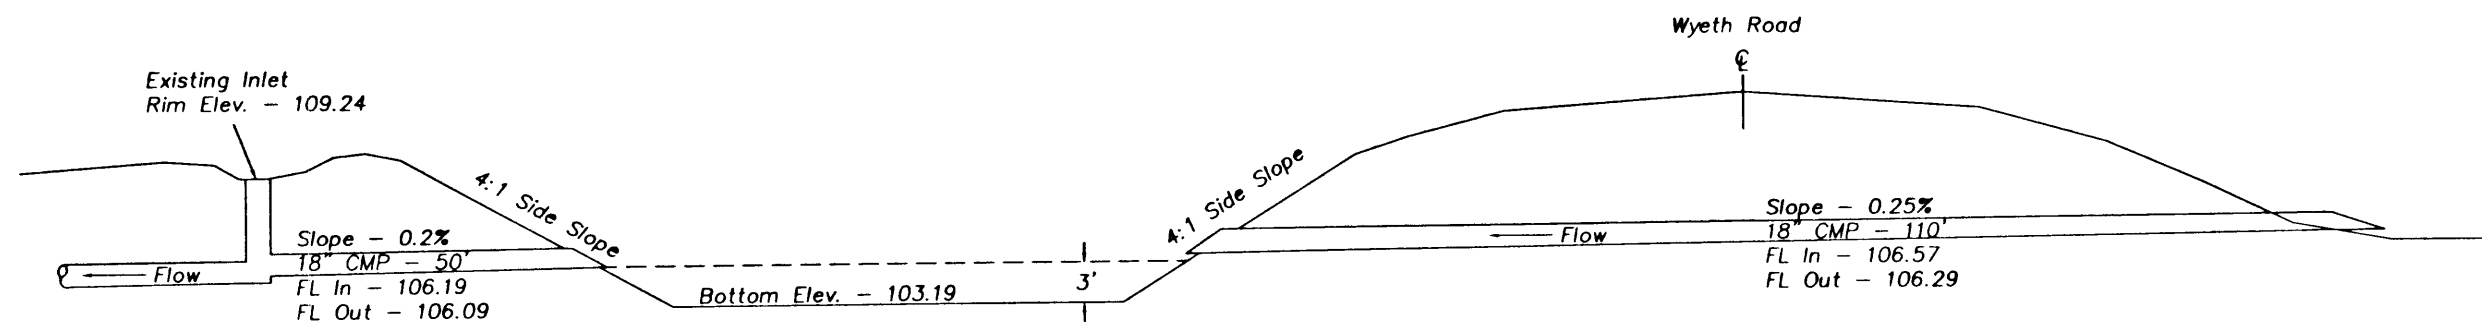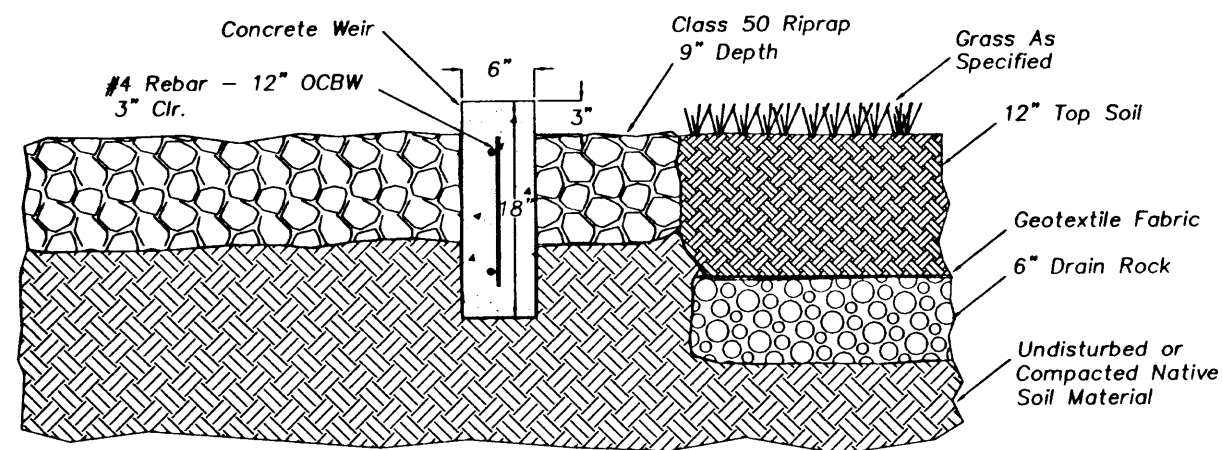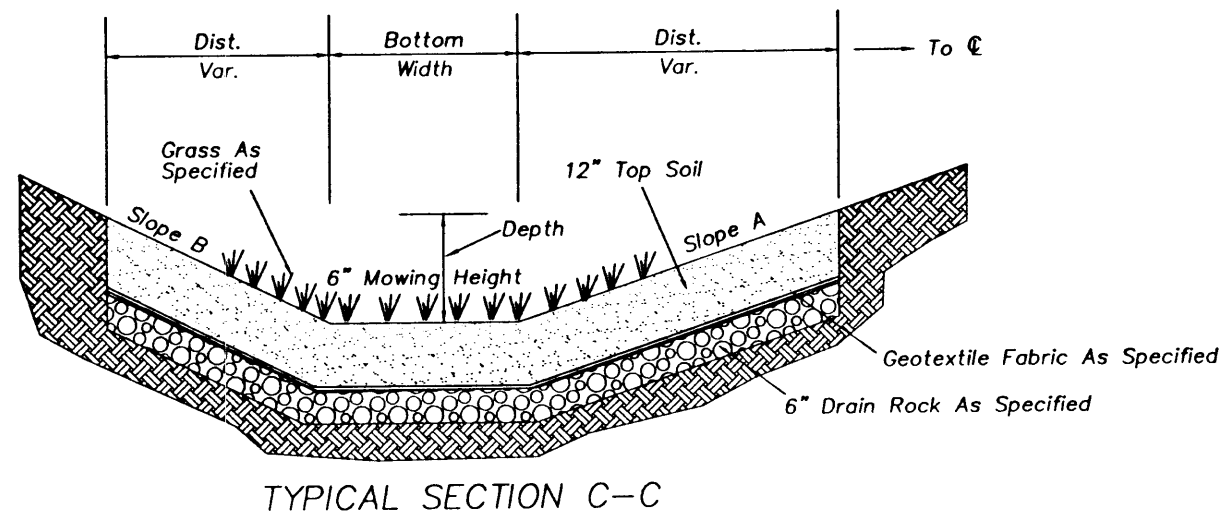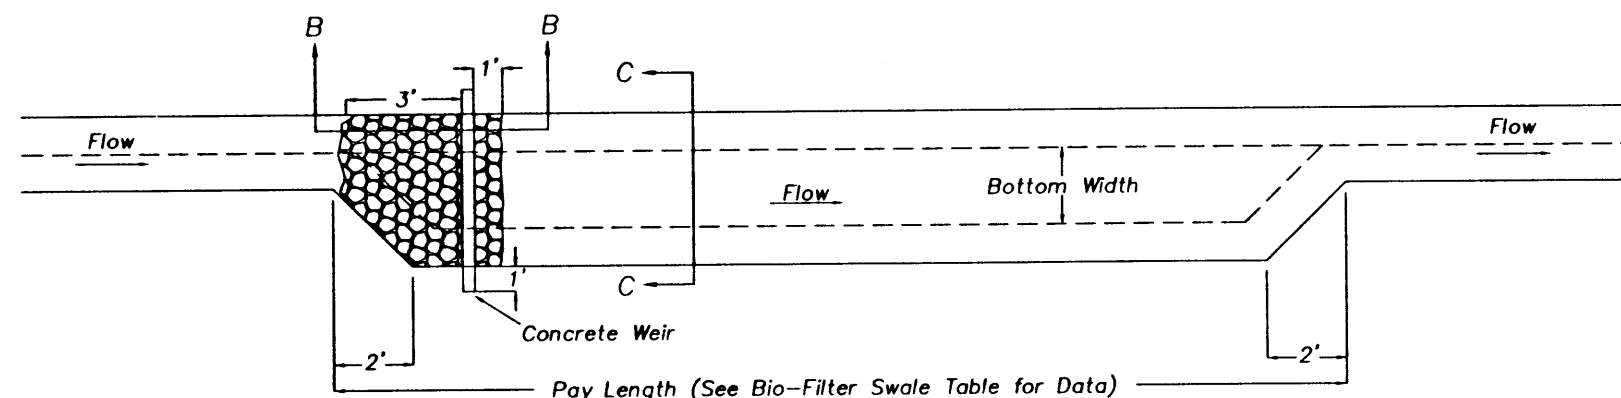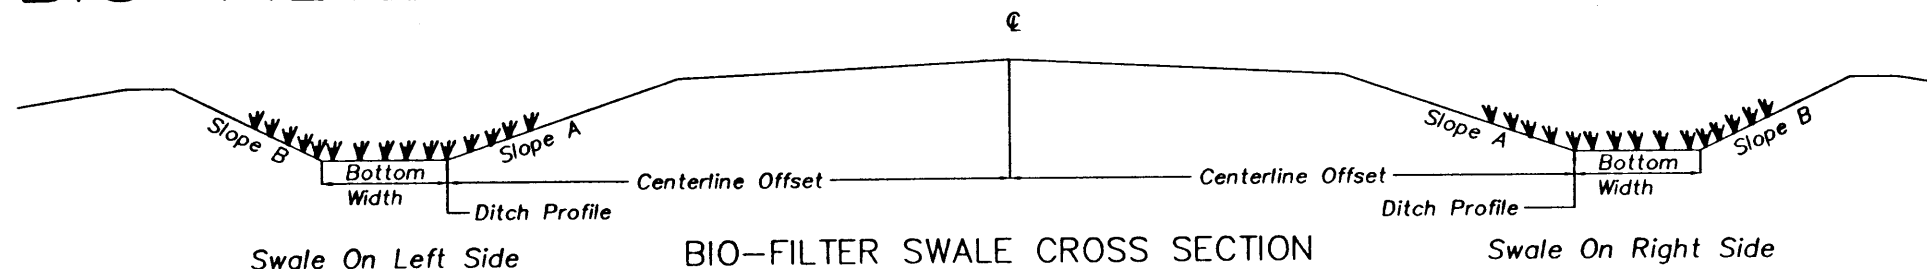

COLUMBIA CITY N.C.L. - WARREN SEC. COLUMBIA RIVER HIGHWAY (LOWER) COLUMBIA COUNTY		
FEDERAL HIGHWAY ADMINISTRATION	PROJECT NUMBER	SHEET NO.
REGION 10	OREGON DIVISION	2B-17

2B-17.DWG 05-OCT-1995 MOM

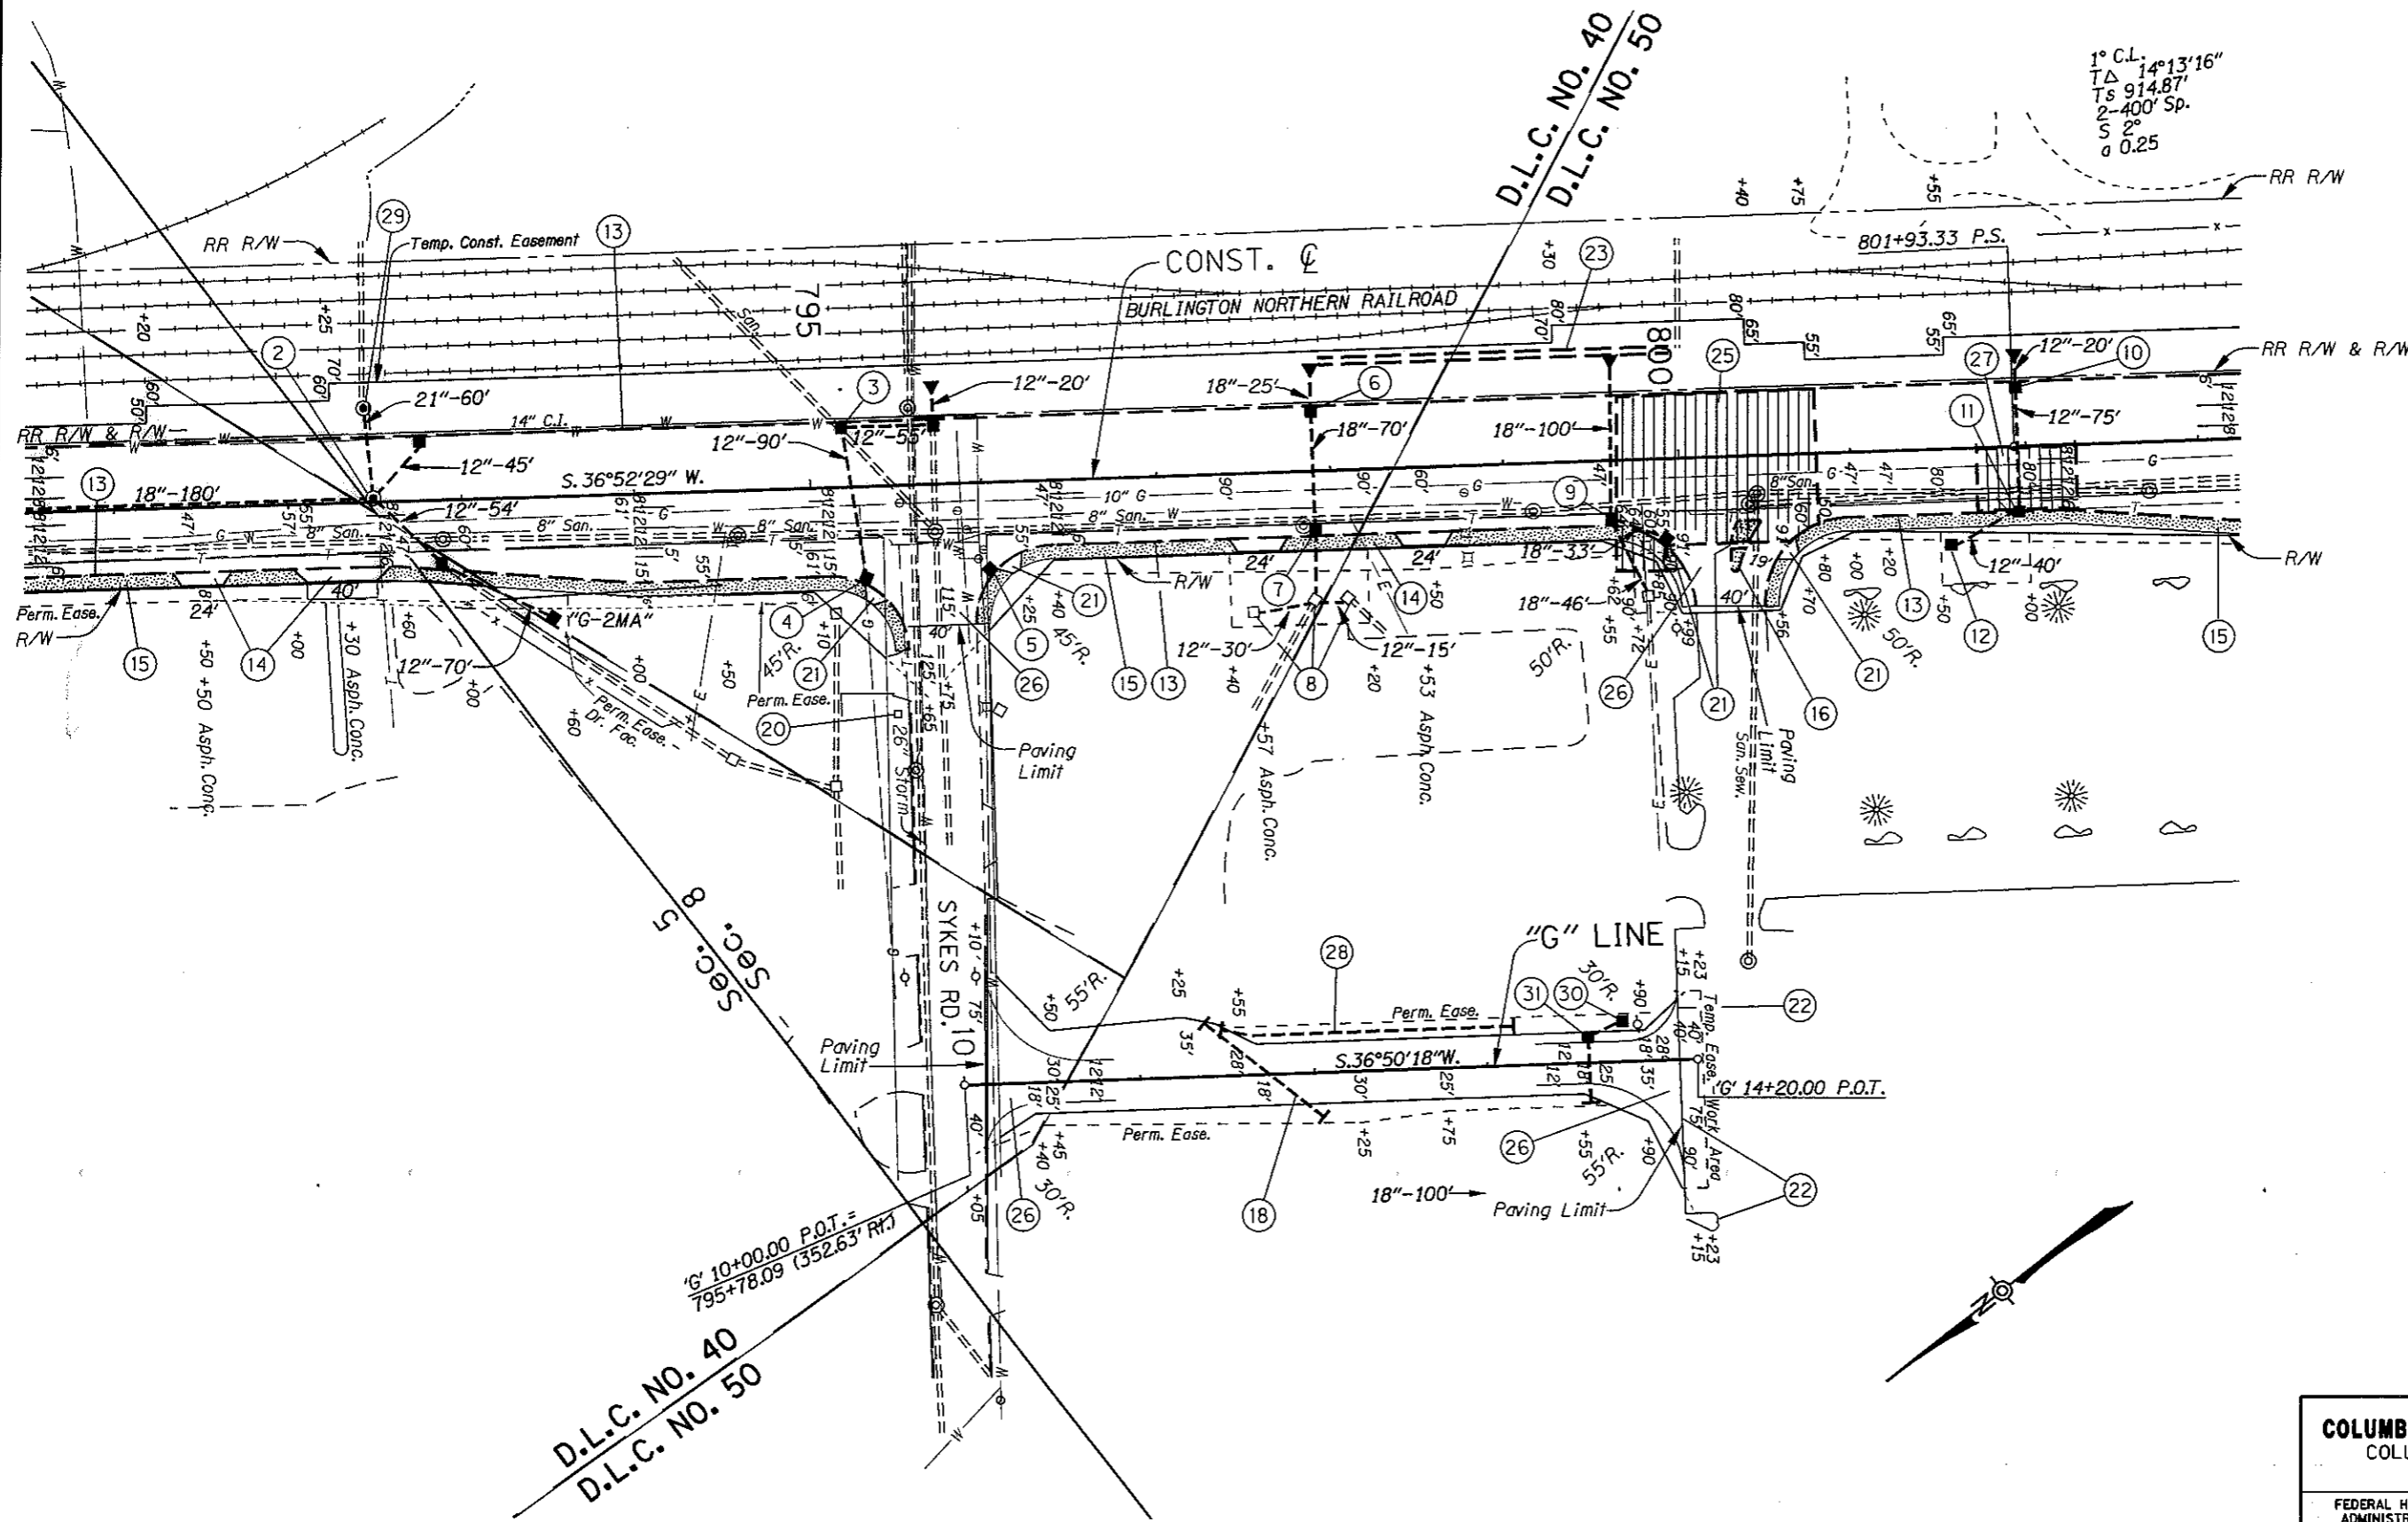

1° C.L. 14°13'16"
TΔ 914.87'
2-400' Sp.
S 2°
a 0.25

D.L.C. NO. 40
D.L.C. NO. 50

COLUMBIA CITY N.C.L. - WARREN SEC.
COLUMBIA RIVER HIGHWAY (LOWER)
COLUMBIA COUNTY

FEDERAL HIGHWAY ADMINISTRATION		PROJECT NUMBER	SHEET NO.
REGION 10	OREGON DIVISION		26

26-PLAN.DGN 26-SEP-1995 T.J.T. #####

- ② Sta. 792+50
Const. Manhole
Const. Type "G-2MA" Inlet
Const. Type "CG-2" Inlet - 2
Inst. 12" Sew. Pipe - 169'
Inst. 18" Sew. Pipe - 180'
Inst. 21" Sew. Pipe - 60'
Tr. Exc. - 90 C.Y.
Tr. Rock Exc. - 95 C.Y.
- ③ Sta. 795+20, Lt.
Const. Type "CG-2" Inlet
Inst. 12" Sew. Pipe - 165'
Const. Paved End Slope
Tr. Exc. - 35 C.Y.
- ④ Sta. 795+30, Rt.
Const. Type "CG-2" Inlet - 2
Tr. Exc. - 25 C.Y.
- ⑤ Sta. 796+05, Rt.
Const. Type "CG-2" Inlet
- ⑥ Sta. 797+90, Lt.
Const. Type "CG-2" Inlet
Inst. 18" Sew. Pipe - 95'
Const. Paved End Slope
Tr. Exc. - 55 C.Y.
- ⑦ Sta. 797+90, Rt.
Const. Type "CG-2" Inlet
Inst. 18" Sew. Pipe - 35'
Conn. To Extg. Inlet
Tr. Exc. - 20 C.Y.
- ⑧ Sta. 797+90, Rt.
Inst. 12" Sew. Pipe - 45'
Conn. to Extg. Inlets - 3
Tr. Exc. - 15 C.Y.
- ⑨ Sta. 799+90, Rt.
Const. Type "CG-2" Inlet - 2
Inst. 18" Sew. Pipe - 179'
Conn. to Extg. Inlet
Const. Paved End Slope
Tr. Exc. - 80 C.Y.
- ⑩ Sta. 801+95, Lt.
Const. Type "CG-2" Inlet
Inst. 12" Sew. Pipe - 95'
Const. Paved End Slope
Tr. Exc. - 38 C.Y.
- ⑪ Sta. 801+95, Rt.
Const. Type "CG-2" Inlet
Inst. 12" Sew. Pipe - 40'
Tr. Exc. - 15 C.Y.
- ⑫ Sta. 801+70, Rt.
Const. Type "G-2MA" Inlet
- ⑬ Const. Type "A" Mod. Curb
(For Detail, See Sht. 2B-5)
- ⑭ Const. P.C. Conc. Dwy. Type "A" - 4
Const. Asph. Conc. Dwy. Connection - 4
(For Detail, See Sht. 2B-6)


- ⑮ Const. P.C. Conc. Walk
(For Planting Detail, See Sheets 37, 37A & 37B)
- ⑯ Sta. 800+30, Rt.
Const. Appr.
Const. Type "C" Non-Mountable Island
(See Drg. No. 2077A)
(For Detail, See Sheet 2B-10)
- ⑰ Sta. "G" 11+80
Inst. 18" Culv. Pipe - 87'
Tr. Exc. - 30 C.Y.
- ⑱ Inst. Single Mailbox Support
Const. Conc. Collar
- ⑲ Const. Sidewalk Ramp - 5
- ⑳ Sta. 797+90 To Sta. 800+08, Lt.
Const. Swale - 245 S.Y.
Dt. Exc. - 110 C.Y.
(For Details, See Sheet 2B-17)
- ㉑ Contaminated Soil Removal (Site 3)
Exc. - 1,300 C.Y.
Straw Bales - 288
Visquine - 222 Sq. Yd.
Aggr. Base - 2,600 Ton
Temp. Const. Fence - 300 Lin. Ft.
Nutrients - 4,800 lbs.
- ㉒ Const. Road Conn. - 4
- ㉓ Contaminated Soil Removal (Site 4)
Exc. - 180 C.Y.
Straw Bales - 288
Visquine - 222 Sq. Yd.
Aggr. Base - 360 Ton
Temp. Const. Fence - 160 Lin. Ft.
Nutrients - 4,800 lbs.
- ㉔ Sta. "G" 11+46 To Sta. "G" 13+16
Inst. 4" Drain Pipe - 170'
Granular Drain Backfill - 18 C.Y.
Drainage Geotextile - 145 Sq. Yd.
Tr. Exc. - 18 C.Y.
(See Drg. No. 2091A)
- ㉕ Sta. 792+45, 55' Lt.
Const. Pollution Control Manhole With Grate
Connect To Extg. Pipe
(For Details, See Sheet 2B-9A)
- ㉖ Sta. 13+80, 25' Lt.
Const. Type "G-2MA" Inlet
Inst. 8" Sew. Pipe - 30'
- ㉗ Sta. 13+57, 15' Lt.
Const. Type "CG-2" Inlet
Inst. 8" DIP - 35'

26-PLAN.DGN ***** 16-OCT-1995 T.JT

COLUMBIA CITY N.C.L. - WARREN SEC.
COLUMBIA RIVER HIGHWAY (LOWER)
COLUMBIA COUNTY

FEDERAL HIGHWAY ADMINISTRATION		PROJECT NUMBER	SHEET NO.
REGION 10	OREGON DIVISION		26A

"CONST" LINE

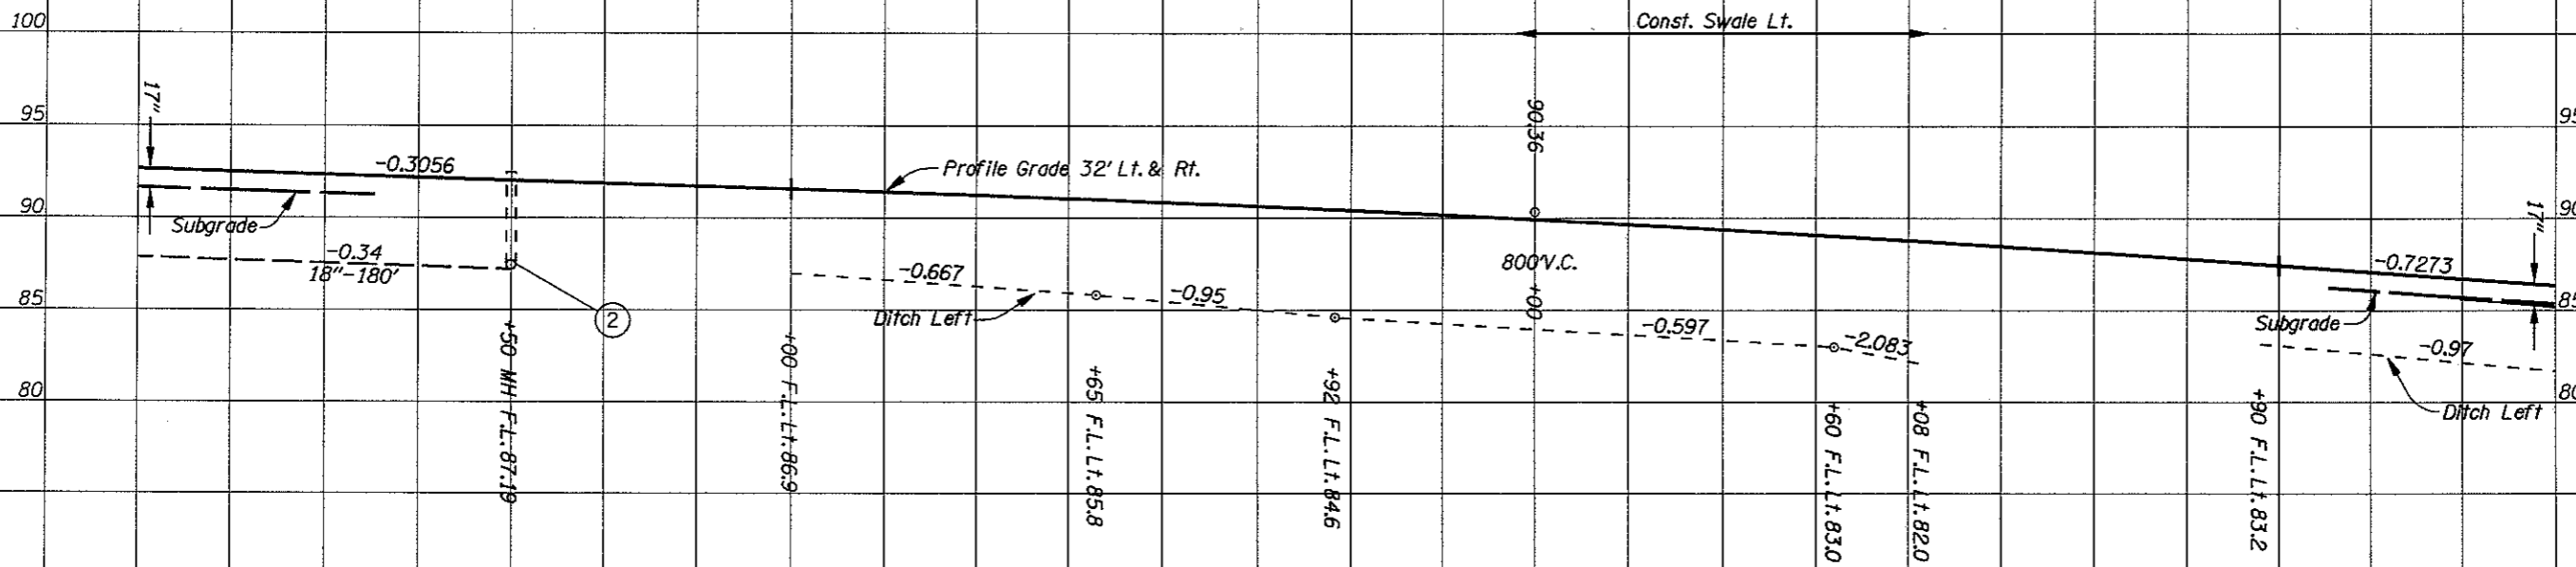

STAGE I

STAGE II

790


795

800

"GE" LINE
(For Plan, See Sheet 27)

"G" LINE
(For Plan, See Sheet 26)

"GW" LINE
(For Plan, See Sheet 27)

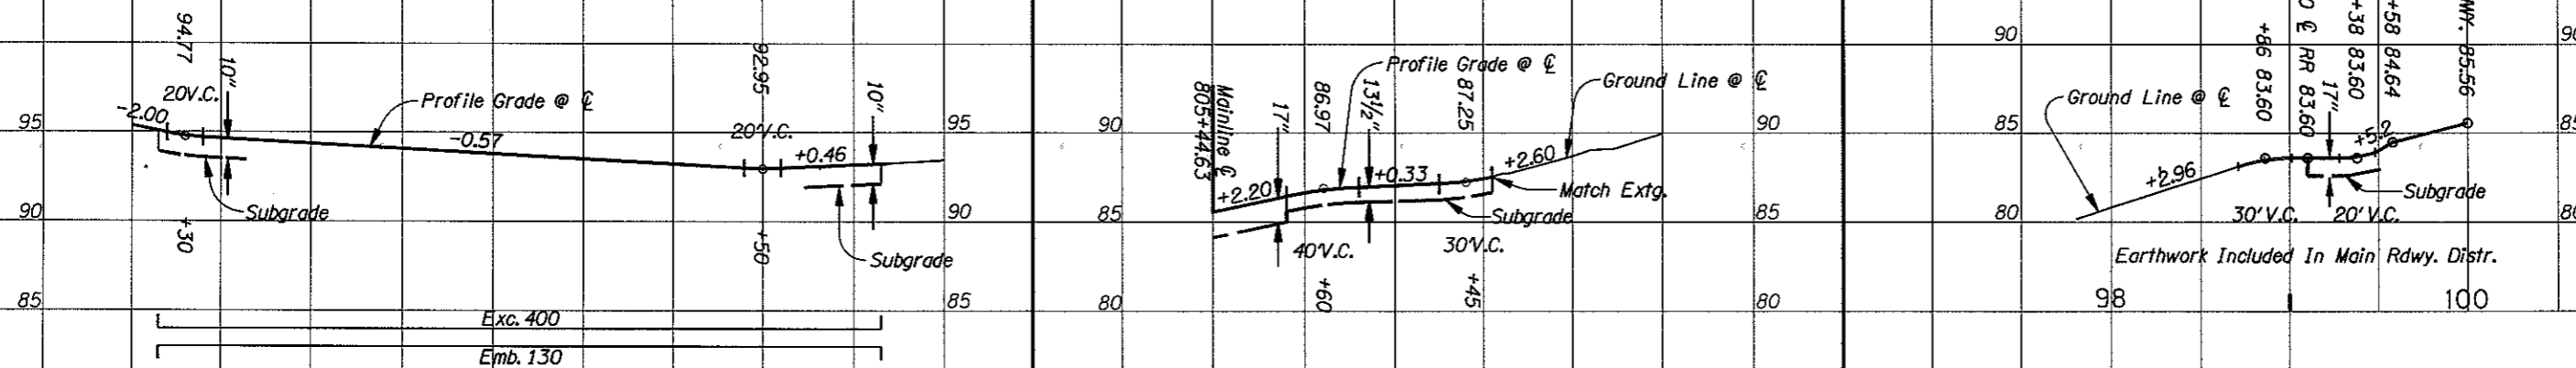

Exc. 400

Emb. 130

Exc. 110

Emb. 20

COLUMBIA CITY N.C.L. - WARREN SEC.
COLUMBIA RIVER HIGHWAY (LOWER)
COLUMBIA COUNTY

FEDERAL HIGHWAY ADMINISTRATION		PROJECT NUMBER	SHEET NO.
REGION 10	OREGON DIVISION		26B