

# OPERATION & MAINTENANCE MANUAL

**DFI No. : D00186**

**Facility Type: Water Quality Vault**



**JUNE, 2011**

**INDEX**

**1. IDENTIFICATION..... 1**

**2. FACILITY CONTACT INFORMATION..... 1**

**3. CONSTRUCTION..... 1**

**4. STORM DRAIN SYSTEM AND FACILITY OVERVIEW ..... 2**

**5. FACILITY HAZ MAT SPILL FEATURE(S)..... 5**

**6. AUXILIARY OUTLET (HIGH FLOW BYPASS)..... 6**

**7. MAINTENANCE REQUIREMENTS..... 6**

**8. WASTE MATERIAL HANDLING..... 7**

**APPENDIX A: Operational Plan and Profile Drawing(s)**

**APPENDIX B: ODOT Project Plan Sheets**

## 1. Identification

Drainage Facility ID (DFI): **D00186**

Facility Type: Water Quality Vault

Construction Drawings: (V-File Number) 26V-092

Location: District: 1 (Old 2A)

Highway No.: 092

Mile Post: 27.57 (beg./end)

Description: This facility is located along the east side Hwy. 92 just north of McNulty Creek, south of Firllok Park Blvd., and adjacent to the northbound travel lanes and railroad tracks. Unobstructed access can be obtained from the right shoulder of Hwy. 92 just north of McNulty Creek.

## 2. Facility Contact Information

Contact the Engineer of Record, Region Technical Center, or Geo-Environmental's Senior Hydraulics Engineer for:

- Operational clarification
- Maintenance clarification
- Repair or restoration assistance

### Engineering Contacts:

Region Technical Center Hydro Unit Manager

Or

Geo-Environmental Senior Hydraulics Engineer (503) 986-3365.

## 3. Construction

Engineer of Record:

Consultant Designer - W&H Pacific, William Evans,  
P.E., (503) 362-4675

Facility construction: 1996

Contractor: N/A

#### **4. Storm Drain System and Facility Overview**

This water quality vault is an underground media filter facility designed to treat stormwater runoff. The system is an ODOT internally designed facility, providing treatment using filtration by removing target pollutants from the water via the use of a compost filter bed, wrapped in filter fabric, overtop a series of eight perforated drain pipes inside the vault. The intent of the filter media is to remove solids, dissolved metals, oil and total nutrients from the water by trapping particulate matter above and within the porous composition of the compost filter media bed. See the ODOT project plan sheets, Appendix B, for further information.

This facility is an open-unit compost stormwater filter situated the middle of a ditch alignment where ditch flows enter the vault through an open-ended rectangular inlet. The vault is an on-line facility designed to treat low and high flows, providing both treatment and high flow conveyance in a single facility. The facility is covered with two large steel plates and is essentially a large compost filter bed wrapped in filter fabric; overtop a series of eight perforated drain pipes, with a low flow bypass pipe running alongside. The facility is located along the east side Columbia River Highway (Hwy092) just north of McNulty Creek, south of Firlok Park Blvd., and adjacent to the northbound travel lanes and railroad tracks. Unobstructed access can be obtained from the right shoulder of Hwy. 92 just north of McNulty Creek.

Stormwater is conveyed from the north toward the facility via the ditch and also from a 12-inch pipe outfall from the west as part of a localized storm piping system running alongside Hwy. 92; see the Operational Plan, Appendix A. Water quality treatment occurs within the vault before the stormwater outfalls to McNulty Creek. The Operational Plan shows the typical flow path inside the vault – how treated water enters the vault at Point A, how low flows are conveyed through a 4-inch PVC pipe around the compost bed and how the vault is utilized as the water level rises in the ditch or a high flow event occurs. Increasing water levels in the vault's inlet bay are conveyed through a retrofitted set of three riser pipes/inlet hood before overtopping a scum baffle and a set of weirs and energy dissipators placed inline with the compost filter media bed; see the Operational Plan. Periodic maintenance of the compost bed and vault is required to maximize water quality treatment efficiencies.

A. Maintenance equipment access:

The water quality vaults are accessible via the right shoulder of Hwy. 92 just north of McNulty Creek.

B. Heavy equipment access into facility:

- Allowed (no limitations)
- Allowed (with limitations)
- Not allowed

C. Special Features:

- Amended Soils
- Porous Pavers
- Liners (filter fabric encases the compost filter media)
- Underdrains (perforated drain pipe located beneath the filter media)



Photo 1: Looking south at the facility inlet and opening to the vault's inlet bay.



Photo 2: View of the facility inlet and vault opening, riser pipes and inlet bay.



Photo 3: Closer view of the facility inlet, vault's riser pipes/inlet hood and inlet bay.



Photo 4: View of the riser pipes and inlet hood as they would convey water to the filter bed.



Photo 5: View of the riser pipes/inlet hood with debris seen in inlet bay.

## 5. Facility Haz Mat Spill Feature(s)

The water quality vault can be used to store a volume of liquid by blocking the 18-inch diameter outlet pipe located at the outlet of the vault to

McNulty Creek. This outlet pipe is noted as point B in Operational Plan; Appendix A.

## 6. Auxiliary Outlet (High Flow Bypass)

Auxiliary Outlets are provided if the primary outlet control structure can not safely pass the projected high flows. Broad-crested spillway weirs and over flow risers are the two most common auxiliary outlets used in stormwater treatment facility design. The auxiliary outlet feature is either a part of the facility or an additional storm drain feature/structure.

The auxiliary outlet feature for this facility is:

Designed into facility

Water quality vaults can be designed for use as either on-line or off-line facilities, though typically planned as on-line systems. As mentioned, this particular facility is an on-line facility designed to treat low and high flows alike, providing water quality treatment and high flow conveyance in a single facility. Lower flows exit through the 4-inch PVC by-pass pipe and conveyed around the vault, while higher flows are passed through the facility and passed overtop the outlet stem wall and scum baffle at the vault's outlet; see Section A-A of the Operational Plan, Appendix A.

## 7. Maintenance Requirements

Routine maintenance table for non-proprietary stormwater treatment and storage/detention facilities have been incorporated into ODOT's Maintenance Guide. These tables summarize the maintenance requirements for ponds, swales, filter strips, bioslopes, and detention tanks and vaults. Special maintenance requirements in addition to the routine requirements are noted below when applicable.

The ODOT Maintenance Guide can be viewed at the following website:

<http://www.oregon.gov/ODOT/HWY/OOM/MGuide.shtml>

Maintenance requirements for proprietary structures, such as underground water quality manholes and/or vaults with filter media are noted in Appendix C when applicable.

The following stormwater facility maintenance table (See ODOT Maintenance Guide) should be used to maintain the facility outlined in this Operation and Maintenance Manual or follow the Maintenance requirements outlined in Appendix C when proprietary structure is selected below:



Mark as Required and always include Table 1:

- Table 1 (general maintenance)
- Table 2 (stormwater ponds)
- Table 3 (water quality biofiltration swales)
- Table 4 (water quality filter strips)
- Table 5 (water quality bioslopes)
- Table 6 (detention tank)
- Table 7 (detention vault)
- Appendix C (proprietary structure)
- Special Maintenance requirements:

Note: Special maintenance Requirements Require Concurrence from ODOT SR Hydraulics Engineer.

## 8. Waste Material Handling

Material removed from the facility is defined as waste by DEQ. Refer to the roadwaste section of the ODOT Maintenance Yard Environmental Management System (EMS) Policy and Procedures Manual for disposal options: <http://egov.oregon.gov/ODOT/HWY/OOM/EMS.shtml>


Contact any of the following for more detailed information about management of waste materials found on site:

ODOT Clean Water Unit	(503) 986-3008
ODOT Statewide Hazmat Coordinator	(503) 229-5129
ODOT Region Hazmat Coordinator	(503) 731-8304
ODEQ Northwest Region Office	(503) 229-5263


# Appendix A

## Content:


- **Operational Plan and Profile Drawing(s)**

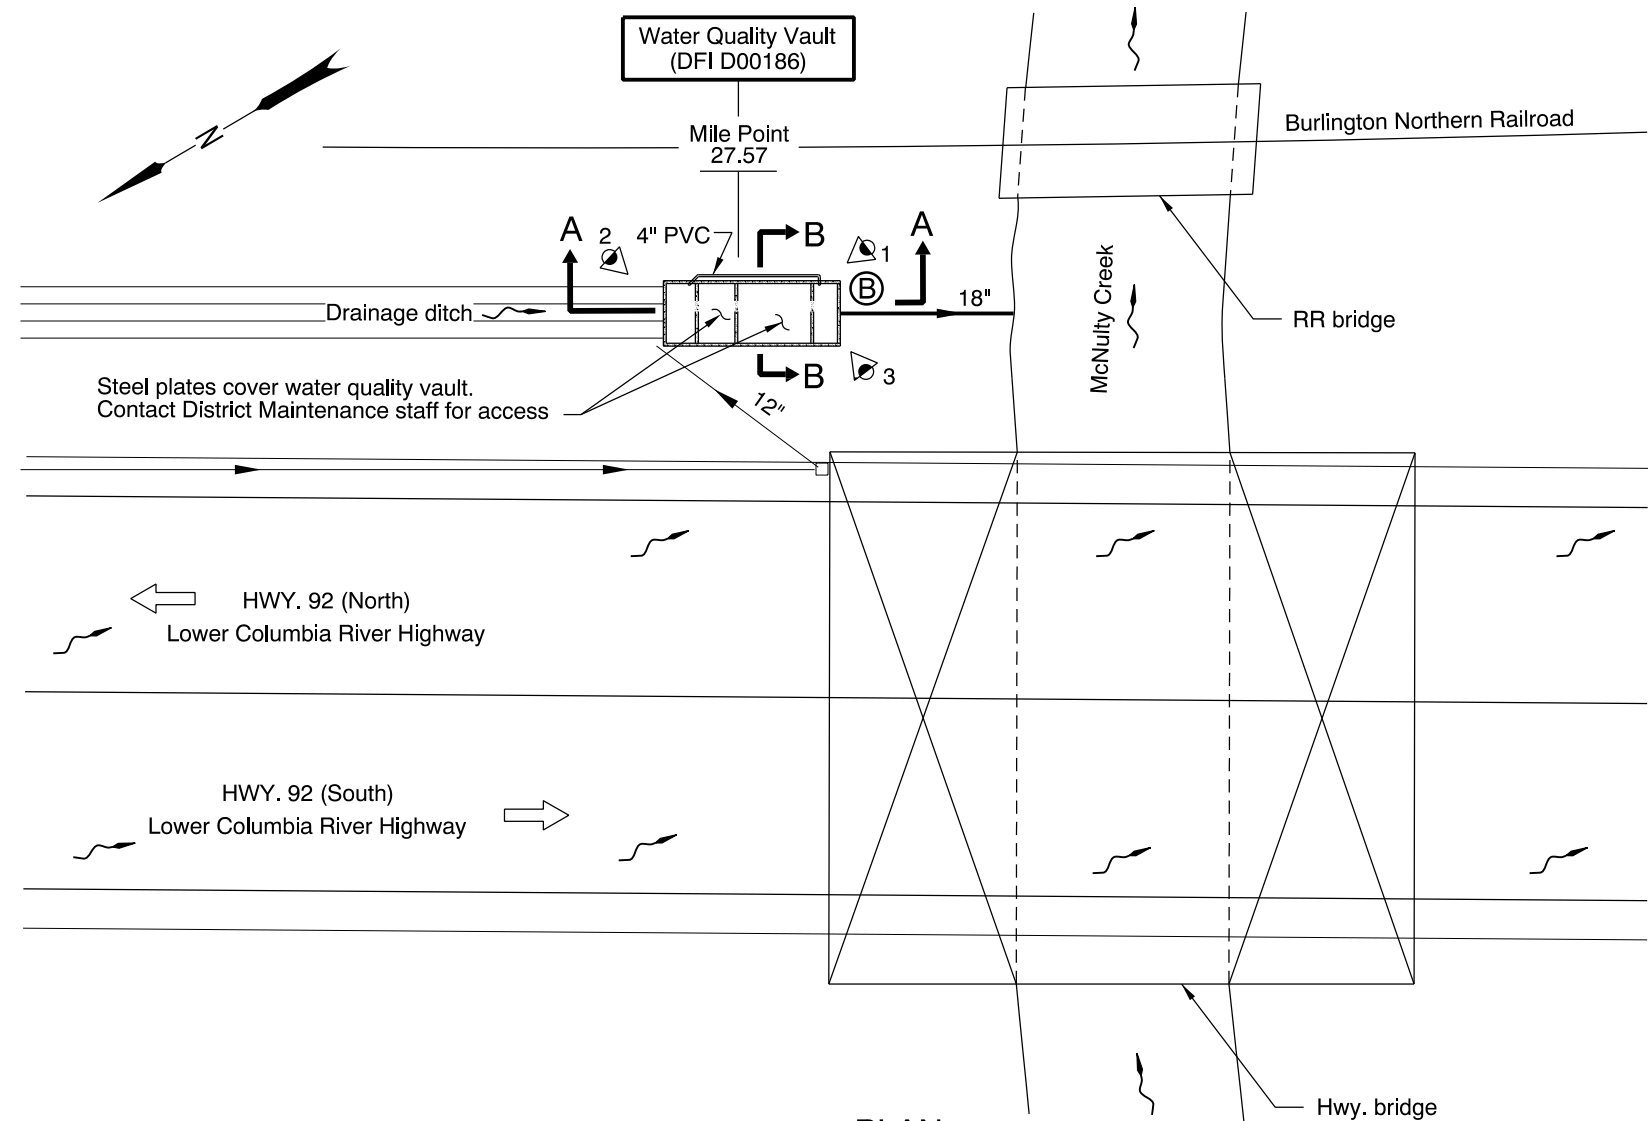

**PLAN**  
N.T.S.

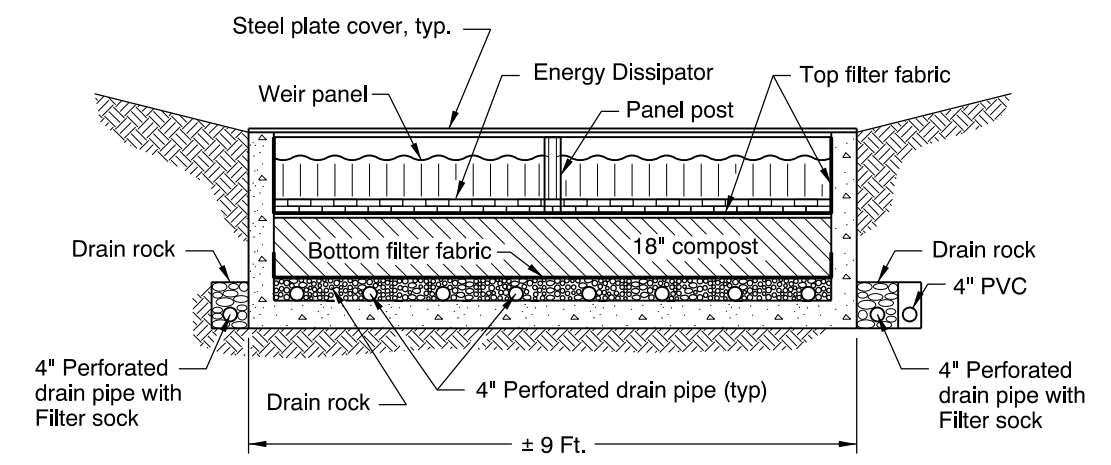

**SECTION B-B**  
N.T.S.

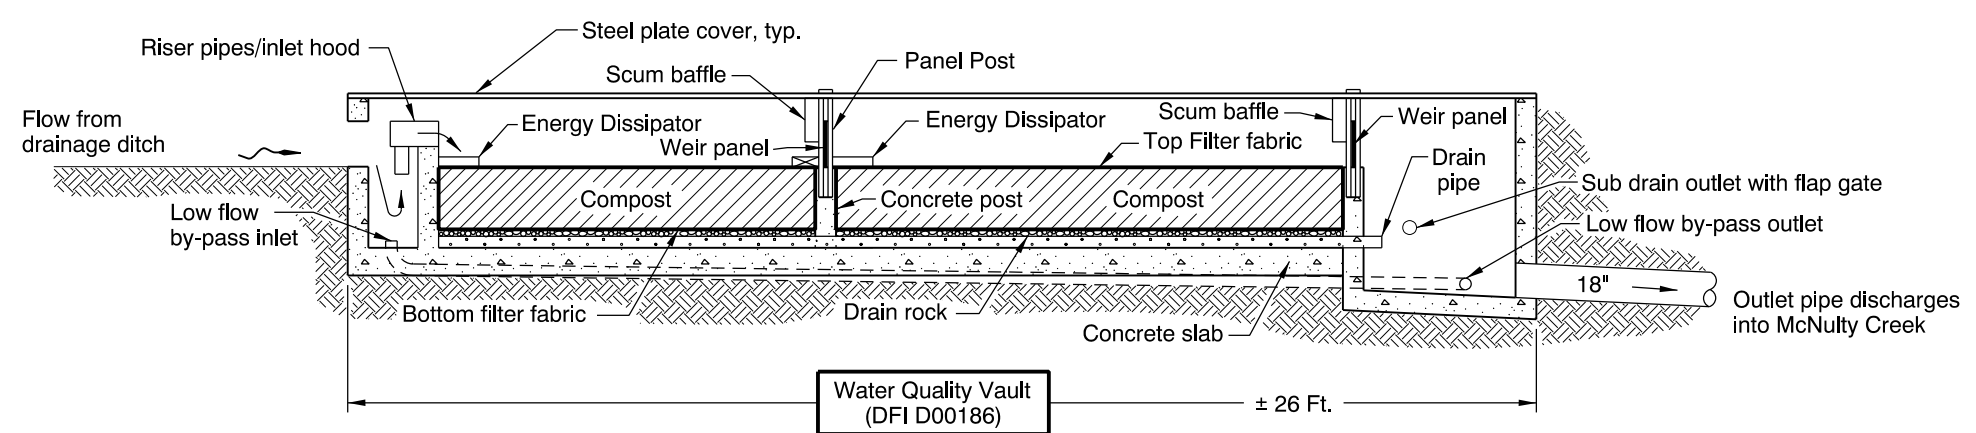

**SECTION A-A**  
N.T.S.

- LEGEND:**
- Photograph Location / Direction
  - Vault Inlet
  - Vault Outlet
  - Manhole
  - Inlet
  - Storm Pipe (Facility)
  - Storm Pipe
  - Conveyance Direction
  - Pavement / Facility Flow Path

Sht. 1 of 1 OREGON DEPARTMENT OF TRANSPORTATION

Prepared By: J.D. Koziol  
Drafted By: Ed Gahan/HDR

**DFI D00186**  
**MAINTENANCE DISTRICT 1 HWY 92**  
**WATER QUALITY VAULT**  
LOWER COLUMBIA RIVER HWY MP 27.57  
COLUMBIA COUNTY

# Appendix B







## Content:

- **ODOT Project Plan Sheets**
  - *Cover/Title Sheet*
  - *Water Quality/Detention Plan Sheets*
  - *Other Details*



NOT REVISED AS CONSTRUCTED  
10/98 CONTRACT 11695

# COMPOST STORMWATER FILTER OPEN UNITS

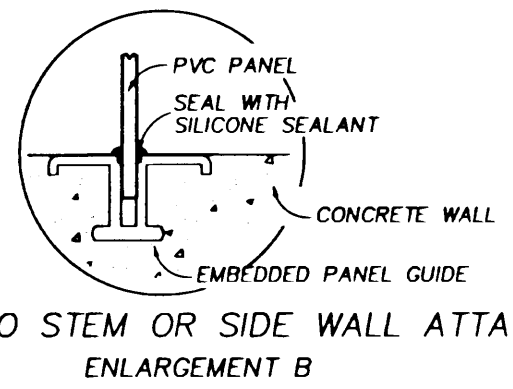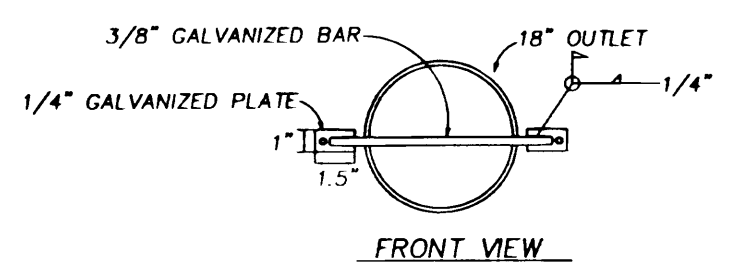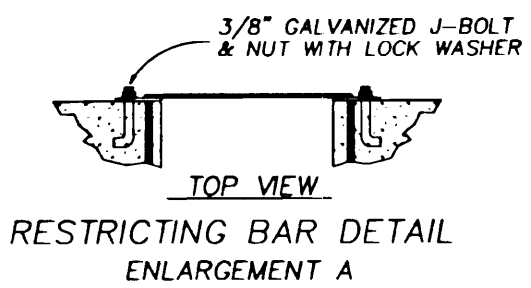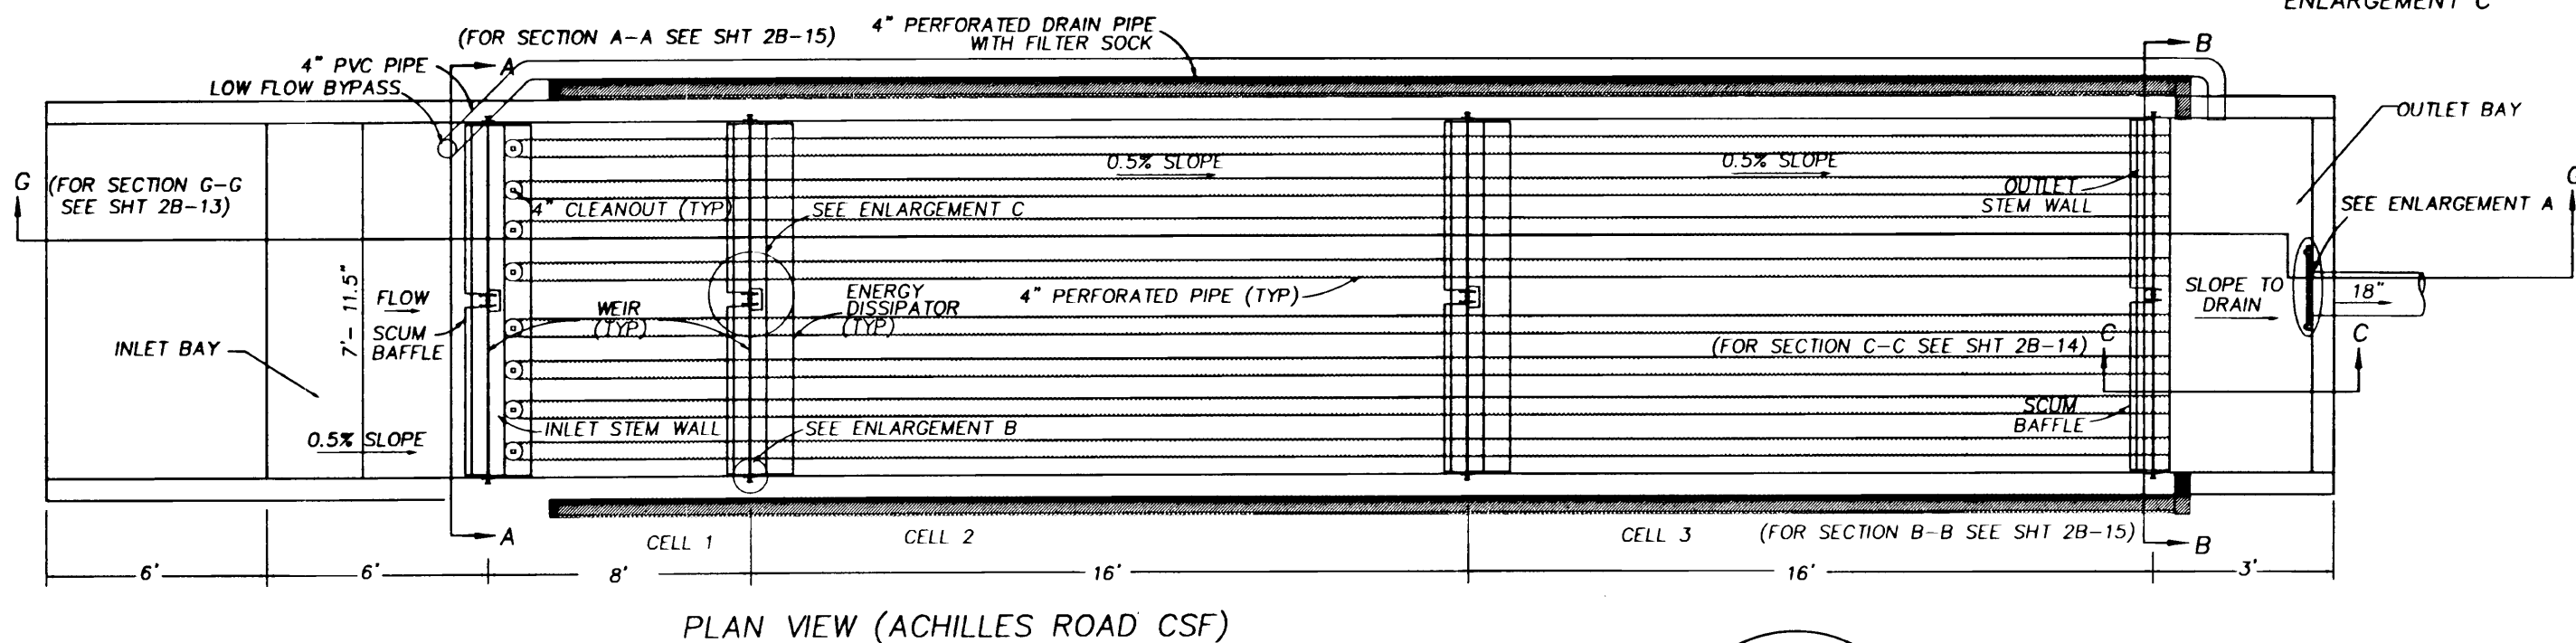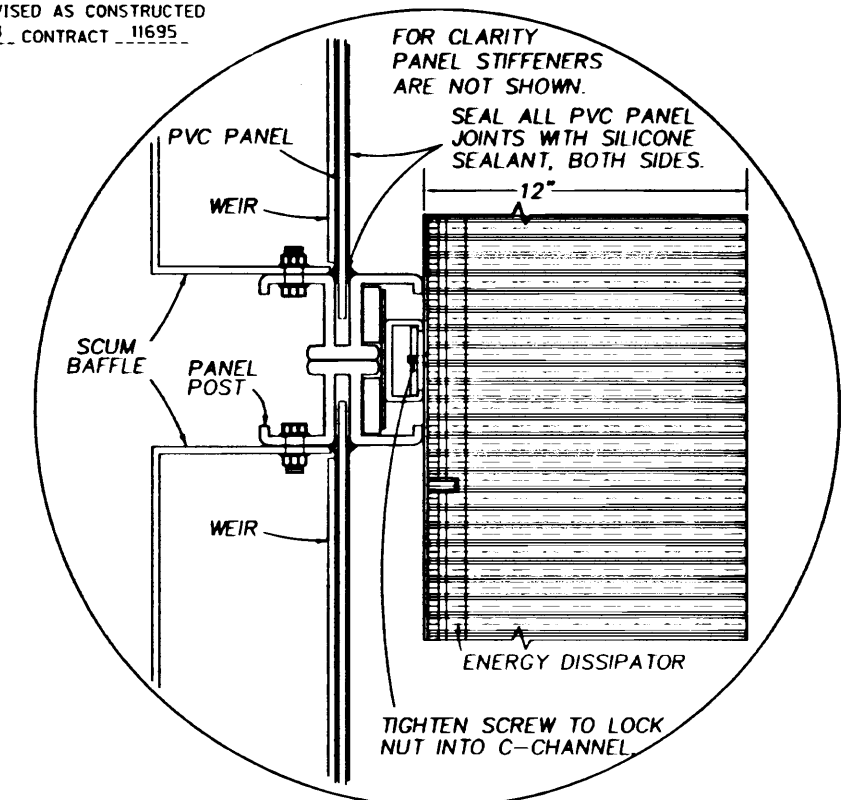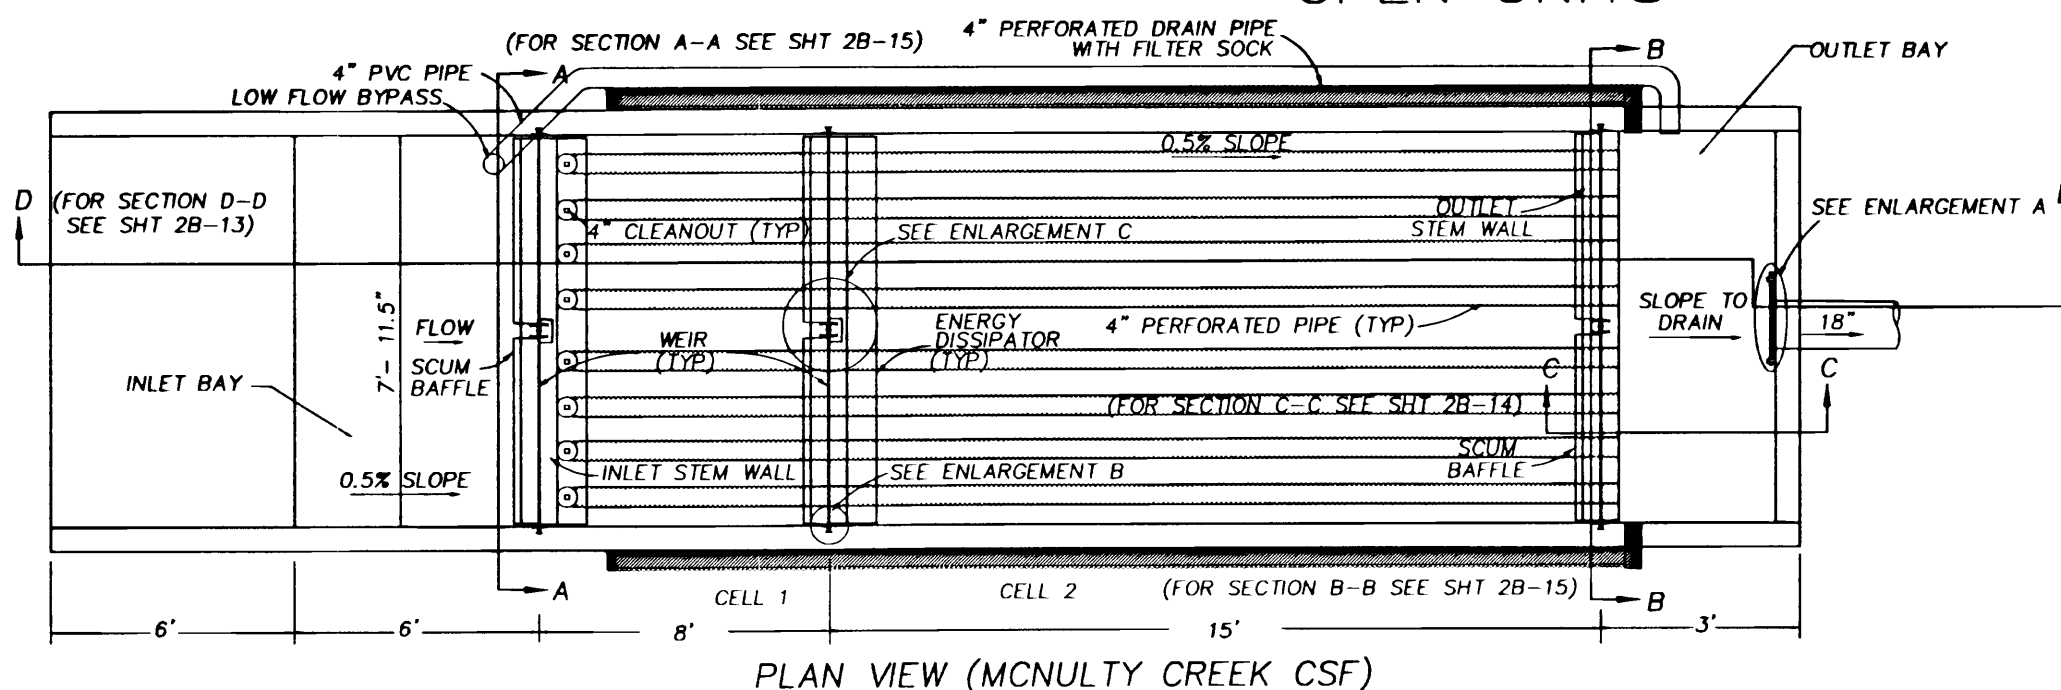

COLUMBIA CITY N.C.L. - WARREN SEC. COLUMBIA RIVER HIGHWAY (LOWER) COLUMBIA COUNTY		
FEDERAL HIGHWAY ADMINISTRATION	PROJECT NUMBER	SHEET NO.
REGION 10	OREGON DIVISION	2B-12

2B-12.DWG 12-OCT-1995 MCM

# COMPOST STORMWATER FILTER OPEN UNITS

NOT REVISED AS CONSTRUCTED  
10/98 CONTRACT 11695

### NOTES:

- ① FOR CLARITY, FIRST WEIR AND BAFFLE ARE NOT SHOWN.
- ② ASSEMBLE WEIRS, BAFFLES, POSTS AND PANELS PER MANUFACTURER'S INSTRUCTIONS. SEAL ALL JOINTS WITH SILICON SEALANT.
- ③ LEVEL WEIR WITH LEVELING BOLTS.
- ④ FILTER FABRIC SHALL EXTEND 6" ABOVE THE BASE OF THE COMPOST ON ALL FOUR SIDES. FASTEN FABRIC TO WALLS WITH TAPE PRIOR TO FILLING WITH COMPOST.
- ⑤ PROVIDE POSITIVE DRAINAGE TO DISCHARGE POINT.
- ⑥ WEIR INVERT 0.5' BELOW TOP OF BAFFLE AND POST (TYP).
- ⑦ INSTALL 8' x 8' FILTER FABRIC ON TOP OF COMPOST BED IN CELL 1 ONLY. EVENLY SPACE 10 ANCHOR BRICKS AROUND THE EDGE OF THE FABRIC TO HOLD THE FABRIC IN PLACE.
- ⑧ PRECAST OPTION AVAILABLE, IF USED SUBMIT SHOP DRAWING TO ENGINEER FOR APPROVAL.





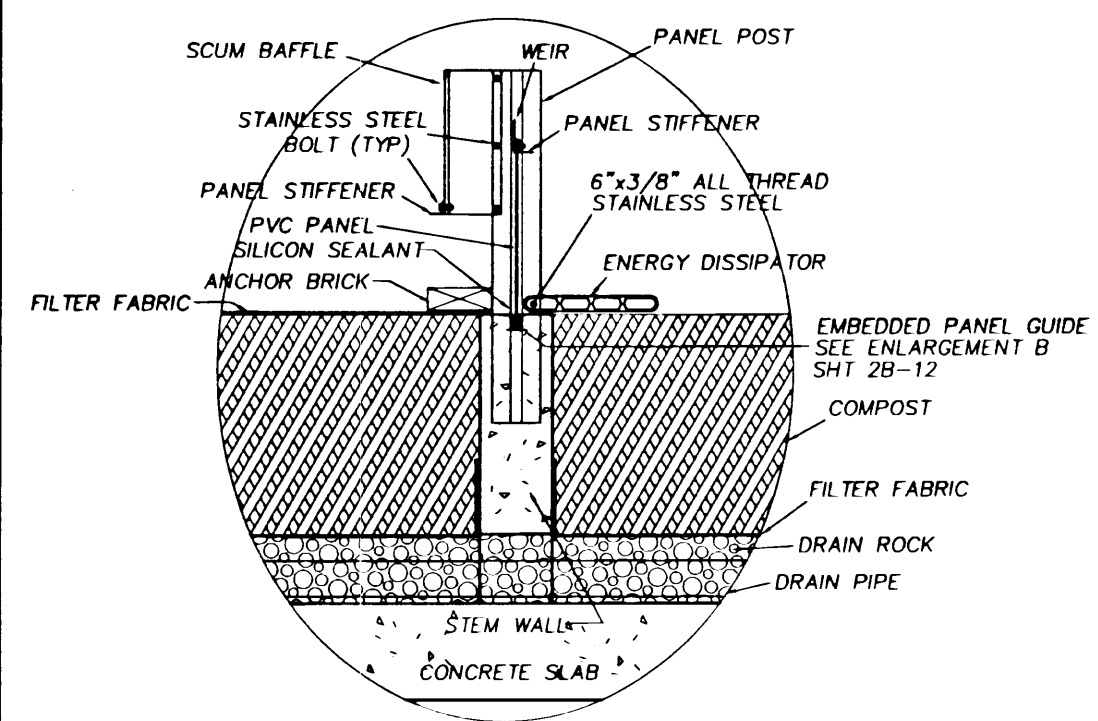


TABLE 1 - ELEVATION DATA Δ

POINT	DESCRIPTION	ELEVATION McNULTY CK	ELEVATION ACHILLES RD
①	FINISHED FLOOR AT OUTLET STEM WALL	73.93	40.02
②	TOP OF WALL	78.05	44.22
③	TOP OF WALL	78.05	44.22
④	I.E. INLET	76.09	42.26
⑤	I.E. OUTLET PIPE	72.88	39.10
⑥	TOP OF BAFFLE & POST	77.55	43.72
⑦	TOP OF BAFFLE & POST	77.51	43.68
⑧	TOP OF BAFFLE & POST	77.43	43.60
⑨	INLET BAY FINISHED FLOOR	74.09	40.26
⑩	OVERFLOW NOTCH	77.55	43.72
⑪	OUTLET FLOOR	73.03	39.12
⑫	TOP OF BAFFLE & POST	N/A	43.52

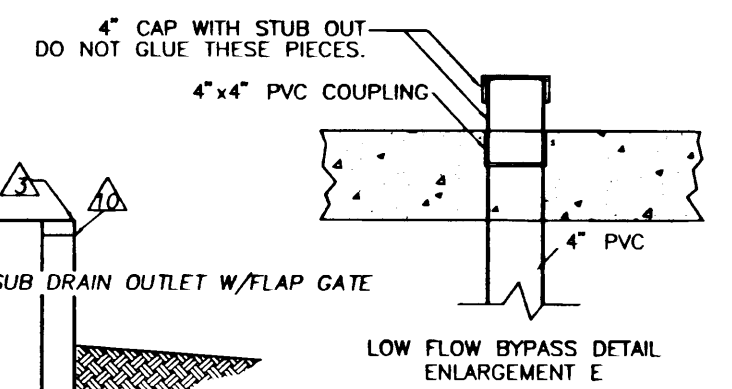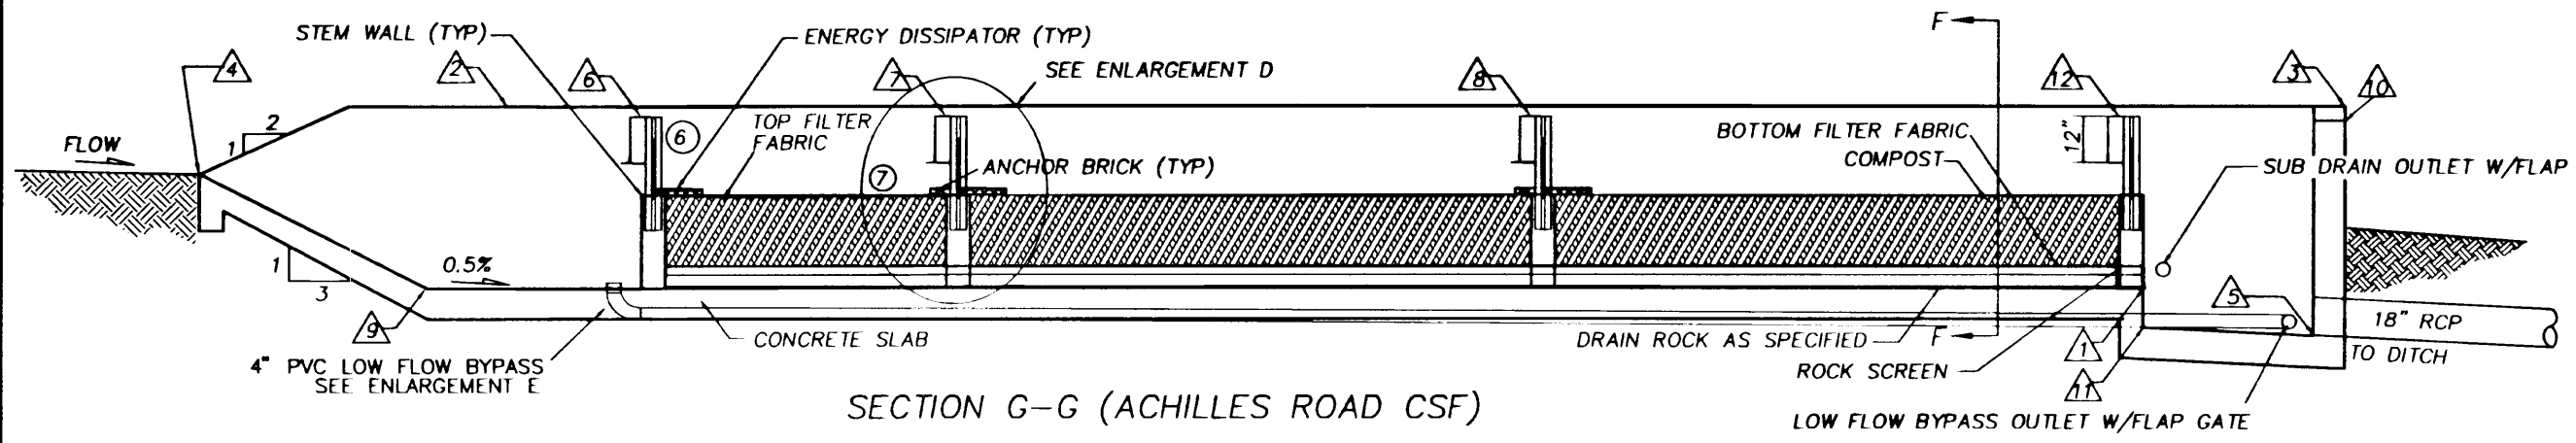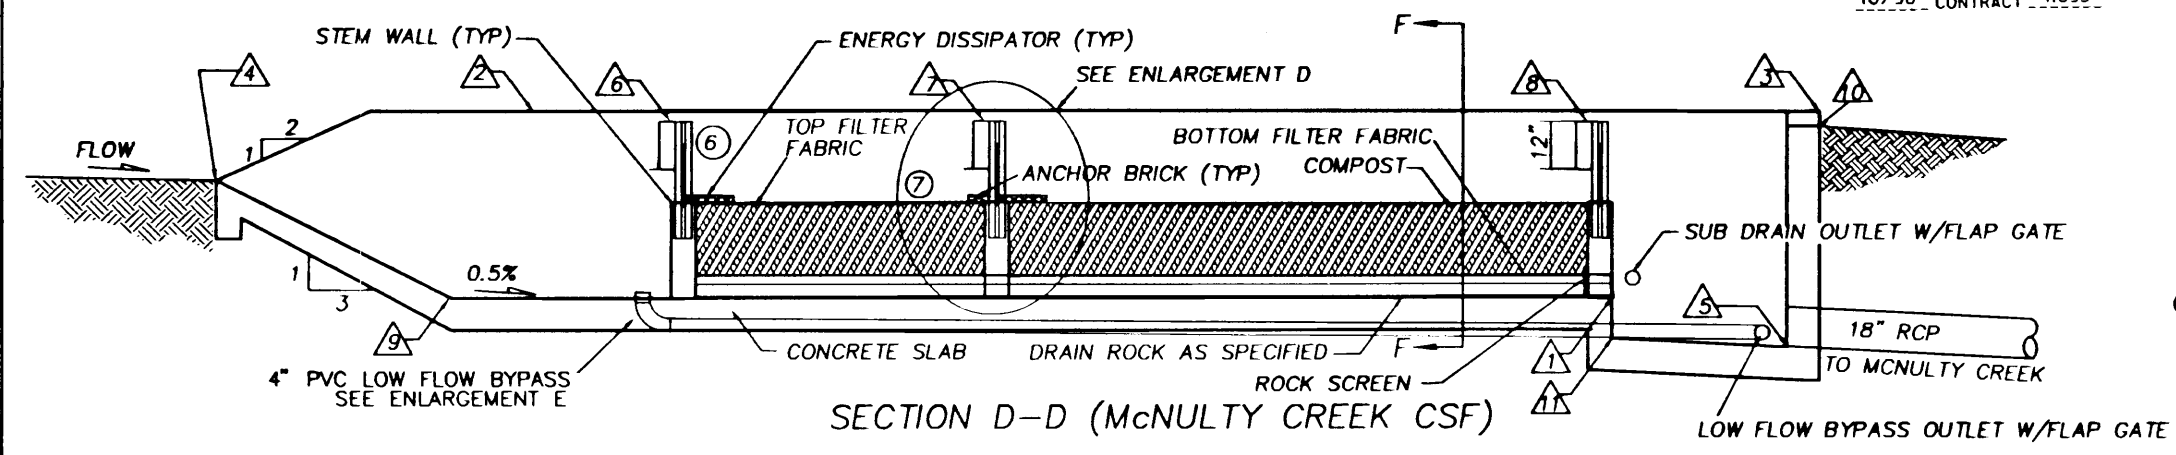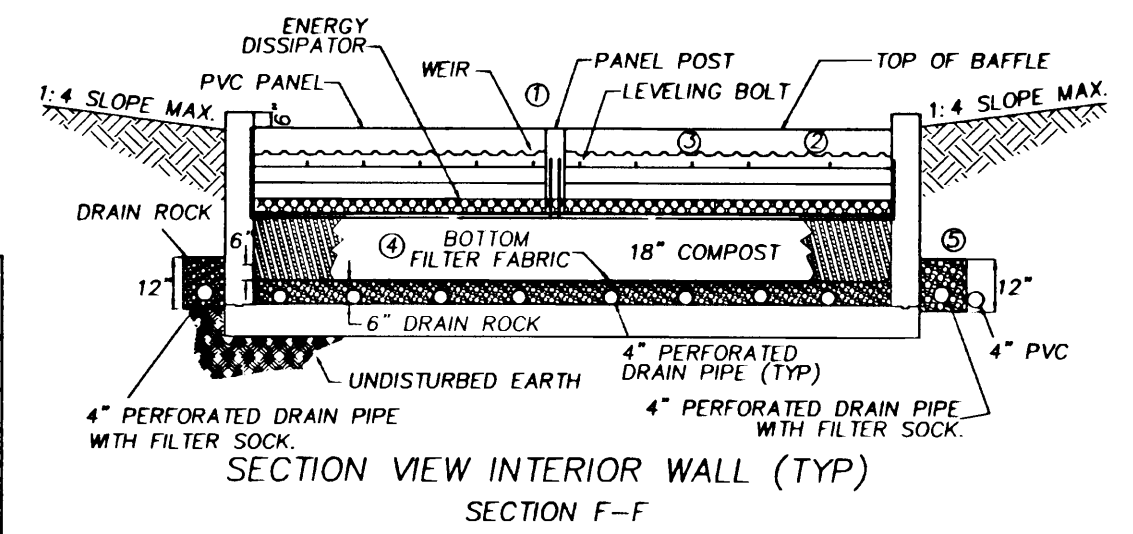


COLUMBIA CITY N.C.L. - WARREN SEC.  
COLUMBIA RIVER HIGHWAY (LOWER)  
COLUMBIA COUNTY


FEDERAL HIGHWAY ADMINISTRATION	PROJECT NUMBER	SHEET NO.
REGION 10	OREGON DIVISION	2B-13

12-OCT-1995 MOM  
2B-13.DWG


# COMPOST STORMWATER FILTER OPEN UNITS

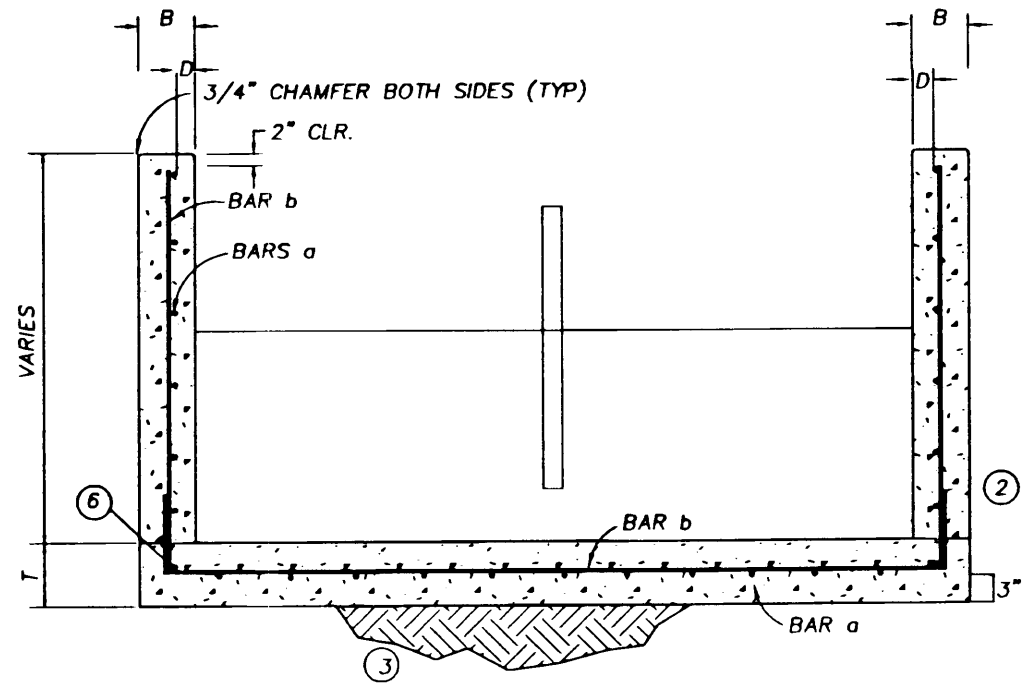

CROSS SECTION - REBAR DETAIL

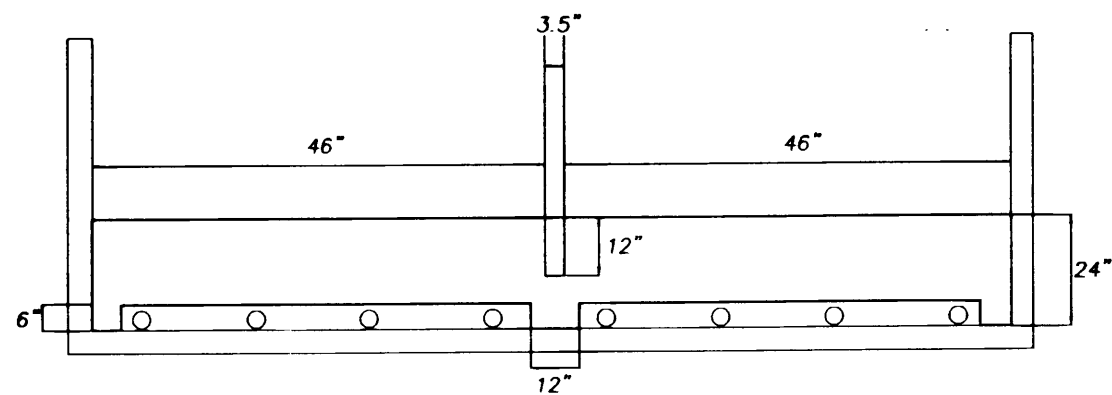


POST SPACING AND UNDERDRAIN BLOCKOUT

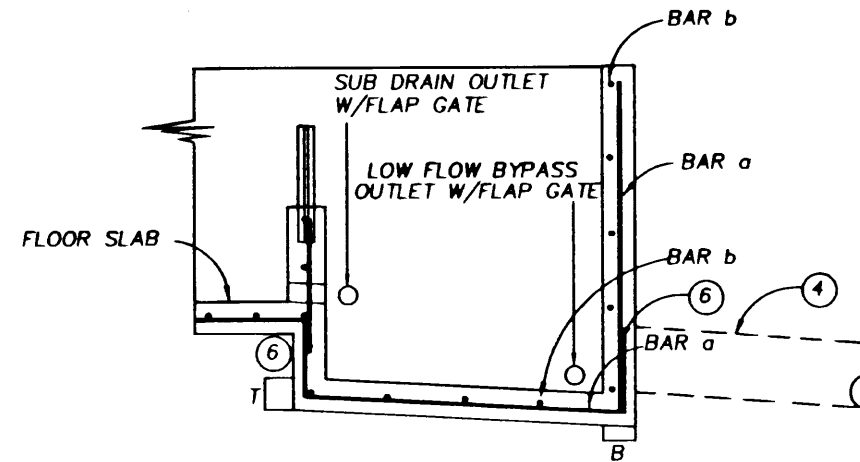


(SEE CROSS SECTION REBAR DETAIL FOR CLEARANCES)


OUTLET BAY - REBAR DETAIL  
Section C-C

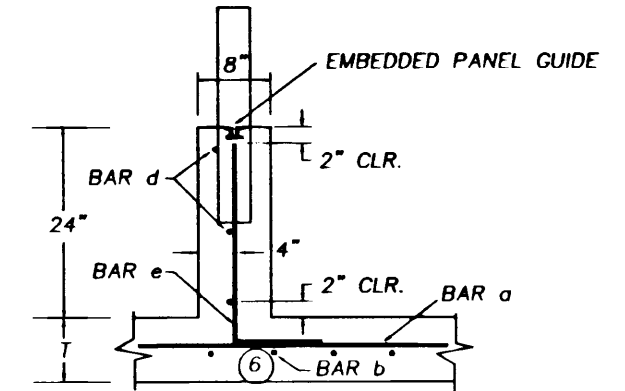


STEM WALL - FULL DEPTH  
Section K-K

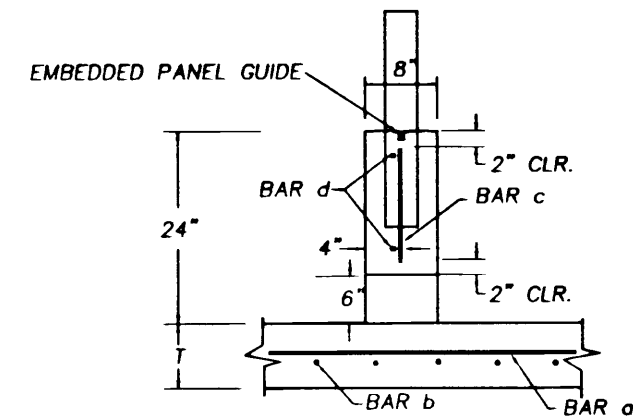

STEM WALL AT UNDERDRAIN BLOCKOUT  
Section J-J

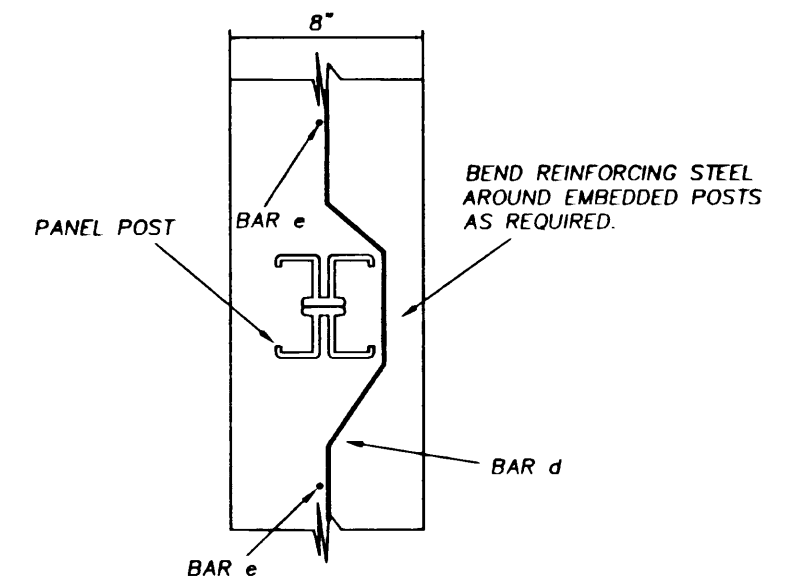

PANEL POST DETAIL-TOP VIEW  
Section I-I

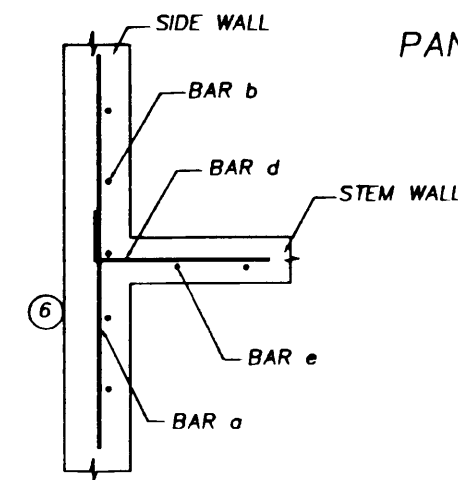

CORNER JOINT DETAIL-TOP VIEW  
Section H-H

**NOTES:**

- ① STRUCTURAL DETAILS SHOWN ARE BASED UPON "H-20" CONSTRUCTION VEHICLE SURCHARGE LOADING ONLY.
- ② ALL CONCRETE USED SHALL BE PORTLAND CEMENT CONCRETE WITH MINIMUM COMPRESSIVE STRENGTH = 3300 PSI.
- ③ POUR SLAB AGAINST ACCEPTABLE UNDISTURBED SOIL OR AGAINST COMPACTED STRUCTURAL FILL MATERIAL COMPACTED AS SPECIFIED.
- ④ INSTALL #4 HOOP REBAR AROUND OUTLET PIPE.
- ⑤ ALL REBAR DEFORMED 60 KSI
- ⑥ 12" MIN. REBAR LAP LENGTHS.

**REBAR SCHEDULE**

B	T	D (CLR.)	bar a	bar b	bar c	bar d	bar e
6"	8"	3"	#4@12"	#4@12"	#4@12"	#4@12"	#4@12"


COLUMBIA CITY N.C.L. - WARREN SEC. COLUMBIA RIVER HIGHWAY (LOWER) COLUMBIA COUNTY		
FEDERAL HIGHWAY ADMINISTRATION	PROJECT NUMBER	SHEET NO.
REGION 10	OREGON DIVISION	2B-14

12-OCT-1995 MOM  
2B-14.DWG




NOT REVISED AS CONSTRUCTED  
10/98 CONTRACT 11695

# COMPOST STORMWATER FILTER OPEN UNITS

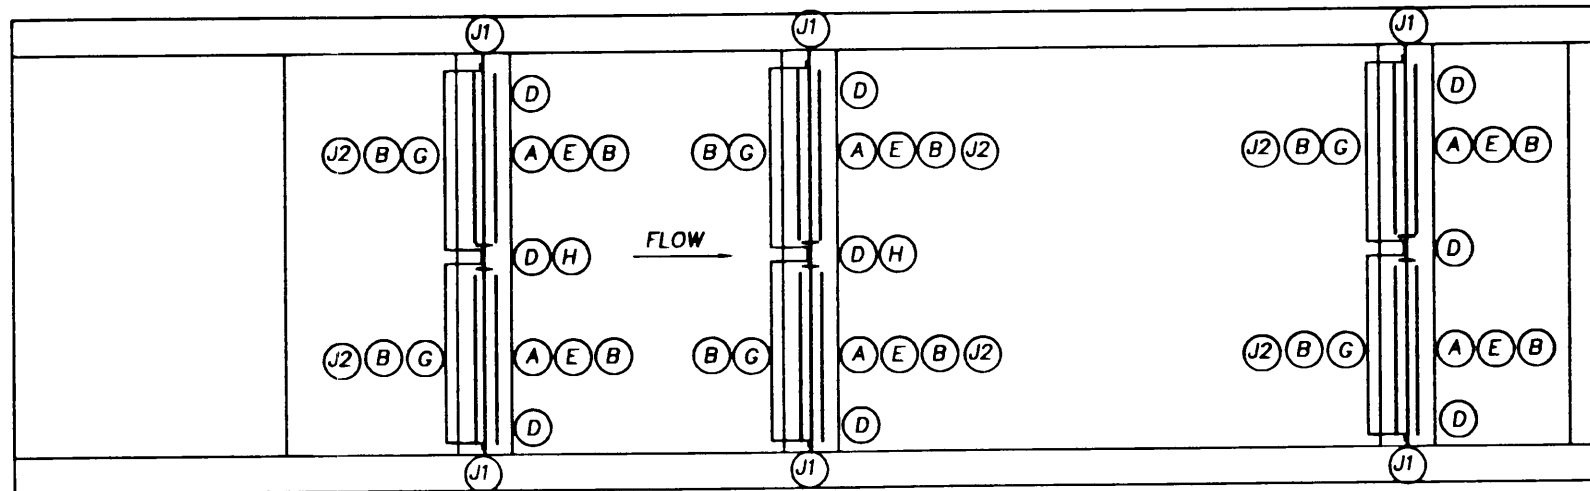

LOCATION OF PLASTI-FAB FLOW KIT COMPONENTS - PLAN VIEW (McNULTY CREEK CSF)

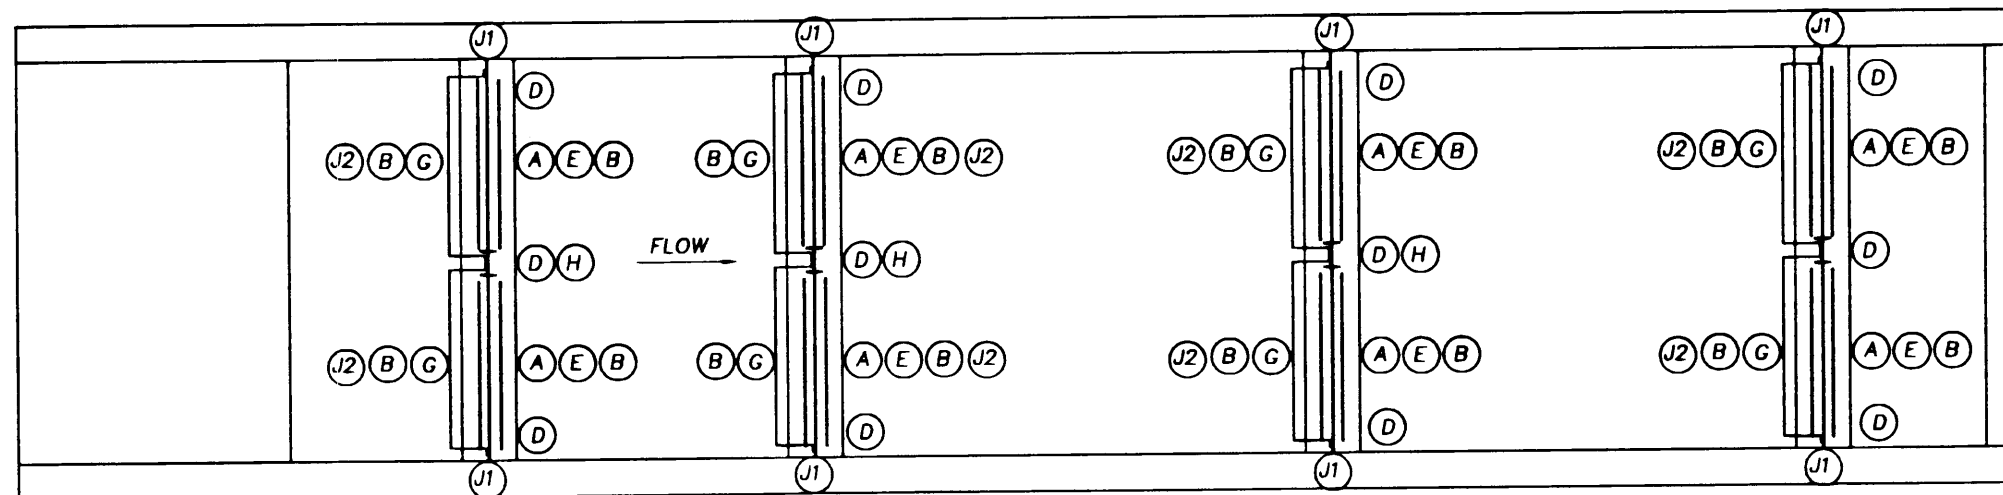

LOCATION OF PLASTI-FAB FLOW KIT COMPONENTS - PLAN VIEW (ACHILLES ROAD CSF)

TABLE II - FLOW KIT MATERIAL LIST  
(McNULTY CREEK CSF)


DESCRIPTION:	DIMENSION	QUANTITY
PLASTIFAB FLOW KIT: *		
(A) 46 IN. WEIR	STANDARD	6
(B) 46 IN. PANEL STIFFENER	STANDARD	12
(D) PANEL POST	30.0 IN.	3
(E) 48 IN. PVC PANEL	12.5 IN.	6
(G) SCUM BAFFLE	STANDARD	6
(H) 12 IN. ENERGY DISSIPATOR	8 FT.	2
(J1) EMBEDDED PANEL GUIDE (SIDE WALL)	29 IN.	6
(J2) EMBEDDED PANEL GUIDE (STEM WALL)	46 IN.	6

\* MISC. STAINLESS STEEL HARDWARE INCLUDED.


TABLE III - FLOW KIT MATERIAL LIST  
(ACHILLES ROAD CSF)

DESCRIPTION:	DIMENSION	QUANTITY
PLASTIFAB FLOW KIT: *		
(A) 46 IN. WEIR	STANDARD	8
(B) 46 IN. PANEL STIFFENER	STANDARD	16
(D) PANEL POST	30.0 IN.	4
(E) 48 IN. PVC PANEL	12.5 IN.	8
(G) SCUM BAFFLE	STANDARD	6
(H) 12 IN. ENERGY DISSIPATOR	8 FT.	3
(J1) EMBEDDED PANEL GUIDE (SIDE WALL)	30 IN.	8
(J2) EMBEDDED PANEL GUIDE (STEM WALL)	46 IN.	8

\* MISC. STAINLESS STEEL HARDWARE INCLUDED.

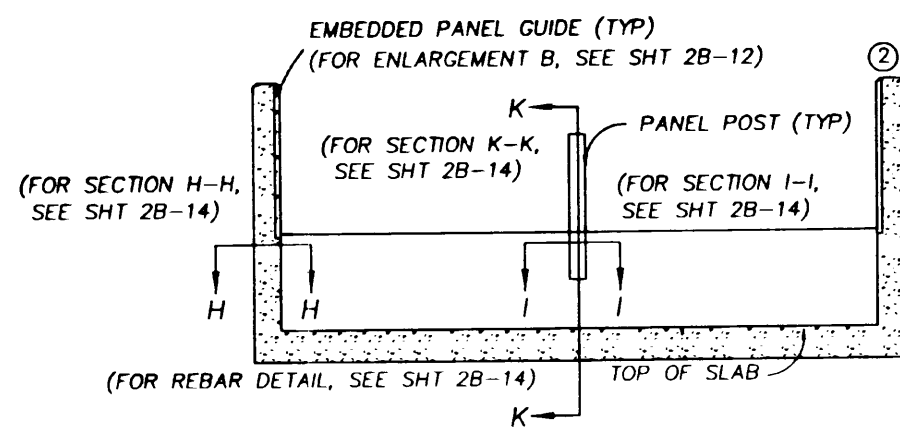

INLET STEM WALL  
Section A-A

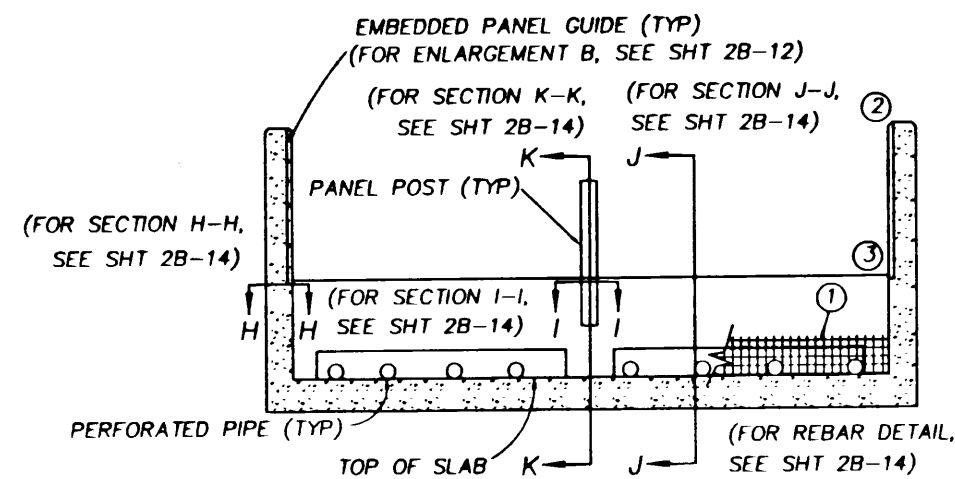

OUTLET AND INTERIOR STEM WALL  
Section B-B

NOTES:

- ① 8'x2' ROCK SCREEN AS SPECIFIED FOR UPSTREAM SIDE OF OUTLET STEM WALL ONLY.
- ② TRIM EMBEDDED PANEL GUIDE FLUSH WITH TOP OF WALL (TYP).
- ③ BOTTOM OF PANEL GUIDE SHOULD BE 22" ABOVE TOP OF SLAB.

COLUMBIA CITY N.C.L. - WARREN SEC.  
COLUMBIA RIVER HIGHWAY (LOWER)  
COLUMBIA COUNTY






FEDERAL HIGHWAY ADMINISTRATION	PROJECT NUMBER	SHEET NO.
REGION 10	OREGON DIVISION	2B-15

2B-15.DWG 12-OCT-1995 MOM

# BIO-FILTER SWALE

Bio-Filter Swale Table



Station From	Station To	Left Or Right	Slope A	Slope B	Bottom Width (Ft)	Depth (Ft)	Length (Ft)	Channel Slope (%)
573+00	575+50	Rt	6:1	4:1	4	1	250	1.83
610+50	613+50	Rt	6:1	4:1	4	1	300	1.10
615+20	618+20	Rt	6:1	1 1/2:1	4	1	300	0.57
719+70	720+90	Rt	6:1	4:1	4	1	120	1.57
720+90	722+60	Rt	6:1	4:1	4	1	170	1.33
797+90	800+08	Lt	3:1	2:1	4	1	218	0.83
839+45	-	Lt	2:1	2:1	10	1	160	3.12
856+70	860+75	Lt	4:1	4:1	4	1	405	0.75-2.0
897+37	-	Lt	3:1	3:1	6	1	290	1.20
898+50	900+75	Rt	4:1	1 1/2:1	4	1	225	0.98

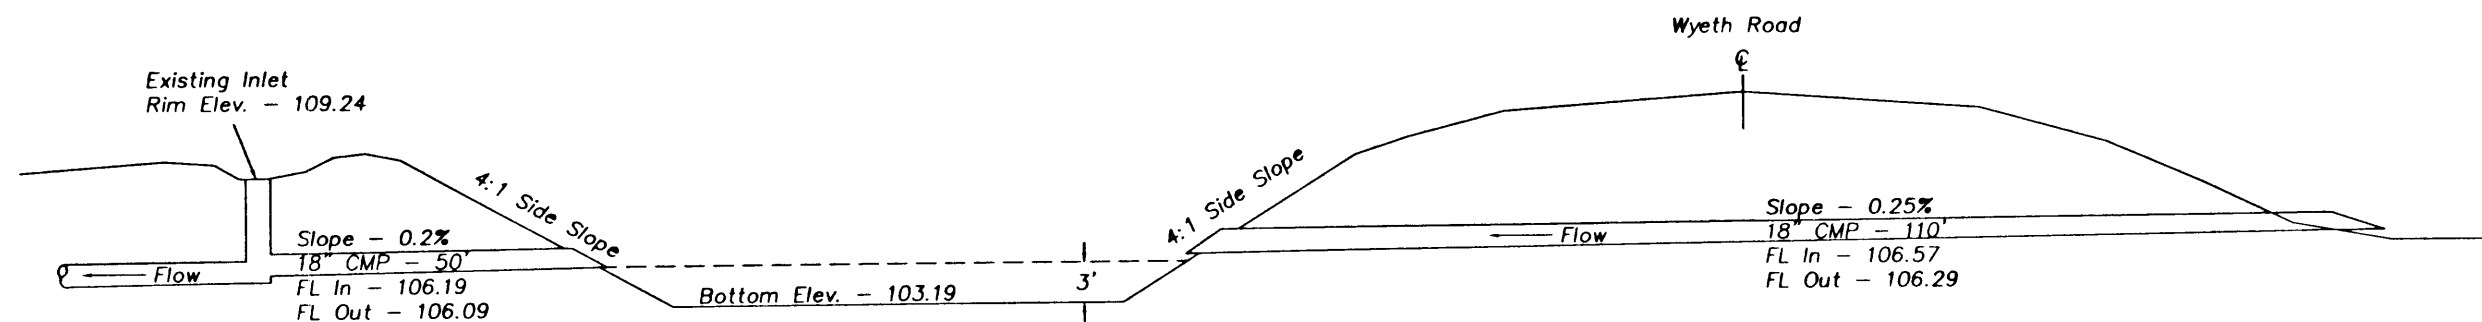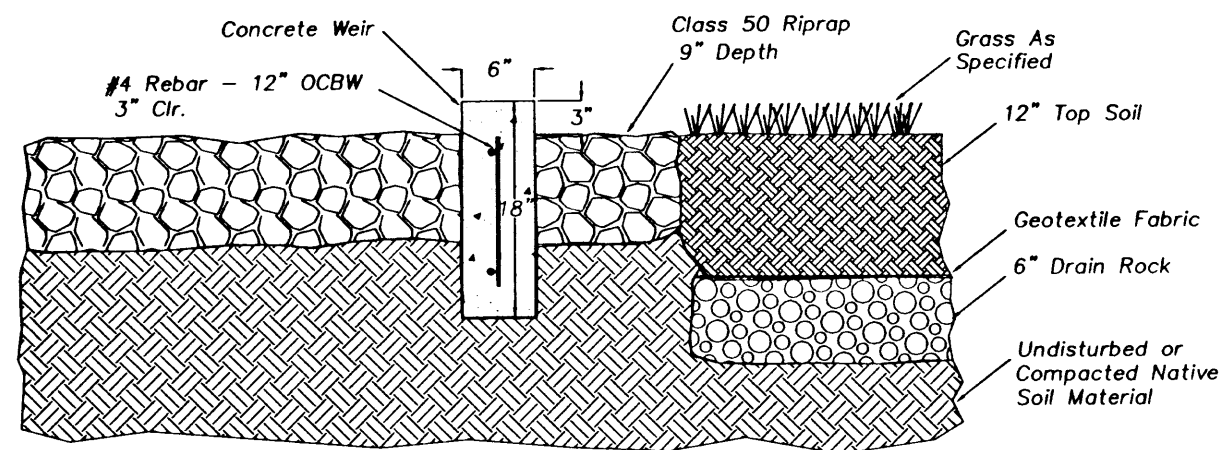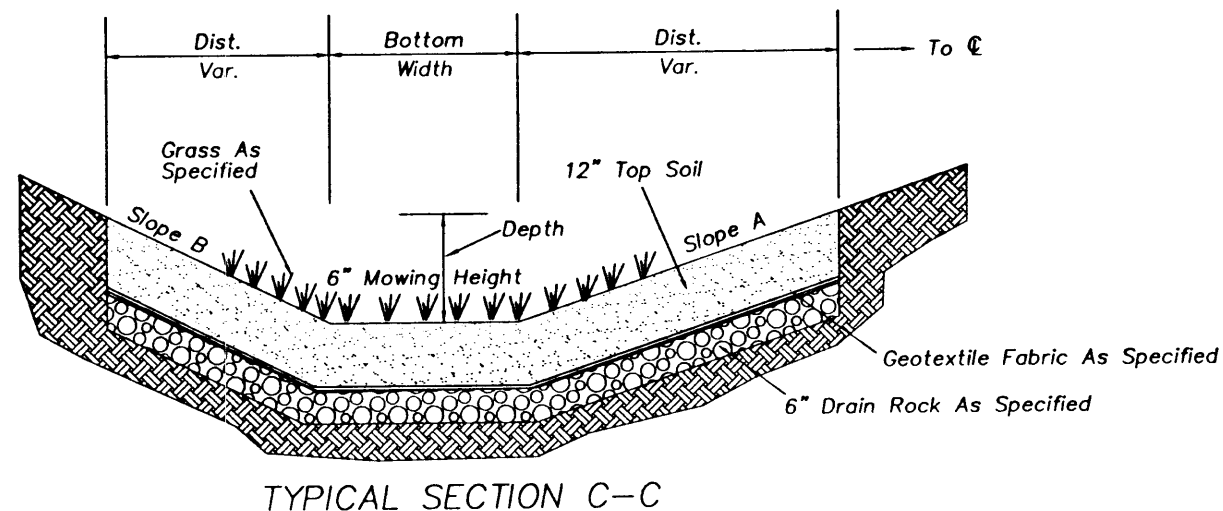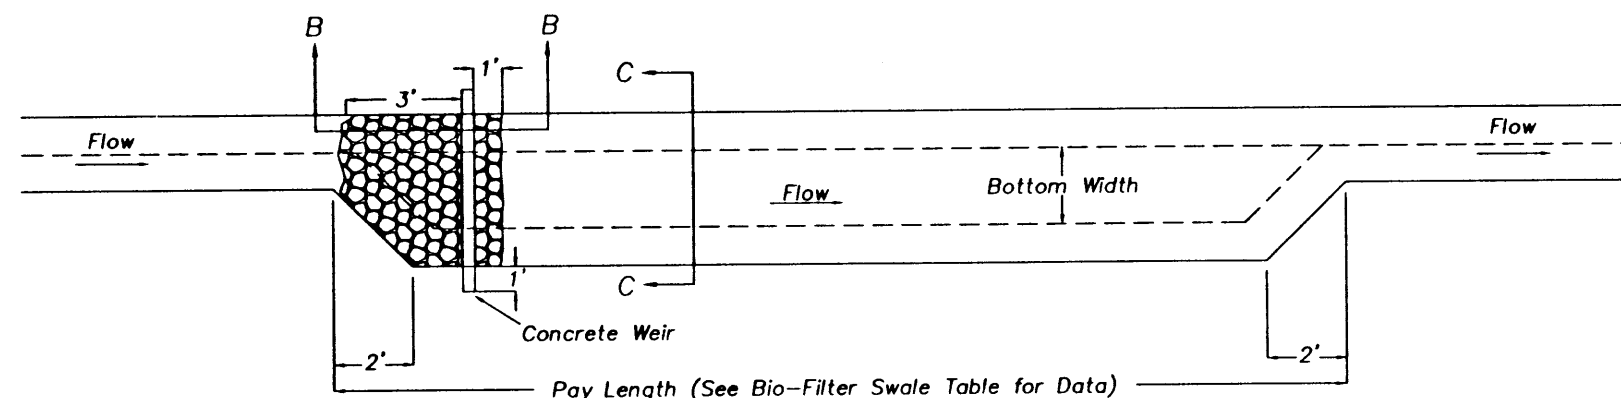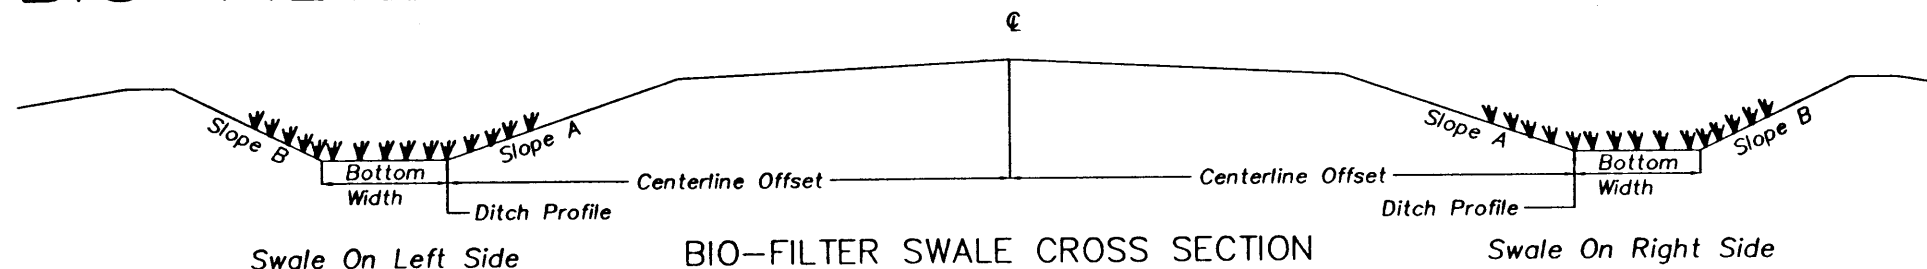

COLUMBIA CITY N.C.L. - WARREN SEC. COLUMBIA RIVER HIGHWAY (LOWER) COLUMBIA COUNTY		
FEDERAL HIGHWAY ADMINISTRATION	PROJECT NUMBER	SHEET NO.
REGION 10	OREGON DIVISION	2B-17

2B-17.DWG 05-OCT-1995 MOM

1° C.L.  
TΔ 14°13'16"  
Ts 914.87'  
2-400' Spirals  
S 2°  
a 0.25  
e 0.025'/ft.

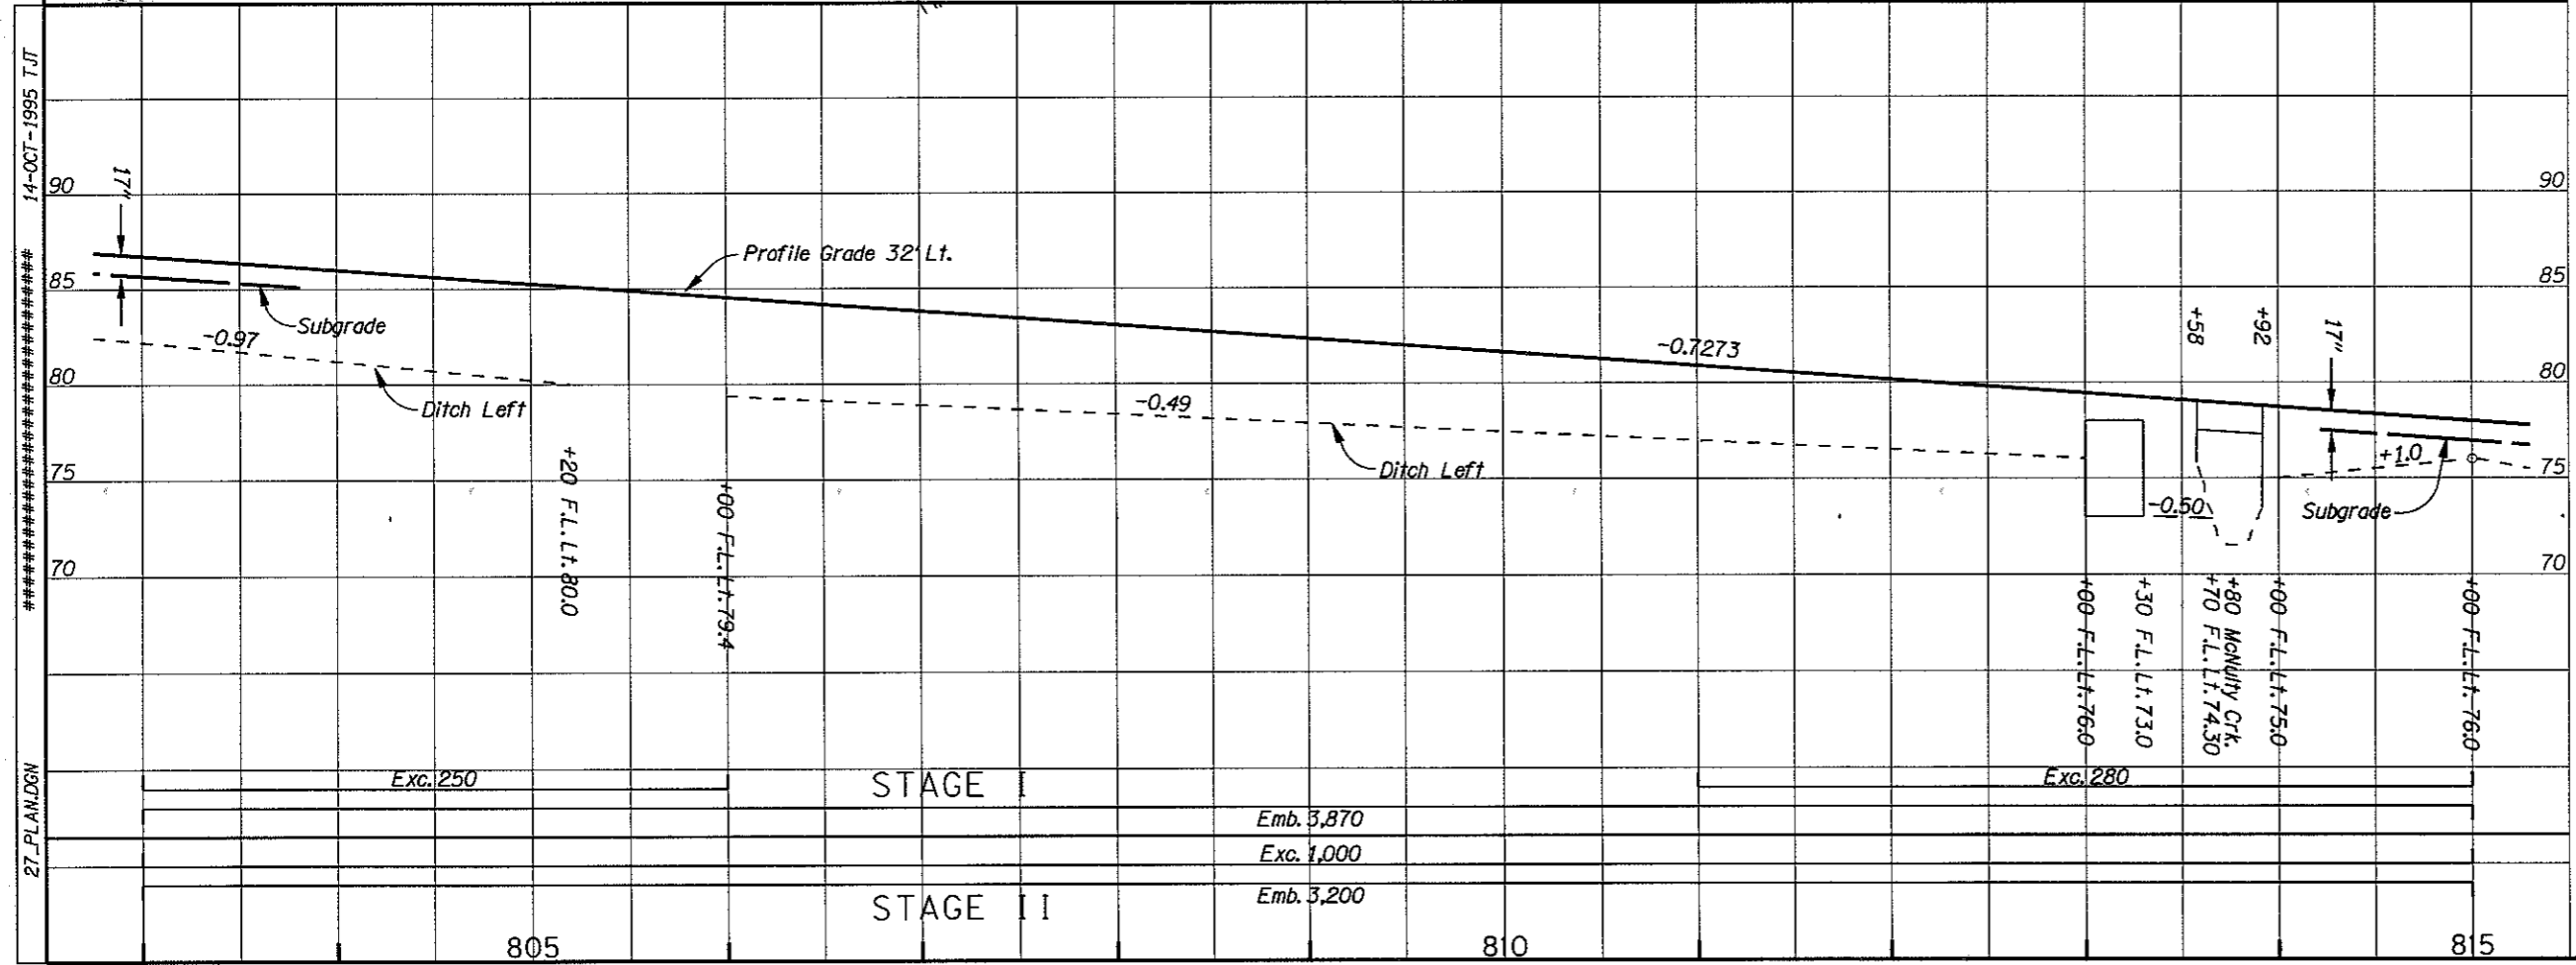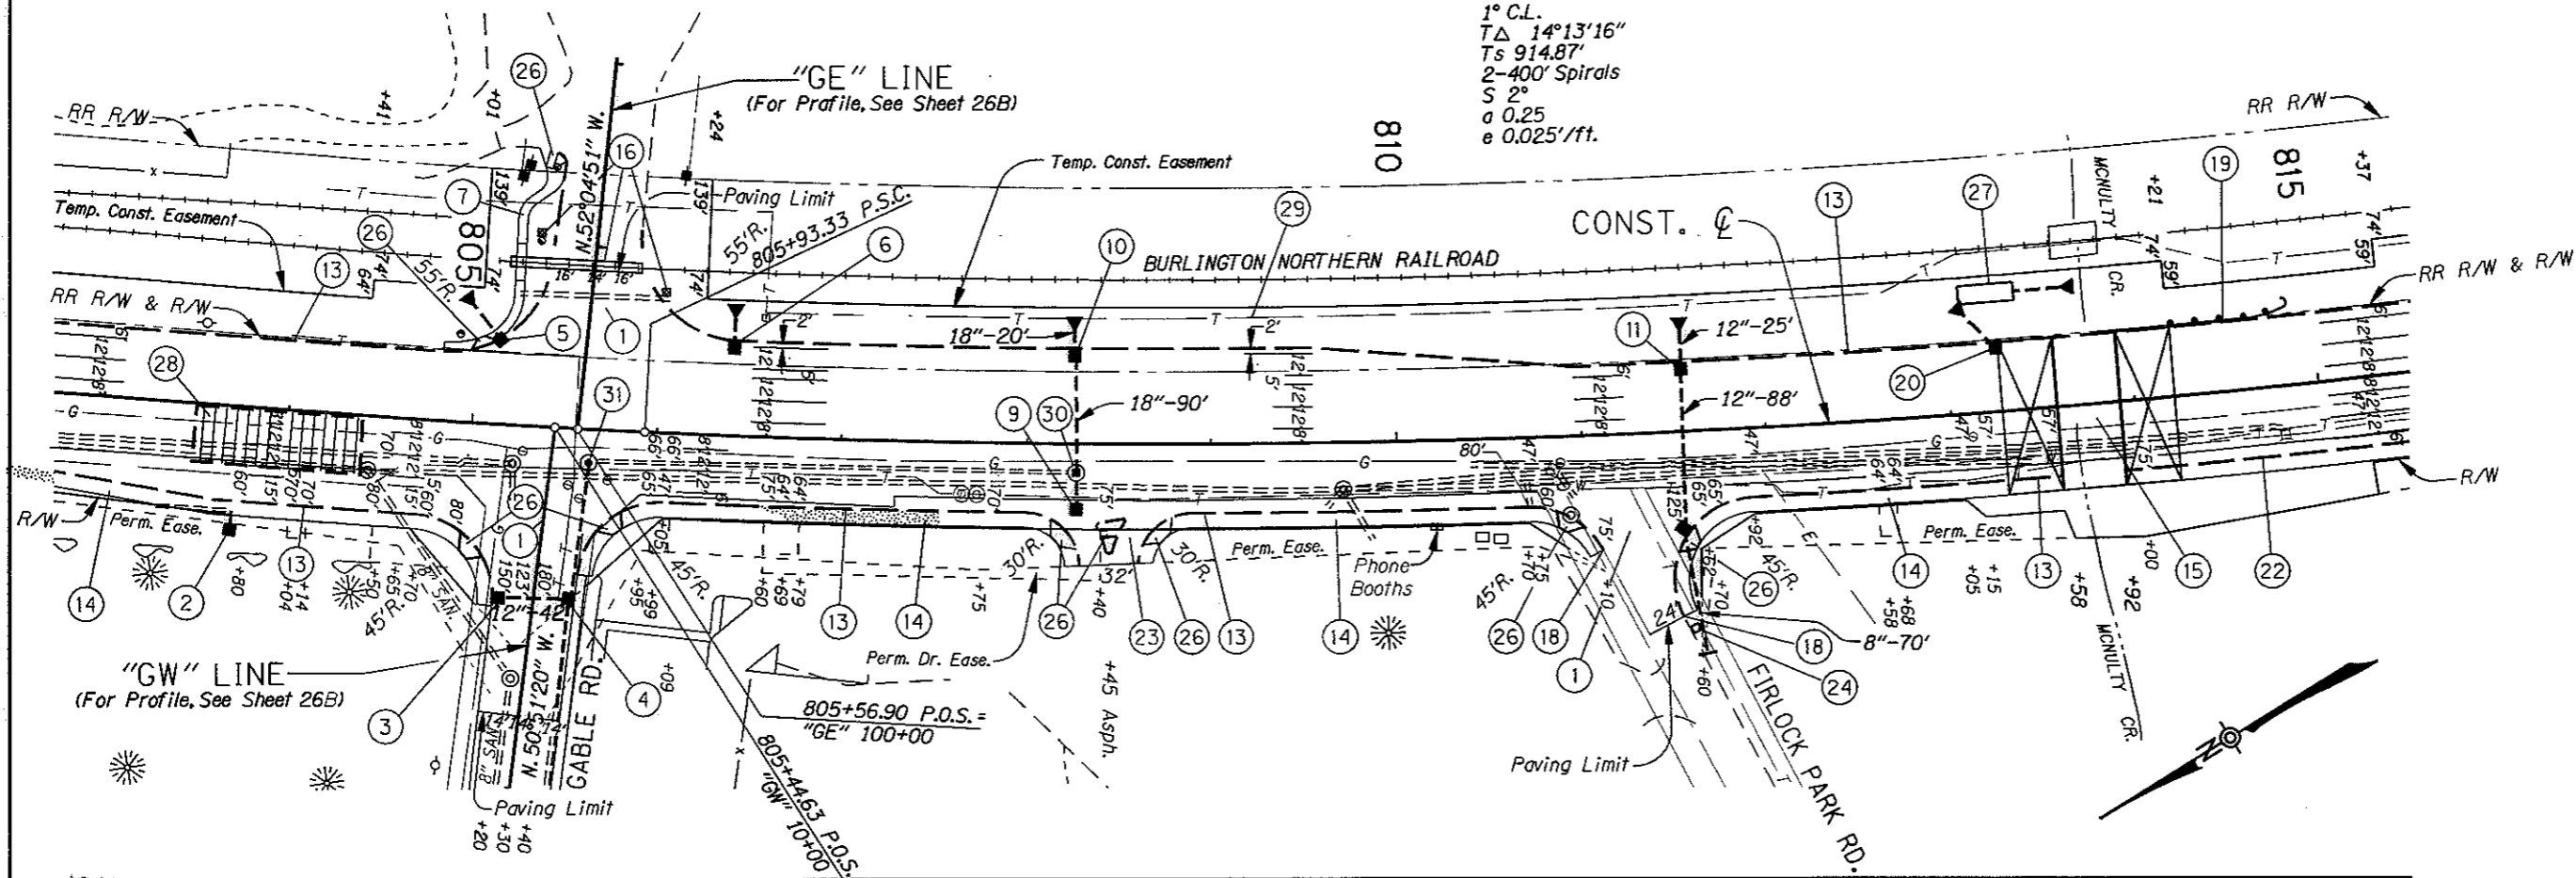

14-OCT-1995 T.JT  
27\_PLANDGN

STAGE I	Emb. 3,870
	Exc. 1,000
STAGE II	Emb. 3,200

<b>COLUMBIA CITY N.C.L. - WARREN SEC.</b>		
COLUMBIA RIVER HIGHWAY (LOWER)		
COLUMBIA COUNTY		
FEDERAL HIGHWAY ADMINISTRATION	PROJECT NUMBER	SHEET NO.
REGION 10	OREGON DIVISION	27

- ① Const. Road Conn. - 3
- ② Sta. 803+72.5  
Const. Type "G-2" Inlet  
Inst. 12" Sew. Pipe - 10'  
Connect To Extg. Pipe
- ③ Sta. "GW" 10+97. Rt.  
Const. Type "CG-2" Inlet  
Inst. 12" Sew. Pipe - 42'  
Tr. Exc. - 15 C.Y.
- ④ Sta. "GW" 10+95. Lt.  
Const. Type "CG-2" Inlet  
Inst. 18" Sew. Pipe - 60'
- ⑤ Sta. 805+10. Lt.  
Const. Type "CG-2" Inlet  
Inst. 12" Sew. Pipe - 30'  
Const. Paved End Slope  
Tr. Exc. - 14 C.Y.
- ⑥ Sta. 806+40. Lt.  
Const. Type "CG-2" Inlet  
Inst. 12" Sew. Pipe - 20'  
Const. Paved End Slope  
Tr. Exc. - 10 C.Y.
- ⑦ Const. 5' P.C. Conc. Walk
- ⑨ Sta. 808+25. Rt.  
Const. Type "G-2" Inlet At  
Extg. Inlet
- ⑩ Sta. 808+25. Lt.  
Const. Type "CG-2" Inlet  
Inst. 18" Sew. Pipe - 110'  
Const. Paved End Slope  
Tr. Exc. - 70 C.Y.
- ⑪ Sta. 811+60. Lt.  
Const. Type "CG-2" Inlet - 2  
Inst. 8" Sew. Pipe - 70'  
Inst. 12" Sew. Pipe - 115'  
Const. Paved End Slope  
Tr. Exc. - 45 C.Y.
- ⑬ Const. Type "A" Mod. Curb  
(For Detail, See Sht. 2B-5)
- ⑭ Const. P.C. Conc. Walk  
(For Planting Detail, See Sheet 37, 37A & 37B)
- ⑮ Bridge No. 17435  
Const. Bridge - 34'  
Roadway Width - 76'-8"  
Const. Conc. Panels @ Bridge Ends - 30'4"  
(See Drg. No's 51053 Through 51059 Incl.)
- ⑯ Const. Conc. R.R. Xing  
Inst. R.R. Xing Gate Signals - 2 } (By Others)
- ⑰ Const. Curb Ending - 2
- ⑲ Sta. 814+22 To Sta. 814+85  
Const. Guard Rail - 12.5' (Type 3)  
Const. Guard Rail Transition  
Flare Rate = 0, W=4, E=0  
Inst. SRT-100 End Terminal  
(See Drg. No. 43496)
- ⑳ Sta. 813+25  
Const. Type "CG-2" Inlet  
Inst. 12" Sew. Pipe - 25'  
Const. Paved End Slope  
Tr. Exc. - 10 C.Y.
- ㉑ Const. Type "D" Mod. Curb  
(For Detail, See Sht. 2B-5)
- ㉒ Sta. 808+45. Rt.  
Const. Road Appr.  
Const. Type "C" Non-Mountable Island  
(For Detail, See Sheet 2B-10)
- ㉓ Inst. Single Mailbox Support  
Const. Conc. Collar
- ㉕ Const. Sidewalk Ramp - 9
- ㉖ Sta. 813+00. Lt.  
Inst. Compost Stormwater Filter -  
Open Unit - 10'x30'  
Inst. 18" Sew. Pipe - 35'  
(For Details, See Sheet 2B-12 Through 2B-15)
- ㉗ Contaminated Soil Removal (Site 5)  
Exc. - 300 C.Y.  
Straw Bales - 288  
Visquine - 222 S.Y.  
Aggr. Base - 600 Ton  
Temp. Const. Fence - 230 Lin. Ft.  
Nutrients - 4,800 lbs.
- ㉘ Sta. 808+75 To Sta. 809+75  
Const. Conc. Cap (Type A) - 100'  
(For Details, See Sheet 2B-26)
- ㉙ Const. MH At Extg. Inlet
- ㉚ Replace Extg. Inlet With MH  
Inst. 18" Sew. Pipe - 53'

18-SEP-1995 T.JT

\*\*\*\*\*

27A\_PLAND6W

<b>COLUMBIA CITY N.C.L. - WARREN SEC.</b>		
COLUMBIA RIVER HIGHWAY (LOWER) COLUMBIA COUNTY		
FEDERAL HIGHWAY ADMINISTRATION	PROJECT NUMBER	SHEET NO.
REGION 10	OREGON DIVISION	27A