

OPERATION & MAINTENANCE MANUAL

Water Quality Biofiltration Swale

Manual prepared: August 2017

DFI No. D00207



Figure 1: DFI No. D00207, looking Southeast

1. Identification

Drainage Facility ID (DFI): D00207
Facility Type: Water Quality Biofiltration Swale
Construction Drawings: (V-File Numbers) 40V-046
Location: District: 4
Highway No.: 091
Mile Post: 102.74 to 102.75, Left

2. Manual Purpose

The purpose of this manual is to outline inspection needs and summarize maintenance actions.

3. Facility Location

The location map below details the facility location. The highway, mile posts, side streets, access location, and stormwater flow directions are noted on the map.

Flow direction: Southeast




Figure 2: Facility location map

4. Facility Summary

The length and width of a swale is based on the bottom dimensions.

The bottom length and bottom width of the swale is:


Bottom Length (feet)	Bottom Width (feet)
100	10

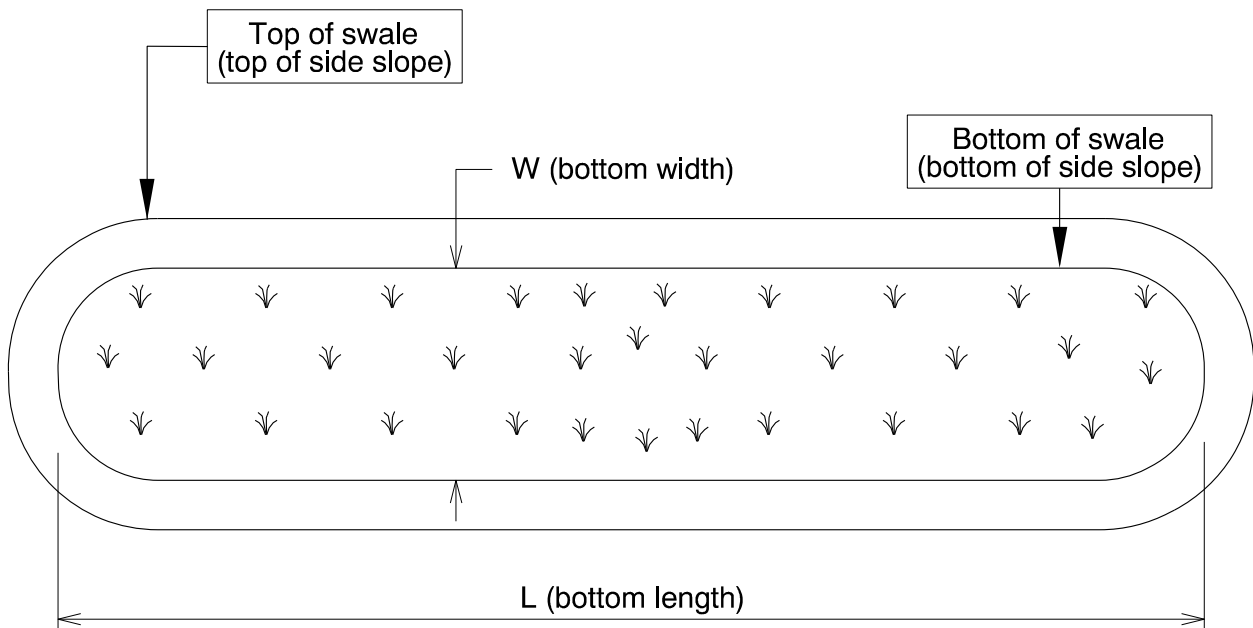

The depth of the swale is the vertical distance measured from the bottom of the swale to the top. The slope of the swale sides is presented by a vertical distance (rise) followed by the horizontal distance (run).

Depth and side slopes:

Depth (feet)	Rise (feet)	Run (feet)
varies	1	4

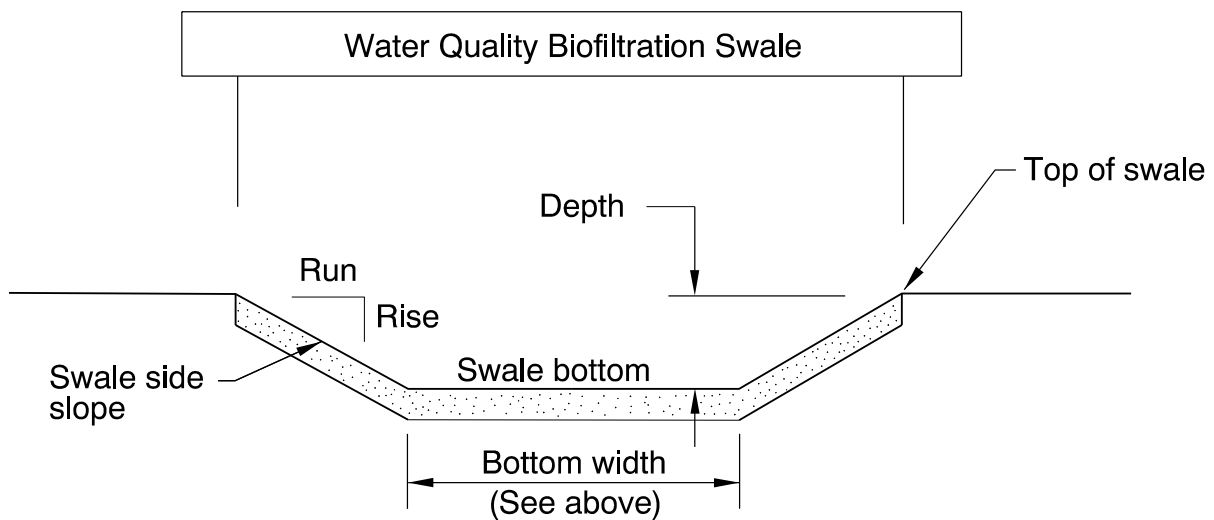

Site Specific Information: 12 inches of select topsoil was used for the swale water quality soil mixture within the treatment area. This swale serves bridge No. 20463.

5. Facility Access

Maintenance access to the facility:

<input type="checkbox"/> Roadside pad	<input checked="" type="checkbox"/> Roadside shoulder
<input type="checkbox"/> Access road with Gate	<input type="checkbox"/> Access road without Gate



Figure 3: Facility access via roadside shoulder, looking Northwest

6. Operational Components / Maintenance Items

Classification

This facility is classified as an:

<input checked="" type="checkbox"/> On-line Swale	<input type="checkbox"/> Off-line Swale
A swale that does not include a high flow bypass component; flow drains into and through the facility	A swale that treats low/small flows and diverts high flows using a bypass component

Bypass Component

This facility includes a high flow bypass component:

<input checked="" type="checkbox"/> No	<input type="checkbox"/> Yes
There is no bypass component. High flows drain into and through the facility	There is a bypass component. Only low/small flows drain into the swale. High flows are diverted around the swale using a bypass component

Operational Components

A swale has many components that assist with treatment, conveyance, and reducing flow velocity to minimize erosion. The components in use can vary depending if the facility was designed to operate on-line or off-line. The facility components table (**Table 1**) has been provided to highlight the applicable components for this facility. The component is in use when the box contains an “x” (e.g.).

The Standard Operation Manual for Water Quality Biofiltration Swales (implemented March 2017) outlines facility operation, typical footprint configuration, and component definitions and details. A link to the manual is attached to the feature marker in TransGIS.

<https://gis.odot.state.or.us/TransGIS/>

Operational Plan

The applicable standard operational plan for this facility is:

<input checked="" type="checkbox"/> Operational Plan A <input type="checkbox"/> Operational Plan B <input type="checkbox"/> Operational Plan C
A standard operational plan illustrates the general facility footprint configuration and explains the purpose of each facility component. Operational plans (A, B, C) are provided in the Standard Operation Manual.

See Appendix A for the site specific operational plan.

Maintenance Items

Operational components marked in **Table 1** should be inspected and maintained according to Section 7. Each facility component is defined and detailed in the Standard Operation Manual using the associated ID number indicated below.

Table 1: Swale Components		ID #
Manholes/Structures		
Pre-treatment manhole	<input type="checkbox"/>	S1
Weir type flow splitter/flow splitter manhole	<input type="checkbox"/>	S2
Orifice type flow splitter/flow splitter manhole	<input type="checkbox"/>	S3
Standard manhole	<input type="checkbox"/>	S4
Swale Inlet		
Pavement sheet flow	<input type="checkbox"/>	S5
Inlet Pipe (s)	<input checked="" type="checkbox"/>	S6
Open channel inlet	<input type="checkbox"/>	S7
Riprap pad	<input checked="" type="checkbox"/>	S8
Ground Cover		
Grass bottom	<input checked="" type="checkbox"/>	S9
Grass side slopes	<input checked="" type="checkbox"/>	S10
Granular drain rock	<input type="checkbox"/>	S11
Plantings	<input type="checkbox"/>	S12
Underground Components		
Geotextile fabric	<input type="checkbox"/>	S13
Water quality mix	<input checked="" type="checkbox"/>	S14
Perforated pipe	<input type="checkbox"/>	S15
Porous pavers (access grid)	<input type="checkbox"/>	S16
Flow Spreader		
Rock basin (used at inlet)	<input type="checkbox"/>	S17
Anchored board (midpoint of swale or every 50 feet along swale bottom)	<input type="checkbox"/>	S18
Other:	<input type="checkbox"/>	S19
Swale Outlet		
Catch basin with grate	<input type="checkbox"/>	S20
Outlet Pipe (s)	<input type="checkbox"/>	S21
Open channel outlet	<input checked="" type="checkbox"/>	S22
Auxiliary Outlet:	<input type="checkbox"/>	S23
Outfall Type		
Waterbody (Creek/Lake/Ocean)	<input type="checkbox"/> C	S24
	<input type="checkbox"/> L	
	<input type="checkbox"/> O	
Ditch	<input checked="" type="checkbox"/>	S25
Storm drain system	<input type="checkbox"/>	S26
Outfall Components		
Riprap pad	<input type="checkbox"/>	S27
Riprap bank protection	<input type="checkbox"/>	S28

7. Maintenance

Maintenance Frequency/Maintain Records

- a. Inspect annually. Preferably prior to the rainy season.
- b. Clean and maintain as necessary. Refer to Activity 125 for conditions when maintenance is needed.
- c. Keep a record of inspections, maintenance, and repairs.

Maintenance Guide/Maintenance Actions

The ODOT Routine Road Maintenance Water Quality and Habitat Guide (the *Blue Book*) outlines the standard maintenance actions for water quality facilities under Activity 125.

There are standard maintenance tables for standard ODOT designs. The maintenance tables describe the maintenance component, the defect or problem, the condition when maintenance is needed, and the recommended maintenance to correct the problem. Use the following tables to maintain ODOT swales:

- Table 1 (General Maintenance): Contains general maintenance and inspection guidelines that are applicable to all ODOT water quality facilities
- Table 3 (Maintenance of Water Quality or Biofiltration Swales): Contains maintenance information for swales

The *Blue Book* can be viewed at the following website:

http://www.oregon.gov/ODOT/Maintenance/Documents/blue_book.pdf

8. Limitations

Access grid installed:

<input checked="" type="checkbox"/> No	<input type="checkbox"/> Yes
There are (Choose applicable weight: no, light, med., heavy) duty porous pavers installed in this swale	

Swales are designed to allow equipment access along the bottom. If an access grid is **NOT** installed, vehicles entering the swale can create depressions (tire ruts), damage vegetation, and damage structural components (e.g. flow spreaders). These conditions may result in poor treatment and drainage performance.

Equipment wheels should be kept on the tops and side slopes. Mower arms may be run along the swale bottom.

9. Waste Material Handling

Material removed from the facility is defined as waste by the Department of Environmental Quality (DEQ). Refer to the roadwaste section of the ODOT Maintenance Yard Environmental Management System (EMS) Policy and Procedures Manual for disposal options:

http://www.oregon.gov/ODOT/Maintenance/Documents/ems_manual.pdf


Contact any of the following for more detailed information about management of waste materials found on site:

ODOT Clean Water Unit	(503) 986-3008
ODOT Statewide Hazmat Coordinator	(503) 667-7442
ODOT Region 1 Hazmat Coordinator	(503) 731-8290
ODOT Region 2 Hazmat Coordinator	(503) 986-2647
ODOT Region 3 Hazmat Coordinator	(541) 957-3594
ODOT Region 4 Hazmat Coordinator	(541) 388-6186
ODOT Region 5 Hazmat Coordinator	(541) 963-1590
ODEQ Northwest Region Office	(503) 229-5263


A Appendix A – Site Specific Operational Plan

Contents:


Operational Plan: DFI D00207

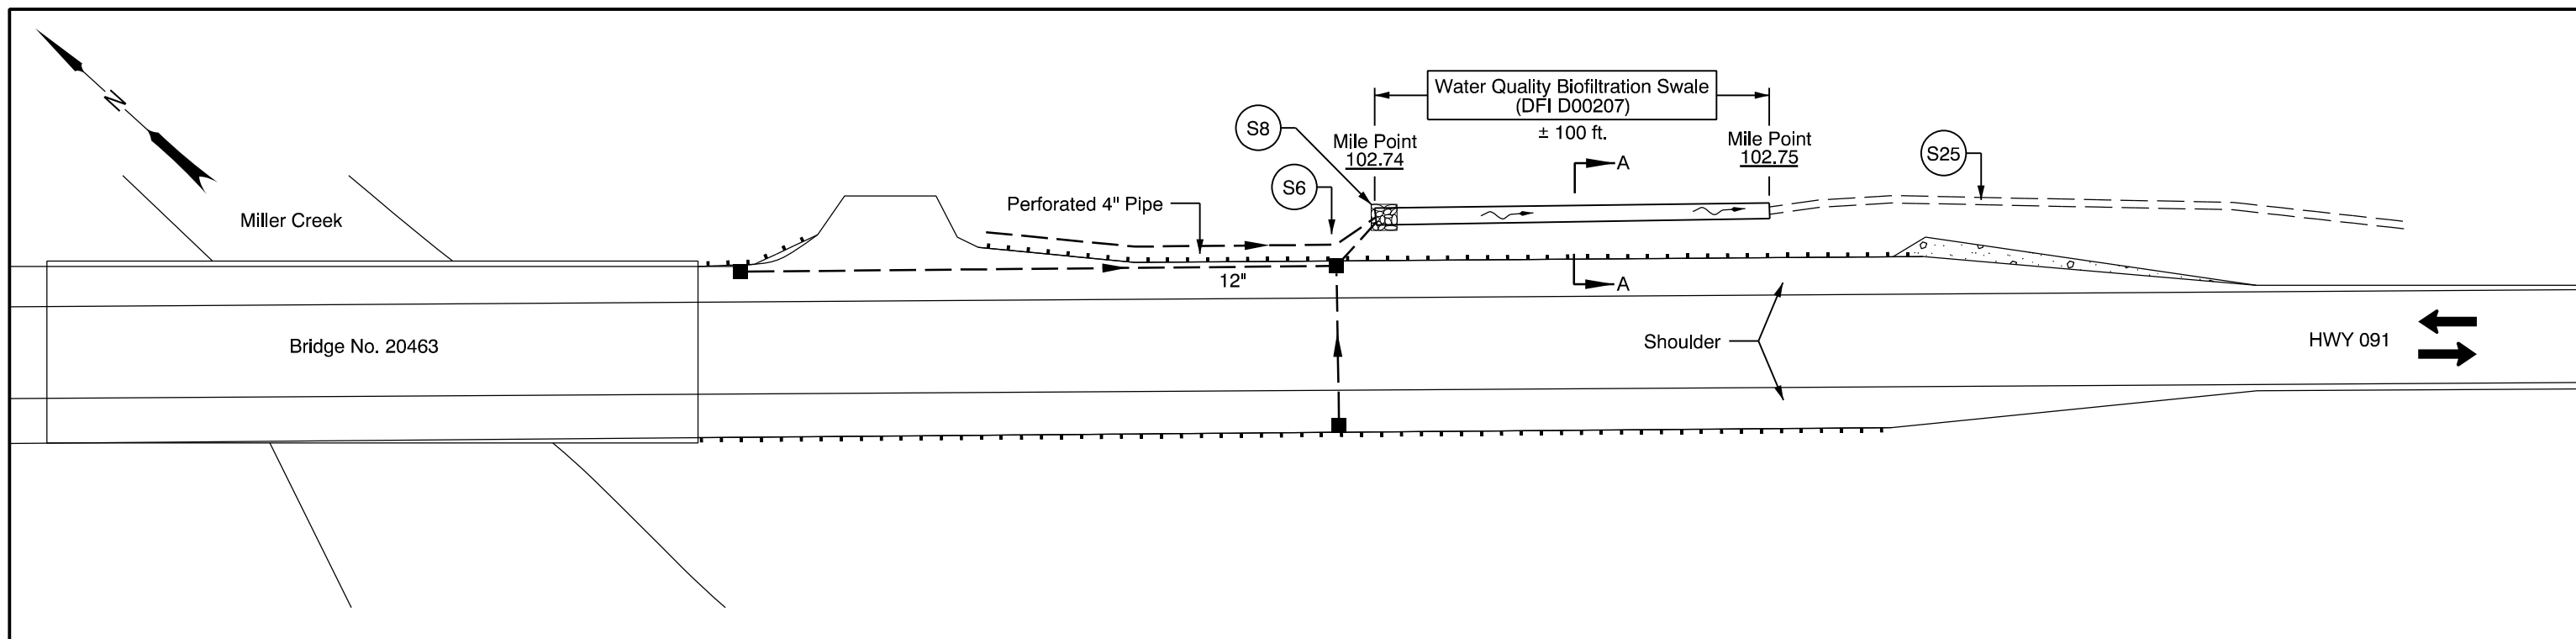

PLAN
N.T.S.

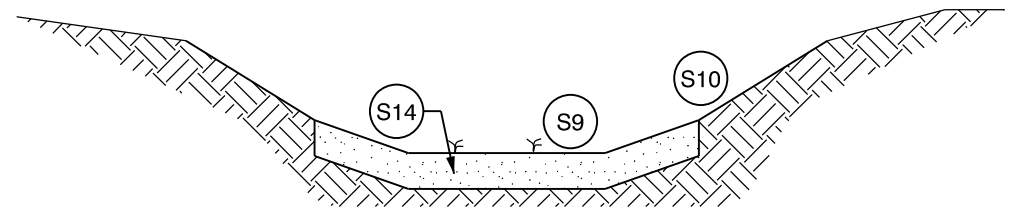

SECTION A-A
N.T.S.

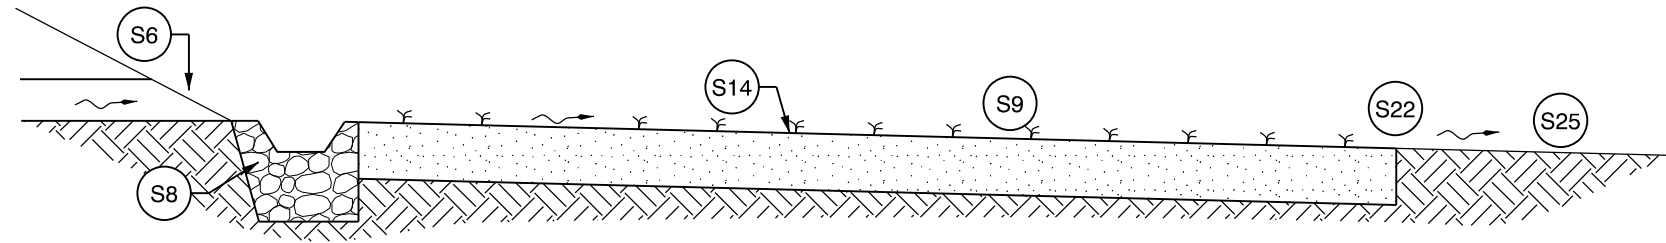

PROFILE
N.T.S.

- LEGEND**
- Catch Basin
 - - - Storm Pipe
 - |-|- Guardrail
 - ➔ Traffic Flow Direction
 - ~ Stormwater Flow Path

OREGON DEPARTMENT OF TRANSPORTATION

Prepared By:
Brooklyn Scholz

Drafted By:
Brooklyn Scholz

DFI D00207
MAINTENANCE DISTRICT 4 HWY 091
WATER QUALITY BIOFILTRATION SWALE
HIGHWAY MP 102.75, 102.75
BENTON

B Appendix B – Project Contract Plans

Contents:

Site Specific Subset of Project Contract Plan 40V-046


INDEX OF SHEETS	
SHEET NO.	DESCRIPTION
1	Title Sheet
1A	Index Of Sheets Cont'd. & Std. Drg. Nos.

STATE OF OREGON
DEPARTMENT OF TRANSPORTATION
PLANS FOR PROPOSED PROJECT

GRADING, STRUCTURES, PAVING, SIGNALS AND ROADSIDE DEVELOPMENT

OR 99W: MILLER CREEK BRIDGE

**PACIFIC HIGHWAY WEST
BENTON COUNTY
MAY 2007**

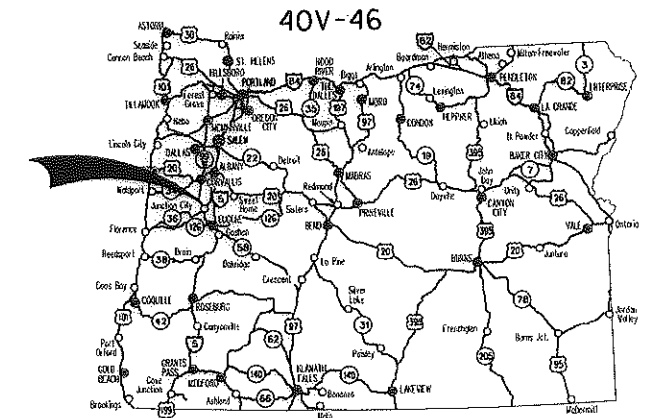


Overall Length Of Project - 0.18 Miles

ATTENTION:
Oregon Law Requires You To Follow Rules Adopted By The Oregon Utility Notification Center. Those Rules Are Set Forth In OAR 952-001-0010 Through OAR 952-001-0090. You May Obtain Copies Of The Rules By Calling The Center. (Note: The Telephone Number For The Oregon Utility Center Is (503) 232-1987.)

**BEGINNING OF PROJECT
X-STP-S091(019)
STA. 78+24.67 (M.P. 102.63)**


**PROJECT SITE: BRIDGE #01588
STA. 83+02.50 (M.P. 102.72)**

**END OF PROJECT
X-STP-S091(019)
STA. 87+85.43 (M.P. 102.81)**

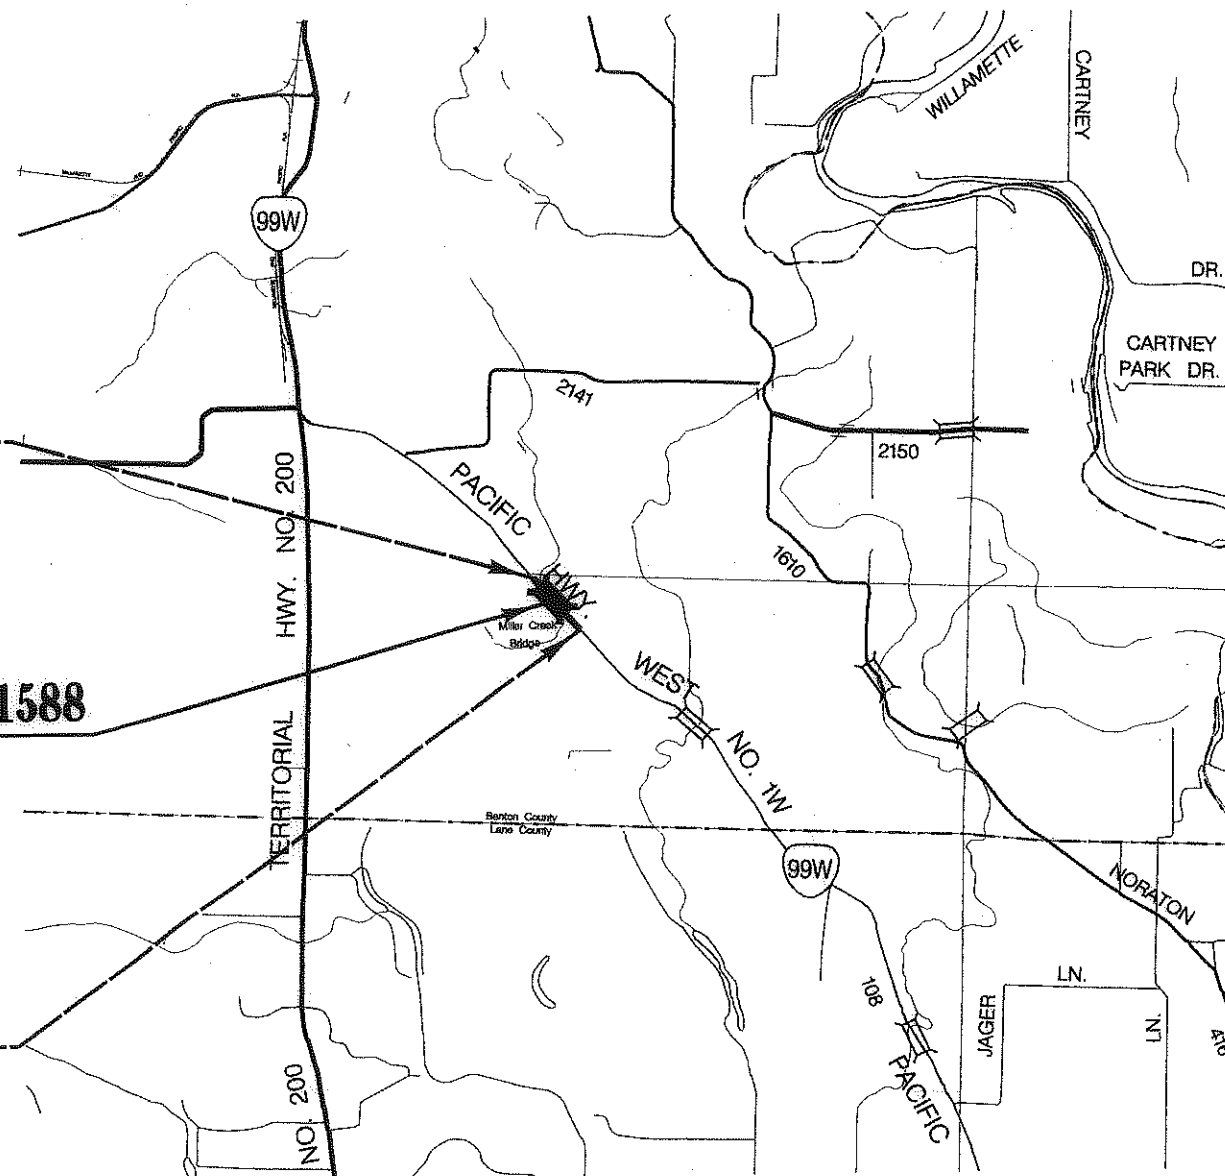

LET'S ALL
WORK TOGETHER
TO MAKE THIS
JOB SAFE

REVISED AS CONSTRUCTED
16/10/08 CONTRACT 13381
PROJ. MGR. CURT VANDERZANDEN

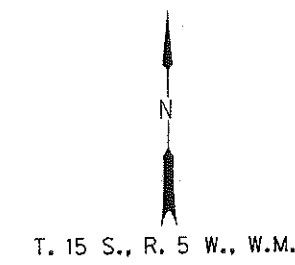

OREGON TRANSPORTATION COMMISSION

Stuart Foster	CHAIRMAN
Gail L. Achterman	COMMISSIONER
Mike Nelson	COMMISSIONER
Randall Papé	COMMISSIONER
Janice Wilson	COMMISSIONER
Matthew L. Garrett	DIRECTOR OF TRANSPORTATION

EXPIRATION DATE: 6/30/08

CURTIS C. VANDERZANDEN
KPFF CONSULTING ENGINEERS - PROJECT MANAGER

**OREGON DEPARTMENT OF TRANSPORTATION
CONCURRENCE**


TECHNICAL SERVICES MANAGING ENGINEER	DATE
--------------------------------------	------

**OR99W: MILLER CREEK BRIDGE
PACIFIC HIGHWAY WEST
BENTON COUNTY**

FEDERAL HIGHWAY ADMINISTRATION	PROJECT NUMBER	SHEET NO.
OREGON DIVISION	X-STP-S091(019)	1

STATION / OFFSET / ELEVATION TABLE

STA.	A cl	B		C		D		E		F		G		H	
		Offset	Elev.	Offset	Elev.	Offset	Elev.	Offset	Elev.	Offset	Elev.	Offset	Elev.	Offset	Elev.
85+60	288.45	24.00	287.97	28.32	286.38	30.28	285.40	31.28	284.90	35.28	284.90	36.28	285.29	39.50	286.90
85+70	288.43	24.00	287.95	28.32	286.36	30.34	285.35	31.34	284.85	35.34	284.85	36.34	285.22	39.50	286.80
85+80	288.41	24.00	287.93	28.32	286.34	30.40	285.30	31.40	284.80	35.40	284.80	36.40	285.15	39.50	286.70
85+90	288.39	24.00	287.91	28.32	286.32	30.70	285.13	31.70	284.75	35.70	284.75	36.70	285.00	39.50	286.40
86+00	288.38	24.00	287.90	28.32	286.31	31.00	284.95	32.00	284.70	36.00	284.70	37.00	284.95	39.50	286.40
86+10	288.37	24.00	287.89	28.32	286.30	31.12	284.90	32.12	284.65	36.12	284.65	37.12	284.90	39.22	285.95
86+20	288.36	24.00	287.88	28.32	286.29	31.20	284.85	32.20	284.60	36.20	284.60	37.20	284.85	38.90	285.70
86+30	288.35	24.00	287.87	28.32	286.28	31.28	284.80	32.28	284.55	36.28	284.55	37.28	284.80	39.28	285.80
86+40	288.34	24.00	287.86	28.32	286.27	31.28	284.75	32.36	284.50	36.36	284.50	37.36	284.75	39.26	285.70
86+50	288.32	24.00	287.84	28.32	286.25	31.42	284.70	32.42	284.45	36.42	284.45	37.42	284.70	39.02	285.50
86+60	288.30	24.00	287.82	28.32	286.23	31.48	284.65	32.48	284.40	36.48	284.40	37.48	284.65	38.78	285.30

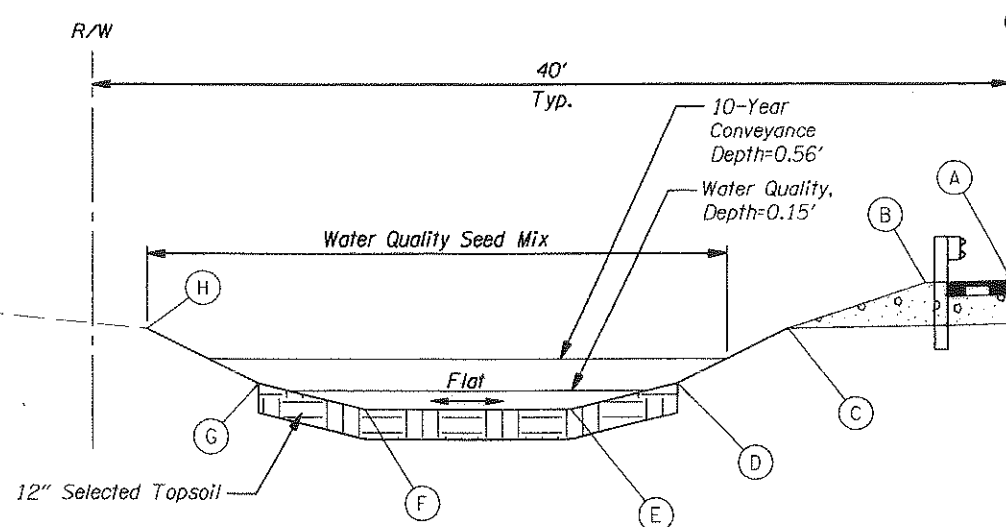


WATER QUALITY SWALE

STA. 85+60.00 To, STA. 86+60.00 Lt.


- Notes:
1. Install Riprap Pad Where Pipe Enters Swale. (See Sht. No. 2B-2)

- Notes:
1. For Transition Details, See Appropriate Bridge Standard Drawings. Eliminate Thrie Beam To W-Beam Rail Element When Type 4 Rail Is Used.
2. Place Radius ID Plate (See Drg. RD415).
3. Shop Fabricate All Radius Rail To Dimensions Shown
4. Rail Elements:
* Thrie Beam Rail:
2 - 12 Gauge Rail Elements Or
1 - 10 Gauge Rail Element
** Thrie Beam Rail:
1 - 12 Gauge Rail Element

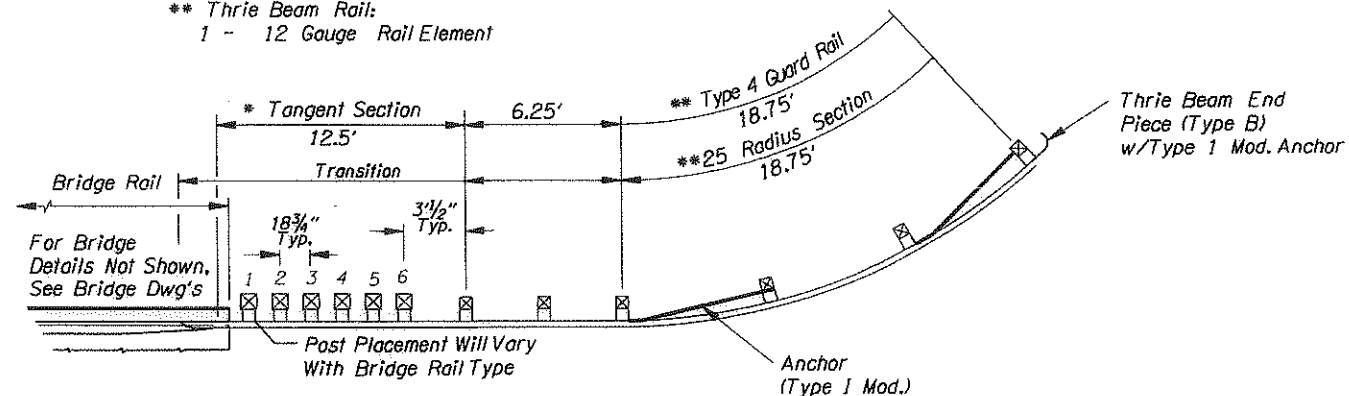


PARTIAL TRANSITION IN TANGENT
25' RADIUS

BRIDGE RAIL END PROTECTION (TYPE 4 RAIL)

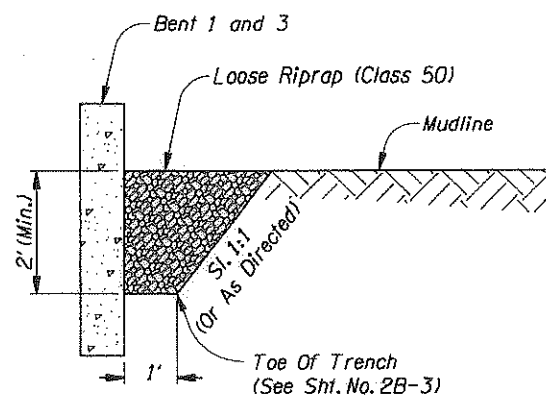

REVETMENT

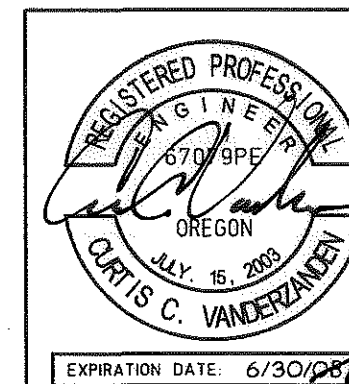

OREGON DEPARTMENT OF TRANSPORTATION

KPFF Consulting Engineers
111 S.W. 5th Avenue, Suite 2500
Portland, OR 97204-3628
(503) 227-3251 Fax (503) 274-4681




OR99W: MILLER CREEK BRIDGE
PACIFIC HIGHWAY WEST
BENTON COUNTY




Design Team Leader - Curt Vanderzanden
Designed By - Brad Cooper/Fred Maddox
Drafted By - Benjamin Eneas

DETAILS


SHEET NO.
2B

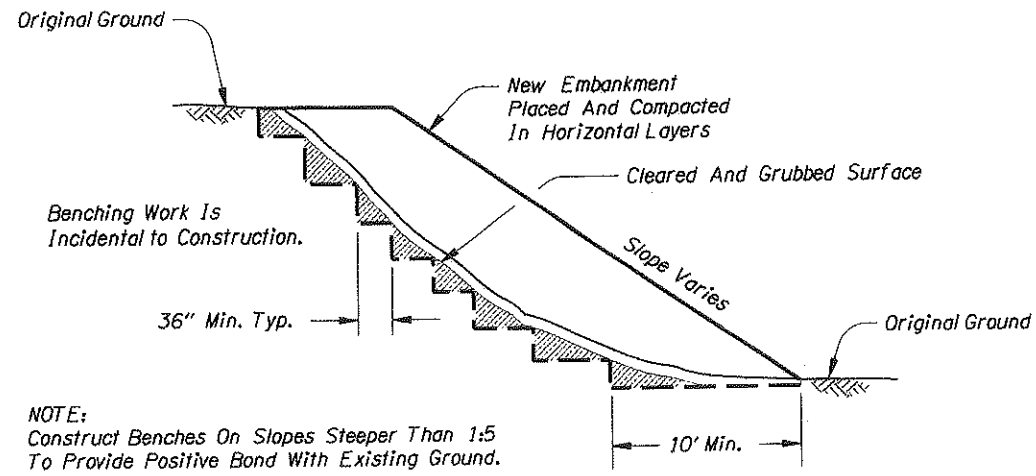


STANDARD EMBANKMENT CONSTRUCTION

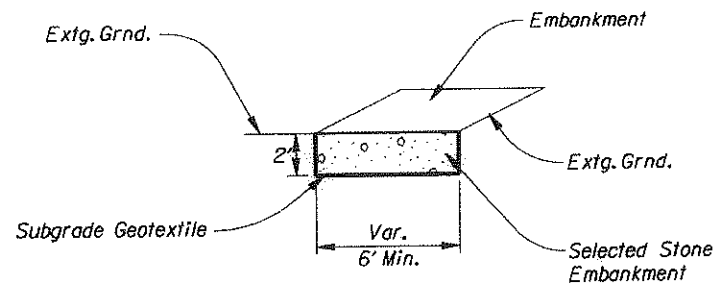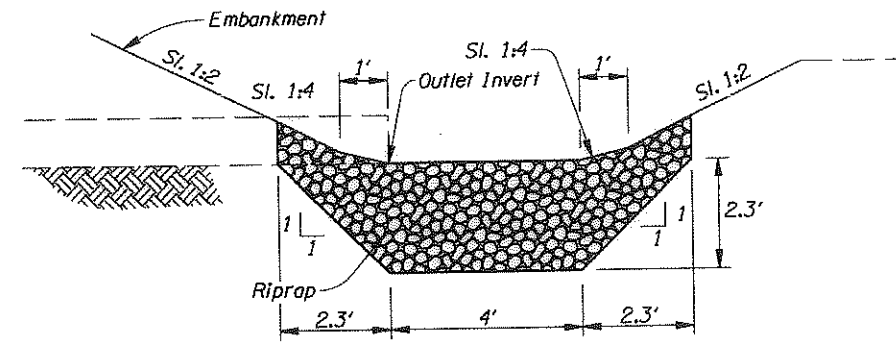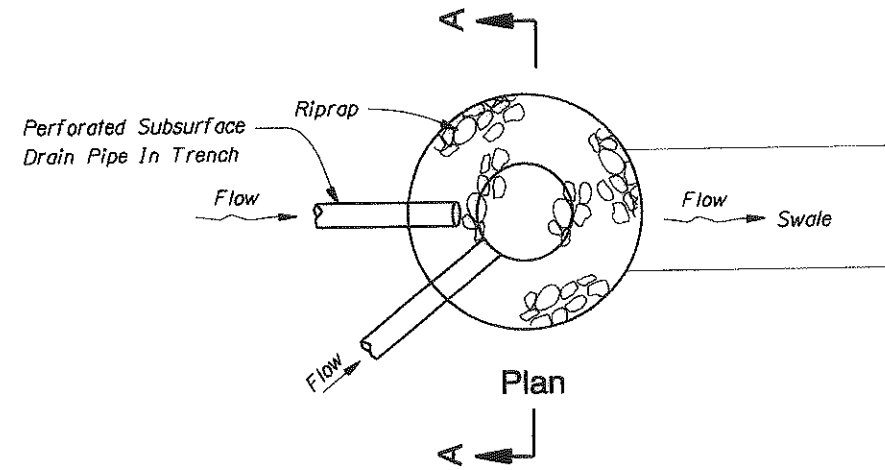

FOUNDATION EXCAVATION
(Locations As Directed)

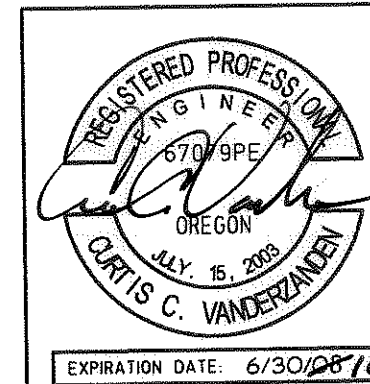

OREGON DEPARTMENT OF TRANSPORTATION	
KPFF Consulting Engineers 111 S.W. 5th Avenue, Suite 2500 Portland, OR 97204-3628 (503) 227-3251 Fax (503) 274-4681	
OR99W: MILLER CREEK BRIDGE PACIFIC HIGHWAY WEST BENTON COUNTY	
Design Team Leader - Curt Vanderzanden Designed By - Brad Cooper/Fred Maddox Drafted By - Benjamin Eneas	
DETAILS	SHEET NO. 2B-2

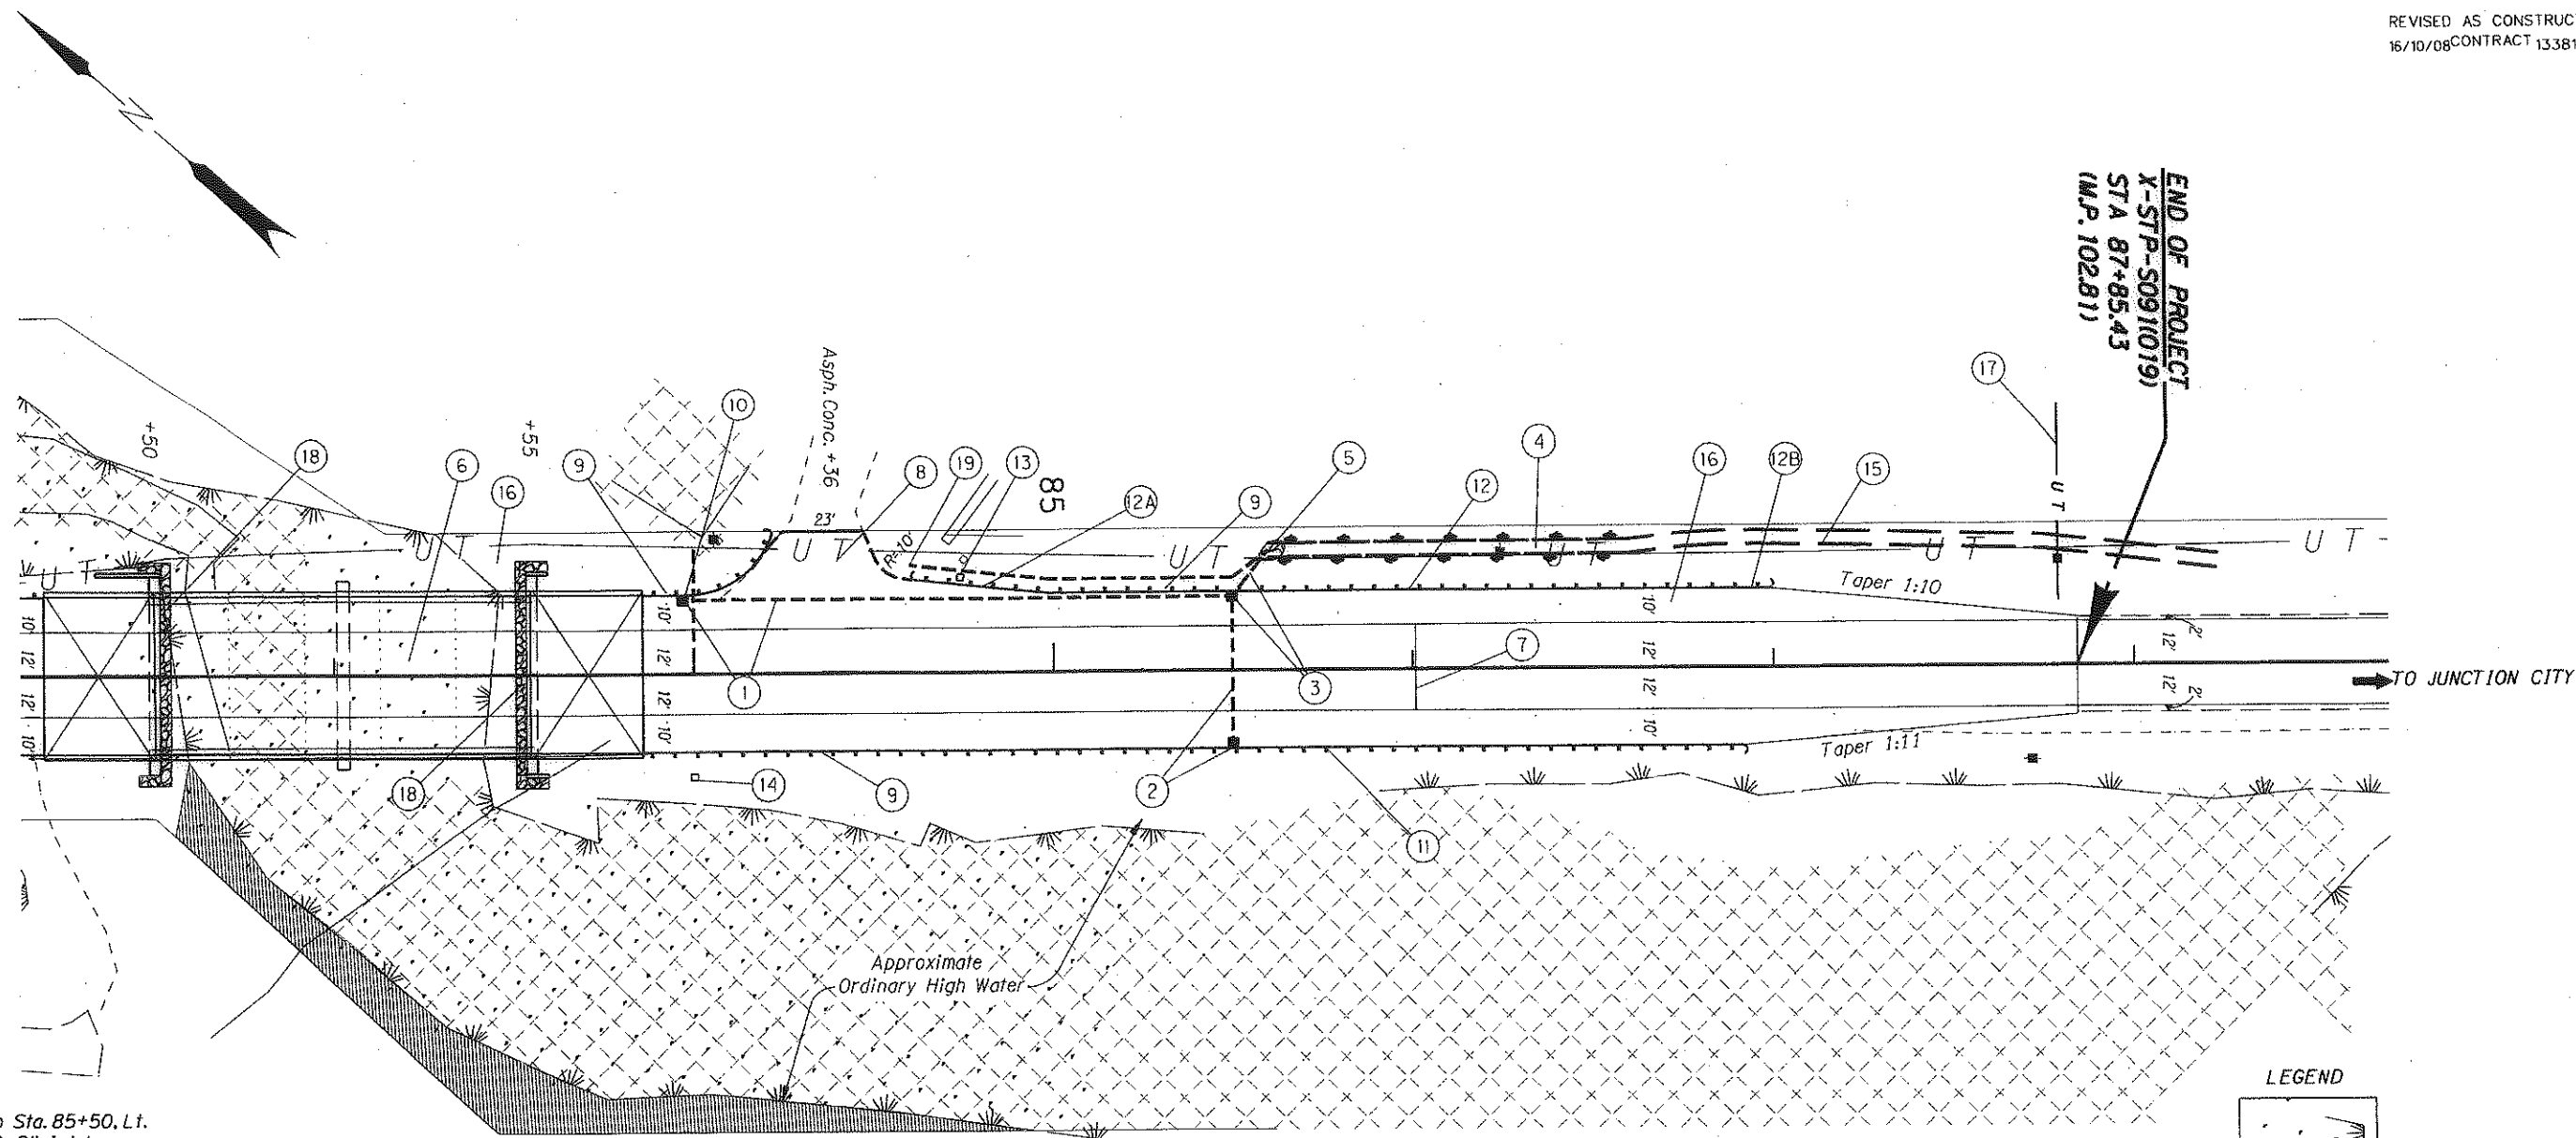

① Sta. 83+97 To Sta. 85+50, Lt.
Const. Type "G-2" Inlet
Inst. 12" Sew. Pipe - 153'
5' Depth
(See Drg. Nos. RD300 & RD364)

② Sta. 85+50.00, Rt.
Const. Type "G-2" Inlet
Inst. 12" Sew. Pipe - 41'
5' Depth
S=0.0050'/FT
I.E. (12" Out)-285.19

③ Sta. 85+60, Lt.
Const. Type "G-2" Inlet
Inst. 12" Sew. Pipe - 16'
5' Depth

④ Sta. 85+60 (33.5' Lt.) To Sta. 86+60 (34.0' Lt.)
Const. Water Quality Swale
Dt. Exc. - 70 Cu. Yd.
(For Details, See Sht. 2B)

⑤ Const. Riprap Pad
(Class 50) - 5 Cu. Yd.
(For Details, See Sht. 2B-2)

⑥ Structure No. 20463
Const. Structure - 105'
Rdwy. Width 44'-8"
And Reinf. Panel At Bridge Ends
(For Drg. Nos., See Sht. 1A)

⑦ Construct AC Pavement Match

⑧ Const. Appr.

⑨ Const. Drainage Curb
Sta. 83+86 To Sta. 83+98, Lt.
Sta. 84+61 To Sta. 85+55, Lt.
Sta. 83+86 To Sta. 85+55, Rt.
(See Drg's. No's. RD400 & RD700)

⑩ Sta. 83+86 To Sta. 84+22, Lt.
Const. Guardrail - 25' (Type 4)
(25' Radius)
Const. Guardrail Transition
Flare Rate=0, W=0, E=2'
Const. Anchor (Type 1 Mod.) - 2
Inst. End Piece (Type B)
(For Details, See Sht. 2B)

⑪ Sta. 83+86 To Sta. 86+91, Rt.
Const. Guardrail - 237.5' (Type 2A)
- 12.5' (Type 3)
Const. Guardrail Transition
Const. Guardrail Terminal, Non-Flared, (Test Level 3)
Flare Rate=0, W=0, E=2'

⑫ Sta. 84+61 To Sta. 86+99, Lt.
⑫A Const. Guardrail Terminal, Flared, (Test Level 3)
Flare Rate=0, W=4', E=2'
⑫B Const. Guardrail Terminal, Non-Flared, (Test Level 3)
Flare Rate=0, W=0, E=2'

⑬ Install Single Mailbox Support
Const. Conc. Collar
(Locate As Dir.)
(See Drg. No's. RD100 & RD101)

⑭ Install Bat Housing
(Locate As, Dir.)

⑮ Const. Ditch
"V" Bottom, 1:2 Slopes
S=0.0020'/FT
Dt. Exc. - 11 Cu. Yd.

⑯ See Sht. 3, Note 5

⑰ Approx. Location of Relocated
Monroe Telephone Line
(By Others)


⑱ Const. Revetment
(For Details, See Sht. 2B-3)

⑲ Sta. 84+60, Lt. To Sta. 85+55, Lt.
Inst. 4" Subsurface Drain
I.E. = 285.68
S = 0.0050'/Ft Min.
Const. Outlet To Riprap Pad
(See Drg. No. RD312)

LEGEND



Wetland Shown Thus:

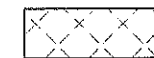

No Work Area



EXPIRATION DATE: 6/30/2010

OREGON DEPARTMENT OF TRANSPORTATION

KPFF Consulting Engineers
111 S.W. 5th Avenue, Suite 2500
Portland, OR 97204-3628
(503) 227-3251 Fax (503) 274-4681




OR99W: MILLER CREEK BRIDGE
PACIFIC HIGHWAY WEST
BENTON COUNTY

Design Team Leader - Curt Vanderzanden
Designed By - Brad Cooper/Fred Maddox
Drafted By - Benjamin Eneas

GENERAL CONSTRUCTION

SHEET NO.
4

END OF PROJECT
X-STP-S0910191
STA. 87+85.43 (IMP. 102871)

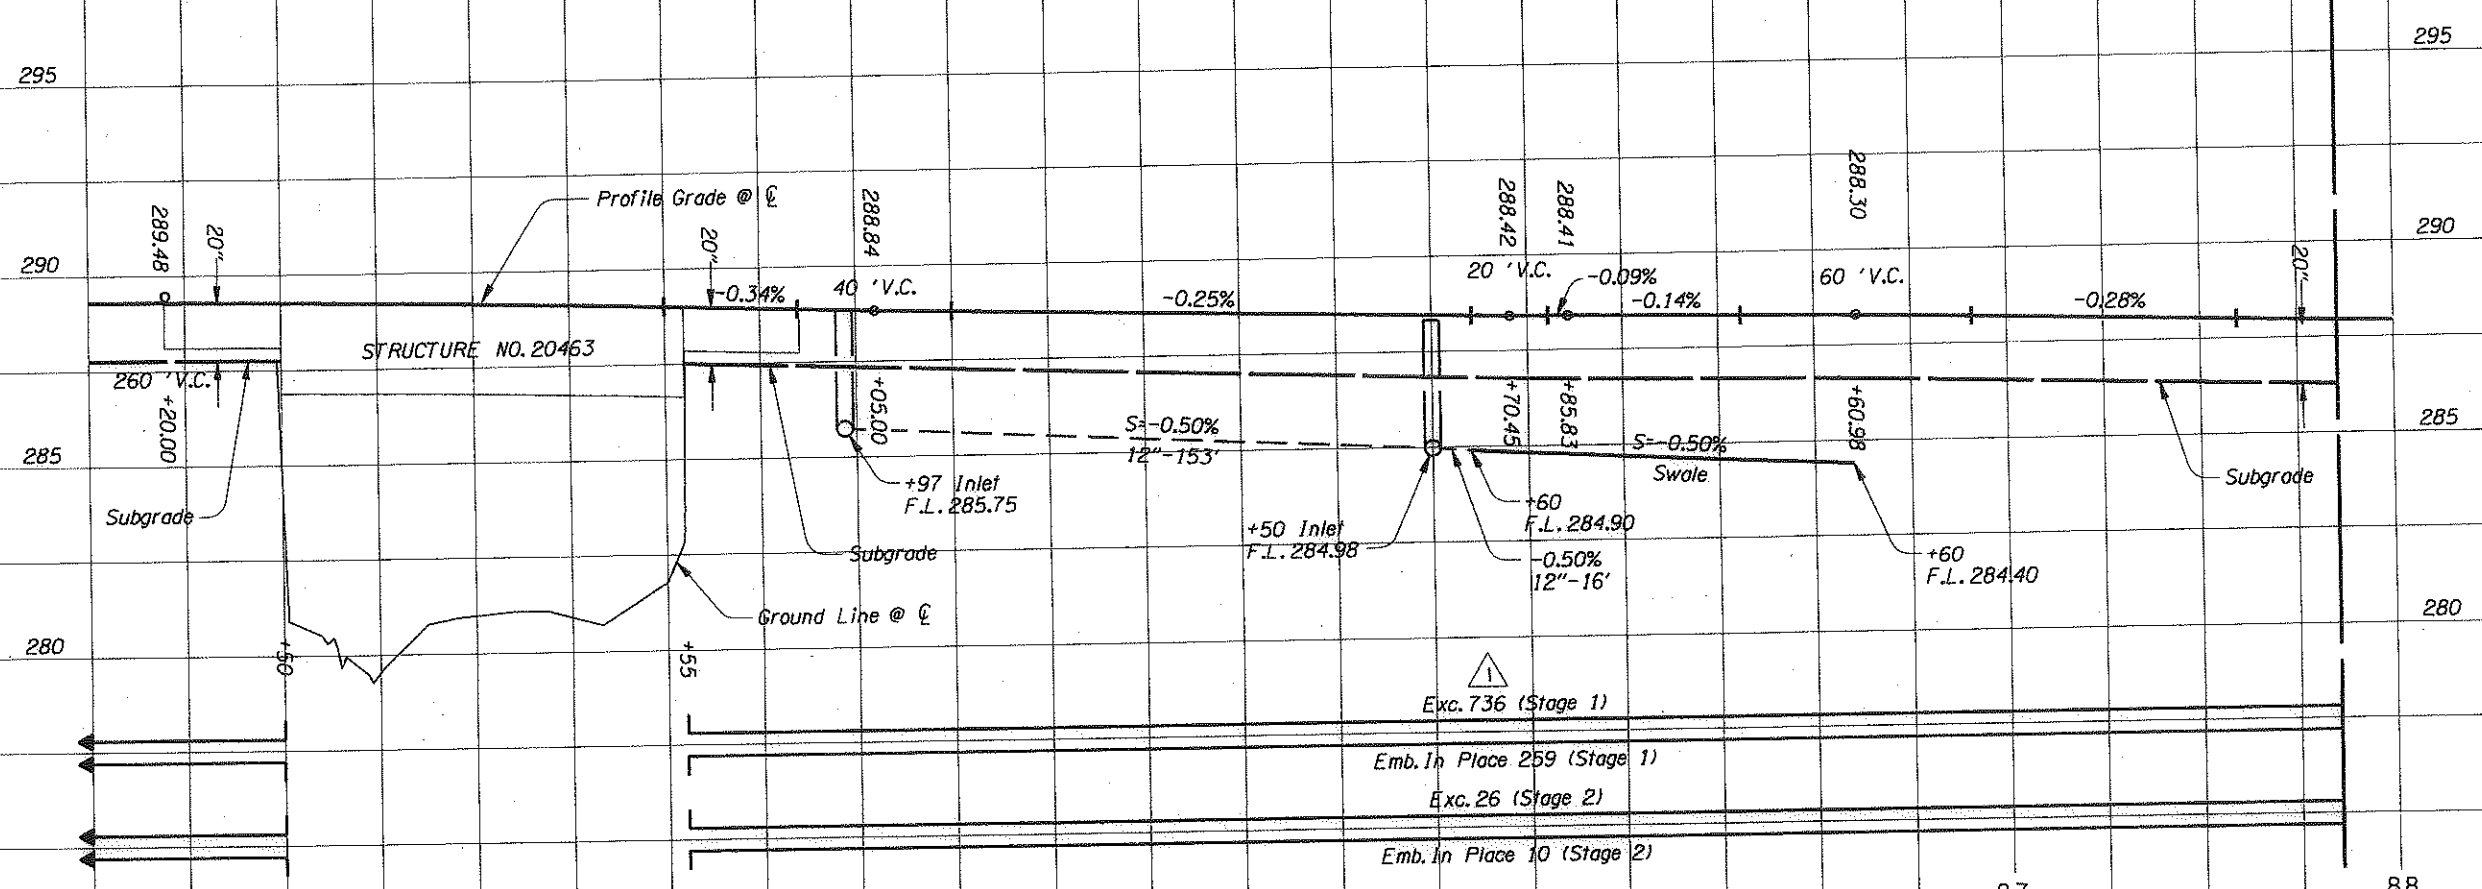


OREGON DEPARTMENT OF TRANSPORTATION

KPFF Consulting Engineers
111 S.W. 5th Avenue, Suite 2500
Portland, OR 97204-3628
(503) 227-3251 Fax (503) 274-4681



OR99W: MILLER CREEK BRIDGE
PACIFIC HIGHWAY WEST
BENTON COUNTY

Design Team Leader - Curt Vanderzanden
Designed By - Brad Cooper/Fred Maddox
Drafted By - Benjamin Eneas

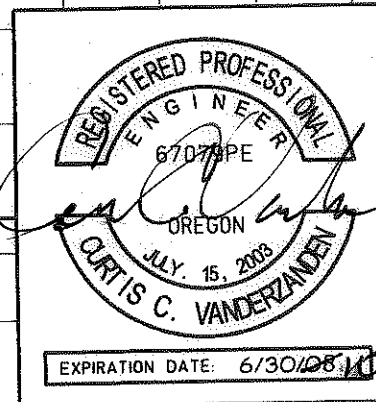

REVISIONS	
△	Revised 5-15-2007
	Revised Exc. Qty.

PROFILE SHEET

SHEET NO.
4A