

# OPERATION & MAINTENANCE MANUAL

Manual prepared: August 2017

DFI No. D00208



Figure 1: DFI No. D00208, looking Southeast

## 1. Identification

Drainage Facility ID (DFI): D00208  
Facility Type: Water Quality Biofiltration Swale  
Construction Drawings: (V-File Numbers) 39V-005  
Location: District: 04  
Highway No.: 033  
Mile Post: 51.20 to 51.26, Left

## 2. Manual Purpose

The purpose of this manual is to outline inspection needs and summarize maintenance actions.

## 3. Facility Location

The location map below details the facility location. The highway, mile posts, side streets, access location, and stormwater flow directions are noted on the map.

Facility location type: Off ramp

Flow direction: Southeast

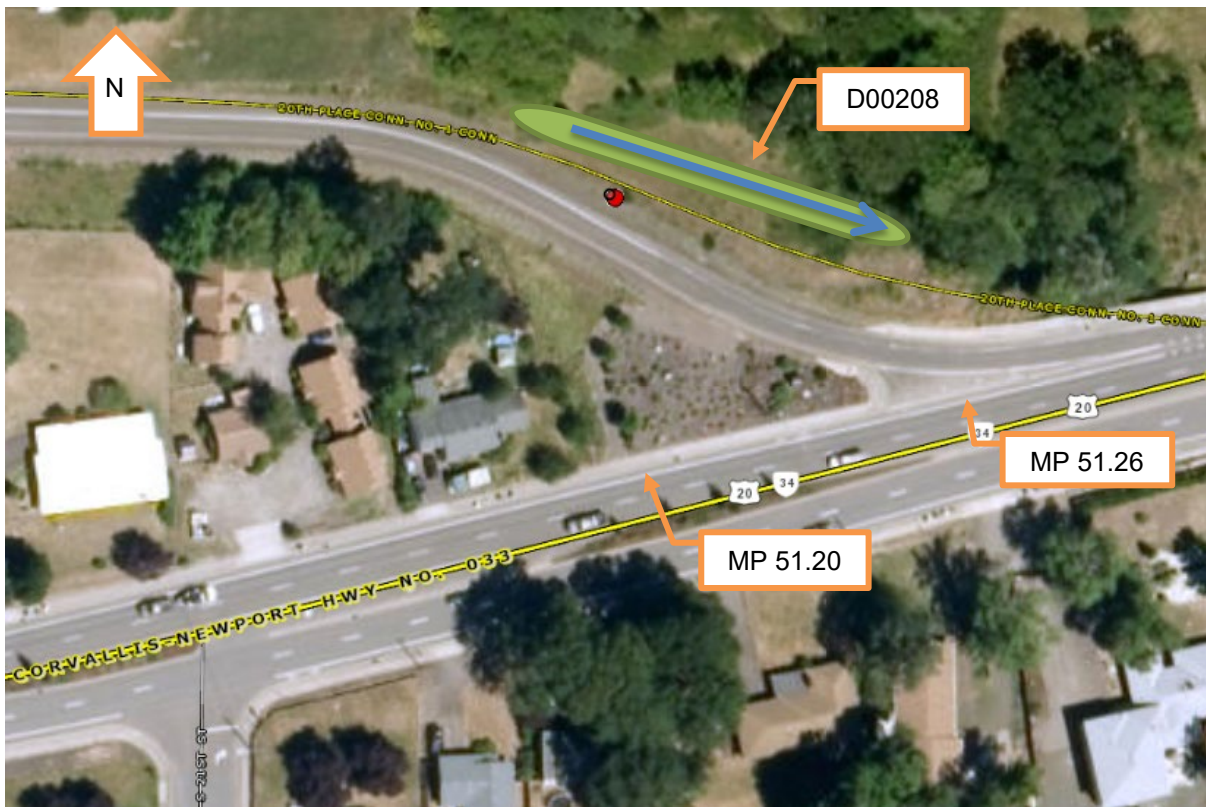



Figure 2: Facility location map

#### 4. Facility Summary

The length and width of a swale is based on the bottom dimensions.

The bottom length and bottom width of the swale is:


Bottom Length (feet)	Bottom Width (feet)
300	4

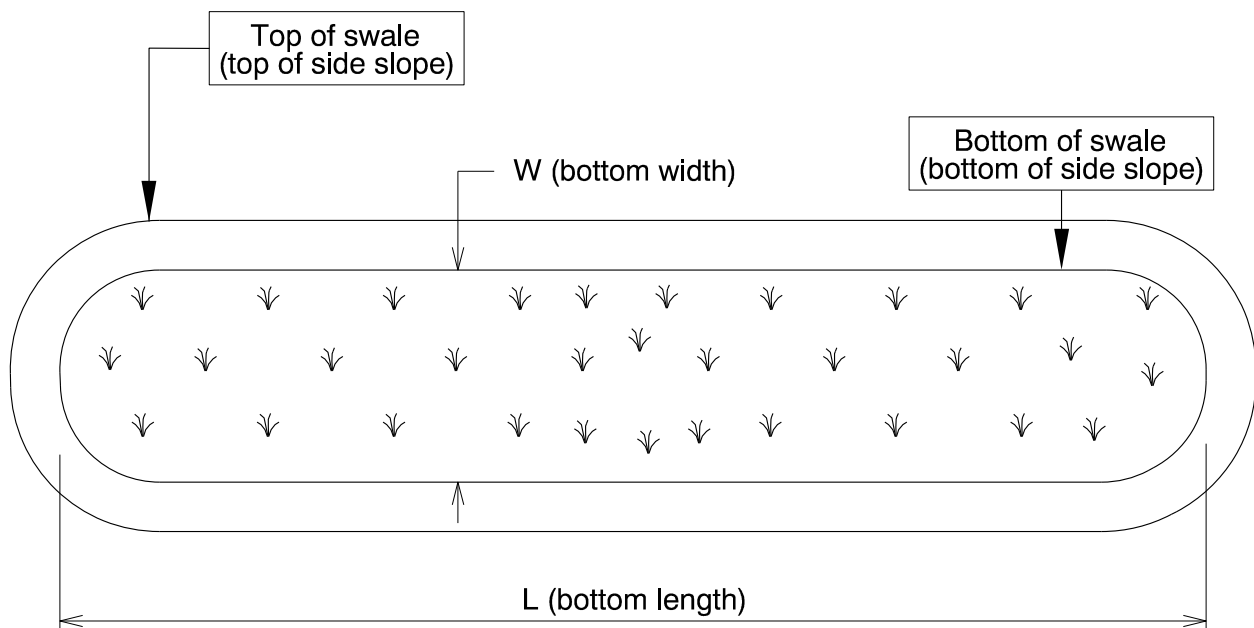

The depth of the swale is the vertical distance measured from the bottom of the swale to the top. The slope of the swale sides is presented by a vertical distance (rise) followed by the horizontal distance (run).

Depth and side slopes:

Depth (feet)	Rise (feet)	Run (feet)
1.5	Varies	Varies

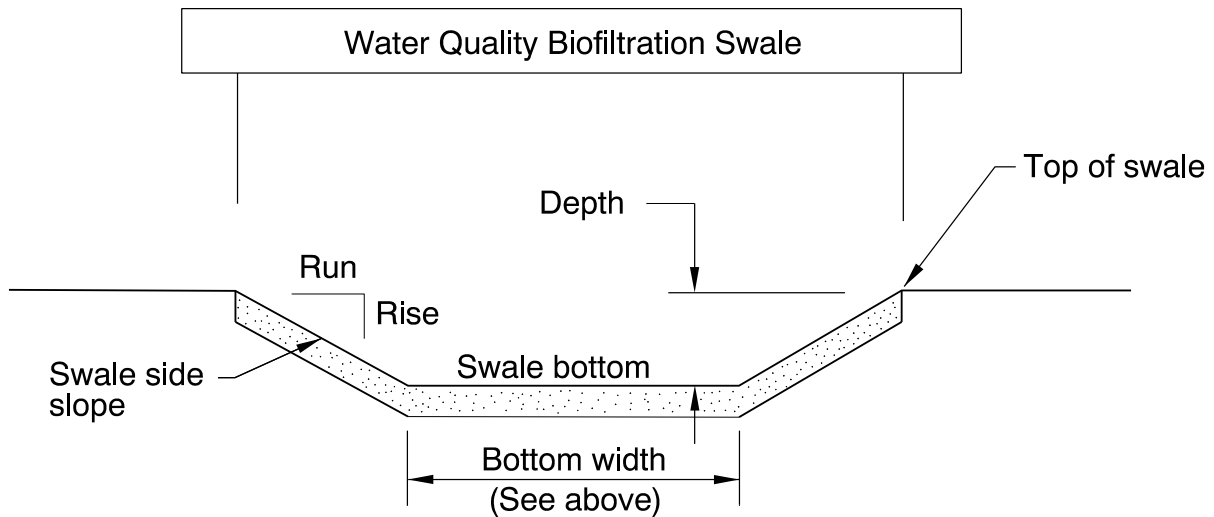

**Site Specific Information:** The facility uses a mixture of drain rock and water quality mix in the treatment area of the swale.



## 5. Facility Access

Maintenance access to the facility:

<input type="checkbox"/> Roadside pad	<input checked="" type="checkbox"/> Roadside shoulder
<input type="checkbox"/> Access road with Gate	<input type="checkbox"/> Access road without Gate



Figure 3: Facility access via roadside shoulder, looking Northwest

## 6. Operational Components / Maintenance Items

### Classification

This facility is classified as an:

<input checked="" type="checkbox"/> <b>On-line Swale</b>	<input type="checkbox"/> <b>Off-line Swale</b>
A swale that does not include a high flow bypass component; flow drains into and through the facility	A swale that treats low/small flows and diverts high flows using a bypass component

## Bypass Component

This facility includes a high flow bypass component:

<input checked="" type="checkbox"/> No	<input type="checkbox"/> Yes
There is no bypass component. High flows drain into and through the facility	There is a bypass component. Only low/small flows drain into the swale. High flows are diverted around the swale using a bypass component

## Operational Components

A swale has many components that assist with treatment, conveyance, and reducing flow velocity to minimize erosion. The components in use can vary depending if the facility was designed to operate on-line or off-line. The facility components table (**Table 1**) has been provided to highlight the applicable components for this facility. The component is in use when the box contains an "x" (e.g. ).

The Standard Operation Manual for Water Quality Biofiltration Swales (implemented March 2017) outlines facility operation, typical footprint configuration, and component definitions and details. A link to the manual is attached to the feature marker in TransGIS.

<https://gis.odot.state.or.us/TransGIS/>

## Operational Plan

The applicable standard operational plan for this facility is:

<input checked="" type="checkbox"/> Operational Plan A	<input type="checkbox"/> Operational Plan B	<input type="checkbox"/> Operational Plan C
A standard operational plan illustrates the general facility footprint configuration and explains the purpose of each facility component. Operational plans (A, B, C) are provided in the Standard Operation Manual.		

See Appendix A for the site specific operational plan.

## Maintenance Items

Operational components marked in **Table 1** should be inspected and maintained according to Section 7. Each facility component is defined and detailed in the Standard Operation Manual using the associated ID number indicated below.

<b>Table 1: Swale Components</b>		<b>ID #</b>
<b>Manholes/Structures</b>		
Pre-treatment manhole	<input type="checkbox"/>	<b>S1</b>
Weir type flow splitter/flow splitter manhole	<input type="checkbox"/>	<b>S2</b>
Orifice type flow splitter/flow splitter manhole	<input type="checkbox"/>	<b>S3</b>
Standard manhole	<input type="checkbox"/>	<b>S4</b>
<b>Swale Inlet</b>		
Pavement sheet flow	<input type="checkbox"/>	<b>S5</b>
Inlet Pipe (s)	<input checked="" type="checkbox"/>	<b>S6</b>
Open channel inlet	<input type="checkbox"/>	<b>S7</b>
Riprap pad	<input checked="" type="checkbox"/>	<b>S8</b>
<b>Ground Cover</b>		
Grass bottom	<input checked="" type="checkbox"/>	<b>S9</b>
Grass side slopes	<input checked="" type="checkbox"/>	<b>S10</b>
Granular drain rock	<input checked="" type="checkbox"/>	<b>S11</b>
Plantings	<input type="checkbox"/>	<b>S12</b>
<b>Underground Components</b>		
Geotextile fabric	<input checked="" type="checkbox"/>	<b>S13</b>
Water quality mix	<input checked="" type="checkbox"/>	<b>S14</b>
Perforated pipe	<input type="checkbox"/>	<b>S15</b>
Porous pavers (access grid)	<input checked="" type="checkbox"/>	<b>S16</b>
<b>Flow Spreader</b>		
Rock basin (used at inlet)	<input type="checkbox"/>	<b>S17</b>
Anchored board (midpoint of swale or every 50 feet along swale bottom)	<input type="checkbox"/>	<b>S18</b>
Other: Riprap flow spreader	<input checked="" type="checkbox"/>	<b>S19</b>
<b>Swale Outlet</b>		
Catch basin with grate	<input type="checkbox"/>	<b>S20</b>
Outlet Pipe (s)	<input type="checkbox"/>	<b>S21</b>
Open channel outlet	<input checked="" type="checkbox"/>	<b>S22</b>
Auxiliary Outlet:	<input type="checkbox"/>	<b>S23</b>
<b>Outfall Type</b>		
Waterbody (Creek/Lake/Ocean)	<input checked="" type="checkbox"/> <b>C</b>	<b>S24</b>
	<input type="checkbox"/> <b>L</b>	
	<input type="checkbox"/> <b>O</b>	
Ditch	<input type="checkbox"/>	<b>S25</b>
Storm drain system	<input type="checkbox"/>	<b>S26</b>
<b>Outfall Components</b>		
Riprap pad	<input checked="" type="checkbox"/>	<b>S27</b>
Riprap bank protection	<input checked="" type="checkbox"/>	<b>S28</b>

## 7. Maintenance

### Maintenance Frequency/Maintain Records

- a. Inspect annually. Preferably prior to the rainy season.
- b. Clean and maintain as necessary. Refer to Activity 125 for conditions when maintenance is needed.
- c. Keep a record of inspections, maintenance, and repairs.

### Maintenance Guide/Maintenance Actions

The ODOT Routine Road Maintenance Water Quality and Habitat Guide (the *Blue Book*) outlines the standard maintenance actions for water quality facilities under Activity 125.

There are standard maintenance tables for standard ODOT designs. The maintenance tables describe the maintenance component, the defect or problem, the condition when maintenance is needed, and the recommended maintenance to correct the problem. Use the following tables to maintain ODOT swales:

- Table 1 (General Maintenance): Contains general maintenance and inspection guidelines that are applicable to all ODOT water quality facilities
- Table 3 (Maintenance of Water Quality or Biofiltration Swales): Contains maintenance information for swales

The *Blue Book* can be viewed at the following website:

[http://www.oregon.gov/ODOT/Maintenance/Documents/blue\\_book.pdf](http://www.oregon.gov/ODOT/Maintenance/Documents/blue_book.pdf)

## 8. Limitations

Access grid installed:

<input type="checkbox"/> No	<input checked="" type="checkbox"/> Yes
There are (Choose applicable weight: no, light, med., heavy) duty porous pavers installed in this swale	

Swales are designed to allow equipment access along the bottom. If an access grid is **NOT** installed, vehicles entering the swale can create depressions (tire ruts), damage vegetation, and damage structural components (e.g. flow spreaders). These conditions may result in poor treatment and drainage performance.

Equipment wheels should be kept on the tops and side slopes. Mower arms may be run along the swale bottom.



## 9. Waste Material Handling

Material removed from the facility is defined as waste by the Department of Environmental Quality (DEQ). Refer to the roadwaste section of the ODOT Maintenance Yard Environmental Management System (EMS) Policy and Procedures Manual for disposal options:

[http://www.oregon.gov/ODOT/Maintenance/Documents/ems\\_manual.pdf](http://www.oregon.gov/ODOT/Maintenance/Documents/ems_manual.pdf)


Contact any of the following for more detailed information about management of waste materials found on site:

ODOT Clean Water Unit	(503) 986-3008
ODOT Statewide Hazmat Coordinator	(503) 667-7442
ODOT Region 1 Hazmat Coordinator	(503) 731-8290
ODOT Region 2 Hazmat Coordinator	(503) 986-2647
ODOT Region 3 Hazmat Coordinator	(541) 957-3594
ODOT Region 4 Hazmat Coordinator	(541) 388-6186
ODOT Region 5 Hazmat Coordinator	(541) 963-1590
ODEQ Northwest Region Office	(503) 229-5263

## **A Appendix A – Site Specific Operational Plan**

### **Contents:**

**Operational Plan: DFI D00208**

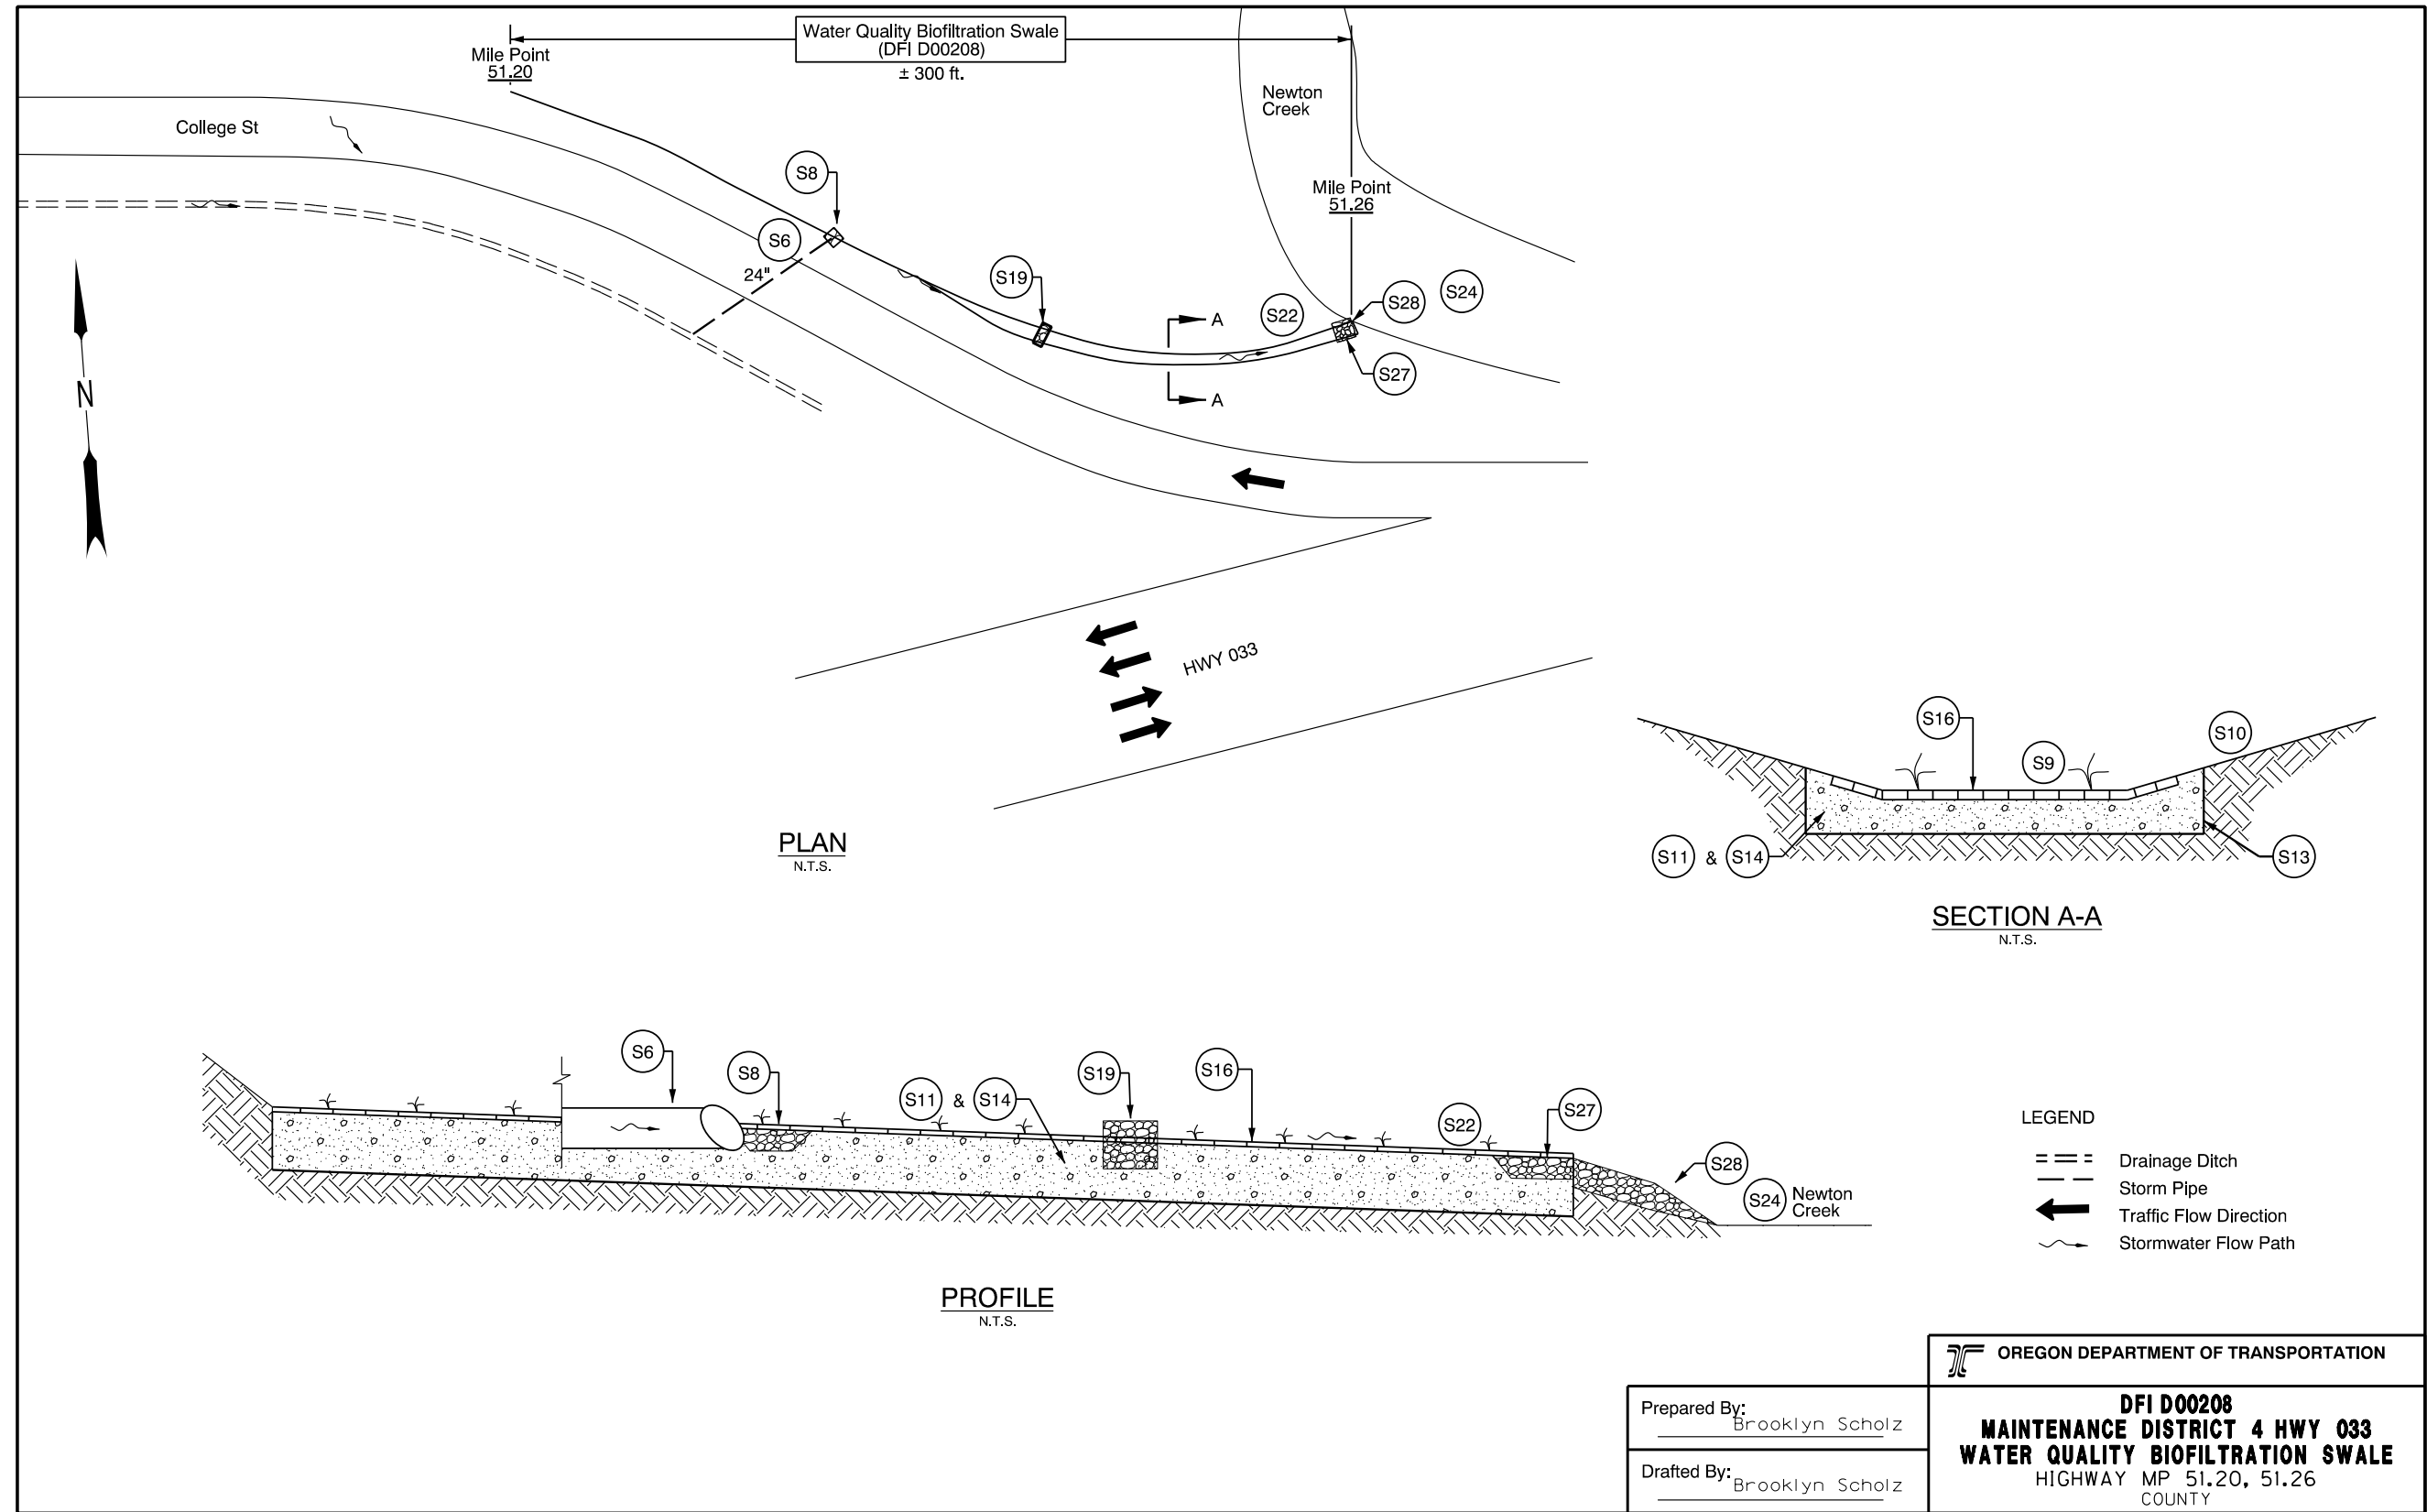

DFI\_D00208.dgn

## **B Appendix B – Project Contract Plans**

### **Contents:**


**Site Specific Subset of Project Contract Plan 39V-005**

STATE OF OREGON  
DEPARTMENT OF TRANSPORTATION

PLANS FOR PROPOSED PROJECT  
**GRADING, DRAINAGE, STRUCTURES, PAVING & SIGNALS**

**US 20: PHILOMATH COUPLET  
(PHILOMATH)  
CORVALLIS-NEWPORT HIGHWAY**

REVISED AS CONSTRUCTED  
9 JUNE 2008 CONTRACT I3295  
PROJ. MGR. RAYMOND S. CRANSTON, PLS

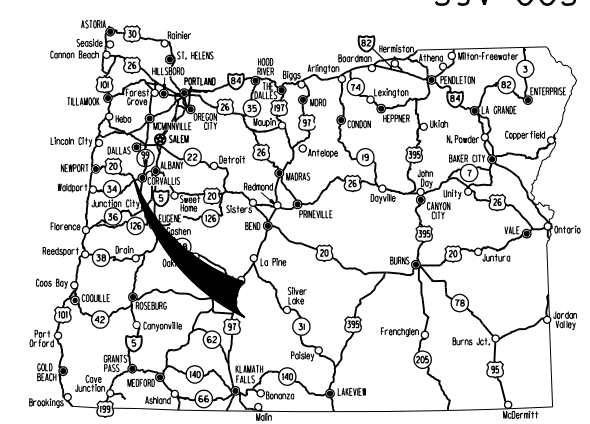

Overall Length Of Project - 8036 ft (1.53 Miles)

INDEX OF SHEETS	
SHEET NO.	DESCRIPTION
1	Title Sheet
1A	Index Of Sheets Cont'd.
1B	Standard Drg. Nos.
1C	Sheet Layout
2, 2A Thru 2A-10 Incl.	Typical Sections
2B, 2B-2, 2B-3	Superelevation Chart
2B-4 Thru 2B-18 Incl.	Details
2C, 2C-2 Thru 2C-26 Incl.	Traffic Control Plans
2D, 2D-2 Thru 2D-4 Incl.	Pipe Data Sheets



BENTON COUNTY  
OCTOBER 2006

END OF PROJECT

STA. "HWY" 346+36 (M.P. 51.39)

**WREN HILL  
MITIGATION SITE**  
STA "HWY" 117+63 (M.P. 47.05)


**ATTENTION:**  
Oregon Law Requires You To Follow Rules Adopted By The Oregon Utility Notification Center. Those Rules Are Set Forth In OAR 952-001-0010 Through OAR 952-001-0090. You May Obtain Copies Of The Rules By Calling The Center. (Note: The Telephone Number For The Oregon Utility Center Is (503) 232-1987.)



**OREGON TRANSPORTATION COMMISSION**

Stuart Foster	CHAIRMAN
Gail L. Achterman	COMMISSIONER
Mike Nelson	COMMISSIONER
Randall Pape	COMMISSIONER
Janice Wilson	COMMISSIONER
Matthew Garrett	DIRECTOR OF TRANSPORTATION

PLANS PREPARED FOR  
**OREGON DEPARTMENT OF TRANSPORTATION**  
BY:  
**MURRAY, SMITH & ASSOC., INC.**

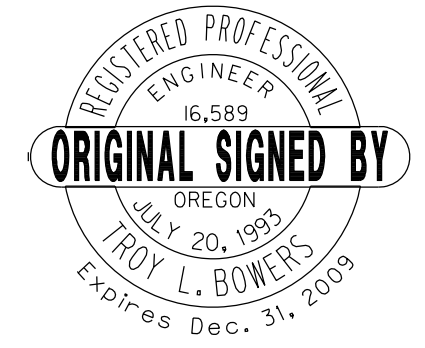


OREGON DEPARTMENT OF TRANSPORTATION  
CONCURRENCE


TECHNICAL SERVICES MANAGING ENGINEER \_\_\_\_\_ DATE \_\_\_\_\_

**US 20: PHILOMATH COUPLET (PHILOMATH)  
CORVALLIS-NEWPORT HIGHWAY**  
BENTON COUNTY


FEDERAL HIGHWAY ADMINISTRATION	PROJECT NUMBER	SHEET NO.
OREGON DIVISION	OTIA-S0-S033 (025)	1

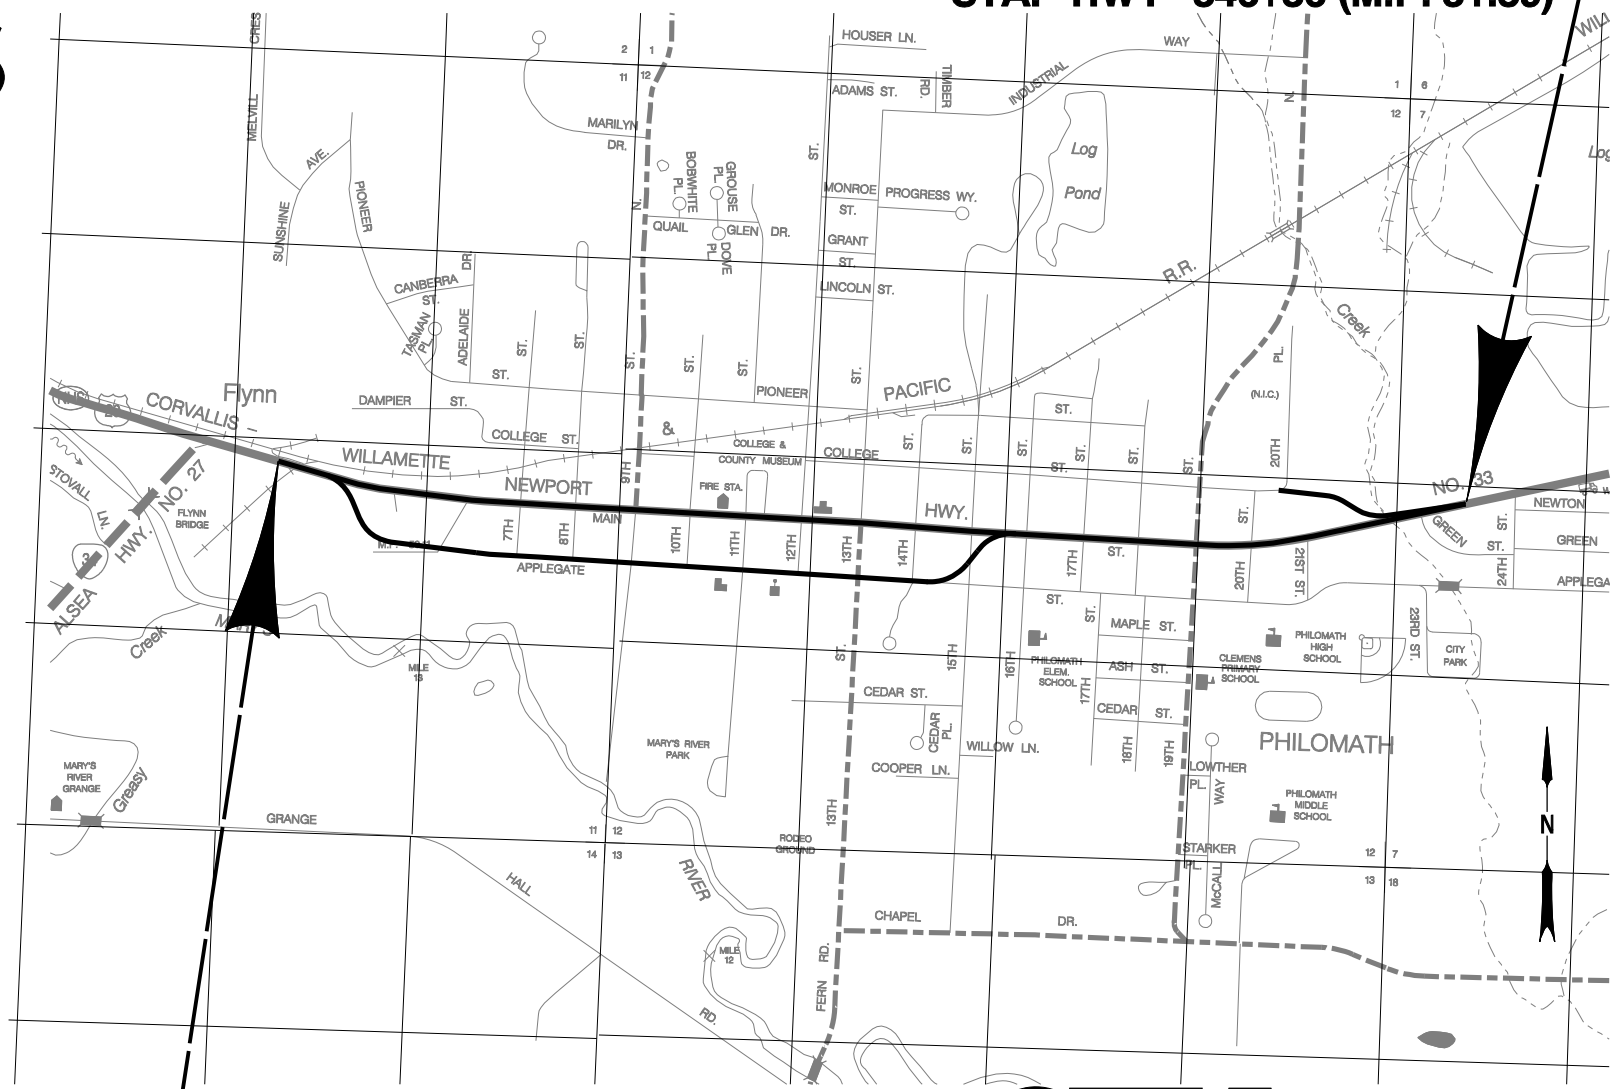

**BEGINNING OF PROJECT**  
STA. "HWY" 263+45 (M.P. 49.81)

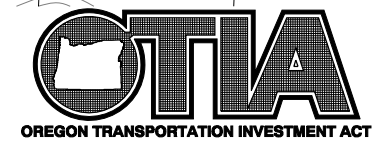

T. 12 S., R. 6 W., W.M.

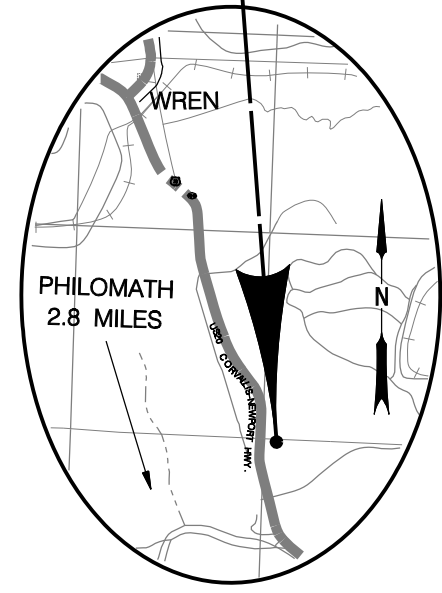

**RECORD DRAWINGS**


THIS DRAWING IS FOR RECORD PURPOSES ONLY, AND HAS BEEN PREPARED BASED IN PART ON INFORMATION PROVIDED BY OTHERS RELATIVE TO REPORTED CONSTRUCTED CONDITIONS. WHILE THIS INFORMATION IS BELIEVED TO BE RELIABLE, MURRAY, SMITH & ASSOCIATES, INC. MAKES NO ASSURANCES, STATED OR IMPLIED, AS TO THE ACCURACY OF THIS DRAWING. THOSE RELYING ON THIS RECORD DRAWING FOR ANY PURPOSE ARE ADVISED TO OBTAIN INDEPENDENT VERIFICATION OF ITS ACCURACY. CONTRACT MODIFICATION INFORMATION, FABRICATOR'S SHOP DRAWINGS AND OTHER PROJECT SUBMITTAL INFORMATION PROVIDED BY THE CONTRACTOR WHICH FURTHER CLARIFY DETAILS OF CONSTRUCTION MAY BE ON FILE. SEE ORIGINAL CONTRACT DRAWINGS FOR ENGINEER'S SEAL AND SIGNATURES.

VERSION 4.0 12-9-97

**REVISIONS**

Revised 11-03-06
Added Sheet 2A-10



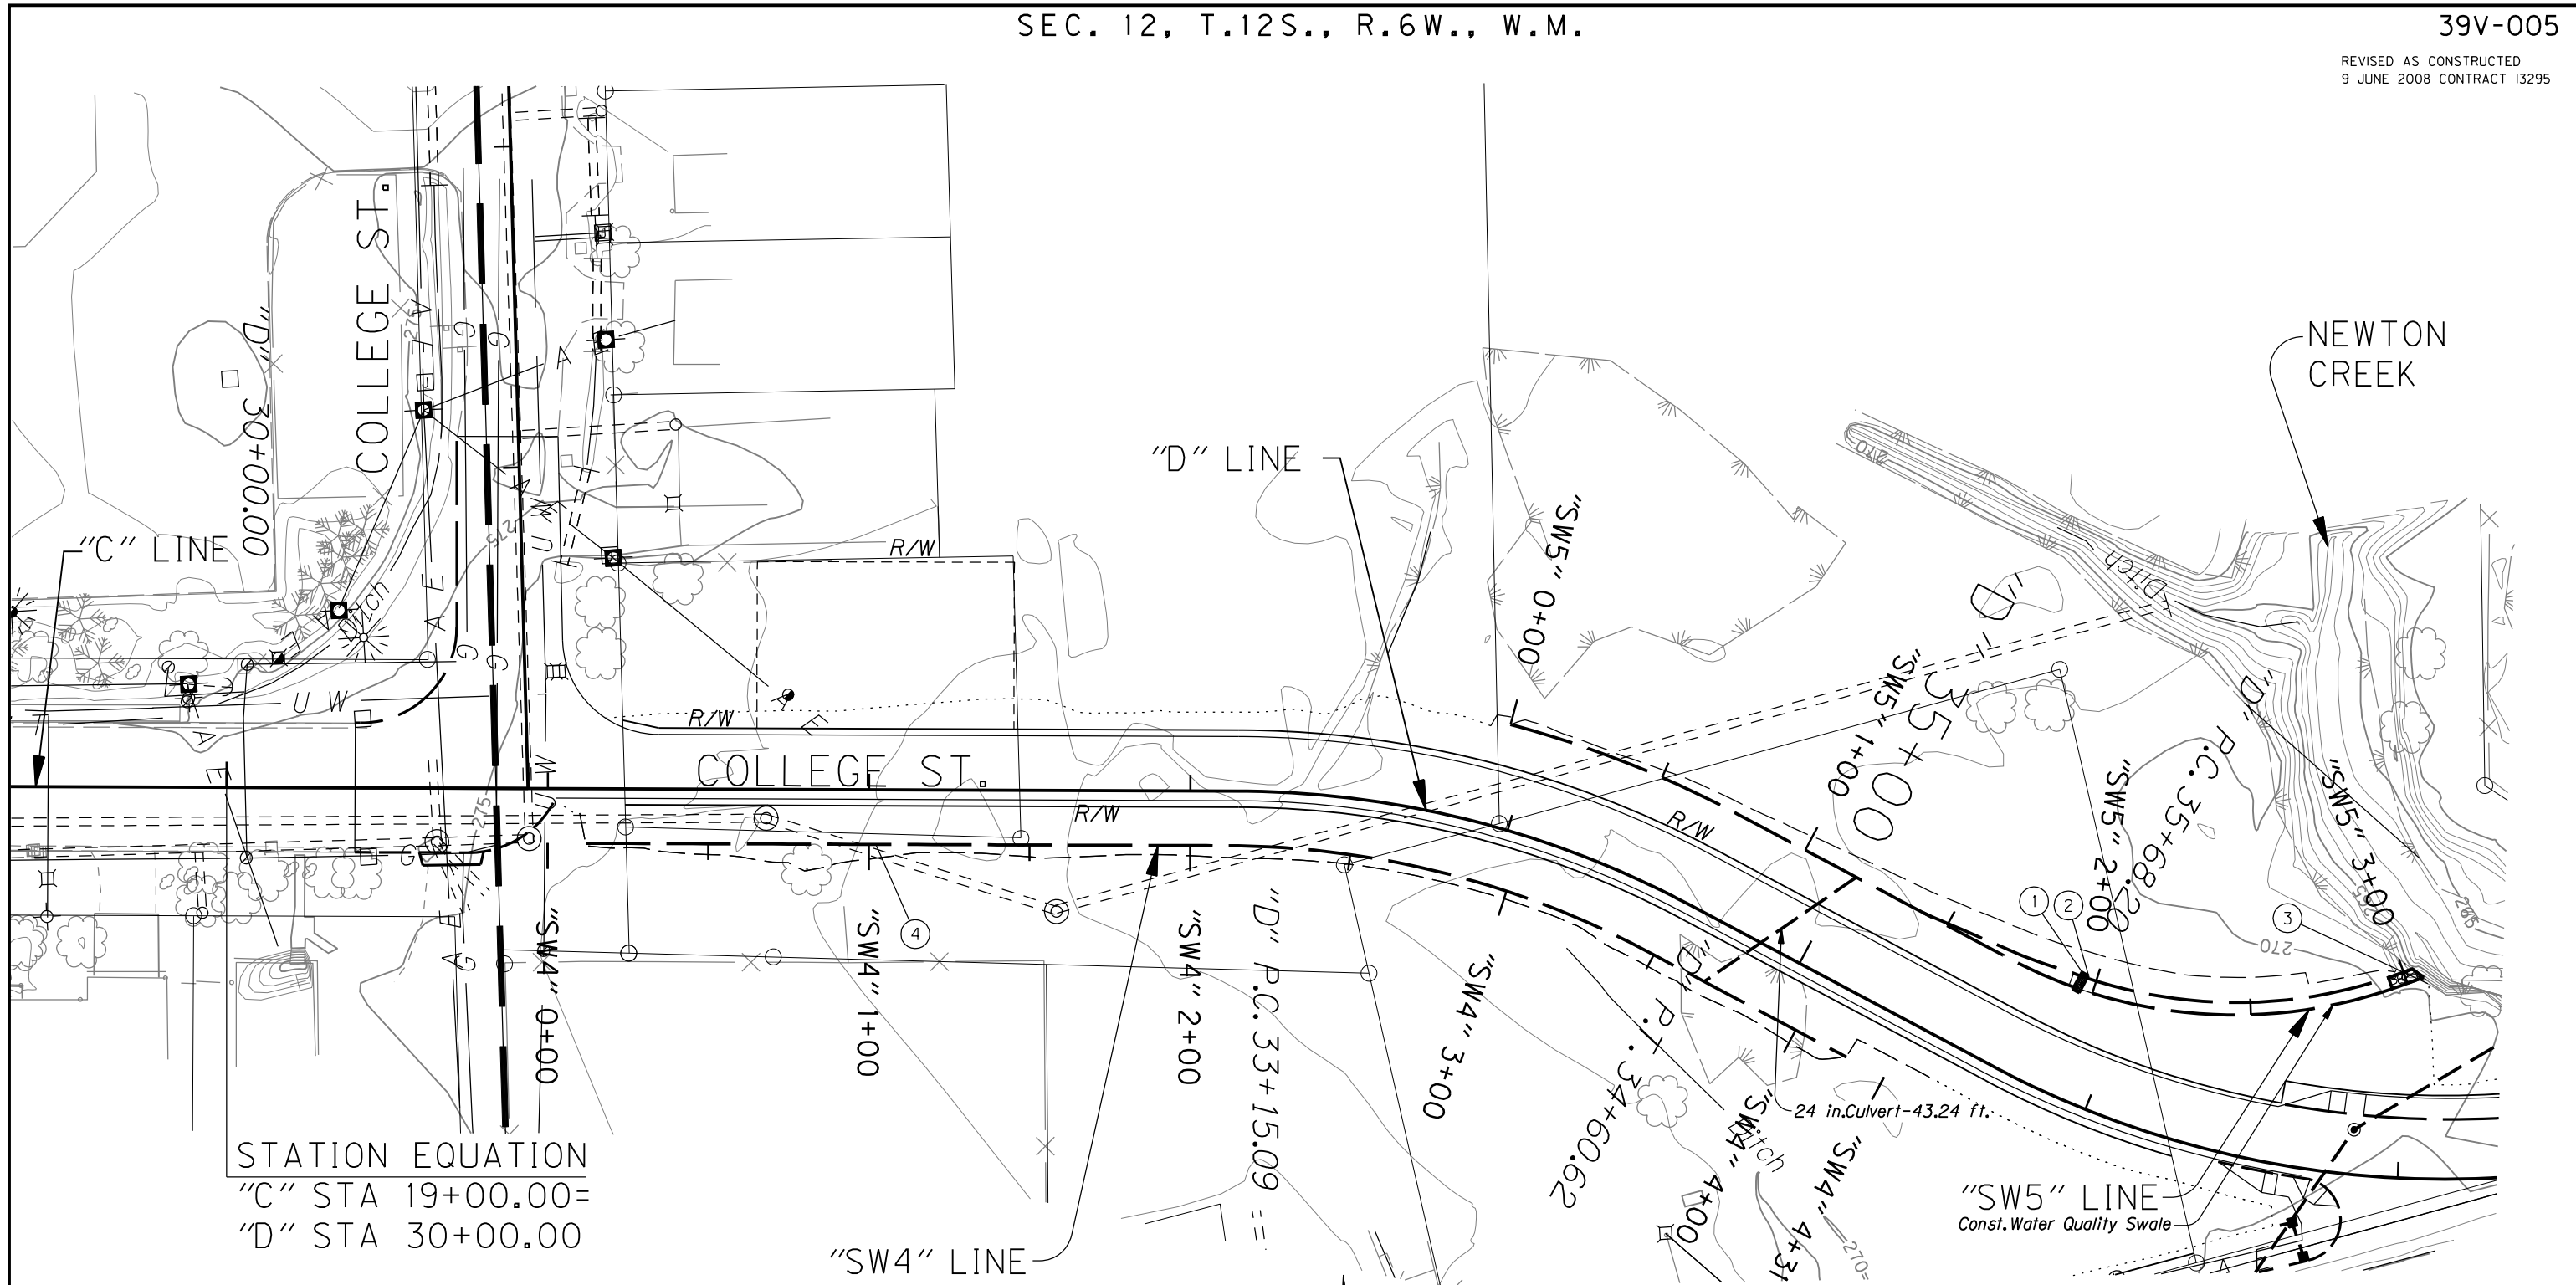

STATION EQUATION  
"C" STA 19+00.00 =  
"D" STA 30+00.00

- ① Sta. "SW5" 1+95  
Const. Swale Flow Spreader  
Stone Emb. Matl. - 18 ft<sup>3</sup>  
Type 1 Riprap Geotextile - 60 ft<sup>2</sup>  
(For Details, See Sht. GJ-15)
- ② Sta. "SW5" 1+95 To Sta. "SW5" 2+95  
Const. Water Quality Swale, "SW5"  
Inst. Rigid Porous Pvmt. System - 130 ft<sup>2</sup>  
Exc. 140 yd<sup>3</sup>  
(For Details, See Shts. GJ-14, And GJ-16)
- ③ Sta. "SW5" 2+95  
Const. Outlet Protection, Type 5, With Approx. 17% Slope  
Loose Riprap, Class 50 - 25.6 ft<sup>2</sup>  
Drainage Geotextile, Type 2 - 35 ft<sup>2</sup>  
(For Details, See Sht. GJ-13)
- ④ Sta. "SW4" 0+12 To Sta. "SW4" 4+18  
Const. Ditch "SW4"  
Ditch Exc. 39 yd<sup>3</sup>



**MSA**  
Murray, Smith & Associates, Inc.  
Engineers/Planners  
Portland, Oregon

REGISTERED PROFESSIONAL  
ENGINEER  
13,265  
**ORIGINAL SIGNED BY**  
WILLIAM H. HOLLINGS  
JULY 17, 1986  
Expires Jun. 30, 2009

**OREGON DEPARTMENT OF TRANSPORTATION**  
ROADWAY ENGINEERING SECTION

**US 20: PHILOMATH COUPLET (PHILOMATH)**  
CORVALLIS-NEWPORT HIGHWAY  
BENTON COUNTY


Reviewed By - William H. Hollings  
Designed By - Brendan V. O'Sullivan  
Drafted By - Harry C. Marx

**WATER QUALITY PLAN**  
SHEET NO. **GJ-7**


# "SW4" LINE PROFILE

39V-005

REVISED AS CONSTRUCTED  
9 JUNE 2008 CONTRACT 13295

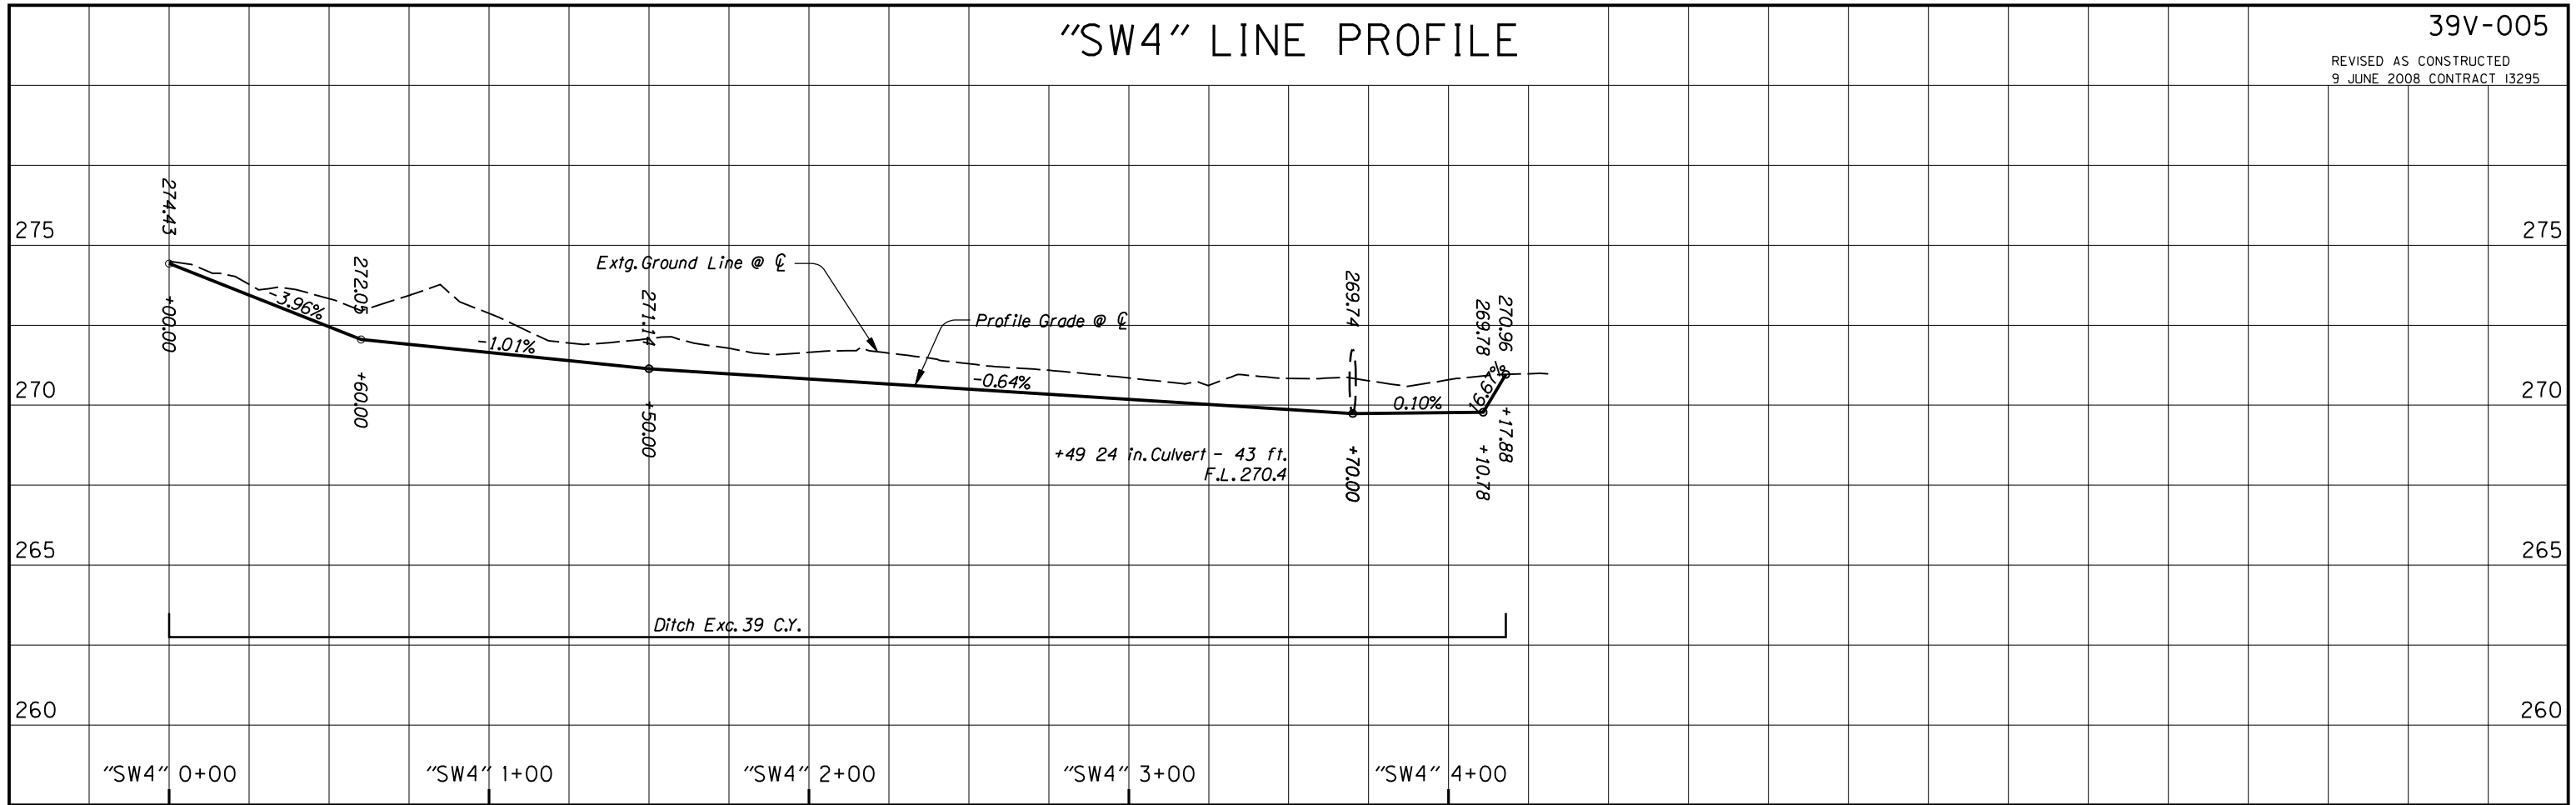

# "SW5" LINE PROFILE

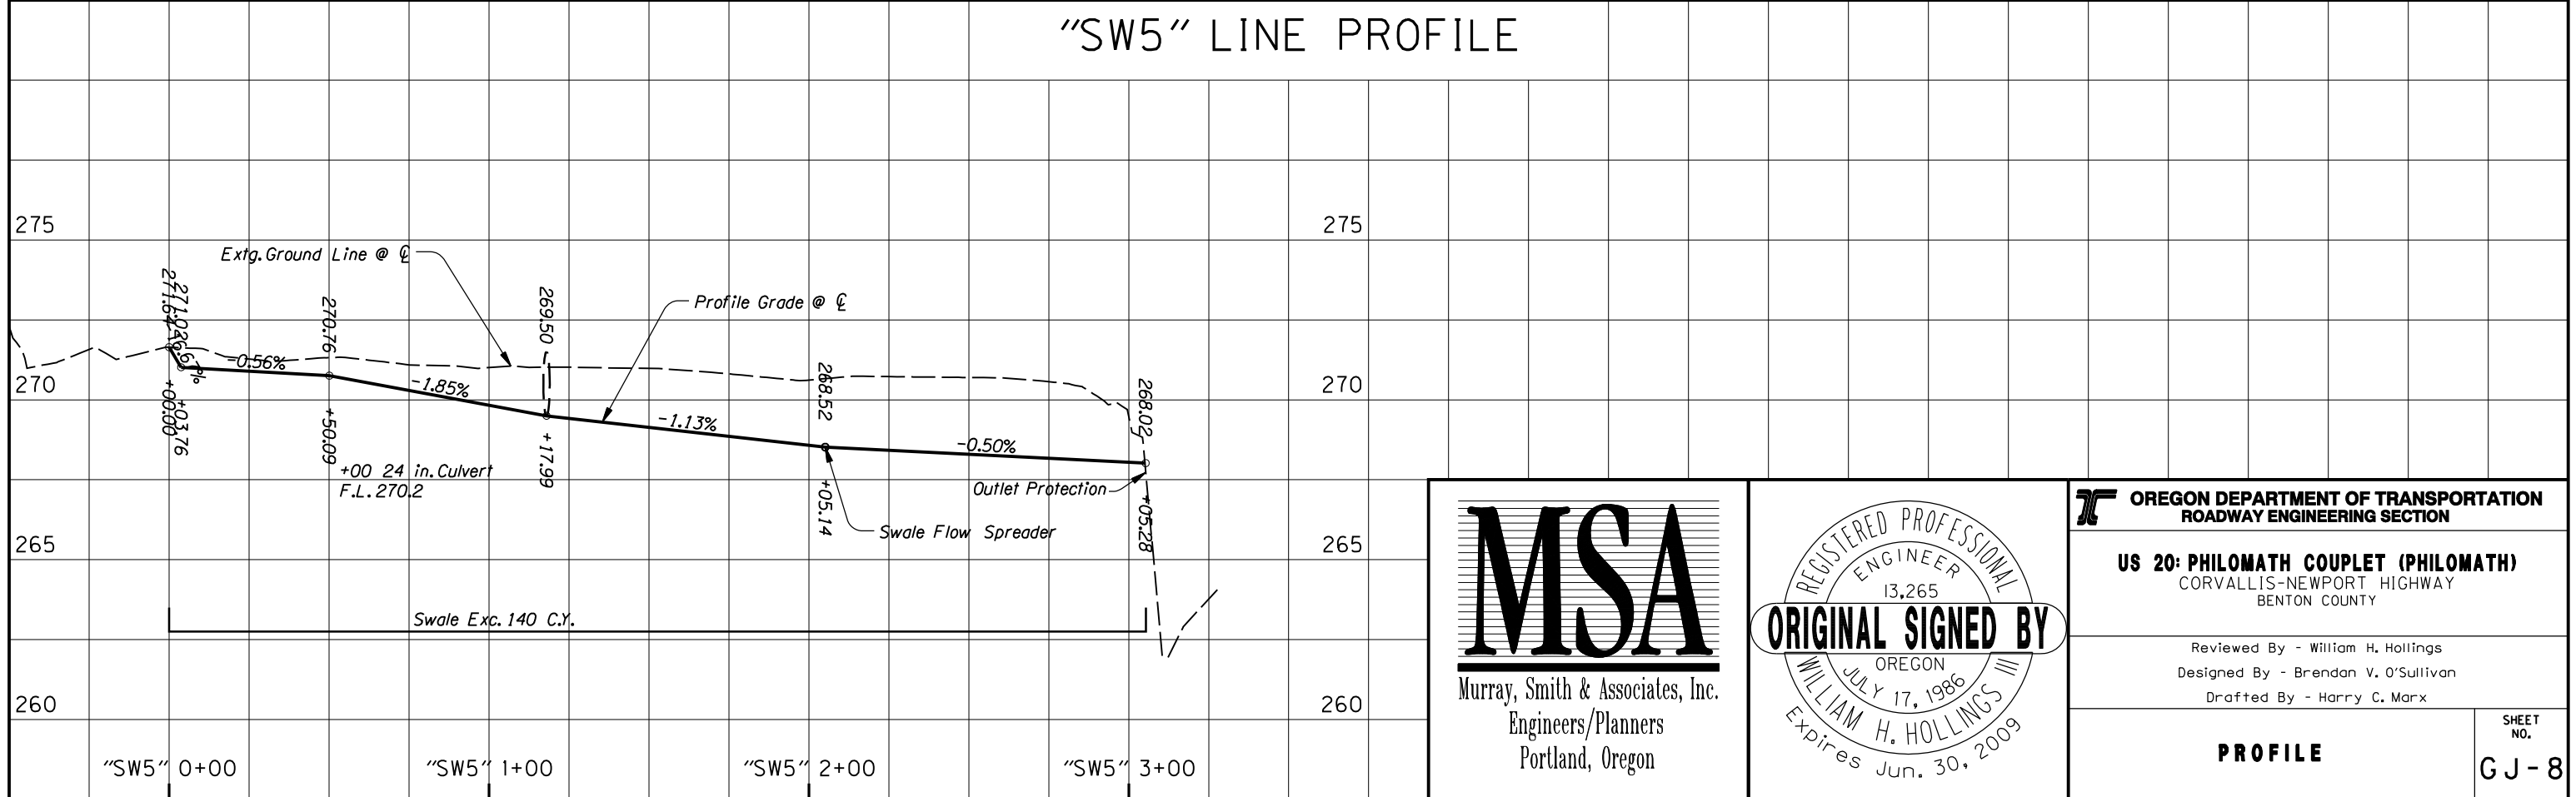

**MSA**  
Murray, Smith & Associates, Inc.  
Engineers/Planners  
Portland, Oregon

REGISTERED PROFESSIONAL  
ENGINEER  
13,265  
**ORIGINAL SIGNED BY**  
WILLIAM H. HOLLINGS  
JULY 17, 1986  
Expire Jun. 30, 2009

**OREGON DEPARTMENT OF TRANSPORTATION**  
ROADWAY ENGINEERING SECTION

**US 20: PHILOMATH COUPLET (PHILOMATH)**  
CORVALLIS-NEWPORT HIGHWAY  
BENTON COUNTY

Reviewed By - William H. Hollings  
Designed By - Brendan V. O'Sullivan  
Drafted By - Harry C. Marx





**PROFILE**

SHEET NO.  
**GJ-8**

POROUS PAVEMENT DETAILS

39V-005

REVISED AS CONSTRUCTED  
9 JUNE 2008 CONTRACT 13295

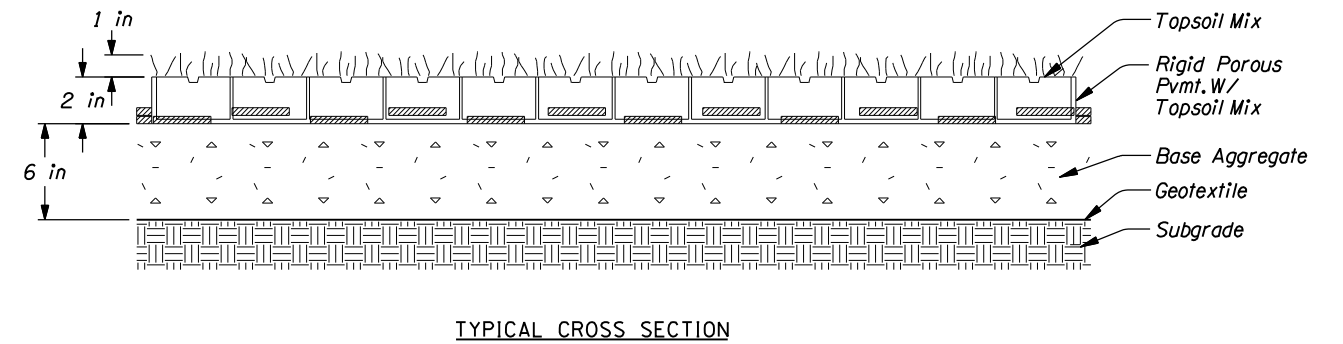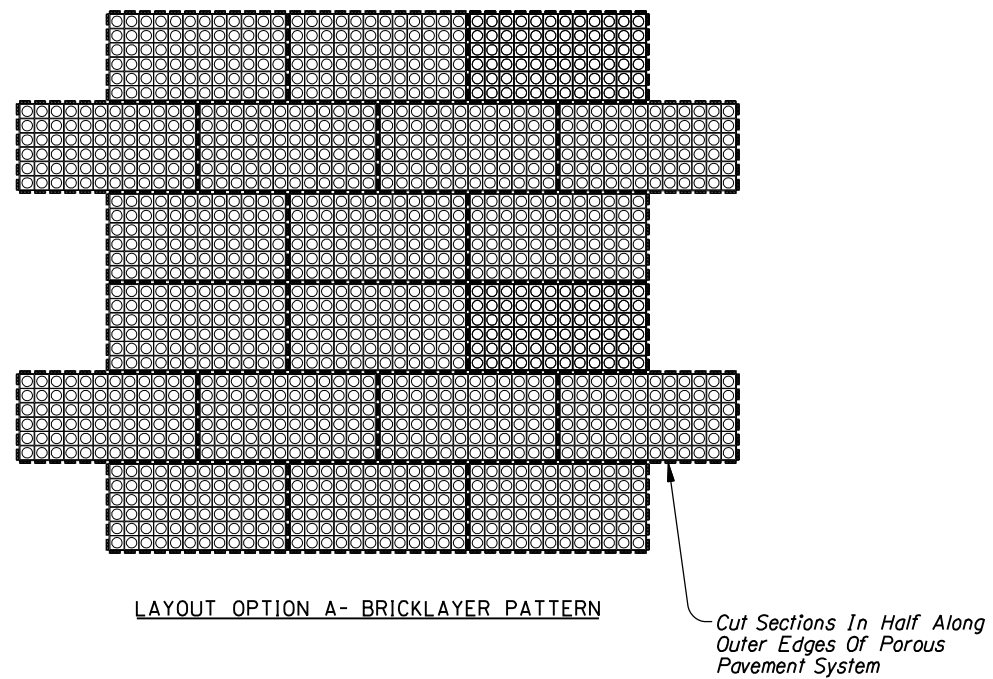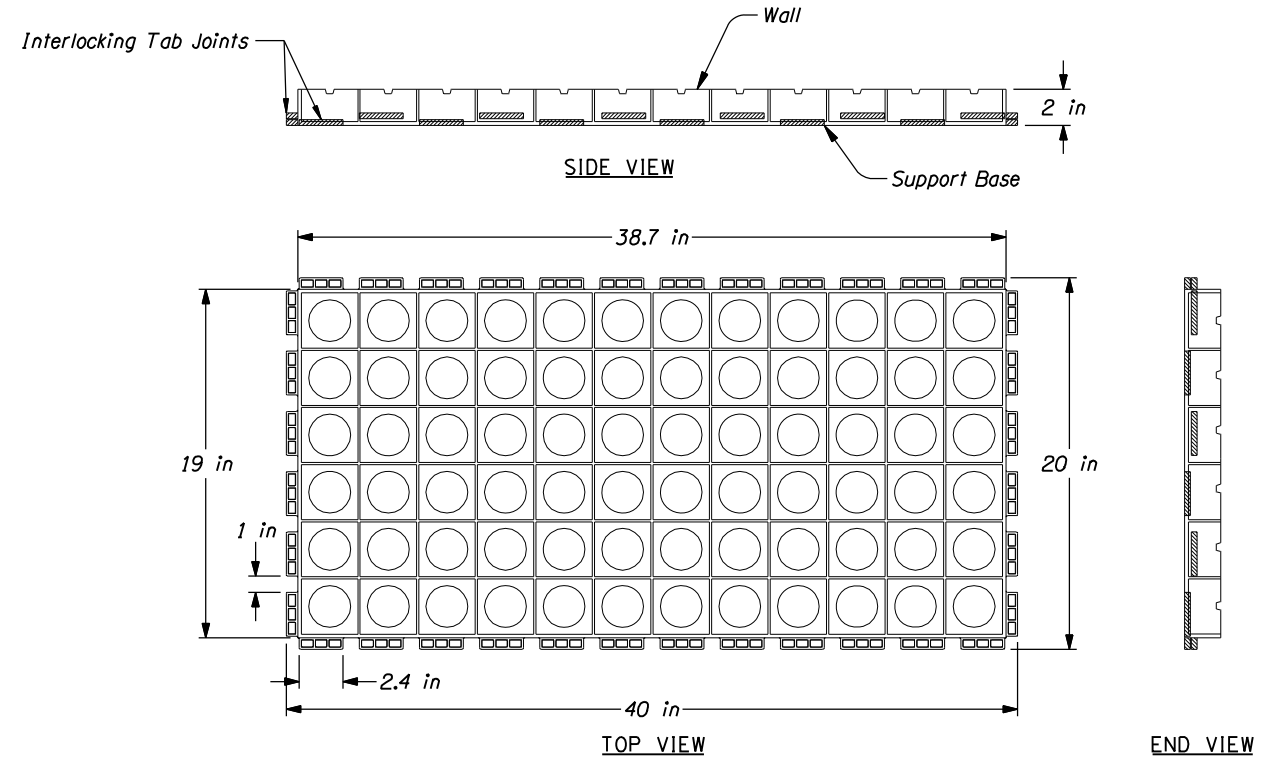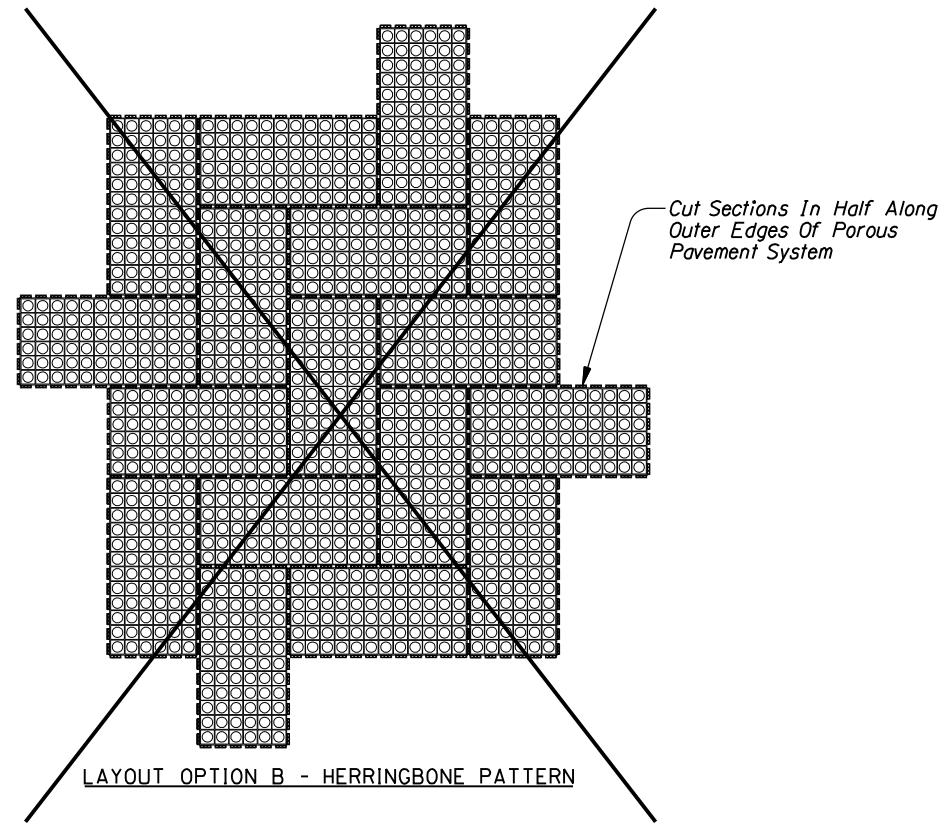

**MSA**  
Murray, Smith & Associates, Inc.  
Engineers/Planners  
Portland, Oregon

REGISTERED PROFESSIONAL  
ENGINEER  
13,265  
**ORIGINAL SIGNED BY**  
WILLIAM H. HOLLINGS  
JULY 17, 1986  
Expires Jun. 30, 2009


**OREGON DEPARTMENT OF TRANSPORTATION**  
ROADWAY ENGINEERING SECTION

**US 20: PHILOMATH COUPLET (PHILOMATH)**  
CORVALLIS-NEWPORT HIGHWAY  
BENTON COUNTY

Reviewed By - William H. Hollings  
Designed By - Brendan V. O'Sullivan  
Drafted By - Harry C. Marx

**WATER QUALITY DETAILS**

SHEET NO. **GJ-14**

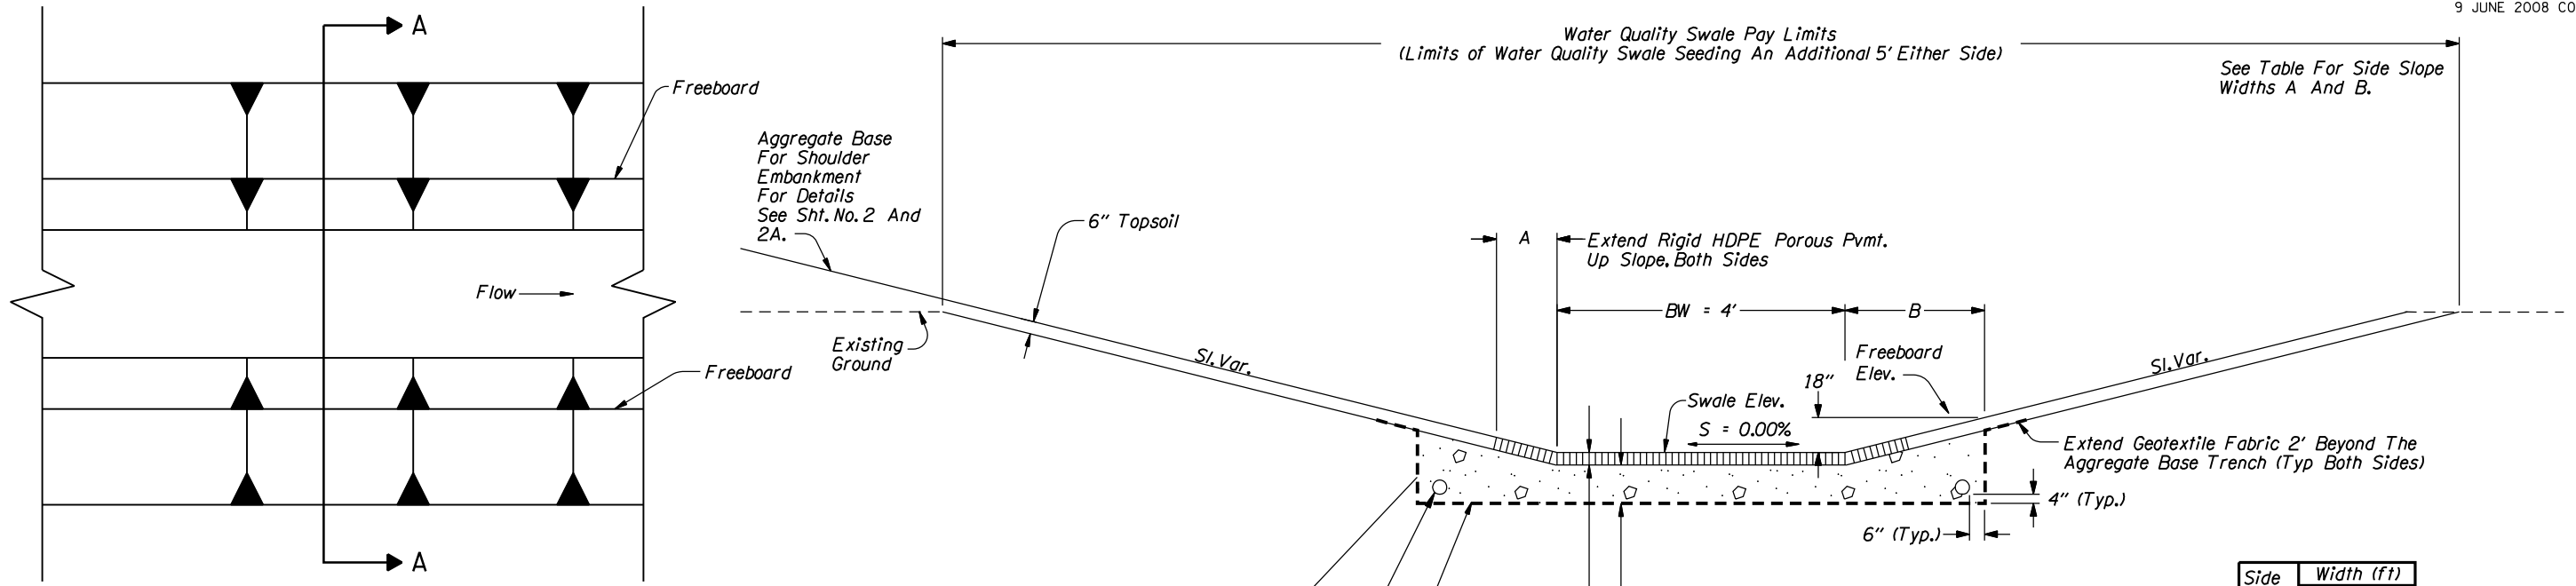


PLAN  
GENERAL SWALE LAYOUT

SECTION A-A  
SWALE SOIL STRUCTURE  
NTS

Side Slope	Width (ft)	
	A	B
6:1	3	9
4:1	2	6

- Notes:
1. Base Aggregate, 1" - 0 Per Sec 00641 Mix Approx. 50/50 with Topsoil Before Placing.
  2. Swale Elevation Called Out On Plans Is At Top Of Rigid HDPE Porous Pvmt.
  3. Swale Side Slopes To Be Constructed As Specified On Typical Sections. See Shts. No. GJ-11 And GJ-12.

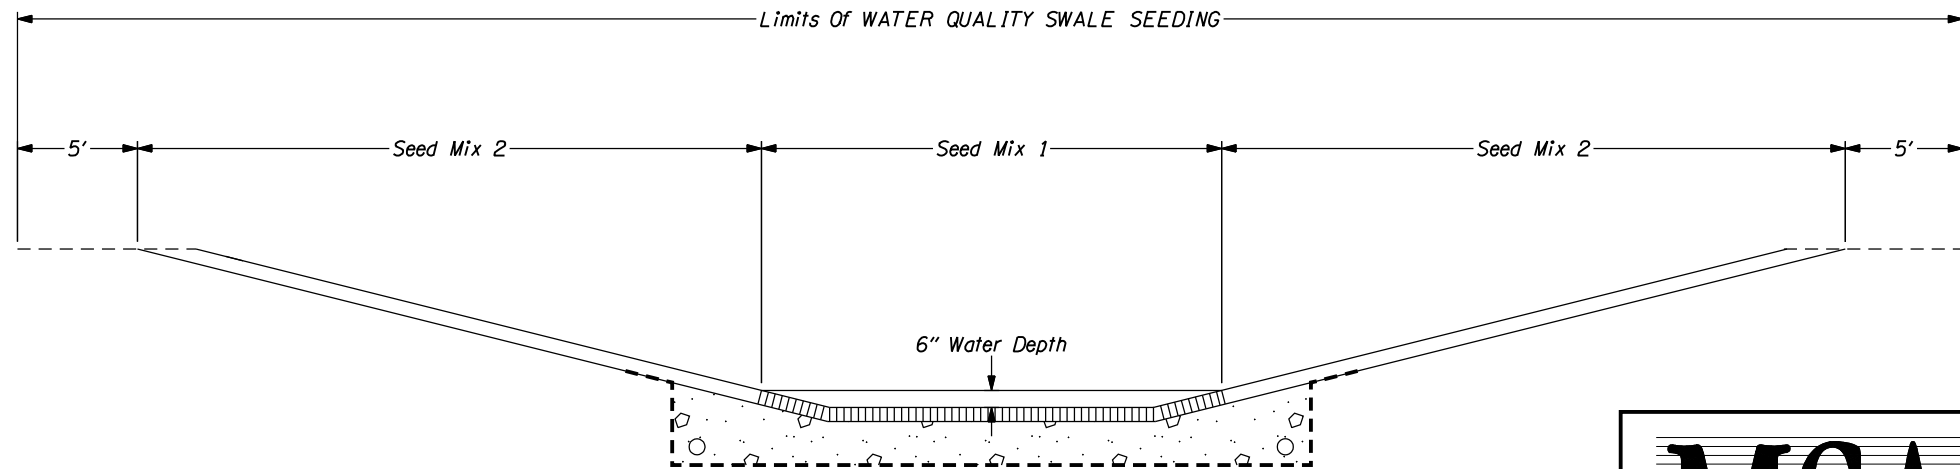

SECTION A-A  
SWALE SEEDING LIMITS  
(For Seed Mix Details, See Sht. GN-1)

**MSA**  
Murray, Smith & Associates, Inc.  
Engineers/Planners  
Portland, Oregon

REGISTERED PROFESSIONAL  
ENGINEER  
13,265  
**ORIGINAL SIGNED BY**  
WILLIAM H. HOLLINGS  
JULY 17, 1986  
Expires Jun. 30, 2009

**OREGON DEPARTMENT OF TRANSPORTATION**  
ROADWAY ENGINEERING SECTION

**US 20: PHILOMATH COUPLET (PHILOMATH)**  
CORVALLIS-NEWPORT HIGHWAY  
BENTON COUNTY

Reviewed By - William H. Hollings  
Designed By - Brendan V. O'Sullivan  
Drafted By - Harry C. Marx

**WATER QUALITY DETAILS**

SHEET NO. **GJ-16**