

OPERATION & MAINTENANCE MANUAL

Manual prepared: August 2017

DFI No. D00209



Figure 1: DFI No. D00209, looking East

1. Identification

Drainage Facility ID (DFI): D00209
Facility Type: Water Quality Biofiltration Swale
Construction Drawings: (V-File Numbers) 39V-005
Location: District: 4
Highway No.: 033
Mile Post: 50.01 to 50.12, Left

2. Manual Purpose

The purpose of this manual is to outline inspection needs and summarize maintenance actions.

3. Facility Location

The location map below details the facility location. The highway, mile posts, side streets, access location, and stormwater flow directions are noted on the map.

Flow direction: East




Figure 2: Facility location map

4. Facility Summary

The length and width of a swale is based on the bottom dimensions.

The bottom length and bottom width of the swale is:


Bottom Length (feet)	Bottom Width (feet)
150, 115 (two sections)	4

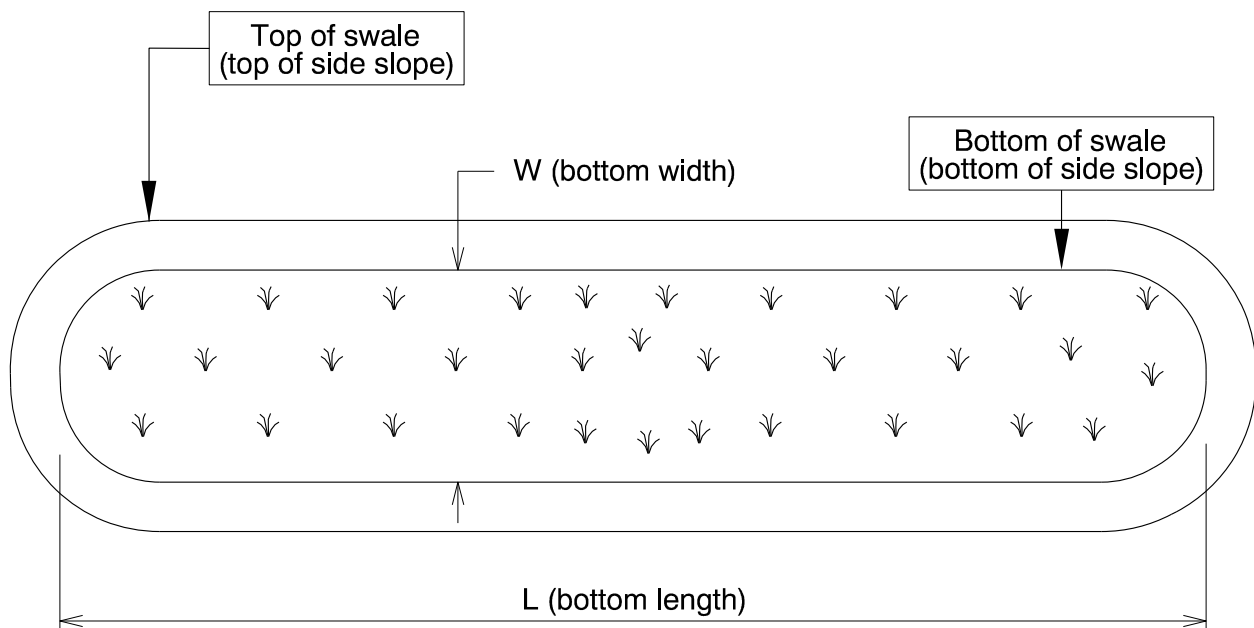

The depth of the swale is the vertical distance measured from the bottom of the swale to the top. The slope of the swale sides is presented by a vertical distance (rise) followed by the horizontal distance (run).

Depth and side slopes:

Depth (feet)	Rise (feet)	Run (feet)
1.5	Varies	Varies

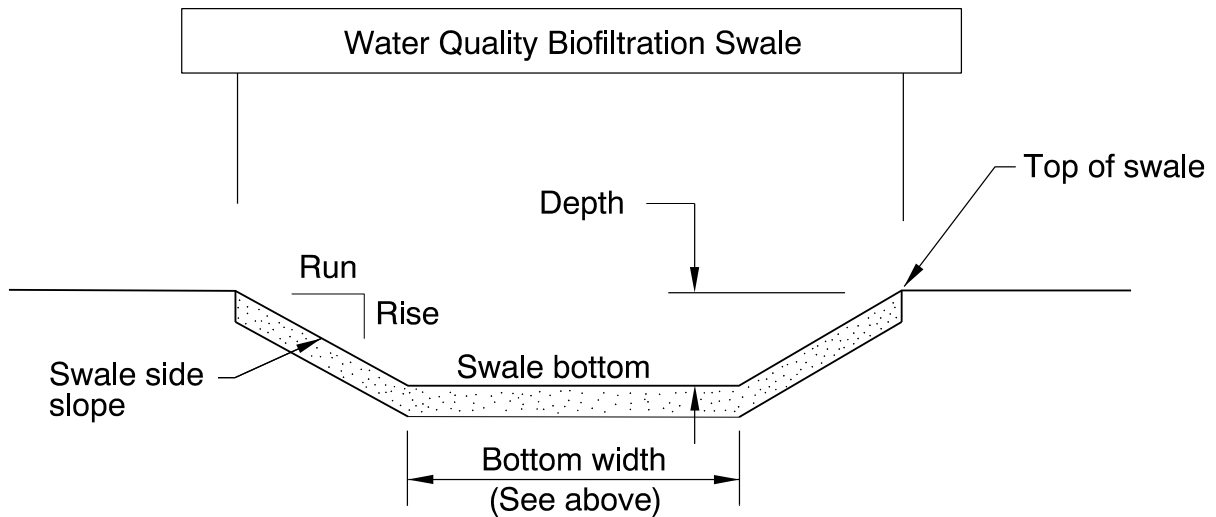

Site Specific Information: Swale split into two sections, divided by a drainage ditch. See Appendix A, Site Specific Operational Plan.

5. Facility Access

Maintenance access to the facility:

<input type="checkbox"/> Roadside pad	<input checked="" type="checkbox"/> Roadside shoulder
<input type="checkbox"/> Access road with Gate	<input type="checkbox"/> Access road without Gate



Figure 3: Facility access via roadside shoulder, looking East

6. Operational Components / Maintenance Items

Classification

This facility is classified as an:

<input checked="" type="checkbox"/> On-line Swale	<input type="checkbox"/> Off-line Swale
A swale that does not include a high flow bypass component; flow drains into and through the facility	A swale that treats low/small flows and diverts high flows using a bypass component

Bypass Component

This facility includes a high flow bypass component:

<input checked="" type="checkbox"/> No	<input type="checkbox"/> Yes
There is no bypass component. High flows drains into and through the facility	There is a bypass component. Only low/small flows drain into the swale. High flows are diverted around the swale using a bypass component

Operational Components

A swale has many components that assist with treatment, conveyance, and reducing flow velocity to minimize erosion. The components in use can vary depending if the facility was designed to operate on-line or off-line. The facility components table (**Table 1**) has been provided to highlight the applicable components for this facility. The component is in use when the box contains an “x” (e.g.).

The Standard Operation Manual for Water Quality Biofiltration Swales (implemented March 2017) outlines facility operation, typical footprint configuration, and component definitions and details. A link to the manual is attached to the feature marker in TransGIS.

<https://gis.odot.state.or.us/TransGIS/>

Operational Plan

The applicable standard operational plan for this facility is:

<input checked="" type="checkbox"/> Operational Plan A <input type="checkbox"/> Operational Plan B <input type="checkbox"/> Operational Plan C
A standard operational plan illustrates the general facility footprint configuration and explains the purpose of each facility component. Operational plans (A, B, C) are provided in the Standard Operation Manual.

See Appendix A for the site specific operational plan.

Maintenance Items

Operational components marked in **Table 1** should be inspected and maintained according to Section 7. Each facility component is defined and detailed in the Standard Operation Manual using the associated ID number indicated below.

Table 1: Swale Components		ID #
Manholes/Structures		
Pre-treatment manhole	<input type="checkbox"/>	S1
Weir type flow splitter/flow splitter manhole	<input type="checkbox"/>	S2
Orifice type flow splitter/flow splitter manhole	<input type="checkbox"/>	S3
Standard manhole	<input type="checkbox"/>	S4
Swale Inlet		
Pavement sheet flow	<input type="checkbox"/>	S5
Inlet Pipe (s)	<input type="checkbox"/>	S6
Open channel inlet	<input checked="" type="checkbox"/>	S7
Riprap pad	<input type="checkbox"/>	S8
Ground Cover		
Grass bottom	<input checked="" type="checkbox"/>	S9
Grass side slopes	<input checked="" type="checkbox"/>	S10
Granular drain rock	<input checked="" type="checkbox"/>	S11
Plantings	<input type="checkbox"/>	S12
Underground Components		
Geotextile fabric	<input checked="" type="checkbox"/>	S13
Water quality mix	<input checked="" type="checkbox"/>	S14
Perforated pipe	<input checked="" type="checkbox"/>	S15
Porous pavers (access grid)	<input checked="" type="checkbox"/>	S16
Flow Spreader		
Rock basin (used at inlet)	<input type="checkbox"/>	S17
Anchored board (midpoint of swale or every 50 feet along swale bottom)	<input type="checkbox"/>	S18
Other: Riprap	<input checked="" type="checkbox"/>	S19
Swale Outlet		
Catch basin with grate	<input checked="" type="checkbox"/>	S20
Outlet Pipe (s)	<input type="checkbox"/>	S21
Open channel outlet	<input checked="" type="checkbox"/>	S22
Auxiliary Outlet:	<input type="checkbox"/>	S23
Outfall Type		
Waterbody (Creek/Lake/Ocean)	<input type="checkbox"/> C	S24
	<input type="checkbox"/> L	
	<input type="checkbox"/> O	
Ditch	<input checked="" type="checkbox"/>	S25
Storm drain system	<input checked="" type="checkbox"/>	S26
Outfall Components		
Riprap pad	<input checked="" type="checkbox"/>	S27
Riprap bank protection	<input type="checkbox"/>	S28

7. Maintenance

Maintenance Frequency/Maintain Records

- a. Inspect annually. Preferably prior to the rainy season.
- b. Clean and maintain as necessary. Refer to Activity 125 for conditions when maintenance is needed.
- c. Keep a record of inspections, maintenance, and repairs.

Maintenance Guide/Maintenance Actions

The ODOT Routine Road Maintenance Water Quality and Habitat Guide (the *Blue Book*) outlines the standard maintenance actions for water quality facilities under Activity 125.

There are standard maintenance tables for standard ODOT designs. The maintenance tables describe the maintenance component, the defect or problem, the condition when maintenance is needed, and the recommended maintenance to correct the problem. Use the following tables to maintain ODOT swales:

- Table 1 (General Maintenance): Contains general maintenance and inspection guidelines that are applicable to all ODOT water quality facilities
- Table 3 (Maintenance of Water Quality or Biofiltration Swales): Contains maintenance information for swales

The *Blue Book* can be viewed at the following website:

http://www.oregon.gov/ODOT/Maintenance/Documents/blue_book.pdf

8. Limitations

Access grid installed:

<input type="checkbox"/> No	<input checked="" type="checkbox"/> Yes
There are (Choose applicable weight: no, light, med., heavy) duty porous pavers installed in this swale	

Swales are designed to allow equipment access along the bottom. If an access grid is **NOT** installed, vehicles entering the swale can create depressions (tire ruts), damage vegetation, and damage structural components (e.g. flow spreaders). These conditions may result in poor treatment and drainage performance.

Equipment wheels should be kept on the tops and side slopes. Mower arms may be run along the swale bottom.

9. Waste Material Handling

Material removed from the facility is defined as waste by the Department of Environmental Quality (DEQ). Refer to the roadwaste section of the ODOT Maintenance Yard Environmental Management System (EMS) Policy and Procedures Manual for disposal options:

http://www.oregon.gov/ODOT/Maintenance/Documents/ems_manual.pdf


Contact any of the following for more detailed information about management of waste materials found on site:

ODOT Clean Water Unit	(503) 986-3008
ODOT Statewide Hazmat Coordinator	(503) 667-7442
ODOT Region 1 Hazmat Coordinator	(503) 731-8290
ODOT Region 2 Hazmat Coordinator	(503) 986-2647
ODOT Region 3 Hazmat Coordinator	(541) 957-3594
ODOT Region 4 Hazmat Coordinator	(541) 388-6186
ODOT Region 5 Hazmat Coordinator	(541) 963-1590
ODEQ Northwest Region Office	(503) 229-5263


A Appendix A – Site Specific Operational Plan

Contents:


Operational Plan: DFI D00209

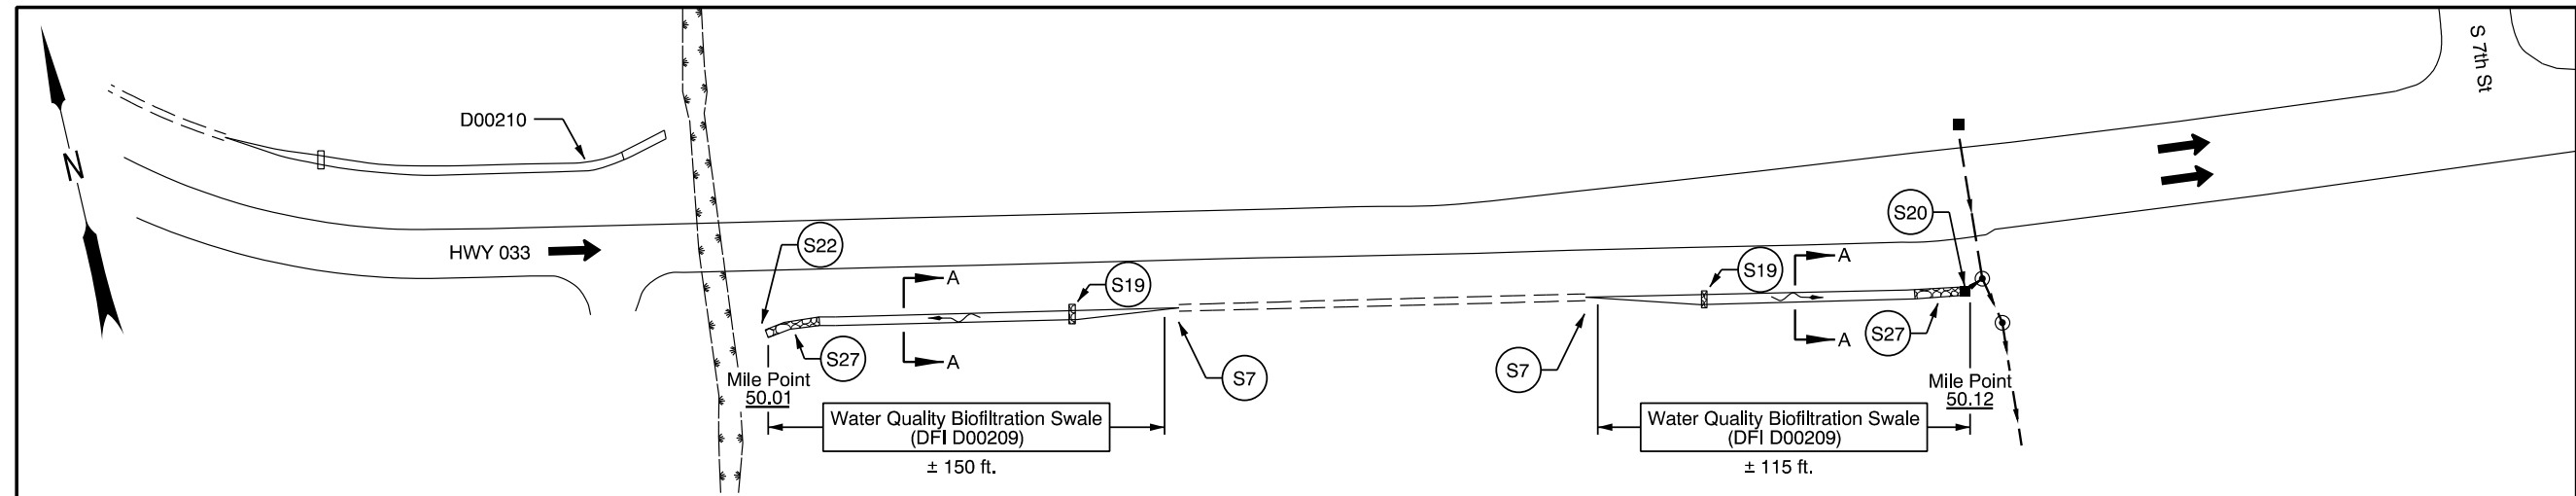

PLAN
N.T.S.

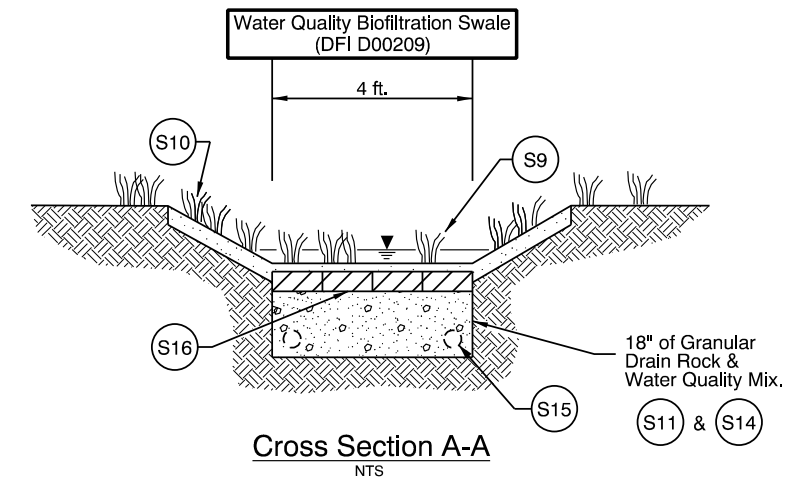

Cross Section A-A
N.T.S.

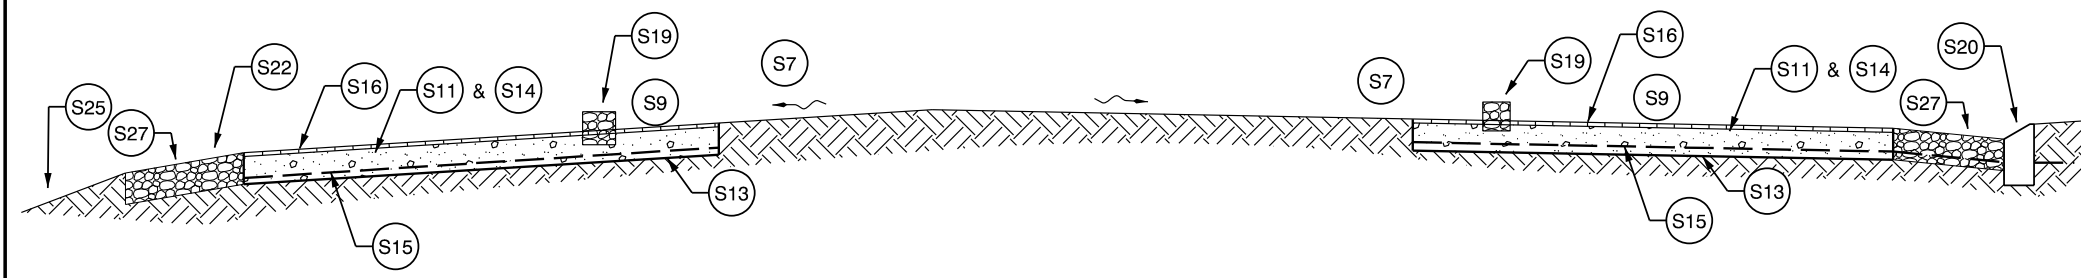

PROFILE
N.T.S.

- LEGEND
- ⊙ Manhole
 - Catch Basin
 - ➔ Traffic Flow Direction
 - ~ Stormwater Flow Path
 - Storm Pipe
 - == Drainage Ditch
 - Wetland
 - ⊙ S# Table 1 Facility Components

OREGON DEPARTMENT OF TRANSPORTATION	
DFI D00209 MAINTENANCE DISTRICT 4 HWY 033 WATER QUALITY BIOFILTRATION SWALE HIGHWAY MP 50.01, 50.12 BENTON	
Prepared By:	Brooklyn Scholz
Drafted By:	Brooklyn Scholz

DFI_D00209.dgn

B Appendix B – Project Contract Plans

Contents:


Site Specific Subset of Project Contract Plan 39V-005

STATE OF OREGON
DEPARTMENT OF TRANSPORTATION

PLANS FOR PROPOSED PROJECT
GRADING, DRAINAGE, STRUCTURES, PAVING & SIGNALS

**US 20: PHILOMATH COUPLET
(PHILOMATH)
CORVALLIS-NEWPORT HIGHWAY**

REVISED AS CONSTRUCTED
9 JUNE 2008 CONTRACT I3295
PROJ. MGR. RAYMOND S. CRANSTON, PLS

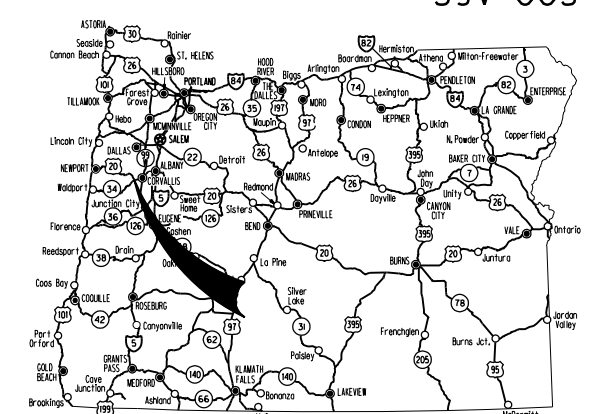

Overall Length Of Project - 8036 ft (1.53 Miles)

INDEX OF SHEETS	
SHEET NO.	DESCRIPTION
1	Title Sheet
1A	Index Of Sheets Cont'd.
1B	Standard Drg. Nos.
1C	Sheet Layout
2, 2A Thru 2A-10 Incl.	Typical Sections
2B, 2B-2, 2B-3	Superelevation Chart
2B-4 Thru 2B-18 Incl.	Details
2C, 2C-2 Thru 2C-26 Incl.	Traffic Control Plans
2D, 2D-2 Thru 2D-4 Incl.	Pipe Data Sheets



BENTON COUNTY
OCTOBER 2006

END OF PROJECT

STA. "HWY" 346+36 (M.P. 51.39)


**WREN HILL
MITIGATION SITE**
STA "HWY" 117+63 (M.P. 47.05)

ATTENTION:
Oregon Law Requires You To Follow Rules Adopted By The Oregon Utility Notification Center. Those Rules Are Set Forth In OAR 952-001-0010 Through OAR 952-001-0090. You May Obtain Copies Of The Rules By Calling The Center. (Note: The Telephone Number For The Oregon Utility Center Is (503) 232-1987.)



OREGON TRANSPORTATION COMMISSION
Stuart Foster CHAIRMAN
Gail L. Achterman COMMISSIONER
Mike Nelson COMMISSIONER
Randall Pape COMMISSIONER
Janice Wilson COMMISSIONER
Matthew Garrett DIRECTOR OF TRANSPORTATION


PLANS PREPARED FOR
OREGON DEPARTMENT OF TRANSPORTATION
BY:
MURRAY, SMITH & ASSOC., INC.

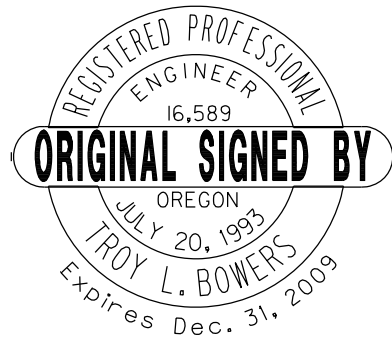

OREGON DEPARTMENT OF TRANSPORTATION
CONCURRENCE
TECHNICAL SERVICES MANAGING ENGINEER _____ DATE _____

US 20: PHILOMATH COUPLET (PHILOMATH)
CORVALLIS-NEWPORT HIGHWAY
BENTON COUNTY


FEDERAL HIGHWAY ADMINISTRATION	PROJECT NUMBER	SHEET NO.
OREGON DIVISION	OTIA-S0-S033 (025)	1

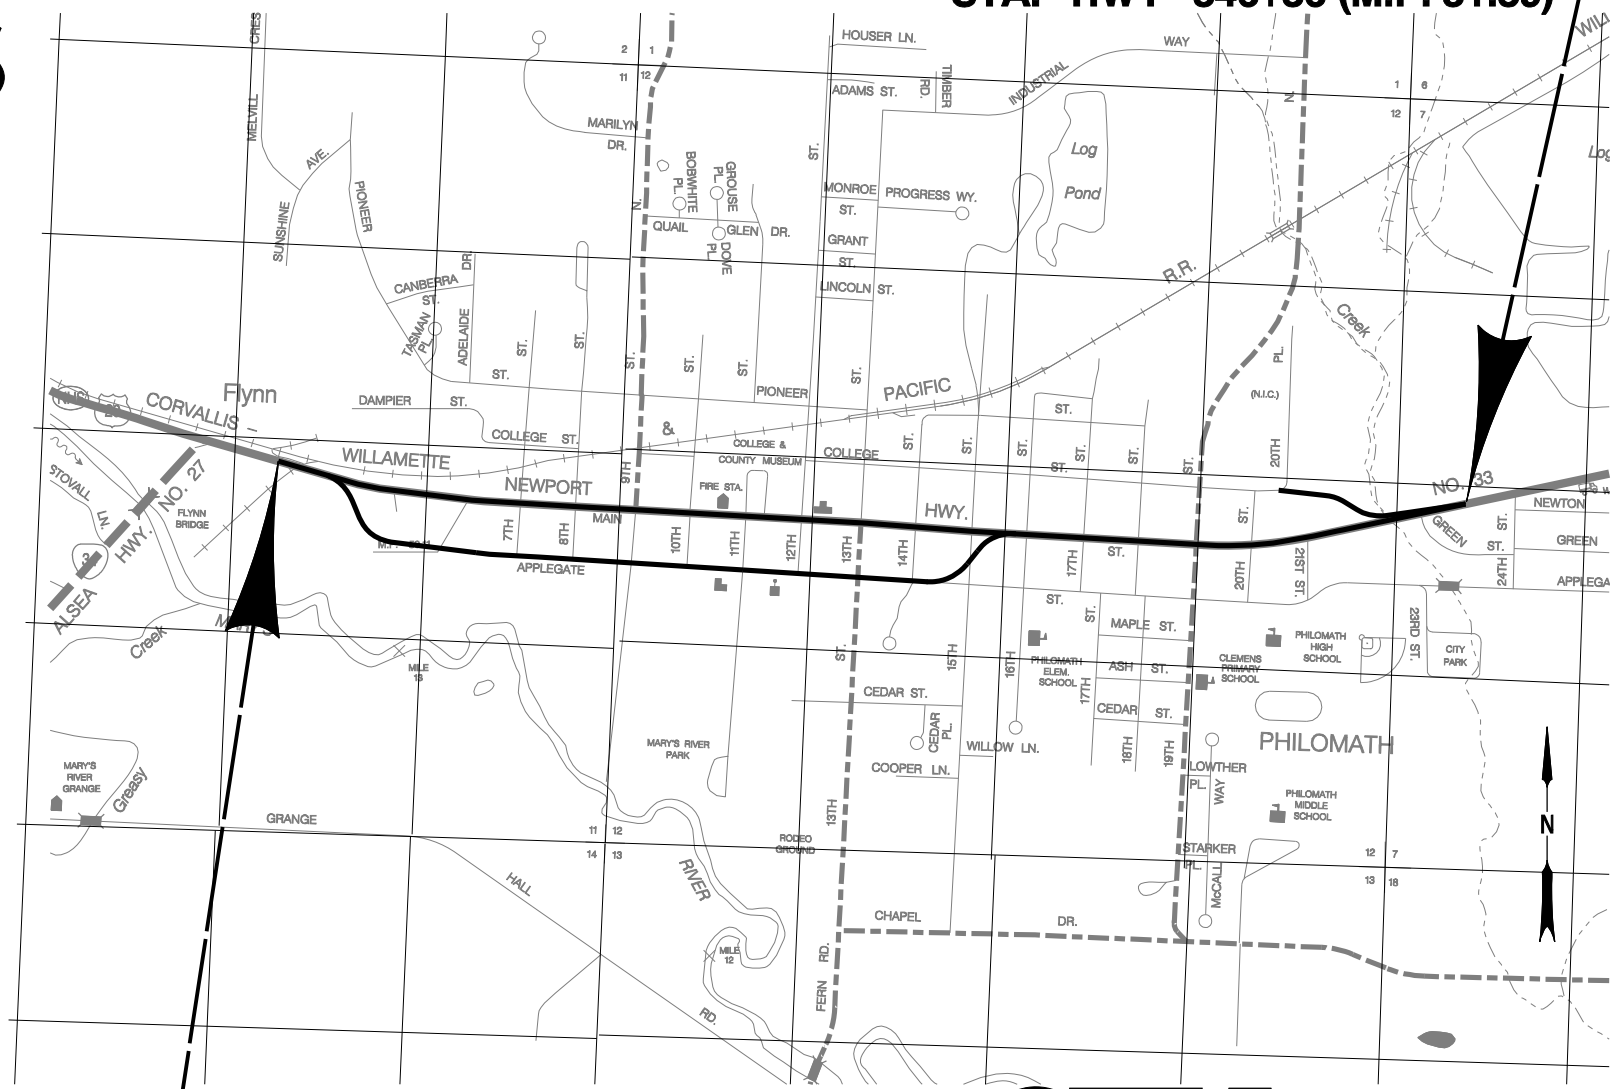

BEGINNING OF PROJECT
STA. "HWY" 263+45 (M.P. 49.81)




T. 12 S., R. 6 W., W.M.

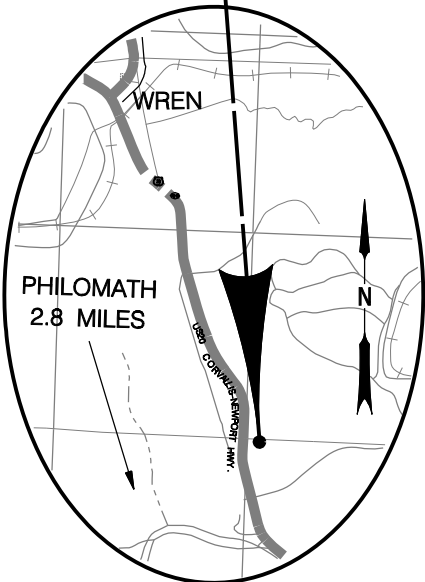


RECORD DRAWINGS
THIS DRAWING IS FOR RECORD PURPOSES ONLY, AND HAS BEEN PREPARED BASED IN PART ON INFORMATION PROVIDED BY OTHERS RELATIVE TO REPORTED CONSTRUCTED CONDITIONS. WHILE THIS INFORMATION IS BELIEVED TO BE RELIABLE, MURRAY, SMITH & ASSOCIATES, INC. MAKES NO ASSURANCES, STATED OR IMPLIED, AS TO THE ACCURACY OF THIS DRAWING. THOSE RELYING ON THIS RECORD DRAWING FOR ANY PURPOSE ARE ADVISED TO OBTAIN INDEPENDENT VERIFICATION OF ITS ACCURACY. CONTRACT MODIFICATION INFORMATION, FABRICATOR'S SHOP DRAWINGS AND OTHER PROJECT SUBMITTAL INFORMATION PROVIDED BY THE CONTRACTOR WHICH FURTHER CLARIFY DETAILS OF CONSTRUCTION MAY BE ON FILE. SEE ORIGINAL CONTRACT DRAWINGS FOR ENGINEER'S SEAL AND SIGNATURES.
VERSION 4.0 12-9-97

REVISIONS	
	Revised 11-03-06 Added Sheet 2A-10

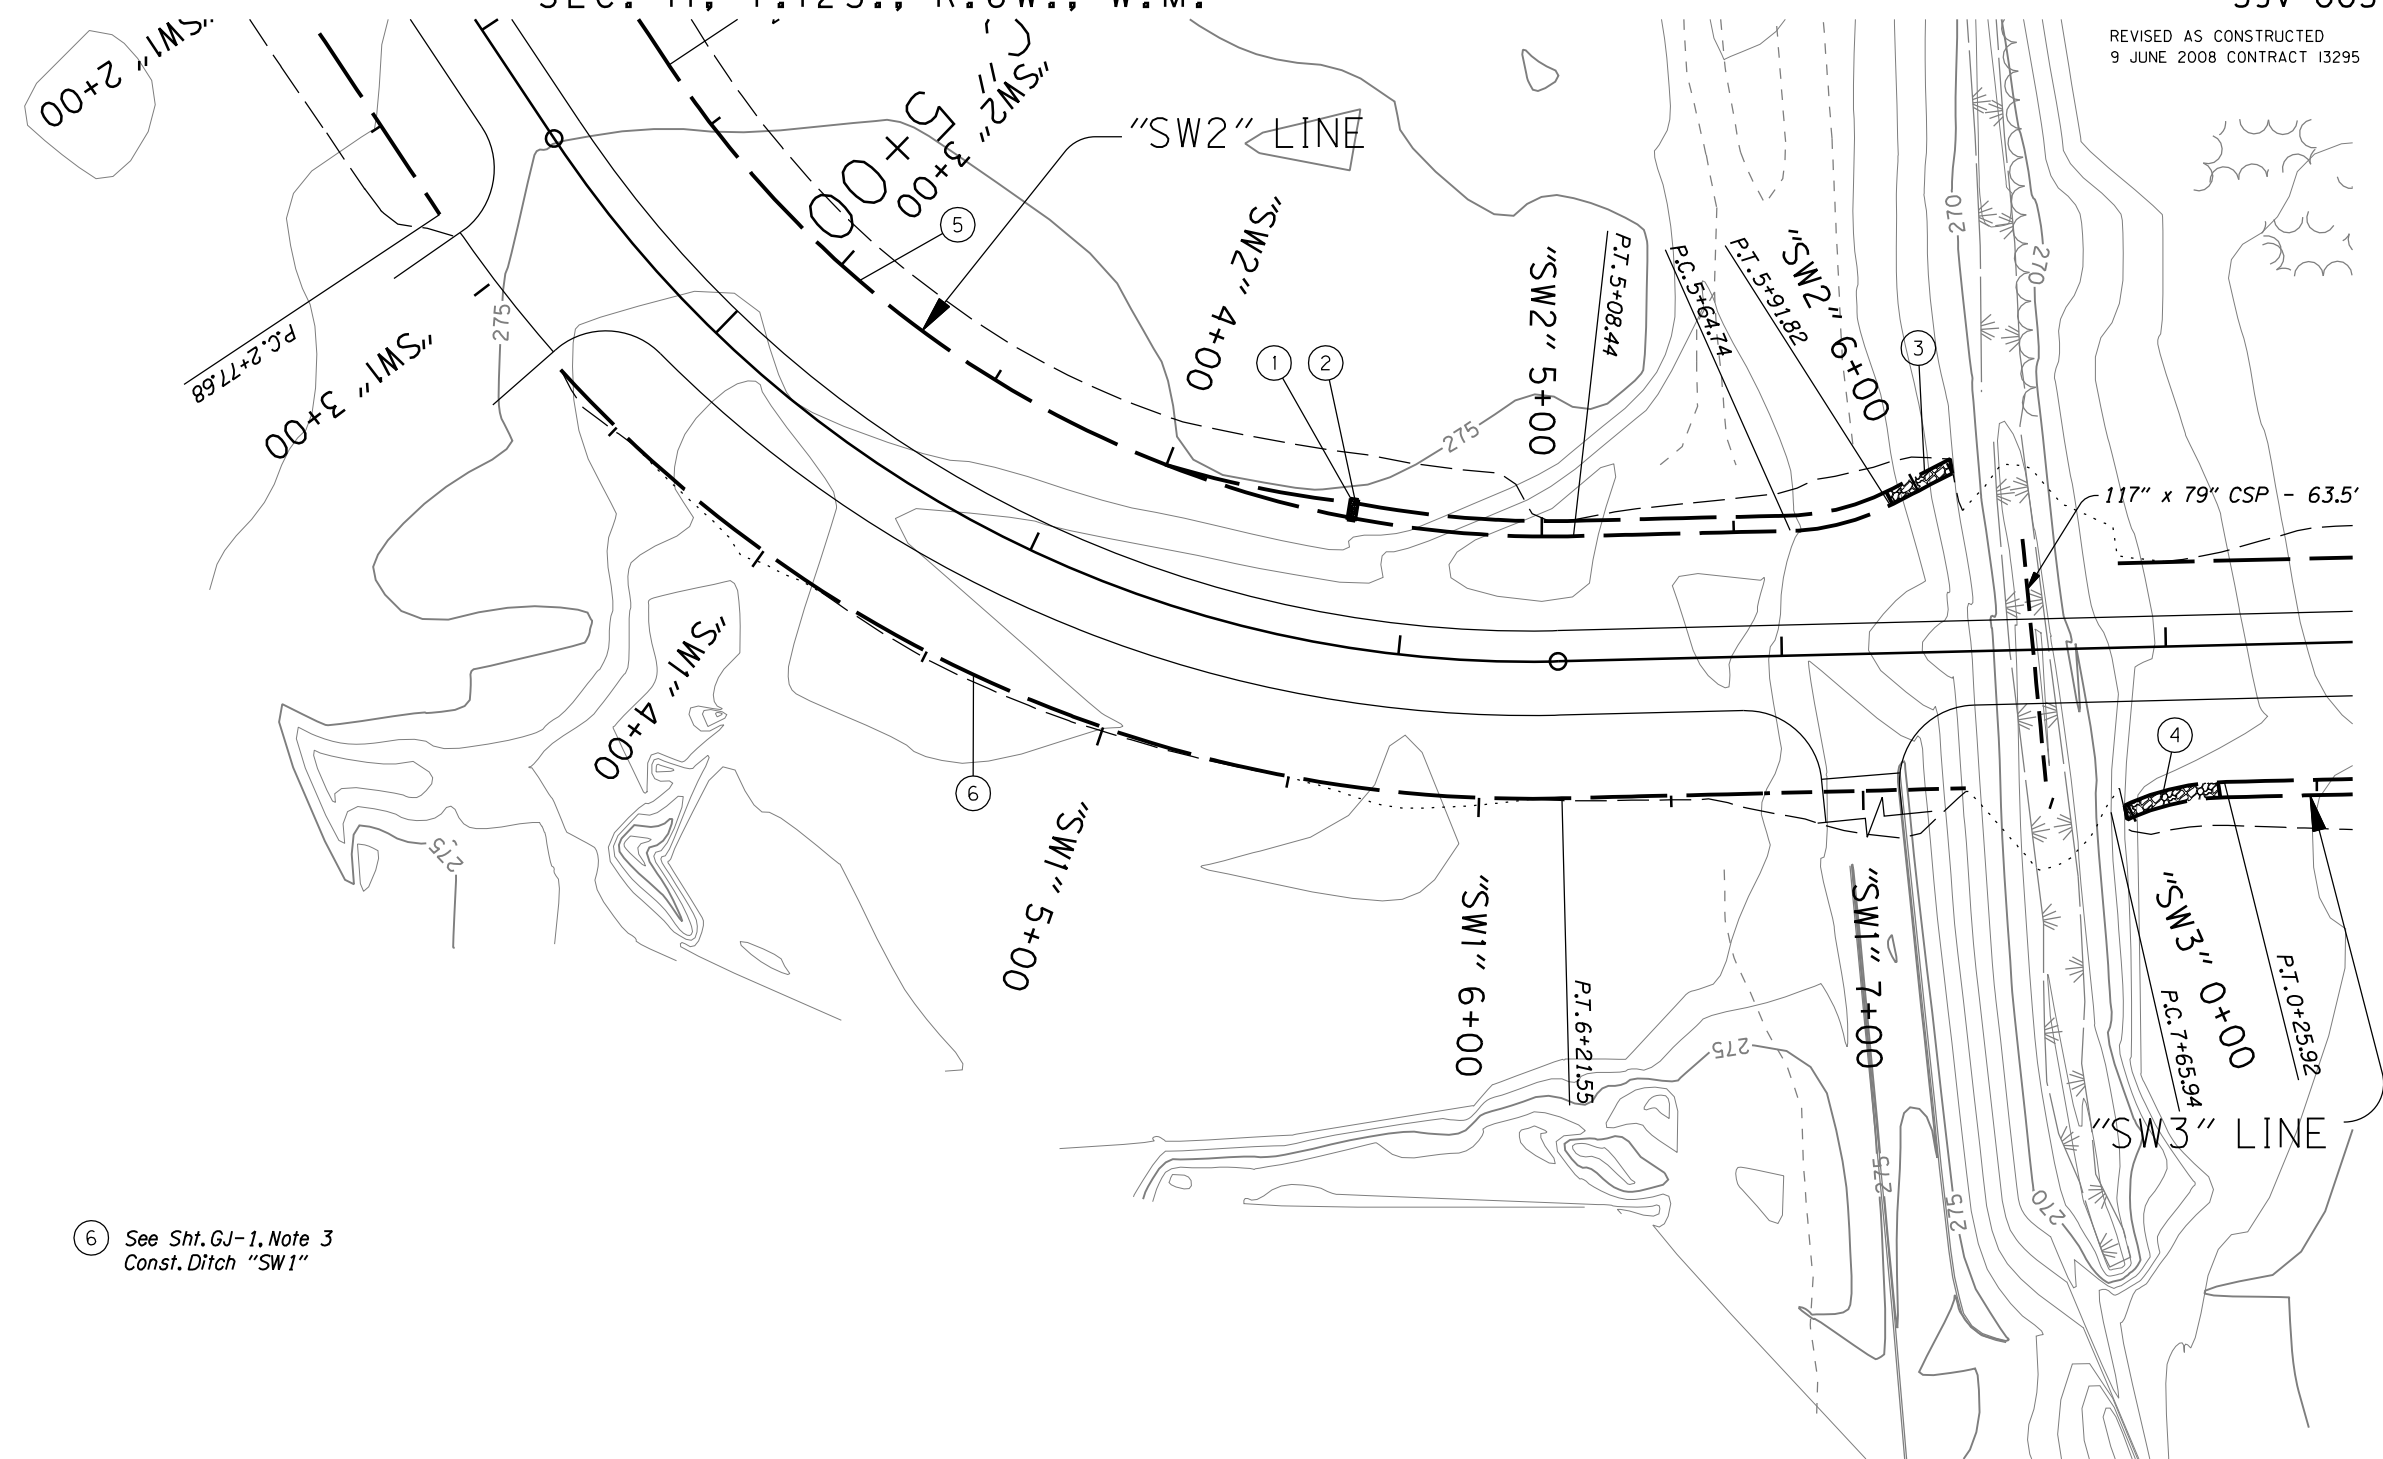

- ① Sta. "SW2" 4+52 To Sta. "SW2" 5+92
Const. Water Quality Swale, "SW2" - 140 ft
Inst. Rigid Porous Pvmt. System - 661.5 ft² Exc. 22 yd³
(For Details, See Shts. GJ-11, GJ-14, And GJ-16)
- ② Sta. "SW2" 4+50
Const. Swale Flow Spreader
Stone Emb. Matl. - 18 ft³
Type 1 Riprap Geotextile - 60 ft²
(For Details, See Shts. GJ-15)
- ③ Sta. "SW2" 5+92
Const. Outlet Protection, Type 5, With Approx. 6.7% Slope
Loose Riprap, Class 50 - 75 ft³
Drainage Geotextile, Type 2 - 100 ft²
(For Details, See Shts. GJ-13)
- ④ Sta. "SW3" 0+24
Const. Outlet Protection, Type 5, With Approx. 8.60% Slope
Loose Riprap Class 50 - 180 ft³
Drainage Geotextile, Type 2 - 245 ft²
(For Details, See Sht. GJ- 13)
- ⑤ Sta. "SW2" 0+00 To Sta. "SW2" 4+52
Const. Ditch "SW2"
Ditch Exc. 420 yd³

⑥ See Sht. GJ-1, Note 3
Const. Ditch "SW1"

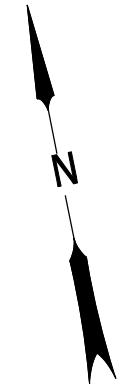

MSA
Murray, Smith & Associates, Inc.
Engineers/Planners
Portland, Oregon

REGISTERED PROFESSIONAL
ENGINEER
13,265
ORIGINAL SIGNED BY
WILLIAM H. HOLLINGS
JULY 17, 1986
Expires Jun. 30, 2009


OREGON DEPARTMENT OF TRANSPORTATION
ROADWAY ENGINEERING SECTION

US 20: PHILOMATH COUPLET (PHILOMATH)
CORVALLIS-NEWPORT HIGHWAY
BENTON COUNTY

Reviewed By - William H. Hollings
Designed By - Brendan V. O'Sullivan
Drafted By - Harry C. Marx

WATER QUALITY PLAN

SHEET NO.
GJ-3

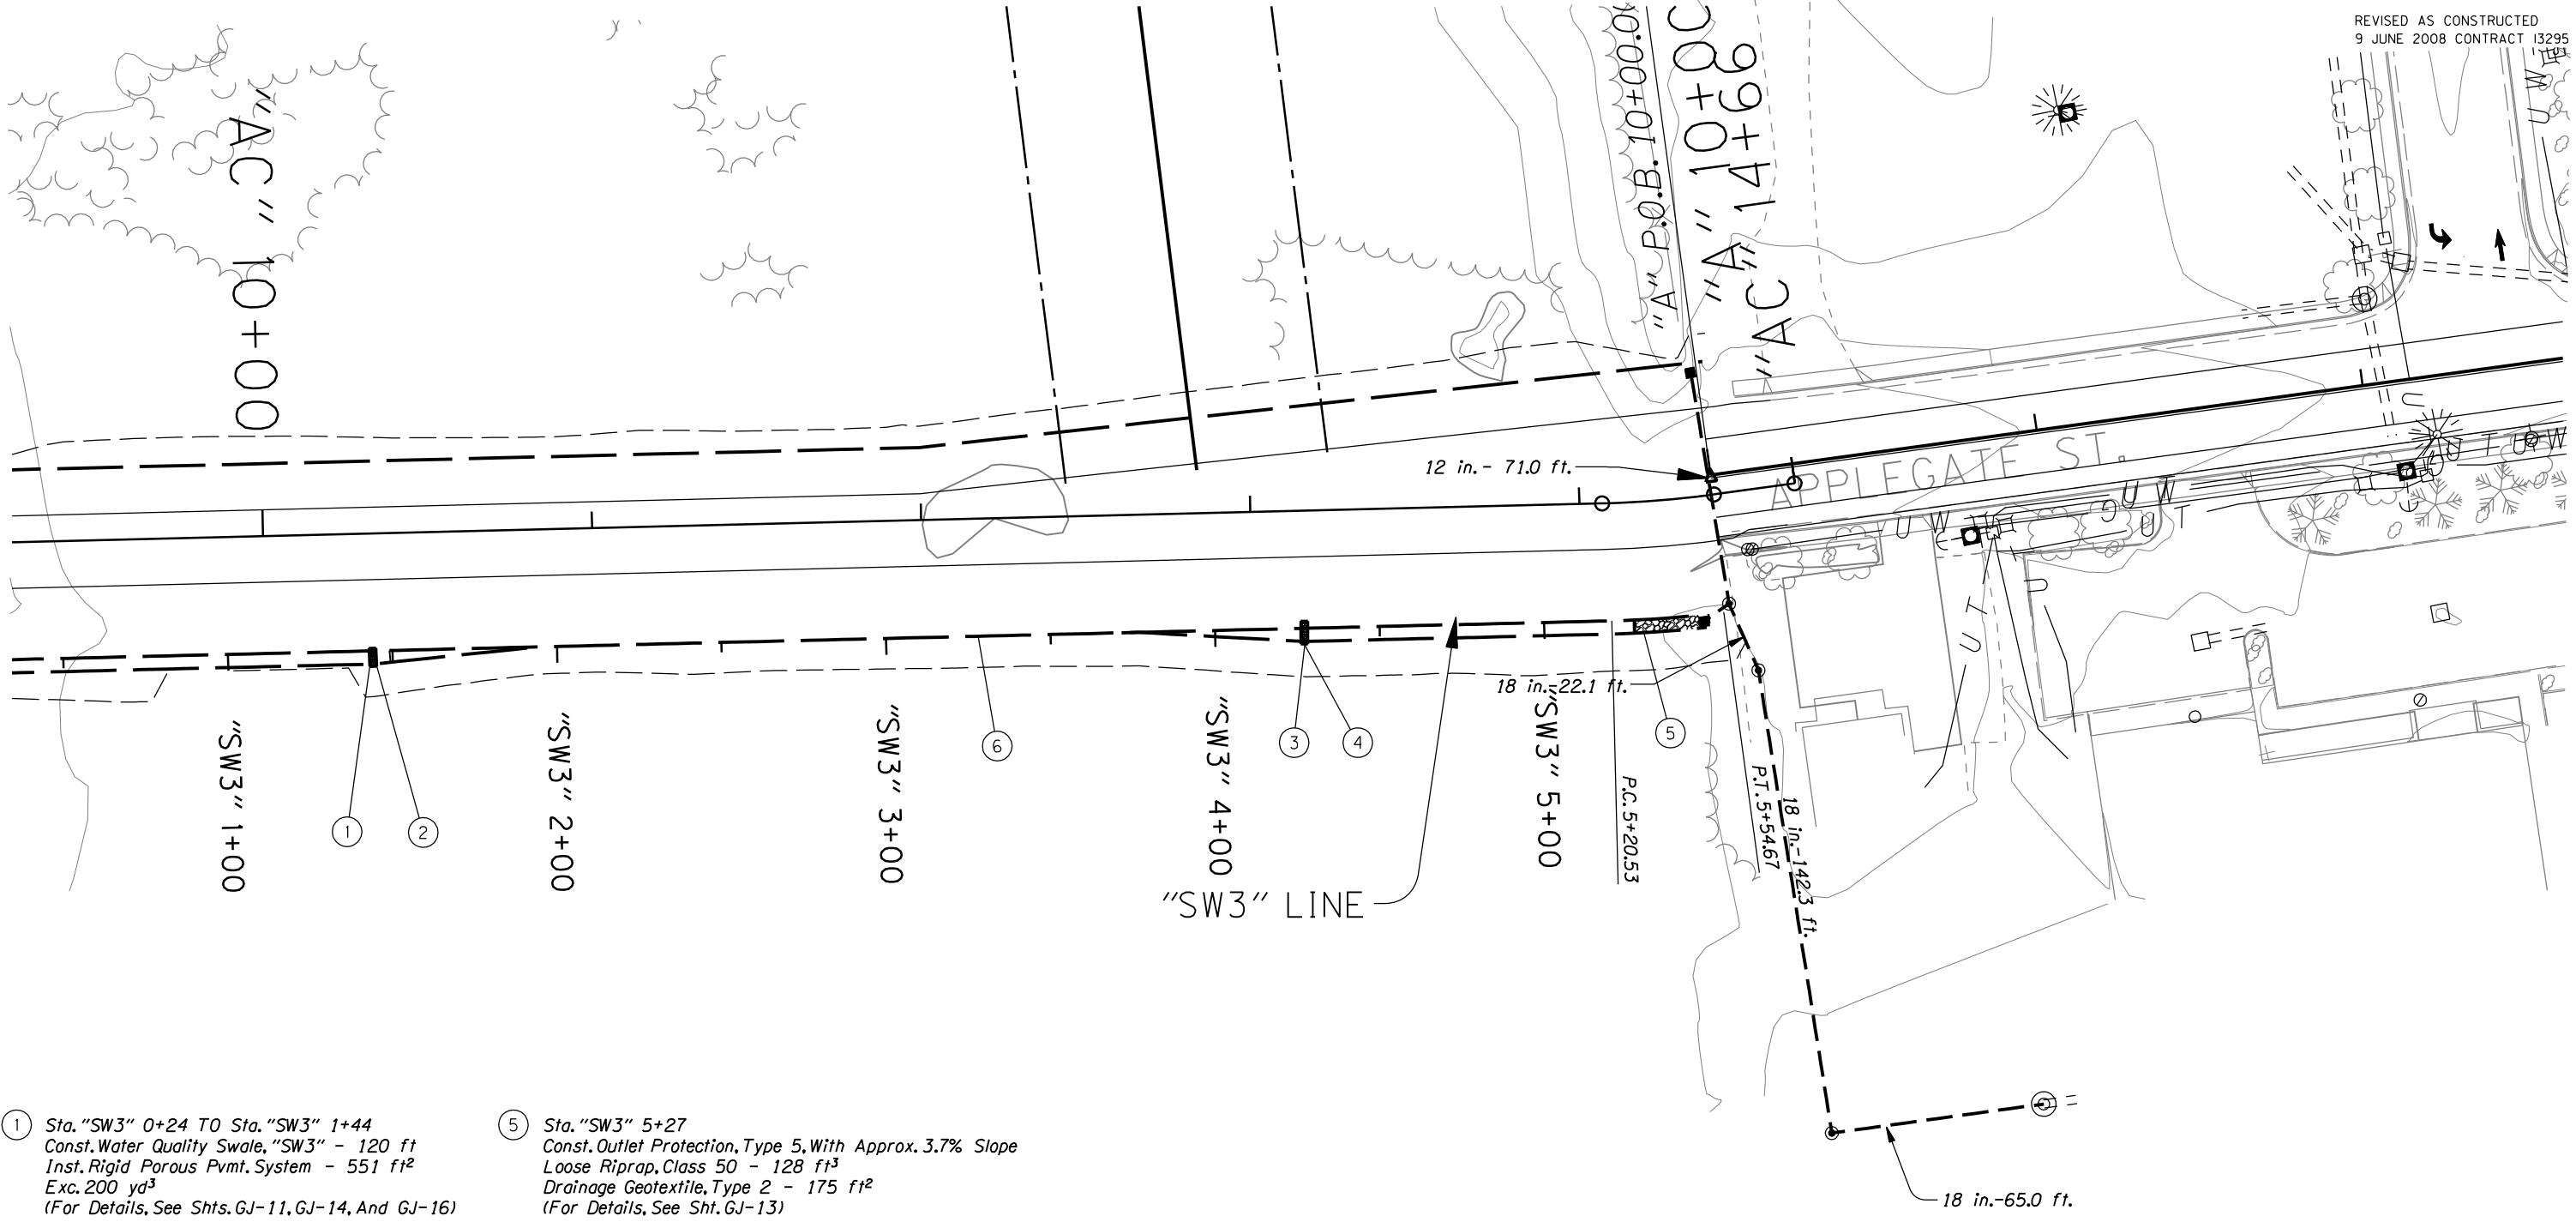

① Sta. "SW3" 0+24 TO Sta. "SW3" 1+44
 Const. Water Quality Swale, "SW3" - 120 ft
 Inst. Rigid Porous Pvmf. System - 551 ft²
 Exc. 200 yd³
 (For Details, See Shts. GJ-11, GJ-14, And GJ-16)


② Sta. "SW3" 1+44
 Const. Swale Flow Spreader
 Stone Emb. Matl. - 18 ft³
 Type 1 Riprap Geotextile - 60 ft²
 (For Details, See Sht. GJ-15)

③ Sta. "SW3" 4+27 TO Sta. "SW3" 5+27
 Const. Water Quality Swale, "SW3" - 100 ft
 Inst. Rigid Porous Pvmf. System - 441 ft²
 Exc. 200 yd³
 (For Details, See Shts. GJ-11, GJ-14, And GJ-16)

④ Sta. "SW3" 4+27
 Const. Swale Flow Spreader
 Stone Emb. Matl. - 18 ft³
 Type 1 Riprap Geotextile - 60 ft²
 (For Details, See Sht. GJ-15)

⑤ Sta. "SW3" 5+27
 Const. Outlet Protection, Type 5, With Approx. 3.7% Slope
 Loose Riprap, Class 50 - 128 ft³
 Drainage Geotextile, Type 2 - 175 ft²
 (For Details, See Sht. GJ-13)

⑥ Sta. "SW3" 1+44 TO Sta. "SW3" 4+27
 Const. Ditch "SW3"
 Ditch Exc. 126 yd³

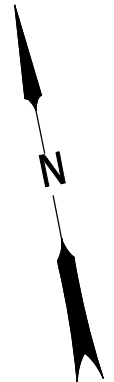

MSA
 Murray, Smith & Associates, Inc.
 Engineers/Planners
 Portland, Oregon

REGISTERED PROFESSIONAL
 ENGINEER
 13,265
ORIGINAL SIGNED BY
 OREGON
 JULY 17, 1986
 WILLIAM H. HOLLINGS
 Expires Jun. 30, 2009

OREGON DEPARTMENT OF TRANSPORTATION
 ROADWAY ENGINEERING SECTION

US 20: PHILOMATH COUPLET (PHILOMATH)
 CORVALLIS-NEWPORT HIGHWAY
 BENTON COUNTY

Reviewed By - William H. Hollings
 Designed By - Brendan V. O'Sullivan
 Drafted By - Harry C. Marx


WATER QUALITY PLAN

SHEET NO.
GJ-5

"SW3" LINE PROFILE

39V-005

REVISED AS CONSTRUCTED
9 JUNE 2008 CONTRACT 13295

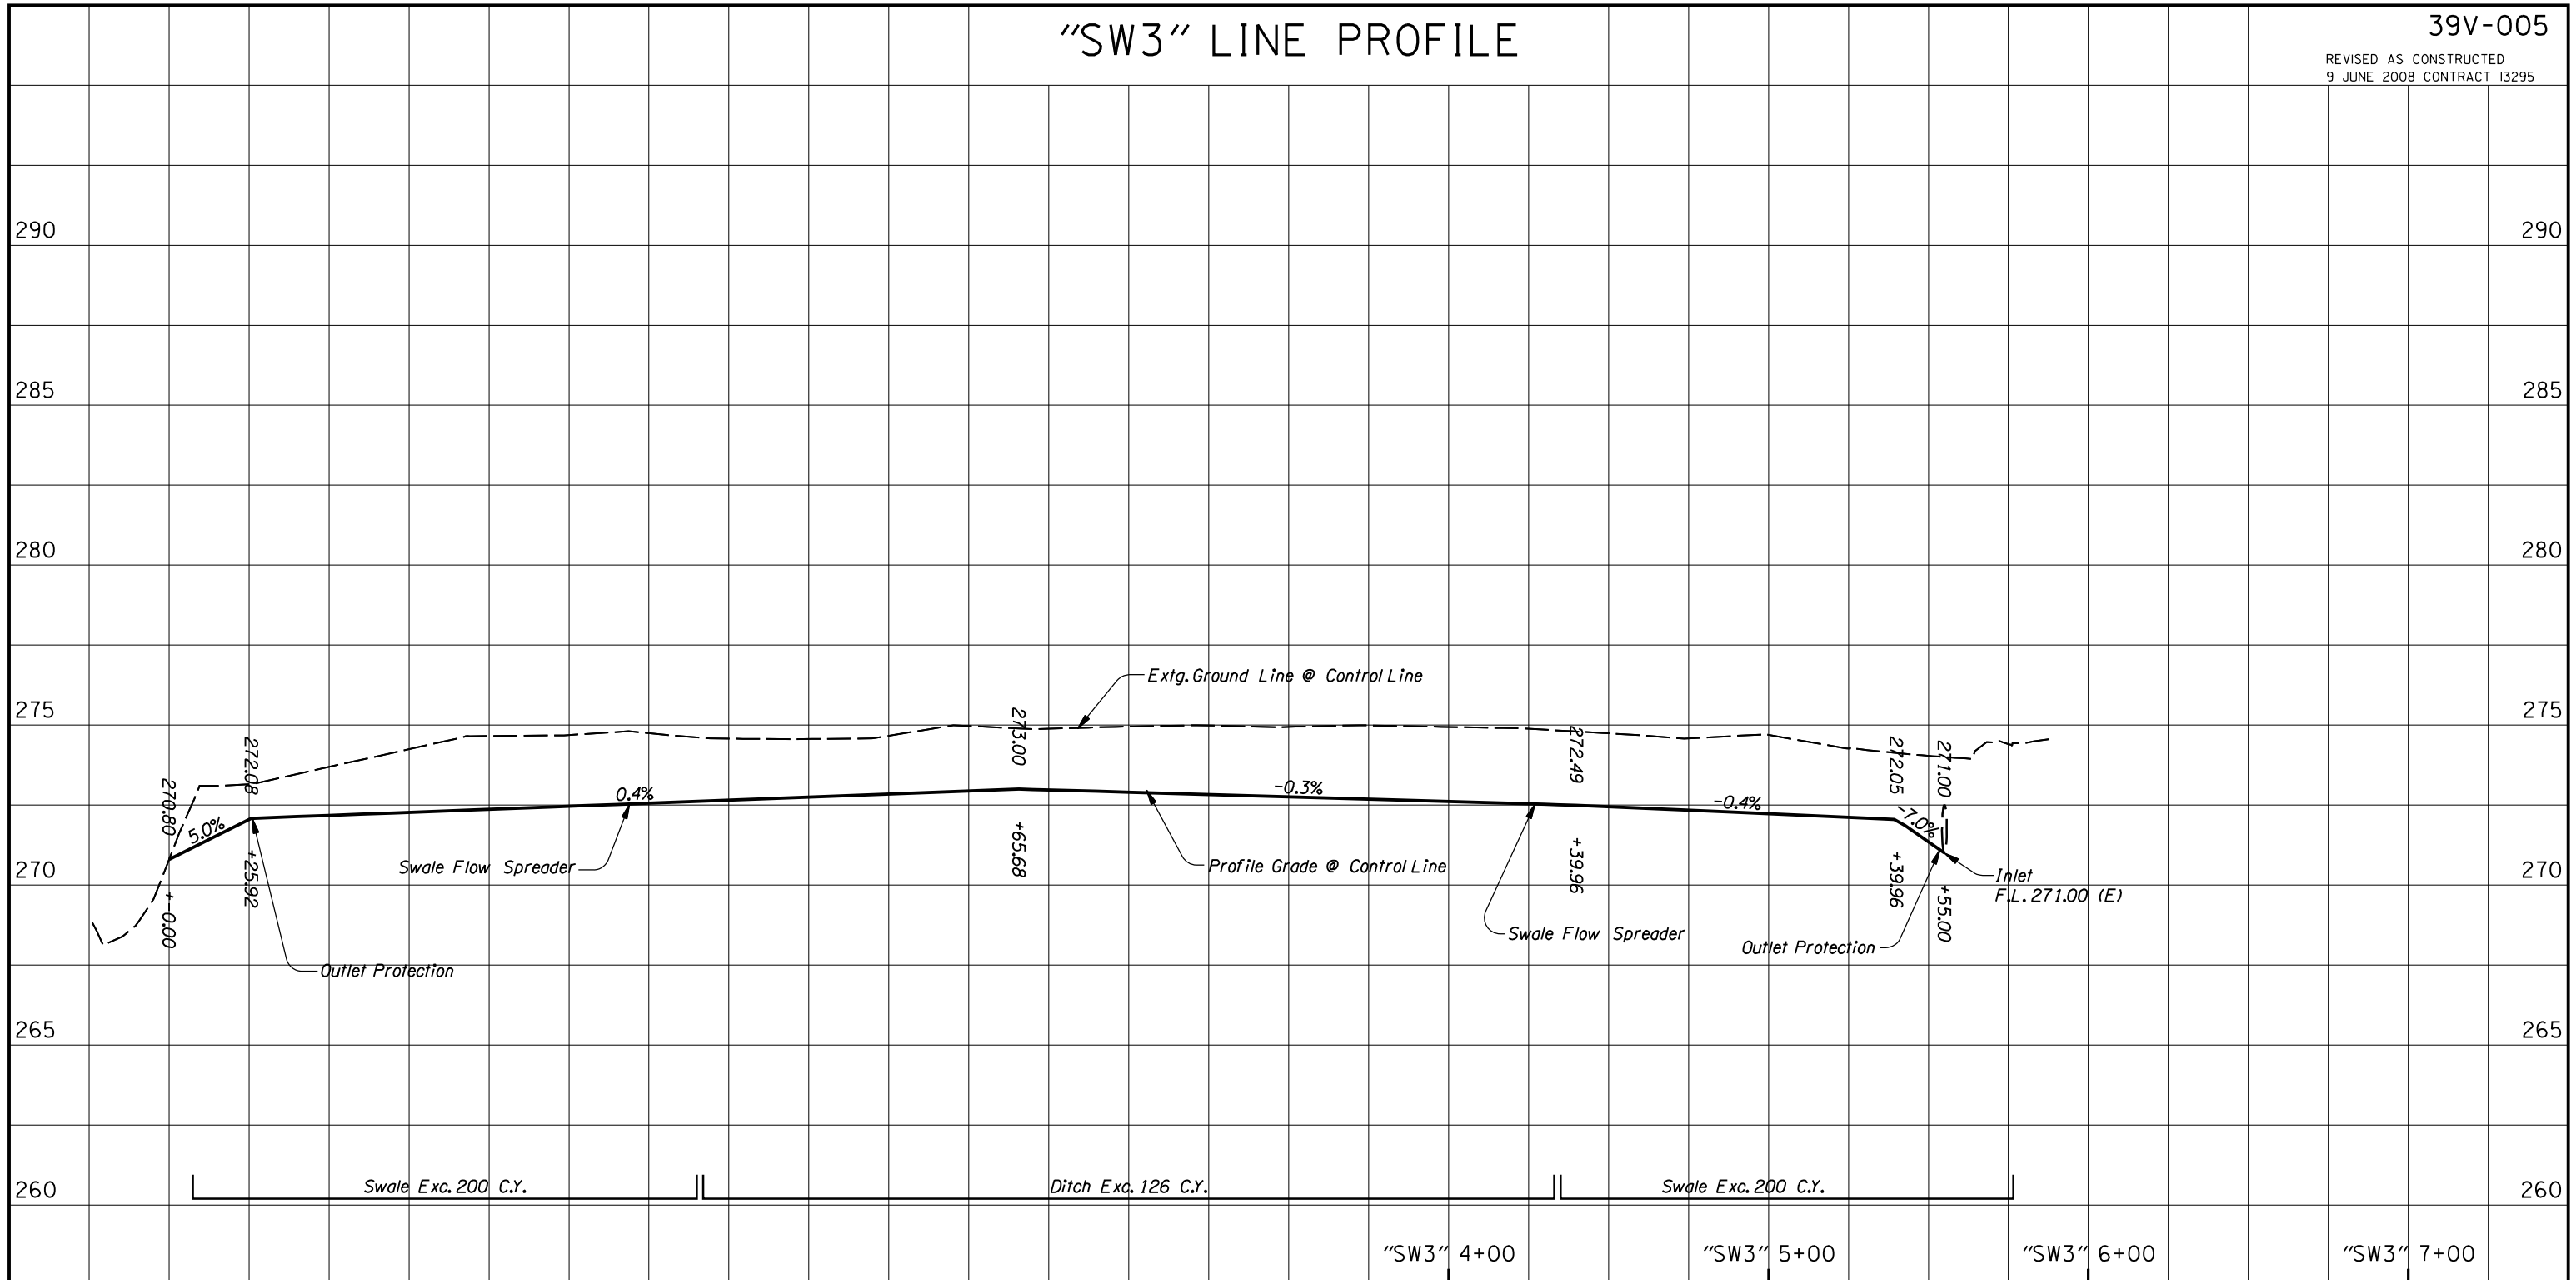

Swale Exc. 200 C.Y.

Ditch Exc. 126 C.Y.

Swale Exc. 200 C.Y.

"SW3" 4+00

"SW3" 5+00

"SW3" 6+00

"SW3" 7+00

"SW3" 0+00

"SW3" 1+00

"SW3" 2+00

"SW3" 3+00

MSA
Murray, Smith & Associates, Inc.
Engineers/Planners
Portland, Oregon

REGISTERED PROFESSIONAL
ENGINEER
13,265
ORIGINAL SIGNED BY
WILLIAM H. HOLLINGS
JULY 17, 1986
OREGON
Expires Jun. 30, 2009


OREGON DEPARTMENT OF TRANSPORTATION
ROADWAY ENGINEERING SECTION

US 20: PHILOMATH COUPLET (PHILOMATH)
CORVALLIS-NEWPORT HIGHWAY
BENTON COUNTY


Reviewed By - William H. Hollings
Designed By - Brendan V. O'Sullivan
Drafted By - Harry C. Marx

PROFILE


SHEET NO.
GJ-6

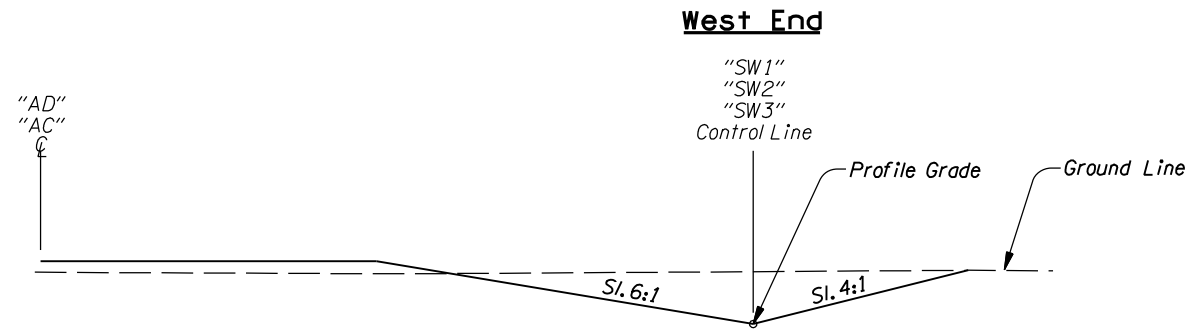


STA. "SW1" 0+00 TO STA. "SW1" 6+74
STA. "SW2" 0+00 TO STA. "SW2" 4+02
STA. "SW3" 1+94 TO STA. "SW3" 3+77

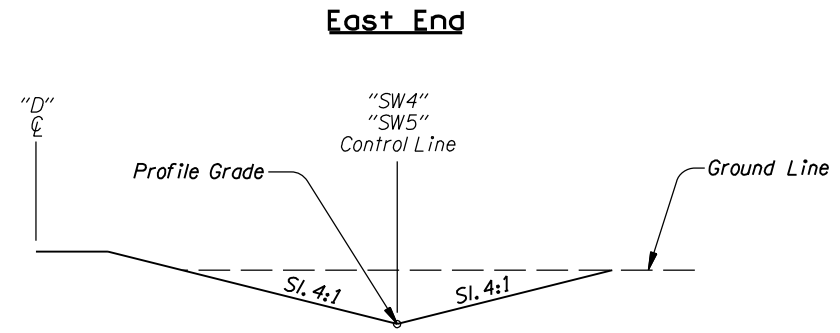


STA. "SW4" 0+12 TO STA. "SW4" 4+18
STA. "SW5" 0+00 TO STA. "SW5" 1+45

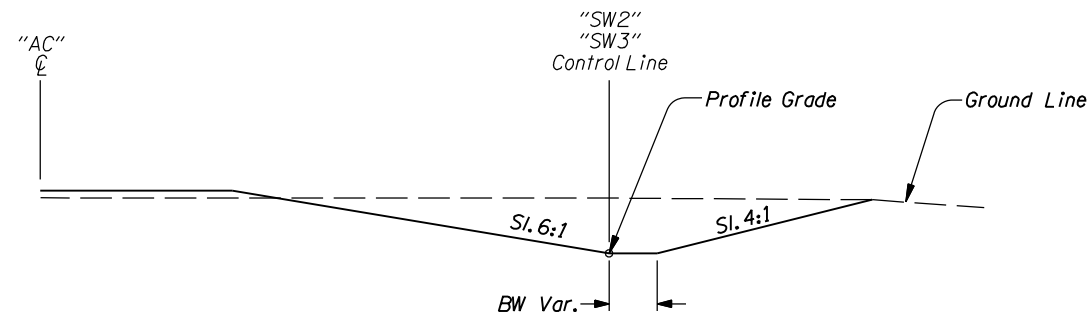


STA. "SW2" 4+02 TO STA. "SW2" 4+52
STA. "SW3" 1+44 TO STA. "SW3" 1+94
STA. "SW3" 3+77 TO STA. "SW3" 4+27

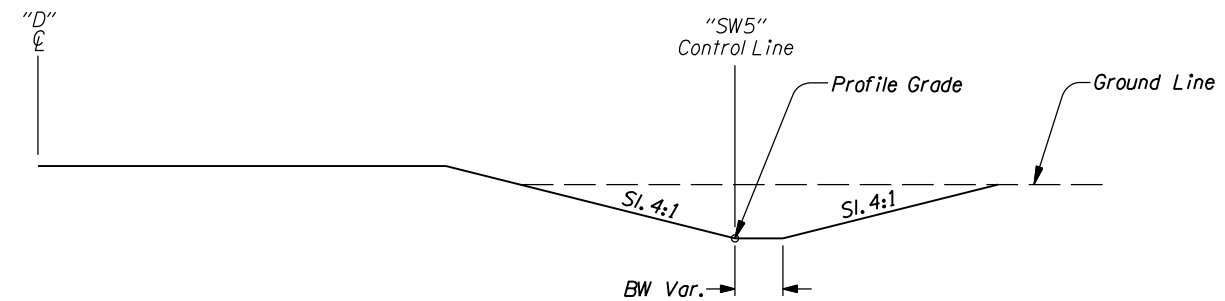

STA. "SW5" 1+45 TO STA. "SW5" 1+95

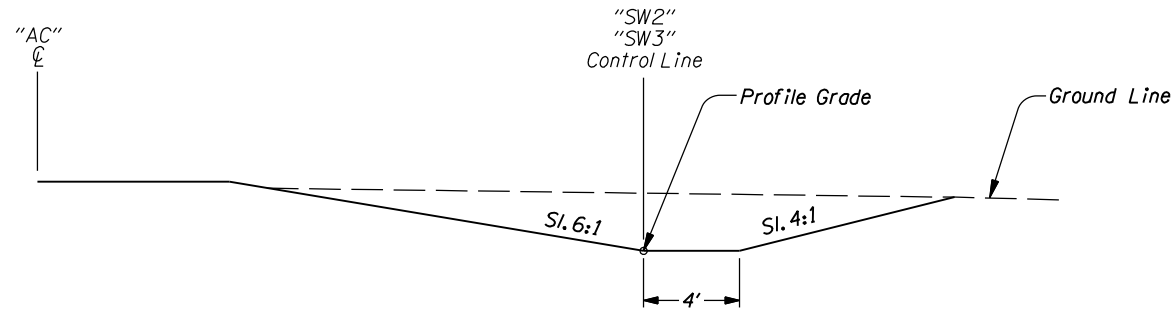

STA. "SW2" 4+52 TO STA. "SW2" 5+92
STA. "SW3" 0+24 TO STA. "SW3" 1+44
STA. "SW3" 4+27 TO STA. "SW3" 5+27
(For Details, See Sht. GJ-16)

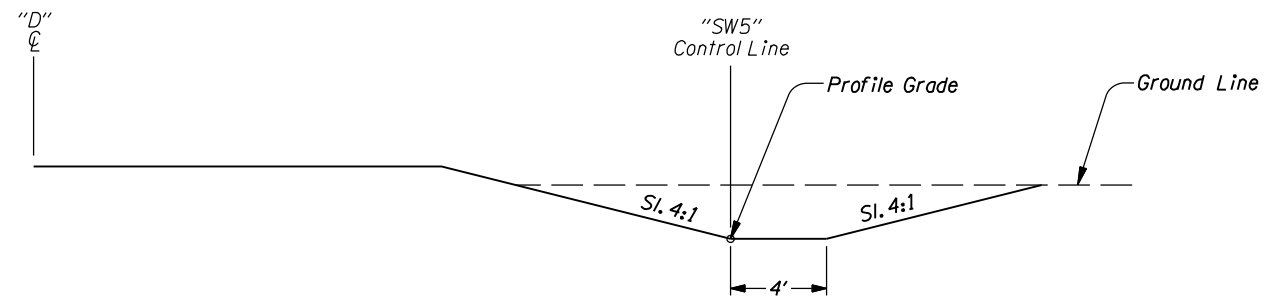

STA. "SW5" 1+95 TO STA. "SW5" 2+95
(For Details, See Sht. GJ-16)

**WATER QUALITY SWALE AND DITCH
TYPICAL SECTIONS**

MSA
Murray, Smith & Associates, Inc.
Engineers/Planners
Portland, Oregon

REGISTERED PROFESSIONAL
ENGINEER
13,265
ORIGINAL SIGNED BY
WILLIAM H. HOLLINGS
JULY 17, 1986
Expire Jun. 30, 2009


**OREGON DEPARTMENT OF TRANSPORTATION
ROADWAY ENGINEERING SECTION**

US 20: PHILOMATH COUPLET (PHILOMATH)
CORVALLIS-NEWPORT HIGHWAY
BENTON COUNTY

Reviewed By - William H. Hollings
Designed By - Brendan V. O'Sullivan
Drafted By - Harry C. Marx

WATER QUALITY DETAILS

SHEET
NO.
GJ-11

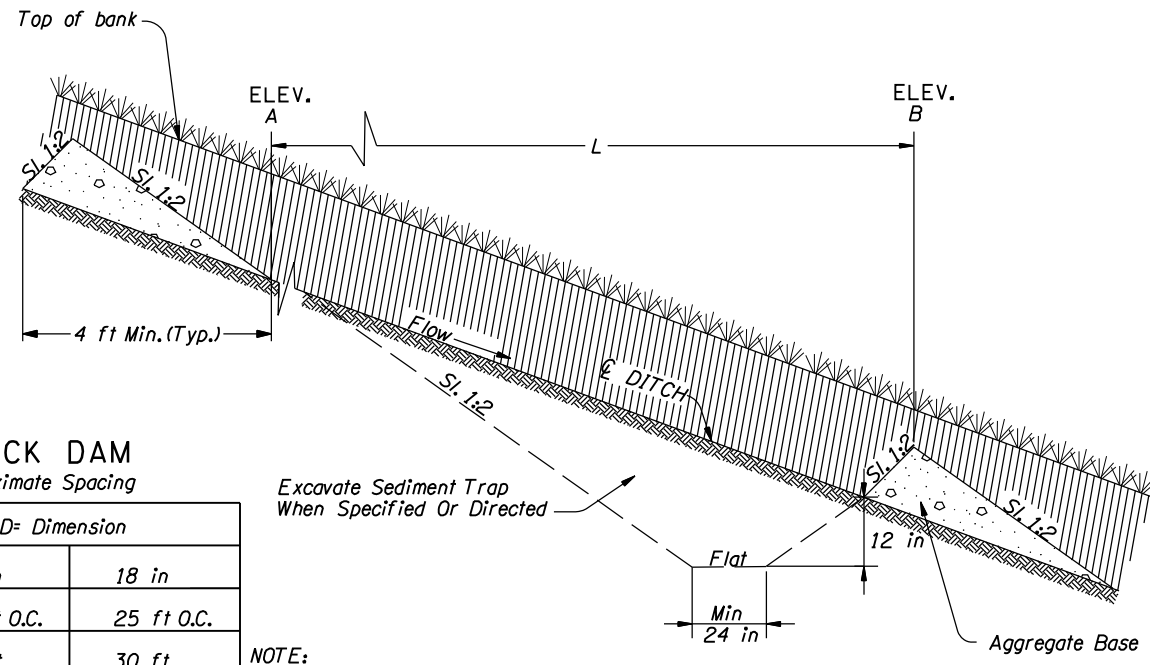


CHECK DAM
Approximate Spacing

Ditch Grade	D= Dimension	
	12 in	18 in
6%	15 ft O.C.	25 ft O.C.
5%	20 ft	30 ft
4%	25 ft	40 ft
3%	30 ft	50 ft
2%	55 ft	80 ft
1%	82 ft	131 ft
0.5%	164 ft	262 ft

NOTE:

When bid item is "Check Dams" the following materials may be used, as appropriate to meet the functional requirements of the control.
 Type 1. aggregate
 Type 2. straw bales with aggregate weir
 Type 3. biofilter bags
 Type 4. sand bags
 Type 5. prefab. check dam system



**DITCH PROFILE SECTION
TYPE 1 CHECK DAMS**

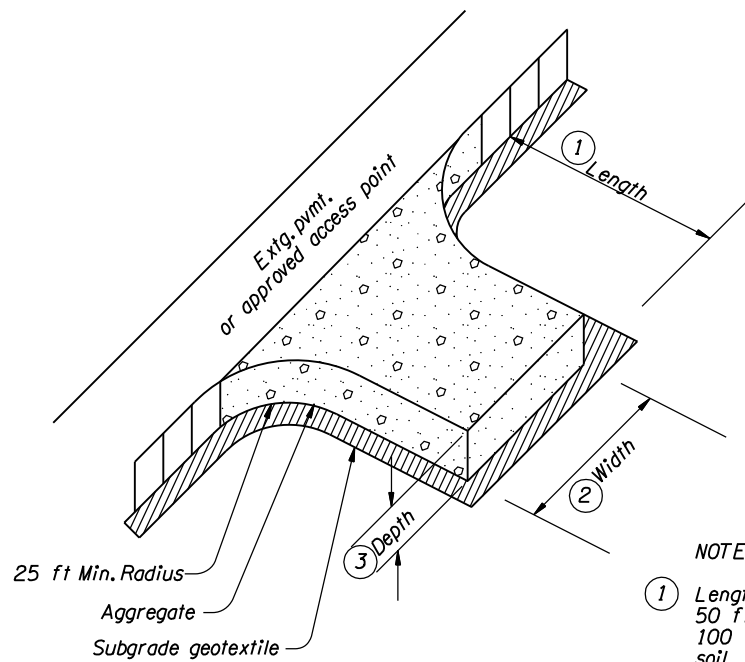

NOTE:

- ① Length:
50 ft min. - for less than 1 acre exposed soil
100 ft min. - for greater than 1 acre exposed soil
- ② Width:
20 ft - or width of extg. approach, whichever is greater.
- ③ Depth:
8 in. min

CONSTRUCTION ENTRANCE

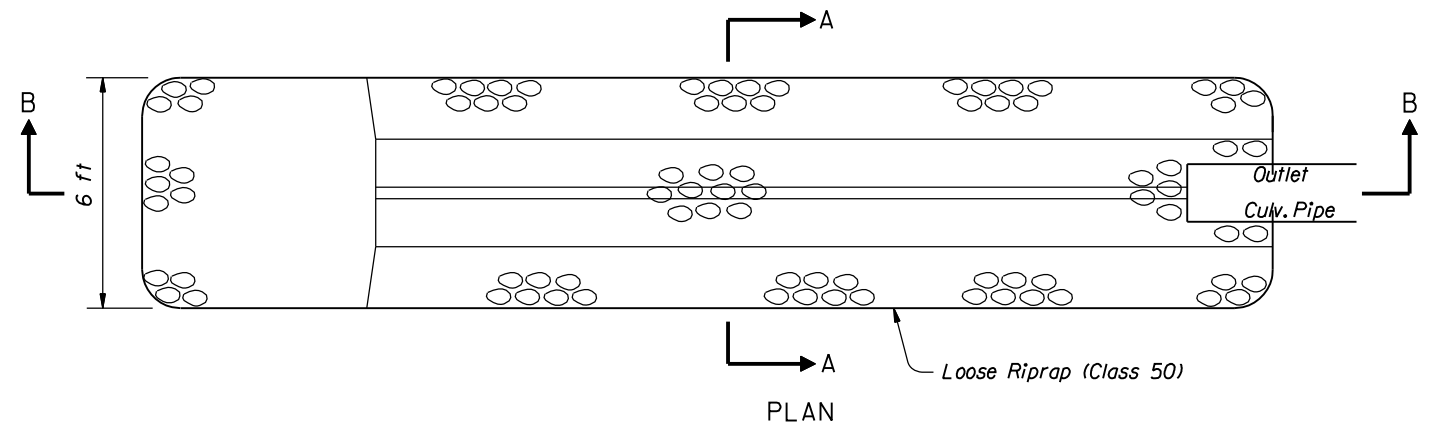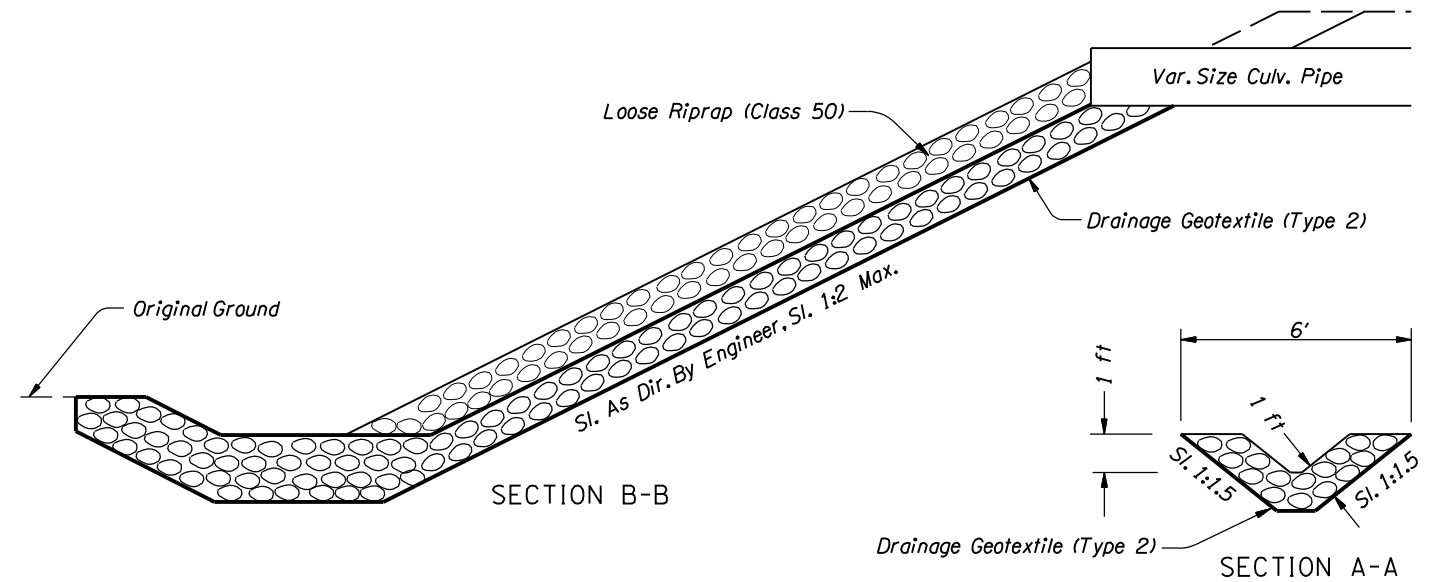

**OUTLET PROTECTION
Type 5**

MSA
Murray, Smith & Associates, Inc.
Engineers/Planners
Portland, Oregon

REGISTERED PROFESSIONAL
ENGINEER
13,265
ORIGINAL SIGNED BY
WILLIAM H. HOLLINGS
JULY 17, 1986
Expires Jun. 30, 2009

OREGON DEPARTMENT OF TRANSPORTATION
ROADWAY ENGINEERING SECTION

US 20: PHILOMATH COUPLET (PHILOMATH)
CORVALLIS-NEWPORT HIGHWAY
BENTON COUNTY

Reviewed By - William H. Hollings
Designed By - Brendan V. O'Sullivan
Drafted By - Harry C. Marx





WATER QUALITY DETAILS

SHEET NO.
GJ-13

POROUS PAVEMENT DETAILS

39V-005

REVISED AS CONSTRUCTED
9 JUNE 2008 CONTRACT 13295

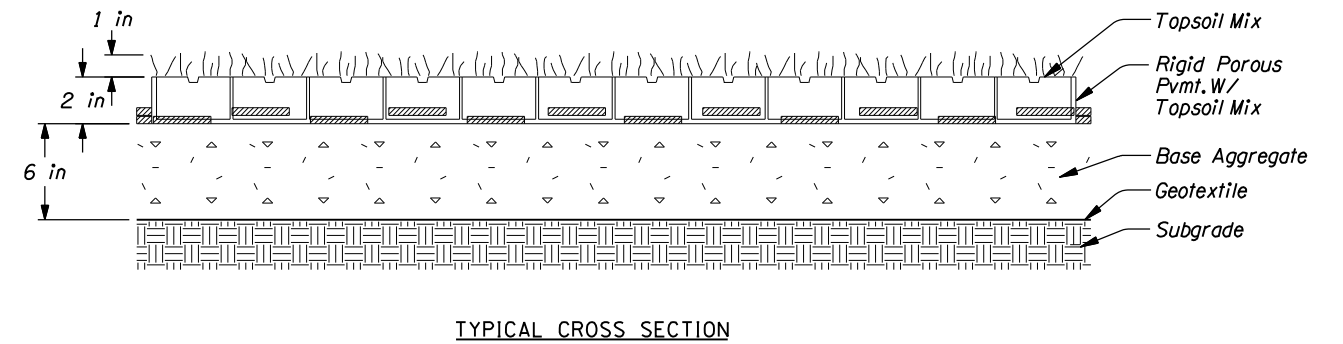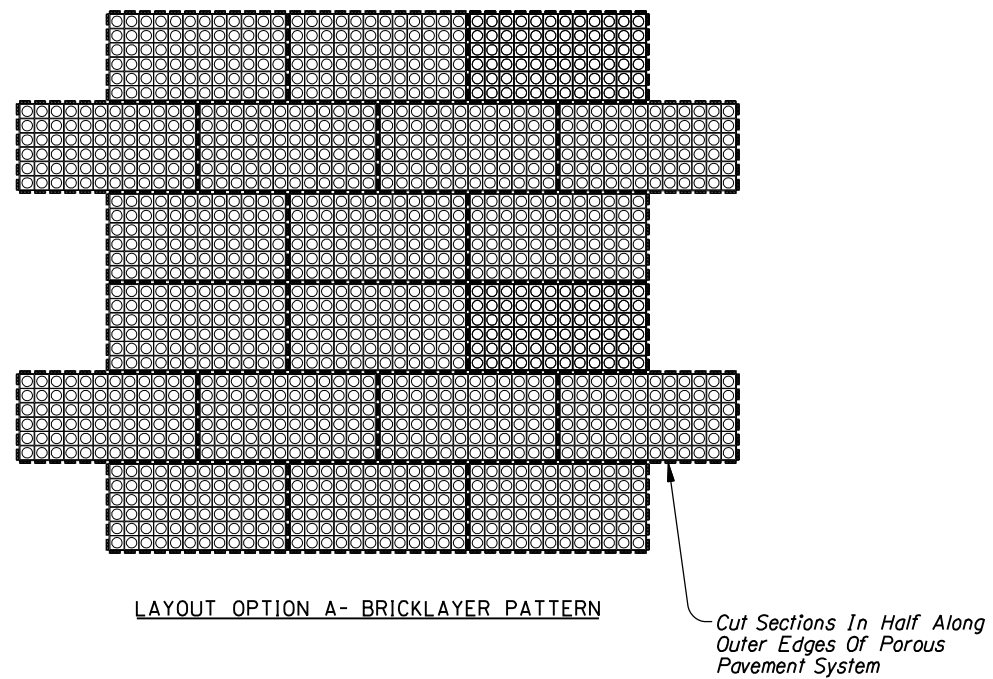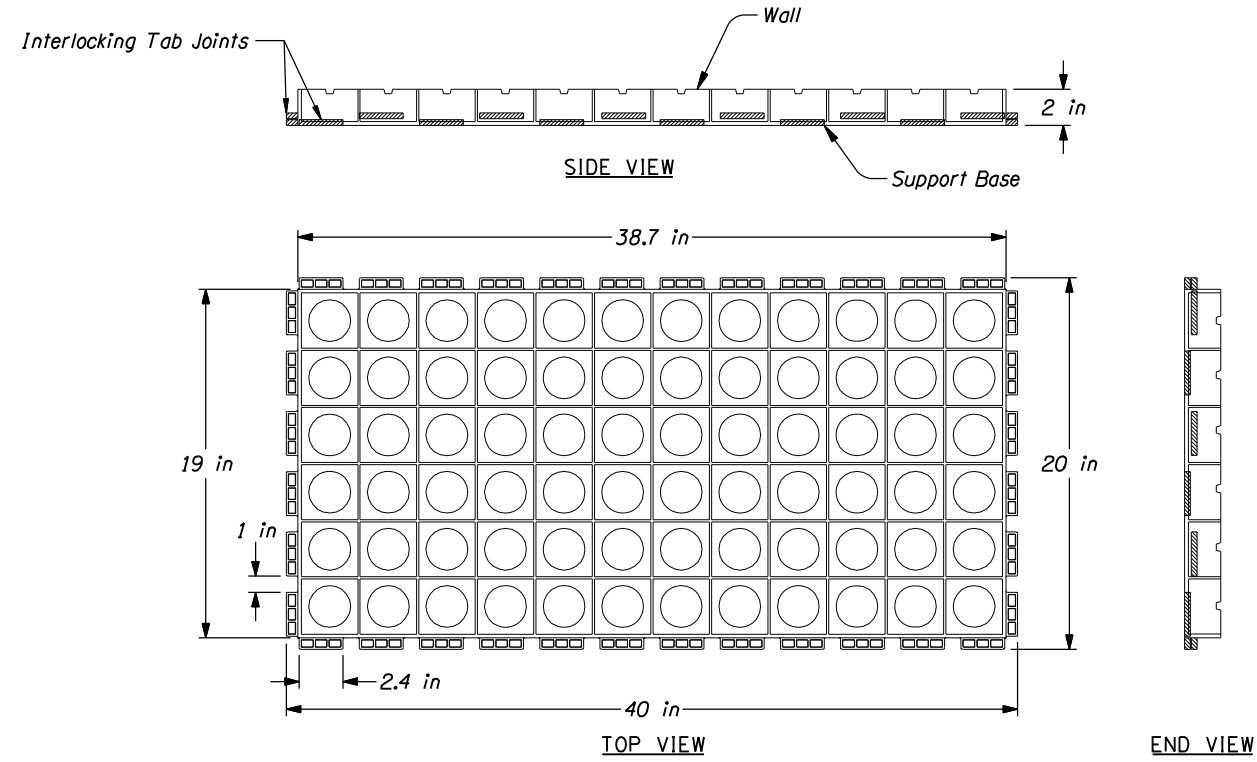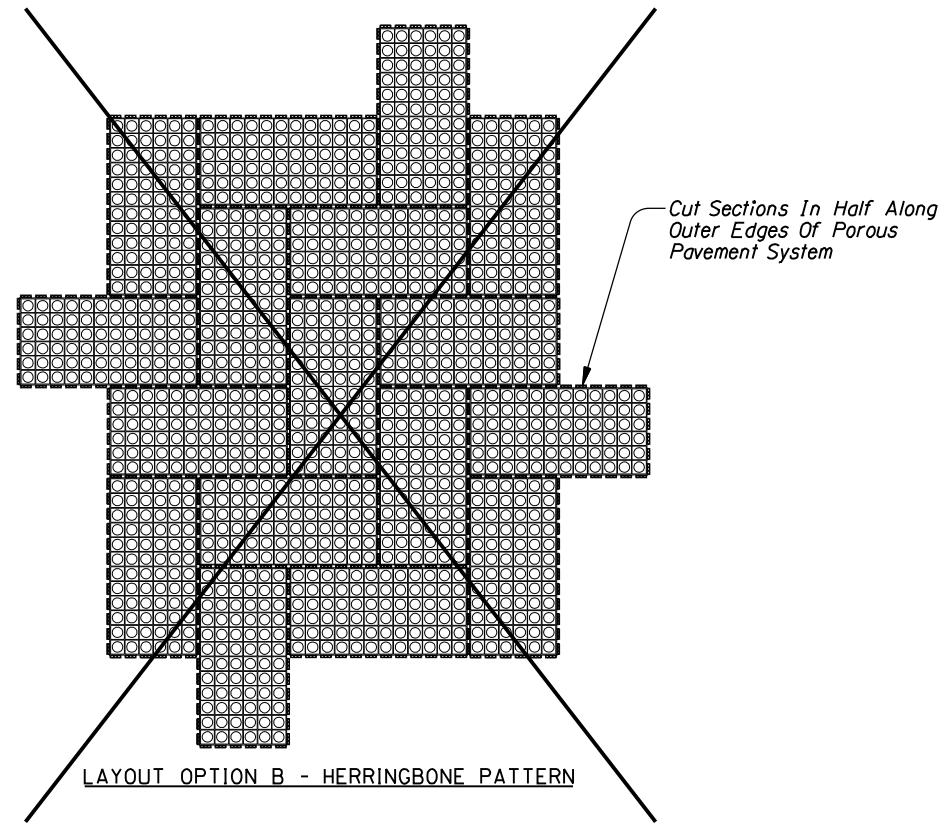

MSA
Murray, Smith & Associates, Inc.
Engineers/Planners
Portland, Oregon

REGISTERED PROFESSIONAL
ENGINEER
13,265
ORIGINAL SIGNED BY
WILLIAM H. HOLLINGS
JULY 17, 1986
Expires Jun. 30, 2009


OREGON DEPARTMENT OF TRANSPORTATION
ROADWAY ENGINEERING SECTION

US 20: PHILOMATH COUPLET (PHILOMATH)
CORVALLIS-NEWPORT HIGHWAY
BENTON COUNTY


Reviewed By - William H. Hollings
Designed By - Brendan V. O'Sullivan
Drafted By - Harry C. Marx

WATER QUALITY DETAILS

SHEET NO. **GJ-14**

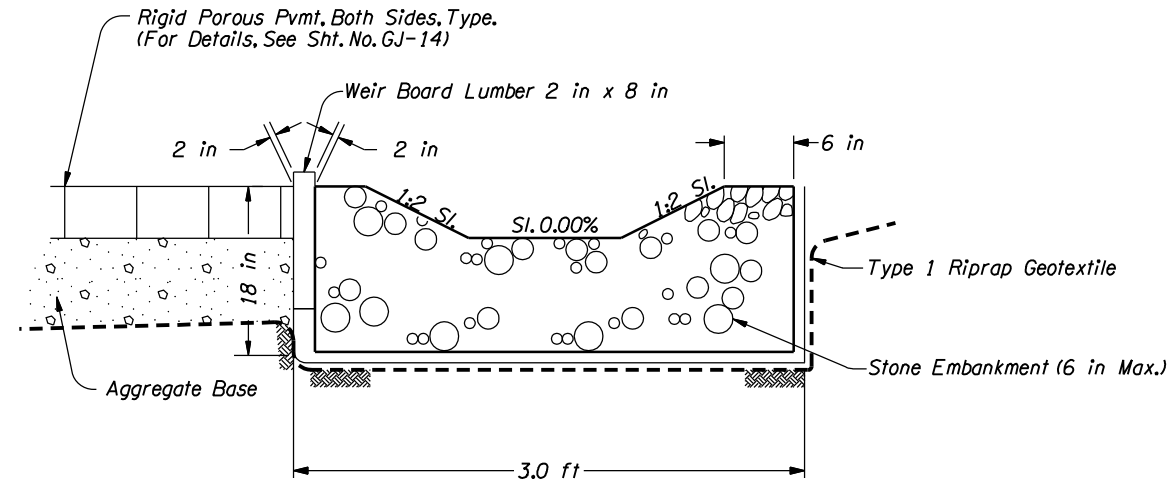


SECTION B-B

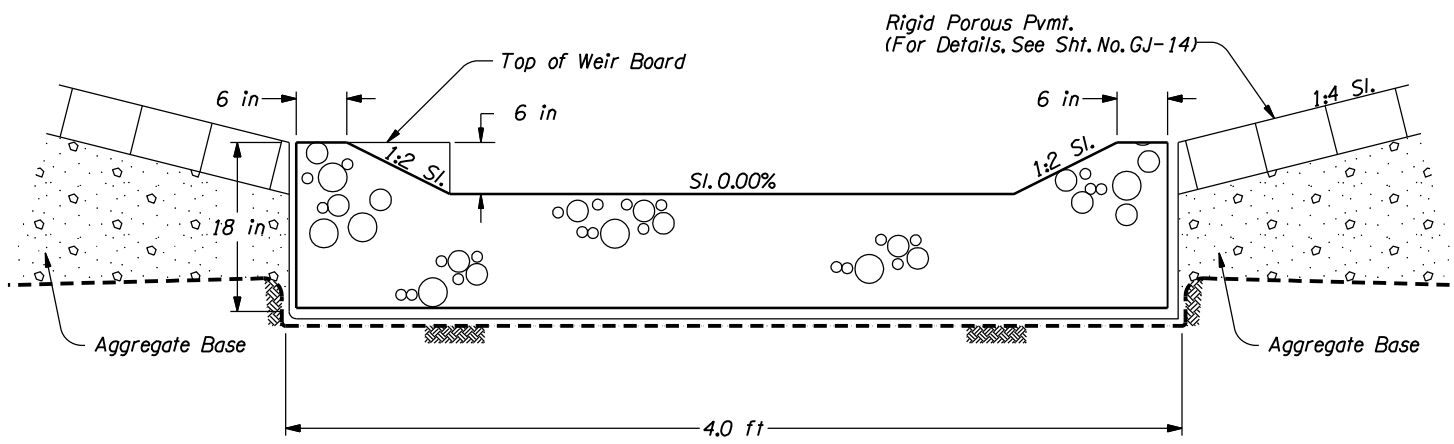

SECTION A-A

Swale	Side Widths (in)				Pipe Outfall Side	"W"	Top of Weir Board Elev.
	1	2	3	4			
SW	6	6	6	6	1	4.0 ft	-

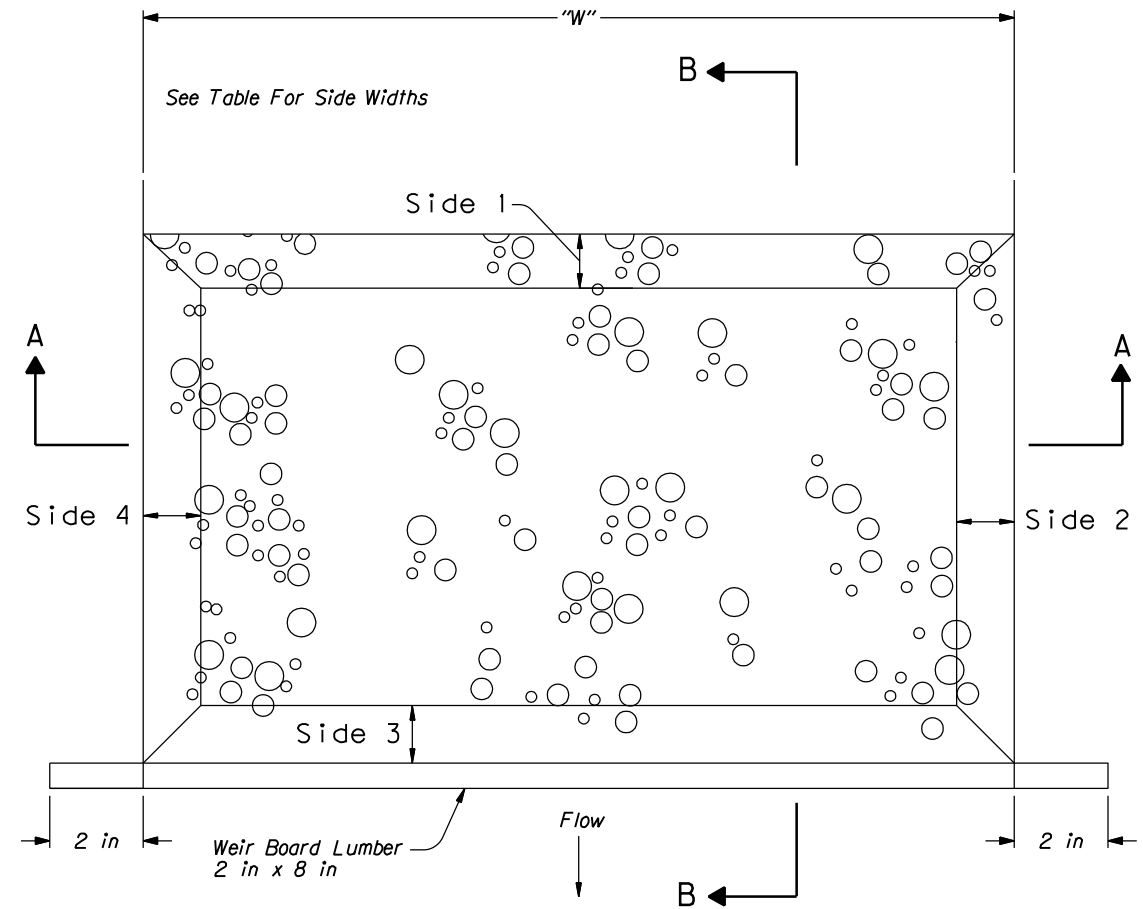

PLAN
SWALE FLOW SPREADER

MSA
Murray, Smith & Associates, Inc.
Engineers/Planners
Portland, Oregon

REGISTERED PROFESSIONAL
ENGINEER
13,265
ORIGINAL SIGNED BY
WILLIAM H. HOLLINGS
JULY 17, 1986
Expires Jun. 30, 2009


OREGON DEPARTMENT OF TRANSPORTATION
ROADWAY ENGINEERING SECTION

US 20: PHILOMATH COUPLET (PHILOMATH)
CORVALLIS-NEWPORT HIGHWAY
BENTON COUNTY

Reviewed By - William H. Hollings
Designed By - Brendan V. O'Sullivan
Drafted By - Harry C. Marx

WATER QUALITY DETAILS

SHEET NO.
GJ-15

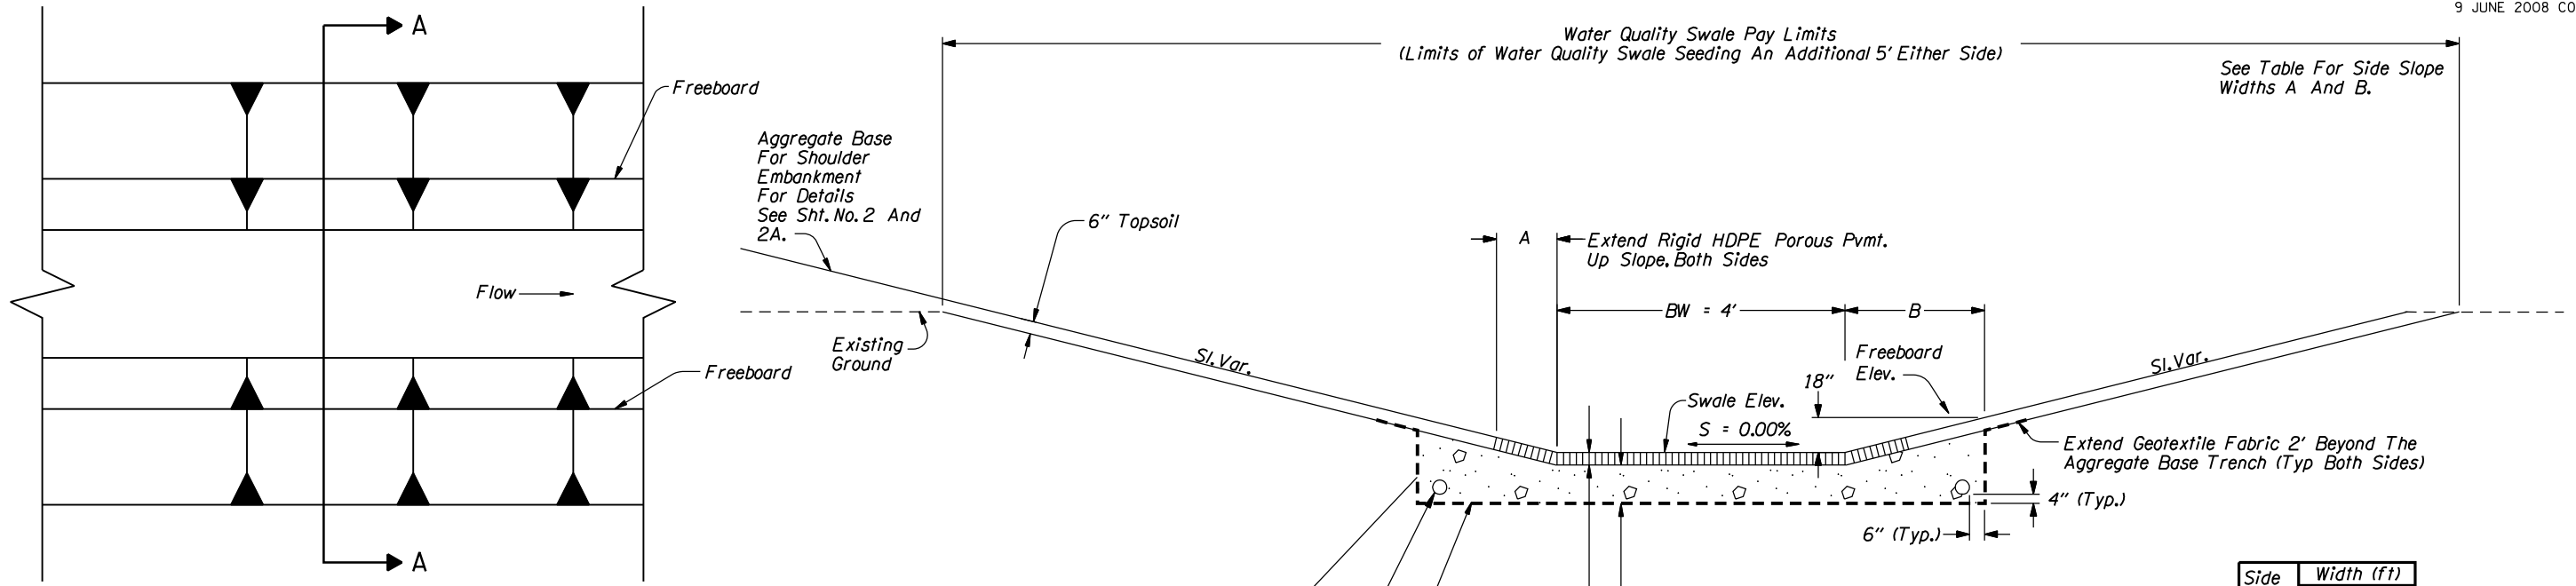


PLAN
GENERAL SWALE LAYOUT

SECTION A-A
SWALE SOIL STRUCTURE
NTS

Side Slope	Width (ft)	
	A	B
6:1	3	9
4:1	2	6

- Notes:
1. Base Aggregate, 1" - 0 Per Sec 00641 Mix Approx. 50/50 with Topsoil Before Placing.
 2. Swale Elevation Called Out On Plans Is At Top Of Rigid HDPE Porous Pvmt.
 3. Swale Side Slopes To Be Constructed As Specified On Typical Sections. See Shts. No. GJ-11 And GJ-12.

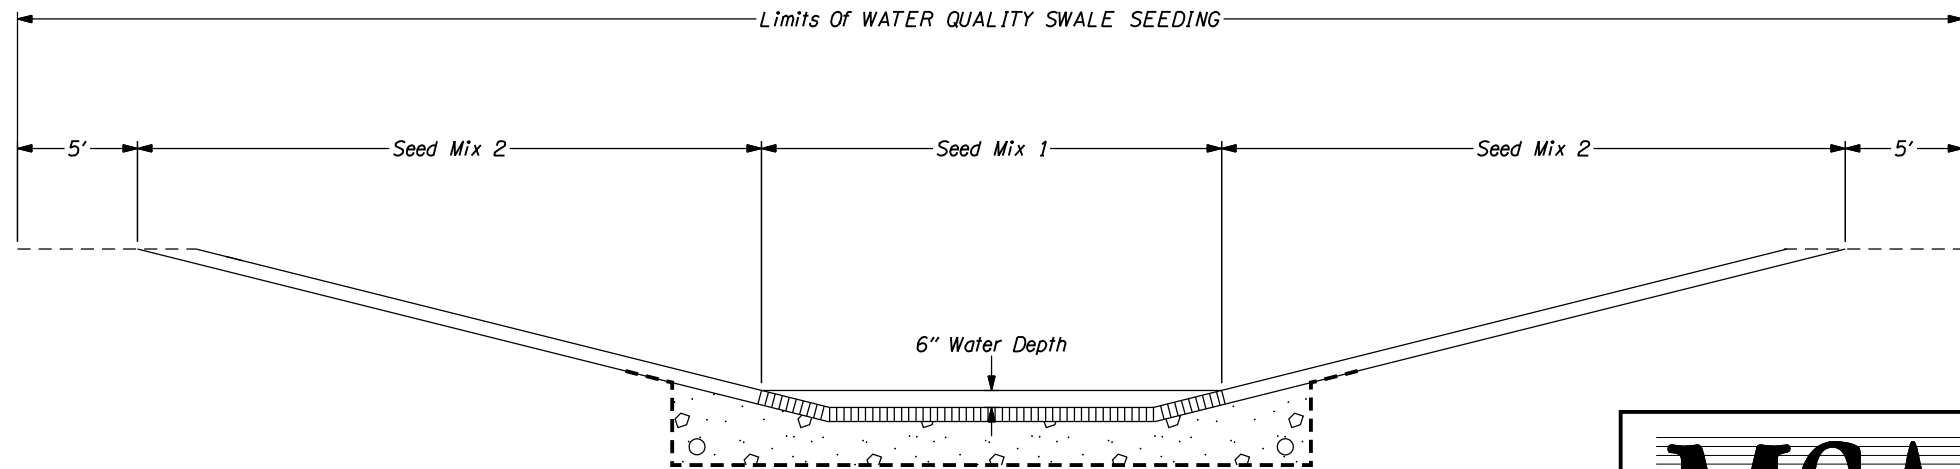

SECTION A-A
SWALE SEEDING LIMITS
(For Seed Mix Details, See Sht. GN-1)

MSA
Murray, Smith & Associates, Inc.
Engineers/Planners
Portland, Oregon

REGISTERED PROFESSIONAL
ENGINEER
13,265
ORIGINAL SIGNED BY
WILLIAM H. HOLLINGS
JULY 17, 1986
Expires Jun. 30, 2009

OREGON DEPARTMENT OF TRANSPORTATION
ROADWAY ENGINEERING SECTION

US 20: PHILOMATH COUPLET (PHILOMATH)
CORVALLIS-NEWPORT HIGHWAY
BENTON COUNTY

Reviewed By - William H. Hollings
Designed By - Brendan V. O'Sullivan
Drafted By - Harry C. Marx

WATER QUALITY DETAILS

SHEET NO. **GJ-16**