

OPERATION & MAINTENANCE MANUAL

Water Quality Biofiltration Swale

Manual prepared: May 2018

DFI No. D00215



Figure 1: DFI No. D00215, looking West.

Identification

Drainage Facility ID (DFI): D00215
Facility Type: Water Quality Biofiltration Swale
Construction Drawings: (V-File Numbers) 41V-002
Location: District: 2B
Highway No.: 001
Mile Post: 306.23 to 306.27, RT

1. Manual Purpose

The purpose of this manual is to outline inspection needs and summarize maintenance actions.

2. Facility Location

The location map below details the facility location. The highway, mile posts, side streets, access location, and stormwater flow directions are noted on the map.

Facility location type: On ramp

Flow direction: Southeast




Figure 2: Facility location map

3. Facility Summary

The length and width of a swale is based on the bottom dimensions.

The bottom length and bottom width of the swale is:


Bottom Length (feet)	Bottom Width (feet)
275	24

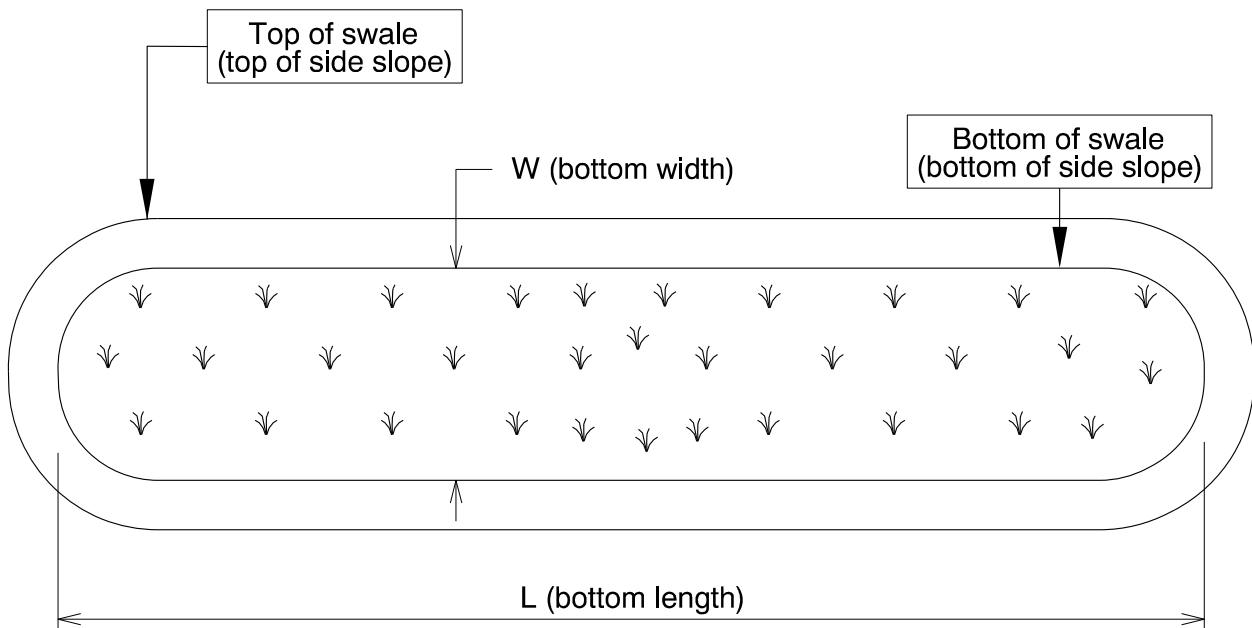

The depth of the swale is the vertical distance measured from the bottom of the swale to the top. The slope of the swale sides is presented by a vertical distance (rise) followed by the horizontal distance (run).

Depth and side slopes:

Depth (feet)	Rise (feet)	Run (feet)
3	1	4

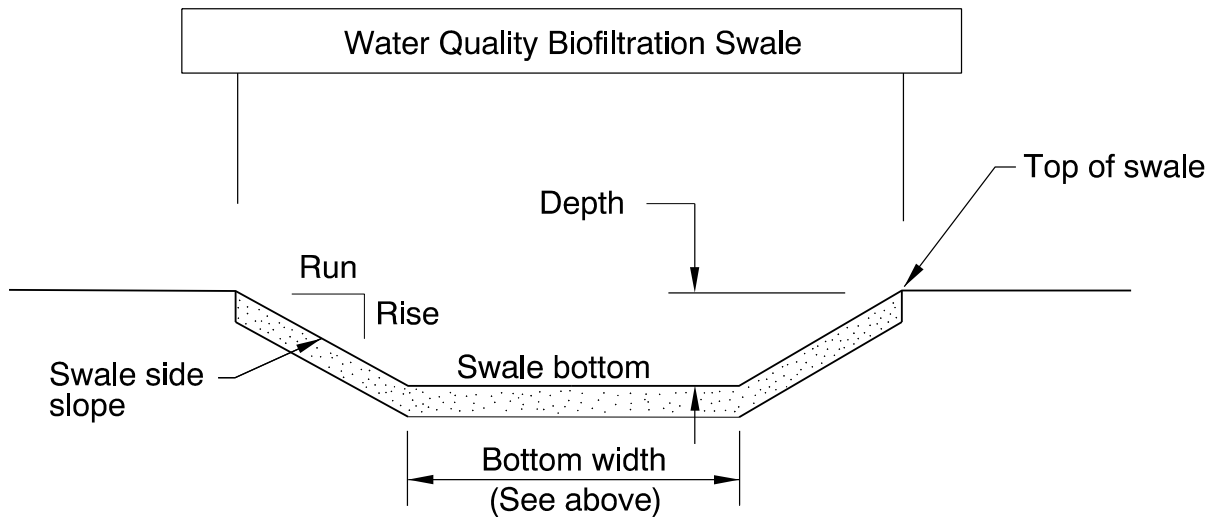

Site Specific Information: Facility is located on the right shoulder of the I-5 (Hwy 001) Columbia Blvd. southbound on-ramp.

4. Facility Access

Maintenance access to the facility:

<input checked="" type="checkbox"/> Roadside pad	<input type="checkbox"/> Roadside shoulder
<input type="checkbox"/> Access road with Gate	<input type="checkbox"/> Access road without Gate



Figure 3: Maintenance Access Road entrance, facing Columbia Blvd. Southbound on-ramp.

5. Operational Components / Maintenance Items

Classification

This facility is classified as an:

<input checked="" type="checkbox"/> On-line Swale	<input type="checkbox"/> Off-line Swale
A swale that does not include a high flow bypass component; flow drains into and through the facility	A swale that treats low/small flows and diverts high flows using a bypass component

Bypass Component

This facility includes a high flow bypass component:

<input checked="" type="checkbox"/> No	<input type="checkbox"/> Yes
There is no bypass component. High flows drain into and through the facility	There is a bypass component. Only low/small flows drain into the swale. High flows are diverted around the swale using a bypass component

Operational Components

A swale has many components that assist with treatment, conveyance, and reducing flow velocity to minimize erosion. The components in use can vary depending if the facility was designed to operate on-line or off-line. The facility components table (**Table 1**) has been provided to highlight the applicable components for this facility. The component is in use when the box contains an “x” (e.g.).

The Standard Operation Manual for Water Quality Biofiltration Swales (implemented March 2017) outlines facility operation, typical footprint configuration, and component definitions and details. A link to the manual is attached to the feature marker in TransGIS.

<https://gis.odot.state.or.us/TransGIS/>

Operational Plan

The applicable standard operational plan for this facility is:

<input type="checkbox"/> Operational Plan A	<input checked="" type="checkbox"/> Operational Plan B	<input type="checkbox"/> Operational Plan C
A standard operational plan illustrates the general facility footprint configuration and explains the purpose of each facility component. Operational plans (A, B, C) are provided in the Standard Operation Manual.		

See Appendix A for the site specific operational plan.

Maintenance Items

Operational components marked in **Table 1** should be inspected and maintained according to Section 7. Each facility component is defined and detailed in the Standard Operation Manual using the associated ID number indicated below.

Table 1: Swale Components		ID #
Manholes/Structures		
Pre-treatment manhole	<input type="checkbox"/>	S1
Weir type flow splitter/flow splitter manhole	<input type="checkbox"/>	S2
Orifice type flow splitter/flow splitter manhole	<input type="checkbox"/>	S3
Standard manhole	<input checked="" type="checkbox"/>	S4
Swale Inlet		
Pavement sheet flow	<input checked="" type="checkbox"/>	S5
Inlet Pipe (s)	<input checked="" type="checkbox"/>	S6
Open channel inlet	<input type="checkbox"/>	S7
Riprap pad	<input type="checkbox"/>	S8
Ground Cover		
Grass bottom	<input checked="" type="checkbox"/>	S9
Grass side slopes	<input checked="" type="checkbox"/>	S10
Granular drain rock	<input type="checkbox"/>	S11
Plantings	<input type="checkbox"/>	S12
Underground Components		
Geotextile fabric	<input checked="" type="checkbox"/>	S13
Water quality mix	<input type="checkbox"/>	S14
Perforated pipe	<input type="checkbox"/>	S15
Porous pavers (access grid)	<input checked="" type="checkbox"/>	S16
Flow Spreader		
Rock basin (used at inlet)	<input checked="" type="checkbox"/>	S17
Anchored board (midpoint of swale or every 50 feet along swale bottom)	<input checked="" type="checkbox"/>	S18
Other:	<input type="checkbox"/>	S19
Swale Outlet		
Catch basin with grate	<input checked="" type="checkbox"/>	S20
Outlet Pipe (s)	<input checked="" type="checkbox"/>	S21
Open channel outlet	<input type="checkbox"/>	S22
Auxiliary Outlet:	<input type="checkbox"/>	S23
Outfall Type		
Waterbody (Creek/Lake/Ocean)	<input type="checkbox"/> C	S24
	<input type="checkbox"/> L	
	<input type="checkbox"/> O	
Ditch	<input type="checkbox"/>	S25
Storm drain system	<input checked="" type="checkbox"/>	S26
Outfall Components		
Riprap pad	<input type="checkbox"/>	S27
Riprap bank protection	<input type="checkbox"/>	S28

6. Maintenance

Maintenance Frequency/Maintain Records

- a. Inspect annually. Preferably prior to the rainy season.
- b. Clean and maintain as necessary. Refer to Activity 125 for conditions when maintenance is needed.
- c. Keep a record of inspections, maintenance, and repairs.

Maintenance Guide/Maintenance Actions

The ODOT Routine Road Maintenance Water Quality and Habitat Guide (the *Blue Book*) outlines the standard maintenance actions for water quality facilities under Activity 125.

There are standard maintenance tables for standard ODOT designs. The maintenance tables describe the maintenance component, the defect or problem, the condition when maintenance is needed, and the recommended maintenance to correct the problem. Use the following tables to maintain ODOT swales:

- Table 1 (General Maintenance): Contains general maintenance and inspection guidelines that are applicable to all ODOT water quality facilities
- Table 3 (Maintenance of Water Quality or Biofiltration Swales): Contains maintenance information for swales

The *Blue Book* can be viewed at the following website:

http://www.oregon.gov/ODOT/Maintenance/Documents/blue_book.pdf

7. Limitations

Access grid installed:

<input type="checkbox"/> No	<input checked="" type="checkbox"/> Yes
There are light duty porous pavers installed in this swale	

Swales are designed to allow equipment access along the bottom. If an access grid is **NOT** installed, vehicles entering the swale can create depressions (tire ruts), damage vegetation, and damage structural components (e.g. flow spreaders). These conditions may result in poor treatment and drainage performance.

Equipment wheels should be kept on the tops and side slopes. Mower arms may be run along the swale bottom.

8. Waste Material Handling

Material removed from the facility is defined as waste by the Department of Environmental Quality (DEQ). Refer to the roadwaste section of the ODOT Maintenance Yard Environmental Management System (EMS) Policy and Procedures Manual for disposal options:

http://www.oregon.gov/ODOT/Maintenance/Documents/ems_manual.pdf


Contact any of the following for more detailed information about management of waste materials found on site:

ODOT Clean Water Unit	(503) 986-3008
ODOT Statewide Hazmat Coordinator	(503) 667-7442
ODOT Region 1 Hazmat Coordinator	(503) 731-8290
ODOT Region 2 Hazmat Coordinator	(503) 986-2647
ODOT Region 3 Hazmat Coordinator	(541) 957-3594
ODOT Region 4 Hazmat Coordinator	(541) 388-6186
ODOT Region 5 Hazmat Coordinator	(541) 963-1590
ODEQ Northwest Region Office	(503) 229-5263


A Appendix A – Site Specific Operational Plan

Contents:


Operational Plan: DFI D00215

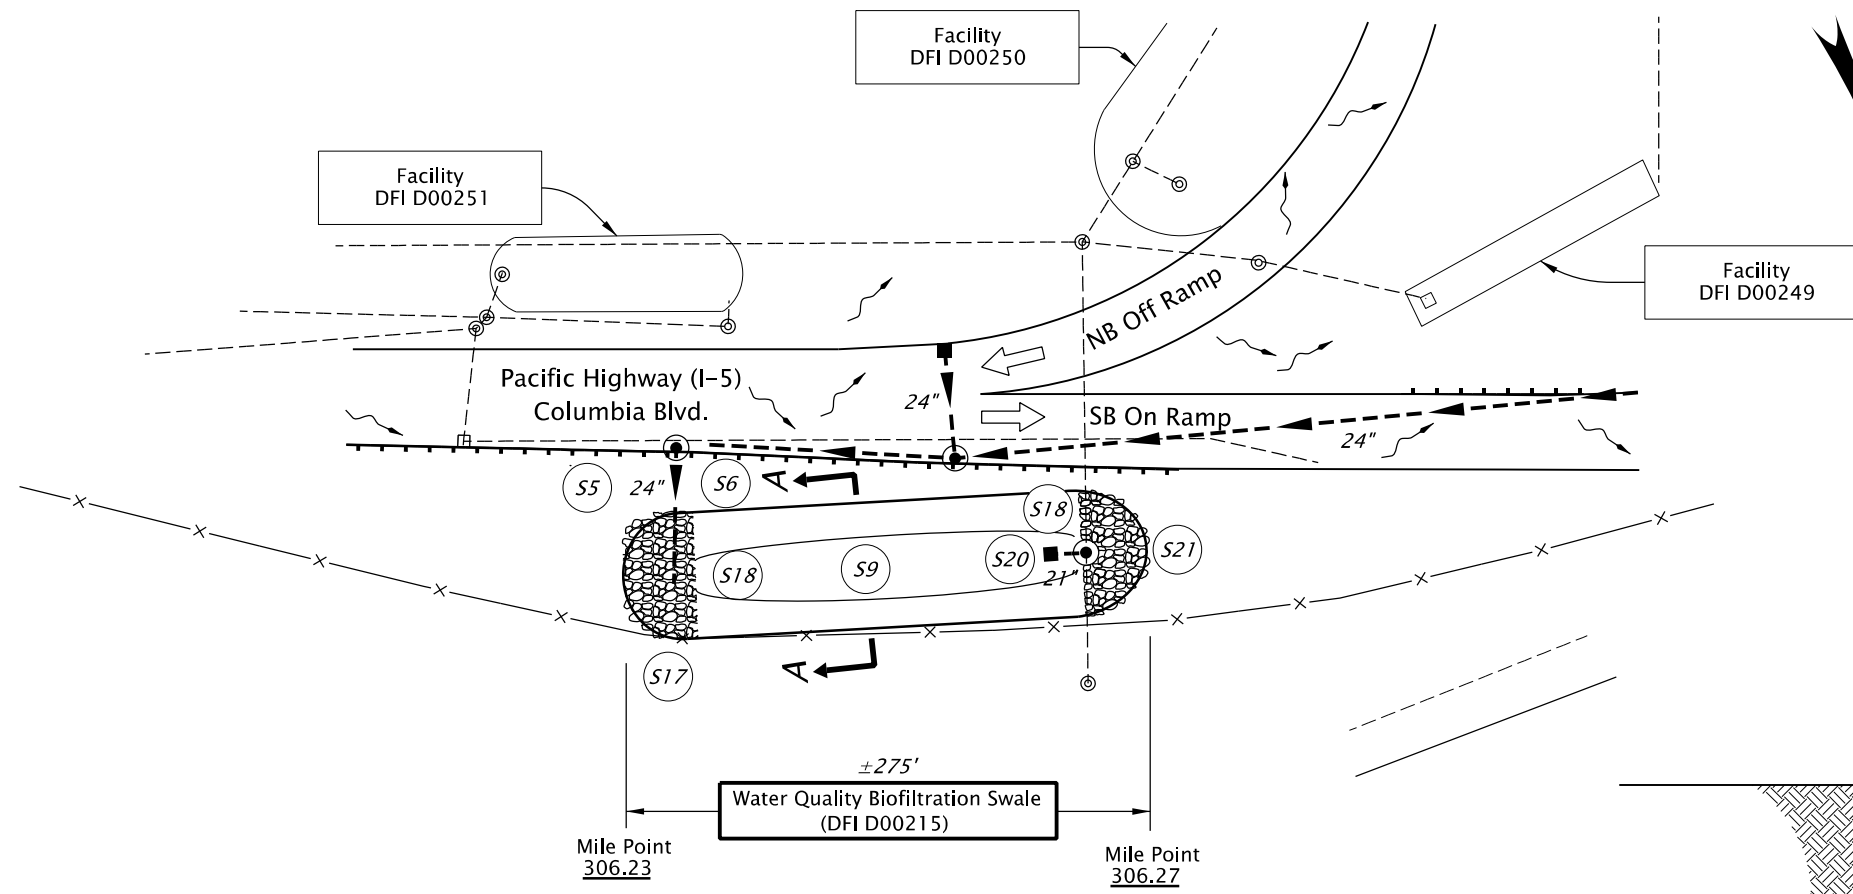

PLAN
N.T.S.

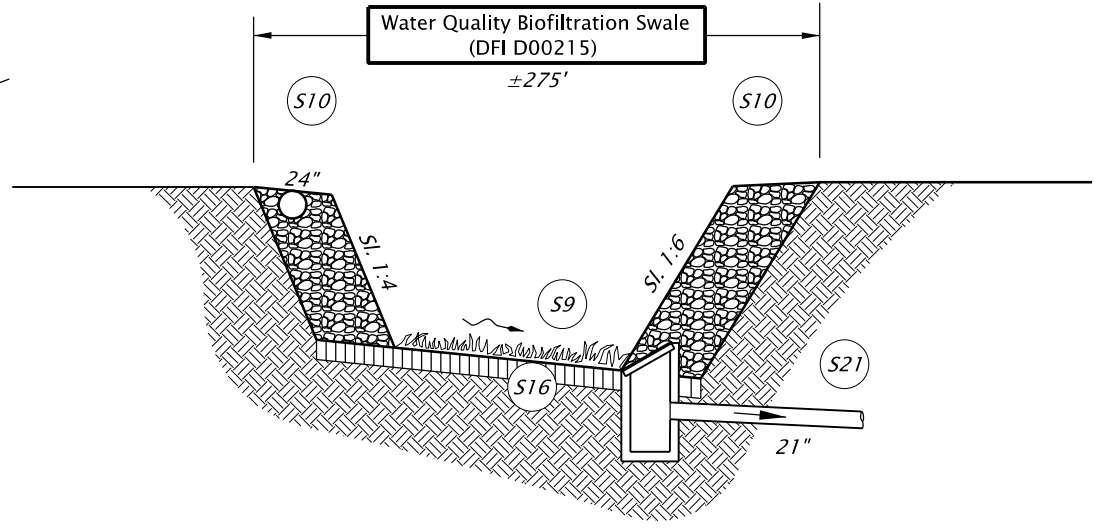

PROFILE
N.T.S.

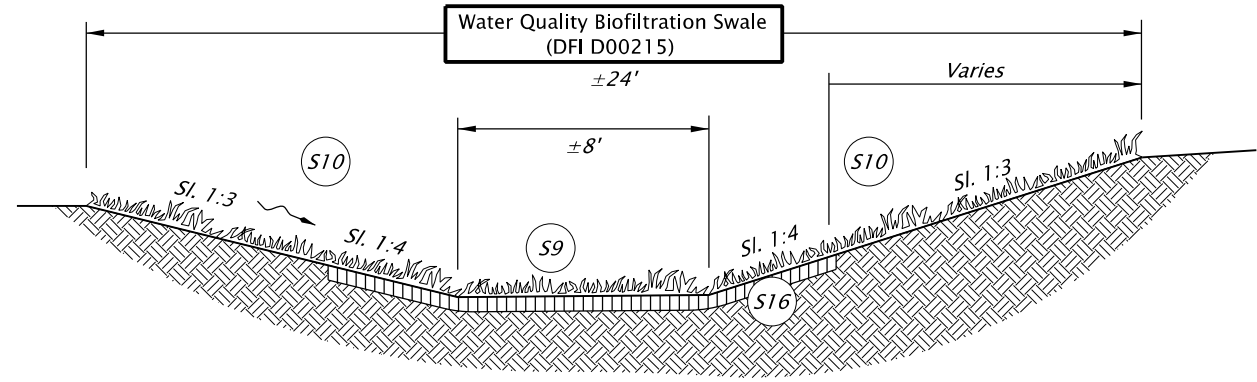

SECTION A-A
N.T.S.

- LEGEND:
- (S#) Facility Component (see table 1 in O&M Manual)
 - or ○ Manhole
 - or □ Inlet
 - Storm Pipe (Facility)
 - Storm Pipe
 - Conveyance Direction
 - ~ Pavement / Facility Flow Path
 - ← Traffic Flow Direction



Prepared By:
Jenn Mora

Drafted By:
Jenn Mora

DFI D00215
MAINTENANCE DISTRICT 2B HWY 001
WATER QUALITY BIOFILTRATION SWALE
 HIGHWAY MP 306.23 - 306.27
 MULTNOMAH COUNTY

B Appendix B – Project Contract Plans

Contents:


Site Specific Subset of Project Contract Plan 41v-002

STATE OF OREGON
DEPARTMENT OF TRANSPORTATION
PLANS FOR PROPOSED PROJECT

GRADING, DRAINAGE, STRUCTURES, PAVING, SIGNING,
ILLUMINATION, SIGNALS & ROADSIDE DEVELOPMENT

I-5: VICTORY BLVD. TO LOMBARD ST. SECTION
PACIFIC HIGHWAY
MULTNOMAH COUNTY
JANUARY 2008

INDEX OF SHEETS	
SHEET NO.	DESCRIPTION
1	Title Sheet
1A, 1A-2	Index Of Sheets Cont'd.
1B	Std. Drg. Nos.
1C	Sheet Layout
1D	Survey Control Network
1E	Survey Control Chart

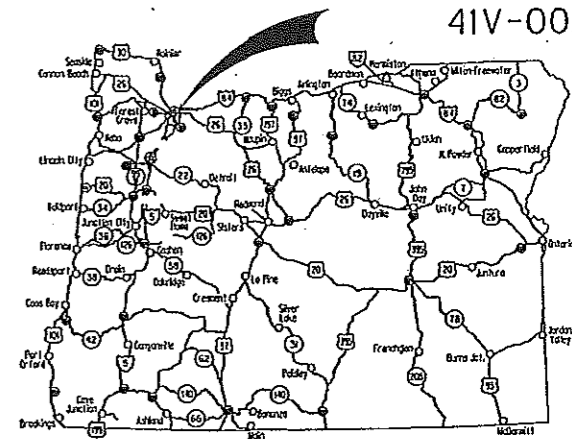


Overall Length Of Project - 1.22 Miles

ATTENTION:
Oregon Law Requires You To Follow Rules Adopted By The Oregon Utility Notification Center. Those Rules Are Set Forth In OAR 952-001-0010 Through OAR 952-001-0090. You May Obtain Copies Of The Rules By Calling The Center. (Note: The Telephone Number For The Oregon Utility Center Is (503) 232-1987.)

"AS CONSTRUCTED"
Mike Bevan
Date 11/26/14 Project Mgr

BEGINNING OF PROJECT
IM-STP-S001(258)
STA. "L2" 129+93.4 (M.P. 306.70)

END OF PROJECT
IM-STP-S001(258)
STA. "L2" 193+92.8 (M.P. 305.48)

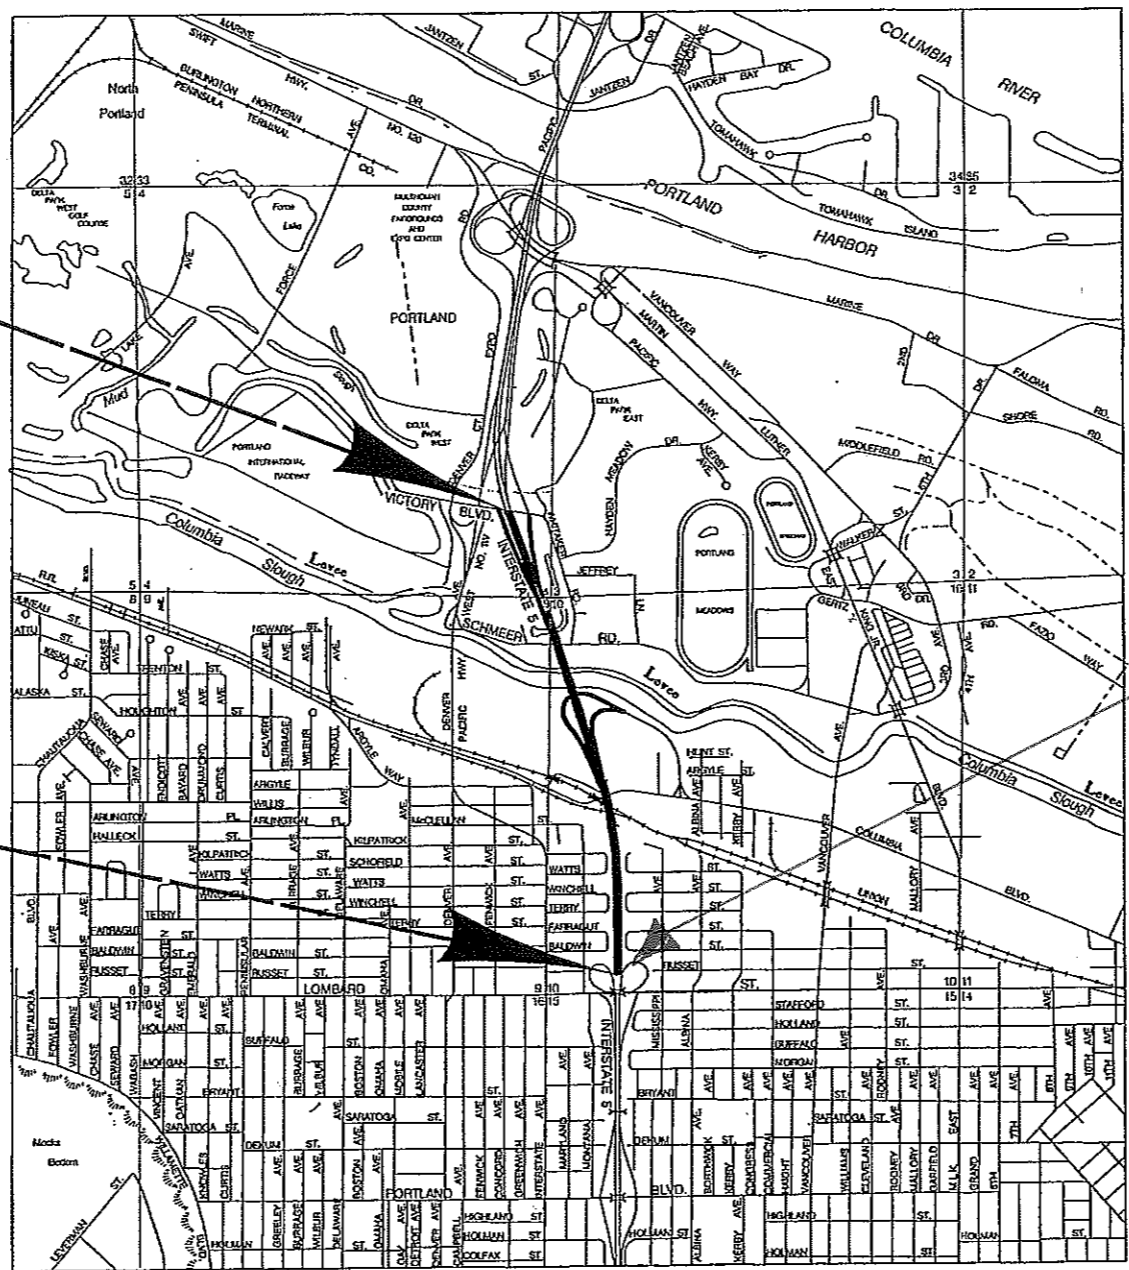

Additional work was done in each of the Lombard loops. This included burial of soil that was contaminated.



- OREGON TRANSPORTATION COMMISSION**
- Stuart Foster CHAIRMAN
 - Gail L. Achterman COMMISSIONER
 - Mike Nelson COMMISSIONER
 - Randall Pope COMMISSIONER
 - Janice J. Wilson COMMISSIONER
 - Matthew L. Garrett DIRECTOR OF TRANSPORTATION

PLANS PREPARED FOR
OREGON DEPARTMENT OF TRANSPORTATION
BY:
DAVID EVANS AND ASSOCIATES INC.




OREGON DEPARTMENT OF TRANSPORTATION
CONCURRENCE
TECHNICAL SERVICES MANAGING ENGINEER DATE 12-07

I-5: VICTORY BLVD. TO LOMBARD ST. SECTION PACIFIC HIGHWAY MULTNOMAH COUNTY		
FEDERAL HIGHWAY ADMINISTRATION	PROJECT NUMBER	SHEET NO.
OREGON DIVISION	IM-STP-S001(258)	1



Sec. 3, 4, 9, 10, T. 1 N., R. 1 E., W.M.

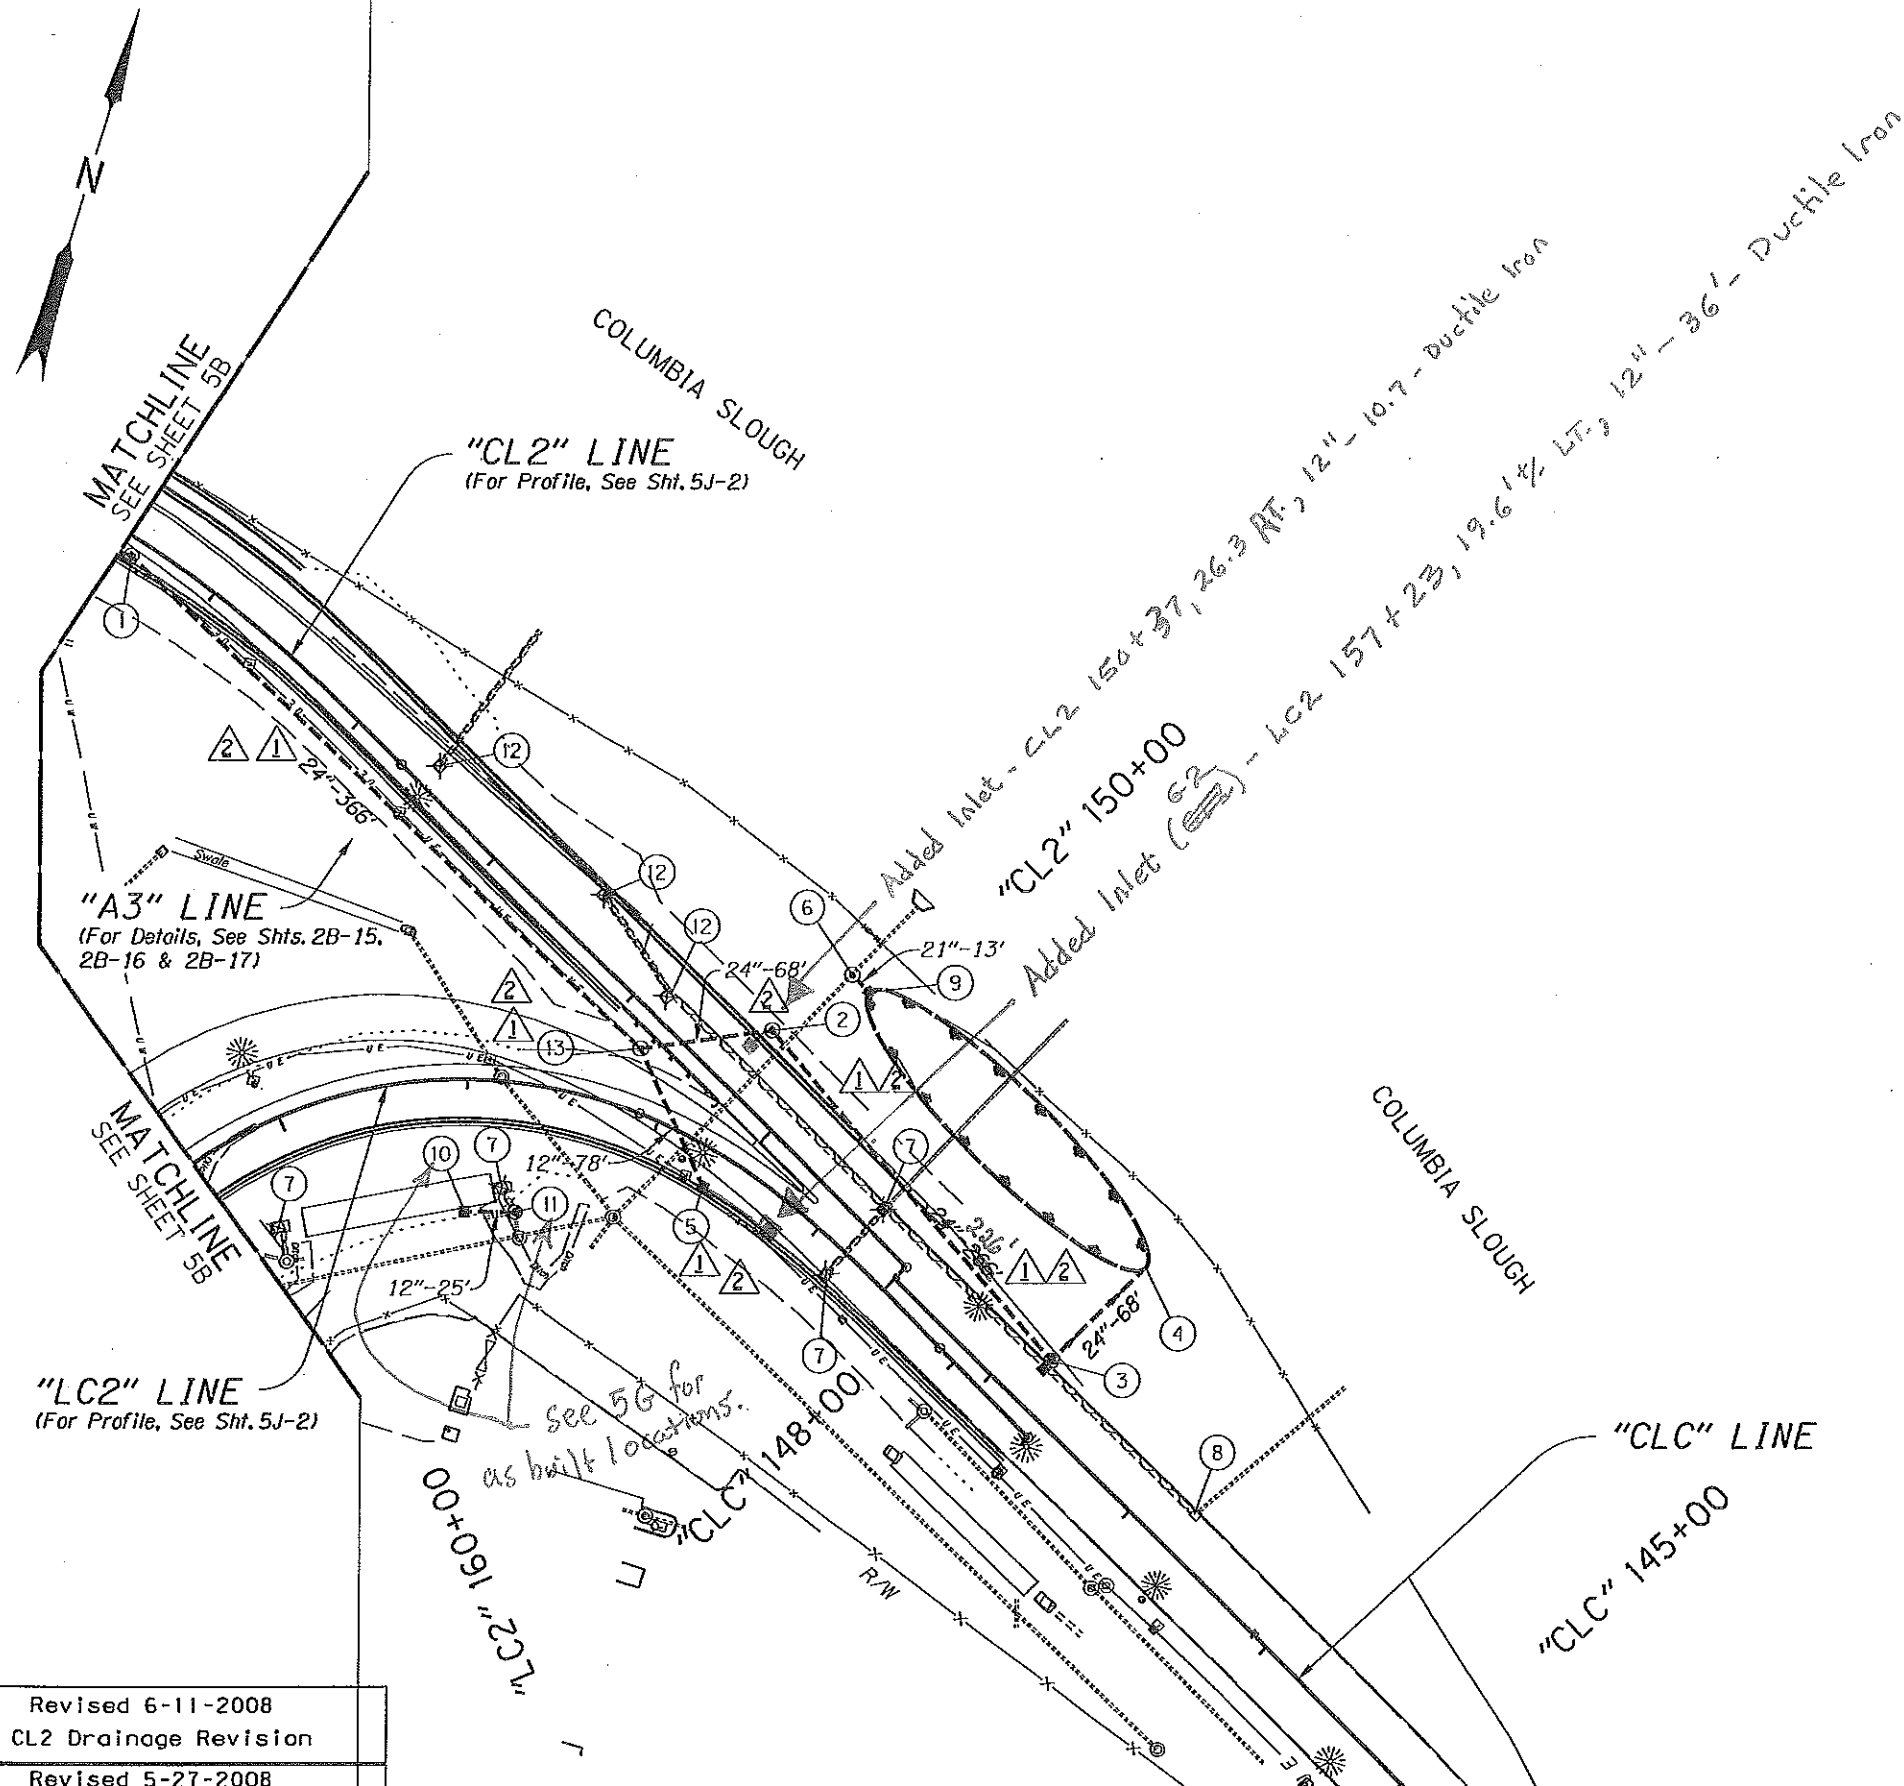

"AS CONSTRUCTED"
Mark Burn
 Date 11/26/14 Project Mgr

Remove or Abandon Pipe
 Shown Thus:

	Revised 6-11-2008 CL2 Drainage Revision
	Revised 5-27-2008 CL2 Drainage Revision

REVISED DRAINAGE PLAN
 DRAINAGE AND UTILITIES

① Sta. "CL2" 154+45, Lt.
 Const. Manhole with Type "G-2" Inlet
 Inst. 24" Storm Sew. Pipe - 145'
 10' Depth
 Const. Subsurface Drain Pipe - 477'
 Const. Subsurface Drain Outlet

A 60" M.H. was constructed here

② Sta. "CL2" 150+37, 37'
 Const. Manhole
 Inst. 24" Storm Sew. Pipe - 68'
 20' Depth

Inlet at CL2 150+37, 26.3 LT.
 12" Ductile Iron - 10.7'

③ Sta. "CL2" 148+12, = LC2 155+64, 32.7 Rt.
 Const. (60" Dia.) Manhole with Type "G-2" Inlet
 Inst. 24" Storm Sew. Pipe - 226'
 20' Depth
 (See Drg. No. RD346)

④ Sta. "LC2" 155+63, 102' Rt.
 Const. Water Quality Swale #1
 Inst. 24" Storm Sew. Pipe - 68'
 20' Depth
 (See Drg. No. RD1055)
 (For Details, See Sht. GJ-2 and GJ-3)

⑤ Sta. "CL2" 150+04, 45' Lt. = "LC2" 157+61, 20' Lt.
 Const. Type "G-2" Inlet
 Const. Subsurface Drain Pipe - 92'
 Const. Subsurface Drain Outlet

ADDED G-2 Inlet @ LC2 157+23 (see SF)

⑥ Sta. "CL2" 150+25, 87' Rt.
 Const. Large Precast Manhole (84" Dia.) Over Exlg. 54" CMP
 Inst. 21" Storm Sew. Pipe - 13'
 10' Depth

⑦ Abandon Inlet - 4

⑧ Protect Exlg. Inlet


⑨ Sta. "CL2" 150+12, 87' Rt.
 Const. Type "M-E" Inlet

⑩ Sta. "LC2" 159+00, 70' Lt. 158+96.41, 75.24' Lt.
 Const. Type "G-2" Inlet (G-2 - MA)
 (See Drg. No. RD370)

⑪ Sta. "LC2" 158+80, 70' Lt. 158+64.26, 68.35' Lt.
 Connect to Exlg. Manhole
 Inst. 12" Storm Sew. Pipe - 25'
 5' Depth

⑫ Remove Inlet - 3

⑬ Sta. "CL2" 150+78, 17.3' Lt.
 Const. Manhole
 Inst. 12" Storm Sew. Pipe - 78'
 5' Depth
 Inst. 24" Storm Sew. Pipe - 366'
 20' Depth

"AS CONSTRUCTED"

 Date 11/26/14 Project Ring

TROUTDALE CONSTRUCTION OFFICE
 Revised 6-20-2008
 ③ LC2 Station correction


TROUTDALE CONSTRUCTION OFFICE
 Revised 6-11-2008
 ② CL2 Drainage Revision
 Revised 5-27-2008


① CL2 Drainage Revision

REVISED DRAINAGE NOTES


DRAINAGE AND
 UTILITIES NOTES

5G

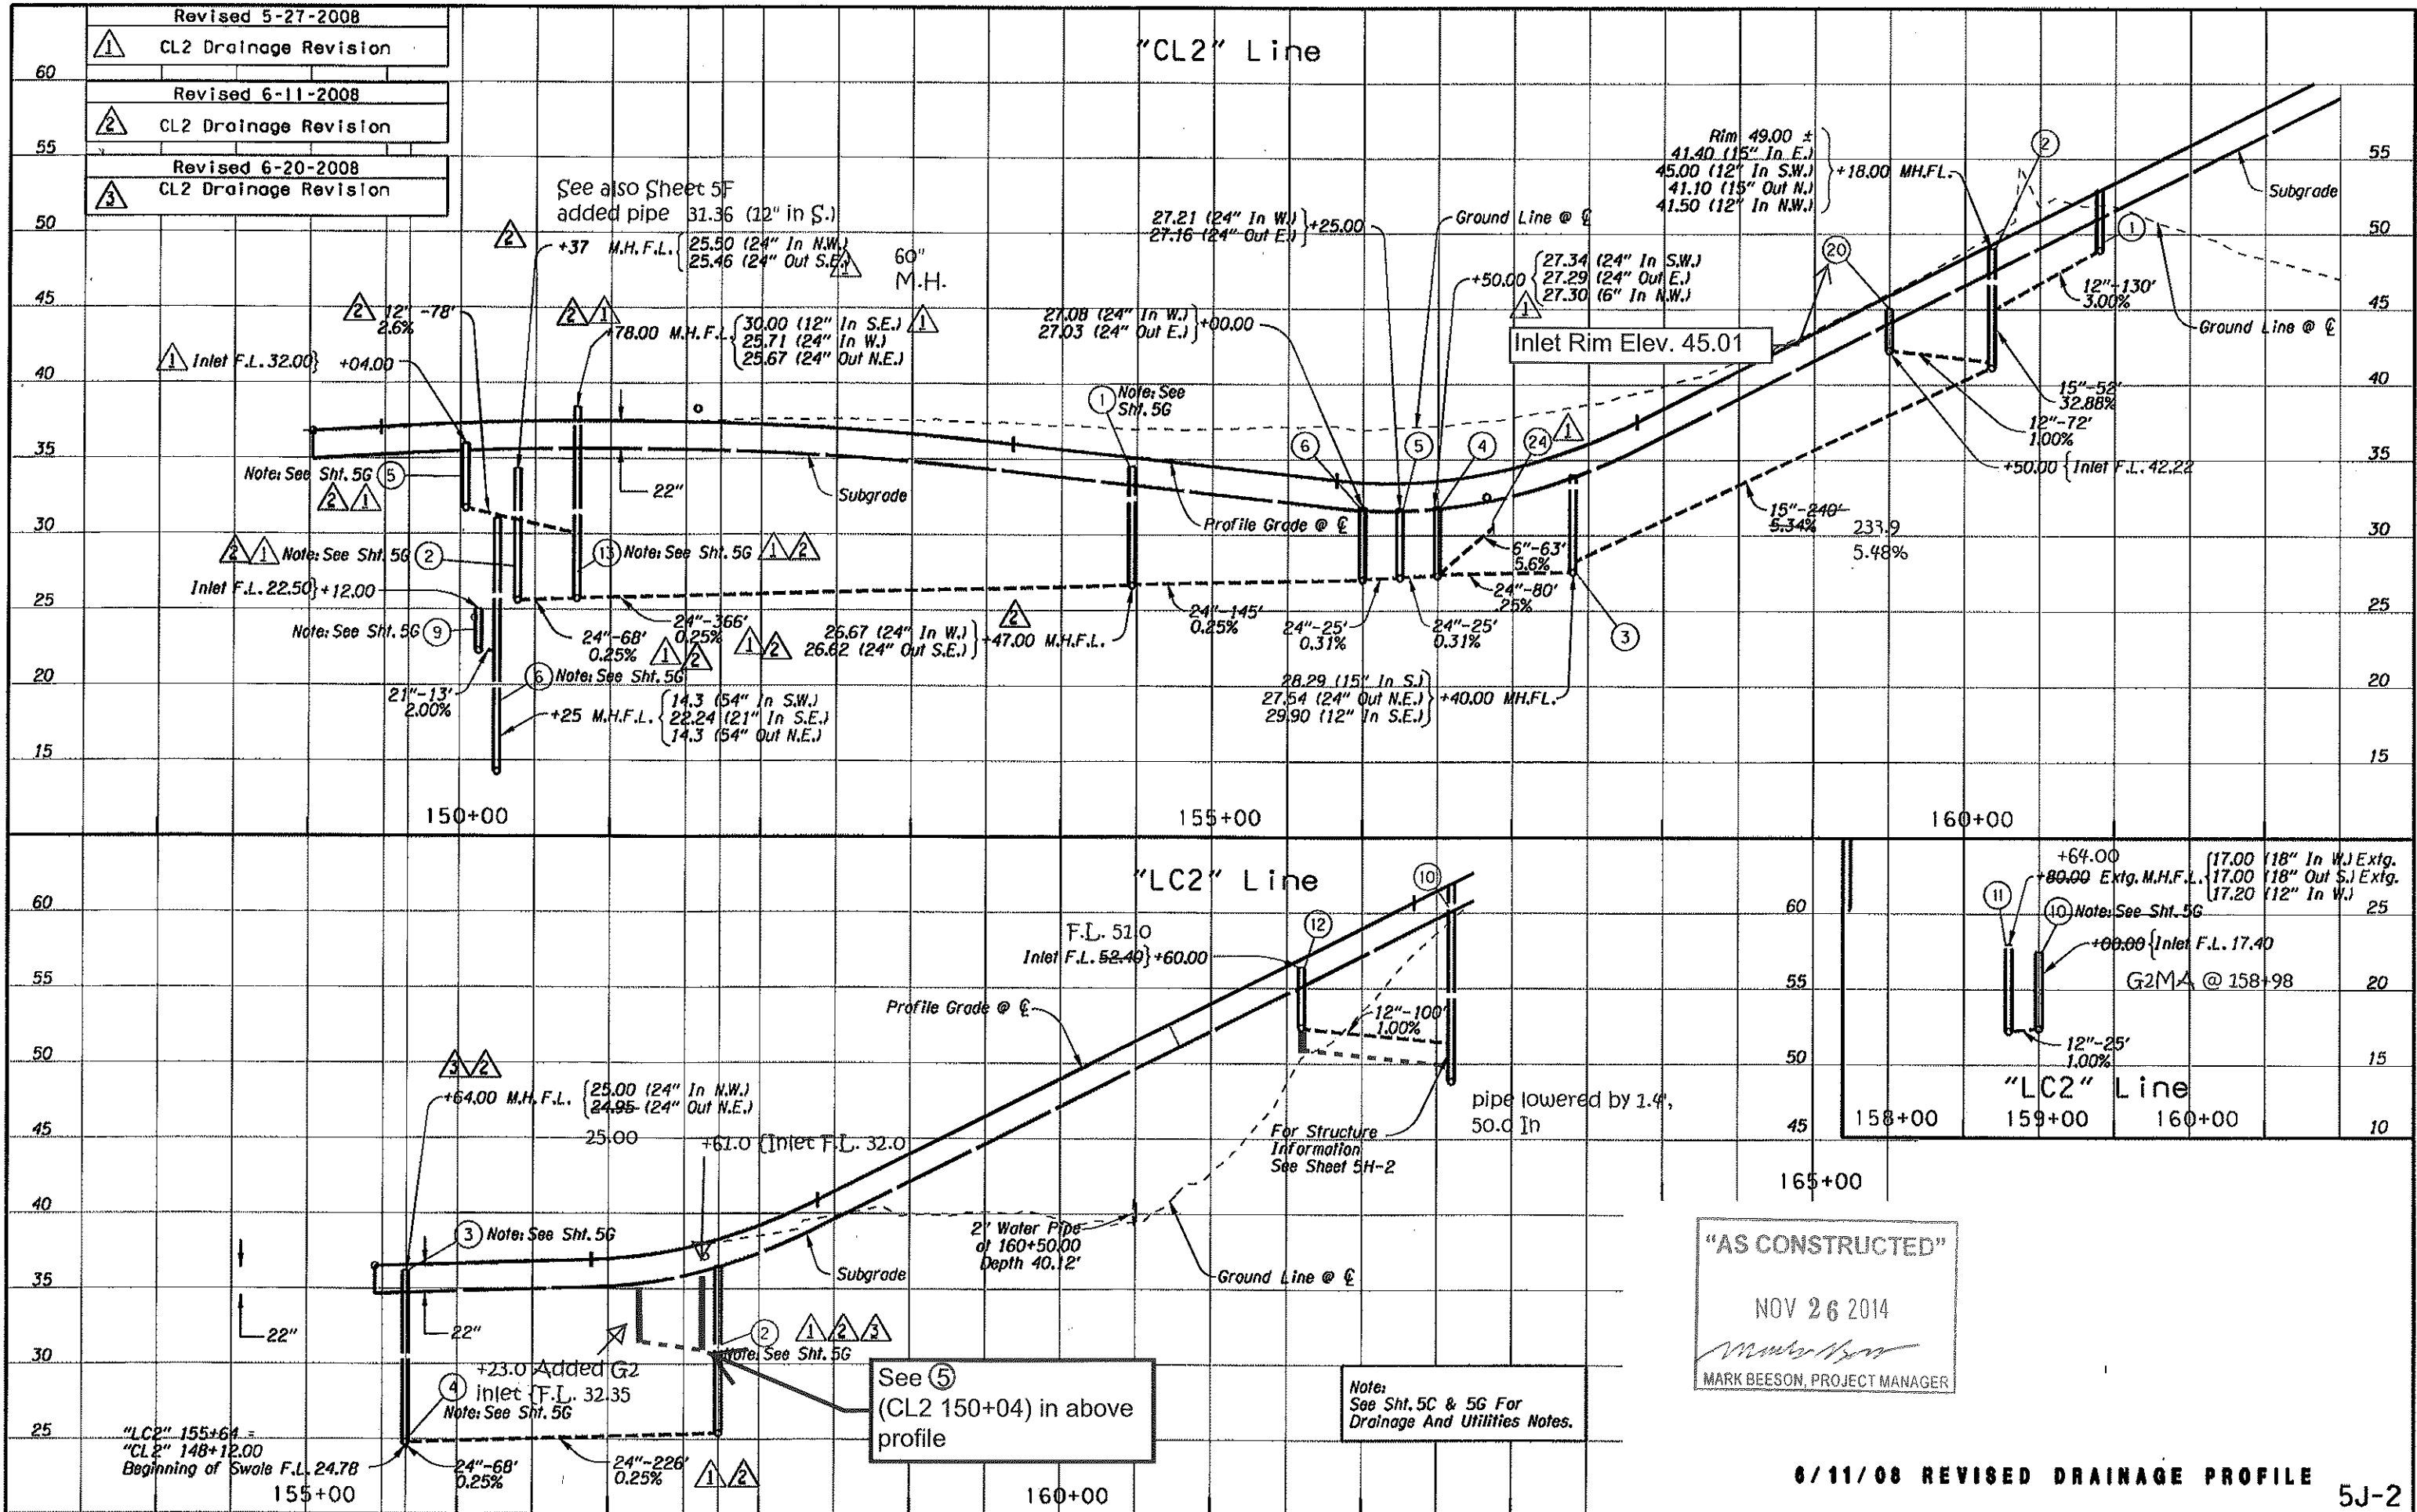


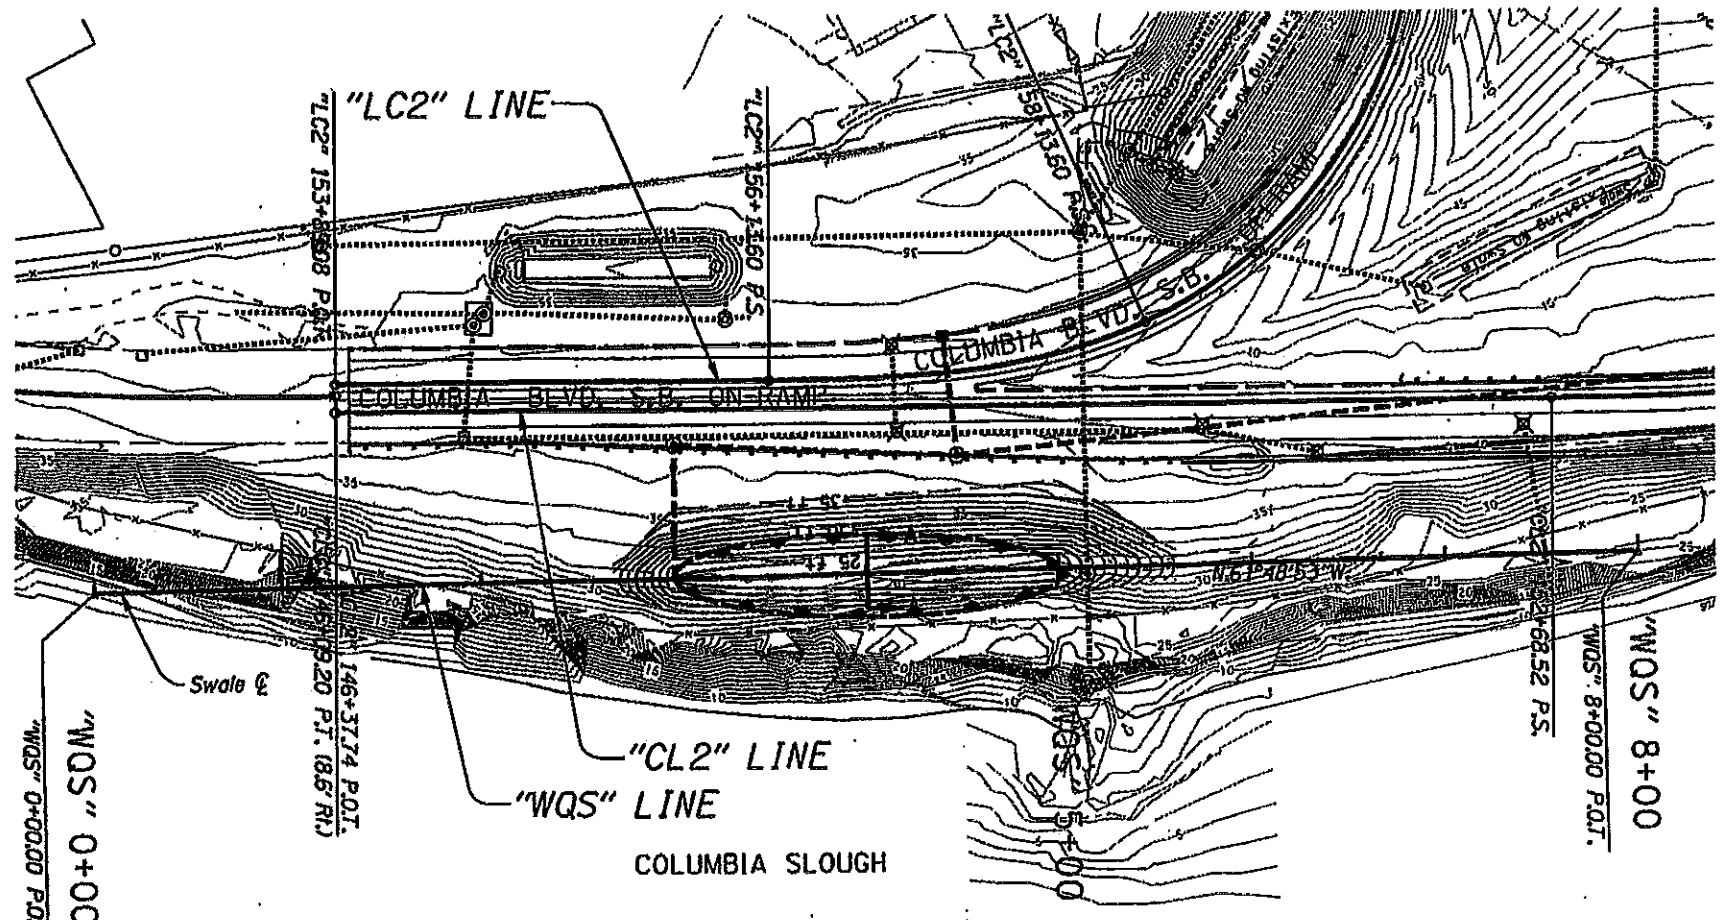

SWALE GRADING PLAN

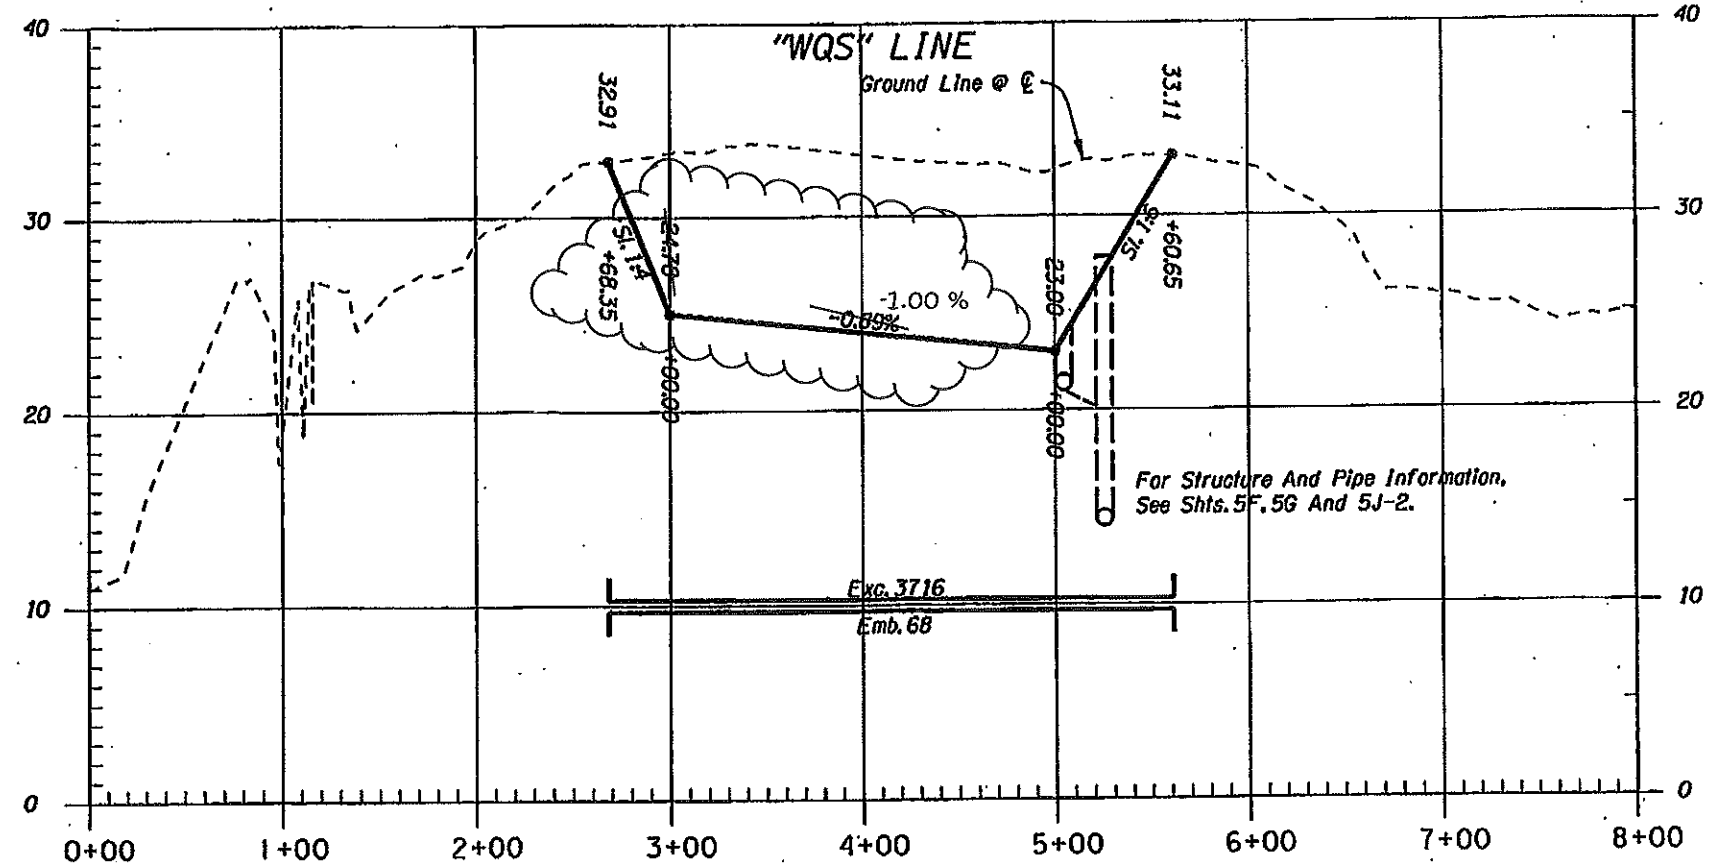


SWALE PROFILE

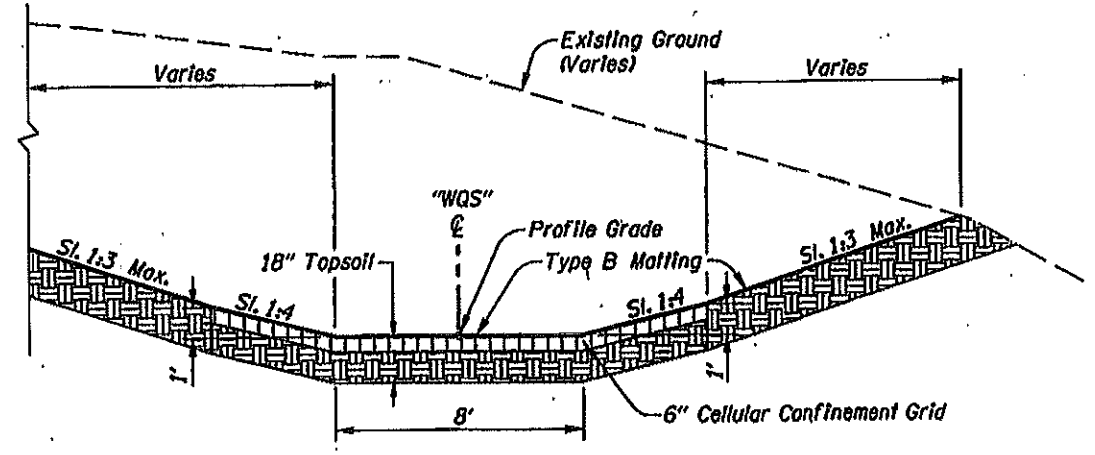



Water Quality Swale SECTION A-A (TYPICAL)

"AS CONSTRUCTED"
 NOV 26 2014
Mark Beeson
 MARK BEESON, PROJECT MANAGER



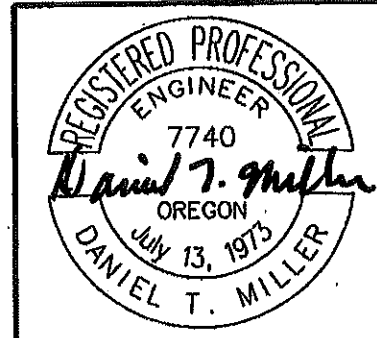


EXPIRES 12-31-08

OREGON DEPARTMENT OF TRANSPORTATION	
DAVID EVANS AND ASSOCIATES, INC. 2100 Southwest River Parkway Portland Oregon 97201 Ph: 503.223.6663	
1-5: VICTORY BLVD. TO LOMBARD ST. SECTION PACIFIC HIGHWAY MULTNOMAH COUNTY	
Reviewed By - <i>Chris Higgins</i> CAH Designed By - <i>Don Miller</i> Drafted By - <i>Mike Youngs</i>	
WATER QUALITY SWALE #1	SHEET NO. GJ-2

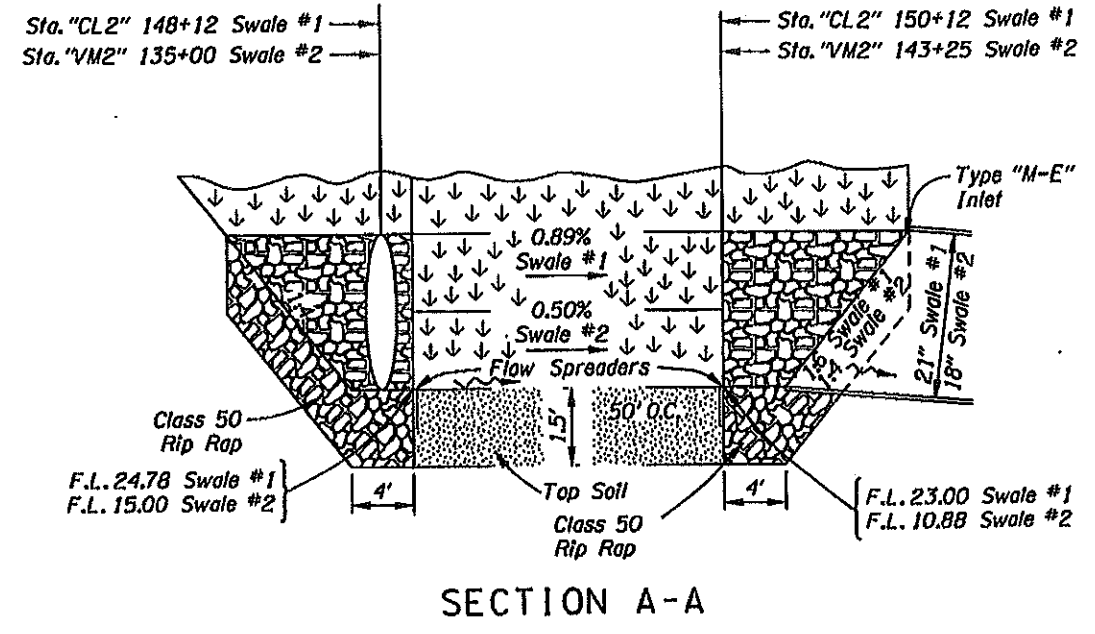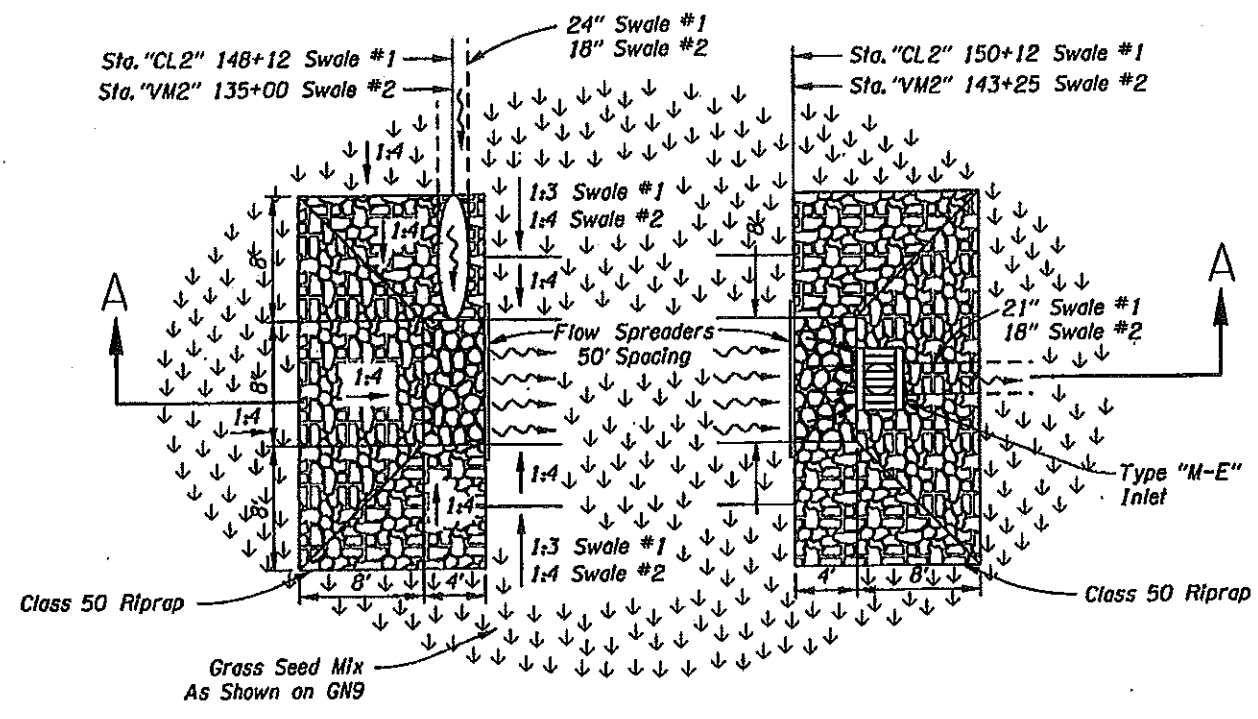

RIPRAP BASINS FOR UPSTREAM AND DOWNSTREAM END FOR SWALES 1 & 2

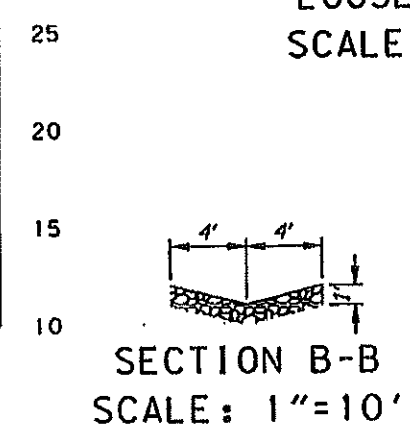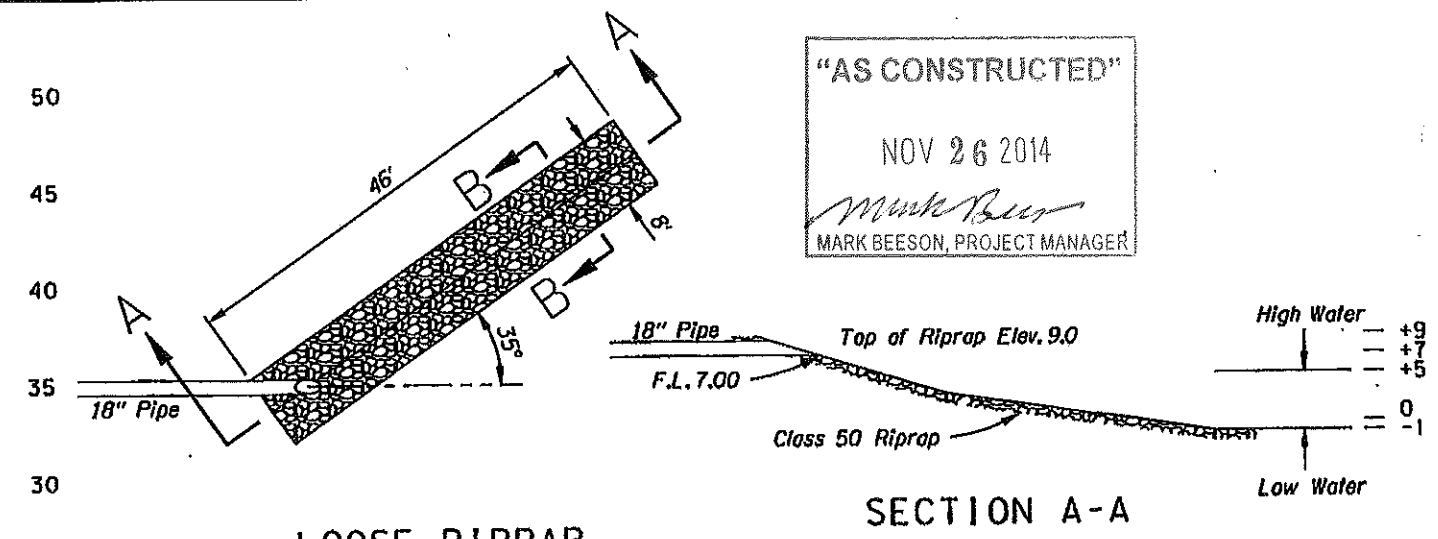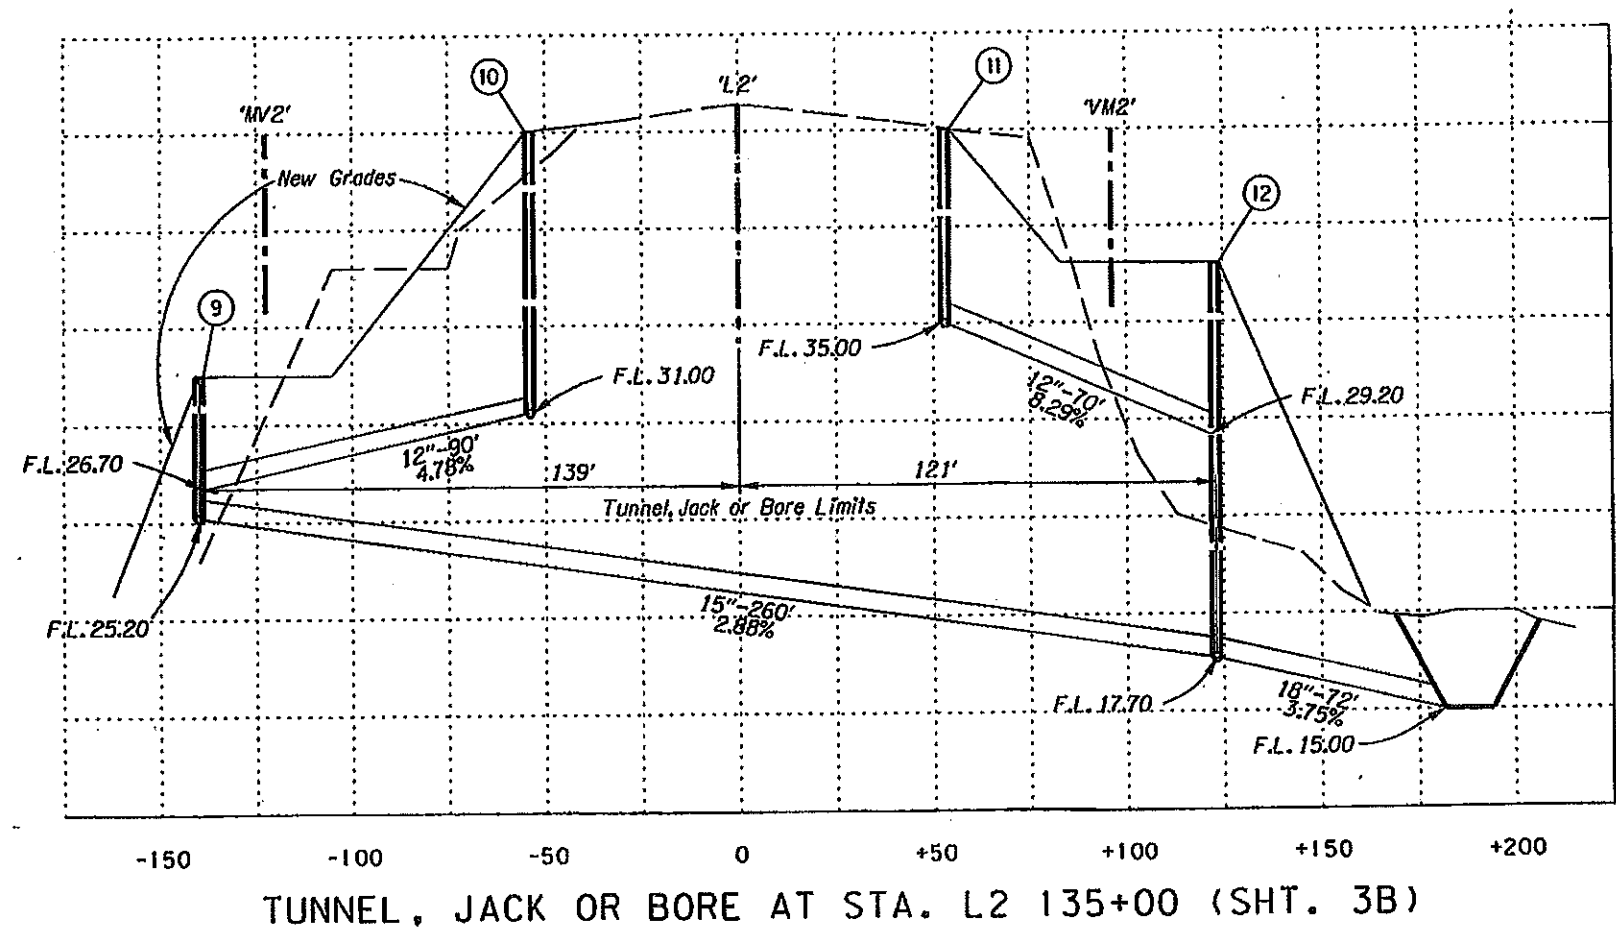

OREGON DEPARTMENT OF TRANSPORTATION

Ukiah Engineering, Inc.

1-5: VICTORY BLVD. TO LOMBARD ST. SECTION
PACIFIC HIGHWAY
MULTNOMAH COUNTY

Reviewed By - CHRIS STEINBRECHER
Designed By - DAN MILLER
Drafted By - STERLIN DRIGGS

DRAINAGE DETAILS

SHEET NO. **GJ-3**