

# OPERATION & MAINTENANCE MANUAL

## Water Quality Biofiltration Swale

Manual prepared: May 2018  
Revised: September 2023

DFI No. D00216



Figure 1: DFI No. D00216, looking south.

## Identification

Drainage Facility ID (DFI): D00216  
Facility Type: Water Quality Biofiltration Swale  
Construction Drawings: (V-File Numbers) 41V-002  
Location: District: 2B  
Highway No.: 001  
Mile Post: 306.60 to 306.44, RT

### 1. Manual Purpose

The purpose of this manual is to outline inspection needs and summarize maintenance actions.

### 2. Facility Location

The location map below details the facility location. The highway, mile posts, side streets, access location, and stormwater flow directions are noted on the map.

Facility location type: On ramp

Flow direction: Southeast




Figure 2: Facility location map

### 3. Facility Summary

The length and width of a swale is based on the bottom dimensions.

The bottom length and bottom width of the swale is:


Bottom Length (feet)	Bottom Width (feet)
850	24

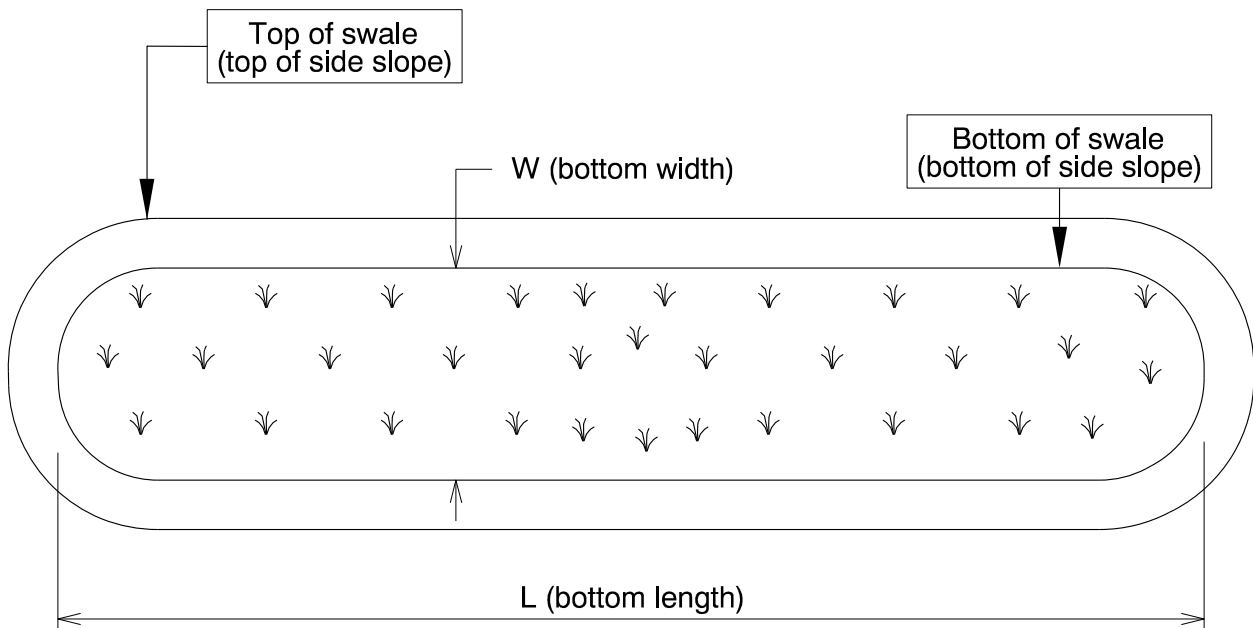

The depth of the swale is the vertical distance measured from the bottom of the swale to the top. The slope of the swale sides is presented by a vertical distance (rise) followed by the horizontal distance (run).

Depth and side slopes:

Depth (feet)	Rise (feet)	Run (feet)
3	1	4

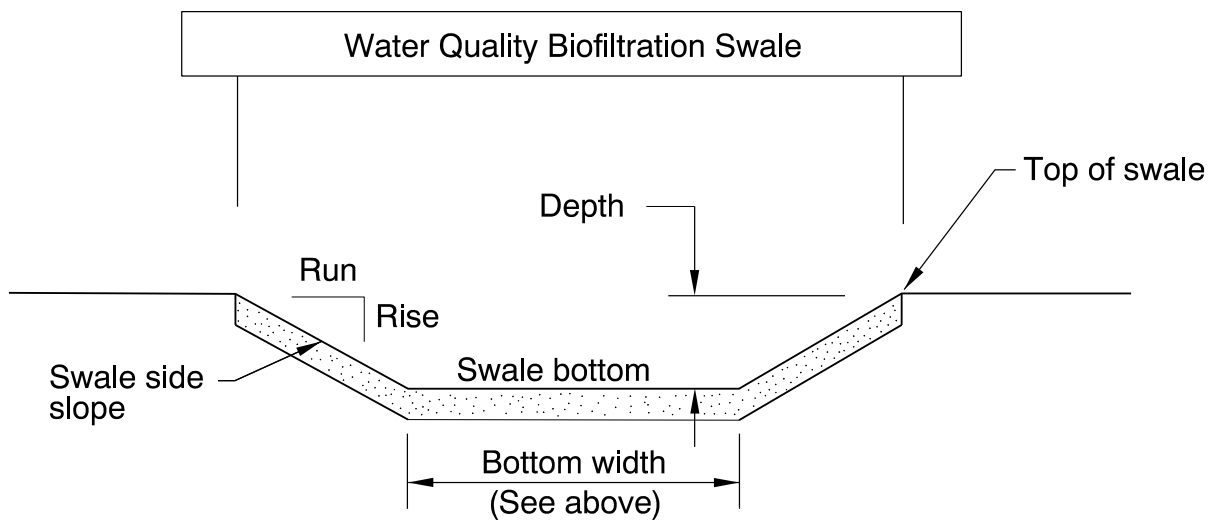

**Site Specific Information:** Facility is located west of I-5 (Hwy 001), adjacent to a maintenance access road located between the N. Victory Blvd. Southbound On-ramp and N. Denver Ave.

#### 4. Facility Access

Maintenance access to the facility:

<input type="checkbox"/> Roadside pad	<input type="checkbox"/> Roadside shoulder
<input type="checkbox"/> Access road with Gate	<input checked="" type="checkbox"/> Access road without Gate



Figure 3: Maintenance Access Road entrance, facing South from N. Victory Blvd.

#### 5. Operational Components / Maintenance Items

##### Classification

This facility is classified as an:

<input checked="" type="checkbox"/> <b>On-line Swale</b>	<input type="checkbox"/> <b>Off-line Swale</b>
A swale that does not include a high flow bypass component; flow drains into and through the facility	A swale that treats low/small flows and diverts high flows using a bypass component

## Bypass Component

This facility includes a high flow bypass component:

<input checked="" type="checkbox"/> No	<input type="checkbox"/> Yes
There is no bypass component. High flows drain into and through the facility	There is a bypass component. Only low/small flows drain into the swale. High flows are diverted around the swale using a bypass component

## Operational Components

A swale has many components that assist with treatment, conveyance, and reducing flow velocity to minimize erosion. The components in use can vary depending if the facility was designed to operate on-line or off-line. The facility components table (**Table 1**) has been provided to highlight the applicable components for this facility. The component is in use when the box contains an “x” (e.g.  ).

The Standard Operation Manual for Water Quality Biofiltration Swales (implemented March 2017) outlines facility operation, typical footprint configuration, and component definitions and details. A link to the manual is attached to the feature marker in TransGIS.

<https://gis.odot.state.or.us/TransGIS/>

## Operational Plan

The applicable standard operational plan for this facility is:

<input type="checkbox"/> Operational Plan A	<input checked="" type="checkbox"/> Operational Plan B	<input type="checkbox"/> Operational Plan C
A standard operational plan illustrates the general facility footprint configuration and explains the purpose of each facility component. Operational plans (A, B, C) are provided in the Standard Operation Manual.		

See Appendix A for the site specific operational plan.

## Maintenance Items

Operational components marked in **Table 1** should be inspected and maintained according to Section 7. Each facility component is defined and detailed in the Standard Operation Manual using the associated ID number indicated below.

<b>Table 1: Swale Components</b>		<b>ID #</b>
<b>Manholes/Structures</b>		
Pre-treatment manhole	<input type="checkbox"/>	<b>S1</b>
Weir type flow splitter/flow splitter manhole	<input type="checkbox"/>	<b>S2</b>
Orifice type flow splitter/flow splitter manhole	<input type="checkbox"/>	<b>S3</b>
Standard manhole	<input checked="" type="checkbox"/>	<b>S4</b>
<b>Swale Inlet</b>		
Pavement sheet flow	<input checked="" type="checkbox"/>	<b>S5</b>
Inlet Pipe (s)	<input checked="" type="checkbox"/>	<b>S6</b>
Open channel inlet	<input type="checkbox"/>	<b>S7</b>
Riprap pad	<input checked="" type="checkbox"/>	<b>S8</b>
<b>Ground Cover</b>		
Grass bottom	<input checked="" type="checkbox"/>	<b>S9</b>
Grass side slopes	<input checked="" type="checkbox"/>	<b>S10</b>
Granular drain rock	<input type="checkbox"/>	<b>S11</b>
Plantings	<input type="checkbox"/>	<b>S12</b>
<b>Underground Components</b>		
Geotextile fabric	<input checked="" type="checkbox"/>	<b>S13</b>
Water quality mix	<input type="checkbox"/>	<b>S14</b>
Perforated pipe	<input type="checkbox"/>	<b>S15</b>
Porous pavers (access grid)	<input checked="" type="checkbox"/>	<b>S16</b>
<b>Flow Spreader</b>		
Rock basin (used at inlet)	<input checked="" type="checkbox"/>	<b>S17</b>
Anchored board (midpoint of swale or every 50 feet along swale bottom)	<input checked="" type="checkbox"/>	<b>S18</b>
Other:	<input type="checkbox"/>	<b>S19</b>
<b>Swale Outlet</b>		
Catch basin with grate	<input checked="" type="checkbox"/>	<b>S20</b>
Outlet Pipe (s)	<input checked="" type="checkbox"/>	<b>S21</b>
Open channel outlet	<input type="checkbox"/>	<b>S22</b>
Auxiliary Outlet:	<input type="checkbox"/>	<b>S23</b>
<b>Outfall Type</b>		
Waterbody (Creek/Lake/Ocean)	<input type="checkbox"/> C	<b>S24</b>
	<input type="checkbox"/> L	
	<input type="checkbox"/> O	
Ditch	<input type="checkbox"/>	<b>S25</b>
Storm drain system	<input checked="" type="checkbox"/>	<b>S26</b>
<b>Outfall Components</b>		
Riprap pad	<input checked="" type="checkbox"/>	<b>S27</b>
Riprap bank protection	<input type="checkbox"/>	<b>S28</b>

## 6. Maintenance

### Maintenance Frequency/Maintain Records

- a. Inspect annually. Preferably prior to the rainy season.
- b. Clean and maintain as necessary. Refer to Activity 125 for conditions when maintenance is needed.
- c. Keep a record of inspections, maintenance, and repairs.

### Maintenance Guide/Maintenance Actions

The ODOT Routine Road Maintenance Water Quality and Habitat Guide (the *Blue Book*) outlines the standard maintenance actions for water quality facilities under Activity 125.

There are standard maintenance tables for standard ODOT designs. The maintenance tables describe the maintenance component, the defect or problem, the condition when maintenance is needed, and the recommended maintenance to correct the problem. Use the following tables to maintain ODOT swales:

- Table 1 (General Maintenance): Contains general maintenance and inspection guidelines that are applicable to all ODOT water quality facilities
- Table 3 (Maintenance of Water Quality or Biofiltration Swales): Contains maintenance information for swales

The *Blue Book* can be viewed at the following website:

[http://www.oregon.gov/ODOT/Maintenance/Documents/blue\\_book.pdf](http://www.oregon.gov/ODOT/Maintenance/Documents/blue_book.pdf)

## 7. Limitations

Access grid installed:

<input type="checkbox"/> No	<input checked="" type="checkbox"/> Yes
There are light duty porous pavers installed in this swale	

Swales are designed to allow equipment access along the bottom. If an access grid is **NOT** installed, vehicles entering the swale can create depressions (tire ruts), damage vegetation, and damage structural components (e.g. flow spreaders). These conditions may result in poor treatment and drainage performance.

Equipment wheels should be kept on the tops and side slopes. Mower arms may be run along the swale bottom.



## 8. Waste Material Handling

Material removed from the facility is defined as waste by the Department of Environmental Quality (DEQ). Refer to the roadwaste section of the ODOT Maintenance Yard Environmental Management System (EMS) Policy and Procedures Manual for disposal options:

[http://www.oregon.gov/ODOT/Maintenance/Documents/ems\\_manual.pdf](http://www.oregon.gov/ODOT/Maintenance/Documents/ems_manual.pdf)


Contact any of the following for more detailed information about management of waste materials found on site:

ODOT Clean Water Unit	(503) 986-3008
ODOT Statewide Hazmat Coordinator	(503) 667-7442
ODOT Region 1 Hazmat Coordinator	(503) 731-8290
ODOT Region 2 Hazmat Coordinator	(503) 986-2647
ODOT Region 3 Hazmat Coordinator	(541) 957-3594
ODOT Region 4 Hazmat Coordinator	(541) 388-6186
ODOT Region 5 Hazmat Coordinator	(541) 963-1590
ODEQ Northwest Region Office	(503) 229-5263

## **A Appendix A – Site Specific Operational Plan**

### **Contents:**

**Operational Plan: DFI D00216**

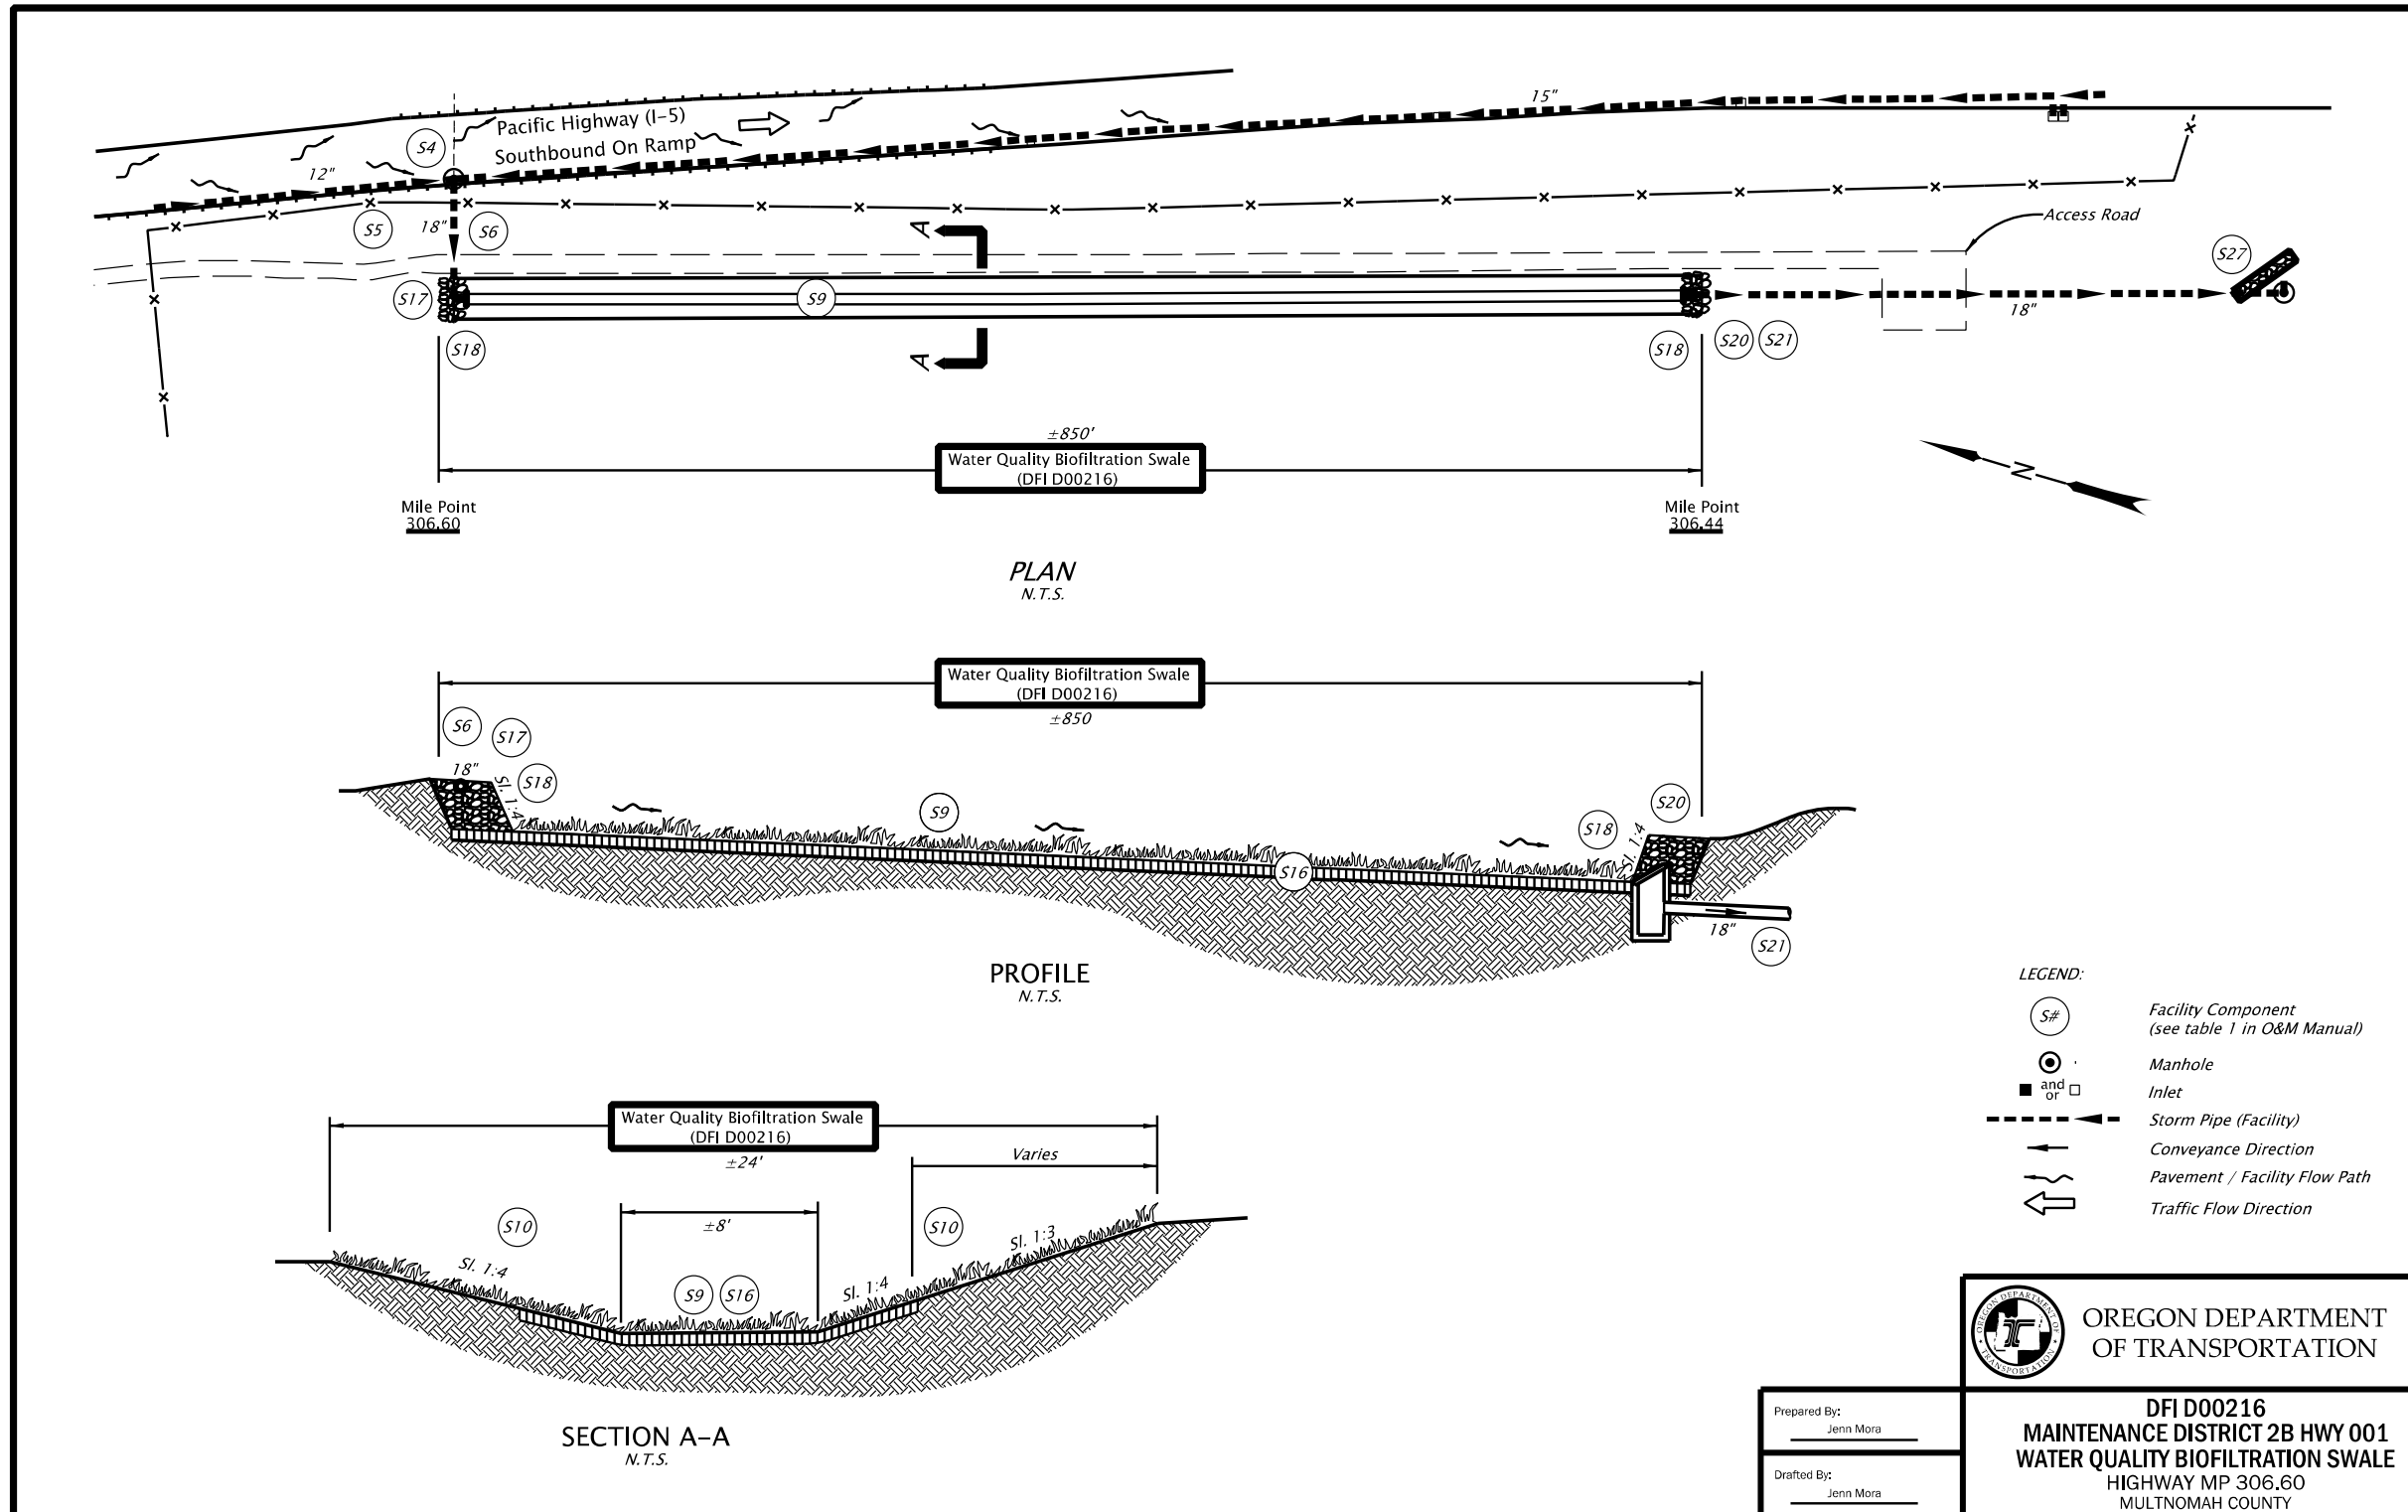

## **B Appendix B – Project Contract Plans**

### **Contents:**

**Site Specific Subset of Project Contract Plan 47V-099**

**Site Specific Subset of Project Contract Plan 41V-002**

INDEX OF SHEETS	
SHEET NO.	DESCRIPTION
1	Title Sheet
1A	Index Of Sheets Cont. & Std. Drg. Nos.
1A-2	Std. Drg. Nos. Cont.
1B	Sheet Layout
1C	Control Data Sheet

STATE OF OREGON  
DEPARTMENT OF TRANSPORTATION


PLANS FOR PROPOSED PROJECT

GRADING, DRAINAGE, STRUCTURES, PAVING, SIGNING,  
ILLUMINATION, SIGNALS & ROADSIDE DEVELOPMENT

**OR99W: N. VICTORY BLVD. - N. ARGYLE ST.  
(PORTLAND) SEC.**

**PACIFIC HIGHWAY WEST**

**MULTNOMAH COUNTY  
JULY 2014**

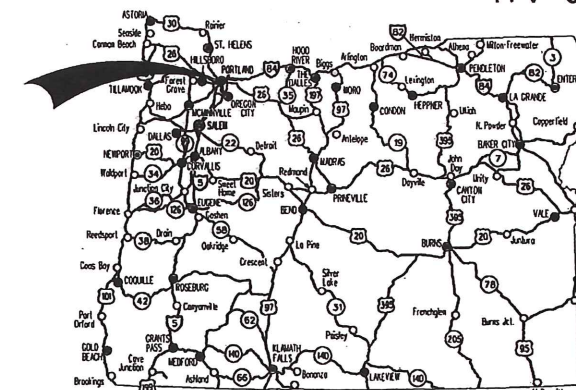

Overall Length Of Project - 0.75 Miles

*Adam Markell*  
**"AS CONSTRUCTED"**  
AUG 25 2017  
ADAM MARKELL,  
INTERIM PROJECT MANAGER


LET'S ALL  
WORK TOGETHER  
TO MAKE THIS  
JOB SAFE

**ATTENTION:**  
Oregon Law Requires You To Follow Rules  
Adopted By The Oregon Utility Notification  
Center. Those Rules Are Set Forth In  
OAR 952-001-0010 Through OAR 952-001-0090.  
You May Obtain Copies Of The Rules By Calling  
The Center. (Note: The Telephone Number For  
The Oregon Utility Center Is (503) 232-1987.)

**BEGINNING OF PROJECT**

**STP-S091(068)**

**STA. "99W" 51+60 (M.P. -5.50)**

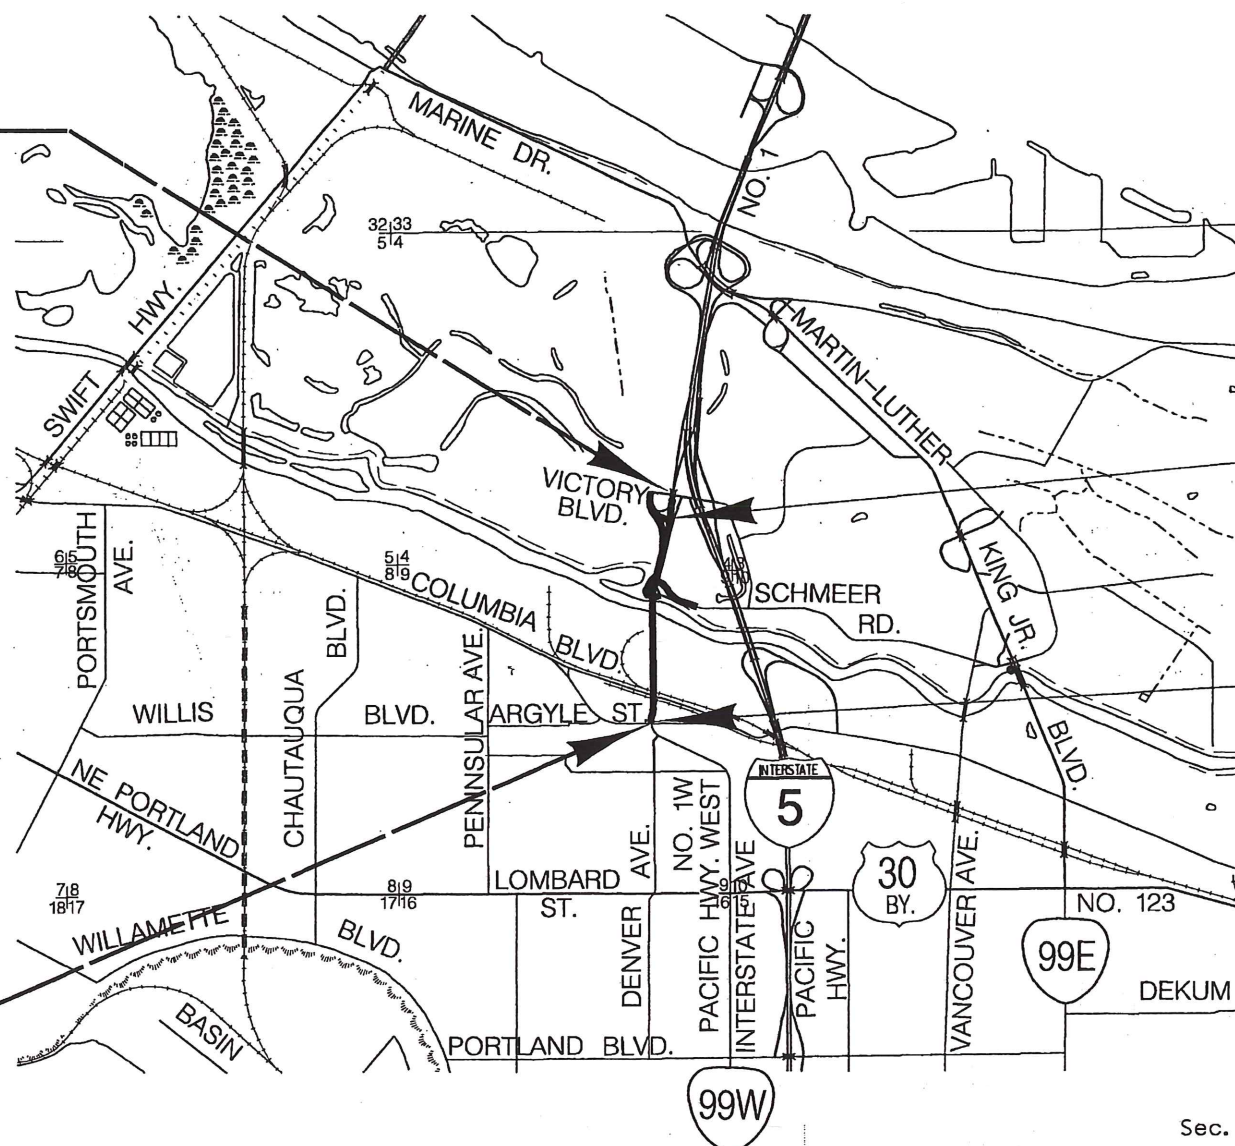

**PAVING LIMIT**

**STA. "99W" 56+00**

**PAVING LIMIT**

**STA. "99W" 91+00**

**END OF PROJECT**

**STP-S091(068)**

**STA. "99W" 91+54 (M.P. -4.75)**

OREGON TRANSPORTATION COMMISSION

Catherine Moter CHAIR  
David Lohmeyer COMMISSIONER  
Tommy Bone, COMMISSIONER  
Susan Morgan COMMISSIONER  
Alando Simpson COMMISSIONER  
Matthew L. Garrett DIRECTOR OF TRANSPORTATION

PLANS PREPARED FOR  
OREGON DEPARTMENT OF TRANSPORTATION

**HDR** HDR Engineering, Inc.

These plans were developed using ODOT design standards. Exceptions to these standards, if any, have been submitted and approved by the ODOT Chief Engineer or their delegated authority.

Approving Authority: *Brian R. Baker*  
Signature & date 6/2/14

BRIAN R. BAKER, P.E.,  
SR. PROJECT MANAGER,  
HDR ENGINEERING, INC.

Print name and title  
*Thomas J. Jones*  
Concurrence by ODOT Chief Engineer

**OR99W: N. VICTORY BLVD. - N. ARGYLE ST.  
(PORTLAND) SEC.  
PACIFIC HIGHWAY WEST  
MULTNOMAH COUNTY**

FEDERAL HIGHWAY ADMINISTRATION	PROJECT NUMBER	SHEET NO.
OREGON DIVISION	STP-S091(068)	1

Sec. 4, 9, T. 1 N., R. 1 E., W. M.



INDEX OF SHEETS, CONT.	
SHEET NO.	DESCRIPTION
2, 2A thru 2A-10	Typical Sections
2B, 2B-2 thru 2B-22	Details
2C thru 2C-4	Detour Plan
2C-5 thru 2C-22	Traffic Control Plan
2D, 2D-2	Pipe Data Sheet
3	Alignment
3A	General Construction
3B	Construction Notes
3C	Drainage & Utilities
3D	Drainage Notes
3E, 3E-2	Profile
3F, 3F-2	Drainage Profile
4	Alignment
4A	General Construction
4B	Construction Notes
4C	Drainage & Utilities
4D	Drainage Notes
4E, 4E-2	Profile
4F, 4F-2	Drainage Profile
5	Alignment
5A	General Construction
5B	Construction Notes
5C	Drainage & Utilities
5D	Drainage Notes
5E	Profile
5F	Drainage Profile
6	Alignment
6C	Drainage & Utilities
6D	Drainage Notes
6E	Profile and Drainage Profile
<b>GEO/HYDRO/ENVIRO</b>	
GA thru GA-5	Erosion and Sediment Control Details
GA-6 thru GA-16	Erosion and Sediment Control Plan
GB, T	Foundation Data
GJ thru GJ-5	Drainage Details
GN	Planting Bid Log and Notes
GN-1, GN-2	Planting Plan
DRAWING NO.	DESCRIPTION
<b>BRIDGE NO. 04517</b>	
93578 thru 93598	Bridge Plan and Details
<b>BRIDGE NO. 04518</b>	
93599 thru 93616	Bridge Plan and Details



INDEX OF SHEETS, CONT.	
SHEET NO.	DESCRIPTION
<b>PERMANENT PAVEMENT MARKINGS</b>	
ST	Striping Details
ST-2 thru ST-4	Striping Plan
<b>PERMANENT SIGNING</b>	
S-14697 thru S-14710	Permanent Signing
<b>ILLUMINATION</b>	
I-02299	ILLUMINATION Legend & Abbreviations
I-02300 thru I-02301	ILLUMINATION Schedules
I-02302 thru I-02304	ILLUMINATION Plan
I-02305	General Notes & Panel Schematic
I-02306 thru I-02310	PBOT Std. Details
<b>TRAFFIC SIGNAL</b>	
17658	Legend
17659	Signal Plan
17660, 17661	Detector Plan
17662	Existing Utilities Plan
17663 thru 17665	Details
17666 thru 17667	Interconnect Plan

<b>FOR INFORMATION ONLY</b>	
No.	DESCRIPTION
1	Levee Raise Plan and Profile
2	Levee Raise Cross Section

City of Portland Standard Drg. Nos.

- P-161 - Sedimentation Manhole with Hood
- P-400 - Sign Placement
- P-405 - Breakaway Anchor Traffic Sign Supports
- P-410 - Sign Bracket, Cap Details
- P-540 - Thickened Curb & Gutter
- P-551 - Sidewalks
- P-632 - Pull Box Type A & B Details
- P-651 - Street Lighting Cobra-Head Pole Details
- P-660 - Street Lighting Standard Street Light Standard Pole Footing
- P-671 - Street Lighting Service Cabinet Details
- P-680 - Street Lighting Pole Wiring Diagrams

R/W Map Nos.

- 5B-25-12
- 6B-13-18
- 6B-16-9
- 8B-12-18
- 8B-14-18

*Adam Markell*  
**"AS CONSTRUCTED"**  
 AUG 25 2017  
 ADAM MARKELL,  
 INTERIM PROJECT MANAGER

No.	DATE	REVISIONS	BY
1	07-09-14	Added drainage detail sheet to index	M.H.T.


Standard Drawings located on the web at:  
[http://www.oregon.gov/ODOT/HWY/ENGSEVICES/pages/standard\\_drawings\\_home.aspx](http://www.oregon.gov/ODOT/HWY/ENGSEVICES/pages/standard_drawings_home.aspx)  
<http://www.portlandoregon.gov/transportation/50383>

<b>OR99W: N. VICTORY BLVD. - N. ARGYLE ST. (PORTLAND) SEC. PACIFIC HIGHWAY WEST MULTNOMAH COUNTY</b>		
FEDERAL HIGHWAY ADMINISTRATION	PROJECT NUMBER	SHEET NO.
OREGON DIVISION	STP-S09I(068)	1A

**BUREAU OF TRANSPORTATION  
CITY OF PORTLAND, OREGON**  
*James Wardlaw for S.T.*  
 APPROVAL  
 CITY ENGINEER REG. PROF. ENGR. NO. 51,538 16,399  
**Bureau of Environmental Services Approval**  
 BES JOB NO. 7ESTRS000090  
 BES JOB TITLE: OR99W (Denver); Victory-Argyle  
*Walt Fry 7/14/17*  
 Chief Engineer Reg. Prof. Engr Date

*Adam Markell*  
**"AS CONSTRUCTED"**  
 AUG 25 2017  
 ADAM MARKELL,  
 INTERIM PROJECT MANAGER

No.	DATE	REVISIONS	BY
1	08-07-2014	MOVED INLET 9 AND 10	M.D.S.
2	12-18-2014	ADDED NOTE AND REVISED PIPE LENGTHS	M.D.S.
3	07-02-2015	ADDED MANHOLE AND REVISED PIPE LENGTH	M.D.S.

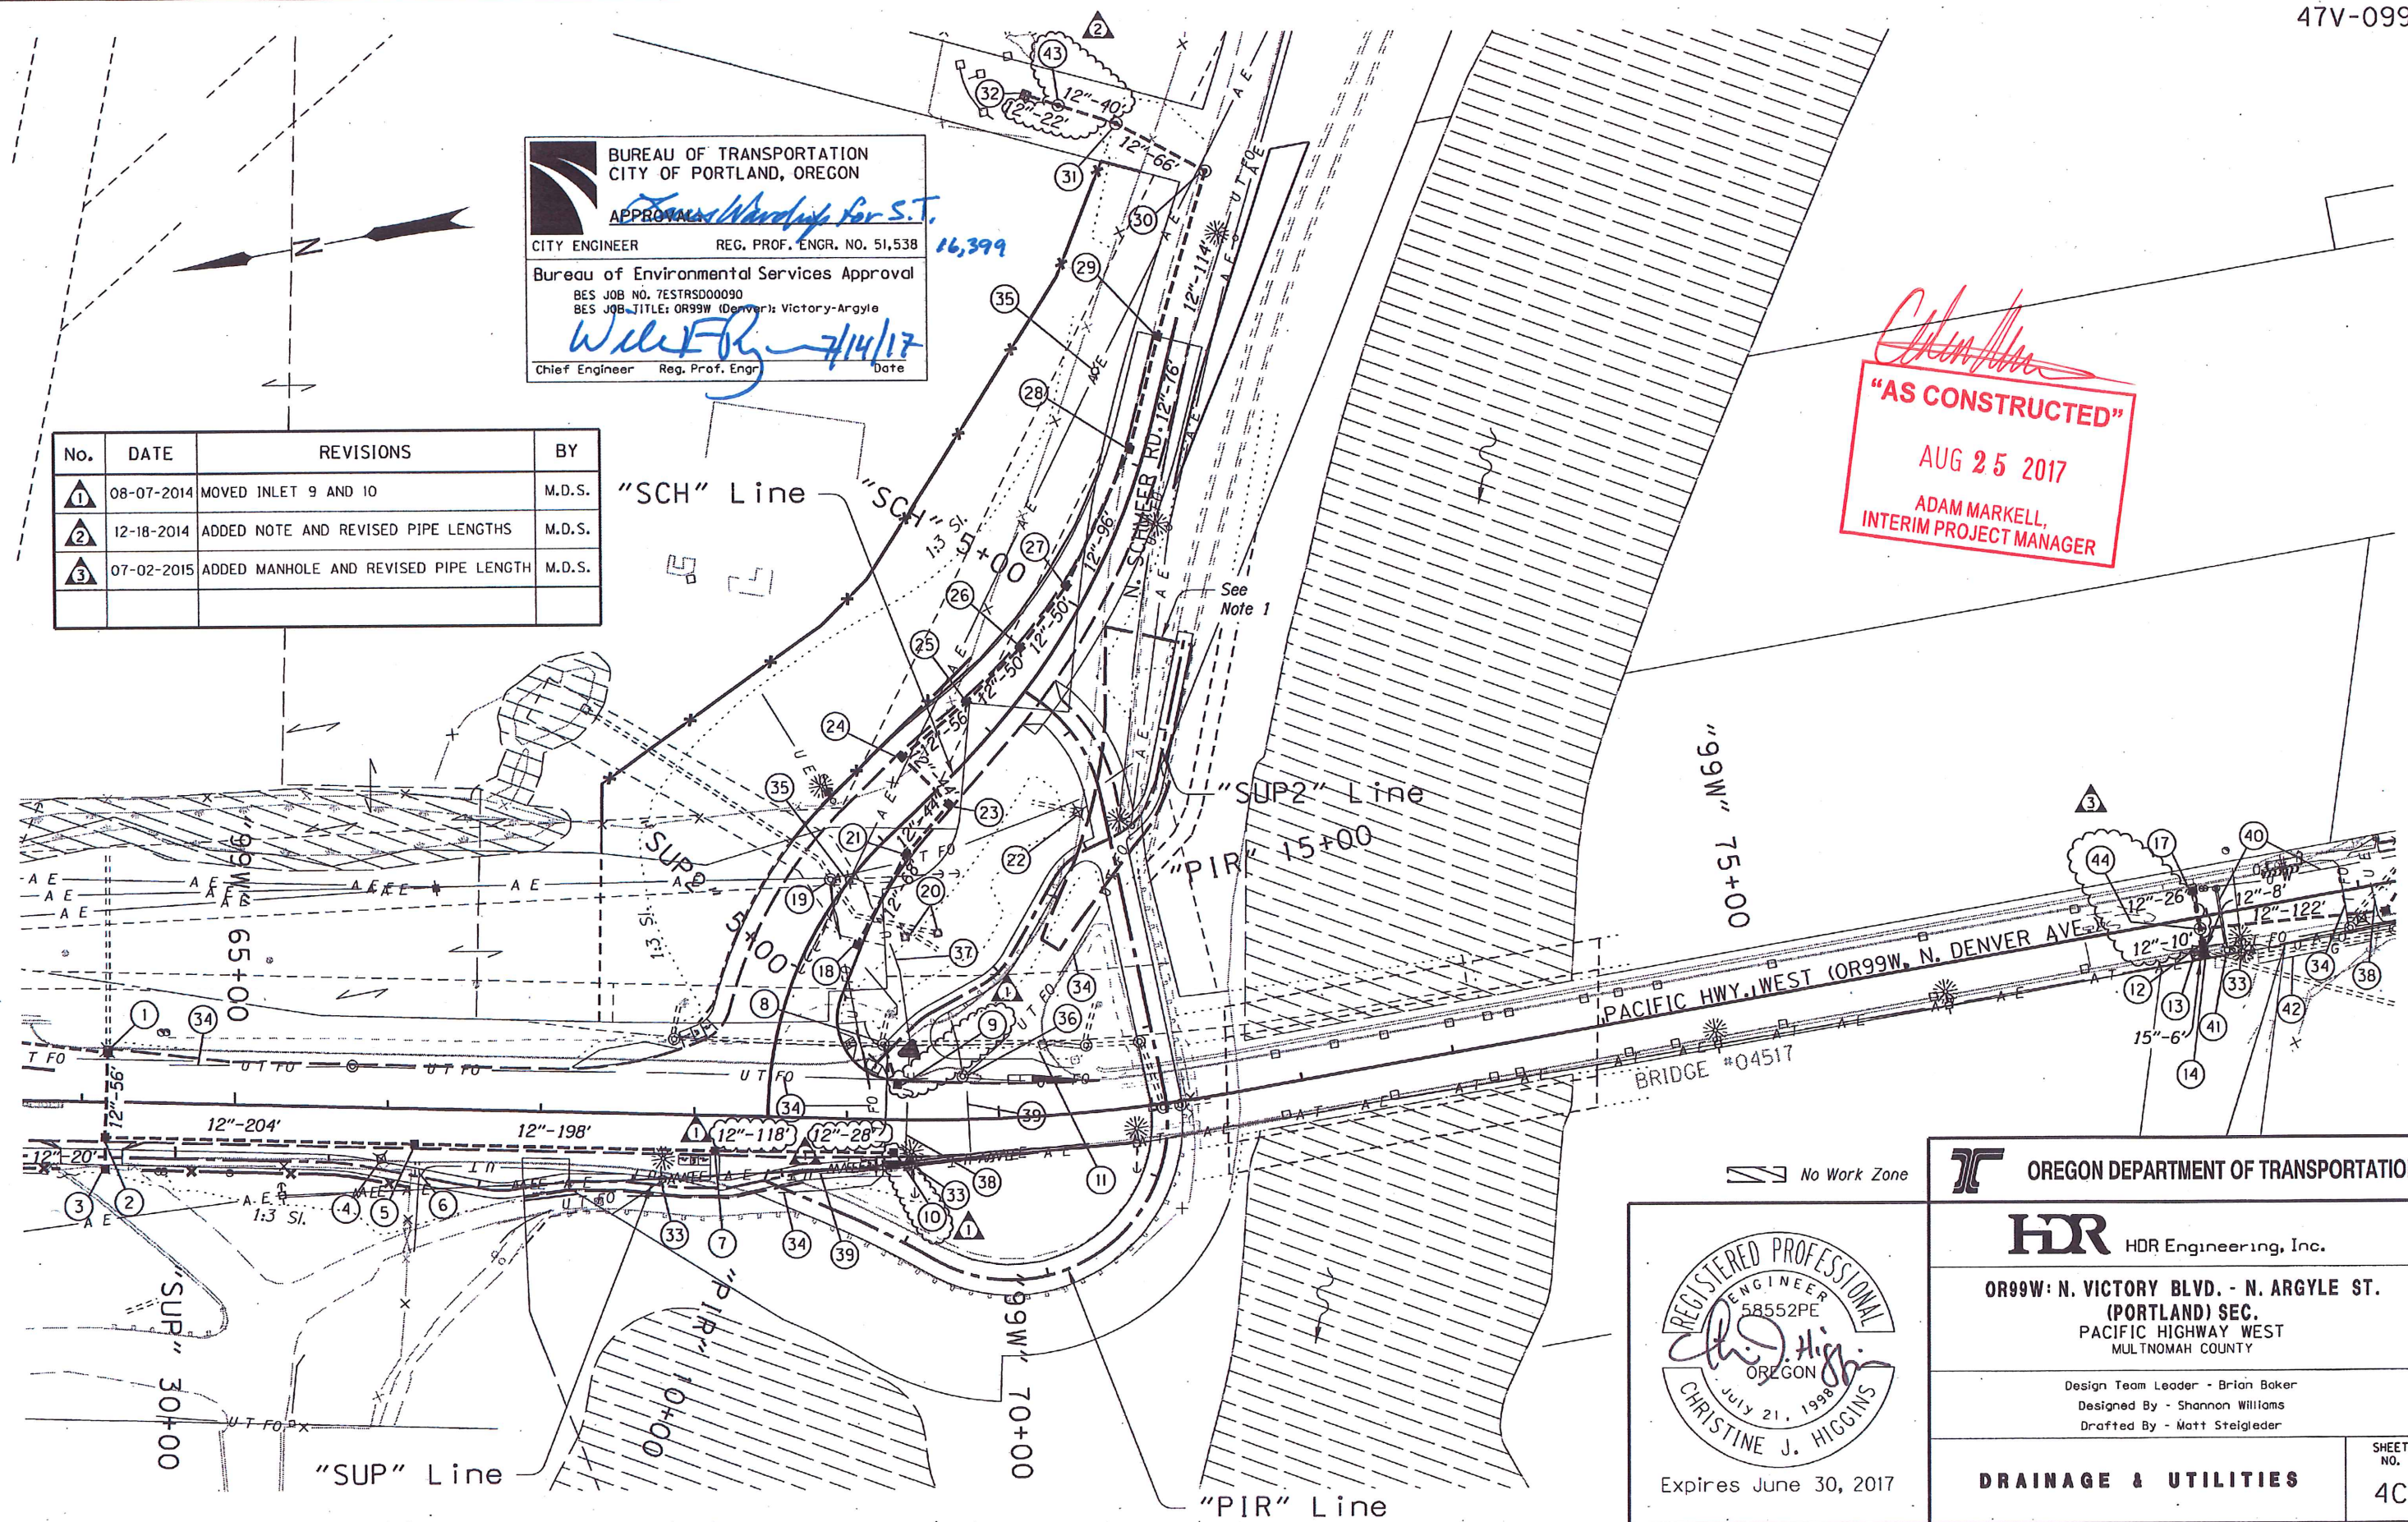

REGISTERED PROFESSIONAL  
 ENGINEER  
 58552PE  
*Christine J. Higgins*  
 OREGON  
 JULY 21, 1998  
 CHRISTINE J. HIGGINS  
 Expires June 30, 2017

**OREGON DEPARTMENT OF TRANSPORTATION**

**HDR** HDR Engineering, Inc.

OR99W: N. VICTORY BLVD. - N. ARGYLE ST.  
 (PORTLAND) SEC.  
 PACIFIC HIGHWAY WEST  
 MULTNOMAH COUNTY

Design Team Leader - Brian Baker  
 Designed By - Shannon Williams  
 Drafted By - Matt Steigleder

**DRAINAGE & UTILITIES**

SHEET NO.  
**4C**

① Sta. "99W" 64+16.25, Lt.  
Remove Extg. Inlet  
Remove Extg. 8" Storm Sew. Pipe - 126'  
Const. Type "G-2" Inlet  
Inst. 12" D.I. Storm Sew. Pipe - 56'  
5' Depth

② Sta. "99W" 64+15.55, Rt.  
Const. Type "G-2" Inlet  
Inst. 12" D.I. Storm Sew. Pipe - 204'  
5' Depth  
Inst. 12" D.I. Storm Sew. Pipe - 20'  
5' Depth

③ Sta. "99W" 64+16.08, Rt.  
Const. Type "G-2" Inlet

④ Sta. "99W" 65+96.33, 33' Rt.  
Remove Inlet

⑤ Sta. "99W" 66+18.77, Rt.  
Const. Type "G-2" Inlet  
Inst. 12" D.I. Storm Sew. Pipe - 198'  
5' Depth

⑥ Sta. "99W" 66+20.16, 35' Rt.  
Remove Extg. 12" Storm Sew. Pipe - 10'

⑦ Sta. "99W" 68+14.19, Rt.  
Const. Type "G-2" Inlet  
Inst. 12" D.I. Storm Sew. Pipe - 118'  
5' Depth

⑧ Sta. "99W" 69+23.07, 49' Lt.  
Minor Adjust. Manhole  
Inst. 12" Storm Sew. Pipe - 28'  
5' Depth  
Connect to Extg. Structure

⑨ Sta. "99W" 69+33.00, Lt.  
Const. Type "G-2" Inlet

⑩ Sta. "99W" 69+31.00, Rt.  
Const. Type "G-2" Inlet

⑪ Sta. "99W" 70+31.80, 47' Lt.  
Remove Extg. Inlet  
Remove Extg. 8" Storm Sew. Pipe - 23'

⑫ Sta. "99W" 77+93.83, Rt.  
Saw Cut and Remove Extg. Conc. Slab  
Remove Extg. Inlet  
Remove Extg. 12" Storm Sew. Pipe - 34'  
Const. Type "G-2" Inlet  
Inst. 12" Storm Sew. Pipe - 10'  
10' Depth  
Trench Resurfacing - 5 Sq.Yd.

⑬ Sta. "99W" 77+87.93, 24' Rt.  
Const. Riprap Basin  
Inst. 15" Storm Sew. Pipe - 6'  
5' Depth

⑭ Sta. "99W" 77+93.92, 24' Rt.  
Remove Extg. Inlet  
Remove Extg. 8" Pipe - 12'  
Const. Type "B" Inlet  
Const. Sewer thru Extg. Conc. Structure  
Inst. 12" Storm Sew. Pipe - 8'  
5' Depth  
Connect Extg. Pipe

⑮ Note not used

⑯ Note not used

⑰ Sta. "99W" 77+93.53, Lt.  
Saw Cut and Remove Extg. Conc. Slab  
Preserve and Protect Extg. 8" D.I. Water Main  
Remove Extg. Inlet  
Const. Type "G-2" Inlet

⑱ Sta. "SCH" 2+32.23, Rt.  
Const. Type "G-2" Inlet

⑲ Relocate Extg. Fiber Optic Manhole (By Others)

⑳ Protect Water Wells (Relief Wells)

㉑ Sta. "SCH" 3+04.36, Rt.  
Const. Type "G-2" Inlet  
Inst. 12" Storm Sew. Pipe - 68'  
5' Depth

㉒ Sta. "SCH" 3+98.56, 76' Rt.  
Remove Extg. Inlet  
Remove Extg. 12" Storm Sew. Pipe - 30'

㉓ Sta. "SCH" 3+47.14, Rt.  
Const. Type "G-2" Inlet  
Inst. 12" Storm Sew. Pipe - 44'  
5' Depth

㉔ Sta. "SCH" 3+47.14, Lt.  
Const. Type "G-2" Inlet  
Inst. 12" Storm Sew. Pipe - 44'  
5' Depth

㉕ Sta. "SCH" 4+04.40, Lt.  
Const. Type "G-2" Inlet  
Inst. 12" Storm Sew. Pipe - 56'  
5' Depth

㉖ Sta. "SCH" 4+56.30, Lt.  
Const. Type "G-2" Inlet  
Inst. 12" Storm Sew. Pipe - 50'  
5' Depth

㉗ Sta. "SCH" 5+08.29, Lt.  
Const. Type "G-2" Inlet  
Inst. 12" Storm Sew. Pipe - 50'  
5' Depth

㉘ Sta. "SCH" 6+08.98, Lt.  
Const. Type "G-2" Inlet  
Inst. 12" D.I. Storm Pipe - 96'  
5' Depth

㉙ Sta. "SCH" 6+85.04, Lt.  
Const. Type "G-2" Inlet  
Inst. 12" Storm Sew. Pipe - 76'  
5' Depth

㉚ Sta. "SCH" 7+96.69, Lt.  
Const. Shallow Manhole  
Inst. 12" Storm Sew. Pipe - 114'  
5' Depth  
Trench Resurfacing - 52 Sq.Yd.

㉛ Sta. "SCH" 8+08.91, Lt.  
Const. Storm Sew. Manhole  
Inst. 12" Storm Sew. Pipe - 66'  
5' Depth

㉜ Sta. "SCH" 8+09.01, Lt.  
Const. Riprap Basin  
Inst. 12" Storm Sew. Pipe - 22'  
5' Depth

㉝ Preserve and Protect Extg. Utility Pole

㉞ Preserve and Protect Extg. Fiber Optic

㉟ Relocate Extg. Utility Pole (by others)

㊱ Adjust Extg. Communication Manhole (by others)

㊲ Relocate Extg. UG Electric (by others)

㊳ Preserve and Protect Extg. UG Electric

㊴ Preserve and Protect Extg. UG Telephone

④⑩ Preserve and Protect Extg. Water Line

④① Preserve and Protect Extg. Hydrant

④② Preserve and Protect Extg. Natural Gas Line

④③ Sta. "SCH" 8+08.97, Lt.  
Const. COP Sedimentation Manhole  
Inst. 12" Storm Sew. Pipe - 40'  
5' Depth  
(For Details, See Sht. GJ-4)

④④ Sta. "99W" 77+93.75, Rt.  
Const. Storm Sew. Manhole  
Inst. 12" Storm Sew. Pipe - 26'  
5' Depth  
Trench Resurfacing - 12 Sq.Yd.  
Inst. 12" Storm Sew. Pipe - 122'  
10' Depth  
Trench Resurfacing - 56 Sq.Yd.

*Adam Markell*  
**"AS CONSTRUCTED"**  
AUG 25 2017  
ADAM MARKELL,  
INTERIM PROJECT MANAGER

No.	DATE	REVISIONS	BY
①	07-09-2014	REVISED DEPTH	M.D.S.
②	08-04-2014	REVISED NOTES	M.D.S.
③	12-18-2014	REVISED NOTES	M.D.S.
④	02-19-2015	REVISED NOTES	M.D.S.
⑤	07-02-2015	REVISED NOTES	M.D.S.

Bureau of Environmental Services Approval  
BES JOB NO. 7ESTRSD00090  
BES JOB TITLE: OR99W (Denver): Victory-Argyle  
*Wileen Flynn 7/14/17*  
Chief Engineer Reg. Prof. Engr. Date  
BUREAU OF TRANSPORTATION  
CITY OF PORTLAND, OREGON  
*James Wardlaw for S.T.*  
APPROVAL  
CITY ENGINEER REG. PROF. ENGR. NO. 51,538

REGISTERED PROFESSIONAL  
ENGINEER  
58552PE  
*Christine J. Higgins*  
OREGON  
July 21, 1998  
CHRISTINE J. HIGGINS  
Expires June 30, 2017

**OREGON DEPARTMENT OF TRANSPORTATION**

**HDR** HDR Engineering, Inc.

**OR99W: N. VICTORY BLVD. - N. ARGYLE ST. (PORTLAND) SEC. PACIFIC HIGHWAY WEST MULTNOMAH COUNTY**

Design Team Leader - Brian Baker  
Designed By - Shannon Williams  
Drafted By - Matt Steigleder

**DRAINAGE NOTES**

SHEET NO. 4D



Sec. 9, T. 1 N., R. 1 E., W.M.


47V-099

*Adam Markell*  
**"AS CONSTRUCTED"**  
 AUG 25 2017  
 ADAM MARKELL,  
 INTERIM PROJECT MANAGER



"A1" Line  
 (For Profile, see Sht 6E)

N. VICTORY BLVD

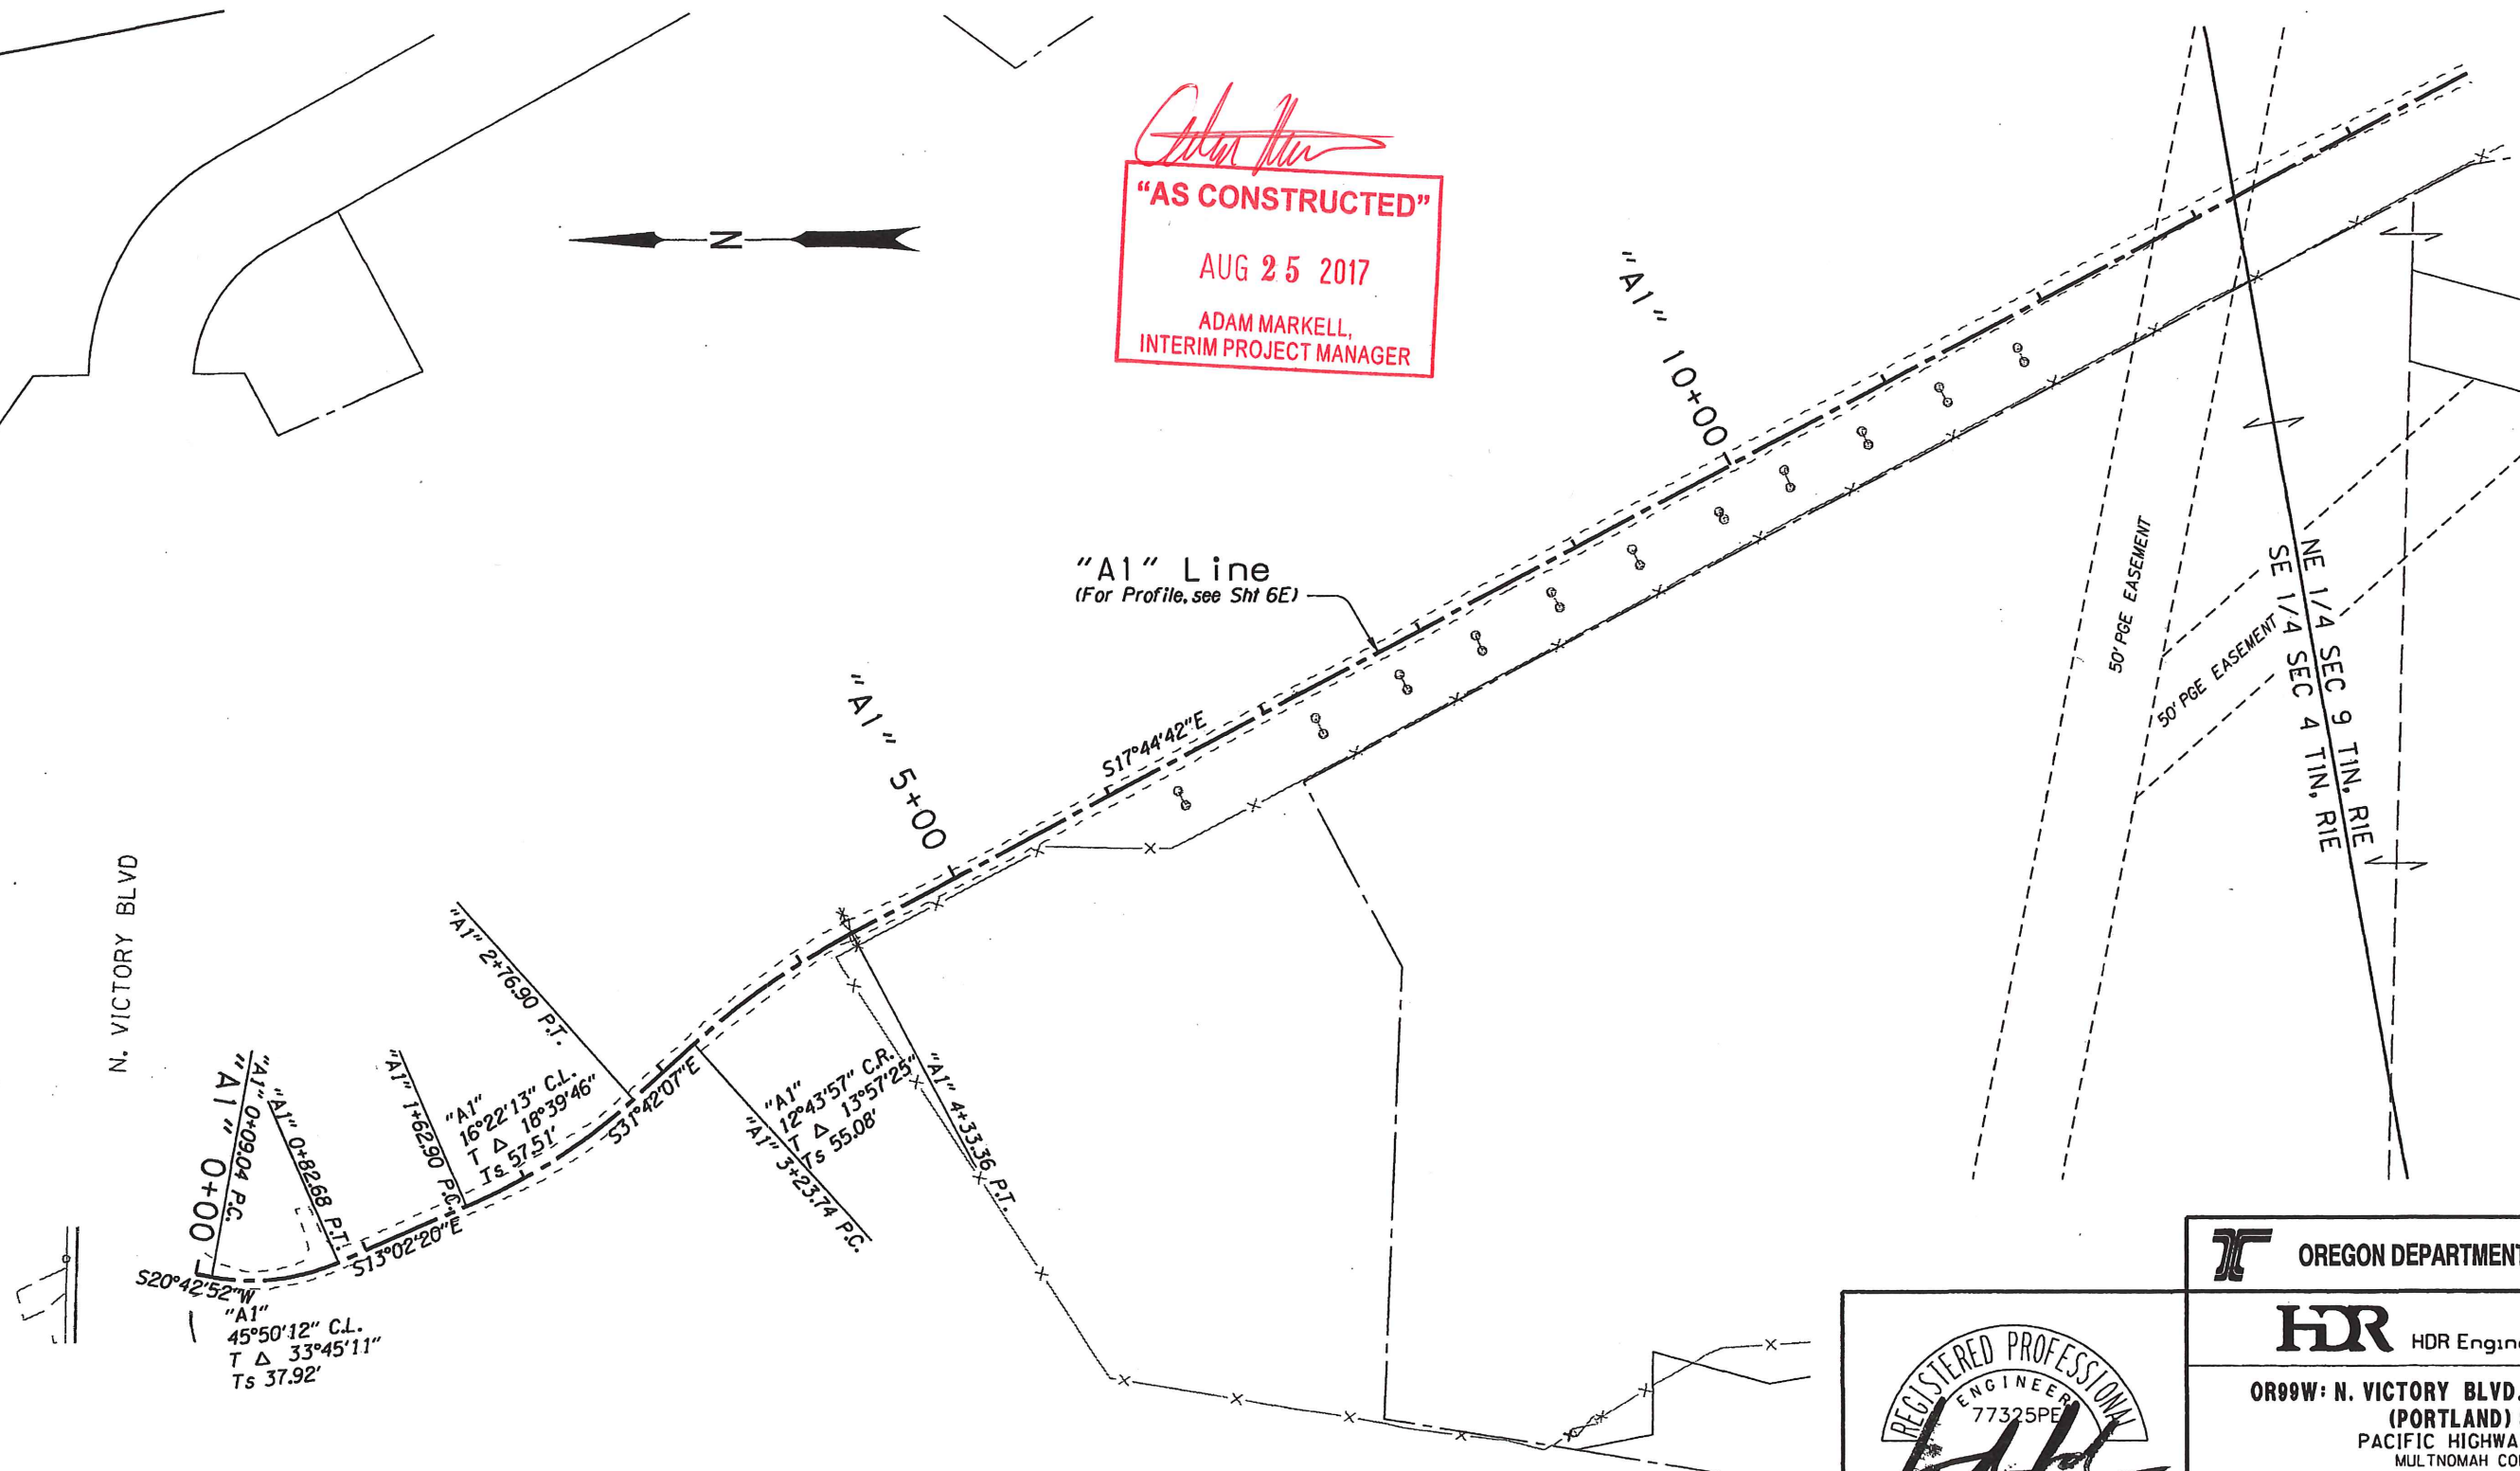

**OREGON DEPARTMENT OF TRANSPORTATION**

**HDR** HDR Engineering, Inc.


**OR99W: N. VICTORY BLVD. - N. ARGYLE ST.  
 (PORTLAND) SEC.  
 PACIFIC HIGHWAY WEST  
 MULTNOMAH COUNTY**

Design Team Leader - Brian Baker  
 Designed By - Mark Taylor  
 Drafted By - Matt Steigleder

REGISTERED PROFESSIONAL  
 ENGINEER  
 77325PE  
*Brian R. Baker*  
 OREGON  
 Sept. 13, 2005  
 BRIAN R. BAKER  
 Expires Dec. 31, 2014

<b>ALIGNMENT</b>	SHEET NO. <b>6</b>
------------------	-----------------------

*Adam Markell*  
**"AS CONSTRUCTED"**  
 AUG 25 2017  
 ADAM MARKELL,  
 INTERIM PROJECT MANAGER

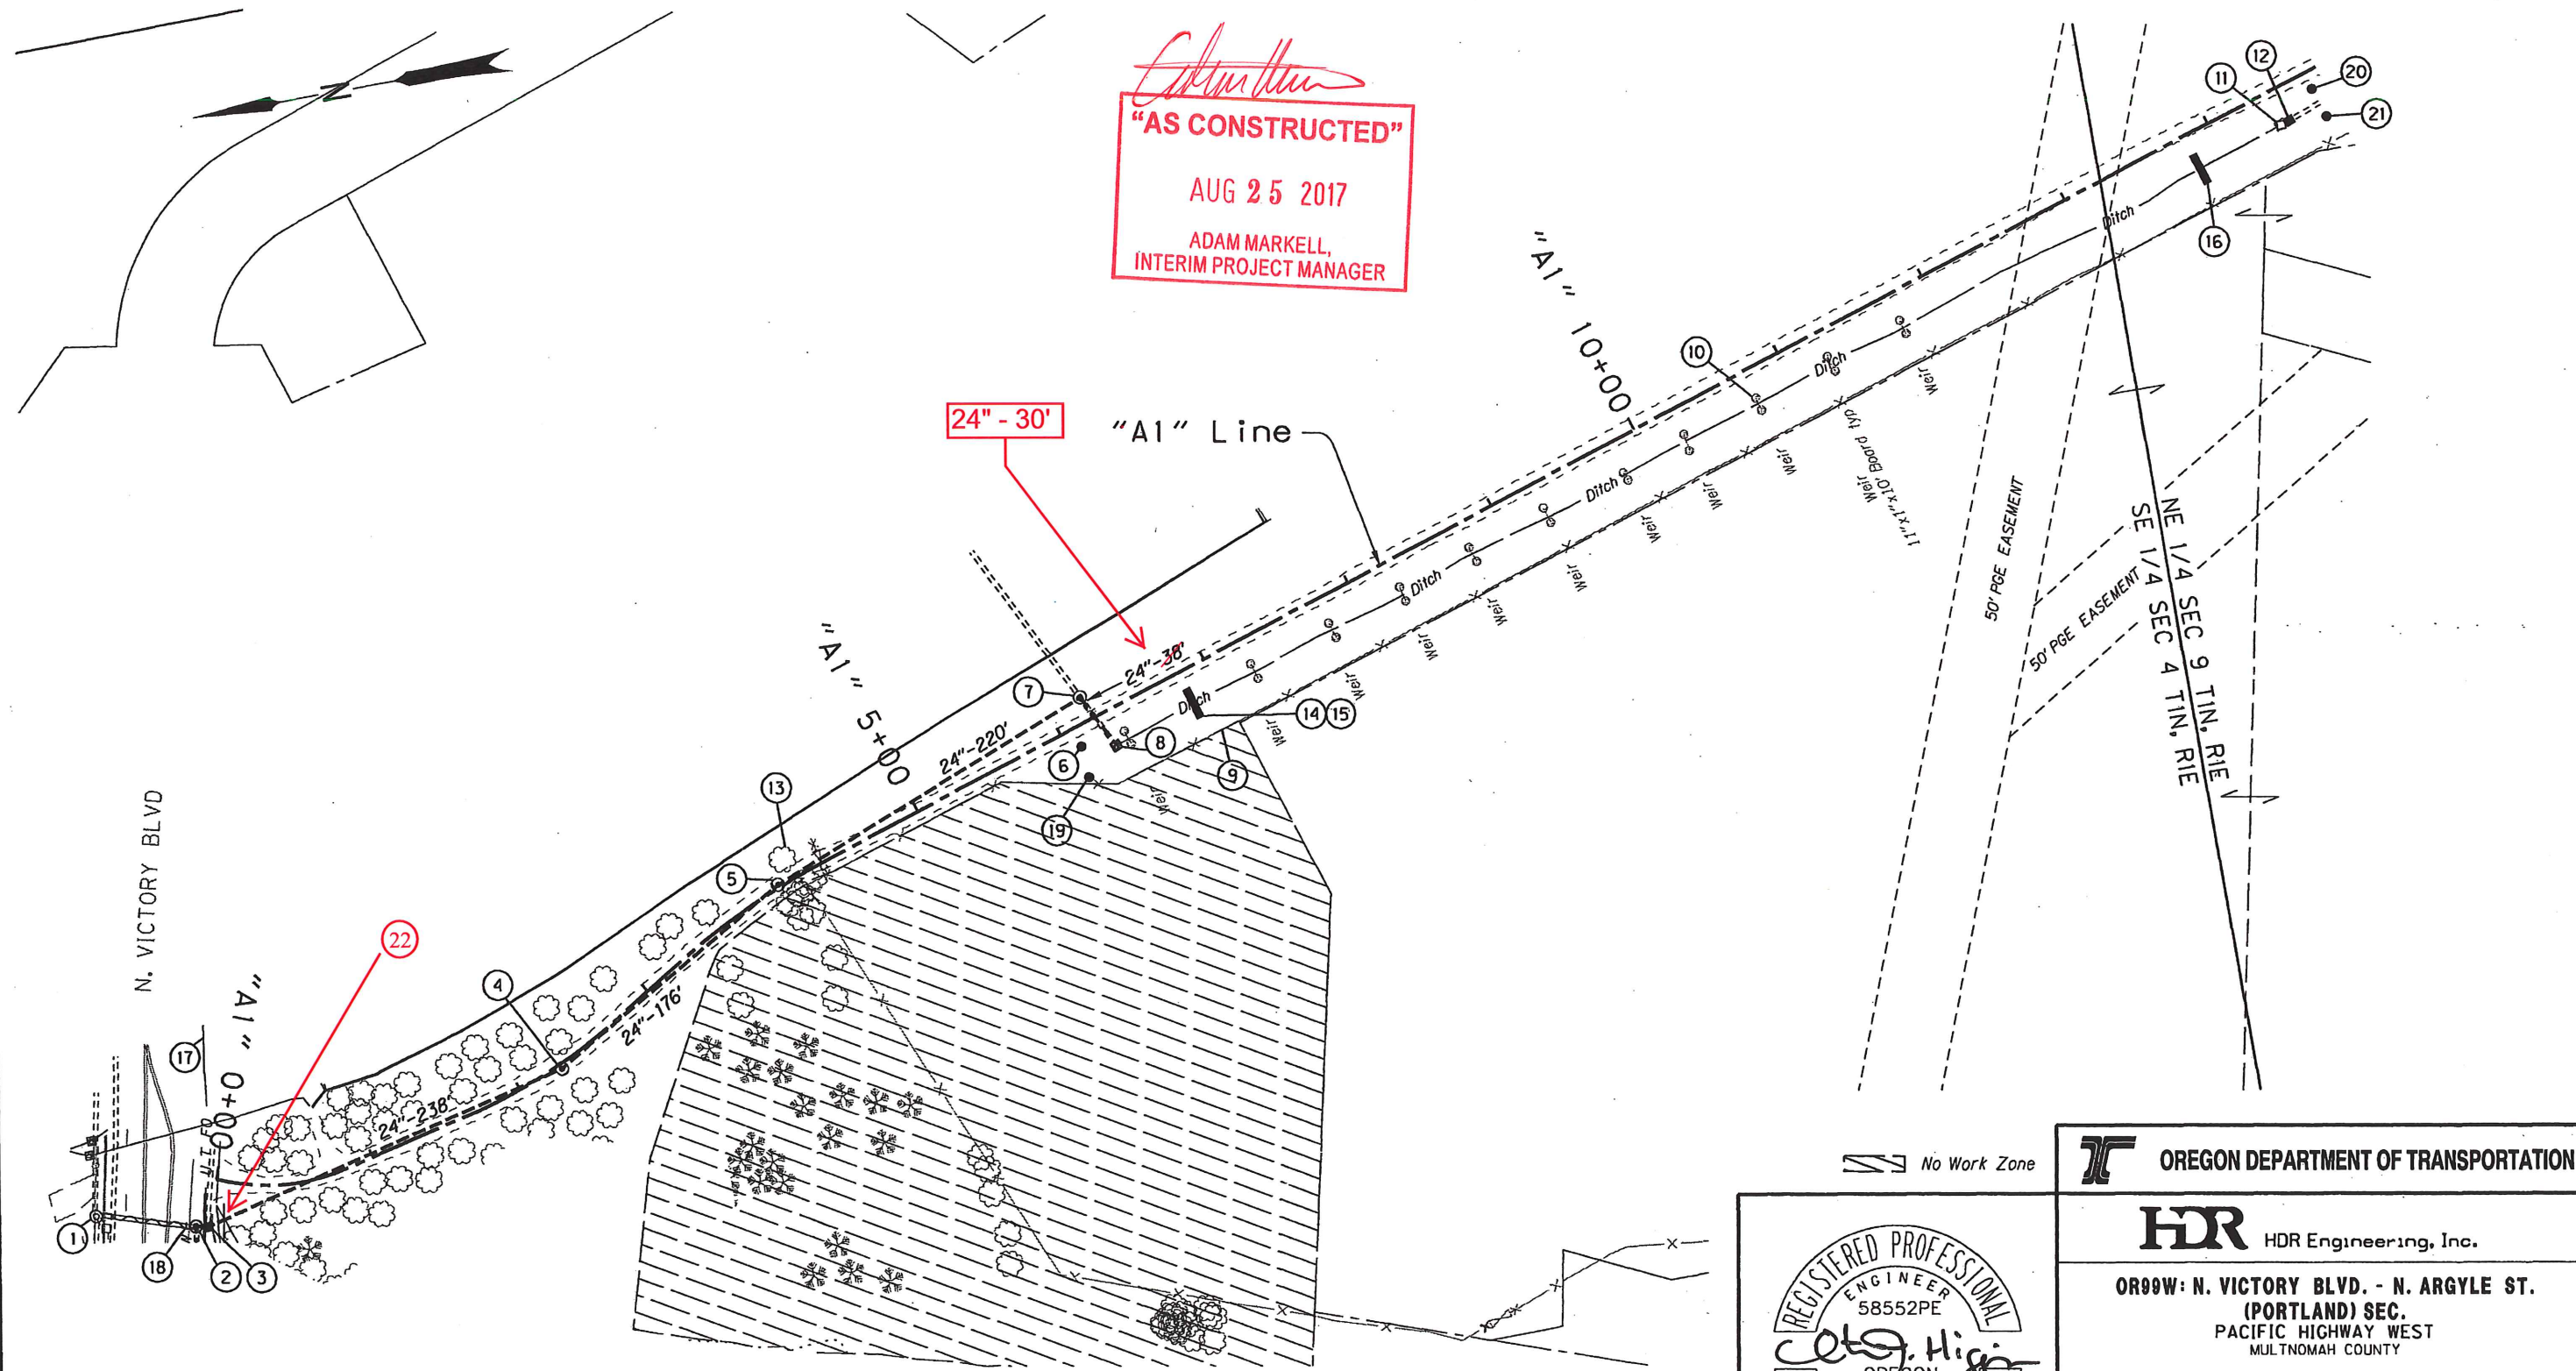

N. VICTORY BLVD

No Work Zone

REGISTERED PROFESSIONAL  
 ENGINEER  
 58552PE  
*Christine J. Higgins*  
 OREGON  
 July 21, 1998  
 CHRISTINE J. HIGGINS  
 Expires June 30, 2015

**OREGON DEPARTMENT OF TRANSPORTATION**

**HDR** HDR Engineering, Inc.

OR99W: N. VICTORY BLVD. - N. ARGYLE ST.  
 (PORTLAND) SEC.  
 PACIFIC HIGHWAY WEST  
 MULTNOMAH COUNTY

Design Team Leader - Brian Baker  
 Designed By - Shannon Williams  
 Drafted By - Matt Steigleder


**DRAINAGE & UTILITIES** SHEET NO. 6C


  
**"AS CONSTRUCTED"**  
 AUG 25 2017  
 ADAM MARKELL,  
 INTERIM PROJECT MANAGER

- ① See Sheet 3C and 3D, Note 1
- ② See Sheet 3C and 3D, Note 2
- ③ See Sheet 3C and 3D, Note 3
- ④ See Sheet 3C and 3D, Note 4
- ⑤ Sta. "A1" 4+03.36, 2' Lt.  
Const. Storm Manhole  
Inst. 24" Storm Sew. Pipe - .176'  
5' Depth  
Trench Resurfacing - 142 Sq.Yd.
- ⑥ Sta. "A1" 6+08.23, 12' Rt.  
Inst. Field Facility Marker Type "S1" (Red) (D00216)  
(For Details, See RD399)
- ⑦ Sta. "A1" 6+24.94, 7' Lt.  
Remove Extg. 18" Pipe - 37'  
Const. Water Quality Structure, D00838  
Const. Manhole Slope Protector  
Inst. Field Facility Marker Type "S3" (D00838)  
Connect Extg. Pipe  
Inst. 24" Storm Sew. Pipe - 220'  
5' Depth  
Trench Resurfacing - 152 Sq.Yd.
- ⑧ Sta. "A1" 6+27.30, 22' Rt.  
Const. Riprap Basin  
Inst. 24" Storm Sew. Pipe - 38'  
5' Depth  
Trench Resurfacing - 17 Sq.Yd.  
(For Details, See Sht. GJ-2)
- ⑨ Protect Extg. Fence
- ⑩ Sta. "A1" 6+27.30 to 14+39.40  
Remove Extg. Weir Boards - 11
- ⑪ Sta. "A1" 14+39.40, 22' Rt.  
Adjust Extg. Inlet
- ⑫ Sta. "A1" 14+45.04, 22' Rt.  
Const. Type "D" Inlet over Extg. Storm Sew. Pipe
- ⑬ Protect Extg. Trees (Typ.)
- ⑭ Adjust Aggregate Check Dam Locations to Avoid Trees
- ⑮ Sta. "A1" 6+83.04, 22' Rt.  
Const. Aggregate Check Dams - 15  
50' O.C.  
(For Details, See Sheet GJ-3)
- ⑯ Sta. "A1" 13+83.04, 22' Rt.  
End Aggregate Check Dams
- ⑰ Preserve and Protect Extg. Fiber Optic
- ⑱ Preserve and Protect Extg. Water Line
- ⑲ Sta. "A1" 6+03.49, 31' Rt.  
Inst. Field Facility Marker Type "S2" - (D00216)  
(For Details, See RD399)
- ⑳ Sta. "A1" 14+66.59, 11' Rt.  
Inst. Field Facility Marker Type "S1" (Green) (D00216)  
(For Details, See RD399)
- ㉑ Sta. "A1" 14+66.59, 30' Rt.  
Inst. Field Facility Marker Type "S2" (D00216)  
(For Details, See RD399)

24"-30'

22. See Sheet 3C & 3D note 23

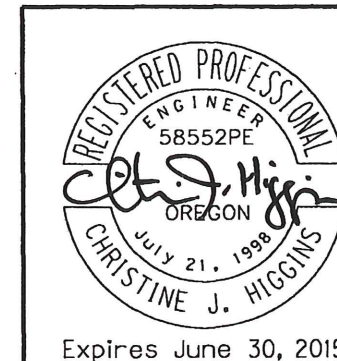


 OREGON DEPARTMENT OF TRANSPORTATION	
 HDR Engineering, Inc.	
0R99W: N. VICTORY BLVD. - N. ARGYLE ST. (PORTLAND) SEC. PACIFIC HIGHWAY WEST MULTNOMAH COUNTY	
Design Team Leader - Brian Baker Designed By - Shannon Williams Drafted By - Matt Steigleder	
<b>DRAINAGE NOTES</b>	SHEET NO. <b>6D</b>

Note:  
See Sht. 3D and 6D For  
Drainage And Utilities Notes

"A1" LINE

*Adam Markell*  
**"AS CONSTRUCTED"**  
AUG 25 2017  
ADAM MARKELL  
INTERIM PROJECT MANAGER

**REVISED SHEET  
BY RFI #17**

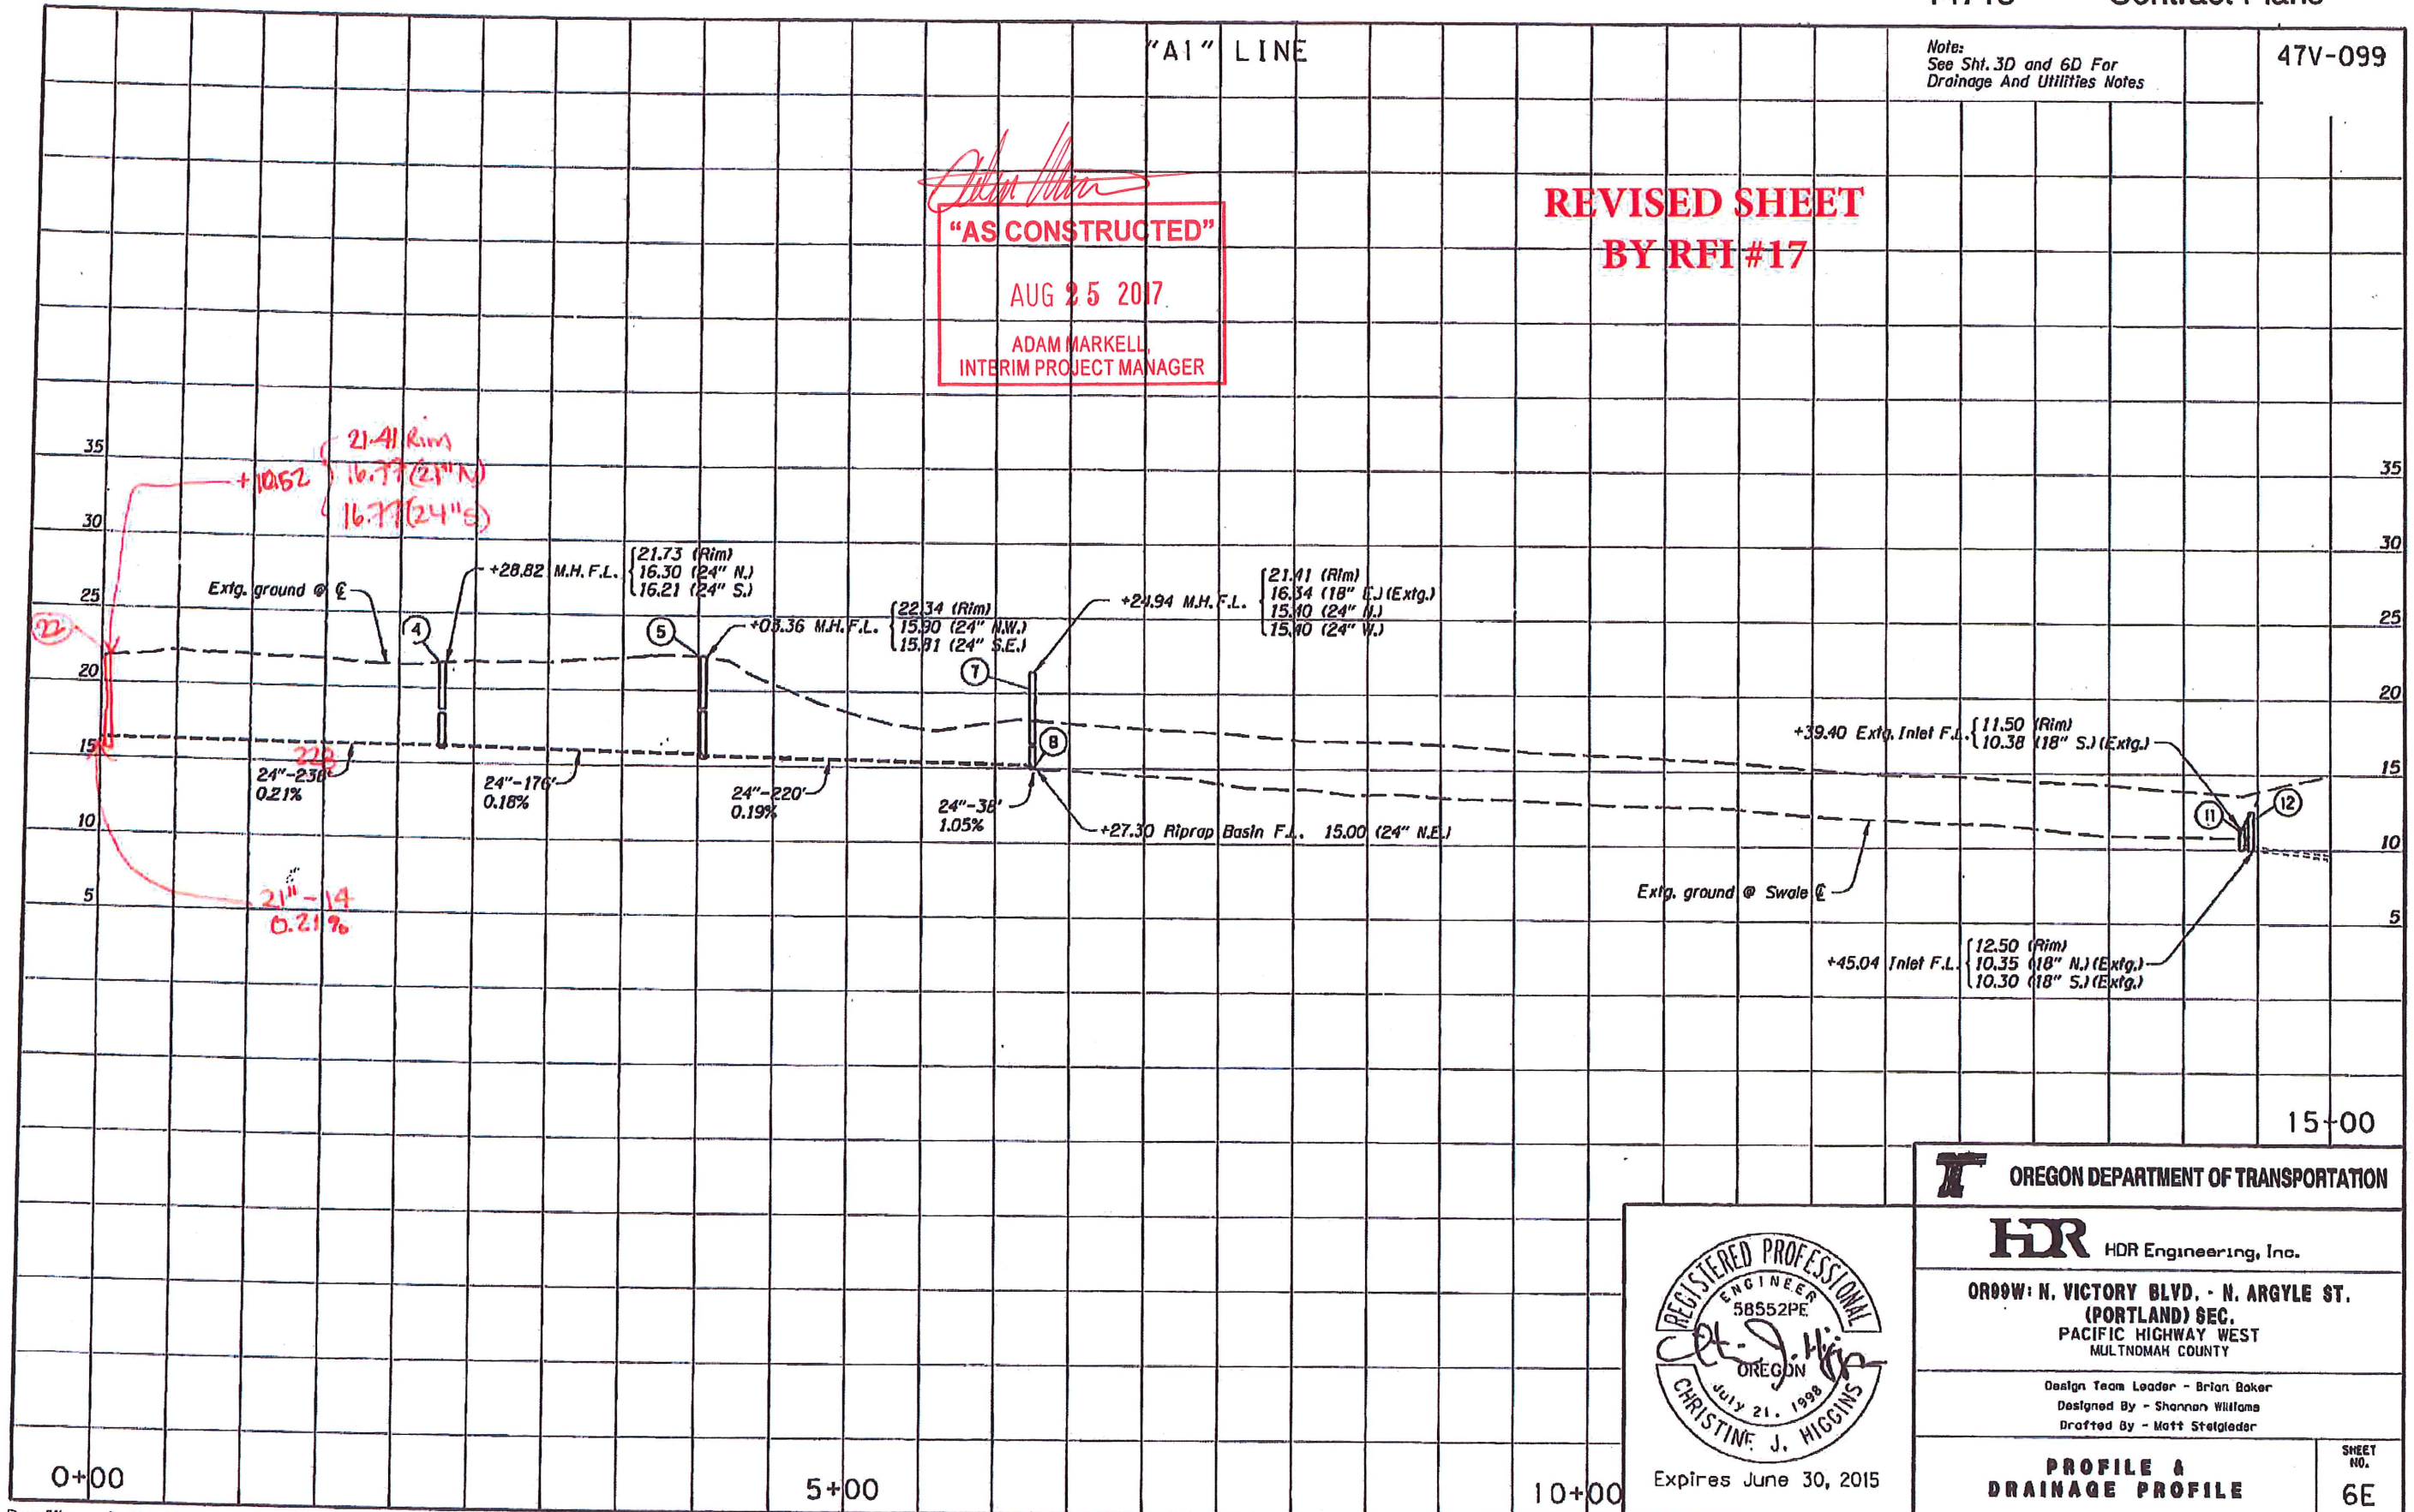


**OREGON DEPARTMENT OF TRANSPORTATION**



**HDR** HDR Engineering, Inc.  
 0909W: N. VICTORY BLVD. - N. ARGYLE ST.  
 (PORTLAND) SEC.  
 PACIFIC HIGHWAY WEST  
 MULTNOMAH COUNTY

Design Team Leader - Brian Baker  
 Designed By - Shannon Williams  
 Drafted By - Matt Stelgleder

**PROFILE & DRAINAGE PROFILE**

SHEET NO. 6E

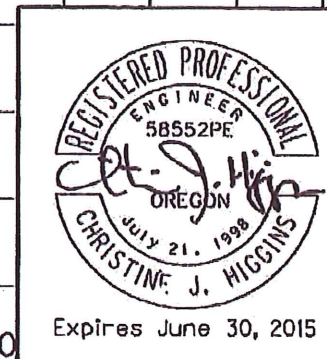


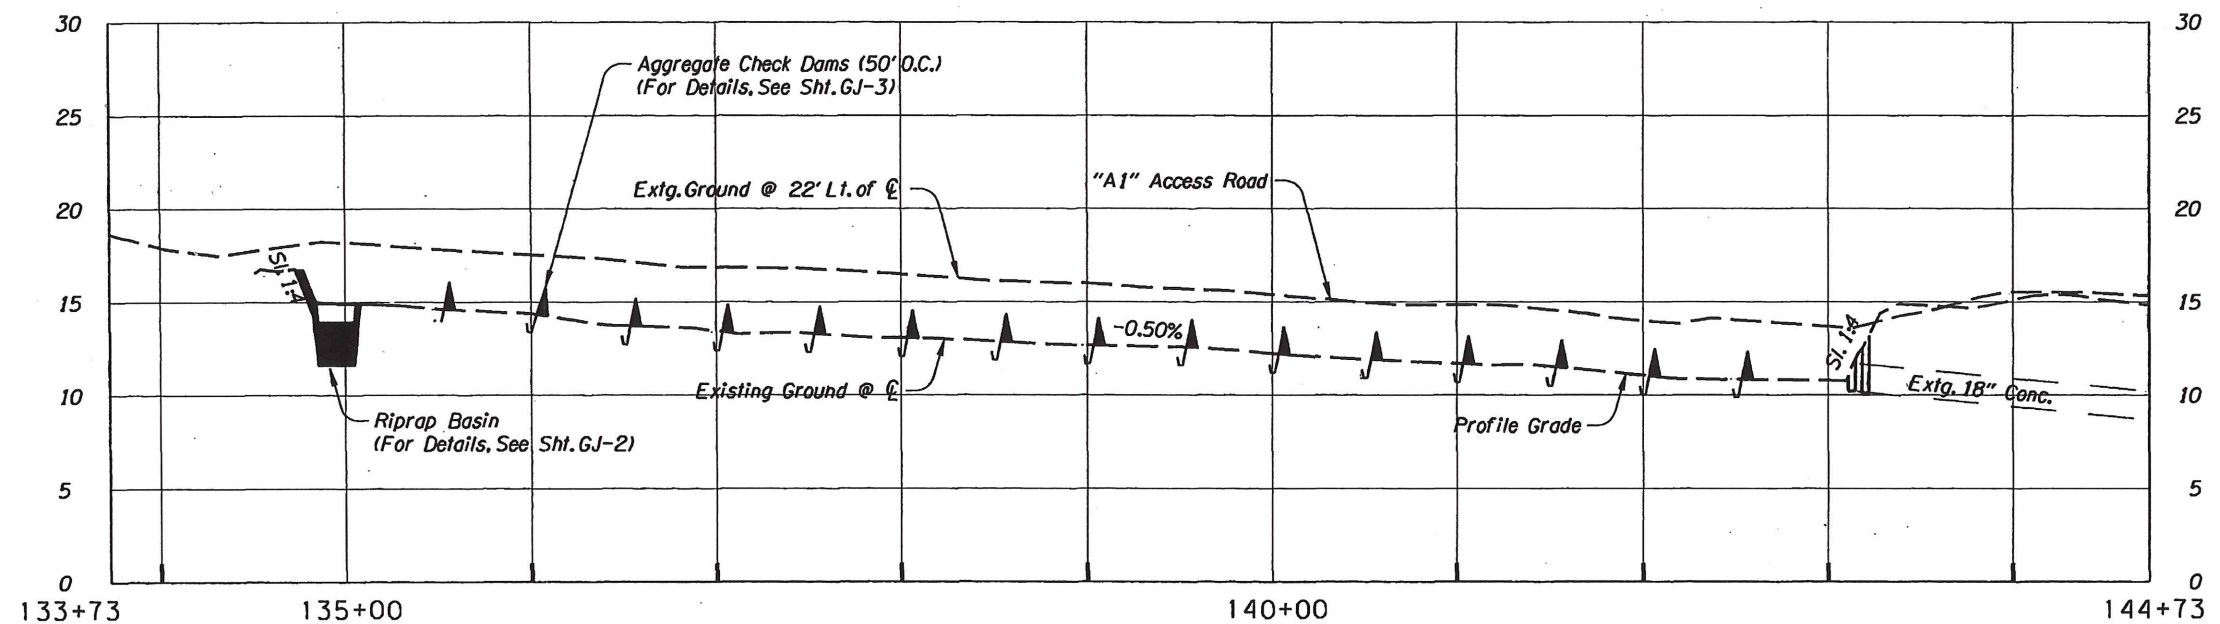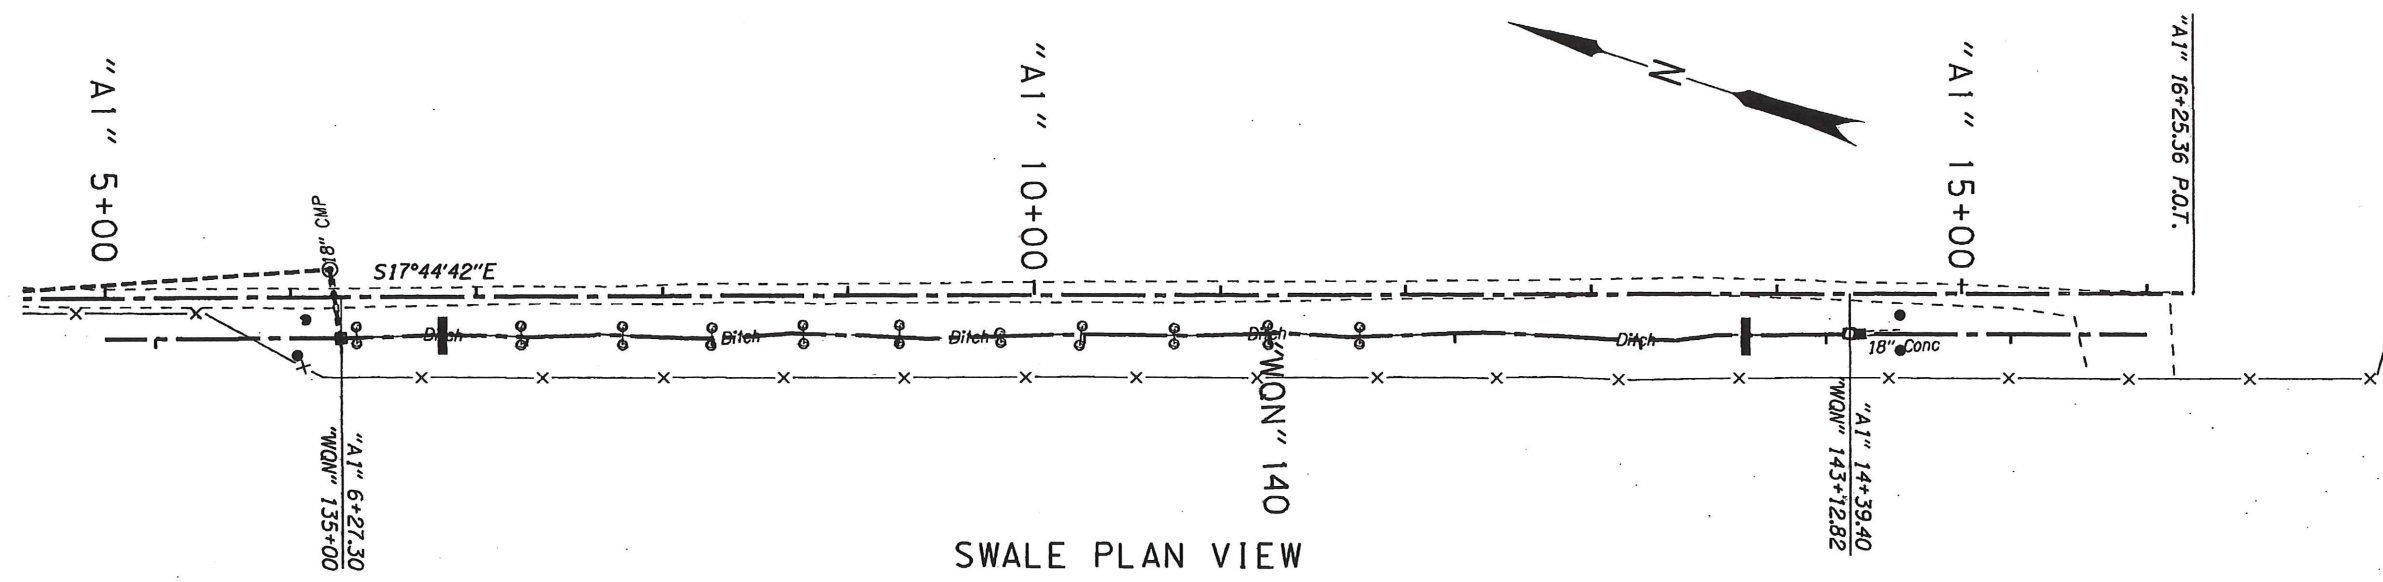


*Adam Markell*  
**"AS CONSTRUCTED"**  
 AUG 25 2017  
 ADAM MARKELL,  
 INTERIM PROJECT MANAGER

REGISTERED PROFESSIONAL  
 ENGINEER  
 58552PE  
*Christine J. Higgins*  
 OREGON  
 JULY 21, 1998  
 CHRISTINE J. HIGGINS  
 Expires June 30, 2015


<b>HDR</b> HDR Engineering, Inc. 0999W: N. VICTORY BLVD. - N. ARGYLE ST. (PORTLAND) SEC. PACIFIC HIGHWAY WEST MULTNOMAH COUNTY	
Design Team Leader - Brian Baker Designed By - Shannon Williams Drafted By - Matt Stelgleder	
<b>DRAINAGE DETAILS</b>	SHEET NO. GJ

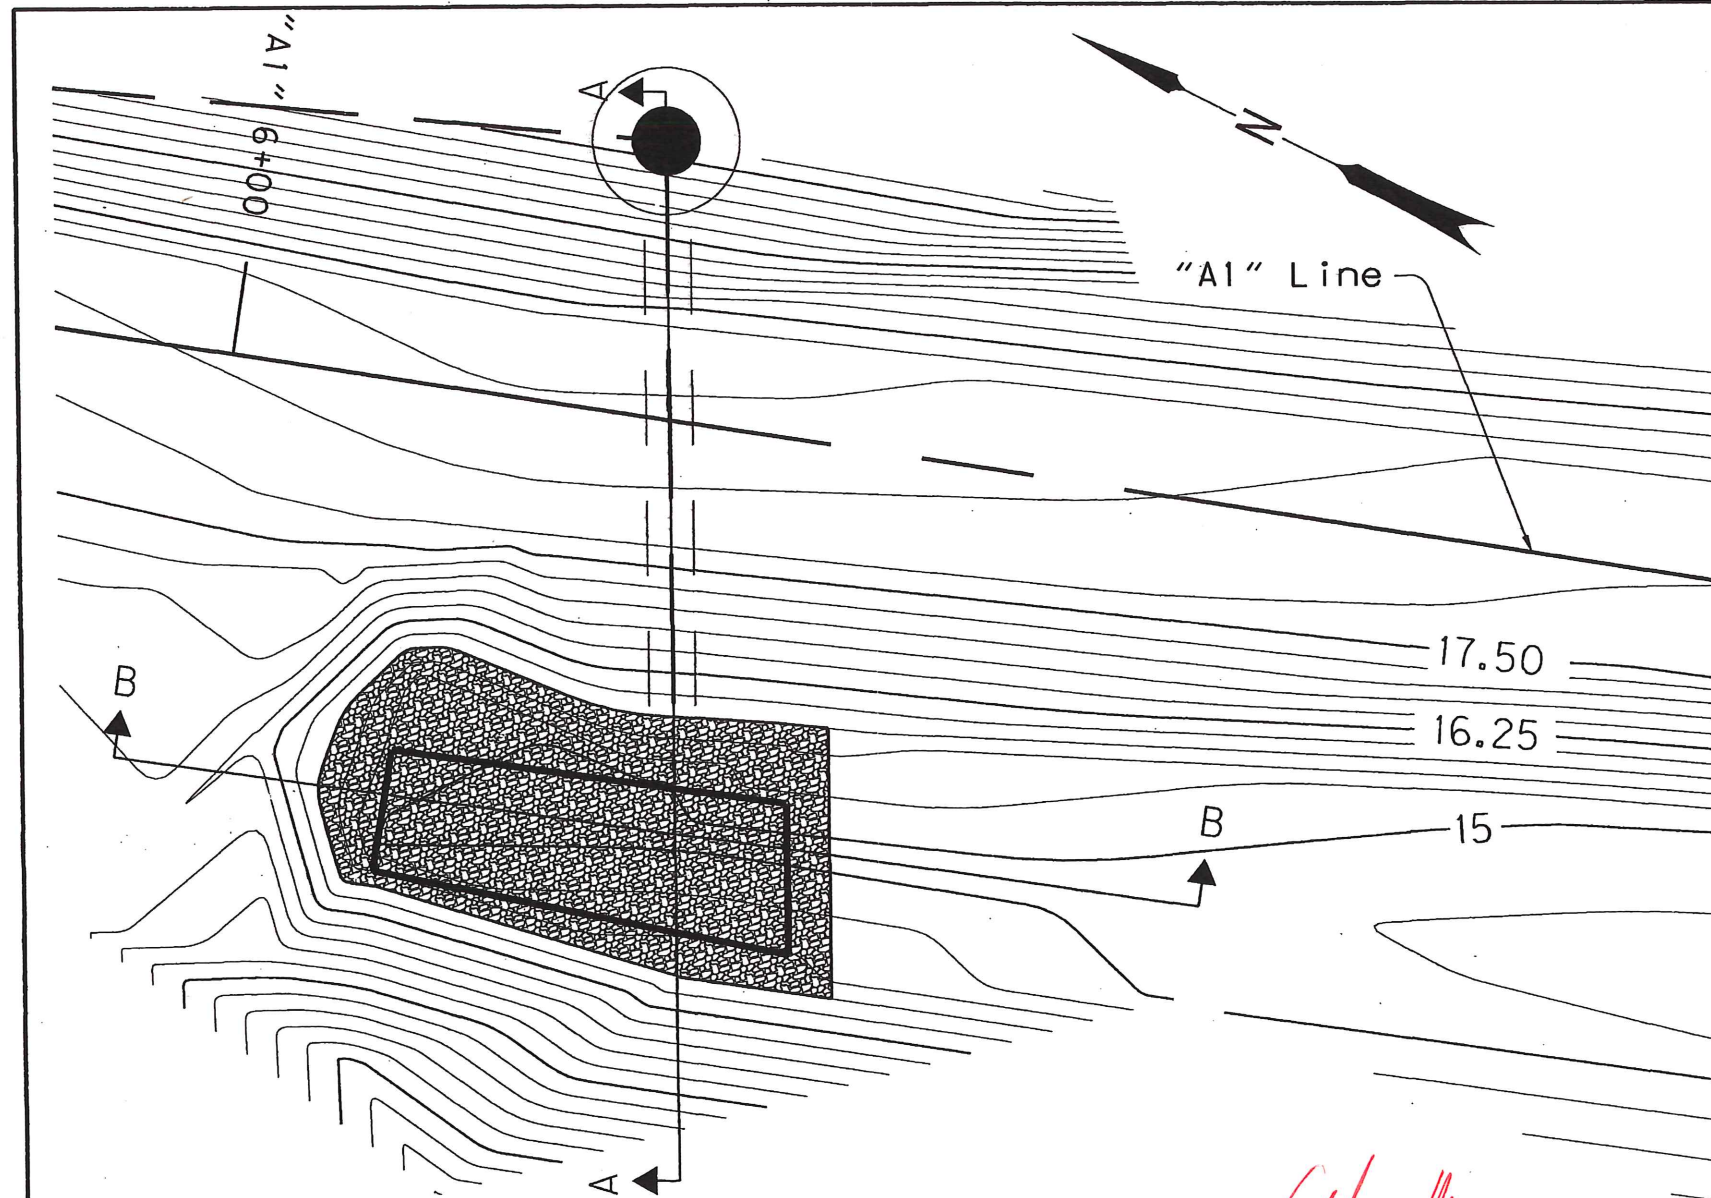

RIPRAP BASIN FOR SWALE


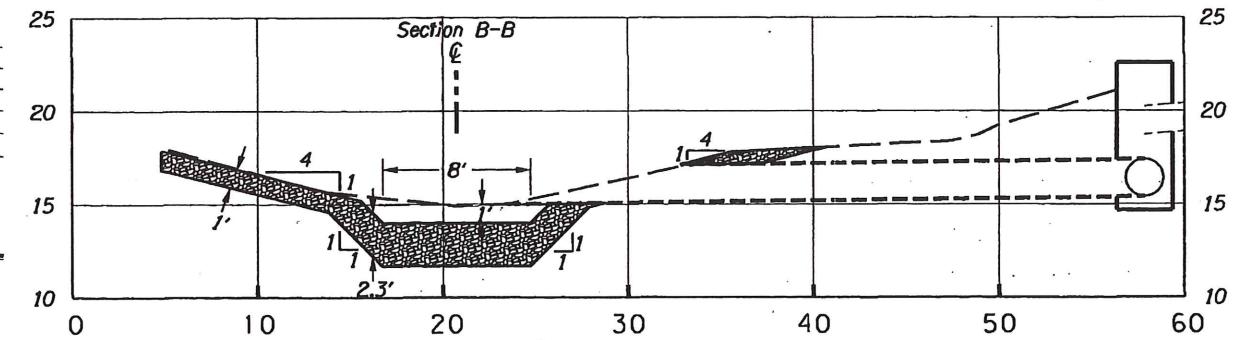


SECTION A-A  
RIPRAP BASIN

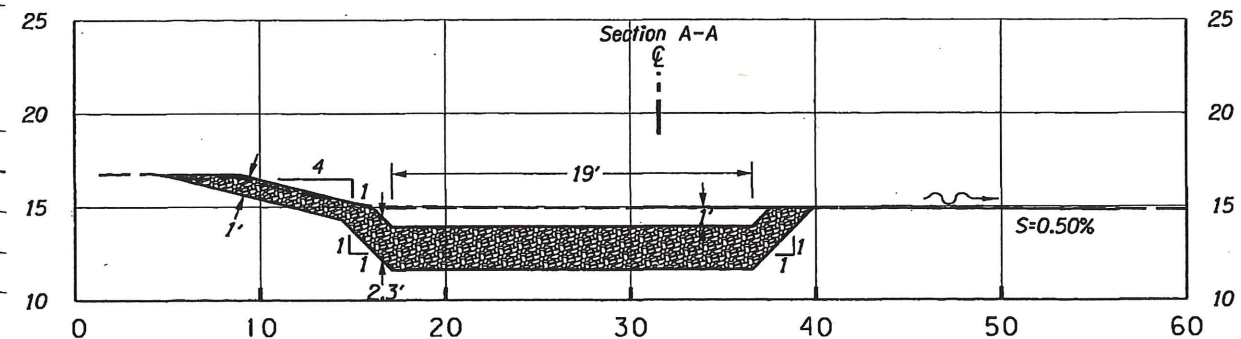


SECTION B-B  
SWALE


*Adam Markell*  
**"AS CONSTRUCTED"**  
 AUG 25 2017  
 ADAM MARKELL,  
 INTERIM PROJECT MANAGER

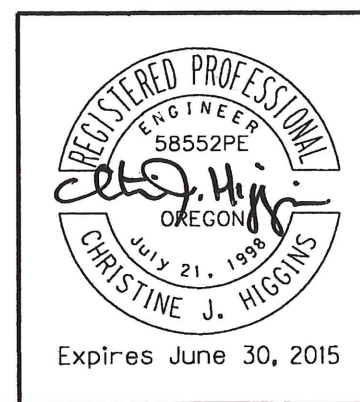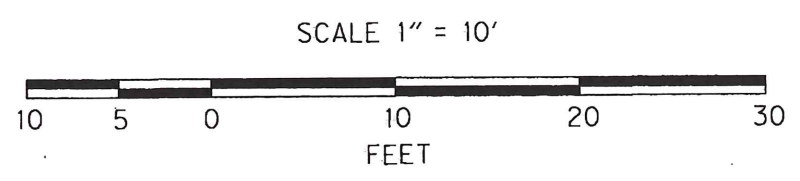


<b>OREGON DEPARTMENT OF TRANSPORTATION</b>	
<b>HDR</b> HDR Engineering, Inc.	
OR99W: N. VICTORY BLVD. - N. ARGYLE ST. (PORTLAND) SEC. PACIFIC HIGHWAY WEST MULTNOMAH COUNTY	
Design Team Leader - Brian Baker Designed By - Shannon Williams Drafted By - Matt Steigleder	
<b>DRAINAGE DETAILS</b>	SHEET NO. <b>GJ-2</b>

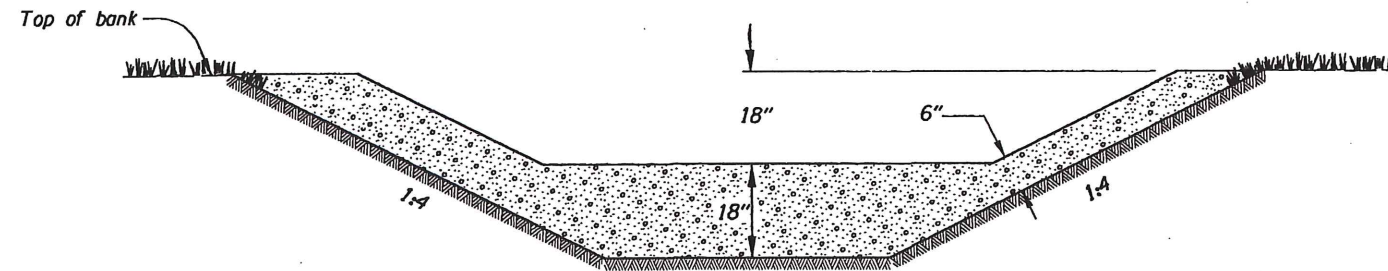


SWALE X-SECTION AT CHECK DAM (NTS)

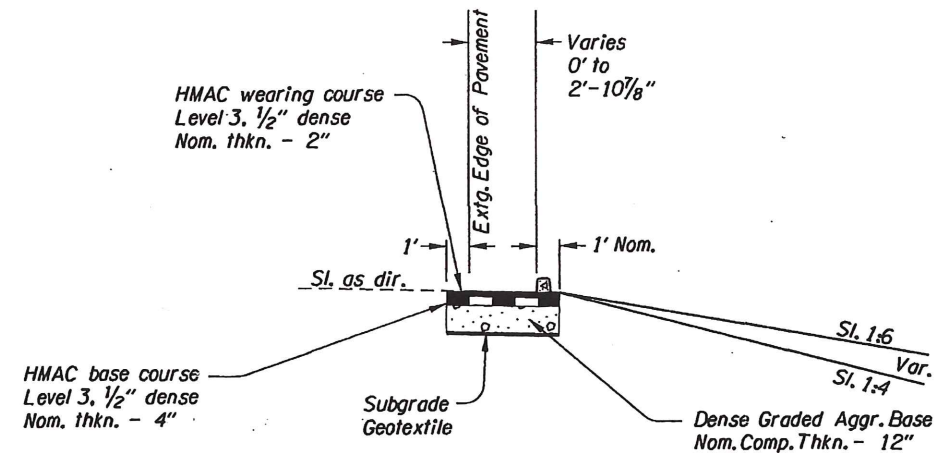

SECTION A-A (NTS)

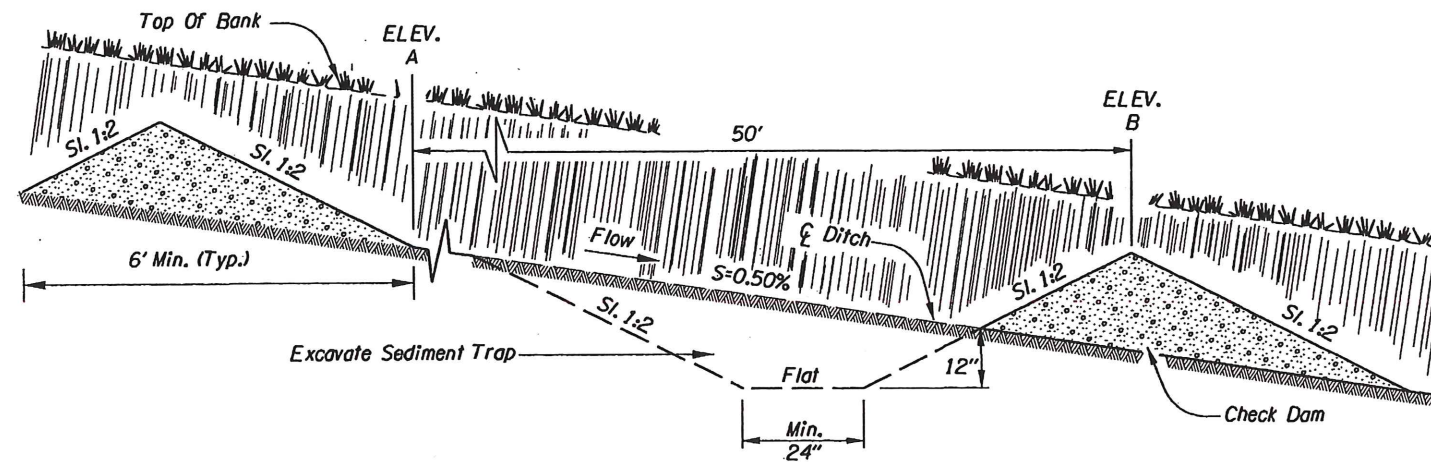


SWALE PROFILE SECTION WITH AGGREGATE CHECK DAMS (NTS)

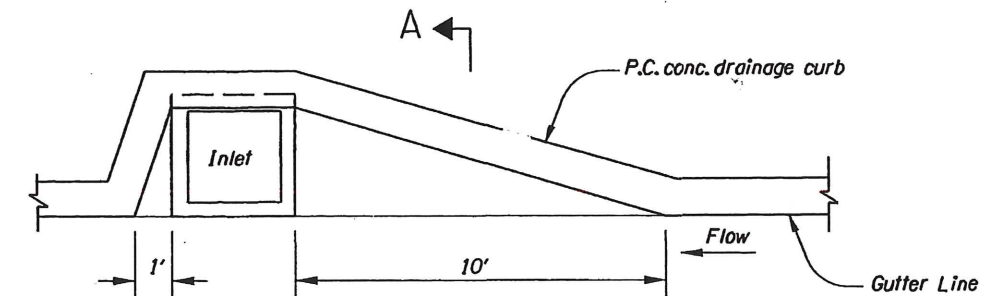


INLET INSTALLATION (NTS)

*Adam Markell*  
**"AS CONSTRUCTED"**  
 AUG 25 2017  
 ADAM MARKELL,  
 INTERIM PROJECT MANAGER

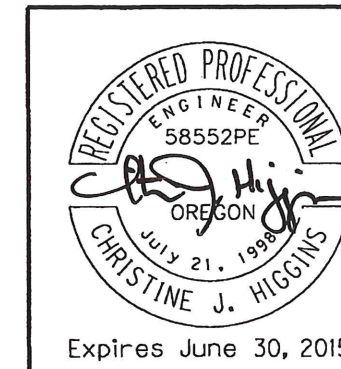


OREGON DEPARTMENT OF TRANSPORTATION	
HDR Engineering, Inc.	
0909W: N. VICTORY BLVD. - N. ARGYLE ST. (PORTLAND) SEC. PACIFIC HIGHWAY WEST MULTNOMAH COUNTY	
Design Team Leader - Brian Baker Designed By - Shannon Williams Drafted By - Matt Steigleder	
<b>DRAINAGE DETAILS</b>	SHEET NO. <b>GJ-3</b>

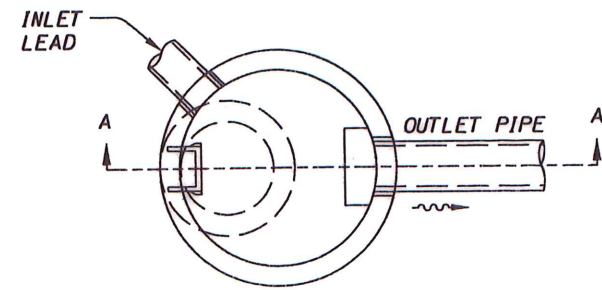


PLAN

Revised plan sheet

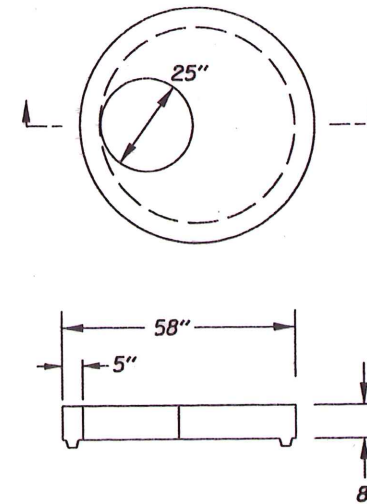

DETAIL A  
(TOP SLAB "A")

- ° FOR USE WITH 48" MANHOLES OR RISER SECTIONS AND STANDARD 24" MANHOLE FRAME
- ° COVER DEPTH LESS THAN 15 INCHES

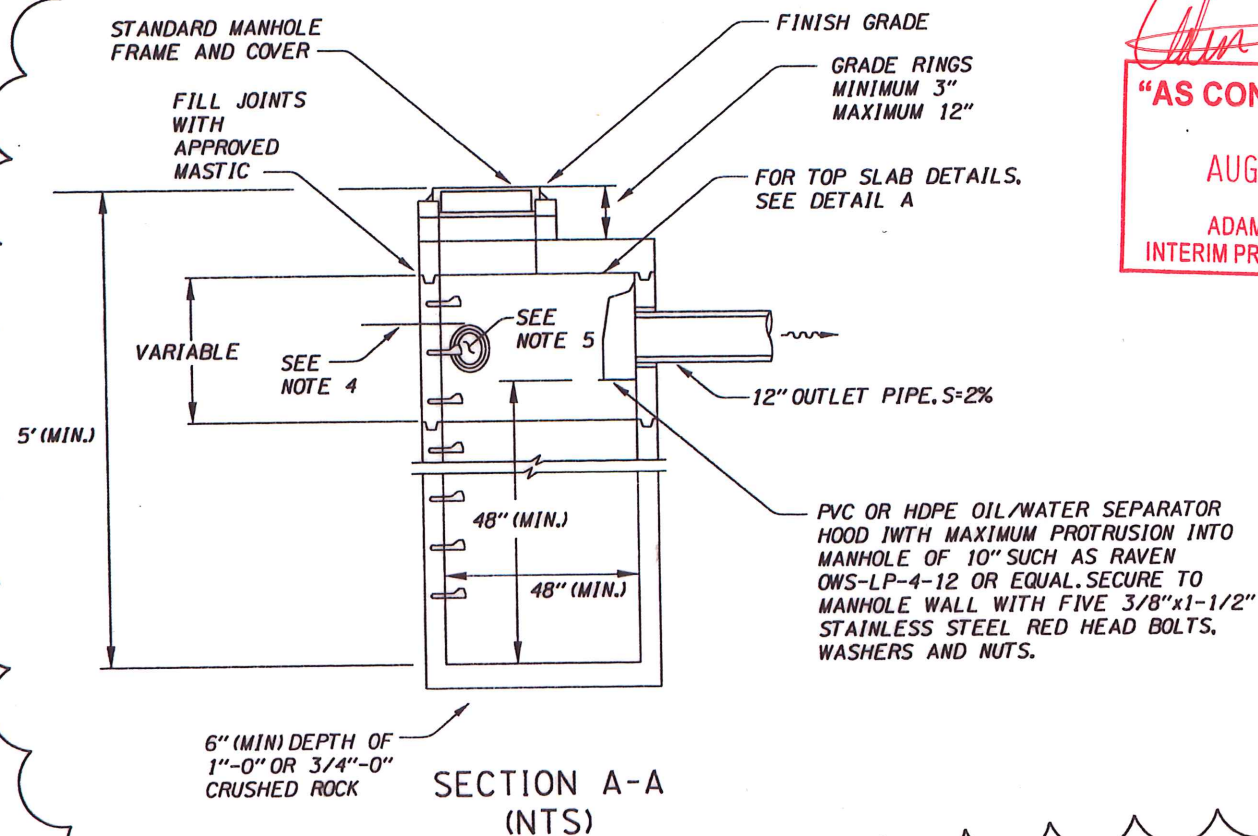

*Adam Markell*  
**"AS CONSTRUCTED"**  
 AUG 25 2017  
 ADAM MARKELL,  
 INTERIM PROJECT MANAGER

NOTES:

1. ALL PRECAST SECTIONS SHALL CONFORM TO THE REQUIREMENTS OF THE CITY OF PORTLAND MANUFACTURING STANDARDS FOR PRECAST CONCRETE PRODUCTS (MSPCP), AS REVISED.
2. MANHOLE STEPS-REFER TO THE STANDARD DETAIL P-168.
3. PROVIDE A FLEXIBLE JOINT FOR ALL CONNECTED PIPES:
  - ° RIGID PIPE LESS THAN 36 INCHES-18 INCHES (MAX.) FROM OUTSIDE WALL
  - ° FLEXIBLE PIPE - 18 INCHES (MAX.) FROM THE OUTSIDE WALL UNLESS A FLEXIBLE JOINT FITTING IS INSTALLED AND ACCEPTED.
4. PROVIDE 12 INCHES (MIN.) OF SEPARATION BETWEEN A SECTION JOINT AND THE OUTER EDGE OF ANY OPENING.
5. LOCATE INVERT OF ANY INLET LEAD 6 INCHES (MIN.) ABOVE THE OUTLET PIPE INVERT.
6. ALL PRECAST CONCRETE SHALL CONFORM TO THE REQUIREMENTS OF THE CITY OF PORTLAND MANUFACTURING STANDARDS FOR PRECAST CONCRETE PRODUCTS (MSPCP), AS REVISED.
7. FOR EACH TOP SLAB, REFER TO MSPCP FOR COMPLETE SIZE AND REINFORCEMENT DETAILS.
8. ALL TOP SLABS SHALL HAVE KEYED OR BELL AND SPIGOT JOINTS AND SHALL USE PREFORMED PLASTIC SEALS (MASTIC) OR PREFORMED RUBBER GASKET SEALS ACCORDING TO THE MANUFACTURER'S SPECIFICATIONS.

No.	DATE	REVISIONS	BY
1	12-18-2014	REVISED DETAIL AND NOTES	M.D.S.

*Steve Tomlin* 12/30/14  
 CITY ENGINEER  
 Bureau of Environmental Services Approval  
 BES JOB NO. 7E5TRSD00090  
 BES JOB TITLE: OR99W (Denver): Victory-Argyle  
*Wiley Flynn* 12/29/14  
 Chief Engineer Reg. Prof. Engr. Date

REGISTERED PROFESSIONAL ENGINEER  
 58552PE  
*Christine J. Higgins*  
 OREGON  
 July 21, 1998  
 CHRISTINE J. HIGGINS  
 Expires June 30, 2015

**OREGON DEPARTMENT OF TRANSPORTATION**

**HDR** HDR Engineering, Inc.  
 OR99W: N. VICTORY BLVD. - N. ARGYLE ST.  
 (PORTLAND) SEC.  
 PACIFIC HIGHWAY WEST  
 MULTNOMAH COUNTY

Design Team Leader - Brian Baker  
 Designed By - Shannon Williams  
 Drafted By - Matt Steigleder

**DRAINAGE DETAILS** SHEET NO. GJ-4




STATE OF OREGON  
DEPARTMENT OF TRANSPORTATION  
PLANS FOR PROPOSED PROJECT

GRADING, DRAINAGE, STRUCTURES, PAVING, SIGNING,  
ILLUMINATION, SIGNALS & ROADSIDE DEVELOPMENT

**I-5: VICTORY BLVD. TO LOMBARD ST. SECTION**  
PACIFIC HIGHWAY  
MULTNOMAH COUNTY  
JANUARY 2008

INDEX OF SHEETS	
SHEET NO.	DESCRIPTION
1	Title Sheet
1A, 1A-2	Index Of Sheets Cont'd.
1B	Std. Drg. Nos.
1C	Sheet Layout
1D	Survey Control Network
1E	Survey Control Chart

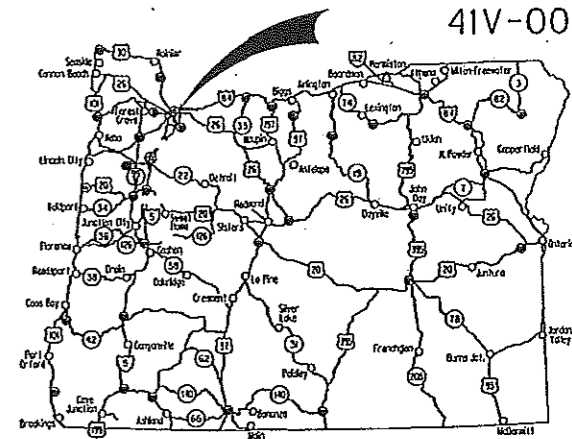


Overall Length Of Project - 1.22 Miles

**ATTENTION:**  
Oregon Law Requires You To Follow Rules Adopted By The Oregon Utility Notification Center. Those Rules Are Set Forth In OAR 952-001-0010 Through OAR 952-001-0090. You May Obtain Copies Of The Rules By Calling The Center. (Note: The Telephone Number For The Oregon Utility Center Is (503) 232-1987.)

**"AS CONSTRUCTED"**  
*Mike Bevan*  
Date 11/26/14 Project Mgr

**BEGINNING OF PROJECT**  
**IM-STP-S001(258)**  
**STA. "L2" 129+93.4 (M.P. 306.70)**

**END OF PROJECT**  
**IM-STP-S001(258)**  
**STA. "L2" 193+92.8 (M.P. 305.48)**

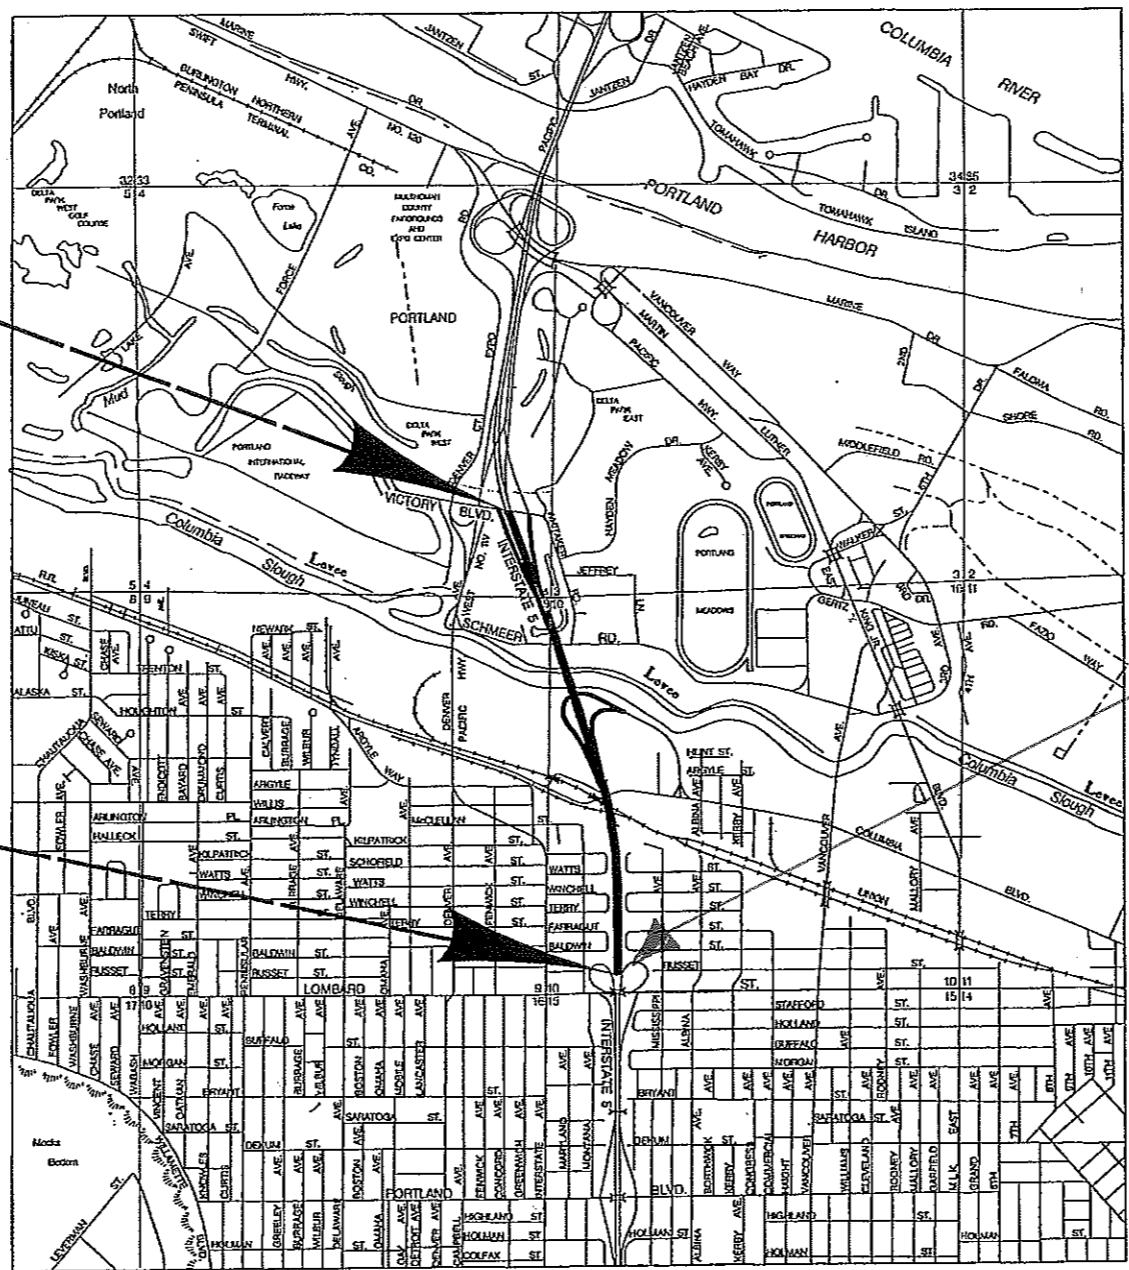

Additional work was done in each of the Lombard loops. This included burial of soil that was contaminated.



- OREGON TRANSPORTATION COMMISSION**
- Stuart Foster CHAIRMAN
  - Gail L. Achterman COMMISSIONER
  - Mike Nelson COMMISSIONER
  - Randall Pope COMMISSIONER
  - Janice J. Wilson COMMISSIONER
  - Matthew L. Garrett DIRECTOR OF TRANSPORTATION

PLANS PREPARED FOR  
**OREGON DEPARTMENT OF TRANSPORTATION**  
BY:  
**DAVID EVANS AND ASSOCIATES INC.**




OREGON DEPARTMENT OF TRANSPORTATION  
CONCURRENCE  
*Ch. M. A.* 12-07  
TECHNICAL SERVICES MANAGING ENGINEER DATE

I-5: VICTORY BLVD. TO LOMBARD ST. SECTION PACIFIC HIGHWAY MULTNOMAH COUNTY		
FEDERAL HIGHWAY ADMINISTRATION	PROJECT NUMBER	SHEET NO.
OREGON DIVISION	IM-STP-S001(258)	1



Sec. 3, 4, 9, 10, T. 1 N., R. 1 E., W.M.

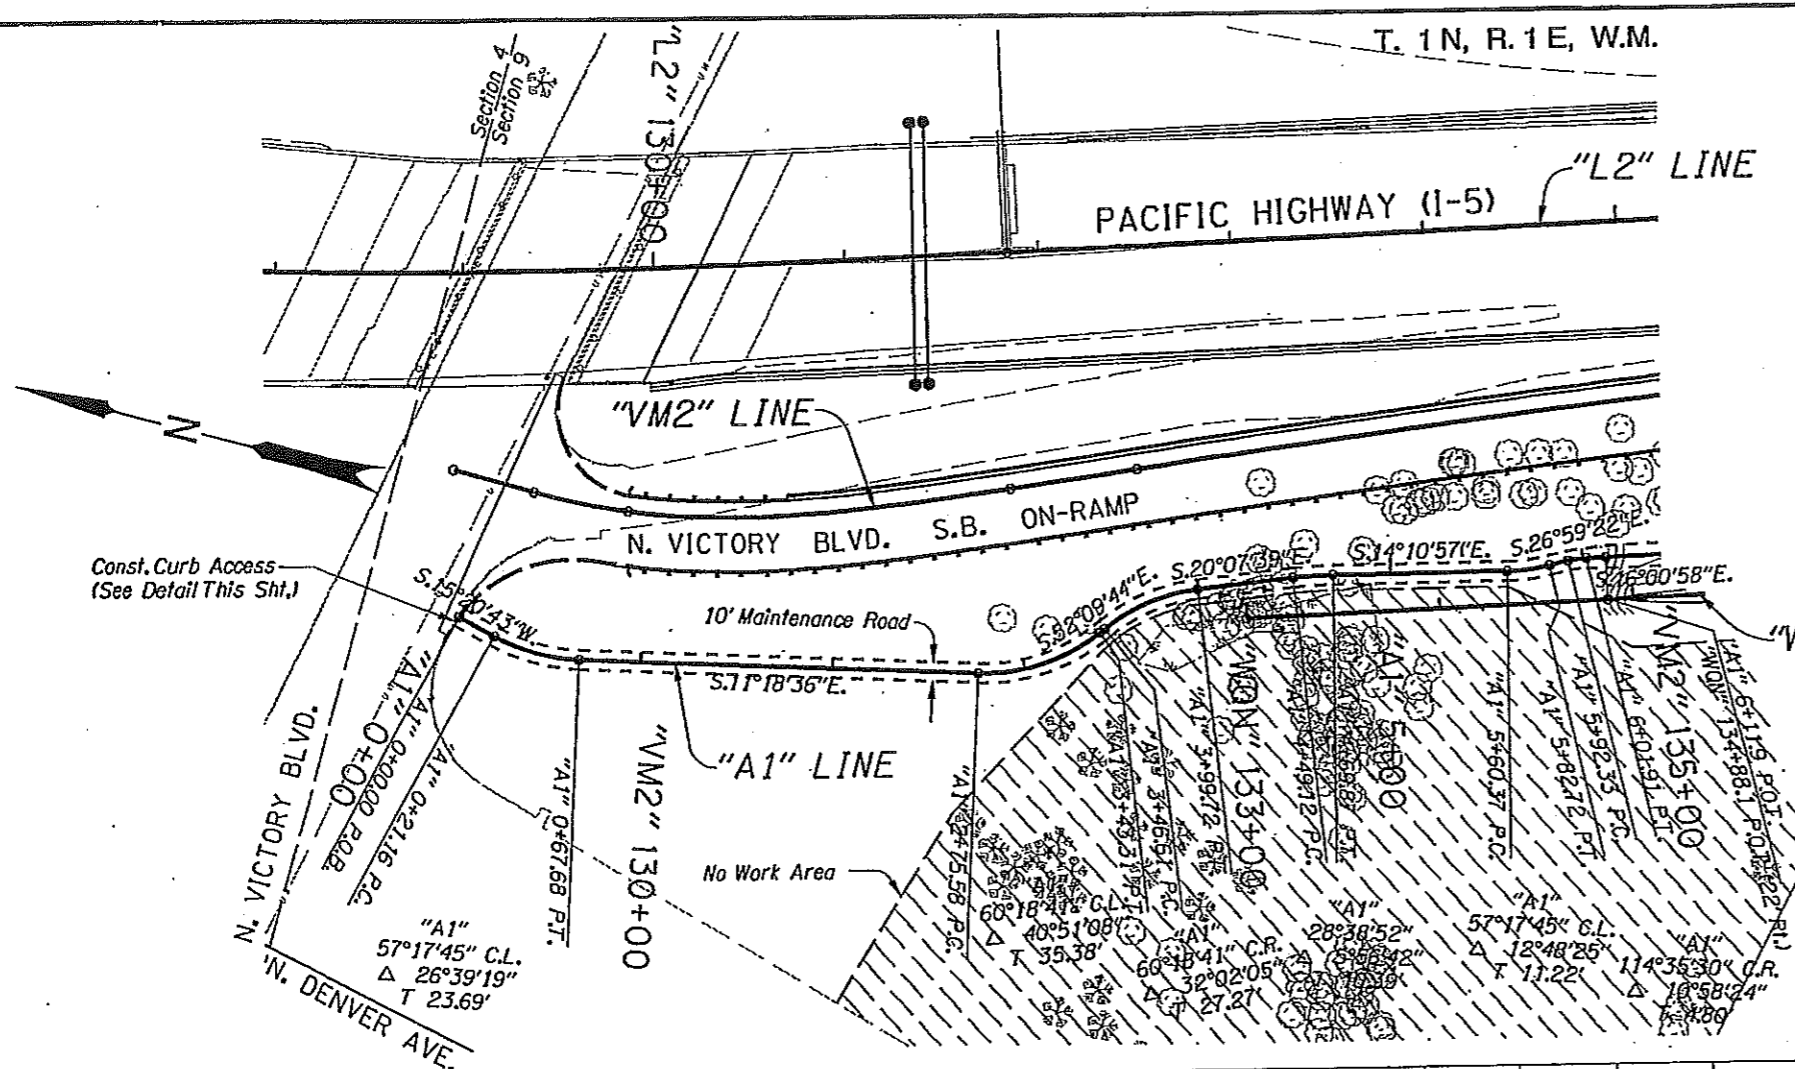


**"AS CONSTRUCTED"**

*[Signature]*

Date: 11/26/14 Project Mngr


Legend

No Work Area Shown Thus:

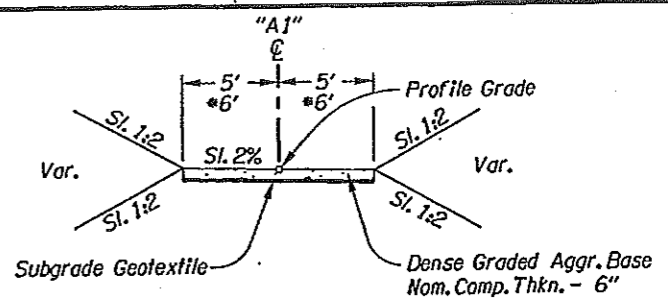


STA. "A1" 0+00.0 To STA. "A1" 6+00.0  
 \* "A1" 6+00.0 To STA. "A1" 6+11.9

NOTE:  
 1. Side-Slopes Are Shown As Vert. To Horiz.

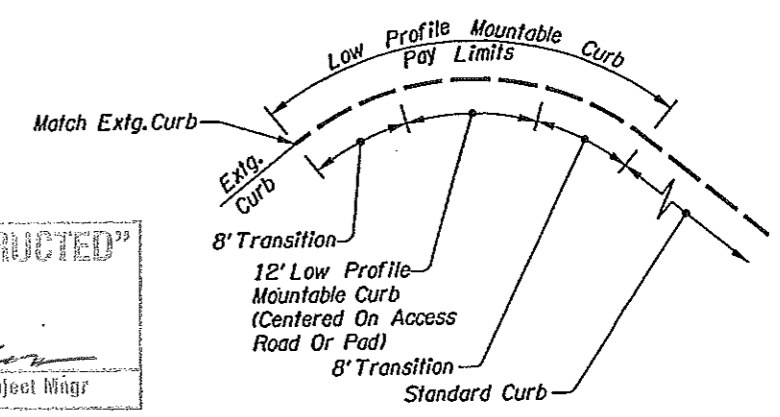

**CURB ACCESS DETAIL**

NOTE:  
 1. For Transition Details, See Drg. No. TM499

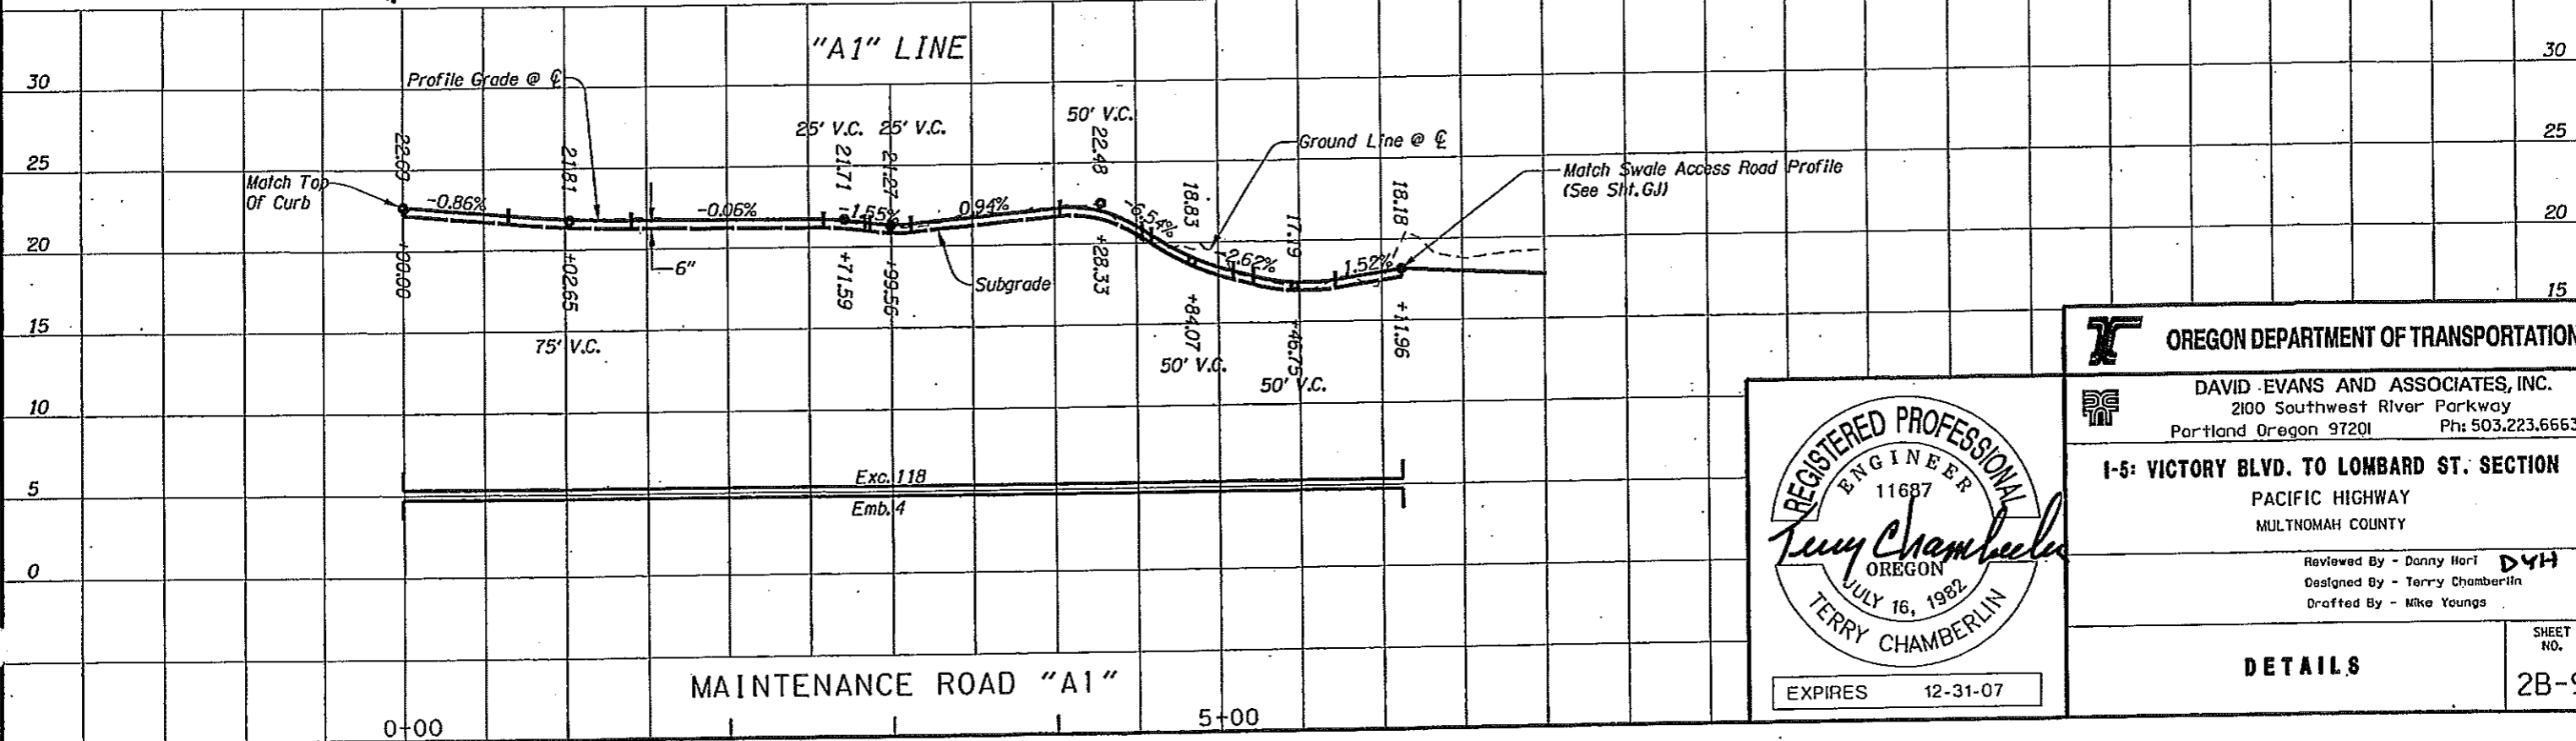

REGISTERED PROFESSIONAL ENGINEER 11687

*Terry Chamberlin*

OREGON

JULY 16, 1982

TERRY CHAMBERLIN

EXPIRES 12-31-07

**OREGON DEPARTMENT OF TRANSPORTATION**

DAVID EVANS AND ASSOCIATES, INC.  
 2100 Southwest River Parkway  
 Portland Oregon 97201 Ph: 503.223.6663




**I-5: VICTORY BLVD. TO LOMBARD ST. SECTION**  
 PACIFIC HIGHWAY  
 MULTNOMAH COUNTY

Reviewed By - Danny Hort **DYH**  
 Designed By - Terry Chamberlin  
 Drafted By - Mike Youngs


**DETAILS**

SHEET NO. **2B-9**



Sec. 9, T. 1 N, R. 1 E, W.M.

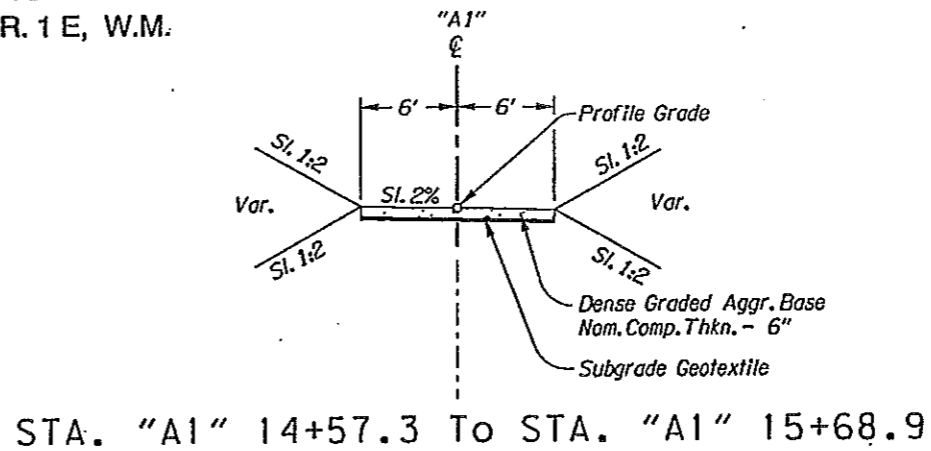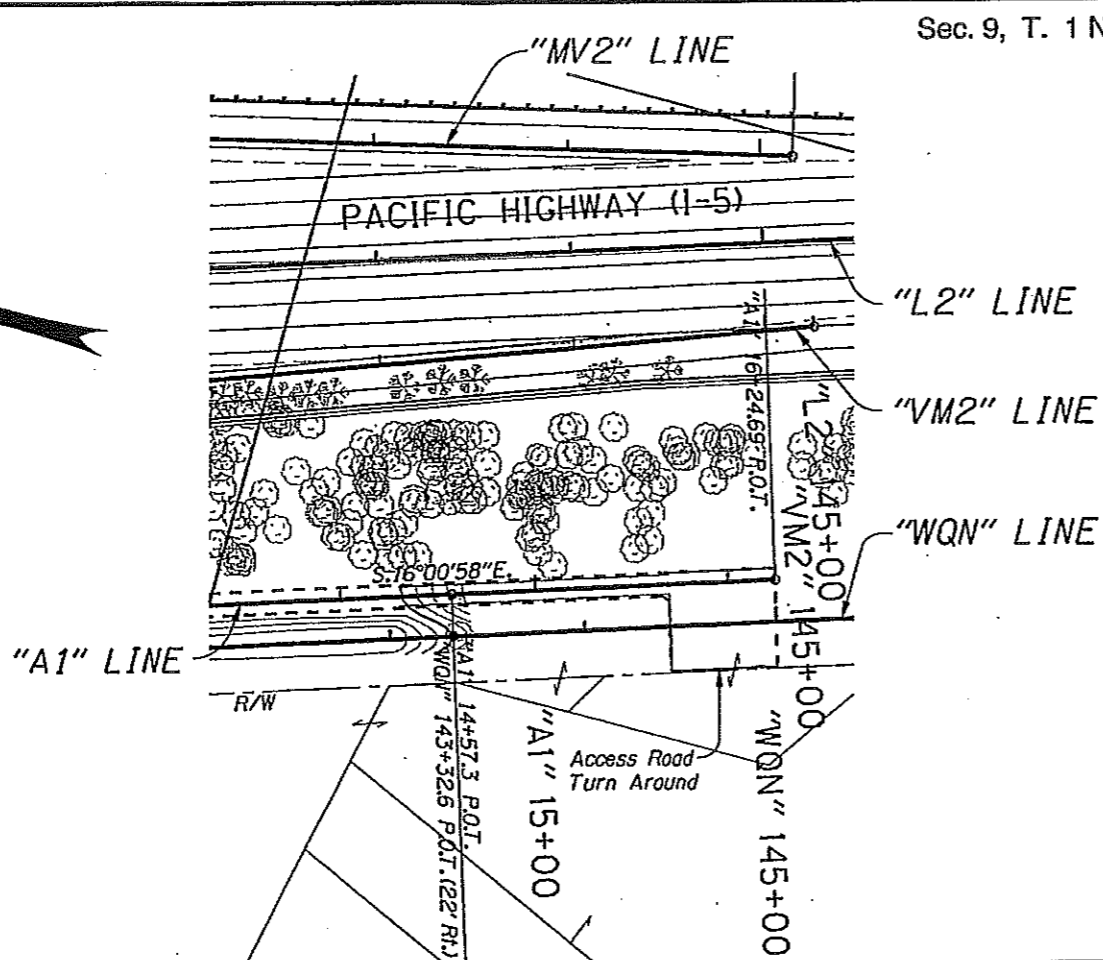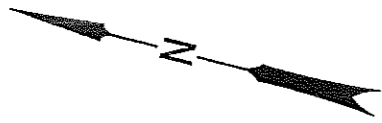

**"AS CONSTRUCTED"**  
*Mark Ben*  
 Date 11/26/14 Project Ring

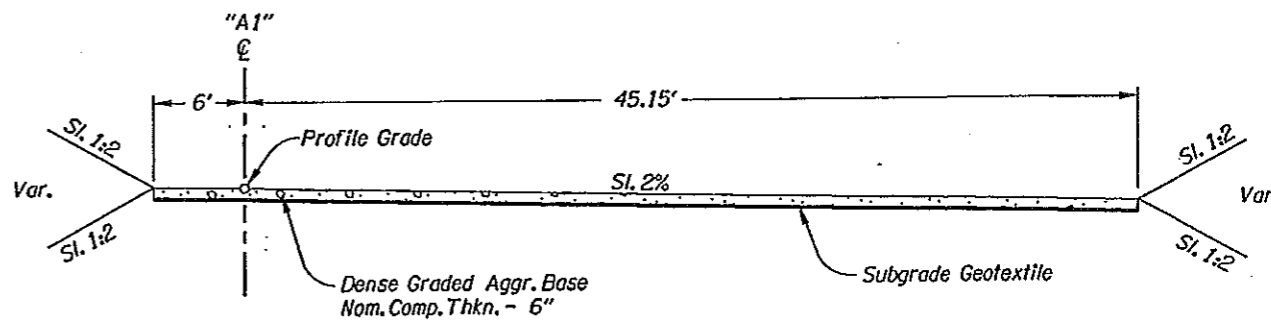



NOTE:  
 1. Side-Slopes Are Shown As Vert. To Horiz.

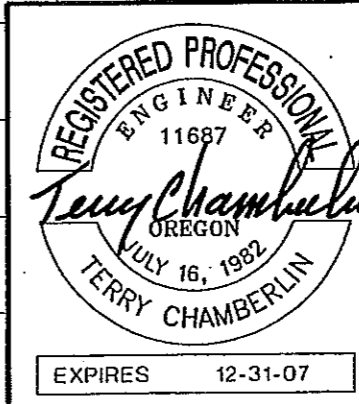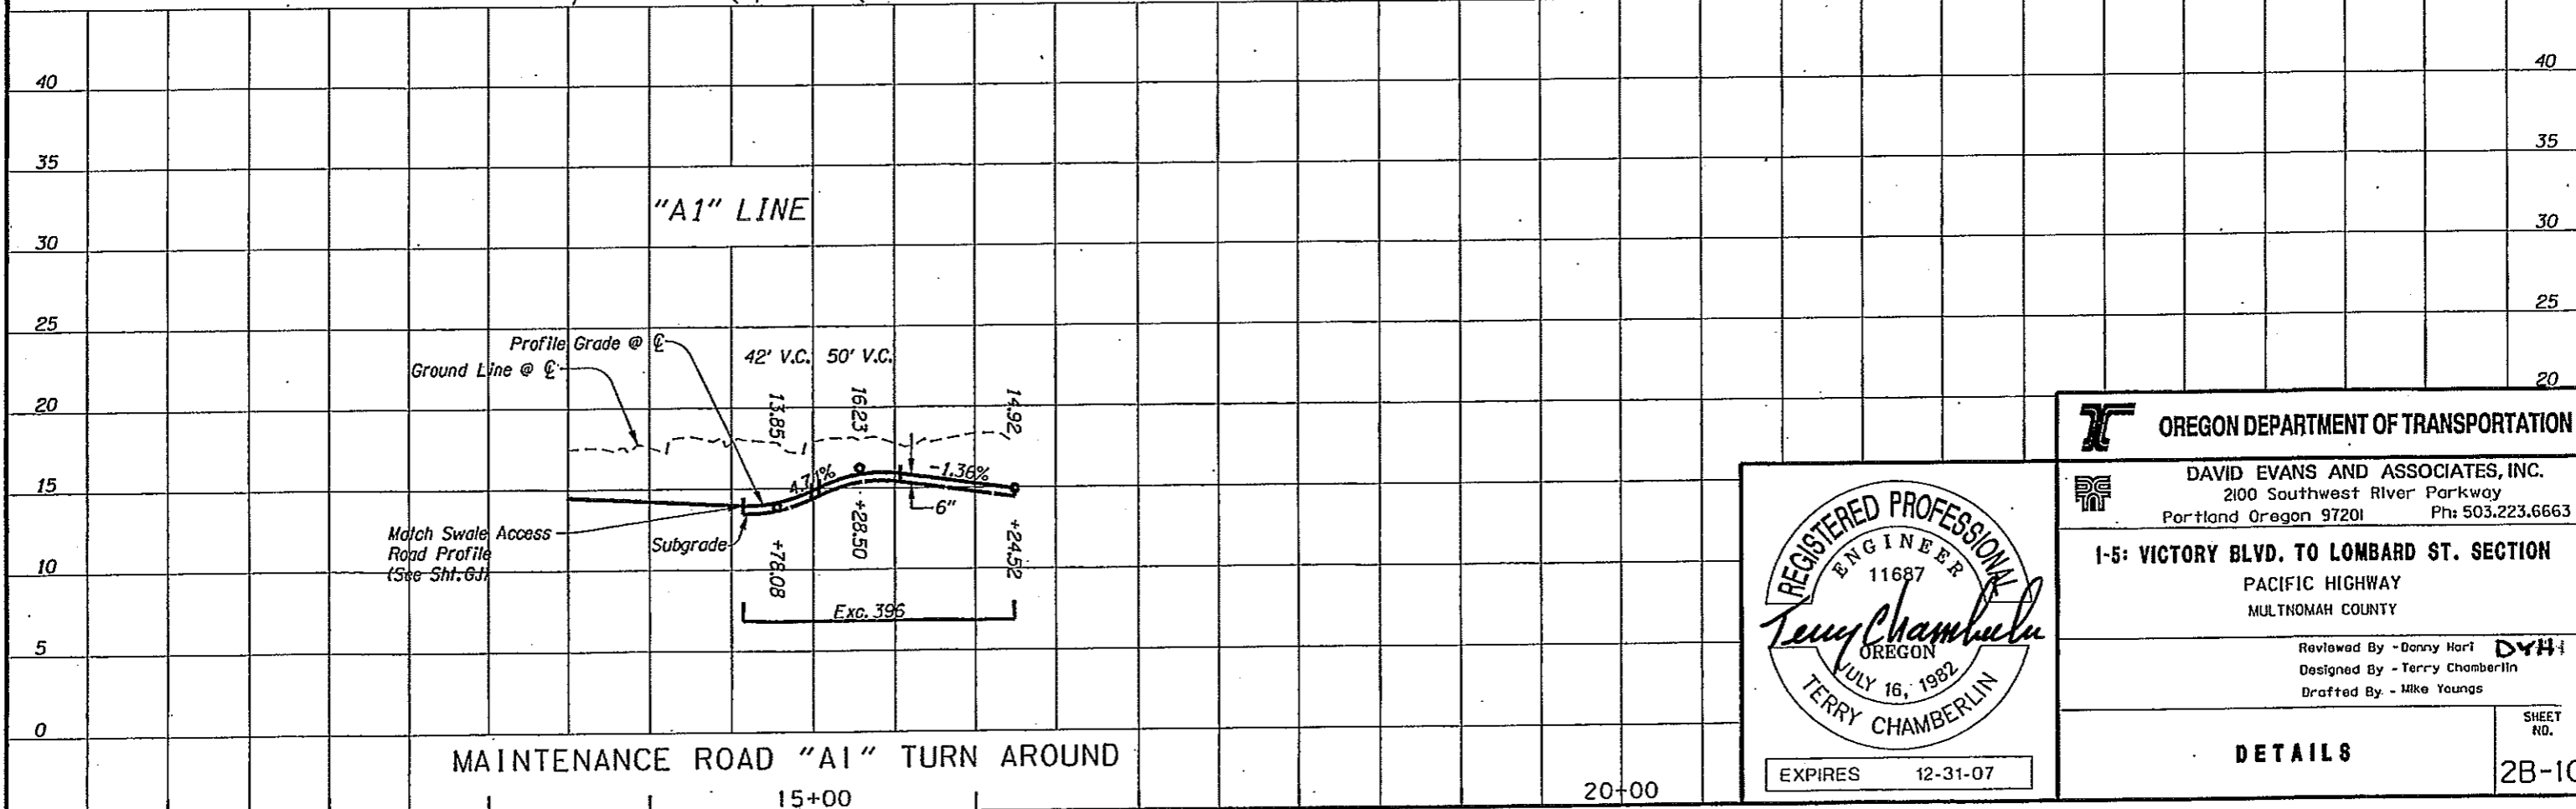

**OREGON DEPARTMENT OF TRANSPORTATION**  
 DAVID EVANS AND ASSOCIATES, INC.  
 2100 Southwest River Parkway  
 Portland Oregon 97201 Ph: 503.223.6663  
**I-5: VICTORY BLVD. TO LOMBARD ST. SECTION**  
 PACIFIC HIGHWAY  
 MULTNOMAH COUNTY  
 Reviewed By - Denny Harl  
 Designed By - Terry Chamberlin  
 Drafted By - Mike Youngs

**DETAILS**

SHEET NO.  
**2B-10**

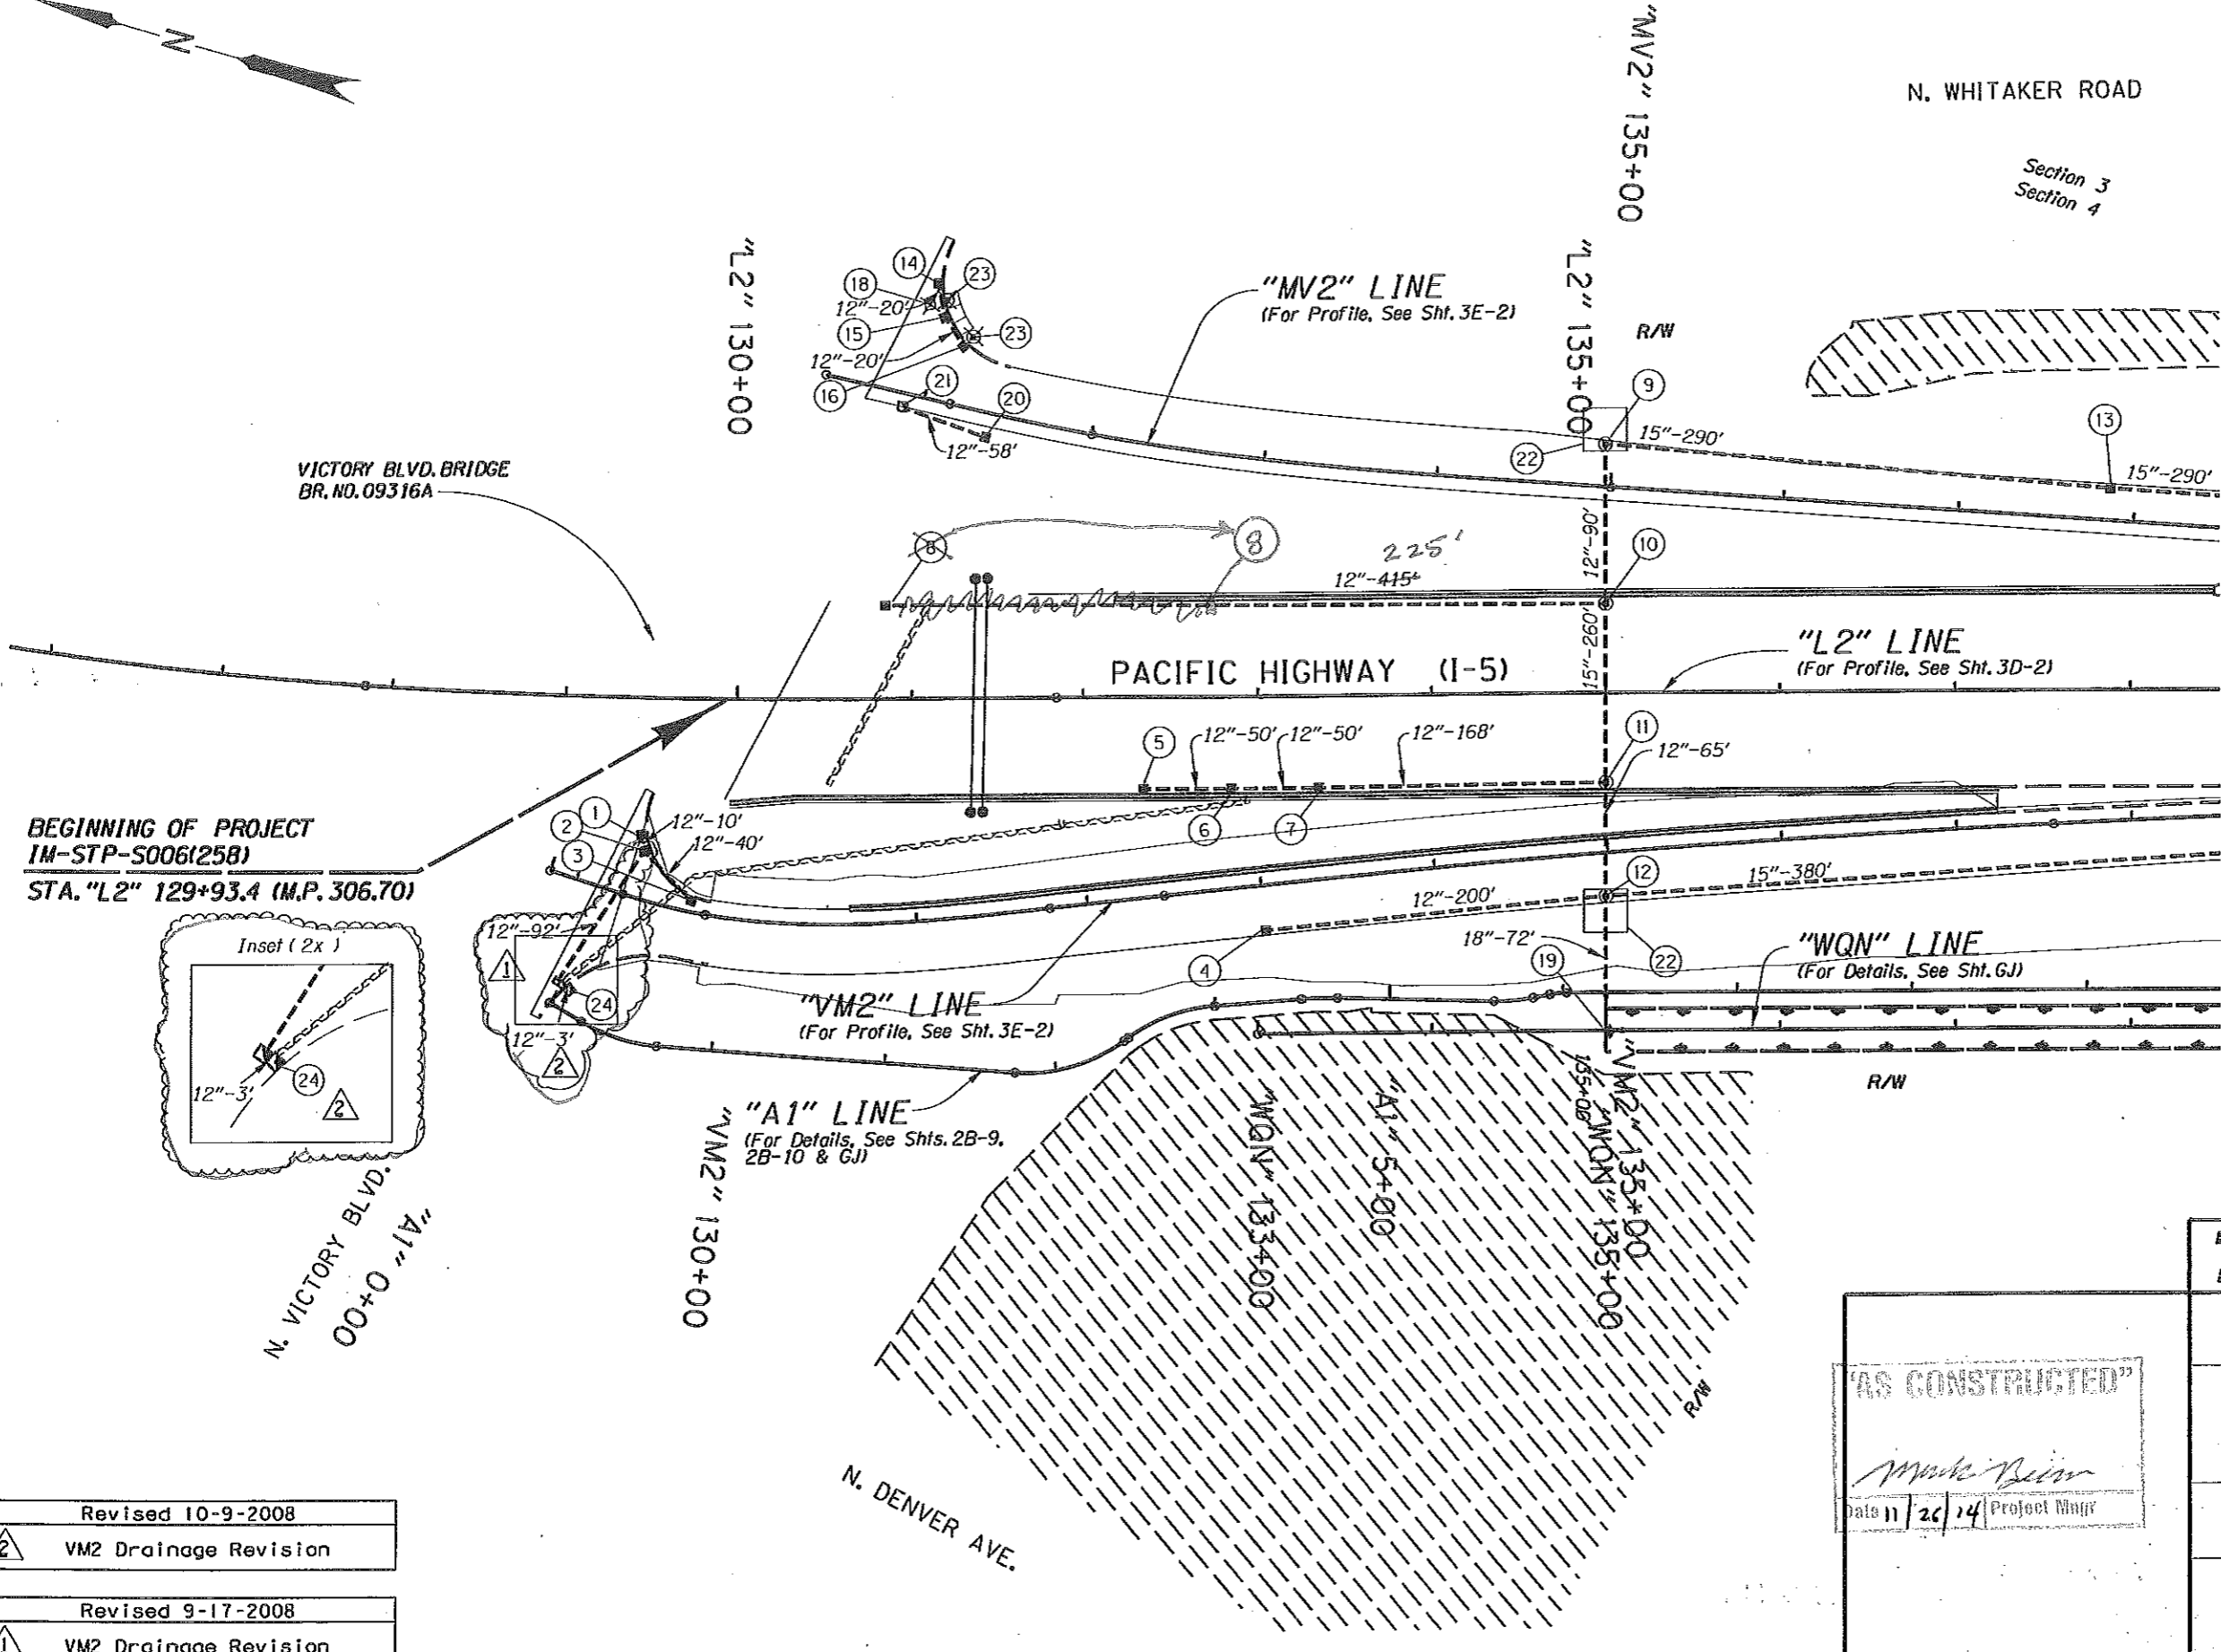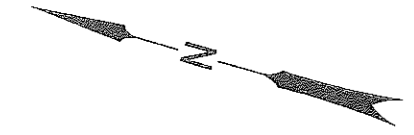

N. WHITAKER ROAD

Section 3  
Section 4

"MV2" LINE  
(For Profile, See Sht. 3E-2)

"L2" LINE  
(For Profile, See Sht. 3D-2)

"VM2" LINE  
(For Profile, See Sht. 3E-2)


"A1" LINE  
(For Details, See Shts. 2B-9,  
2B-10 & GJ)

"WQN" LINE  
(For Details, See Sht. GJ)

Remove or Abandon Pipe  
Shown Thus:

No Work Area Shown Thus:

BEGINNING OF PROJECT  
IM-STP-S006(258)  
STA. "L2" 129+93.4 (M.P. 306.70)

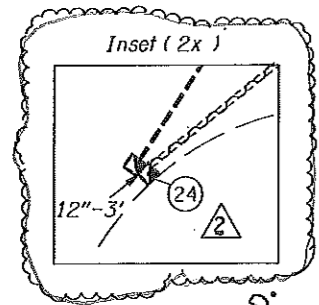

N. VICTORY BLVD.  
"A1" 0+00

Revised 10-9-2008
VM2 Drainage Revision
Revised 9-17-2008
VM2 Drainage Revision

"AS CONSTRUCTED"

*Madelein*

Date 11/26/14 Project Mgr

OREGON DEPARTMENT OF TRANSPORTATION

I-5: VICTORY BLVD. TO LOMBARD ST. SECTION  
PACIFIC HIGHWAY  
MULTNOMAH COUNTY

Reviewed By - CHRIS STEINBREGER  
Designed By - DAN MILLER  
Drafted By - STERLIN DRIGGS

DRAINAGE AND UTILITIES

SHEET NO.  
3B

- ① Sta. "VM2" 129+25, Lt.  
Const. Type "G-2" Inlet  
(See Drg. No. RD364)
- ② Sta. "VM2" 129+30, Lt.  
Const. Type "G-2" Inlet  
Inst. 12" Storm Sew. Pipe - 50'  
5' Depth  
(See Drg. Nos. RD300, RD326, RD380,  
RD384 & RD386)
- ③ Sta. "VM2" 129+68, Lt.  
Const. Type "G-2" Inlet
- ④ Sta. "VM2" 133+00, Rt.  
Const. Type "G-2" Inlet
- ⑤ Sta. "L2" 132+35, Rt.  
Const. Type "G-2" Inlet  
~~Adjust Inlet with Open-Grade-HMAC Inlet Mod.~~  
(See Drg. Nos. ~~RD344~~ & RD376)
- ⑥ Sta. "L2" 132+85, Rt.  
Const. Type "G-2" Inlet  
~~Adjust Inlet with Open-Grade-HMAC Inlet Mod.~~  
Inst. 12" Storm Sew. Pipe - 50'  
5' Depth
- ⑦ Sta. "L2" 133+35, Rt.  
Const. Type "G-2" Inlet  
~~Adjust Inlet with Open-Grade-HMAC Inlet Mod.~~  
Inst. 12" Storm Sew. Pipe - 50'  
5' Depth
- ⑧ Sta. "L2" 130+85, Lt.  
Const. Type "G-2" Inlet  
~~Adjust Inlet with Open-Grade-HMAC Inlet Mod.~~
- ⑨ Sta. "MV2" 135+00, Lt.  
Const. Manhole With Type "G-2" Inlet  
Inst. 15" Storm Sew. Pipe - 290'  
5' Depth  
Inst. 12" Storm Sew. Pipe - 90'  
20' Depth  
(See Drg. No. RD348)
- ⑩ Sta. "L2" 135+00, Lt.  
Const. Manhole With Type "G-2" Inlet  
~~Adjust Inlet with Open-Grade-HMAC Inlet Mod.~~  
Inst. 12" Storm Sew. Pipe - 415'  
10' Depth
- ⑪ Sta. "L2" 135+00, Rt.  
Const. Manhole With Type "G-2" Inlet  
~~Adjust Inlet with Open-Grade-HMAC Inlet Mod.~~  
Inst. 12" Storm Sew. Pipe - 168'  
10' Depth
- ⑫ Sta. "VM2" 135+00, Rt.  
Const. Manhole With Type "G-2" Inlet  
Inst. 15" Storm Sew. Pipe - 260'  
Bore Under Roadway  
Inst. 12" Storm Sew. Pipe - 65'  
20' Depth  
Inst. 12" Storm Sew. Pipe - 200'  
10' Depth  
Inst. 15" Storm Sew. Pipe - 380'  
5' Depth  
(See Drg. No. RD308)  
(For Details, See Sht. GJ-3)

① to ② - 10'  
DUCTILE IRON

- ⑬ Sta. "MV2" 137+90, Lt. 296'  
Const. Type "G-2" Inlet  
Inst. 15" Storm Sew. Pipe - 290'  
5' Depth
- ⑭ Sta. "MV2" 130+90, Lt. 130+94.3, 64.8 Lt.  
Const. Type "G-2" Inlet
- ⑮ Sta. "MV2" 131+08, Lt. 131+08, 52 Lt.  
Const. Type "G-2" Inlet Over Extg. 12" Pipe  
Inst. 12" Storm Sew. Pipe - 40'  
5' Depth
- ⑯ Sta. "MV2" 131+20, Lt. 131+08, 42 Lt.  
Const. Type "G-2" Inlet
- ⑰ Not Used
- ⑱ Remove Inlet
- ⑲ Sta. "VM2" 135+00, 104' Rt.  
Const. Water Quality Swale #2  
Inst. 18" Storm Sew. Pipe - 72'  
10' Depth  
(For Details, See Sht. GJ and GJ-3)  
(See Drg. Nos. RD1035 and RD1055)
- ⑳ Sta. "MV2" 131+40, 21' Rt.  
Const. Type "G-2" Inlet
- ㉑ Sta. "MV2" 130+90, 8' Rt.  
Connect to Extg. Inlet  
Inst. 12" Storm Sew. Pipe - 58'  
5' Depth
- ㉒ Approximate Location of Bore Pit
- ㉓ Minor Adjust Manhole - 2  
(See Drg. No. RD360)
- ㉔ Sta. "VM2" 129+10, 58' Rt. VM2 129+12  
Connect To Extg. Inlet  
Cap To Extg. Inlet  
Inst. 12" Storm Sew. Pipe - 92'  
5' Depth DUCTILE IRON
- Sta. "VM2" 129+10, 6xx' Rt. VM2 129+16  
Const. Type "G-2" Inlet  
Connect To Extg. Inlet (capped)  
Inst. 12" Storm Sew. Pipe - 4'  
5' Depth DUCTILE IRON

"AS CONSTRUCTED"  
Mike Ben  
Date 11/26/14 Project Mng'r

Revised 9-17-2008	Revised 10-9-2008
① VM2 Drainage Revision	② VM2 Drainage Revision

THIS IS THE FILENAME LOCATION \*\*\*\*\* DD-MMM-YYYY HH:MM USERNAME



**OREGON DEPARTMENT OF TRANSPORTATION**

**I-5: VICTORY BLVD. TO LOMBARD ST. SECTION**  
PACIFIC HIGHWAY  
MULTNOMAH COUNTY

Reviewed By - CHRIS STEINBRECHER  
Designed By - DAN MILLER  
Drafted By - STERLIN DRIGGS

**DRAINAGE AND UTILITIES NOTES**

SH N 3

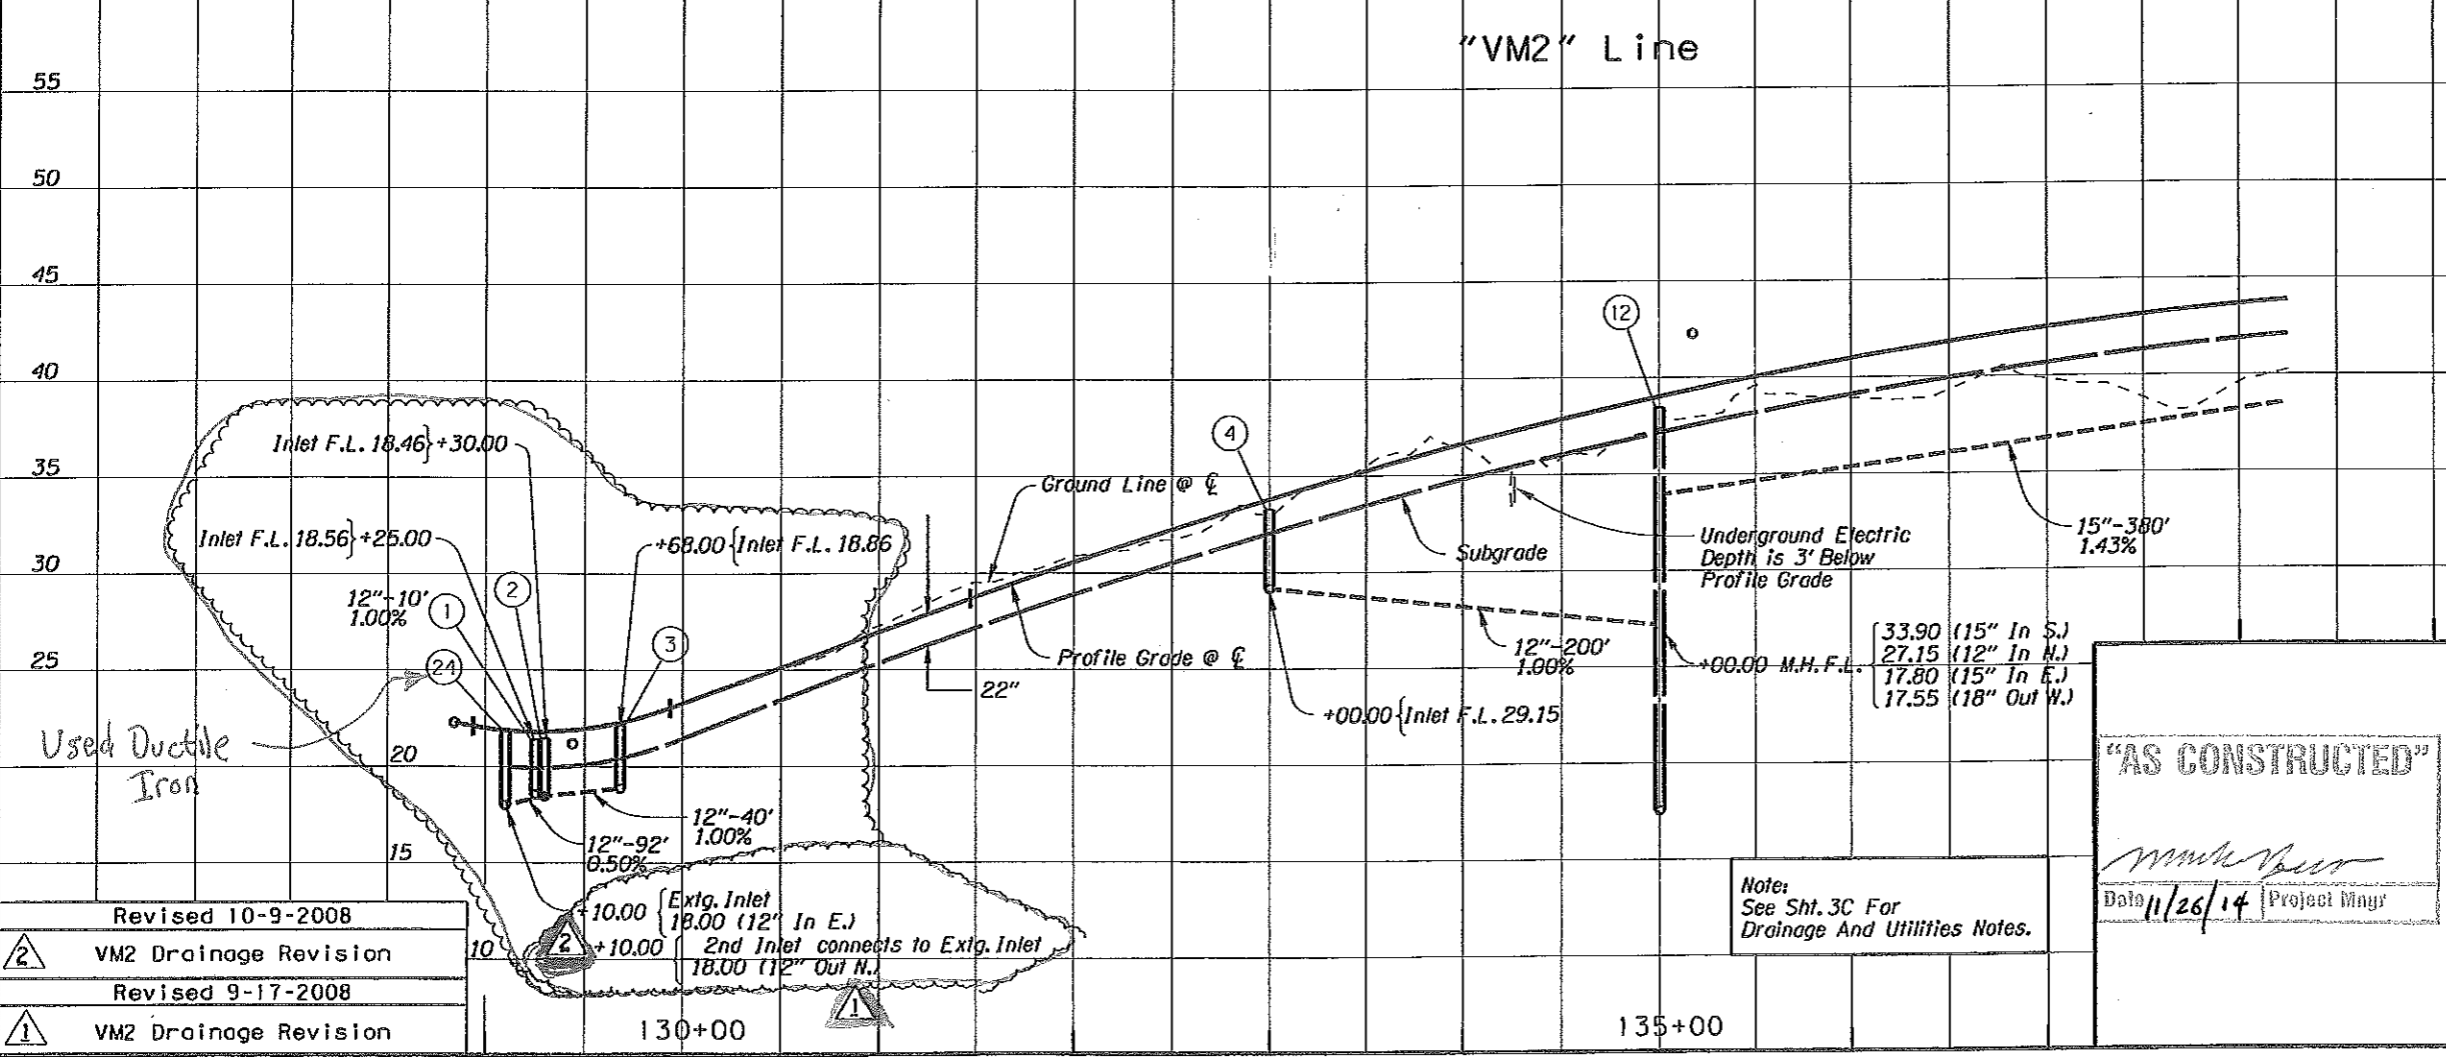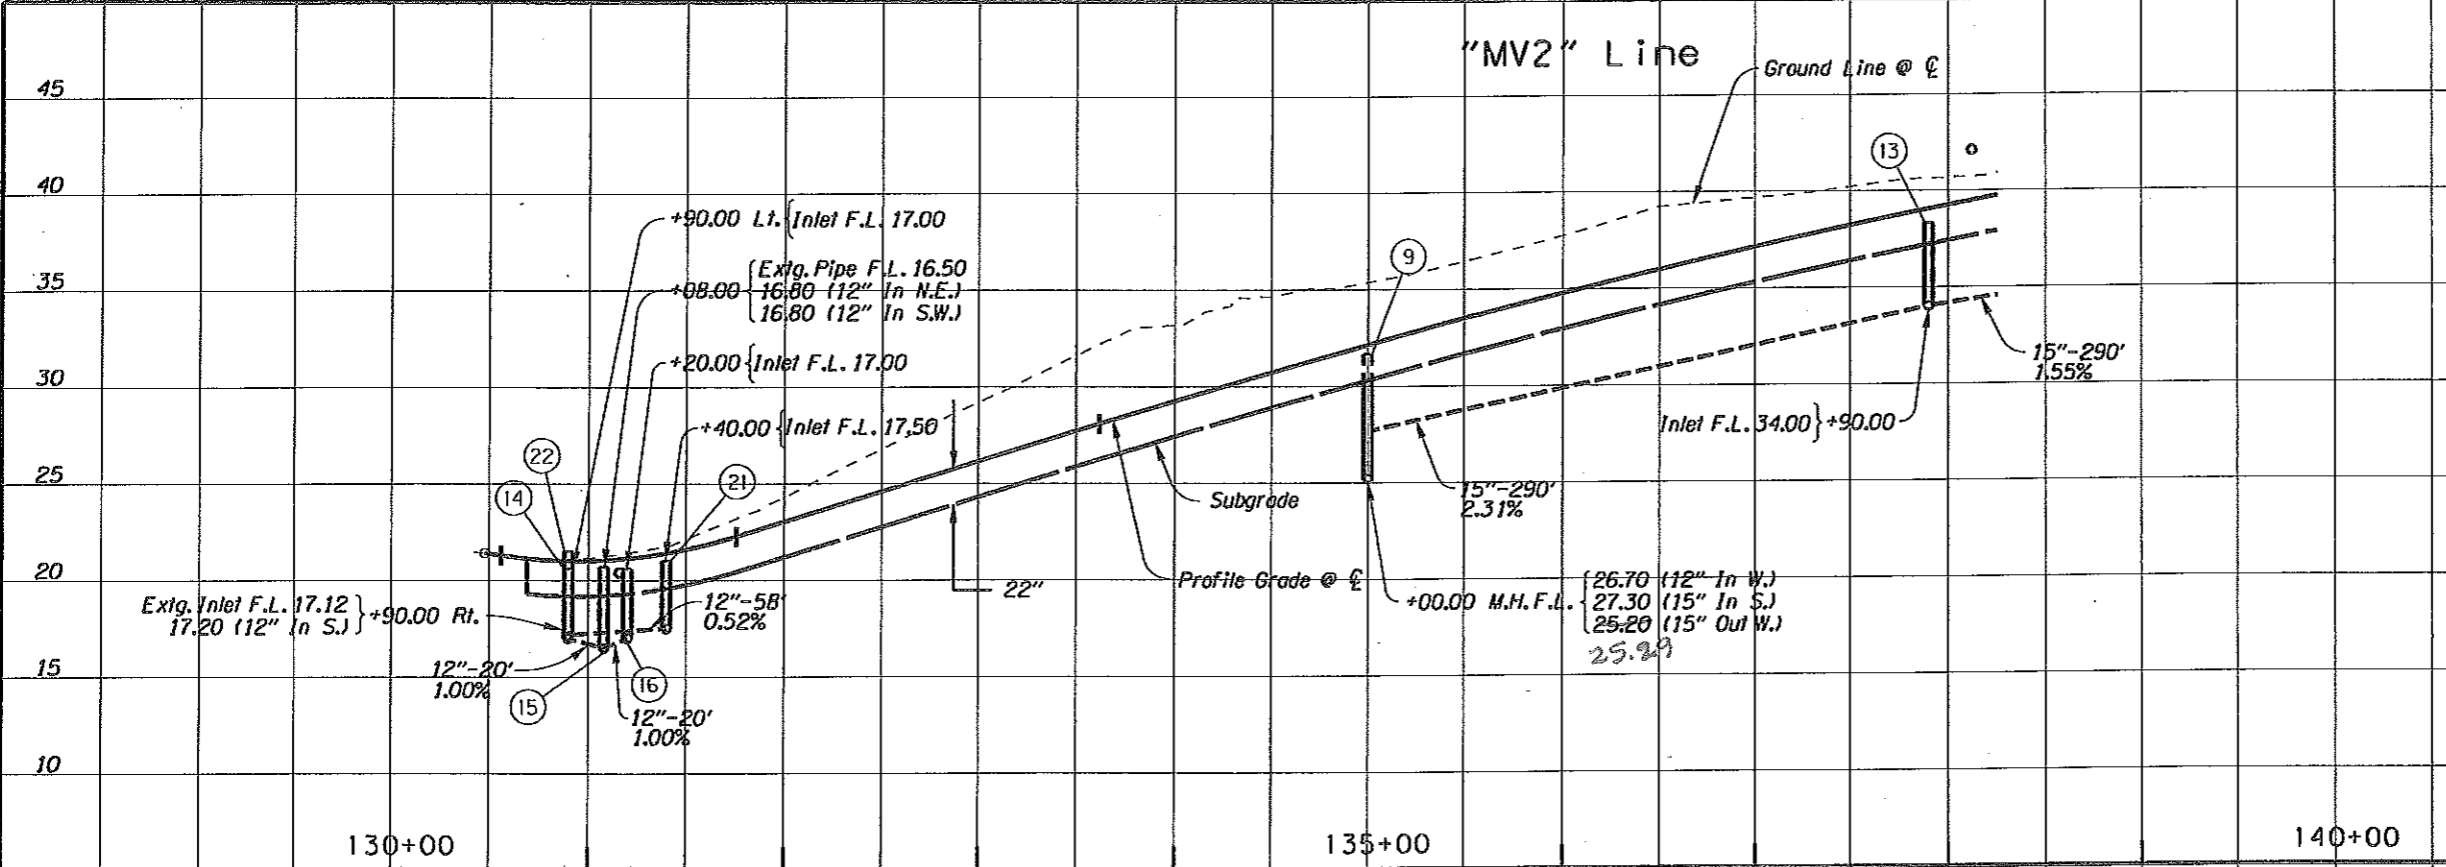

Revised 10-9-2008
2 VM2 Drainage Revision
Revised 9-17-2008
1 VM2 Drainage Revision

Note:  
See Sht. 3C For  
Drainage And Utilities Notes.

**"AS CONSTRUCTED"**

*Wm. Miller*

Date 11/26/14 Project Mgr




**OREGON DEPARTMENT OF TRANSPORTATION**

1-5: VICTORY BLVD. TO LOMBARD ST. SECTION  
PACIFIC HIGHWAY  
MULTNOMAH COUNTY

Reviewed By - CHRIS STEINBRECHER  
Designed By - DAN MILLER  
Drafted By - STERLIN DRIGGS

**DRAINAGE PROFILE**

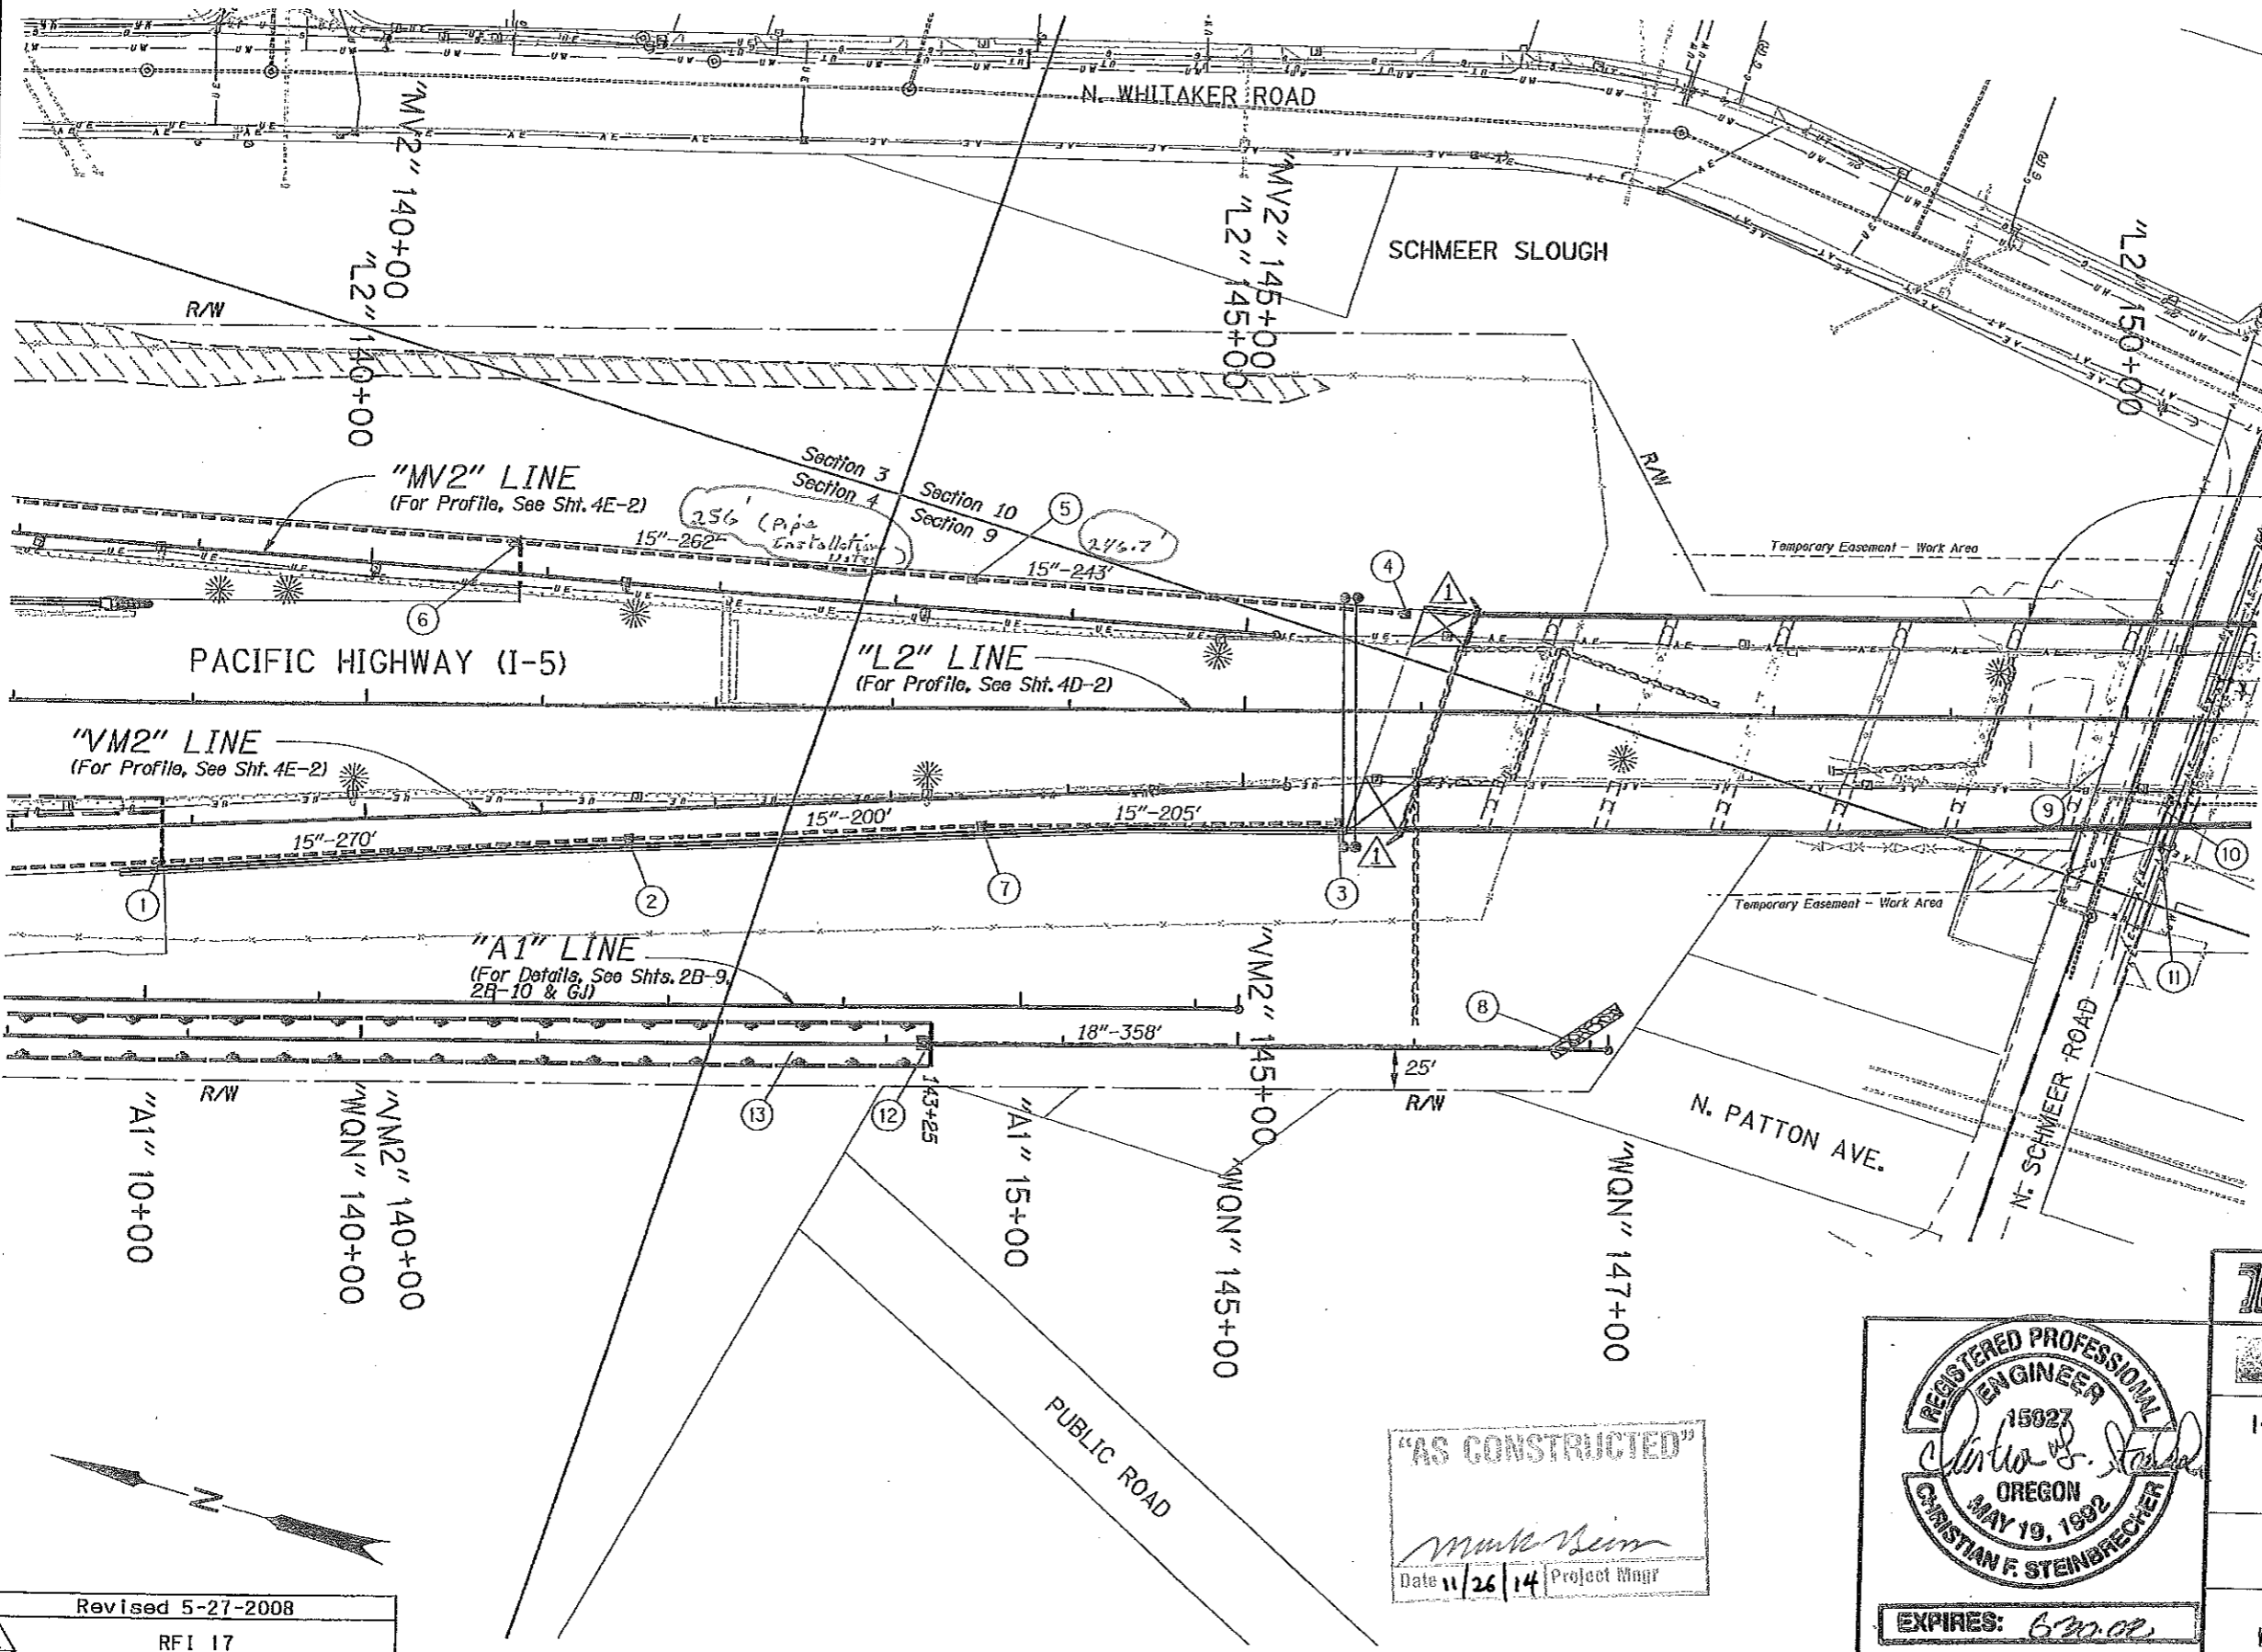

COLUMBIA SLOUGH BRIDGE BR. NO. 08883

Remove or Abandon Pipe Shown Thus:

No Work Area Shown Thus:

No Work Area, Temporary Easement For Overhead Work Shown Thus:



EXPIRES: 6/30/08

"AS CONSTRUCTED"  
*Mark Stein*  
Date 11/26/14 Project Manager

OREGON DEPARTMENT OF TRANSPORTATION

Ukiah Engineering, Inc.

I-5: VICTORY BLVD. TO LOMBARD ST. SECTION  
PACIFIC HIGHWAY  
MULTNOMAH COUNTY

Reviewed By - CHRIS STEINBRECHER / DTM  
Designed By - DAN MILLER / CFS  
Drafted By - STERLIN DRIGGS

DRAINAGE AND UTILITIES

SHEET NO. 4B


Revised 5-27-2008  
RFI 17

- ① Sta. "VM2" 138+83, Rt.  
Const. Type "G-2" Inlet  
~~Adjust Inlet with Open Grade HMAC Inlet Mod.~~  
~~Const. Wearing Surface Drain - 40'~~  
~~Const. Wearing Surface Drain Outlet~~  
~~(Option A Outlet to Inlet)~~  
Inst. 15" Storm Sew. Pipe - 270'  
5' Depth  
(See Drg. No. RD314)
- ② Sta. "VM2" 141+50, Rt.  
Const. Type "G-2" Inlet  
~~Adjust Inlet with Open Grade HMAC Inlet Mod.~~  
Inst. 15" Storm Sew. Pipe - 200'  
5' Depth
- ① ③ Sta. "L2" 145+50, Rt.  
Const. Type "G-2" Inlet  
~~Adjust Inlet with Open Grade HMAC Inlet Mod.~~  
Connect to Bridge Drainage System
- ① ④ Sta. "L2" 145+90, Lt.  
Const. Type "G-2" Inlet  
~~Adjust Inlet with Open Grade HMAC Inlet Mod.~~  
Connect to Bridge Drainage System
- ⑤ Sta. "MV2" 143+42, Lt.  
Const. Type "G-2" Inlet  
~~Adjust Inlet with Open Grade HMAC Inlet Mod.~~  
Inst. 15" Storm Sew. Pipe - 243' 2.4% .7  
5' Depth
- ⑥ Sta. "MV2" 140+86, Lt.  
Const. Type "G-2" Inlet  
~~Adjust Inlet with Open Grade HMAC Inlet Mod.~~  
~~Const. Wearing Surface Drain - 29'~~  
~~Const. Wearing Surface Drain Outlet~~  
~~(Option A Outlet to Inlet)~~  
Inst. 15" Storm Sew. Pipe - 262'  
5' Depth
- ⑦ Sta. "VM2" 143+50, Rt.  
Const. Type "G-2" Inlet  
~~Adjust Inlet with Open Grade HMAC Inlet Mod.~~  
Inst. 15" Storm Sew. Pipe - 205'  
5' Depth
- ⑧ Sta. "L2" 147+00, 192' Rt.  
Const. Loose Riprap, Class 50 - 15 cy  
Const. Sloped End Section, 18 inch  
Inst. 18" Storm Sew. Pipe - 358'  
10' Depth  
(For Details, See Sht. GJ-3)
- ⑨ Relocate Aerial Telephone Line (by Others).
- ⑩ Relocate Waterline (by Others).
- ⑪ Relocate Power Pole (by Others).
- ⑫ Sta. "L2" 143+25, 195' Rt.  
Const. Type "M-E" Inlet  
(See Drg. No. RD368)
- ⑬ See Sht. 3C, Note 19

"AS CONSTRUCTED"

*Mark Hess*

Date 11/26/14 Project Mgr

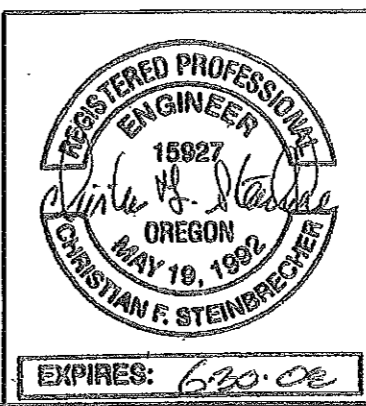

**OREGON DEPARTMENT OF TRANSPORTATION**

**Ukiah Engineering, Inc.**

1-5 VICTORY BLVD. TO LOMBARD ST. SECTION  
PACIFIC HIGHWAY  
MULTNOMAH COUNTY

Reviewed By - CHRIS STEINBRECHER / D  
Designed By - DAN MILLER / CFS  
Drafted By - STERLIN DRIGOS

**DRAINAGE AND UTILITIES NOTES**


SHEET NO. 40

Revised 5-27-2008

RFI 17




"MV2" Line

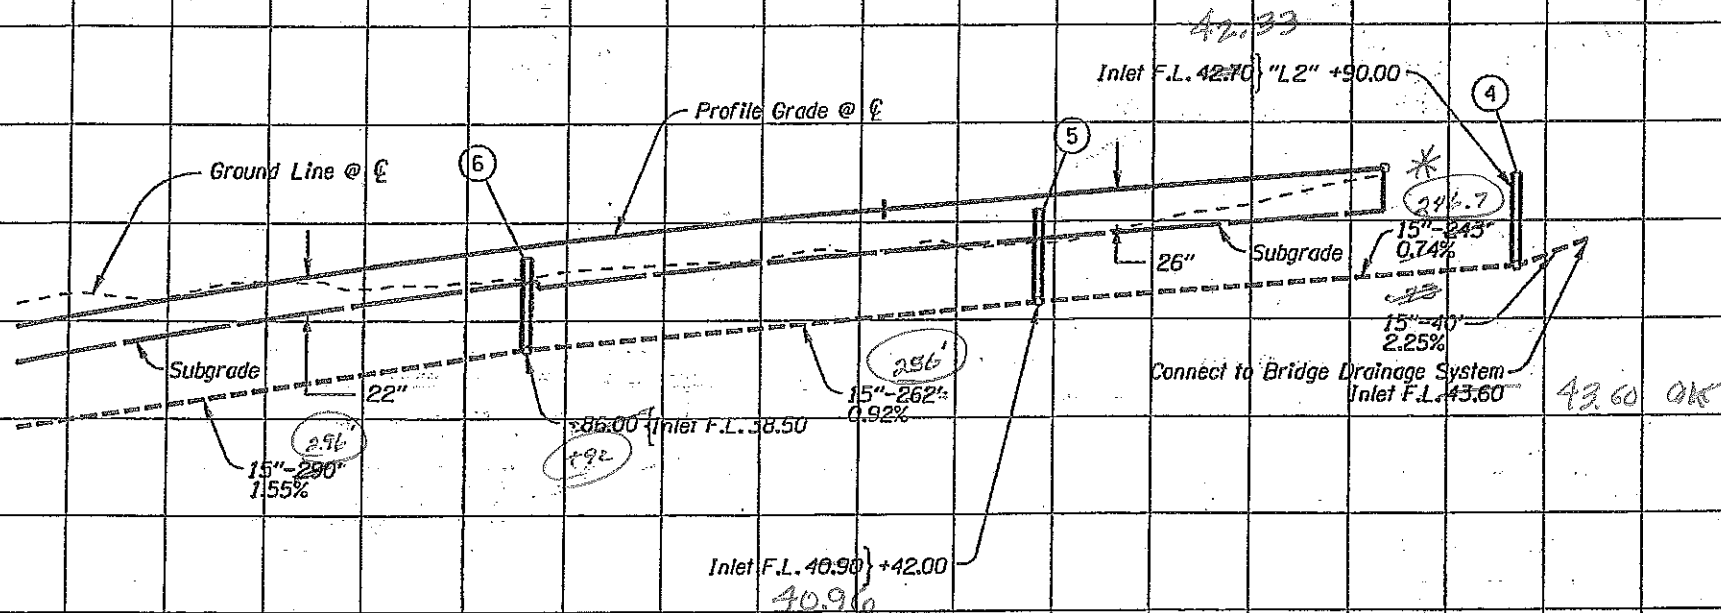

\* The bridge drainage system came into Inlet (4) at 42.43 which forced the need to lower the 15" pipe between the (4) & (5) inlets.

"VM2" Line

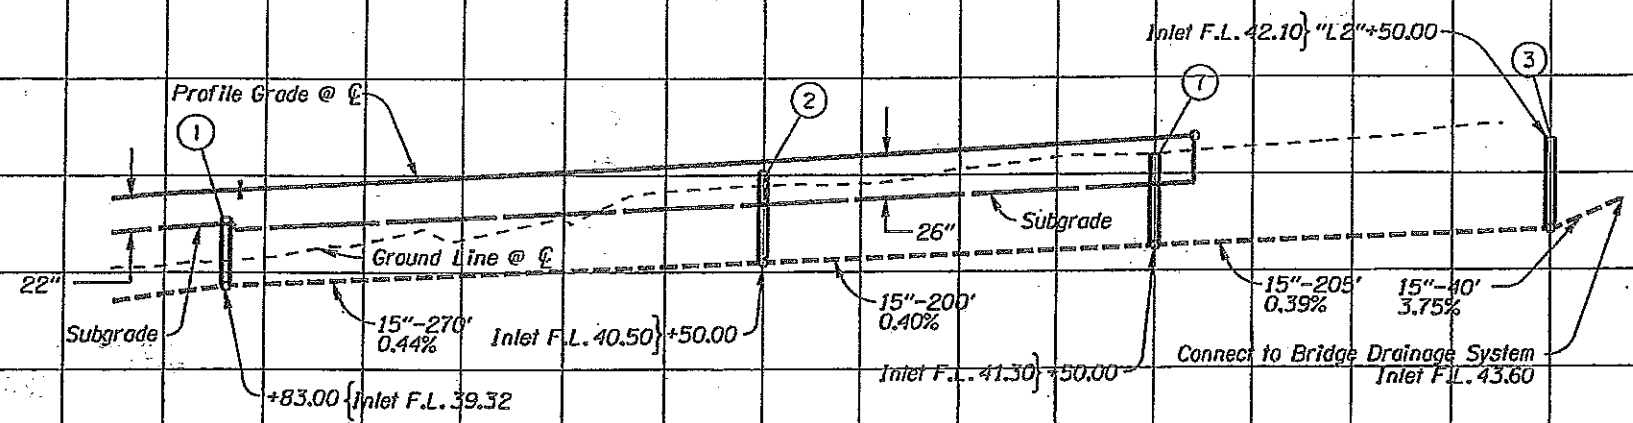

"AS CONSTRUCTED"

*Mark V...*

Date 11/26/14 Project Mngr

Note:  
See Sht. 4C For  
Drainage And Utilities Notes.



EXPIRES 12-31-08

OREGON DEPARTMENT OF TRANSPORTATION


**Ukiah Engineering, Inc.**

1-5: VICTORY BLVD. TO LOMBARD ST. SECTION  
PACIFIC HIGHWAY  
MULTNOMAH COUNTY


Reviewed By - CHRIS STEINBRECHER  
Designed By - DAN MILLER  
Drafted By - STERLIN DRIGGS

DRAINAGE PROFILE


SHEET NO.  
4E-2

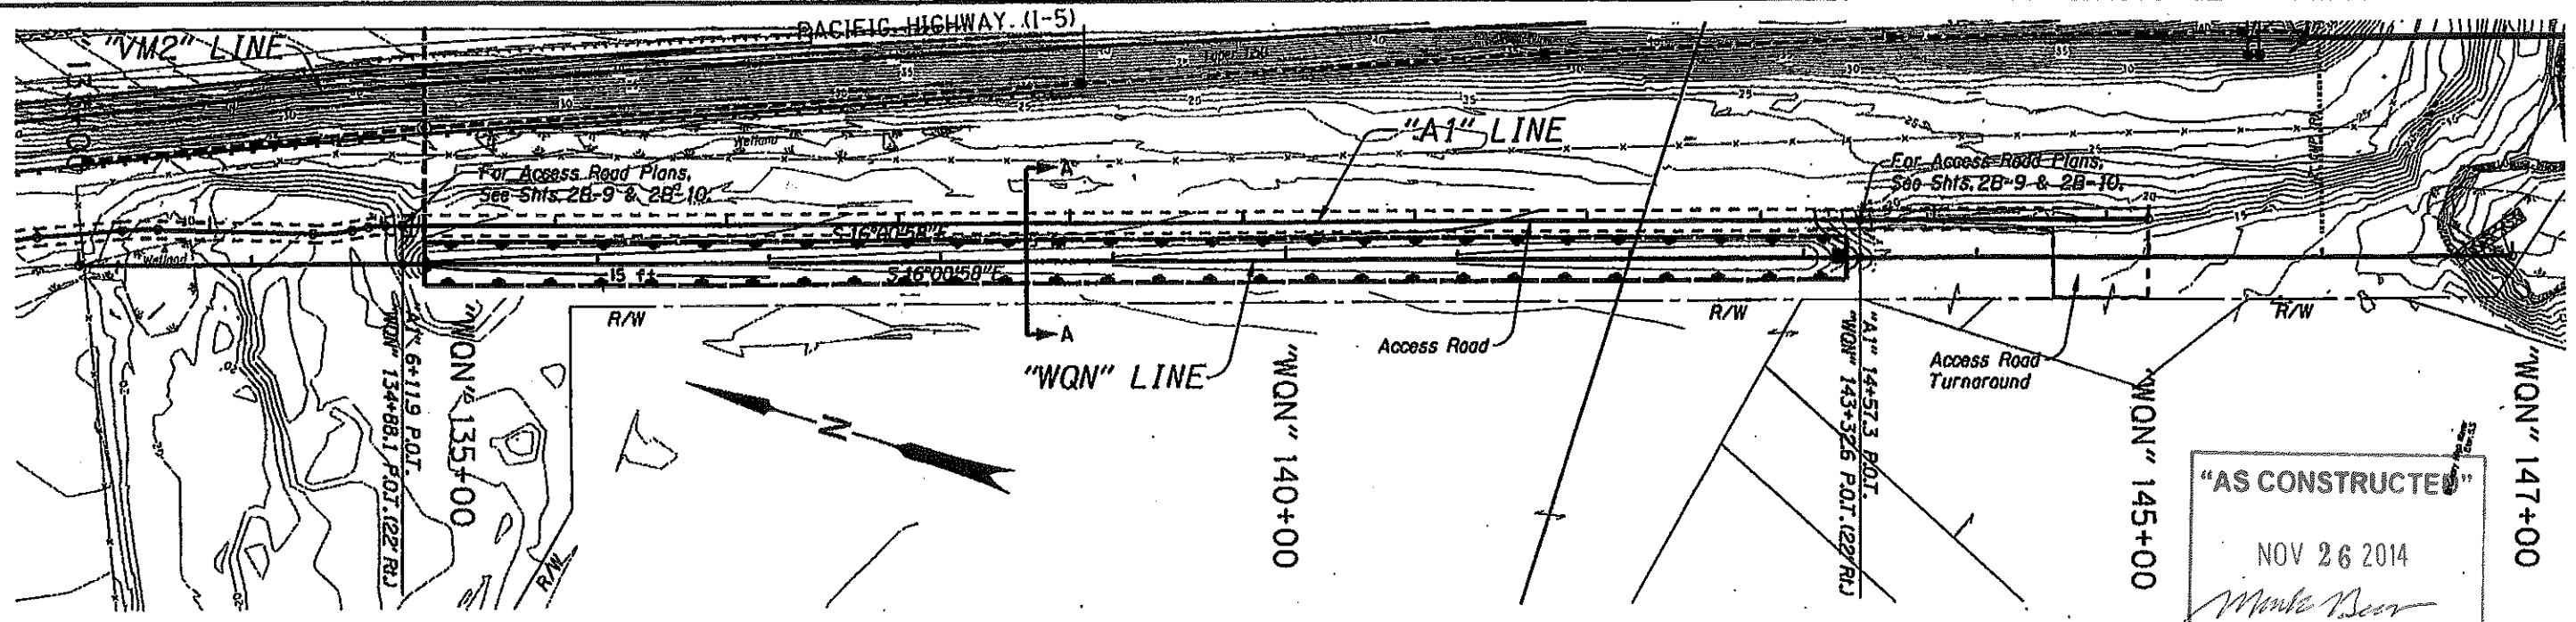

SWALE GRADING PLAN

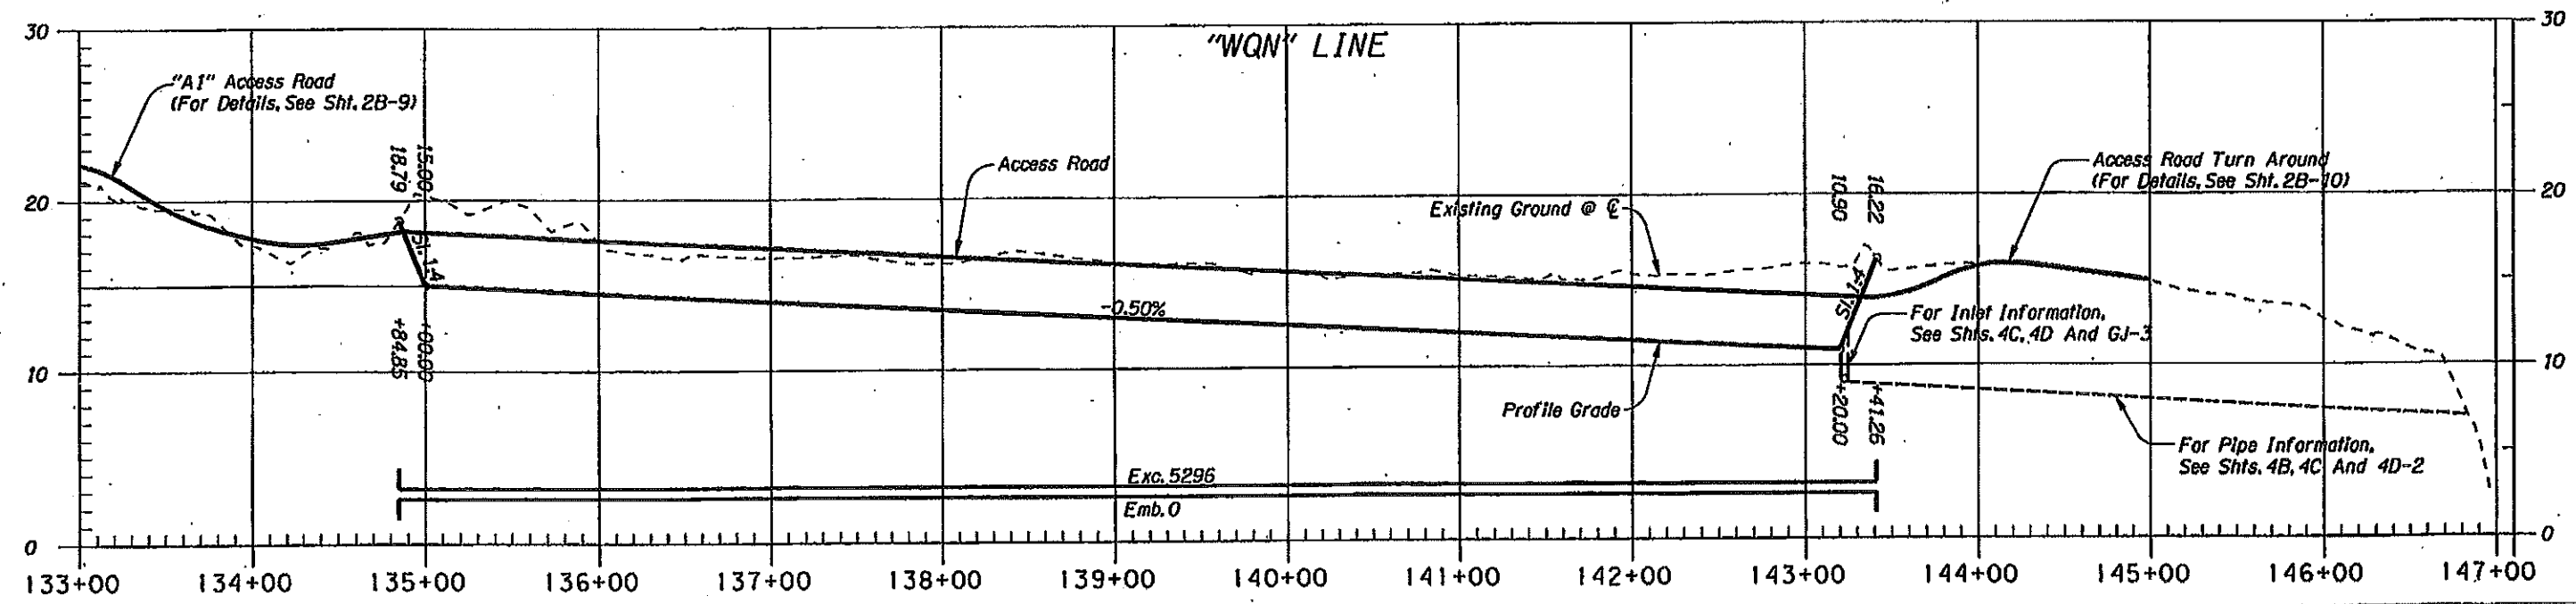

SWALE PROFILE


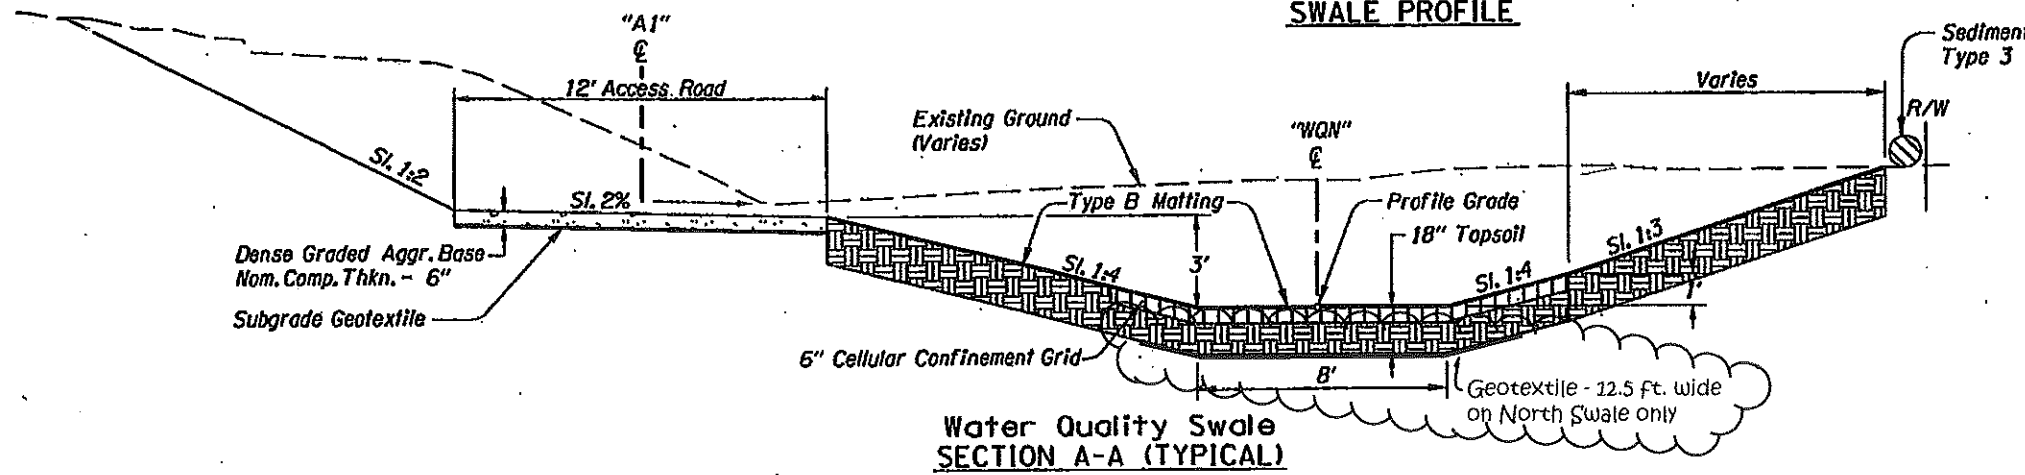


Water Quality Swale SECTION A-A (TYPICAL)




EXPIRES 12-31-08

<p><b>OREGON DEPARTMENT OF TRANSPORTATION</b></p>	
<p>DAVID EVANS AND ASSOCIATES, INC. 2100 Southwest River Parkway Portland Oregon 97201 Ph: 503.223.6663</p>	
<p><b>I-5: VICTORY BLVD. TO LOMBARD ST. SECTION</b> PACIFIC HIGHWAY MULTNOMAH COUNTY</p>	
<p>Reviewed By - Chris Higgins Designed By - Dan Miller Drafted By - Nike Youngs</p>	
<p>WATER QUALITY SWALE #2</p>	<p>SHEET NO. GJ</p>

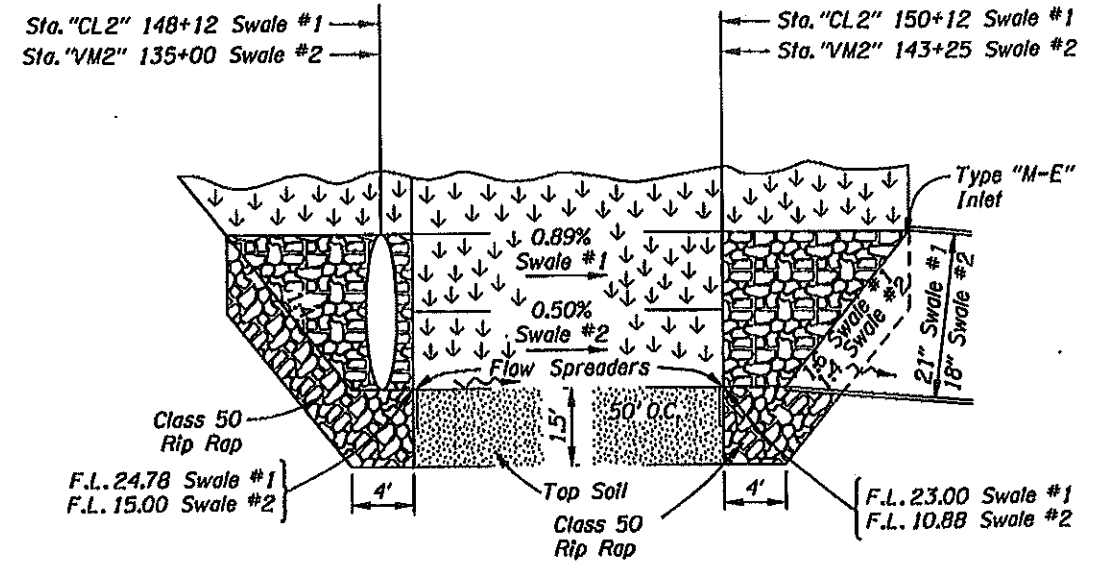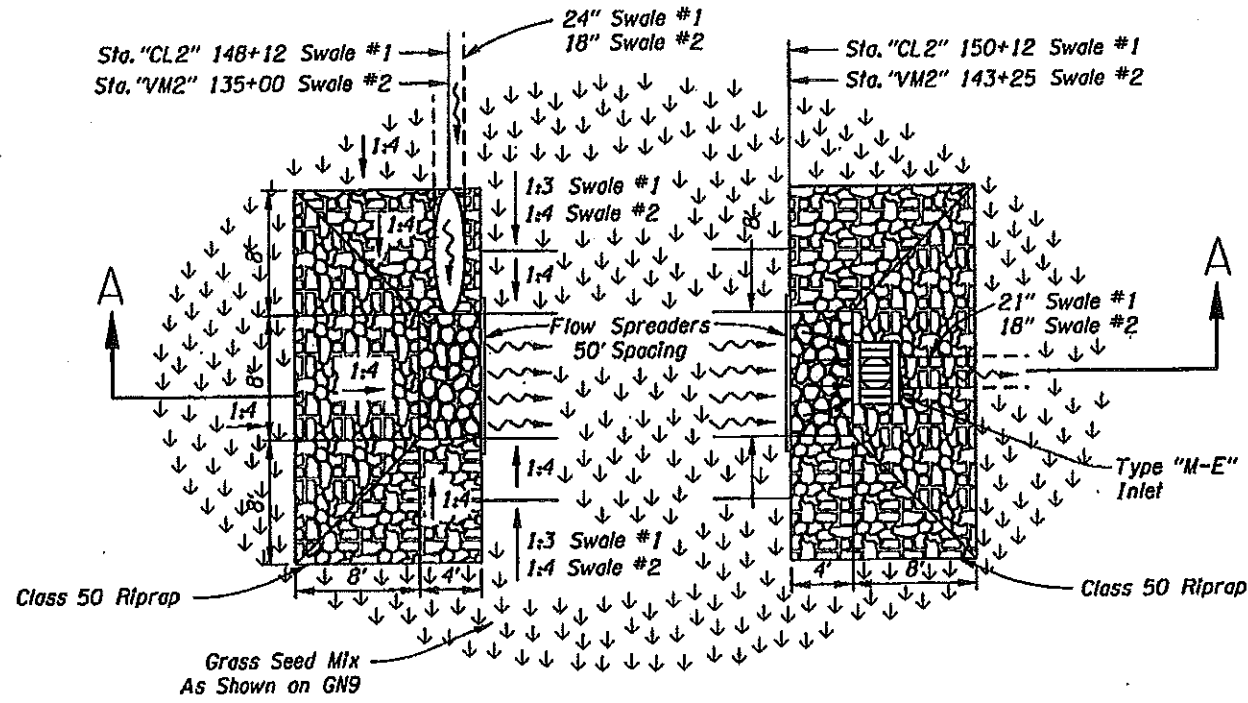


SECTION A-A

RIPRAP BASINS FOR UPSTREAM AND DOWNSTREAM END FOR SWALES 1 & 2

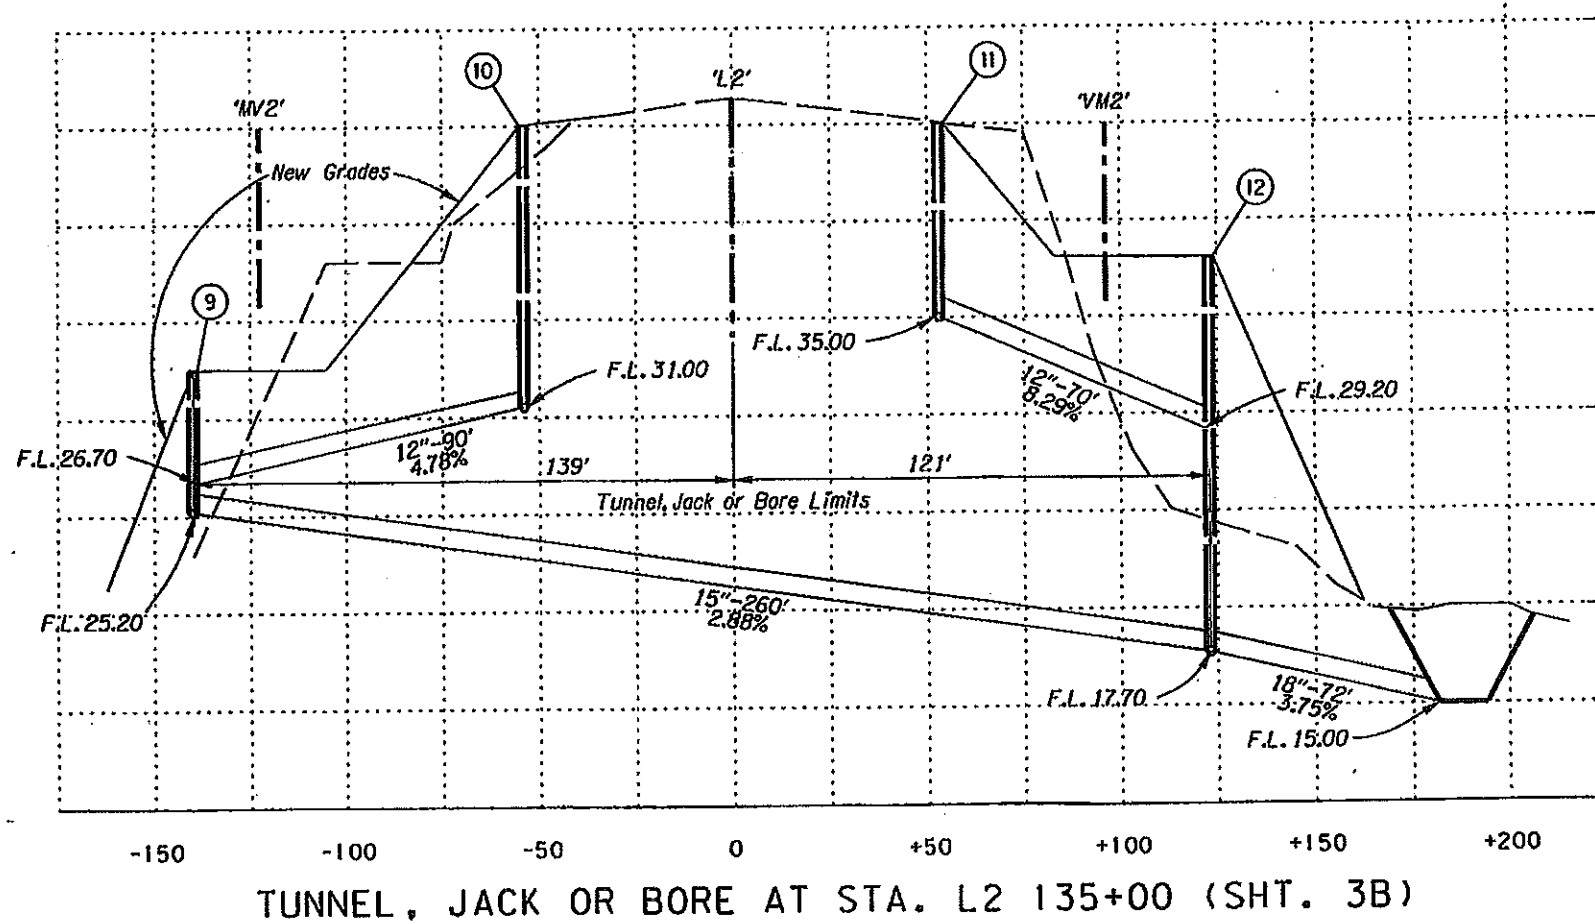


TUNNEL, JACK OR BORE AT STA. L2 135+00 (SHT. 3B)

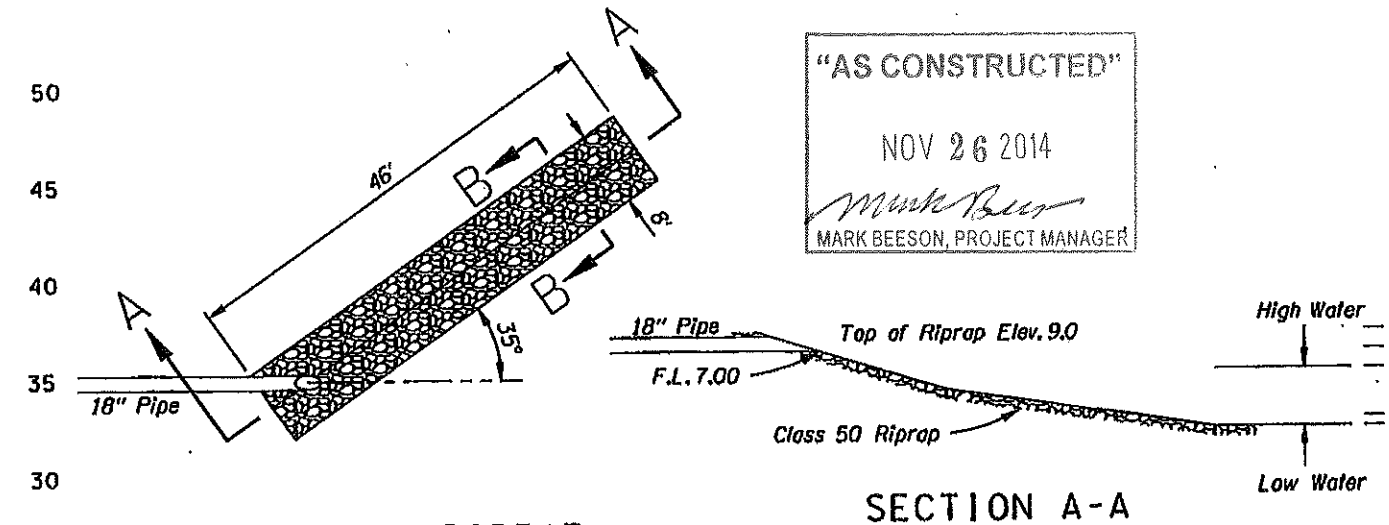

LOOSE RIPRAP  
SCALE: 1"=20'

"AS CONSTRUCTED"  
NOV 26 2014  
*Mark Beeson*  
MARK BEESON, PROJECT MANAGER

SECTION A-A

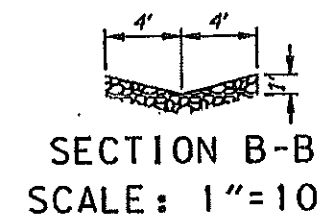

SECTION B-B  
SCALE: 1"=10'



EXPIRES 12-31-08

**OREGON DEPARTMENT OF TRANSPORTATION**

**Ukiah Engineering, Inc.**

1-5: VICTORY BLVD. TO LOMBARD ST. SECTION  
PACIFIC HIGHWAY  
MULTNOMAH COUNTY

Reviewed By - CHRIS STEINBRECHER  
Designed By - DAN MILLER  
Drafted By - STERLIN DRIGGS

**DRAINAGE DETAILS**

SHEET NO. **GJ-3**