

OPERATION & MAINTENANCE MANUAL

Water Quality Biofiltration Swale

Manual prepared: November 2017

DFI No. D00344



Figure 1: DFI No. D00344, looking Northeast

1. Identification

Drainage Facility ID (DFI): D00344
Facility Type: Water Quality Biofiltration Swale
Construction Drawings: (V-File Numbers) 38V-097
Location: District: 05
Highway No.: 001
Mile Post: 180.41 to 180.41, NB [right]

2. Manual Purpose

The purpose of this manual is to outline inspection needs and summarize maintenance actions.

3. Facility Location

The location map below details the facility location. The highway, mile posts, side streets, access location, and stormwater flow directions are noted on the map.

Facility location type: Roadway shoulder

Flow direction: East

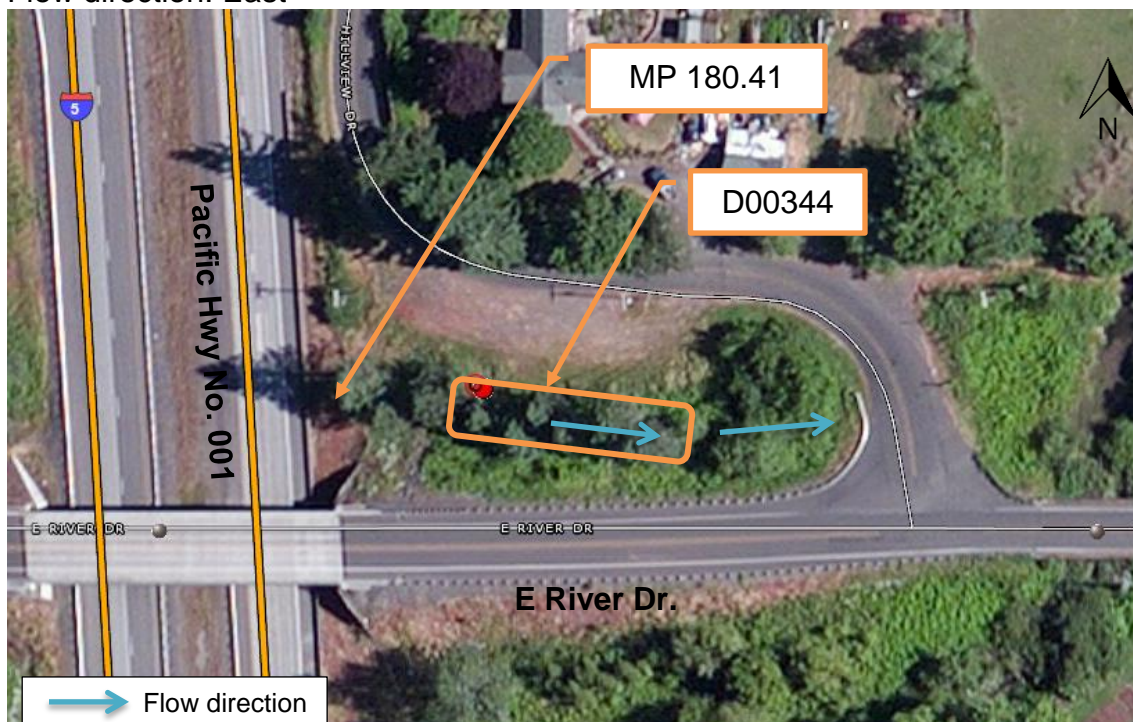



Figure 2: Facility location map

4. Facility Summary

The length and width of a swale is based on the bottom dimensions.

The bottom length and bottom width of the swale is:


Bottom Length (feet)	Bottom Width (feet)
±120	2

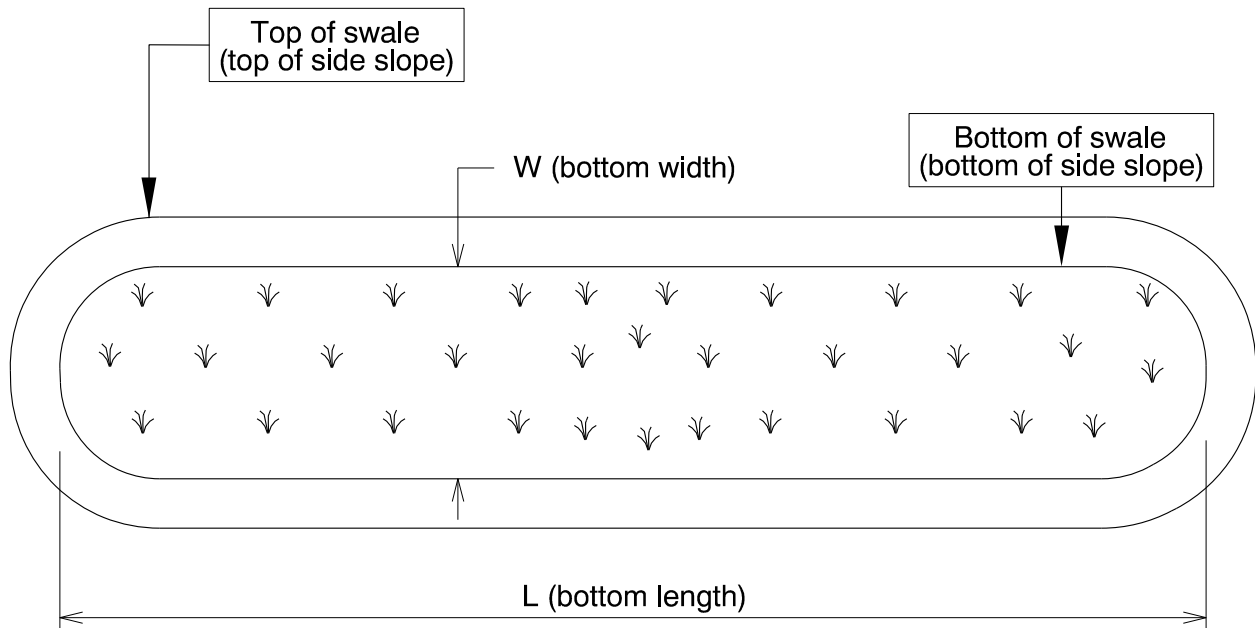

The depth of the swale is the vertical distance measured from the bottom of the swale to the top. The slope of the swale sides is presented by a vertical distance (rise) followed by the horizontal distance (run).

Depth and side slopes:

Depth (feet)	Rise (feet)	Run (feet)
0.5	1	4

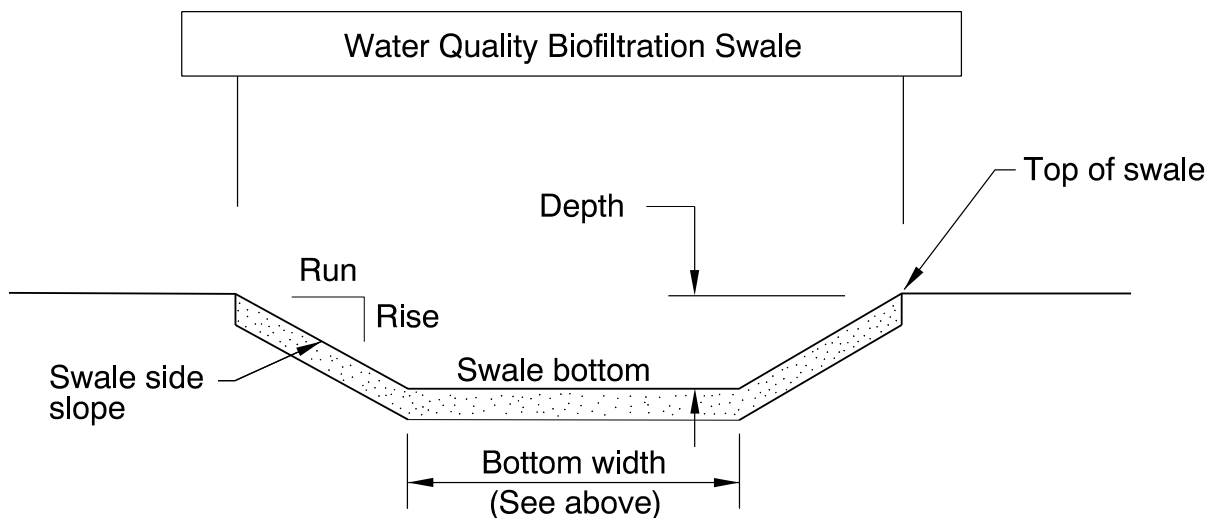

Site Specific Information: The facility is very shallow and it can be difficult to spot. Maintenance crews should use caution when driving vehicles around the area and avoid driving into the facility to prevent damage from occurring.

5. Facility Access

Maintenance access to the facility:

<input type="checkbox"/> Roadside pad	<input checked="" type="checkbox"/> Roadside shoulder
<input type="checkbox"/> Access road with Gate	<input type="checkbox"/> Access road without Gate

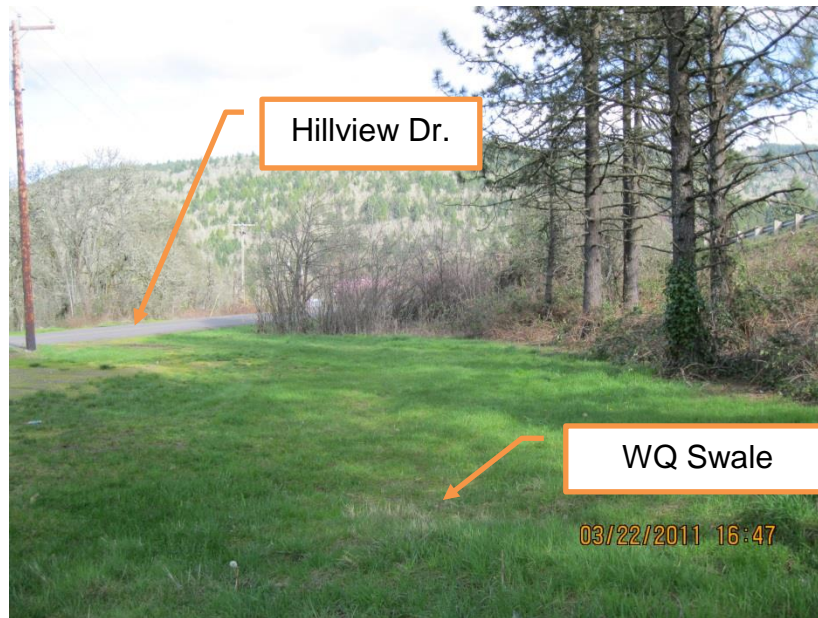


Figure 3: Facility access from Hillview Dr.

6. Operational Components / Maintenance Items

Classification

This facility is classified as an:

<input checked="" type="checkbox"/> On-line Swale	<input type="checkbox"/> Off-line Swale
A swale that does not include a high flow bypass component; flow drains into and through the facility	A swale that treats low/small flows and diverts high flows using a bypass component

Bypass Component

This facility includes a high flow bypass component:

<input checked="" type="checkbox"/> No	<input type="checkbox"/> Yes
There is no bypass component. High flows drain into and through the facility	There is a bypass component. Only low/small flows drain into the swale. High flows are diverted around the swale using a bypass component

Operational Components

A swale has many components that assist with treatment, conveyance, and reducing flow velocity to minimize erosion. The components in use can vary depending if the facility was designed to operate on-line or off-line. The facility components table (**Table 1**) has been provided to highlight the applicable components for this facility. The component is in use when the box contains an “x” (e.g.).

The Standard Operation Manual for Water Quality Biofiltration Swales (implemented March 2017) outlines facility operation, typical footprint configuration, and component definitions and details. A link to the manual is attached to the feature marker in TransGIS.

<https://gis.odot.state.or.us/TransGIS/>

Operational Plan

The applicable standard operational plan for this facility is:

<input checked="" type="checkbox"/> Operational Plan A	<input checked="" type="checkbox"/> Operational Plan B	<input type="checkbox"/> Operational Plan C
A standard operational plan illustrates the general facility footprint configuration and explains the purpose of each facility component. Operational plans (A, B, C) are provided in the Standard Operation Manual.		

See Appendix A for the site specific operational plan.

Maintenance Items

Operational components marked in **Table 1** should be inspected and maintained according to Section 7. Each facility component is defined and detailed in the Standard Operation Manual using the associated ID number indicated below.

Table 1: Swale Components		ID #
Manholes/Structures		
Pre-treatment manhole	<input type="checkbox"/>	S1
Weir type flow splitter/flow splitter manhole	<input type="checkbox"/>	S2
Orifice type flow splitter/flow splitter manhole	<input type="checkbox"/>	S3
Standard manhole	<input type="checkbox"/>	S4
Swale Inlet		
Pavement sheet flow	<input type="checkbox"/>	S5
Inlet Pipe (s)	<input checked="" type="checkbox"/>	S6
Open channel inlet	<input checked="" type="checkbox"/>	S7
Riprap pad	<input type="checkbox"/>	S8
Ground Cover		
Grass bottom	<input checked="" type="checkbox"/>	S9
Grass side slopes	<input checked="" type="checkbox"/>	S10
Granular drain rock	<input type="checkbox"/>	S11
Plantings	<input type="checkbox"/>	S12
Underground Components		
Geotextile fabric	<input checked="" type="checkbox"/>	S13
Water quality mix (Amended native soil)	<input checked="" type="checkbox"/>	S14
Perforated pipe	<input type="checkbox"/>	S15
Porous pavers (access grid)	<input type="checkbox"/>	S16
Flow Spreader		
Rock basin (used at inlet)	<input checked="" type="checkbox"/>	S17
Anchored board (midpoint of swale or every 50 feet along swale bottom)	<input type="checkbox"/>	S18
Other:	<input type="checkbox"/>	S19
Swale Outlet		
Catch basin with grate	<input type="checkbox"/>	S20
Outlet Pipe (s)	<input checked="" type="checkbox"/>	S21
Open channel outlet	<input checked="" type="checkbox"/>	S22
Auxiliary Outlet:	<input type="checkbox"/>	S23
Outfall Type		
Waterbody (Creek/Lake/Ocean) Note: Outfall to wetland area	<input checked="" type="checkbox"/> C <input type="checkbox"/> L <input type="checkbox"/> O	S24
Ditch	<input type="checkbox"/>	S25
Storm drain system	<input type="checkbox"/>	S26
Outfall Components		
Riprap pad	<input type="checkbox"/>	S27
Riprap bank protection	<input type="checkbox"/>	S28

7. Maintenance

Maintenance Frequency/Maintain Records

- a. Inspect annually. Preferably prior to the rainy season.
- b. Clean and maintain as necessary. Refer to Activity 125 for conditions when maintenance is needed.
- c. Keep a record of inspections, maintenance, and repairs.

Maintenance Guide/Maintenance Actions

The ODOT Routine Road Maintenance Water Quality and Habitat Guide (the *Blue Book*) outlines the standard maintenance actions for water quality facilities under Activity 125.

There are standard maintenance tables for standard ODOT designs. The maintenance tables describe the maintenance component, the defect or problem, the condition when maintenance is needed, and the recommended maintenance to correct the problem. Use the following tables to maintain ODOT swales:

- Table 1 (General Maintenance): Contains general maintenance and inspection guidelines that are applicable to all ODOT water quality facilities
- Table 3 (Maintenance of Water Quality or Biofiltration Swales): Contains maintenance information for swales

The *Blue Book* can be viewed at the following website:

http://www.oregon.gov/ODOT/Maintenance/Documents/blue_book.pdf

8. Limitations

Access grid installed:

<input checked="" type="checkbox"/> No	<input type="checkbox"/> Yes
There are no porous pavers installed in this swale	

Swales are designed to allow equipment access along the bottom. If an access grid is **NOT** installed, vehicles entering the swale can create depressions (tire ruts), damage vegetation, and damage structural components (e.g. flow spreaders). These conditions may result in poor treatment and drainage performance.

Equipment wheels should be kept on the tops and side slopes. Mower arms may be run along the swale bottom.

9. Waste Material Handling

Material removed from the facility is defined as waste by the Department of Environmental Quality (DEQ). Refer to the roadwaste section of the ODOT Maintenance Yard Environmental Management System (EMS) Policy and Procedures Manual for disposal options:

http://www.oregon.gov/ODOT/Maintenance/Documents/ems_manual.pdf


Contact any of the following for more detailed information about management of waste materials found on site:

ODOT Clean Water Unit	(503) 986-3008
ODOT Statewide Hazmat Coordinator	(503) 667-7442
ODOT Region 1 Hazmat Coordinator	(503) 731-8290
ODOT Region 2 Hazmat Coordinator	(503) 986-2647
ODOT Region 3 Hazmat Coordinator	(541) 957-3594
ODOT Region 4 Hazmat Coordinator	(541) 388-6186
ODOT Region 5 Hazmat Coordinator	(541) 963-1590
ODEQ Northwest Region Office	(503) 229-5263

A Appendix A – Site Specific Operational Plan

Contents:

Operational Plan: DFI D00344

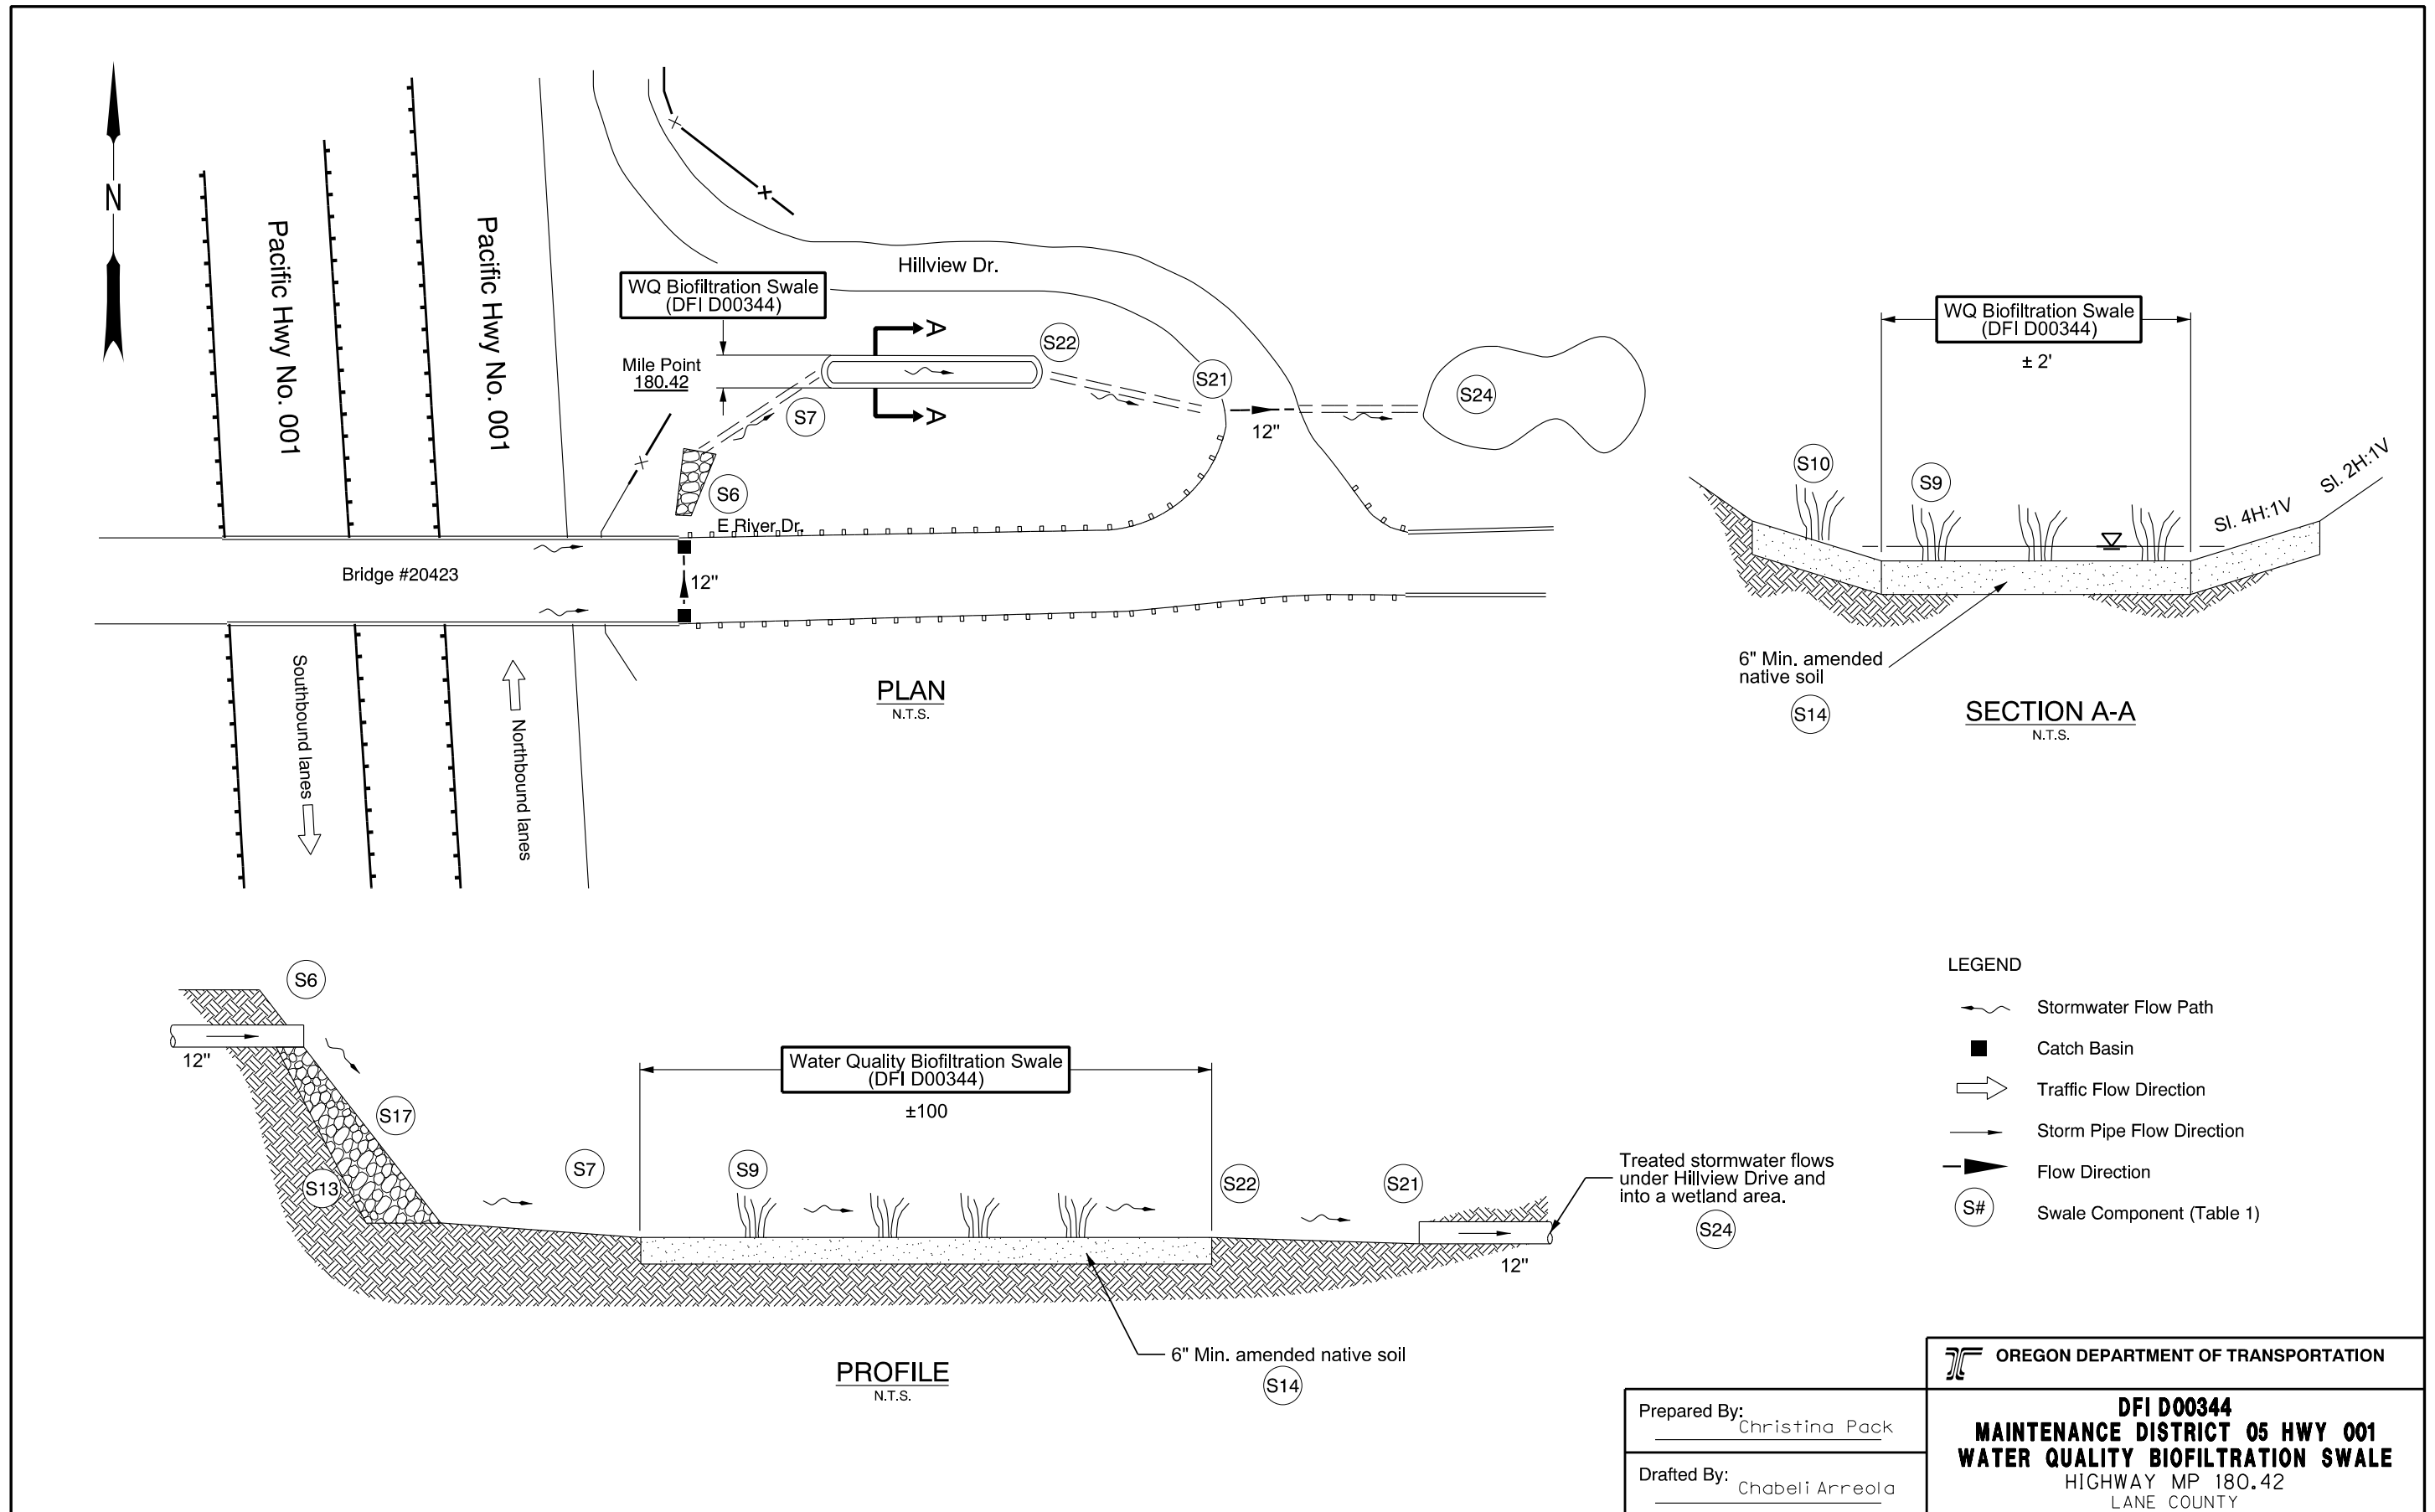

B Appendix B – Project Contract Plans

Contents:

Site Specific Subset of Project Contract Plan 38V-097

Index Of Roadway Drawings On Sheet 1A
Standard Drg. Nos.


- BR150 Double Strip Seal Expansion Joint
- BR155 Bridge Joint Details
- BR203 Standard Transition Concrete Bridge Rail to Guardrail
- BR236 Trailing End Br. Connection Concrete Br. Rail to Guardrail
- BR240 Protective Fencing
- BR241 Protective Fencing
- BR350 Temp. Diaphragm Beam for Prestressed Concrete Beams
- RD364 Concrete Inlets Types G-1, G-2 & G-2M
- RD376 Misc. Drainage Structures, Siphon Box & Inlet Adj. Cap
- RD400 Guardrail and Metal Median Barrier
- RD405 Guardrail and Metal Median Barrier Parts
- RD415 Guardrail and Metal Median Barrier Parts
- RD425 2'6" - 4'0" Flared Terminal
- RD440 Guardrail Installation at Bridge Ends
- RD450 Guardrail Anchors (Steel)
- RD470 Guardrail Over Low-Fill Culverts
- RD500 Precast Concrete Barrier Pin and Loop Assembly
- RD515 Median Barrier Anchoring Details
- RD516 Securing Concrete Barrier To Roadway
- RD530 Guardrail Transition to Concrete Barrier
- RD545 Precast Tall (42") Concrete Barrier
- RD550 Cast-In-Place Concrete Barrier Transition To Bridge Rail
- RD560 Cast-In-Place Barrier Transition To Standard Concrete Barrier
- RD570 Guardrail Transition to Tall Concrete Barrier
- RD600 Portland Cement Concrete Pavement
- RD605 Continuously Reinforced Concrete Pavement
- RD610 Asphalt Pavement Details
- RD700 Curbs
- RD810 Barbed And Woven Wire Fences
- RD900 Traffic Control Plans Details
- RD920 Traffic Control Plans Freeway Sections
- RD945 Traffic Control Plans Details
- RD950 Temporary Barricades
- RD955 Temporary Impact Attenuators
- RD960 Temporary Impact Attenuators

STATE OF OREGON
DEPARTMENT OF TRANSPORTATION

PLANS FOR PROPOSED PROJECT
GRADING, DRAINAGE, STRUCTURES & PAVING

**I-5: CLARKS BRANCH TUNNEL MILL RACE SEC.
DESIGN-BUILD PROJECT**

**PACIFIC HIGHWAY
DOUGLAS AND LANE COUNTIES
April 11, 2007**

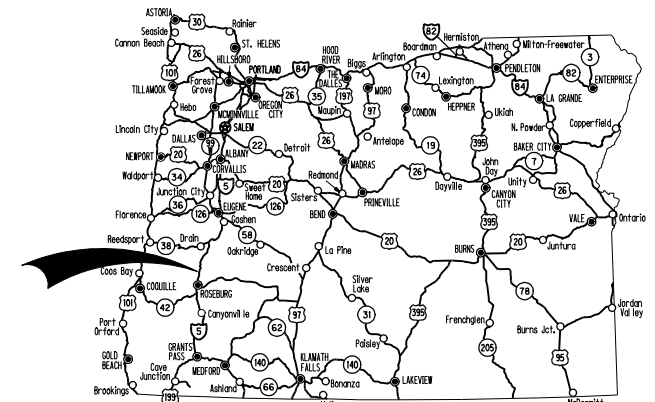


Overall Length Of Project - 67.05 Miles

ATTENTION:
Oregon Law Requires You To Follow Rules Adopted By The Oregon Utility Notification Center. Those Rules Are Set Forth In OAR 952-001-0010 Through OAR 952-001-0090. You May Obtain Copies Of The Rules By Calling The Center. (Note: The Telephone Number For The Oregon Utility Center Is (503) 232-1987.)




REVISED AS CONSTRUCTED
04/07 CONTRACT 13111
DESIGN MGR. JAMES BAUMAN

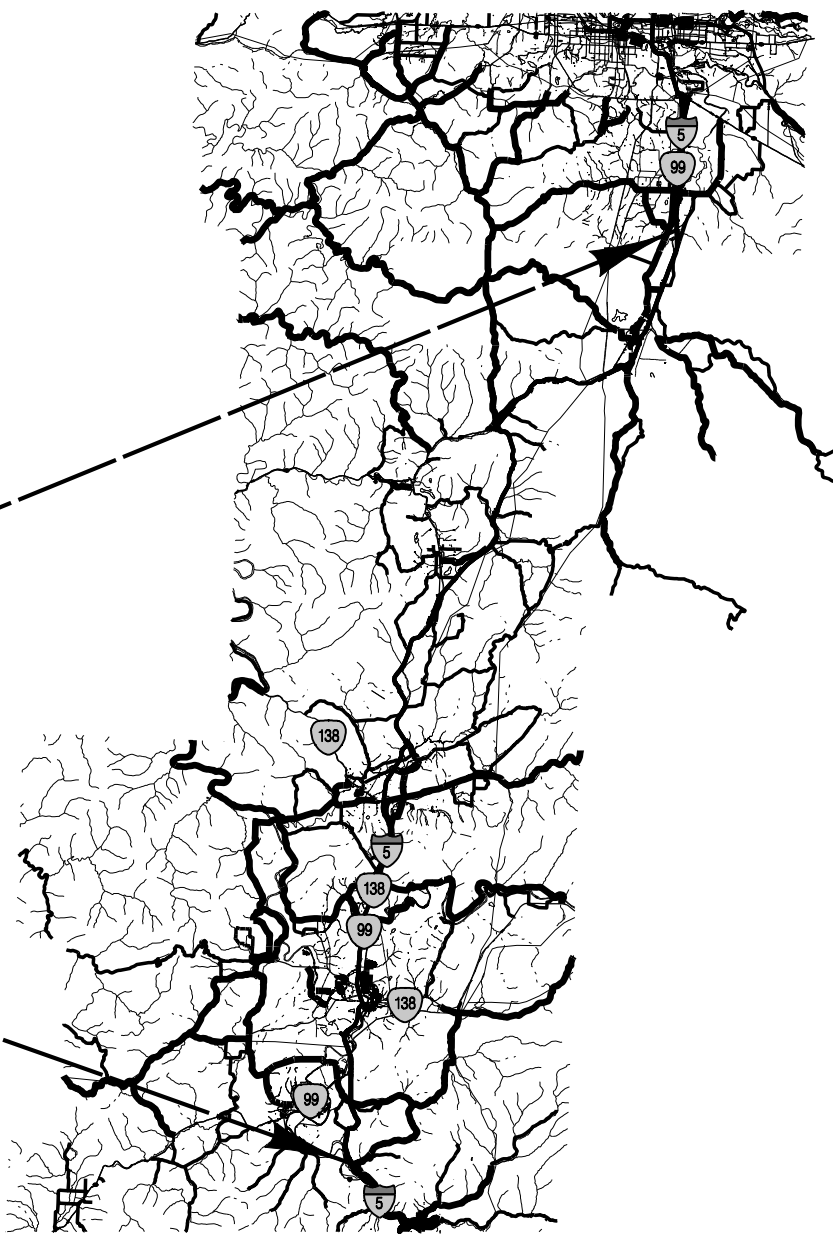

**BEGINNING OF PROJECT
M.P. 180.49**

**END OF PROJECT
M.P. 113.44**

Sec. 26, T. 19 S., R. 3 W., W.M.
Sec. 35, T. 19 S., R. 3 W., W.M.
Sec. 2, T. 20 S., R. 3 W., W.M.
Sec. 11, T. 20 S., R. 3 W., W.M.
Sec. 1, T. 28 S., R. 6 W., W.M.
Sec. 2, T. 28 S., R. 6 W., W.M.
Sec. 11, T. 28 S., R. 6 W., W.M.
Sec. 12, T. 28 S., R. 6 W., W.M.
Sec. 13, T. 28 S., R. 6 W., W.M.
Sec. 14, T. 28 S., R. 6 W., W.M.
Sec. 23, T. 28 S., R. 6 W., W.M.
Sec. 24, T. 28 S., R. 6 W., W.M.

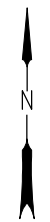

Rev. No.	Date	Revision
1	4/11/07	As Constructed

OREGON TRANSPORTATION COMMISSION
Stuart Foster CHAIRMAN
Gail L. Achterman COMMISSIONER
Mike Nelson COMMISSIONER
Randall Pape COMMISSIONER
Janice J. Wilson COMMISSIONER
Matt Garrett DIRECTOR OF TRANSPORTATION

PLANS PREPARED FOR
ODOT
BY:
CH2MHILL




EXPIRES: 12/31/07


OREGON DEPARTMENT OF TRANSPORTATION
CONCURRENCE

TECHNICAL SERVICES MANAGING ENGINEER _____ DATE _____
**I-5: CLARKS BRANCH TO TUNNEL MILL RACE SEC.
DESIGN-BUILD PROJECT
PACIFIC HIGHWAY
LANE AND DOUGLAS COUNTIES**


FEDERAL HIGHWAY ADMINISTRATION	PROJECT NUMBER	SHEET NO.
OREGON DIVISION	OTIA-S0-S001(197)	1

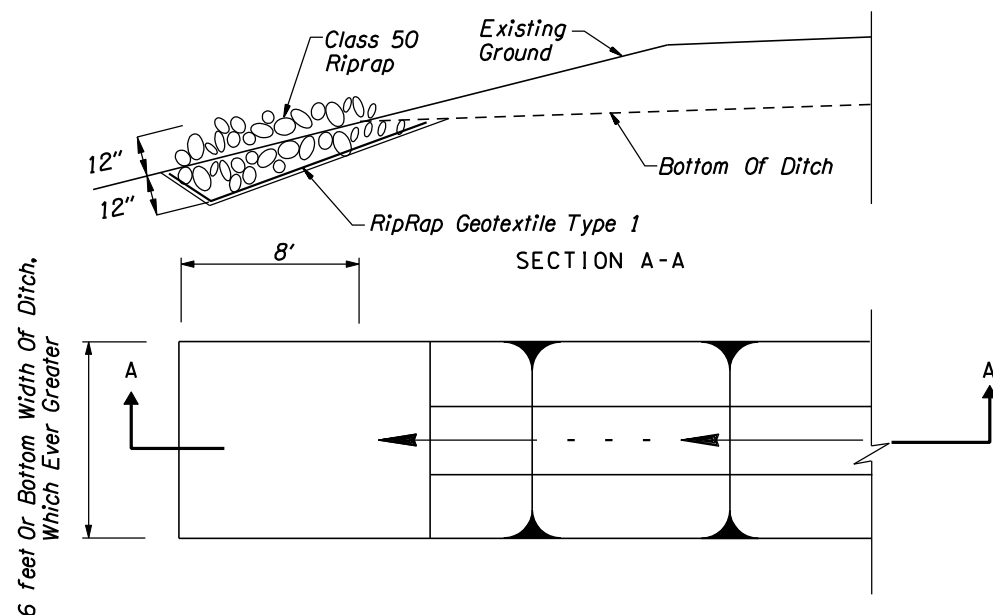

RIPRAP OUTLET PAD
AT END OF SWALES/DITCHES

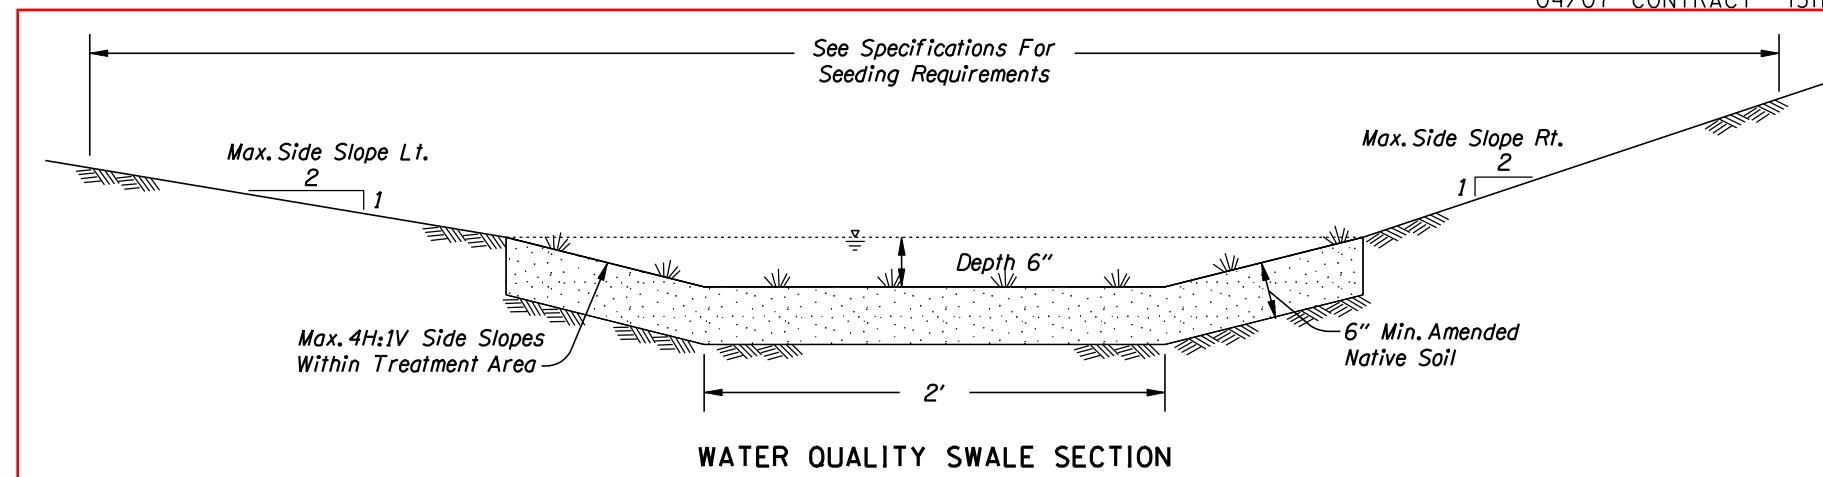


WATER QUALITY SWALE SECTION


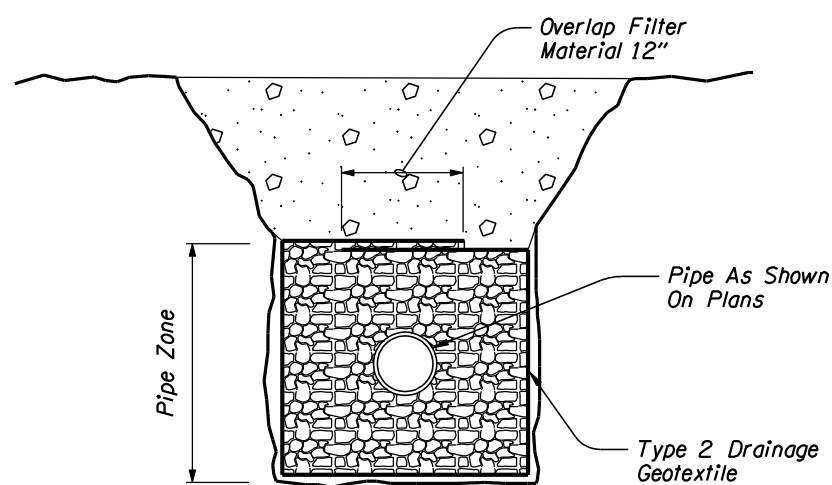


LINED PIPE
TRENCH DETAIL

Note:
For Additional Trench
Details, See Drg. No. RD300.

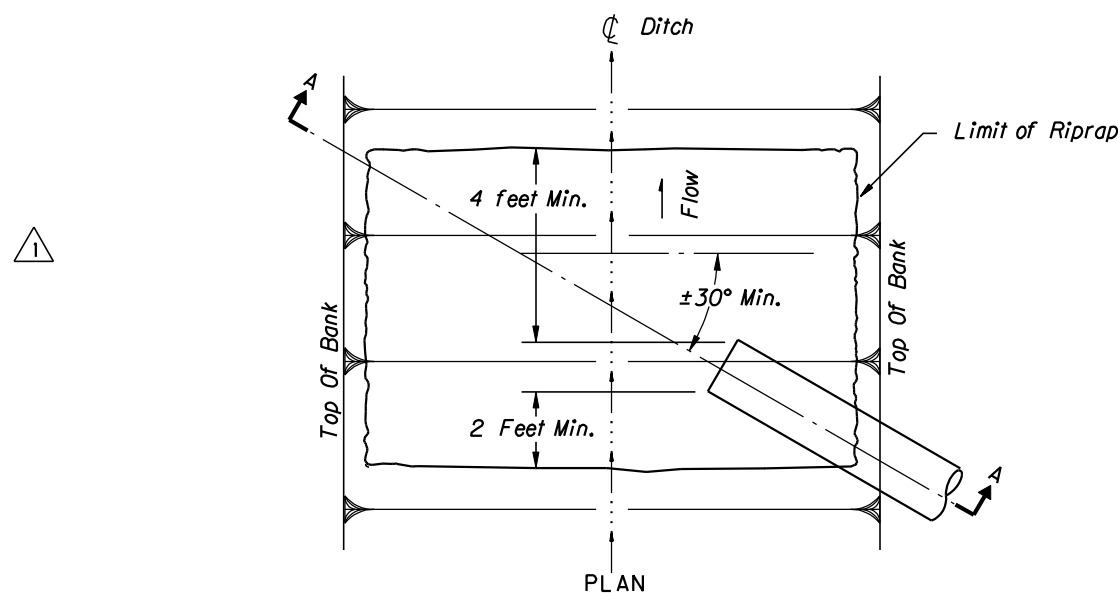


RIPRAP OUTLET PAD
AT END OF PIPE

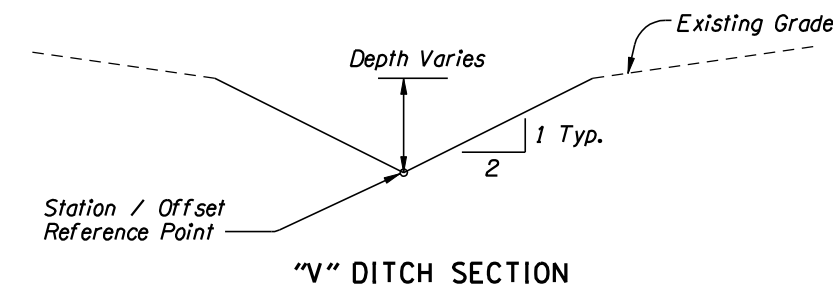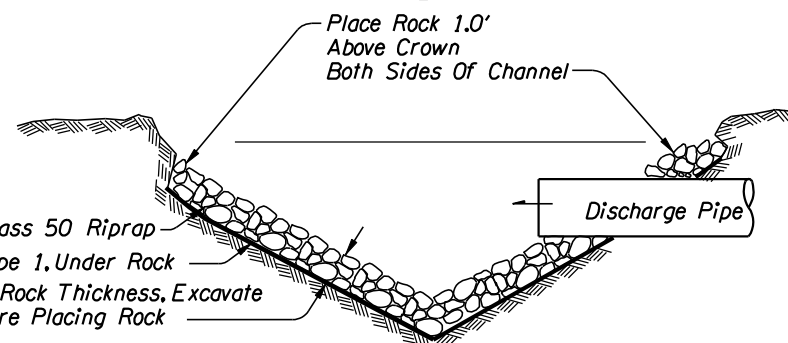

"V" DITCH SECTION

Rev. No.	Date	Revision
2	4/11/2007	As Constructed
1	6/20/2006	Added Pipe Trench Detail

OREGON DEPARTMENT OF TRANSPORTATION ROADWAY ENGINEERING SECTION	
I-5: CLARKS BRANCH TO TUNNEL MILL RACE SEC. DESIGN-BUILD PROJECT PACIFIC HIGHWAY LANE AND DOUGLAS COUNTIES Reviewed By - Steve Katko Designed By - Mark Anderson Drafted By - Robert Luke	
DRAINAGE DETAILS	SHEET NO. 2B-4

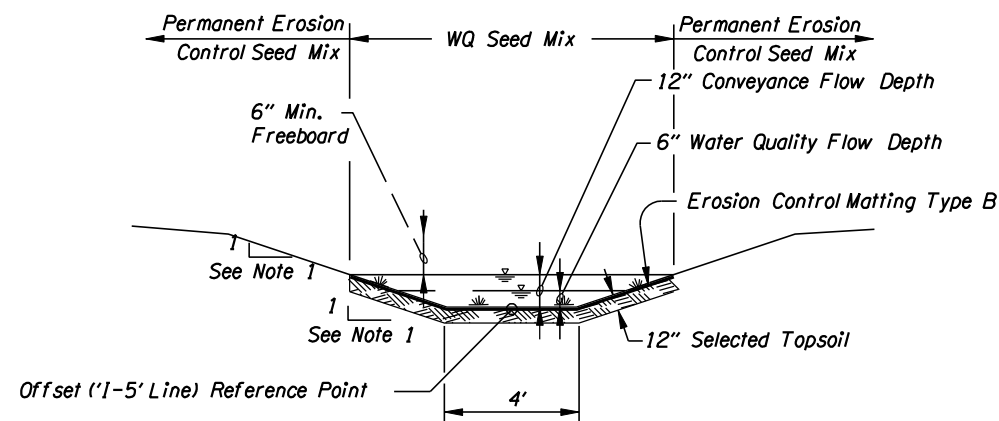

Notes:


1. Sideslopes In The Water Quality Section Of The Swale Shall Be 4H:1V Maximum. Sideslopes In the Conveyance Flow Depth Section Above The Water Quality Flow Depth Shall Match Embankment Slopes, Not To Exceed 3H:1V.
2. Erosion Control Matting Materials And Installation Per ODOT Std. Spec. Section 280.

TYPICAL BIOSWALE SECTION

Rev. No.	Date	Revision
1	4/11/2007	As Constructed


OREGON DEPARTMENT OF TRANSPORTATION ROADWAY ENGINEERING SECTION	
I-5: CLARKS BRANCH TO TUNNEL MILL RACE SEC. DESIGN-BUILD PROJECT PACIFIC HIGHWAY LANE AND DOUGLAS COUNTIES	
Reviewed By - Tim Yamada Designed By - Chris Allen Drafted By - Robert Luke	
DRAINAGE DETAILS	
SHEET NO. 2B-5	

Sec. 26, T. 19 S., R. 3 W., W.M.

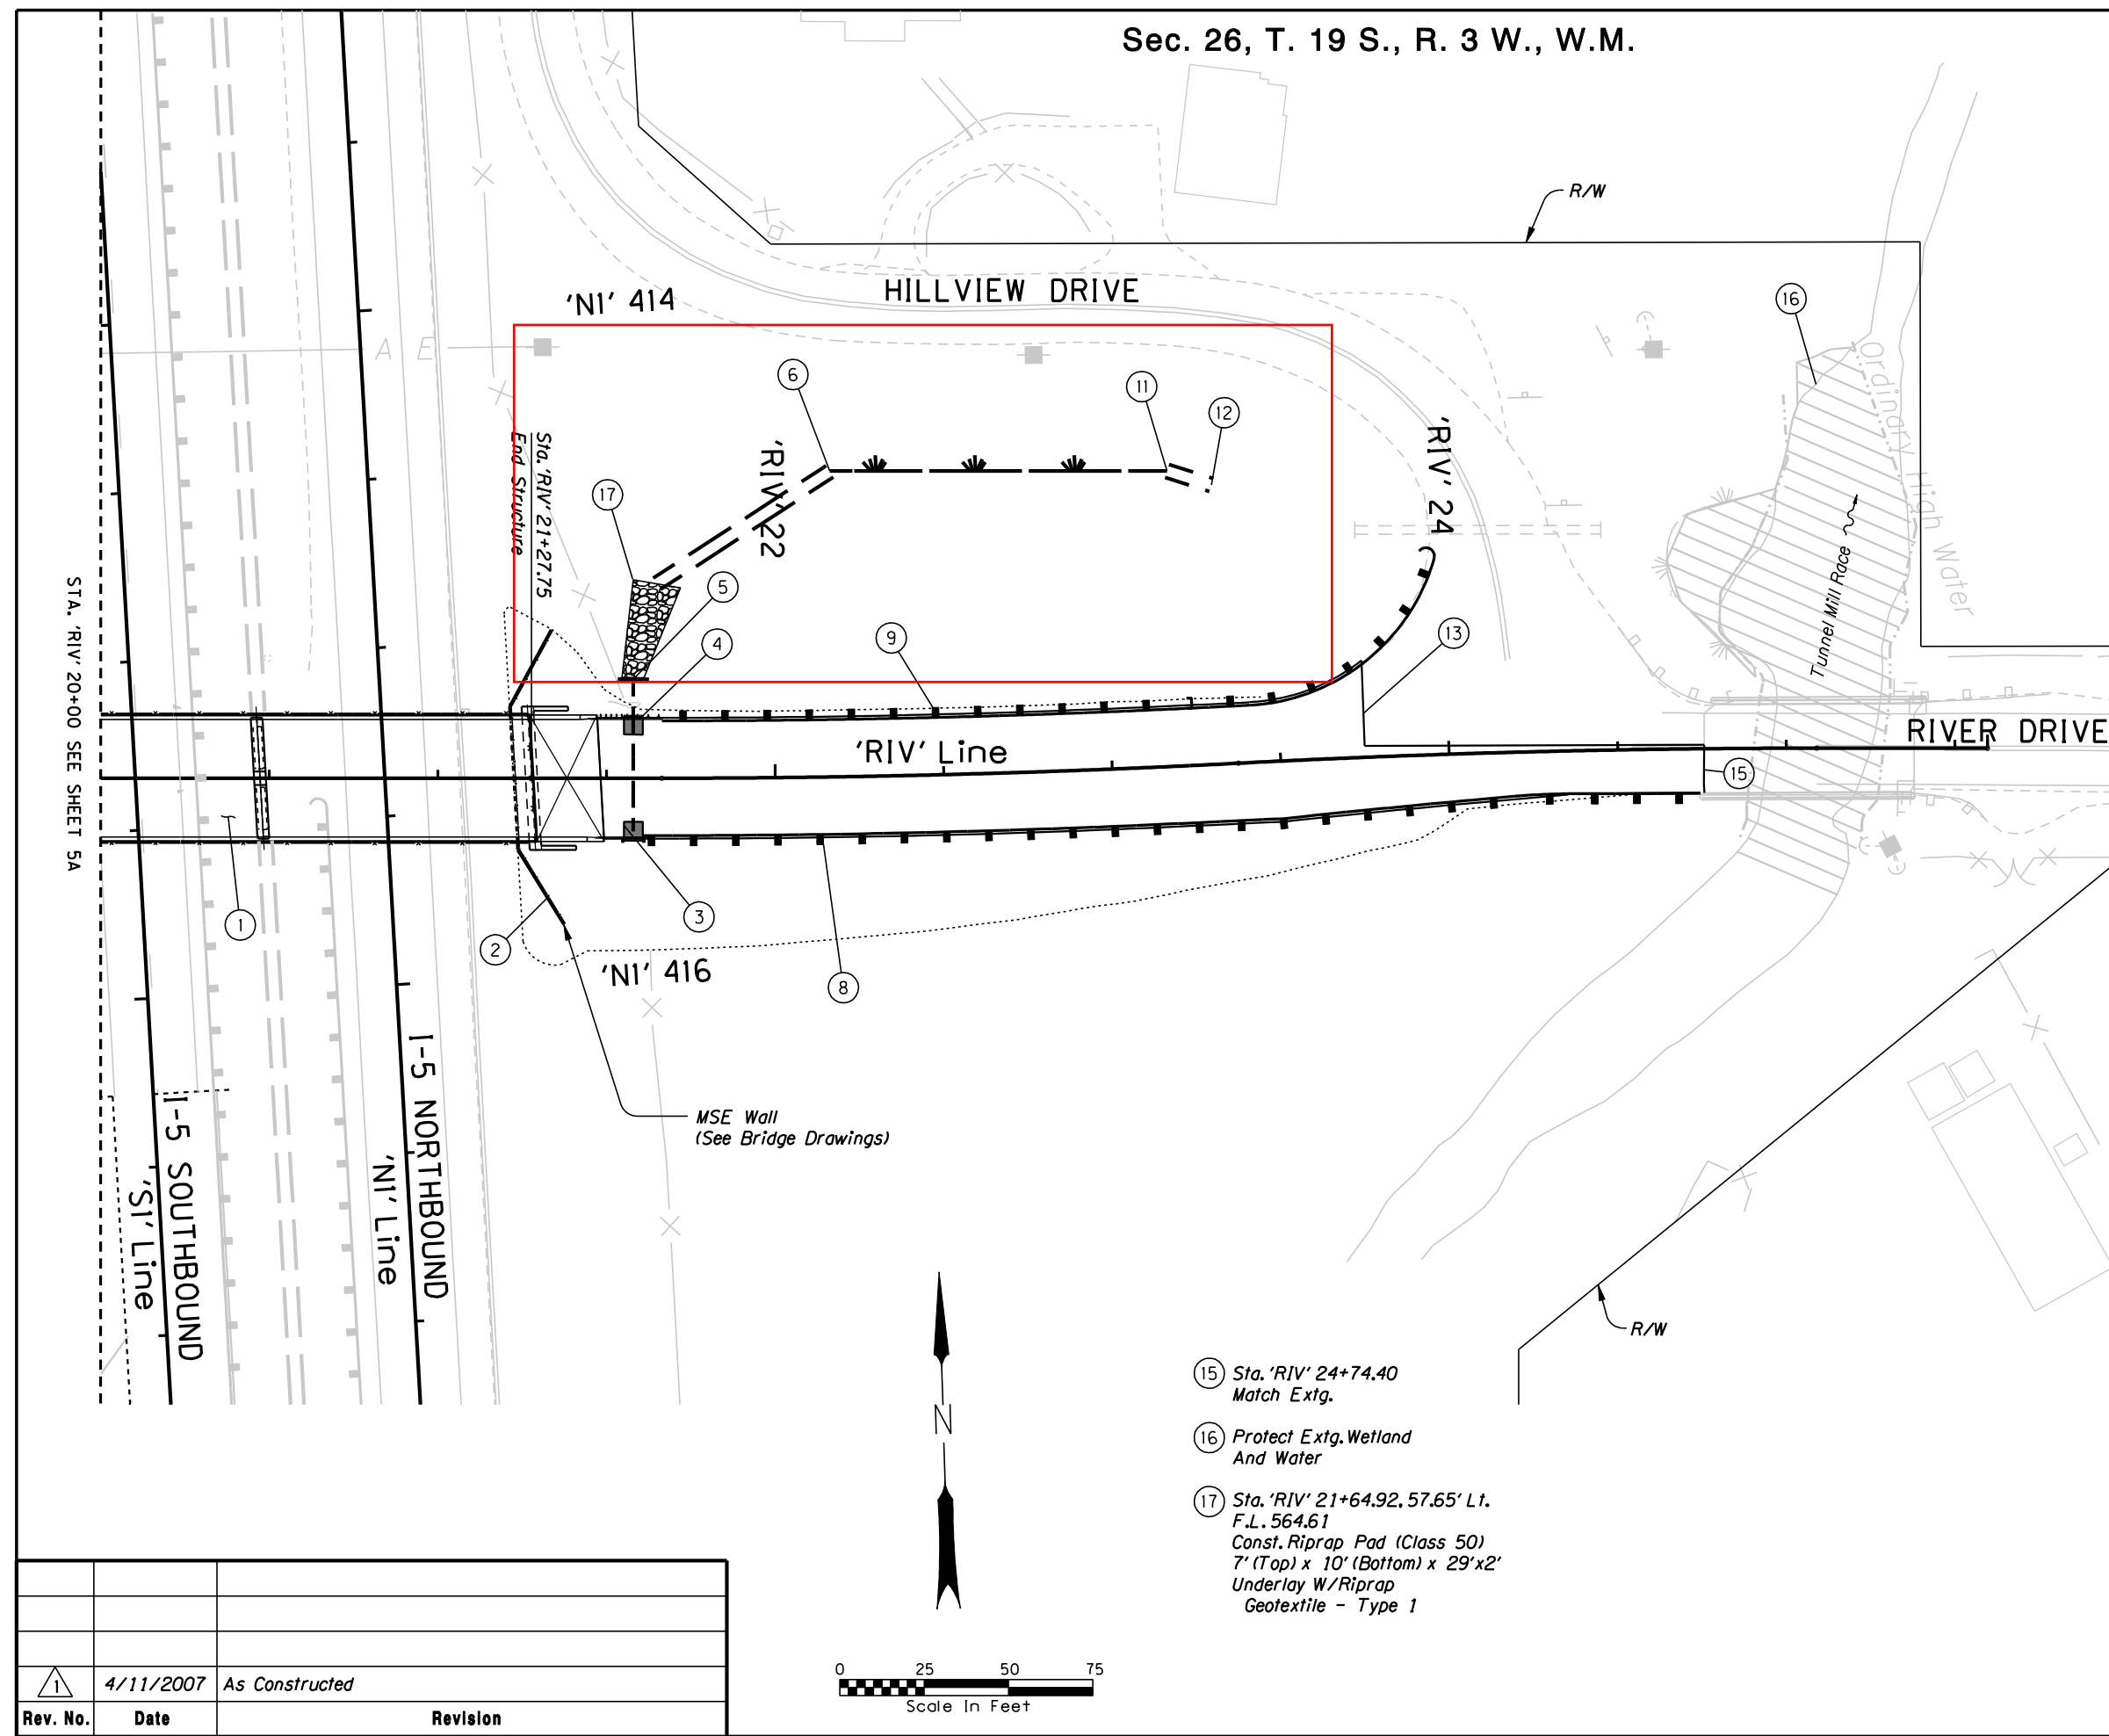

- ① Const. Structure
(See Sht. 5A, Note 16)
- ② Install Type 2 Fence - 94'
(See Drg. No. RD810)
- ③ Sta. 'RIV' 21+57.92, 15.74' Rt.
Const. Type "G-2" Inlet
Grate Elev. 586.71
I.E. 583.71 N.
Inst. Drainage Curb - 11'
- ④ Sta. 'RIV' 21+57.92, 15.73' Lt.
Const. Type "G-2" Inlet
Grate Elev. 586.71
I.E. 583.20 N.
I.E. 583.40 S.
Inst. 12" Storm Sew. Pipe, CPEP - 31'
Inst. Drainage Curb - 13'
- ⑤ Sta. 'RIV' 21+57.92, 29.37' Lt.
Inst. 12" Storm Sew. Pipe, CPEP - 14'
I.E. 583.06
- ⑥ Sta. 'RIV' 22+17.58, 90.70' Lt.
Const. Ditch 2' Bottom, 2:1 Slopes
F.L. 564.30
- ⑧ Sta. 'RIV' 21+49.24 To
Sta. 'RIV' 24+73.64
Const. Guardrail Transition - 1
Const. Bridge Rail To Guardrail Connection - 1
Const. Guardrail (Type 3) - 12.5'
Const. Guardrail (Type 2A) - 281.85'
(See Drg. Nos. RD400, RD405, RD415,
RD440, BR203, BR236)
- ⑨ Sta. 'RIV' 21+47.18 To
Sta. 'RIV' 23+97.60
Const. Guardrail Transition - 1
Const. Guardrail (Type 3) - 25'
Const. Guardrail (Type 2A) - 175'
Const. Weak Post W Beam - 50'
Const. Type 1 Anchor
(For Details, See Sht. 2B-8 And Drg. Nos.
RD400, RD405, RD415, RD420, RD440, BR203)
- ⑩ Sta. 'RIV' 23+20.34, 87.58' Lt.
Const. Bioswale - 100'
(For Details, See Sht. 2B-4)
F.L. 563.80
- ⑪ Sta. 'RIV' 23+33.64, 82.79' Lt.
Const. Ditch 4' Bottom, 2:1 Slopes
F.L. 563.74 (Match Extg.)
- ⑫ Sta. 'RIV' 23+75.00
Match Extg. (Westbound Lane)
Begin Inlay (Eastbound Lane)

- ⑮ Sta. 'RIV' 24+74.40
Match Extg.
- ⑯ Protect Extg. Wetland
And Water
- ⑰ Sta. 'RIV' 21+64.92, 57.65' Lt.
F.L. 564.61
Const. Riprap Pad (Class 50)
7' (Top) x 10' (Bottom) x 29'x2'
Underlay W/Riprap
Geotextile - Type 1

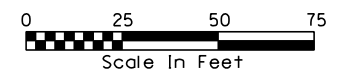

Rev. No.	Date	Revision
1	4/11/2007	As Constructed

OREGON DEPARTMENT OF TRANSPORTATION
ROADWAY ENGINEERING SECTION

I-5: CLARKS BRANCH TO TUNNEL MILL RACE SEC. DESIGN-BUILD PROJECT


PACIFIC HIGHWAY
LANE AND DOUGLAS COUNTIES

Reviewed By - Shari Munroe
Designed By - Scott Christopherson
Drafted By - Lewis Demitroff


STA. 'RIV' 20+00 TO STA. 'RIV' 26+00
ROADWAY PLAN

SHEET NO. **5C**

RIV PROFILE

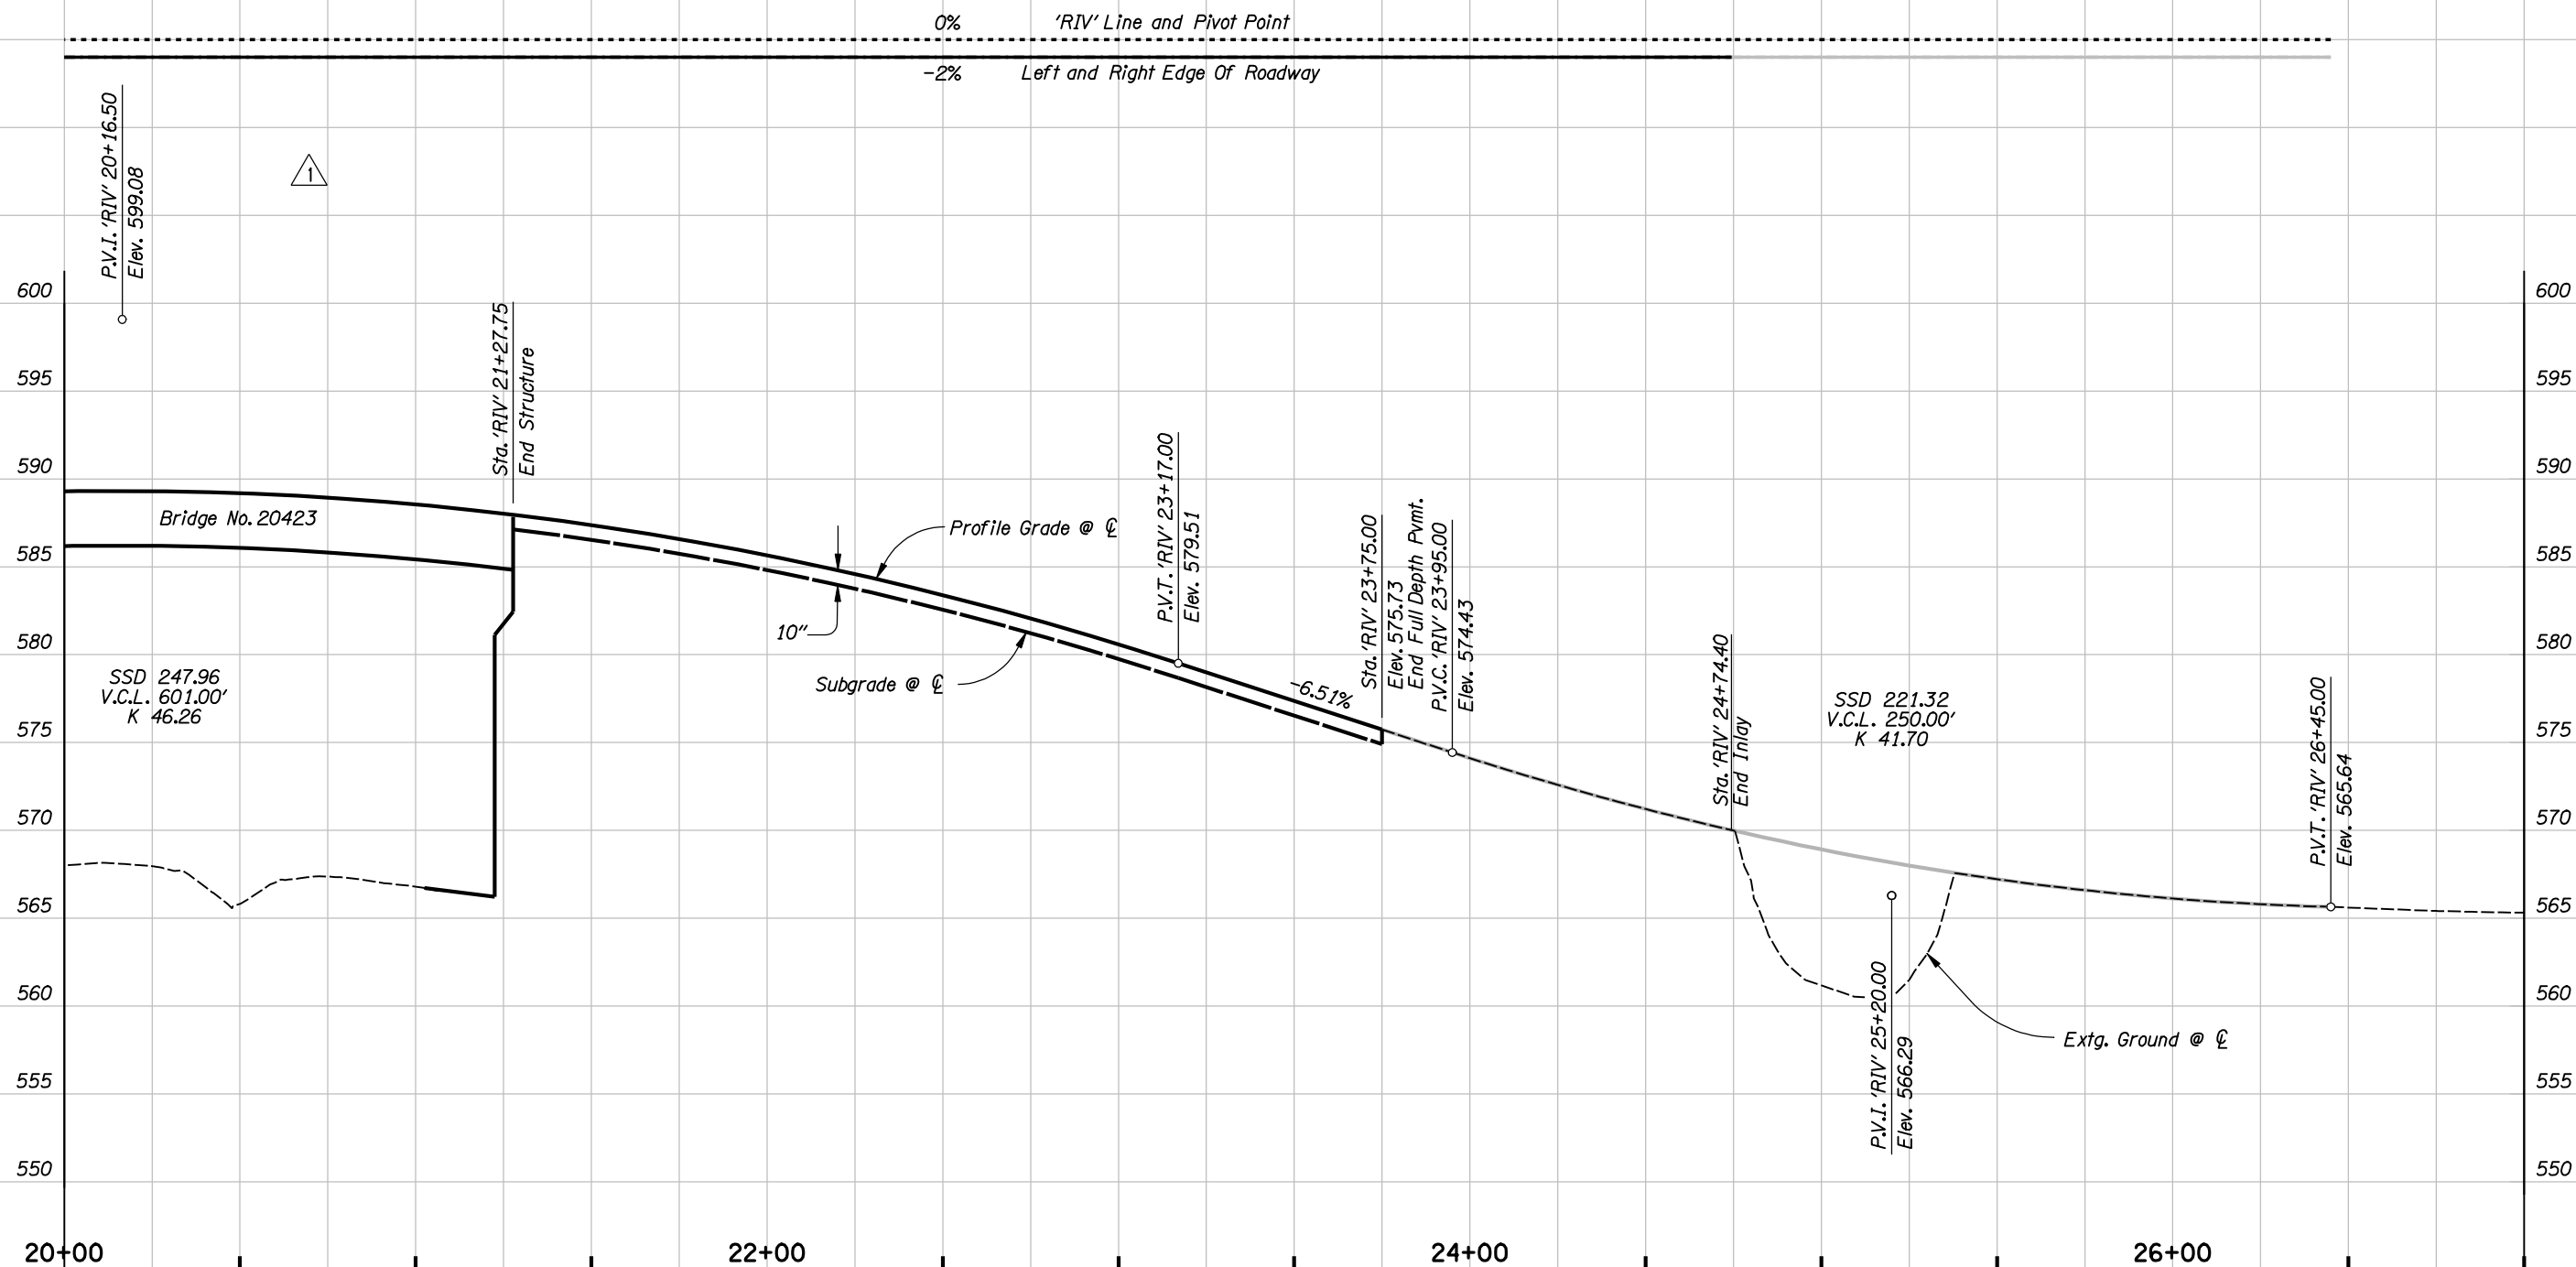

Rev. No.	Date	Revision
2	4/11/2007	As Constructed
1	2/12/2007	Profile Adjustment During Construction

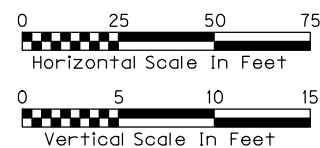

OREGON DEPARTMENT OF TRANSPORTATION
ROADWAY ENGINEERING SECTION

I-5: CLARKS BRANCH TO TUNNEL MILL RACE SEC. DESIGN-BUILD PROJECT


PACIFIC HIGHWAY
LANE AND DOUGLAS COUNTIES

Reviewed By - Shari Munroe
Designed By - Scott Christopherson
Drafted By - Lewis Demitroff

STA. 'RIV' 20+00 TO STA. 'RIV' 26+00
ROADWAY PROFILE

SHEET NO. **5D**

Sec. 26, T. 19 S., R. 3 W., W.M.

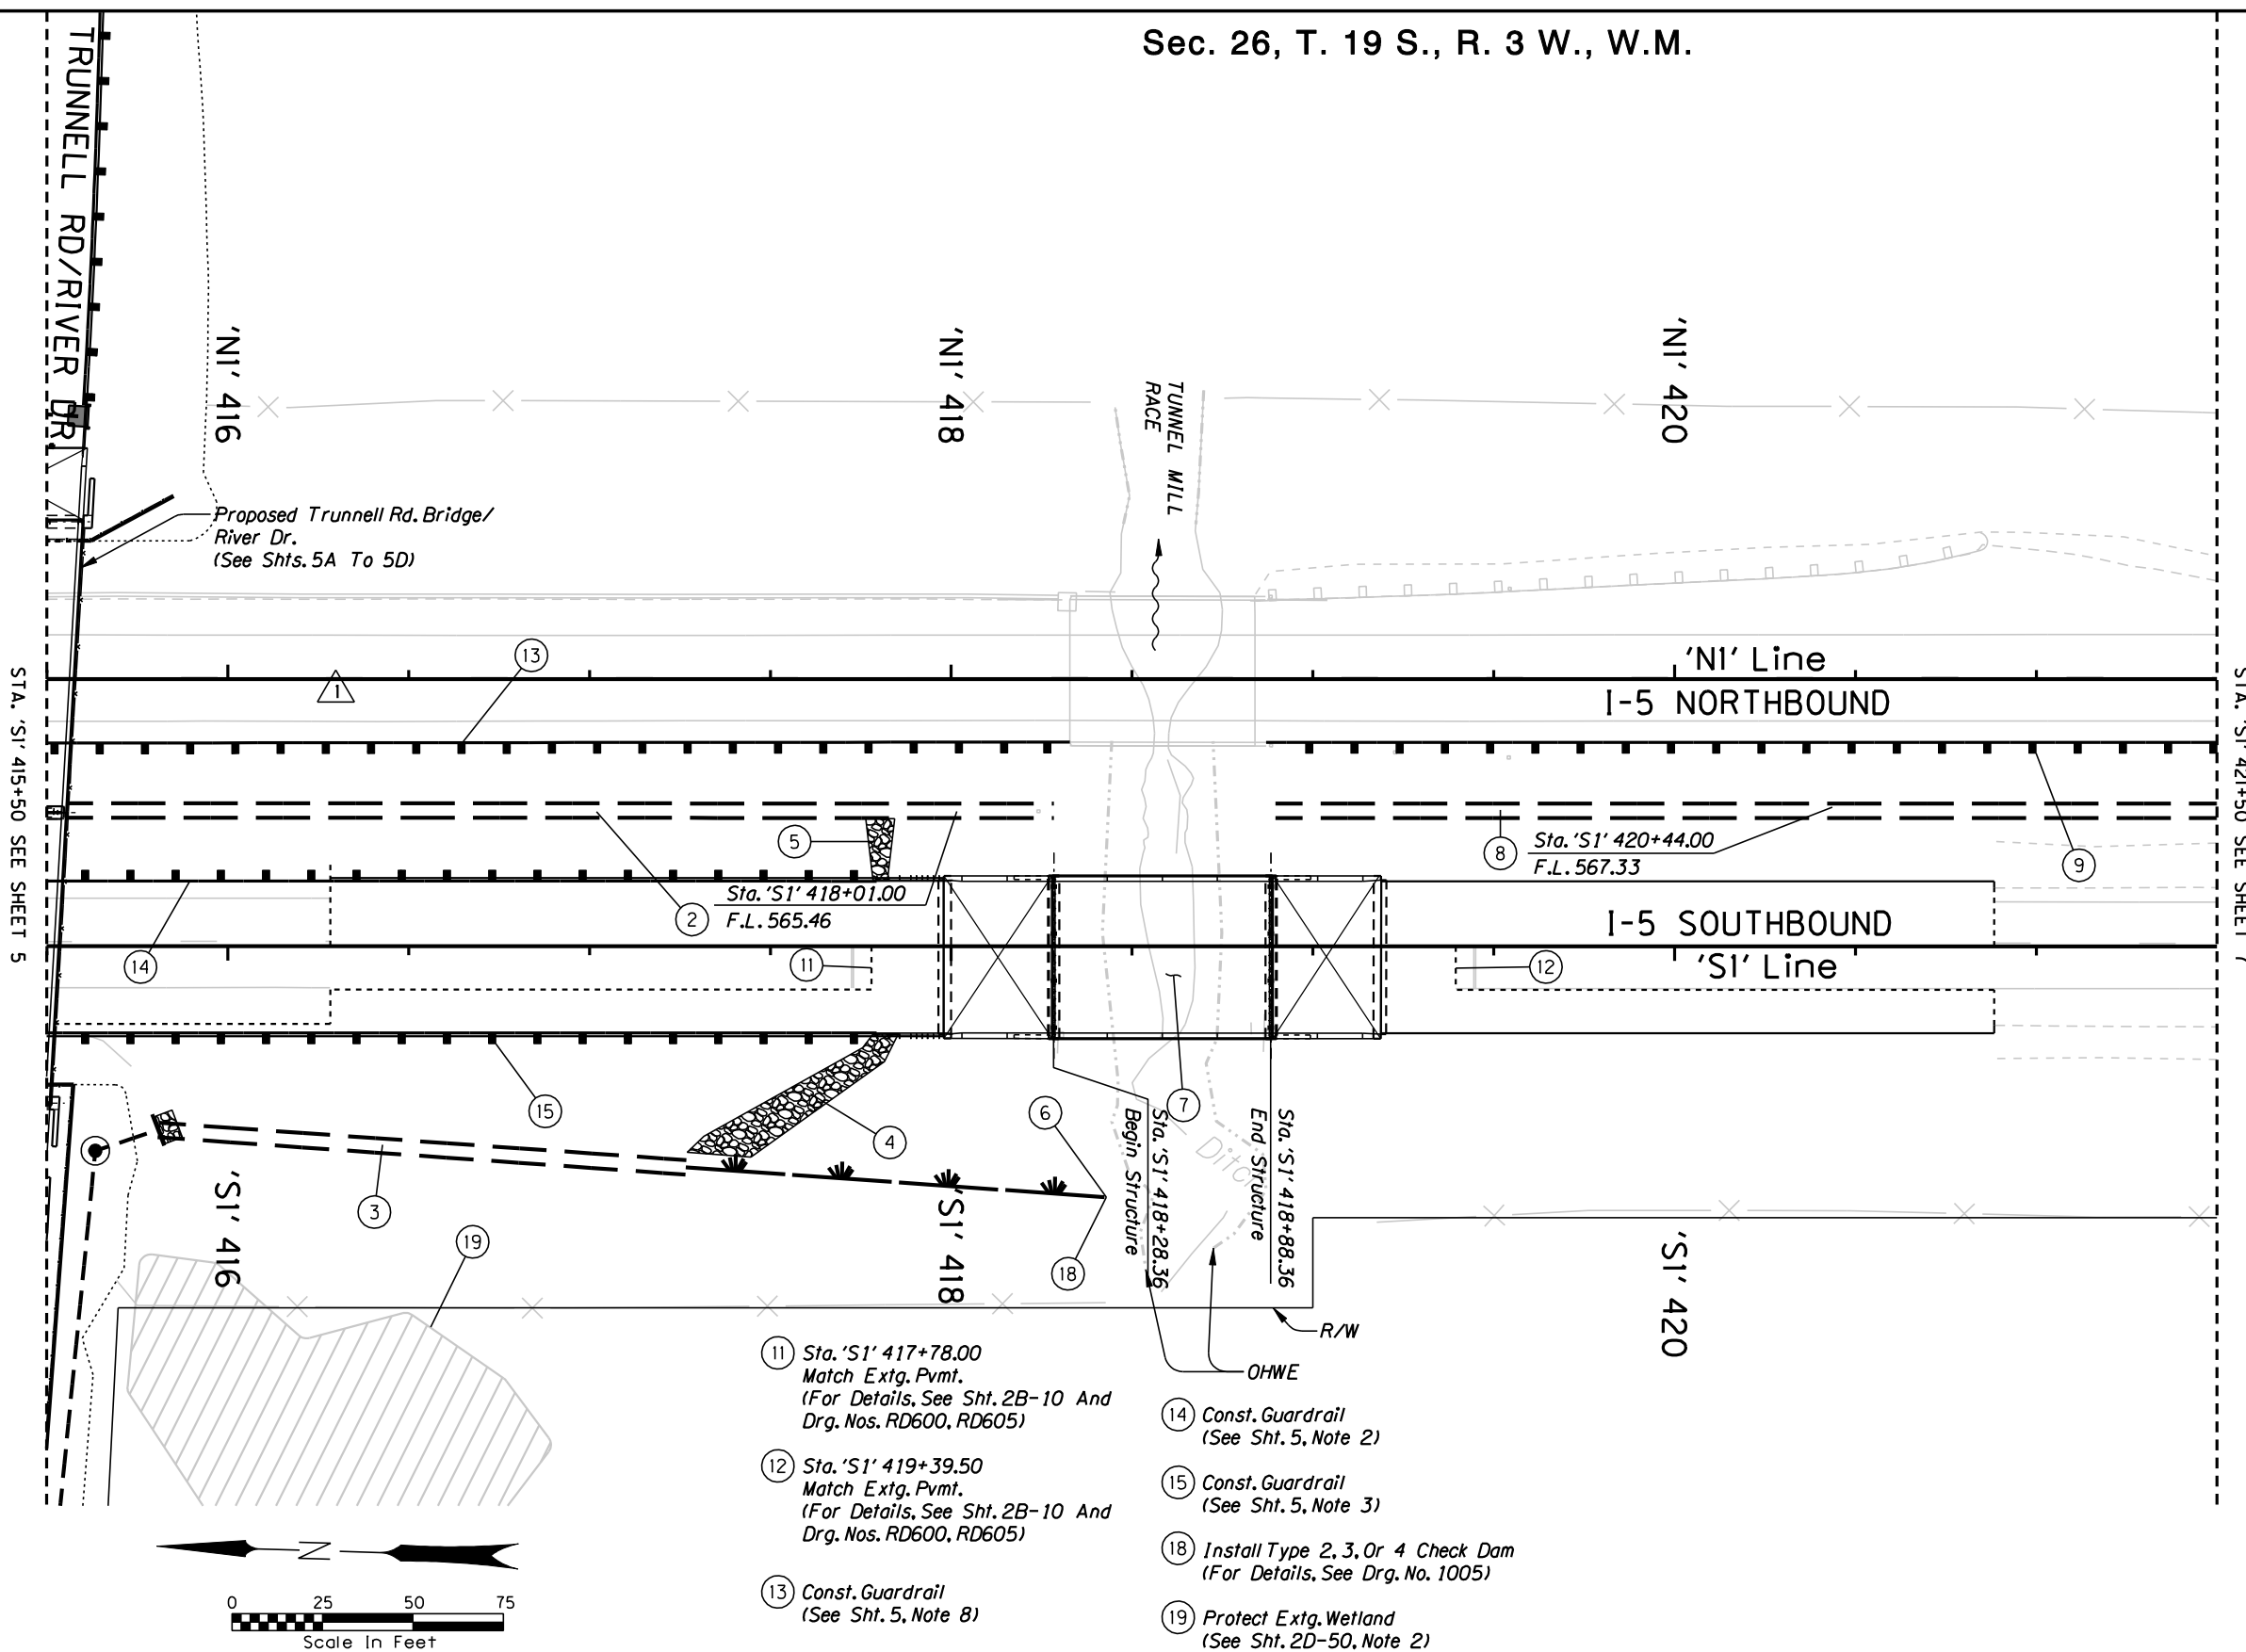

- ② Sta. 'S1' 415+55.00, 37.50' Lt., F.L. 565.84 To Sta. 'S1' 418+28.00, 37.50' Lt., F.L. 564.95
(Match Extg.)
Const. Ditch
"V" Bottom, Varying Slopes.
(See Plans For Intermediate F.L. Elevations At Grade Breaks)
- ③ Sta. 'S1' 415+80.80, 50.80' Rt., F.L. 563.55 To Sta. 'S1' 417+26.66, 61.15' Rt., F.L. 562.82
Const. Ditch W/Berm
"V" Bottom, 3:1 Slopes
(For Details, See Sht. 2B)
- ④ Sta. 'S1' 417+36.00, 60.00' Rt. To Sta. 'S1' 417+81.50, 24.00' Rt.
Const. Riprap Pad (Class 50)
4'(Top) x 12'(Bottom) x 60' x 2'
Underlay W/Riprap Geotextile - Type 1
- ⑤ Sta. 'S1' 417+80.00, Lt.
Const. Riprap Pad (Class 50)
4'(Top) x 10'(Bottom) x 18' x 2'
Underlay W/Riprap Geotextile - Type 1
- ⑥ Sta. 'S1' 417+26.66, 61.15' Rt., F.L. 562.82 To Sta. 'S1' 418+42.86, 69.38' Rt., F.L. 562.23
(Match Extg.)
Const. Bioswale - 116'
At 0.5% Grade
(For Details, See Sht. 2B-5)
- ⑦ Bridge No. 20413
Const. Structure - 60'
Rdwy. Width 42'
And Reinf. Panel At Bridge Ends
(For Details, See Sht. C8-101)
- ⑧ Sta. 'S1' 418+90.00, 37.50' Lt., F.L. 566.23 (Match Extg.) To Sta. 'S1' 424+39.00, 37.50' Lt., F.L. 568.81 (Match Extg.)
Const. Ditch
"V" Bottom, Varying Slopes.
(See Plans For Intermediate F.L. Elevations At Grade Breaks)
- ⑨ Sta. 'N1' 418+87.07 To Sta. 'N1' 422+55.22
Const. Transition - 1
Const. Guardrail (Type 3) - 12.5'
Const. Guardrail (Type 2A) - 312.5'
Const. Flared Terminal - 1
W=4', E=0'
(For Details, See Sht. 2A-31 And Drg. Nos. BR203, RD400, RD405, RD415, RD425 & RD440)

- ⑪ Sta. 'S1' 417+78.00 Match Extg. Pvmt. (For Details, See Sht. 2B-10 And Drg. Nos. RD600, RD605)
- ⑫ Sta. 'S1' 419+39.50 Match Extg. Pvmt. (For Details, See Sht. 2B-10 And Drg. Nos. RD600, RD605)
- ⑬ Const. Guardrail (See Sht. 5, Note 8)
- ⑭ Const. Guardrail (See Sht. 5, Note 2)
- ⑮ Const. Guardrail (See Sht. 5, Note 3)
- ⑯ Install Type 2, 3, Or 4 Check Dam (For Details, See Drg. No. 1005)
- ⑰ Protect Extg. Wetland (See Sht. 2D-50, Note 2)

Rev. No.	Date	Revision
②	4/11/2007	As Constructed
①	6/26/2006	Replaced Roadside Barrier

OREGON DEPARTMENT OF TRANSPORTATION
ROADWAY ENGINEERING SECTION

I-5: CLARKS BRANCH TO TUNNEL MILL RACE SEC. DESIGN-BUILD PROJECT


PACIFIC HIGHWAY
LANE AND DOUGLAS COUNTIES

Reviewed By - Shari Munroe
Designed By - Scott Christopherson
Drafted By - Lewis Demitroff


STA. 'S1' 415+50 TO STA. 'S1' 421+50
ROADWAY PLAN

SHEET NO. **6**

S1 PROFILE

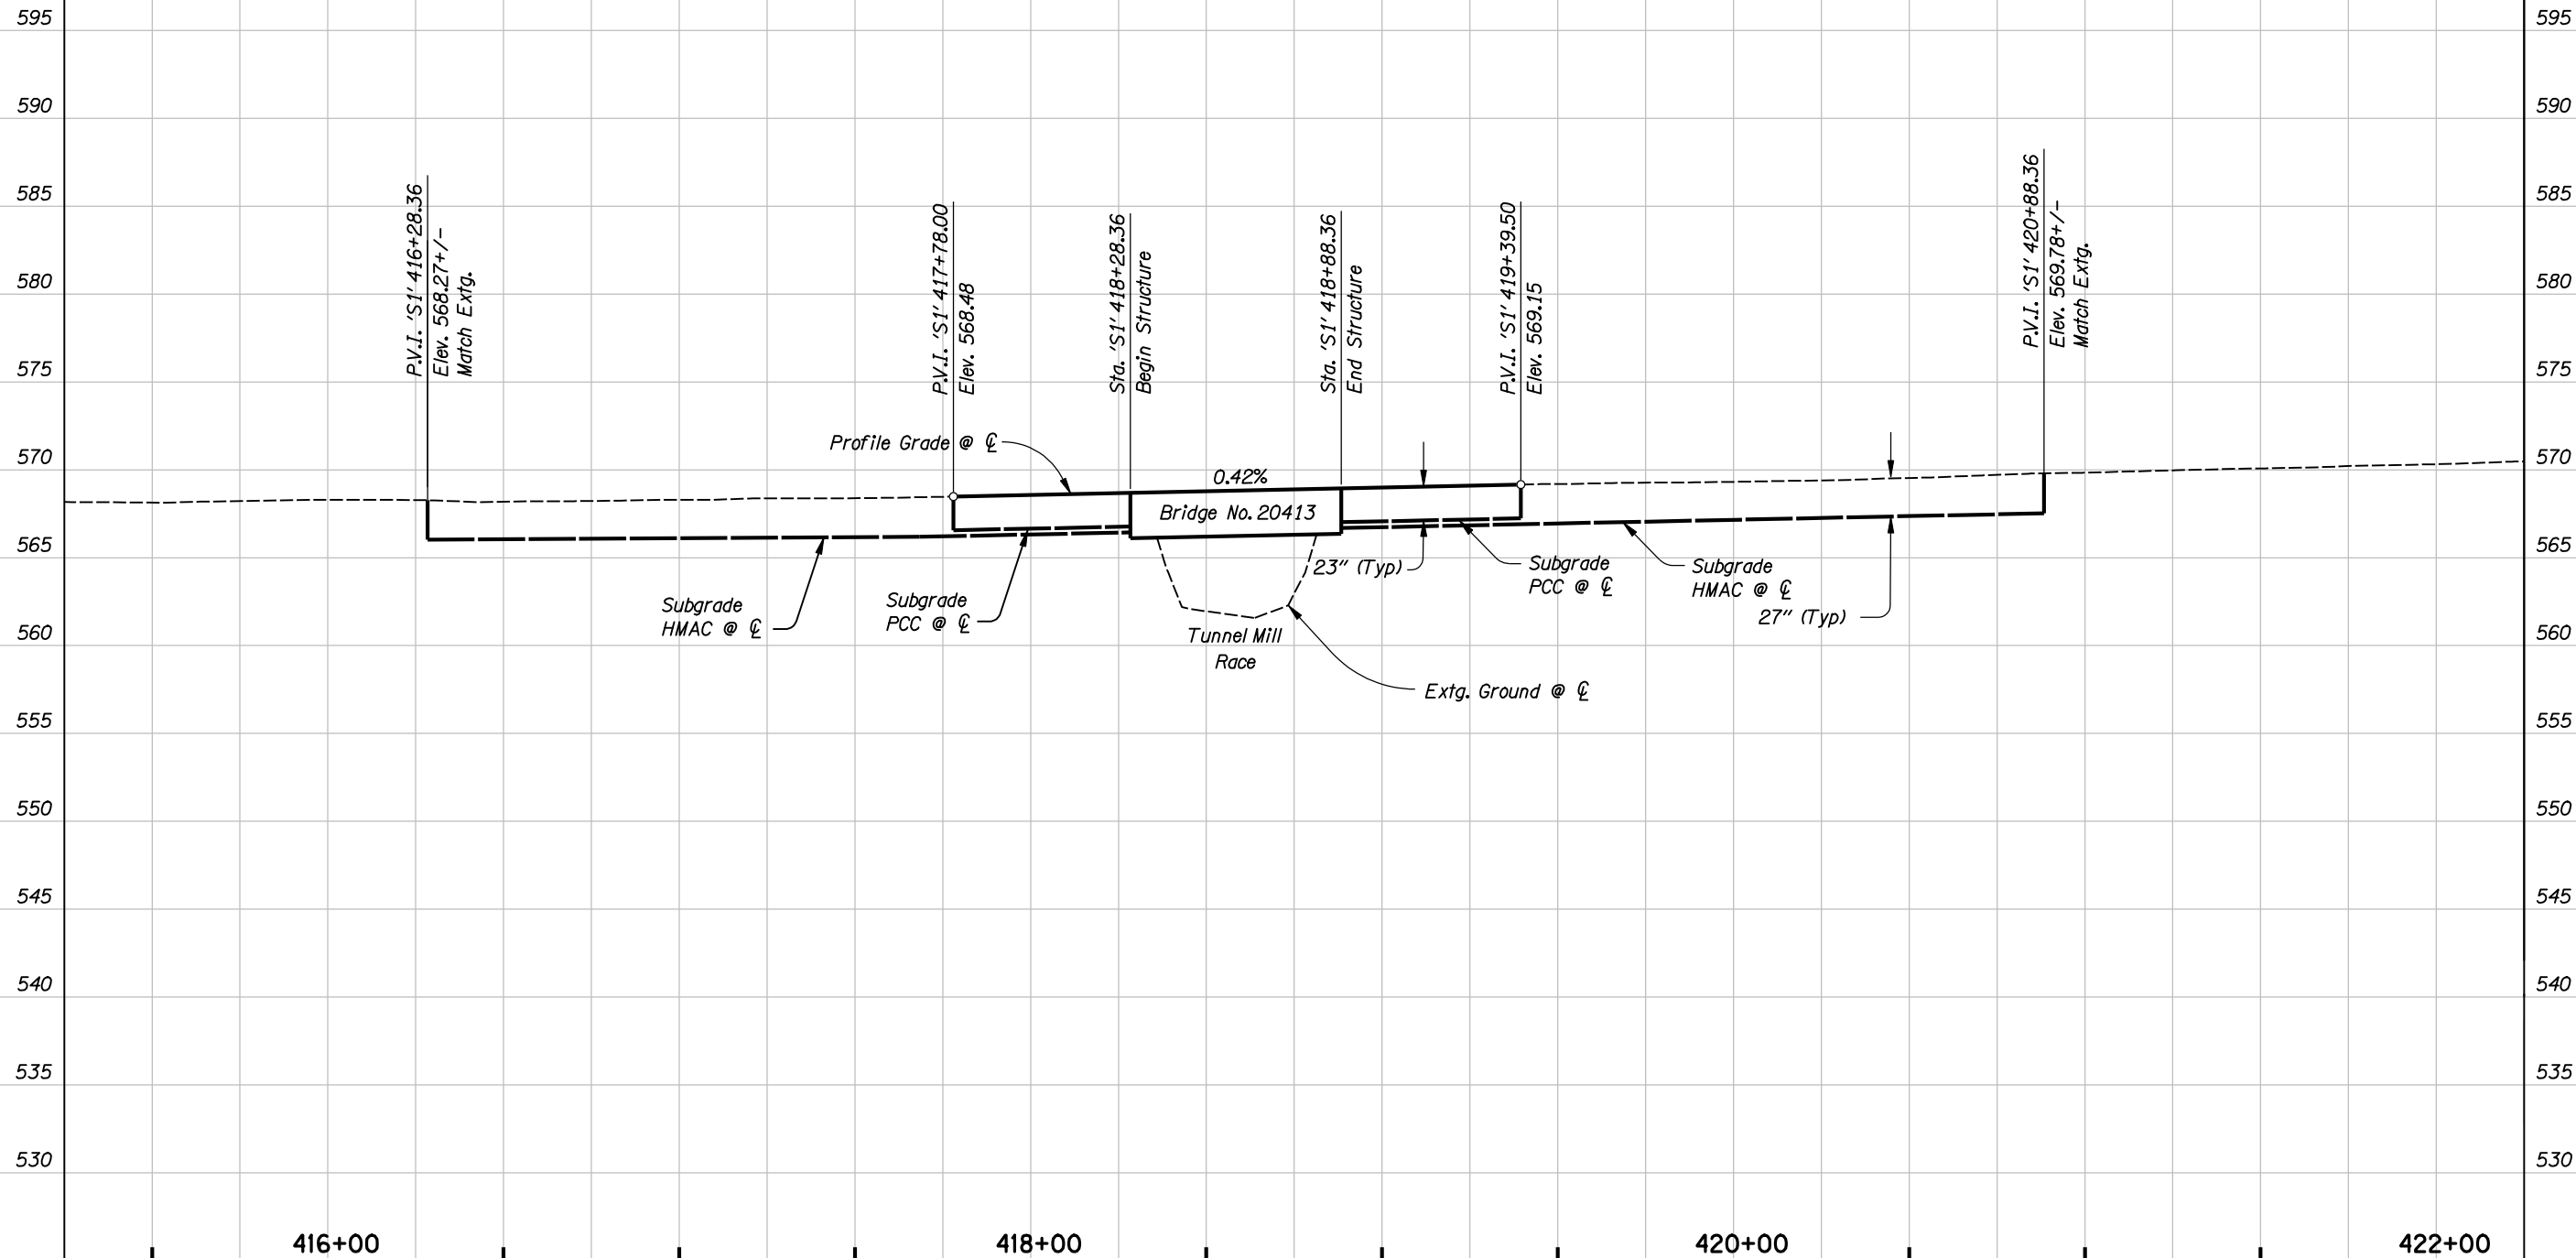

Rev. No.	Date	Revision
1	4/11/2007	As Constructed

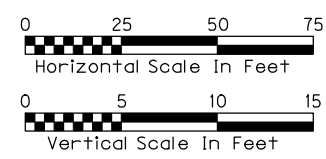

OREGON DEPARTMENT OF TRANSPORTATION
ROADWAY ENGINEERING SECTION

I-5: CLARKS BRANCH TO TUNNEL MILL RACE SEC. DESIGN-BUILD PROJECT

PACIFIC HIGHWAY
LANE AND DOUGLAS COUNTIES

Reviewed By - Shari Munroe
Designed By - Scott Christopherson
Drafted By - Lewis Demitroff

STA. 'S1' 415+50 TO STA. 'S1' 421+50
ROADWAY PROFILE

SHEET NO. **6A**