

OPERATION & MAINTENANCE MANUAL

DFI No. : D00349

Facility Type: Detention Pond



July, 2016

INDEX

1. IDENTIFICATION3

2. FACILITY CONTACT INFORMATION.....3

3. CONSTRUCTION3

4. STORM DRAIN SYSTEM AND FACILITY OVERVIEW.....4

5. FACILITY HAZ MAT SPILL FEATURE(S).....7

6. AUXILIARY OUTLET (HIGH FLOW BYPASS)7

7. MAINTENANCE ACTIONS.....7

8. WASTE MATERIAL HANDLING8

APPENDIX A: Operational Plan and Profile Drawing(s)

APPENDIX B: ODOT Project Plan Sheets

1. Identification

Drainage Facility ID (DFI): **D00349**
Facility Type: Detention Pond
Construction Drawings: (V-File Number) 41V-065
Location: District: 2C
Highway No.: 002
Mile Post: 18.02; 18.02 (beg./end)
Description: This facility is located on the northeast corner or exit 18 off of I-84. The pond is adjacent to the west bound off ramp.

2. Facility Contact Information

Contact the Engineer of Record, Region Technical Center, or Geo-Environmental's Senior Hydraulics Engineer for:

- Operational clarification
- Maintenance clarification
- Repair or restoration assistance

Engineering Contacts:

Region Technical Center Hydro Unit Manager

Or

Geo-Environmental Senior Hydraulics Engineer (503) 986-3365.

3. Construction

Engineer of Record: ODOT Designer –Geo-Environmental, Alvin Shoblom,
503-986-3365
Consultant Designer – Region 1 Roadway Engineering

Facility construction: 2008
Contractor: Unable to Determine

4. Storm Drain System and Facility Overview

A detention facility is designed to control the quantity of runoff, by reducing the peak discharge and only detaining runoff for some short period of time. These facilities are designed to store and gradually release or attenuate stormwater runoff via a control structure or release mechanism, and completely drain after the design storm has passed. The most common detention facilities include:

- Dry ponds - these are depressed storage areas that store runoff during wet weather and are dry the rest of the time. Usually they are earthen depressions.
- Tanks - these are underground storage facilities that are typically constructed from large diameter pipe.
- Vaults - these are enclosed underground storage facilities. They are typically constructed from reinforced concrete.

This particular facility is a bioretention pond, designed to detain stormwater runoff and infiltrate it through a water quality mix, filtering the particulates (soil particles) contained in the water. The facility collects stormwater runoff along I-84 east of Exit 18 by means of sheet flow and one G-2MA and a 12 inch ductile iron pipe. The facility's only outlet is an overflow spillway which flows east to a neighboring roadside ditch. Additionally, photos of the facility can be seen in photos 1 through 4. A plan view and cross-sections of the facility are shown in Appendix A on the operational plan provided.

A. Maintenance equipment access:

The facility can be accessed for maintenance from I-84 west's north shoulder at exit 18's off ramp. The shoulder slopes are between four to six units horizontal to one unit vertical (4H : 1V). Maintenance equipment can park on these slopes near the facility but not on the facility. There are no guardrails at the road edge; however there are boulders along the facility edge.

B. Heavy equipment access into facility:

- Allowed (no limitations)
- Allowed (with limitations)
- Not allowed

C. Special Features:

- Amended Soils
- Porous Pavers
- Liners
- Underdrains



Photo 1: Facility Footprint



Photo 2: Looking from the East or Decreasing Mileage

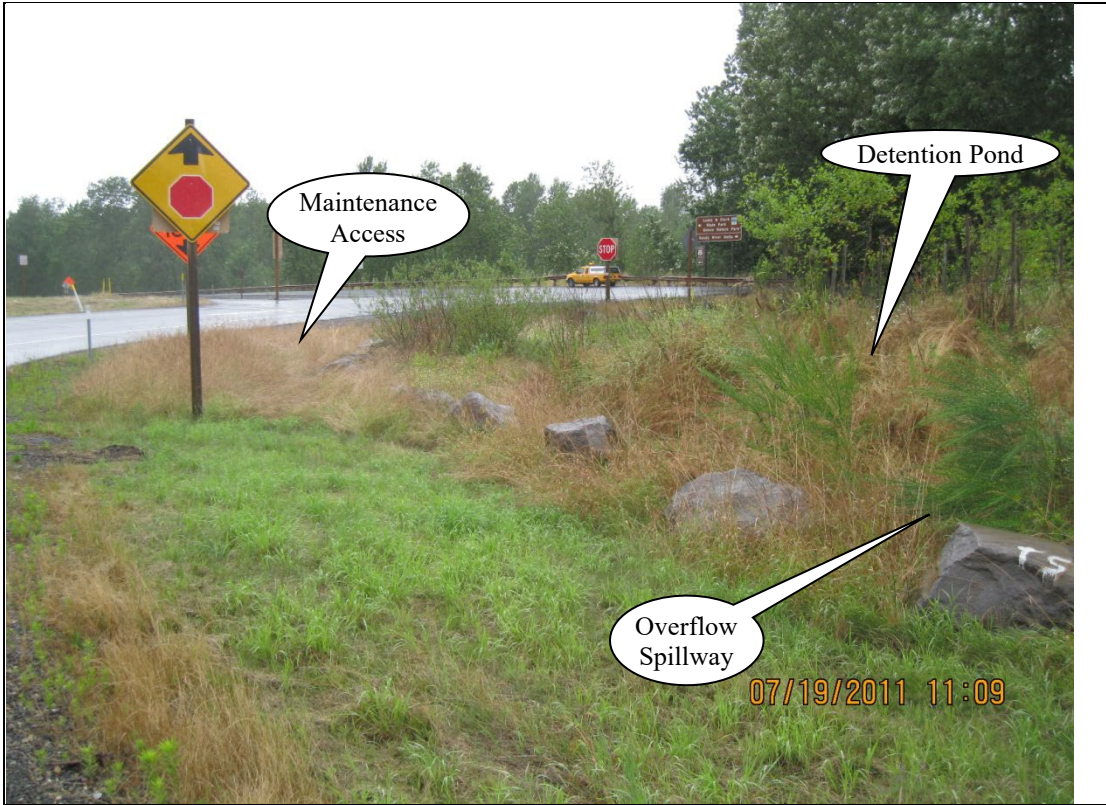


Photo 3: Looking From South, Overflow Spillway

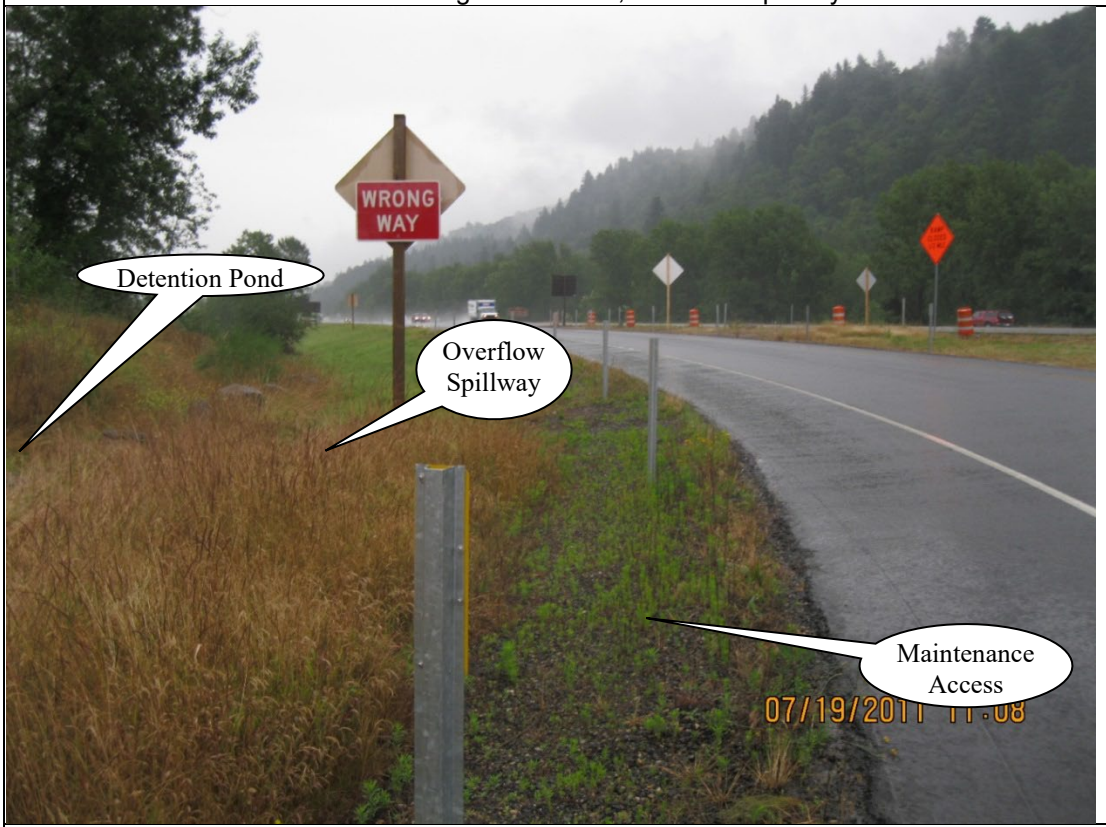


Photo 4: Looking from the West (or Increasing Mileage), Overflow Spillway

5. Facility Haz Mat Spill Feature(s)

Spill prevention is important to the successful operation of a stormwater management system. Prevention measures shall be taken at all times when handling substances that contaminate water. Should a spill occur, immediate attention is required and corrective measures shall be enacted as part of the response to control the spill.

If a Haz Mat spill were to occur within this drainage area, pond can be used to store a volume of liquid by blocking the adjacent roadside ditch (seen in Appendix A's operational plan).

6. Auxiliary Outlet (High Flow Bypass)

Auxiliary Outlets are provided if the primary outlet control structure can not safely pass the projected high flows. Broad-crested spillway weirs and over flow risers are the two most common auxiliary outlets used in stormwater facility design. The auxiliary outlet feature is either a part of the facility or an additional storm drain feature/structure.

The auxiliary outlet feature for this facility is:

- Designed into facility
- Other, as noted below

The facility incorporates an overflow spillway to neighboring roadside ditch, allowing high flows to exit.

7. Maintenance Actions

Routine maintenance table for non-proprietary stormwater treatment and storage/detention facilities have been incorporated into ODOT's Maintenance Guide. These tables summarize the maintenance actions for ponds, swales, filter strips, bioslopes, and detention tanks and vaults. Special maintenance actions in addition to the routine actions are noted below when applicable.

The ODOT Maintenance Guide can be viewed at the following website:

<http://www.oregon.gov/ODOT/HWY/OOM/MGuide.shtml>

Maintenance actions for proprietary structures, such as underground water quality manholes and/or vaults with filter media are noted in Appendix C when applicable.

The following stormwater facility maintenance table (See ODOT Maintenance Guide) should be used to maintain the facility outlined in this Operation and Maintenance Manual or follow the Maintenance actions outlined in Appendix C when proprietary structure is selected below:

- Table 1 (general maintenance)
- Table 2 (stormwater ponds)
- Table 3 (water quality biofiltration swales)
- Table 4 (water quality filter strips)
- Table 5 (water quality bioslopes)
- Table 6 (detention tank)
- Table 7 (detention vault)
- Appendix C (proprietary structure)
- Special Maintenance actions:

Note: Special maintenance Actions Require Concurrence from ODOT SR Hydraulics Engineer.

8. Waste Material Handling

Material removed from the facility is defined as waste by DEQ. Refer to the road waste section of the ODOT Maintenance Yard Environmental Management System (EMS) Policy and Procedures Manual for disposal options:

<http://egov.oregon.gov/ODOT/HWY/OOM/EMS.shtml>


Contact any of the following for more detailed information about management of waste materials found on site:

ODOT Clean Water Unit	(503) 986-3008
ODOT Statewide Hazmat Coordinator	(503) 229-5129
ODOT Region Hazmat Coordinator	(503) 731-8290
ODEQ Northwest Region Office	(503) 229-5263

Appendix A

Content:

- **Operational Plan and Profile Drawing(s)**

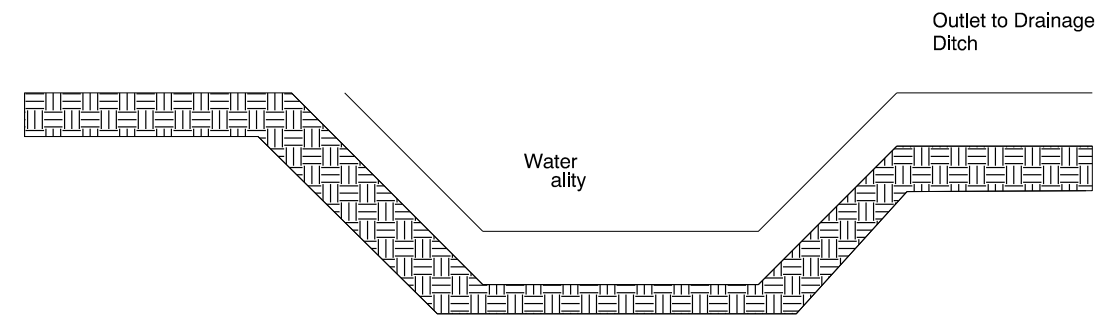

SECTION A-A
N.T.S.

Inlet Pipe

Detention Pond
(DFI D00349)

Water Quality
Mix

SECTION B-B
N.T.S.

PLAN
N.T.S.

Appendix B

Content:

- **ODOT Project Plan Sheets**
 - *Cover/Title Sheet*
 - *Water Quality/Detention Plan Sheets*
 - *Other Details*

INDEX OF SHEETS	
SHEET NO.	DESCRIPTION
1	Title Sheet
1A	Index Of Sheets Cont'd. & Std. Drg. Nos.

Revised Plan
Sheets Incorporated

BEGINNING OF PROJECT
X-PLH-S002(094)
STA. "JR" 10+72.8 (M.P. 18.37)
17.90



MULTNOMAH COUNTY
MAY 2008

STATE OF OREGON
DEPARTMENT OF TRANSPORTATION
PLANS FOR PROPOSED PROJECT
GRADING, PAVING, SIGNING & ROADSIDE DEVELOPMENT
I-84: SANDY RIVER DELTA ACCESS SEC.
COLUMBIA RIVER HIGHWAY

Revised Plan
Sheets Incorporated

41V-65

"AS CONSTRUCTED"
MAY 2008
PROJECT MANAGER
DATE

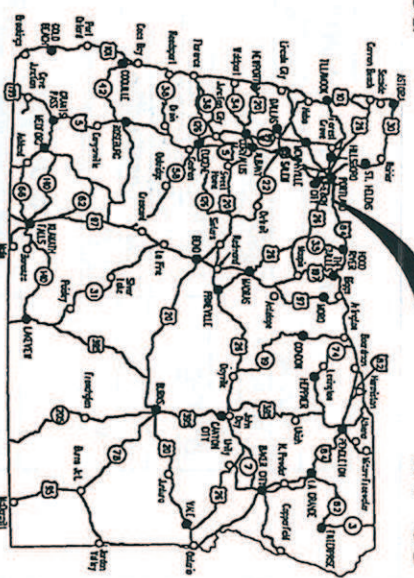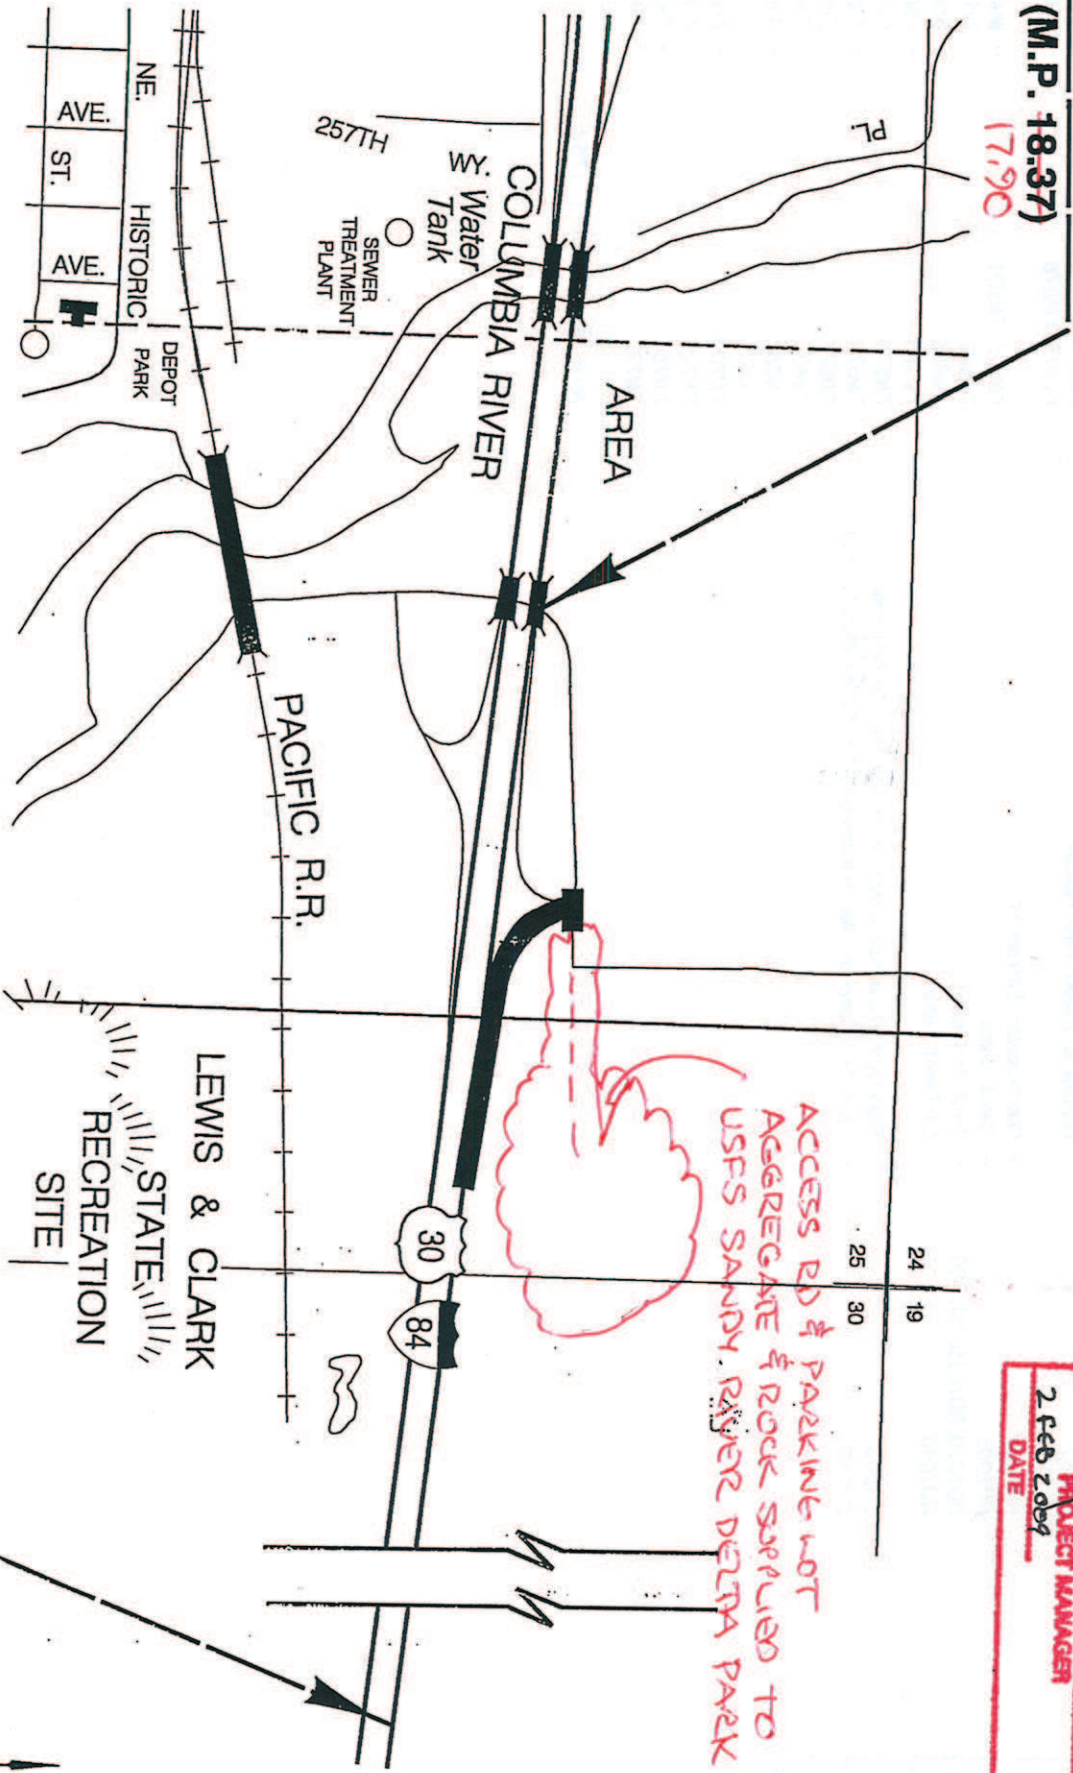

ATTENTION:
Oregon Law Requires You To Follow Rules Adopted By The Oregon Utility Notification Center. Those Rules Are Set Forth In OAR 852-001-0010 Through OAR 852-001-0090. You May Obtain Copies Of The Rules By Calling The Center. Note: The Telephone Number For The Oregon Utility Center is (503) 232-1987.

LET'S ALL
WORK TOGETHER
TO MAKE THIS
JOB SAFE

OREGON TRANSPORTATION COMMISSION
Gail Achtermon
Michael Nelson
Janice Wilson
Aron Brown
David Lohman
Matthew L. Garrett
CHAIR
VICE CHAIR
COMMISSIONER
COMMISSIONER
DIRECTOR OF TRANSPORTATION

By: *Nancy Shuck*
Signature
NANCY S. CHAMBERLAIN, P.E.
Print name and title
Shuck
Concurrence by ODOT Chief Engineer


I-84: SANDY RIVER DELTA ACCESS SEC.
COLUMBIA RIVER HIGHWAY
MULTNOMAH COUNTY

FEDERAL HIGHWAY ADMINISTRATION	PROJECT NUMBER	SHEET NO.
OREGON DIVISION	X-PLH-S002(094)	1

END OF PROJECT **X-PLH-S002(094)**
(M.P. 19.40)

T. I. N., R. 3 E., W. M.

PE001407 - 000

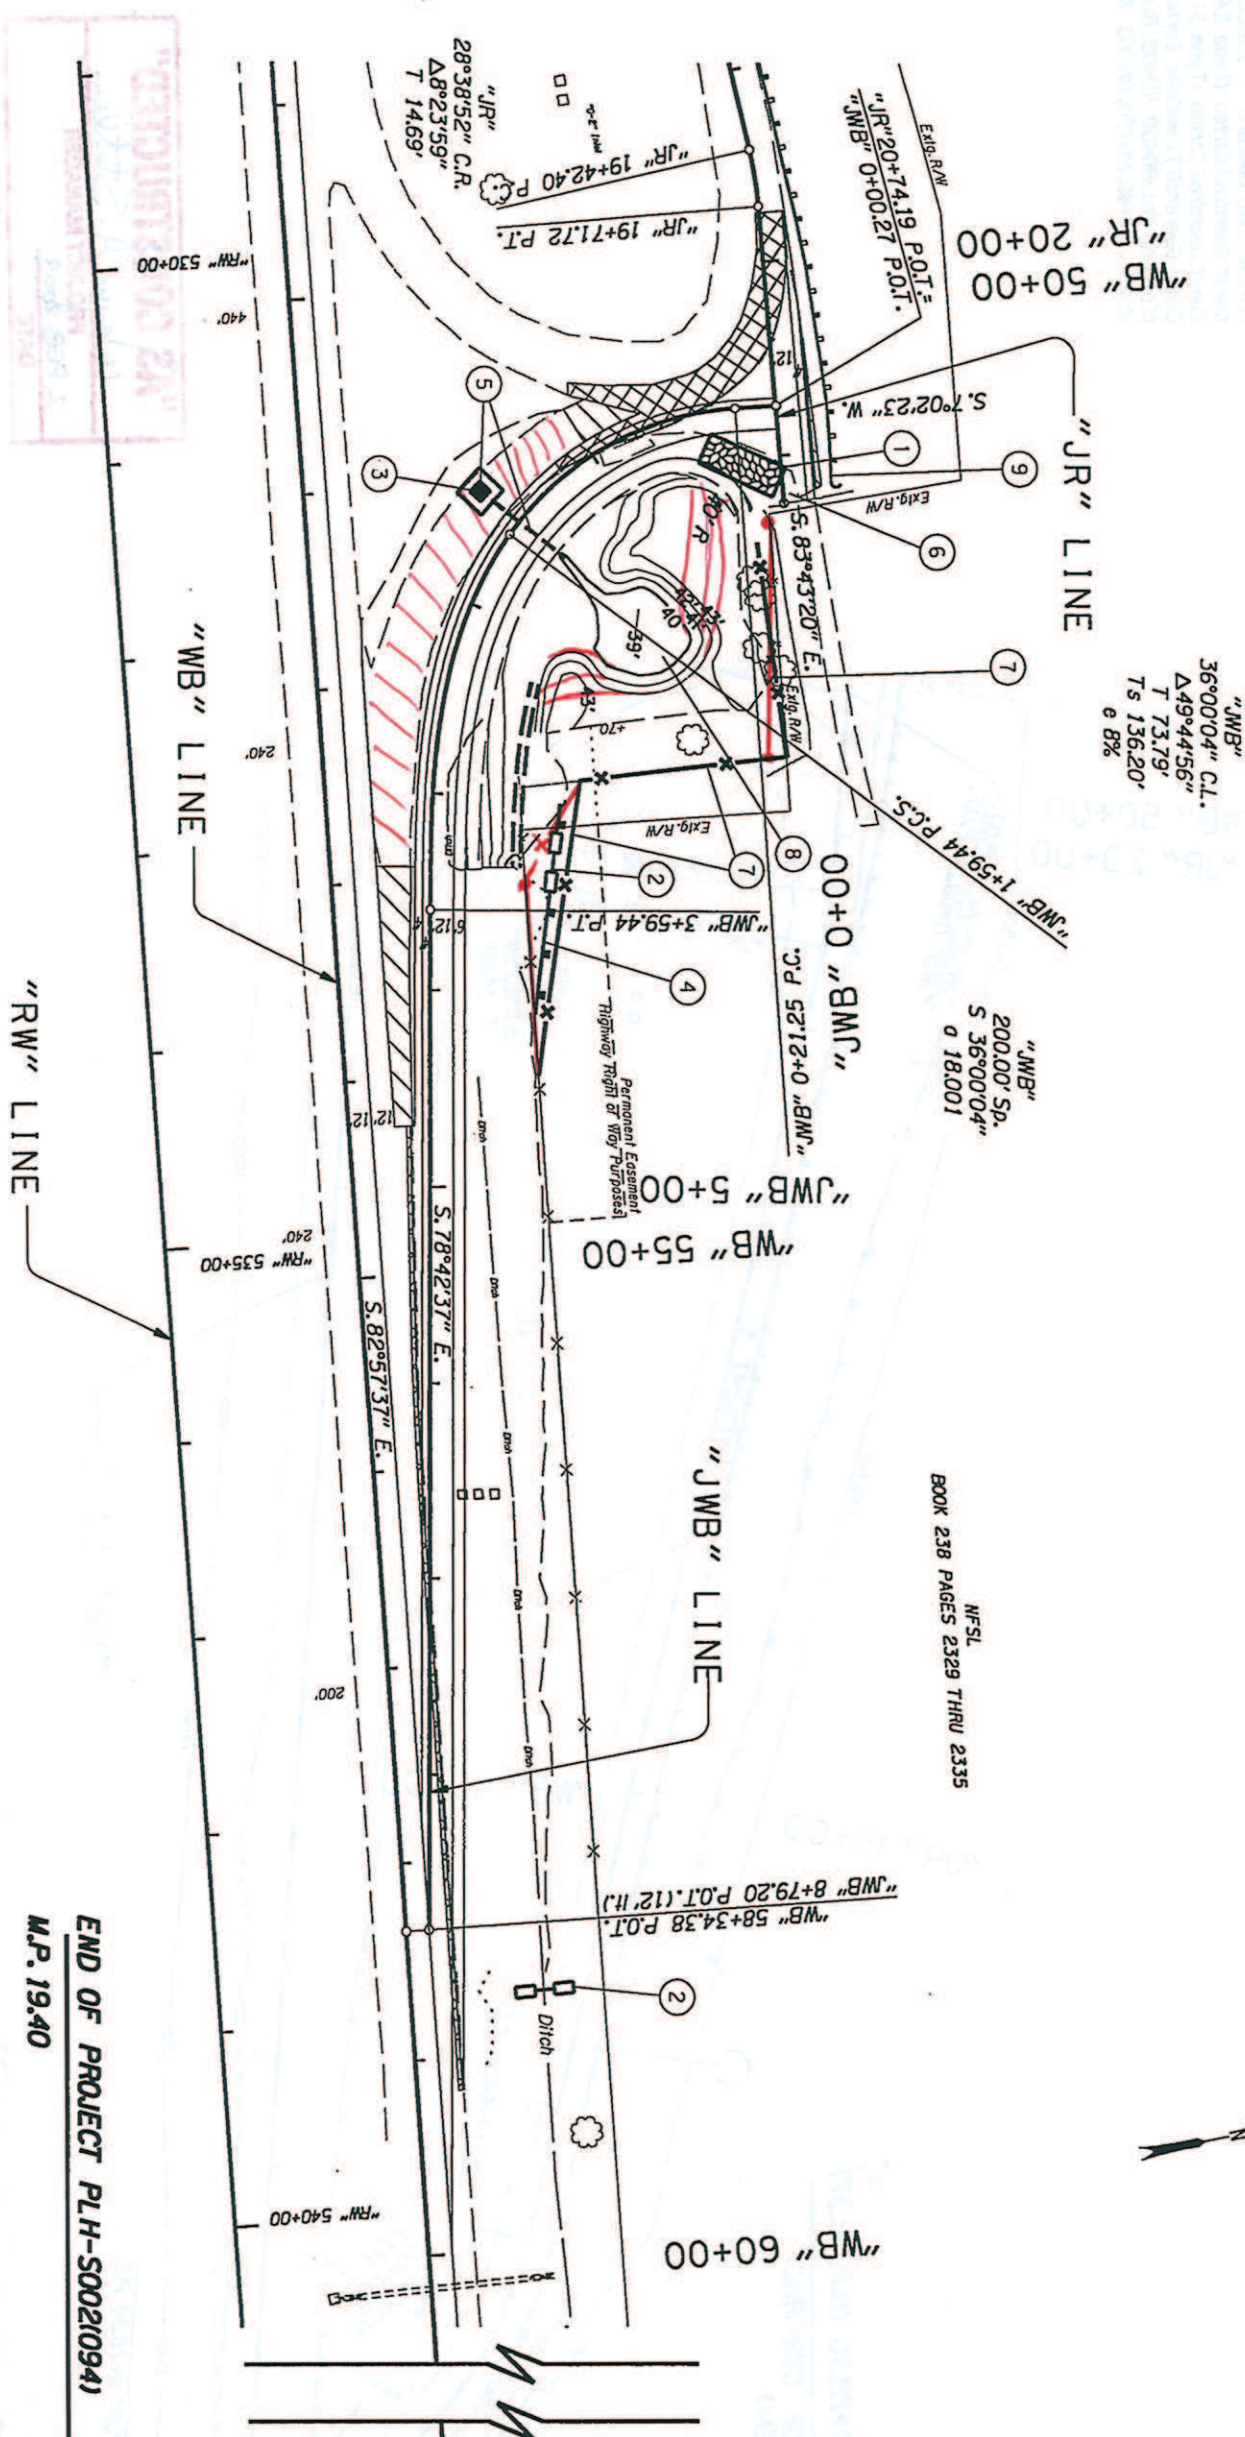

"WB" 36°00'04" C.L.
 Δ49°44'56"
 T 73.79'
 Ts 136.20'
 e 8%

"JWB" 200.00' SR.
 S 36°00'04"
 Δ 18.001

NFSL
 BOOK 238 PAGES 2329 THRU 2335



- ① Const. Construction Entrance
(See Drg. No. RD1000)
- ② Const. Check Dam - 2
(See Drg. No. RD1005)
- ③ Const. Inlet Protection
(See Drg. No. RD1010)
- ④ Const. Sediment Fence
Unsupported
(See Drg. No. RD1040)
- ⑤ Sta. "JWB" 1+52.04, 25.3' RI.
Const. Type "G-2MA" Inlet
w/ 2' Sump
Inst. 12" Ductile Iron Pipe - 56'
Grate El. 41.9'
5' Depth
Flow Line El. In - 40.25'
Flow Line El. Out - 39.25'
Outlet Slope End 1:4
(See Drg. RD300, RD316 &
RD364)
- ⑥ Const. Asphalt Approach
1-4W CCO #12
- ⑦ Const. Type 2 Fence
(See Drg. No. RD810) SEE NOTE *
- ⑧ Exc. And Grade Detention Pond And
Planting Area Per Finish Grade
Contours Shown And As Directed
Excavation Quantity Includes Exc.
1' Below Finish Grade - 1270 CY
(contaminated material)
(If or Planting Details See GN, GN-2,
GN-3, GN-4 & GN-5)
- ⑨ See Sh. 3, Note 1
Const. Guardrail (Type 2A)
Const. Anchor (Type 1 Mod.)
Const. Type B End Piece

"AS CONSTRUCTED"
 Wayne A. Stetler
 PROJECT MANAGER
 2 Feb 2009
 DATE

SEE THE DATES FENCING
 * PROJECT SHRT 2, REV 1 10-6-08
 ADDED

GENERAL NOTES:

The construction, adjustment, maintenance, and upgrading of these Erosion Control measures is the responsibility of the contractor for the duration of the project.

Erosion Control measures shown on this plan are for anticipated site conditions. Adjust or upgrade these measures for unexpected storm events to ensure that sediment and sediment-laden water does not leave the site.

Develop a revised plan of the Erosion Control measures shown as required by Section 00280, Oregon Standard Specifications for Construction. Implement this plan for all clearing and grading activities and in segments applicable to each staging phase. Construct in such a manner so as to ensure that sediment and sediment-laden water does not enter the roadway or drainage system, or violate applicable water standards.

Install measures within the right-of-way unless directed otherwise.

Install stabilized construction entrances at the beginning of construction and maintain for the duration of the project.

Additional measures may be required to insure that all paved areas are kept clean.

Construct sediment fence 1.5 meters (5 feet) downslope from the toe of fill slopes where sediment-laden water has a potential of entering waterways or leaving the R/W.


Protect all inlets during surface grinding, paving, and earthwork operations to prevent pollutants from entering storm water systems.

Graphic symbols are approximate. Place Erosion Control measures as required or directed.

LEGEND

- Fill slope
- Cut slope
- Inlet Protection
- Sediment Fence, Unsupported
- Check Dam
- ▨ Construction Entrance
- ▧ Remove Exlg. Surfacing Shown Thus:
3" Cold Plane Pavement Removal
and 3" HMA Replacement

END OF PROJECT PLH-S00210941
 M.P. 19.40

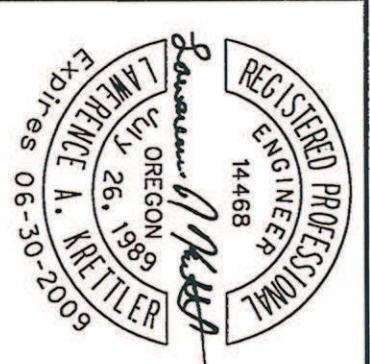


OREGON DEPARTMENT OF TRANSPORTATION

REGION 1 - ROADWAY ENGINEERING SECTION
 1-84 SANDY RIVER DELTA ACCESS SEC.
 COLUMBIA RIVER HIGHWAY
 MULTNOMAH COUNTY

GENERAL CONSTRUCTION


Project Leader - Adam Morkell
 Designed By - Sharon Bell
 Drafted By - Sharon Bell

SHEET NO. 4

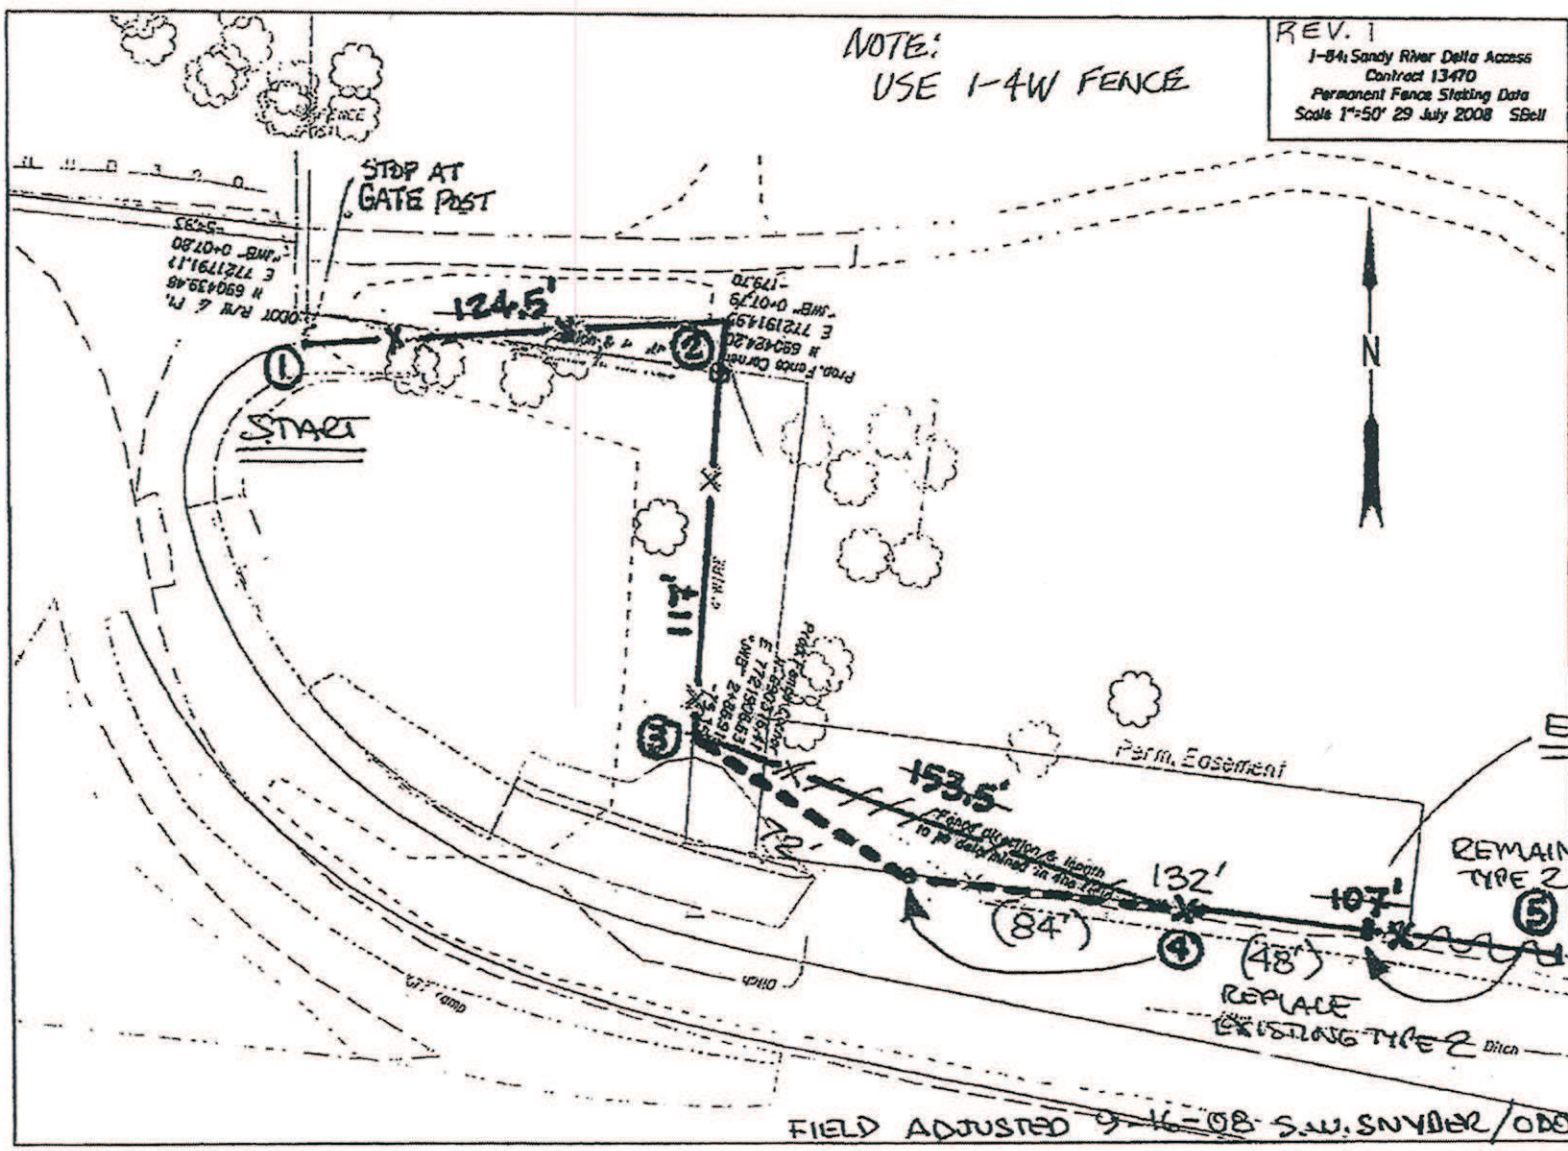

REV. 1
 1-84 Sandy River Delta Access
 Contract 13470
 Permanent Fence Stationing Data
 Scale 1"=50' 29 July 2008 SSB


Page 1 of 2 Pages
 ATTACHMENT A
 Price Agreement # C/C-12
 OSHD Contract # 17470

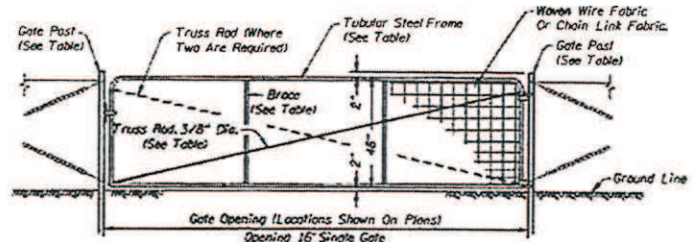

GATE COMPONENTS (1)				GATE POSTS (2)	
GATE OPENING (ft)	TUBULAR FRAME NOM. DIA. (in)	MIN. WT. lb/ft	BRACES NUMBER	TRUSS RODS NOM. DIA. (in)	TUBULAR NOM. DIA. (in)
16	1-1/2	2.22	2	1-1/4	6


- 1. Gates Shall Be Untreated (Non-Galvanized) Steel, Non-Painted.
- 2. Gate Posts On Each Side Of A Gate Opening To Be The Same Size And Are Untreated (Non-Galvanized) Steel, Non-Painted.

FENCE GATES

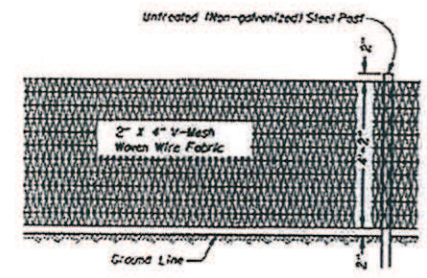

4' V-MESH WIRE FENCE


Page 2 of 2 Pages
 ATTACHMENT A
 Price Agreement # C/C-12
 OSHD Contract # 17470

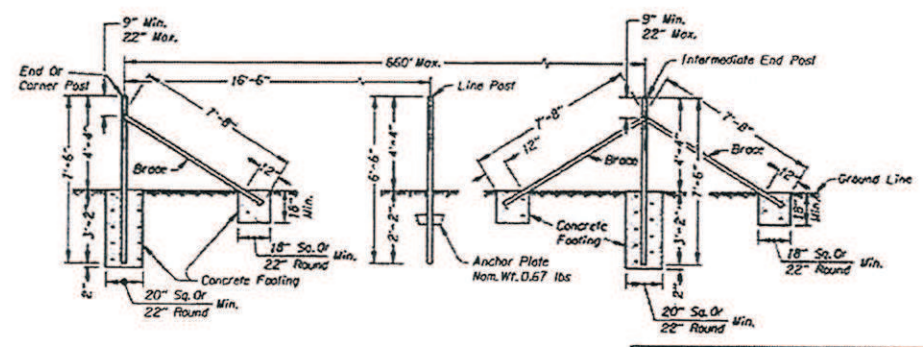

- NOTES:
1. For Line Post Spacing Use 16'-6" Dimension.
 2. For Shapes, Weights And Size Of Members, See Metal Fence Member Table.
 3. Posts And Braces Shall Be Untreated (Non-galvanized) Steel, Non-Painted.

METAL POSTS

METAL FENCE MEMBER			
MEMBER	SHAPE	MASS PER FOOT Nominal	SIZE Spacing
Line Post	Tee Channel or U-bar	1.33 lb.	ASTM A-702
Brace or Brace Rail	Tubular or Angle	3.18 lb.	Approx. 1 1/2" O.D. 2" x 2" x 1/4"
Other Post	Tubular or Angle	4.10 lb.	2 1/2" x 2 1/2" x 1/4"

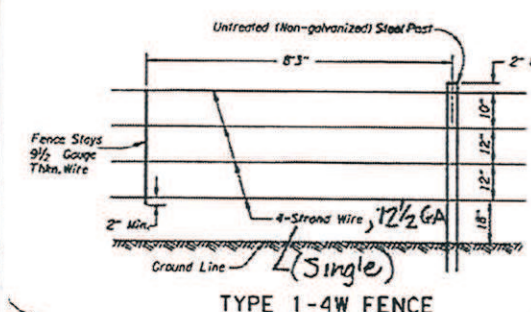

TYPE 1-4W FENCE

REGISTERED PROFESSIONAL ENGINEER
 52.835
 OREGON
 JULY 15, 2003
 FLOYD A. HARRINGTON
 RENEWAL DATE: 6-30-2007

OREGON DEPARTMENT OF TRANSPORTATION
 REGION 1 - ROADWAY ENGINEERING SECTION
 1-84: SANDY RIVER - THE DALLES (FENCING) PROJECT
 COLUMBIA RIVER HIGHWAY
 MULTNOMAH, HOOD RIVER & WASCOCO COUNTIES
 Project Leader - Sandy Van Bommel
 Designed By - Dawnel Vymozec
 Drafted By - David Moore
 DETAILS
 SHEET 2


"AS CONSTRUCTED"
 MAJOR PROJECT MANAGER
 WALTER J. STEFFEN
 2 FEB 2009
 DATE

C13470
 CCO #12

4B

EXTENT OF PETROLEUM CONTAMINATED SOIL

41V-65

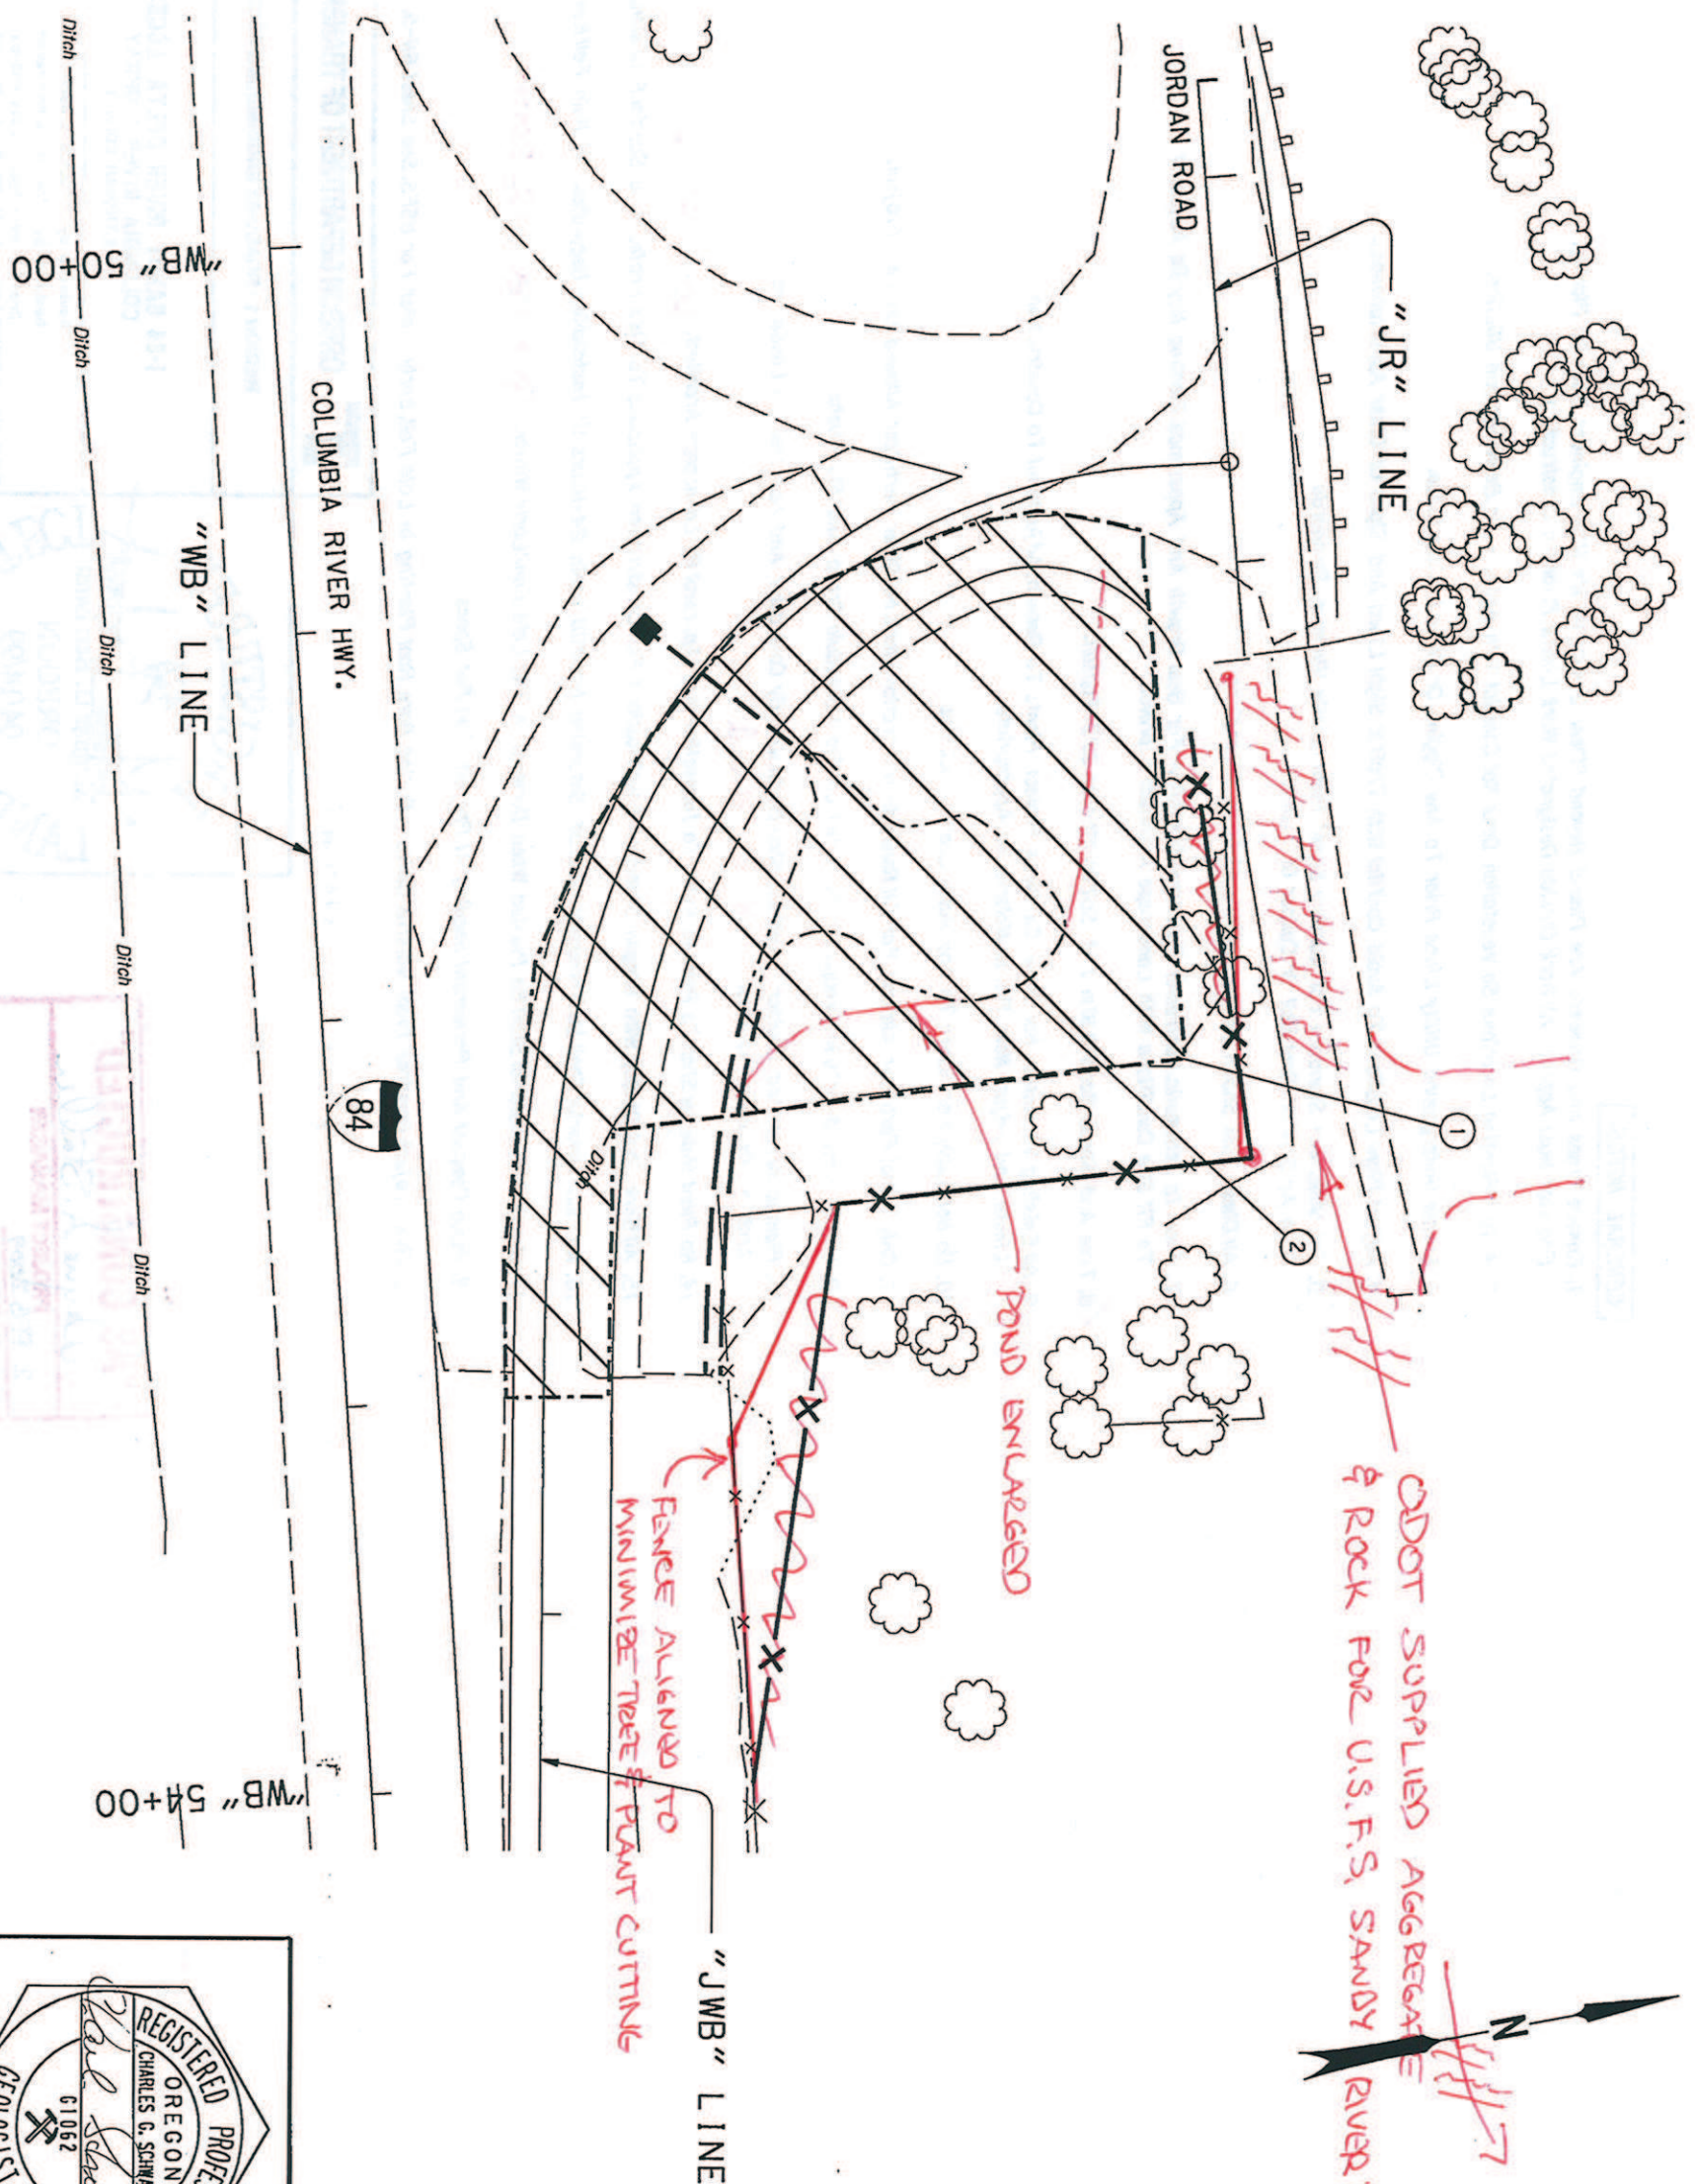

7-1-2008 SCHWARZ TO NEEL
PRF 0853

- ① Soil within the area shown is contaminated with heavy oil. To the extent possible, all soil excavated within that area shall be re-used on the project as either embankment material or for berms. Wherever it is re-used, contaminated soil must be covered with a layer of clean soil at least 12" thick.
- ② Following excavation of this detention pond, soil samples must be collected for heavy oil analysis prior to placement of clean fill. Those samples will be collected by ODOT.

"AS CONSTRUCTED"
Lawrence A. Steffen
PROJECT MANAGER
2 FEB 2009
DATE



RENEWAL DATE: 05-31-2008

OREGON DEPARTMENT OF TRANSPORTATION

REGION 1 - GEO/HYDRO UNIT

1-84 SANDY RIVER DELTA ACCESS SEC.
COLUMBIA RIVER HIGHWAY
MULTNOMAH COUNTY

Reviewed By - Paul Wittbrodt
Designed By - Charles Schwarz
Drafted By - Charlotte Gerken

PCS LOCATION PLAN

SHEET NO. GL

Preliminary Plant Schedule

SYMBOL	QTY.	SIZE	SPACING	SCIENTIFIC NAMES	COMMON NAMES	REMARKS
	17	1" Colip.	As Shown	Crotaegus douglasii	Black Hawthorne	
	17	1" Colip.	As Shown	Fraxinus latifolia	Oregon Ash	
	18	1" Colip.	As Shown	Populus trichocarpa	Black Cottonwood	

Proposed Boulders 2.5'-4' above grade - outside designated clearzone with 000T engineer approval. Coordinate installation and placement with Landscape Architect.


Shrubs

SYMBOL	S.F.	SIZE	SPACING	QTY.	SCIENTIFIC NAMES	COMMON NAMES	PERCENT OF MIX
	5400	Bare Root 18"-24"	4' O.C.	44	Amelanchier alnifolia	Serviceberry	10%
				66	Ribes sanguineum	Red-Flowering Currant	15%
				10	Rosa nutkana	Nootka Rose	25%
				110	Salix scouleriana	Scouler's Willow	25%
				110	Symphoricarpos albus	Snowberry	25%
				61	Cornus sericea	Red-Twig Dogwood	30%
				41	Sambucus caerulea	Blue Elderberry	20%
				61	Salix lucida	Columbia Willow	30%
				41	Spiraea douglasii	Douglas Spiraea	20%
				88	Melonia nervosa	Compact Barberry	20%
				132	Rosa nutkana	Nootka Rose	30%
				88	Spiraea douglasii	Douglas Spiraea	20%
				132	Symphoricarpos albus	Snowberry	30%
				132	Elymus glaucus	Blue Wildrye	40% PLS
				132	Bromus cornutus	California Brome	40% PLS
				132	Festuca rubra var. rubra	Native Red Fescue	15% PLS
				132	Deschampsia cespitosa	Tufted Hairgrass	5% PLS


"AS CONSTRUCTED"
Walter J. Steffen
 PROJECT MANAGER
 2 Feb 2009
 DATE

Key Notes

- Apply seed according to Special Detail 5 with Seed Mix No. 1. Prepare seed bed according to Method C under Section 01040.4B.
- Shrub Mix A plant quantity per plan and schedule. **PLANTED DEC 2008**
- Shrub Mix B plant quantity per plan and schedule. **PLANTED DEC 2008**
- Shrub Mix C plant quantity per plan and schedule. **PLANTED DEC 2008**
- Prepare soil for shrub mix according to Method A.
- 2" Compost Blanket (No Seed) per Detail 6.
- 12" Imported Topsoil Depth
- 6" Imported Topsoil Depth
- Boulders Max. Spacing 10' O.C. apart and outside the "Clear Zone."
- Existing trees to remain, **FENCE ADJUSTED**
- Apply Seed Mix No. 1 per detail 7 between Nov. 30 - Mar. 15. **NOT APPLIED AS OF FEB 1 2009 PER WAUKUS**
- Gravel Shoulder.

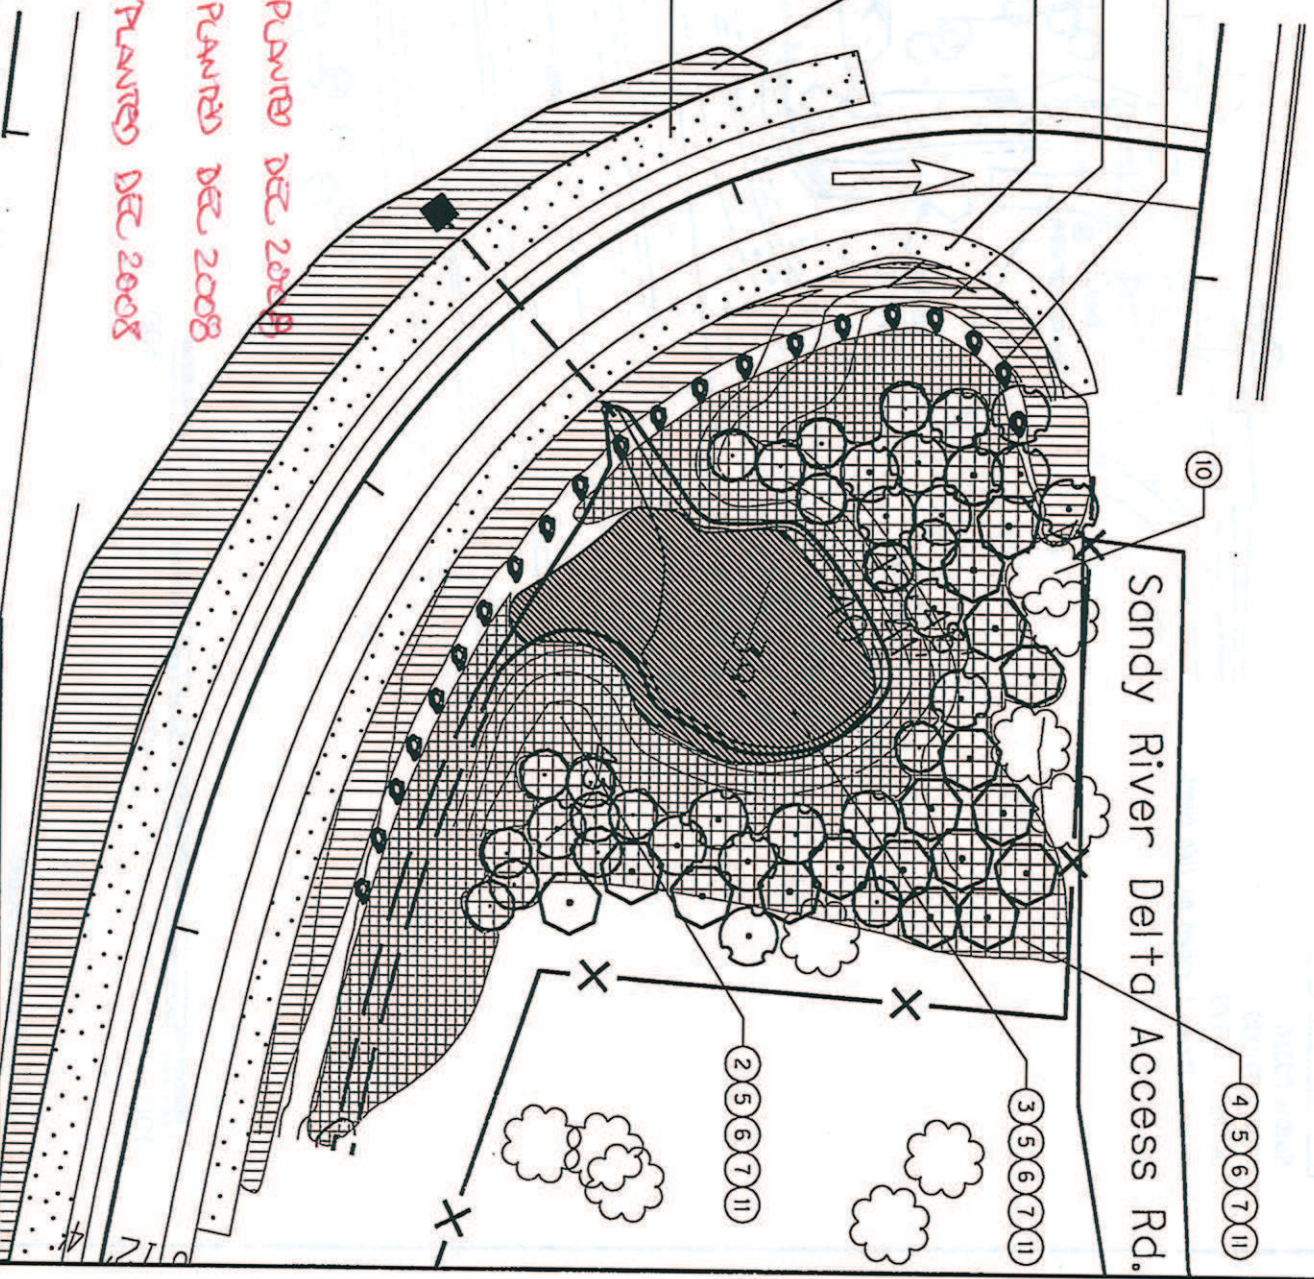

Planting and Irrigation Note:
 1. Planting will require hand watering via water truck and additional "water bound" irrigation supplement.
 2. The first year of establishment.
 3. Shrub species to be planted in massings of 5-12 min.
 4. Planted species to be planted in massings of 5-12 min.
 5. Planted species to be planted in massings of 5-12 min.
 6. Planted species to be planted in massings of 5-12 min.
 7. Planted species to be planted in massings of 5-12 min.
 8. Planted species to be planted in massings of 5-12 min.
 9. Planted species to be planted in massings of 5-12 min.
 10. Planted species to be planted in massings of 5-12 min.
 11. Planted species to be planted in massings of 5-12 min.
 12. Planted species to be planted in massings of 5-12 min.

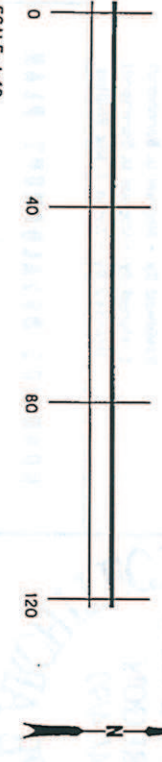

* SEE GN-5, SHOWS AREAS NOT COVERED BY COMPACT DWES.



OREGON DEPARTMENT OF TRANSPORTATION
 REGION 1 - ROADWAY ENGINEERING SECTION

1-84: SANDY RIVER DELTA ACCESS
 COLUMBIA RIVER HIGHWAY
 MULTNOMAH COUNTY

Reviewed By - Magnus U. Bernhardt
 Designed By - Magnus U. Bernhardt
 Drafted By - Zyoia T. Mik Phillips


ROADSIDE DEVELOPMENT PLAN

SHEET NO. GN-4

ROADSIDE RESTORATION WEED REMOVAL PLAN

GENERAL NOTES:

Section 00320
Section 001030
Section 01040,75
Apply to the work shown on this sheet.

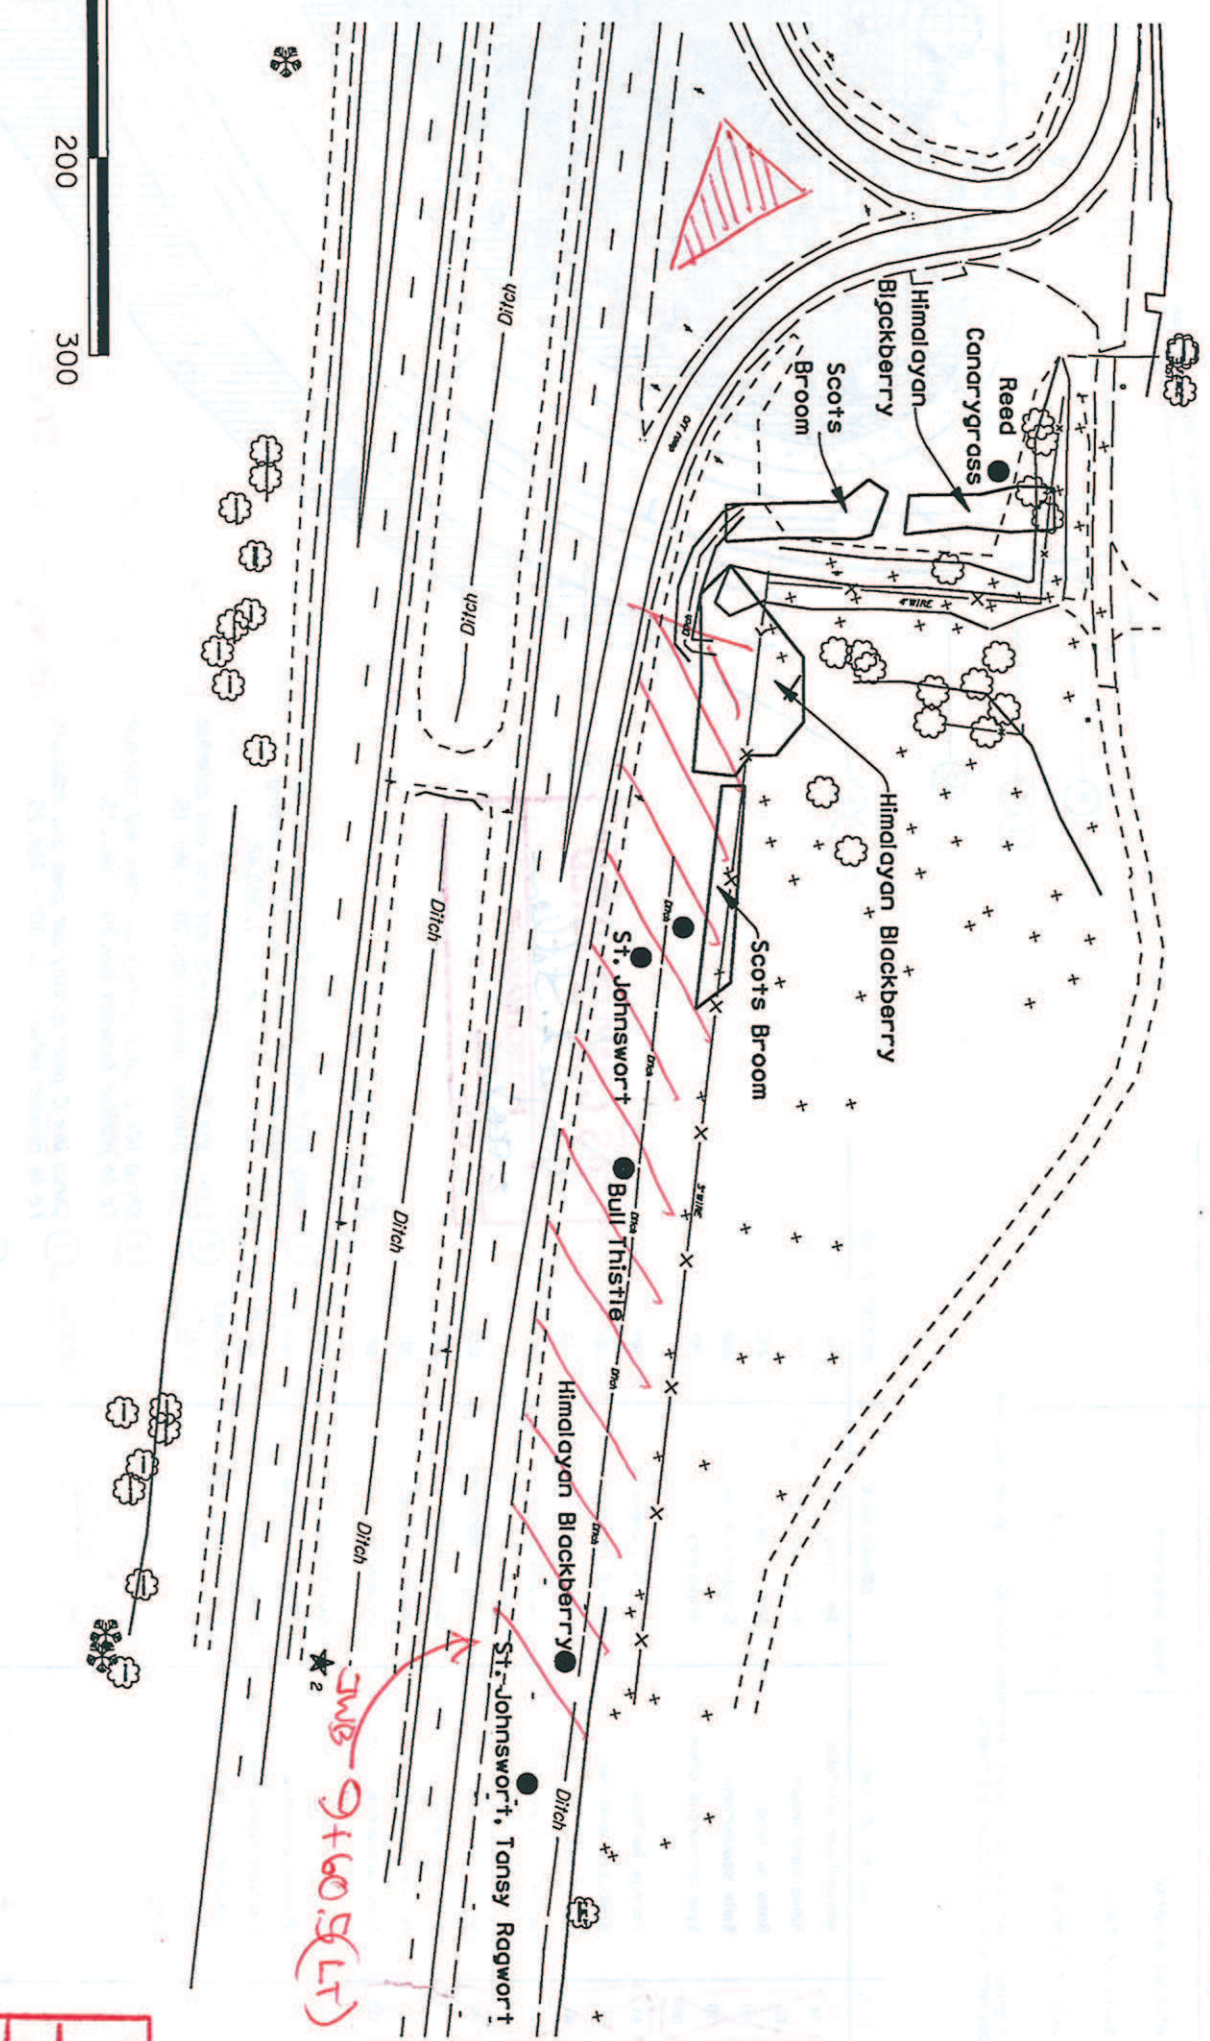

"AS CONSTRUCTED"
Magne U. Bernhardt
PROJECT MANAGER
2 FEB 2009
DATE

OREGON DEPARTMENT OF TRANSPORTATION
REGION 1 - ROADWAY ENGINEERING SECTION

1-84 SANDY RIVER DELTA ACCESS
COLUMBIA RIVER HIGHWAY
MULTNOMAH COUNTY
Reviewed By - Magne U. Bernhardt
Designed By - Magne U. Bernhardt
Drafted By - Zvole T. Mix Phillips

ROADSIDE DEVELOPMENT PLAN
SHEET NO. CN-5

LEGEND

ADDITIONAL AREAS COVERED WITH TOPSOIL MULCH & SEED (COMPOST)

USFS Plant Schedule

Quantity	Size	Spacing	Scientific Name	Common Name	Remarks
10	1 Gallon	2' O.C.	Carex obnupta	Slough Sedge	Plant in groups of 3-5
5	1 Gallon	3' O.C.	Rosa nootkana	Nootka Rose	Plant in groups of 2-3
5	1 Gallon	3' O.C.	Rosda pisocarpa	Swamp Rose	Plant in groups of 2-3
10	1 Gallon	2' O.C.	Scirpus microcarpus	Small-fruited Bulrush	Plant in groups of 3-5
3	3 Gallon	10' O.C.	Crataegus douglasii	Black Hawthorne	

Important Note: Deliver Plants to ODOT Troutdale Sign Shop During Bare Root planting in late Fall early Winter (Contact David Smith 503.666.9391) at 620 West Columbia, Troutdale, OR 97060.
Notify Robin Dobson, USFS at 541.308.1717 upon delivery to Sign Shop **DELIVERED BY SNYDER TO DOBSON 12-4-08**
PLANTS PLACED INSIDE SANDY RIVER DELTA PARK

REGISTERED
424
Magne U. Bernhardt
OREGON
04/14/99
LANDSCAPE ARCHITECT