

OPERATION & MAINTENANCE MANUAL

DFI No. : D00351

**Facility Type: Water Quality Biofiltration
Swale**



September, 2011

1. Identification

Drainage Facility ID (DFI): **D00351**

Facility Type: Water Quality Biofiltration Swale

Construction Drawings: (V-File Number) 42V-004

Location: District: 2C

Highway No.: 002

Mile Post: 38.81 / 38.83 (beg./end)]

Description: This facility is located in the median between the east and westbound lanes of I-84 (Hwy 002), approximately two miles west of the Bonneville Dam. Access to the swale may be obtained from the eastbound lanes of I-84.

2. Facility Contact Information

Contact the Engineer of Record, Region Technical Center, or Geo-Environmental's Senior Hydraulics Engineer for:

- Operational clarification
- Maintenance clarification
- Repair or restoration assistance

Engineering Contacts:

Region Technical Center Hydro Unit Manager

Or

Geo-Environmental Senior Hydraulics Engineer (503) 986-3365.

3. Construction

Engineer of Record: Consultant Designer – Parsons Brinckerhoff, Inc.,
Constance Kratovil, P.E., 503-274-8772

Facility construction: 2009

Contractor: Cascade Bridge, LLC Construction Company.

4. Storm Drain System and Facility Overview

A water quality swale is a flat-bottomed open channel designed to treat stormwater runoff from highway pavement areas. This type of facility is lined with grass. Treatment by trapping sedimentation occurs when stormwater runoff flows through the grass.

This facility is located in the median between the east and westbound lanes of I-84 (Hwy 002), approximately two miles west of the Bonneville Dam. Access may be obtained from the eastbound lanes of I-84, and optionally from the westbound lanes where a maintenance access pad is found near an associated stormwater outfall.

A localized storm drain system conveys stormwater to the water quality facility, via an 18-inch storm pipe, and its facility inlet and flow spreader; see points A and C of the Operational Plan, Appendix A. Once in the swale the stormwater is treated as it flows in a westward direction toward the facility outlet at point B. The outlet is a grated inlet that collects any remaining treated flows and conveys them to an 18-inch storm pipe, leading to a stormwater outfall further down line to the west, and near the westbound lanes of I-84.

A. Maintenance equipment access:

Access to the swale may be obtained from the eastbound lanes of I-84. The shoulder width may be narrow and a guardrail is present here, however. Access to a stormwater outfall, associated with this facility, is obtained from the westbound lanes and a nearby maintenance access pad. However, the slope and vegetation between the outfall and the actual swale facility may make reaching the swale somewhat difficult.

B. Heavy equipment access into facility:

- Allowed (no limitations)
- Allowed (with limitations): A guardrail is present alongside the shoulder of the eastbound lanes of I-84 when accessing the swale facility.
- Not allowed

C. Special Features:

- Amended Soils
- Porous Pavers
- Liners
- Underdrains



Photo 1: Water Quality Biofiltration Swale, looking east at the facility inlet. I-84 is located to the right.



Photo 2: Water Quality Biofiltration Swale, looking west. I-84 is located to the left.



Photo 3: Water Quality Biofiltration Swale, looking west at the facility outlet. I-84 is located to the left.

5. Facility Haz Mat Spill Feature(s)

The water quality biofiltration swale can be used to store a volume of liquid by blocking either the outlet structure or the 18-inch diameter outlet pipe located at the outlet of the water quality biofiltration swale. This pipe is noted as point B on the Operational Plan; Appendix A. Use of sandbags or a metal plate may more easily facilitate this effort.

6. Auxiliary Outlet (High Flow Bypass)

Auxiliary Outlets are provided if the primary outlet control structure can not safely pass the projected high flows. Broad-crested spillway weirs and over flow risers are the two most common auxiliary outlets used in stormwater treatment facility design. The auxiliary outlet feature is either a part of the facility or an additional storm drain feature/structure.

The auxiliary outlet feature for this facility is:

Designed into facility

Other, as noted below

An auxiliary outlet feature is not designed or provided for as part of this facility.

7. Maintenance Requirements

Routine maintenance table for non-proprietary stormwater treatment and storage/detention facilities have been incorporated into ODOT's Maintenance Guide. These tables summarize the maintenance requirements for ponds, swales, filter strips, bioslopes, and detention tanks and vaults. Special maintenance requirements in addition to the routine requirements are noted below when applicable.

The ODOT Maintenance Guide can be viewed at the following website:

<http://www.oregon.gov/ODOT/HWY/OOM/MGuide.shtml>

Maintenance requirements for proprietary structures, such as underground water quality manholes and/or vaults with filter media are noted in Appendix C when applicable.

The following stormwater facility maintenance table (See ODOT Maintenance Guide) should be used to maintain the facility outlined in this Operation and Maintenance Manual or follow the Maintenance requirements outlined in Appendix C when proprietary structure is selected below:

- Table 1 (general maintenance)
- Table 2 (stormwater ponds)
- Table 3 (water quality biofiltration swales)
- Table 4 (water quality filter strips)
- Table 5 (water quality bioslopes)
- Table 6 (detention tank)
- Table 7 (detention vault)
- Appendix C (proprietary structure)
- Special Maintenance requirements:

Note: Special maintenance Requirements Require Concurrence from ODOT SR Hydraulics Engineer.

8. Waste Material Handling

Material removed from the facility is defined as waste by DEQ. Refer to the roadwaste section of the ODOT Maintenance Yard Environmental Management System (EMS) Policy and Procedures Manual for disposal options: <http://egov.oregon.gov/ODOT/HWY/OOM/EMS.shtml>



Contact any of the following for more detailed information about management of waste materials found on site:

ODOT Clean Water Unit	(503) 986-3008
ODOT Statewide Hazmat Coordinator	(503) 229-5129
ODOT Region Hazmat Coordinator	(503) 731-8290
ODEQ Northwest Region Office	(503) 229-5263


Appendix A

Content:


- **Operational Plan and Profile Drawing(s)**

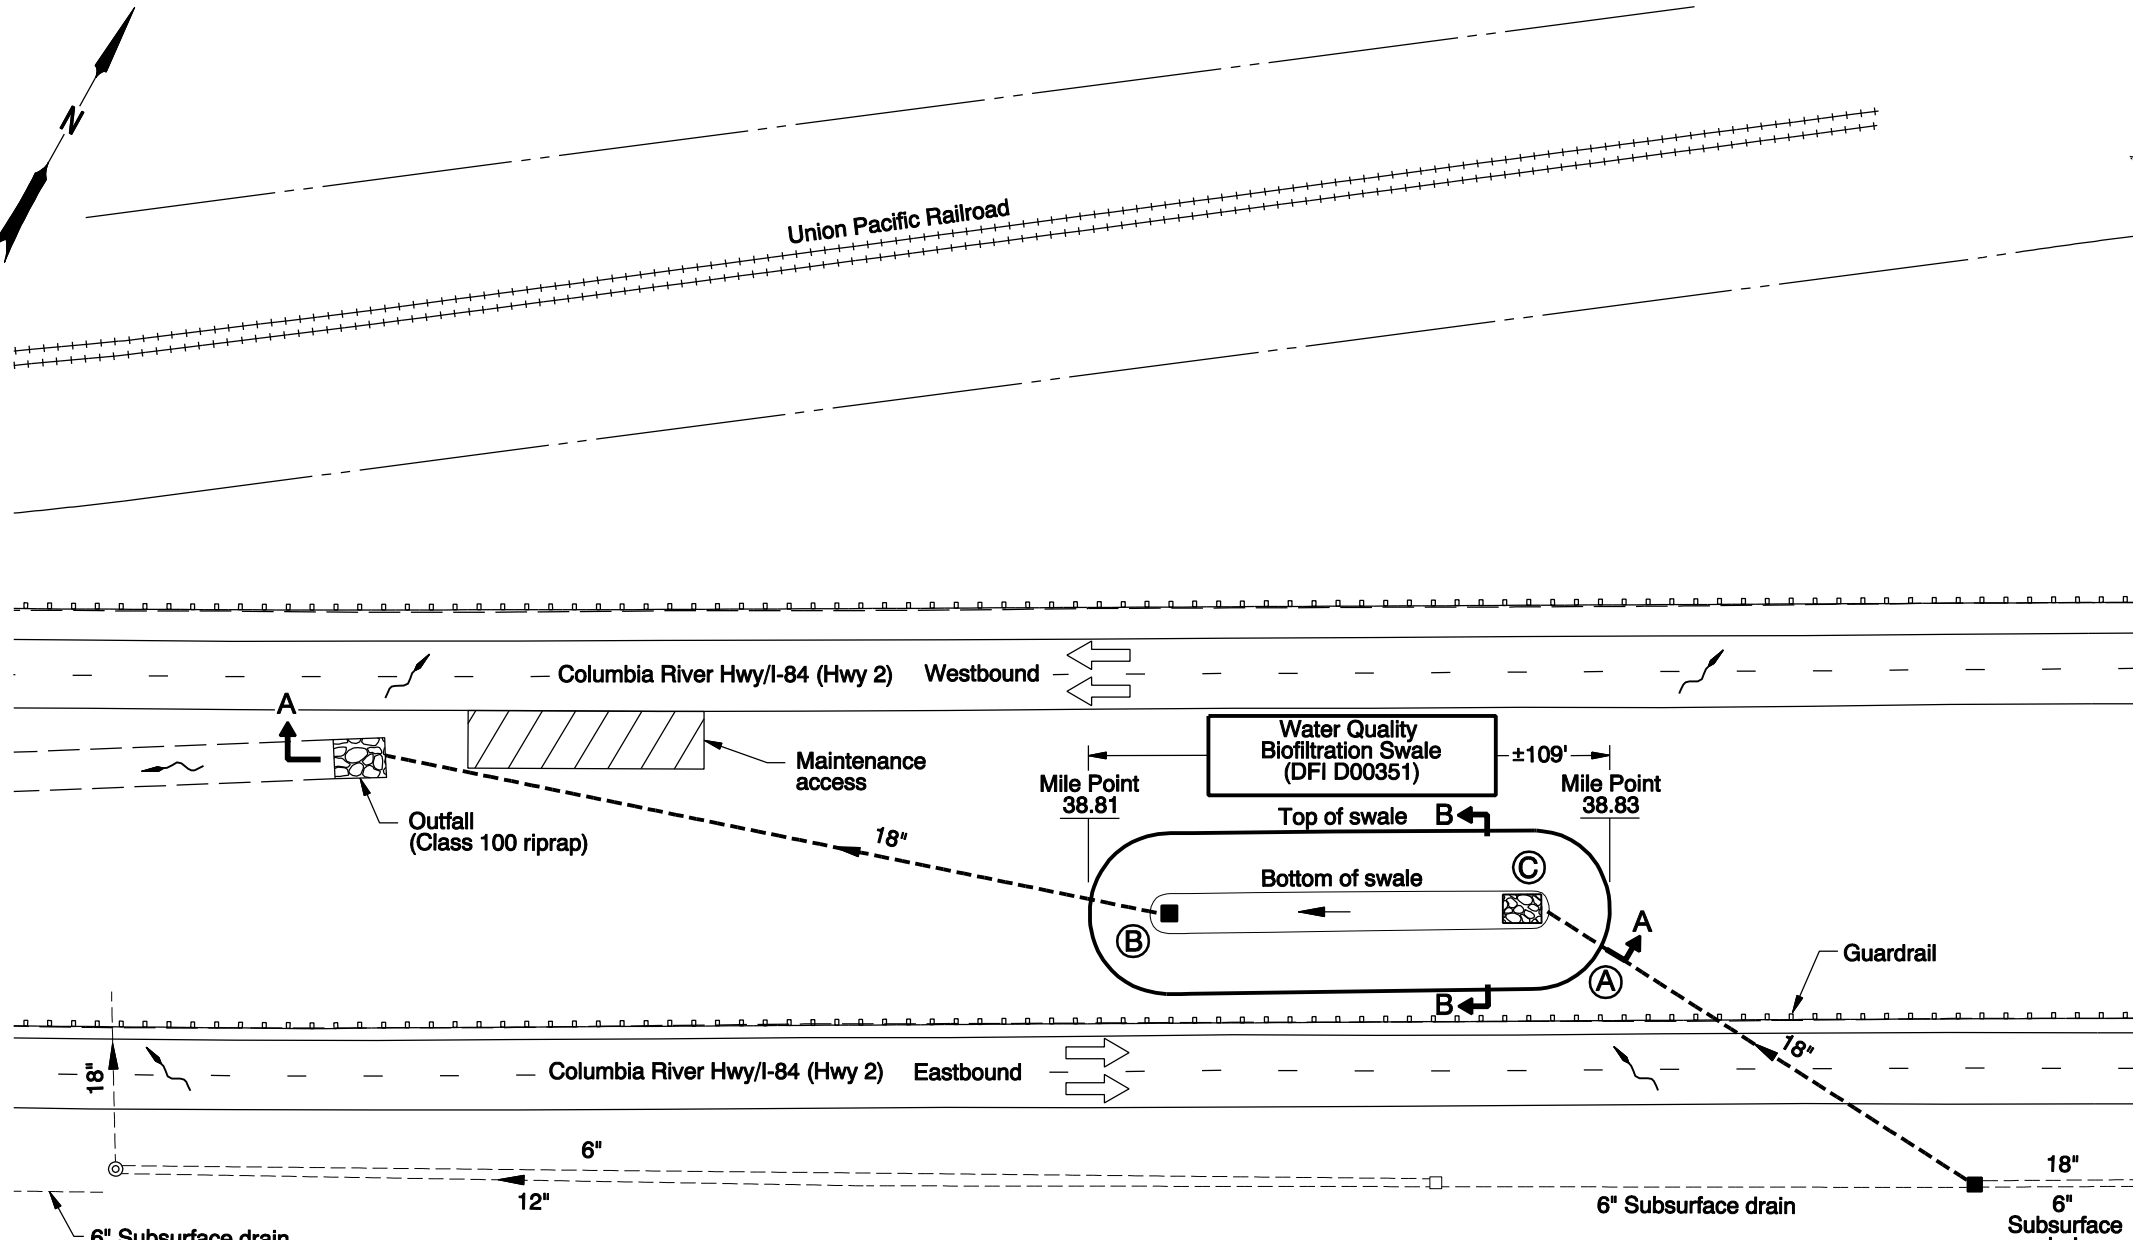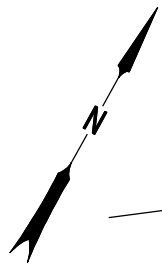

PLAN
N.T.S.

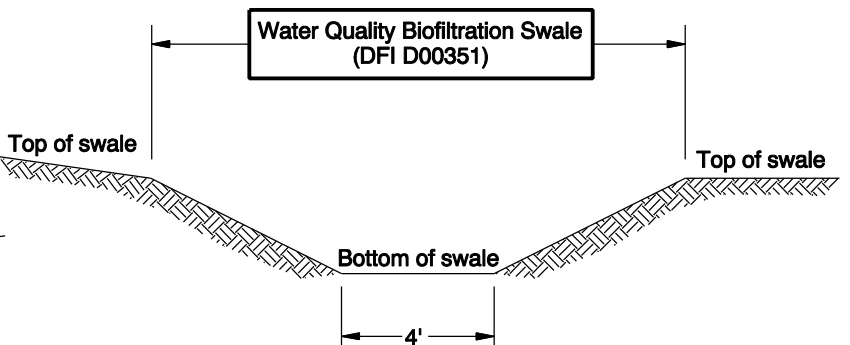

SECTION B-B
N.T.S.

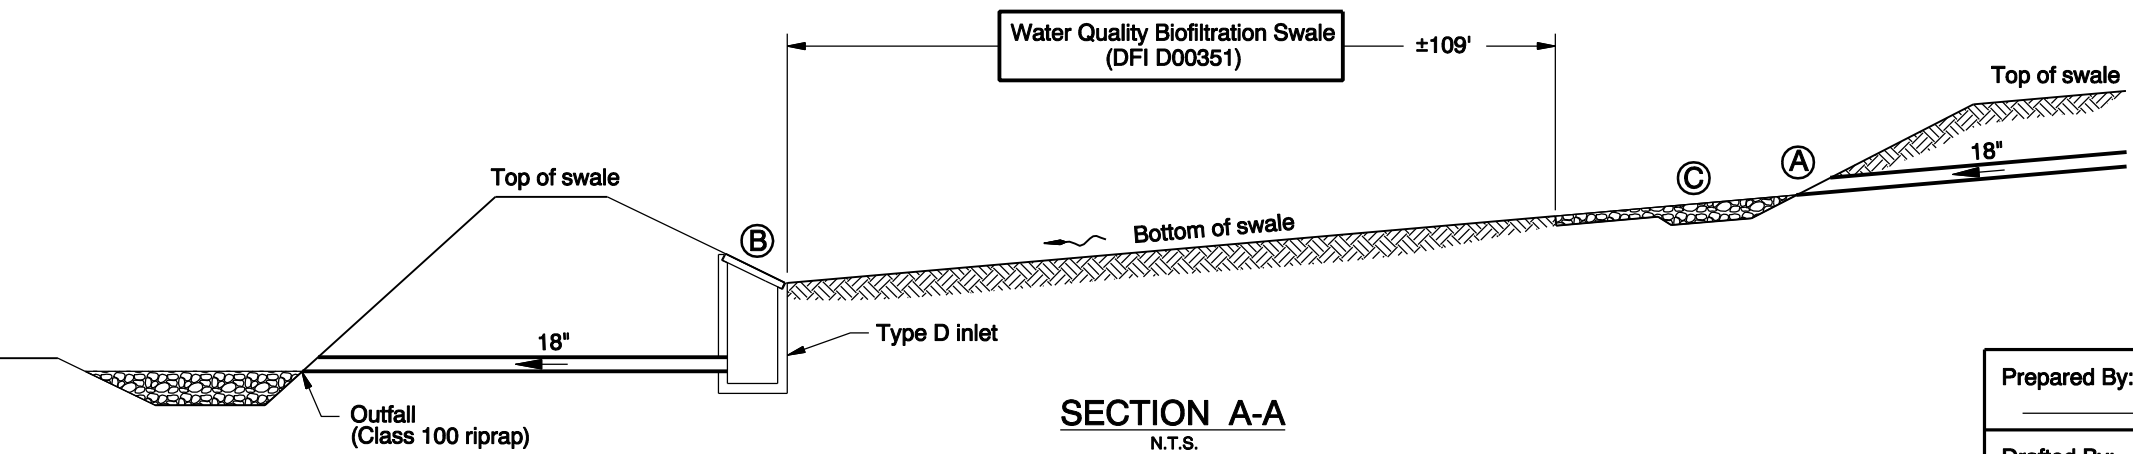

SECTION A-A
N.T.S.

- LEGEND:**
- Photo Location / Direction
 - Swale Inlet
 - Swale Outlet
 - Flow Spreader
 - Manhole
 - Inlet
 - Traffic Direction/Flow
 - Storm Pipe (Facility)
 - Storm Pipe
 - Conveyance Direction
 - Pavement / Facility Flow Path
 - Maintenance Access

Sht. 1 of 1



Prepared By: Craig Fox
 Drafted By: E. Gahan/HDR

DFI D00351
MAINTENANCE DISTRICT 2C HWY 2
WATER QUALITY BIOFILTRATION SWALE
 COLUMBIA RIVER HWY. MP 38.81-38.83
 MULTINOMAH COUNTY


Appendix B

Content:

- **ODOT Project Plan Sheets**
 - *Cover/Title Sheet*
 - *Water Quality/Detention Plan Sheets*
 - *Other Details*

INDEX OF SHEETS	
SHEET NO.	DESCRIPTION
1	Title Sheet
1A	Index Of Sheets Cont'd. & Std. Drg. Nos.

STATE OF OREGON
DEPARTMENT OF TRANSPORTATION
PLANS FOR PROPOSED PROJECT
GRADING, DRAINAGE, STRUCTURES AND PAVING
I-84: DODSON - TANNER CREEK BUNDLE 209
COLUMBIA RIVER HIGHWAY
MULTNOMAH COUNTY
MARCH 2009

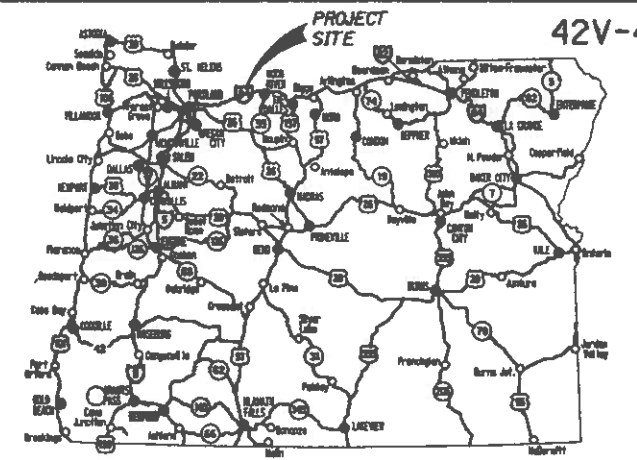


Overall Length of Project - 5.02 Mile

REVISED AS CONSTRUCTED
10/01/10 CONTRACT C13985
PROJ. MGR. Tom Marzolf

ATTENTION!
Oregon Law Requires You To Follow Rules Adopted By The Oregon Utility Notification Center. Those Rules Are Set Forth In OAR 952-001-0010 Through OAR 952-001-0090. You May Obtain Copies Of The Rules By Calling The Center. (Note The Telephone Number For The Oregon Utility Center Is (503) 232-1987.)

LET'S ALL
WORK TOGETHER
TO MAKE THIS
JOB SAFE

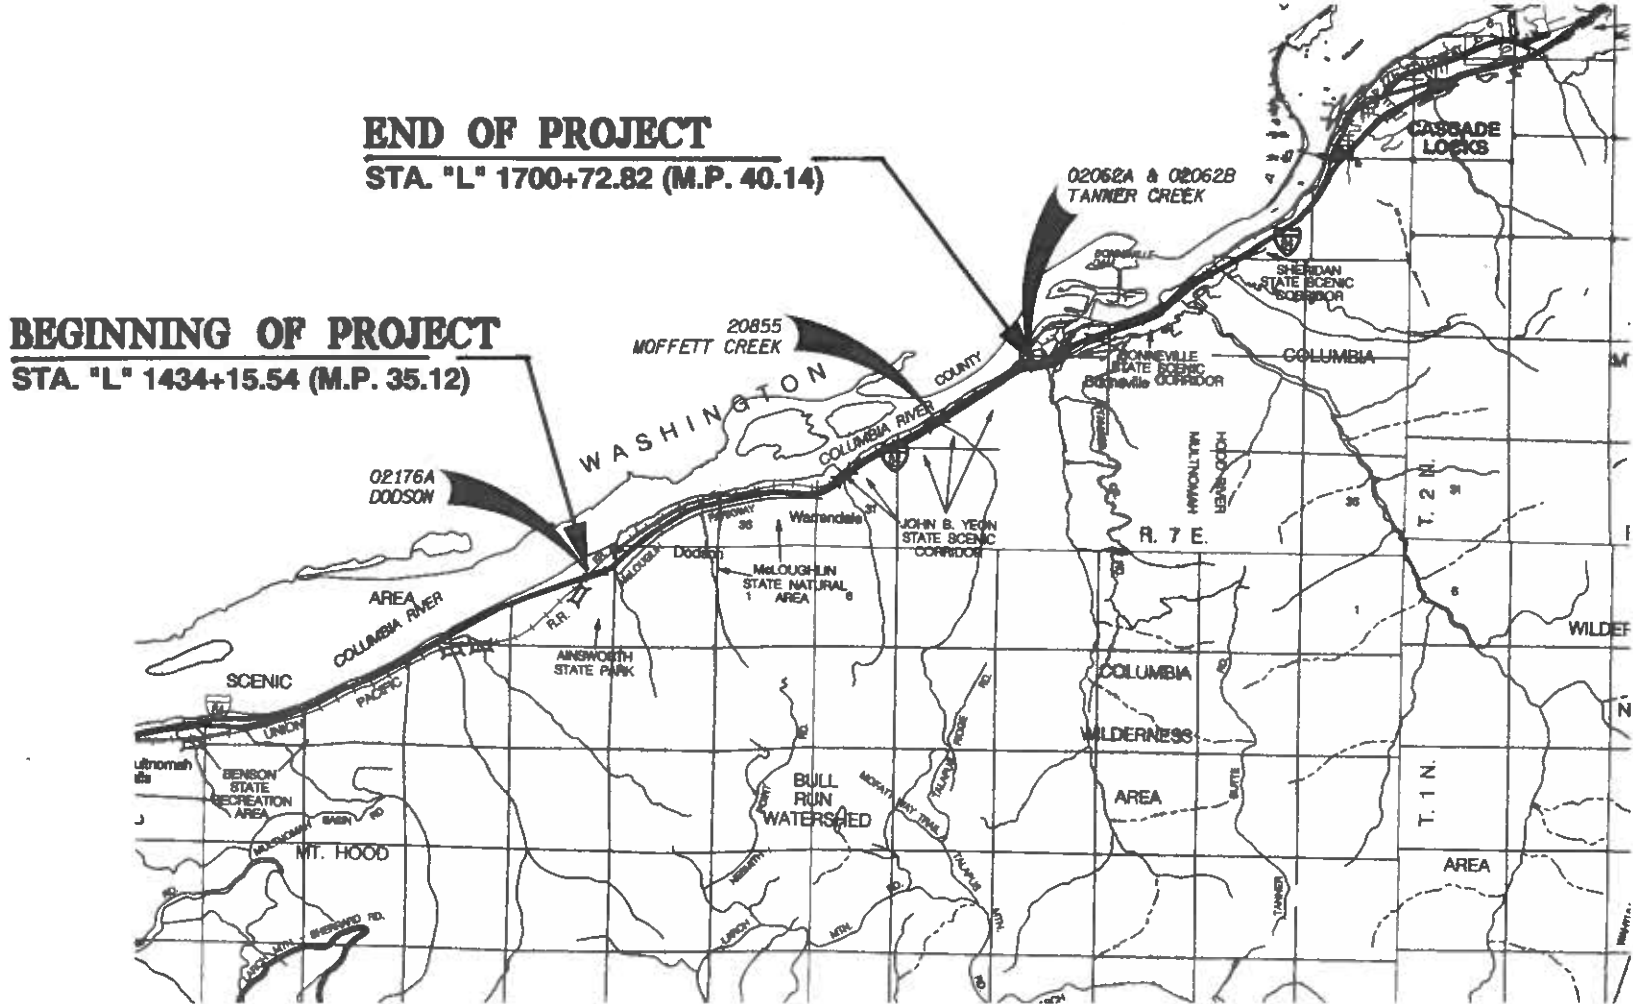

END OF PROJECT
STA. "L" 1700+72.82 (M.P. 40.14)

BEGINNING OF PROJECT
STA. "L" 1434+15.54 (M.P. 35.12)

OREGON TRANSPORTATION COMMISSION

Gail L. Achterman	CHAIR
Mike Nelson	VICE-CHAIR
Janice J. Wilson	COMMISSIONER
Alan Brown	COMMISSIONER
David Lohman	COMMISSIONER
Matthew L. Garrett	DIRECTOR OF TRANSPORTATION

PLANS PREPARED FOR ODOT BY: PB

These plans were developed using ODOT design standards. Exceptions to these standards, if any, have been submitted and approved by the ODOT Chief Engineer or their delegated authority.

By: *Laura M. Anderson*
Signature

James M. Amundson
Print name and title

Concurrence by ODOT Chief Engineer

I-84: DODSON - TANNER CREEK BUNDLE 209 COLUMBIA RIVER HIGHWAY MULTNOMAH COUNTY		
FEDERAL HIGHWAY ADMINISTRATION	PROJECT NUMBER	SHEET NO.
OREGON DIVISION	X-IM-OTIA-S002(091)	1

PB PARSONS BRINCKERHOFF
122 400 S.W. Sixth Ave, Portland, OR 97204


OTIA
OREGON TRANSPORTATION INVESTMENT ACT

TABLE A

WETLAND PLANTS, PLUGS - BOTTOM GROUND LAYER PLANTS				
SCIENTIFIC NAME	COMMON NAME	SIZE AND DESCRIPTION	DENSITY	QUANTITY
<i>Carex Densa</i>	Dense Sedge	Plugs	2/sq.ft.	984
<i>Eleocharis Palustris</i>	Creeping Spikerush	Plugs	2/sq.ft.	984
<i>Juncus Tenuis</i>	Poverty Rush	Plugs	2/sq.ft.	984
<i>Mimulus Guttatus</i>	Yellow Monkeyflower	Plugs	2/sq.ft.	984

TABLE B


WATER QUALITY SEEDING - SIDE SLOPE GROUND LAYER PLANTS				
SCIENTIFIC NAME	COMMON NAME	PLS (lb/acre)	(% PURITY x % GERMINATION) (minimum)	AMOUNT (minimum) Aplic. rate(lb/acre)
<i>Deschampsia caespitosa</i>	HairGrass	.27		
<i>Bromus carinatus</i>	California Brome	4.75		
<i>Elymus glaucus</i>	Blue Wildrye	2.55		
<i>Festuca rubra</i>	Red Fescue	.65		
<i>Sitanion hystrix</i>	Squirrel-tail	2.10		
<i>Glyceria occidentalis</i>	Mannagrass	.65		
<i>Agrostis exarata</i>	Spikegrass	.02		
Total		11.00		

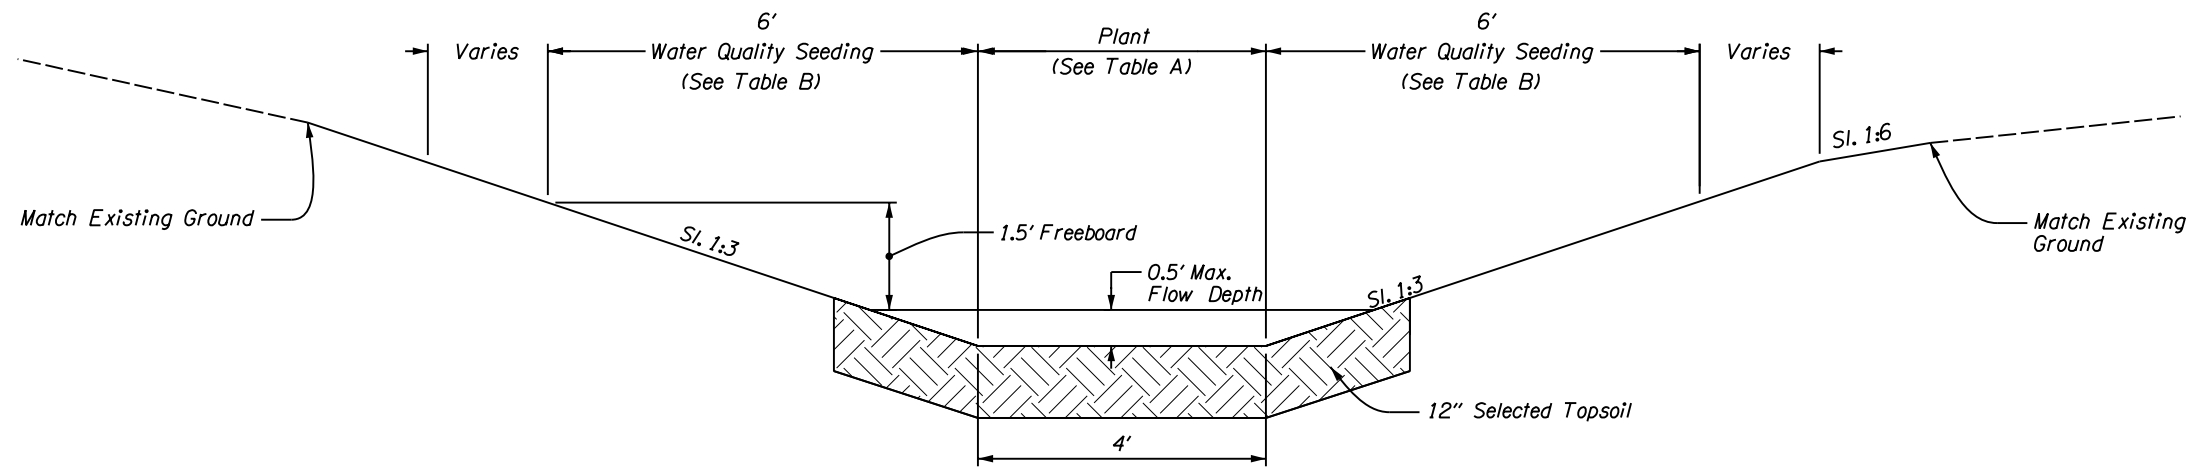

TYPICAL BIO-SWALE SECTION


Not To Scale

NOTES:
1. See Sheet 3A For Plan.

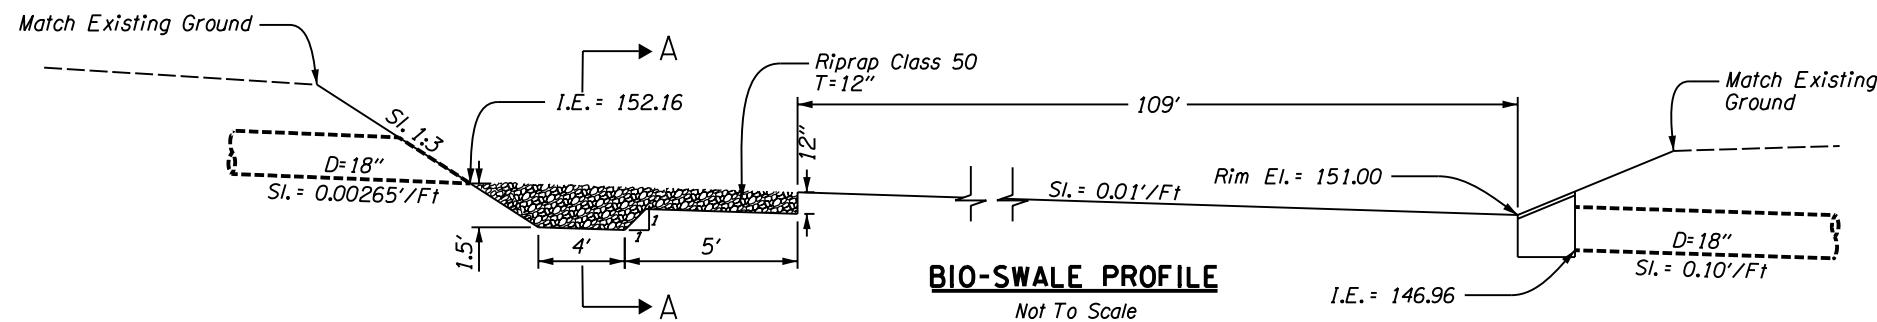


BIO-SWALE PROFILE

Not To Scale

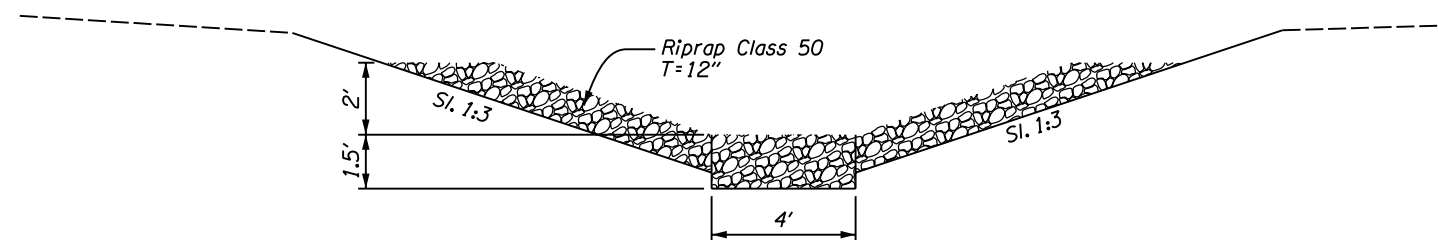

SECTION A-A

Not To Scale

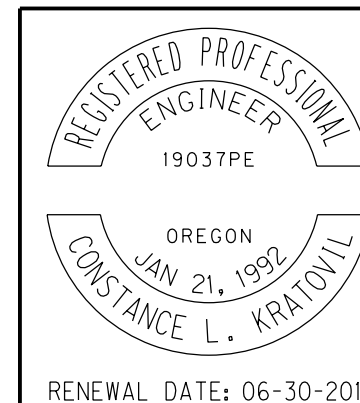

OREGON DEPARTMENT OF TRANSPORTATION

PB PARSONS BRINCKERHOFF
400 S.W. Sixth Ave, Portland, OR 97204


I-84: DODSON - TANNER CREEK BUNDLE 209
COLUMBIA RIVER HIGHWAY
MULTNOMAH COUNTY

Design Team Leader - LAURA AMUNDSON
Designed By - LUCY CASTRILLON
Drafted By - ANTHONY O'DONNELL

DETAILS


SHEET NO.
2B

SECTION A-A

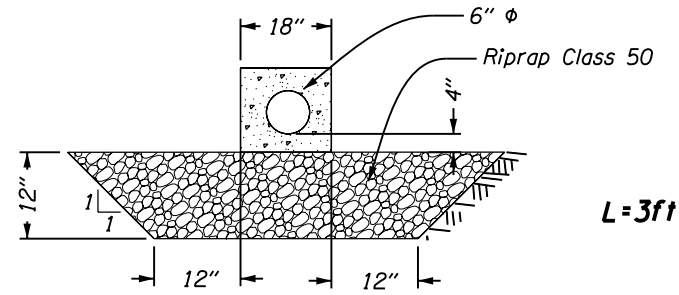


STA. "LE" 1622+50.00 And STA. "LE" 1636+16.00


OUTFALL DETAIL
Not To Scale

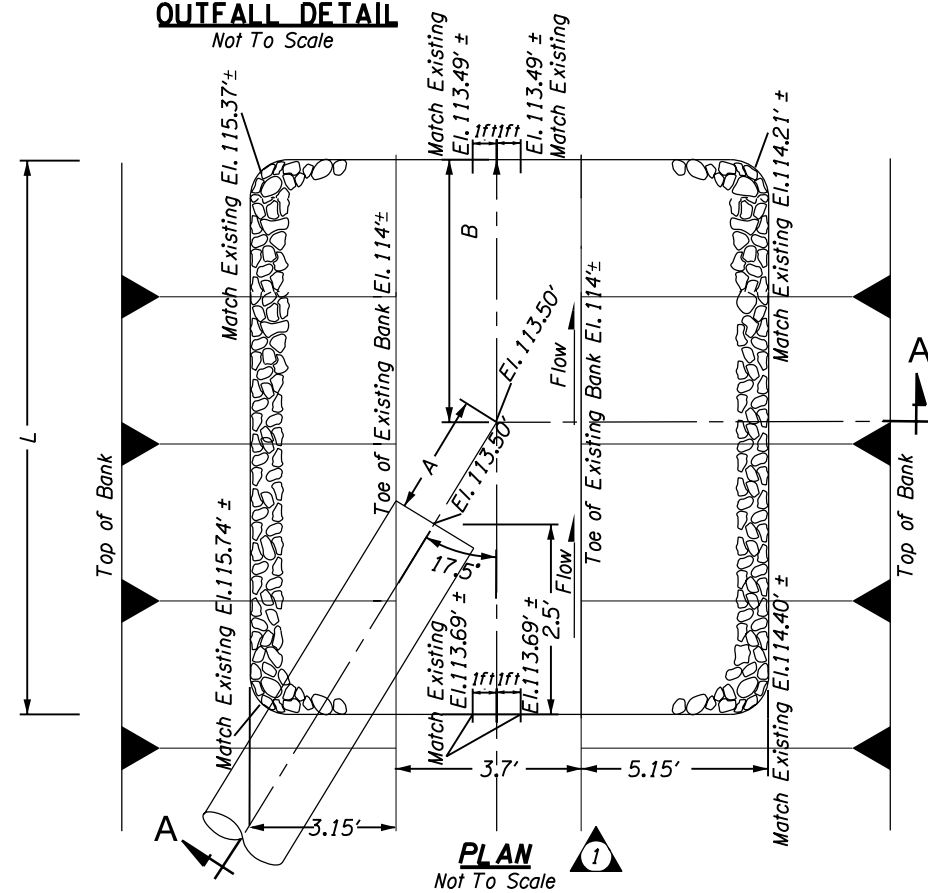


Required Dimensions	
"A"	4 Ft.
"B"	14 Ft. Min.
"L"	20.5 Ft. Min.

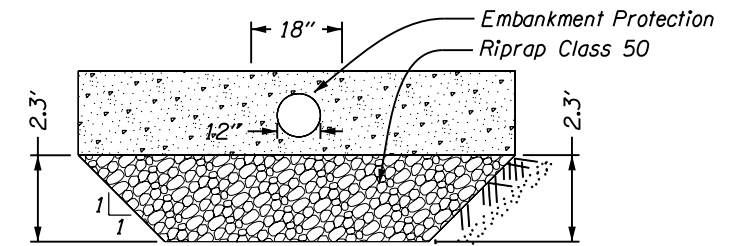

PROFILE

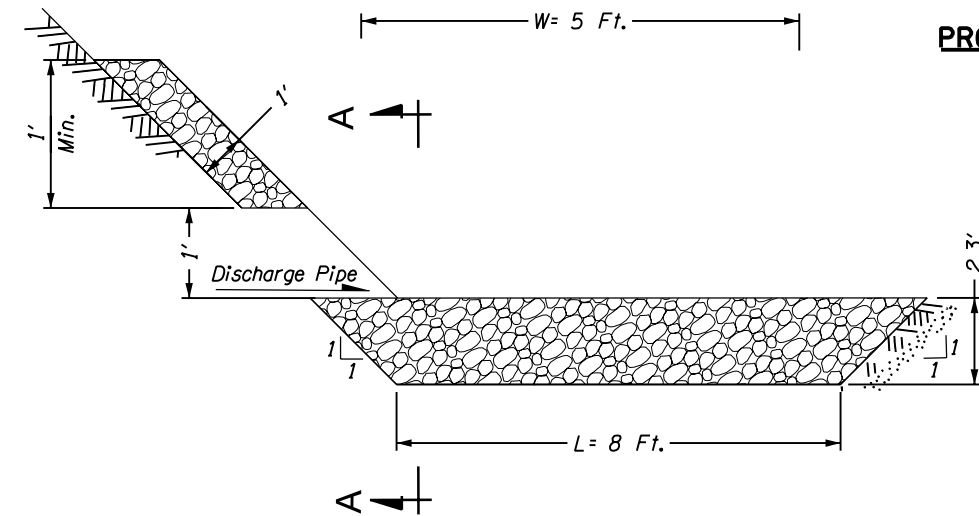


RIPRAP OUTFALL AT STA 1642+80.69.5' RT.
Not To Scale

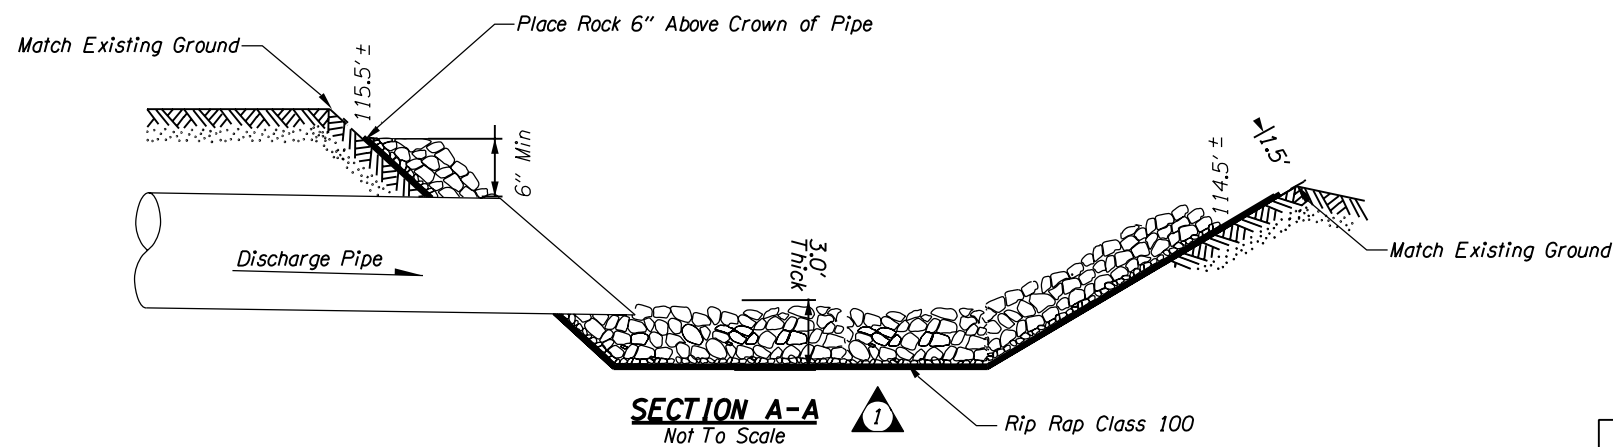

SECTION A-A
Not To Scale


STA "LE" 1627+12.19, 123.29' LT
PIPE/CULVERT OUTFALL DISCHARGE PROTECTION

REVISIONS	
1	Revised 02-25-2010 Modified Pipe/Culvert Outfall Discharge Protection

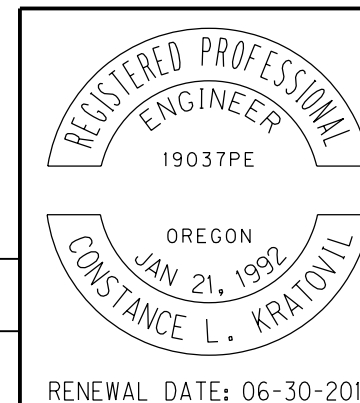

RENEWAL DATE: 06-30-2011

OREGON DEPARTMENT OF TRANSPORTATION	
PARSONS BRINCKERHOFF 400 S.W. Sixth Ave, Portland, OR 97204	
I-84: DODSON - TANNER CREEK BUNDLE 209 COLUMBIA RIVER HIGHWAY MULTNOMAH COUNTY	
Design Team Leader - LAURA AMUNDSON Designed By - LUCY CASTRILLON Drafted By - ANTHONY O'DONNELL	
DETAILS	SHEET NO. 2B-5

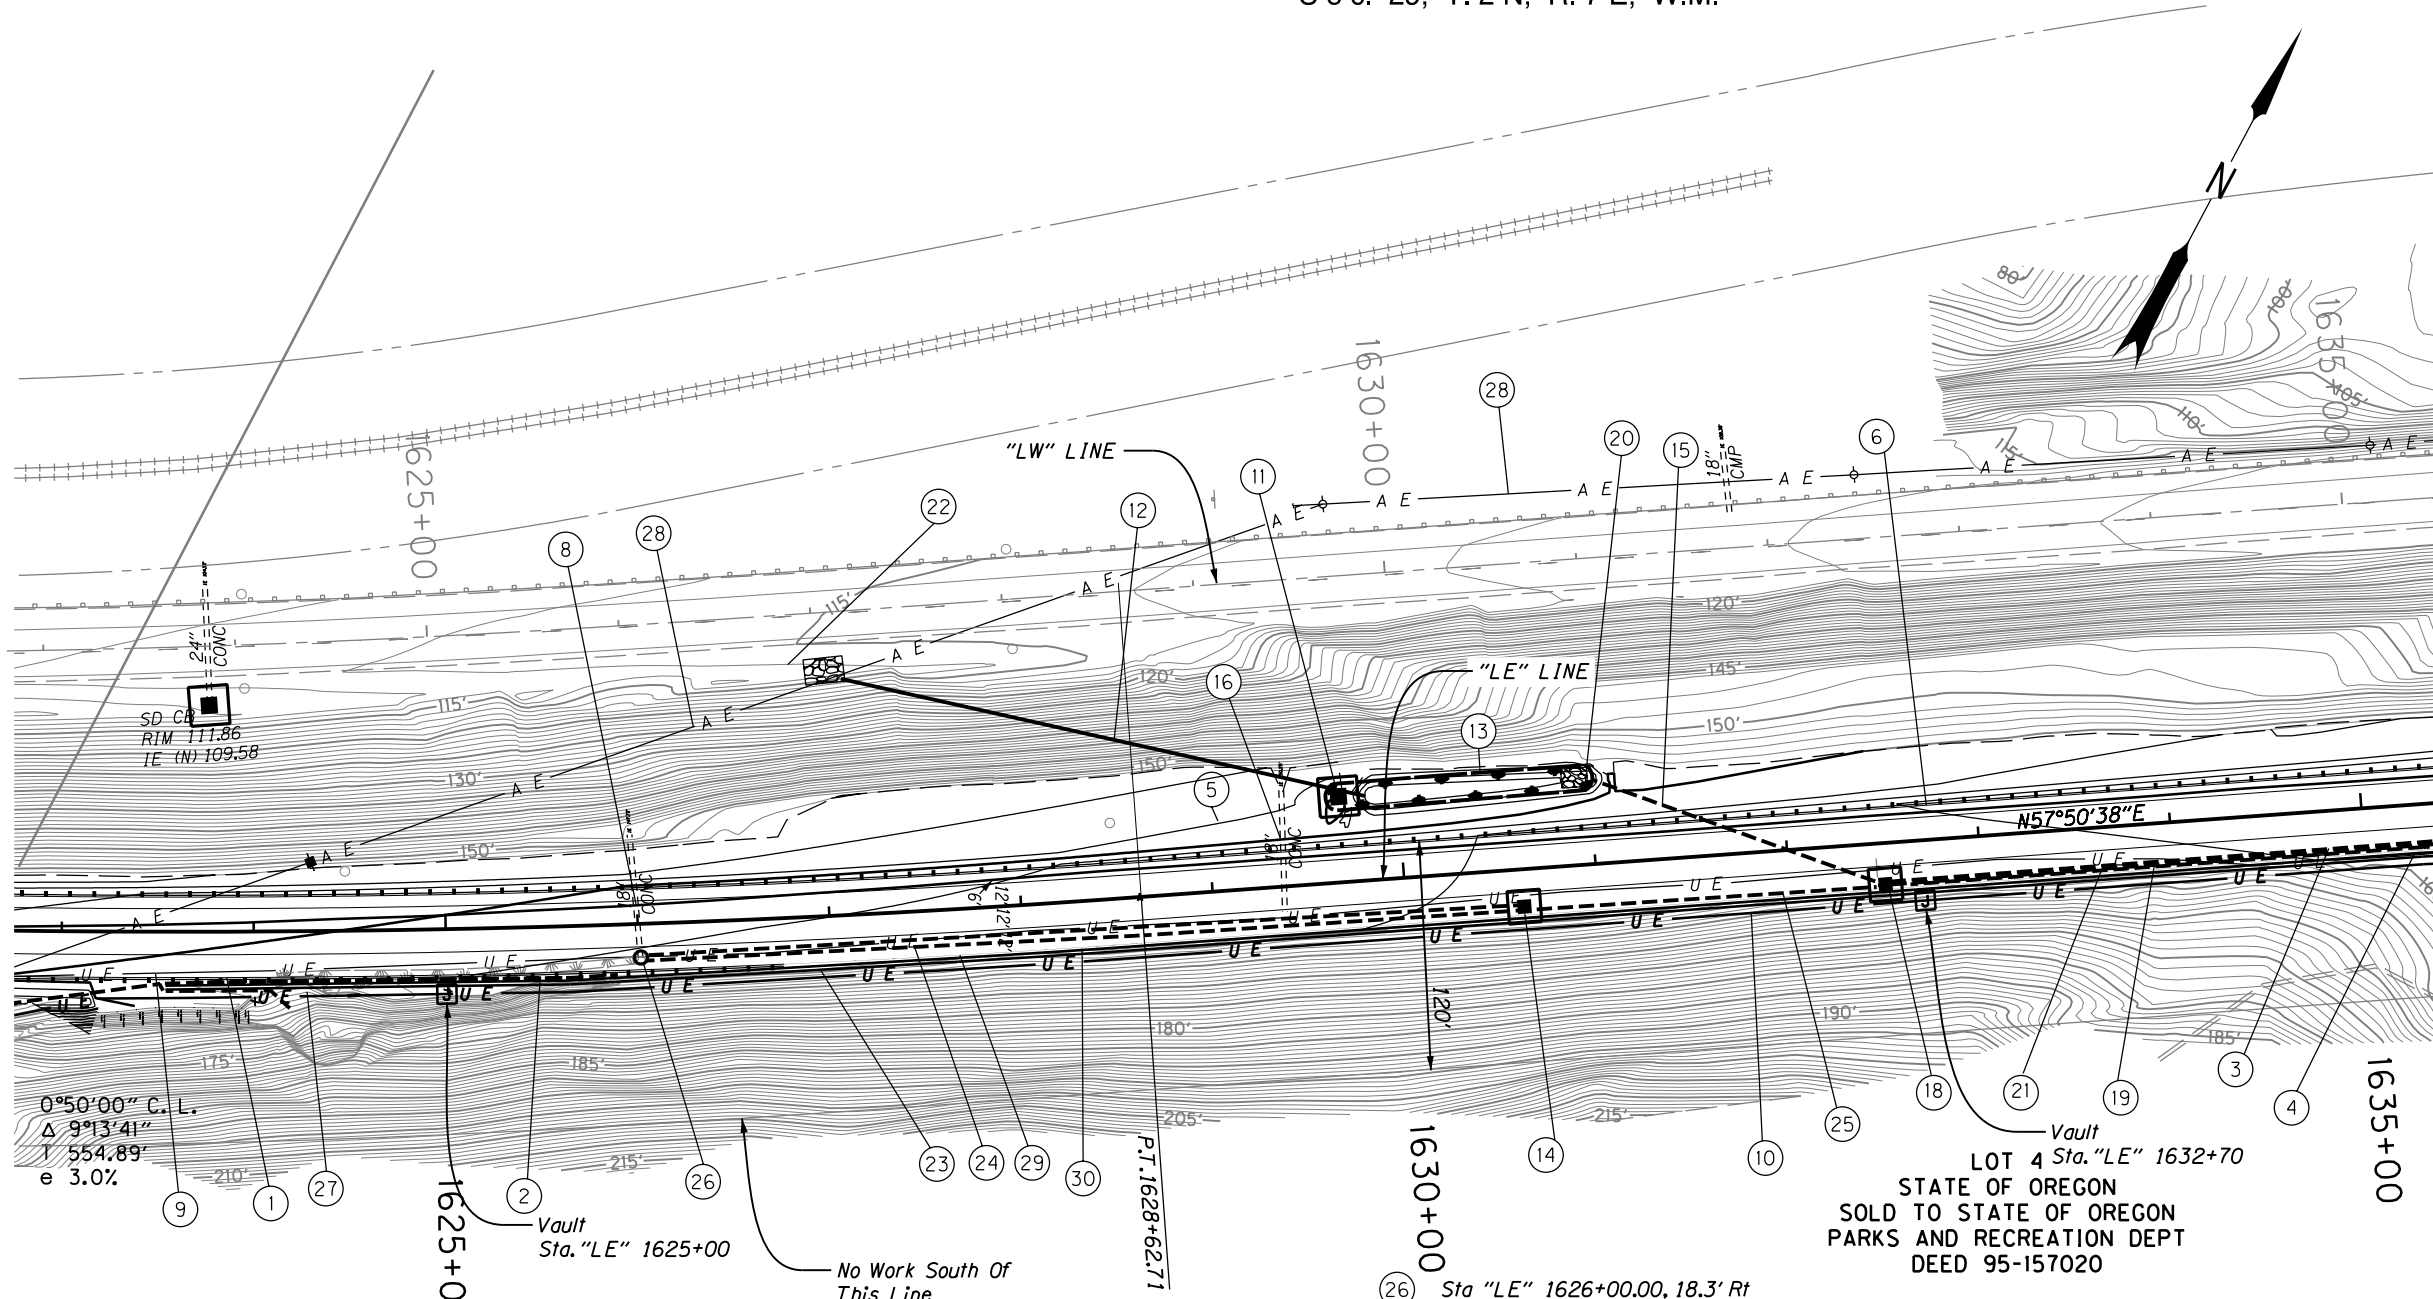


- ② See Sheet 3, Note 4
- ③ Sta. "LE" 1634+55, 18.9' Rt. To Sta. "LE" 1636+84, 4.8' Rt. Remove Extg. Guardrail - 230'
- ④ Sta. "LE" 1635+36.63, 24.0' Rt. To Sta. "LE" 1636+57.29, 24.0' Rt. Const. Conc. Barrier To Weatherized Guardrail Transition To Type 4 Weatherized Guardrail, Double Thkn. 2-0.105" Thick Elements" - 18.75'. See Sheet 2B-4 Construct Type 4 Weatherized Guardrail, Double Thkn. 2-0.105" Thick Elements" - 87.5' Const. Weatherized Guardrail Transition To Bridge Rail - 18.84' See Structure No. 20855 Dwg. No. 80526.
- ⑤ See Sheet 3, Note 1
- ⑥ See Sheet 3, Note 2
- ⑧ Sta. "LE" 1626+00.00, 18.30' Rt. Connect Shallow Manhole to Existing 18" Concrete Culvert.
- ⑩ See Sheet 3, Note 10
- ⑪ Sta. "LE" 1629+83.00, 44.0' Lt. Install Ditch Inlet Type D I.E. (18" Out) = 148.50 NW
- ⑫ Sta. "LE" 1627+12.19, 123.29' Lt. To Sta. "LE" 1629+83.00, 44.0' Lt. Install 18" Stormpipe - 282' 10' Depth s = 0.125'/Ft
- ⑬ Sta. "LE" 1629+71.75, 44.0' Lt. To Sta. "LE" 1631+13.12, 44.0' Lt. Const. Bioswale - 109' s = 0.01'/Ft Exc. 361 c.y. Topsoil = 32 c.y.

- ⑭ Sta. "LE" 1630+62.80, 22.9' Rt. Install Manhole With Inlet Type G-2 I.E. (12" out) = 153.29 SW I.E. (6" in) = 153.96 NE I.E. (6" out) = 153.96 SW See Sheet 2B-2
- ⑮ Sta. "LE" 1632+57.00, 22.9' Rt. To Sta. "LE" 1631+00.38, 44.0' Lt. Install 18" Concrete culvert - 166' 5' Depth s = 0.00265'/Ft
- ⑯ Sta. "LE" 1629+37 Plug And Abandon Existing 18" Concrete Culvert
- ⑰ Sta. "LE" 1632+57, 22.9' Rt. Install Concrete Inlet Type G2 I.E. (18" out) = 152.60 W I.E. (18" in) = 152.62 NE
- ⑱ Sta. "LE" 1632+57, 22.9' Rt. To Sta. "LE" 1636+57, 22.9' Rt. Install 18" Stormpipe - 400' 5' Depth s = 0.00315'/Ft
- ⑲ Sta. "LE" 1631+00, 44.0' Lt. Construct Riprap Class 50 5.0 c.y. See Sheet 2B
- ⑳ Sta. "LE" 1632+59.00, 23.5' Rt. To Sta. "LE" 1636+16.00, 40.0' Rt. Construct 6" Subsurface Drain. - 357' 5' Depth s=0.0040'/Ft
- ㉑ Sta. "LE" 1627+12.19, 123.29' Lt. Const. Outfall, See Sheet 2B-5 Riprap Class 100 18c.y.
- ㉒ Sta. "LE" 1626+00.00, 19.5' Rt To Sta. "LE" 1630+62.80, 23.5' Rt Construct 6" Subsurface Drain - 462.8' 5' Depth s=0.0040'/Ft
- ㉓ Sta. "LE" 1626+00.00, 17.6' Rt To Sta. "LE" 1630+62.80, 22.4' Rt Install 12" Stormpipe - 462.8' 5' Depth s=0.0040'/Ft
- ㉔ Sta. "LE" 1630+62.80, 24.1' Rt To Sta. "LE" 1632+55.80, 24.15' Rt Construct 6" Subsurface Drain - 193' See Drg. RD312 5' Depth s=0.0040'/Ft
- ㉕ Sta. "LE" 1626+74.79, 24' Rt. To Sta. "LE" 1635+36.63, 24' Rt. Construct Cast-in-place Conc. Shoulder Barrier, Narrow Base. See Sheet 2B-3 And Drg. No. RD505
- ㉖ Sta. "LE" 1626+74.79, Rt. To Sta. "LE" 1635+36.63, Rt. Construct Type 5 Traffic Delineators At 50' Spacing - 15 Each

LOT 4 Sta. "LE" 1632+70
STATE OF OREGON
SOLD TO STATE OF OREGON
PARKS AND RECREATION DEPT
DEED 95-157020

REVISIONS	
①	Revised 02-25-2010 Updated Notes 12 and 22

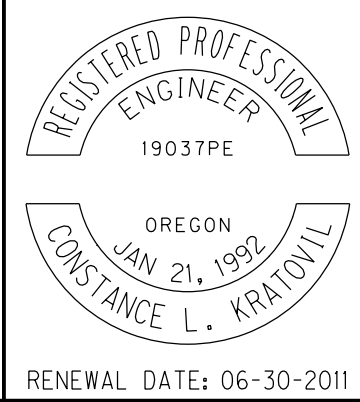

OREGON DEPARTMENT OF TRANSPORTATION




I-84: DODSON - TANNER CREEK BUNDLE 209
COLUMBIA RIVER HIGHWAY
MULTNOMAH COUNTY

Design Team Leader - LAURA AMUNDSON
Designed By - LUCY CASTRILLON & CORY BURLINGAME
Drafted By - ANTHONY O'DONNELL

ALIGNMENT AND GENERAL CONSTRUCTION


SHEET NO.
3A

"LE" LINE

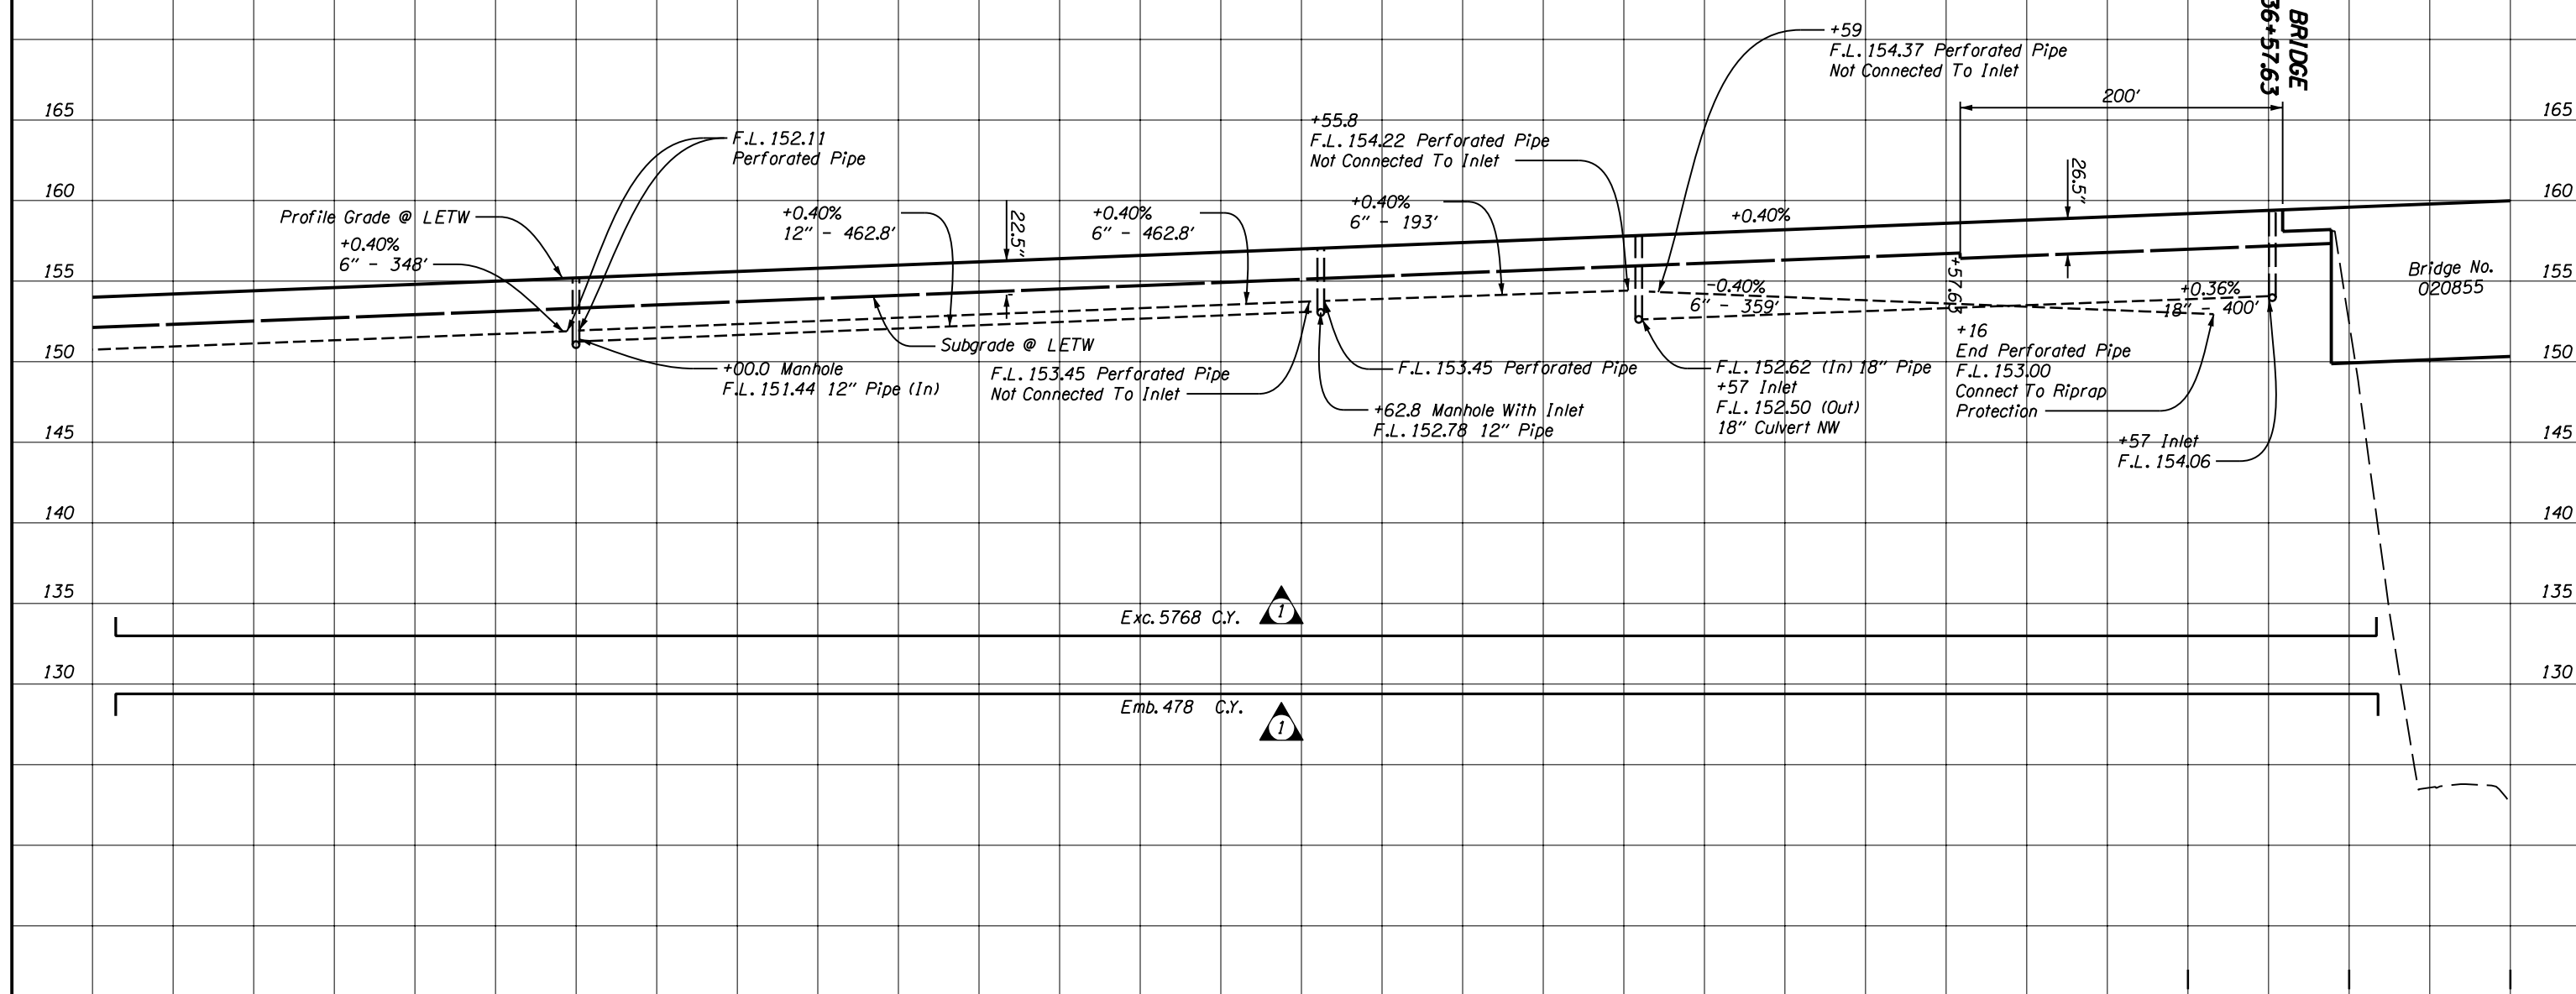

NOTE:
LETW = Left Edge Traveled Way
RETW = Right Edge Traveled Way

REVISIONS	
1	Revised 03-09-2009 Revised Quantities To Be Called Out Per Sheet

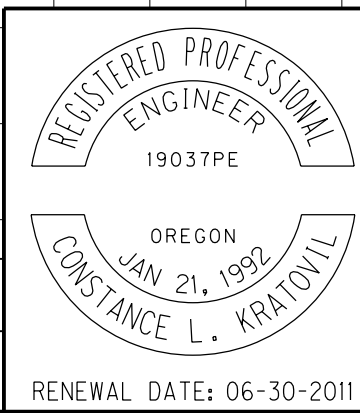

1635 OREGON DEPARTMENT OF TRANSPORTATION



I-84: DODSON - TANNER CREEK BUNDLE 209
COLUMBIA RIVER HIGHWAY
MULTNOMAH COUNTY

Design Team Leader - LAURA AMUNDSON
Designed By - LUCY CASTRILLON
Drafted By - ANTHONY O'DONNELL

PROFILE

SHEET NO.
3B-2

1625

1630