

OPERATION & MAINTENANCE MANUAL

DFI No.: D00388

**Facility Type: Water Quality Biofiltration
Swale**



MARCH, 2011

1. Identification

Drainage Facility ID (DFI): **D00388**
Facility Type: Water Quality Biofiltration Swale
Construction Drawings: (V-File Number) 38V-055
Location: District: 7
Highway No.: 001
Mile Post: 126.52 / 126.54 (beg./end)
Description: This facility is located on the eastern side of I-5 (Hwy 001, Pacific Highway) in the interior area of the Edenbower loop on-ramp. Access can be obtained from the northbound loop on-ramp.

2. Facility Contact Information

Contact the Engineer of Record, Region Technical Center, or Geo-Environmental's Senior Hydraulics Engineer for:

- Operational clarification
- Maintenance clarification
- Repair or restoration assistance

Engineering Contacts:

Region Technical Center Hydraulics Engineer (541) 957-3693

Or

Geo-Environmental Senior Hydraulics Engineer (503) 986-3365.

3. Construction

Engineer of Record: ODOT Designer – Region 3 Tech. Center, James Bauman, 541-957-3573

Facility construction: 2007
Contractor: CH2M Hill, Inc., (Design – Build)

4. Storm Drain System and Facility Overview

A water quality swale is a flat-bottomed open channel designed to treat stormwater runoff from highway pavement areas. This type of facility is lined with grass. Treatment by trapping sedimentation occurs when stormwater runoff flows through the grass.

Stormwater for the facility is conveyed to the facility through a roadside ditch. The ditch collects stormwater from sheet flow generated by the northbound loop on-ramp. Refer to the Operational Plan in Appendix A for further information. Water conveyed into the swale undergoes treatment as it flows through the length of the channel. The treated water flows out of the swale through an inlet/outlet control structure connected to an 18-inch storm pipe. This storm pipe discharges into a roadside ditch on the south side of the loop ramp. The flow from this roadside ditch is conveyed in a southerly direction along the northbound lanes of I-5.

A. Maintenance equipment access:

Maintenance crew can access the facility from the northbound shoulder of I-5 or from the northbound Edenbower Road off-ramp.

B. Heavy equipment access into facility:

- Allowed (no limitations)
- Allowed (with limitations)
- Not allowed

C. Special Features:

- Amended Soils
- Porous Pavers
- Liners
- Underdrains



Photo 1: Looking east, flow into the swale is generated from the northbound loop on-ramp shown in the picture. Water is flowing towards the bottom of the picture.



Photo 2: Looking north, flow into the swale is generated from the northbound loop on-ramp on the left side of the picture. Water is collected in the inlet/outlet structure shown at the bottom of the picture.



Photo 3: Looking east, flow into the swale is generated from the northbound loop on-ramp shown in the picture. Water is flowing towards the bottom of the picture.

5. Facility Haz Mat Spill Feature(s)

The water quality biofiltration swale can be used to store a volume of liquid by blocking the 18-inch diameter outlet pipe located at the outlet of the swale facility; see Photo 2. Covering the inlet/outlet control structure with sandbags or a steel plate may help accomplish this task.

6. Auxiliary Outlet (High Flow Bypass)

Auxiliary Outlets are provided if the primary outlet control structure can not safely pass the projected high flows. Broad-crested spillway weirs and over flow risers are the two most common auxiliary outlets used in stormwater treatment facility design. The auxiliary outlet feature is either a part of the facility or an additional storm drain feature/structure.

The auxiliary outlet feature for this facility is:

- Designed into facility
- Other, as noted below
There is no auxiliary outlet for this facility.

7. Maintenance Requirements

Routine maintenance table for non-proprietary stormwater treatment and storage/detention facilities have been incorporated into ODOT's Maintenance Guide. These tables summarize the maintenance requirements for ponds, swales, filter strips, bioslopes, and detention tanks and vaults. Special maintenance requirements in addition to the routine requirements are noted below when applicable.

The ODOT Maintenance Guide can be viewed at the following website:

<http://www.oregon.gov/ODOT/HWY/OOM/MGuide.shtml>

Maintenance requirements for proprietary structures, such as underground water quality manholes and/or vaults with filter media are noted in Appendix C when applicable.

The following stormwater facility maintenance table (See ODOT Maintenance Guide) should be used to maintain the facility outlined in this Operation and Maintenance Manual or follow the Maintenance requirements outlined in Appendix C when proprietary structure is selected below:

- Table 1 (general maintenance)
- Table 2 (stormwater ponds)
- Table 3 (water quality biofiltration swales)
- Table 4 (water quality filter strips)
- Table 5 (water quality bioslopes)
- Table 6 (detention tank)
- Table 7 (detention vault)
- Appendix C (proprietary structure)
- Special Maintenance requirements:

Note: Special maintenance Requirements Require Concurrence from ODOT SR Hydraulics Engineer.

8. Waste Material Handling

Material removed from the facility is defined as waste by DEQ. Refer to the roadwaste section of the ODOT Maintenance Yard Environmental Management System (EMS) Policy and Procedures Manual for disposal options: <http://egov.oregon.gov/ODOT/HWY/OOM/EMS.shtml>


Contact any of the following for more detailed information about management of waste materials found on site:

ODOT Clean Water Unit	(503) 986-3008
ODOT Statewide Hazmat Coordinator	(503) 229-5129
ODOT Region Hazmat Coordinator	(541) 957-3594
ODEQ Northwest Region Office	(503) 229-5263

Appendix A

Content:

- **Operational Plan and Profile Drawing(s)**

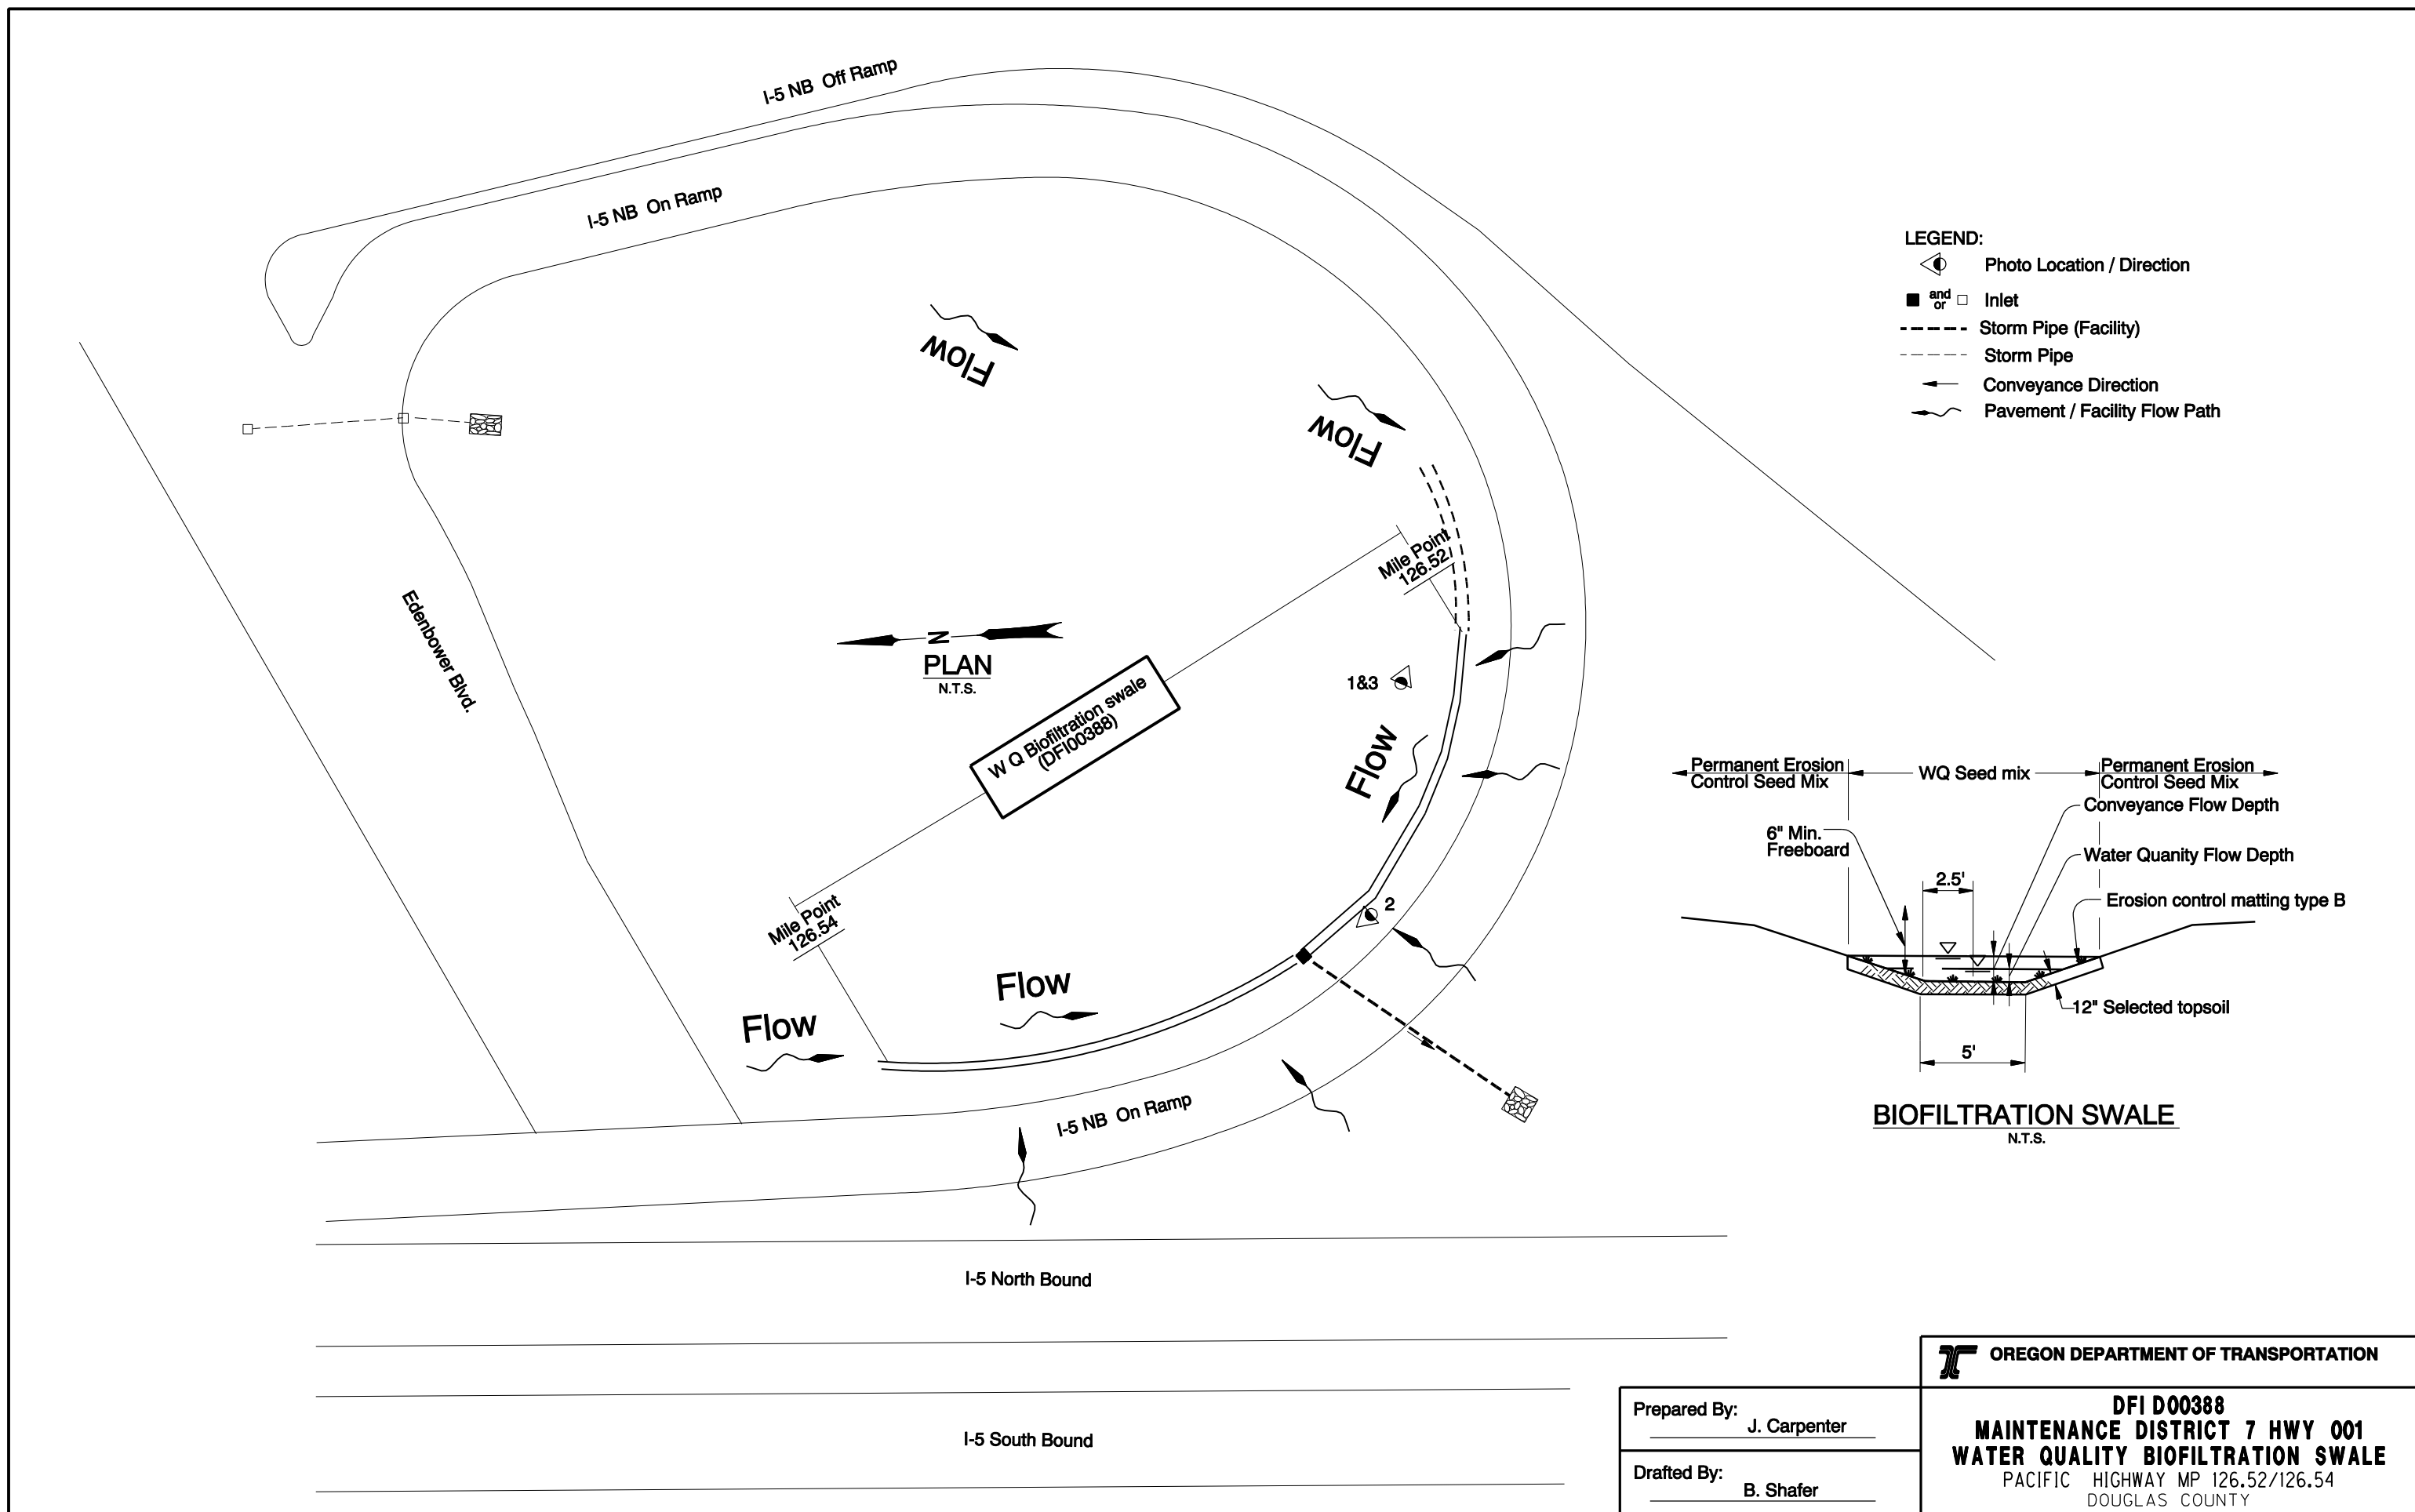

- LEGEND:**
- Photo Location / Direction
 - and Inlet
 - Storm Pipe (Facility)
 - Storm Pipe
 - Conveyance Direction
 - Pavement / Facility Flow Path

PLAN
N.T.S.

BIOFILTRATION SWALE
N.T.S.

OREGON DEPARTMENT OF TRANSPORTATION

Prepared By: J. Carpenter
 Drafted By: B. Shafer

DFI D00388
MAINTENANCE DISTRICT 7 HWY 001
WATER QUALITY BIOFILTRATION SWALE
 PACIFIC HIGHWAY MP 126.52/126.54
 DOUGLAS COUNTY

Appendix B

Content:

- **ODOT Project Plan Sheets**
 - *Cover/Title Sheet*
 - *Water Quality/Detention Plan Sheets*
 - *Other Details*

Index Of Roadway And Bridge Drawings On Sheet 1A Thru 1N
Standard Drg. Nos.

- BR140 Expansion Joint with Compression Seal or Poured Sealant
- BR145 Single Strip Seal Expansion Joint
- BR155 Bridge Joint Details (Joints A through F)
- BR203 Transition Concrete Bridge Rail to Guardrail
- BR236 Trailing End Br. Connection Concrete Rail to Guardrail
- BR240 Protective Fencing
- BR241 Protective Fencing
- BR350 Temporary Diaphragm Beam for Prestressed Concrete Beams
- RD300 Trench Backfill, Bedding, Pipe Zone and Multiple Installations
- RD302 Street Cut
- RD312 Subsurface Drain
- RD314 Open Grade HMAC Drainage Details
- RD318 Sloped Ends For Concrete Pipe
- RD320 Paved End, Slope For Culverts
- RD336 Standard Storm Sewer Manhole
- RD348 Manhole With Inlet
- RD356 Manhole Covers And Frames
- RD364 Concrete Inlets Types G-1, G-2 & G-2M
- RD368 Concrete Inlets, Type ME, M-O, And B-SL
- RD370 Ditch Inlet, Type D
- RD374 Area Drainage Basin or Field Inlet
- RD376 Miscellaneous Drainage Structures, Siphon Box and Inlet Adj. Cap
- RD386 Circular Concrete Pipe Fill Height Table
- RD400 Guardrail And Metal Median Barrier
- RD405 Guardrail And Metal Median Barrier Parts
- RD410 Guardrail Parts (Thrie Beam)
- RD415 Guardrail And Metal Median Barrier Parts
- RD425 2'6" - 4'0" Flared Terminal
- RD440 Guardrail Installation At Bridge Ends
- RD450 Guardrail Anchors (Steel)
- RD500 Precast Concrete Barrier Pin And Loop Assembly
- RD530 Guardrail Connection To Concrete Barrier
- RD545 Precast Tall (42") Concrete Barrier
- RD550 Cast In Place Tall Concrete Barrier Transition To Bridge Rail
- RD560 Cast In Place Tall Barrier Transition To Standard Concrete Barrier
- RD610 Asphalt Pavement Details
- RD700 Curbs
- RD720 Sidewalks
- RD755 Sidewalk Ramp Details
- RD760 Sidewalk Ramp Placement
- RD800 Traffic Delineators
- RD805 Traffic Delineator Installations
- RD810 Barbed And Woven Wire Fences
- RD900 Traffic Control Plans (Details)
- RD905 Traffic Control Plans (Intersection Details)
- RD906 Traffic Control Plans (Signalized Intersection Details)
- RD907 Traffic Control Plans (Multi-Lane Signalized Intersection Details)
- RD910 Traffic Control Plans (2-Lane, 2-Way and 3-Lane, 2-Way Roadways)
- RD915 Traffic Control Plans (Non-Freeway, Multi-Lane Sections)
- RD920 Traffic Control Plans (Freeway Section)
- RD925 Traffic Control Plans (Freeway Section)
- RD930 Traffic Control Plans (Freeway Section)
- RD945 Traffic Control Plans (Details)
- RD950 Barricades
- RD955 Temporary Impact Attenuators
- RD960 Temporary Impact Attenuators
- RD1005 Check Dams
- RD1010 Inlet Protection (Type 1, 2, & 3)
- RD1040 Sediment Fence, Supported Sediment Fence, Unsupported
- TM100 Temporary Wood Post Sizing Chart
- TM105 Orange Flag Board Mounting Details
- TM200 Sign Installation Details
- TM201 Sign Installation Details for Secondary Signs
- TM205 Aluminum Panels And Installation
- TM206 Sign Bracing Details Sign Mountain Details
- TM207 Additional Mountain Details
- TM211 Sign Details US And Interstate Route Shields
- TM212 Signing Details Oregon Route Shields

STATE OF OREGON
DEPARTMENT OF TRANSPORTATION


PLANS FOR PROPOSED PROJECT
GRADING, DRAINAGE, STRUCTURE AND PAVING
**I-5: SUTHERLIN - ROSEBURG SEC.
DESIGN-BUILD PROJECT**

PACIFIC HIGHWAY
DOUGLAS COUNTY

MAY 2007

BEGINNING OF PROJECT

M.P. 138.71

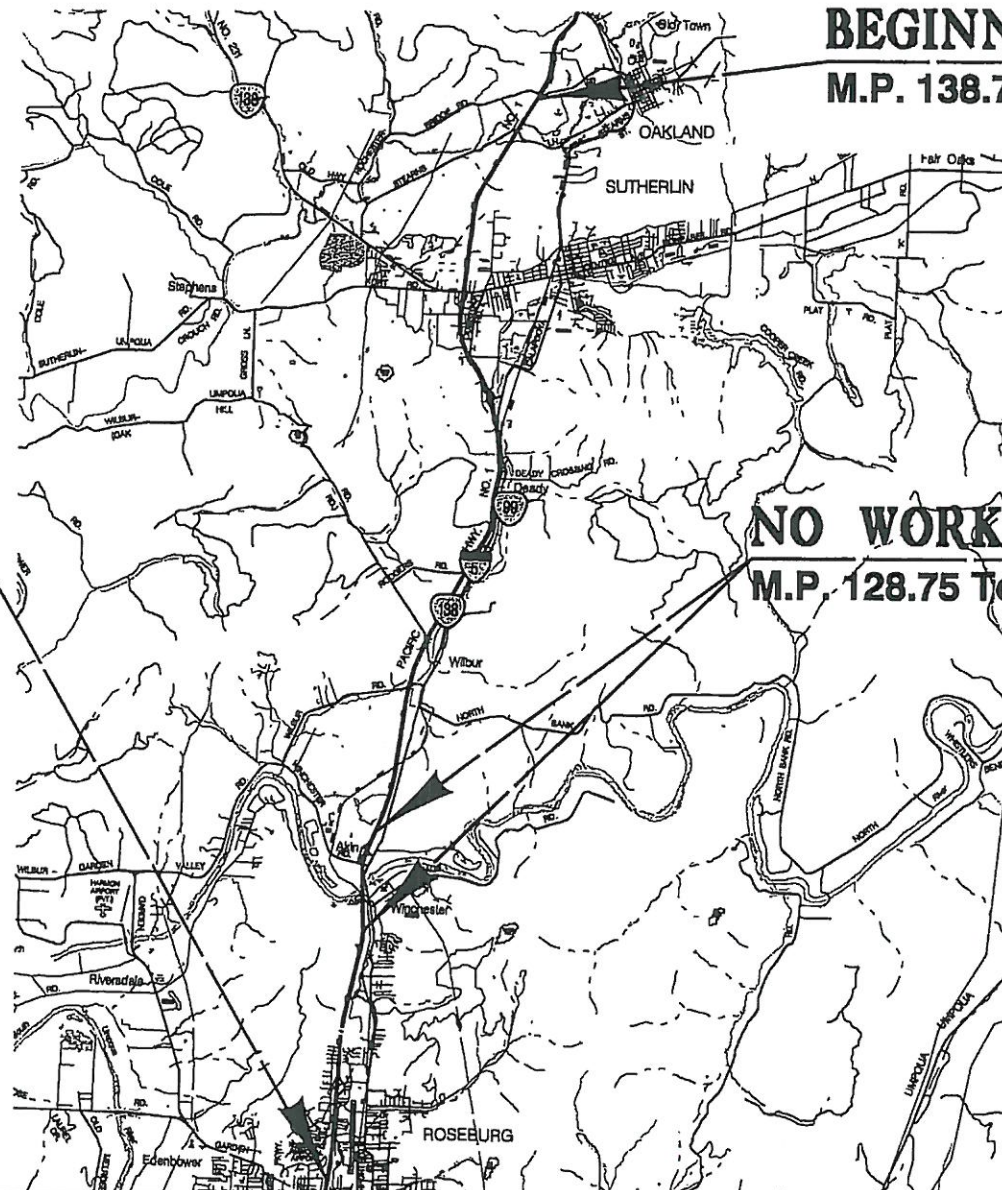


END OF PROJECT

M.P. 125.38


NO WORK ZONE

M.P. 128.75 To M.P. 129.80

 REVISED AS CONSTRUCTED
5/06 CONTRACT 13070
DESIGN MGR. James Bauman



T. 25 S., R. 5 W., W.M.
T. 26 S., R. 5 W., W.M.
T. 26 S., R. 6 W., W.M.
T. 27 S., R. 6 W., W.M.

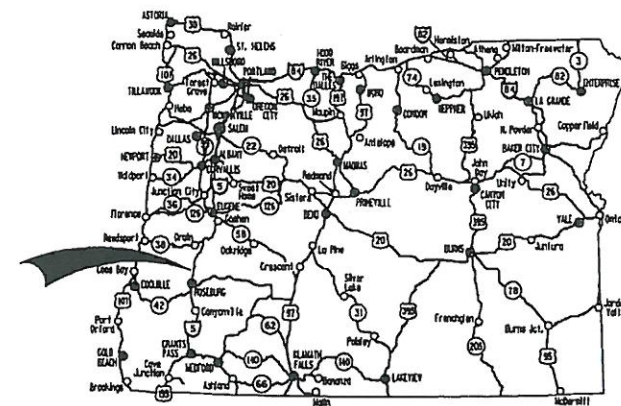

Overall Length Of Project - 13.33 Miles

ATTENTION:
Oregon Law Requires You To Follow Rules
Adopted By The Oregon Utility Notification
Center. Those Rules Are Set Forth In
OAR 952-001-0010 Through OAR 952-001-0090.
You May Obtain Copies Of The Rules By Calling
The Center. (Note: The Telephone Number For
The Oregon Utility Center Is (503) 232-1987.)

LET'S ALL
WORK TOGETHER
TO MAKE THIS
JOB SAFE

OREGON TRANSPORTATION COMMISSION
Stuart Foster CHAIRMAN
Gail L. Achterman COMMISSIONER
Mike Nelson COMMISSIONER
Randall Pape COMMISSIONER
Janice J. Wilson COMMISSIONER
Matt Garrett DIRECTOR OF TRANSPORTATION

PLANS PREPARED FOR
ODOT
BY:
CH2MHILL



EXPIRES: 12/31/07

OREGON DEPARTMENT OF TRANSPORTATION
CONCURRENCE


TECHNICAL SERVICES MANAGING ENGINEER DATE

**I-5: SUTHERLIN-ROSEBURG SEC.
DESIGN-BUILD PROJECT
PACIFIC HIGHWAY
DOUGLAS COUNTY**

FEDERAL HIGHWAY ADMINISTRATION	PROJECT NUMBER	SHEET NO.
OREGON DIVISION	OTIA-IM-S001(192)	1

Note: See Sht. 1A For Additional Standard Drawings

Rev. No.	Date	Revision
1	11/21/06	As Constructed

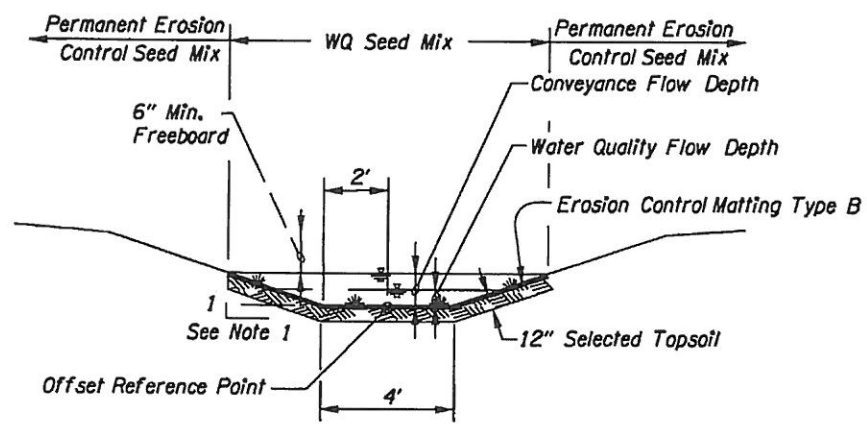


Notes:

1. Sideslopes In The Water Quality Section Of The Swale Shall Be 4H:1V Maximum. Sideslopes Above The Water Quality Flow Depth Shall Match Roadway Embankment Slopes.
2. Erosion Control Matting Materials And Installation Per ODOT Std. Spec. Section 280.




BIOSWALE SECTION - TYPICAL

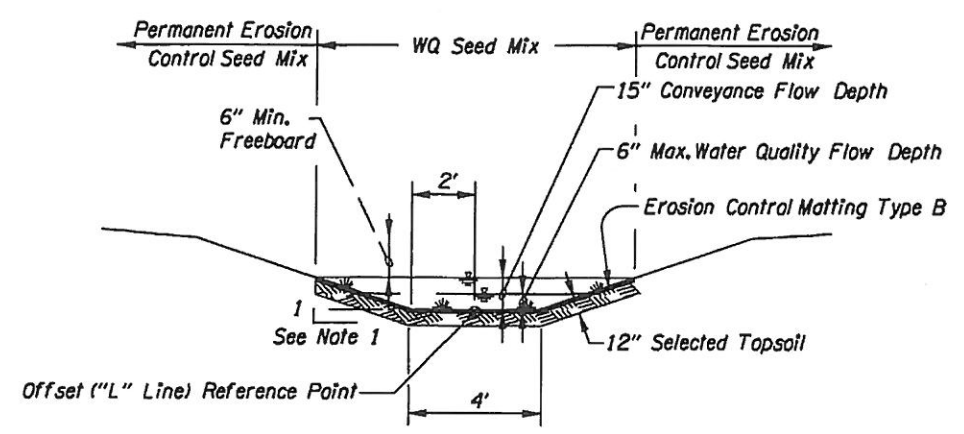

Notes:

1. Sideslopes In The Water Quality Section Of The Swale Shall Be 4H:1V Maximum. Sideslopes Above The Water Quality Flow Depth Shall Match Roadway Embankment Slopes.
2. Erosion Control Matting Materials And Installation Per ODOT Std. Spec. Section 280.

BIOSWALE SECTION - SUTHERLIN INTERCHANGE

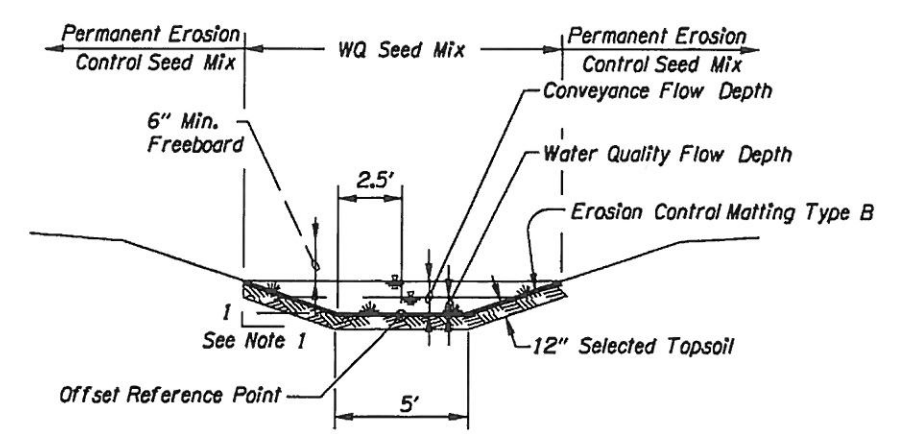

Notes:


1. Sideslopes In The Water Quality Section Of The Swale Shall Be 4H:1V Maximum. Sideslopes Above The Water Quality Flow Depth Shall Match Roadway Embankment Slopes.
2. Erosion Control Matting Materials And Installation Per ODOT Std. Spec. Section 280.



BIOSWALE SECTION - NORTH ROSEBURG INTERCHANGE


Rev. No.	Date	Revision
3	11/21/06	As Constructed
2	2/1/07	Revision - Addition Of Bioswale Section
1	12/9/05	Revision - Addition Of Non-Specific Bioswale Section

OREGON DEPARTMENT OF TRANSPORTATION ROADWAY ENGINEERING SECTION	
I-5: SUTHERLIN-ROSEBURG SEC. DESIGN-BUILD PROJECT PACIFIC HIGHWAY DOUGLAS COUNTY	
Reviewed By - Mark Anderson Designed By - Scott Christopherson Drafted By - Prisciliano Peralta-Ramirez	
DRAINAGE DETAILS TYPICAL BIOSWALE SECTION	
SHEET NO. 2B-20	

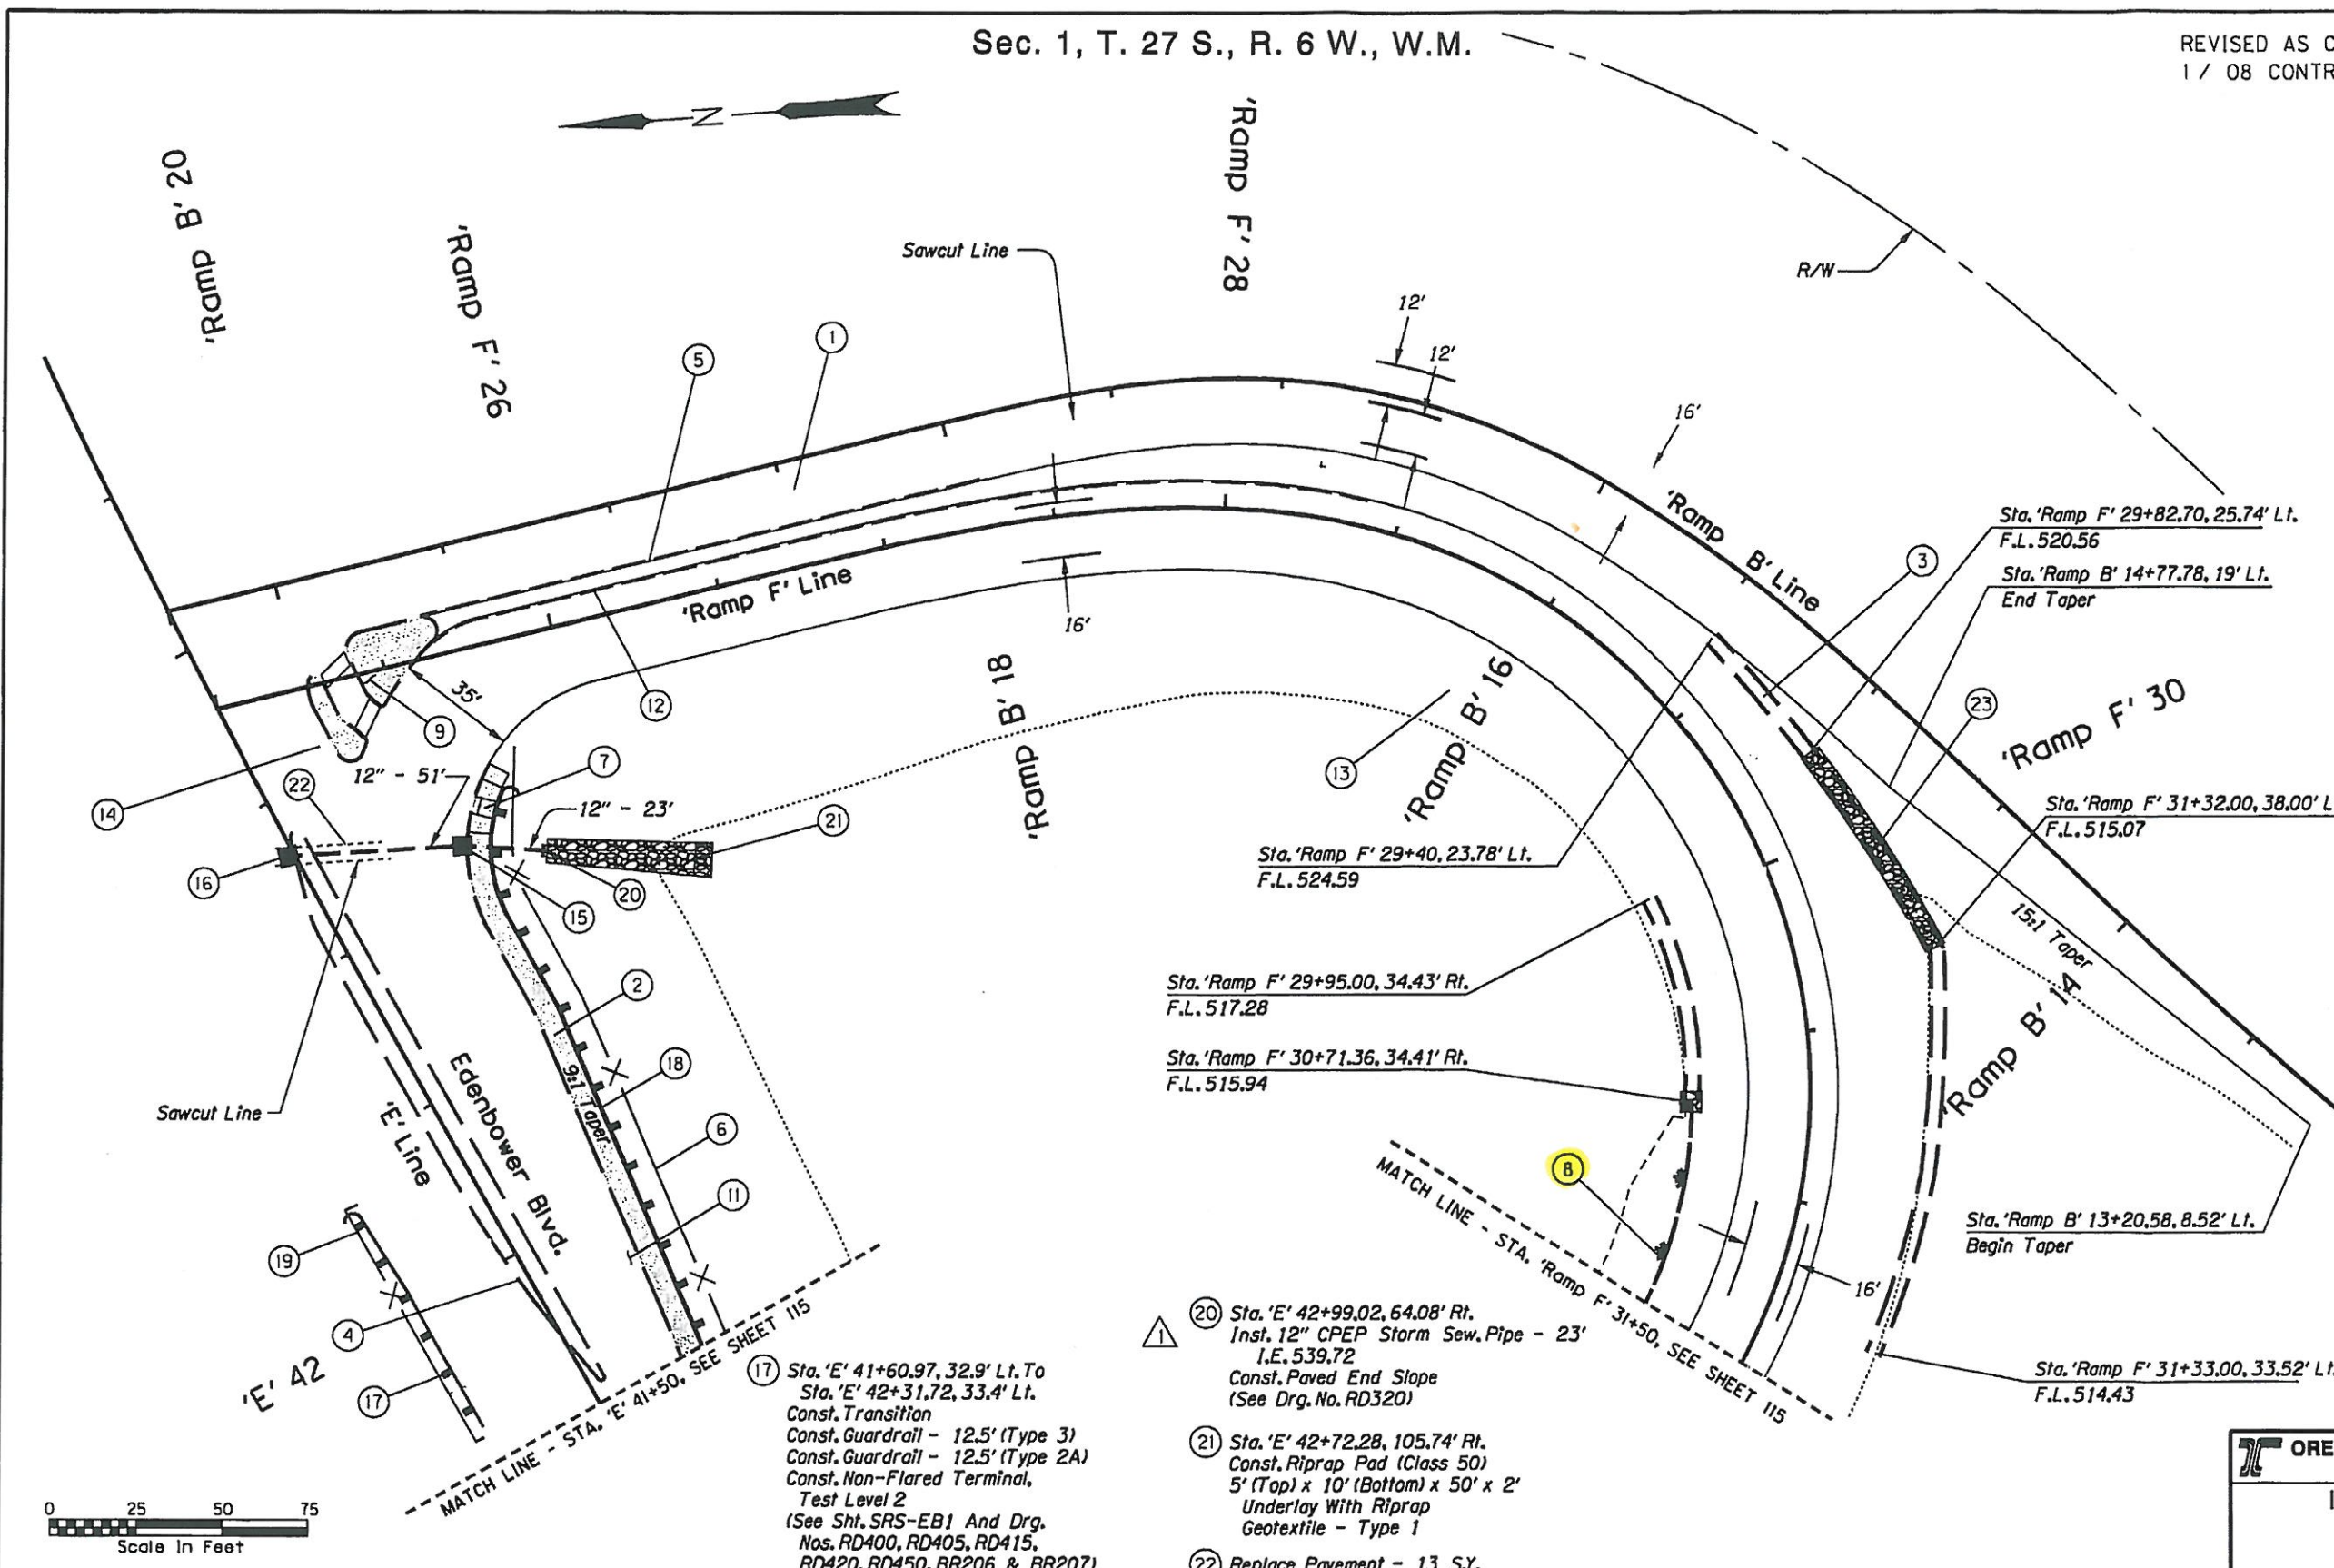

- ① Remove Existing Guardrail - 427'
- ② Remove Existing Fence - 290'
- ③ Const. Ditch
"V" Bottom, 3:1 Slopes
- ④ Sta. 'E' 41+55.50 To Sta. 'E' 43+49.50
Const. Type CA Island With
Mountable Curb - 393'
(See Sht. 2A-38 & Std. Drg. No. RD705)
- ⑤ Sta. 'Ramp B' 17+91.00, Lt. To
Sta. 'Ramp B' 19+64.15, Lt.
Const. Mountable Curb
Low Profile
(See Std. Drg. No. RD700)
- ⑥ Const. CL-4 Fence - 199'
Connect To Existing
(See Drg. No. RD810)
- ⑦ Const. Sidewalk Ramp (Parallel)
End Taper
(See Drg. No. RD755)
- ⑧ Const. Bioswale
(See Sht. 115, Note 7)
- ⑨ Const. Raised Right Turn
Cut Through Channelization Island
With Type "C" Curb
(See Sht. 2B-26 And Drg. No. RD710)
- ⑩ Remove Existing Curb And Sidewalk
- ⑪ Sta. 'Ramp F' 25+63.80, Lt. To
Sta. 'Ramp F' 28+40.00, Lt.
Const. Mountable Curb
Low Profile
(See Sht. 2B-26 And Drg. No. RD700)
- ⑫ Remove Existing Survey Monument And
Rebuild Embankment
- ⑬ Cap Inlet And Plug Connecting Pipe
Fill Inlet With Granular MH
(See Drg. No. 376)
- ⑭ Sta. 'E' 43+11.68, 44.13' Rt.
Const. Type "G-2" Inlet
Grate Elev. 543.61±
F.L. 539.96 S (Out)
Inst. 12" Storm Sew. Pipe, CPEP - 51'
I.E. 540.16 N (In)
(See Drg. Nos. RD300 & RD364)
- ⑮ Sta. 'E' 43+33.38, 1.80' Lt.
Const. Type "G-2" Inlet
Grate Elev. 545.62±
F.L. 542.12
(See Drg. No. RD364)

- ⑰ Sta. 'E' 41+60.97, 32.9' Lt. To
Sta. 'E' 42+31.72, 33.4' Lt.
Const. Transition
Const. Guardrail - 12.5' (Type 3)
Const. Guardrail - 12.5' (Type 2A)
Const. Non-Flared Terminal,
Test Level 2
(See Sht. SRS-EB1 And Drg.
Nos. RD400, RD405, RD415,
RD420, RD450, BR206 & BR207)
- ⑱ Const. Guardrail
(See Sht. 115, Note 17)
- ⑲ Remove And Install CL-4 Fence - 84.5'
Connect To Existing (See Drg. No. RD700)
- ⑳ Sta. 'E' 42+99.02, 64.08' Rt.
Inst. 12" CPEP Storm Sew. Pipe - 23'
I.E. 539.72
Const. Paved End Slope
(See Drg. No. RD320)
- ㉑ Sta. 'E' 42+72.28, 105.74' Rt.
Const. Riprap Pad (Class 50)
5' (Top) x 10' (Bottom) x 50' x 2'
Underlay With Riprap
Geotextile - Type 1
- ㉒ Replace Pavement - 13 S.Y.
(See Drg. No. RD302)
- ㉓ Sta. 'Ramp F' 29+78.28, 26.27' Lt.
Sta. 'Ramp F' 30+34.22, 37.80' Lt.
Const. Riprap Pad
(Class 50) - 6' x 68' x 2'
Underlay with Riprap
Geotextile - Type 1

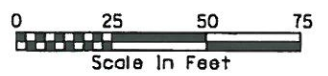

Rev. No.	Date	Revision
2	9/07	As Constructed
1	7/31/07	Revised Guardrail And Island Requirements - NDC 10

OREGON DEPARTMENT OF TRANSPORTATION
 ROADWAY ENGINEERING SECTION

1-5: SUTHERLIN-ROSEBURG SEC.
 DESIGN-BUILD PROJECT


PACIFIC HIGHWAY
 DOUGLAS COUNTY

Reviewed By - Shari Munroe
 Designed By - Andy Kutansky
 Drafted By - Prisciliano Paralta-Ramirez

NORTH ROSEBURG INTERCHANGE
 ROADWAY PLAN
 'RAMP B' & 'RAMP F'

SHEET NO. **116**

Sec. 1, T. 27 S., R. 6 W., W.M.

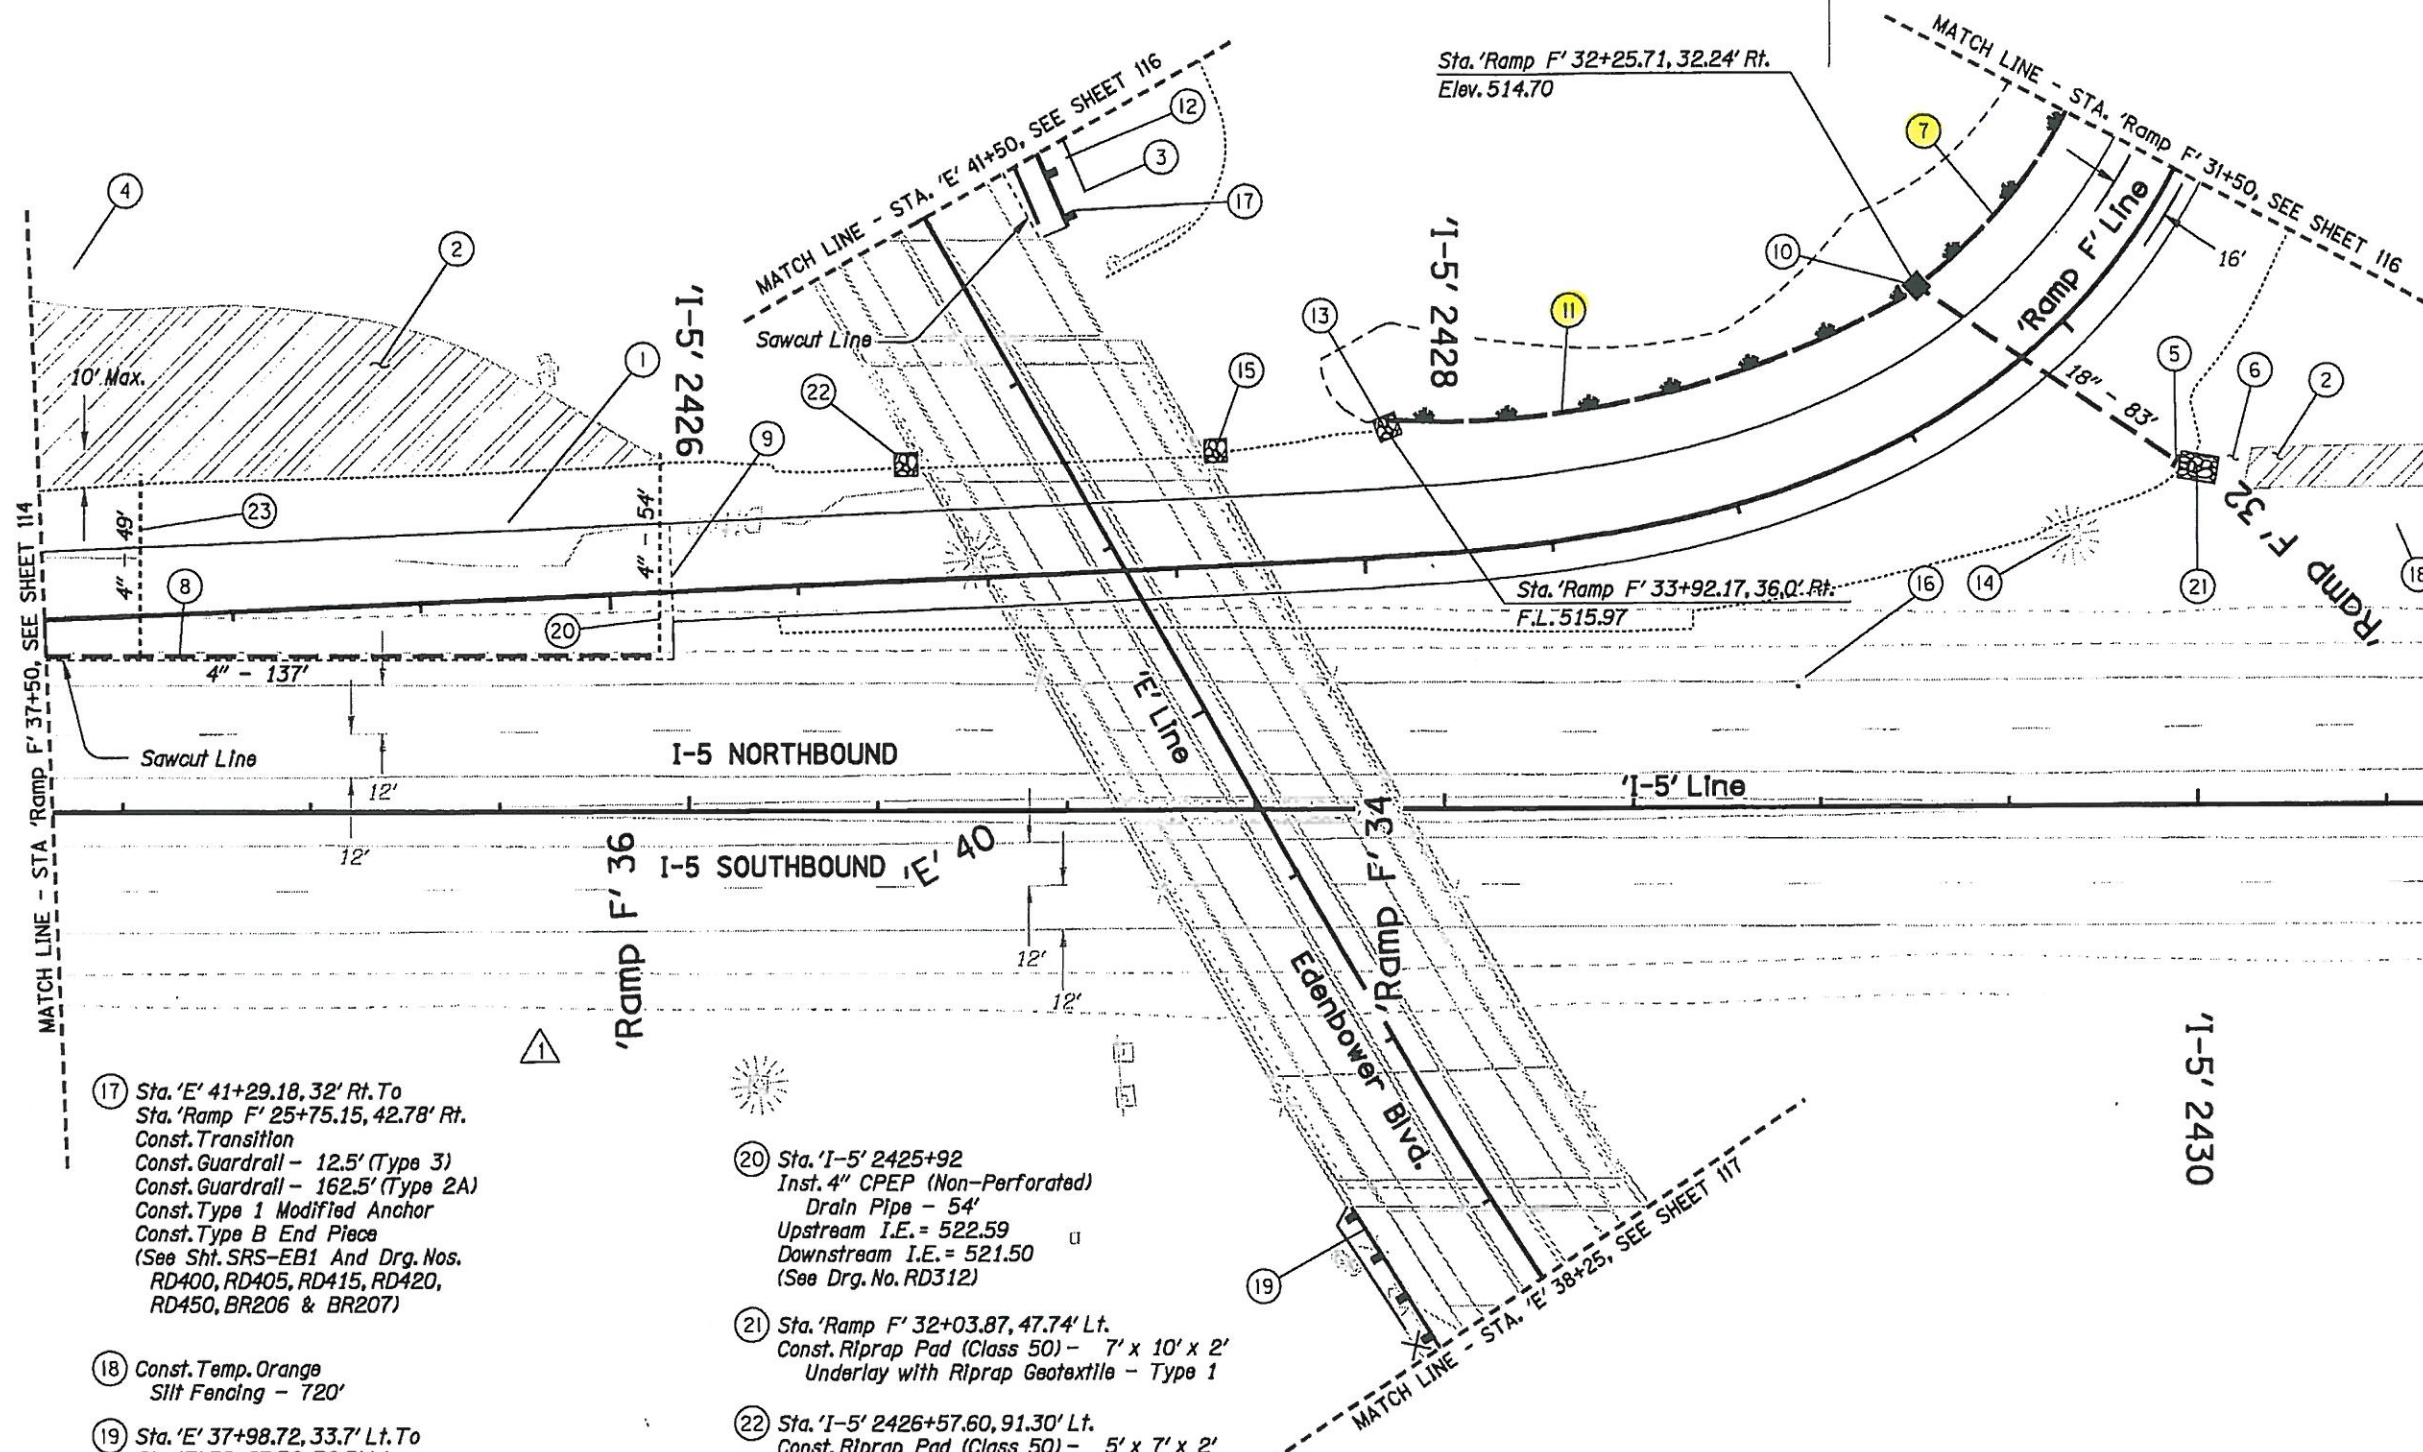

- ① Remove Existing Luminaire (For Details, See Sht. I-013)
- ② Protect Existing Wetlands And Waters Per Wetland Removal/Fill Permits
- ③ Tie Into Existing Fence
- ④ Const. Temp. Orange Silt Fencing - 871'
- ⑤ Sta. 'Ramp F' 32+03.87, 47.74' Lt. Inst. 18" CPEP Culv. Pipe - 83' I.E. 508.82 Const. Paved End Slope (See Drg. No. RD320)
- ⑥ Minimize Temp. Wetland Impacts, And Restore Impacted Wetlands Per Wetland Removal/Fill Permits Upon Completion Of Work
- ⑦ Const. Blowwale - 125' At 1.0% Grade (For Details, See Sht. 2B-20)
- ⑧ Const. Subgrade Drain (See Sht. 114, Note 9)
- ⑨ Sta. 'Ramp F' 35+83.45, 8' Lt to 18' Rt. End Dense HMAC Paving Begin Open Graded HMAC Paving
- ⑩ Sta. 'Ramp F' 32+25.71, 32.24' Rt. Const. Type "G-2" Inlet Grate Elev. 514.70 F.L. 509.65 (See Drg. No. 364)
- ⑪ Const. Blowwale - 145' At 0.85% Grade (For Details, See Sht. 2B-20)
- ⑫ Remove Existing Fence - 290' (See Sht. 116, Note 2)
- ⑬ Const. Riprap Pad (Class 50) - 5' x 7' x 2' Underlay with Riprap Geotextile - Type 1
- ⑭ Protect Existing Luminaire - 1
- ⑮ Sta. 'I-5' 2427+39.00, 94.90' Lt. Const. Riprap Pad (Class 50) - 5' x 7' x 2' Underlay with Riprap Geotextile - Type 1
- ⑯ Sta. 'I-5' 2428+95.88, 34.3' Lt. End Rumble Strips (See Interstate Maint. Plans)

- ⑰ Sta. 'E' 41+29.18, 32' Rt. To Sta. 'Ramp F' 25+75.15, 42.78' Rt. Const. Transition Const. Guardrail - 12.5' (Type 3) Const. Guardrail - 162.5' (Type 2A) Const. Type 1 Modified Anchor Const. Type B End Piece (See Sht. SRS-EB1 And Drg. Nos. RD400, RD405, RD415, RD420, RD450, BR206 & BR207)
- ⑱ Const. Temp. Orange Silt Fencing - 720'
- ⑲ Sta. 'E' 37+98.72, 33.7' Lt. To Sta. 'E' 38+67.32, 32.5' Lt. Const. Transition Const. Guardrail - 12.5' (Type 3) Const. Non-Flared Terminal, Test Level 2 (See Sht. SRS-EB1 And Drg. Nos. RD400, RD405, RD415, RD420, RD450, BR206 & BR207)

- ⑳ Sta. 'I-5' 2425+92 Inst. 4" CPEP (Non-Perforated) Drain Pipe - 54' Upstream I.E. = 522.59 Downstream I.E. = 521.50 (See Drg. No. RD312)
- ㉑ Sta. 'Ramp F' 32+03.87, 47.74' Lt. Const. Riprap Pad (Class 50) - 7' x 10' x 2' Underlay with Riprap Geotextile - Type 1
- ㉒ Sta. 'I-5' 2426+57.60, 91.30' Lt. Const. Riprap Pad (Class 50) - 5' x 7' x 2' Underlay with Riprap Geotextile - Type 1
- ㉓ Sta. 'I-5' 2424+54.60 Inst. 4" CPEP (Non-Perforated) Drain Pipe - 49' Upstream I.E. = 526.41 Downstream I.E. = 525.43 (See Drg. No. RD312)


OREGON DEPARTMENT OF TRANSPORTATION
ROADWAY ENGINEERING SECTION

I-5: SUTHERLIN-ROSEBURG SEC.
DESIGN-BUILD PROJECT
PACIFIC HIGHWAY
DOUGLAS COUNTY

Reviewed By - Sharl Munroe
Designed By - Andy Kutansky
Drafted By - Prisciliano Peralta-Ramirez

NORTH ROSEBURG INTERCHANGE
ROADWAY PLAN
STA. 'Ramp F' 31+50 TO STA. 'Ramp F' 37+50

SHEET NO. **115**

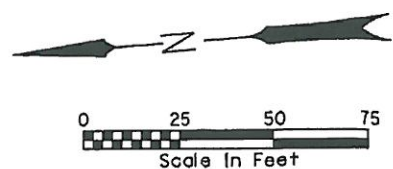

Rev. No.	Date	Revision
②	10/08	As Constructed
①	7/31/07	Revised Guardrail Requirements - NDC 10