

OPERATION & MAINTENANCE MANUAL

DFI No.: D00393

**Facility Type: Water Quality Biofiltration
Swale**



MARCH, 2011

1. Identification

Drainage Facility ID (DFI): **D00393**
Facility Type: Water Quality Biofiltration Swale
Construction Drawings: (V-File Number) 38V-055
Location: District: 7
Highway No.: 001
Mile Post: 136.51 / 136.53 (beg./end)
Description: This facility is located in the gore area between the northbound lanes of I-5 (Hwy 001, Pacific Highway) and the northbound Exit 136 off ramp. Access can be obtained from the Exit 136 northbound off ramp.

2. Facility Contact Information

Contact the Engineer of Record, Region Technical Center, or Geo-Environmental's Senior Hydraulics Engineer for:

- Operational clarification
- Maintenance clarification
- Repair or restoration assistance

Engineering Contacts:

Region Technical Center Hydraulics Engineer (541) 957-3693

Or

Geo-Environmental Senior Hydraulics Engineer (503) 986-3365.

3. Construction

Engineer of Record: ODOT Designer – Region 3 Tech. Center, James Bauman, 541-957-3573

Facility construction: 2007
Contractor: CH2M Hill, Inc., (Design – Build)

4. Storm Drain System and Facility Overview

A water quality swale is a flat-bottomed open channel designed to treat stormwater runoff from highway pavement areas. This type of facility is lined with grass. Treatment by trapping sedimentation occurs when stormwater runoff flows through the grass.

Stormwater is conveyed to the facility by a 15-inch storm pipe in addition to sheet flow that collects water from the Exit 136 northbound off ramp and the northbound travel lanes of I-5. Refer to the Operational Plan in Appendix A for further information. Water conveyed into the swale undergoes treatment as it flows through the length of the channel. The treated water flows out of the swale and into a Type-D inlet; the facility's outlet control structure. The Type-D inlet connects to a 12-inch storm sewer system that flows along OR138 towards the west.

A. Maintenance equipment access:

Maintenance crew can access the facility from the Exit 136 northbound off ramp.

B. Heavy equipment access into facility:

- Allowed (no limitations)
- Allowed (with limitations)
- Not allowed

C. Special Features:

- Amended Soils
- Porous Pavers
- Liners
- Underdrains



Photo 1: Looking south, flow into the swale is generated from a 15-inch storm pipe and sheet flow originating from the northbound travel lanes of I-5 and the Exit 136 northbound offramp. Water is flowing towards the bottom of the picture.



Photo 2: Looking north, flow from the swale is collected in the Type -D inlet/outlet control structure shown.



Photo 3: Looking north. The 15-inch culvert, located at the bottom of the picture, contributes flow at the facility inlet. Sheet flow from I-5 Northbound travel lanes and the Exit 136 northbound off ramp also contribute flow. Water is flowing towards the top of the picture.

5. Facility Haz Mat Spill Feature(s)

The water quality biofiltration swale can be used to store a volume of liquid by blocking the 12-inch diameter outlet pipe located at the outlet of the swale. This pipe is part of the outlet control structure shown in Photos 1 and 2. Blocking the Type-D inlet/outlet with sandbags or a steel plate may also be considered here.

6. Auxiliary Outlet (High Flow Bypass)

Auxiliary Outlets are provided if the primary outlet control structure can not safely pass the projected high flows. Broad-crested spillway weirs and over flow risers are the two most common auxiliary outlets used in stormwater treatment facility design. The auxiliary outlet feature is either a part of the facility or an additional storm drain feature/structure.

The auxiliary outlet feature for this facility is:

- Designed into facility
- Other, as noted below
There is no auxiliary outlet for this facility.

7. Maintenance Requirements

Routine maintenance table for non-proprietary stormwater treatment and storage/detention facilities have been incorporated into ODOT's Maintenance Guide. These tables summarize the maintenance requirements for ponds, swales, filter strips, bioslopes, and detention tanks and vaults. Special maintenance requirements in addition to the routine requirements are noted below when applicable.

The ODOT Maintenance Guide can be viewed at the following website:

<http://www.oregon.gov/ODOT/HWY/OOM/MGuide.shtml>

Maintenance requirements for proprietary structures, such as underground water quality manholes and/or vaults with filter media are noted in Appendix C when applicable.

The following stormwater facility maintenance table (See ODOT Maintenance Guide) should be used to maintain the facility outlined in this Operation and Maintenance Manual or follow the Maintenance requirements outlined in Appendix C when proprietary structure is selected below:

- Table 1 (general maintenance)
- Table 2 (stormwater ponds)
- Table 3 (water quality biofiltration swales)
- Table 4 (water quality filter strips)
- Table 5 (water quality bioslopes)
- Table 6 (detention tank)
- Table 7 (detention vault)
- Appendix C (proprietary structure)

Special Maintenance requirements:
Note: Special maintenance Requirements Require Concurrence from
ODOT SR Hydraulics Engineer.

8. Waste Material Handling

Material removed from the facility is defined as waste by DEQ. Refer to the roadwaste section of the ODOT Maintenance Yard Environmental Management System (EMS) Policy and Procedures Manual for disposal options: <http://egov.oregon.gov/ODOT/HWY/OOM/EMS.shtml>


Contact any of the following for more detailed information about management of waste materials found on site:

| | |
|-----------------------------------|----------------|
| ODOT Clean Water Unit | (503) 986-3008 |
| ODOT Statewide Hazmat Coordinator | (503) 229-5129 |
| ODOT Region Hazmat Coordinator | (541) 957-3594 |
| ODEQ Northwest Region Office | (503) 229-5263 |


Appendix A

Content:

- **Operational Plan and Profile Drawing(s)**

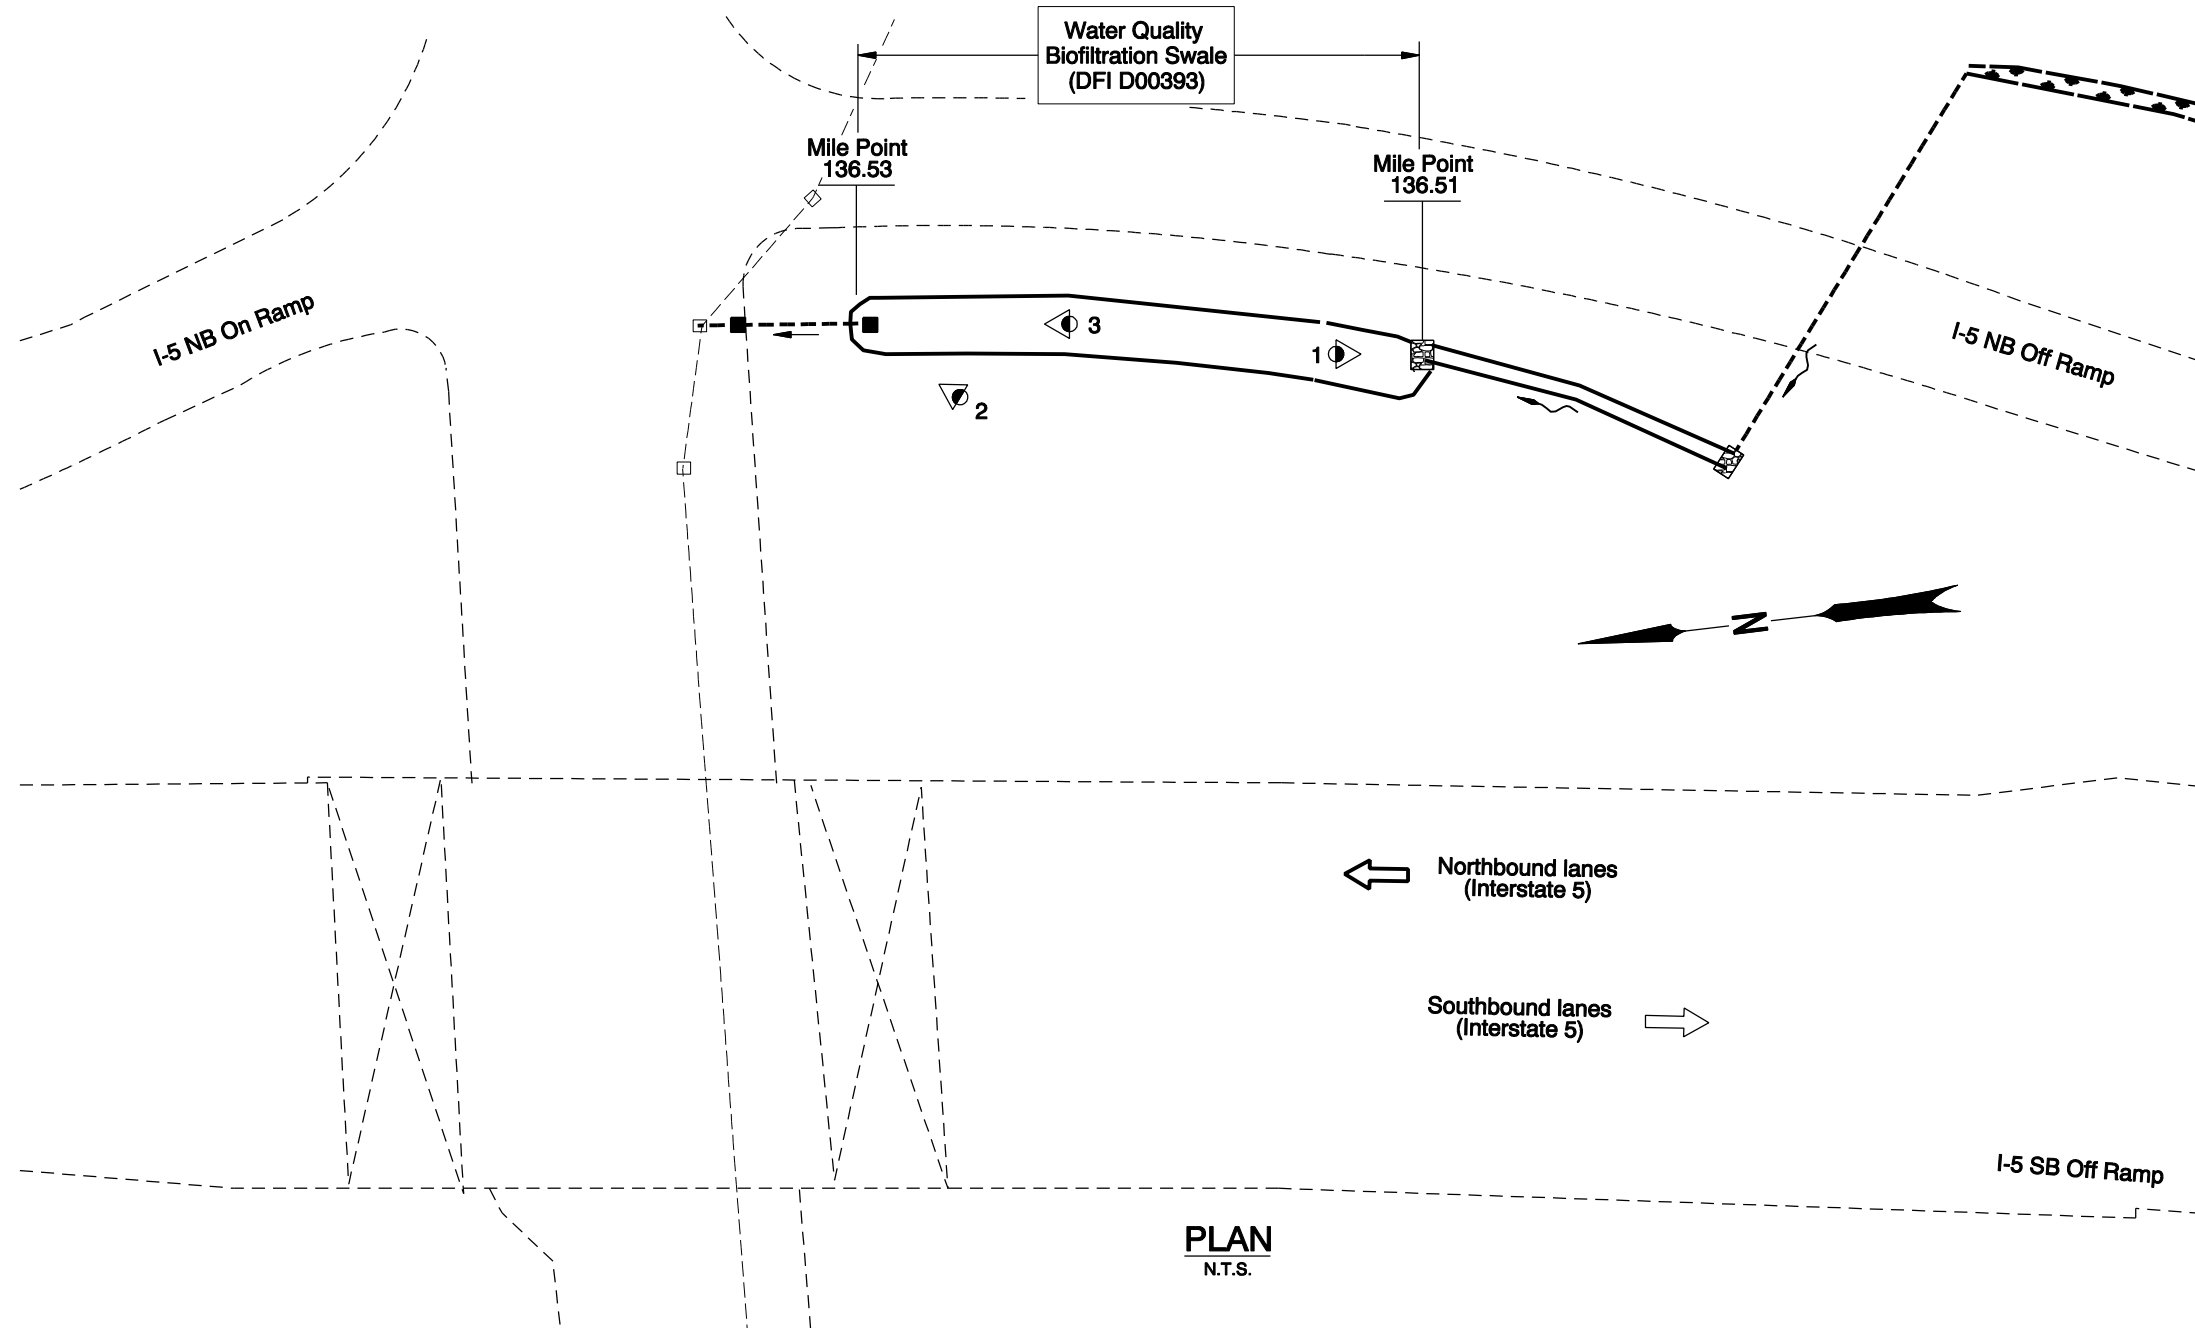

PLAN
N.T.S.

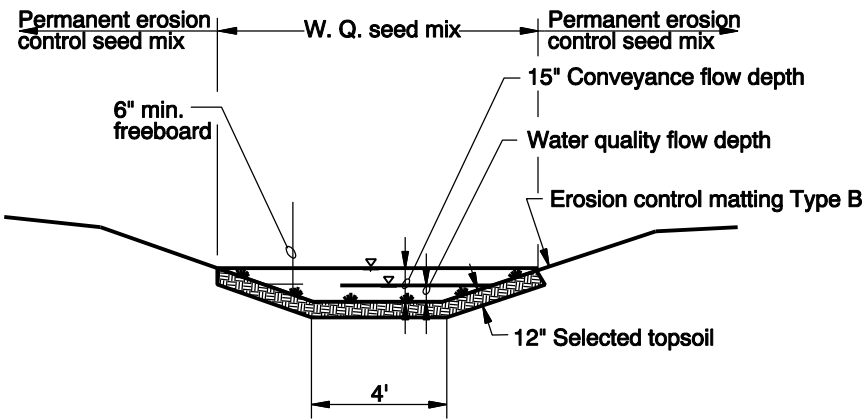

BIOSWALE SECTION
N.T.S.

- LEGEND:**
- ◁ Photo Location / Direction
 - and □ Inlet
 - Storm Pipe (Facility)
 - - - Storm Pipe
 - ← Conveyance Direction
 - ~ Pavement / Facility Flow Path

Prepared By: J. Carpenter
 Drafted By: B. Shafer

OREGON DEPARTMENT OF TRANSPORTATION

DFI D00393
MAINTENANCE DISTRICT 7 HWY 001
WATER QUALITY BIOFILTRATION SWALE
 PACIFIC HIGHWAY MP 136.51/136.53
 DOUGLAS COUNTY

Appendix B

Content:


- **ODOT Project Plan Sheets**
 - *Cover/Title Sheet*
 - *Water Quality/Detention Plan Sheets*
 - *Other Details*

STATE OF OREGON
DEPARTMENT OF TRANSPORTATION

PLANS FOR PROPOSED PROJECT
GRADING, DRAINAGE, STRUCTURE AND PAVING
I-5: SUTHERLIN - ROSEBURG SEC.
DESIGN-BUILD PROJECT

PACIFIC HIGHWAY
DOUGLAS COUNTY

MAY 2007

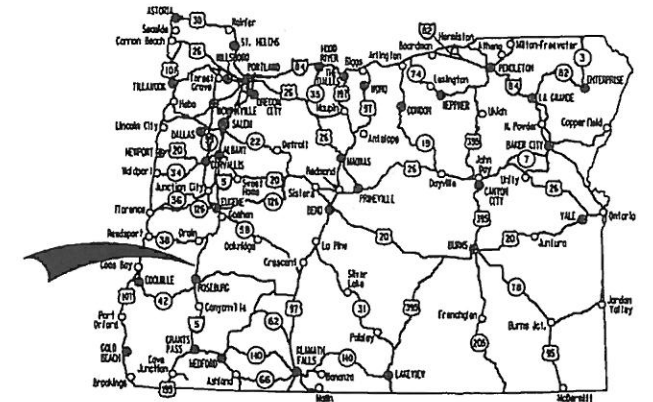


Overall Length Of Project - 13.33 Miles

ATTENTION:
Oregon Law Requires You To Follow Rules Adapted By The Oregon Utility Notification Center. Those Rules Are Set Forth In OAR 952-001-0010 Through OAR 952-001-0090. You May Obtain Copies Of The Rules By Calling The Center. (Note: The Telephone Number For The Oregon Utility Center Is (503) 232-1987.)

- BR140 Expansion Joint with Compression Seal or Paired Sealant
- BR145 Single Strip Seal Expansion Joint
- BR155 Bridge Joint Details (Joints A through F)
- BR203 Transition Concrete Bridge Rail to Guardrail
- BR236 Trailing End Br. Connection Concrete Rail to Guardrail
- BR240 Protective Fencing
- BR241 Protective Fencing
- BR350 Temporary Diaphragm Beam for Prestressed Concrete Beams
- RD300 Trench Backfill, Bedding, Pipe Zone and Multiple Installations
- RD302 Street Cut
- RD312 Subsurface Drain
- RD314 Open Grade HMAC Drainage Details
- RD318 Sloped Ends For Concrete Pipe
- RD320 Paved End, Slope For Culverts
- RD336 Standard Storm Sewer Manhole
- RD348 Manhole With Inlet
- RD356 Manhole Covers And Frames
- RD364 Concrete Inlets Types G-1, G-2 & G-2M
- RD368 Concrete Inlets, Type ME, M-O, And B-SL
- RD370 Ditch Inlet, Type D
- RD374 Area Drainage Basin or Field Inlet
- RD376 Miscellaneous Drainage Structures, Siphon Box and Inlet Adj. Cap
- RD386 Circular Concrete Pipe Fill Height Table
- RD400 Guardrail And Metal Median Barrier
- RD405 Guardrail And Metal Median Barrier Parts
- RD410 Guardrail Parts (Thrie Beam)
- RD415 Guardrail And Metal Median Barrier Parts
- RD425 2'6" - 4'0" Flared Terminal
- RD440 Guardrail Installation At Bridge Ends
- RD450 Guardrail Anchors (Steel)
- RD500 Precast Concrete Barrier Pin And Loop Assembly
- RD530 Guardrail Connection To Concrete Barrier
- RD545 Precast Tall (42") Concrete Barrier
- RD550 Cast In Place Tall Concrete Barrier Transition To Bridge Rail
- RD560 Cast In Place Tall Barrier Transition To Standard Concrete Barrier
- RD610 Asphalt Pavement Details
- RD700 Curbs
- RD720 Sidewalks
- RD755 Sidewalk Ramp Details
- RD760 Sidewalk Ramp Placement
- RD800 Traffic Delineators
- RD805 Traffic Delineator Installations
- RD810 Barbed And Woven Wire Fences
- RD900 Traffic Control Plans (Details)
- RD905 Traffic Control Plans (Intersection Details)
- RD906 Traffic Control Plans (Signalized Intersection Details)
- RD907 Traffic Control Plans (Multi-Lane Signalized Intersection Details)
- RD910 Traffic Control Plans (2-Lane, 2-Way and 3-Lane, 2-Way Roadways)
- RD915 Traffic Control Plans (Non-Freeway, Multi-Lane Sections)
- RD920 Traffic Control Plans (Freeway Section)
- RD925 Traffic Control Plans (Freeway Section)
- RD930 Traffic Control Plans (Freeway Section)
- RD945 Traffic Control Plans (Details)
- RD950 Barricades
- RD955 Temporary Impact Attenuators
- RD960 Temporary Impact Attenuators
- RD1005 Check Dams
- RD1010 Inlet Protection (Type 1, 2, & 3)
- RD1040 Sediment Fence, Supported Sediment Fence, Unsupported
- TM100 Temporary Wood Post Sizing Chart
- TM105 Orange Flag Board Mounting Details
- TM200 Sign Installation Details
- TM201 Sign Installation Details for Secondary Signs
- TM205 Aluminum Panels And Installation
- TM206 Sign Bracing Details Sign Mountain Details
- TM207 Additional Mountain Details
- TM211 Sign Details US And Interstate Route Shields
- TM212 Signing Details Oregon Route Shields

BEGINNING OF PROJECT

M.P. 138.71

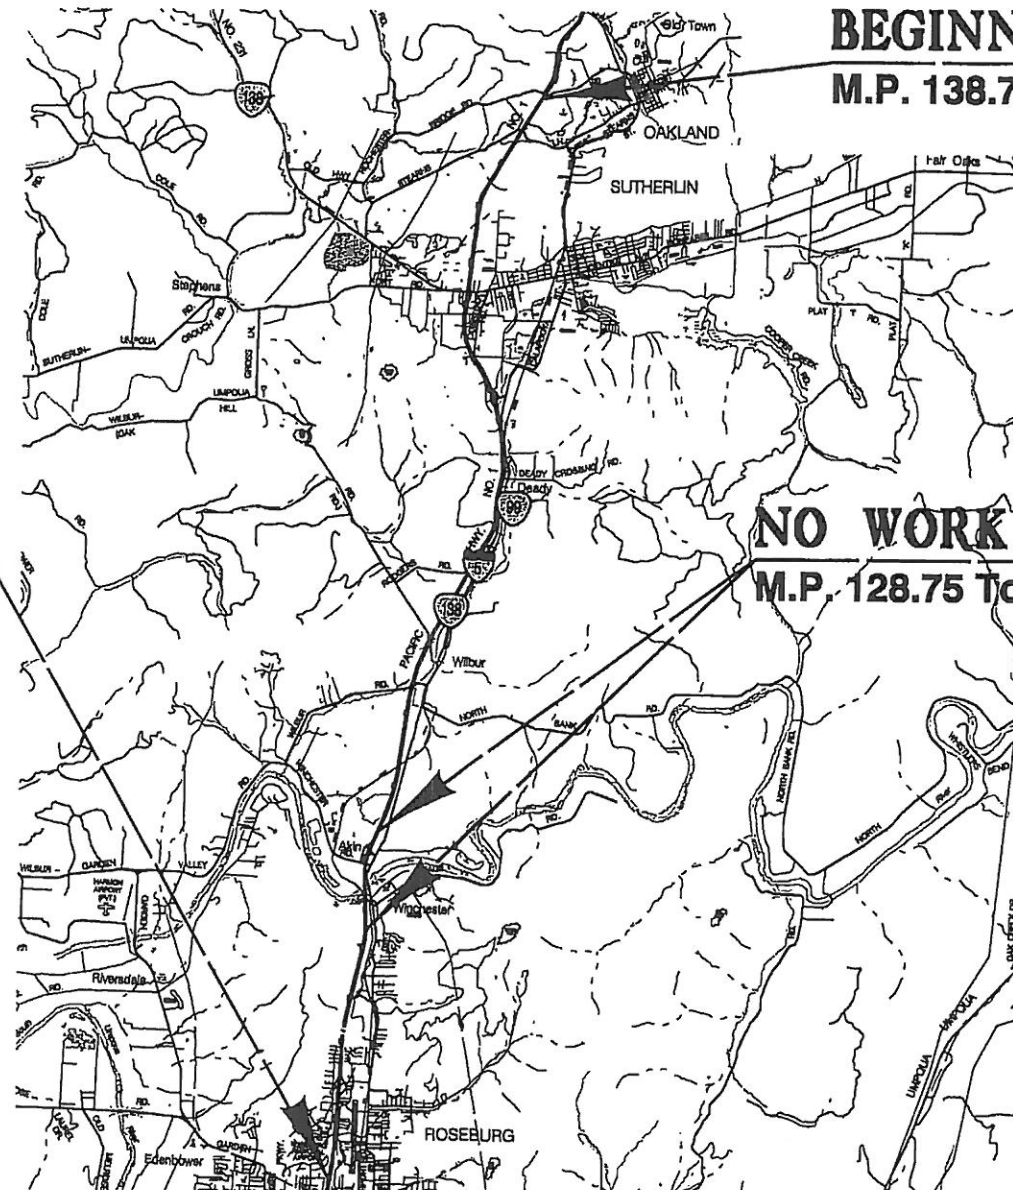

END OF PROJECT

M.P. 125.38

NO WORK ZONE

M.P. 128.75 To M.P. 129.80

REVISED AS CONSTRUCTED
5/06 CONTRACT 13070
DESIGN MGR. James Bauman



OREGON TRANSPORTATION COMMISSION

- Stuart Foster CHAIRMAN
- Gail L. Achterman COMMISSIONER
- Mike Nelson COMMISSIONER
- Randall Pape COMMISSIONER
- Janice J. Wilson COMMISSIONER
- Matt Garrett DIRECTOR OF TRANSPORTATION

PLANS PREPARED FOR
ODOT

BY:
CH2MHILL



EXPIRES: 12/31/07

OREGON DEPARTMENT OF TRANSPORTATION CONCURRENCE


TECHNICAL SERVICES MANAGING ENGINEER _____ DATE _____

I-5: SUTHERLIN-ROSEBURG SEC.
DESIGN-BUILD PROJECT
PACIFIC HIGHWAY
DOUGLAS COUNTY

| | | |
|--------------------------------|-------------------|-----------|
| FEDERAL HIGHWAY ADMINISTRATION | PROJECT NUMBER | SHEET NO. |
| OREGON DIVISION | OTIA-IM-S001(192) | 1 |

Note: See Sht. 1A For Additional Standard Drawings

| Rev. No. | Date | Revision |
|----------|----------|----------------|
| 1 | 11/21/06 | As Constructed |

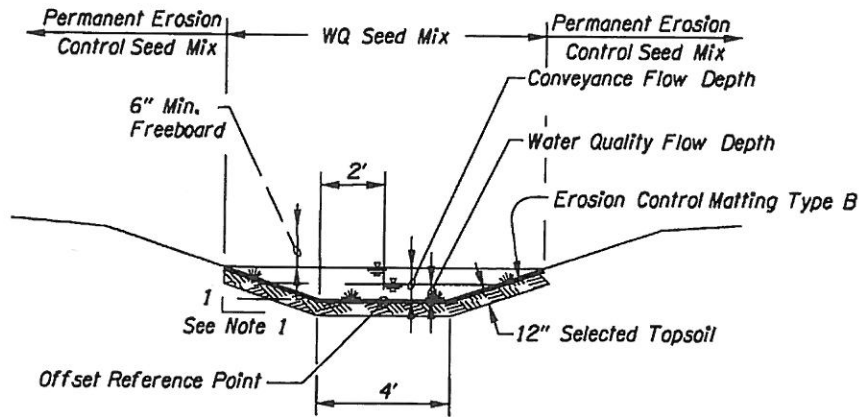


Notes:

1. Sideslopes In The Water Quality Section Of The Swale Shall Be 4H:1V Maximum. Sideslopes Above The Water Quality Flow Depth Shall Match Roadway Embankment Slopes.
2. Erosion Control Matting Materials And Installation Per ODOT Std. Spec. Section 280.




BIOSWALE SECTION - TYPICAL

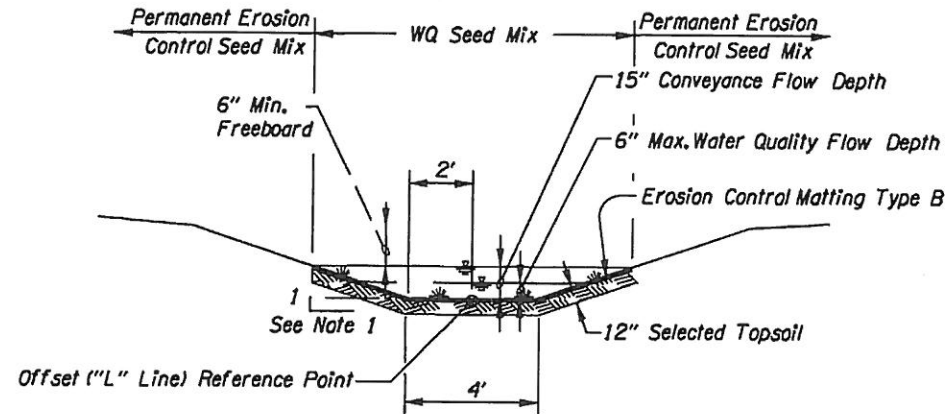

Notes:

1. Sideslopes In The Water Quality Section Of The Swale Shall Be 4H:1V Maximum. Sideslopes Above The Water Quality Flow Depth Shall Match Roadway Embankment Slopes.
2. Erosion Control Matting Materials And Installation Per ODOT Std. Spec. Section 280.

BIOSWALE SECTION - SUTHERLIN INTERCHANGE

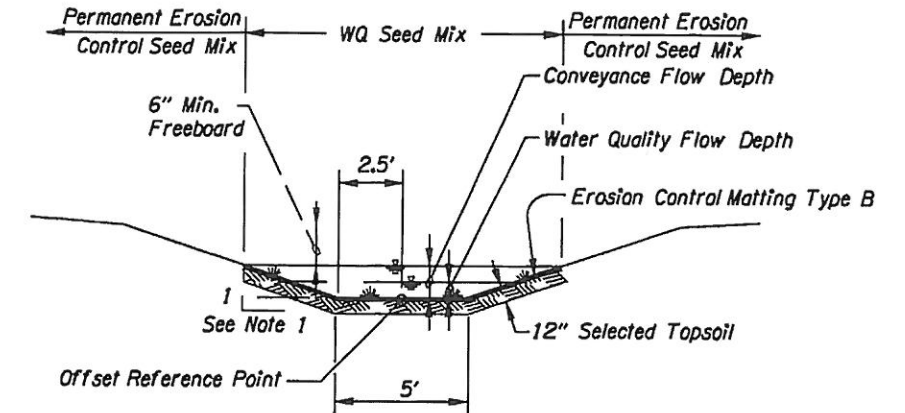

Notes:


1. Sideslopes In The Water Quality Section Of The Swale Shall Be 4H:1V Maximum. Sideslopes Above The Water Quality Flow Depth Shall Match Roadway Embankment Slopes.
2. Erosion Control Matting Materials And Installation Per ODOT Std. Spec. Section 280.




BIOSWALE SECTION - NORTH ROSEBURG INTERCHANGE

| Rev. No. | Date | Revision |
|----------|----------|--|
| 3 | 11/21/06 | As Constructed |
| 2 | 2/1/07 | Revision - Addition Of Bioswale Section |
| 1 | 12/9/05 | Revision - Addition Of Non-Specific Bioswale Section |

| | |
|---|---------------------------|
| OREGON DEPARTMENT OF TRANSPORTATION ROADWAY ENGINEERING SECTION | |
| I-5: SUTHERLIN-ROSEBURG SEC. DESIGN-BUILD PROJECT PACIFIC HIGHWAY DOUGLAS COUNTY | |
| Reviewed By - Mark Anderson Designed By - Scott Christopherson Drafted By - Prisciliano Peralta-Ramirez | |
| DRAINAGE DETAILS TYPICAL BIOSWALE SECTION | SHEET NO. 2B-20 |

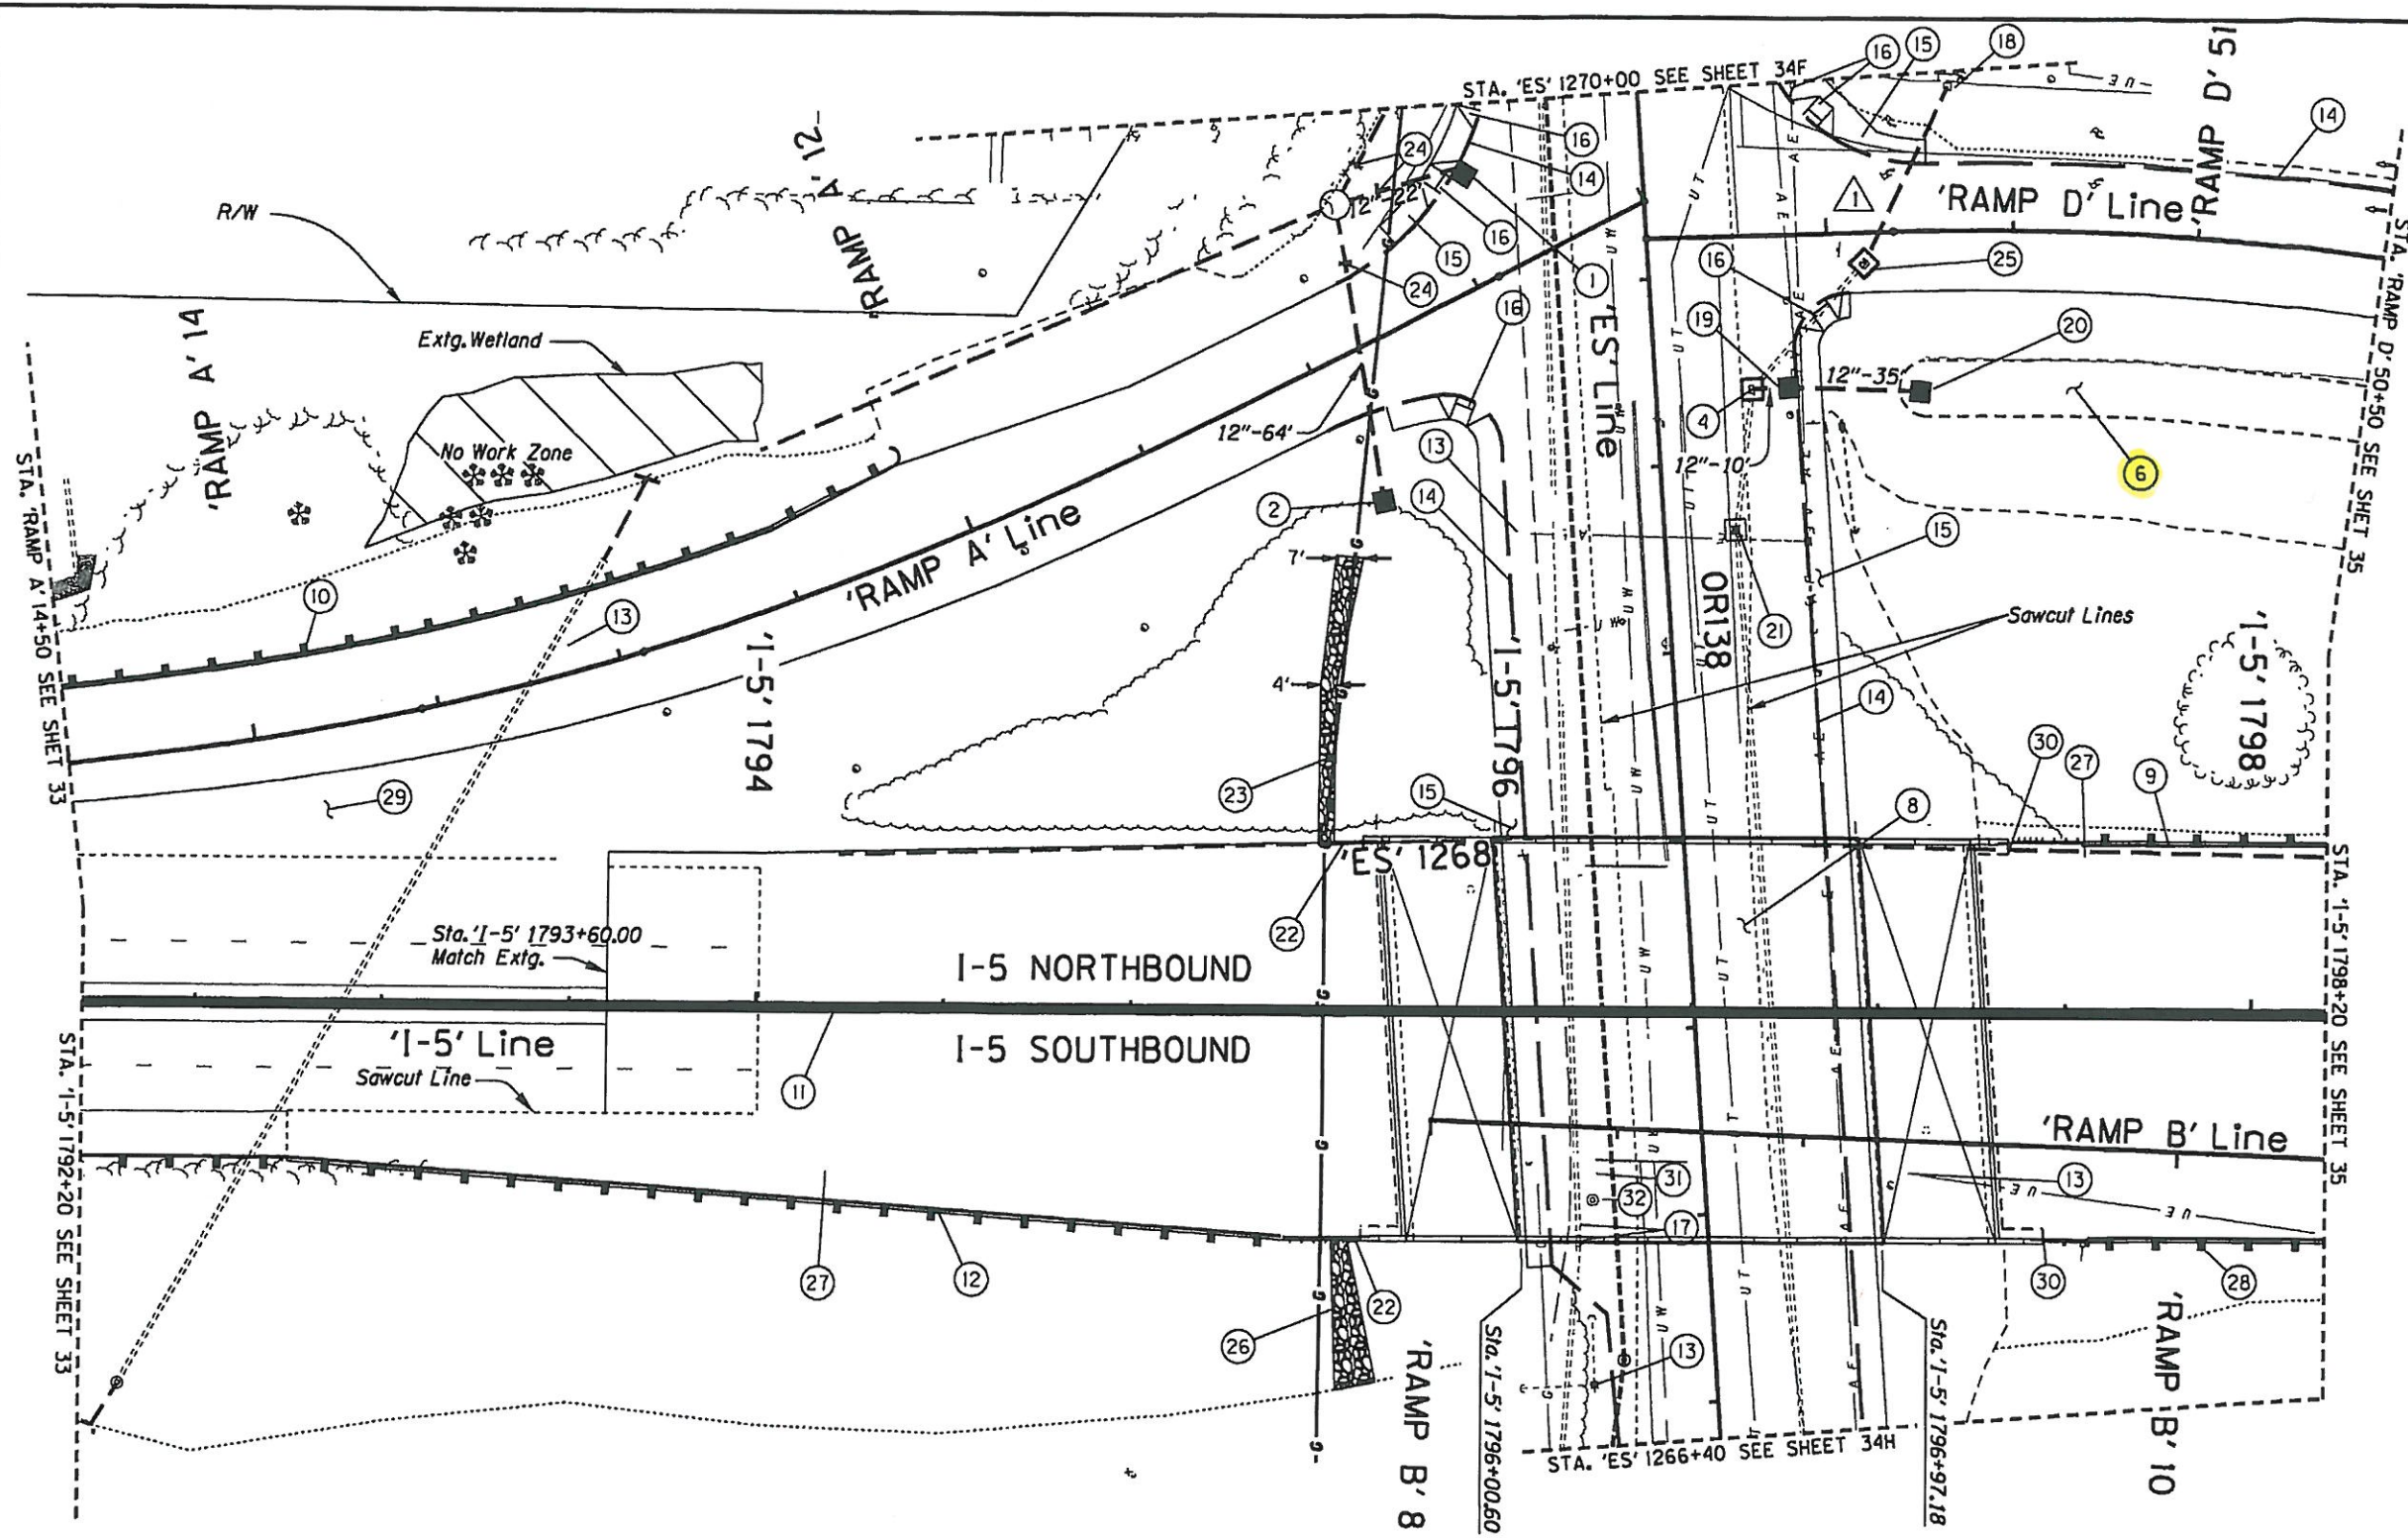



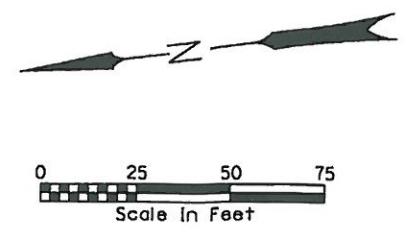

| Rev. No. | Date | Revision |
|----------|----------|----------------|
| 1 | 11/21/06 | As Constructed |
| | | |
| | | |




| | |
|--|------------------------|
| OREGON DEPARTMENT OF TRANSPORTATION ROADWAY ENGINEERING SECTION | |
| I-5: SUTHERLIN-ROSEBURG SEC. DESIGN-BUILD PROJECT PACIFIC HIGHWAY DOUGLAS COUNTY | |
| Reviewed By - Steve Katko Designed By - John Thomas Drafted By - Robert Luke | |
| STA. 'I-5' 1792+20 TO STA. 'I-5' 1798+20 ROADWAY PLAN | SHEET NO. 34 |


- ① Sta. 'ES' 1269+81.36, 47.86' Lt.
Const. Type "G-2" Inlet
Grate Elev. To Match Finished Surface
(See Std. Dwg. No. RD364)
- ② Sta. 'Ramp A' 10+98.00, 39.71' Lt.
Const. Type "D" Inlet
Grate Elev. 487.0±
(See Std. Dwg. No. RD370)
- ③ Note Not Used
- ④ Sta. 'ES' 1268+18.87, 26.06' Rt.
Cap Inlet
Plug and Abandon Extg.
12" RCP Storm Pipe To SE
Inst. 12" CPEP Storm Pipe - 10'
(See Std. Dwg. No. RD376)
- ⑤ Note Not Used
- ⑥ Sta. 'Ramp D' 51+73.00, 42.00' Lt.
I.E. 484.57' To
Sta. 'Ramp D' 50+26.00, 43.30' Lt.
I.E. 485.27'
Const. Water Quality Swale - 140'
At 0.5% Grade
(For Swale Detail, See Sht. 2B-20)
- ⑦ Note Not Used
- ⑧ Bridge No. 07565A
Const. Structure - 96.58'
Roadway Width Varies
And Reinf. Panel At Bridge Ends
(For Details, See Bridge Plans)
- ⑨ Sta. 'I-5' 1797+35.59 To
Sta. 'I-5' 1800+41.35
Const. Flared Terminal
W=4', E=2'
Const. Guardrail (Type 2A) - 237.5'
Const. Guardrail (Type 3) - 12.5'
Const. Guardrail Transition
(See Std. Drgs. BR203, RD400, RD405,
RD415, RD425, RD440)
- ⑩ See Sht. 32, Note 1
Const. Guardrail
- ⑪ See Sht. 32, Note 2
Remove Extg. Conc. Median Barrier
Const. Tall Conc. Median Barrier
(See Drg. No. RD545)
- ⑫ See Sht. 33, Note 3
Const. Guardrail
- ⑬ Remove Extg. Luminaire
- ⑭ Const. Curb
(See Drg. No. RD700)
- ⑮ Const. P.C. Conc. Sidewalk
(See Drg. No. RD720)
- ⑯ Const. Sidewalk Ramp
(See Drg. No. RD755)

- ⑰ Remove Extg. Abandoned Sewer Line
& Manhole
- ⑱ Sta. 'Ramp D' 51+67.34, 38.50' Rt.
Adjust Inlet To Finished Sloped Grade
Replace Extg. Grate W/Type 'B-SL'
(Slope) Inlet Cover 
- ⑲ Sta. 'ES' 1269+18.71, 35.90' Rt.
Const. Type "G-2" Inlet
Grate Elev. 485.9± 
- ⑳ Sta. 'ES' 1269+15.25, 70.76' Rt.
Const. Type "D" Inlet
Grate Elev. 484.57' (Bottom Of 30° Angle)
Inst. 12" CPEP Storm Pipe - 35'
(See Std. Drg. No. RD374) 
- ㉑ Sta. 'ES' 1268+81.71, 19.19' Rt.
Cap Inlet
(See Std. Drg. No. RD376)
- ㉒ Sta. 'I-5' 1795+63.00, 45.00' Lt. To
Sta. 'I-5' 1795+54.00, 45.00' Lt.
Sta. 'I-5' 1795+61.41, 61.20' Rt. To
Sta. 'I-5' 1795+58.36, 61.20' Rt.
Const. Drainage Curb - 12'
(See Std. Drg. No. RD700)
- ㉓ Sta. 'I-5' 1795+52.00, 44.70' Lt. To
Sta. 'I-5' 1795+57.00, 122.00' Lt.
Const. Riprap Pad (Class 50)
4' (Top) x 7' (Bottom) x 77' x 2'
Underlay With Riprap Geotextile - Type 2
- ㉔ Connect To Extg. Stubout
Inst. 12" CPEP Storm Pipe - 22'
Inst. 12" CPEP Storm Pipe - 64'
Inst. 18" CPEP Storm Pipe - 66'
Field Verify Stubout Location
- ㉕ Cap & Cover Existing Inlet. 
- ㉖ Sta. 'I-5' 1795+58.00, 61.20' Rt. To
Sta. 'I-5' 1795+61.00, 100.00' Rt.
Const. Riprap Pad (Class 50)
4' (Top) x 12' (Bottom) x 39' x 2'
Underlay With Riprap Geotextile - Type 2
- ㉗ Remove Extg. Guardrail


- ㉘ Sta. 'I-5' 1797+44.42, Rt. To
Sta. 'I-5' 1800+43.68 Rt.
Const. Guardrail (Type 2A) - 299.4'
Const. Bridgerail To Guardrail Connection
Const. Type 1 Anchor
Const. Type C End Piece
(See Drg. Nos. BR236, RD400, RD405,
RD415, RD450)
- ㉙ See Sht. 33, Note 10
Obliterate Extg. Pvmf.
- ㉚ Const. Pvmf. Drain
(See Drg. No. RD314)
- ㉛ Relocated Sanitary Sewer Line
By Others
- ㉜ Adjust M.H.

| Rev. No. | Date | Revision |
|---|----------|----------------|
|  | 11/21/06 | As Constructed |

| | |
|--|-------------------------|
| OREGON DEPARTMENT OF TRANSPORTATION ROADWAY ENGINEERING SECTION | |
| I-5: SUTHERLIN-ROSEBURG SEC. DESIGN-BUILD PROJECT PACIFIC HIGHWAY DOUGLAS COUNTY | |
| Reviewed By - Steve Katko Designed By - John Thomas Drafted By - Robert Luke | |
| STA. I-5' 1792+20 TO STA. 'I-5' 1798+20 ROADWAY PLAN NOTES | SHEET NO. 34A |

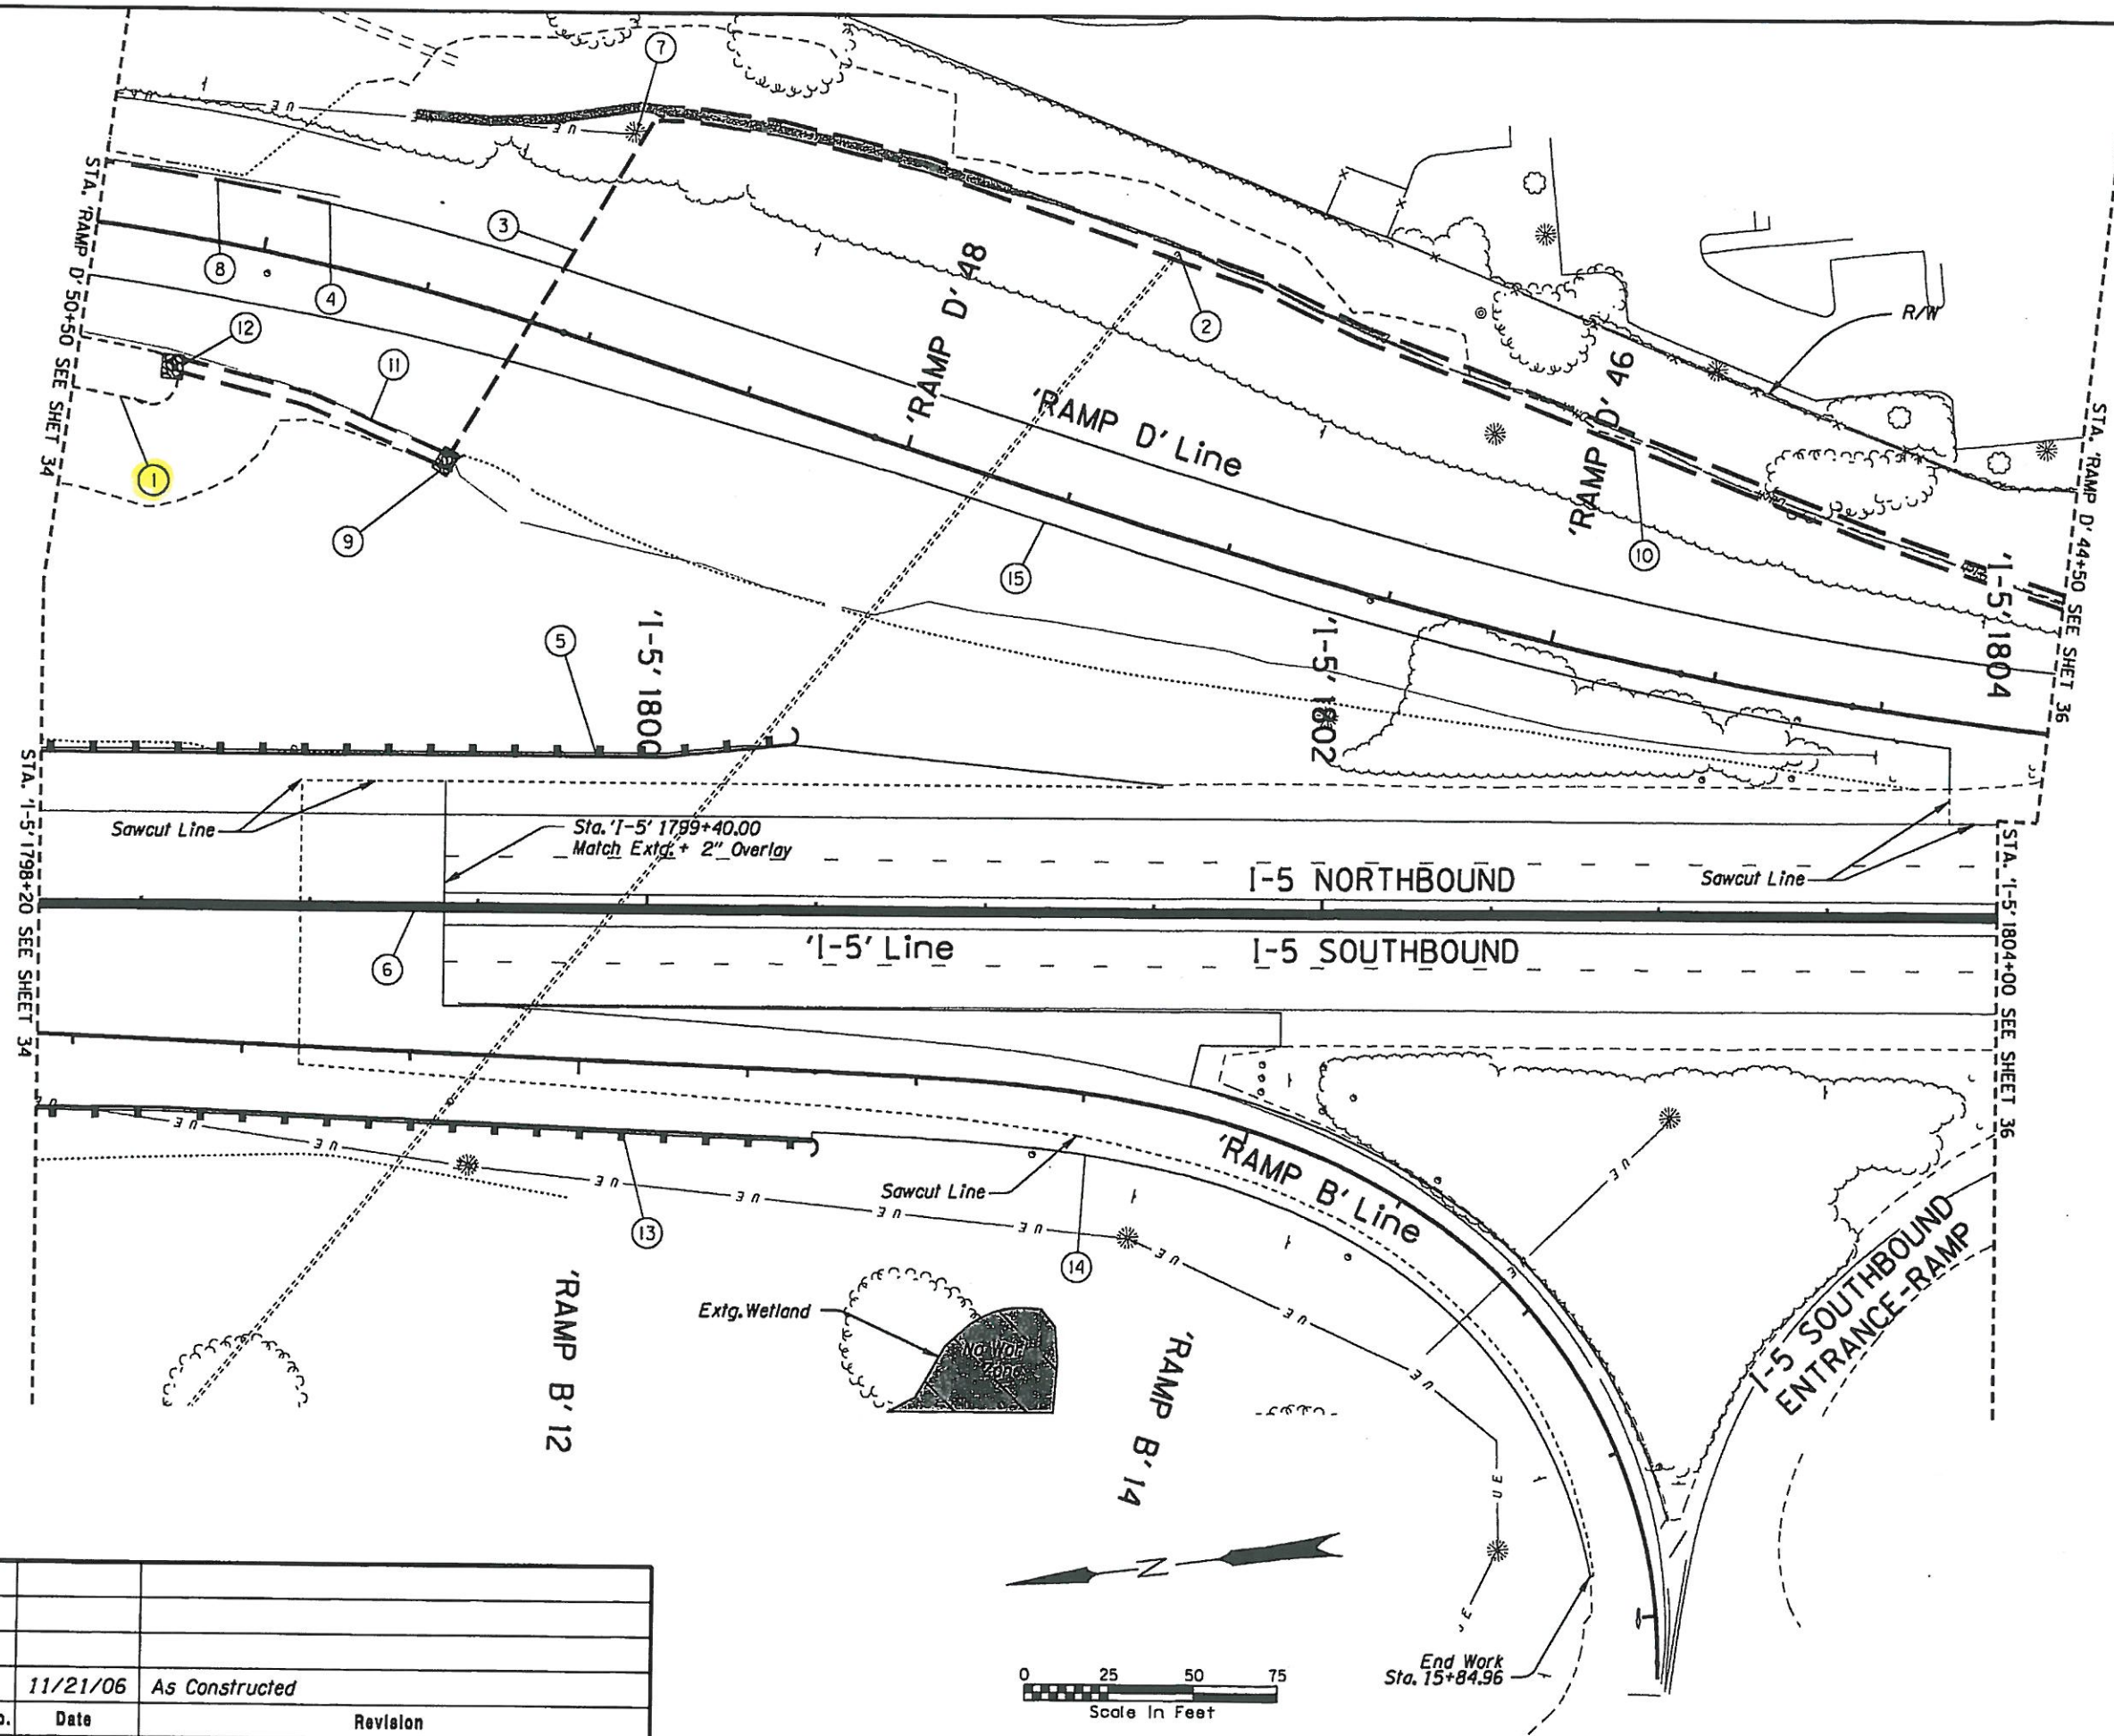


| Rev. No. | Date | Revision |
|----------|----------|----------------|
| 1 | 11/21/06 | As Constructed |

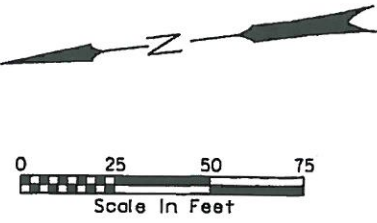

| | |
|--|------------------------|
| OREGON DEPARTMENT OF TRANSPORTATION ROADWAY ENGINEERING SECTION | |
| I-5: SUTHERLIN-ROSEBURG SEC. DESIGN-BUILD PROJECT PACIFIC HIGHWAY DOUGLAS COUNTY | |
| Reviewed By - Steve Katko Designed By - John Thomas Drafted By - Robert Luke | |
| STA. 'I-5' 1798+20 TO STA. 'I-5' 1804+00 ROADWAY PLAN | SHEET NO. 35 |

- ① Const. Water Quality Swale
(See Sht. 34, 34A Note 6)
- ② Sta. 'Ramp D' 47+42.00, 80.0' Rt.
Plug and Abandon Extg.
24" RCP Storm Pipe
Field Verify Pipe Location
- ③ Sta. 'Ramp D' 49+00, 69.0' Rt.
Sta. 'Ramp D' 49+30, 45' Lt.
Inst. 15" CPEP Storm Culvert - 120'
- ④ Sta. 'RAMP D' 49+84.00, 18' Rt. End Curb
- ⑤ Const. Guardrail
(See Sht. 34A, Note 9)
- ⑥ Remove Extg. Conc. Median Barrier
Const. Tall Conc. Median Barrier
(See Drg. No. RD545)
(See Sht. 32, Note 2)
- ⑦ Remove Extg. Luminaire
- ⑧ Const. Curb
(See Drg. No. RD700)
- ⑨ Sta. 'Ramp D' 49+30, 45' Lt.
Const. 5'x7'x1' Riprap Pad (Class 50)
Underlay with Geotextile Membrane - Type 2
- ⑩ Provide V-Ditch Along Extg. Ditch Alignment.
(See Profile For Ditch Elev.)
- ⑪ Sta. 'Ramp D' 49+29.05, 45.50' Lt.
I.E. 490.00' To
Sta. 'Ramp D' 50+21.00, 38.50' Lt.
I.E. 486.50
Const. Trapezoidal, Flat-Bottom Ditch
3' (Bottom) x 1' (Depth), 3:1 Backside Slope
Match Side Slope on 'Ramp D' Fill Side.
- ⑫ Sta. 'Ramp D' 50+26.00, 39.50' Lt.
I.E. 485.27' To
Sta. 'Ramp D' 50+21.00, 38.50' Lt.
I.E. 486.50'
Const. 7'x6'x1' Riprap Pad (Class 50)
Underlay With Geotextile Membrane - Type 2
- ⑬ Const. Guardrail
(See Sht. 34A, Note 28)
- ⑭ Reconstruct Southbound
Exit Ramp
(For Ramp Gore Detail, See Sht. 28-17)
- ⑮ Reconstruct Northbound
Exit Ramp
(See Sht. 37, Note 1)

| Rev. No. | Date | Revision |
|----------|----------|----------------|
| △ | 11/21/06 | As Constructed |

| | |
|---|----------------------------|
|  OREGON DEPARTMENT OF TRANSPORTATION ROADWAY ENGINEERING SECTION | |
| I-5: SUTHERLIN-ROSEBURG SEC. DESIGN-BUILD PROJECT PACIFIC HIGHWAY DOUGLAS COUNTY | |
| Reviewed By - Steve Katko Designed By - John Thomas Drafted By - Robert Luke | |
| STA. 'I-5' 1798+20 TO STA. 'I-5' 1804+00 ROADWAY PLAN NOTES | SHEET NO. 35A |