

OPERATION & MAINTENANCE MANUAL

DFI No.: D00394

**Facility Type: Water Quality Biofiltration
Swale**



MARCH, 2011

INDEX

1. IDENTIFICATION 1

2. FACILITY CONTACT INFORMATION..... 1

3. CONSTRUCTION..... 1

4. STORM DRAIN SYSTEM AND FACILITY OVERVIEW 1

5. FACILITY HAZ MAT SPILL FEATURE(S)..... 5

6. AUXILIARY OUTLET (HIGH FLOW BYPASS) 5

7. MAINTENANCE REQUIREMENTS 6

8. WASTE MATERIAL HANDLING 6

APPENDIX A: Operational Plan and Profile Drawing(s)

APPENDIX B: ODOT Project Plan Sheets

1. Identification

Drainage Facility ID (DFI): **D00394**
Facility Type: Water Quality Biofiltration Swale
Construction Drawings: (V-File Number) 38V-055
Location: District: 7
Highway No.: 001
Mile Post: 138.70 / 138.71 (beg./end)
Description: This facility is located on the west side of I-5 (Hwy 001, Pacific Highway) adjacent to and south of Calapooya Creek. Access can be obtained from the south via an ODOT maintenance road connected to Stearns Lane.

2. Facility Contact Information

Contact the Engineer of Record, Region Technical Center, or Geo-Environmental's Senior Hydraulics Engineer for:

- Operational clarification
- Maintenance clarification
- Repair or restoration assistance

Engineering Contacts:

Region Technical Center Hydraulics Engineer (541) 957-3693

Or

Geo-Environmental Senior Hydraulics Engineer (503) 986-3365.

3. Construction

Engineer of Record: ODOT Designer – Region 3 Tech. Center, James Bauman, 541-957-3573

Facility construction: 2007
Contractor: CH2M Hill, Inc., (Design – Build)

4. Storm Drain System and Facility Overview

A water quality swale is a flat-bottomed open channel designed to treat stormwater runoff from highway pavement areas. This type of facility is lined with grass. Treatment by trapping sedimentation occurs when stormwater runoff flows through the grass.

Stormwater is conveyed to the facility by a storm sewer system that collects water from the I-5 Calapooya Creek Bridge. The storm system discharges into two separate riprap pads located on each side of the bridge. The stormwater flows from these riprap pads directly into the water quality swale. Refer to the Operational Plan in Appendix A for further information. Water conveyed into the swale undergoes treatment as it flows through the length of the channel. The treated water flows out of the swale directly into Calapooya Creek.

A. Maintenance equipment access:

Access can be obtained from the south via an ODOT maintenance road connected to Stearns Lane.

B. Heavy equipment access into facility:

- Allowed (no limitations)
- Allowed (with limitations)
- Not allowed

C. Special Features:

- Amended Soils
- Porous Pavers
- Liners
- Underdrains

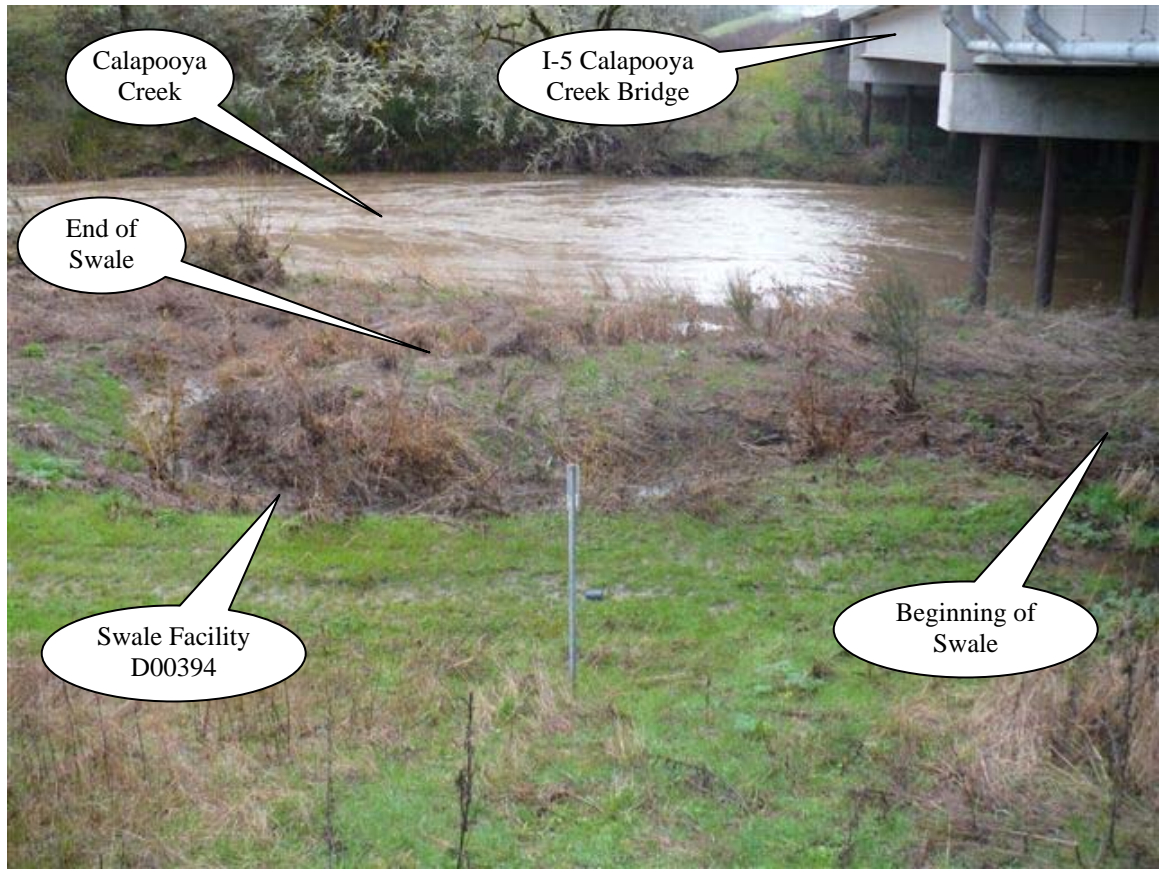


Photo 1: Looking north, flow into the swale is generated from I-5 Calapooya Creek Bridge shown on the right side of the picture. Stormwater flows from this structure onto riprap pads and is conveyed to the beginning of the swale as shown.

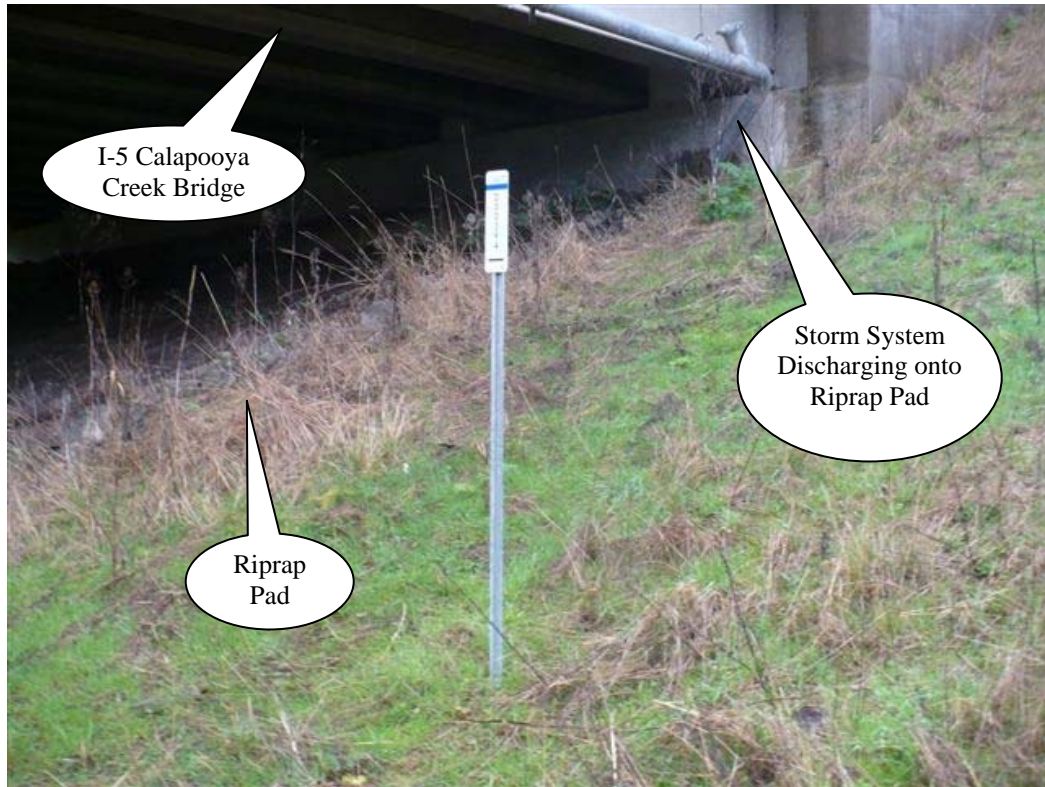


Photo 2: Looking south, flow into the swale is generated from the I-5 Calapooya Creek Bridge. Water discharges directly onto riprap pads located on each side of the bridge. The stormwater then flows down slope to the beginning of the swale.



Photo 3: Looking west, stormwater flows from the bottom of the picture towards the top.

5. Facility Haz Mat Spill Feature(s)

The water quality biofiltration swale can not be used to store a volume of liquid due to the porous nature of the soils and the proximity of the facility to Calapooya Creek.

6. Auxiliary Outlet (High Flow Bypass)

Auxiliary Outlets are provided if the primary outlet control structure can not safely pass the projected high flows. Broad-crested spillway weirs and over flow risers are the two most common auxiliary outlets used in

stormwater treatment facility design. The auxiliary outlet feature is either a part of the facility or an additional storm drain feature/structure.

The auxiliary outlet feature for this facility is:

- Designed into facility
- Other, as noted below
There is no auxiliary outlet for this facility.

7. Maintenance Requirements

Routine maintenance table for non-proprietary stormwater treatment and storage/detention facilities have been incorporated into ODOT's Maintenance Guide. These tables summarize the maintenance requirements for ponds, swales, filter strips, bioslopes, and detention tanks and vaults. Special maintenance requirements in addition to the routine requirements are noted below when applicable.

The ODOT Maintenance Guide can be viewed at the following website:

<http://www.oregon.gov/ODOT/HWY/OOM/MGuide.shtml>

Maintenance requirements for proprietary structures, such as underground water quality manholes and/or vaults with filter media are noted in Appendix C when applicable.

The following stormwater facility maintenance table (See ODOT Maintenance Guide) should be used to maintain the facility outlined in this Operation and Maintenance Manual or follow the Maintenance requirements outlined in Appendix C when proprietary structure is selected below:

- Table 1 (general maintenance)
- Table 2 (stormwater ponds)
- Table 3 (water quality biofiltration swales)
- Table 4 (water quality filter strips)
- Table 5 (water quality bioslopes)
- Table 6 (detention tank)
- Table 7 (detention vault)
- Appendix C (proprietary structure)
- Special Maintenance requirements:A

Note: Special maintenance Requirements Require Concurrence from ODOT SR Hydraulics Engineer.

8. Waste Material Handling

Material removed from the facility is defined as waste by DEQ. Refer to the roadwaste section of the ODOT Maintenance Yard Environmental Management System (EMS) Policy and Procedures Manual for disposal options: <http://egov.oregon.gov/ODOT/HWY/OOM/EMS.shtml>



Contact any of the following for more detailed information about management of waste materials found on site:

ODOT Clean Water Unit	(503) 986-3008
ODOT Statewide Hazmat Coordinator	(503) 229-5129
ODOT Region Hazmat Coordinator	(541) 957-3594
ODEQ Northwest Region Office	(503) 229-5263

Appendix A

Content:

- **Operational Plan and Profile Drawing(s)**

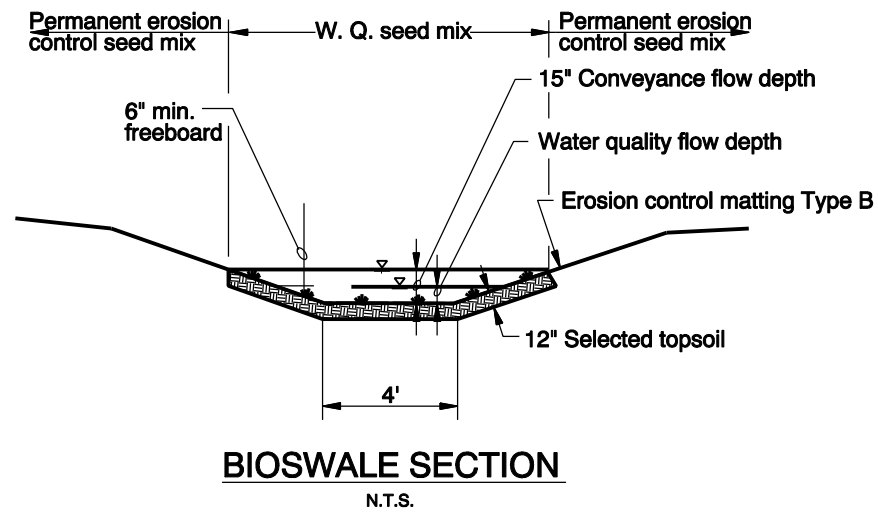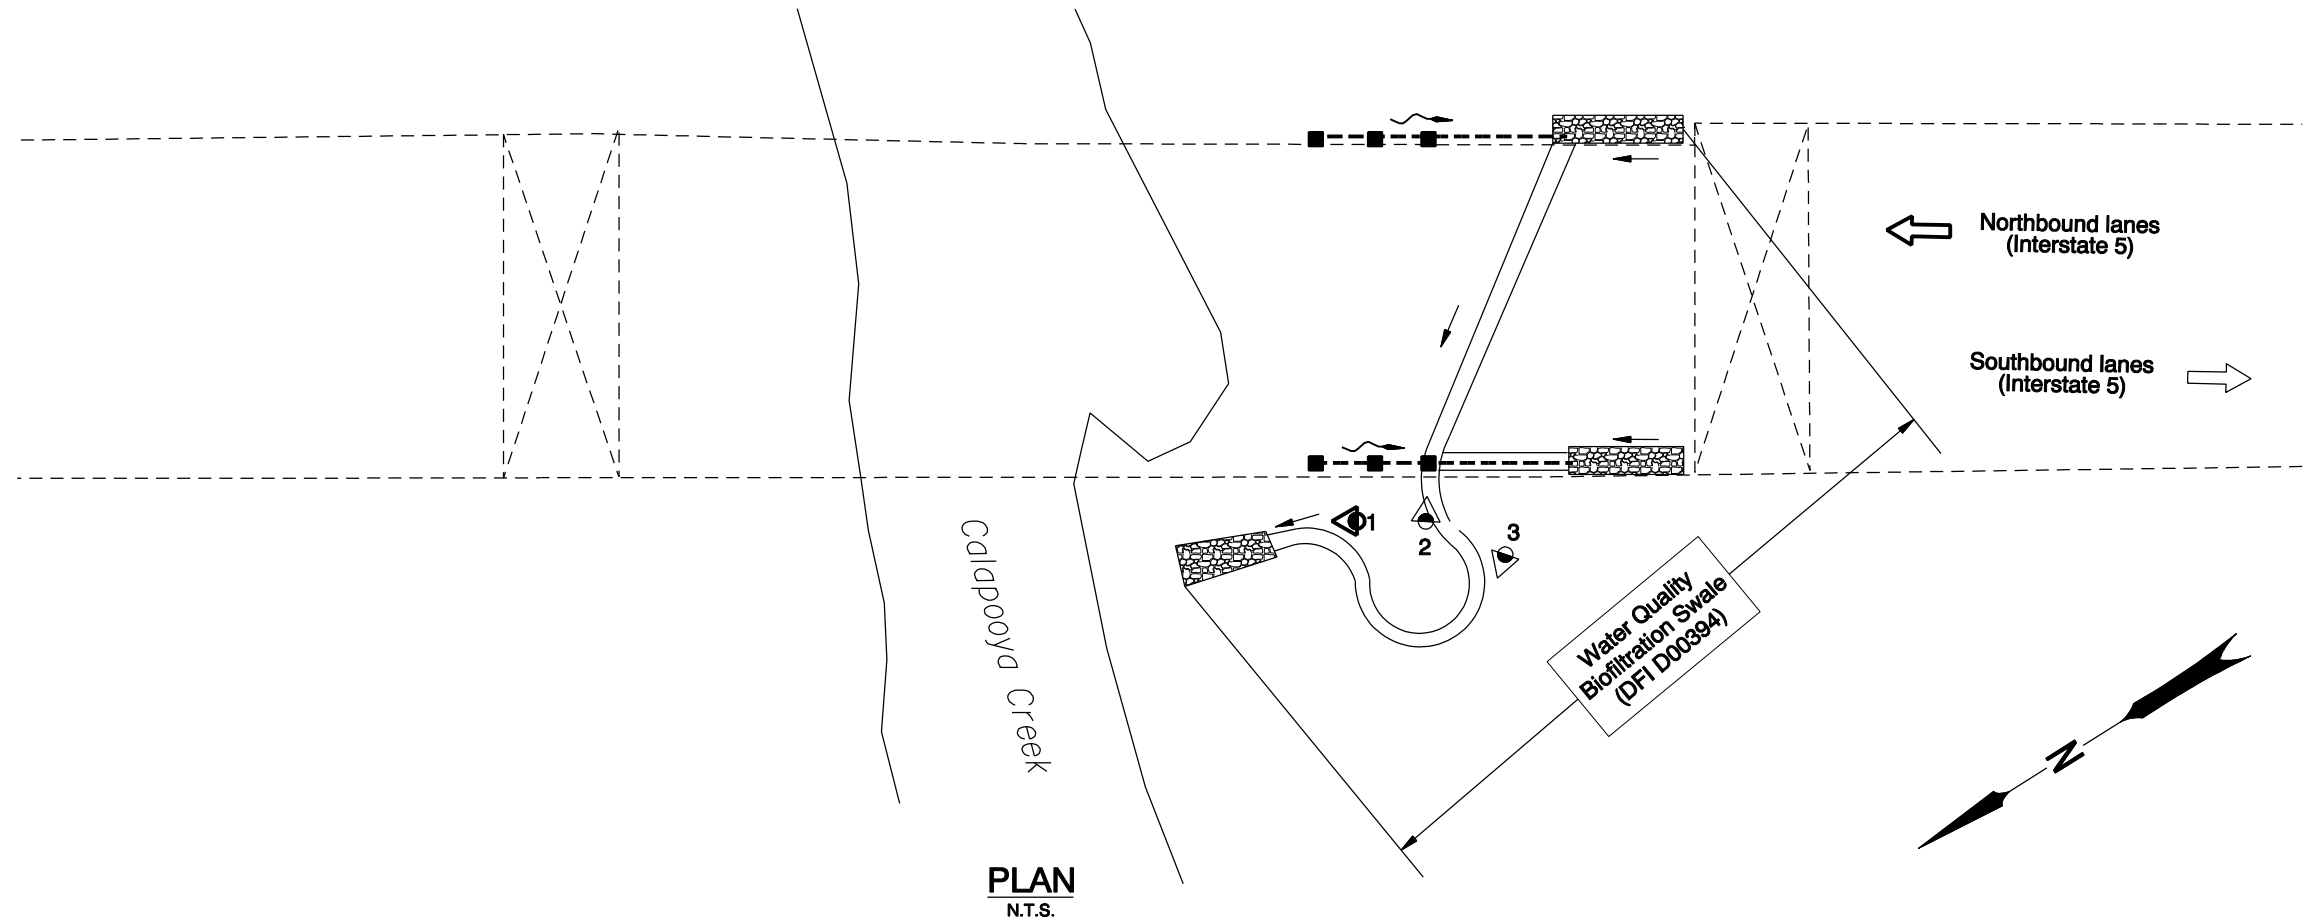

- LEGEND:**
- Photo Location / Direction
 - Inlet
 - Storm Pipe (Facility)
 - Storm Pipe
 - Conveyance Direction
 - Pavement / Facility Flow Path


OREGON DEPARTMENT OF TRANSPORTATION	
Prepared By: <u>J. Carpenter</u> Drafted By: <u>B. Shafer</u>	DFI D00394 MAINTENANCE DISTRICT 7 HWY 001 WATER QUALITY BIOFILTRATION SWALE PACIFIC HIGHWAY MP 138.70/138.71 DOUGLAS COUNTY

Appendix B

Content:

- **ODOT Project Plan Sheets**
 - *Cover/Title Sheet*
 - *Water Quality/Detention Plan Sheets*
 - *Other Details*

STATE OF OREGON
DEPARTMENT OF TRANSPORTATION
PLANS FOR PROPOSED PROJECT
GRADING, DRAINAGE, STRUCTURE AND PAVING
I-5: SUTHERLIN - ROSEBURG SEC.
DESIGN-BUILD PROJECT

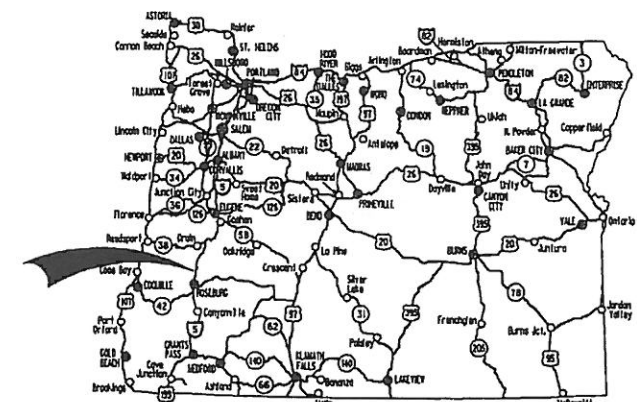


Overall Length Of Project - 13.33 Miles

PACIFIC HIGHWAY
DOUGLAS COUNTY

MAY 2007

BEGINNING OF PROJECT

M.P. 138.71

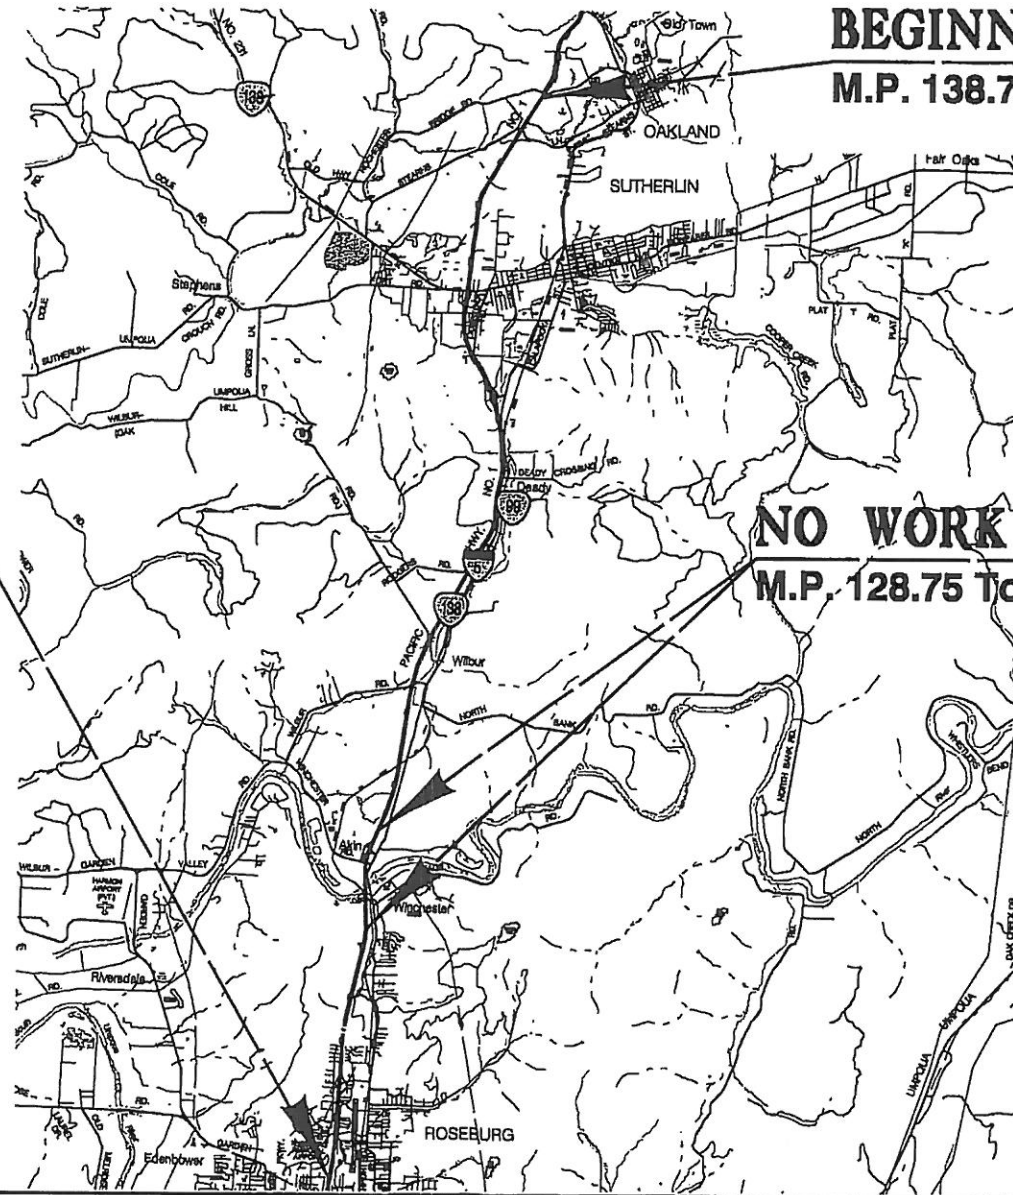

END OF PROJECT

M.P. 125.38

NO WORK ZONE

M.P. 128.75 To M.P. 129.80

ATTENTION:
Oregon Law Requires You To Follow Rules Adopted By The Oregon Utility Notification Center. Those Rules Are Set Forth In OAR 952-001-0010 Through OAR 952-001-0090. You May Obtain Copies Of The Rules By Calling The Center. (Note: The Telephone Number For The Oregon Utility Center Is (503) 232-1987.)



OREGON TRANSPORTATION COMMISSION
Stuart Foster CHAIRMAN
Gail L. Achterman COMMISSIONER
Mike Nelson COMMISSIONER
Randall Pape COMMISSIONER
Janice J. Wilson COMMISSIONER
Matt Garrett DIRECTOR OF TRANSPORTATION

PLANS PREPARED FOR
ODOT
BY:
CH2MHILL



EXPIRES: 12/31/07

OREGON DEPARTMENT OF TRANSPORTATION
CONCURRENCE

TECHNICAL SERVICES MANAGING ENGINEER DATE

I-5: SUTHERLIN-ROSEBURG SEC.
DESIGN-BUILD PROJECT
PACIFIC HIGHWAY
DOUGLAS COUNTY

FEDERAL HIGHWAY ADMINISTRATION	PROJECT NUMBER	SHEET NO.
OREGON DIVISION	OTIA-IM-S001(192)	1


Note: See Sht. 1A For Additional Standard Drawings

Rev. No.	Date	Revision
1	11/21/06	As Constructed

REVISED AS CONSTRUCTED
5/06 CONTRACT 13070
DESIGN MGR. James Bauman



T. 25 S., R. 5 W., W.M.
T. 26 S., R. 5 W., W.M.
T. 26 S., R. 6 W., W.M.
T. 27 S., R. 6 W., W.M.

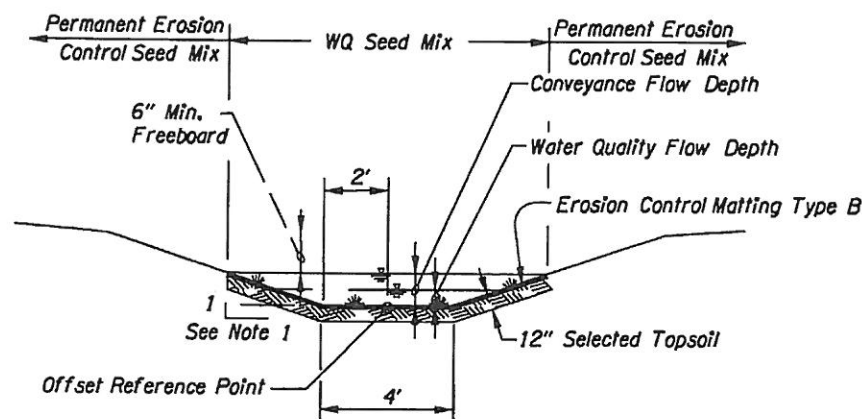


Notes:

1. Sideslopes In The Water Quality Section Of The Swale Shall Be 4H:1V Maximum. Sideslopes Above The Water Quality Flow Depth Shall Match Roadway Embankment Slopes.
2. Erosion Control Matting Materials And Installation Per ODOT Std. Spec. Section 280.




BIOSWALE SECTION - TYPICAL

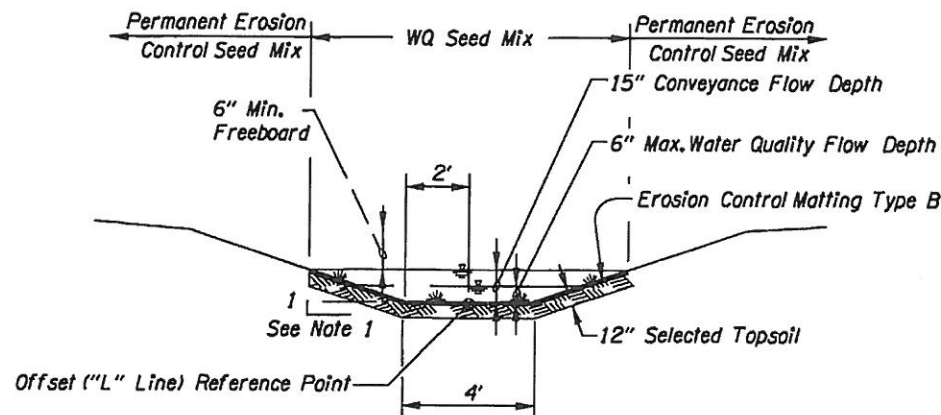

Notes:

1. Sideslopes In The Water Quality Section Of The Swale Shall Be 4H:1V Maximum. Sideslopes Above The Water Quality Flow Depth Shall Match Roadway Embankment Slopes.
2. Erosion Control Matting Materials And Installation Per ODOT Std. Spec. Section 280.

BIOSWALE SECTION - SUTHERLIN INTERCHANGE

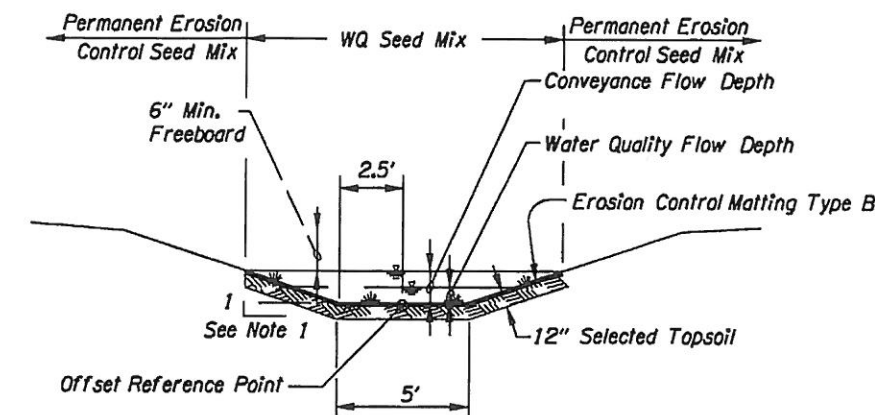

Notes:


1. Sideslopes In The Water Quality Section Of The Swale Shall Be 4H:1V Maximum. Sideslopes Above The Water Quality Flow Depth Shall Match Roadway Embankment Slopes.
2. Erosion Control Matting Materials And Installation Per ODOT Std. Spec. Section 280.



BIOSWALE SECTION - NORTH ROSEBURG INTERCHANGE

Rev. No.	Date	Revision
3	11/21/06	As Constructed
2	2/1/07	Revision - Addition Of Bioswale Section
1	12/9/05	Revision - Addition Of Non-Specific Bioswale Section

OREGON DEPARTMENT OF TRANSPORTATION ROADWAY ENGINEERING SECTION	
I-5: SUTHERLIN-ROSEBURG SEC. DESIGN-BUILD PROJECT PACIFIC HIGHWAY DOUGLAS COUNTY	
Reviewed By - Mark Anderson Designed By - Scott Christopherson Drafted By - Prisciliano Peralta-Ramirez	
DRAINAGE DETAILS TYPICAL BIOSWALE SECTION	SHEET NO. 2B-20

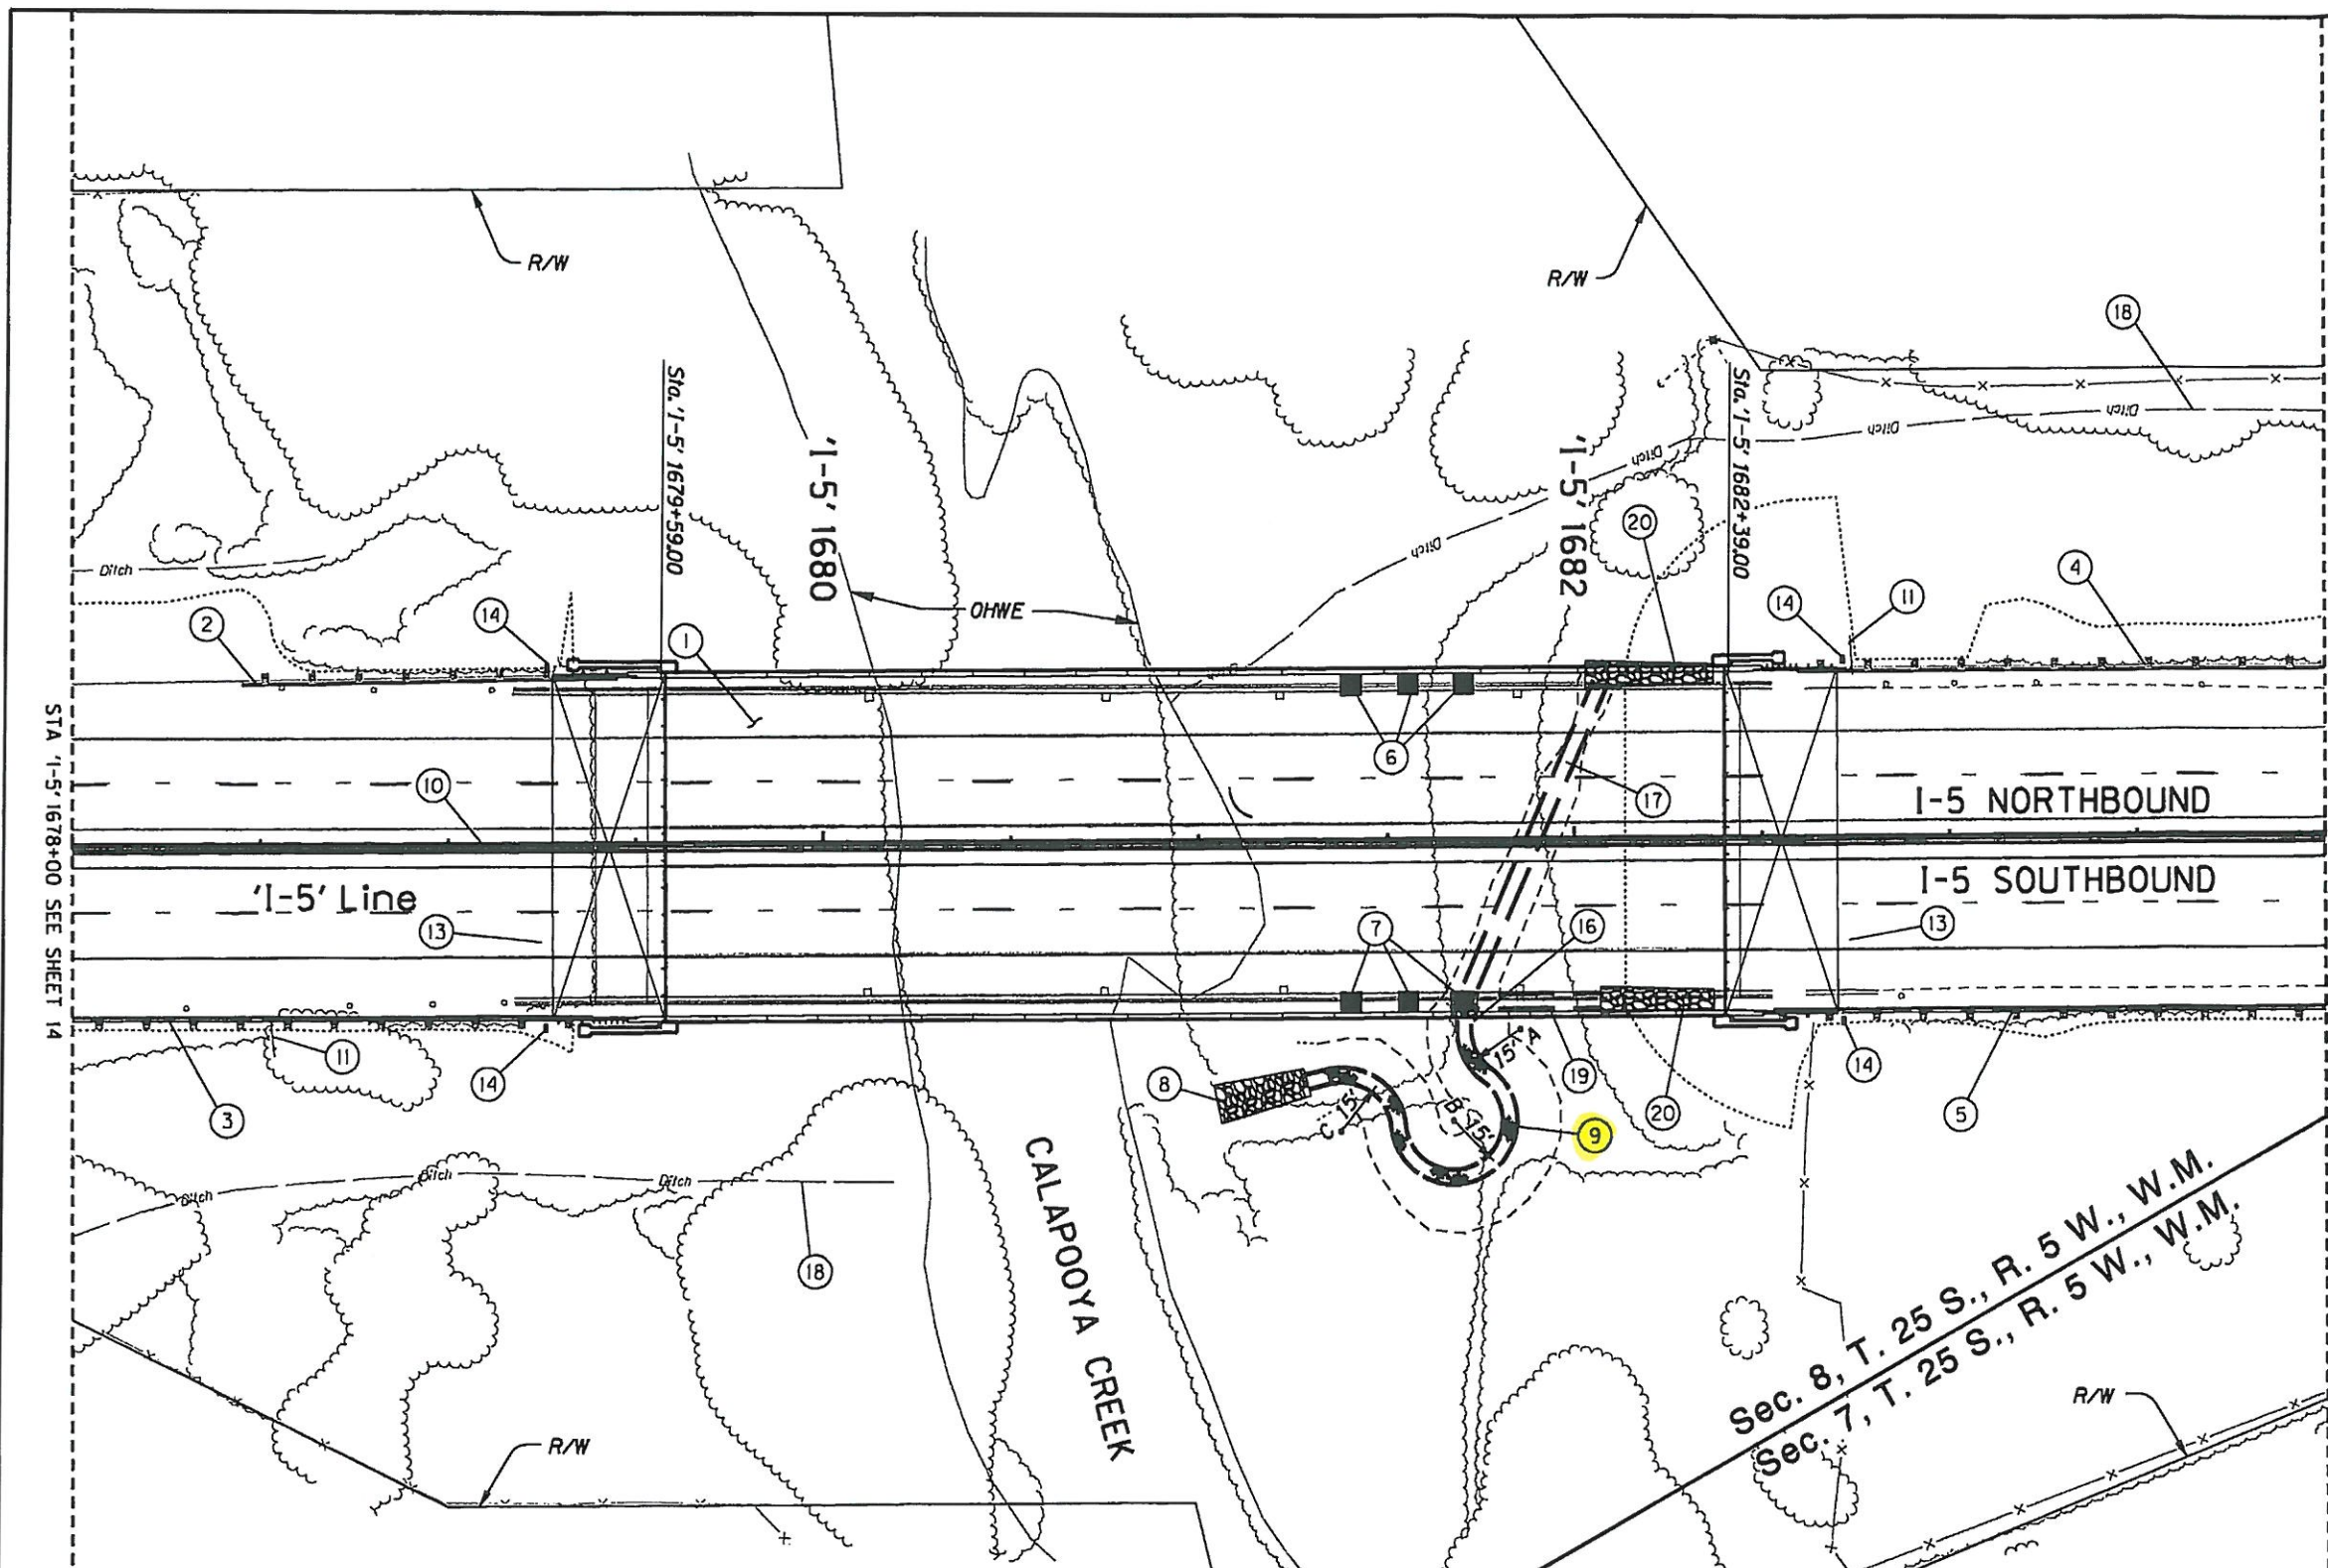


STA. 'I-5' 1684+00 SEE SHEET 16

STA. 'I-5' 1678+00 SEE SHEET 14


OREGON DEPARTMENT OF TRANSPORTATION ROADWAY ENGINEERING SECTION	
I-5: SUTHERLIN-ROSEBURG SEC. DESIGN-BUILD PROJECT PACIFIC HIGHWAY DOUGLAS COUNTY	
Reviewed By - Steve Katko Designed By - Scott Christopherson Drafted By - Karen Wagner	
STA. 'I-5' 1678+00 TO STA. 'I-5' 1684+00 ROADWAY PLAN	SHEET NO. 15

Rev. No.	Date	Revision
△	11/21/06	As Constructed
△	9/01/06	Revised Drainage, Added Note Sheet

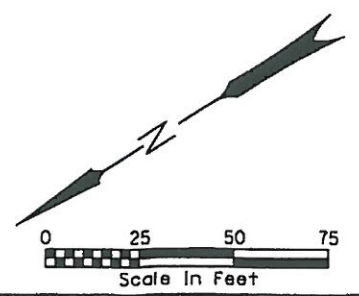

- ① Bridge No. 20239
Const. Structure - 280'
Rdwy. Width 90'
And Reinf. Panel At Bridge Ends
(For Details, See Sht. B7-101)
- ② Sta. 'I-5' 1678+45.10 To
Sta. 'I-5' 1679+59.00
Remove Extg. Guardrail - 63'
Const. Guardrail (Type 2A) - 87.5'
Const. Guardrail (Type 3) - 12.5'
Const. Guardrail Transition - 1
(See Drg. Nos. BR203, RD400, RD405,
RD415 & RD440)
- ③ Const. Guardrail
(See Sht. 14, Note 1)
- ④ Sta. 'I-5' 1682+39.00 To
Sta. 'I-5' 1686+42.50
Remove Extg. Guardrail - 340'
Const. Guardrail (Type 2A) - 337.5'
Const. Guardrail (Type 3) - 25'
Const. Guardrail Transition - 2
(See Drg. Nos. BR203, RD400, RD405,
RD415 & RD440)
- ⑤ Sta. 'I-5' 1682+39.00 To
Sta. 'I-5' 1686+42.50
Remove Extg. Guardrail - 340'
Const. Guardrail (Type 2A) - 337.5'
Const. Guardrail (Type 3) - 25'
Const. Guardrail Transition - 2
(See Drg. Nos. BR203, RD400, RD405,
RD415 & RD440)
- ⑥ Sta. 'I-5' 1681+40.50, 45' Lt.
Sta. 'I-5' 1681+55.50, 45' Lt.
Sta. 'I-5' 1681+70.50, 45' Lt.
Const. Inlet
(For Details, See Sht. B7-601)
- ⑦ Sta. 'I-5' 1681+40.50, 45' Rt.
Sta. 'I-5' 1681+55.50, 45' Rt.
Sta. 'I-5' 1681+70.50, 45' Rt.
Const. Inlet
(For Details, See Sht. B7-601)
- ⑧ Const. Riprap Pad (Class 50)
7' (Top) x 10' (Bottom) x 28" x 2"
Underlay With Riprap Geotextile - Type 2
- ⑨ Sta. 'I-5' 1681+70.50, 49.20' Rt. F.L. 399.52
Sta. 'I-5' 1681+28.79 63.35' Rt. F.L. 399.00
Const. Bioswale - 100' At 0.5% Grade
(For Details, See Sht. 2B-20)
(Pt. A Sta. 'I-5' 1681+85.42, 49.66' Rt.)
(Pt. B Sta. 'I-5' 1681+67.62, 73.82' Rt.)
(Pt. C Sta. 'I-5' 1681+37.75, 76.53' Rt.)
- ⑩ Const. Tall Conc. Barrier
(See Sht. 14, Note 3)
- ⑪ Protect Extg. Sign
- ⑬ Const. Pymt. Drain
(See Drg. No. RD314)
- ⑭ Const. Pymt. Drain
Outlet Protection Block
(See Drg. No. RD314)
- ⑯ Const. Riprap Pad (Class 50)
7'x7'x2'
Underlay With Riprap
Geotextile - Type 1
- ⑰ Sta. 'I-5' 1682+07.00, 42.20 Lt., F.L. 401.93
Sta. 'I-5' 1681+70.42, 42.20 Rt., F.L. 399.57
Const. Ditch
"V" Bottom, 3:1 Slopes
- ⑱ Avoid Impacts To Ditch
- ⑲ Sta. 'I-5' 1682+07.00, 42.20 Rt., F.L. 400.27
Sta. 'I-5' 1681+70.42, 42.20 Rt., F.L. 399.57
Const. Ditch
"V" Bottom, 3:1 Slopes
- ⑳ Const. Riprap Pad (Class 50)
5' (Top) x 7' (Bottom) x 2' (Depth)
Line With Riprap Geotextile - Type 1

Rev. No.	Date	Revision
△	11/21/06	As Constructed
△	9/01/06	Revised Drainage, Added Note Sheet

 OREGON DEPARTMENT OF TRANSPORTATION ROADWAY ENGINEERING SECTION	
I-5: SUTHERLIN-ROSEBURG SEC. DESIGN-BUILD PROJECT PACIFIC HIGHWAY DOUGLAS COUNTY	
Reviewed By - Steve Katko Designed By - John Thomas Drafted By - Robert Luke	
STA. 'I-5' 1678+20 TO STA. 'I-5' 1684+00 ROADWAY PLAN NOTES	SHEET NO. 15A