

OPERATION & MAINTENANCE MANUAL

DFI No.: D00398

**Facility Type: Water Quality Biofiltration
Swale**



MARCH, 2011

INDEX

1. IDENTIFICATION 1

2. FACILITY CONTACT INFORMATION..... 1

3. CONSTRUCTION..... 1

4. STORM DRAIN SYSTEM AND FACILITY OVERVIEW 1

5. FACILITY HAZ MAT SPILL FEATURE(S)..... 5

6. AUXILIARY OUTLET (HIGH FLOW BYPASS) 5

7. MAINTENANCE REQUIREMENTS 6

8. WASTE MATERIAL HANDLING 6

APPENDIX A: Operational Plan and Profile Drawing(s)

APPENDIX B: ODOT Project Plan Sheets

1. Identification

Drainage Facility ID (DFI): **D00398**
Facility Type: Water Quality Biofiltration Swale
Construction Drawings: (V-File Number) 41V-055
Location: District: 7
Highway No.: 045
Mile Post: 39.54 / 39.56 (beg./end)
Description: This facility is located on the southern side of OR38 (Hwy 045, Umpqua Highway). Access can be obtained from the eastbound shoulder of OR38.

2. Facility Contact Information

Contact the Engineer of Record, Region Technical Center, or Geo-Environmental's Senior Hydraulics Engineer for:

- Operational clarification
- Maintenance clarification
- Repair or restoration assistance

Engineering Contacts:

Region Technical Center Hydraulics Engineer (541) 957-3693

Or

Geo-Environmental Senior Hydraulics Engineer (503) 986-3365.

3. Construction

Engineer of Record: Consultant Designer – T.Y. Lin International., Kevin Ducharme, P.E., 503-385-4200.

Facility construction: 2008
Contractor: Slayden Construction Group

4. Storm Drain System and Facility Overview

A water quality swale is a flat-bottomed open channel designed to treat stormwater runoff from highway pavement areas. This type of facility is lined with grass. Treatment by trapping sedimentation occurs when stormwater runoff flows through the grass.

Stormwater is conveyed to the facility from a storm sewer system that collects water from the Elk Creek Bridge. A 12-inch storm pipe delivers the stormwater to the beginning of the swale. Sheet flow from OR38 also contributes runoff directly to the swale. Refer to the Operational Plan in Appendix A for further information. Water conveyed into the swale undergoes treatment as it flows through the length of the channel. The treated water flows out of the swale and into a ditch which discharges into Elk Creek.

A. Maintenance equipment access:

Maintenance crews can access the facility from the eastbound shoulder of OR38.

B. Heavy equipment access into facility:

- Allowed (no limitations)
- Allowed (with limitations)
- Not allowed

C. Special Features:

- Amended Soils
- Porous Pavers
- Liners
- Underdrains



Photo 1: Looking west, storm flow generated from OR38 on the right side of the picture contributes stormwater into the swale. Stormwater is flowing from the bottom of the picture towards top of the picture.



Photo 2: Looking west, storm flow generated from OR38 on the left side of the picture contributes stormwater into the swale. The 12-inch inlet pipe shown contributes storm flow from the Elk Creek Bridge.



Photo 3: Looking east, storm flow generated from OR38 on the left side of the picture contributes stormwater into the swale. Stormwater is flowing from the top of the picture towards the bottom of the picture.

5. Facility Haz Mat Spill Feature(s)

The swale can not be used to feasibly store liquid due to the flat cross section and close proximity to Elk Creek.

6. Auxiliary Outlet (High Flow Bypass)

Auxiliary Outlets are provided if the primary outlet control structure can not safely pass the projected high flows. Broad-crested spillway weirs and over flow risers are the two most common auxiliary outlets used in stormwater treatment facility design. The auxiliary outlet feature is either a part of the facility or an additional storm drain feature/structure.

The auxiliary outlet feature for this facility is:

- Designed into facility
- Other, as noted below
There is no auxiliary outlet for this facility.

7. Maintenance Requirements

Routine maintenance table for non-proprietary stormwater treatment and storage/detention facilities have been incorporated into ODOT's Maintenance Guide. These tables summarize the maintenance requirements for ponds, swales, filter strips, bioslopes, and detention tanks and vaults. Special maintenance requirements in addition to the routine requirements are noted below when applicable.

The ODOT Maintenance Guide can be viewed at the following website:

<http://www.oregon.gov/ODOT/HWY/OOM/MGuide.shtml>

Maintenance requirements for proprietary structures, such as underground water quality manholes and/or vaults with filter media are noted in Appendix C when applicable.

The following stormwater facility maintenance table (See ODOT Maintenance Guide) should be used to maintain the facility outlined in this Operation and Maintenance Manual or follow the Maintenance requirements outlined in Appendix C when proprietary structure is selected below:

- Table 1 (general maintenance)
- Table 2 (stormwater ponds)
- Table 3 (water quality biofiltration swales)
- Table 4 (water quality filter strips)
- Table 5 (water quality bioslopes)
- Table 6 (detention tank)
- Table 7 (detention vault)
- Appendix C (proprietary structure)
- Special Maintenance requirements:N/A

Note: Special maintenance Requirements Require Concurrence from ODOT SR Hydraulics Engineer.

8. Waste Material Handling

Material removed from the facility is defined as waste by DEQ. Refer to the roadwaste section of the ODOT Maintenance Yard Environmental Management System (EMS) Policy and Procedures Manual for disposal options: <http://egov.oregon.gov/ODOT/HWY/OOM/EMS.shtml>

Contact any of the following for more detailed information about management of waste materials found on site:

ODOT Clean Water Unit


(503) 986-3008

ODOT Statewide Hazmat Coordinator (503) 229-5129
ODOT Region Hazmat Coordinator (541) 957-3594
ODEQ Northwest Region Office (503) 229-5263


Appendix A

Content:

- **Operational Plan and Profile Drawing(s)**

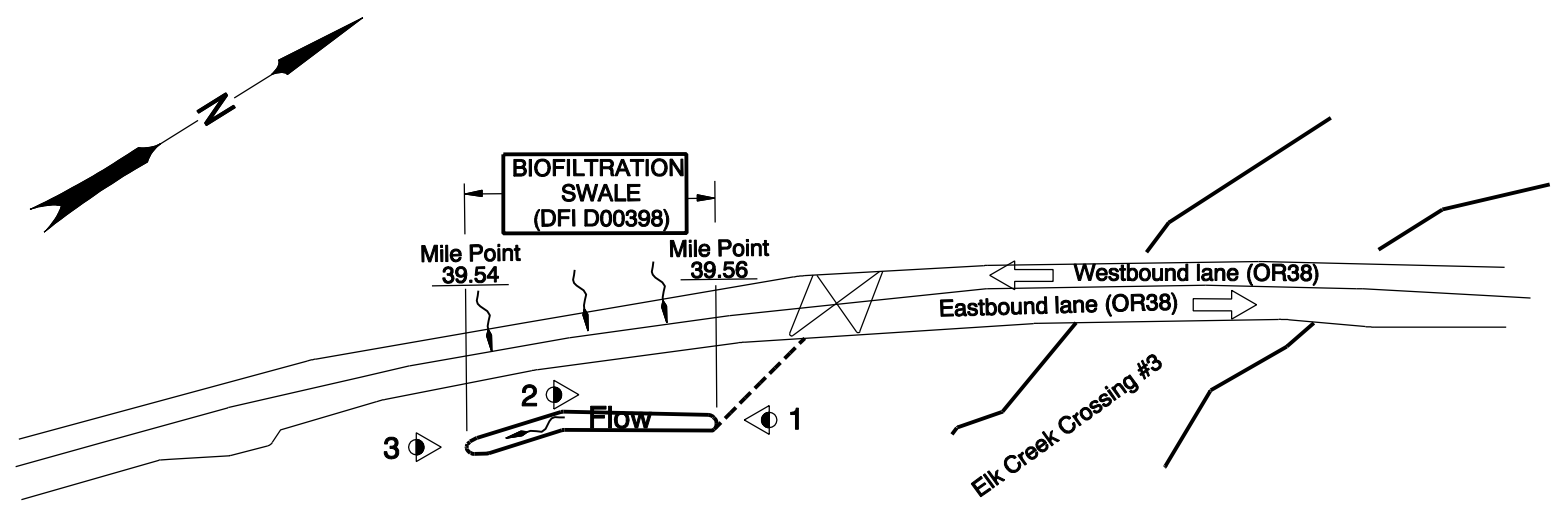

PLAN
N.T.S.

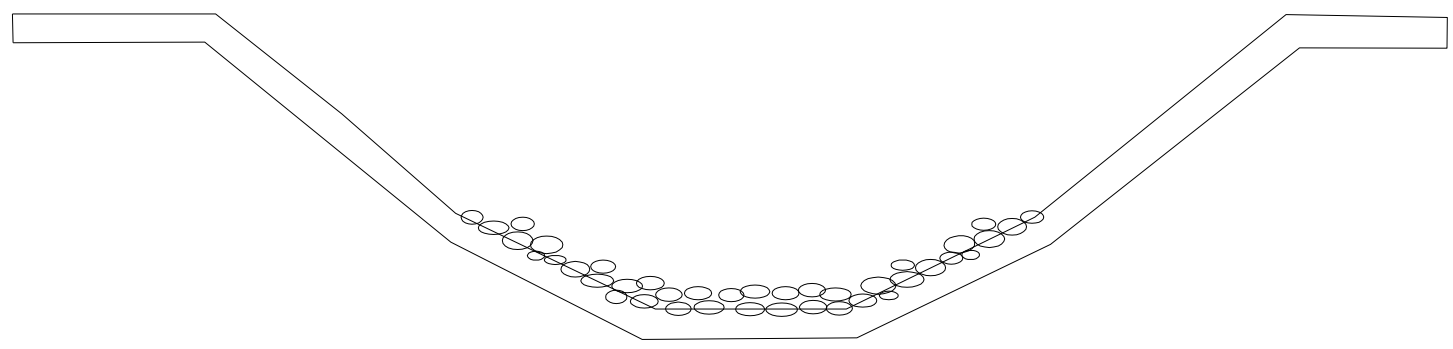

TYPICAL BIOSWALE CROSS-SECTION

- LEGEND:**
- Photograph location / direction
 - and Manhole
 - and Inlet
 - Storm Pipe (Facility)
 - Storm Pipe
 - Conveyance Direction
 - Pavement / Facility Flow Path

OREGON DEPARTMENT OF TRANSPORTATION

Prepared By:
J. Carpenter

Drafted By:
L. Coffel

DFI D00398
MAINTENANCE DISTRICT 7 HWY 45
BIOFILTRATION SWALE
UMPQUA HIGHWAY MP 39.54-39.56
DOUGLAS COUNTY

Appendix B

Content:


- **ODOT Project Plan Sheets**
 - *Cover/Title Sheet*
 - *Water Quality/Detention Plan Sheets*
 - *Other Details*

STATE OF OREGON
DEPARTMENT OF TRANSPORTATION
PLANS FOR PROPOSED PROJECT

STRUCTURES, SIGNING & PAVING

**OR38: ELK CREEK TO HARDCRABBLE CREEK DESIGN BUILD
BUNDLE 401**

UMPQUA HIGHWAY (NO. 45)
DOUGLAS COUNTY
JANUARY 2008

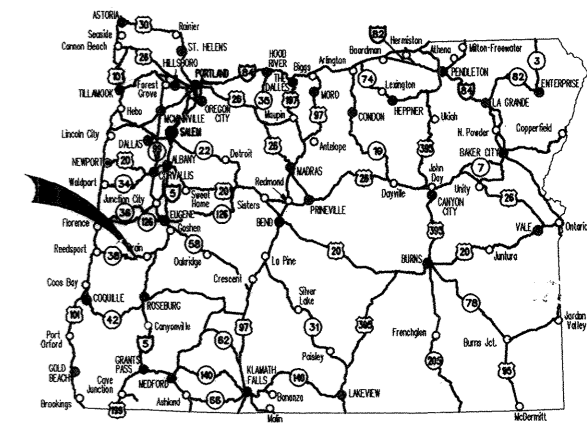

Overall Length Of Project - 11.11 Miles

ATTENTION:
Oregon Law Requires You To Follow Rules Adopted By The Oregon Utility Notification Center. Those Rules Are Set Forth In OAR 952-001-0010 Through OAR 952-001-0090. You May Obtain Copies Of The Rules By Calling The Center. (Note: The Telephone Number For The Oregon Utility Center Is (503) 232-1987.)



REVISED AS CONSTRUCTED
10-APR-2009 CONTRACT #13339
PROJ. MGR. John Ferguson P.E.

OREGON TRANSPORTATION COMMISSION

- Stuart Foster CHAIRMAN
- Gail L. Achterman COMMISSIONER
- Mike Nelson COMMISSIONER
- Randall Pape COMMISSIONER
- John Russell COMMISSIONER
- Matthew Garrett DIRECTOR OF TRANSPORTATION



TYLIN INTERNATIONAL

ELK CREEK TO HARDCRABBLE DESIGN BUILD
UMPQUA HIGHWAY (NO. 45)
DOUGLAS COUNTY

| | | |
|--------------------------------|--------------------|-----------|
| FEDERAL HIGHWAY ADMINISTRATION | PROJECT NUMBER | SHEET NO. |
| OREGON DIVISION | BSR-OTIA-S045(030) | 1 |


Elk Creek Crossing #1
01614 - Replacement (M.P. 36.39)

Hardscrabble Creek Crossing
01424 - Replacement (M.P. 47.50)

END OF PROJECT
Sta. 1663+00 (M.P. 47.55)

BEGINNING OF PROJECT

Sta. 1063+00 (M.P. 36.39)

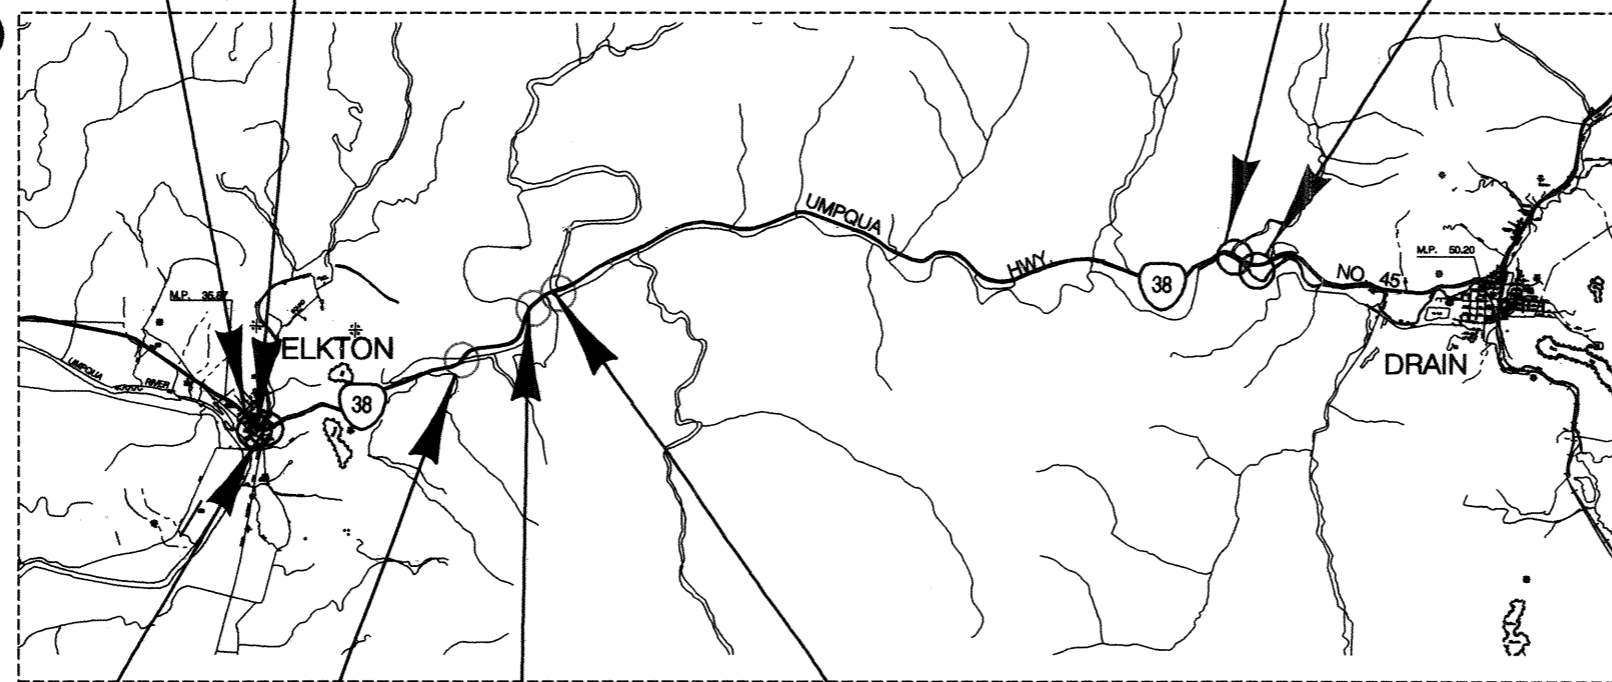



OR38 - OR138
Intersection Upgrade

Elk Creek Crossing #2
01601 - Replacement (M.P. 38.76)

Elk Creek Crossing #4
01406 - Replacement (M.P. 39.97)

Elk Creek Crossing #3
01465 - Replacement (M.P. 39.64)

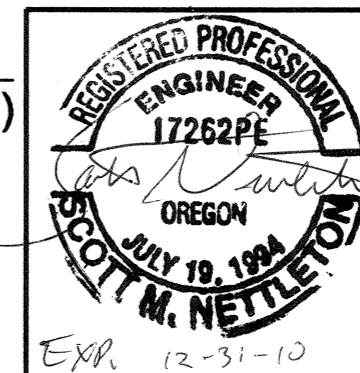


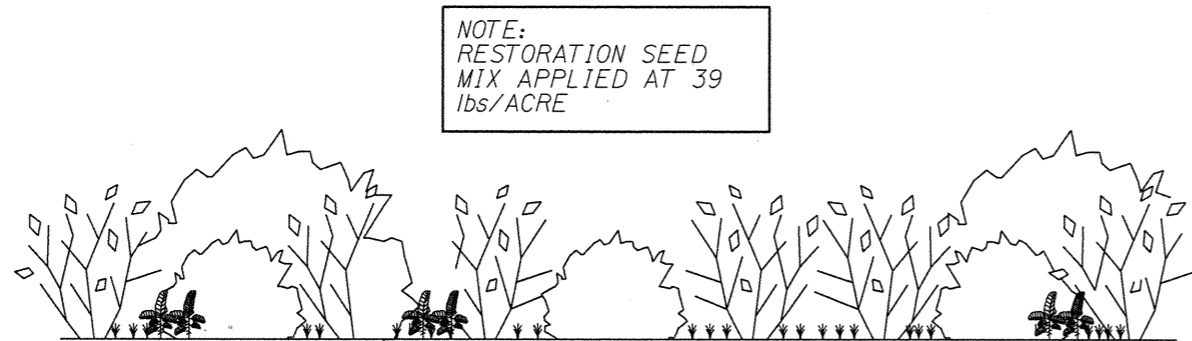

TYPICAL RESTORATION PLANTING AREA TYPE 1 CROSS-SECTION
SEE SHEET GN-4



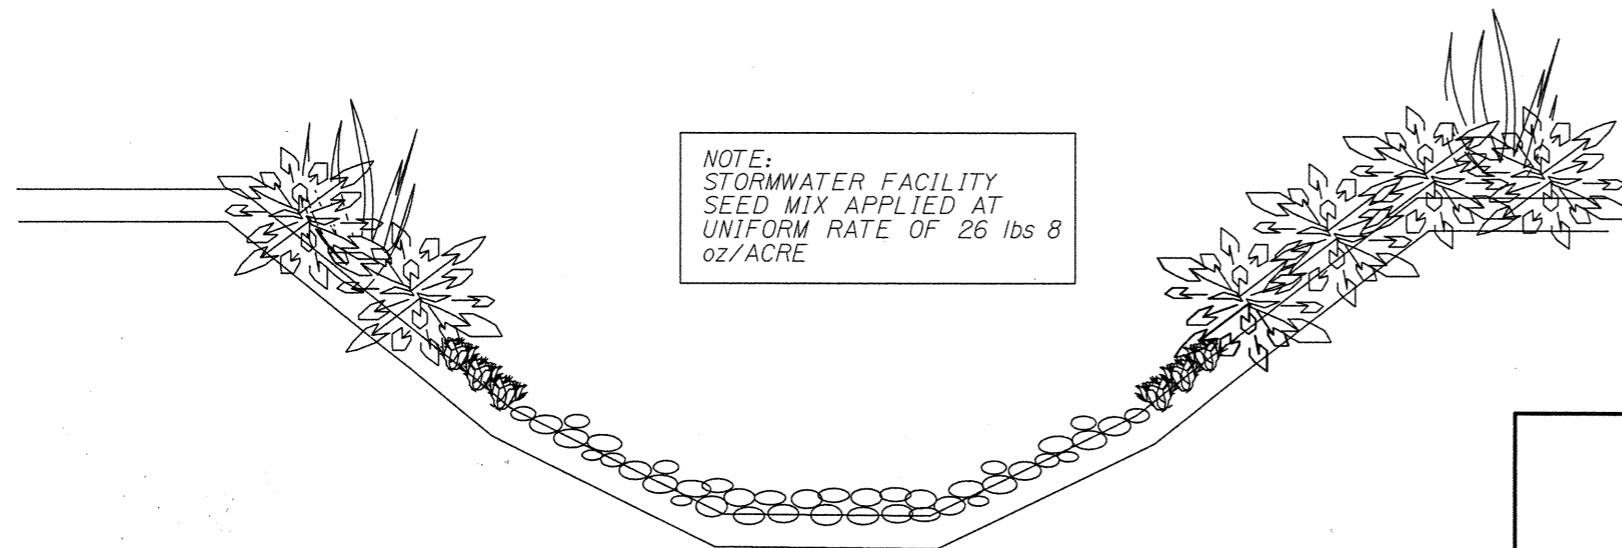


TYPICAL RESTORATION PLANTING AREA TYPE 2 CROSS-SECTION
SEE SHEET GN-5



TYPICAL BIOSWALE CROSS-SECTION


REVISED AS CONSTRUCTED
18-Feb-2010 CONTRACT C13319

| | | |
|--|---|---|
|  Engineering + Environmental |  |  OREGON DEPARTMENT OF TRANSPORTATION REGION 3 TECHNICAL SERVICES |
| | | ELK CREEK TO HARDCRABBLE DESIGN BUILD BUNDLE 401 HIGHWAY 45 DOUGLAS COUNTY |
| | | Design Team Leader - Frank Groznik Designed By - Morgan Holen and Elisabeth Bowers Drafted By - Don James and Fouad El-Gharabli |
| | | PLANTING DETAILS |
| | | SHEET NO. GN-6 |

Crossing #3

Sec. 15, T. 22 S., R. 7 W., W.M.

41V-55

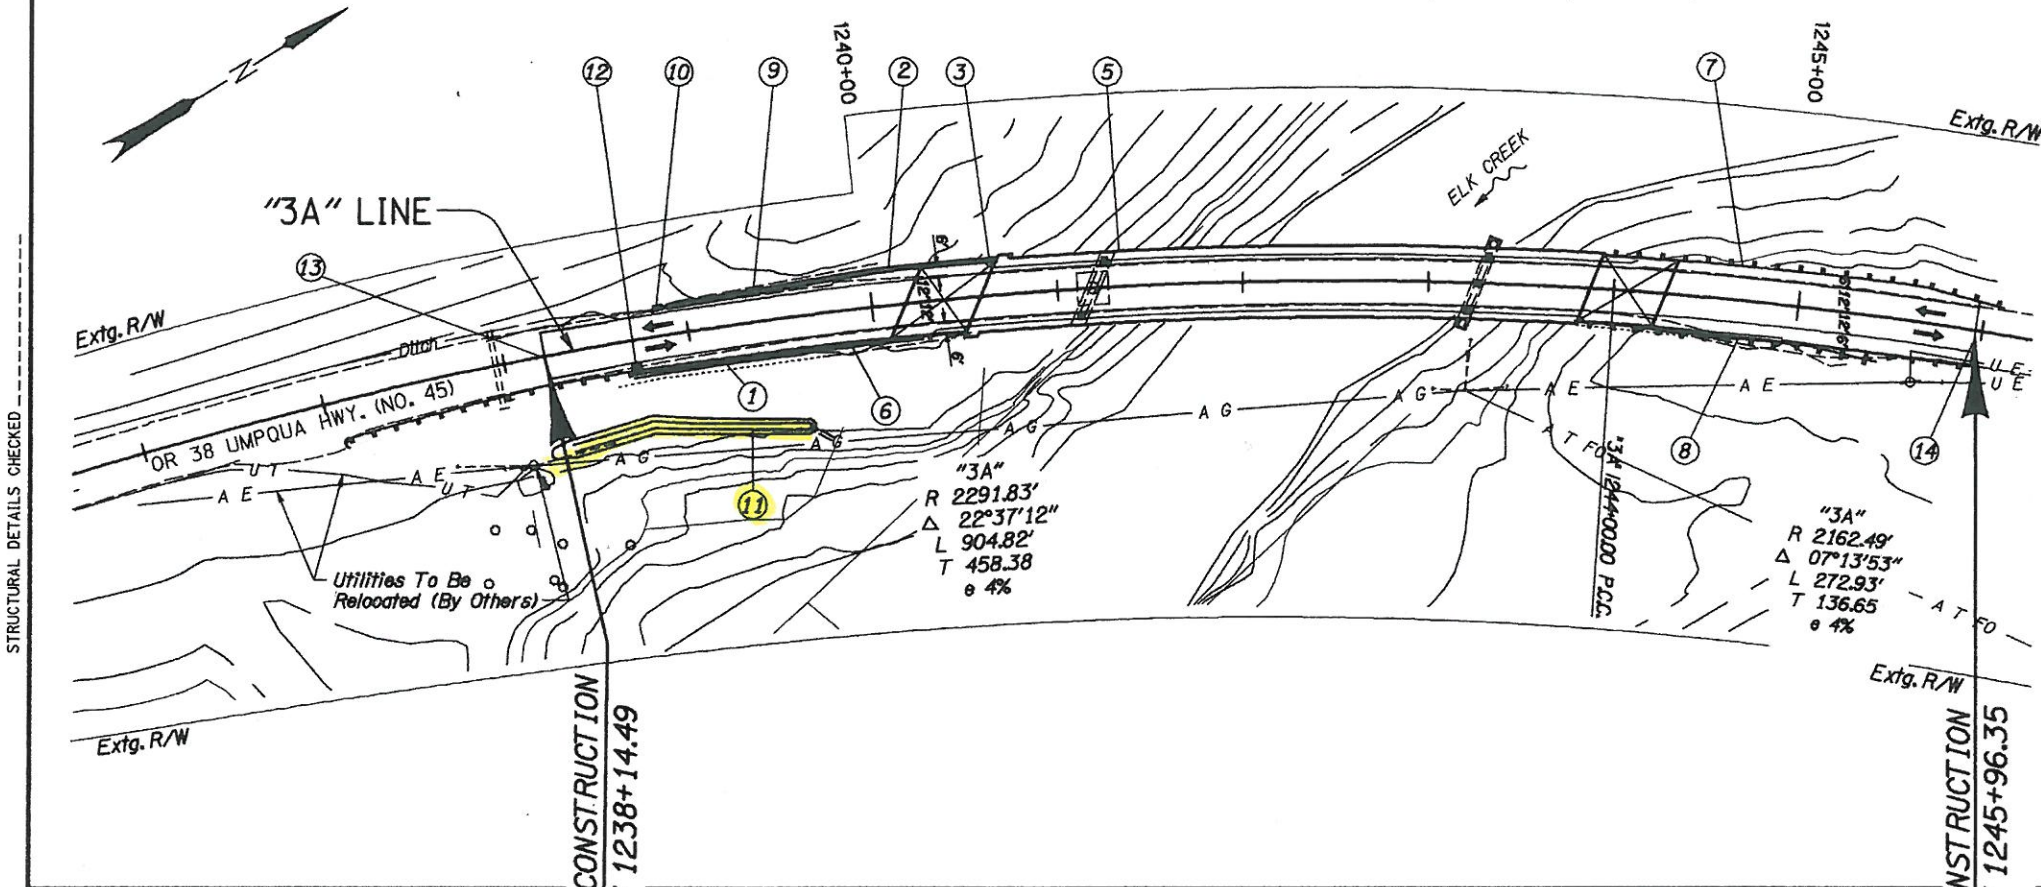


- ① Sta. "3A" 1237+09 to 1240+49.50
Remove Extg. Guardrail
Const. Guardrail Transition - 18.5'

Const. Guardrail (Type 3) - 12.5'
Const. Guardrail (Type 2A) - 27.2'


Const. Non-Flared Energy Absorbing Terminal (TL-3) - 37.5'
- ② Sta. "3A" 1240+04.5 to 1240+54.5
Remove Extg. Guardrail
Const. ReflectORIZED Conc. Shldr. Barrier - 50' Lt.
Pin And Grout Barrier
Flare Rate=0,W=0,E=0
(See Drg. No. RD505)
- ③ Sta. "3A" 1240+54.5 to 1240+67
Const. Cast-In-Place Bridge
Rail Transition - 12.5'
(For Detail, See Sht. 2B)
(See Drg. No. RD550)
- ⑤ Bridge No. 20584
Const. Structure - 329'±
Roadway Width - 36'
And Precast Reinforced Panel At Bridge Ends
(For Drg. Nos. See Sheet 1A)
- ⑥ Sta. "3A" 1238+60.00 to 1240+43.50
Structure No. 76558
Const. Structure - 182.0'
Gravity Retaining Wall
(For Drg. Nos., See Sheet 1A)
- ⑦ Sta. "3A" 1243+93 to 1246+12
Remove Extg. Guardrail
Const. Guardrail Transition - 18.5'
Const. Guardrail (Type 3) - 12.5'
Const. Guardrail (Type 2A) - 69'±
Const. Guardrail (Type 3) - 12.5'
Const. Guardrail Transition (Type 4) - 18.5'

Connect to Existing as Directed
- ⑧ Sta. "3A" 1243+71.75 to 1245+45.00
Remove Extg. Guardrail
Const. Guardrail Transition - 18.5'
Const. Guardrail (Type 3) - 12.5'
Const. Transition Parabola - 25'
Const. Guardrail (Type 2A) - 105.5' Rt.
Construct Energy Absorb. Terminal - 37.5'
Flare Rate=0,W= 4',E=2'(See Drg. No. RD440)
- ⑨ Sta. "3A" 1239+04.5 to 1240+04.5
Rock Cut Embankment Taper = 26:1 min.
Const. ReflectORIZED Conc. Shldr. Barrier - 100' Lt. Pin And Grout Barrier (See Drg. No. RD505)
- ⑩ Sta. "3A" 1238+92 to 1239+04.5
Rock Cut Embankment Taper = 26:1 Min.
Const. Conc. Shldr. Barrier End Panel
Match Edge Of Existing Ditch
(For Detail, See Sht. 2B)
- ⑪ Sta. "3A" 1238+16, 52' Rt.
Const. 120' x 10' Water Quality Swale
(For Details, See Sht. GJ-1)
- ⑫ Sta. "3A" 1238+69, 15' Rt.
Const. Inlet Type G-1
Inst. 12" Storm Sew. Pipe - 61'
(See Drg. No. RD364)
(For Details, See Sht. GJ-1)
- ⑬ Sta. "3A" 1238+14.49
Grind and Match Pavement
(See Drg. No. RD610)
- ⑭ Sta. "3A" 1245+96.35
Grind and Match Pavement
(See Drg. No. RD610)

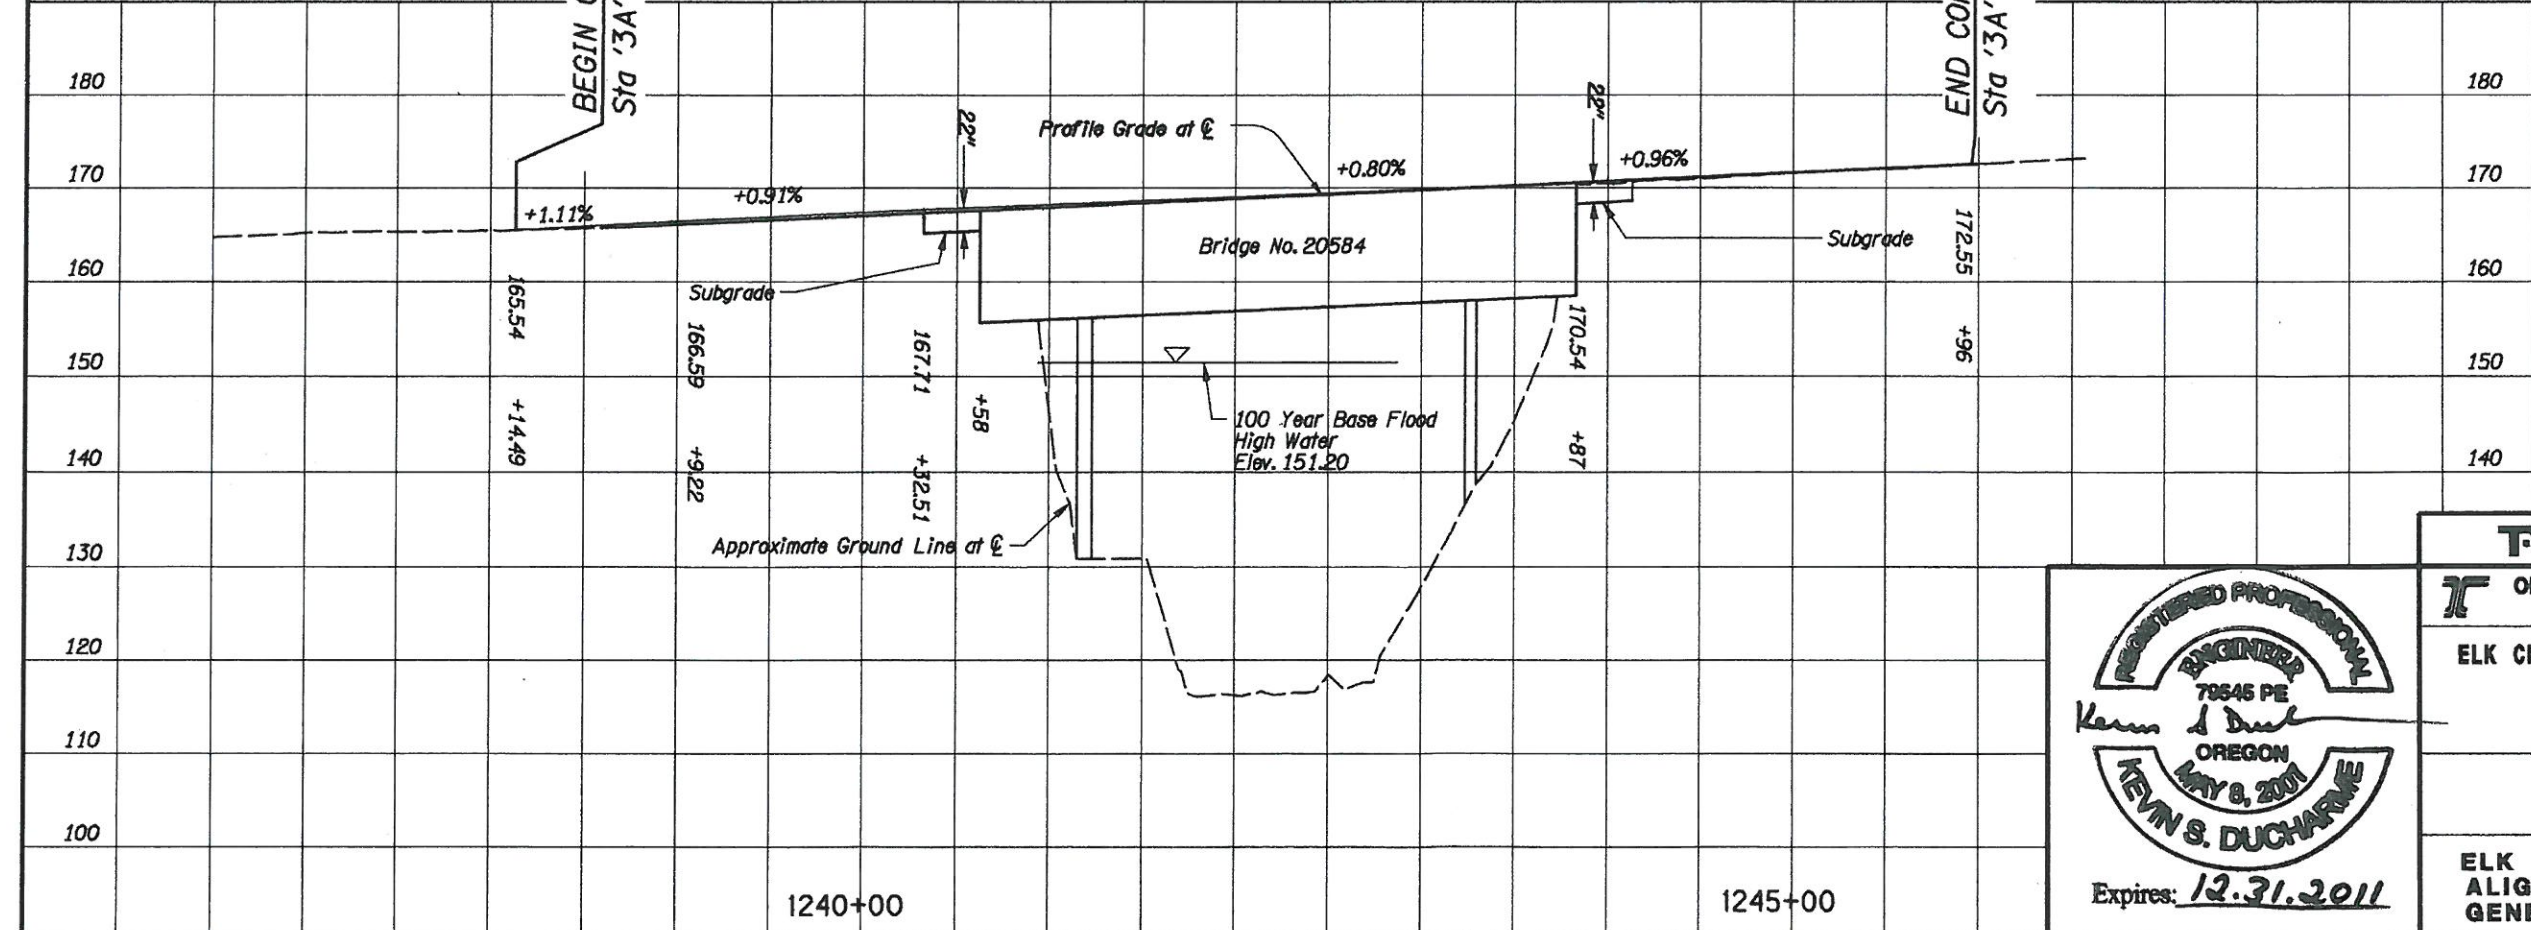

- ⑫ Sta. "3A" 1238+69, 15' Rt.
Const. Inlet Type G-1
Inst. 12" Storm Sew. Pipe - 61'
(See Drg. No. RD364)
(For Details, See Sht. GJ-1)
- ⑬ Sta. "3A" 1238+14.49
Grind and Match Pavement
(See Drg. No. RD610)
- ⑭ Sta. "3A" 1245+96.35
Grind and Match Pavement
(See Drg. No. RD610)




REVISED AS CONSTRUCTED
10-APR-2009 CONTRACT #13339

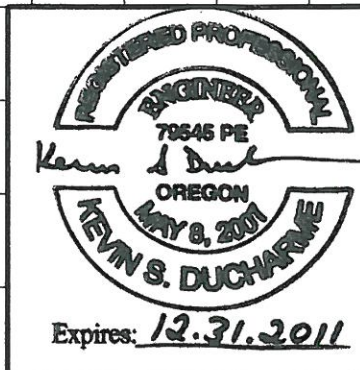

TYL INTERNATIONAL
OREGON DEPARTMENT OF TRANSPORTATION
REGION 3 TECHNICAL SERVICES
ELK CREEK TO HARDSCRABBLE DESIGN BUILD
BUNDLE 401 SECTION
 HIGHWAY 45
 DOUGLAS COUNTY
 Design Team Leader - KSD
 Designed By - PJD
 Drafted By - JG
ELK CREEK CROSSING #3
ALIGNMENT, PROFILE &
GENERAL CONSTRUCTION
 SHEET NO. 3

RECORD DRAWING


This Record Drawing Documents Field Modifications To The Original Design Reported By Others. It Does Not Represent a Field Review Of Construction Activities Provided By The Design Engineer. The Information Shown Has Not Been Verified For Completeness or Accuracy.

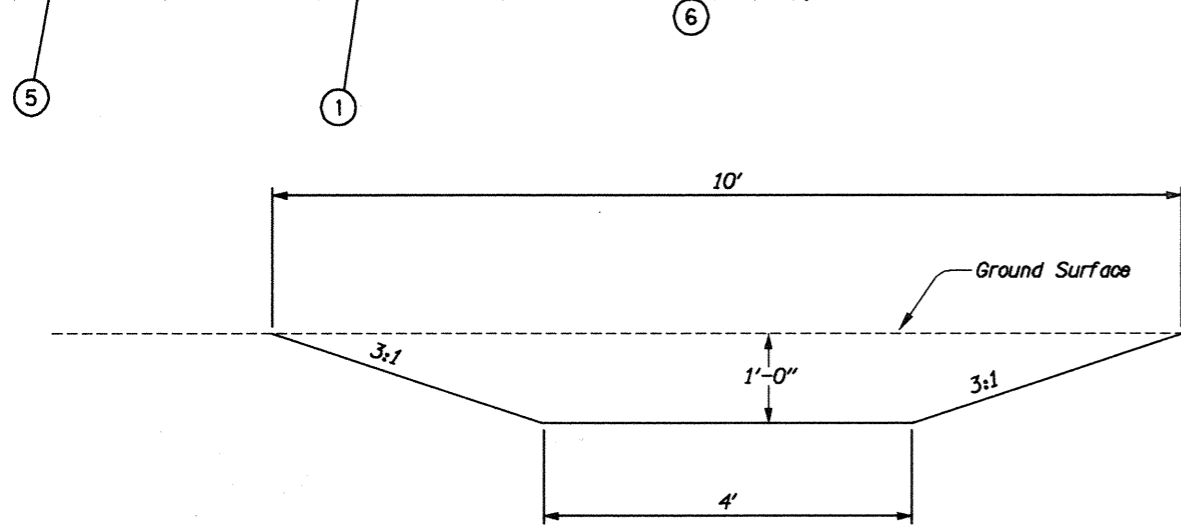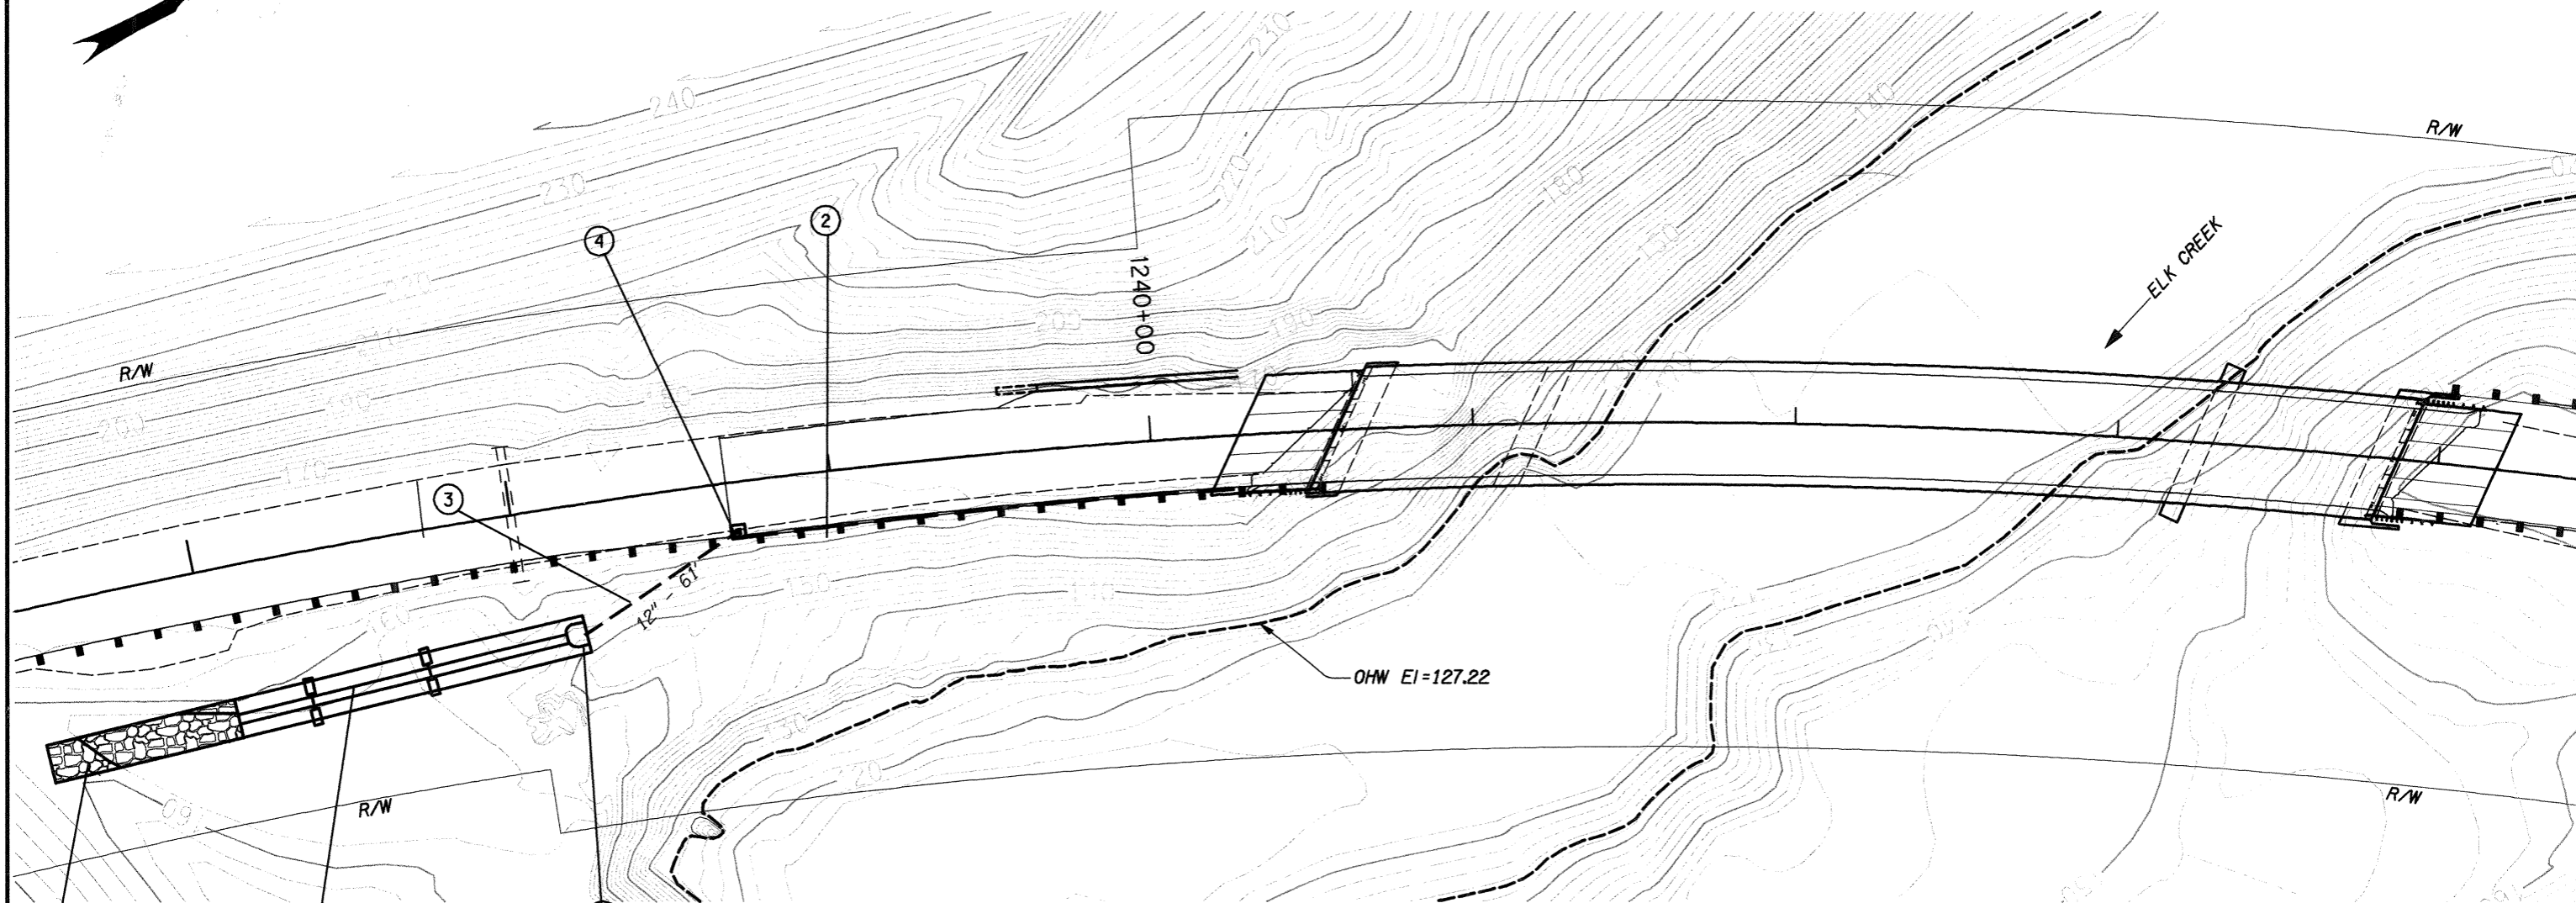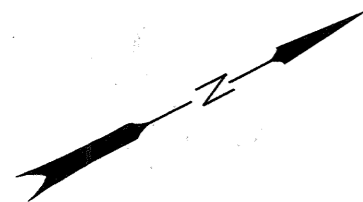

- ① Const. 171'x10' Water Quality Swale At 1% Longitudinal Slope (For Detail See This Sheet) And Special Specifications
- ② Sta. 1238+71.7', 17.2' Rt. To Sta. 1240+25', 16.8' Rt. Const. 6" Drainage Curb From Bridge Deck To Inlet. - 152' (See Drg. No. RD700)
- ③ Sta. 1238+22', 51' Rt. Inst. 12" Dia. Storm Sew. Pipe - 61'
- ④ Sta. 1238+69.3', 15.1' Rt. Const. Storm Water Inlet Type G-1 (See Drg. No. RD364)
- ⑤ Inst. Trapezoidal Rock-Lined Ditch. 0.5' deep 2:1 Side Slopes. 5' Base, Transition From Swale, Class 100 Rip Rap.
- ⑥ Const. Energy Dissipator Splash Pad. 5' Wide x 4' Long x 2-3' Deep, Using Class 50 Rip Rap

Check Dam

NOTE:
Final Locations And Elevations Will Be Based On The Final Site Grading Plan. The Final Grading Plan Must Be Checked For Compatibility With Stormwater Design Features Prior To Construction. Accordingly, Design Features May Need To Be Modified And Other Design Features May Need To Be Added.

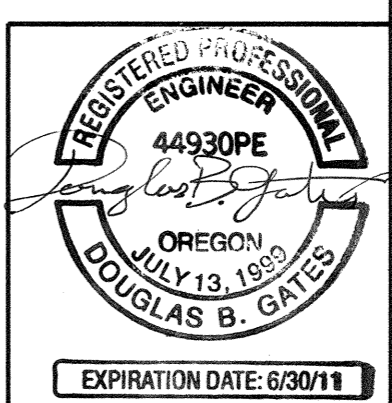

| | |
|--|-----------------|
| Parametrix | |
| OREGON DEPARTMENT OF TRANSPORTATION | |
| ELK CREEK TO HARDSCRABBLE DESIGN BUILD BUNDLE 401 SECTION HIGHWAY 45 DOUGLAS COUNTY | |
| Design Team Leader - Randy Reeve Designed By - Douglas Gates Drafted By - Paula Morgan | |
| ELK CREEK BRIDGE (CROSSING NO. 3) STORM WATER MANAGEMENT | SHEET NO. GJ |