

OPERATION & MAINTENANCE MANUAL

DFI No.: D00399

**Facility Type: Water Quality Biofiltration
Swale**



MARCH, 2011

INDEX

1. IDENTIFICATION 1

2. FACILITY CONTACT INFORMATION..... 1

3. CONSTRUCTION..... 1

4. STORM DRAIN SYSTEM AND FACILITY OVERVIEW 1

5. FACILITY HAZ MAT SPILL FEATURE(S)..... 5

6. AUXILIARY OUTLET (HIGH FLOW BYPASS) 5

7. MAINTENANCE REQUIREMENTS 5

8. WASTE MATERIAL HANDLING 6

APPENDIX A: Operational Plan and Profile Drawing(s)

APPENDIX B: ODOT Project Plan Sheets

1. Identification

Drainage Facility ID (DFI): **D00399**
Facility Type: Water Quality Biofiltration Swale
Construction Drawings: (V-File Number) 41V-055
Location: District: 7
Highway No.: 045
Mile Post: 39.98 / 40.00 (beg./end)
Description: This facility is located on the northern side of OR38 (Hwy 045, Umpqua Highway). Access can be obtained from the westbound shoulder of OR38.

2. Facility Contact Information

Contact the Engineer of Record, Region Technical Center, or Geo-Environmental's Senior Hydraulics Engineer for:

- Operational clarification
- Maintenance clarification
- Repair or restoration assistance

Engineering Contacts:

Region Technical Center Hydraulics Engineer (541) 957-3693

Or

Geo-Environmental Senior Hydraulics Engineer (503) 986-3365.

3. Construction

Engineer of Record: Consultant Designer – T.Y. Lin International., Kevin Ducharme, P.E., 503-385-4200.

Facility construction: 2008
Contractor: Slayden Construction Group

4. Storm Drain System and Facility Overview

A water quality swale is a flat-bottomed open channel designed to treat stormwater runoff from highway pavement areas. This type of facility is lined with grass. Treatment by trapping sedimentation occurs when stormwater runoff flows through the grass.

Stormwater is conveyed to the facility from a storm sewer system that collects water from the Elk Creek Bridge. A 12-inch storm pipe delivers the stormwater to the beginning of the swale. Sheet flow from OR38 also contributes runoff directly to the swale. Refer to the Operational Plan in Appendix A for further information. Water conveyed into the swale undergoes treatment as it flows through the length of the channel. The treated water flows out of the swale and into a ditch which discharges into Elk Creek.

A. Maintenance equipment access:

Maintenance crews can access the facility from the westbound shoulder of OR38.

B. Heavy equipment access into facility:

- Allowed (no limitations)
- Allowed (with limitations)
- Not allowed

C. Special Features:

- Amended Soils
- Porous Pavers
- Liners
- Underdrains



Photo 1: Looking west, storm flow generated from OR38 on the left side of the picture contributes stormwater into the swale. Stormwater is flowing from the bottom of the picture towards top of the picture.

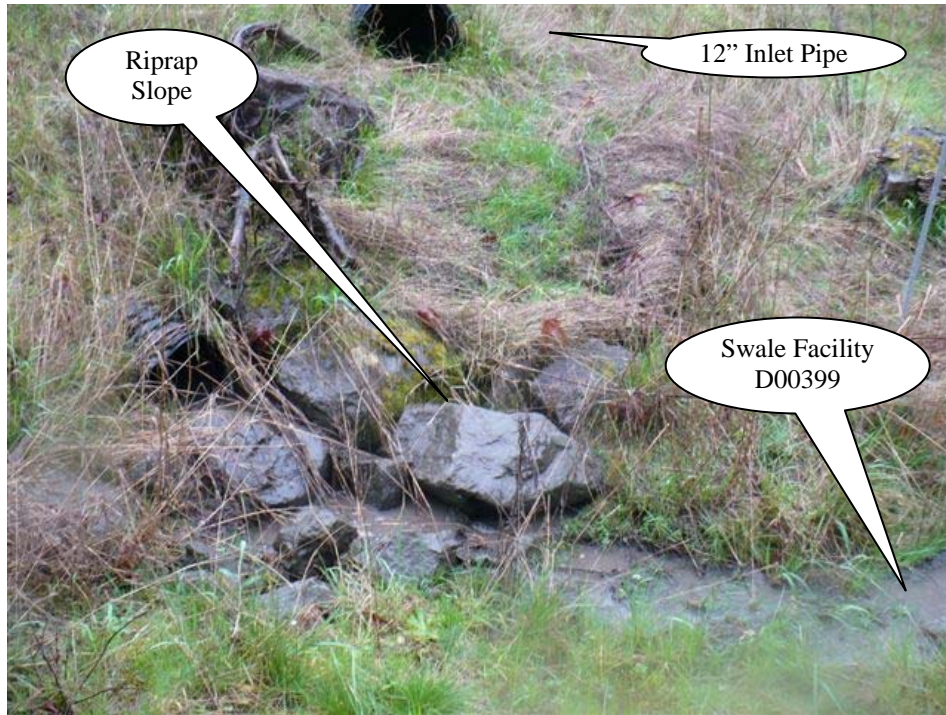


Photo 2: Looking east, storm flow generated from contributes stormwater into the swale. The 12" inlet pipe shown contributes storm flow from the Elk Creek Bridge.

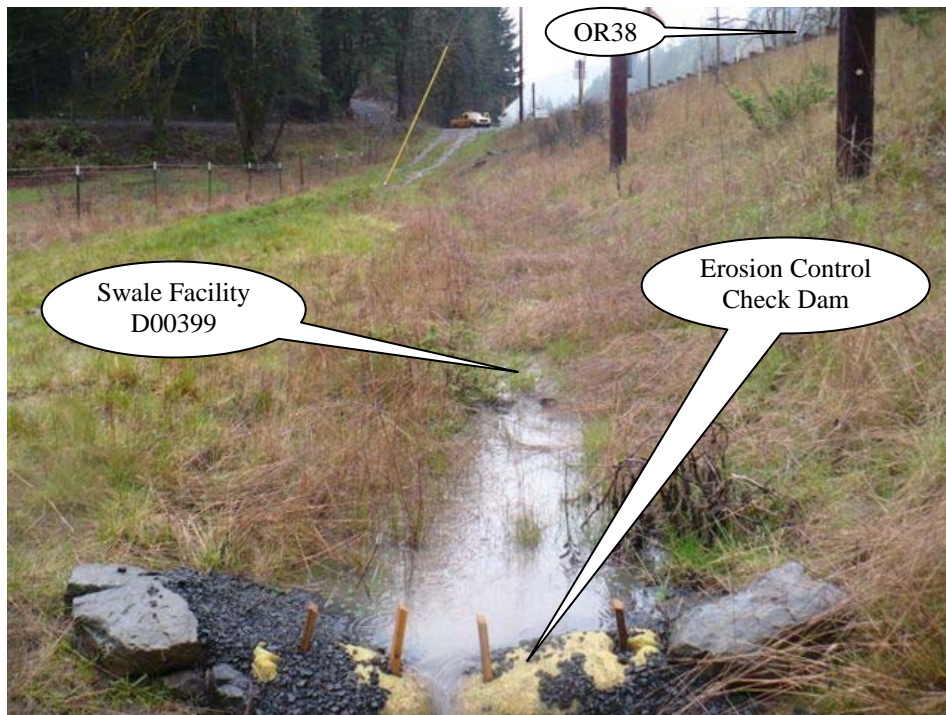


Photo 3: Looking east, storm flow generated from OR38 on the right side of the picture contributes stormwater into the swale. Stormwater is flowing from the top of the picture towards the bottom of the picture.

5. Facility Haz Mat Spill Feature(s)

The swale can not be used to feasibly store liquid due to the flat cross section and close proximity to Elk Creek.

6. Auxiliary Outlet (High Flow Bypass)

Auxiliary Outlets are provided if the primary outlet control structure can not safely pass the projected high flows. Broad-crested spillway weirs and over flow risers are the two most common auxiliary outlets used in stormwater treatment facility design. The auxiliary outlet feature is either a part of the facility or an additional storm drain feature/structure.

The auxiliary outlet feature for this facility is:

- Designed into facility
- Other, as noted below
There is no auxiliary outlet for this facility.

7. Maintenance Requirements

Routine maintenance table for non-proprietary stormwater treatment and storage/detention facilities have been incorporated into ODOT's Maintenance Guide. These tables summarize the maintenance requirements for ponds, swales, filter strips, bioslopes, and detention tanks and vaults. Special maintenance requirements in addition to the routine requirements are noted below when applicable.

The ODOT Maintenance Guide can be viewed at the following website:

<http://www.oregon.gov/ODOT/HWY/OOM/MGuide.shtml>

Maintenance requirements for proprietary structures, such as underground water quality manholes and/or vaults with filter media are noted in Appendix C when applicable.

The following stormwater facility maintenance table (See ODOT Maintenance Guide) should be used to maintain the facility outlined in this Operation and Maintenance Manual or follow the Maintenance requirements outlined in Appendix C when proprietary structure is selected below:

- Table 1 (general maintenance)
- Table 2 (stormwater ponds)
- Table 3 (water quality biofiltration swales)

- Table 4 (water quality filter strips)
- Table 5 (water quality bioslopes)
- Table 6 (detention tank)
- Table 7 (detention vault)
- Appendix C (proprietary structure)
- Special Maintenance requirements:

Note: Special maintenance Requirements Require Concurrence from ODOT SR Hydraulics Engineer.

8. Waste Material Handling

Material removed from the facility is defined as waste by DEQ. Refer to the roadwaste section of the ODOT Maintenance Yard Environmental Management System (EMS) Policy and Procedures Manual for disposal options: <http://egov.oregon.gov/ODOT/HWY/OOM/EMS.shtml>


Contact any of the following for more detailed information about management of waste materials found on site:

ODOT Clean Water Unit	(503) 986-3008
ODOT Statewide Hazmat Coordinator	(503) 229-5129
ODOT Region Hazmat Coordinator	(541) 957-3594
ODEQ Northwest Region Office	(503) 229-5263

Appendix A

Content:


- **Operational Plan and Profile Drawing(s)**

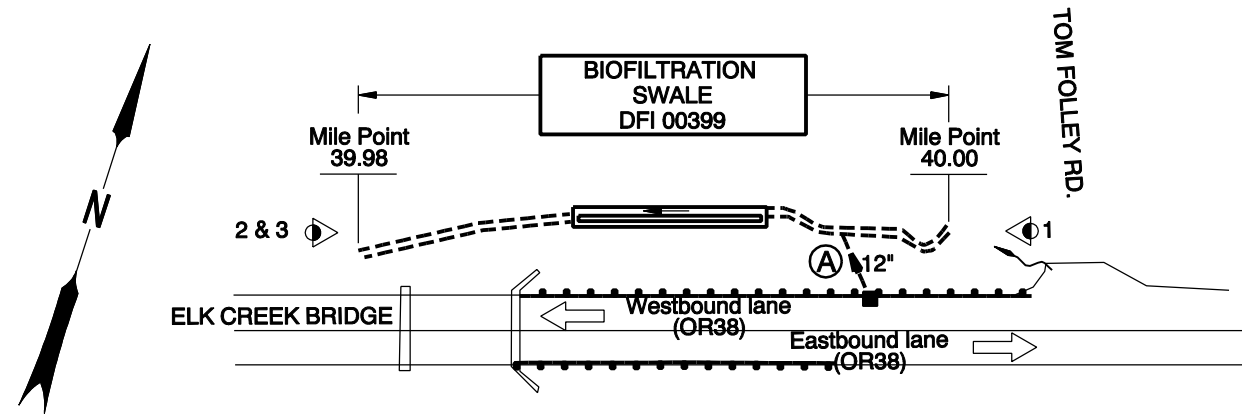

LEGEND:

- ◁ Photo Location / Direction
- Ⓐ 12" Storm drain pipe outfalls into pond
- and □ Inlet
- - - Storm Pipe (Facility)
- ← Conveyance Direction
- ~ Pavement / Facility Flow Path
- Ⓓ Riprap lined ditch

PLAN
N.T.S.

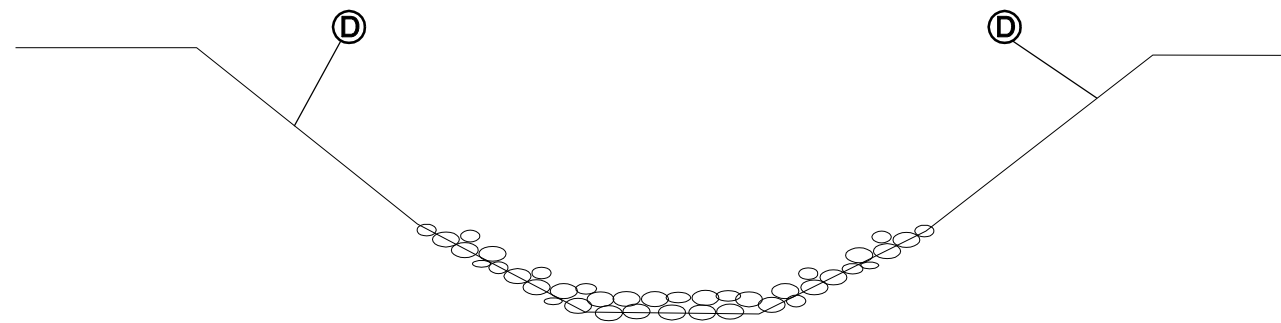

BIOSWALE SECTION
N.T.S.

 OREGON DEPARTMENT OF TRANSPORTATION

Prepared By:
J. Carpenter

Drafted By:
L. Coffel

DFI D00399
MAINTENANCE DISTRICT 7 HWY 45
WATER QUALITY BIOFILTRATION SWALE
UMPQUA HIGHWAY MP 39.98-40.0
DOUGLAS COUNTY

Appendix B

Content:


- **ODOT Project Plan Sheets**
 - *Cover/Title Sheet*
 - *Water Quality/Detention Plan Sheets*
 - *Other Details*

STATE OF OREGON
DEPARTMENT OF TRANSPORTATION
PLANS FOR PROPOSED PROJECT

STRUCTURES, SIGNING & PAVING

OR38: ELK CREEK TO HARDSCRABLE CREEK DESIGN BUILD
BUNDLE 401

UMPQUA HIGHWAY (NO. 45)
DOUGLAS COUNTY
JANUARY 2008

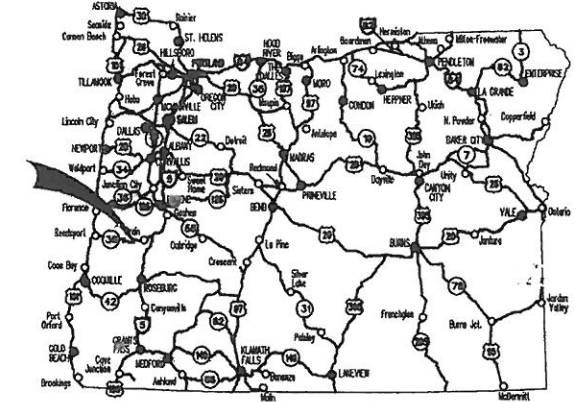

Overall Length Of Project - 11.11 Miles

ATTENTION:
Oregon Law Requires You To Follow Rules
Adopted By The Oregon Utility Notification
Center. Those Rules Are Set Forth In
OAR 952-001-0010 Through OAR 952-001-0090.
You May Obtain Copies Of The Rules By Calling
The Center. (Note: The Telephone Number For
The Oregon Utility Center Is (503) 232-1987.)



REVISED AS CONSTRUCTED
10-APR-2009 CONTRACT #13339
PROJ. MGR. John Ferguson P.E.

OREGON TRANSPORTATION COMMISSION

- Stuart Foster CHAIRMAN
- Gail L. Achterman COMMISSIONER
- Mike Nelson COMMISSIONER
- Randall Pape COMMISSIONER
- John Russell COMMISSIONER
- Matthew Garrett DIRECTOR OF TRANSPORTATION



TYLIN INTERNATIONAL


ELK CREEK TO HARDSCRABLE DESIGN BUILD
UMPQUA HIGHWAY (NO. 45)
DOUGLAS COUNTY

FEDERAL HIGHWAY ADMINISTRATION	PROJECT NUMBER	SHEET NO.
OREGON DIVISION	BSR-OTIA-S045(030)	1

Elk Creek Crossing #1 x2
01614 - Replacement (M.P. 36.39)
BEGINNING OF PROJECT
Sta.1063+00 (M.P. 36.39)


Hardscrabble Creek Crossing
01424 - Replacement (M.P. 47.50)


END OF PROJECT
Sta.1663+00 (M.P. 47.55)

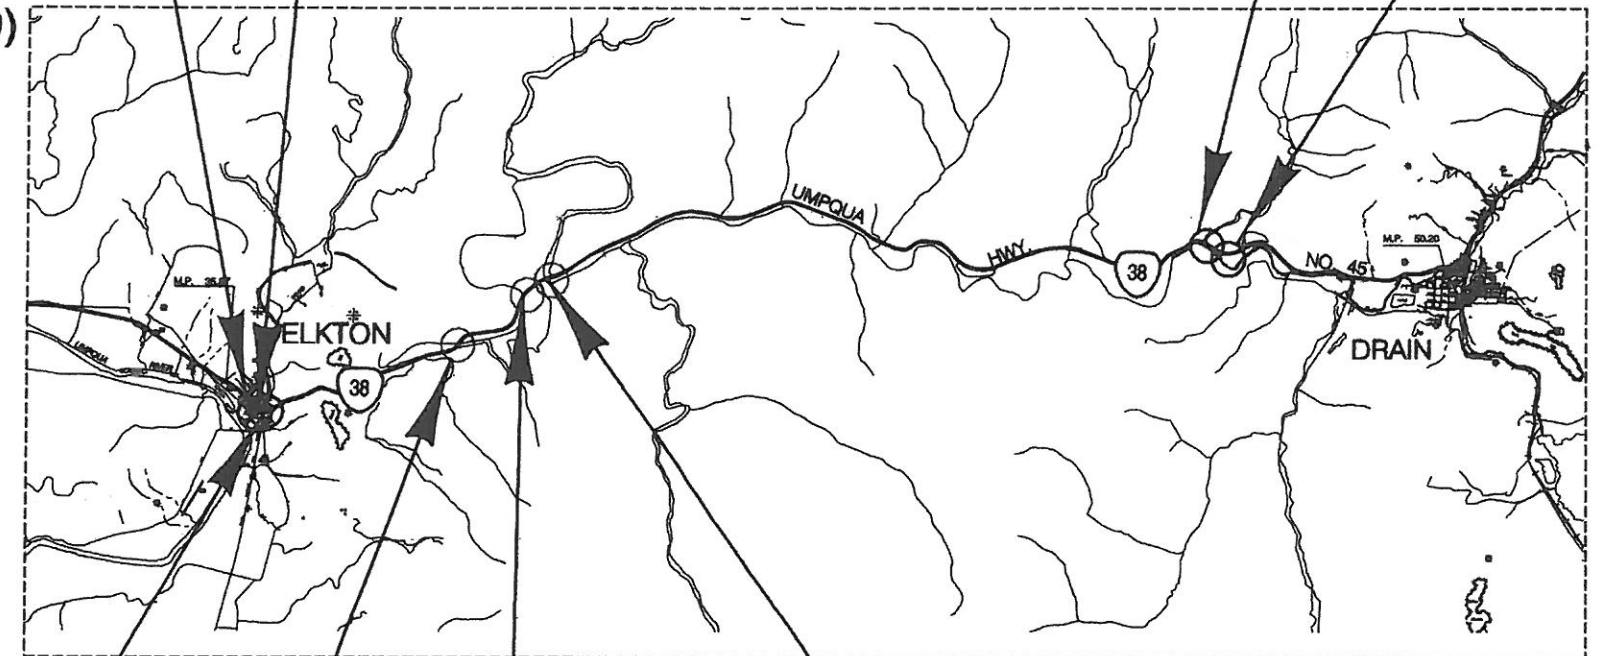

OR38 - OR138
Intersection Upgrade
Elk Creek Crossing #2
01601 - Replacement (M.P. 38.76)

Elk Creek Crossing #4
01406 - Replacement (M.P. 39.97)
Elk Creek Crossing #3
01465 - Replacement (M.P. 39.64)

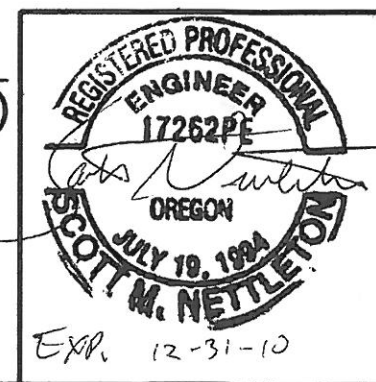

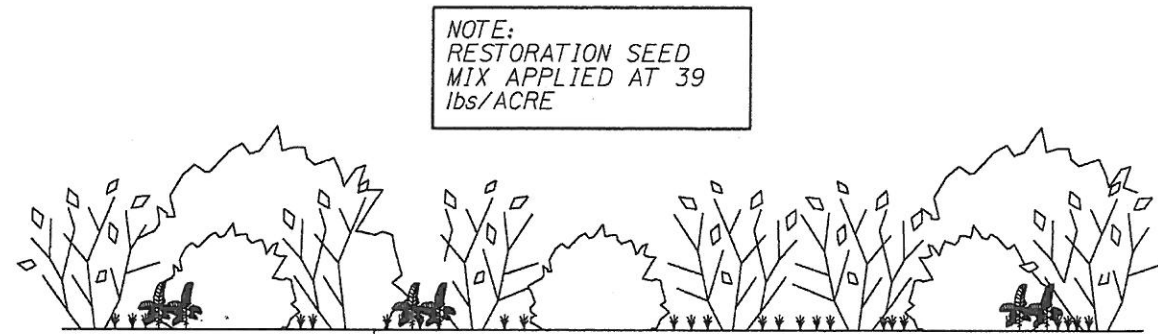


NOTE:
RESTORATION SEED
MIX APPLIED AT 39
lbs/ACRE

TYPICAL RESTORATION PLANTING AREA TYPE 1 CROSS-SECTION
SEE SHEET GN-4



NOTE:
RESTORATION SEED
MIX APPLIED AT 39
lbs/ACRE

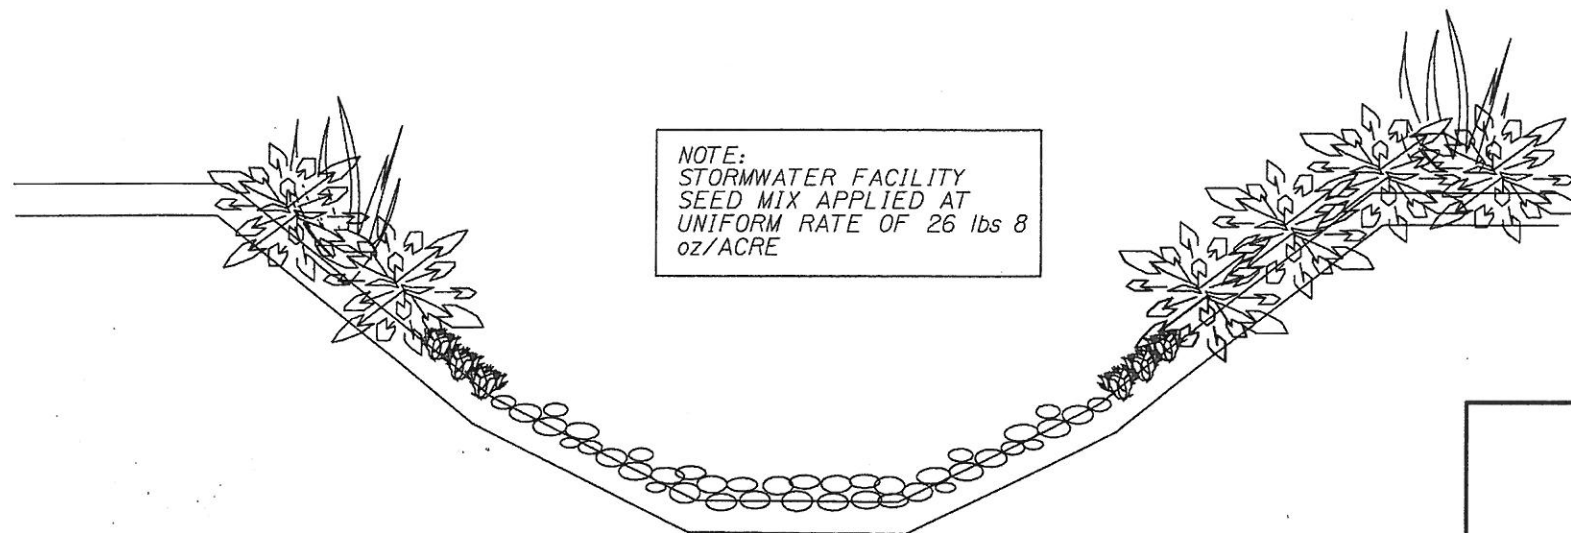


TYPICAL RESTORATION PLANTING AREA TYPE 2 CROSS-SECTION
SEE SHEET GN-5



NOTE:
STORMWATER FACILITY
SEED MIX APPLIED AT
UNIFORM RATE OF 26 lbs 8
oz/ACRE

TYPICAL BIOSWALE CROSS-SECTION


REVISED AS CONSTRUCTED
18-Feb-2010 CONTRACT C13319

	Engineering + Environmental		 OREGON DEPARTMENT OF TRANSPORTATION REGION 3 TECHNICAL SERVICES	SHEET NO. GN-6
			ELK CREEK TO HARDSCRABBLE DESIGN BUILD BUNDLE 401 HIGHWAY 45 DOUGLAS COUNTY	
			Design Team Leader - Frank Groznik Designed By - Morgan Holen and Elisabeth Bowers Drafted By - Don James and Fouad El-Gharabli	PLANTING DETAILS

Crossing #4

Sec. 14, T. 22 S., R. 5 W., W.M.



41V-55

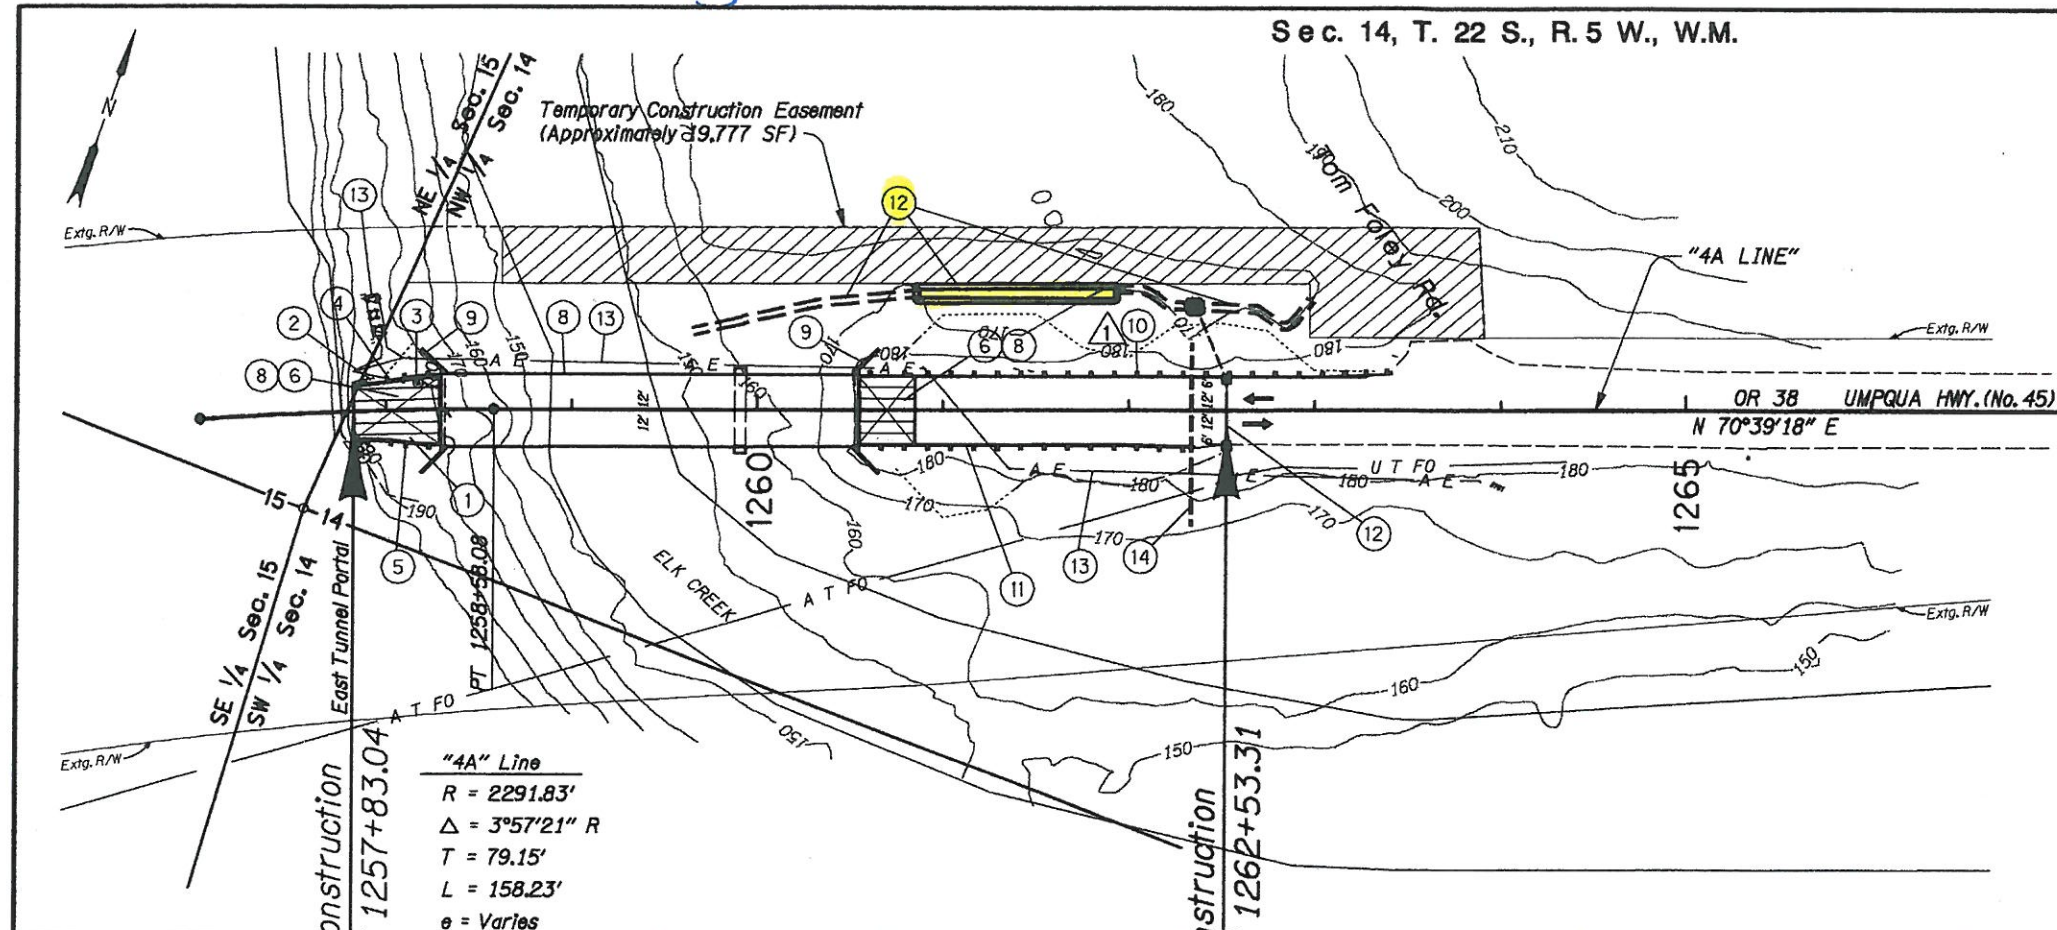


CONSTRUCTION NOTES

- ① Sta. "4A" 1257+83 to 1258+30
Remove Extg. Guardrail
- ② Sta. "4A" 1257+83 to 1257+95
Remove Extg. Guardrail
- ③ Sta. "4A" 1258+09 to 1258+19
Remove Extg. Guardrail
- ④ Sta. "4A" 1257+83 to 1258+29.81
Const. Guardrail Transition
Const. Guardrail Type 4
Const. Guardrail Transition
(See Detail Sheet 2B-2)
- ⑤ Sta. "4A" 1257+83 to 1258+29.81
Const. Guardrail Transition
Const. Guardrail Type 4
Const. Guardrail Transition
(See Detail Sheet 2B-2)
- ⑥ Remove Extg. PCC Roadway
- ⑦ Bridge No. 20585
Const. Structure - 222'
Const. Substructure
Const. Cast-In-Place Wingwalls
Roadway Width - 36'
Inst. Reinforced Panels At Bridge Ends
(For Drg. Nos. See Sheet 1A)
- ⑧ Bridge No. 20585
Inst. Precast Wingwalls
(For Drg. Nos. See Sheet 1A)
- ⑩ Sta. "4A" 1260+54.81 to Sta. "4A" 1263+35.3, 60' Lt.
Remove Extg. Guardrail
Const. Guardrail Transition
Const. Guardrail (Type 2A) - 292.3'
Const. Energy Absorbing Terminal
Flare Rate=0, W=4', E=2'
(For Details See BR203, DET 240, DET 241, RD400, RD405, RD410, RD415 & RD420)
- ⑪ Sta. "4A" 1260+54.81 to 1262+35.7
Remove Extg. Guardrail
Const. Guardrail Transition
Const. Guardrail Type 2A - 125'
Const. Energy Absorbing Terminal
Flare Rate=0, W=4', E=2'
(For Details See BR203, RD400, RD405, RD410, RD415 & RD420)
- ⑫ Construct Stormwater Treatment Facility
(See Geo/Hydro Sheets for Details)
- ⑬ Relocate Existing Utility (by Others)
(See Utility Plans for Details)
- ⑭ Install Wildlife Crossing Culvert
(See Geo/Hydro Sheets for Details)

REVISED AS CONSTRUCTED
10-APR-2009 CONTRACT #13339

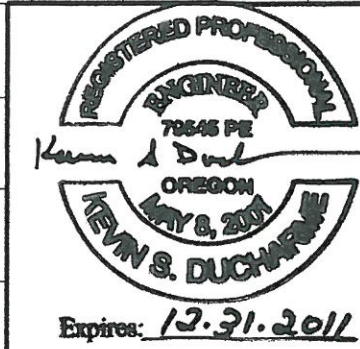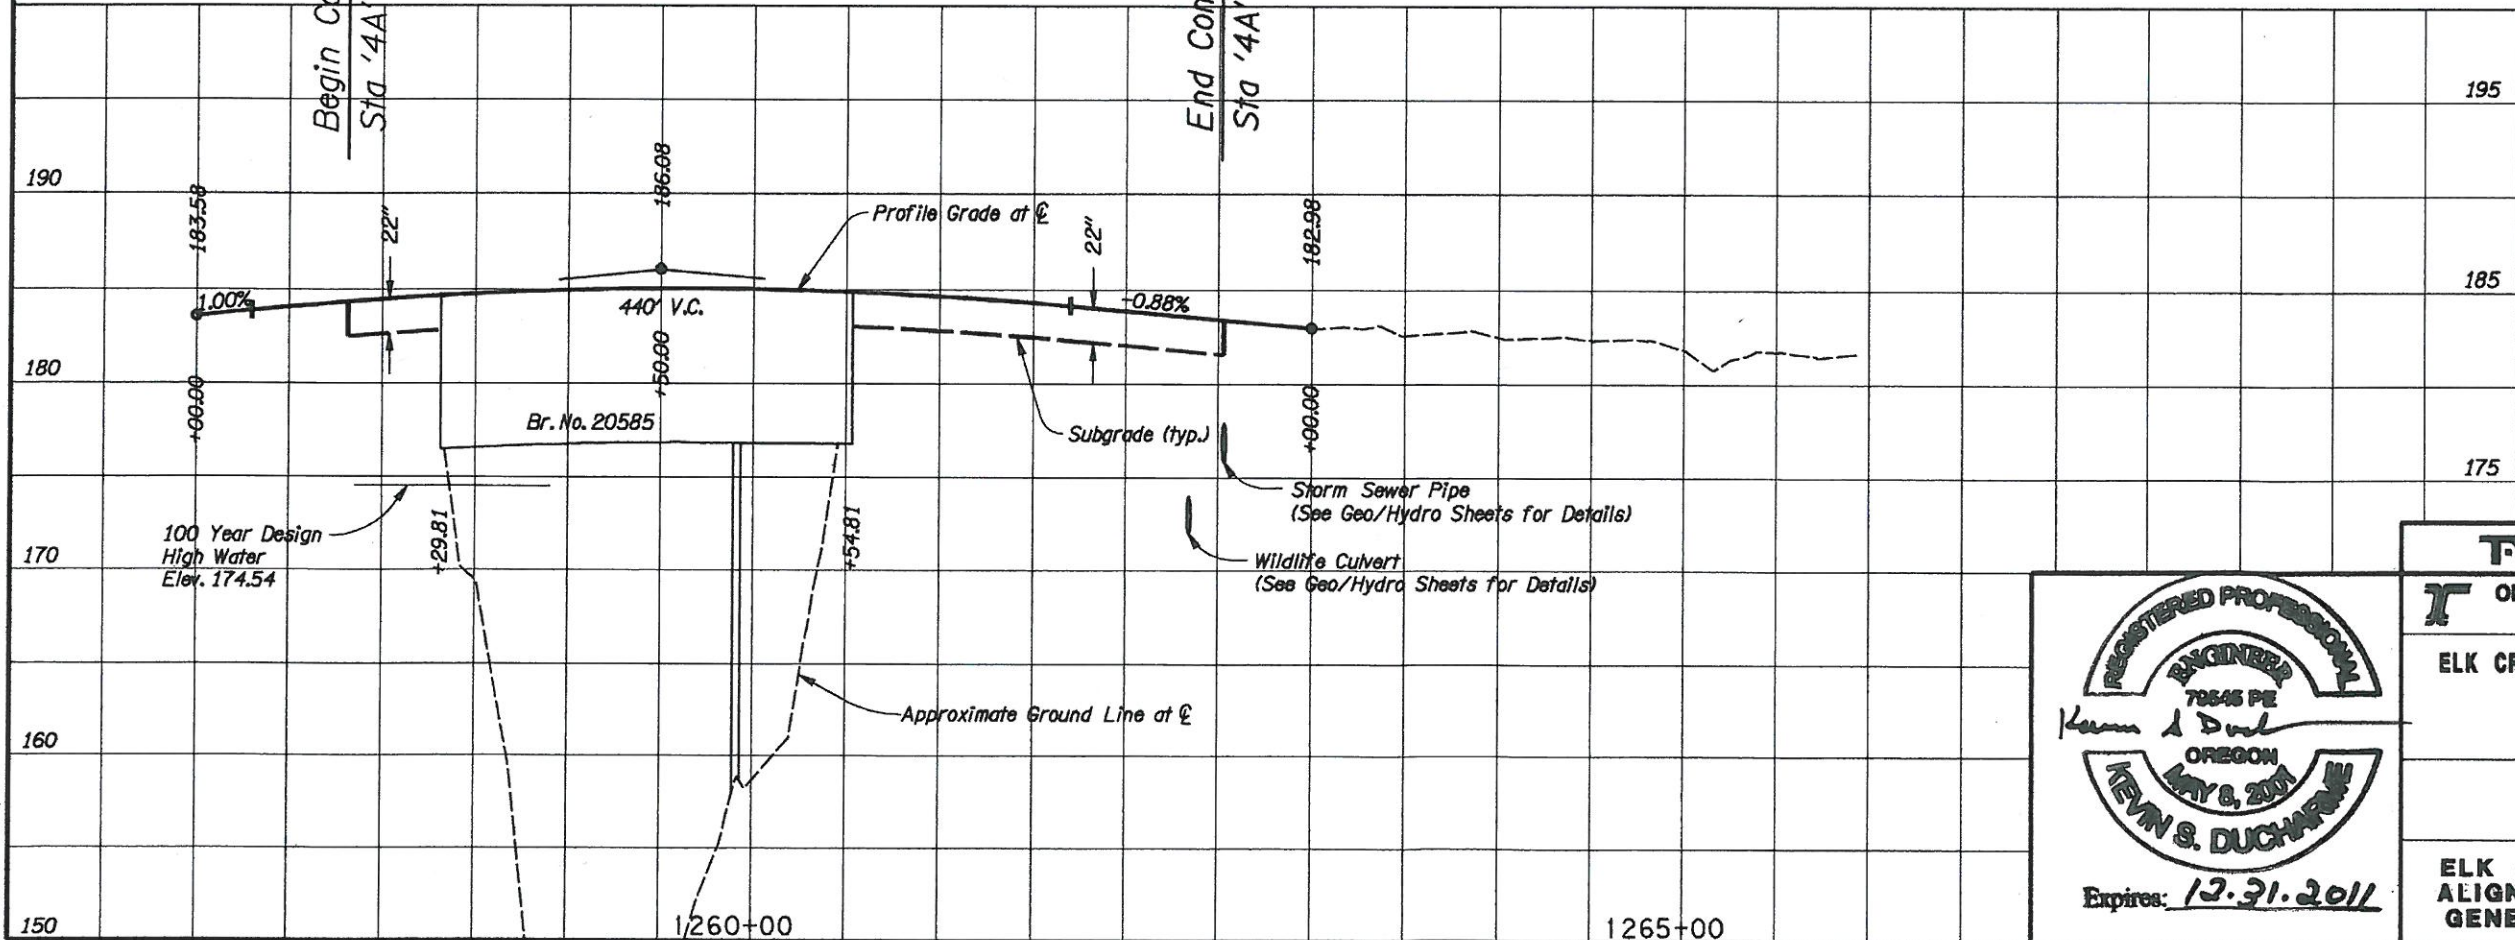


TYLINT INTERNATIONAL
OREGON DEPARTMENT OF TRANSPORTATION
REGION 3 TECHNICAL SERVICES
ELK CREEK TO HARDCRABBLE DESIGN BUILD BUNDLE 401 SECTION
 HIGHWAY 45
 DOUGLAS COUNTY
 Design Team Leader - KSD
 Designed By - TSK
 Drafted By - TSK
ELK CREEK CROSSING #4 ALIGNMENT, PROFILE AND GENERAL CONSTRUCTION
 SHEET NO. 4

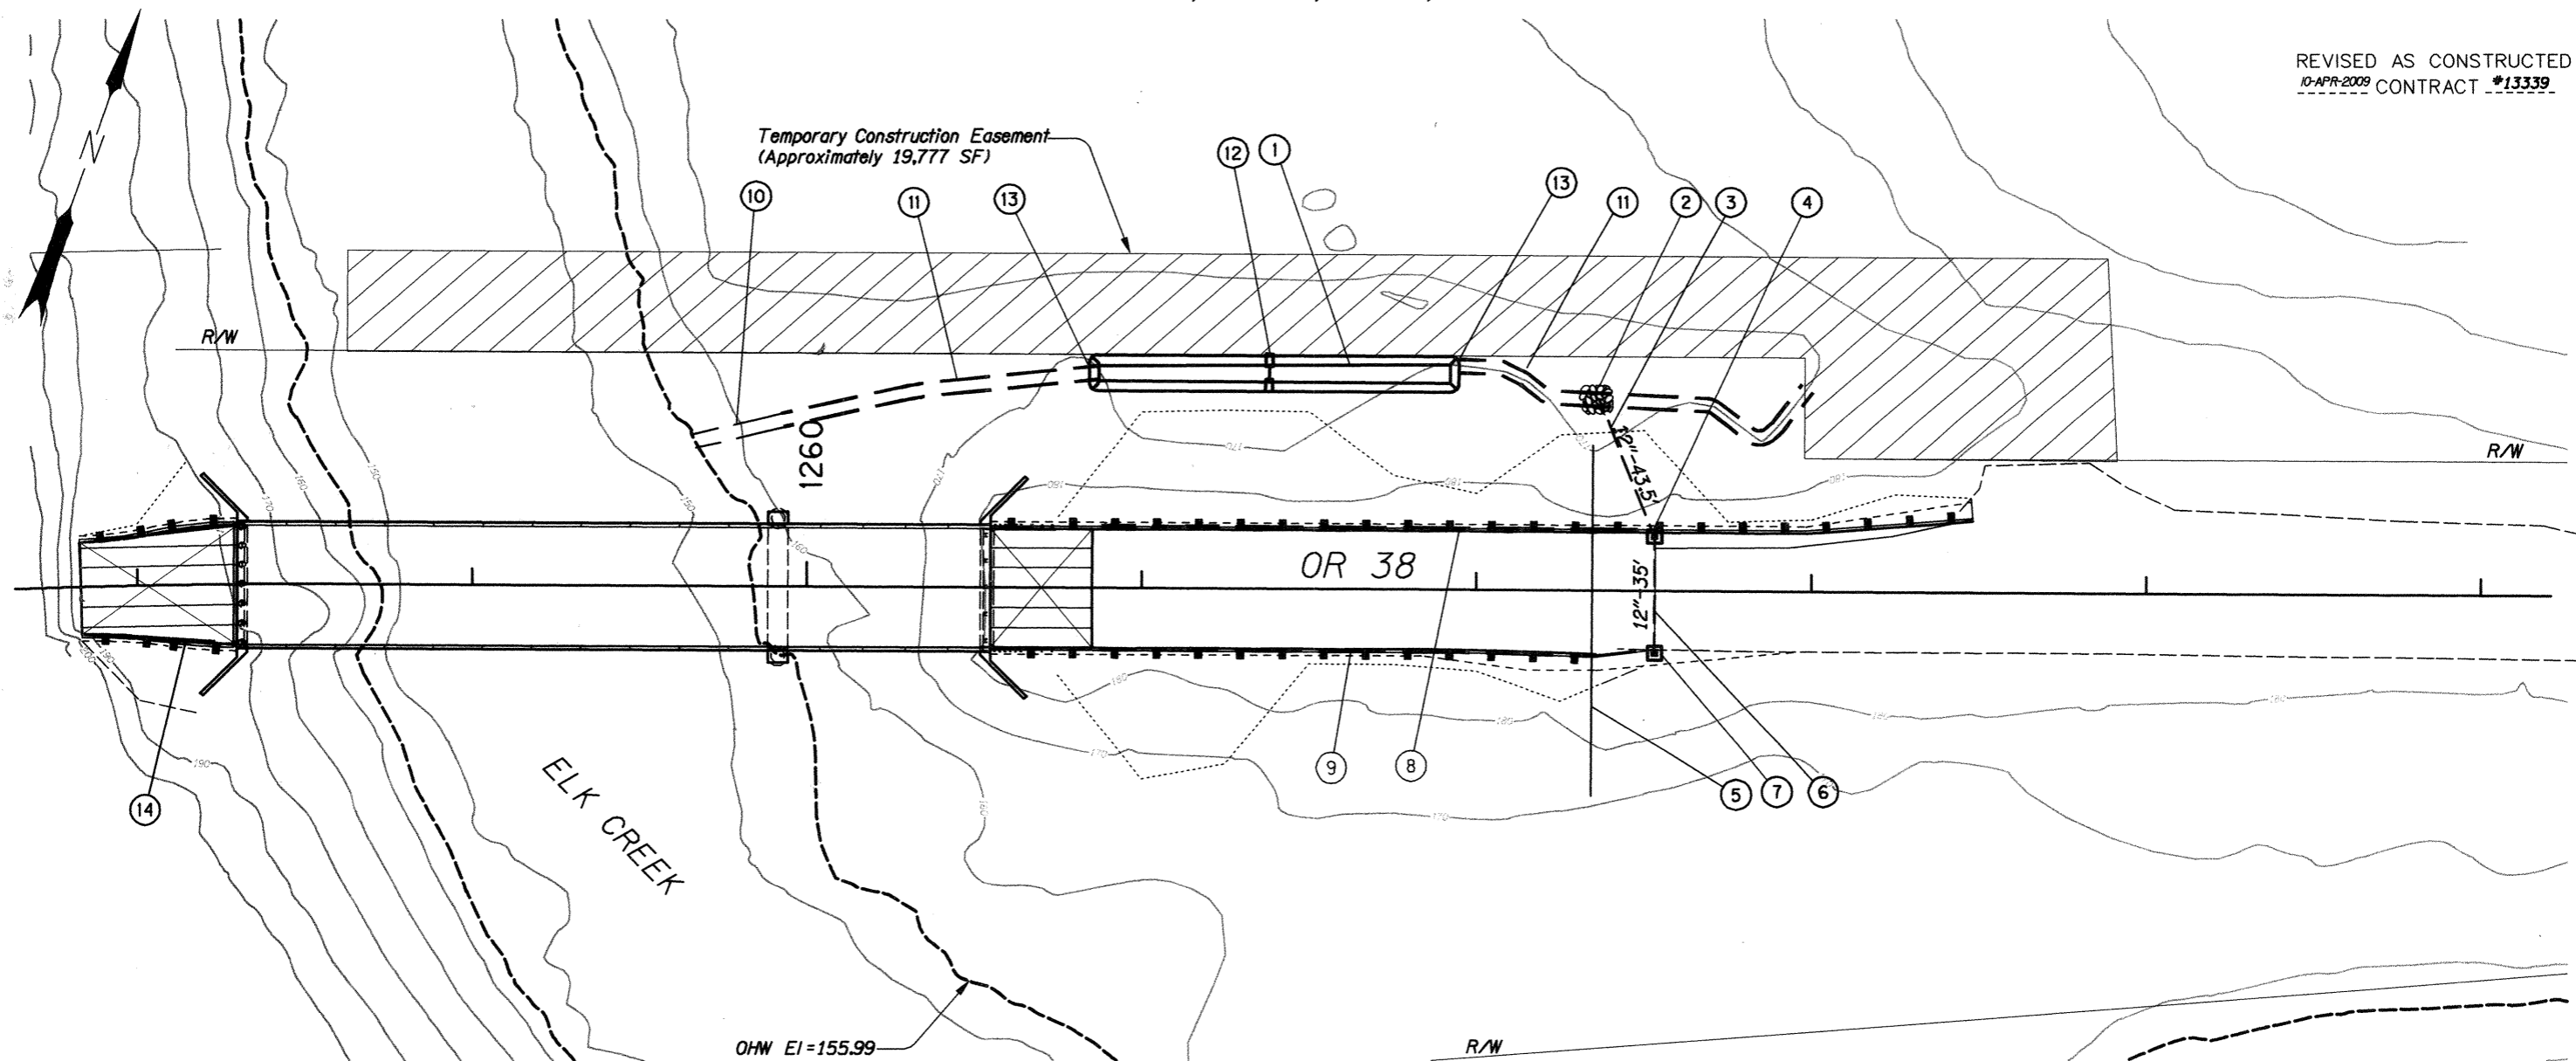


- ① Const. 110'x10' Water Quality Swale, S=1% (For Detail See This Sheet)
- ② Install Energy Dissipator, 5' Wide, 4' Long, 2.3' Deep. Using Class 50 Rip Rap
- ③ Sta. 1261+91.23', 64.4' Lt. Install 12" Storm Sew. Pipe - 43.5'
- ④ Sta. 1262+53.12', 16.6' Lt. Install Type G1 Inlet (See Drg. No. RD364)
- ⑤ Install Wildlife Crossing Culvert, ADS 24" Corrugated Pipe - 105', Fill With 4"-6" Clean Top Soil At IE In = 172' IE Out = 172'
- ⑥ Sta. 1262+53.12', 16.6' Lt. To Sta. 1262+53.12', 18.5' Rt. Install 12" Storm Sew. Pipe - 35'
- ⑦ Sta. 1262+53.12', 18.5' Rt. Install Type G1 Inlet (See Drg. No. RD364)

- ⑧ Sta. 1260+54.81', To Sta. 1262+50.93', 18' Lt. Install Drainage 6" Curb In Front Of Guardrails At Edge Of Paving Extend From Bridge Barrier To Inlet.
- ⑨ Sta. 1260+54.81' To Sta. 1262+50.77', 18' Rt. Install Drainage 6" Curb In Front Of Guardrails At Edge Of Paving Extend From Bridge Barrier To Inlet.
- ⑩ Install V-Shaped Rock Lined Ditch 1' Deep, 2:1 Side Slopes, Class 100 RipRap
- ⑪ Install V-Shaped Grass Lined Ditch, 3:1 Side Slopes, Depth - 1'
- ⑫ Install Check Dam
- ⑬ Transition Ditch To Swale
- ⑭ Sta. 1257+88' To Sta. 1258+29.81', Rt. Install Drainage 6" Curb In Front Of Guardrails At Edge Of Paving

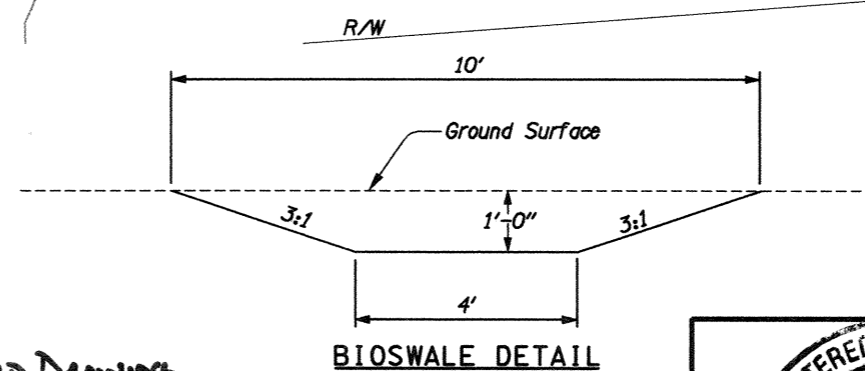

RECORD DRAWING
THIS RECORD DRAWING DOCUMENTS FIELD MODIFICATIONS TO THE ORIGINAL DRAWINGS DESIGN REPORTED BY OTHERS. IT DOES NOT REPRESENT A FIELD REVIEW OF CONSTRUCTION ACTIVITIES PROVIDED BY THE DESIGN ENGINEER. THE INFORMATION SHOWN HAS NOT BEEN VERIFIED FOR COMPLETENESS OR ACCURACY.

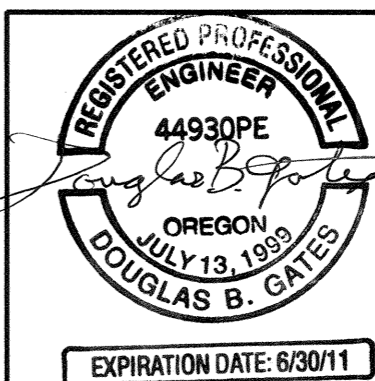

NOTE:
Final Locations And Elevations Will Be Based On The Final Site Grading Plan. The Final Grading Plan Must Be Checked For Compatibility With Stormwater Design Features Prior To Construction. Accordingly, Design Features May Need To Be Modified And Other Design Features May Need To Be Added.

Parametrix	
OREGON DEPARTMENT OF TRANSPORTATION	
ELK CREEK TO HARDCRABBLE DESIGN BUILD BUNDLE 401 SECTION	
HIGHWAY 45 DOUGLAS COUNTY	
Design Team Leader - Randy Reeve Designed By - Douglas Gates Drafted By - Paula Morgan	
ELK CREEK BRIDGE 01406 (CROSSING NO. 4) STORM WATER MANAGEMENT	SHEET NO. GJ-2