

OPERATION & MAINTENANCE MANUAL

Manual prepared: September 2017

DFI No. D00476



Figure 1: DFI No. D00476, looking East

1. Identification

Drainage Facility ID (DFI): D00476
Facility Type: Water Quality Biofiltration Swale
Construction Drawings: (V-File Numbers) 41V-028
Location: District: 10
Highway No.: 041
Mile Post: 33.96 to 33.98, Left

2. Manual Purpose

The purpose of this manual is to outline inspection needs and summarize maintenance actions.

3. Facility Location

The location map below details the facility location. The highway, mile posts, side streets, access location, and stormwater flow directions are noted on the map.

Flow direction: East

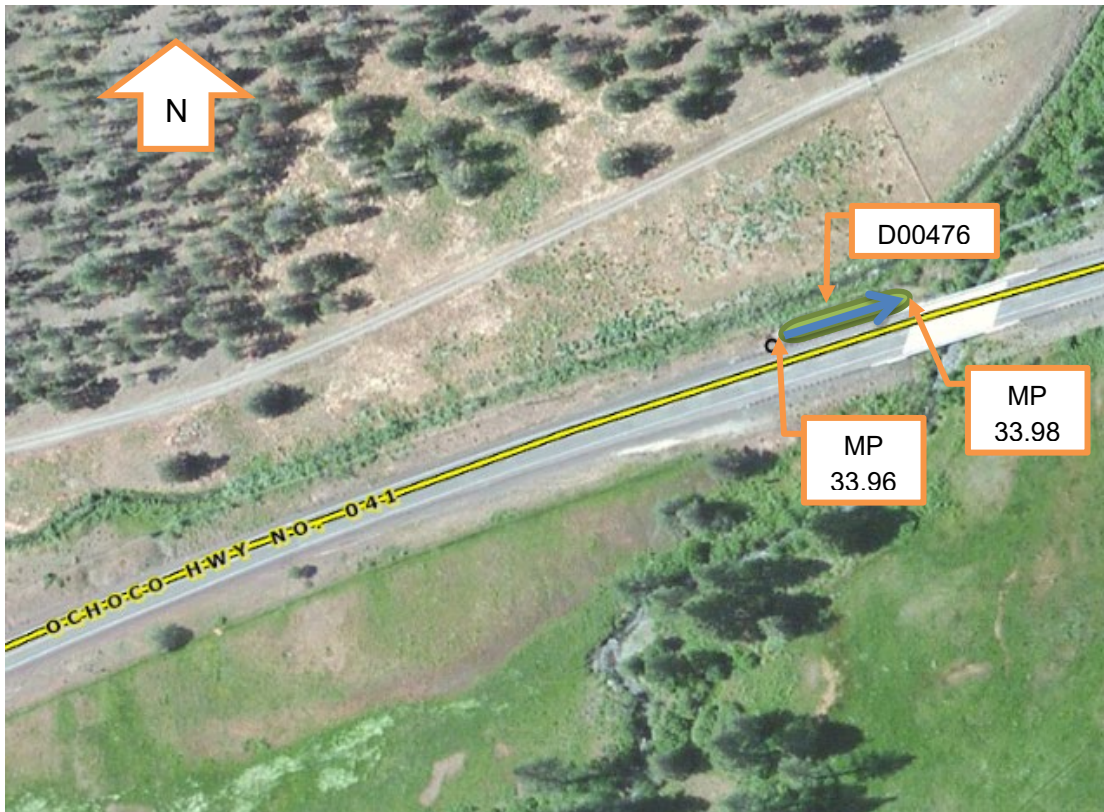



Figure 2: Facility location map

4. Facility Summary

The length and width of a swale is based on the bottom dimensions.

The bottom length and bottom width of the swale is:


Bottom Length (feet)	Bottom Width (feet)
150	4

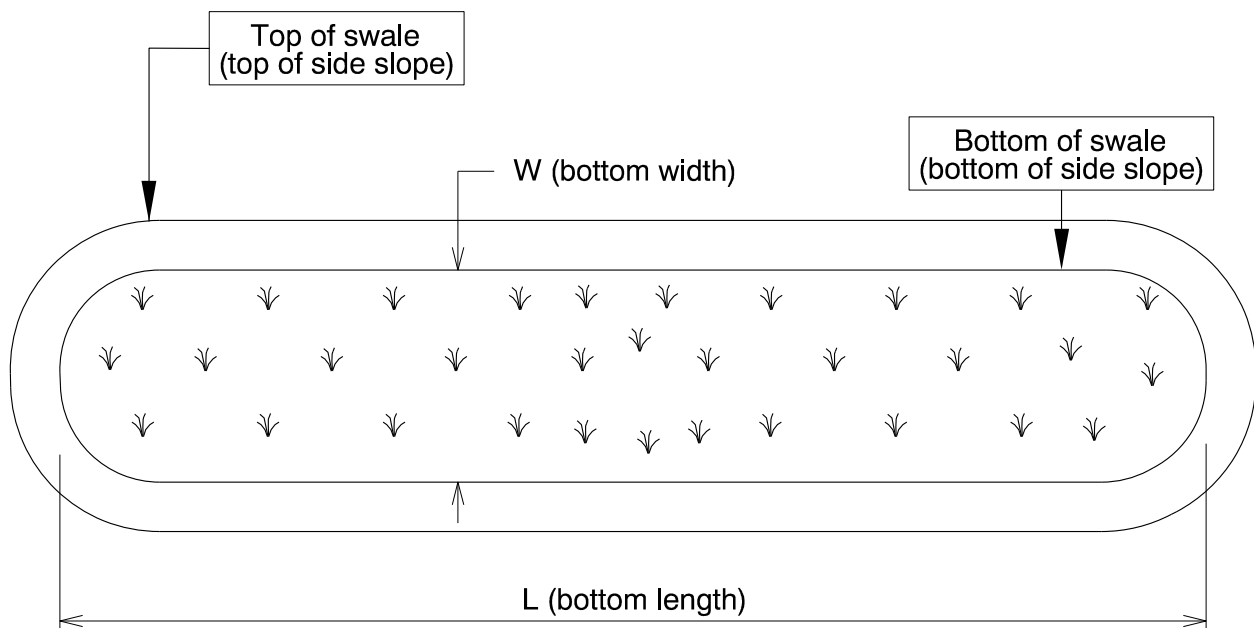

The depth of the swale is the vertical distance measured from the bottom of the swale to the top. The slope of the swale sides is presented by a vertical distance (rise) followed by the horizontal distance (run).

Depth and side slopes:

Depth (feet)	Rise (feet)	Run (feet)
1	1	4

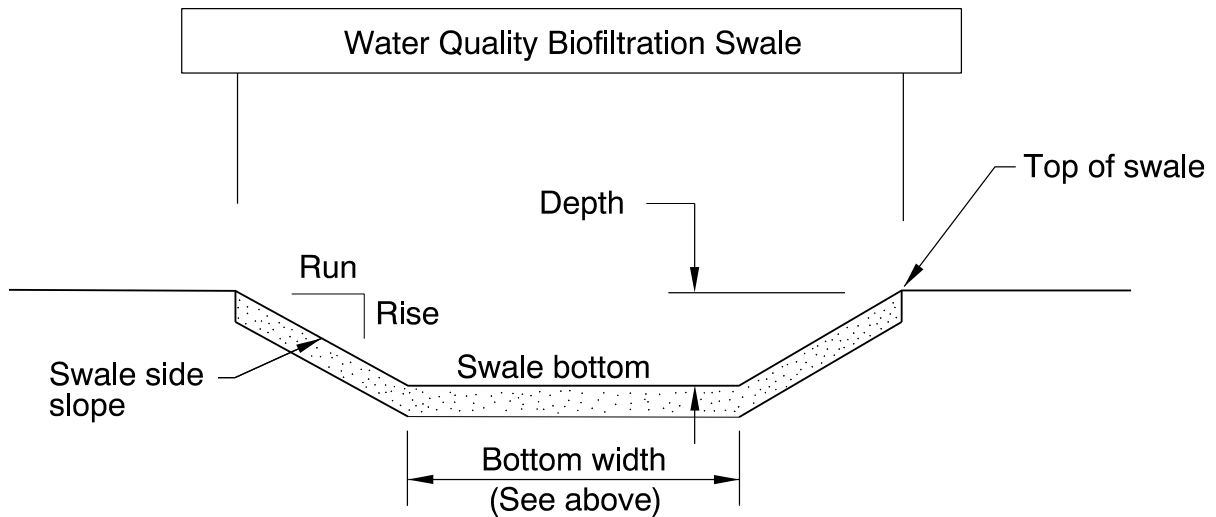

Site Specific Information:

5. Facility Access

Maintenance access to the facility:

<input type="checkbox"/> Roadside pad	<input checked="" type="checkbox"/> Roadside shoulder
<input type="checkbox"/> Access road with Gate	<input type="checkbox"/> Access road without Gate



Figure 3: Facility access via roadside shoulder, looking East

6. Operational Components / Maintenance Items

Classification

This facility is classified as an:

<input checked="" type="checkbox"/> On-line Swale	<input type="checkbox"/> Off-line Swale
A swale that does not include a high flow bypass component; flow drains into and through the facility	A swale that treats low/small flows and diverts high flows using a bypass component

Bypass Component

This facility includes a high flow bypass component:

<input checked="" type="checkbox"/> No	<input type="checkbox"/> Yes
There is no bypass component. High flows drain into and through the facility	There is a bypass component. Only low/small flows drain into the swale. High flows are diverted around the swale using a bypass component

Operational Components

A swale has many components that assist with treatment, conveyance, and reducing flow velocity to minimize erosion. The components in use can vary depending if the facility was designed to operate on-line or off-line. The facility components table (**Table 1**) has been provided to highlight the applicable components for this facility. The component is in use when the box contains an “x” (e.g.).

The Standard Operation Manual for Water Quality Biofiltration Swales (implemented March 2017) outlines facility operation, typical footprint configuration, and component definitions and details. A link to the manual is attached to the feature marker in TransGIS.

<https://gis.odot.state.or.us/TransGIS/>

Operational Plan

The applicable standard operational plan for this facility is:

<input checked="" type="checkbox"/> Operational Plan A <input type="checkbox"/> Operational Plan B <input type="checkbox"/> Operational Plan C
A standard operational plan illustrates the general facility footprint configuration and explains the purpose of each facility component. Operational plans (A, B, C) are provided in the Standard Operation Manual.

See Appendix A for the site specific operational plan.

Maintenance Items

Operational components marked in **Table 1** should be inspected and maintained according to Section 7. Each facility component is defined and detailed in the Standard Operation Manual using the associated ID number indicated below.

Table 1: Swale Components		ID #
Manholes/Structures		
Pre-treatment manhole	<input type="checkbox"/>	S1
Weir type flow splitter/flow splitter manhole	<input type="checkbox"/>	S2
Orifice type flow splitter/flow splitter manhole	<input type="checkbox"/>	S3
Standard manhole	<input type="checkbox"/>	S4
Swale Inlet		
Pavement sheet flow	<input type="checkbox"/>	S5
Inlet Pipe (s)	<input checked="" type="checkbox"/>	S6
Open channel inlet	<input type="checkbox"/>	S7
Riprap pad	<input checked="" type="checkbox"/>	S8
Ground Cover		
Grass bottom	<input checked="" type="checkbox"/>	S9
Grass side slopes	<input type="checkbox"/>	S10
Granular drain rock	<input type="checkbox"/>	S11
Plantings	<input type="checkbox"/>	S12
Underground Components		
Geotextile fabric	<input type="checkbox"/>	S13
Water quality mix	<input checked="" type="checkbox"/>	S14
Perforated pipe	<input type="checkbox"/>	S15
Porous pavers (access grid)	<input type="checkbox"/>	S16
Flow Spreader		
Rock basin (used at inlet)	<input type="checkbox"/>	S17
Anchored board (midpoint of swale or every 50 feet along swale bottom)	<input type="checkbox"/>	S18
Other:	<input type="checkbox"/>	S19
Swale Outlet		
Catch basin with grate	<input type="checkbox"/>	S20
Outlet Pipe (s)	<input type="checkbox"/>	S21
Open channel outlet	<input checked="" type="checkbox"/>	S22
Auxiliary Outlet:	<input type="checkbox"/>	S23
Outfall Type		
Waterbody (Creek/Lake/Ocean)	<input checked="" type="checkbox"/> C	S24
	<input type="checkbox"/> L	
	<input type="checkbox"/> O	
Ditch	<input type="checkbox"/>	S25
Storm drain system	<input type="checkbox"/>	S26
Outfall Components		
Riprap pad	<input checked="" type="checkbox"/>	S27
Riprap bank protection	<input type="checkbox"/>	S28

7. Maintenance

Maintenance Frequency/Maintain Records

- a. Inspect annually. Preferably prior to the rainy season.
- b. Clean and maintain as necessary. Refer to Activity 125 for conditions when maintenance is needed.
- c. Keep a record of inspections, maintenance, and repairs.

Maintenance Guide/Maintenance Actions

The ODOT Routine Road Maintenance Water Quality and Habitat Guide (the *Blue Book*) outlines the standard maintenance actions for water quality facilities under Activity 125.

There are standard maintenance tables for standard ODOT designs. The maintenance tables describe the maintenance component, the defect or problem, the condition when maintenance is needed, and the recommended maintenance to correct the problem. Use the following tables to maintain ODOT swales:

- Table 1 (General Maintenance): Contains general maintenance and inspection guidelines that are applicable to all ODOT water quality facilities
- Table 3 (Maintenance of Water Quality or Biofiltration Swales): Contains maintenance information for swales

The *Blue Book* can be viewed at the following website:

http://www.oregon.gov/ODOT/Maintenance/Documents/blue_book.pdf

8. Limitations

Access grid installed:

<input checked="" type="checkbox"/> No	<input type="checkbox"/> Yes
There are (Choose applicable weight: no, light, med., heavy) duty porous pavers installed in this swale	

Swales are designed to allow equipment access along the bottom. If an access grid is **NOT** installed, vehicles entering the swale can create depressions (tire ruts), damage vegetation, and damage structural components (e.g. flow spreaders). These conditions may result in poor treatment and drainage performance.

Equipment wheels should be kept on the tops and side slopes. Mower arms may be run along the swale bottom.

9. Waste Material Handling

Material removed from the facility is defined as waste by the Department of Environmental Quality (DEQ). Refer to the roadwaste section of the ODOT Maintenance Yard Environmental Management System (EMS) Policy and Procedures Manual for disposal options:

http://www.oregon.gov/ODOT/Maintenance/Documents/ems_manual.pdf


Contact any of the following for more detailed information about management of waste materials found on site:

ODOT Clean Water Unit	(503) 986-3008
ODOT Statewide Hazmat Coordinator	(503) 667-7442
ODOT Region 1 Hazmat Coordinator	(503) 731-8290
ODOT Region 2 Hazmat Coordinator	(503) 986-2647
ODOT Region 3 Hazmat Coordinator	(541) 957-3594
ODOT Region 4 Hazmat Coordinator	(541) 388-6186
ODOT Region 5 Hazmat Coordinator	(541) 963-1590
ODEQ Northwest Region Office	(503) 229-5263

A Appendix A – Site Specific Operational Plan

Contents:

Operational Plan: DFI D00476

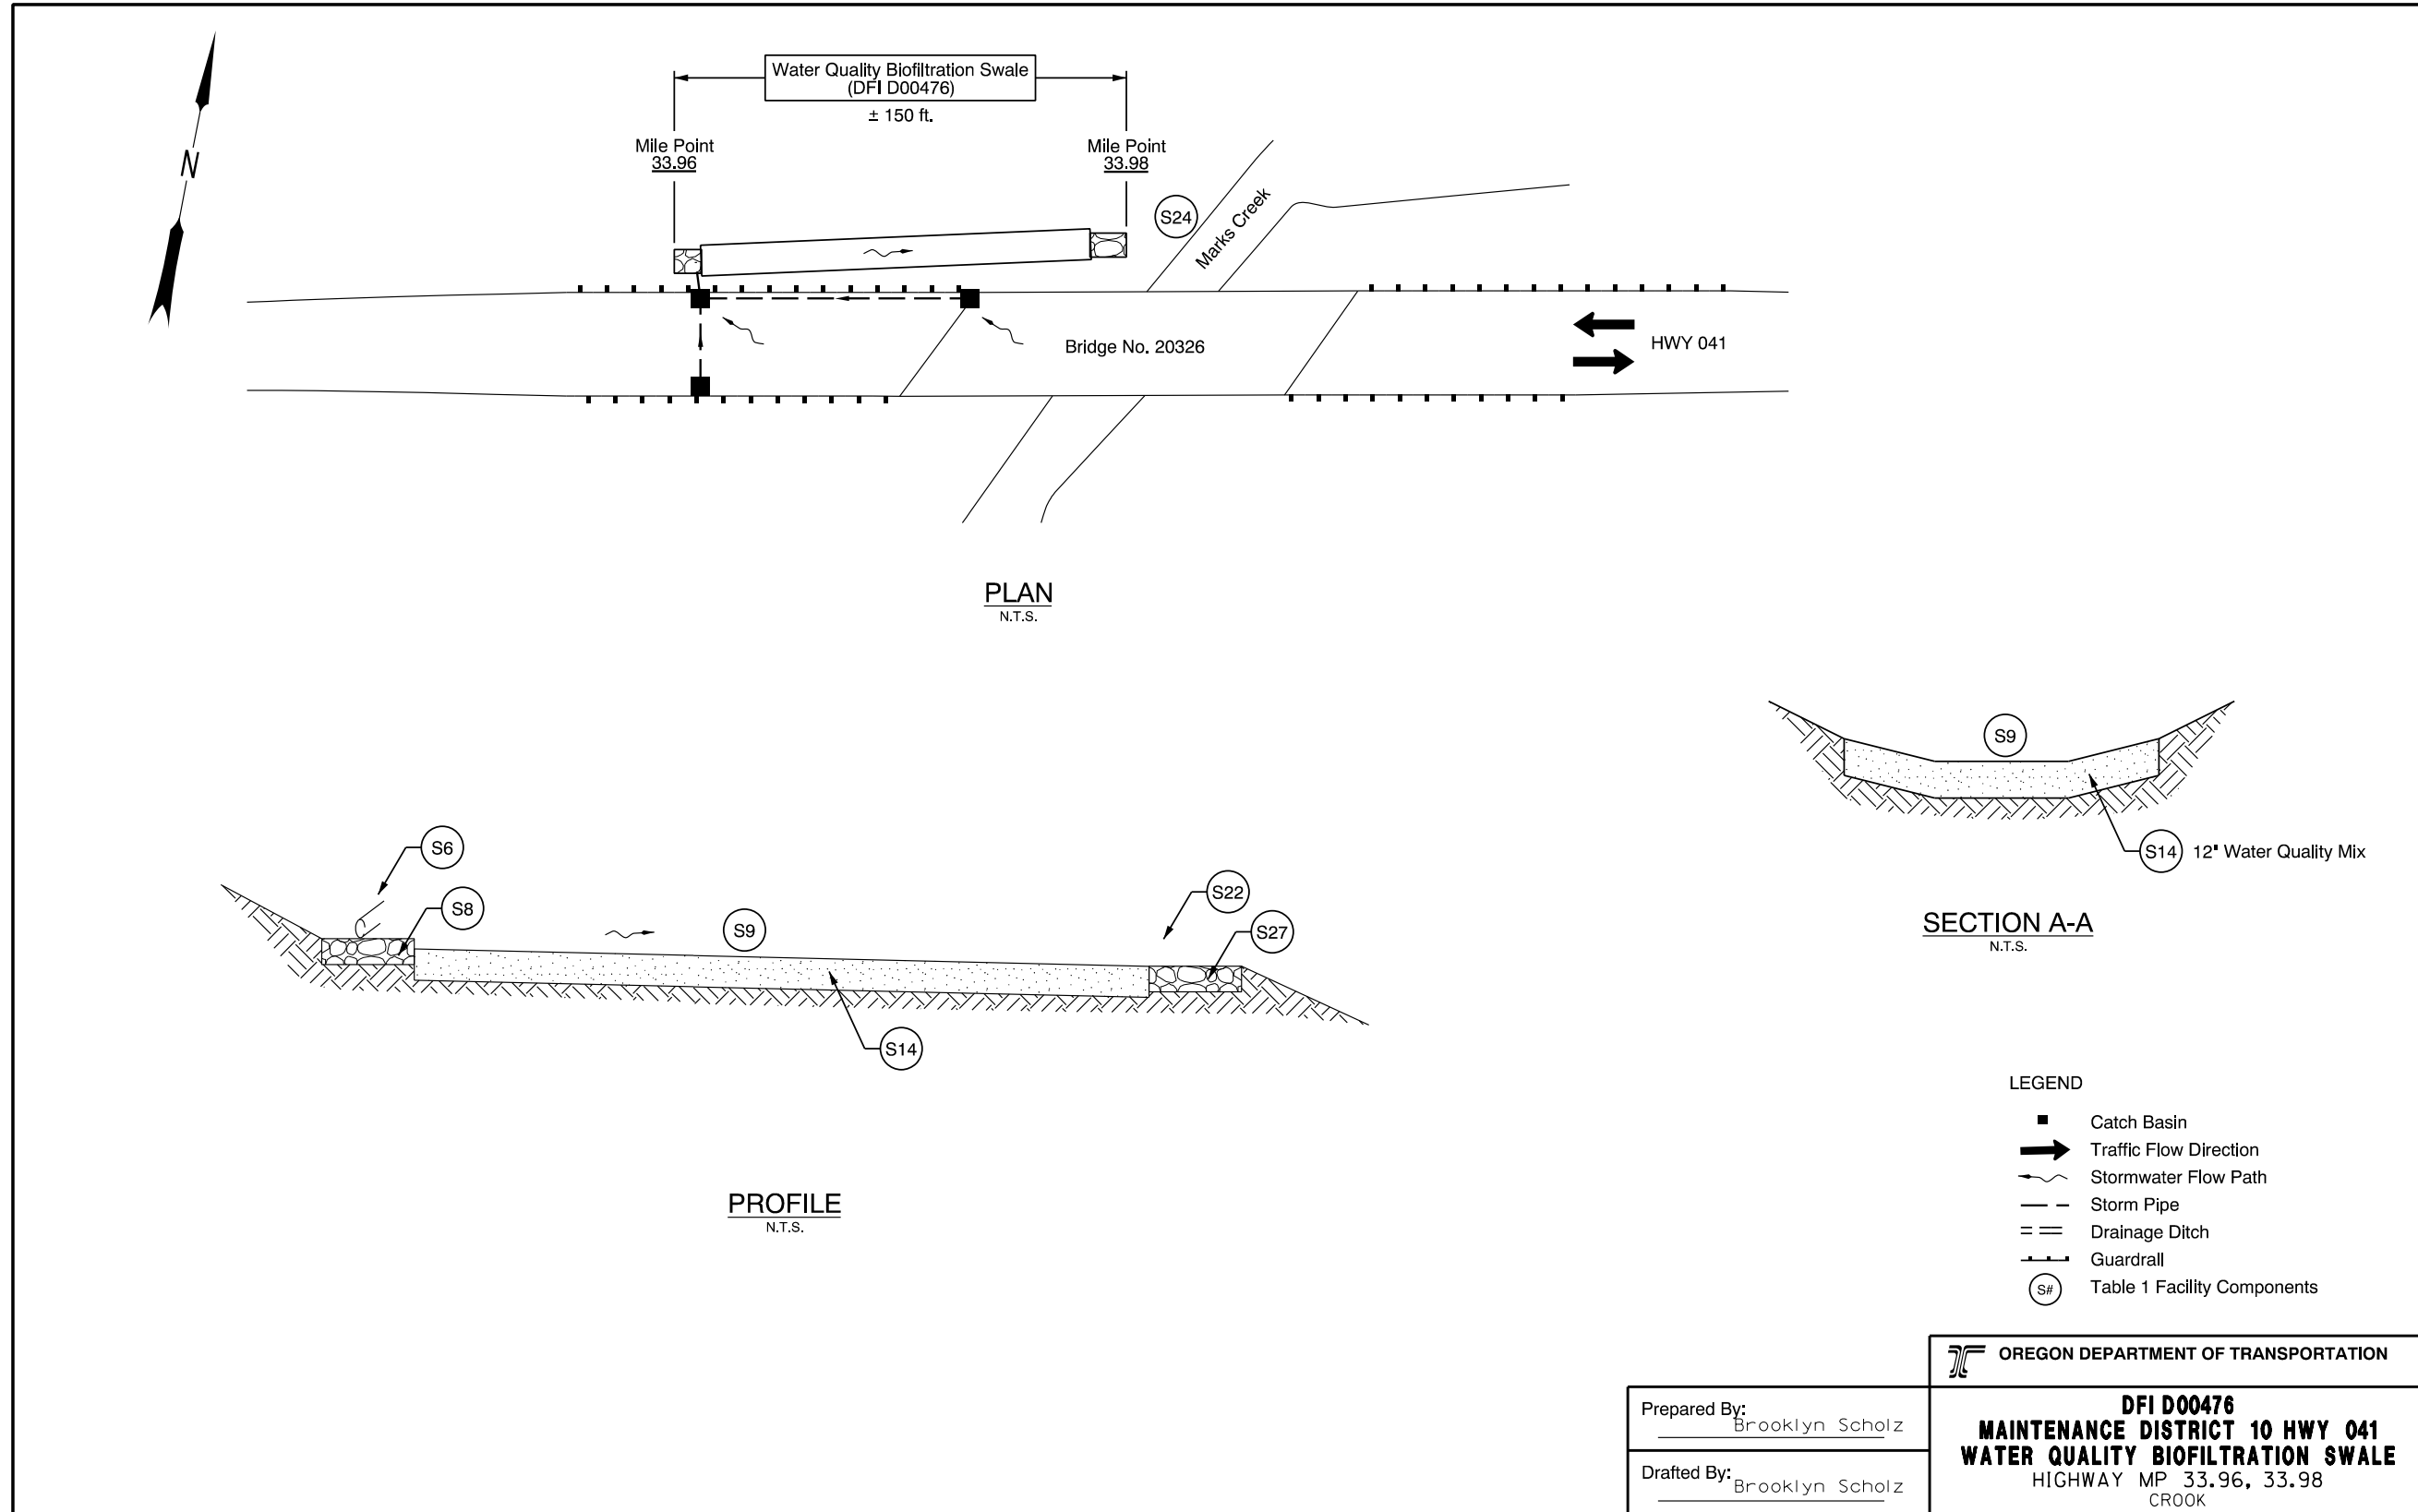

DFI_D00476.dgn

[BLANK]

B Appendix B – Project Contract Plans

Contents:

Site Specific Subset of Project Contract Plan 41V-028

[BLANK]

INDEX OF SHEETS	
SHEET NO.	DESCRIPTION
1	Title Sheet
1A	Index Of Sheets Cont'd., Index Of Std. Drg. Nos.



STATE OF OREGON
DEPARTMENT OF TRANSPORTATION

PLANS FOR PROPOSED PROJECT


STRUCTURES, EARTHWORK AND DRAINAGE

US26: OCHOCO CREEK-BRIDGE CREEK- BUNDLE A05

OCHOCO HIGHWAY

CROOK COUNTY

FEBRUARY 2008

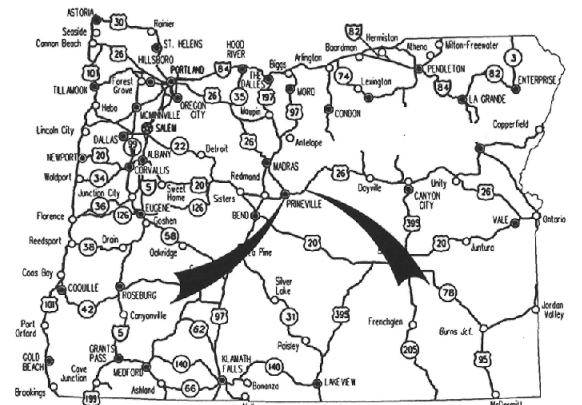

Overall Length Of Project - 18.29 Miles

END OF WORK SECTION

STA. 39+25 (M.P. 19.49)

BEGINNING OF WORK SECTION



STA. 727+30 (M.P. 37.36)

END OF PROJECT

STA. 734+35 (M.P. 37.49)

ATTENTION:
Oregon Law Requires You To Follow Rules Adopted By The Oregon Utility Notification Center. Those Rules Are Set Forth In OAR 952-001-0010 Through OAR 952-001-0090. You May Obtain Copies Of The Rules By Calling The Center. (Note: The Telephone Number For The Oregon Utility Center Is (503) 232-1987.)

REVISED AS CONSTRUCTED
03/15/10 CONTRACT C13438
PROJ. MGR. PATRICK CIMMYOTTI

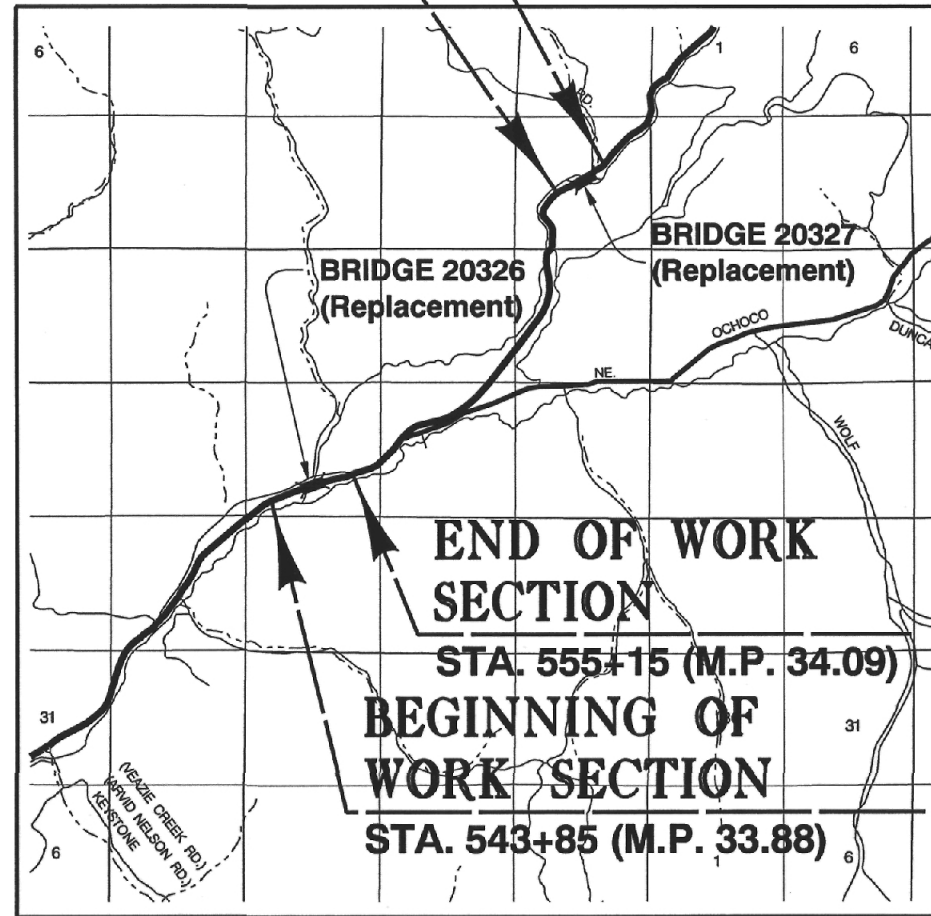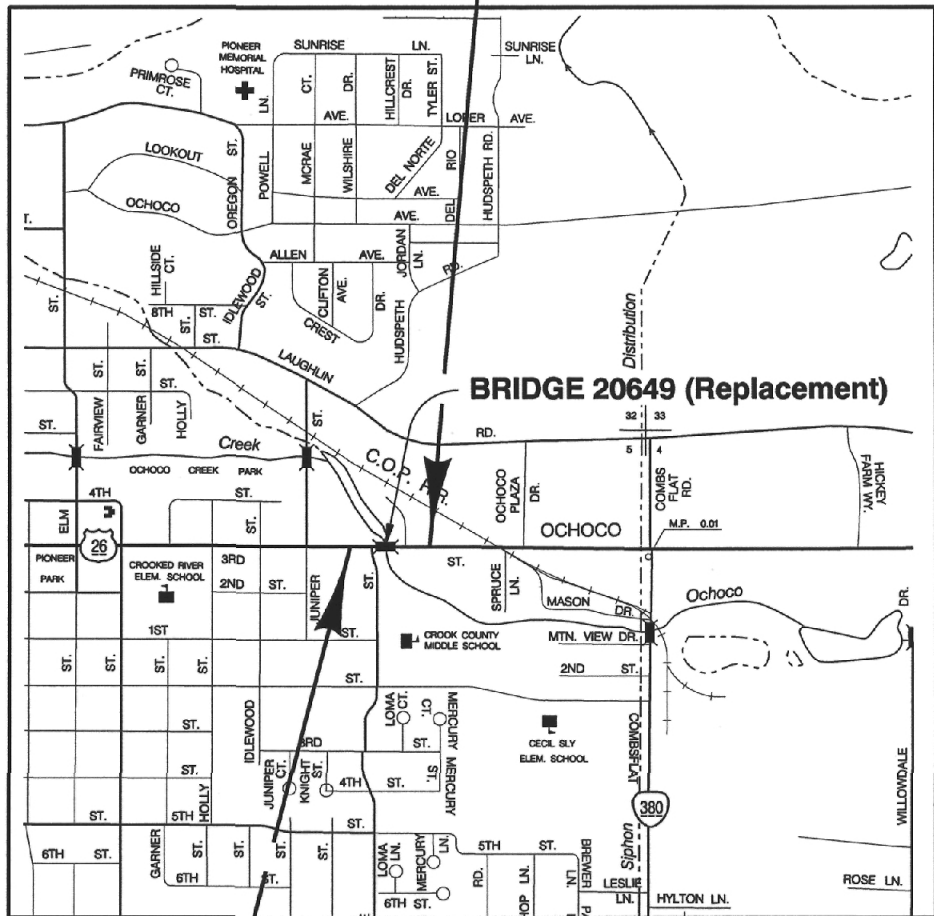

BEGINNING OF PROJECT

STA. 29+25 (M.P. 19.30)

END OF WORK SECTION

STA. 555+15 (M.P. 34.09)


BEGINNING OF WORK SECTION

STA. 543+85 (M.P. 33.88)

OREGON TRANSPORTATION COMMISSION

- Stuart Foster CHAIRMAN
- Gail L. Acherman COMMISSIONER
- Mike Neilson COMMISSIONER
- Randall Papé COMMISSIONER
- Janice J. Wilson COMMISSIONER
- Matthew L. Garrett DIRECTOR OF TRANSPORTATION

PLANS PREPARED FOR
ODOT
BY:
URS CORPORATION

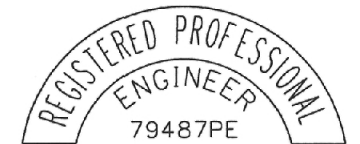

RENEWAL DATE: 12-31-2009
OREGON DEPARTMENT OF TRANSPORTATION
CONCURRENCE

URS
111 S.W. Columbia, Suite 1500
Portland, Oregon 97201
(tel) 503-222-7200
(fax) 503-222-4292

US26: OCHOCO CREEK-BRIDGE CREEK- BUNDLE A05 OCHOCO HIGHWAY CROOK COUNTY		
FEDERAL HIGHWAY ADMINISTRATION	PROJECT NUMBER	SHEET NO.
OREGON DIVISION	NH-0T1A-S041 (022)	1

INDEX OF SHEETS CON'D	
SHEET NO.	DESCRIPTION
2A - 2A-4	Typical Sections Br. 20649
2A-5 - 2A-6	Typical Sections Br. 20326
2A-7 - 2A-8	Typical Sections Br. 20327
2B thru 2B-15	Details
2C thru 2C-6	Traffic Control Br. 20649
2C-7 thru 2C-9	Traffic Control Br. 20326
2C-10 thru 2C-18	Traffic Control Br. 20327
2D	Pipe Data Sheet
3-3B	Construction Br. 20649
3C	Profile Br. 20649
4-4B	Construction Staging Br. 20649
5, 5A	Construction, Profile Br. 20326
6	Detour Plan & Profile Br. 20326
7, 7A	Construction, Profile Br. 20327
8	Detour Plan & Profile Br. 20327

SHEET NO.	DESCRIPTION
GEO/HYDRO	
GA-GA3	Erosion Control Plan Br. 20649
GA-4	Erosion Control Plan Br. 20326
GA-5	Erosion Control Plan Br. 20327

DRAWING NO.	DESCRIPTION
20649 BRIDGE	
77853	Plan & Elevation
77854	General Notes and Quantities
77855	Construction Staging
77856	Staging Plan
77857	Footing Plan
77858	Foundation Data
77859	End Bent 1
77860	End Bent 2
77861	End Bent Details 1
77862	End Bent Details 2
77863	End Bent Details 3
77864	Wingwall Details 1
77865	Wingwall Details 2
77866	Typical Deck Section
77867	Deck Plan
77868	Girder Details
77869	Girder Schedule
77870	Rail Details

DRAWING NO.	DESCRIPTION
20757 MSE Wall	
78049	Plan & Elevation
78050	General Notes

DRAWING NO.	DESCRIPTION
20326 BRIDGE	
77885	Plan & Elevation
77886	General Notes
77887	Footing Plan
77888	Foundation Data
77889	End Bent 1 Plan & Elevation
77890	End Bent 2 Plan & Elevation
77891	End Bent Detail and Bearing Details
77892	Wingwall Details
77893	Typical Deck Section
77894	Deck Plan
77895	Deck Elevations

DRAWING NO.	DESCRIPTION
20326 BRIDGE (Con'd)	
77896	Bulb-T Beam Schedule and Misc. Details
77897	Standard Bulb-T Beam Details
77898	Miscellaneous Details

DRAWING NO.	DESCRIPTION
20327 BRIDGE	
77871	Plan & Elevation
77872	General Notes
77873	Footing Plan
77874	Foundation Data
77875	End Bent 1 Plan & Elevation
77876	End Bent 2 Plan & Elevation
77877	End Bent Detail and Bearing Details
77878	Wingwall Details
77879	Typical Deck Section
77880	Deck Plan
77881	Deck Elevations
77882	Bulb-T Beam Schedule and Misc. Details
77883	Standard Bulb-T Beam Details
77884	Miscellaneous Details

SHEET NO.	DESCRIPTION
PERMANENT SIGNING	
S-10015 Thru	Signing Plan
S-10020	

SHEET NO.	DESCRIPTION
TRAFFIC SIGNALS	
14825 Thru 14827	Temporary Traffic Signal

Standard Drg. Nos.

- RD115 - Monument Box
- RD200 - Rdwy. Cross Slopes Superelevated Sections
- RD230 - Slope Rounding
- RD300 - Trench Backfill, Bedding, Pipe Zone and Multiple Installations
- RD302 - Street Cut
- RD326 - Coupling Bands
- RD362 - Sanitary Cleanout
- RD364, RD366 - Inlets
- RD380, RD386 - Pipe Fill Height Tables
- RD400, RD405 - Guardrail Parts
- RD410 - Thriebeam
- RD415 - Guardrail
- RD420 - Terminals
- RD440 - Guardrail at Bridge Ends
- RD450 - Guardrail Anchors
- RD500 - Precast Conc. Bar. Pin & Loop Assembly
- RD505 - Concrete Barrier Cast-In-Place
- RD516 - Securing Conc. Barrier to Roadway
- RD520 - Cast-In-Place Concrete Barrier Transition To Bridge Rail
- RD610 - Asphalt Pavement

Standard Drg. Nos.

- RD700 - Curbs
- RD715 - Approaches & Non-Sidewalk Dwys
- RD720 - Sidewalks
- RD735 - Curb Line Sidewalk Dwys. Or Alleys
- RD740 - Separated Sidewalk Dwys. - Local Jurisdictions
- RD755 - Sidewalk Ramp Details
- RD760 - Sidewalk Ramp Placement
- RD1000 - Construction Entrances
- RD1005 - Check Dams
- RD1025 - Sediment Barrier
- RD1040 - Sediment Fence
- BR140, BR141, BR145, BR150 - Expansion Joints
- BR165 - Bridge End Panel Details
- BR200 - Conc. Bridge Rail Type F
- BR203 - Transition Conc. Br. Rail To Guardrail
- BR250 (Modified) - Pedestrian Rail On Sidewalk Mounted Concreted Parapet
- BR270 - Flex Beam Rail To Curb & Parapet Rail
- BR310 - Bulb-T Beams Details
- BR350 - Temp. Diaphragms Beam For Prestressed Conc. Beams
- BR440 - 48" Precast Prestressed Box
- BR445 - General Details for Prestressed Boxes & Slabs
- BR450 - Precast Prestressed Conc. Slab Design Sheet
- BR460 - Precast Prestressed Conc. Box Design Sheet
- TM200 - Sign Installation Details
- TM201 - Miscellaneous Sign Placement Details
- TM204 - Flag Board Mounting Detail
- TM221 - Signing Details Milepost Marker
- TM222 - Installation Details Milepost Marker Posts
- TM230 - Mounting Details For Removable Legend (203 & 152 UC & LC Letters/Numbers)
- TM457 - Vehicle, Pedestrian Signal And Push Button Mounting Option Details
- TM485 - Service Cabinet And Service Cabinet Wiring Details
- TM488 - Terminal Cabinet Detail
- TM500, TM501, TM502 - Pavement Markings
- TM515 - Raise Pavement Marking Details
- TM525 - Pavement Marking Details
- TM570 - Traffic Delineators
- TM670 - Permanent Signing Wood Post Supports Sizing Charts
- TM700 - Tables, Abrupt Edge, and PCMS Details
- TM710 - 2 Lane, 2 way Roadways
- TM717 - Non-Freeway Multilane Section
- TM735 - Bridge Construction
- TM745 - Temporary Concrete Barrier Details
- TM747 - Temporary Reflective Pavement Markers
- TM750 - Traffic Control Plans - Temporary Barricades
- TM755, TM760 - Temporary Impact Attenuators
- TM775 - Temporary Sign Supports
- TM780 - Closure Details



REVISIONS


△	Revised 01-06-2008 Deleted Std. Drgs.	△	Revised 01-06-2008 Adjusted Sheets	△	Revised 01-06-2008 Added Std. Drgs.
---	---------------------------------------	---	------------------------------------	---	-------------------------------------

US26: OCHOCO CREEK-BRIDGE CREEK- BUNDLE A05		
OCHOCO HIGHWAY CROOK COUNTY		
FEDERAL HIGHWAY ADMINISTRATION	PROJECT NUMBER	SHEET NO.
OREGON DIVISION	NH-0T1A-S041 (022)	1A

Sec. 21, T. 14 S., R. 18 E., W.M.
BRIDGE NO. 20326

41V-28

REVISED AS CONSTRUCTED
03/15/10 CONTRACT C13438

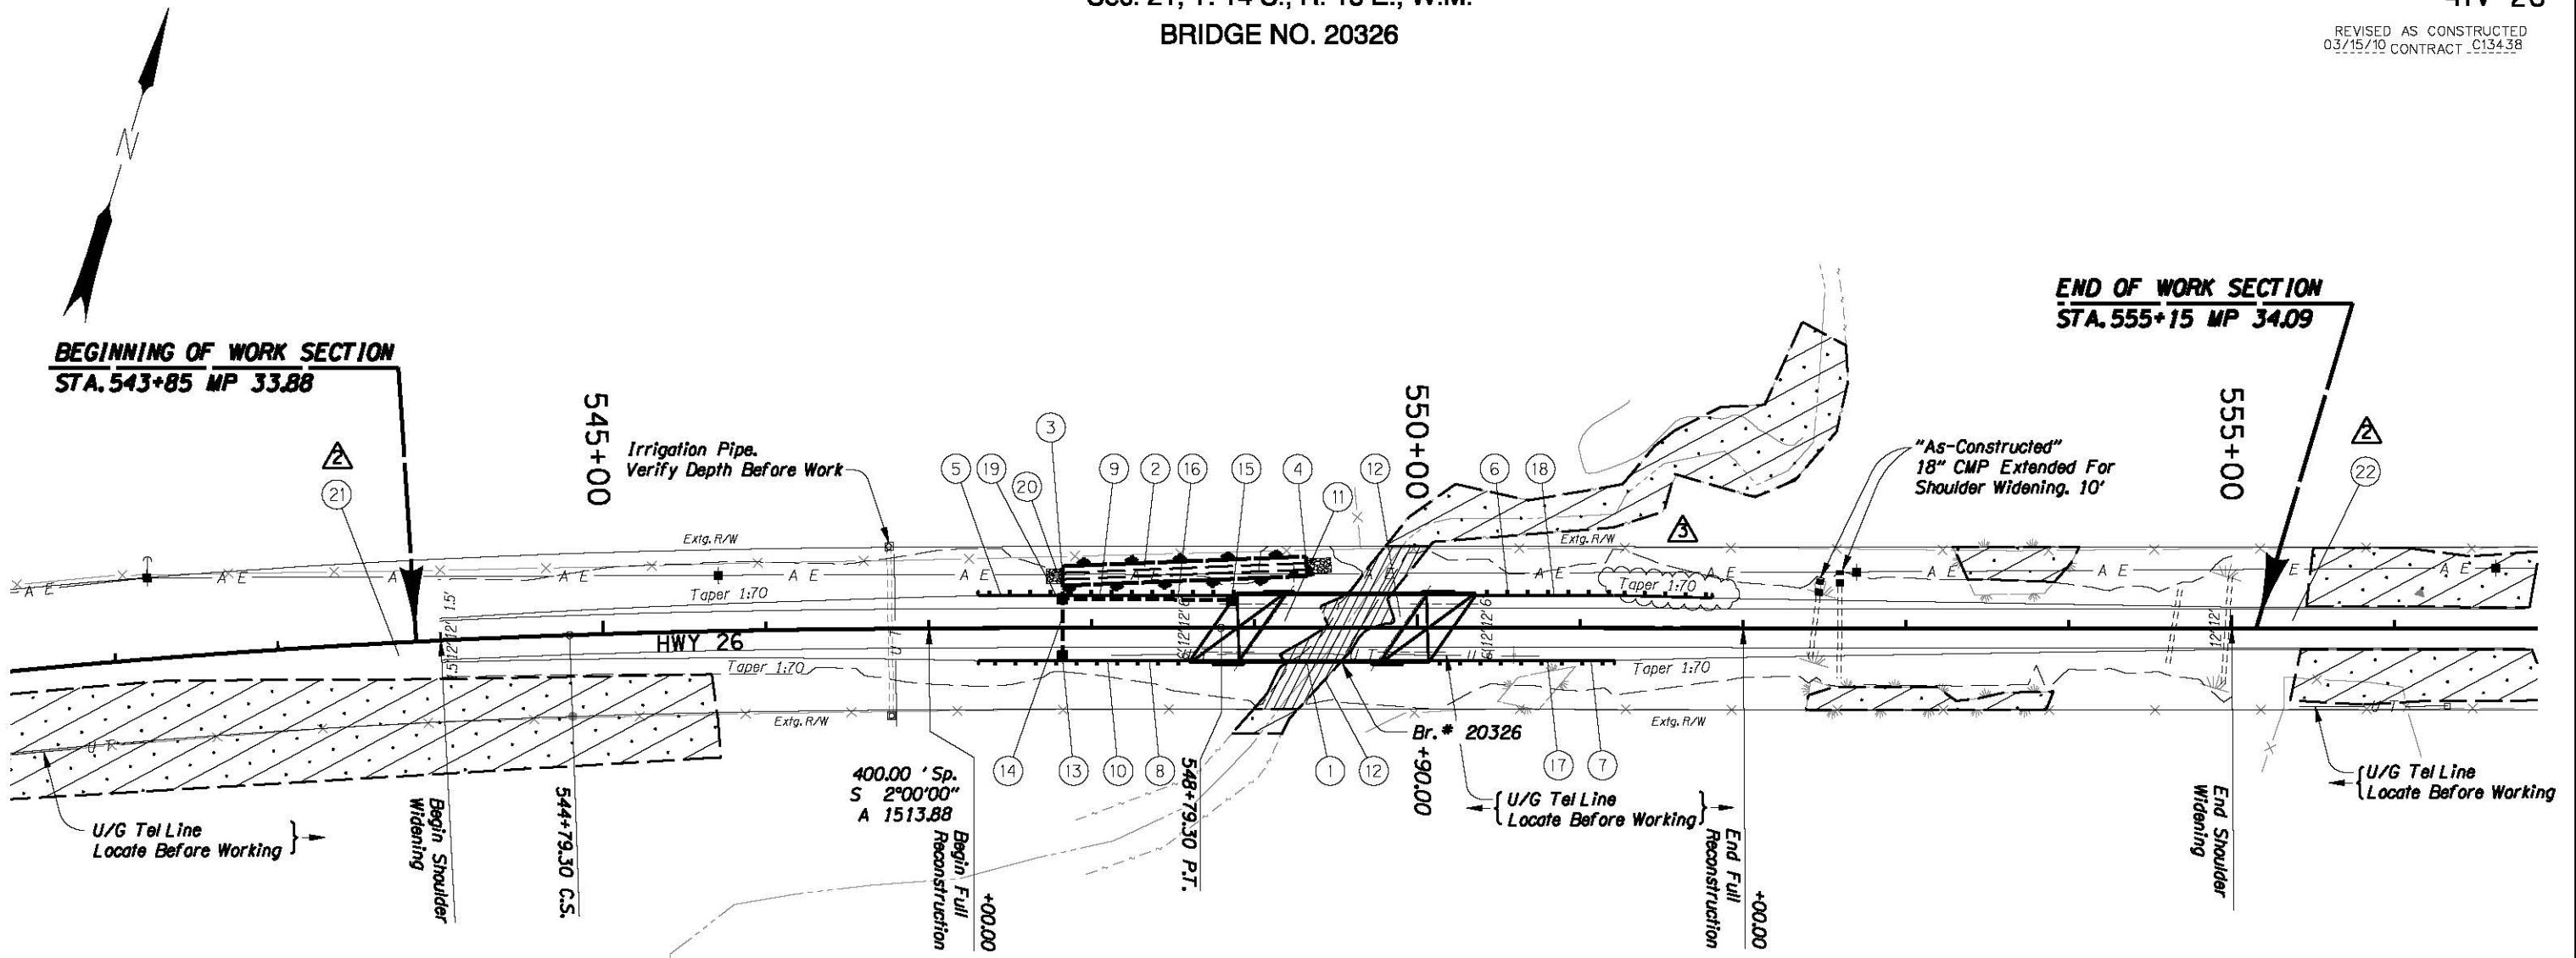


- ① Const. Bridge (Str. #20326)
(For Bridge Details, See Index of Sheets)
- ② Sta. 547+82, 32" Lt. To Sta. 549+32, 38" Lt.
Const. Stormwater Detention Basinswale #1
4:1 Side Slope, 4' Wide, 150' Long
(For Details, See Sht. 2B-4)
- ③ Sta. 547+82 Lt.
Const. Loose Riprap (Class 50) - 3 C.Y.
(For Details, See Sht. 2B)
- ④ Sta. 549+32 Lt.
Const. Loose Riprap (Class 50) - 3 C.Y.
(For Details, See Sht. 2B)
- ⑤ Sta. 547+31 Lt. To 548+89 Lt.
Const. G.R. - 93.75' (Type 2A)
- 12.5' (Type 3)
Const. G.R. Transition
Const. G.R. Terminal (Level 3) Non-Flared
Flare Rate=0', W=1', E=2'
(See Drg. Nos. BR203, RD400, RD405,
RD410, RD415, RD420, RD440)


- ⑥ Sta. 550+37 Lt. To 551+80 Lt.
Const. G.R. - 62.5' (Type 2A)
- 12.5' (Type 3)
Const. G.R. Transition
Const. G.R. Terminal (Level 3) Non-Flared
Flare Rate=0', W=1', E=2'
- ⑦ Sta. 550+07 Rt. To 551+20 Rt.
Const. G.R. - 50' (Type 2A)
- 12.5' (Type 3)
Const. G.R. Transition
Const. G.R. Terminal (Level 3) Non-Flared
Flare Rate=0', W=1', E=2'
- ⑧ Sta. 547+31 Rt. To 548+59 Rt.
Const. G.R. - 62.5' (Type 2A)
- 12.5' (Type 3)
Const. G.R. Transition
Const. G.R. Terminal (Level 3) Non-Flared
Flare Rate=0', W=1', E=2'
- ⑨ Sta. 548+69 Lt. To Sta. 548+89 Lt.
Const. Asp. Drainage Curb - 20'
(See Drg. No. RD700)
- ⑩ Sta. 547+31 Rt. To Sta. 548+59 Rt.
Const. Asp. Drainage Curb - 82'

- ⑪ Const. Loose Riprap (Class 100) - 90 C.Y.
(For Details, See Sht. 2B-6)
- ⑫ Const. Loose Riprap (Class 100) - 90 C.Y.
(For Details, See Sht. 2B-6)
- ⑬ Sta. 547+82, 18' Rt.
Const. Type G-2M Inlet
Grate Elev. 3362.67, F.L. Elev. 3359.50
(See Drg. No. RD364)
- ⑭ Sta. 547+82 Rt. To Sta. 547+82 Lt.
Inst. 12" Storm Pipe - 35'
- ⑮ Sta. 548+87, 18' Lt.
Const. Type G-2M Inlet
Grate Elev. 3364.05, F.L. Elev. 3359.82
- ⑯ Sta. 547+82 Rt. To Sta. 548+86 Lt.
Inst. 12" Storm Pipe - 104'
- ⑰ Sta. 550+08 Rt. To Sta. 551+21 Rt.
Const. Asp. Drainage Curb - 113'
- ⑱ Sta. 550+35 Lt. To Sta. 551+21 Lt.
Const. Asp. Drainage Curb - 86'

- ⑲ Sta. 547+82, 18' Lt.
Const. Type G-2M Inlet
Grate Elev. 3362.33, F.L. 3359.32
- ⑳ Sta. 547+82 Lt. To Sta. 547+82 Lt.
Inst. 12" Storm Pipe - 14'
- ㉑ Sta. 542+85 To Sta. 543+85
Cold Plane Pvm. Removal (0" To 2") - 267 S.Y.
(For Details See Sht. 2B-8)
- ㉒ Sta. 555+15 To Sta. 556+15
Cold Plane Pvm. Removal (0" To 2") - 267 S.Y.
(For Details See Sht. 2B-8)

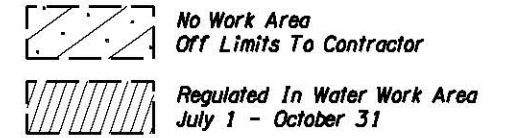

REVISIONS	
⚠	Revised 01-06-2008 Adjusted Note
⚠	Revised 01-13-2008 Added Note
⚠	Revised 05-29-2008 Adjusted GR Length

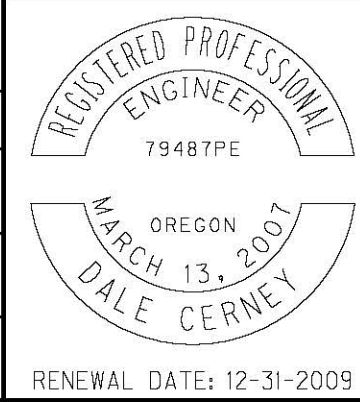

OREGON DEPARTMENT OF TRANSPORTATION

URS CORPORATION
HIGHWAYS AND BRIDGES SECTION

US26: OCHOCO CREEK-BRIDGE CREEK- BUNDLE A05
OCHOCO HIGHWAY
CROOK COUNTY

Design Team Leader - Lee Jordan
Designed By Jim Halloran
Drafted By Serge Valverde


GENERAL CONSTRUCTION

SHEET NO. **5**

Sec. 21, T. 14 S., R. 18 E., W.M.
BRIDGE NO. 20326

41V-28


NOT REVISED AS CONSTRUCTED
03/15/10 CONTRACT C13438

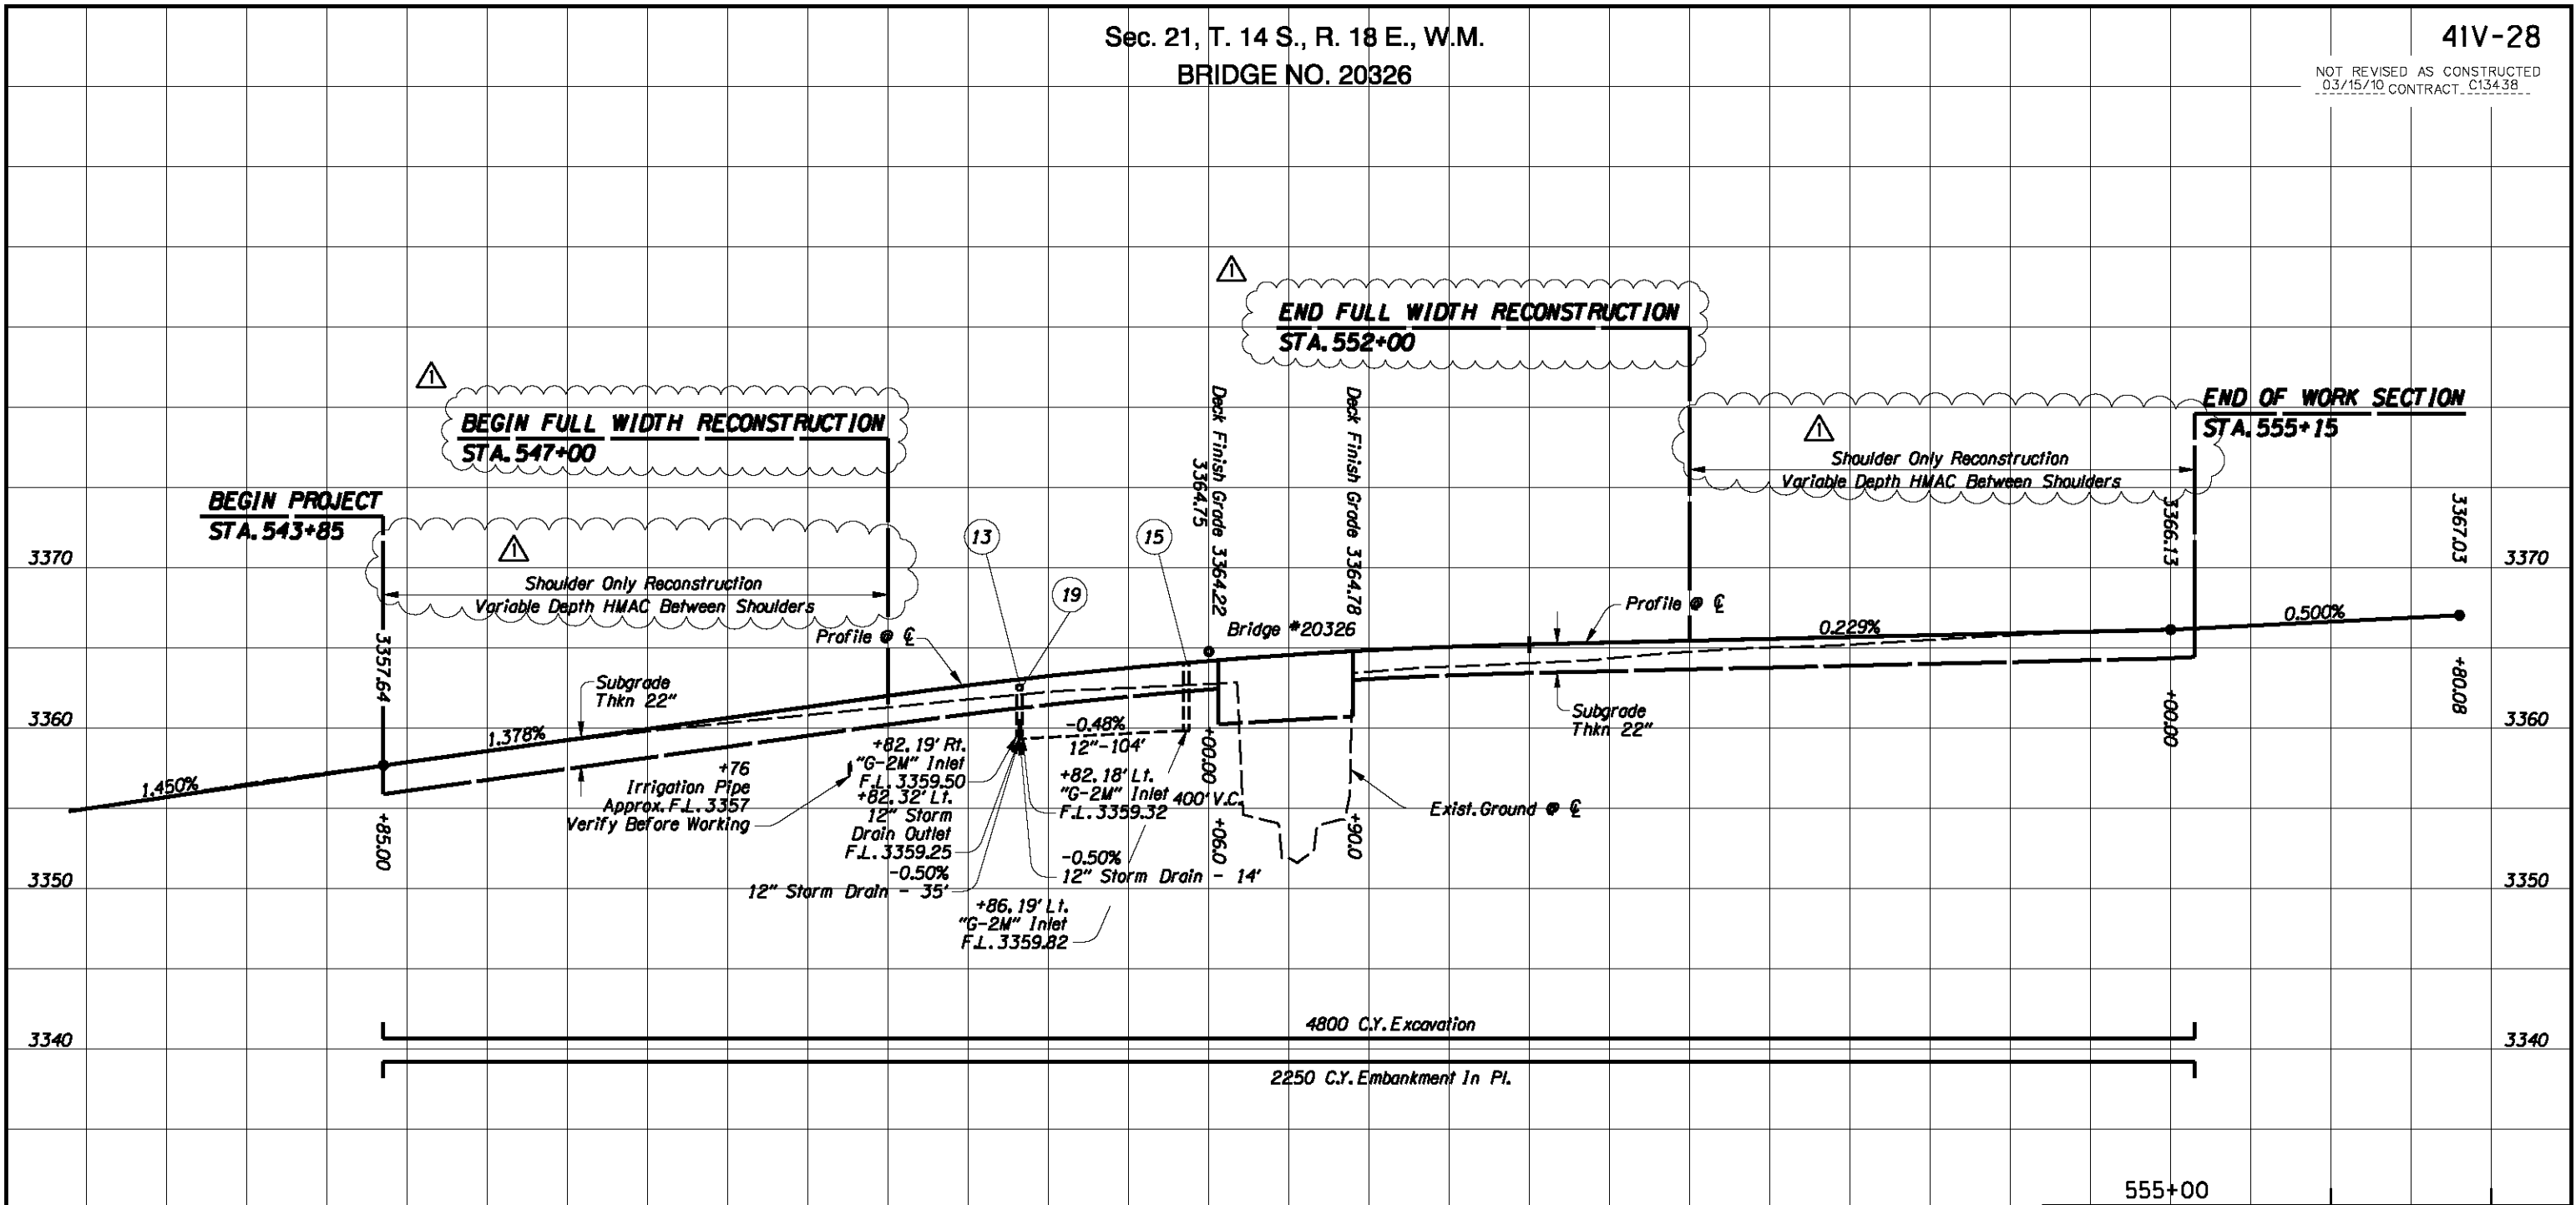


REVISIONS	
△	Revised 05-29-2008 Added Dimension/Note

545+00

550+00

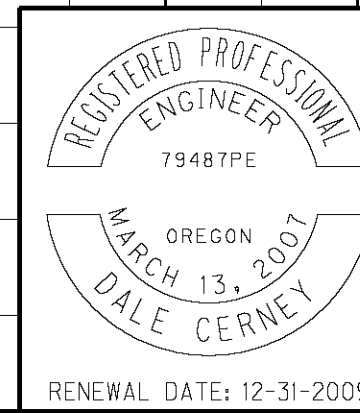


OREGON DEPARTMENT OF TRANSPORTATION	
URS CORPORATION HIGHWAYS AND BRIDGES SECTION	
US26: OCHOCO CREEK-BRIDGE CREEK- BUNDLE A05 OCHOCO HIGHWAY CROOK COUNTY	
Design Team Leader - Lee Jordan Designed By Jim Halloran Drafted By Serge Valverde	
PROFILE	SHEET NO. 5A

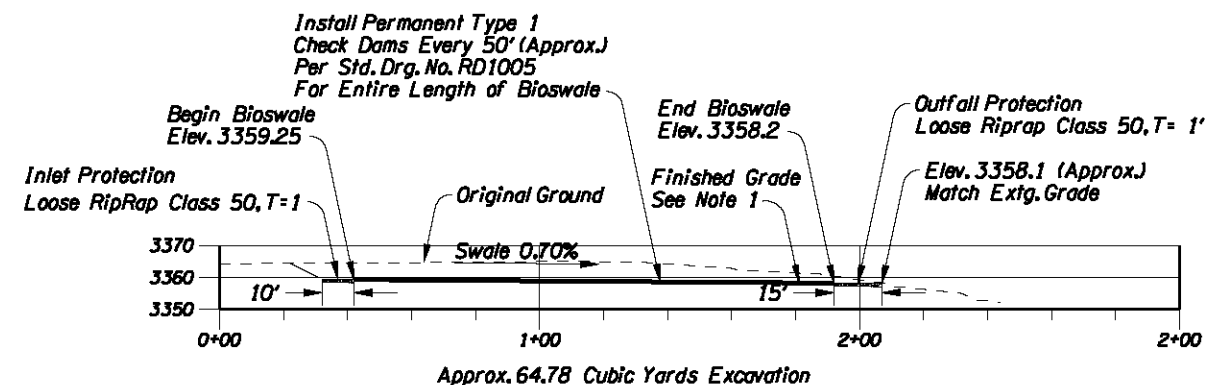


BRIDGE 20326 - STORMWATER BIOSWALE #1
SECTION A-A, Sta. 547+82 Lt To Sta. 549+32 Lt
LENGTH - 150.0 ft
Scale: 1"=60'
For Details, See Sht.5, Note 2


NOTES
1. Bioswales To Be Constructed Within Footprint Of Detour Route After Detour Is Removed. Contractor May Elect To Shape Bioswale To The Required Grades Using In-Place Detour Route Subgrade, Or The Contractor May Remove The Subgrade Material To Restore Surface To Original Grades. Then Construct The Bioswale. Bioswale Subgrade Soils Must Be Loosened To A Minimum Depth Of 3 Feet Below Topsoil Finished Grade To Allow For Percolation And Vegetation Growth. Bioswale Berms To Be Recompacted To 85% Maximum Dry Density.
2. Bioswale #2 Berm As Needed To Divert Upgradient Runoff Around Bioswale And Drain To Creek. Alternatively, Or In Combination, Leave Bench Created By Construction Of Detour Route And Grade Bench To Divert Upgradient Runoff Around Bioswale And Drain To Creek.

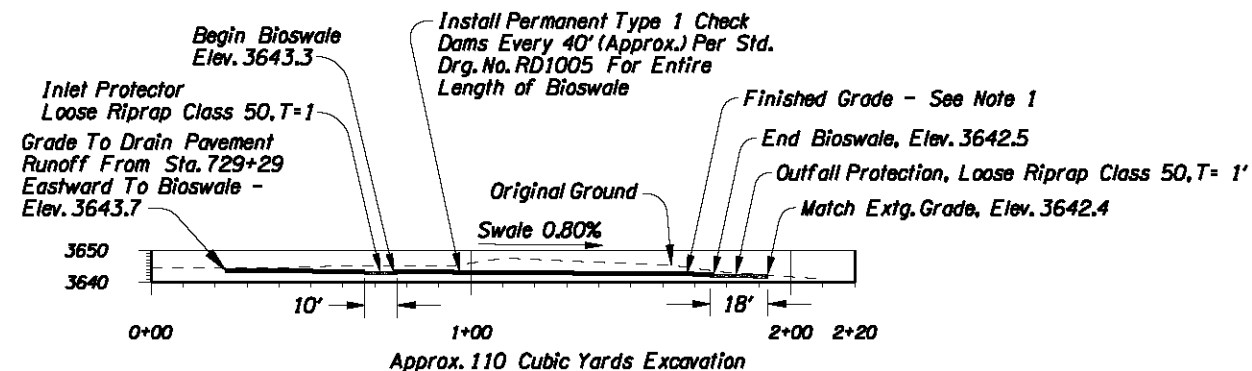

BRIDGE 20327 - STORMWATER BIOSWALE #2
SECTION A-A, Sta. 729+81.2 Rt To Sta. 730+81.8 Rt
LENGTH - 100.0 ft
Scale: 1"=60'
For Details, See Sht.5, Note 6

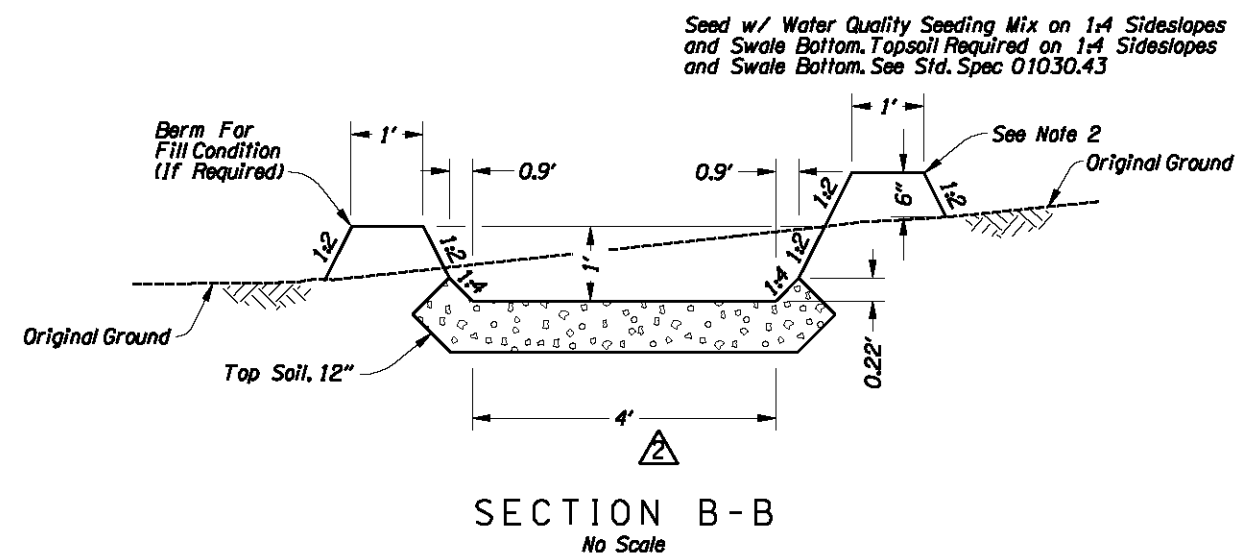


SECTION B-B
No Scale

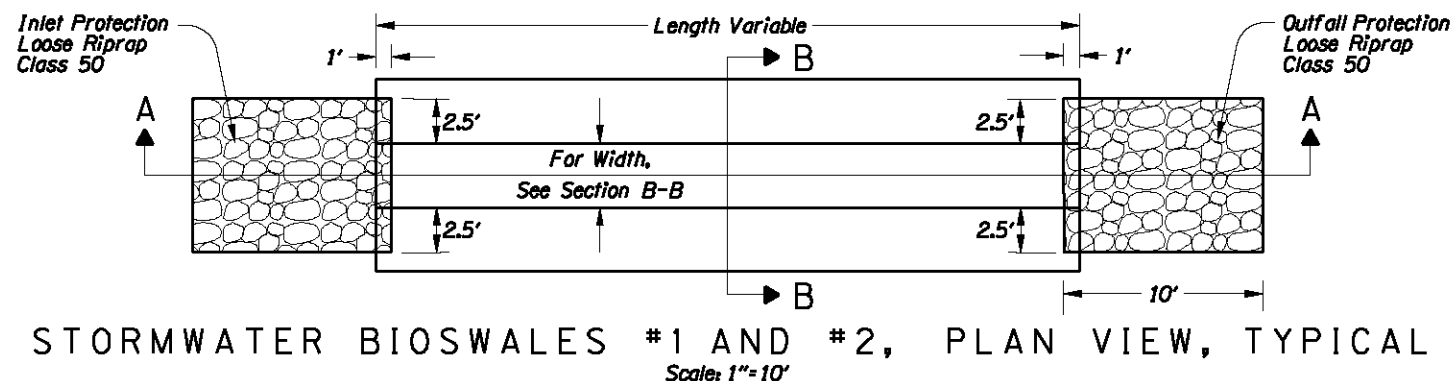

STORMWATER BIOSWALES #1 AND #2, PLAN VIEW, TYPICAL
Scale: 1"=10'

REVISIONS	
⚠	Revised 09-24-2008 Relocated And Adjusted Bioswale
⚠	Revised 09-24-2008 Adjusted Dimension

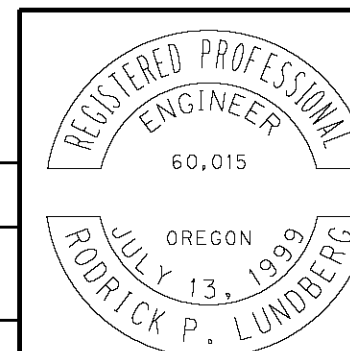

OREGON DEPARTMENT OF TRANSPORTATION

URS CORPORATION
HIGHWAYS AND BRIDGES SECTION

US26: OCHOCO CREEK-BRIDGE CREEK- BUNDLE A05
OCHOCO HIGHWAY
CROOK COUNTY

Design Team Leader - Lee Jordan
Designed By Rod Lundberg
Drafted By Serge Valverde

DETAILS

SHEET NO.
2B-4