

# **OPERATION & MAINTENANCE MANUAL**

**DFI No. : D00490**

**Facility Type: Water Quality Extended  
Det. Dry Pond**



**NOVEMBER, 2010**



## 1. Identification

Drainage Facility ID (DFI): **D00490**  
Facility Type: Water Quality Extended Det. Dry Pond  
Construction Drawings: (V-File Number) 34V-025  
Location: District: 3  
Highway No.: 091  
Mile Post: 22.05 (beg./end)]  
Description: This facility is located just south of OR99W (Hwy 091) at its intersection with Springbrook Road. Access can be obtained from an access driveway along the east side of Springbrook Road and south of an adjacent water quality pond.

## 2. Facility Contact Information

Contact the Engineer of Record, Region Technical Center, or Geo-Environmental's Senior Hydraulics Engineer for:

- Operational clarification
- Maintenance clarification
- Repair or restoration assistance

### Engineering Contacts:

Region Technical Center Hydro Unit Manager

Or

Geo-Environmental Senior Hydraulics Engineer (503) 986-3365.

## 3. Construction

Engineer of Record: ODOT Designer – Region 2 Tech. Center, Paul Wirfs, P.E., 503-986-2990

Facility construction: 2001  
Contractor: Compton Construction Company

#### **4. Storm Drain System and Facility Overview**

A water quality extended detention dry pond is a basin that is designed to detain stormwater for a sufficient time to allow particles and attached pollutants to settle. The outlet control structure limits the rate of runoff leaving the pond by using an orifice. These facilities are designed to completely drain over a 48 hour period. The size of these facilities depends on the location and the amount of contributing impervious area.

This facility is located just south of OR99W (Hwy 091) at its intersection with Springbrook Road. Access can be obtained from a paved access driveway along the east side of Springbrook Road and south of an adjacent water quality pond.

A localized stormwater system comprised of 12", 18", and 36-inch concrete pipes conveys water from along Springbrook Road into a 7-foot diameter drop manhole with a curbside grated inlet. Flows exit the manhole through a 36-inch pipe towards a riprap-lined facility entrance where the water fills the pond and is detained, prior to discharge. An originally designed for cellular confinement structure with vegetated topsoil infill lined the bottom of the pond and emergency spillway. However, this particular structure washed out within the first year of installation and was replaced with a concrete-lining instead; see the Operational Plan, Appendix A.

Stormwater exits the facility outlet control structure at a metered rate of flow via a small diameter orifice. Local maintenance staff originally removed this orifice during the first year when dealing with problems associated with the cellular confinement structure's lining and flows frequently exiting the facility via the emergency spillway. It appears that issues surrounding the orifice and lining have been resolved to a point where the facility functions more optimally. Nonetheless, the outlet control structure's primary and secondary inlet/outlet devices are designed to handle most stormwater flow events and adequately convey water to Springbrook Creek, prior to use of the emergency spillway.

Along with typical maintenance it is recommended that maintenance staff pay particular attention to properly cleaning the primary inlet/outlet device and orifice opening, so that the pond continues to operate smoothly. This facility, like many, has a tendency to become overgrown with vegetation and may need significant trimming and debris removal too.

##### **A. Maintenance equipment access:**

Staff may obtain unrestricted access to the facility from a paved access driveway along the east side of Springbrook Road and south of an adjacent water quality pond. The driveway, itself, is the second

entrance along the east side of Springbrook Road south of a commercial driveway entrance, leading to the adjacent shopping facility.

B. Heavy equipment access into facility:

- Allowed (no limitations)
- Allowed (with limitations)
- Not allowed

C. Special Features:

- Amended Soils
- Porous Pavers
- Liners; Concrete lining
- Underdrains

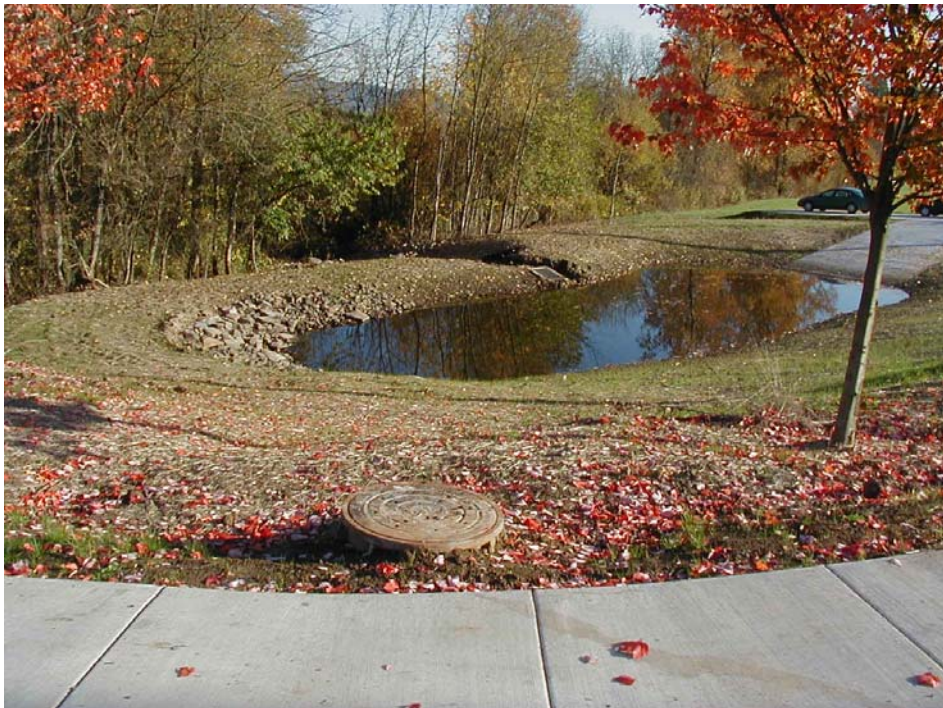


Photo 1: Looking southeast at the facility shortly after its completion, year 2001. Springbrook Road is located to the right.



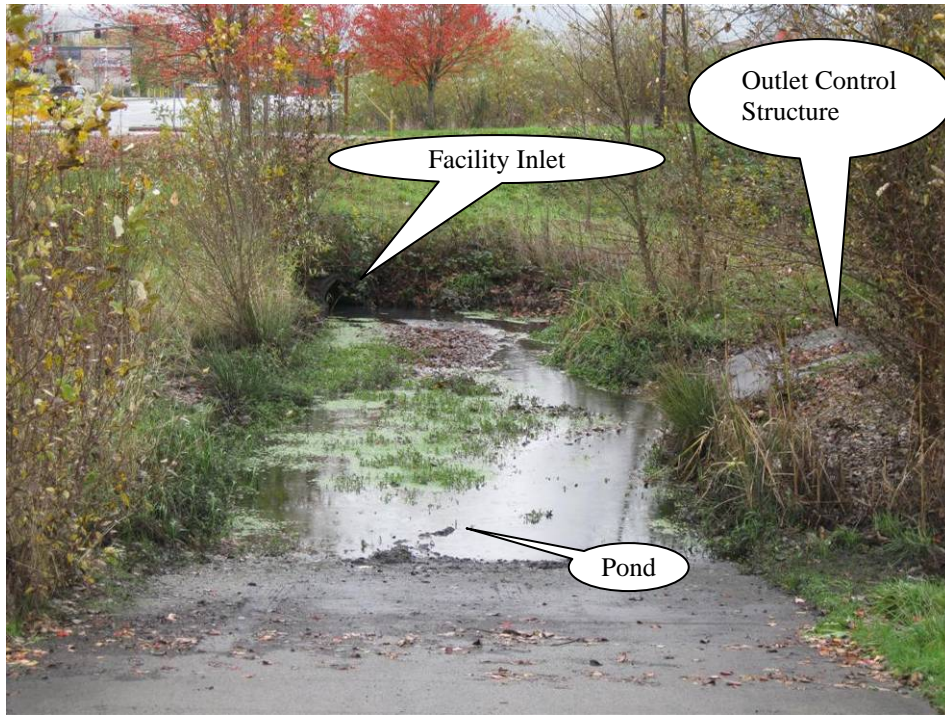


Photo 2: Looking north at the facility. Springbrook Road is located to the left.

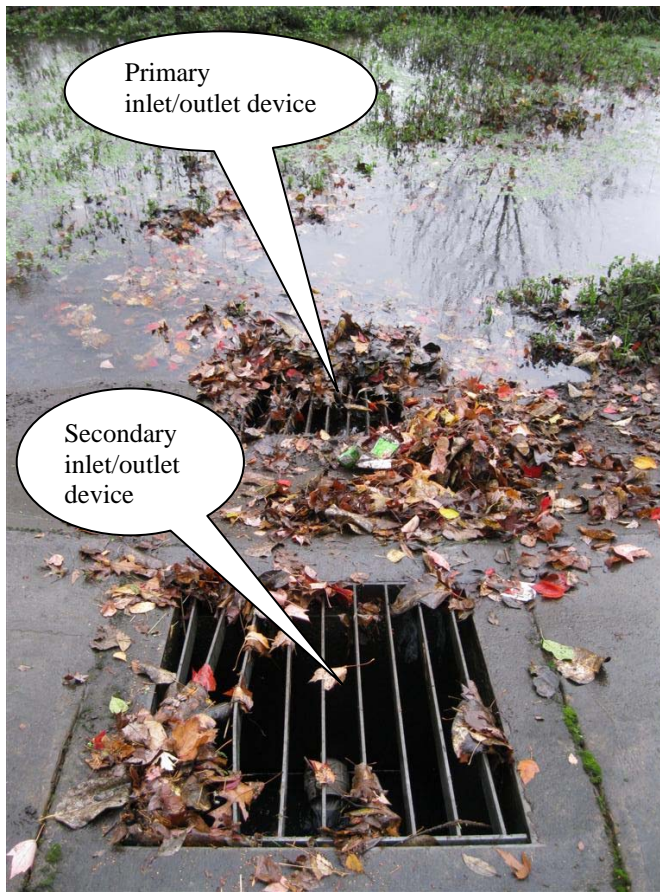


Photo 2: Looking west toward the outlet control structure. Springbrook Road is located straight ahead beyond the pond.





Photo 3: Looking at the secondary inlet/outlet device. Facility was originally designed to contain an orifice cap overtop the pipe exit, above.



Photo 4: Looking east at the facility outlet, paved-end slope pipe exit and riprap lined outfall to Springbrook Creek – straight ahead.

## 5. Facility Haz Mat Spill Feature(s)

The Water Quality Extended Det. Dry Pond can be used to store a volume of liquid by blocking the 24-inch diameter outlet pipe located at the outlet of the detention pond facility. This pipe is noted as point B on the Operational Plan, Appendix A. The use of a steel plate and sandbags may help with blocking the pipe and outlet control structure devices.

## 6. Auxiliary Outlet (High Flow Bypass)

Auxiliary Outlets are provided if the primary outlet control structure can not safely pass the projected high flows. Broad-crested spillway weirs and over flow risers are the two most common auxiliary outlets used in stormwater treatment facility design. The auxiliary outlet feature is either a part of the facility or an additional storm drain feature/structure.

The auxiliary outlet feature for this facility is:

Designed into facility

A secondary auxiliary inlet/outlet grated catch basin has been designed as part of the facility's outlet control structure, and acts as an emergency overflow in the event the primary outlet control device is plugged.

Before flows ever reach the higher level of the secondary inlet/outlet device, however, they are typically released through a primary inlet/outlet grated catch basin located below the secondary device. If runoff should ever exceed the water quality event, where flows normally are directed to the lower primary outlet, the pond level will rise and flows will be released through the secondary auxiliary inlet/outlet device located just above the primary outlet. In the chance the entire outlet control structure overflows due to plugging or a high flow event an auxiliary emergency spillway will further convey flows toward the creek.

Other, as noted below

## 7. Maintenance Requirements

Routine maintenance table for non-proprietary stormwater treatment and storage/detention facilities have been incorporated into ODOT's Maintenance Guide. These tables summarize the maintenance requirements for ponds, swales, filter strips, bioslopes, and detention tanks and vaults. Special maintenance requirements in addition to the routine requirements are noted below when applicable.

The ODOT Maintenance Guide can be viewed at the following website:



<http://www.oregon.gov/ODOT/HWY/OOM/MGuide.shtml>

Maintenance requirements for proprietary structures, such as underground water quality manholes and/or vaults with filter media are noted in Appendix C when applicable.

The following stormwater facility maintenance table (See ODOT Maintenance Guide) should be used to maintain the facility outlined in this Operation and Maintenance Manual or follow the Maintenance requirements outlined in Appendix C when proprietary structure is selected below:

- Table 1 (general maintenance)
- Table 2 (stormwater ponds)
- Table 3 (water quality biofiltration swales)
- Table 4 (water quality filter strips)
- Table 5 (water quality bioslopes)
- Table 6 (detention tank)
- Table 7 (detention vault)
- Appendix C (proprietary structure)
- Special Maintenance requirements:

Note: Special maintenance Requirements Require Concurrence from ODOT SR Hydraulics Engineer.

## 8. Waste Material Handling

Material removed from the facility is defined as waste by DEQ. Refer to the roadwaste section of the ODOT Maintenance Yard Environmental Management System (EMS) Policy and Procedures Manual for disposal options: <http://egov.oregon.gov/ODOT/HWY/OOM/EMS.shtml>


Contact any of the following for more detailed information about management of waste materials found on site:

ODOT Clean Water Unit	(503) 986-3008
ODOT Statewide Hazmat Coordinator	(503) 229-5129
ODOT Region Hazmat Coordinator	(503) 986-2647
ODEQ Northwest Region Office	(503) 229-5263

# Appendix A

## Content:

- **Operational Plan and Profile Drawing(s)**

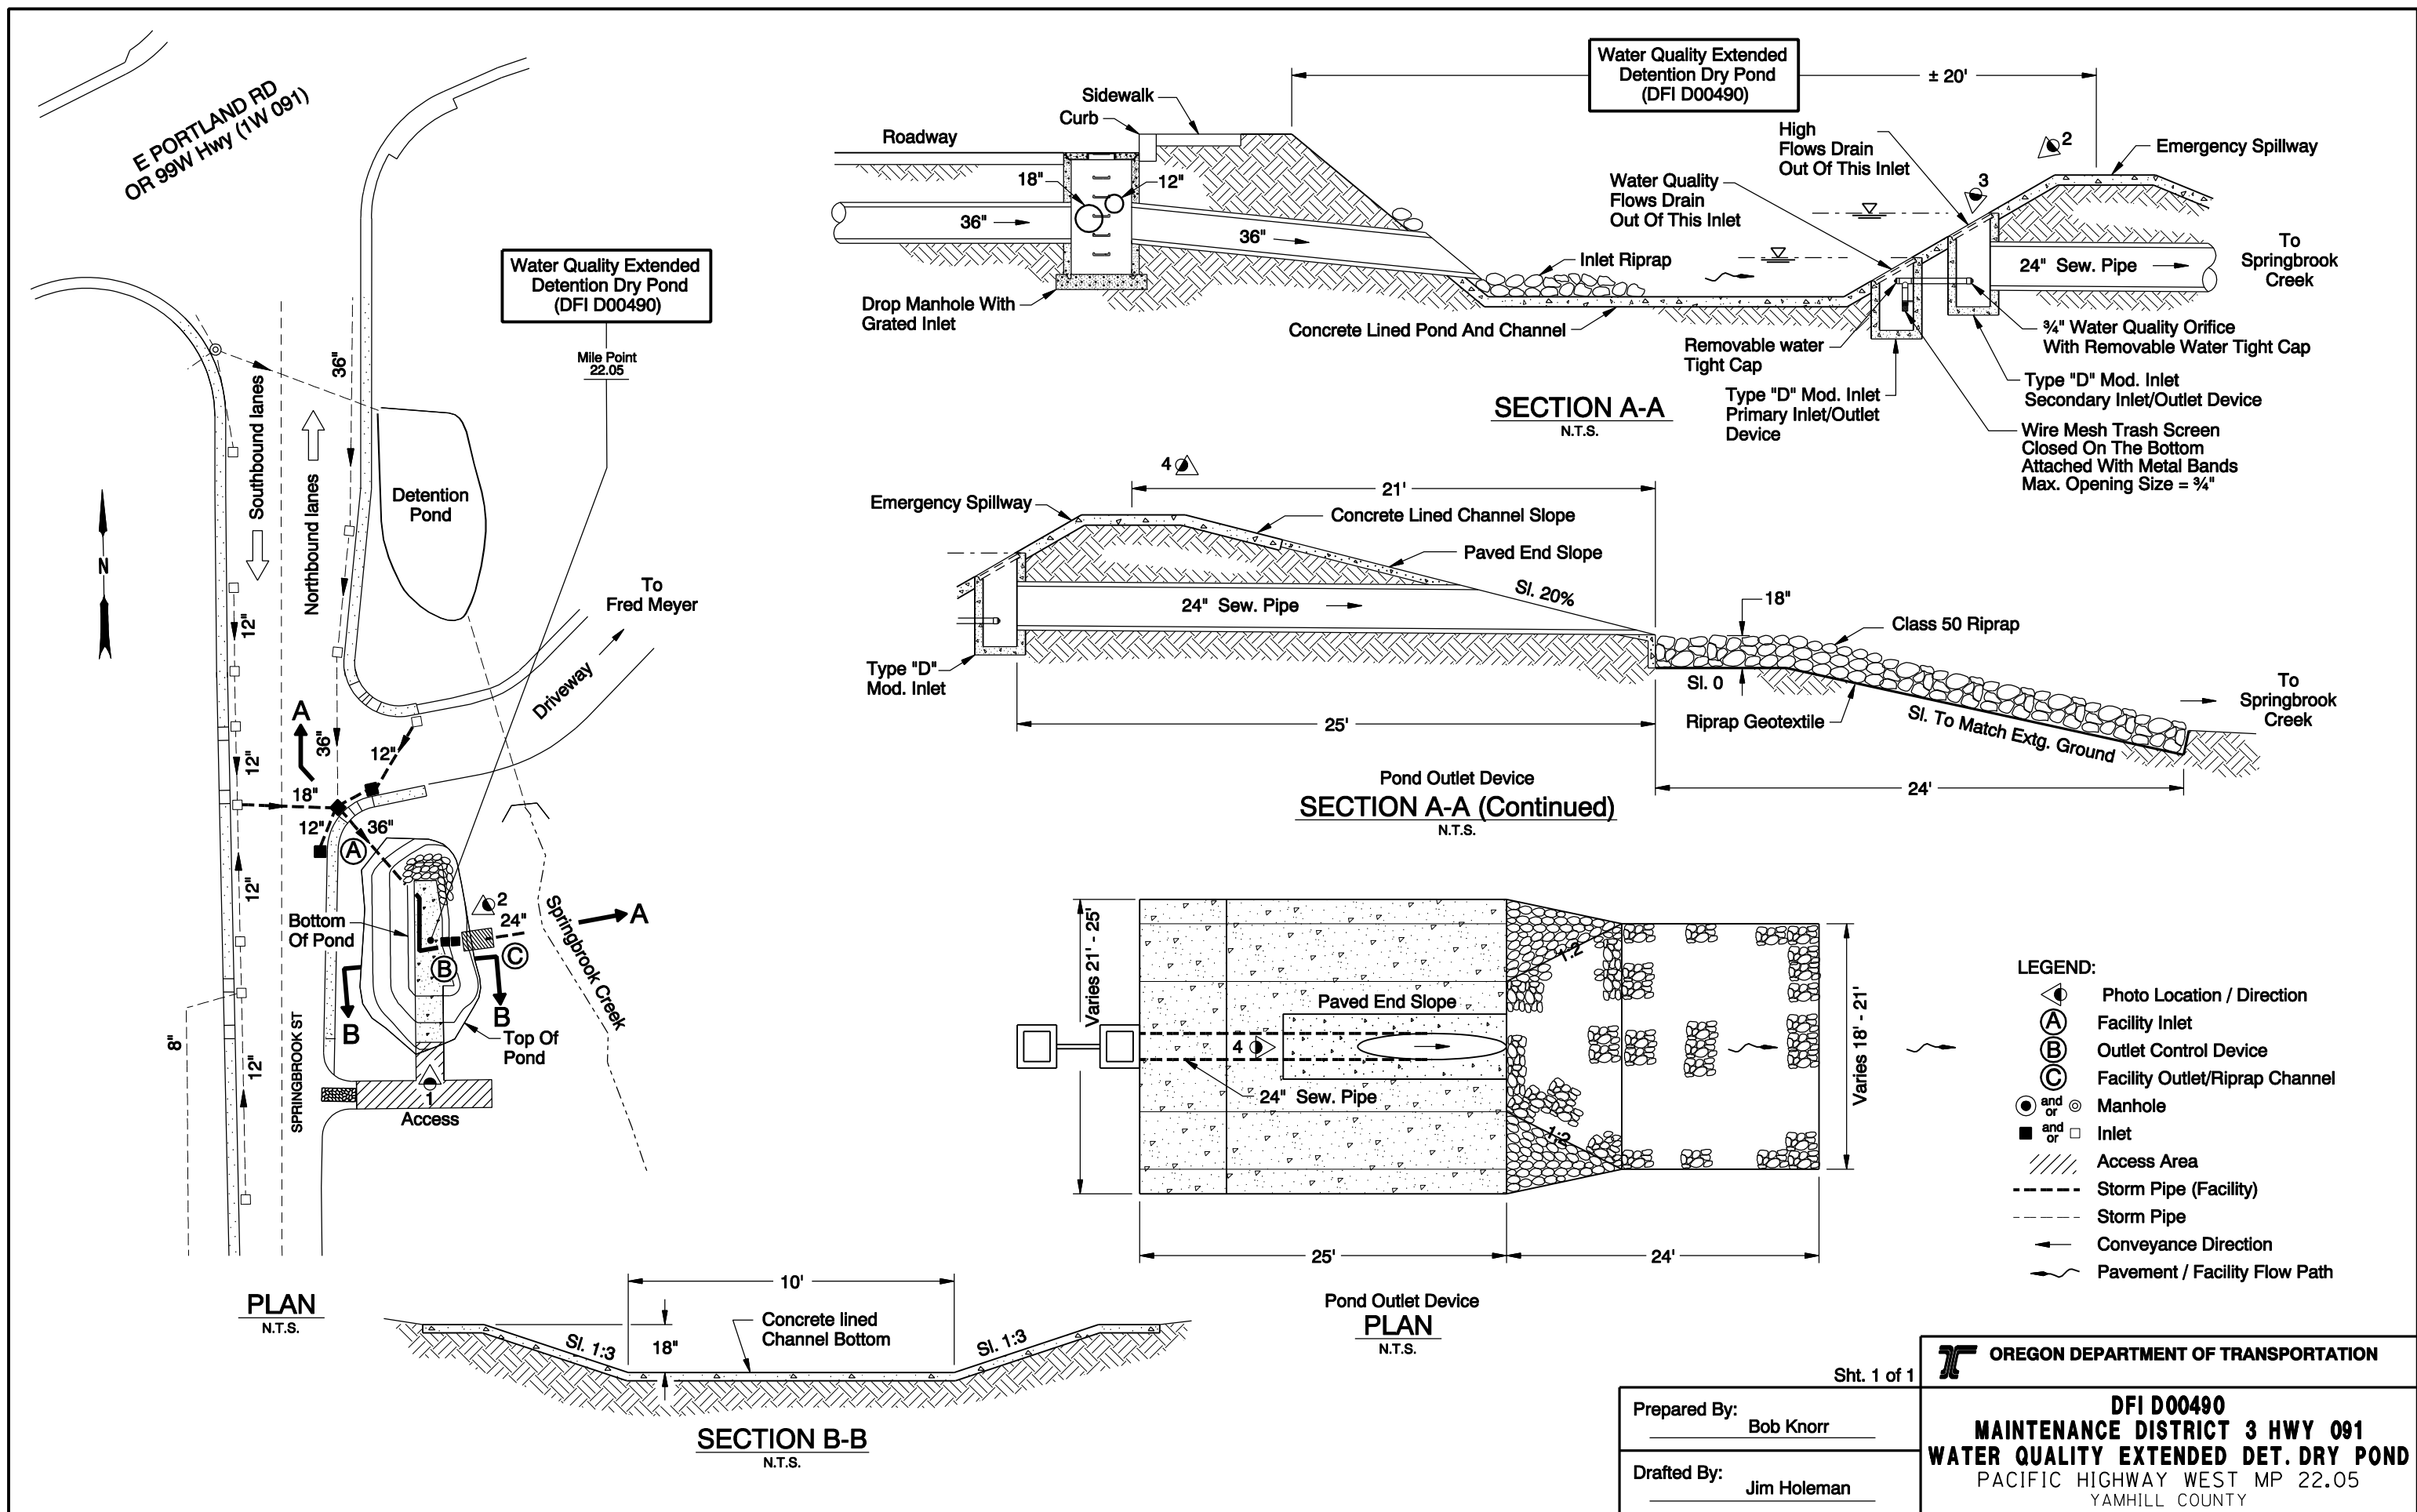

Sht. 1 of 1

**OREGON DEPARTMENT OF TRANSPORTATION**

**DFI D00490**  
**MAINTENANCE DISTRICT 3 HWY 091**  
**WATER QUALITY EXTENDED DET. DRY POND**  
 PACIFIC HIGHWAY WEST MP 22.05  
 YAMHILL COUNTY

Prepared By: Bob Knorr

Drafted By: Jim Holeman




## Appendix B

### Content:

- **ODOT Project Plan Sheets**
  - *Cover/Title Sheet*
  - *Water Quality/Detention Plan Sheets*
  - *Other Details*

STATE OF OREGON  
DEPARTMENT OF TRANSPORTATION  
PLANS FOR PROPOSED PROJECT

GRADING, STRUCTURE, PAVING, SIGNING & SIGNAL  
**BRUTSCHER ST. - EVEREST ST. &  
EVEREST ST. - MAIN ST. (NEWBERG) SECS.**  
PACIFIC HIGHWAY WEST  
YAMHILL COUNTY  
FEBRUARY 2001

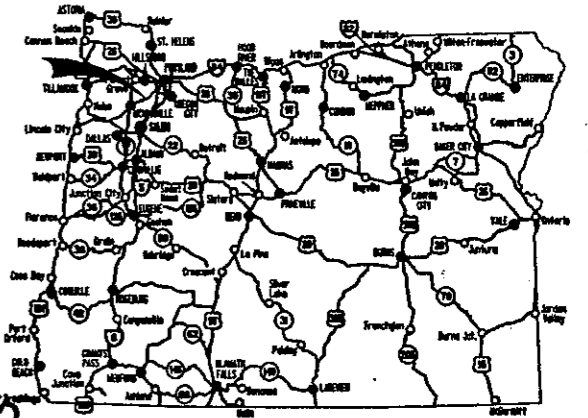

Overall Length Of Project - 3.15 km (1.96 Miles)

INDEX OF SHEETS	
SHEET NO.	DESCRIPTION
1	Title Sheet
1A	Index Of Sheets Contd.
1A-2	Standard Drawing Nos.
2, 2A	Main Line Typical Sections
2A-2 Thru	"F" Line Typical Sections
2A-4 Incl.	
2A-5, 2A-6	"H" Line Typical Sections
2A-7, 2A-8	"S" Line Typical Sections
2A-9	"V" Line Typical Sections
2A-10	"R" Line Typical Sections
2A-11	"HD", "CG", "MD" Line Typical Sections
2A-12	"M", "C" Line Typical Sections
2B	"F" Line, "H" Line Superlevation
2B-2	Mountable Island, Simulated Grid Pattern Details
2B-3	Raised Island, Mountable Table Conc. Island Details
2B-4	River Rd. Details
2B-5	Cul-De-Sac Details
2B-6	Pedestrian Bulb Out Detail
2B-8, 2B-9	Parking Facility Details
2B-10	Modified Sidewalk Ramp,
2B-11	Asph. Conc. Sidewalk Ramp Details
2B-12	Roof Drain, Special Slope Treatment Details
2B-13	Embankment Construction, Silver Fill Details
2B-14	Manhole Adjustment, Valve Box Details
2B-15	Combination Inlet Detail
2B-16	Outside Drop Manhole, Combination Inlet Detail
2B-17	Corrugated Metal Pipe Saddle, Blind Conn. Detail
2B-18	Type "D" Inlet Detail
2C Thru	Traffic Control Plans
2C-33 Incl.	
2D Thru	Erosion Control Details
2D-3 Incl.	
2D-4 Thru	Erosion Control Plans
2D-15 Incl.	
2E Thru	Pipe Data
2E-13 Incl.	
3	Alignment - Main Line
3A, 3B	General Construction - Main Line
3C, 3D	Drainage & Utilities - Main Line
3E	Profile - Main Line
3F	Drainage & Utilities - Main Line
4	Alignment - Main Line, "S" Line
4A	Alignment - "S" Line
4B, 4C	General Construction - Main Line, "S" Line
4D, 4E	General Construction - "S" Line
4F, 4G	Drainage & Utilities - Main Line, "S" Line

REVISED PLAN  
SHEETS INCORPORATED


REVISED PLAN  
SHEETS INCORPORATED

AS CONTRACTED  
PROJECT MANAGER

**ATTENTION :**  
Oregon Law Requires You To Follow Rules  
Adopted By The Oregon Utility Notification Center.  
Those Rules Are Set Forth In OAR 952-001-0010 Through  
OAR 952-001-0090. You May Obtain Copies Of The Rules From The Center,  
Or Answers To Questions About The Rules By Calling (503) 232-1987.

LET'S ALL  
WORK TOGETHER  
TO MAKE THIS  
JOB SAFE

END OF CONTRACT PROJ.  
STA. "SEWER" 1+241.4 (M.P. 23.89)

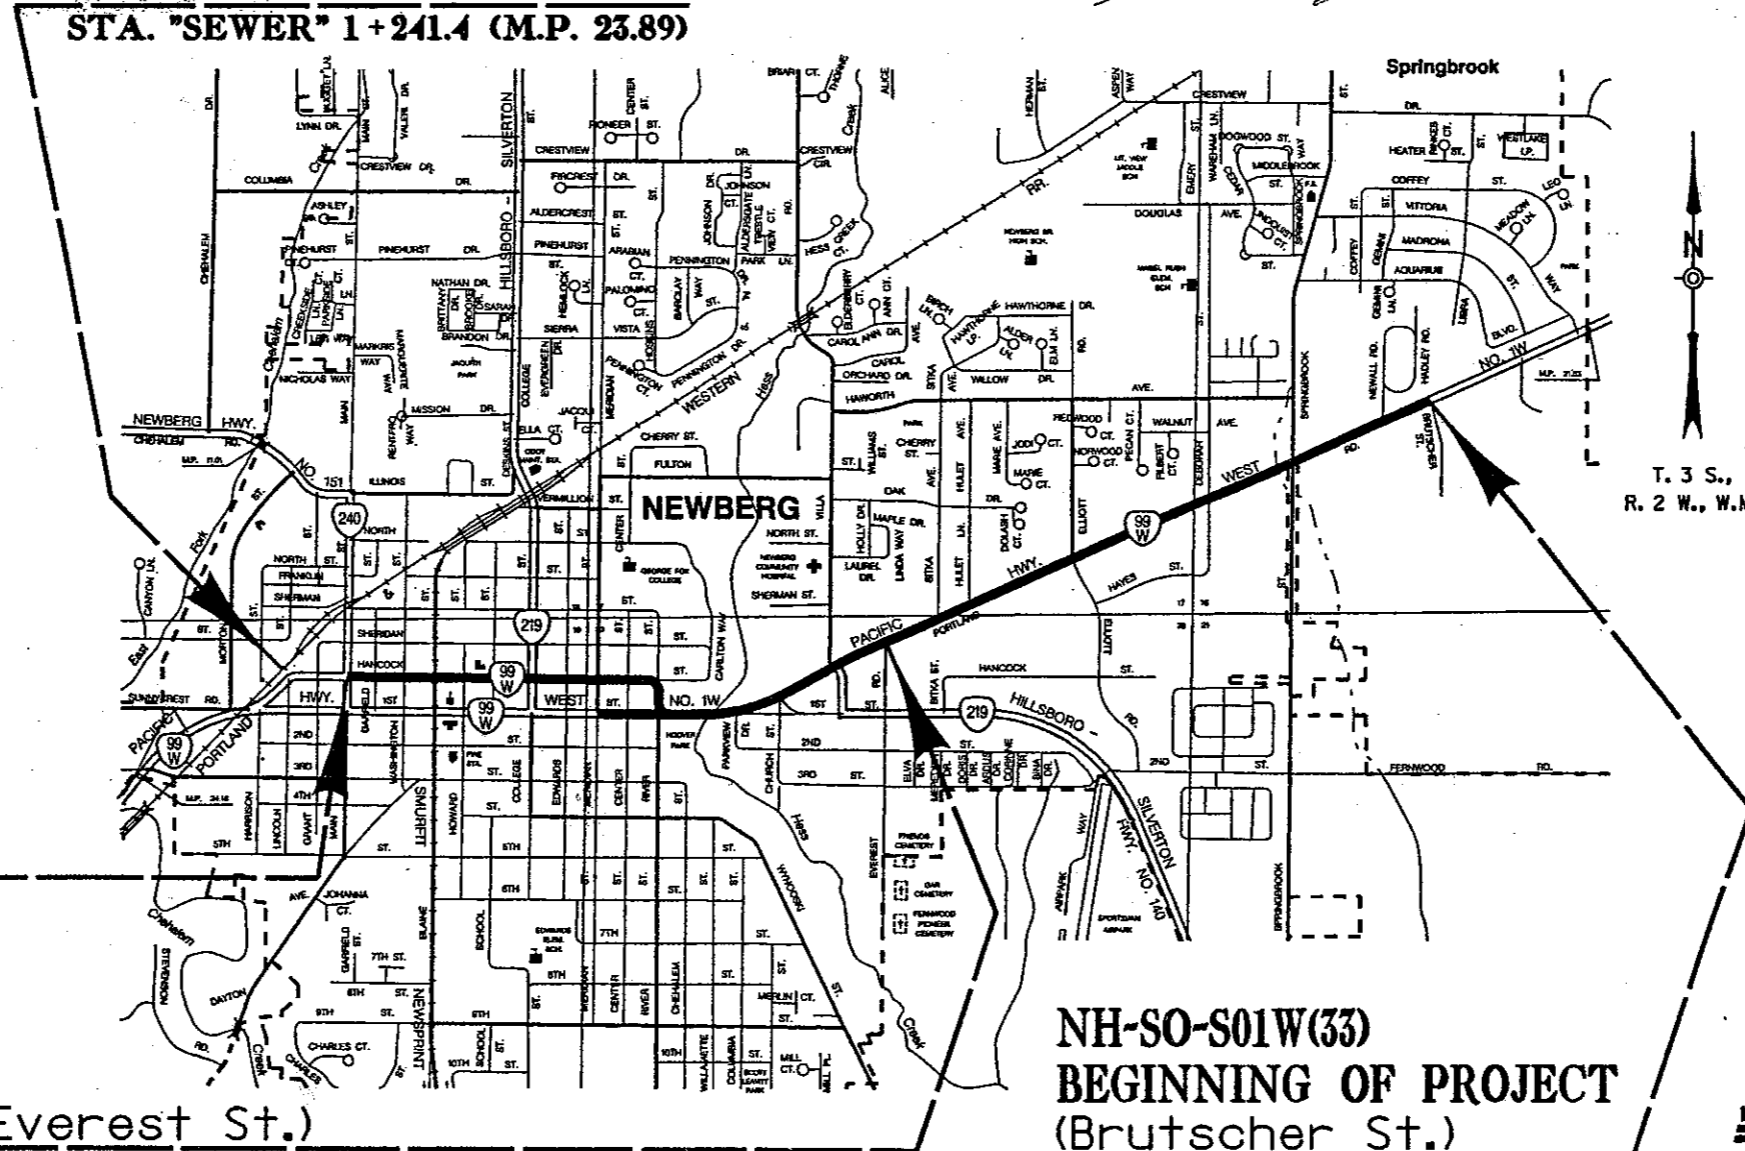


T. 3 S.,  
R. 2 W., W.M.

NH-SO-S01W(33)  
END OF PROJECT (Main St.)  
STA. 26+485 (M.P. 23.76)

NH-SO-S01W(33)  
BEGIN. & END OF PROJECT (Everest St.)  
STA. 24+990 (M.P. 22.80)

NH-SO-S01W(33)  
BEGINNING OF PROJECT  
(Brutscher St.)  
STA. 23+390 (M.P. 21.80)

- OREGON TRANSPORTATION COMMISSION
- Steven H. Corey CHAIRMAN
  - Gail L. Achterman COMMISSIONER
  - Stuart Foster COMMISSIONER
  - Randall Papé COMMISSIONER
  - John Russell COMMISSIONER
  - Grace Crunican DIRECTOR OF TRANSPORTATION

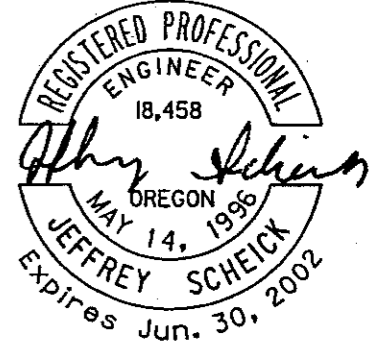

Jeffrey Scheick  
TECHNICAL SERVICES MANAGING ENGINEER


BRUTSCHER ST. - EVEREST ST. &  
EVEREST ST. - MAIN ST. (NEWBERG) SECS.  
PACIFIC HIGHWAY WEST  
YAMHILL COUNTY

FEDERAL HIGHWAY ADMINISTRATION	PROJECT NUMBER	SHEET NO.
REGION 10	OREGON DIVISION	NH-SO-S01W(33) 1

15-DEC-2000 12:42

c:\usr\projects\01222\pap2.mxd

Sec. 16, T.3S., R.2W., W.M.  
NEWBERG

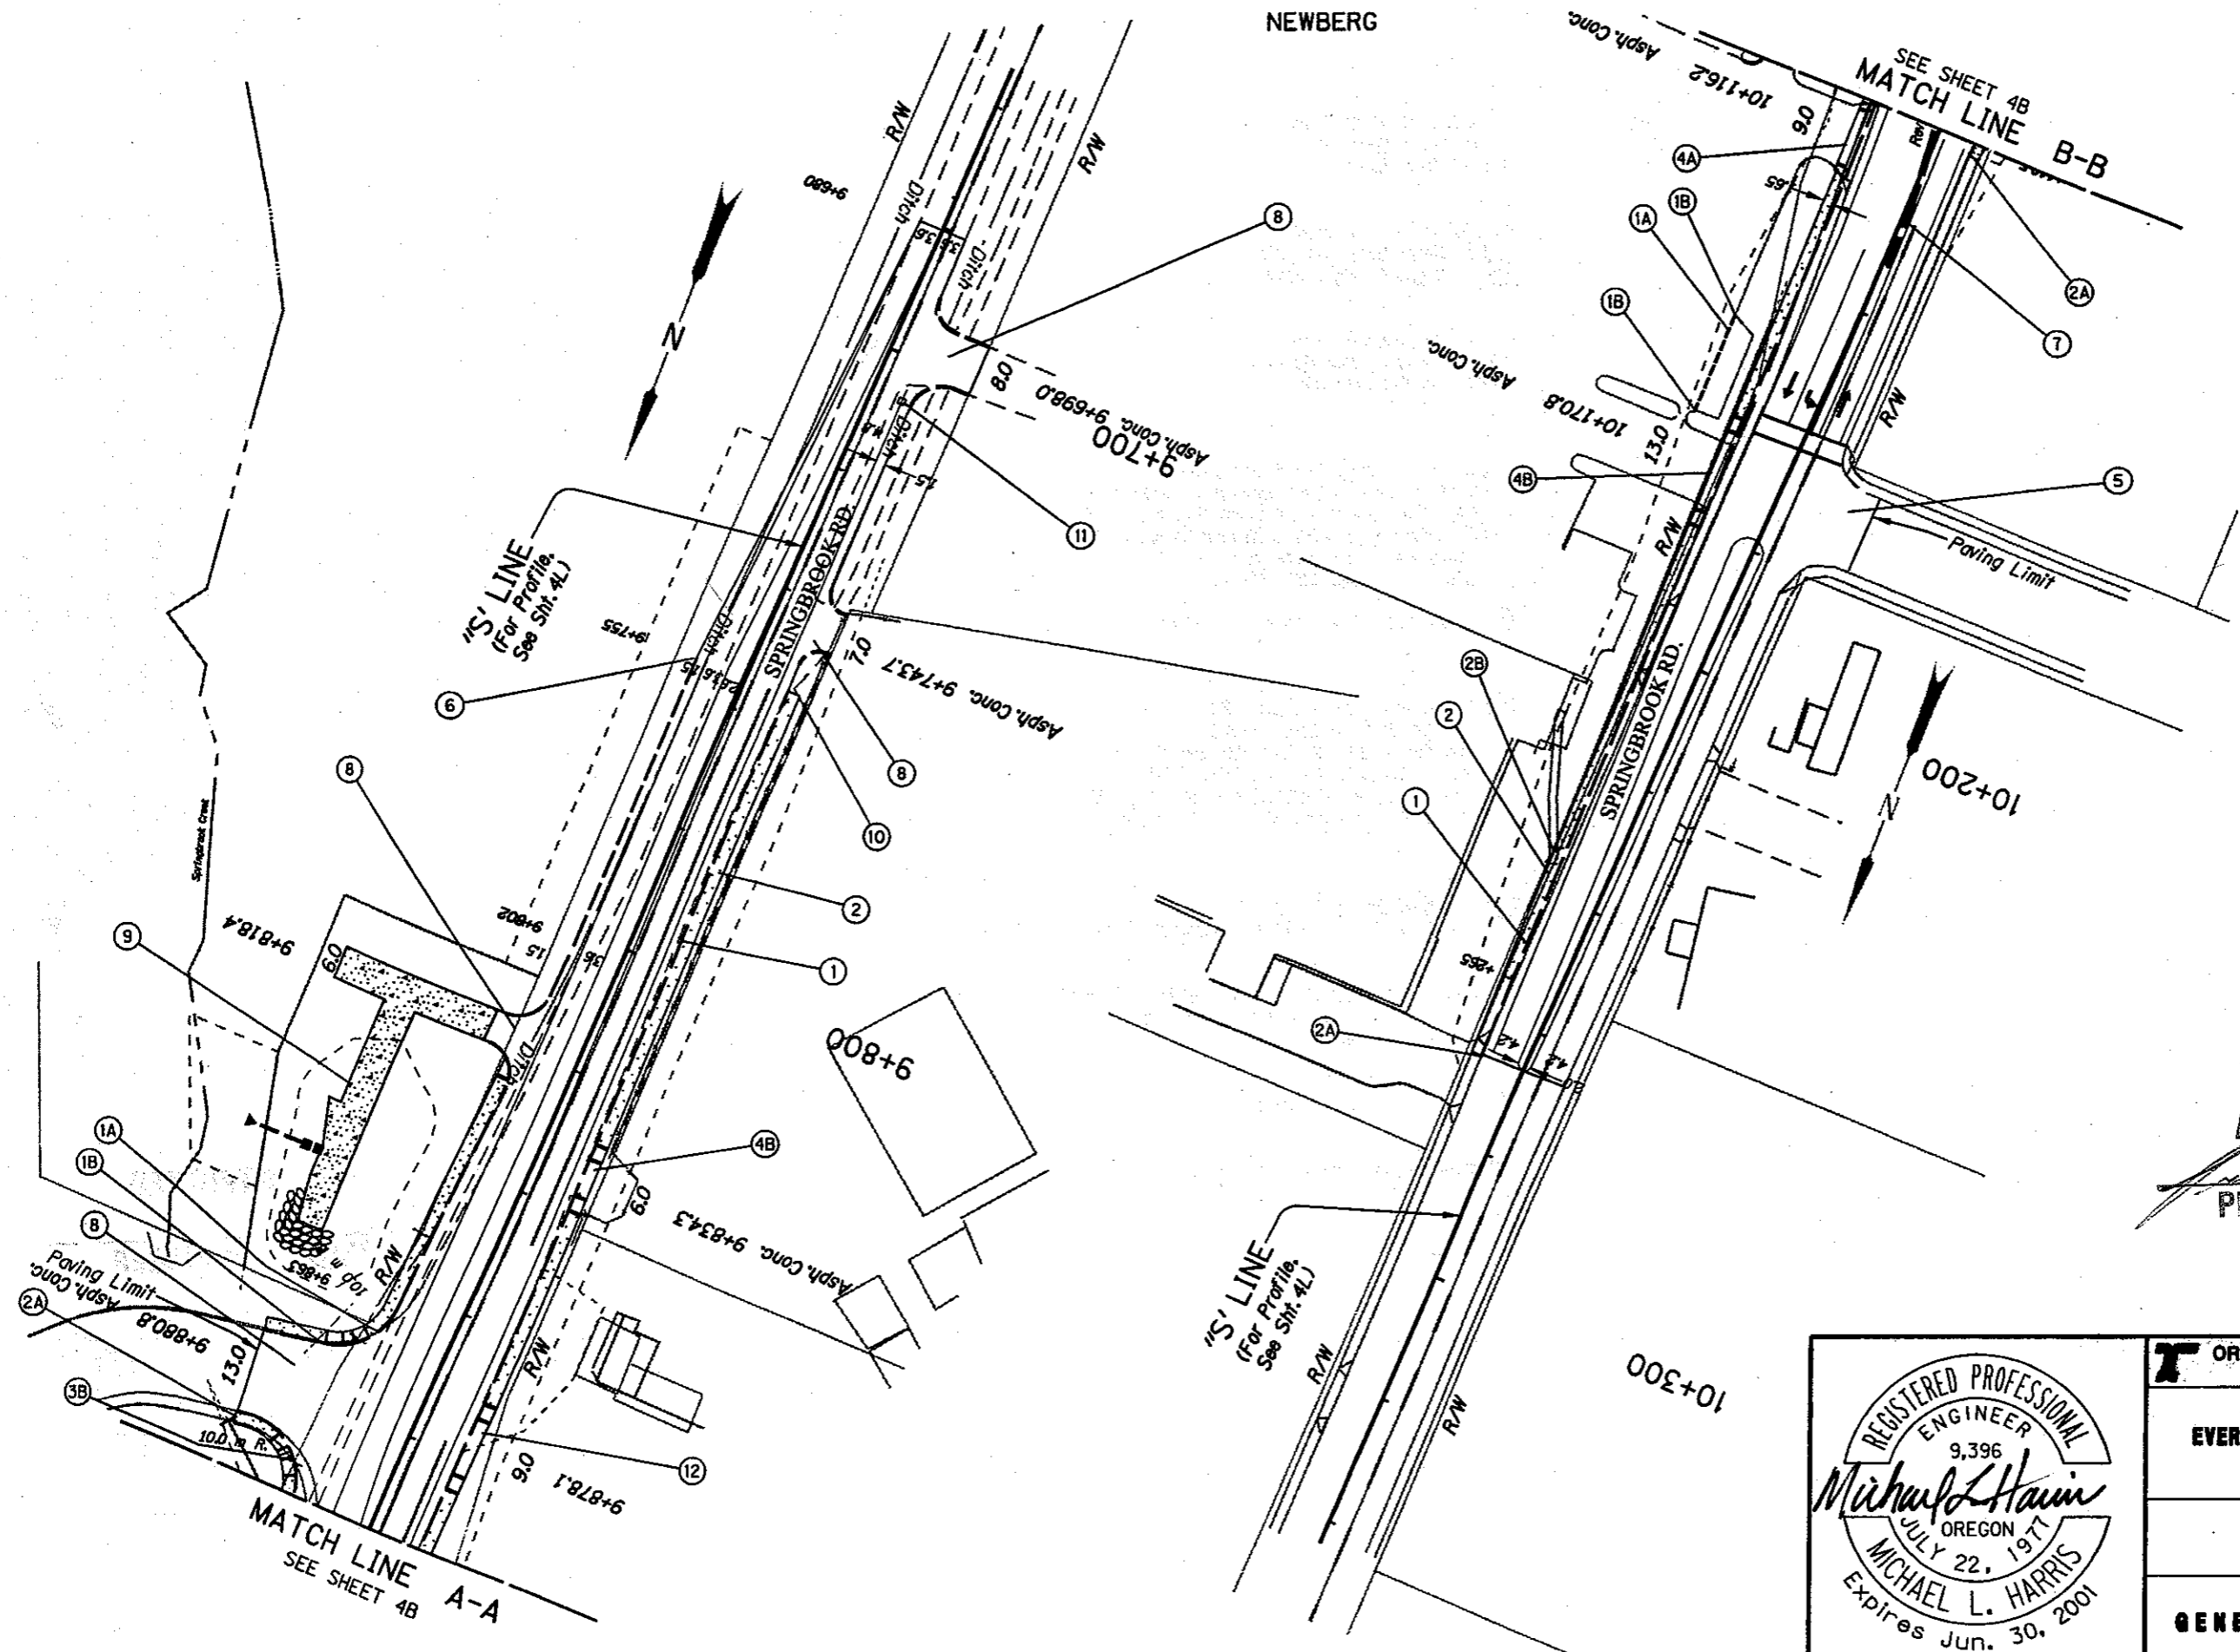

**AS CONSTRUCTED**  
*[Signature]*  
**PROJECT MANAGER**

All Dimensions Are In Meters (m)  
 Unless Otherwise Noted.



<b>OREGON DEPARTMENT OF TRANSPORTATION</b> ROADWAY ENGINEERING SECTION	
<b>BRUTSCHER ST. - EVEREST ST. &amp;          EVEREST ST. - MAIN ST. (NEWBERG) SECS.</b> PACIFIC HIGHWAY WEST YAMHILL COUNTY	
Design Team Leader - Michael L. Harris Designed By - Tandra Mortensen Drafted By - Robert J. Erpelding	
<b>GENERAL CONSTRUCTION</b>	SHEET NO. <b>4D</b>

13-DEC-2000 17:01  
 C:\usr\proj\ecis\022\sp07\0221.pcl



- ① Const. Type "A" Curb
- ①A Const. Type "C" Curb
- ①B Match Extg. Curb - 3

- ② Const. P.C. Conc. Walk
- ②A Match Extg. Sidewalk - 3
- ②B Connect Extg. Sidewalk

- Const. Sidewalk Ramp
- ③A Perpendicular Sidewalk Ramp - 0
- ③B Parallel Sidewalk Ramp - 1

- Const. P.C. Conc. Reinforced Driveway
- ④A Partially Lowered Sidewalk, Option A - 1
- ④B Fully Lowered Sidewalk, Option B - 2
- ④C Driveway In Wide Sidewalk, Option D - 0
- Const. Asph. Conc. Connection - 3
- (For Details, See Sht. 2B-11)

- ⑤ Const. Asph. Conc. Street Connection

- ⑥ Const. Curb Ending

- ⑦ See Sht. 4C, Note 6

- ⑧ Const. Approach - 4
- (See Drg. No. RD715)

- ⑨ Const. Water Quality Facility
- (For Details, See Shts. WC-1 Thru WC-5)

- ⑩ Const. Asph. Conc. Sidewalk Ramp
- (For Details, See Sht. 2B-10)

- ⑪ Remove Extg. Mailbox Support
- Install Single Mailbox Support
- (See Drg. No. RD100)

- ⑫ Const. P.C. Conc. Reinforced Driveway
- Fully Lowered Sidewalk, Option B
- (For Details, See Sht. 2B-11)

**AS CONSTRUCTED**  
  
**PROJECT MANAGER**




<b>OREGON DEPARTMENT OF TRANSPORTATION</b> ROADWAY ENGINEERING SECTION	
<b>BRUTSCHER ST. - EVEREST ST. &amp; EVEREST ST. - MAIN ST. (NEWBERG) SECS.</b> PACIFIC HIGHWAY WEST YAMHILL COUNTY	
Design Team Leader - Michael L. Harris Designed By - Tandra Mortensen Drafted By - Robert J. Erpelding	
<b>GENERAL CONSTRUCTION</b>	SHEET NO. <b>4E</b>

13-DEC-2000 17:2C

C:\usr\Projects\Pop070221.p3

Sec. 16, T.3S., R.2W., W.M.  
NEWBERG

REVISED AS CONSTRUCTED  
10-30-02 CONTRACT C12504

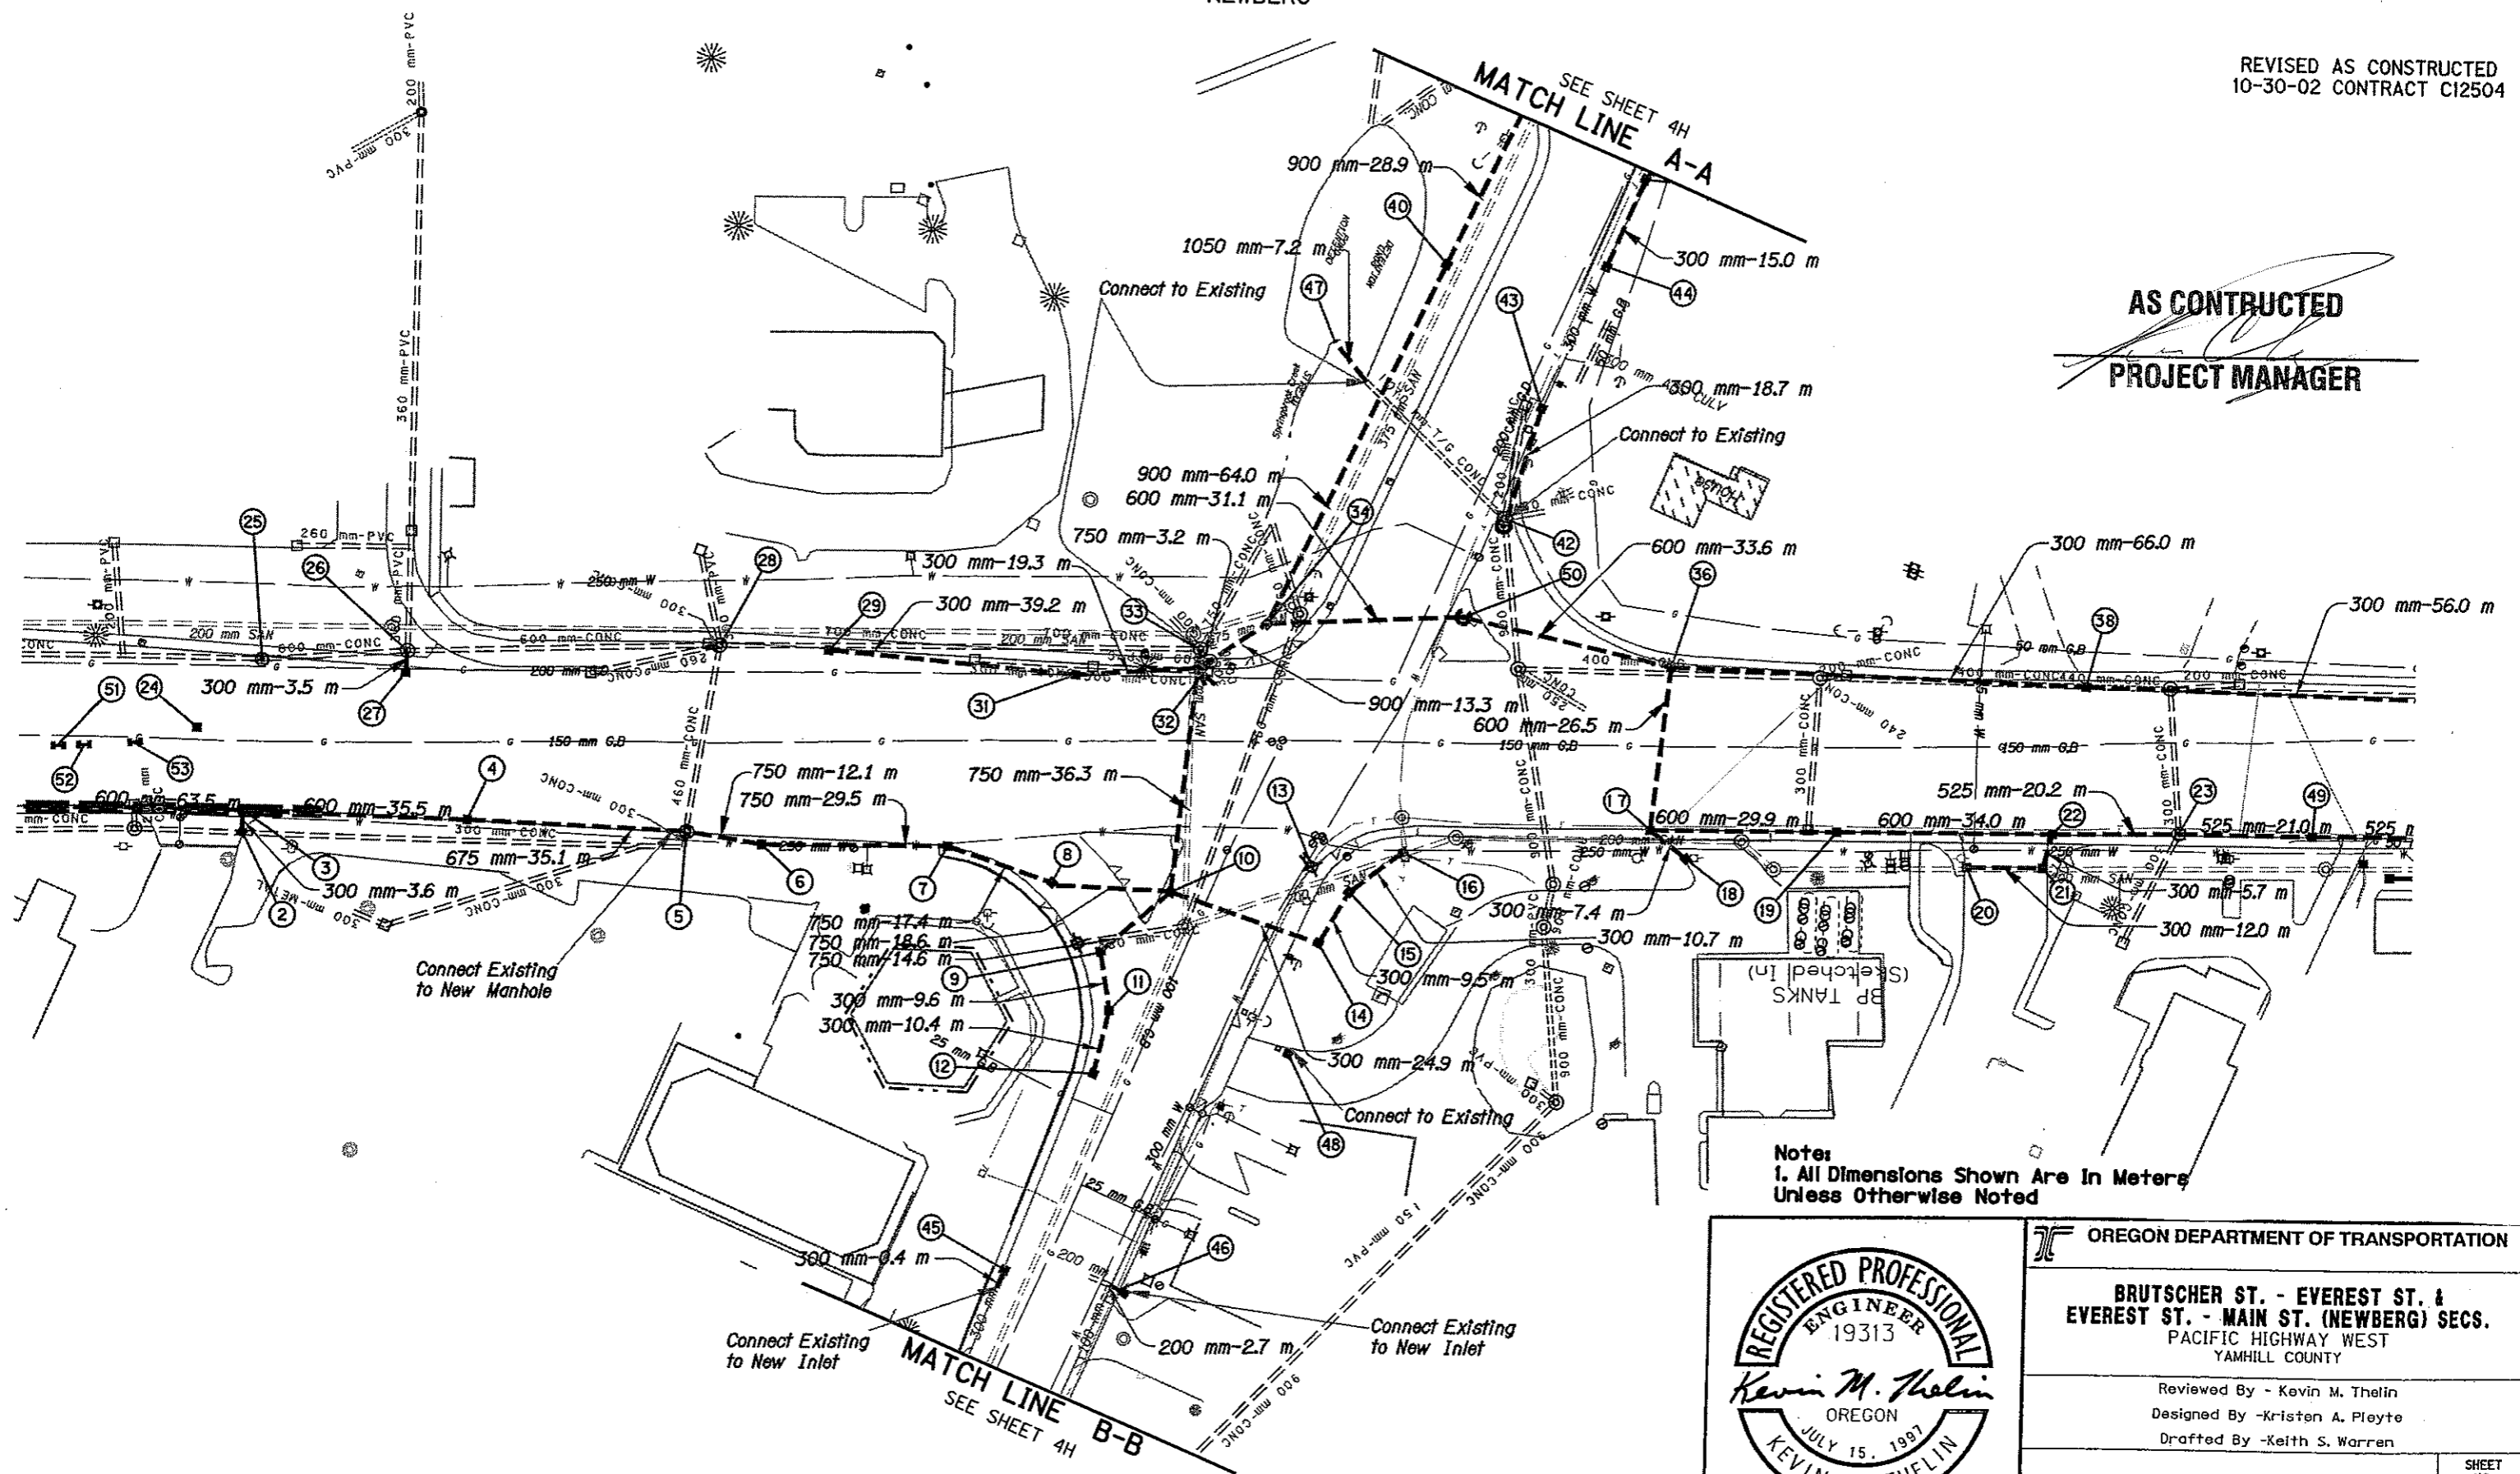

**AS CONSTRUCTED**  
**PROJECT MANAGER**

**Notes**  
1. All Dimensions Shown Are In Meters  
Unless Otherwise Noted

REGISTERED PROFESSIONAL  
ENGINEER  
19313  
*Kevin M. Thelin*  
OREGON  
JULY 15, 1997  
KEVIN M. THELIN  
EXPIRES 6-30-02

<p>OREGON DEPARTMENT OF TRANSPORTATION</p>	
<p><b>BRUTSCHER ST. - EVEREST ST. &amp; EVEREST ST. - MAIN ST. (NEWBERG) SECS.</b> PACIFIC HIGHWAY WEST YAMHILL COUNTY</p>	
<p>Reviewed By - Kevin M. Thelin Designed By - Kristen A. Pleyte Drafted By - Keith S. Warren</p>	
<p><b>DRAINAGE &amp; UTILITIES</b></p>	<p>SHEET NO. 4F</p>

08-NOV-2002 07:52  
C:\user\PROJECTS\From MS\N020212.dwg

# D R A I N A G E

- ② Sta. 23+627.50, 14.61 m Rt.  
Const. Type "G-2" Inlet  
FL = 61.475  
Inst. 300 mm Sew. Pipe - 3.6 m  
Tr. Exc. - 4 m<sup>3</sup>
- ③ Sta. 23+627.50, 11.05 m Rt.  
Const. 1500 mm Manhole with "G-2" Inlet  
Inst. 600 mm Sew. Pipe - 35.5 m  
Tr. Exc. - 66 m<sup>3</sup>
- ④ Sta. 23+663.00, 11.95 m Rt.  
Const. 1200 mm Manhole with "CG-2" Inlet  
Inst. 675 mm Sew. Pipe - 35.1 m  
Tr. Exc. - 82 m<sup>3</sup>
- ⑤ Sta. 23+698.08, 13.31 m Rt.  
  
Const. 1500 mm Manhole  
Connect to Extg. 300 mm Storm Pipe (N)  
Inst. 750 mm Sew. Pipe - 12.1 m  
Tr. Exc. - 35 m<sup>3</sup>
- ⑥ Sta. 23+710.00, 15.25 m Rt.  
Const. 1500 mm Manhole with "CG-2" Inlet  
Inst. 750 mm Sew. Pipe - 29.5 m  
Tr. Exc. - 84 m<sup>3</sup>
- ⑦ Sta. 23+739.54, 15.25 m Rt.  
Const. 1500 mm Manhole with "CG-2" Inlet  
Inst. 750 mm Sew. Pipe - 17.4 m  
Tr. Exc. - 49 m<sup>3</sup>
- ⑧ Sta. 23+756.03, 20.92 m Rt.  
Const. 1500 mm Manhole with "CG-2" Inlet  
Inst. 750 mm Sew. Pipe - 18.6 m  
Tr. Exc. - 33 m<sup>3</sup>
- ⑨ Sta. 23+763.84, 31.85 m Rt.  
= Sta. "S" 10+043.00, 18.30 m Rt.  
  
Const. 2100 mm Manhole with "CG-2" Inlet  
Inst. 300 mm Sew. Pipe - 9.6 m  
Inst. 750 mm Sew. Pipe - 14.6 m  
Under Pvmf. - 14.6 m  
Tr. Exc. - 43 m<sup>3</sup>
- ⑩ Sta. 23+774.73, 22.15 m Rt.  
= Sta. "S" 10+029.72, 12.30 m Rt.  
Const. 1500 mm Manhole with "CG-2" Inlet  
Inst. 300 mm Sew. Pipe - 24.9 m  
Inst. 750 mm Sew. Pipe - 36.3 m  
Under Pvmf. - 61.2 m  
Tr. Exc. - 138 m<sup>3</sup>
- ⑪ Sta. "S" 10+051.00, 13.05 m Rt.  
Const. Type "CG-2" Inlet
- ⑫ Sta. "S" 10+061.18, 11.13 m Rt.  
Const. Type "CG-2" Inlet  
Inst. 300 mm Sew. Pipe - 10.4 m  
Tr. Exc. - 9 m<sup>3</sup>
- ⑬ Sta. 23+798.37, 29.94 m Rt.  
  
Const. Type "CG-2" Inlet  
Inst. 300 mm Sew. Pipe - 9.5 m  
Tr. Exc. - 10 m<sup>3</sup>
- ⑭ Sta. 23+803.10, 21.67 m Rt.  
Const. Type "CG-2" Inlet  
Inst. 300 mm Sew. Pipe - 10.7 m  
Tr. Exc. - 10 m<sup>3</sup>
- ⑮ Sta. 23+812.00, 15.10 m Rt.  
Const. Type "CG-2" Inlet
- ⑯ Sta. 23+850.15, 11.06 m Rt.  
Const. 1500 mm Offset Manhole with  
"CG-2" Inlet  
Inst. 300 mm Sew. Pipe - 7.4 m  
Inst. 600 mm Sew. Pipe - 56.4 m  
Under Pvmf. - 41.5 m  
Tr. Exc. - 140 m<sup>3</sup>
- ⑰ Sta. 23+856.00, 15.61 m Rt.  
Const. Type "G-2" Inlet  
FL = 60.338
- ⑱ Sta. 23+880.00, 11.05 m Rt.  
Remove Inlet  
Const. 1200 mm Manhole with "CG-2" Inlet  
Inst. 600 mm Sew. Pipe - 34.0 m  
  
Tr. Exc. - 71 m<sup>3</sup>
- ⑲ Sta. 23+900.50, 16.51 m Rt.  
Const. Type "G-2" Inlet  
FL = 60.725  
Inst. 300 mm Sew. Pipe - 12.0 m  
Under Pvmf. - 12.0 m  
Tr. Exc. - 13 m<sup>3</sup>
- ⑳ Sta. 23+912.50, 16.51 m Rt.  
Const. Type "G-2" Inlet  
FL (NE) = 60.665  
FL (SW) = 60.605
- ㉑ Sta. 23+914.00, 11.05 m Rt.  
Const. 1500 mm Manhole with "G-2" Inlet  
Inst. 300 mm Sew. Pipe - 5.7 m  
Inst. 525 mm Sew. Pipe - 20.2 m  
Tr. Exc. - 45 m<sup>3</sup>
- ㉒ Sta. 23+934.18, 9.0 m Rt.  
Remove Inlet  
Const. 1500 mm Manhole  
Inst. 525 mm Sew. Pipe - 21.0 m  
Under Pvmf. - 11.0 m  
Tr. Exc. - 40 m<sup>3</sup>
- ㉓ Sta. 23+630.24, 13.40 m Lt.  
  
Const. 1800 mm Drop Manhole
- ㉔ Sta. 23+653.00, 15.50 m Lt.  
Adjust Manhole  
FL (N) = 60.737
- ㉕ Sta. 23+653.00, 12.00 m Lt.  
Const. Type "CG-2" Inlet  
Inst. 300 mm Sew. Pipe - 3.5 m  
Connect to Extg. Manhole  
Tr. Exc. - 4 m<sup>3</sup>
- ㉖ Sta. 23+702.50, 17.00 m Lt.  
  
Adjust Manhole
- ㉗ Sta. 23+720.00, 16.15 m Lt.  
Const. Type "CG-2" Inlet  
Inst. 300 mm Sew. Pipe - 39.2 m  
Tr. Exc. - 33 m<sup>3</sup>
- ㉘ Sta. 23+759.05, 13.00 m Lt.  
  
Const. Type "CG-2" Inlet  
Inst. 300 mm Sew. Pipe - 19.3 m  
Tr. Exc. - 18 m<sup>3</sup>
- ㉙ Sta. 23+779.0, 14.07 m Lt.  
= Sta. "S" 9+995.21, 23.67 m Rt.  
  
Const. 2100 Drop Manhole with  
"CG-2" Inlet  
Inst. 900 mm Sew. Pipe - 13.3 m  
Tr. Exc. - 74 m<sup>3</sup>
- ㉚ Sta. 23+778.00, 17.00 m Lt.  
Adjust Manhole  
Inst. 750 mm Encased CMP - 3.2 m  
Connect to Extg. Manhole  
Plug Extg. FL(S)  
Tr. Exc. - 17 m<sup>3</sup>
- ㉛ Sta. 23+790.6, 21.88 m Lt.  
= Sta. "S" 9+983.96, 16.59 m Rt.  
  
Const. 2100 mm Drop Manhole with  
"CG-2" Inlet  
Inst. 600 mm Sew. Pipe - 31.1 m  
Inst. 900 mm Sew. Pipe - 64.0 m  
Under Pvmf. - 21.0 m  
Tr. Exc. - 378 m<sup>3</sup>
- ㉜ Sta. 23+830.00, 14.50 m Lt.  
  
Adjust Manhole
- ㉝ Sta. 23+853.07, 15.25 m Lt.  
Const. 1500 mm Drop Manhole with  
"CG-2" Inlet  
Inst. 300 mm Sew. Pipe - 66.0 m  
Under Pvmf. - 14.0 m  
Tr. Exc. - 65 m<sup>3</sup>
- ㉞ Sta. 23+919.00, 13.00 m Lt.  
Const. Type "CG-2" Inlet  
Inst. 300 mm Sew. Pipe - 56.0 m  
Under Pvmf. - 14.0 m  
Tr. Exc. - 46 m<sup>3</sup>
- ㉟ Sta. "S" 9+920.00, 14.10 m Rt.  
Const. 1800 mm Manhole with "CG-2" Inlet  
Inst. 900 mm Sew. Pipe - 28.9 m  
Tr. Exc. - 82 m<sup>3</sup>
- ㊱ Sta. "S" 9+953.04, 11.0 m Lt.  
Adjust Manhole  
Inst. 300 mm Sew. Pipe - 18.7 m  
Connect to Extg. Manhole  
Tr. Exc. - 27 m<sup>3</sup>
- ㊲ Sta. "S" 9+935.00, 8.15 m Lt.  
  
Const. Type "CG-2" Inlet
- ㊳ Sta. "S" 9+910.00, 7.98 m Lt.  
Const. Type "CG-2" Inlet  
Inst. 300 mm Sew. Pipe - 15.0 m  
Tr. Exc. - 15 m<sup>3</sup>
- ㊴ Sta. "S" 10+095.19, 10.57 m Rt.  
  
Const. Type "CG-2" Inlet  
Inst. 300 mm Sew. Pipe - 0.4 m  
Connect to Extg. 300 mm Storm Pipe (N)  
Tr. Exc. - 1 m<sup>3</sup>
- ㊵ Sta. "S" 10+091.00, 8.00 m Lt.  
  
Const. Type "G-2" Inlet  
Inst. 200 mm Sew. Pipe - 2.7 m  
Connect to Extg. 200 mm Pipe (E)  
Deflect Extg. 100 mm Pipe (N) to Connect  
to New Inlet  
Tr. Exc. - 2 m<sup>3</sup>
- ㊶ Sta. "S" 9+942.19, 18.50 m Rt.  
Inst. 1050 mm Sew. Pipe - 7.2 m  
Connect to Extg. Culvert Pipe (W)  
Outfall FL = 55.106  
Tr. Exc. - 40 m<sup>3</sup>
- ㊷ Sta. "S" 10+045.27, 15.54 m Lt.  
  
Const. City of Newberg  
Type 2 Catch Basin  
Connect to Extg. Storm line  
As Directed By Field Engineer
- ㊸ See Sheet 5C, Note 1
- ㊹ Sta. 23+820.34, 23.00 m Lt.  
Const. 1200 mm Manhole  
Inst. 600 mm Sew. Pipe - 33.6 m  
Under Pvmf. - 5.0 m  
Tr. Exc. - 95 m<sup>3</sup>
- ㊺ Sta. 23+597.13, 1.15 m Rt.  
Inst. 100 mm PVC Waterline Sleeve  
- 1.7 m
- ㊻ Sta. 23+601.17, 1.02 m Rt.  
Inst. 100 mm PVC Waterline Sleeve  
- 1.7 m
- ㊼ Sta. 23+609.25, 0.56 m Rt.  
Inst. 100 mm PVC Waterline Sleeve  
- 1.7 m

**AS CONSTRUCTED**  
  
**PROJECT MANAGER**




<b>OREGON DEPARTMENT OF TRANSPORTATION ROADWAY ENGINEERING SECTION</b>	
<b>BRUTSCHER ST. - EVEREST ST. &amp; EVEREST ST. - MAIN ST. (NEWBERG) SECS. PACIFIC HIGHWAY WEST YAMHILL COUNTY</b>	
Reviewed By - Kevin M. Thelin Designed By - Kristen A. Pleyte Drafted By - Keith S. Warren	
<b>DRAINAGE &amp; UTILITIES</b>	SHEET NO. <b>4G</b>

26-NOV-2002 07:51  
C:\usr\PROJECTS\From MSANOT02Z1.rtf




REVISED AS CONSTRUCTED  
10-30-02 CONTRACT C12504

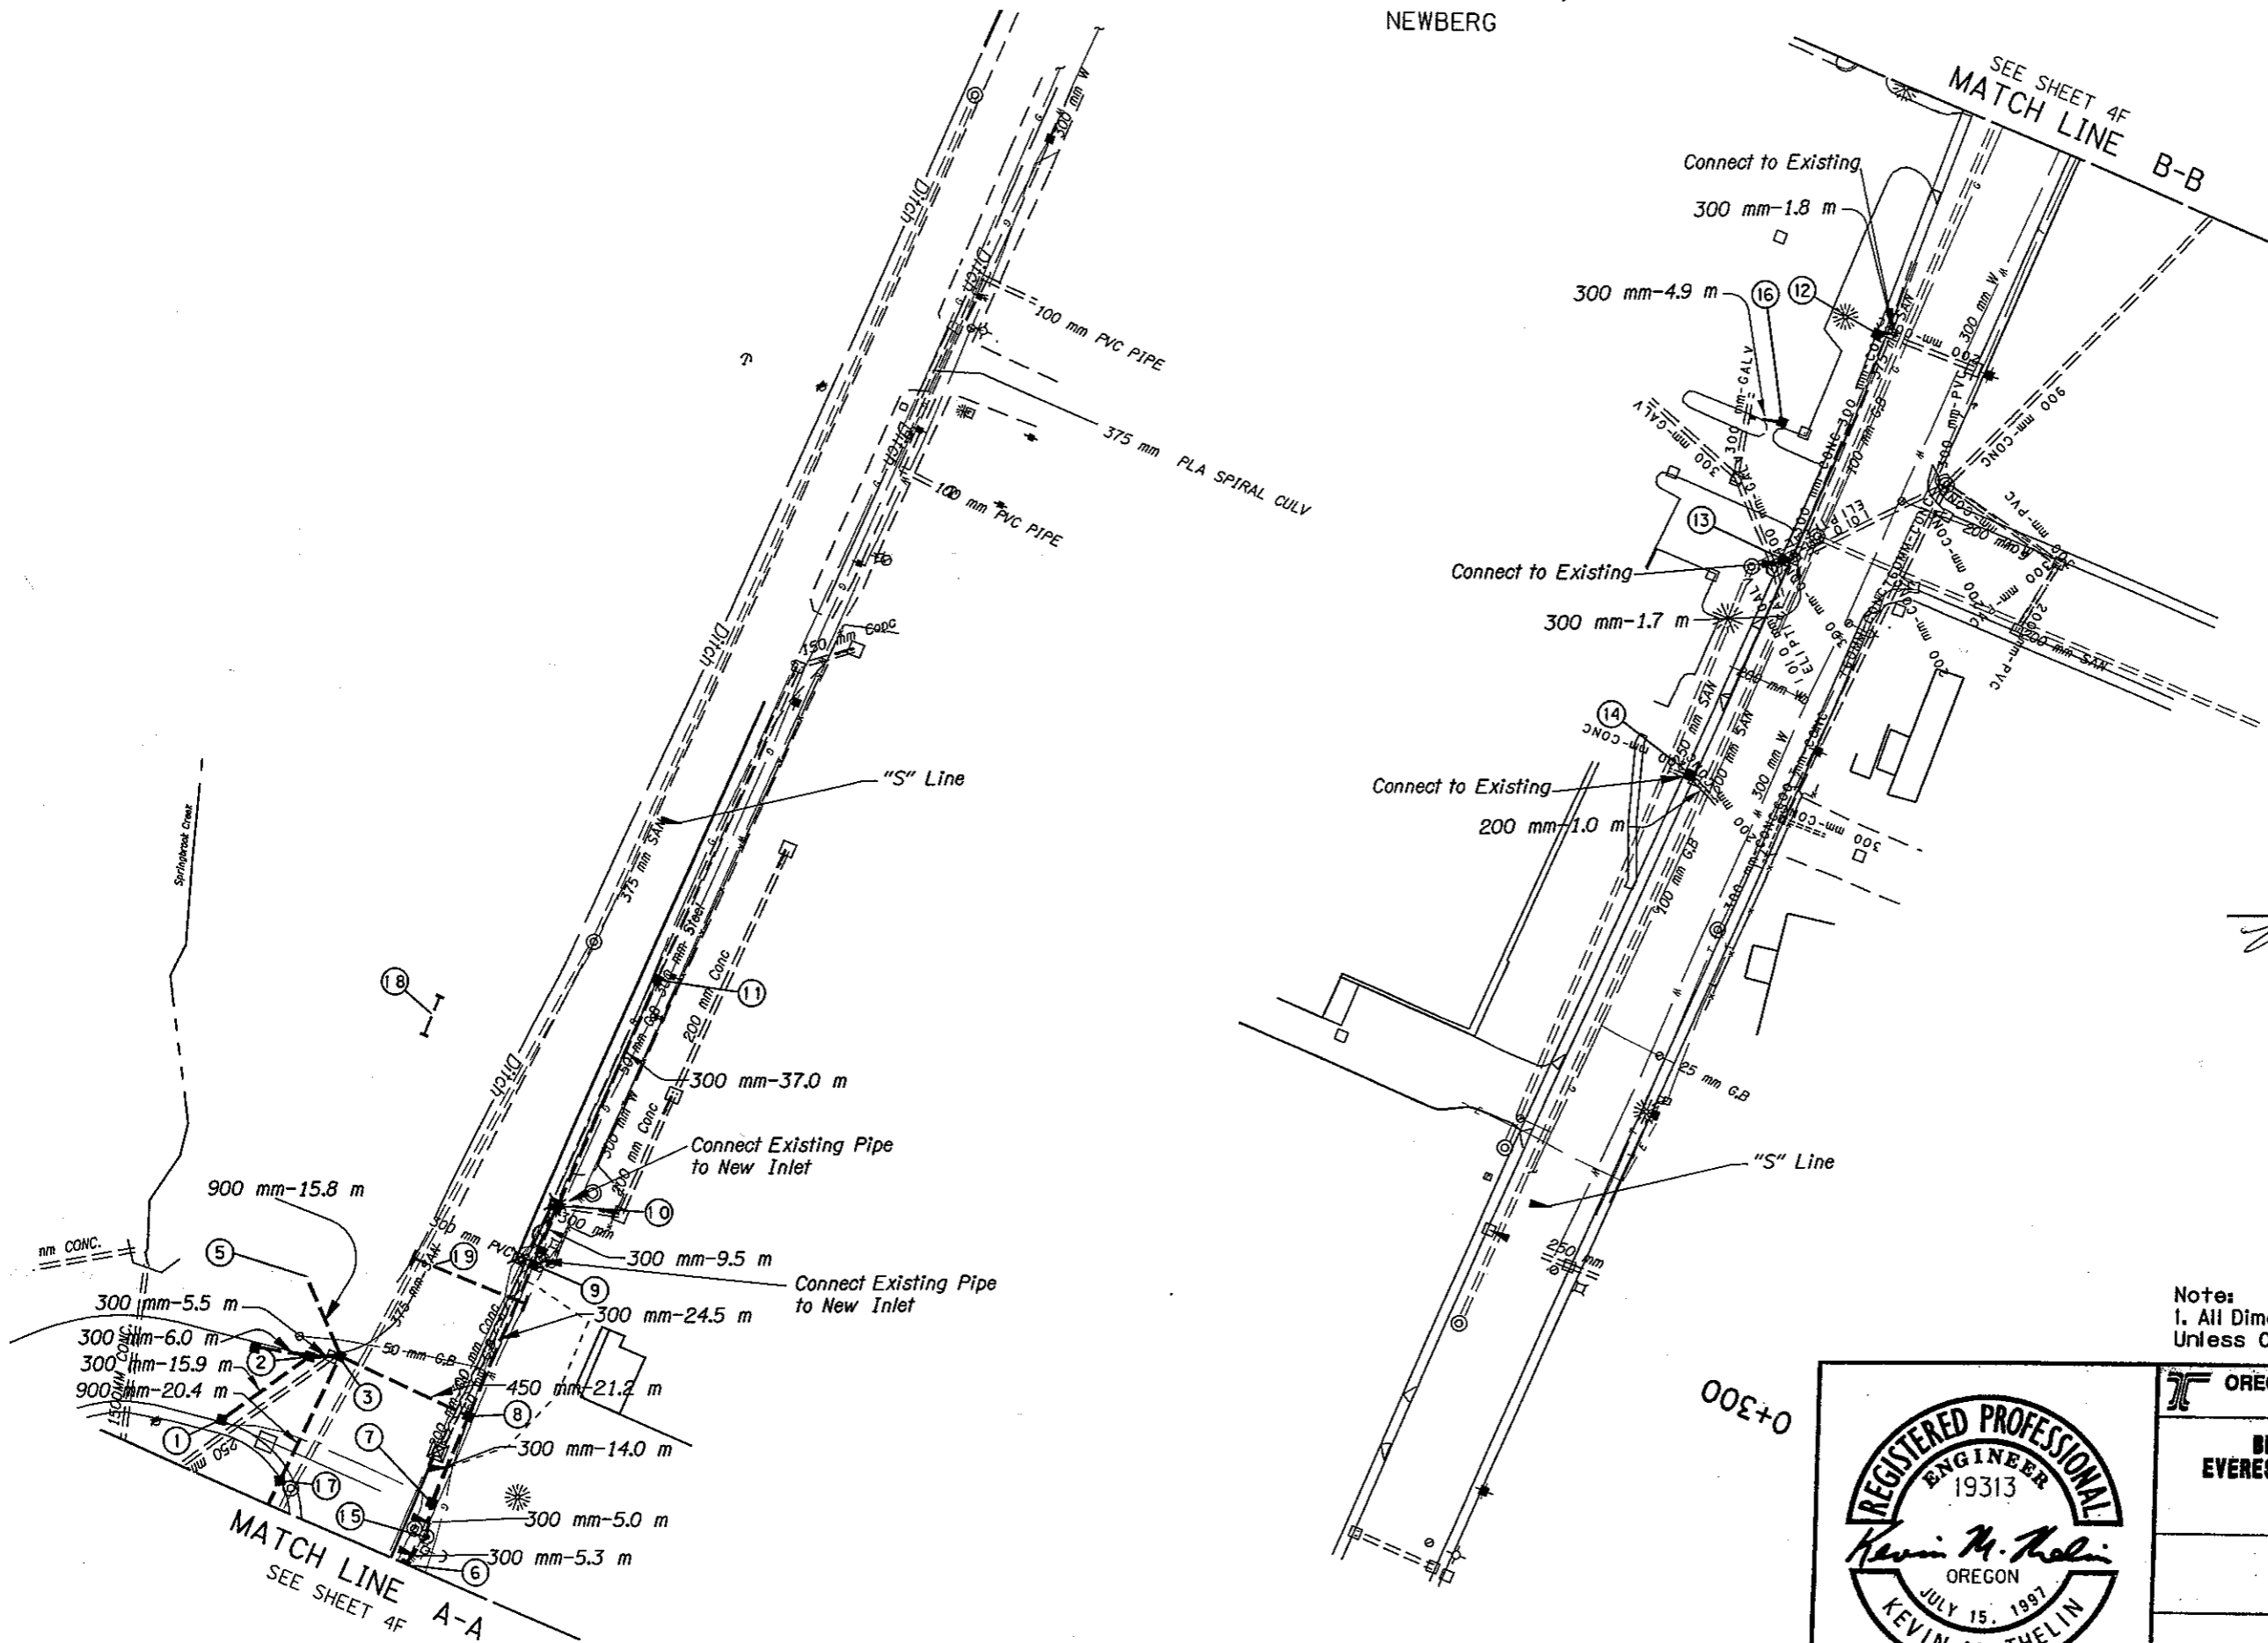

**AS CONSTRUCTED**  
*[Signature]*  
**PROJECT MANAGER**

Note:  
1. All Dimensions Shown Are In Meters  
Unless Otherwise Noted

Abandon Pipe Shown Thus:

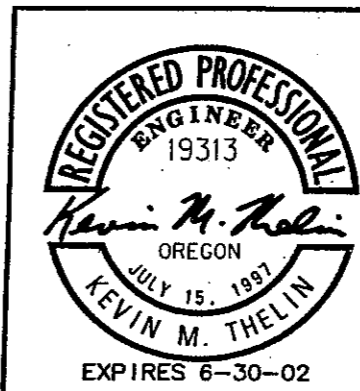

OREGON DEPARTMENT OF TRANSPORTATION	
BRUTSCHER ST. - EVEREST ST. & EVEREST ST. - MAIN ST. (NEWBERG) SECS. PACIFIC HIGHWAY WEST YAMHILL COUNTY	
Reviewed By - Kevin M. Thelin	Designed By - Kristen A. Pleyte
Drafted By - Keith S. Warren	
<b>DRAINAGE &amp; UTILITIES</b>	SHEET NO. <b>4H</b>

26-NOV-2002 08:06  
C:\usr\PROJECTS\From MSA\02272.dwg


# D R A I N A G E

34V-25

REVISED AS CONSTRUCTED  
10-24-02 CONTRACT CI2504

- ① Sta. "S" 9+886.48, 25.51 m Rt.  
Const. Type "CG-2" Inlet  
Inst. 300 mm Sew. Pipe - 15.9 m  
Under Pymt. - 15.9 m  
Tr. Exc. - 14 m<sup>3</sup>
- ② Sta. "S" 9+872.63, 17.68 m Rt.  
Const. 2 Type "CG-2" Inlet  
Inst. 300 mm Sew. Pipe - 11.5 m  
Tr. Exc. - 6 m<sup>3</sup>
- ③ Sta. "S" 9+868.09, 14.47 m Rt.  
Const. 2100 mm Drop Manhole with "CG-2" Inlet  
Inst. 450 mm Sew. Pipe - 21.2 m  
  
Under Pymt. - 21.2 m  
Tr. Exc. - 58 m<sup>3</sup>
- ⑤ Sta. "S" 9+859.13, 24.91 m Rt.  
(See Water Quality Details, Sheet WC-1)  
Inst. 900 mm Sew. Pipe - 15.8 m  
Tr. Exc. - 56 m<sup>3</sup>
- ⑥ Sta. "S" 9+894.99, 7.83 m Lt.  
Const. Type "CG-2" Inlet  
Inst. 300 mm Sew. Pipe - 5.3 m  
Tr. Exc. - 6 m<sup>3</sup>
- ⑦ Sta. "S" 9+885.00, 7.73 m Lt.  
Const. Type "CG-2" Inlet  
Inst. 300 mm Sew. Pipe - 14.0 m  
Under Pymt. - 14.0 m  
Tr. Exc. - 15 m<sup>3</sup>
- ⑧ Sta. "S" 9+871.00, 7.59 m Lt.  
Const. Type "CG-2" Inlet  
Inst. 300 mm Sew. Pipe - 24.5 m  
Tr. Exc. - 27 m<sup>3</sup>
- ⑨ Sta. "S" 9+846.53, 7.35 m Lt.  
Remove Inlet  
Const. Type "CG-2" Inlet  
Connect to Extg. Storm Pipe (W)  
Inst. 300 mm Sew. Pipe - 9.5 m  
Tr. Exc. - 9 m<sup>3</sup>
- ⑩ Sta. "S" 9+837.05, 7.25 m Lt.  
Remove Inlet  
Const. Type "CG-2" Inlet  
Connect to Extg. 200 mm Conc. Storm Pipe (W)  
Inst. 300 mm Sew. Pipe - 37.0 m  
Tr. Exc. - 33 m<sup>3</sup>
- ⑪ Sta. "S" 9+800.00, 6.88 m Lt.  
Const. Type "CG-2" Inlet
- ⑫ Sta. "S" 10+143.03, 9.35 m Rt  
Const. Type "CG-2" Inlet  
Inst. 300 mm Sew. Pipe - 1.8 m  
Connect to Extg. Inlet (W)  
  
Plate Extg. Inlet with 12.7 mm Thick Steel  
Match Outside Edge of Extg. Structure  
Attach with 9.5 mm Bolts Set 75 mm Into  
Extg. Structure, Plate Shall be Below Subgrade  
and Above Pipe Crowns  
Tr. Exc. - 1 m<sup>3</sup>
- ⑬ Sta. "S" 10+181.36, 7.00 m Rt.  
Const. Type "CG-2" Inlet  
Inst. 300 mm Sew. Pipe - 1.7 m  
Connect to Extg. Inlet (SW)  
  
Plate Extg. Inlet with 12.7 mm Thick Steel  
Match Outside Edge of Extg. Structure  
Attach with 9.5 mm Bolts Set 75 mm Into  
Extg. Structure, Plate Shall be Below Subgrade  
and Above Pipe Crowns  
Tr. Exc. - 1 m<sup>3</sup>
- ⑭ Sta. "S" 10+216.46, 7.60 m Rt.  
Const. Type "CG-2" Inlet  
Inst. 200 mm Sew. Pipe - 1.0 m  
Connect to Extg. Pipe (E & W)  
Tr. Exc. - 1 m<sup>3</sup>
- ⑮ Sta. "S" 9+889.84, 9.11 m Lt.  
Const. 1200 mm Manhole  
Inst. 300 mm Sew. Pipe - 5.0 m  
Tr. Exc. - 5 m<sup>3</sup>
- ⑯ Sta. "S" 10+162.77, 17.06 Rt  
Const. Type "G-2" Inlet  
Inlet Location and Connection to be  
Placed As Directed by Field Engineer  
Inst. 300 mm Sew. Pipe - 4.9 m  
Tr. Exc. - 3 m<sup>3</sup>
- ⑰ Sta. "S" 9+892.06, 15.53 m Lt.  
Const. 1800 mm Manhole with "G2" Inlet  
Inst. 900 mm Sew. Pipe - 20.4 m  
Inst. 900 mm Class 52 Ductile  
Under Pymt. - 20.4 m  
Tr. Exc. - 59 m<sup>3</sup>
- ⑱ Sta. "S" 9+821.79, 21.72 m Rt.  
Inst. 100 mm PVC Waterline Sleeve - 6.2 m
- ⑲ Sta. "S" 9+852.93, 9.62 m Rt.  
Inst. 100 mm PVC Waterline Sleeve - 18.3 m

**AS CONSTRUCTED**  
  
**PROJECT MANAGER**


	<b>OREGON DEPARTMENT OF TRANSPORTATION</b> ROADWAY ENGINEERING SECTION
	<b>BRUTSCHER ST. - EVEREST ST. &amp; EVEREST ST. - MAIN ST. (NEWBERG) SECS.</b> PACIFIC HIGHWAY WEST YAMHILL COUNTY
	Reviewed By - Kevin M. Thelin Designed By - Kristen A. Pleyte Drafted By - Keith S. Warren
<b>DRAINAGE &amp; UTILITIES</b>	SHEET NO. <b>4J</b>

26-NOV-2002 09:11  
C:\user\PROJECTS\From MSAN\070221.rvt

# S L I N E P R O F I L E

34V-25

## STORM SEWER RIGHT OF CENTERLINE

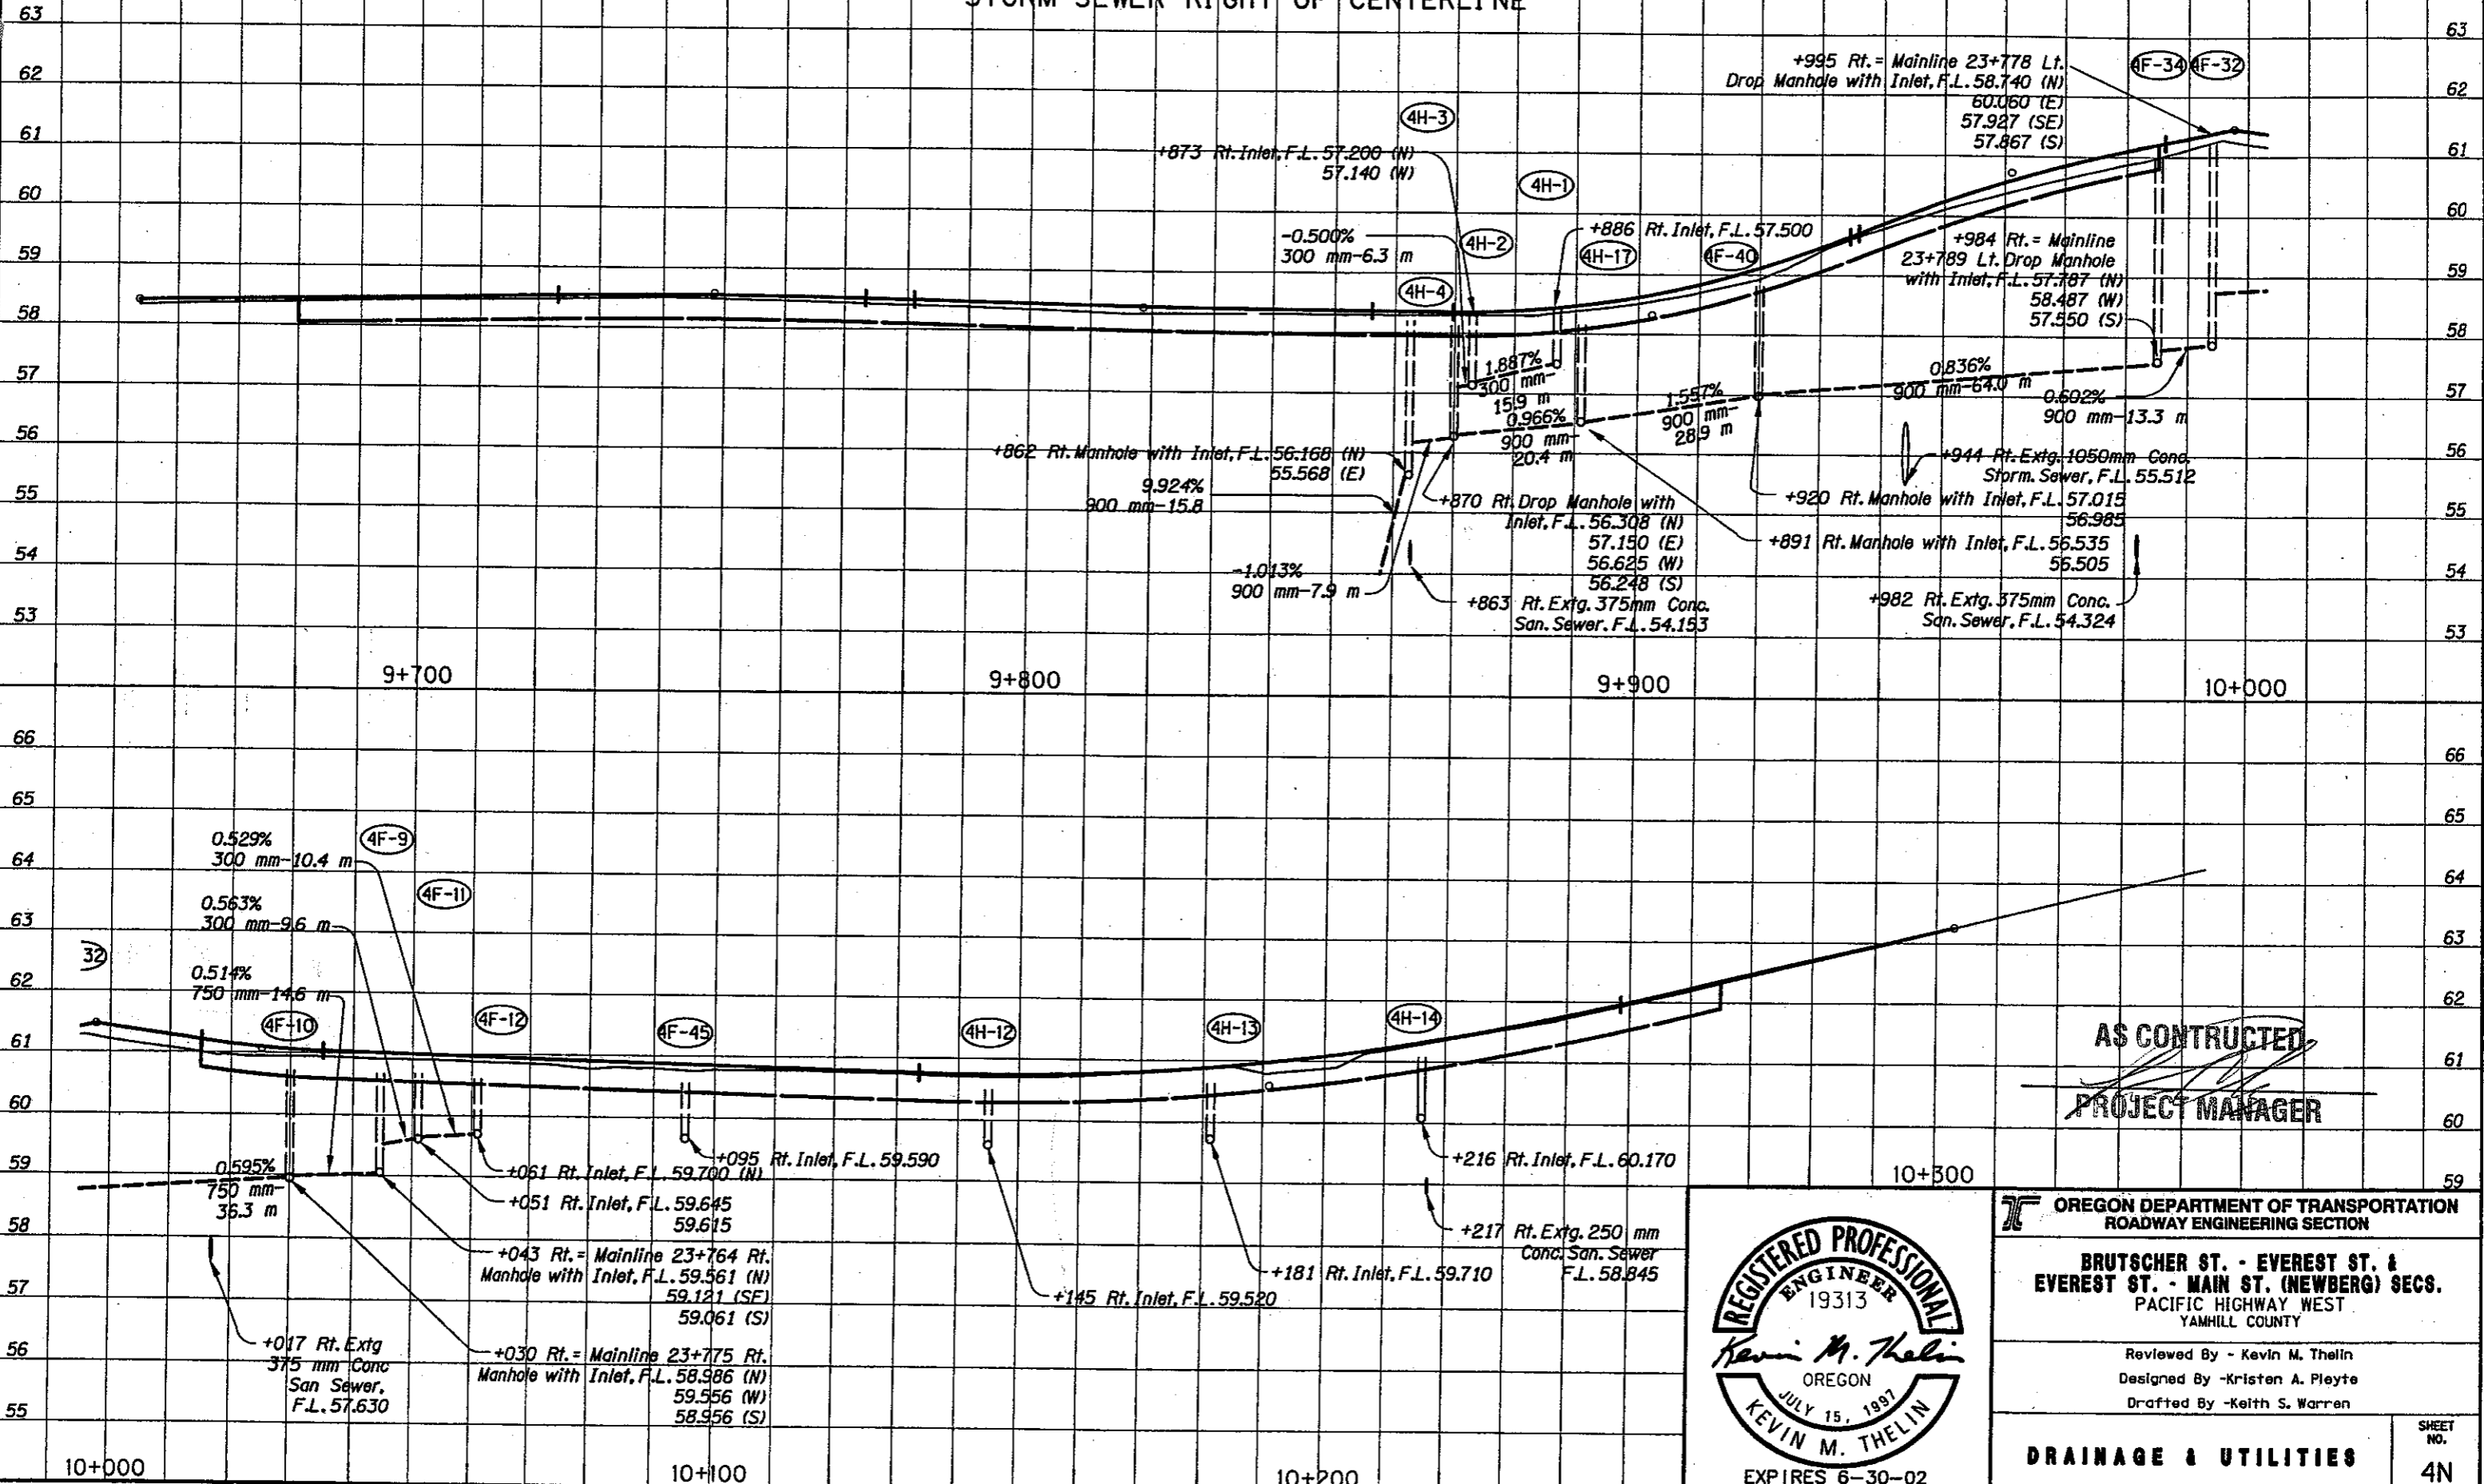

**OREGON DEPARTMENT OF TRANSPORTATION**  
ROADWAY ENGINEERING SECTION

**BRUTSCHER ST. - EVEREST ST. & EVEREST ST. - MAIN ST. (NEWBERG) SECS.**  
PACIFIC HIGHWAY WEST  
YAMHILL COUNTY

Reviewed By - Kevin M. Thelin  
Designed By - Kristen A. Pleyte  
Drafted By - Keith S. Warren


**DRAINAGE & UTILITIES**

SHEET NO.  
**4N**

9-297120366212 2224sm107022f.pdf DO-MM-YY HH:MM

# S L I N E P R O F I L E


## STORM SEWER LEFT OF CENTERLINE

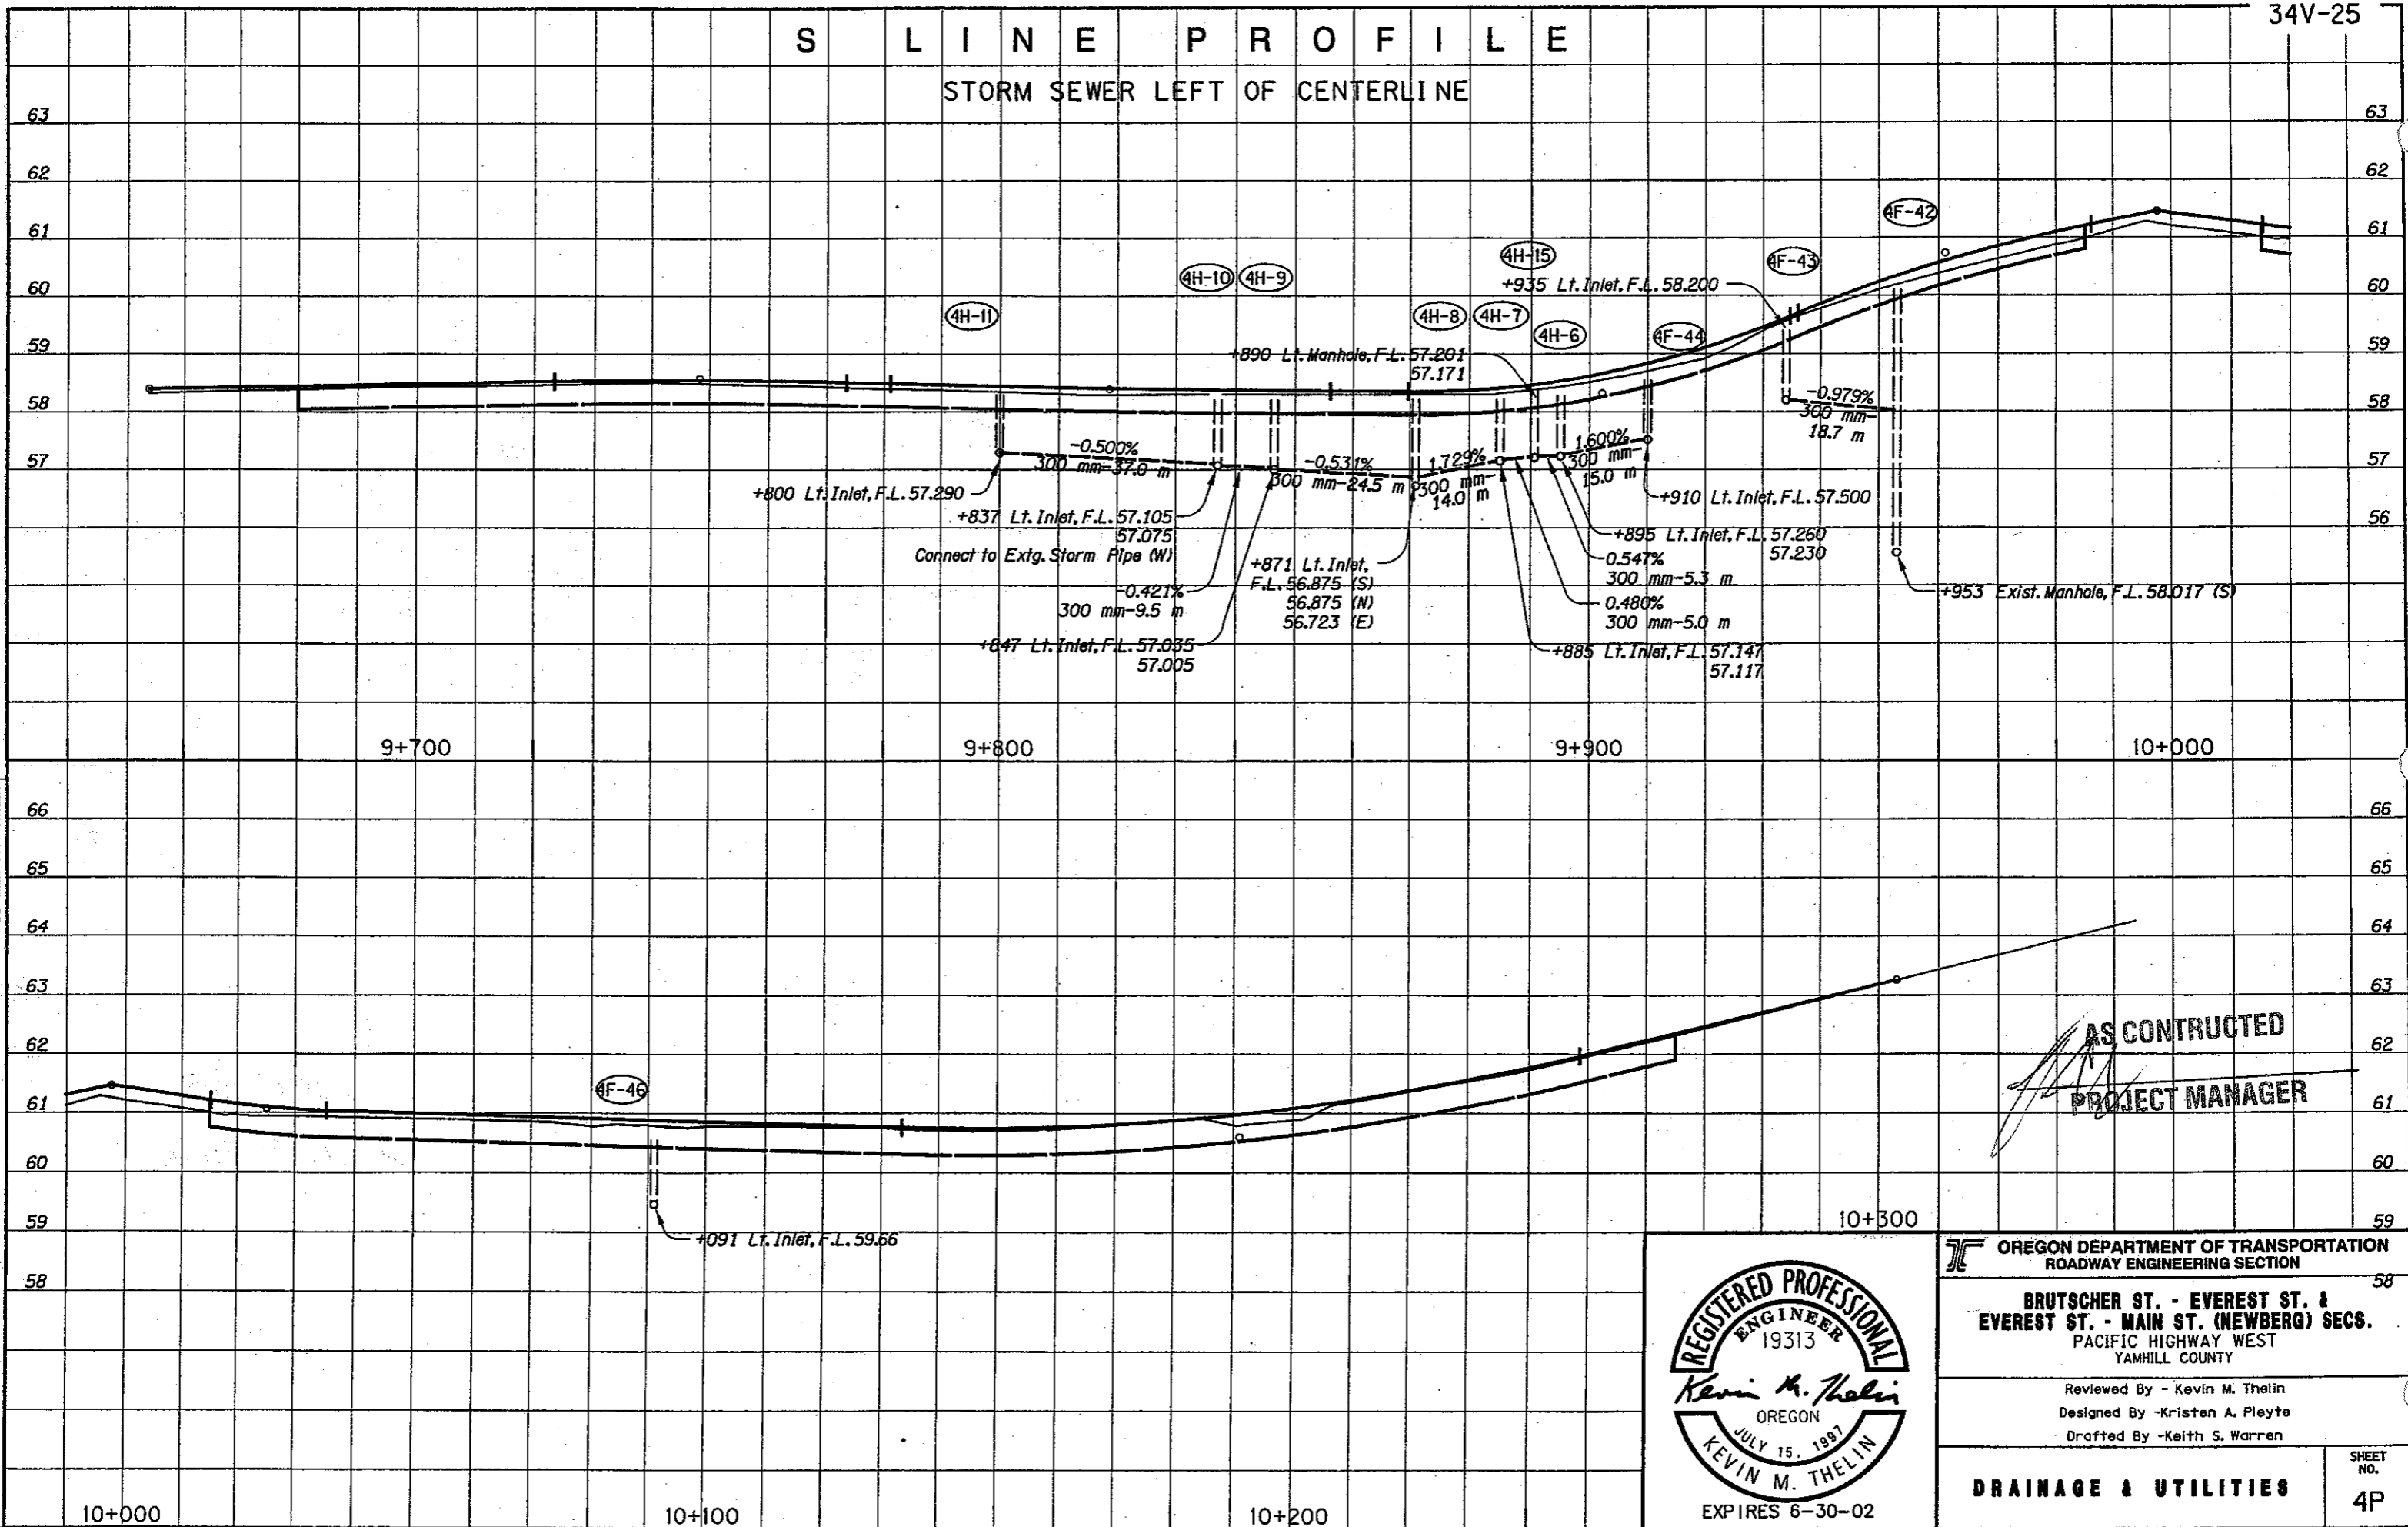

DD-MMM-YYYY HH:MM  
g:\9720366\226\07022022\070221.pd2  
VIEW 3



<b>OREGON DEPARTMENT OF TRANSPORTATION</b> ROADWAY ENGINEERING SECTION	
<b>BRUTSCHER ST. - EVEREST ST. &amp; EVEREST ST. - MAIN ST. (NEWBERG) SECS.</b> PACIFIC HIGHWAY WEST YAMHILL COUNTY	
Reviewed By - Kevin M. Thelin Designed By - Kristen A. Pleyte Drafted By - Keith S. Warren	
<b>DRAINAGE &amp; UTILITIES</b>	SHEET NO. <b>4P</b>

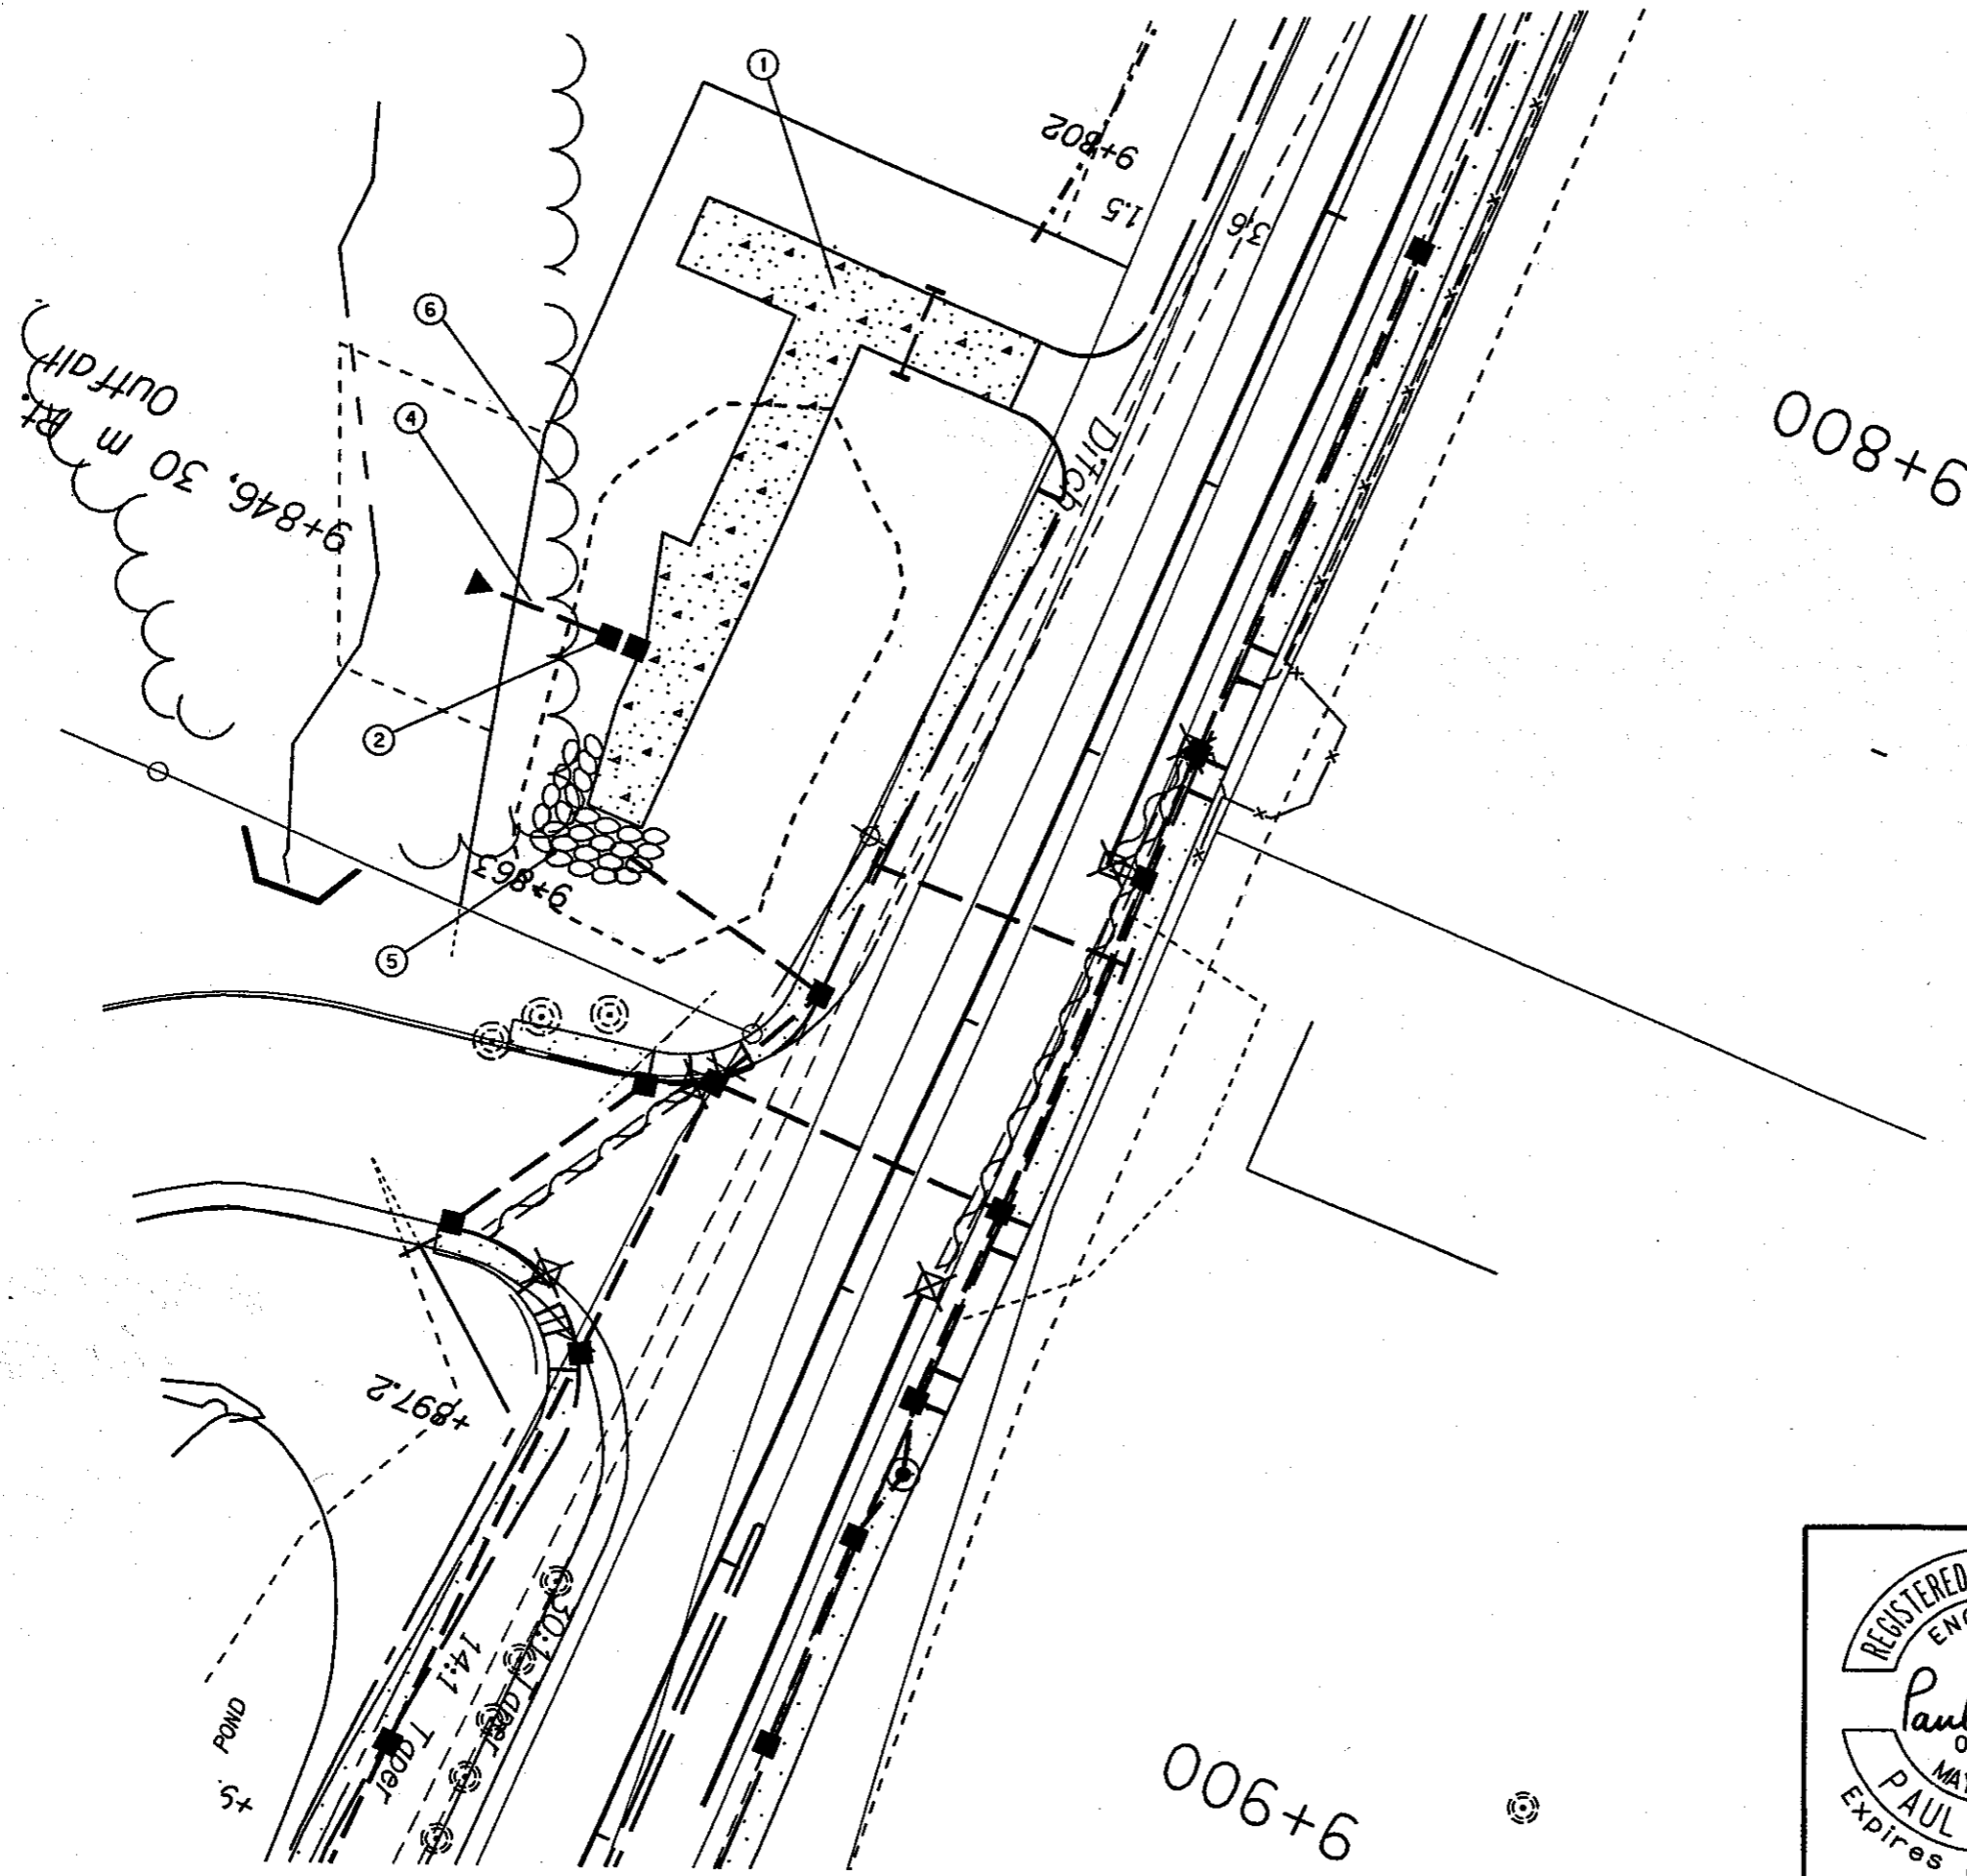

- ① Const. P.C. Conc. Approach  
P.C. Conc. - 336 m<sup>2</sup>  
Agg. Base - 84 m<sup>3</sup>
- ② Sta. "S"9+846 (30 m, Rt.)  
Const. Water Quality Outlet Device  
(For Details, See Sht. WC-5)
- ③ Note Deleted From Plans
- ④ Sta. "S"9+846  
Const. Armored Overflow Channel  
Armored Channel Protection - 27.1 m<sup>2</sup>  
Const. Loose Riprap (Class 50) - 44 m<sup>3</sup>  
(For Details, See Sht. WC-4)
- ⑤ Inst. Loose Riprap (Class 50) - 18 m<sup>3</sup>
- ⑥ Retain & Protect Existing Treeline & Vegetation

9+800

006+6

**AS CONTRACTED**  
  
**PROJECT MANAGER**

All Dimensions Are In Meters (m)  
 Unless Otherwise Noted.



**OREGON DEPARTMENT OF TRANSPORTATION**  
 ROADWAY ENGINEERING SECTION

**BRUTSCHER ST. - EVEREST ST. &  
 EVEREST ST. - MAIN ST. (NEWBERG) SECS.**  
 PACIFIC HIGHWAY WEST  
 YAMHILL COUNTY


Designed By - Danl Nelson  
 Drafted By - Robert J. Erpelding

**WATER QUALITY PLAN**

SHEET NO.  
**WC-1**

11-DEC-2000 1412  
 C:\user\Projects\2202\DETAILS\070221.WC2



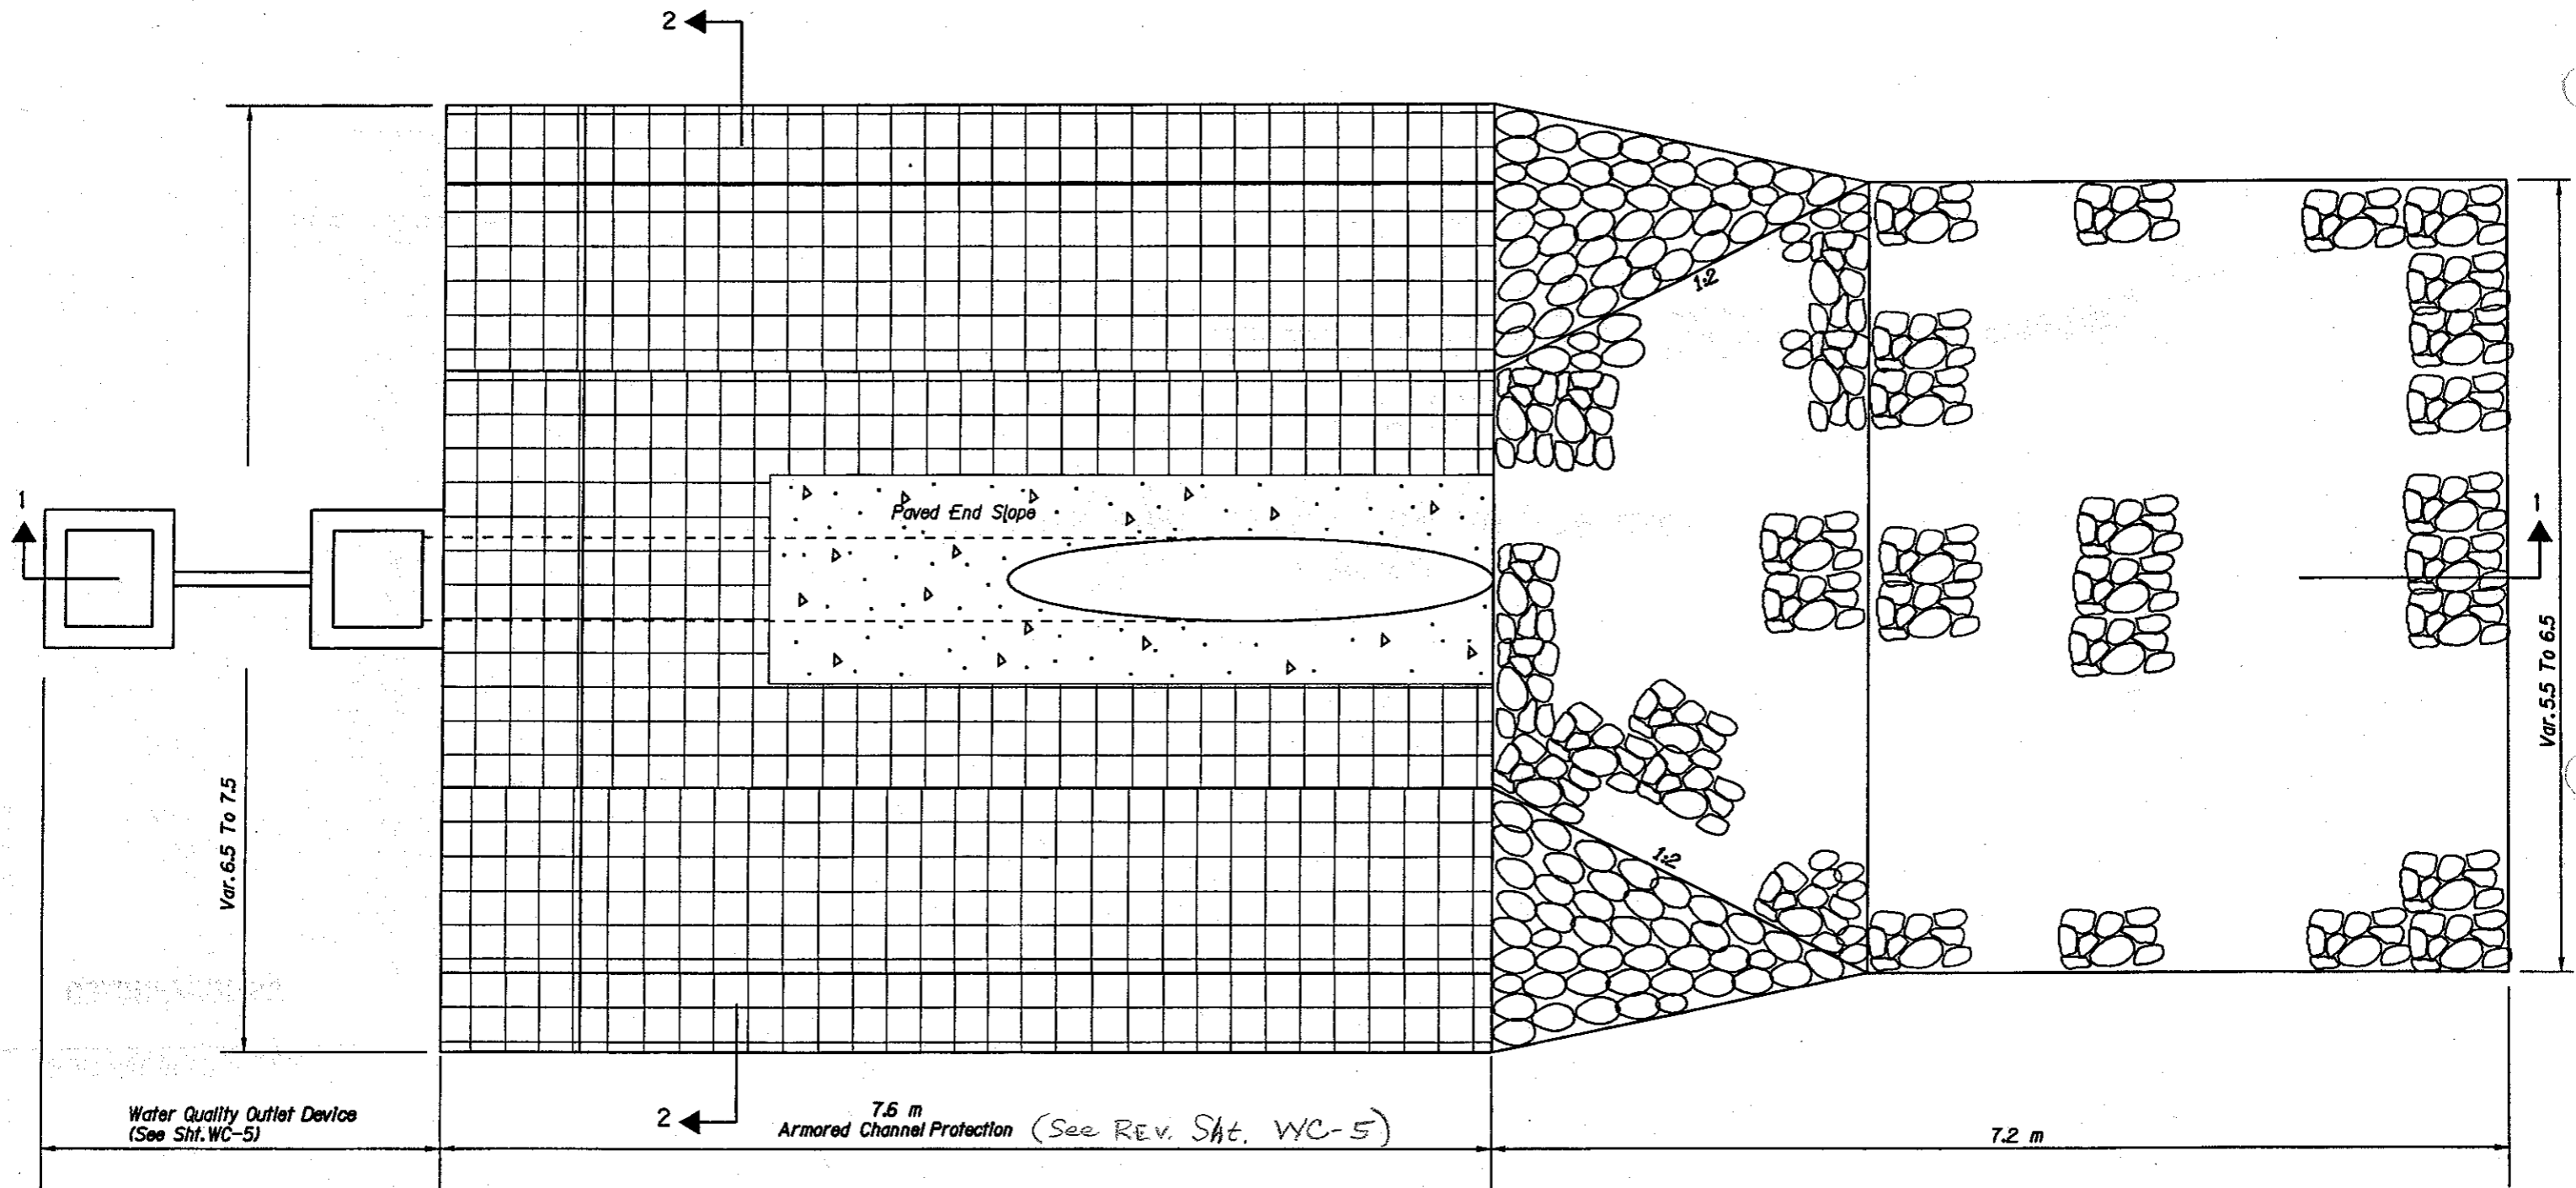

11-DEC-2000 14:14

C:\usr\proj\set\07022\DET\ALS\07022\WC2

Water Quality Outlet Device  
(See Sht. WC-5)

Var. 6.5 To 7.5

2 ←

7.5 m  
Armored Channel Protection (See REV. Sht. WC-5)


7.2 m

Var. 5.5 To 6.5

All Dimensions Are In Meters (m)  
Unless Otherwise Noted.

For Sections 1-1 And 2-2 See Sht. WC-5

AS CONTRACTED  
*[Signature]*  
PROJECT MANAGER

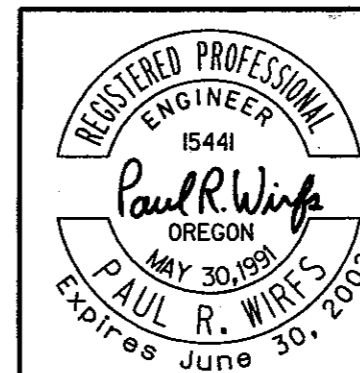

OREGON DEPARTMENT OF TRANSPORTATION  
ROADWAY ENGINEERING SECTION


BRUTSCHER ST. - EVEREST ST. &  
EVEREST ST. - MAIN ST. (NEWBERG) SECS.  
PACIFIC HIGHWAY WEST  
YAMHILL COUNTY

Designed By - Danl Nelson  
Drafted By - Robert J. Erpelding

WATER QUALITY DETAILS

SHEET NO.  
WC-4

# WATER QUALITY POND OUTLET DEVICE

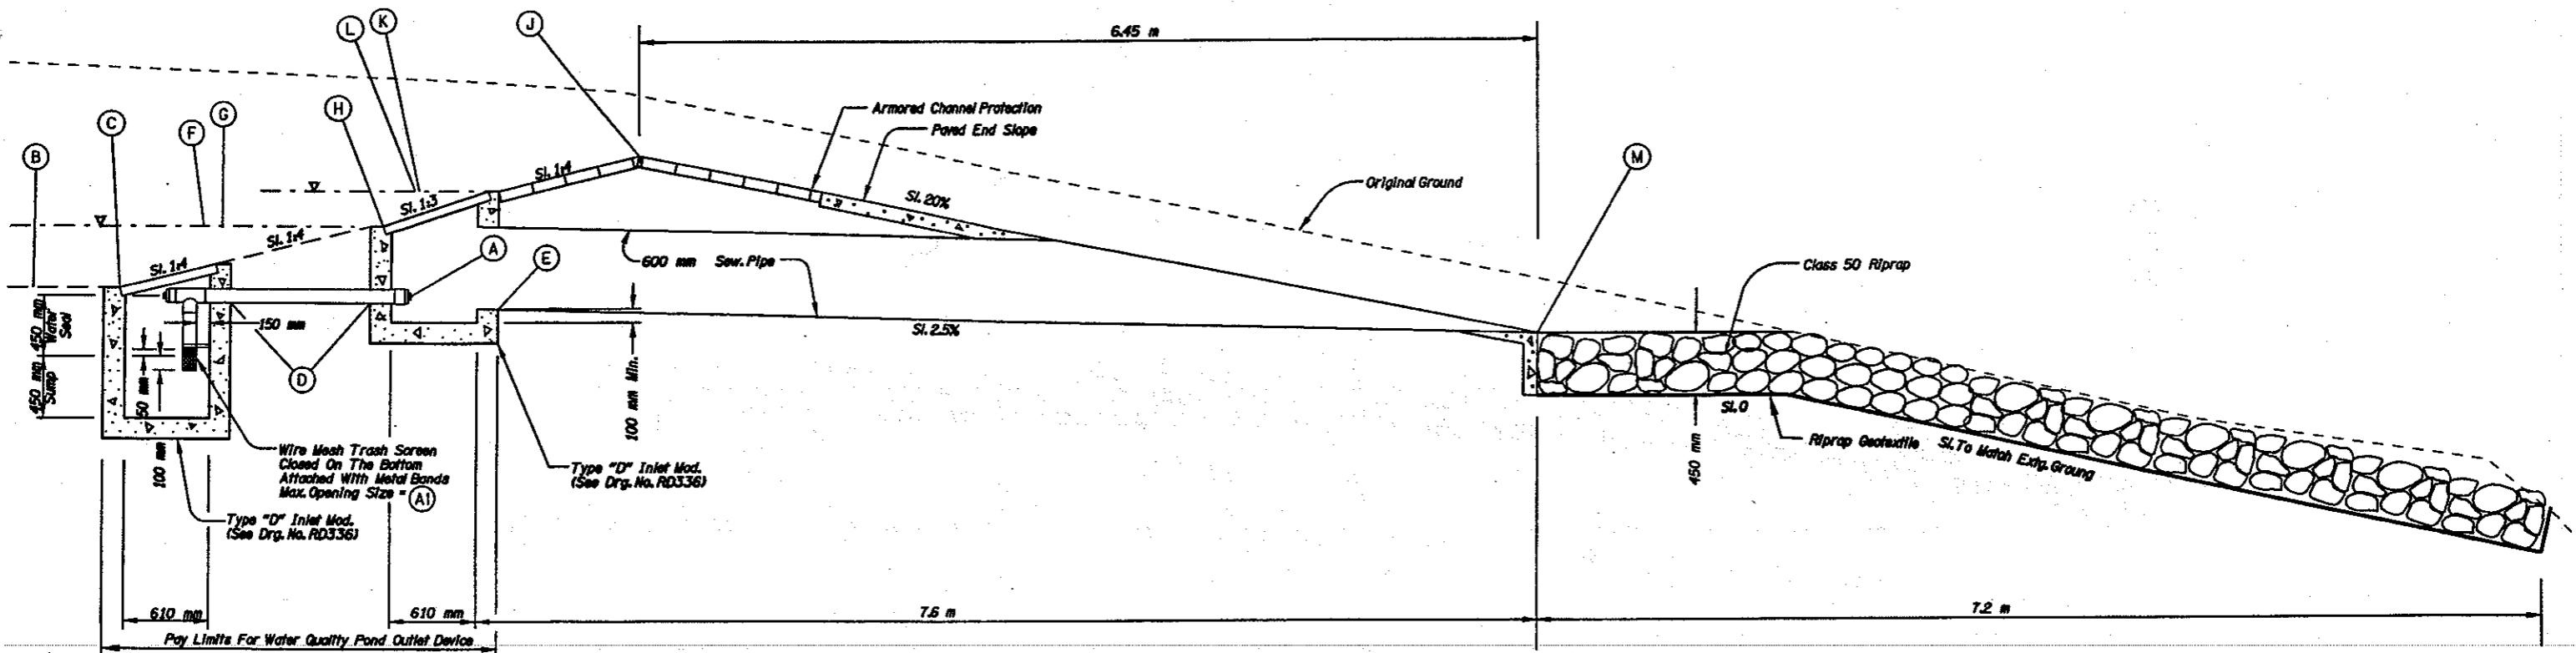


Dimension	Description
A1	17 mm Orifice Diameter
A2	54.43 Elev. Of Center Of Orifice
B	54.50 Elev. Of Pond Bottom
C	54.50 Elev. Of Lip Of Inlet
D	54.39 F.L. Elev. Of P.V.C. Pipe
E	54.35 F.L. Elev. Of Outlet Pipe
F	77.13 m <sup>3</sup> Pond Design W.Q. Volume @ G
G	54.95 Pond Design W.Q. W.S. Elev.
H	54.95 Elev. Of Lip Of Inlet
J	55.45 Auxillary Outlet F.L. Elev.
K	55.20 Pond Design Det. W.S. Elev.
L	144.83 m <sup>3</sup> Pond Design Vol. @ K
M	54.16 F.L. Elev Of Outfall Pipe @ Outlet

SECTION 1-1  
STA. "S"9+846.5, Rt.

CELLULAR CONFINEMENT STRUCTURE WITH VEGETATED TOPSOIL INFILL WASHED OUT FIRST SEASON. ALL OF ARMORED CHANNEL PROTECTION WAS REPLACED WITH CONCRETE.

AS CONSTRUCTED

PROJECT MANAGER

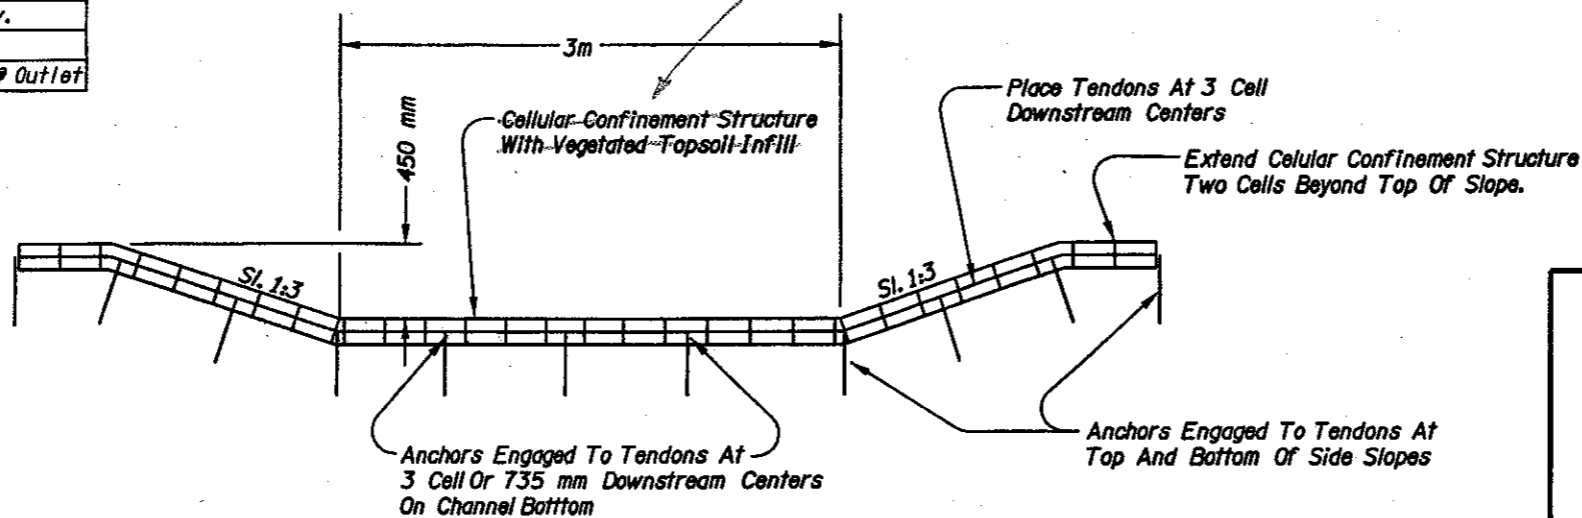

SECTION 2-2  
ARMORED CHANNEL PROTECTION

All Dimensions Are In Meters (m)  
Unless Otherwise Noted.



OREGON DEPARTMENT OF TRANSPORTATION  
ROADWAY ENGINEERING SECTION

BRUTSCHER ST. - EVEREST ST. &  
EVEREST ST. - MAIN ST. (NEWBERG) SECS.  
PACIFIC HIGHWAY WEST  
YAMHILL COUNTY

Designed By - Danl Nelson  
Drafted By - Robert J. Erpelding

WATER QUALITY DETAILS

SHEET NO.  
WC-5

11-DEC-2000 14:11 C:\user\Projects\2\DET\ALS\02022\WC2