

OPERATION & MAINTENANCE MANUAL

Water Quality Biofiltration Swale

Manual prepared: October 2018

DFI No. D00529



Figure 1: DFI No. D00529, looking Northwest

Identification

Drainage Facility ID (DFI): D00529
Facility Type: Water Quality Biofiltration Swale
Construction Drawings: (V-File Numbers) 44V-016
Location: District: 01
Highway No.: 092
Mile Post: 61.55-61.57 (end to beginning))

1. Manual Purpose

The purpose of this manual is to outline inspection needs and summarize maintenance actions.

2. Facility Location

The location map below details the facility location. The highway, mile posts, side streets, access location, and stormwater flow directions are noted on the map.

Facility location type: Roadway shoulder

Flow direction: Northwest




Figure 2: Facility location map

3. Facility Summary

The length and width of a swale is based on the bottom dimensions.

The bottom length and bottom width of the swale is:


Bottom Length (feet)	Bottom Width (feet)
100	2

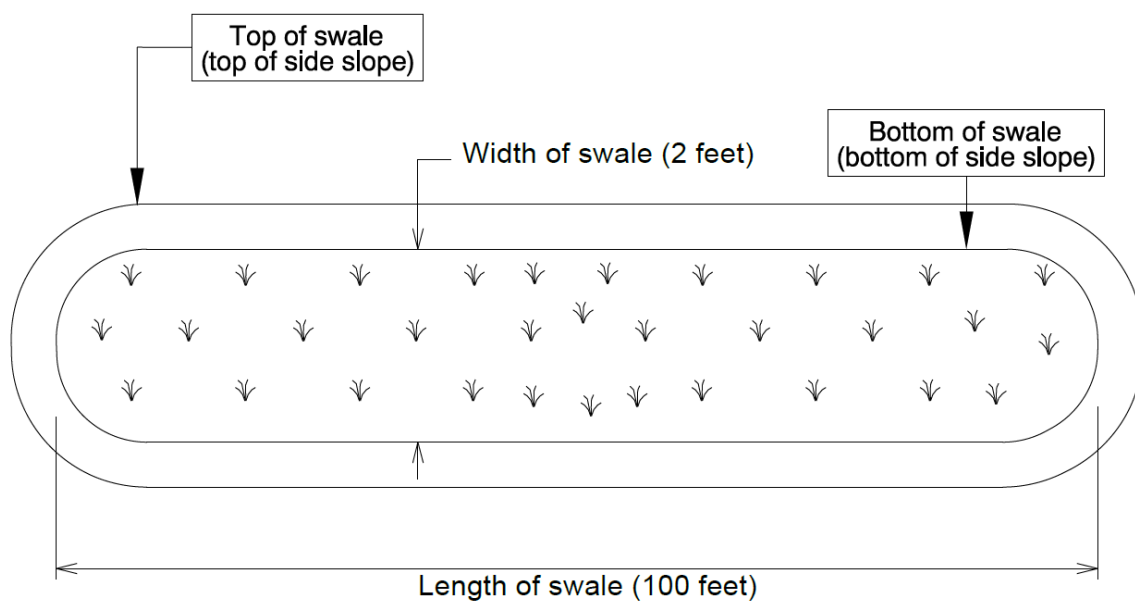

The depth of the swale is the vertical distance measured from the bottom of the swale to the top. The slope of the swale sides is presented by a vertical distance (rise) followed by the horizontal distance (run).

Depth and side slopes:

Depth (feet)	Rise (feet)	Run (feet)
1	1 (Back slope)	4 (Back slope)
	1 (Fore slope)	2 (Fore Slope)

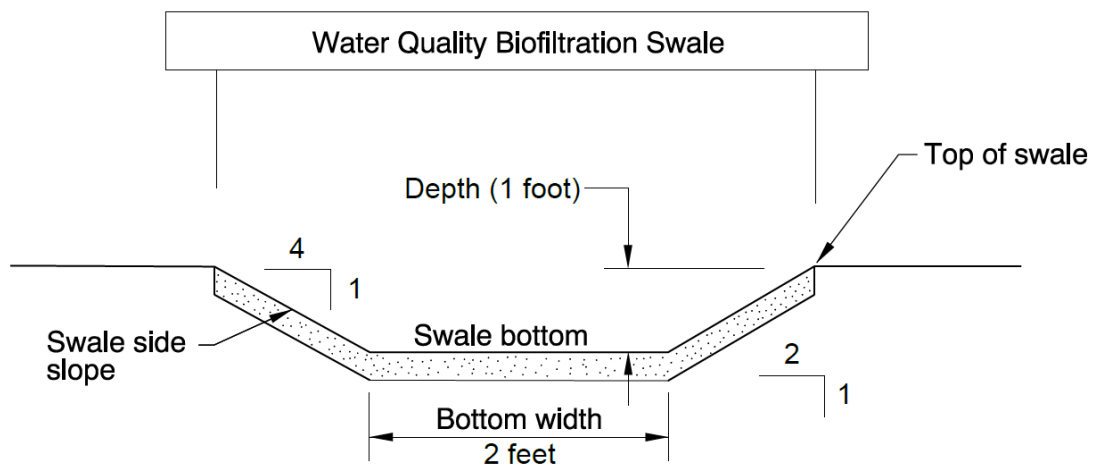

Site Specific Information: Facility is located north of US30 (Hwy 092) between SW Bryant St and SW Tichenor St.

4. Facility Access

Maintenance access to the facility:

<input type="checkbox"/> Roadside pad	<input checked="" type="checkbox"/> Roadside shoulder
<input type="checkbox"/> Access road with Gate	<input type="checkbox"/> Access road without Gate



Figure 3: Four foot shoulder, facing northeast from US30

5. Operational Components / Maintenance Items

Classification

This facility is classified as an:

<input checked="" type="checkbox"/> On-line Swale	<input type="checkbox"/> Off-line Swale
A swale that does not include a high flow bypass component; flow drains into and through the facility	A swale that treats low/small flows and diverts high flows using a bypass component

Bypass Component

This facility includes a high flow bypass component:

<input checked="" type="checkbox"/> No	<input type="checkbox"/> Yes
There is no bypass component. High flows drains into and through the facility	There is a bypass component. Only low/small flows drain into the swale. High flows are diverted around the swale using a bypass component

Operational Components

A swale has many components that assist with treatment, conveyance, and reducing flow velocity to minimize erosion. The components in use can vary depending if the facility was designed to operate on-line or off-line. The facility components table (**Table 1**) has been provided to highlight the applicable components for this facility. The component is in use when the box contains an “x” (e.g.).

The Standard Operation Manual for Water Quality Biofiltration Swales (implemented March 2017) outlines facility operation, typical footprint configuration, and component definitions and details. A link to the manual is attached to the feature marker in TransGIS.

<https://gis.odot.state.or.us/TransGIS/>

Operational Plan

The applicable standard operational plan for this facility is:

<input type="checkbox"/> Operational Plan A	<input checked="" type="checkbox"/> Operational Plan B	<input type="checkbox"/> Operational Plan C
An on-line swale with roadside ditches	An on-line swale with piped inlets and outlets	An off-line swale with a piped high flow bypass
A standard operational plan illustrates the general facility footprint configuration and explains the purpose of each facility component. Operational plans (A, B, C) are provided in the Standard Operation Manual.		

See Appendix A for the site specific operational plan.

Maintenance Items

Operational components marked in **Table 1** should be inspected and maintained according to Section 7. Each facility component is defined and detailed in the Standard Operation Manual using the associated ID number indicated in Table 1.

Table 1: Swale Components		ID #
Manholes/Structures		
Pre-treatment manhole	<input type="checkbox"/>	S1
Weir type flow splitter/flow splitter manhole	<input type="checkbox"/>	S2
Orifice type flow splitter/flow splitter manhole	<input type="checkbox"/>	S3
Standard manhole	<input checked="" type="checkbox"/>	S4
Swale Inlet		
Pavement sheet flow	<input type="checkbox"/>	S5
Inlet Pipe (s)	<input checked="" type="checkbox"/>	S6
Open channel inlet	<input type="checkbox"/>	S7
Riprap pad	<input type="checkbox"/>	S8
Ground Cover		
Grass bottom	<input checked="" type="checkbox"/>	S9
Grass side slopes	<input checked="" type="checkbox"/>	S10
Granular drain rock	<input type="checkbox"/>	S11
Plantings	<input type="checkbox"/>	S12
Underground Components		
Geotextile fabric	<input checked="" type="checkbox"/>	S13
Water quality mix	<input checked="" type="checkbox"/>	S14
Perforated pipe	<input type="checkbox"/>	S15
Porous pavers (access grid)	<input type="checkbox"/>	S16
Flow Spreader		
Rock basin (used at inlet)	<input checked="" type="checkbox"/>	S17
Anchored board (midpoint of swale or every 50 feet along swale bottom)	<input type="checkbox"/>	S18
Other: describe type	<input type="checkbox"/>	S19
Swale Outlet		
Catch basin with grate	<input type="checkbox"/>	S20
Outlet Pipe (s)	<input type="checkbox"/>	S21
Open channel outlet	<input type="checkbox"/>	S22
Check dam (riprap)	<input checked="" type="checkbox"/>	S23
Outfall Type		
Waterbody (River/Lake/Ocean)	<input checked="" type="checkbox"/> R <input type="checkbox"/> L <input type="checkbox"/> O	S24
Ditch	<input type="checkbox"/>	S25
Storm drain system	<input type="checkbox"/>	S26
Outfall Components		
Riprap pad	<input checked="" type="checkbox"/>	S27
Riprap bank protection	<input type="checkbox"/>	S28



Photo 1: A view of swale and outlet into Clatskanie River, looking northwest along US30



Photo 2: Swale outlet into Clatskanie River, looking west

6. Maintenance

Maintenance Frequency/Maintain Records

- a. Inspect annually. Preferably prior to the rainy season.
- b. Clean and maintain as necessary. Refer to Activity 125 for conditions when maintenance is needed.
- c. Keep a record of inspections, maintenance, and repairs.

Maintenance Guide/Maintenance Actions

The ODOT Routine Road Maintenance Water Quality and Habitat Guide (the *Blue Book*) outlines the standard maintenance actions for water quality facilities under Activity 125.

There are standard maintenance tables for standard ODOT designs. The maintenance tables describe the maintenance component, the defect or problem, the condition when maintenance is needed, and the recommended maintenance to correct the problem. Use the following tables to maintain ODOT swales:

- Table 1 (General Maintenance): Contains general maintenance and inspection guidelines that are applicable to all ODOT water quality facilities
- Table 3 (Maintenance of Water Quality or Biofiltration Swales): Contains maintenance information for swales

The *Blue Book* can be viewed at the following website:

http://www.oregon.gov/ODOT/Maintenance/Documents/blue_book.pdf

7. Limitations

Access grid installed:

<input checked="" type="checkbox"/> No	<input type="checkbox"/> Yes
--	------------------------------

Swales are designed to allow equipment access along the bottom. If an access grid is **NOT** installed, vehicles entering the swale can create depressions (tire ruts), damage vegetation, and damage structural components (e.g. flow spreaders). These conditions may result in poor treatment and drainage performance.

Equipment wheels should be kept on the tops and side slopes. Mower arms may be run along the swale bottom.

8. Waste Material Handling

Material removed from the facility is defined as waste by the Department of Environmental Quality (DEQ). Refer to the roadwaste section of the ODOT Maintenance Yard Environmental Management System (EMS) Policy and Procedures Manual for disposal options:

http://www.oregon.gov/ODOT/Maintenance/Documents/ems_manual.pdf


Contact any of the following for more detailed information about management of waste materials found on site:

ODOT Clean Water Unit	(503) 986-3008
ODOT Statewide Hazmat Coordinator	(503) 667-7442
ODOT Region 1 Hazmat Coordinator	(503) 731-8290
ODOT Region 2 Hazmat Coordinator	(503) 986-2647
ODOT Region 3 Hazmat Coordinator	(541) 957-3594
ODOT Region 4 Hazmat Coordinator	(541) 388-6186
ODOT Region 5 Hazmat Coordinator	(541) 963-1590
ODEQ Northwest Region Office	(503) 229-5263

A Appendix A – Site Specific Operational Plan

Contents:

Operational Plan: DFI D00529

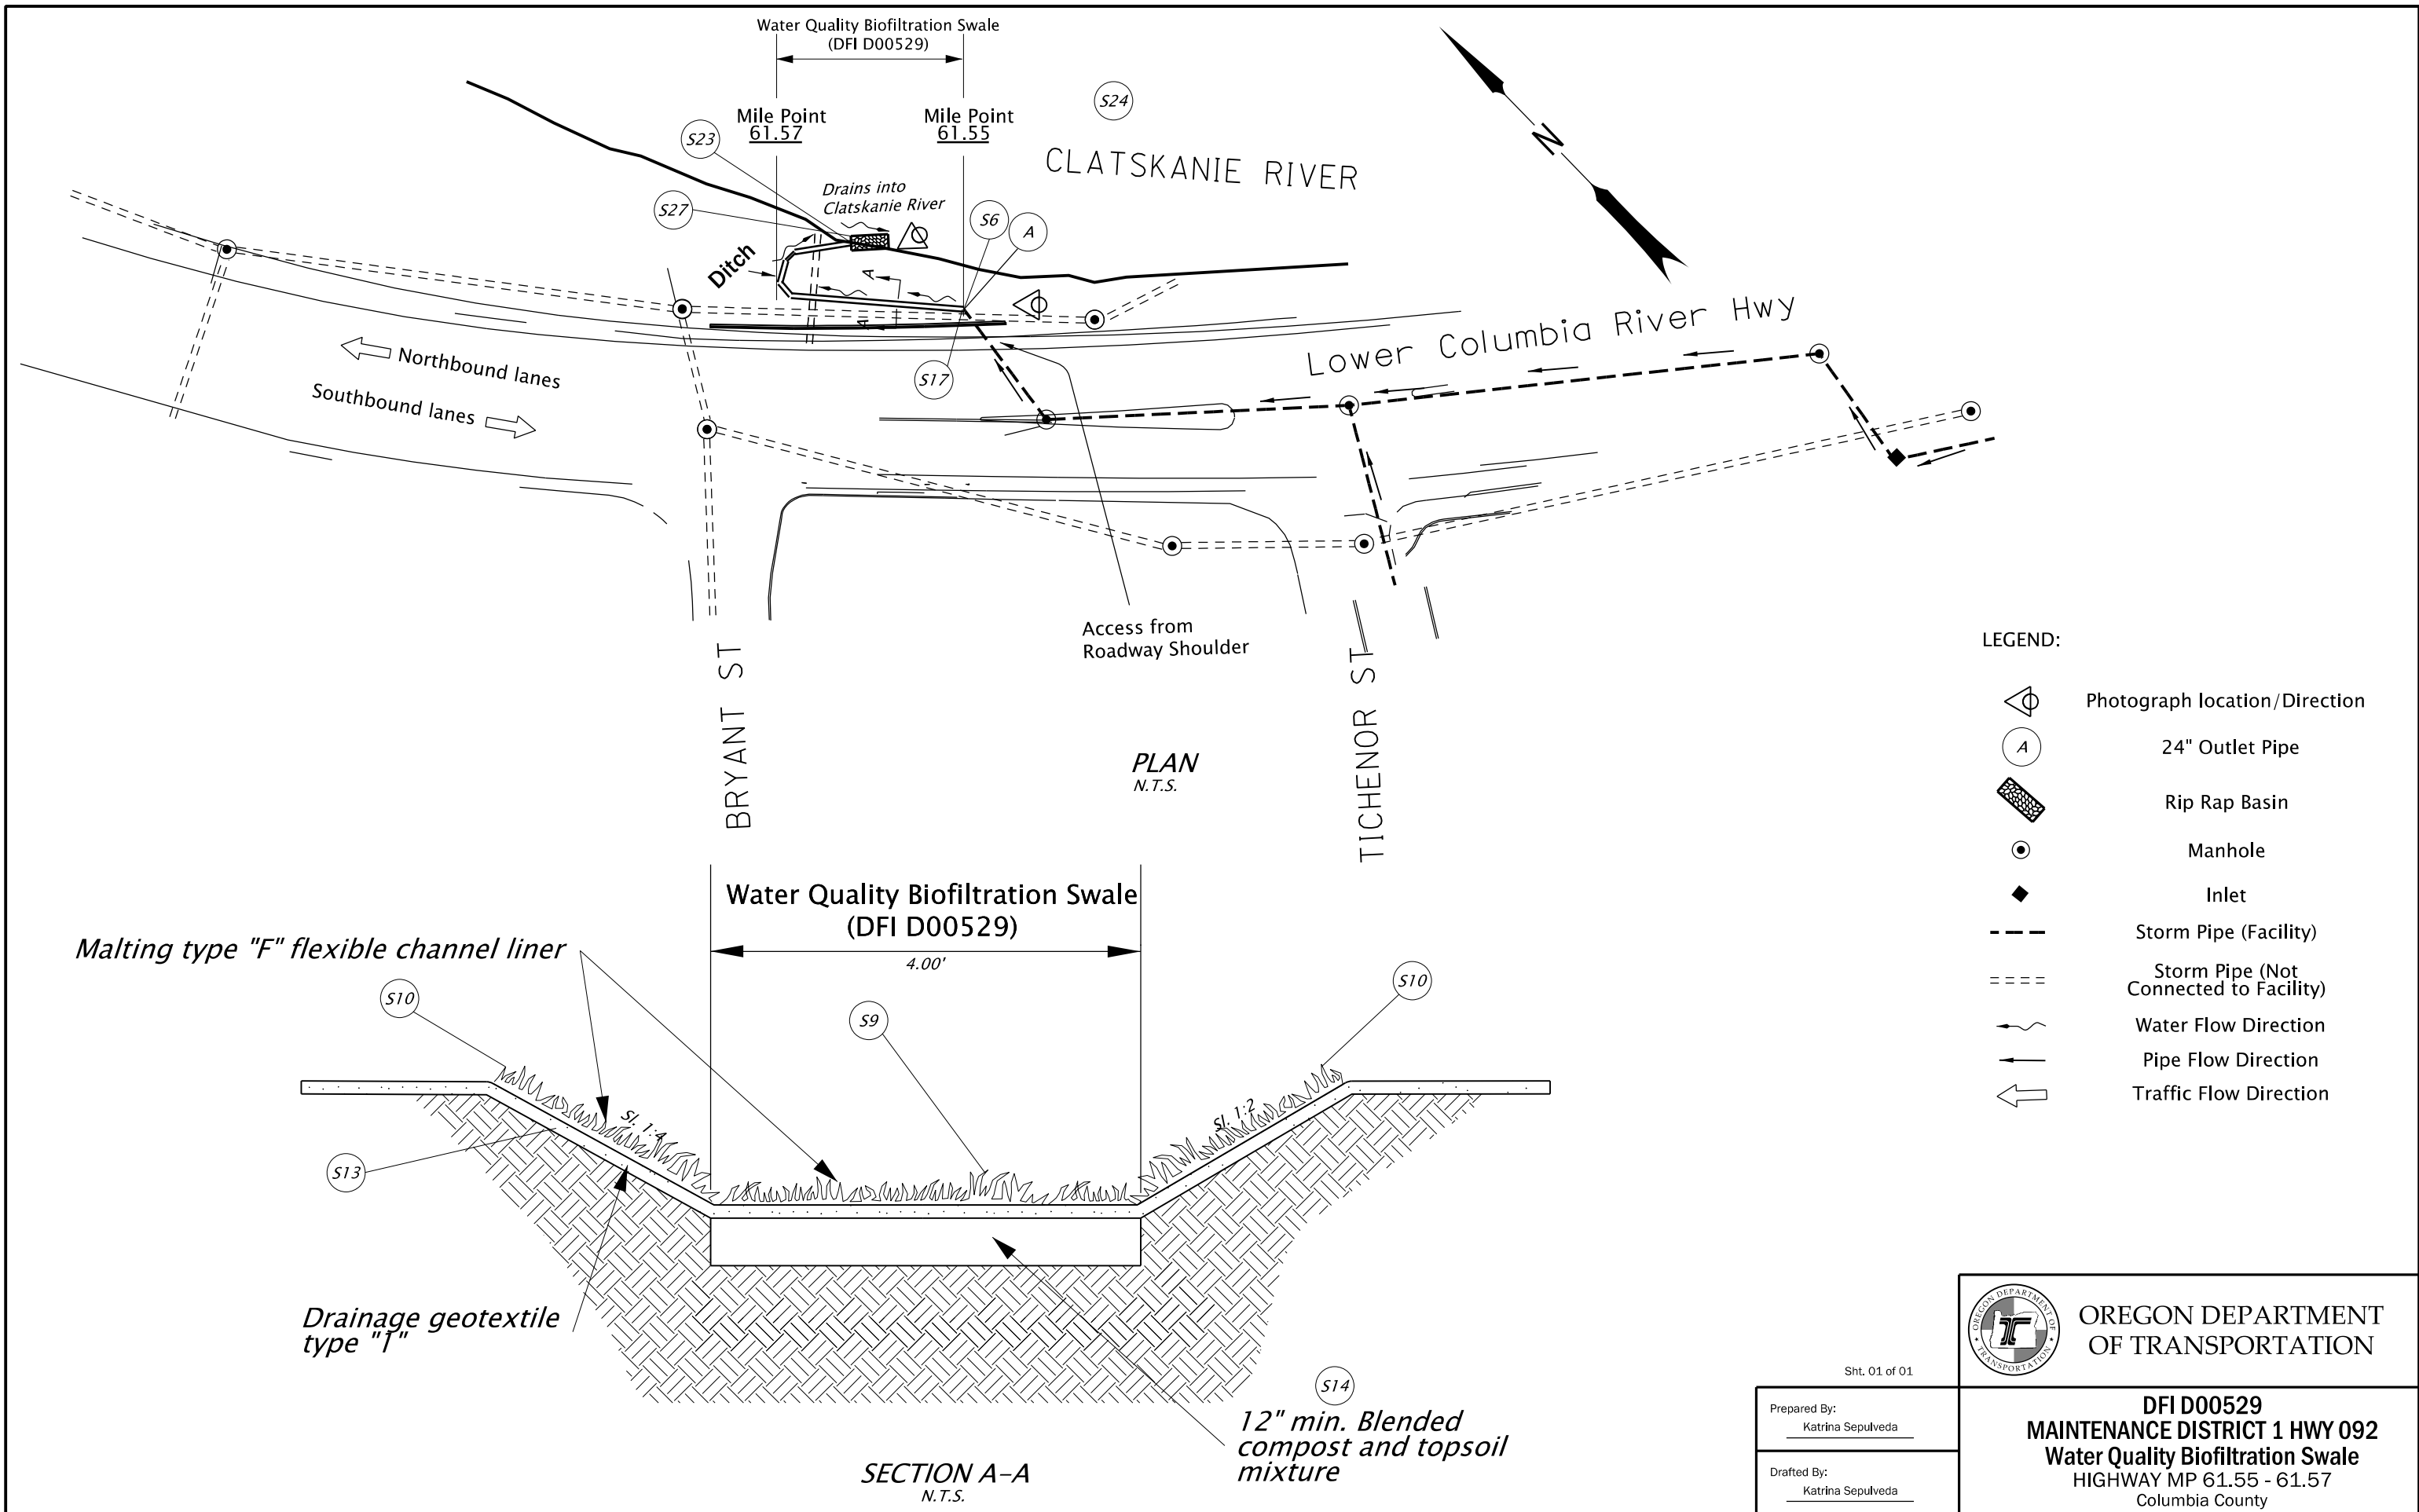

- LEGEND:
- Photograph location/Direction
 - 24" Outlet Pipe
 - Rip Rap Basin
 - Manhole
 - Inlet
 - Storm Pipe (Facility)
 - Storm Pipe (Not Connected to Facility)
 - Water Flow Direction
 - Pipe Flow Direction
 - Traffic Flow Direction



Sht. 01 of 01

Prepared By:
Katrina Sepulveda

Drafted By:
Katrina Sepulveda

DFI D00529
MAINTENANCE DISTRICT 1 HWY 092
Water Quality Biofiltration Swale
 HIGHWAY MP 61.55 - 61.57
 Columbia County


B Appendix B – Project Contract Plans

Contents:

Site Specific Subset of Project Contract Plan 44V-016

STATE OF OREGON
 DEPARTMENT OF TRANSPORTATION
 PLANS FOR PROPOSED PROJECT
 GRADING, DRAINAGE, STRUCTURE, PAVING, SIGNING & SIGNALS
US30: SWEDETOWN ROAD - JCT OR-47 SEC.
 LOWER COLUMBIA RIVER HIGHWAY

INDEX OF SHEETS	
SHEET NO.	DESCRIPTION
1	Title Sheet
1A	Index Of Sheets Cont'd. & Std. Drg. Nos.

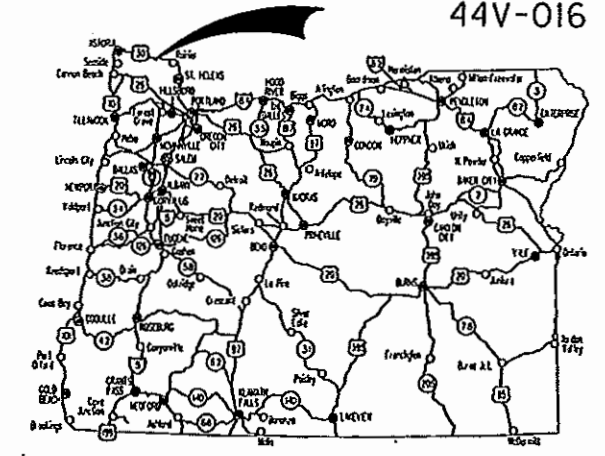

Overall Length Of Project - 0.83 Miles

ATTENTION:
 Oregon Law Requires You To Follow Rules Adopted By The Oregon Utility Notification Center. Those Rules Are Set Forth In OAR 952-001-0010 Through OAR 952-001-0090. You May Obtain Copies Of The Rules By Calling The Center. (Note: The Telephone Number For The Oregon Utility Center Is (503) 232-1987.)



BEGINNING OF CONTRACT

STA. "L" 362+85 (M.P. 69.95)

BEGINNING OF PROJECT

X-STP-HSIP-S092(038)

STA. "L" 1665+93 (M.P. 61.72)

COLUMBIA COUNTY
JANUARY 2011

NOT REVISED AS CONSTRUCTED

6/11/12 CONTRACT 14305

FOR "AS-CONSTRUCTED"




EXPIRES: 12-31-2013

END OF PROJECT
X-STP-HSIP-S092(038)

STA. "L" 1709+90 (M.P. 60.89)

END OF CONTRACT

STA. "L" 1718+00 (M.P. 60.74)

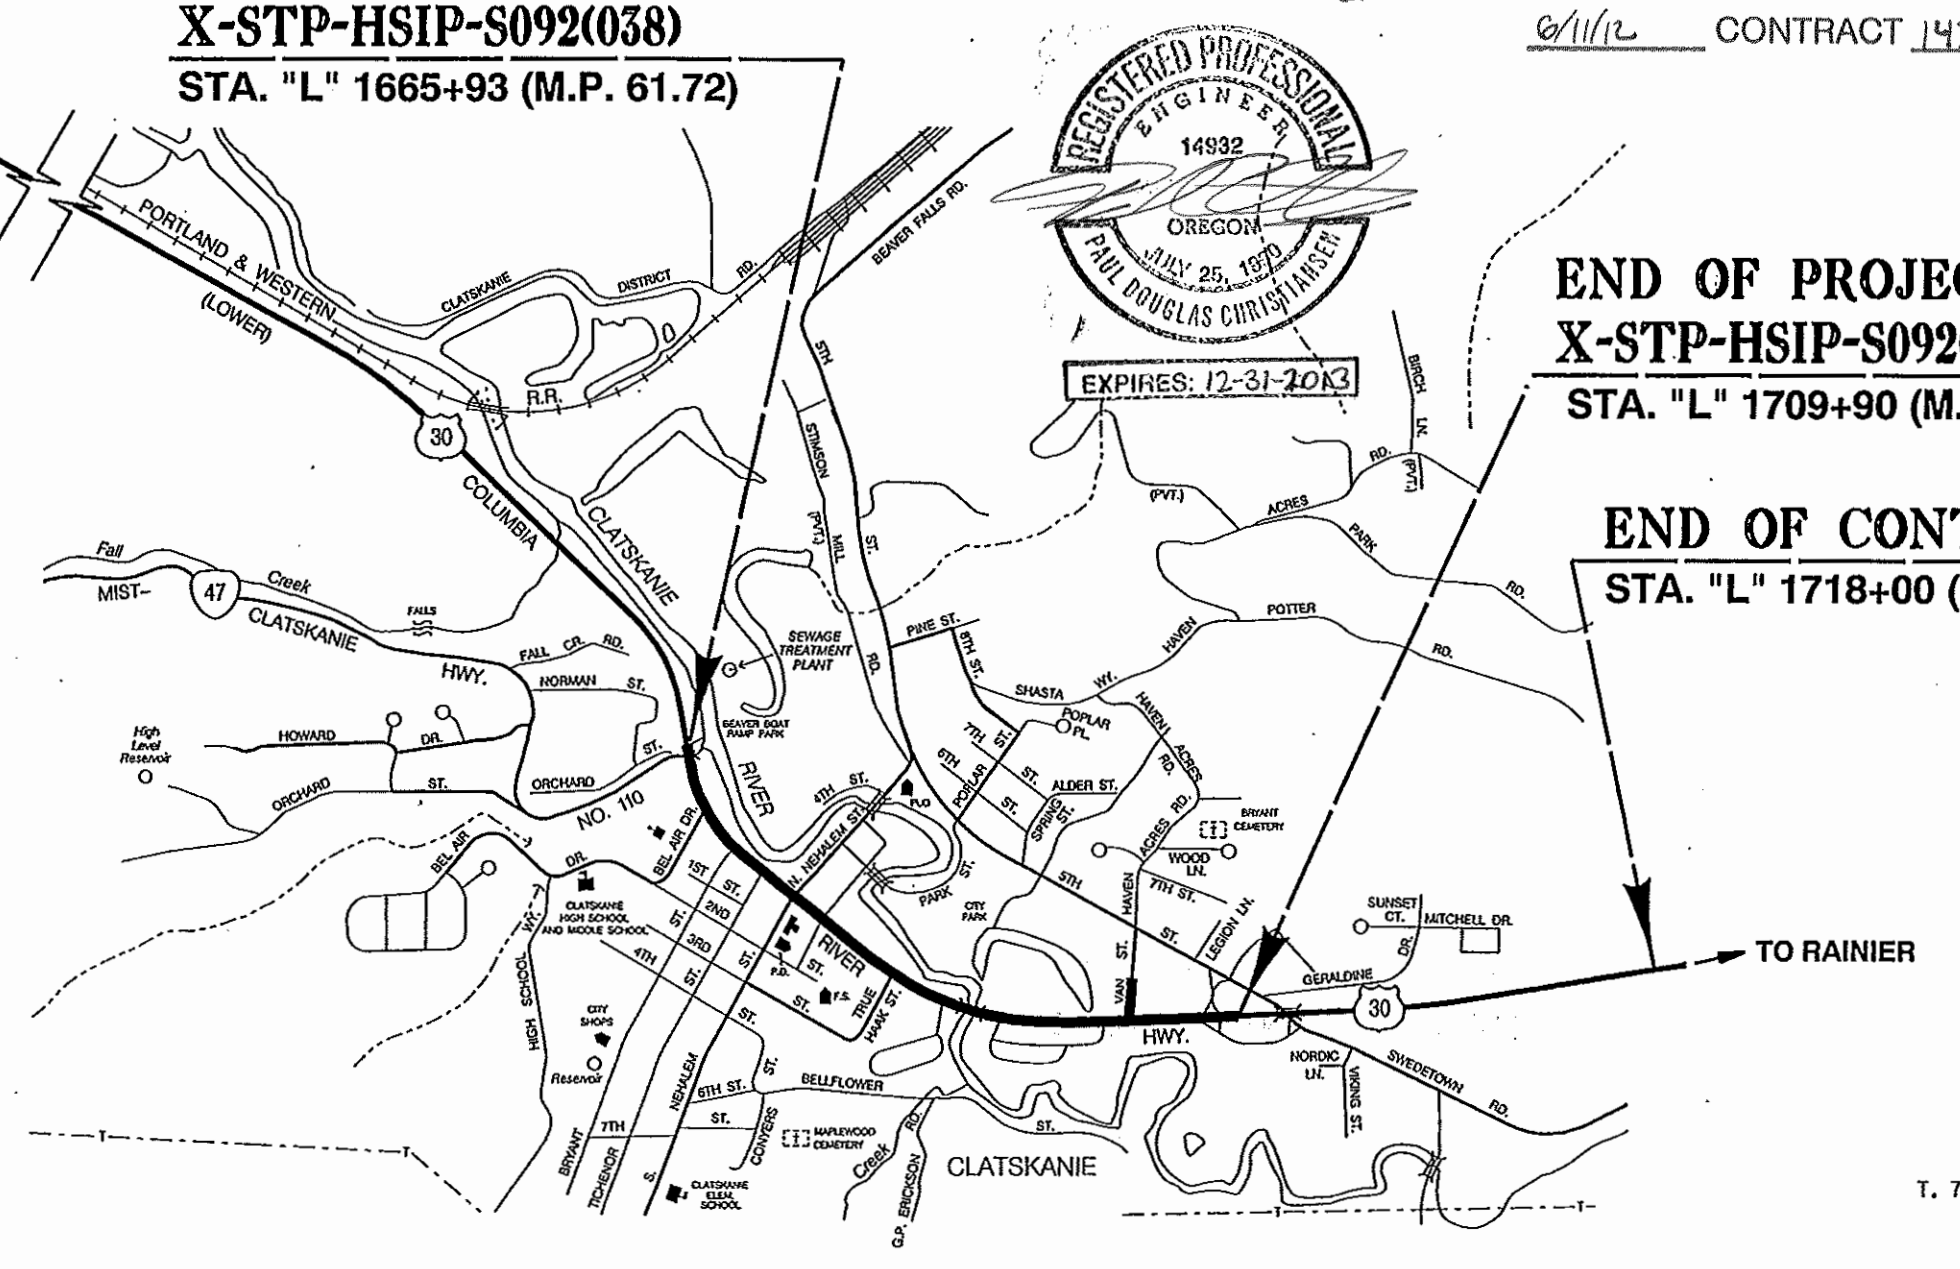

OREGON TRANSPORTATION COMMISSION

Gail Achterman	CHAIR
Michael Nelson	VICE-CHAIR
Mary Olson	COMMISSIONER
Alon Brown	COMMISSIONER
David Lohman	COMMISSIONER
Matthew L. Corrett	DIRECTOR OF TRANSPORTATION

These plans were developed using ODOT design standards. Exceptions to these standards, if any, have been submitted and approved by the ODOT Chief Engineer or their delegated authority.

Approving Authority: *Naveen G. Chandra*
 Naveen G. Chandra, P.E.
 Project Delivery Manager, Region 1

A.M.R.
 Concurrence by ODOT Chief Engineer

US30: SWEDETOWN ROAD - JCT OR-47 SEC.
 LOWER COLUMBIA RIVER HIGHWAY
 COLUMBIA COUNTY


FEDERAL HIGHWAY ADMINISTRATION	PROJECT NUMBER	SHEET NO.
OREGON DIVISION	X-STP-HSIP-S092(038)	1

T. 7 N., R. 4 W., W.M.



PE45911001

Sec. 8, T.7N., R.4W., W.M.

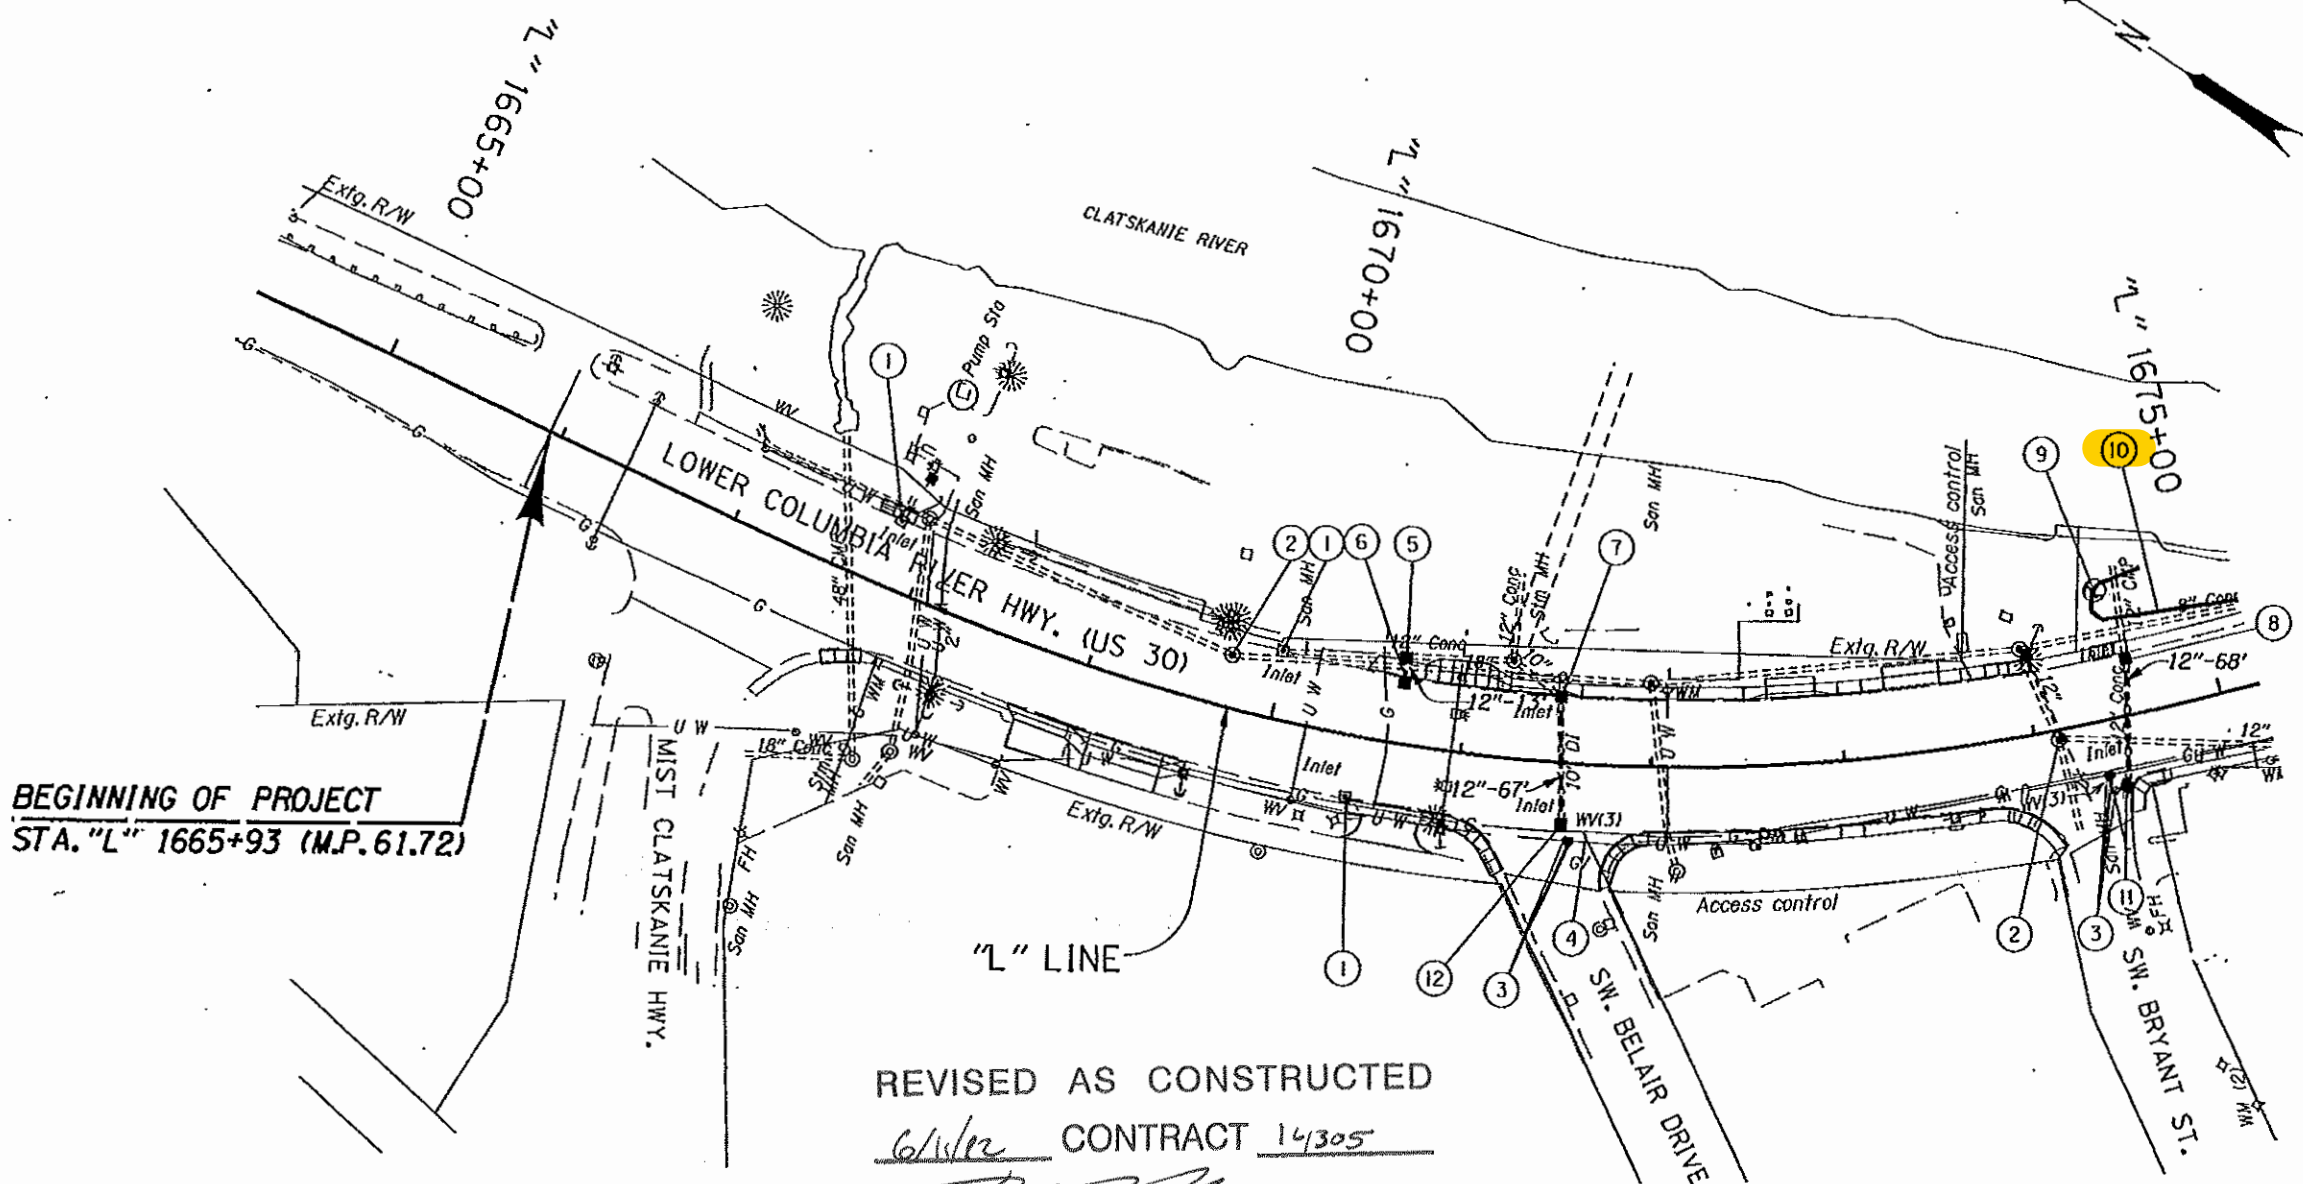

- ① Adjust inlet - 3
- ② Adjust manhole - 2
- ③ Adjust water valve box - 7
- ④ Adjust gas valve (By others)
- ⑤ Sta. "L" 1670+64.5, 45.3' Lt.
Const. type "G-2" inlet
Connect to extg. pipe
Inst. 12" storm sew. pipe - 13'
5' depth
Trench resurf. - 7 sq.yd.
(See drg. nos. RD300, RD302, RD364, RD380, RD384 & RD386)
(For profiles, see sht. GJ-2)
- ⑥ Sta. "L" 1670+65.6, Lt.
Const. type "CG-2" inlet
(See drg. no. RD366)
(For profiles, see sht. GJ-2)
- ⑦ Sta. "L" 1671+50.6, Lt.
Remove inlet
Const. type "CG-2" inlet
Connect to extg. storm sew. pipe
Remove storm sew. pipe - 67'
Inst. 12" storm sew. pipe - 67'
5' depth
Trench resurf. - 53 sq.yd.
(For profiles, see sht. GJ)
- ⑧ Sta. "L" 1674+54.9, 29.4' Lt.
Remove inlet
Const. type "CG-2" inlet
Connect extg. storm sew. pipe
Remove storm sew. pipe - 68'
Inst. 12" storm sew. pipe - 68'
5' depth
Trench resurf. - 53 sq.yd.
(For profiles, see sht. GJ)

BEGINNING OF PROJECT
STA. "L" 1665+93 (M.P. 61.72)

REVISED AS CONSTRUCTED

6/16/12 CONTRACT 14305

[Signature]
Paul Christianson Project Manager DATE 6/11/12


NOTE:
1. Protect and preserve existing sanitary system and water system.

No.	DATE	REVISIONS	BY
①	01-11-11	Revised pipe depth	E.P.F.

- ⑪ Sta. "L" 1674+43.2, 35.7' Rt.
Remove inlet
Const. type "CG-2" inlet
Connect to extg. pipe
(Contractor to verify F.L. and size of extg. incoming storm sew. pipes)
(For profiles, see sht. GJ)
- ⑫ Sta. "L" 1671+55.4, 32.1' Rt.
Remove inlet
Const. type "G-2" inlet
Connect to extg. pipe
(Contractor to verify F.L. and size of extg. incoming storm sew. pipes)
(For profiles, see sht. GJ)

- ⑩ Sta. "L" 1674+72.9, 72.6' Lt.
Const. water quality swale
Riprap basin (Class 50) - 15 cu.yd.
Riprap geotextile type "1" - 50 sq.yd.
Inst. blended compost and topsoil mixture - 15 cu.yd.
Drainage geotextile type "1" - 95 sq.yd.
Permanent seeding, mix no. "1" - 0.03 ac.
Mulling type "F" flexible channel liner - 95 sq.yd.
Ditch, exc. - 31 cu.yd.
Check dam, type "1" - 1
Flow spreader, 2x12 - 16 lf.
(For details, see shts. GJ & GJ-3)

- ⑨ Remove and move roadside ship anchor statue
As directed by engineer
General exc. - 5 cu.yd.
Commercial grade concrete - 4.2 cu.yd.
Reinforcing steel - 140 lb.
Remove and store extg. ship anchor for later installation - 1
Topsoil 4" depth - 20 cu.yd.
Permanent seeding, mix no. "1" - 0.05 ac.
Placement of extg. ship anchor at new location - 1
(For slob details, see sht. GJ-3)

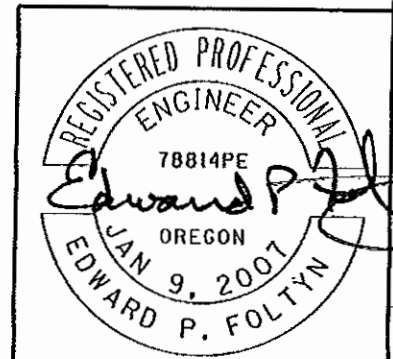

RENEWS: 12-31-2011

OREGON DEPARTMENT OF TRANSPORTATION

REGION 1 - Geo/Hydro/HazMat Unit



US30: SWEDETOWN ROAD - JCT OR-47 SEC.
LOWER COLUMBIA RIVER HIGHWAY
COLUMBIA COUNTY

Reviewed by - Bruce Council
Designed by - Ed Foltyn
Drafted by - Charlotte Gerken

DRAINAGE & UTILITIES

SHEET NO. 3A

Sec. 8, T.7N., R.4W., W.M.

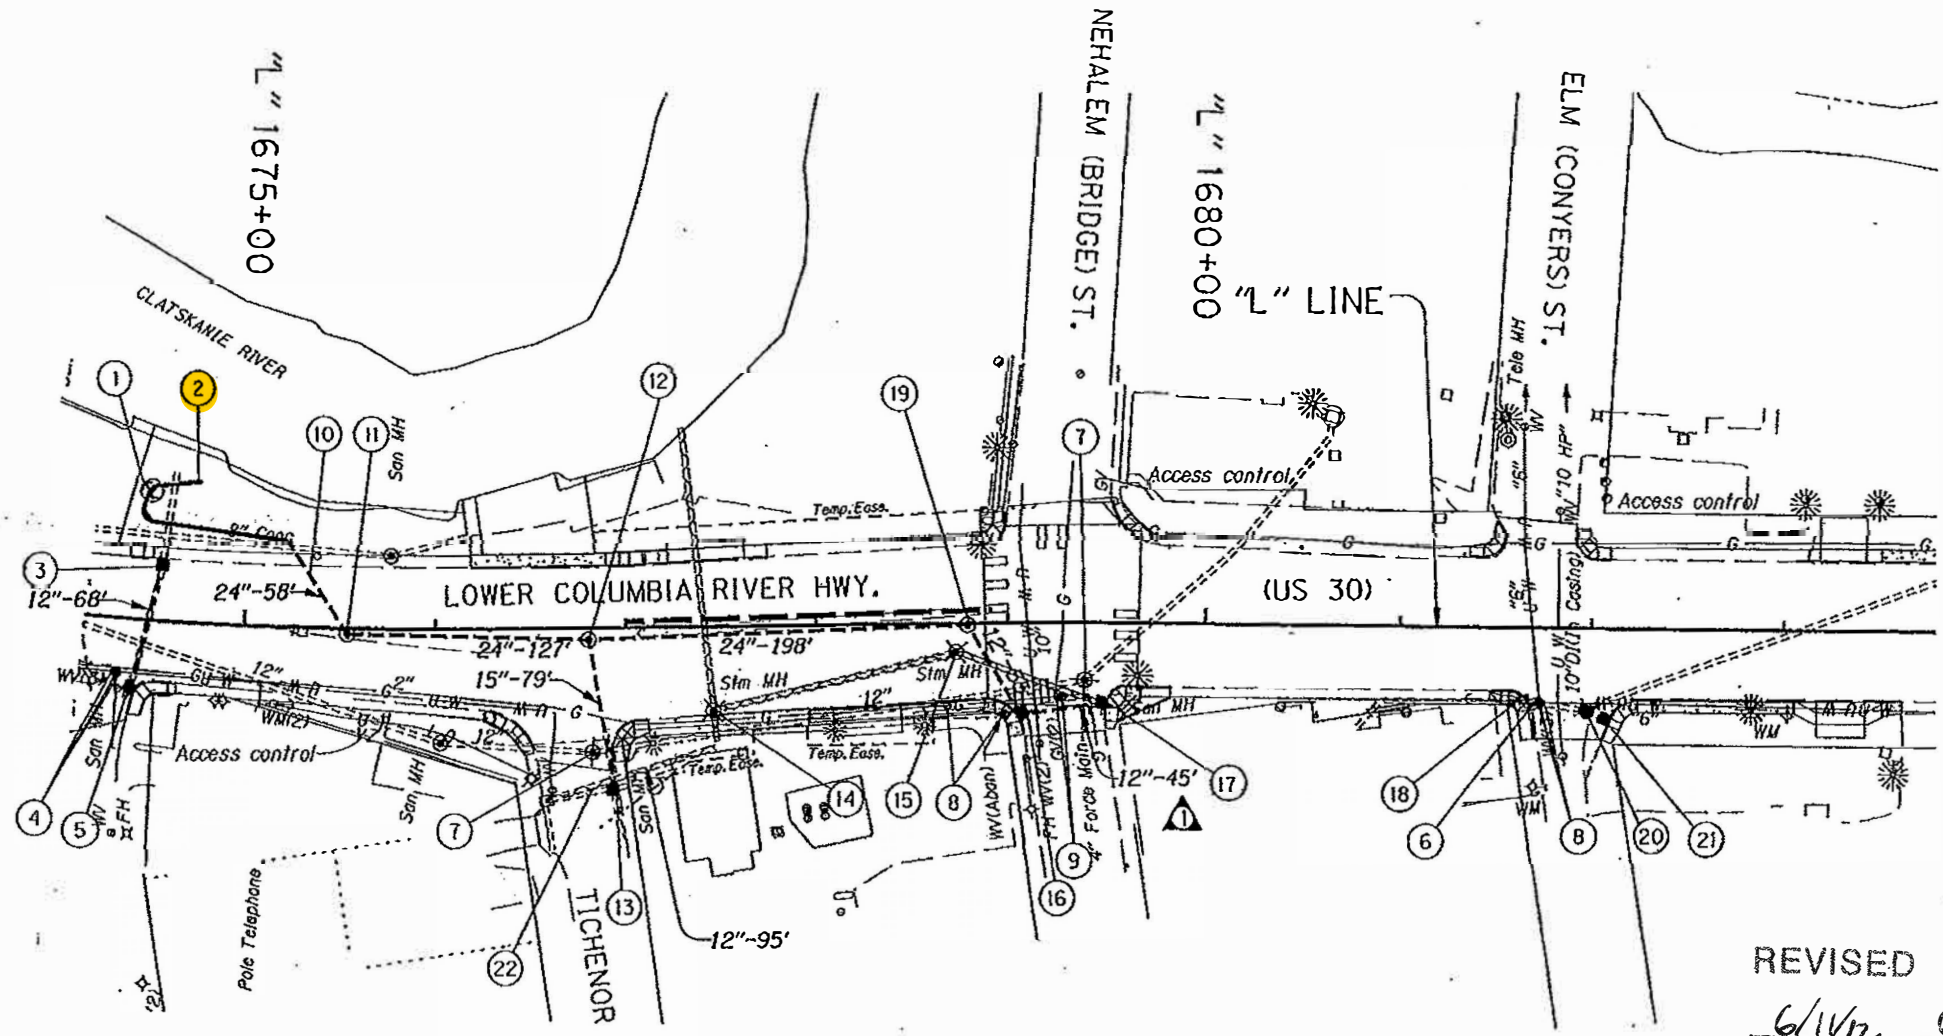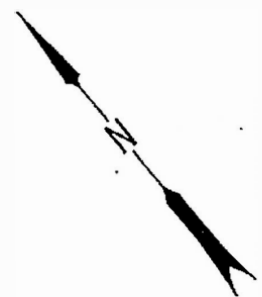

- ① See sht. 3A, note 9
Remove and move roadside ship anchor
- ② See sht. 3A, note 10
Const. water quality swale
Riprap basin
Riprap geotextile
Inst. soil
Ditch exc.
- ③ See sht. 3A, note 8
Remove inlet
Const. inlet
Connect extg. pipe
Remove pipe
Inst. pipe
Trench resurf.
(For profiles, see sht. GJ)
- ④ See sht. 3A, note 3
Adjust water valve box
- ⑤ See sht. 3A, note 11
Remove inlet
Const. inlet
- ⑥ Adjust inlet - 1
- ⑦ Adjust manhole - 2
- ⑧ Adjust water valve box - 5
- ⑨ Adjust gas valve - 2
(By others)
- ⑩ Sta. "L" 1675+21.4, 44.7' Lt.
Inst. 24" ductile iron pipe - 58'
5' depth
Trench resurf. - 52 sqyd.
(For profiles, see sht. GJ)

REVISED AS CONSTRUCTED
 6/11/12 CONTRACT 14305
 Paul Christensen Project Manager

NOTE:
 1. Protect and preserve existing sanitary system and water system.

No.	DATE	REVISIONS	BY
①	01-06-11	Edited pipe length	E.P.F.
②	01-11-11	Revised pipe depth	E.P.F.

OREGON DEPARTMENT OF TRANSPORTATION

REGION 1 - Geo/Hydro/HazMat Unit

US30: SWEDETOWN ROAD - JCT OR-47 SEC.
 LOWER COLUMBIA RIVER HIGHWAY
 COLUMBIA COUNTY


Reviewed by - Bruce Council
 Designed by - Ed Foltyn
 Drafted by - Charlotte Gerken

DRAINAGE & UTILITIES


SHEET NO. 4A

REGISTERED PROFESSIONAL ENGINEER
 7881 ARE
 EDWARD P. FOLTYN
 OREGON
 JAN 9, 2007
 RENEWS: 12-31-2011

- ⑭ Sta. "L" 1677+47.1, 43.3' Rt.
Abandon extg. manhole - depth of 3'
fill and abandon - lower portion of manhole
Fill and abandon extg. 24" storm sew. pipe
(~20' deep) - 146'
Fill and abandon extg. 12" sew. pipe - 129'
Fill and abandon extg. 8" storm sew. pipe - 16'
Trench resurfacing - 10 sqyd.
- ⑮ Sta. "L" 1678+72.9, 14.6' Rt.
Abandon extg. manhole - depth of 3'
fill and abandon - lower portion of manhole
Fill and abandon extg. 8" storm sew. pipe - 78'
Trench resurfacing - 10 sqyd.
- ⑯ Sta. "L" 1679+06.7, Rt.
Const. "CG-2" inlet
Inst. 12" storm sew. pipe - 55'
5' depth
Trench resurfacing - 33 sqyd.
(For profiles, see sht. GJ)
- ⑰ Sta. "L" 1679+46.7, Rt.
Remove inlet
Const. type "CG-2" inlet
Trench resurf. - 10 sqyd.
(For profiles, see sht. GJ)
- ⑱ Relocate power pole and guy wire (By others)
- ⑲ Sta. "L" 1678+78.8, 0.8' Rt.
Const. manhole
Inst. 12" storm sew. pipe - 55'
5' depth
Trench resurf. - 42 sqyd.
(For profiles, see sht. GJ)
- ⑳ Sta. "L" 1681+97.8, 43.1' Rt.
Remove inlet
Const. manhole
Connect to extg. pipes
Inst. 12" storm sew. pipe - 12'
5' depth
Trench resurf. - 10 sqyd.
(For profiles, see sht. GJ-2)
- ㉑ Sta. "L" 1682+07.0, 46.8' Rt.
Const. type "CG-2" inlet
(For profiles, see sht. GJ-2)
- ㉒ Fill and abandon extg. 8" sew. pipe - 87'
- ㉓ Sta. "L" 1675+54.1, 3.0' Rt.
Const. manhole
Inst. 24" storm sew. pipe - 127'
5' depth
Trench resurf. - 113 sqyd.
(For profiles, see sht. GJ)
- ㉔ Sta. "L" 1676+80.8, 6.0' Rt.
Const. manhole
Inst. 24" storm sew. pipe - 198'
5' depth
Inst. 15" storm sew. pipe - 79'
5' depth
Trench resurf. - 237 sqyd.
(For profiles, see sht. GJ)
- ㉕ Sta. "L" 1676+92.6, 84' Rt.
Remove inlet
Const. type "CG-2" inlet
Connect to extg. pipe
Trench resurfacing - 10 sqyd.
(For profiles, see sht. GJ)

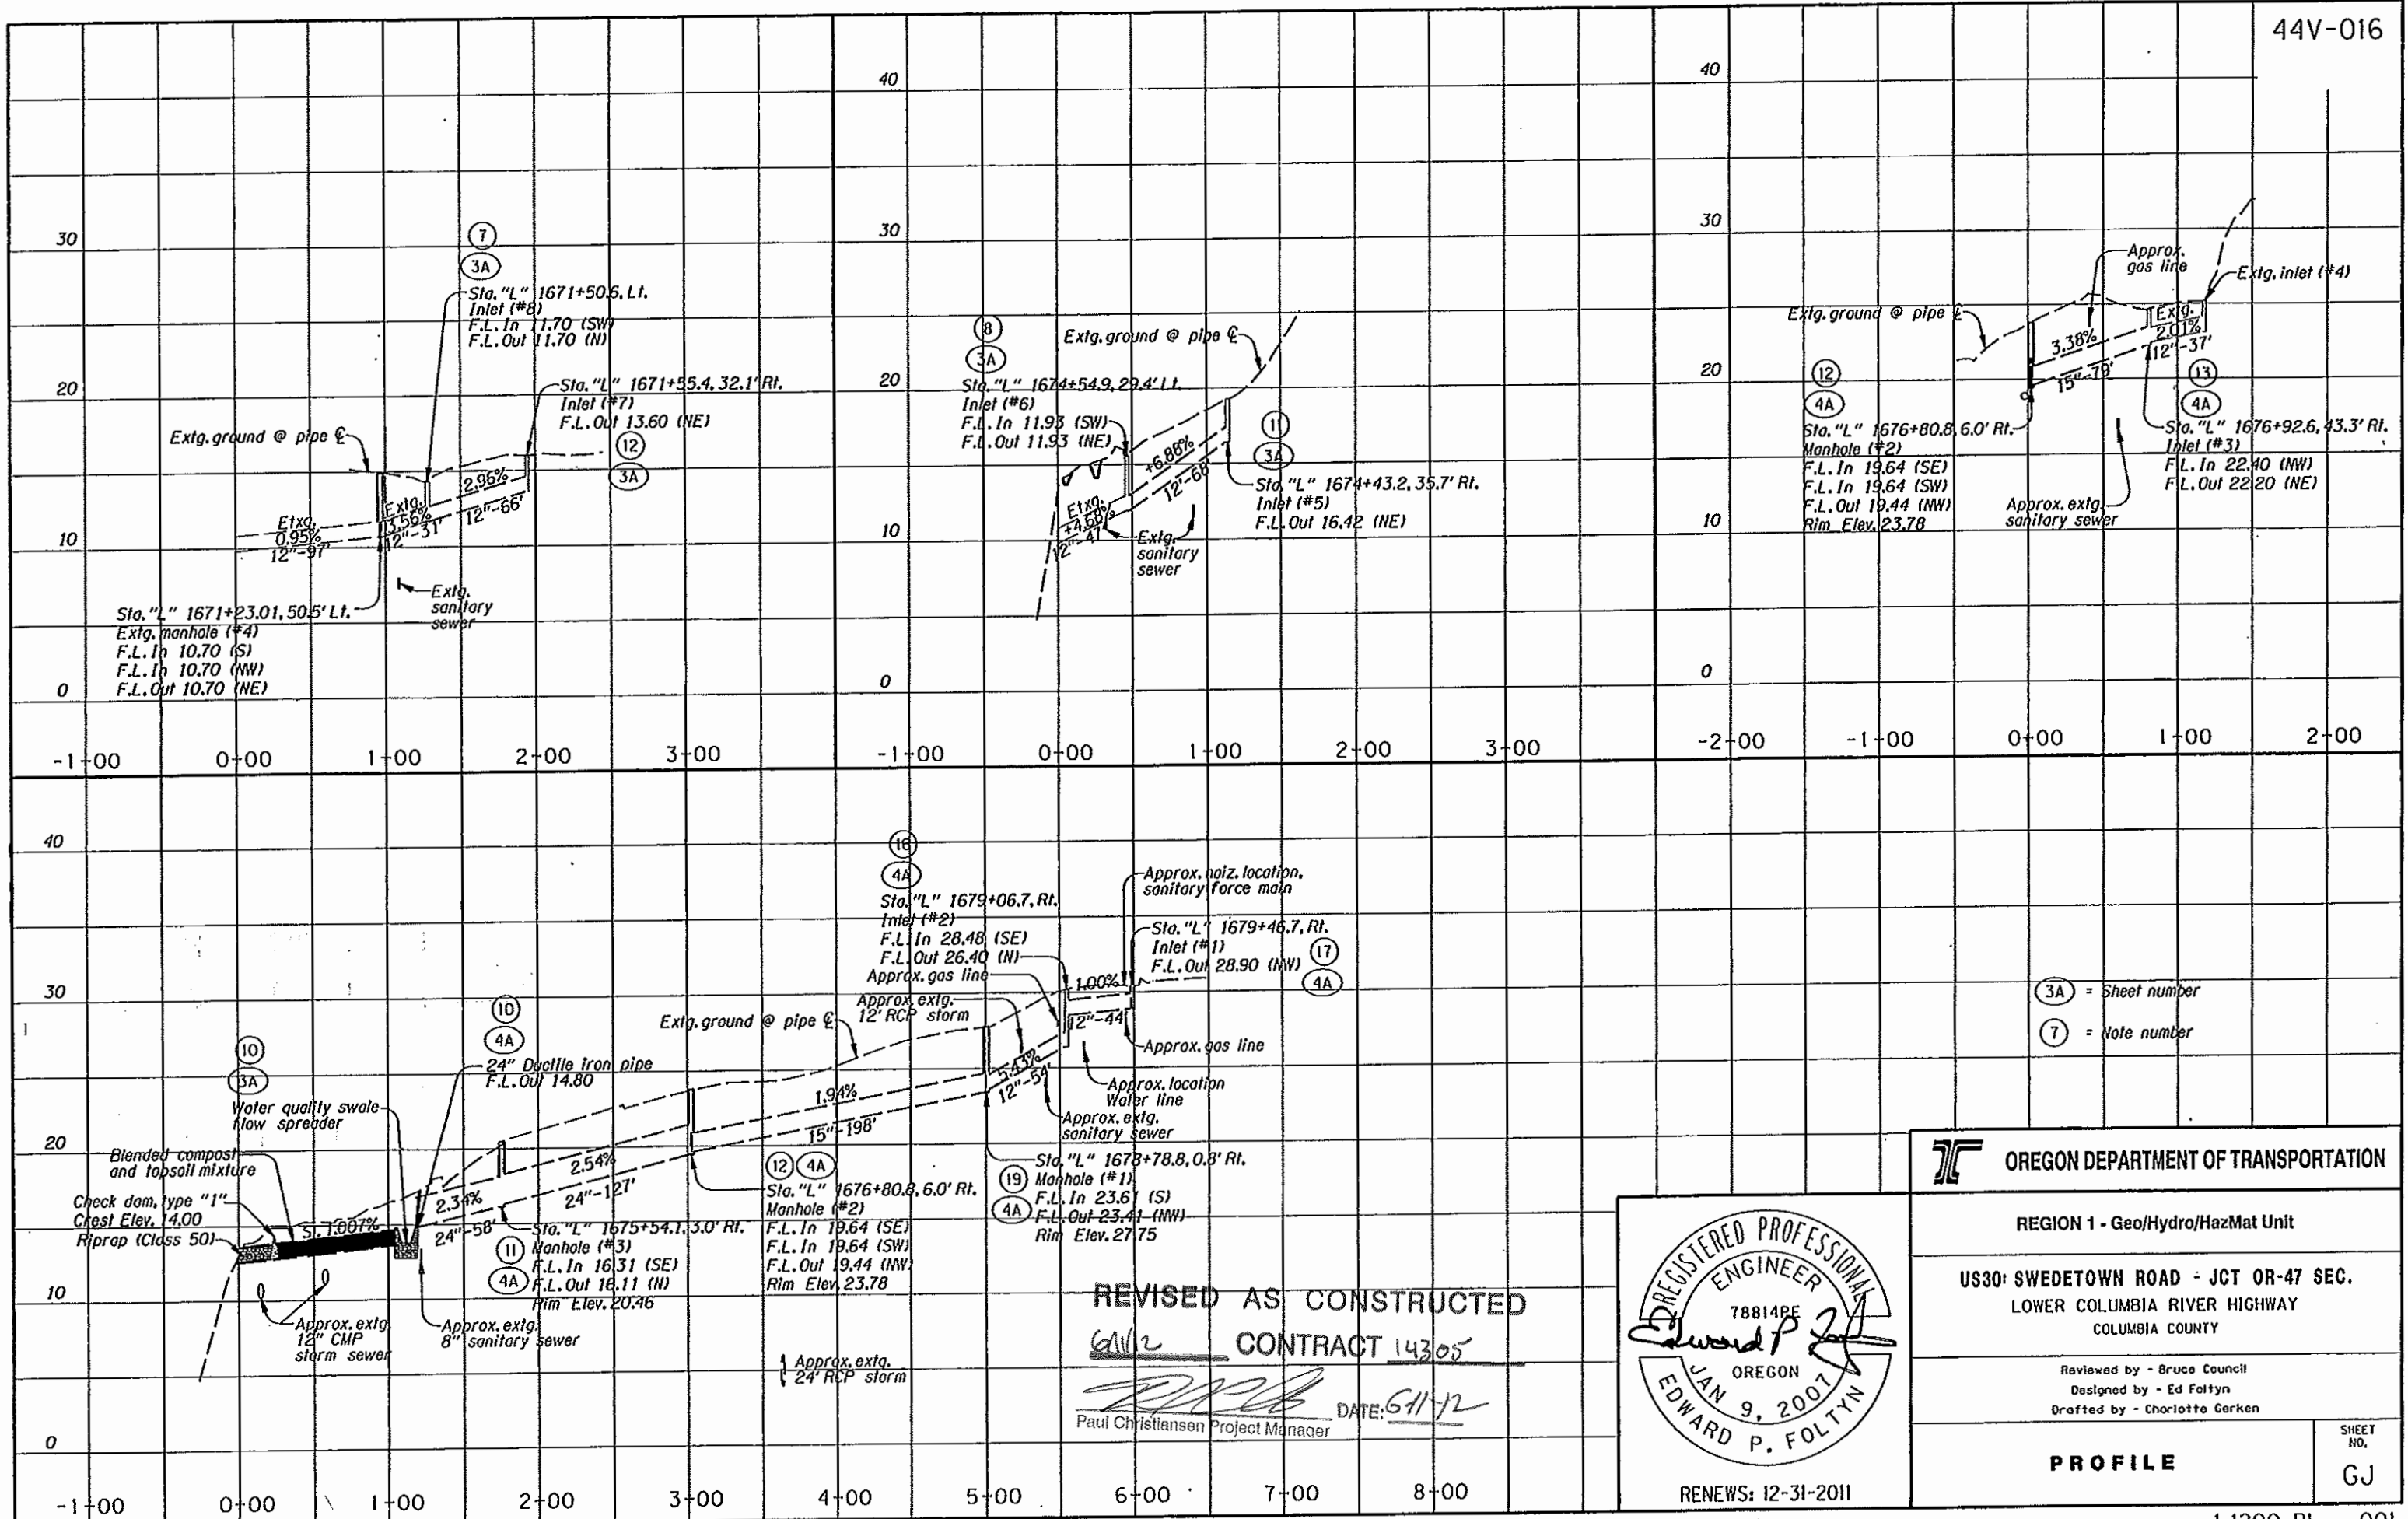

REVISED AS CONSTRUCTED
 Gull CONTRACT 14305
 DATE: 6/1/12
 Paul Christiansen Project Manager

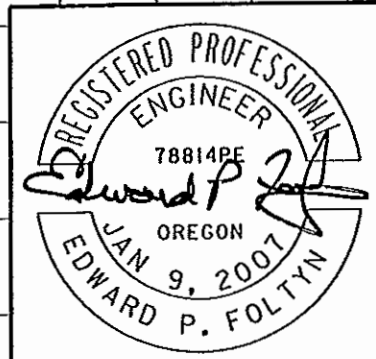

OREGON DEPARTMENT OF TRANSPORTATION

REGION 1 - Geo/Hydro/HazMat Unit


US30: SWEDETOWN ROAD - JCT OR-47 SEC.
 LOWER COLUMBIA RIVER HIGHWAY
 COLUMBIA COUNTY

Reviewed by - Bruce Council
 Designed by - Ed Foltyn
 Drafted by - Charlotte Gerken

PROFILE

SHEET NO. GJ

RENEWS: 12-31-2011

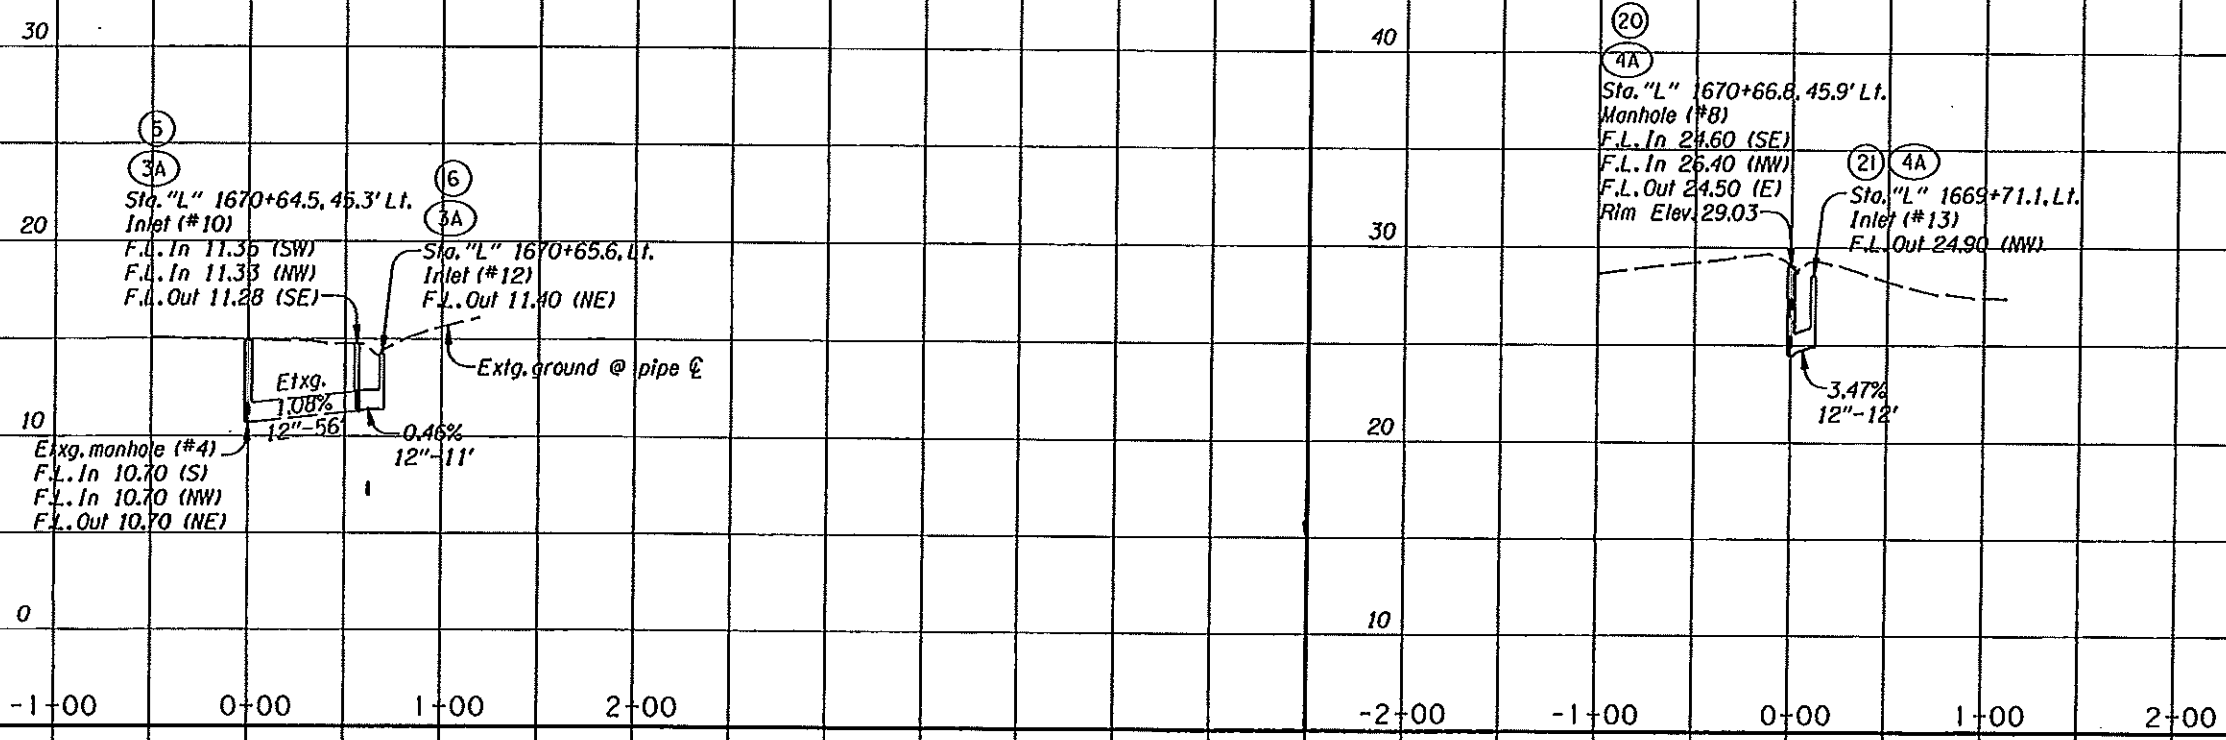

REVISED AS CONSTRUCTED

6/11/12 CONTRACT 14305

[Signature]
 Paul Christensen Project Manager DATE: 6/11/12


OREGON DEPARTMENT OF TRANSPORTATION

REGION 1 - Geo/Hydro/HazMat Unit


US30: SWEDETOWN ROAD - JCT OR-47 SEC.
 LOWER COLUMBIA RIVER HIGHWAY
 COLUMBIA COUNTY

Reviewed by - Bruce Council
 Designed by - Ed Foltyn
 Drafted by - Charlotte Gerken

PROFILE SHEET NO. GJ-2

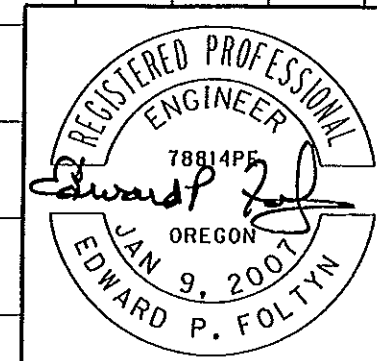


RENEWS: 12-31-2011

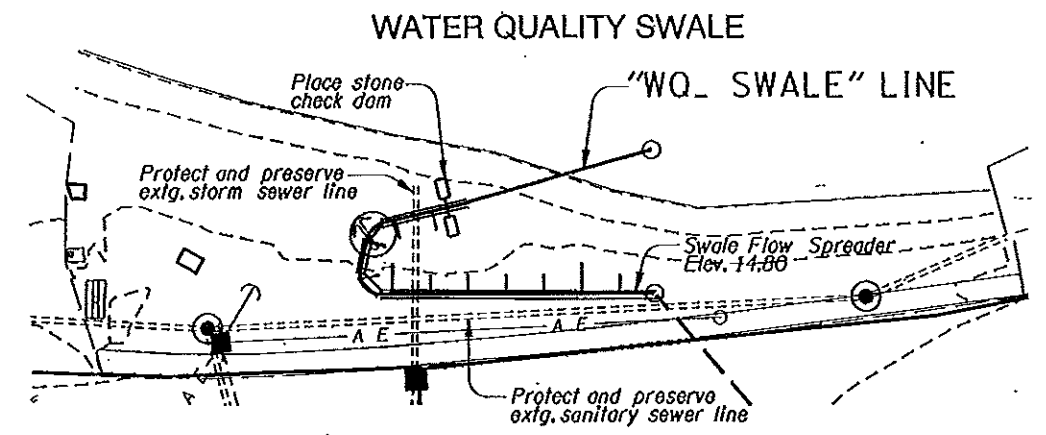


"WQ" SWALE PLAN

"L" 1674+72.9, 72.6' L.I.
(For profile, see shf. GJ)

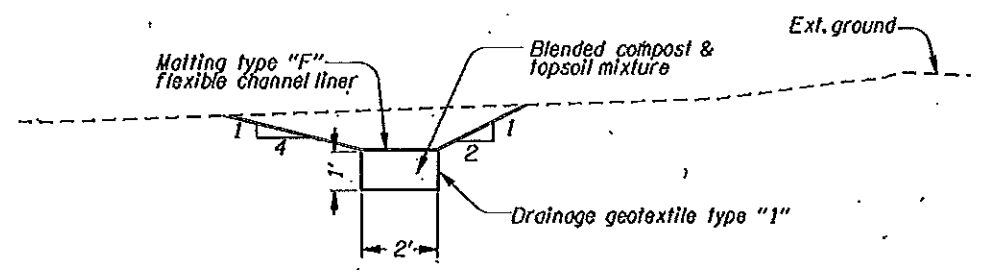


X-SECTION

4' FLAT BOTTOM DITCH

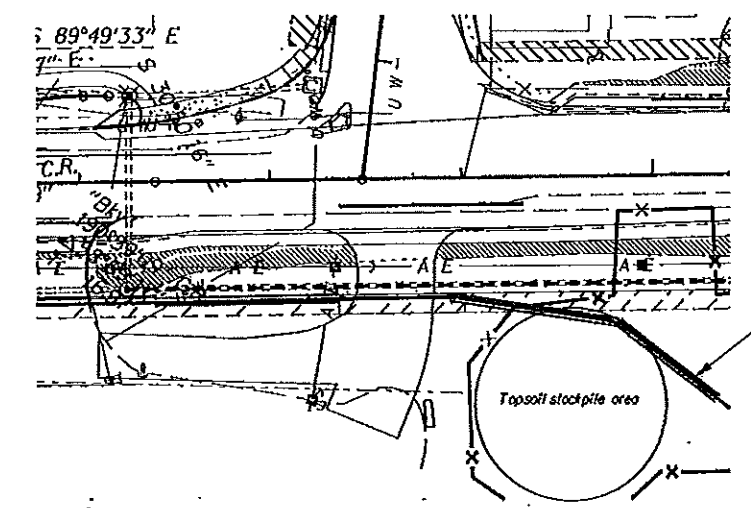


FLAT BOTTOM DITCH PLAN

"L" 1702+38, 61.7' Rt. to "L" 1703+30, 62.3' Rt.
"L" 1703+90, 62.3' Rt. to "L" 1705+32, 116.5' Rt.
(For profile, see shf. GJ-2)

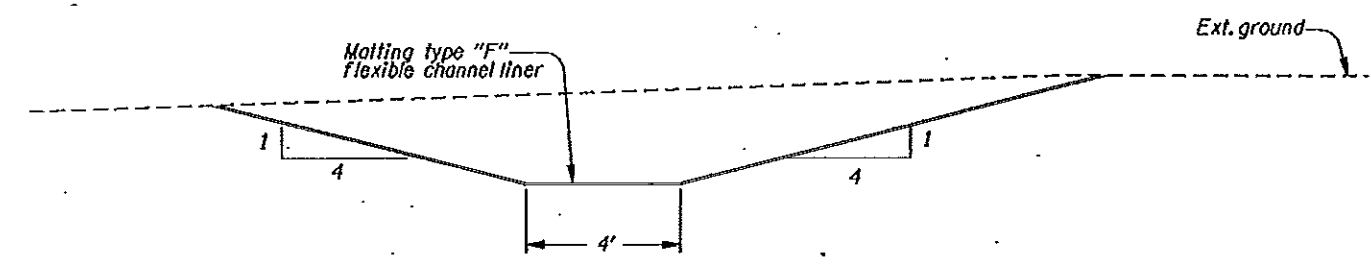

X-SECTION

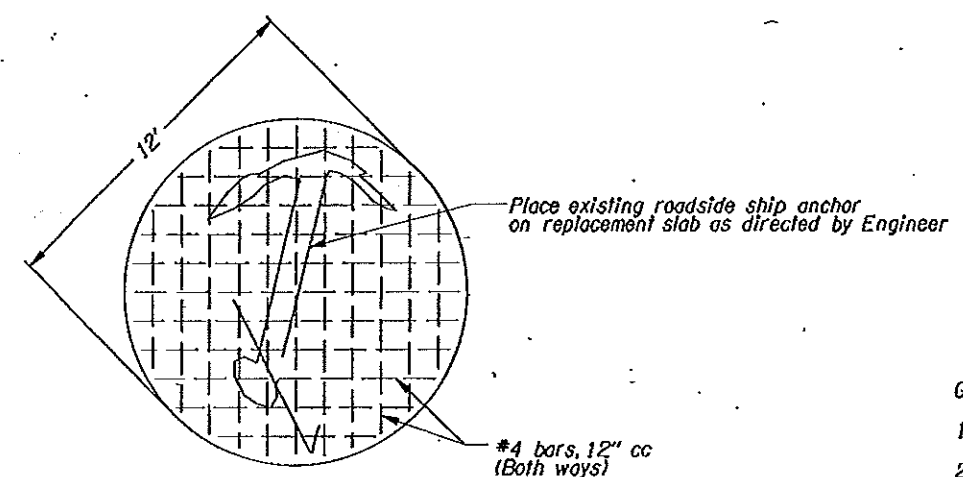

DETAIL


Move roadside ship anchor

GENERAL NOTES:

1. All concrete shall be commercial grade concrete.
2. All reinforcement shall be 3" clear of nearest face of concrete unless otherwise shown.
3. Place 4" deep topsoil on all areas disturbed by construction.
4. Seed all disturbed areas with permanent seed mix.

REVISED AS CONSTRUCTED
4/12 CONTRACT 14305

Paul Christensen Project Manager DATE: 6-11-12

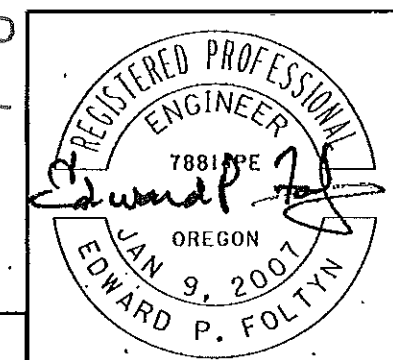



	OREGON DEPARTMENT OF TRANSPORTATION
	REGION 1 - Geo/Hydro/HazMat Unit
	US30: SWEDETOWN ROAD - JCT OR-47 SEC. LOWER COLUMBIA RIVER HIGHWAY COLUMBIA COUNTY
	Reviewed by - Bruce Council Designed by - Ed Foltyn Drafted by - Charlotte Garken

No.	DATE	REVISIONS	BY
	01-03-11	Edited note	E.P.F.

RENEWS: 12-31-2011

PLAN & DETAILS	SHEET NO. GJ-3
---------------------------	--------------------------


WATER QUALITY SWALE FLOW SPREADER

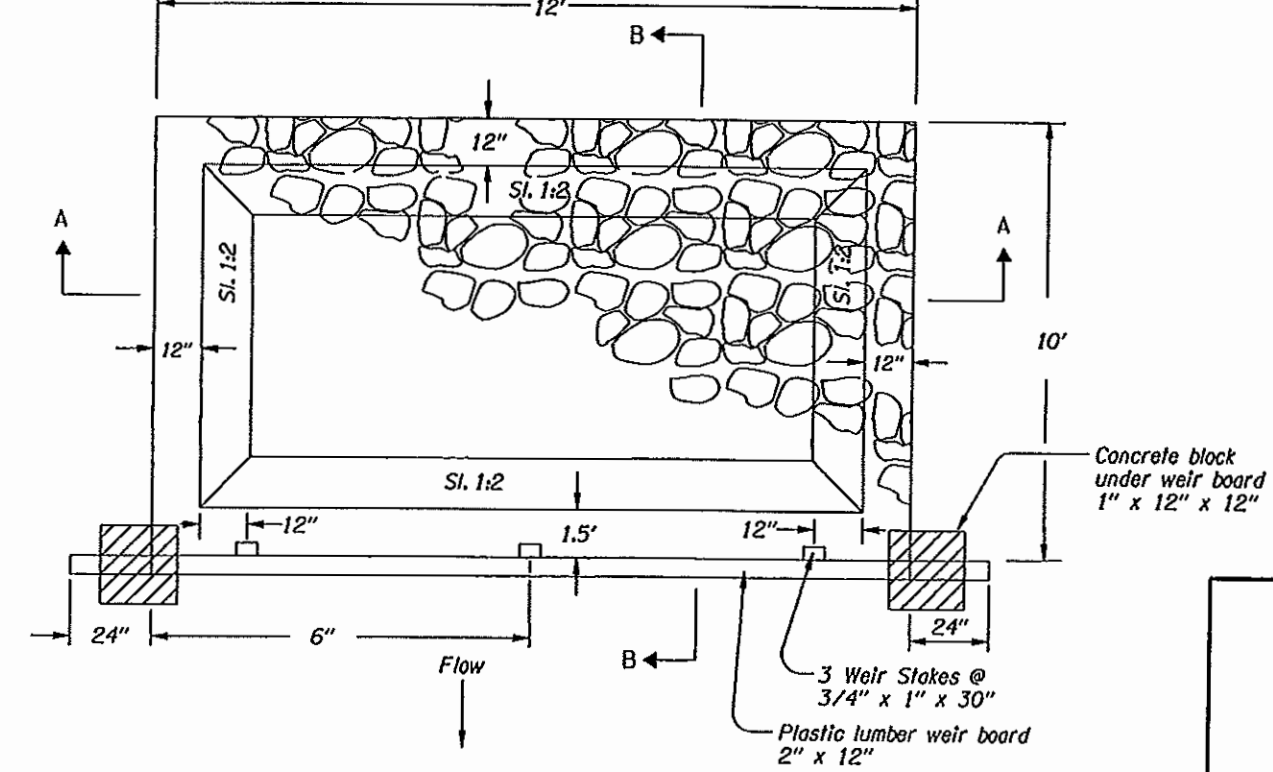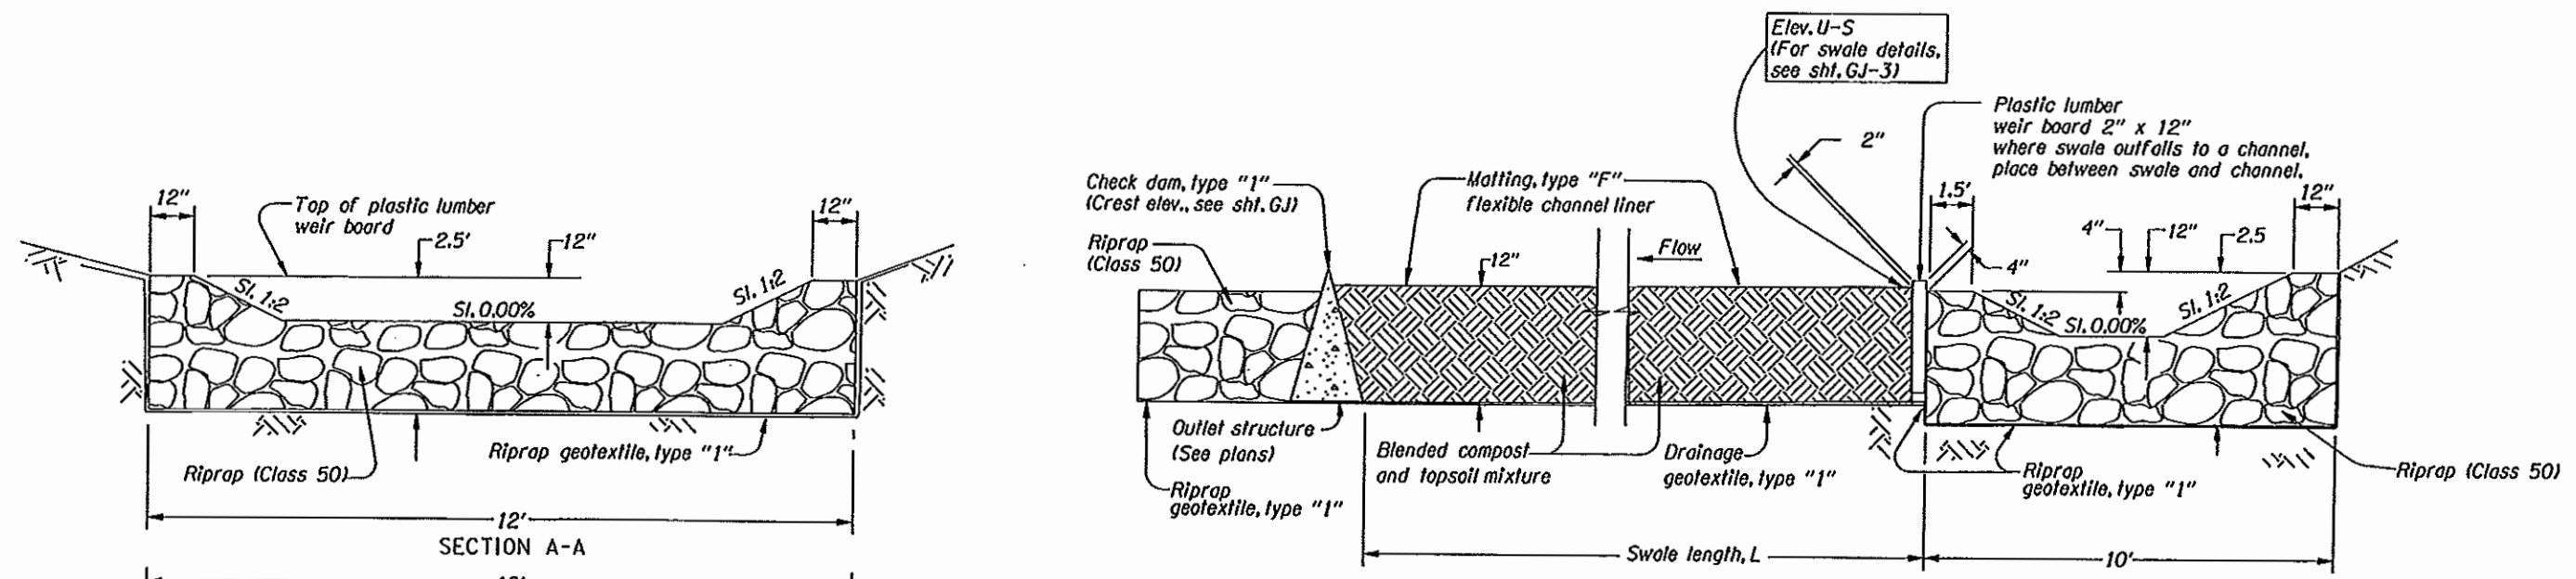

Note:
See 01040 for compost and topsoil mixture


PLAN
SWALE FLOW SPREADER

REVISED AS CONSTRUCTED
6/11/12 CONTRACT 14305
Paul Christensen Project Manager
DATE: 6/11/12

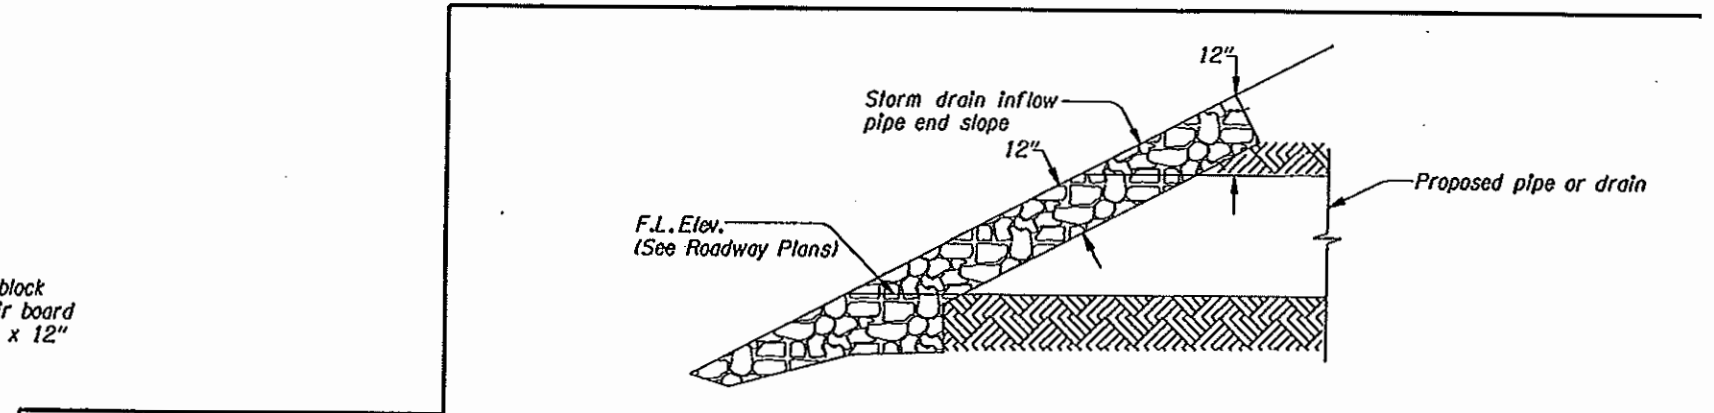


Note:
Pipe F.L. elev. and top of
weir board elev. are the same.

All dimensions are in feet (') unless otherwise noted.

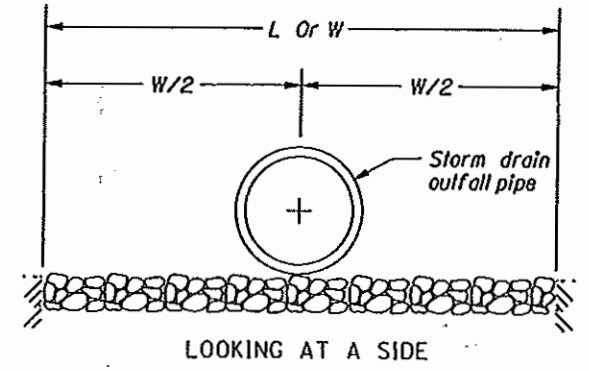

SECTION THROUGH SIDE
PIPE OUTLET

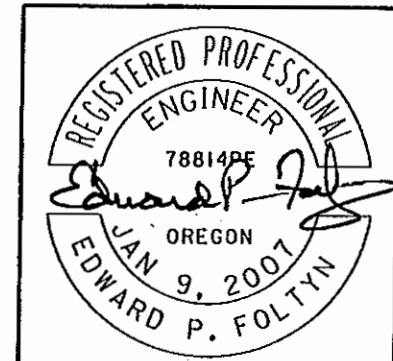

OREGON DEPARTMENT OF TRANSPORTATION	
REGION 1 - Geo/Hydro/HazMat Unit	
US30: SWEDETOWN ROAD - JCT OR-47 SEC. LOWER COLUMBIA RIVER HIGHWAY COLUMBIA COUNTY	
Reviewed by - Bruce Council Designed by - Ed Foltyn Drafted by - Charlotte Gerken	
DETAILS	SHEET NO. GJ-4