

OPERATION & MAINTENANCE MANUAL

DFI No. : D00534

Facility Type: Water Quality Structure



March 2018

INDEX

1. IDENTIFICATION..... 1
2. FACILITY CONTACT INFORMATION 1
3. CONSTRUCTION..... 1
4. STORM DRAIN SYSTEM AND FACILITY OVERVIEW 1
5. FACILITY HAZ MAT SPILL FEATURE(S)..... 2
6. AUXILIARY OUTLET (HIGH FLOW BYPASS)..... 2
7. MAINTENANCE REQUIREMENTS..... 2
8. WASTE MATERIAL HANDLING..... 3

APPENDIX A: Operational Plan and Profile Drawing(s)

APPENDIX B: ODOT Project Plan Sheets

Include Appendix C If Required:

APPENDIX C: Proprietary Structure Maintenance Requirements

1. Identification

Drainage Facility ID (DFI): **D00534**
Facility Type: Water Quality Structure
Construction Drawings: (V-File Number) 45V-32
Location: District: 1
Highway No.: 9
Mile Post: 118.28
Description: This facility is located in the viewing pull out on the west side of the highway just south of the Schooner Creek Bridge – south of Lincoln City

2. Facility Contact Information

Contact the Engineer of Record, Region Technical Center, or Geo-Environmental's Senior Hydraulics Engineer for:

- Operational clarification
- Maintenance clarification
- Repair or restoration assistance

Engineering Contacts:

Region Technical Center Hydro Unit Manager

Or

Geo-Environmental Senior Hydraulics Engineer (503) 986-3365.

3. Construction

Engineer of Record: ODOT Designer – Region 2 Tech. Center, Bruce Carmichael Phone (503) 986-2713

Facility construction: 2012
Contractor: Kerr Contractors Oregon, Inc.

4. Storm Drain System and Facility Overview

The water quality structure consist of three (3) concrete vaults with ecology mix over an undrain (perforated pipe). Stormwater enters the

structures and percolates through the ecology mix and is then collected in the under drains and discharged out of the structures via pipes.

- Facility Type – Water Quality Structure.
- Highway viewing pull out just south of Schooner Creek Bridge.
- Access via parking area.
- Contributing drainage basin – see appendix.
- Features include under drains, pipe cleanouts and curb openings.
- Discharge pipes carry treated stormwater out of structures and discharges off side of hill above the beach.

A. Maintenance equipment access:
Access via the viewing area parking lot.

B. Heavy equipment access into facility:

- Allowed (no limitations)
- Allowed (with limitations)
- Not allowed

C. Special Features:

- Ecology Mix
- Porous Pavers
- Liners
- Underdrains

5. Facility Haz Mat Spill Feature(s)

The facility cannot be used to store HazMat spills.

6. Auxiliary Outlet (High Flow Bypass)

Stormwater flows in excess of structure handling capacities will sheet flow over hillside onto beach / bay. Stormwater will flow as it did before installation of these structures.

The auxiliary outlet feature for this facility is:

- Designed into facility

7. Maintenance Requirements

Routine maintenance table for non-proprietary stormwater treatment and storage/detention facilities have been incorporated into ODOT's

Maintenance Guide. These tables summarize the maintenance requirements for ponds, swales, filter strips, bioslopes, and detention tanks and vaults. Special maintenance requirements in addition to the routine requirements are noted below when applicable.

The ODOT Maintenance Guide can be viewed at the following website:

<http://www.oregon.gov/ODOT/HWY/OOM/MGuide.shtml>

Maintenance requirements for proprietary structures, such as underground water quality manholes and/or vaults with filter media are noted in Appendix C when applicable.

The following stormwater facility maintenance table (See ODOT Maintenance Guide) should be used to maintain the facility outlined in this Operation and Maintenance Manual or follow the Maintenance requirements outlined in Appendix C when proprietary structure is selected below:

Mark as Required and always include Table 1:

- Table 1 (general maintenance)
- Table 2 (stormwater ponds)
- Table 3 (water quality biofiltration swales)
- Table 4 (water quality filter strips)
- Table 5 (water quality bioslopes)
- Table 6 (detention tank)
- Table 7 (detention vault)
- Appendix C (proprietary structure)
- Special Maintenance requirements:

8. Waste Material Handling

Material removed from the facility is defined as waste by DEQ. Refer to the roadwaste section of the ODOT Maintenance Yard Environmental Management System (EMS) Policy and Procedures Manual for disposal options: <http://egov.oregon.gov/ODOT/HWY/OOM/EMS.shtml>


Contact any of the following for more detailed information about management of waste materials found on site:

ODOT Clean Water Unit	(503) 986-3008
ODOT Statewide Hazmat Coordinator	(503) 229-5129
ODOT Region Hazmat Coordinator	(503) 986-2647
ODEQ Northwest Region Office	(503) 229-5263


Appendix A

Content:


- **Operational Plan and Profile Drawing(s)**

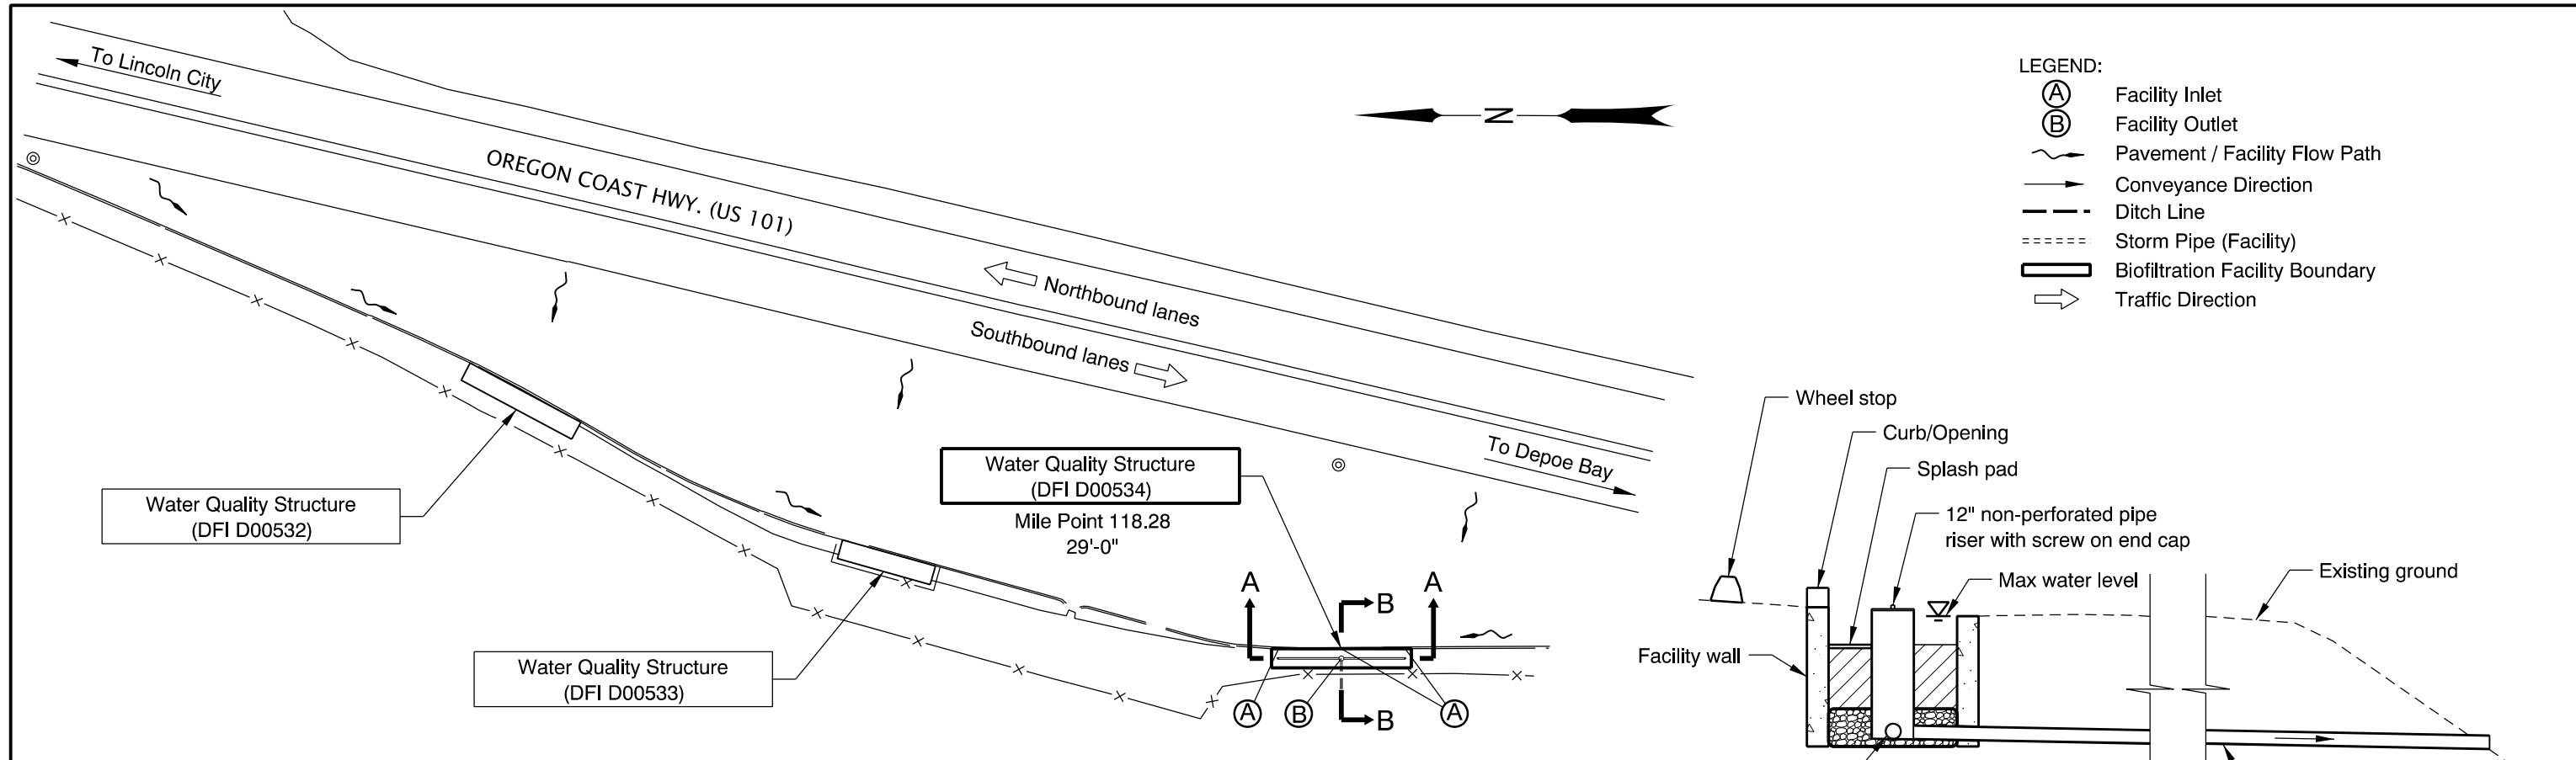


PLAN
N.T.S.

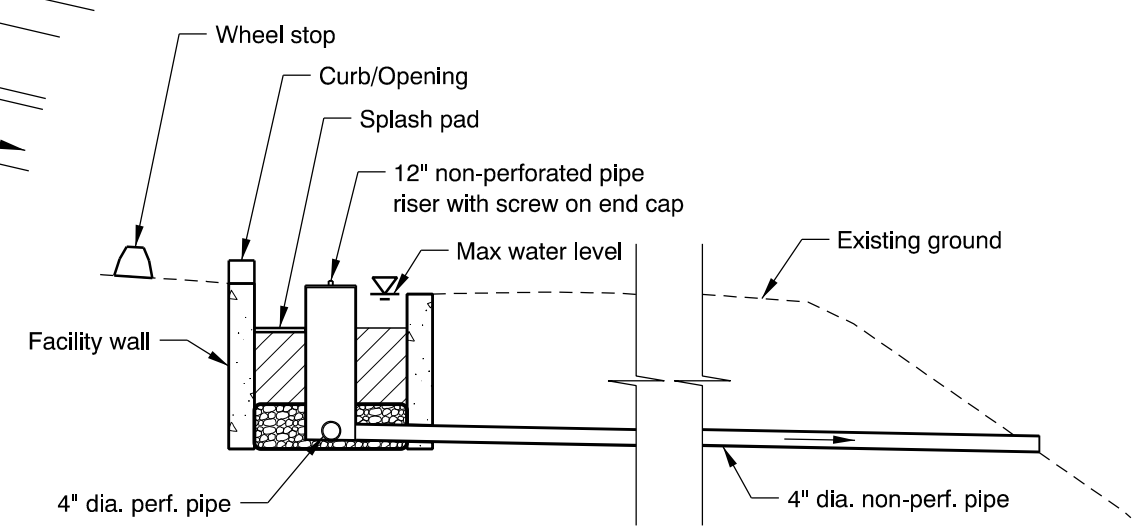

SECTION B-B
N.T.S.

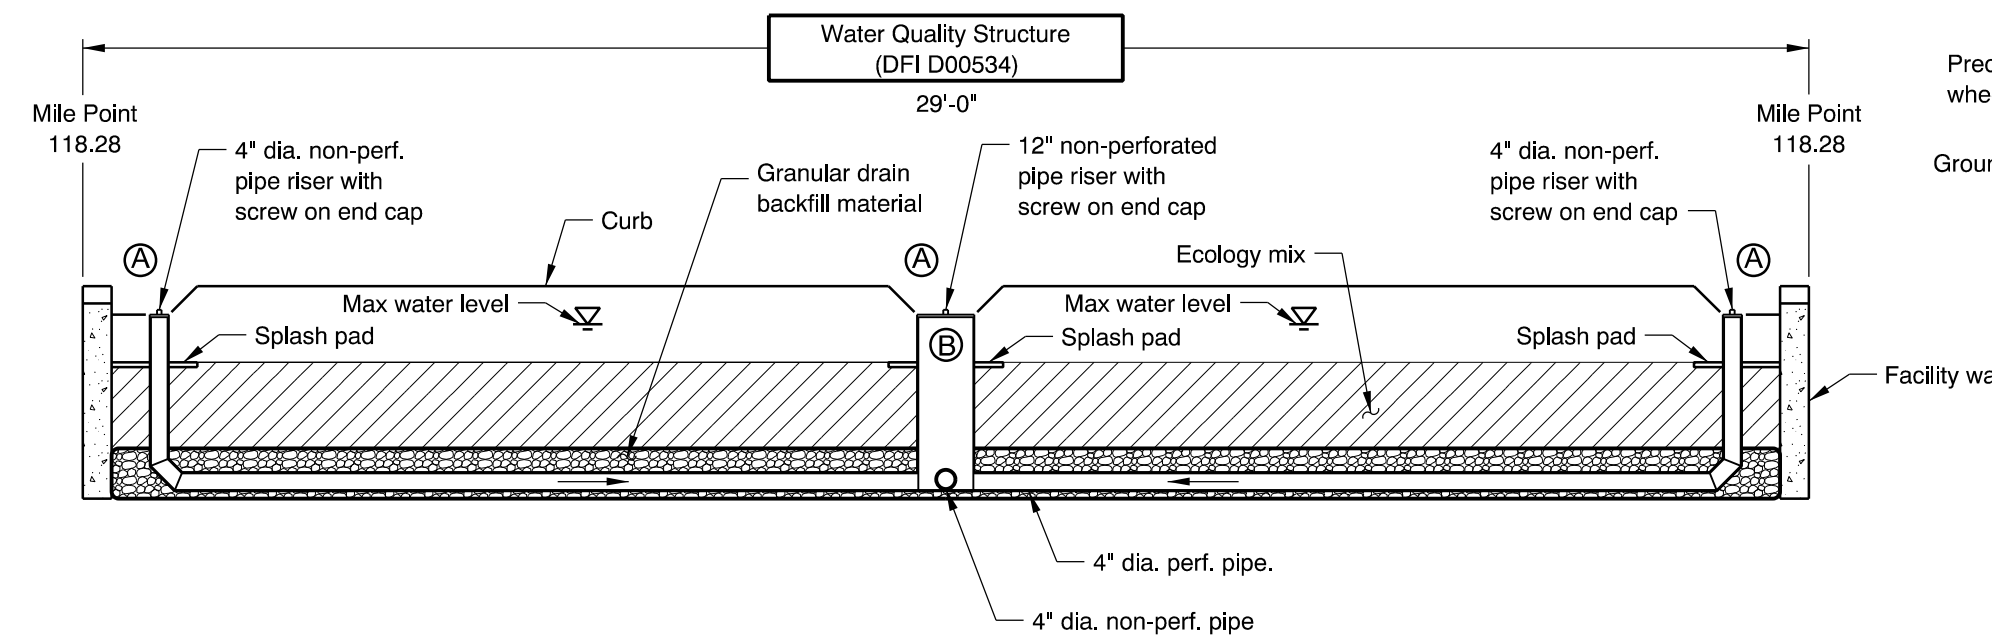

SECTION A-A
N.T.S.

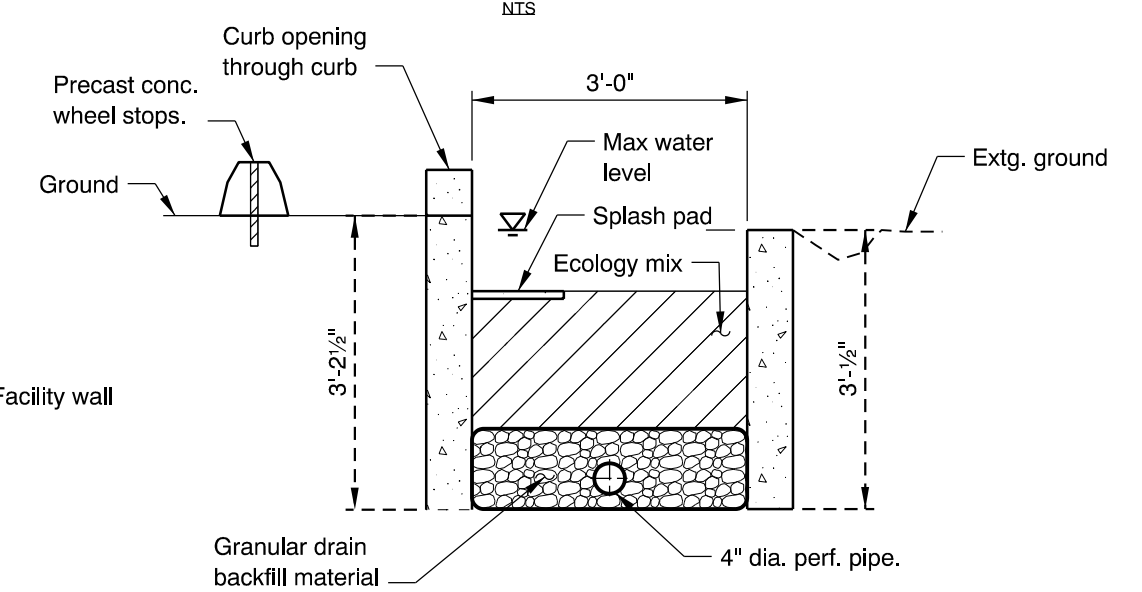

TYPICAL SECTION
N.T.S.

Prepared By: Bruce Carmichael	OREGON DEPARTMENT OF TRANSPORTATION DFI D00534 MAINTENANCE DISTRICT 4 HWY 101 WATER QUALITY STRUCTURE OREGON COAST HIGHWAY MP 118.28 LINCOLN COUNTY

Appendix B

Content:

- **ODOT Project Plan Sheets**
 - *Cover/Title Sheet*
 - *Water Quality/Detention Plan Sheets*
 - *Other Details*

INDEX OF SHEETS	
SHEET NO.	DESCRIPTION
1	Title Sheet
1A	Index Of Sheets Cont'd. & Std. Drg. Nos.

ORIGINAL

REVISED AS CONSTRUCTED

Gene Wilborn

 Gene Wilborn

DATE 12/3/12


STATE OF OREGON
 DEPARTMENT OF TRANSPORTATION

PLANS FOR PROPOSED PROJECT
 GRADING, DRAINAGE, STRUCTURES, PAVING, & ROADSIDE DEVELOPMENT

**REGION 2 CULVERT
 IMPROVEMENTS SEC.**

**VARIOUS HIGHWAYS
 CLATSOP, LINCOLN & MARION COUNTIES**

APRIL 2012

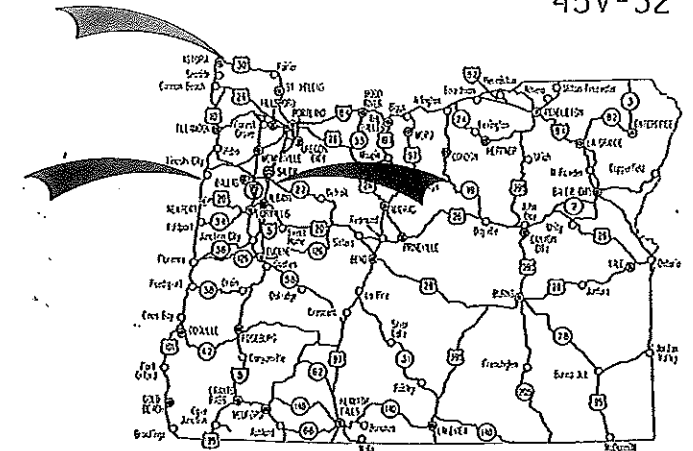

ATTENTION:
 Oregon Law Requires You To Follow Rules Adopted By The Oregon Utility Notification Center. Those Rules Are Set Forth In OAR 952-001-0010 Through OAR 952-001-0090. You May Obtain Copies Of The Rules By Calling The Center. (Note: The Telephone Number For The Oregon Utility Center Is (503) 232-1987.)

**STP-S000(692)
 PROJECT SITE**


Lower Columbia River Hwy.
 STA. "L"27+35 To STA. "L"33+40
 (M.P. 93.97 To M.P. 93.85)

**BIOFILTRATION
 FACILITY SITE**

Oregon Coast Hwy.
 STA. "B"1+14 To STA. "B"3+76
 (M.P. 118.24 To M.P. 118.28)

**STP-S000(692)
 PROJECT SITE**

Oregon Coast Hwy.
 STA. "L"1140+00 To STA. "L"1154+59
 (M.P. 119.10 To M.P. 118.82)

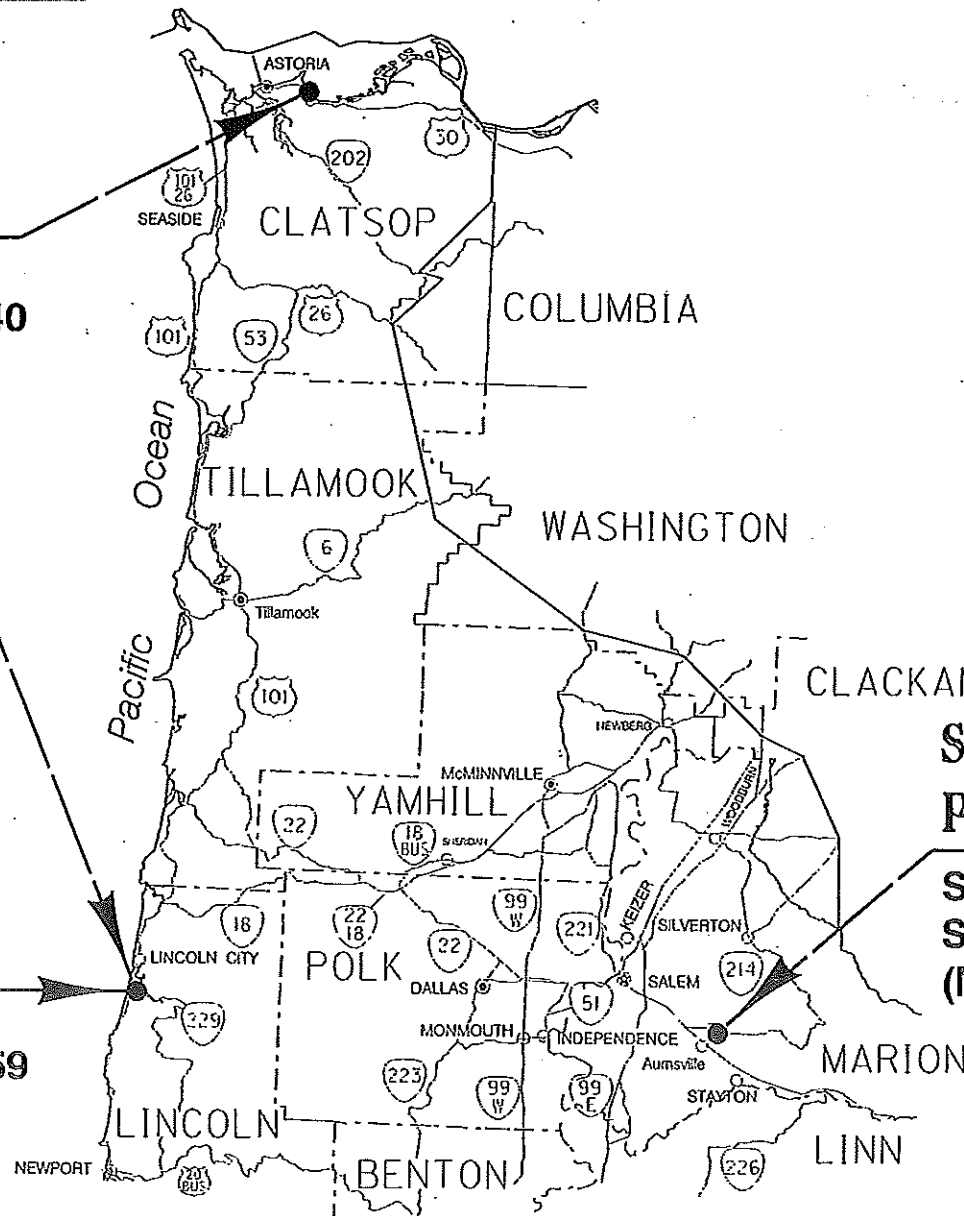

T. 8 N.; T. 7 S. & T. 8 S.
 R. 9 W.; R. 11 W. & R. 1 W., W.M.

● Project Site



OREGON TRANSPORTATION COMMISSION
 Pat Egan CHAIR
 David Lohman COMMISSIONER
 Mory F. Olson COMMISSIONER
 Mark Frohnmayer COMMISSIONER
 Tommy Boney COMMISSIONER
 Matthew L. Garrett DIRECTOR OF TRANSPORTATION

These plans were developed using ODOT design standards. Exceptions to these standards, if any, have been submitted and approved by the ODOT Chief Engineer or their delegated authority.

By: *Carol A. Cortwright* 2/17/12
 Signature & date

Carol A. Cortwright - R2 Tech Center Manager

Print name and title


G. M. NR
 Concurrency by ODOT Chief Engineer

REGION 2 CULVERT IMPROVEMENTS SEC. VARIOUS HIGHWAYS CLATSOP, LINCOLN & MARION COUNTIES		
FEDERAL HIGHWAY ADMINISTRATION	PROJECT NUMBER	SHEET NO.
OREGON DIVISION	STP-S000(692)	1




PE00-1531/000

Sec. 8, T. 8 S., R.11 W., W.M
 OREGON COAST HIGHWAY
 M.P. 118.24 to 118.28

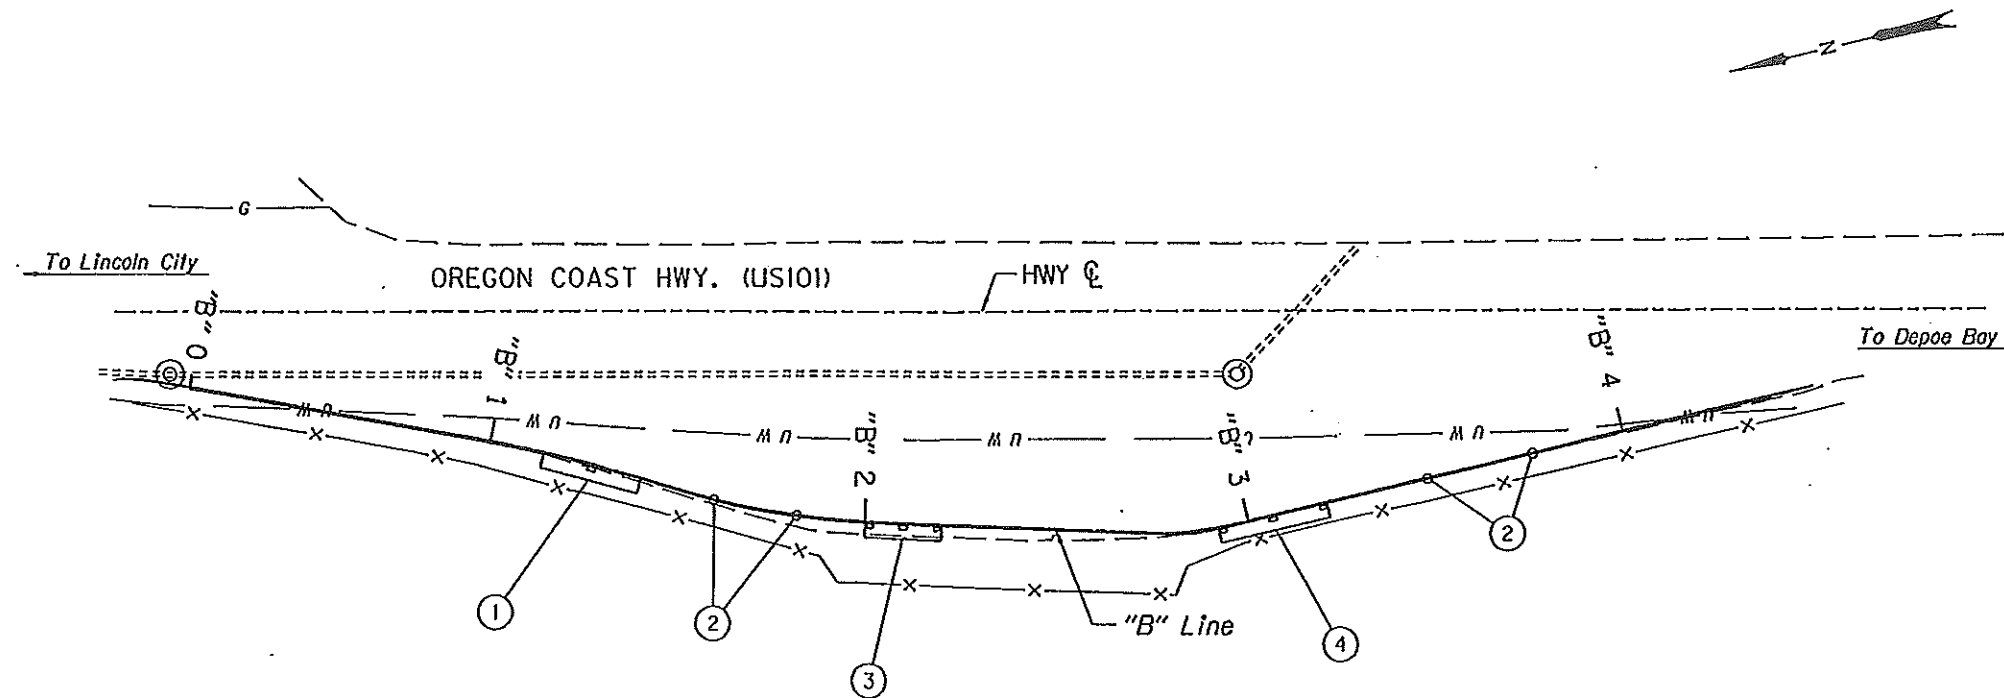


- ① Sta. "B"1+14.33 to Sta. "B"1+40.33
 Biofiltration Facility No. 1
 (For details see shf. GJ-2)
- ② Sta. "B"1+60
 "B"1+82 H62
 "B"3+48
 "B"3+76
 Close extg. curb opening.
- ③ Sta. "B"2+00 to Sta. "B"2+20
 Biofiltration Facility No. 2
 (For details see shf. GJ-3)
- ④ Sta. "B"2+92 to Sta. "B"3+21
 Biofiltration Facility No. 3
 (For details see shf. GJ-4)


PLAN

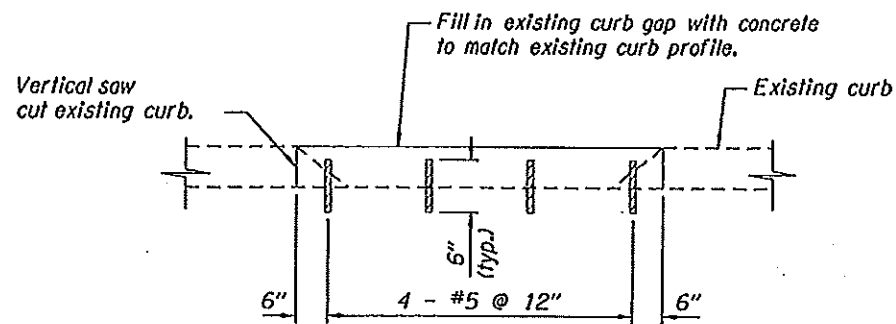

TYPICAL EXISTING CURB FILL

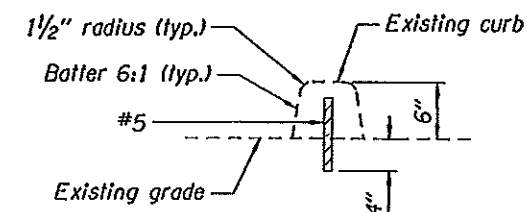

TYPICAL EXISTING CURB SECTION

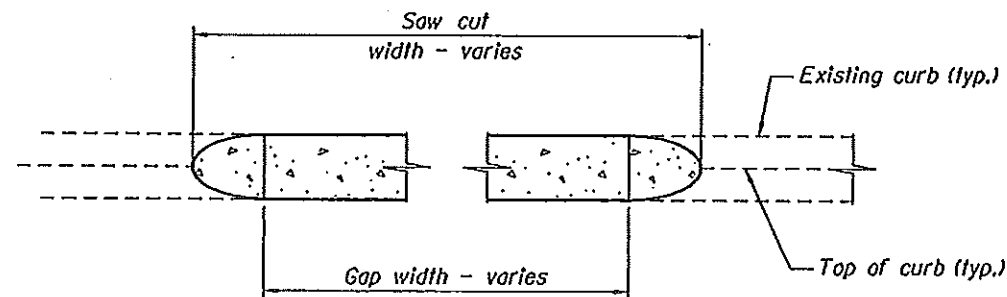


DRAINAGE CURB CUTTING

Note:
 Cut existing curb leaving a vertical face, install 1/2" rebar into existing surface (minimum of 3 per opening). Place concrete matching existing curb profile.


REVISED AS CONSTRUCTED

Gene Wilborn
 Gene Wilborn
 DATE 12/3/12

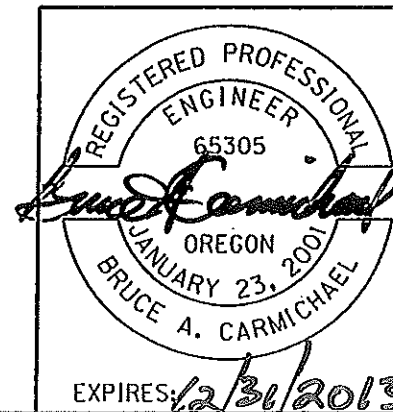


OREGON DEPARTMENT OF TRANSPORTATION	
REGION 2 TECH CENTER	
REGION 2 CULVERT IMPROVEMENTS SEC. VARIOUS HIGHWAYS CLATSOP, LINCOLN & MARION COUNTIES	
Reviewed By - Chris Corman, P.E. Designed By - Bruce Carmichael Drafted By - Michael Skelton	
STORMWATER PLAN	SHEET NO. GJ

Sec. 8, T. 8 S., R.11 W., W.M
OREGON COAST HIGHWAY
M.P. 118.24 to 118.28

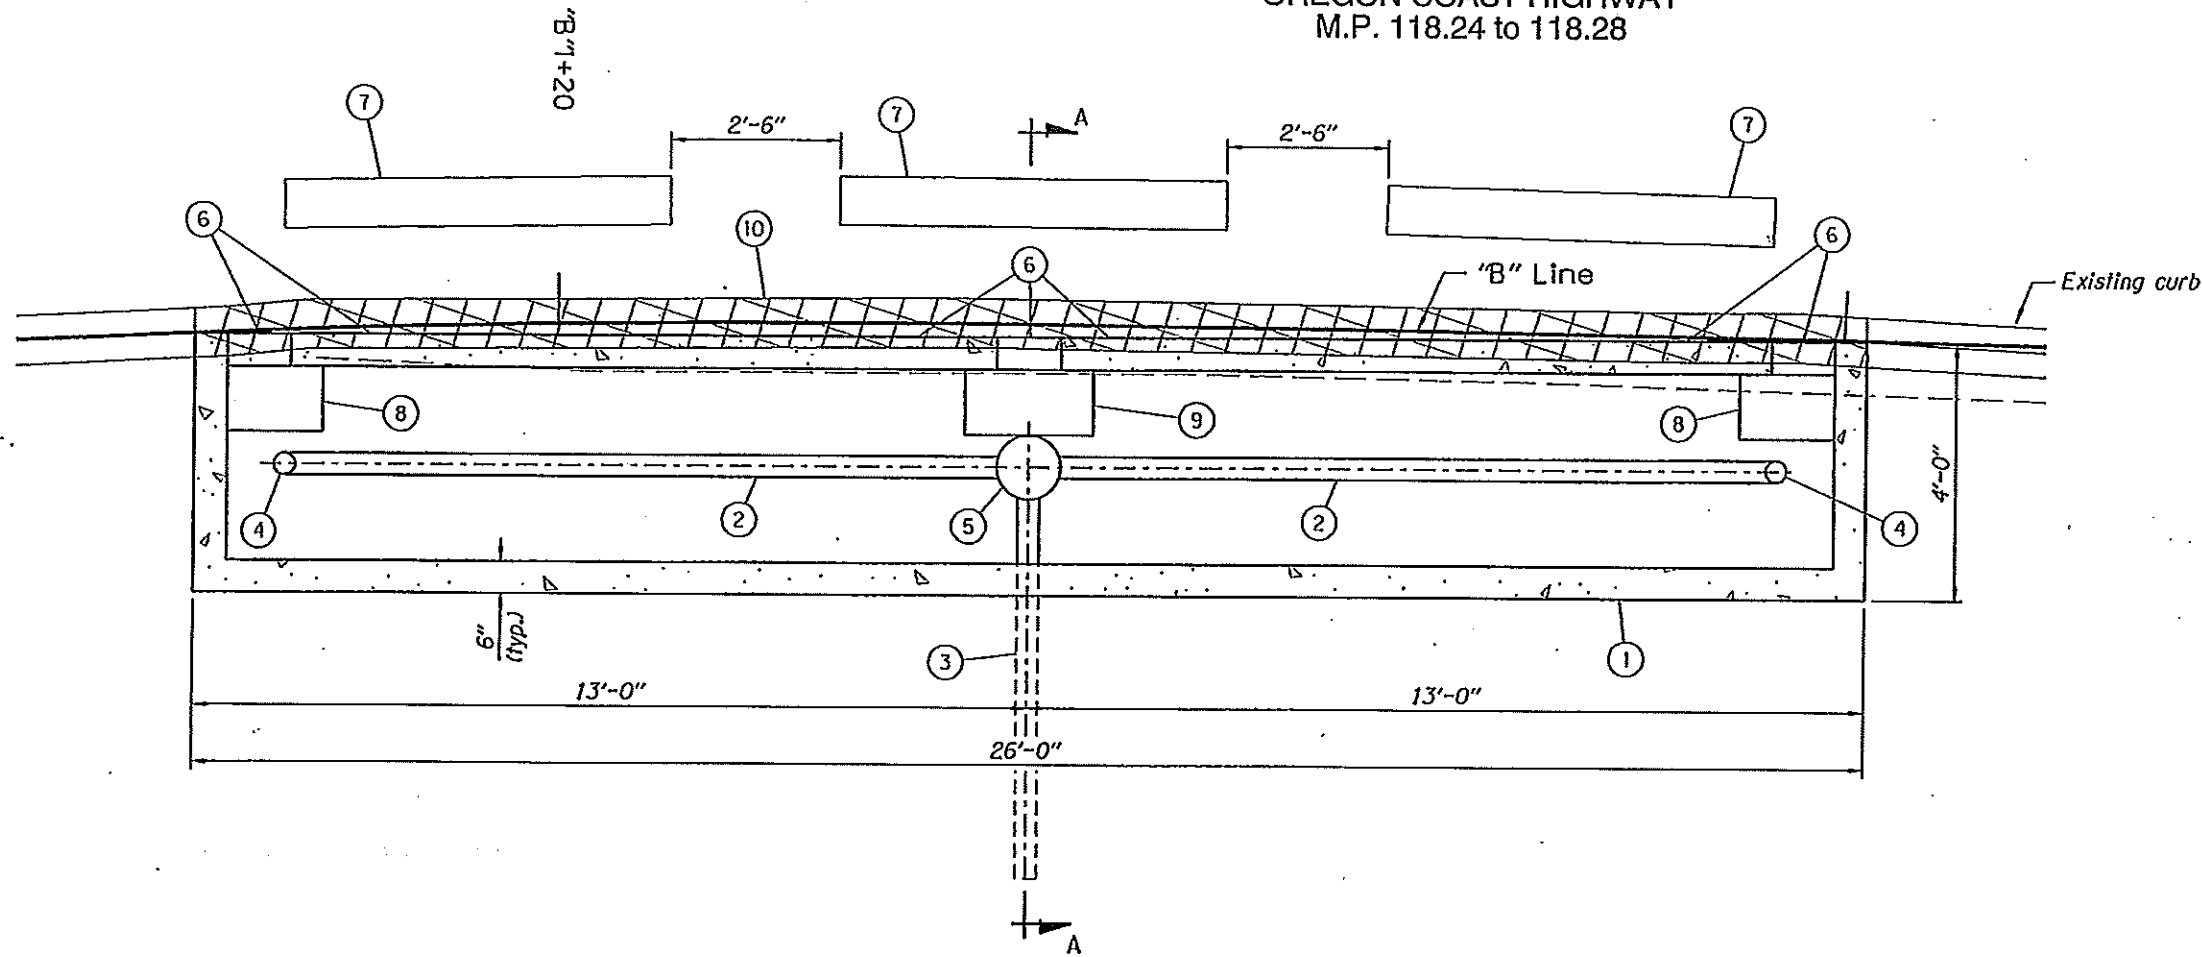

PLAN

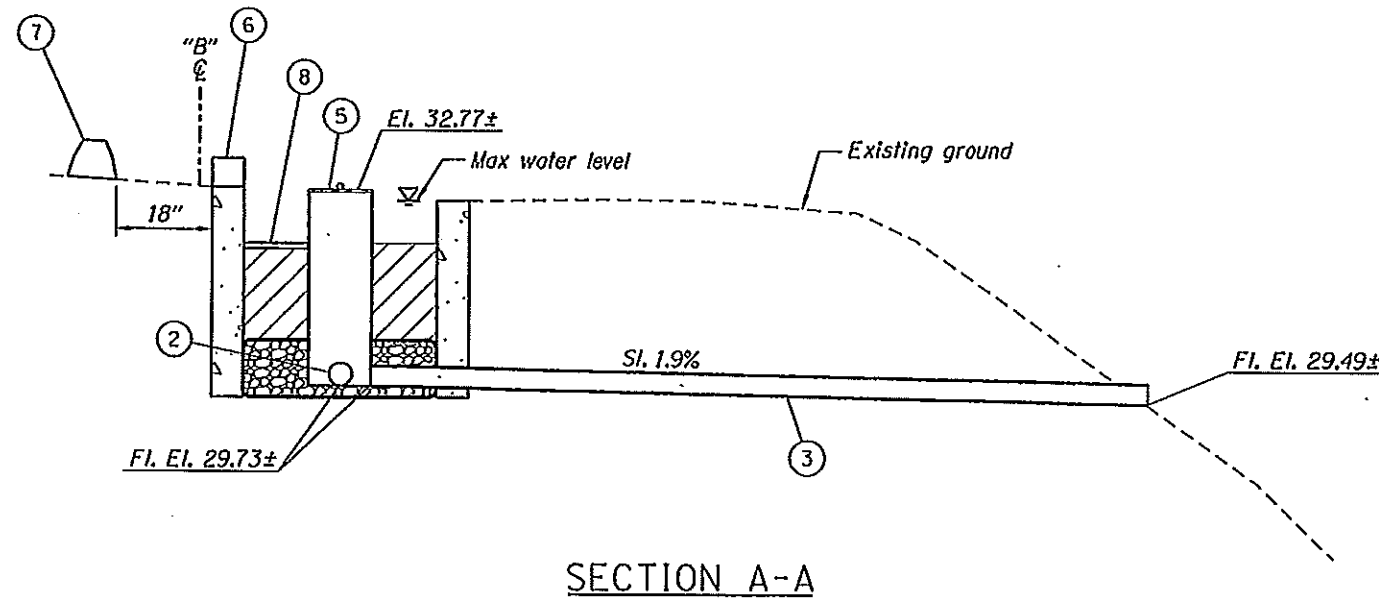

SECTION A-A


- ① Sta. "B"1+14.33 to Sta. "B"1+40.33
Construct Biofiltration Facility No. 1
Drainage Geotextile type 1 - 22.1 sq.yd.
Ecology Mix - 4.2 cu.yd.
Concrete - 3.5 cu.yd.
General excavation - 22.6 cu.yd.
Wire reinforcement - 21.0 sq.yd.
Granular drain backfill material - 2.5 cu.yd.
(For details, see sht. GJ-5)
- ② Inst. 4" perforated PVC pipe - 23'
" 5' depth
- ③ Inst. 4" non-perforated PVC pipe - 13'
5' depth
- ④ Inst. cleanout, 4" non-perforated PVC pipe
riser with screw on caps - 8'
5' depth
(For details, see sht. GJ-5)
- ⑤ Inst. 12" non-perforated PVC pipe riser
with screw on end cap - 3.5'
5' depth.
(For details, see sht. GJ-5)
- ⑥ Curb opening and curb.
(For details, see sht. GJ-5)
- ⑦ Inst. 6'-0" wheel stop - 3
(For details, see sht. GJ-5)
- ⑧ Inst. plastic splash pad 1'-0" x 1'-6"
x 1"
(For details, see sht. GJ-5)
- ⑨ Inst. plastic splash pad 1'-0" x 2'-0"
x 1"
(For details, see sht. GJ-5)
- ⑩ Sta. "B"1+14.33 to Sta. "B"1+40.36
Remove existing curb - 26'
Shown thus -
(For details, see sht. GJ-5)

NOT REVISED AS CONSTRUCTED

Gene Wilborn


Gene Wilborn

DATE 12/3/12

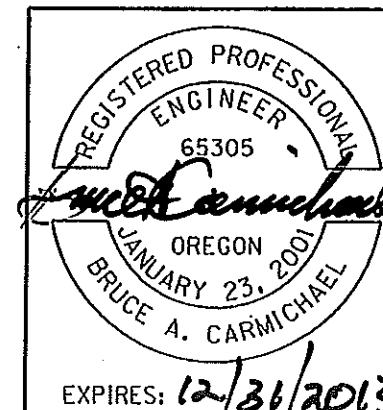

OREGON DEPARTMENT OF TRANSPORTATION	
REGION 2 TECH CENTER	
REGION 2 CULVERT IMPROVEMENTS SEC. VARIOUS HIGHWAYS CLATSOP, LINCOLN & MARION COUNTIES	
Reviewed By - Chris Corman, P.E. Designed By - Bruce Carmichael Drafted By - Michael Skelton	
STORMWATER BIOFILTRATION FACILITY NO. 1	SHEET NO. GJ-2

Sec. 8, T. 8 S., R.11 W., W.M
OREGON COAST HIGHWAY
M.P. 118.24 to 118.28

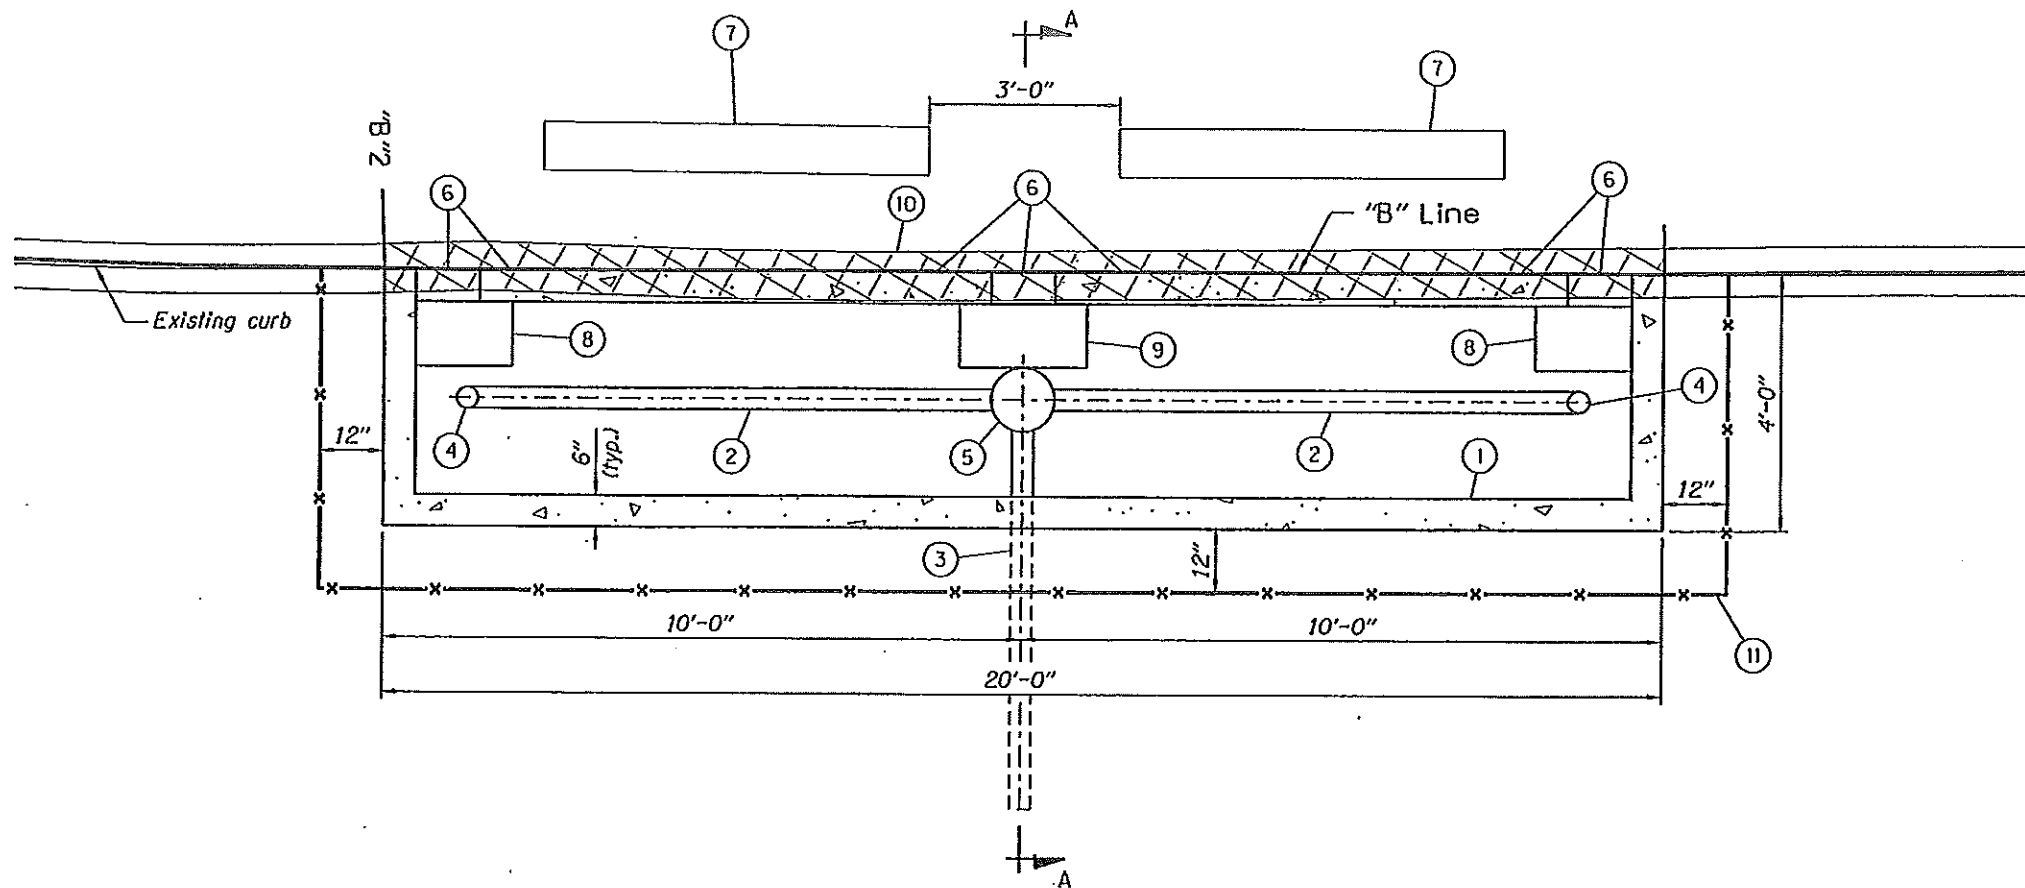

PLAN


- ① Sta. "B"2+00 to Sta. "B"2+20
Construct Biofiltration Facility No. 2
Drainage Geotextile type 1 - 17.0 sq.yd.
Ecology Mix - 3.2 cu.yd.
General excavation - 17.0 cu.yd.
Concrete - 2.5 cu.yd.
Wire reinforcement - 15.1 sq.yd.
Granular drain backfill material - 1.9 cu.yd.
(For details, see dwg. GJ-5)
- ② Inst. 4" perforated PVC pipe - 17'
5' depth
- ③ Inst. 4" non-perforated PVC pipe - 21.5'
5' depth
- ④ Inst. cleanout, 4" non-perforated PVC
pipe riser with screw on caps - 8'
5' depth
(For details, see sht. GJ-5)
- ⑤ Inst. 12" non-perforated PVC pipe riser
with screw on end cap - 3.5'
5' depth
(For details, see sht. GJ-5)
- ⑥ Curb opening and curb.
(For details, see sht. GJ-5)
- ⑦ Inst. 6'-0" wheel stop - 2
(For details, see sht. GJ-5)
- ⑧ Inst. plastic splash pad 1'-0" x 1'-6"
x 1"
(For details, see sht. GJ-5)
- ⑨ Inst. plastic splash pad 1'-0" x 2'-0"
x 1"
(For details, see sht. GJ-5)
- ⑩ Sta. "B"2+00.00 to Sta. "B"2+20.00
Remove existing curb - 20'
Shown thus -
(For details, see sht. GJ-5)
- ⑪ Install fence - 32'
(match nearby existing fence)

REVISED AS CONSTRUCTED


Gene Wilborn

 Gene Wilborn

DATE 12/3/12

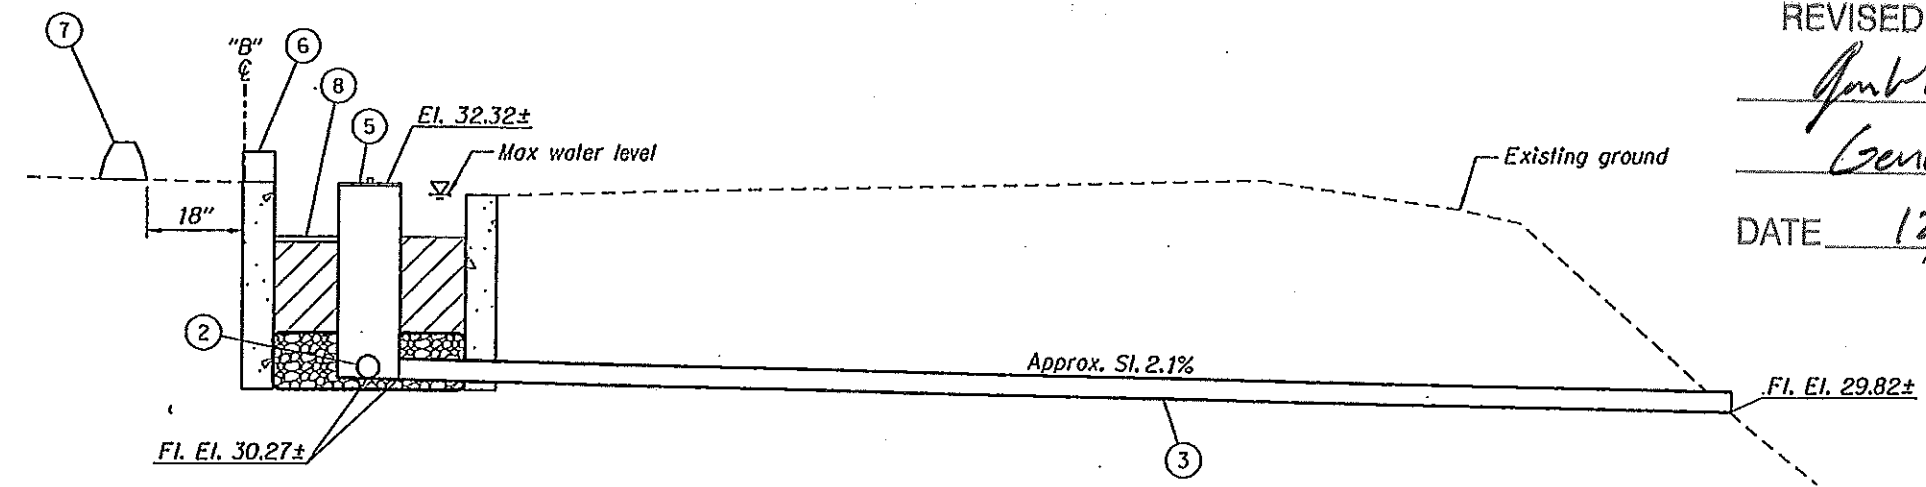


SECTION A-A

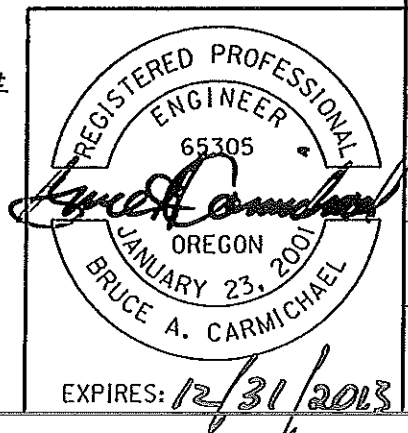


OREGON DEPARTMENT OF TRANSPORTATION	
REGION 2 TECH CENTER	
REGION 2 CULVERT IMPROVEMENTS SEC. VARIOUS HIGHWAYS CLATSOP, LINCOLN & MARION COUNTIES	
Reviewed By - Chris Carman, P.E. Designed By - Bruce Carmichael Drafted By - Michael Skelton	
STORMWATER	SHEET NO.
BIOFILTRATION FACILITY NO. 2	GJ-3

Sec. 8, T. 8 S., R.11 W., W.M
OREGON COAST HIGHWAY
M.P. 118.24 to 118.28

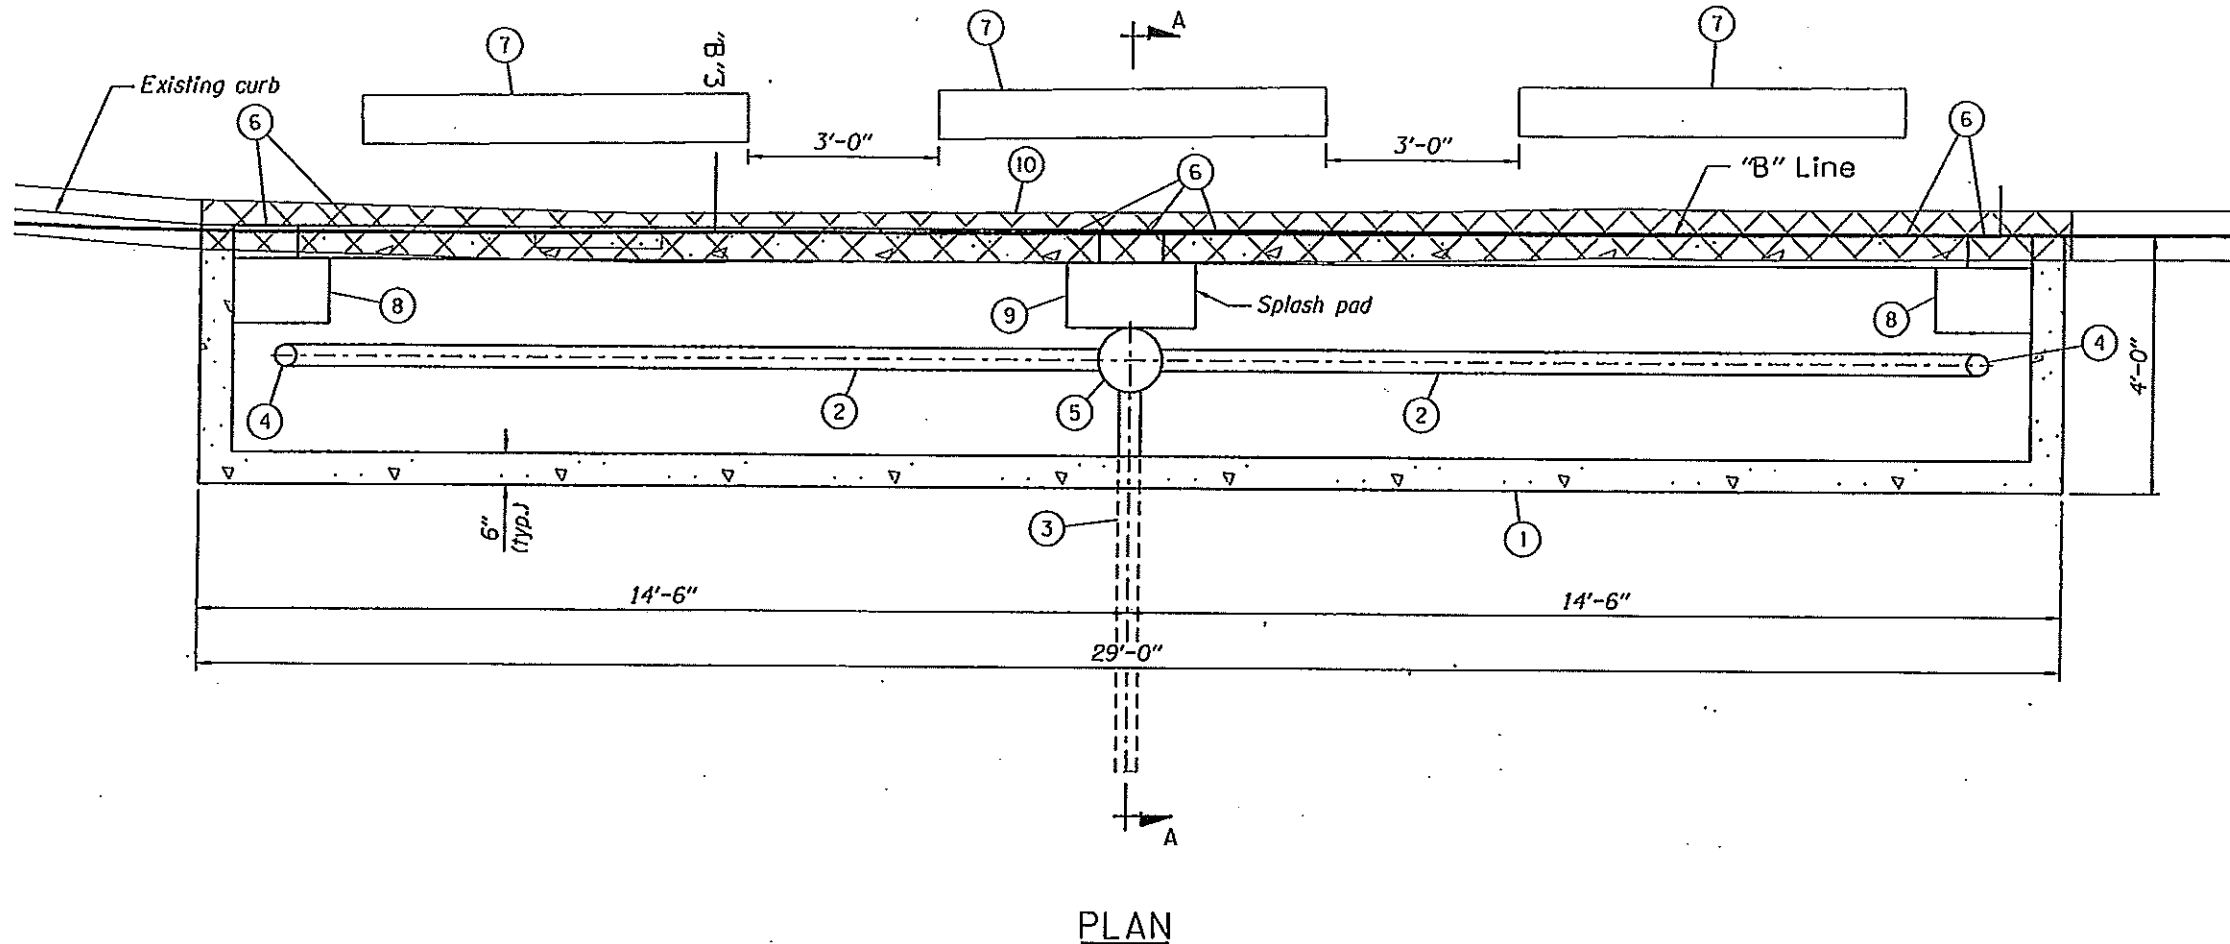


- ① Sta. "B"2+92 to Sta. "B"3+21
Construct Biofiltration Facility No. 3
Drainage Geotextile type 1 - 24.7 sq.yd.
Ecology Mix - 4.7 cu.yd.
General excavation - 25 cu.yd.
Concrete - 3.7 cu.yd.
Wire Reinforcement - 22.5 sq.yd.
Granular drain backfill material - 2.7 cu.yd.
(For details, see dwg. GJ-5)
- ② Inst. 4" perforated PVC pipe - 25'
5' depth
- ③ Inst. 4" non-perforated PVC pipe - 17.5'
5' depth
- ④ Inst. cleanout, 4" non-perforated PVC
pipe riser with screw on caps - 8'
5' depth
(For details, see sht. GJ-5)
- ⑤ Inst. 12" non-perforated PVC pipe riser
with screw on end cap - 3.5'
5' depth
(For details, see sht. GJ-5)
- ⑥ Curb opening and curb.
(For details, see sht. GJ-5)
- ⑦ Inst. 6'-0" wheel stop - 3
(For details, see sht. GJ-5)
- ⑧ Inst. plastic splash pad 1'-0" x 1'-6"
x 1"
(For details, see sht. GJ-5)
- ⑨ Inst. plastic splash pad 1'-0" x 2'-0" x 1"
(For details, see sht. GJ-5)
- ⑩ Sta. "B"2+92.00 to Sta. "B"3+21.00
Remove existing curb - 29'
Shown thus -
(For details, see sht. GJ-5)

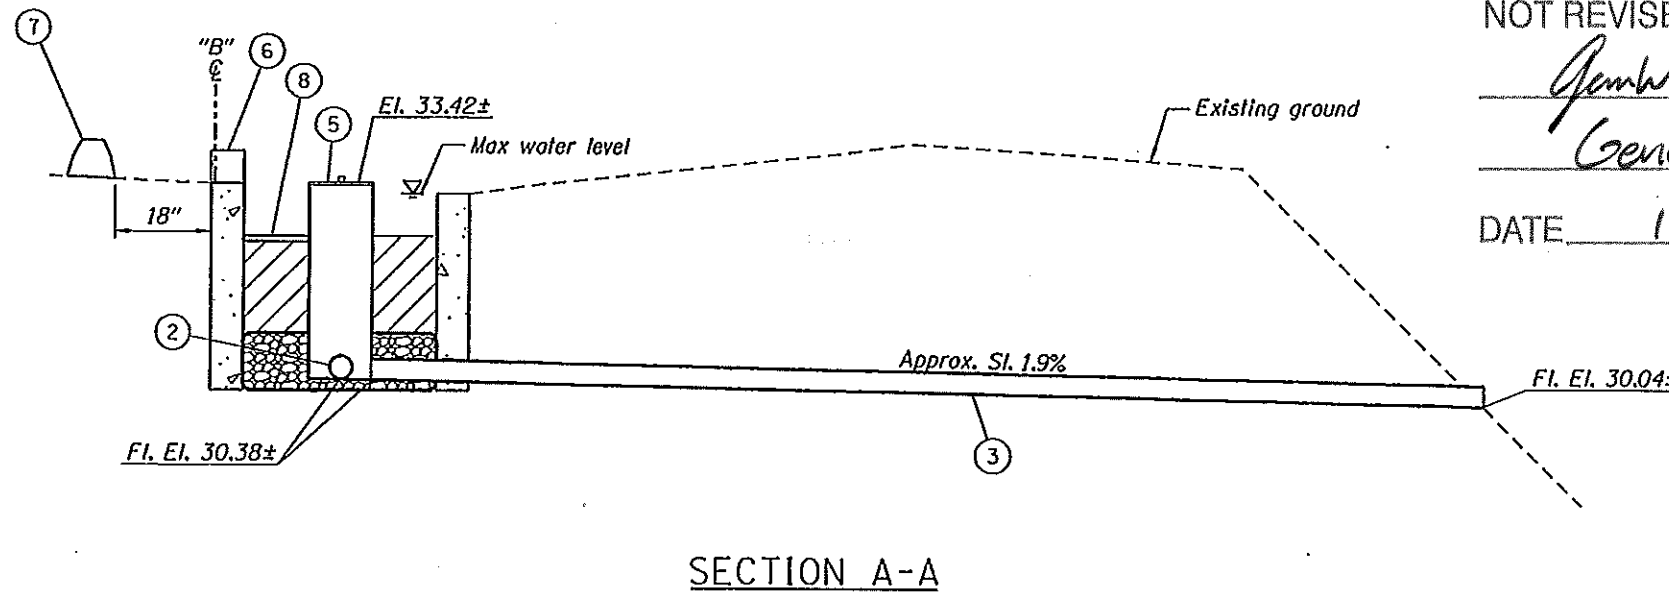

NOT REVISED AS CONSTRUCTED

Gene Wilborn
 Gene Wilborn

DATE 12/3/12

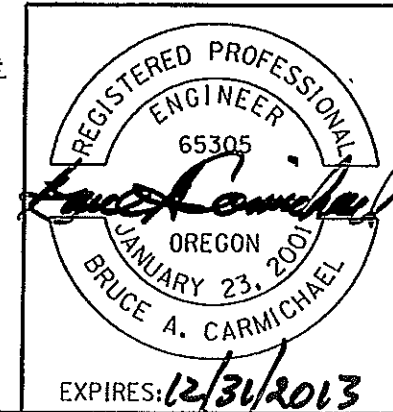

OREGON DEPARTMENT OF TRANSPORTATION	
REGION 2 TECH CENTER	
REGION 2 CULVERT IMPROVEMENTS SEC. VARIOUS HIGHWAYS CLATSOP, LINCOLN & MARION COUNTIES	
Reviewed By - Chris Cormon, P.E. Designed By - Bruce Carmichael Drafted By - Michael Skelton	
STORMWATER	SHEET NO.
BIOFILTRATION FACILITY NO. 3	GJ-4

Sec. 8, T. 8 S., R.11 W., W.M
OREGON COAST HIGHWAY
M.P. 118.24 to 118.28

NOT REVISED AS CONSTRUCTED

Gene Wilborn
Gene Wilborn


DATE 12/3/12

*FACILITY MARKER TABLE

FACILITY LOCATION		DFI NO.	TYPE S2 MARKER LOCATION		TYPE S1 MARKER	
STATION	HWY MP, OFFSET		BEGIN	END	RED	GREEN
"B"1+14.33	118.238, Rt.	D00532	✓			
"B"2+00.00	118.255, Rt.	D00533	✓			
"B"2+92.00	118.272, Rt.	D00534	✓			

* For details, see sht. GJ7


✓ Check where appropriate
Red = Beginning of facility
Green = End of facility

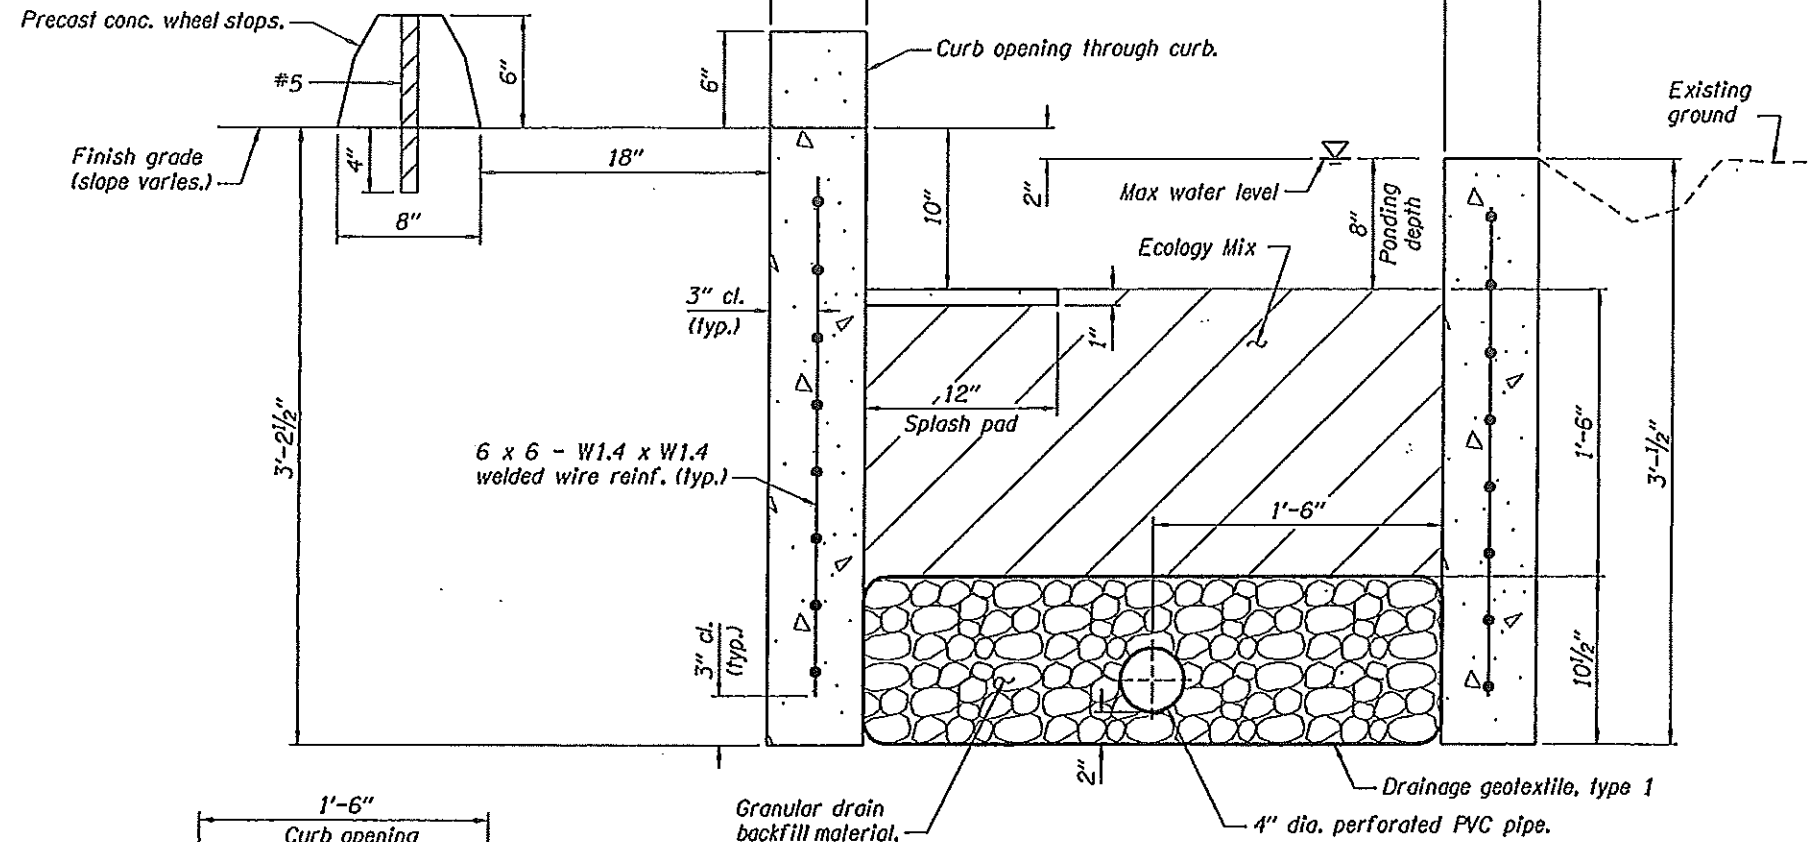


TYPICAL SECTION

Notes:

1. Drainage geotextile to completely enclose granular drain backfill material layer.
2. Fasten wheel stops in place using #5 rebar driven 4" into pavement.

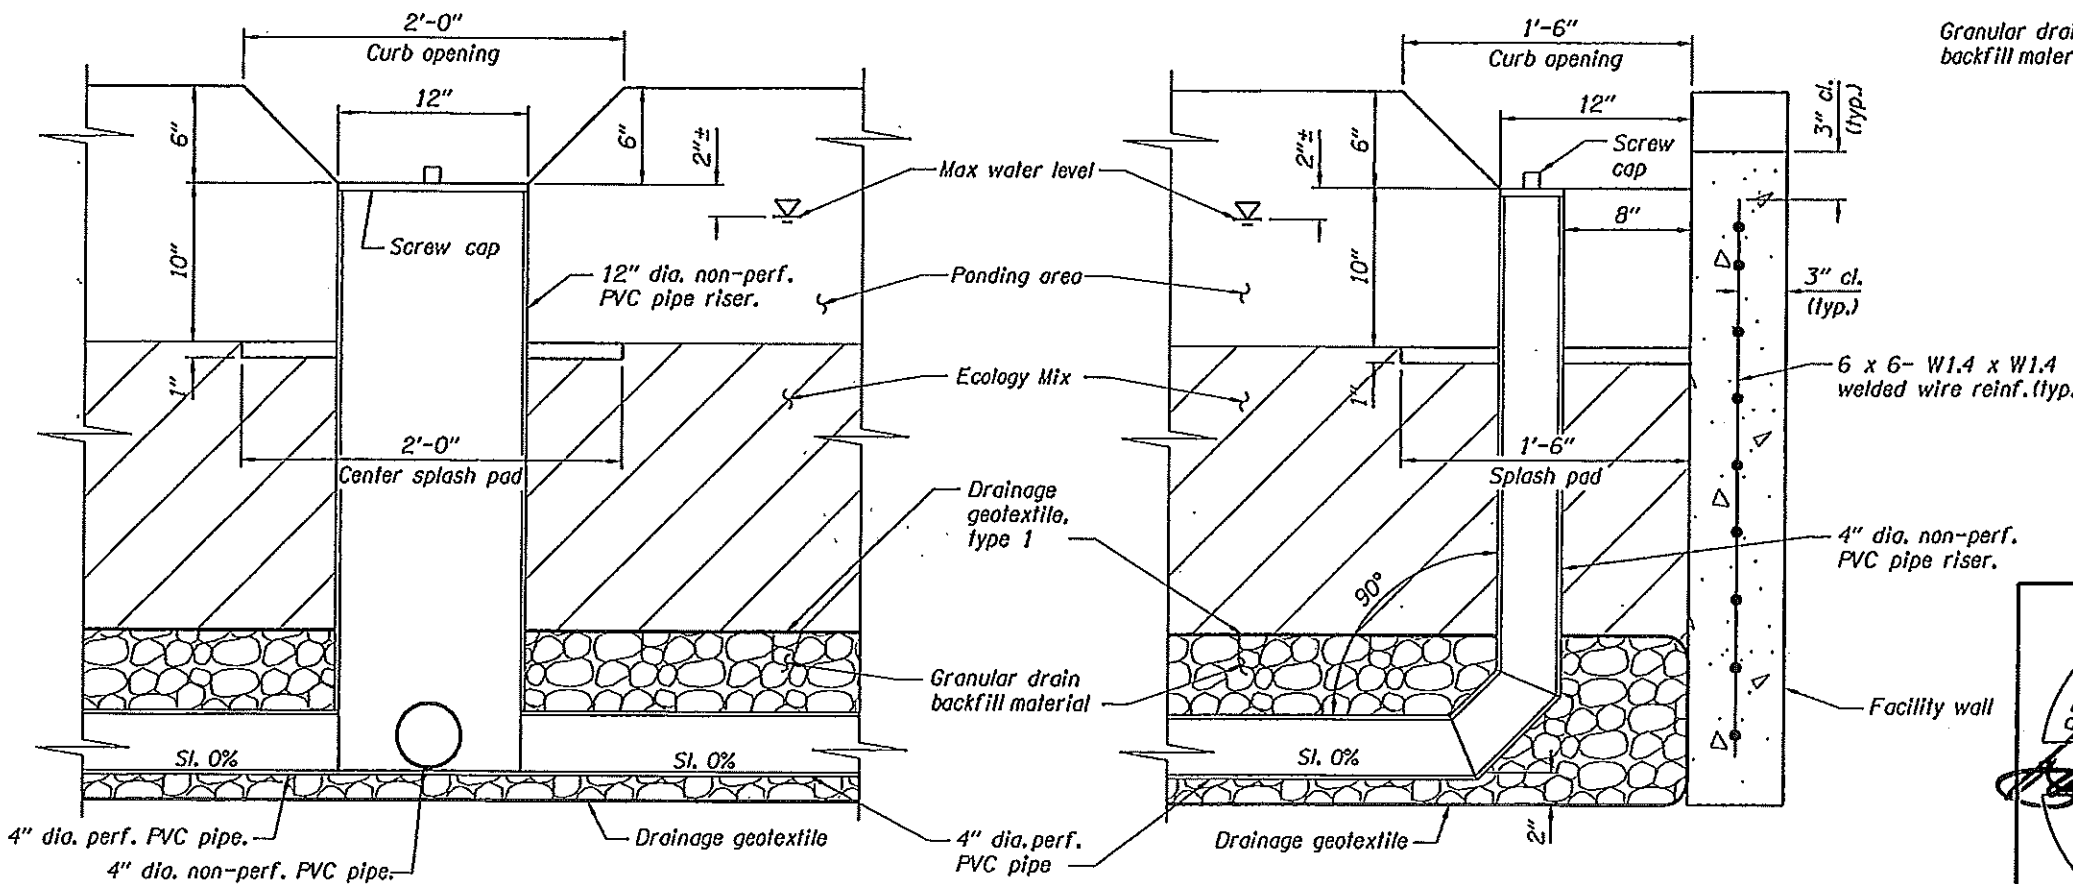

TYPICAL RISER AND CLEAN OUT DETAILS

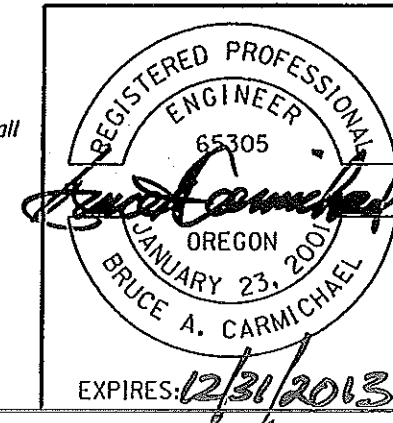

OREGON DEPARTMENT OF TRANSPORTATION	
REGION 2 TECH CENTER	
REGION 2 CULVERT IMPROVEMENTS SEC. VARIOUS HIGHWAYS CLATSOP, LINCOLN & MARION COUNTIES	
Reviewed By - Chris Corman, P.E. Designed By - Bruce Carmichael Drafted By - Michael Skelton	
STORMWATER DETAILS	SHEET NO. GJ-5


Sec. 17, T. 8 S., R. 1 W., W.M.
SILVER CREEK FALLS HIGHWAY

*FACILITY MARKER TABLE

FACILITY LOCATION		DFI #	TYPE S2 MARKER LOCATION		TYPE S1 MARKER	
STATION	MP		BEGIN	END	RED	GREEN
"L"9+09 Lt.	13.85	D00276	✓		✓	
"L"11+25 Lt.	13.89	D00276		✓		✓

* For details, see sh. GJ-7


✓ Check where appropriate
Red = Beginning of facility
Green = End of facility

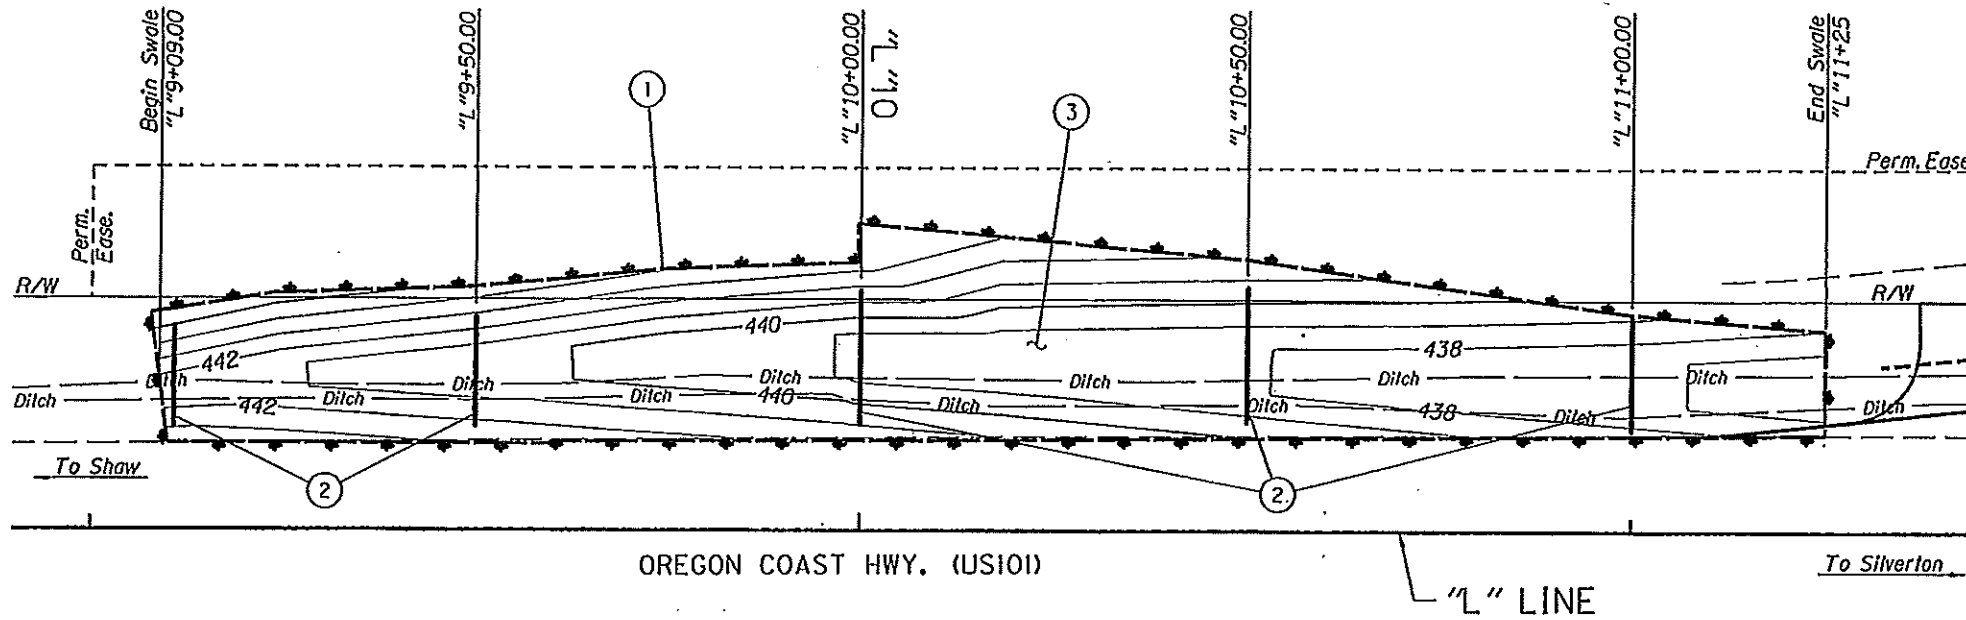


WATER QUALITY BIO-SWALE PLAN

- ① Sta. "L"9+09 Lt. to sta. "L"11+25 Lt. Const. Water Quality Bio-Swale to contours shown.
- ② Install Flow Spreaders Plastic Lumber - 30.0'
- ③ Install blended compost and topsoil mixture - 55 cu.ft.


Note:
Contact the Engineer if basalt bedrock is encountered during excavation.

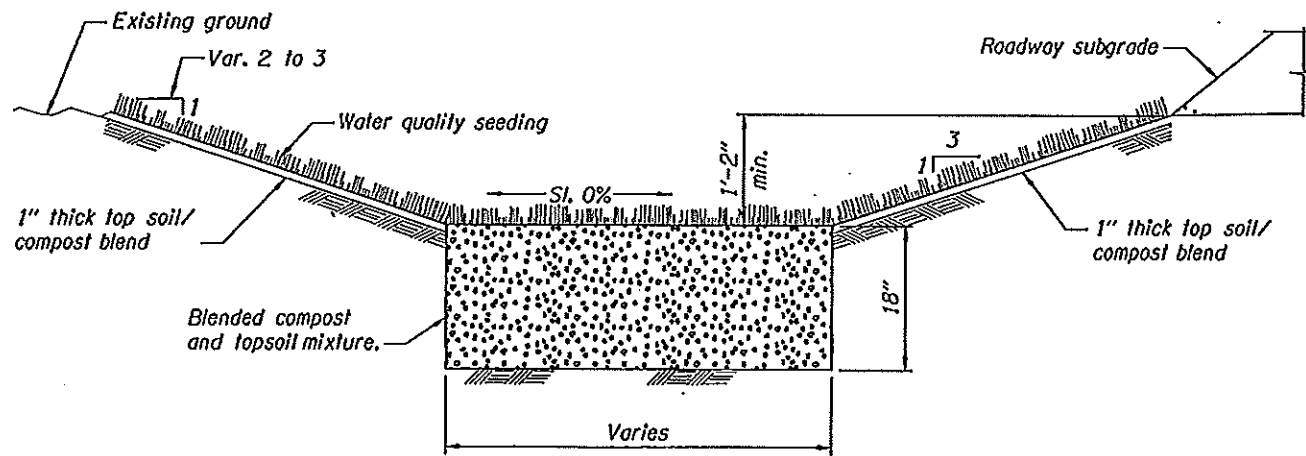

WATER QUALITY BIO-SWALE
TYPICAL SECTION

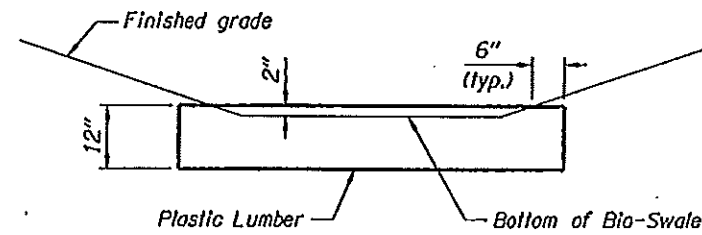

FLOW SPREADER ELEVATION

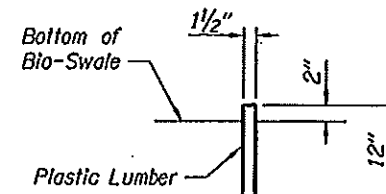

FLOW SPREADER SECTION


BIO-SWALE TABLE

Station "L" (Left)	Channel Bottom Elev. (ft.)	Channel Bottom Width (ft.)
9+09	441.57	2.4
9+25	441.08	3.0
9+50	440.42	4.0
9+75	439.58	5.0
10+00	438.91	6.0
10+25	438.54	6.0
10+50	438.05	6.0
10+75	437.64	6.0
11+00	437.18	6.0
11+25	436.56	2.0

NOT REVISED AS CONSTRUCTED

Gene Wilborn
Gene Wilborn

DATE 12/3/12

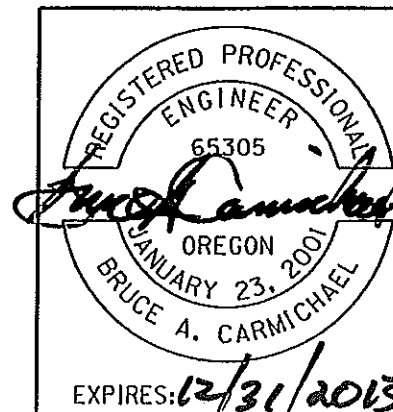

OREGON DEPARTMENT OF TRANSPORTATION


REGION 2 TECH CENTER

REGION 2 CULVERT IMPROVEMENTS SEC. VARIOUS HIGHWAYS
CLATSOP, LINCOLN & MARION COUNTIES


Reviewed By - Chris Cormon, P.E.
Designed By - Bruce Carmichael
Drafted By - Michael Skelton

STORMWATER PLAN AND ELEVATION

SHEET NO. GJ-6

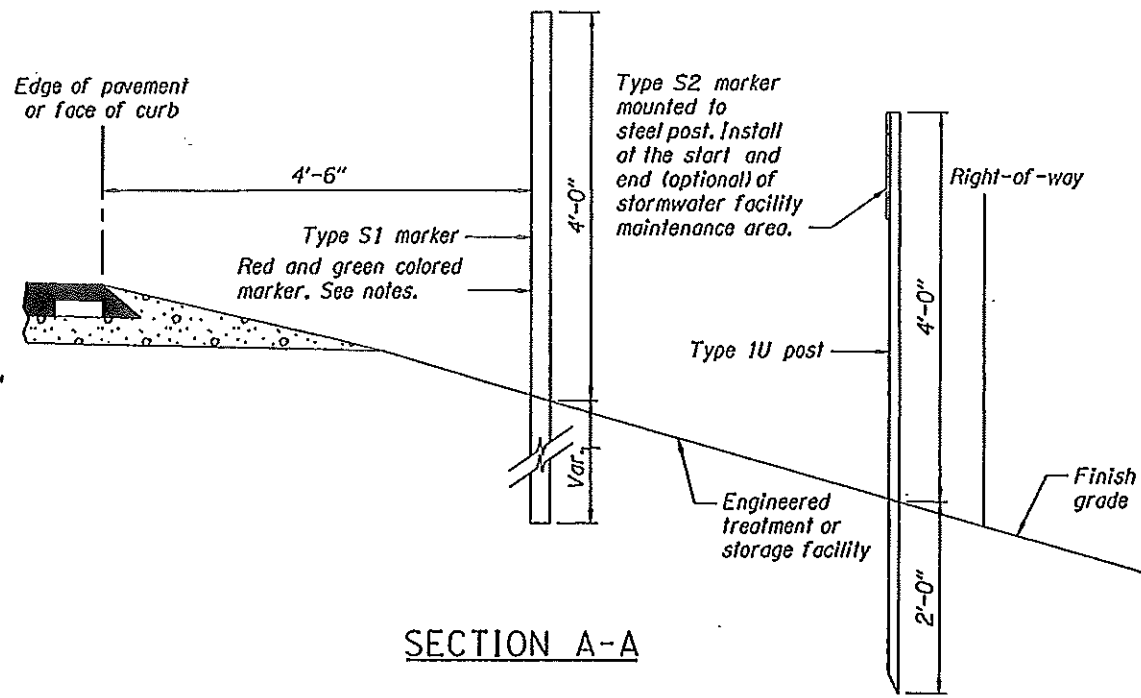

SECTION A-A

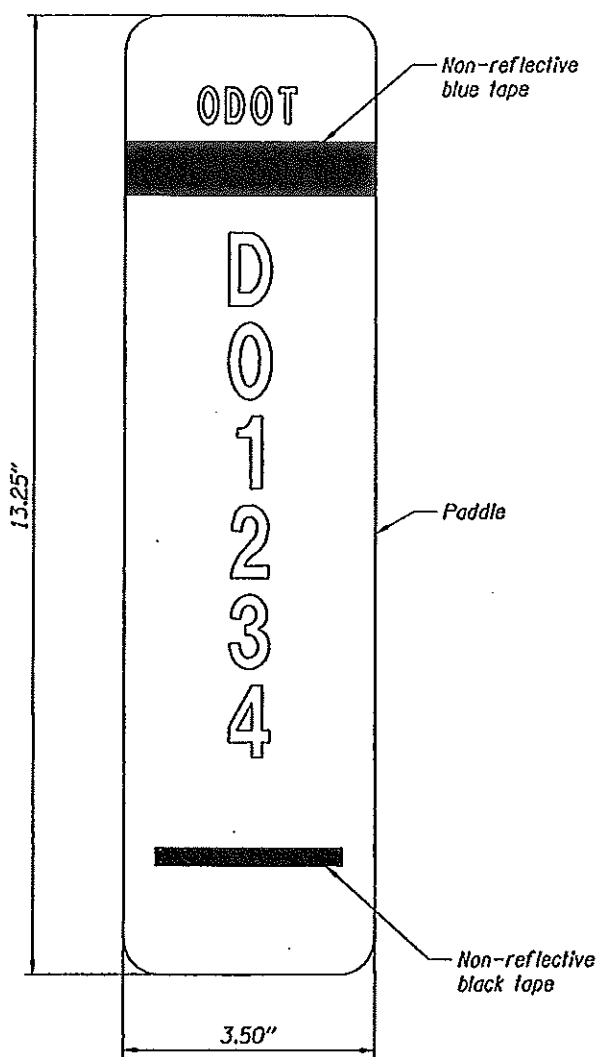

TYPE S2 MARKER

NOT REVISED AS CONSTRUCTED

Gene Wilborn
Gene Wilborn

DATE 12/3/12

NOTES:


- Stormwater Facility Field Marker Type S1:
1. See dwg. TM570 for Type 2 flexible plastic post dimensions. Do not mount reflective sheeting to flexible plastic post.
 2. A red Type S1 marker is used to mark the start of a stormwater facility maintenance area. A green Type S1 marker is used to mark the end of a stormwater facility maintenance area.
 3. Place 4 to 6 feet from edge of pavement or face of curb.
 4. See marker table for installation locations.

Stormwater Facility Field Marker Type S2:


1. Paddle:
 - Aluminum sheet, nominal thickness 0.050"
 - White non-reflective background
 - Mount paddle to one (1) Type 1U steel post using 3/16" diameter aluminum blind rivets and washers. See dwg. TM 570 detail labeled "Steel Posts" for mounting a traffic target. Install paddle onto Type 1U steel post using the same hole pattern.
 - Text and numbers are Type C font in non-reflectORIZED black
 - Band is non-reflective blue tape
 - Do not mount paddle to other highway signing posts
 - Install paddle parallel to travel lane
 - Prepare paddle for each "DFI" noted in the marker table
2. Steel Posts:
 - See dwg. TM571 for Type 1U steel post dimensions

Stormwater Facility Field Marker Type S3:


1. The top of access or manhole cover shall be stamped with the drainage facility ID. Ink stamping ID is not allowed.

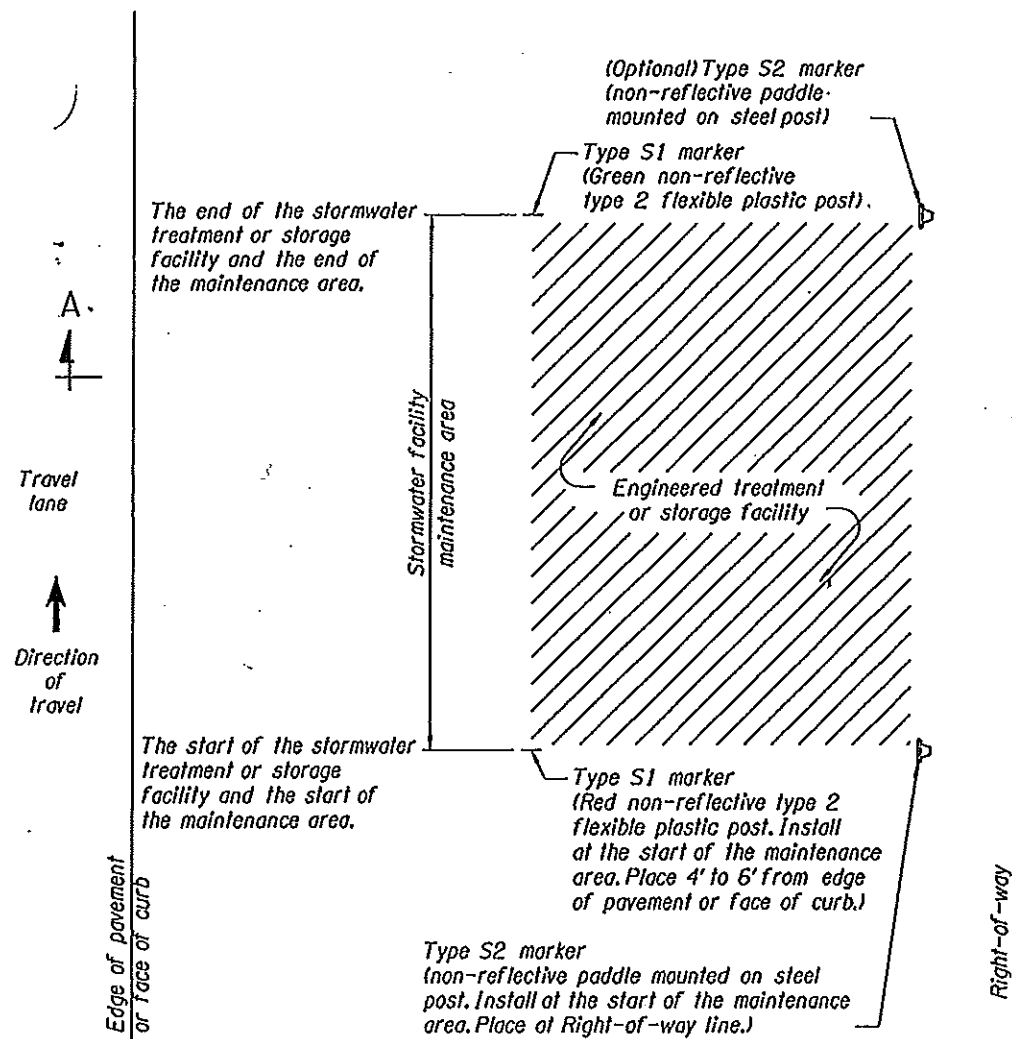

TYPE S1 & S2 MARKERS INSTALLATION DETAIL

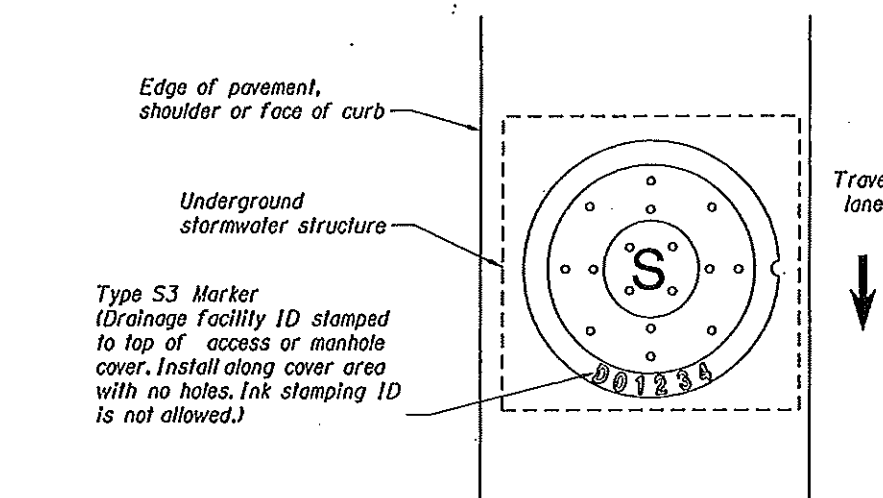

TYPE S3 MARKER INSTALLATION DETAIL

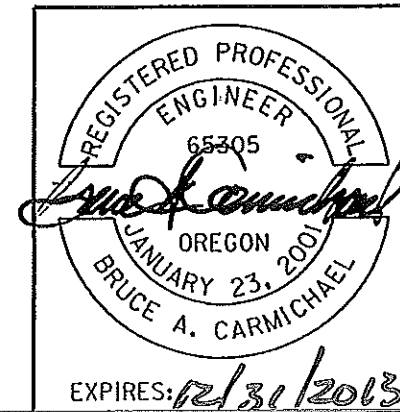

OREGON DEPARTMENT OF TRANSPORTATION	
REGION 2 TECH CENTER	
REGION 2 CULVERT IMPROVEMENTS SEC. VARIOUS HIGHWAYS CLATSOP, LINCOLN & MARION COUNTIES	
Reviewed By - Chris Carman, P.E. Designed By - Bruce Carmichael Drafted By - Michael Skelton	
STORMWATER FACILITY MARKERS	SHEET NO. GJ-7