

OPERATION & MAINTENANCE MANUAL

Infiltration Slope

Manual prepared: March 2019

DFI No. D00539



Figure 1: DFI No. D00539, Looking East

1. Identification

Drainage Facility ID (DFI): D00539
Facility Type: Infiltration Slope
Construction Drawings: (V-File Numbers) 44V-028
Location: District: 2B
Highway No.: 002
Mile Post: 16.59 to 16.84,
I-84 East & Marine Drive Exit

2. Manual Purpose

The purpose of this manual is to outline inspection needs and summarize maintenance actions.

3. Facility Location

The location map below details the facility location. The highway, mile posts, side streets, access location, and stormwater flow directions are noted on the map. **NOTE: Mile posts are based off of the V-File, and may vary from TransGIS mile posts.**

Facility location type: Roadway shoulder

Flow direction: Varies, Infiltration Slope

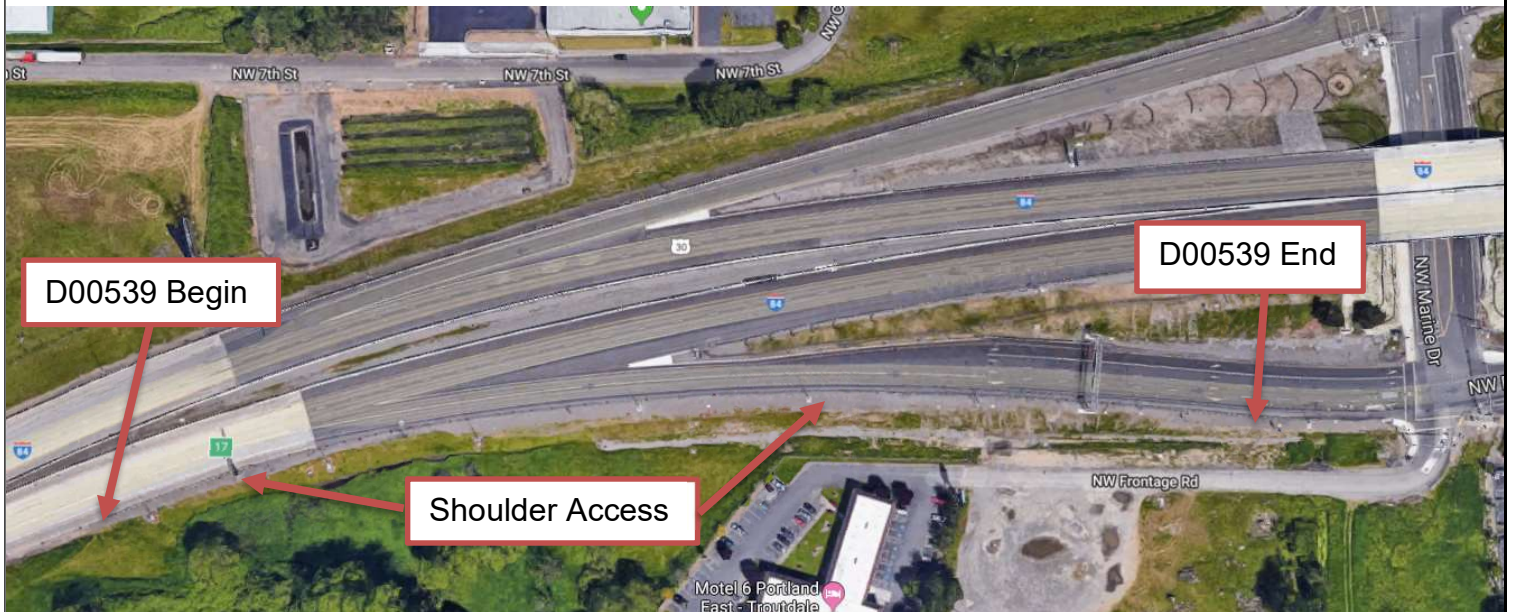



Figure 2: NW Frontage Rd. D00539

4. Facility Summary

The width is measured perpendicular to the edge of pavement and is equivalent to the flow length. The length is measured parallel to the edge of pavement and is equivalent to the length of the contributing impervious area.

The length and width of the applicable facility components are:

Component	Length (feet)	Width (feet)
Infiltration Slope		
“L4E” 455+91 to 459+70	379	2
“EB” 459+71 to 470+03	1032	4

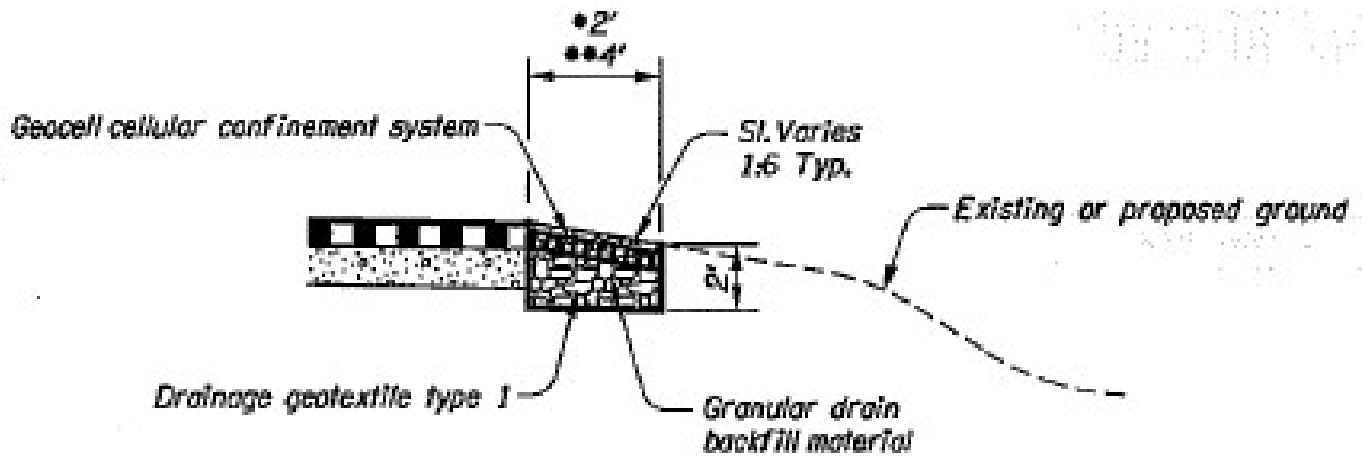

- Sta. "L4E" 455+91.80 to Sta. "L4E" 459+70.00
- Sta. "EB" 459+71.35 to Sta. "EB" 470+03.60

INFILTRATION SLOPE TYPE A

Figure 3: Infiltration Slope Section

Site Specific Information: Traveling I-84 East the infiltration swale begins on the outside shoulder roadside embankment just past the Union Pacific R.R. and continues down the Marine Dr. Exit ramp. The infiltration facility is similar to a Bioslope but all stormwater infiltrates to the ground. It is long and linearly constructed into the existing slope. The treatment is provided and pollutants are removed by infiltration processes. The water is stored in the voids in the trench gravels until it percolates into the surrounding soil. There are no subsurface drain pipes in this facility.

5. Facility Access

Maintenance access to the facility:

<input type="checkbox"/> Roadside pad	<input checked="" type="checkbox"/> Roadside shoulder
<input type="checkbox"/> Access road with Gate	<input type="checkbox"/> Access road without Gate

Note: There is an existing NW Frontage road that could potentially be used for access and staging just past the motel.



Figure 3: Looking east at Infiltration Slope

6. Operational Components / Maintenance Items

Classification and Standard Operational (Op) Plan:

This facility is classified as a:

<input type="checkbox"/> Filter Strip (Op Plan A)	<input checked="" type="checkbox"/> Bioslope (Infiltration Slope) (Op Plan B)
<p>A filter strip consists of a vegetated or media slope located parallel to the edge of pavement. It maintains sheet flow of stormwater runoff over the width of the strip.</p>	<p>A bioslope consists of a filter strip and treatment zone. It is a flow-through stormwater treatment facility located along roadside embankments.</p>
<p>A standard operational plan illustrates the general facility footprint configuration and explains the purpose of each facility component. Operational plans (A, B) are provided in the Standard Operation Manual.</p>	

See Appendix A for the site specific operational plan.

Operational Components

Filter strips and bioslopes have many components that assist with treatment, conveyance, and infiltration of stormwater runoff. The components in use can vary depending on the facility design. The facility components table (Table 1) has been provided to highlight the applicable components for this facility. The component is in use when the box contains an “x” (e.g.).

The Standard Operation Manual for Water Quality Filter Strips and Bioslopes (implemented March 2017) outlines facility operation, typical footprint configuration, and component definitions and details. A link to the manual is attached to the feature marker in TransGIS.

<https://gis.odot.state.or.us/TransGIS/>

Maintenance Items

Operational components marked in Table 1 should be inspected and maintained according to Section 7. Each facility component is defined and detailed in the Standard Operation Manual using the associated ID number indicated below.

Table 1: Bioslope/Infiltration Slope/Filter/Strip Components		ID #
Facility Inlet		
Pavement Sheet Flow	<input checked="" type="checkbox"/>	B1
Flow Spreader	<input type="checkbox"/>	B2
Ground Cover		
Vegetated Slope	<input type="checkbox"/>	B3
Aggregate Media Slope	<input checked="" type="checkbox"/>	B4
Underground Components		
Water Quality Mix	<input type="checkbox"/>	B5
Ecology Mix	<input type="checkbox"/>	B6
Granular Drain Backfill Material	<input checked="" type="checkbox"/>	B7
Geotextile Fabric	<input checked="" type="checkbox"/>	B8
Geocell Grid	<input checked="" type="checkbox"/>	B9
Structures		
Curb/Berm	<input type="checkbox"/>	B10
Check Dam	<input type="checkbox"/>	B11
Cleanout	<input type="checkbox"/>	B12
Facility Outlet		
Perforated Drain Pipe	<input type="checkbox"/>	B13
Open Slope Outlet	<input type="checkbox"/>	B14
Open Channel Outlet	<input type="checkbox"/>	B15
Storm Drain Outlet Pipe	<input type="checkbox"/>	B16
Other: Infiltration Slope	<input checked="" type="checkbox"/>	B17
Outfall Type		
Waterbody (Creek/Lake/Ocean)	<input type="checkbox"/> C	B18
	<input type="checkbox"/> L	
	<input type="checkbox"/> O	
Outfall Channel	<input type="checkbox"/>	B19
Storm Drain System	<input type="checkbox"/>	B20
Outfall Components		
Pervious Berm	<input type="checkbox"/>	B21
Riprap Pad	<input type="checkbox"/>	B22

7. Maintenance

Maintenance Frequency/Maintain Records

- a. Inspect annually. Preferably prior to the rainy season.
- b. Clean and maintain as necessary. Refer to Activity 125 for conditions when maintenance is needed.
- c. Keep a record of inspections, maintenance, and repairs.

Maintenance Guide/Maintenance Actions

The ODOT Routine Road Maintenance Water Quality and Habitat Guide (the *Blue Book*) outlines the standard maintenance actions for water quality facilities under Activity 125.

There are standard maintenance tables for standard ODOT designs. The maintenance tables describe the maintenance component, the defect or problem, the condition when maintenance is needed, and the recommended maintenance to correct the problem. Use the following tables to maintain ODOT filter strips and bioslopes:

- Table 1 (General Maintenance): Contains general maintenance and inspection guidelines that are applicable to all ODOT water quality facilities
- Table 4 (Water Quality Filter Strips)
- Table 5 (Water Quality Bioslopes)

The ODOT Maintenance Guide can be viewed at the following website:

<http://www.oregon.gov/ODOT/HWY/OOM/pages/mguide.aspx>

The *Blue Book* can be viewed at the following website:

http://www.oregon.gov/ODOT/Maintenance/Documents/blue_book.pdf

8. Limitations

Filter strips, bioslopes and infiltration slopes are NOT designed to allow the use of heavy equipment. Vehicles entering the facility can create depressions (tire ruts), damage vegetation, and damage structural components (e.g. flow spreaders). These conditions may result in poor treatment and drainage performance.

9. Waste Material Handling

Material removed from the facility is defined as waste by the Department of Environmental Quality (DEQ). Refer to the road waste section of the ODOT Maintenance Yard Environmental Management System (EMS) Policy and Procedures Manual for disposal options:

<http://www.oregon.gov/ODOT/HWY/OOM/pages/ems.aspx>


Contact any of the following for more detailed information about management of waste materials found on site:

ODOT Clean Water Unit	(503) 986-3008
ODOT Statewide Hazmat Coordinator	(503) 667-7442
ODOT Region 1 Hazmat Coordinator	(503) 731-8290
ODOT Region 2 Hazmat Coordinator	(503) 986-2647
ODOT Region 3 Hazmat Coordinator	(541) 957-3594
ODOT Region 4 Hazmat Coordinator	(541) 388-6186
ODOT Region 5 Hazmat Coordinator	(541) 963-1590
ODEQ Northwest Region Office	(503) 229-5263

A Appendix A – Site Specific Operational Plan

Contents:

Operational Plan: DFI D00539

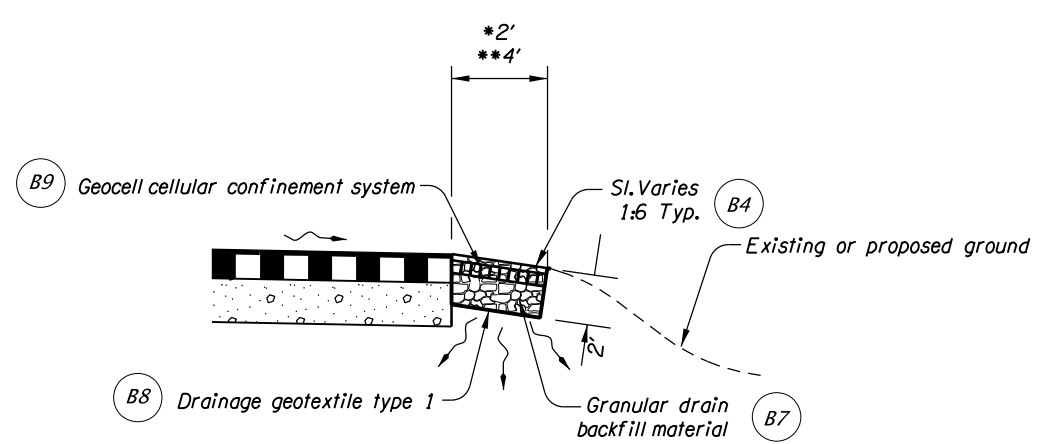

*Sta. "L4E" 455+91.80 to Sta. "L4E" 459+70.00
 **Sta. "EB" 459+71.35 to Sta. "EB" 470+03.60

INFILTRATION SLOPE TYPE A

TYPICAL SECTION
 N.T.S.

- LEGEND:
- (X#) Facility Component (see table 1 in O&M Manual)
 - and ○ Manhole
 - and □ Inlet
 - Storm Pipe (Facility)
 - Storm Pipe
 - ← Conveyance Direction
 - ~ Pavement / Facility Flow Path
 - ⇐ Traffic Flow Direction


Sht. 1 of 3

Prepared By:
 Alan Babicky

Drafted By:
 Alan Babicky



DFI D00539
MAINTENANCE DISTRICT 2B HWY 002
INFILTRATION SLOPE
 HIGHWAY MP 16.59 - 16.84
 MULTNOMAH COUNTY

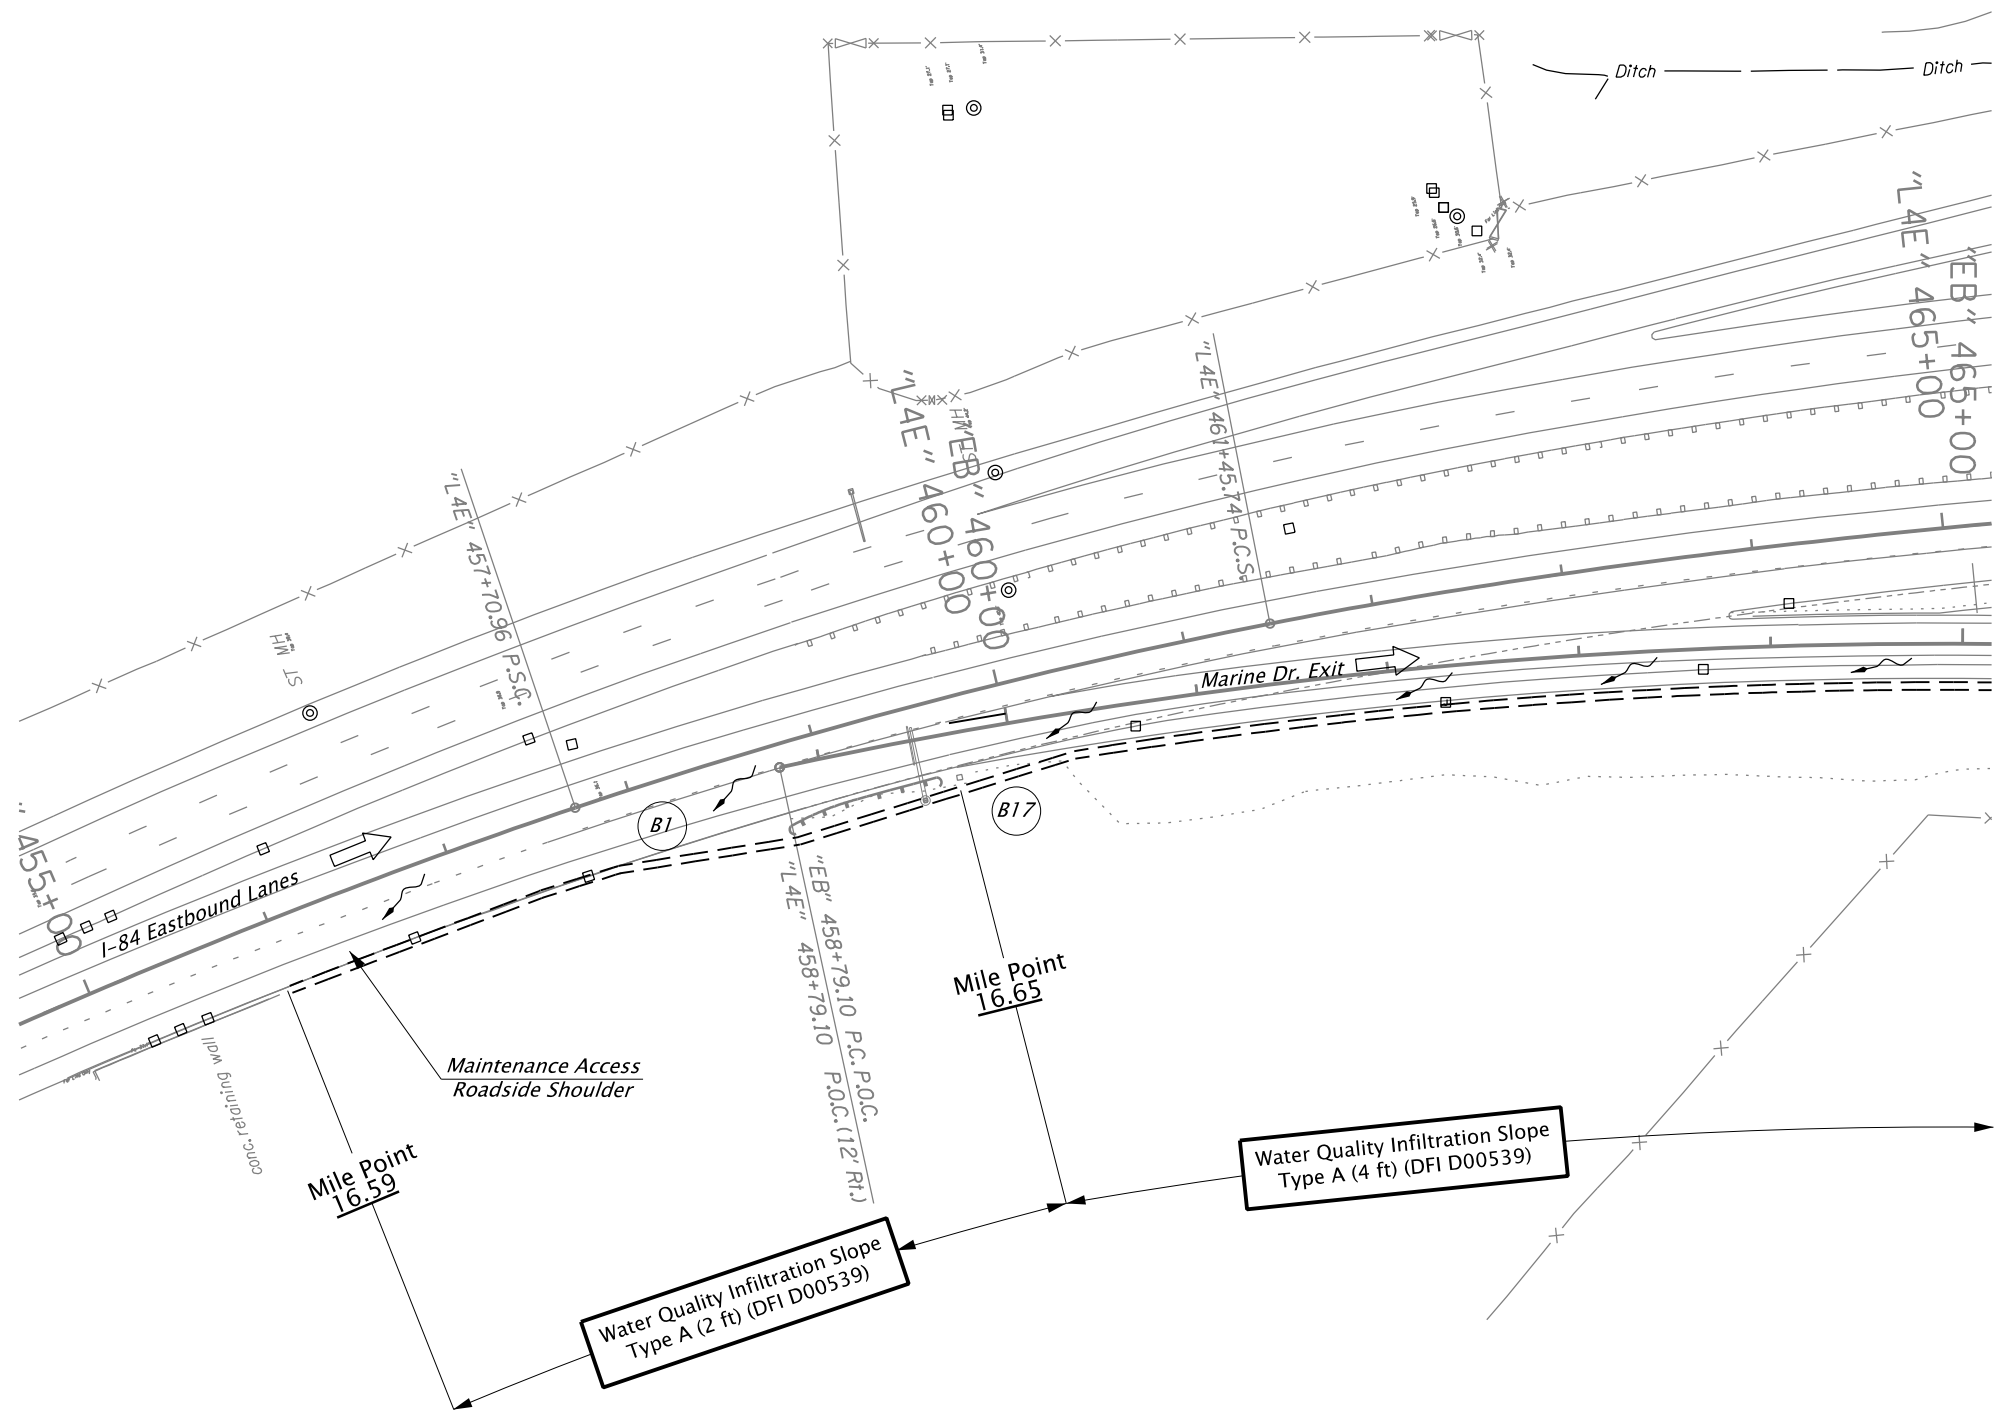

- LEGEND:**
- (X#) Facility Component (see table 1 in O&M Manual)
 - and ○ Manhole
 - and □ Inlet
 - Storm Pipe (Facility)
 - - - Storm Pipe
 - ← Conveyance Direction
 - ~ Pavement / Facility Flow Path
 - ⇐ Traffic Flow Direction

PLAN
N.T.S.




Sht. 2 of 3

Prepared By:
Alan Babicky

Drafted By:
Alan Babicky

DFI D00539
MAINTENANCE DISTRICT 2B HWY 002
INFILTRATION SLOPE
 HIGHWAY MP 16.59 - 16.84
 MULTNOMAH COUNTY

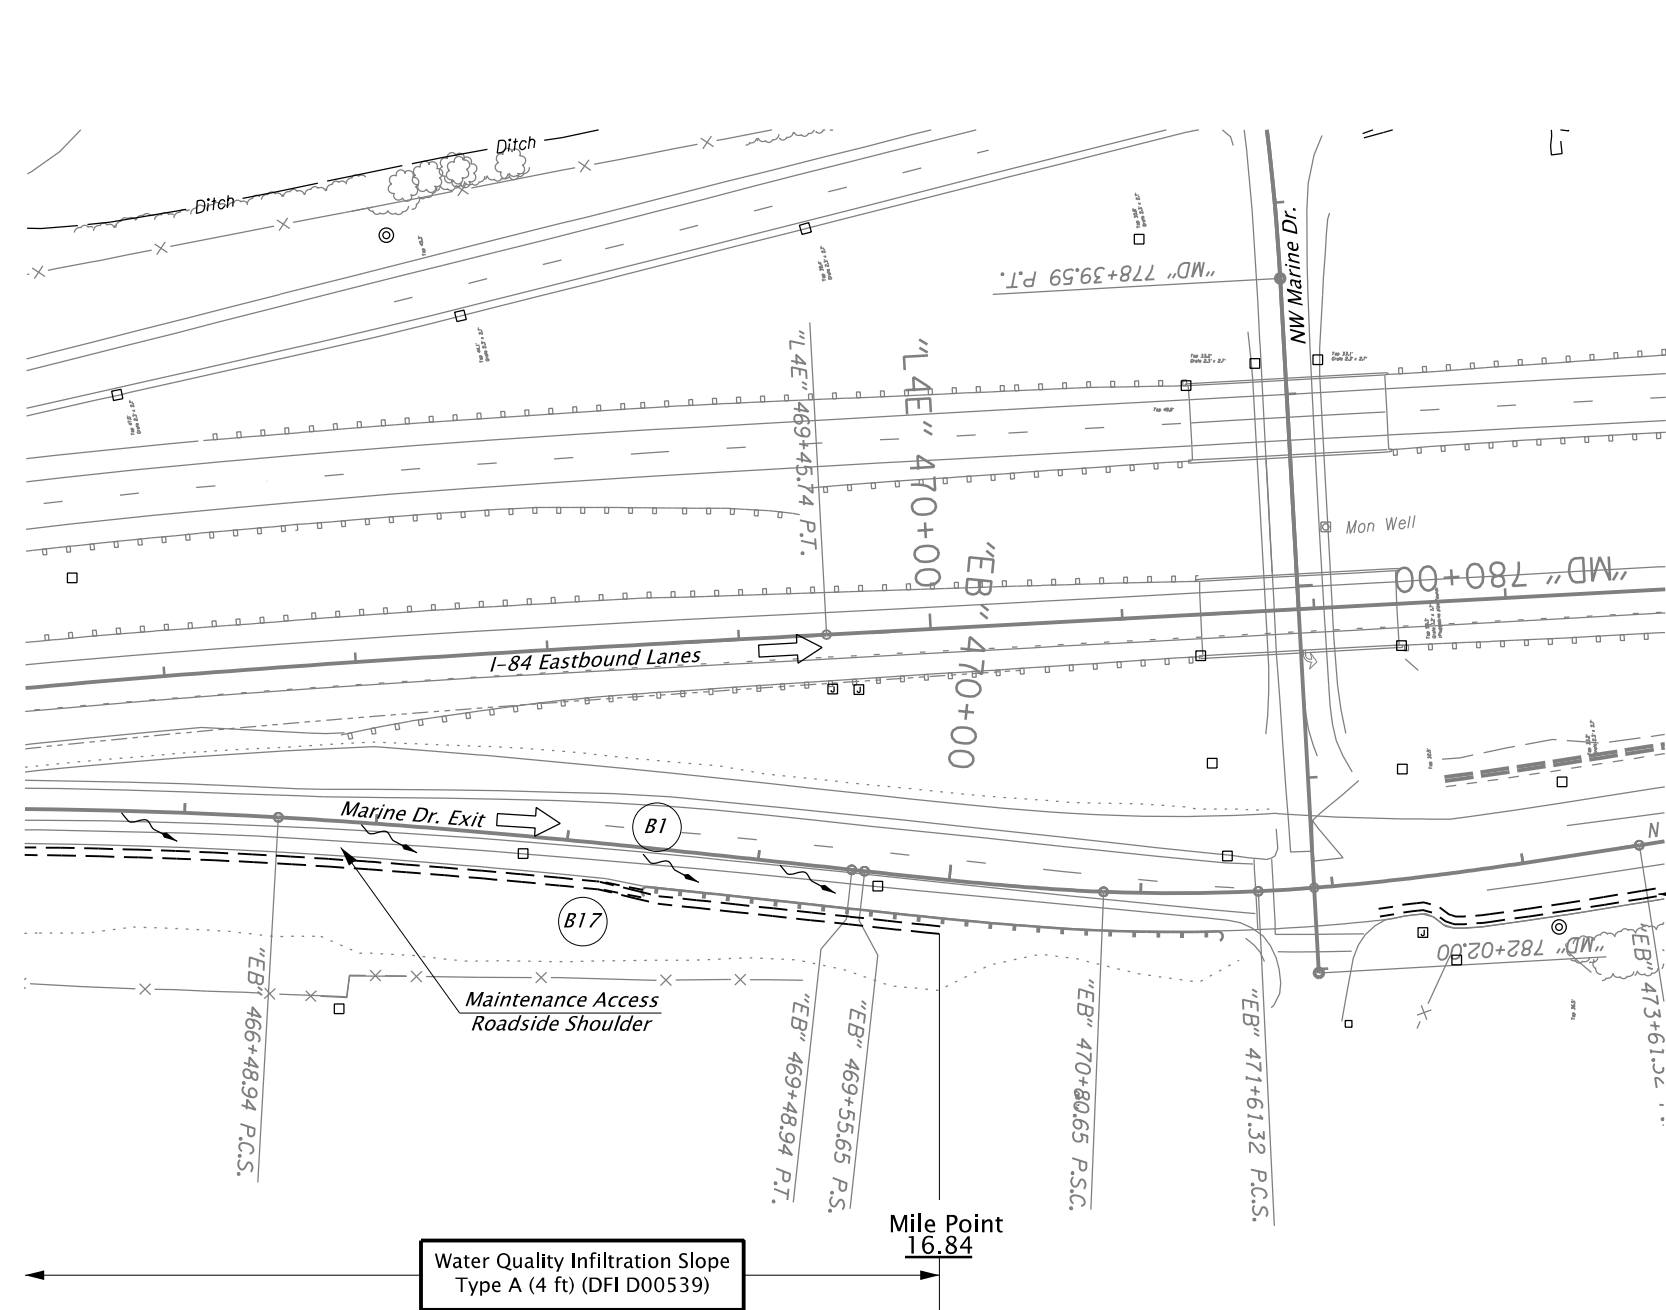

- LEGEND:**
- X# Facility Component (see table 1 in O&M Manual)
 - and Manhole
 - and Inlet
 - Storm Pipe (Facility)
 - Storm Pipe
 - Conveyance Direction
 - Pavement / Facility Flow Path
 - ← Traffic Flow Direction

Water Quality Infiltration Slope
Type A (4 ft) (DFI D00539)

Mile Point
16.84

PLAN
N.T.S.



OREGON DEPARTMENT
OF TRANSPORTATION

Sht. 3 of 3

Prepared By:
Alan Babicky

Drafted By:
Alan Babicky

DFI D00539
MAINTENANCE DISTRICT 2B HWY 002
INFILTRATION SLOPE
HIGHWAY MP 16.59 - 16.84
MULTNOMAH COUNTY

B Appendix B – Project Contract Plans

Contents:

Site Specific Subset of Project Contract Plan 44V-028

INDEX OF SHEETS	
SHEET NO.	DESCRIPTION
1	Title Sheet
1A	Index Of Sheets Cont'd. & Std. Drg. Nos.
1B	Std. Drg. Nos. Cont'd.

STATE OF OREGON
DEPARTMENT OF TRANSPORTATION

PLANS FOR PROPOSED PROJECT

GRADING, DRAINAGE, PAVING, PAVEMENT MARKERS, SIGNING,
ILLUMINATION, SIGNALS & ROADSIDE DEVELOPMENT

I-84 AT 257TH AVE (TROUTDALE INTERCHANGE) SEC.
COLUMBIA RIVER HIGHWAY

MULTNOMAH COUNTY

MARCH 2011

**BEGINNING OF
CONTRACT PROJECT**



STA. "RW" 317+09 (M.P. 13.96)

"AS CONSTRUCTED"

Mark Beem
Date 4-26-12 Project Mgr


END OF PROJECT

STA. "XB" 36+38.20 =
STA. "RW" 501+60.55 (M.P. 17.44)

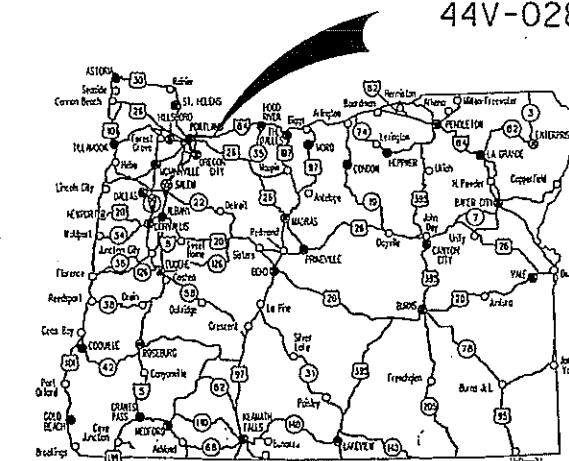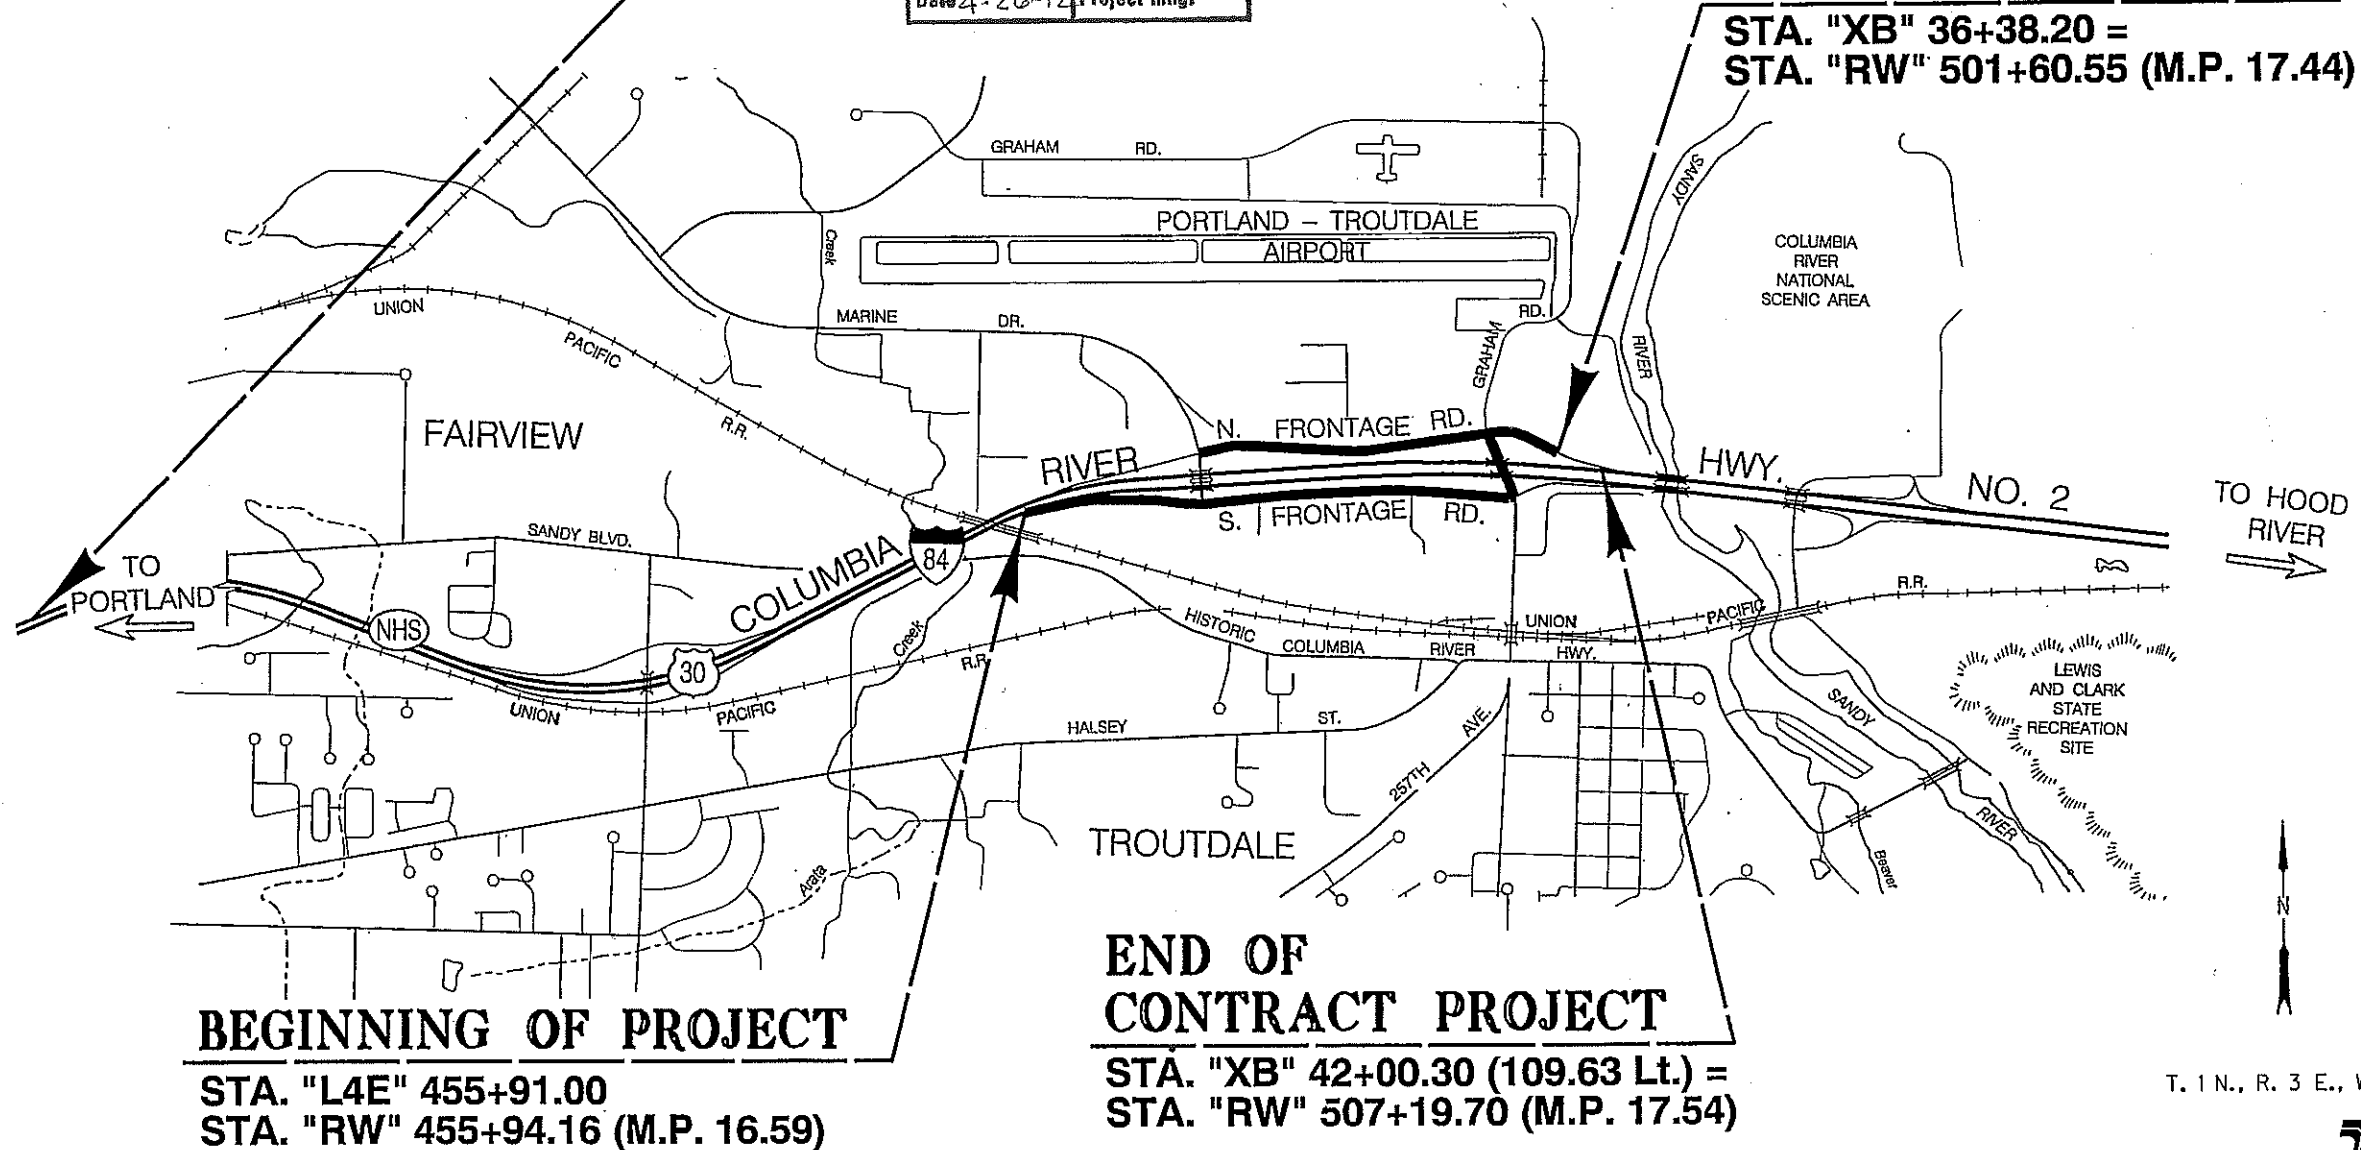

Overall Length Of Project - 0.85 Miles

ATTENTION:
Oregon Law Requires You To Follow Rules Adopted By The Oregon Utility Notification Center. Those Rules Are Set Forth In OAR 952-001-0010 Through OAR 952-001-0090. You May Obtain Copies Of The Rules By Calling The Center. (Note: The Telephone Number For The Oregon Utility Center Is (503) 232-1987.)

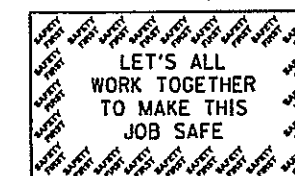

OREGON TRANSPORTATION COMMISSION

Gail Achterman	CHAIR
Michael Nelson	VICE-CHAIR
Mary Olson	COMMISSIONER
Alan Brown	COMMISSIONER
David Lohman	COMMISSIONER
Matthew L. Garrett	DIRECTOR OF TRANSPORTATION

These plans were developed using ODOT design standards. Exceptions to these standards, if any, have been submitted and approved by the ODOT Chief Engineer or their delegated authority.

Approving Authority: *Naveen G. Chandra*
Naveen G. Chandra, P.E.
Project Delivery Manager, Region 1

Concurrence by ODOT Chief Engineer: *[Signature]*

I-84 AT 257TH AVE (TROUTDALE INTERCHANGE) SEC.
COLUMBIA RIVER HIGHWAY
MULTNOMAH COUNTY

FEDERAL HIGHWAY ADMINISTRATION	PROJECT NUMBER	SHEET NO.
OREGON DIVISION	STATE	1

T. 1 N., R. 3 E., W.M.



INDEX OF SHEETS, CONT'D.	
SHEET NO.	DESCRIPTION
2, 2A, 2A-2 thru 2A-13, Incl.	Typical Sections
2B, 2B-2 thru 2B-4, Incl.	Details <i>Added Sht 2B-3A</i>
2C, 2C-2 & 2C-3	Detour
2C-4 thru 2C-16, Incl.	Traffic Control Plans
2D	Pipe Data Sheet
3	Alignment
3A	General Construction
3B	Drainage & Utilities
3C	Profiles
4	Alignment
4A	General Construction
4B	Drainage & Utilities
4B-2	Drainage & Utilities
4C	Profiles
4D	Drainage Profiles
5	Alignment
5A	General Construction
5B	Drainage & Utilities
5B-2	Drainage & Utilities
5C	Profiles
5D	Drainage Profiles
6	Alignment
6A	General Construction
6B	Drainage & Utilities
6B-2	Drainage & Utilities
6C	Profiles
6D	Drainage Profiles
7	Alignment
7A	General Construction
7C	Profiles
B	Alignment
8A	General Construction
GEO/HYDRO	
GA	Erosion Control Details
GA-2 thru GA-8	Erosion Control Plans
GB, GB-2 & GB-3	Geotechnical Data
GJ	Drainage Details
GJ-2, GJ-3, GJ-4	Stormwater Treatment and Storage Facility Field Markers
BRIDGE STRUCTURE 17365	
85233	Bridge General Layout
85235	Structural Mount
85236	Structure Mount Details
PERMANENT PAVEMENT MARKINGS	
ST, ST-2 thru ST-7, Incl.	Pavement Marking Plan
PERMANENT SIGNING	
S-12500 thru S-12517, Incl.	Permanent Signing
BRIDGE STRUCTURE 21529	
S-12518	Cantilever Sign Support, Sta. "EB" 458+80

INDEX OF SHEETS, CONT'D.	
DRAWING NO.	DESCRIPTION
ILLUMINATION	
I-1827	Illumination Legend
I-1828 & I-1829	Illumination Removal Plan
I-1830 & I-1831	Illumination Plan
I-1832	Illumination Details
TRAFFIC SIGNALS	
15969	Signal and Detector Plan Legend
15970	Detector Plan
15971	Signal Removal Plan
15972	Temporary Signal Plan
15973	Signal Plan
15974	Detector Plan
15975	Existing Utility Plan
15976	Signal Removal Plan
15977	Temporary Signal Plan
15978	Signal Plan
15979	Detector Plan
15980	Existing Utility Plan
15981	Temporary Pole Entrance Chart
15982	Pole Entrance Chart
ITS	
ITS-1044	ITS Legend & Symbols
ITS-1045 thru ITS-1049, Incl.	ITS Plan
ITS-1050 thru ITS-1055, Incl.	ITS Details

ADDED 15978A GRADING For Signal Pole # 18

Standard Drg. Nos.

- RD140 - Roadway Cross Slopes Superelevated Sections
- RD150 - Slope Rounding
- RD300 - Trench Backfill, Bedding, Pipe Zone And Mult. Installations
- RD302 - Street Cut
- RD316 - Sloped Ends For Metal Pipe
- RD318 - Sloped Ends For Concrete Pipe
- RD320 - Paved End Slope For Culverts 60" Maximum Pipe Size
- RD326 - Coupling Bands For Corrugated Metal Pipe
- RD336, RD342, RD344, RD346 - Manholes
- RD356 - Manhole Cover & Frames
- RD358 - Manhole Slope Protectors
- RD364, RD370, RD376 - Concrete Inlets
- RD380, RD384, RD386 - Pipe Fill Height Tables
- RD400, RD405, RD415, RD420, RD450 - Guardrail

- RD500 - Precast Concrete Barrier Pin And Loop Assembly
- RD510 - Concrete Barrier Terminal
- RD700 - Curbs
- RD705 - Islands
- RD710 - Accessible Route Islands
- RD715 - Approaches And Non-Sidewalk Driveways
- RD720 - Sidewalks
- RD755 - Sidewalk Ramp Details
- RD759 - Truncated Dome Detectable Warning Surface Details And Locations
- RD1000 - Construction Entrances
- RD1005 - Check Dams
- RD1010, RD1015 - Inlet Protection
- RD1040 - Sediment Fence
- TM200 - Sign Installation Details
- TM201 - Miscellaneous Sign Placement Details
- TM204 - Flag Board Mounting Details
- TM211 - Signage Details
- TM223, TM224 - Directional Sign Layout
- TM225 - Exit Number & Gore Signage Details
- TM230, TM231, TM232, TM233 - Mounting Details For Removable Legend
- TM300, TM301 - Illumination Control Cabinets
- TM450 - Mast Arm Pole Details
- TM452 - Strain Pole Details
- TM455 - Temporary Signal Details
- TM457 - Vehicle, Ped. Signal & Push Button Mounting Details
- TM458 - Pedestrian Ramp Placement Details
- TM460 - Vehicle Signal Details
- TM462 - Adjustable Signal Head Mounting Details
- TM463 - Spanwire Mounting Details
- TM465 - Overhead Sign, Fire Preemption & Photoelectronic Details
- TM467 - Ped. Signal And Ped. Push Button Details
- TM470 - Color Code Charts
- TM472 - Traffic Signal Junction Boxes
- TM475 - Loop Details
- TM480 - Loop Entrance Details
- TM482 - Controller Cabinet And Foundation Details
- TM485 - Service Cabinets And Service Cabinet Wiring Details
- TM488 - Terminal Cabinet Detail
- TM490 - Crosswalk Closure Detail

"AS CONSTRUCTED"
Mark Beem
 Date 4-26-12 Project Mgr

I-84 AT 257TH AVE (TROUTDALE INTERCHANGE) SEC.
 COLUMBIA RIVER HIGHWAY
 MUTNOMAH COUNTY

FEDERAL HIGHWAY ADMINISTRATION	PROJECT NUMBER	SHEET NO.
OREGON DIVISION	STATE	1A

Standard Drawings located on the web at:
http://www.oregon.gov/ODOT/HWY/ENGSERVICES/standard_drawings_home.shtml

Standard Drg. Nos. (contd.)

- TM500, TM501, TM503 - Pavement Marking Standard Details
- TM525 - Turn Arrow Marking Details
- TM530 - Intersection Pavement Markings
- TM551 - Freeway Exit Ramp Pavement Markings
- TM560, TM561 - Alignment Layout
- TM570 - Traffic Delineators
- TM571 - Traffic Delineators Steel Post Details
- TM575 - Traffic Delineator Installation

- TM600, TM601 - Multi-Post Breakaway Sign Supports
- TM602 - Triangular Base Breakaway Multi-Direction Slip Base
- TM618 - Truss Type Sign Bridge
- TM622, TM623, TM624, TM625, TM626, TM627 - Monotube Cantilever Sign Support

- TM629, TM630 - Slip Base & Fixed Base Luminaire Supports

- TM635 - Breakaway Sign & Luminaire Supports
- TM650, TM651, TM652, TM653 - Traffic Signal Supports
- TM670 - Wood Post Sign Supports
- TM671 - 3 Second Gust Wind Speed Isotach
- TM675 - Extruded Aluminum Panels
- TM676 - Sign Attachments
- TM677 - Sign Mounts
- TM678 - Secondary Sign Mounting Details
- TM679 - Signal Mast Arm Street Name Sign Mounts
- TM680 - Signal Pole Mounts
- TM681, TM687, TM688 - Square Tube Sign Supports

- TM800 - Tables, Abrupt Edge And PCMS Details
- TM810 - Temporary Reflective Pavement Markers
- TM820 - Temporary Barricades
- TM821 - Temporary Sign Supports
- TM830 - Temporary Concrete Barrier And Rumble Strips
- TM831, TM832 - Temporary Impact Attenuators
- TM840 - Closure Details
- TM841 - Intersection Work Zone Details
- TM842 - Signalized Intersection Details
- TM843 - Intersection Details
- TM851 - 2-Lane, 2-Way Roadways
- TM860 - Freeway Sections

R/W Map Nos. 6B-15-13, 1A-22-7,
1R-3-1477 and 1R-3-1477

"AS CONSTRUCTED"

Mark Beer

Date 4-26-12 Project Mngr

1-84 AT 257TH AVE (TROUTDALE INTERCHANGE) SEC. COLUMBIA RIVER HIGHWAY MULTNOMAH COUNTY		
FEDERAL HIGHWAY ADMINISTRATION	PROJECT NUMBER	SHEET NO.
OREGON DIVISION	STATE	1B

Standard Drawings located on the web at:
http://www.oregon.gov/ODOT/HWY/ENGSERVICES/standard_drawings_home.shtml


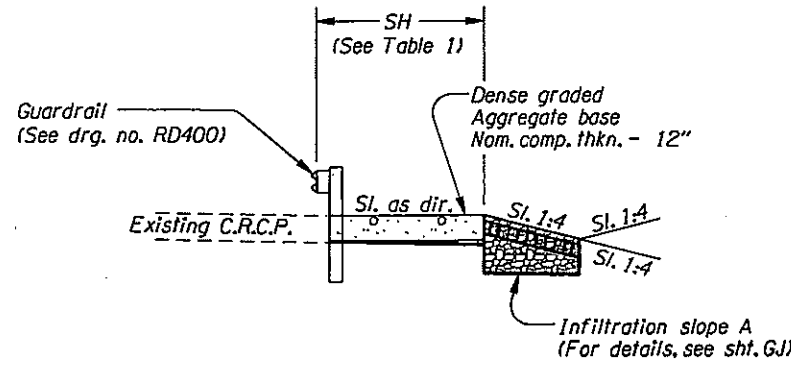



TABLE 1

STA. To	STA.	SH (Ft.)
456+69.79	457+38.83	0 to 8
457+38.83	458+50.00	8
458+50.00	458+78.00	8 to 12
458+78.00	458+98.00	12
458+98.00	459+70.00	12 to 6

STA. "L4E" 456+72.62 To STA. "L4E" 459+70.00

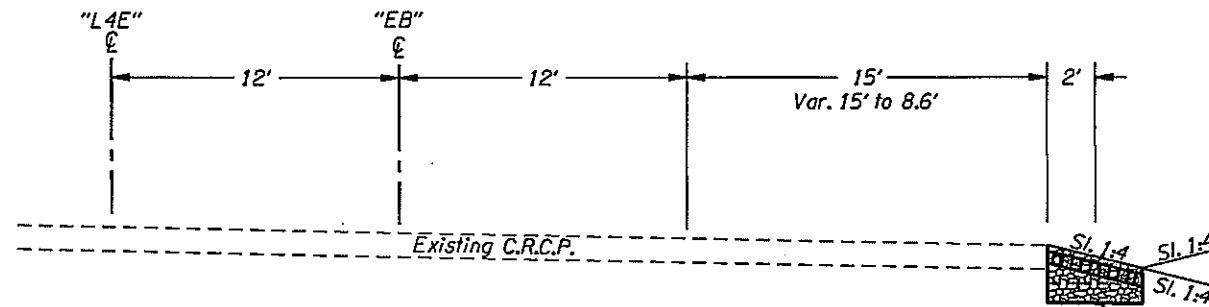

STA. "L4E" 455+91.80 To STA. "L4E" 458+90.00
 "L4E" 458+90.00 To "EB" 459+70.00 (Taper)

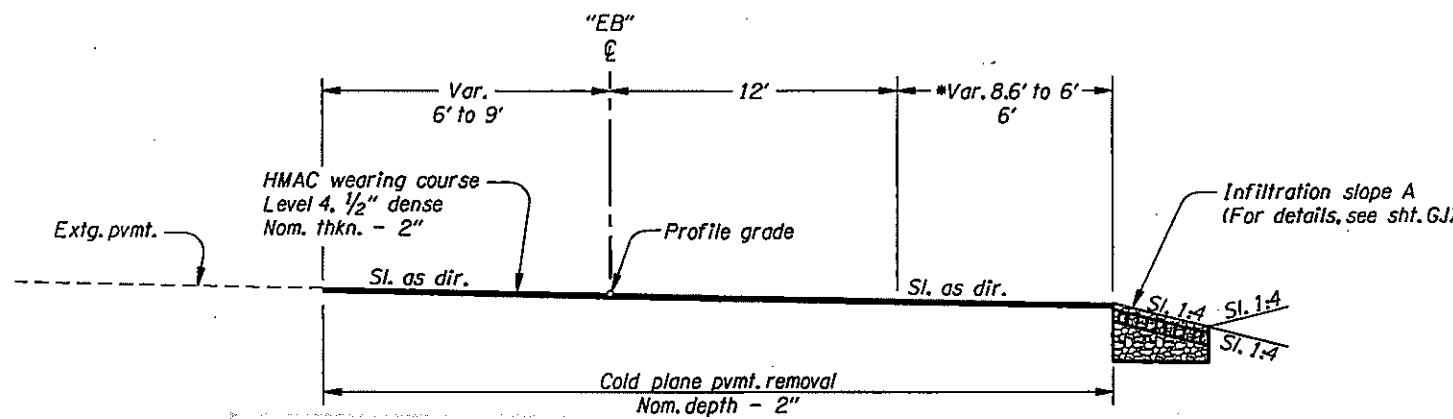

STA. "EB" 459+70.00 To STA. "EB" 460+15.50 (Taper)
 * "EB" 459+70.00 To "EB" 460+02.00 (Taper)

"AS CONSTRUCTED"
Mark Bean
 Date 4-26-12 Project Mngr

- NOTE:
 1. Side-slopes are shown as vert. to horiz.
 2. For standard superelevation, see drg. no. RD140.
 3. For slope rounding, see drg. no. RD150.



EXPIRATION DATE: 6-30-2011

OREGON DEPARTMENT OF TRANSPORTATION


REGION 1 - ROADWAY ENGINEERING SECTION

I-84 AT 257TH AVE (TROUTDALE INTERCHANGE) SEC.
 COLUMBIA RIVER HIGHWAY
 MULTNOMAH COUNTY


Design Team Leader - Lawrence Kretzler
 Designed By - Marco Singer & Dave Hoase
 Drafted By - Carolyn Allen

TYPICAL SECTIONS

SHEET NO.
 2

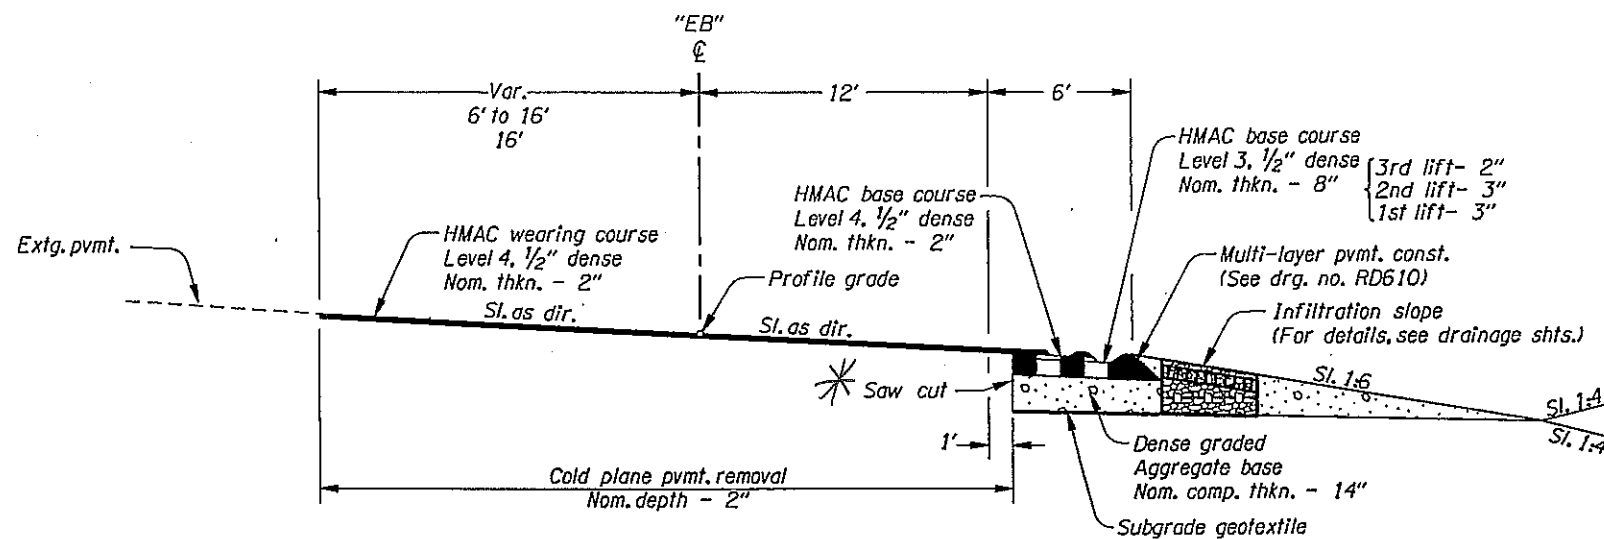

STA. "EB" 460+15.50 To STA. "EB" 461+05.00 (Taper)
 "EB" 461+05.00 To "EB" 463+92.55

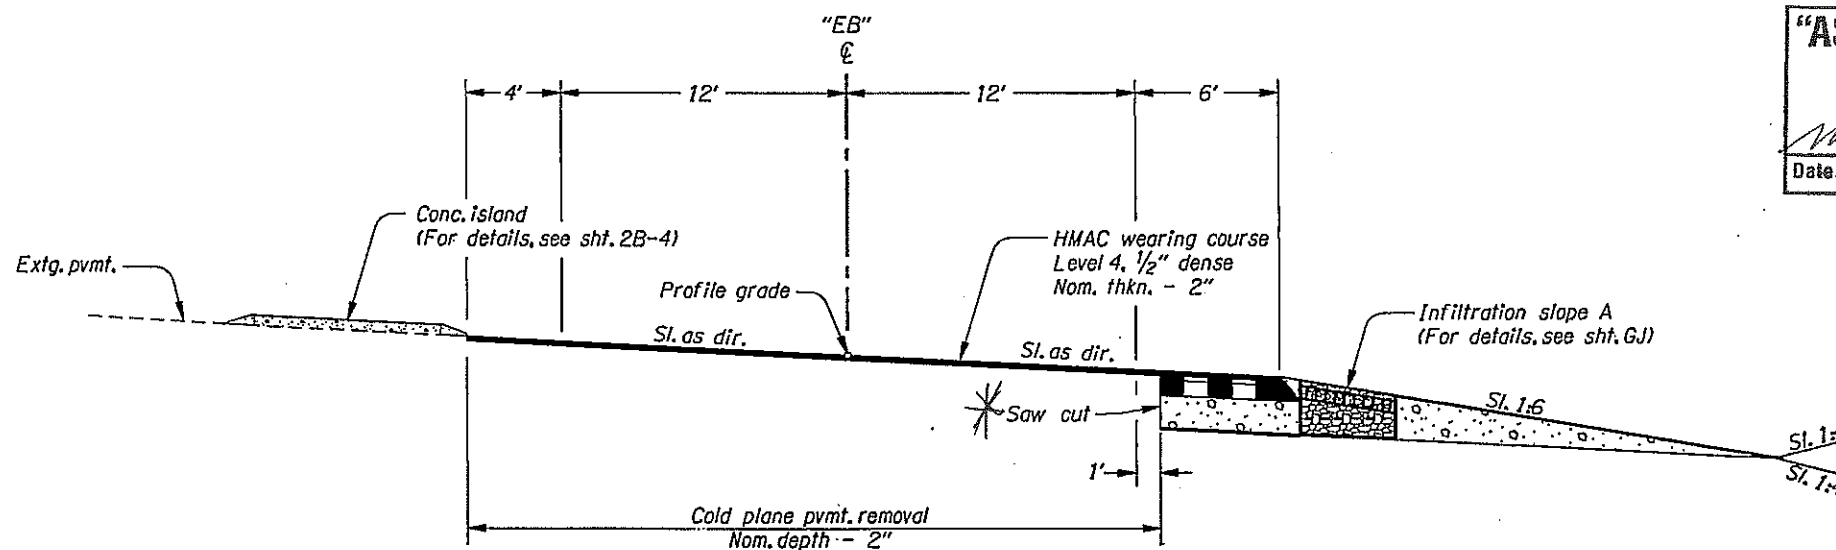


STA. "EB" 463+92.55 To STA. "EB" 464+72.50
 (For surfacing details not shown, see section above)


"AS CONSTRUCTED"
Mark Beon
 Date 4-26-12 Project Mngr

- NOTE:
 1. Side-slopes are shown as vert. to horiz.
 2. For standard superelevation, see drg. no. RD140.
 3. For slope rounding, see drg. no. RD150.


* See TABLE on Sheet 2A-3

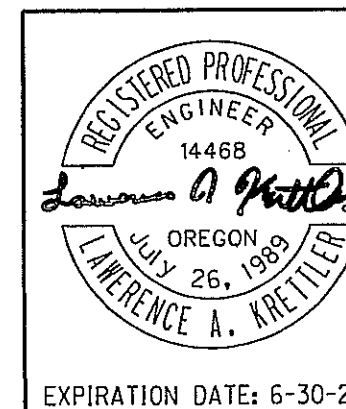

OREGON DEPARTMENT OF TRANSPORTATION	
REGION 1 - ROADWAY ENGINEERING SECTION	
I-84 AT 257TH AVE (TROUTDALE INTERCHANGE) SEC. COLUMBIA RIVER HIGHWAY MULTNOMAH COUNTY	
Design Team Leader - Lawrence Krettlar Designed By - Marco Singer & Dave Hoose Drafted By - Carolyn Allen	
TYPICAL SECTIONS	SHEET NO. 2A

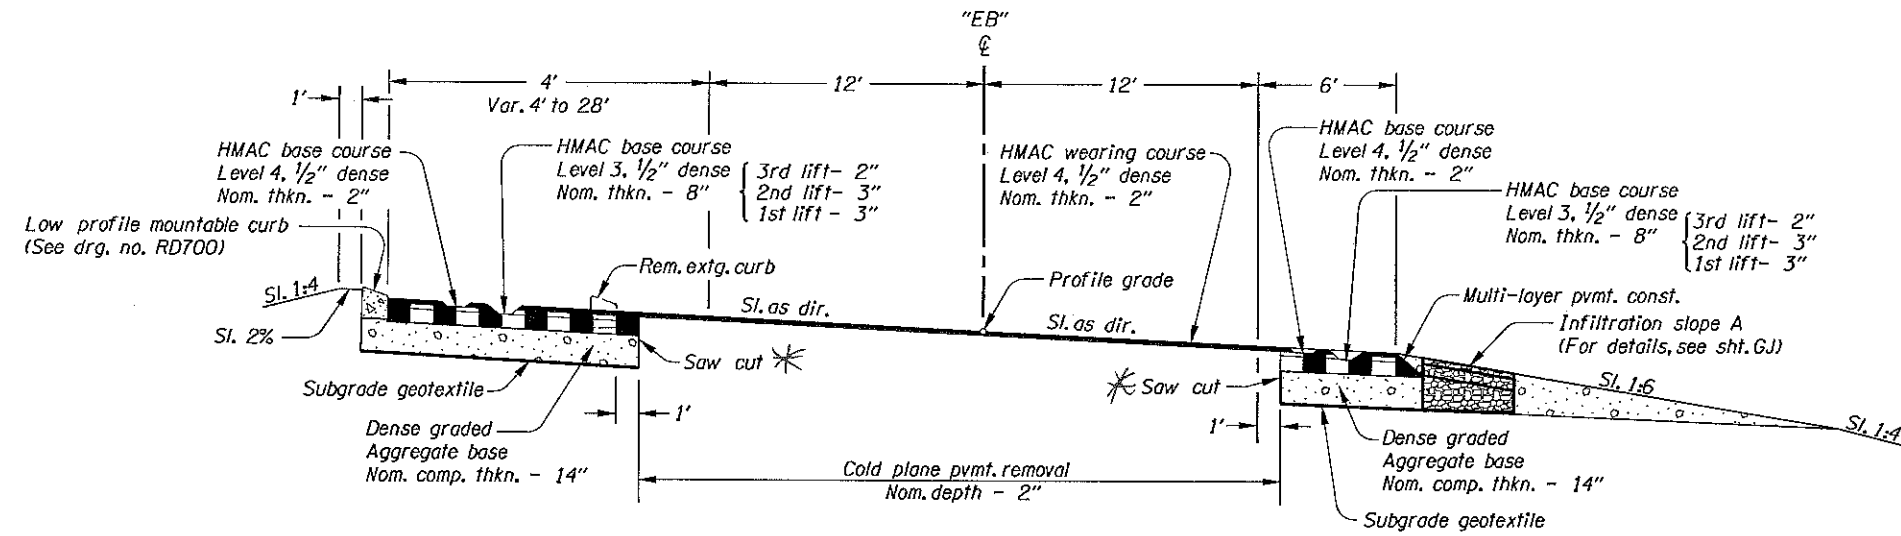

STA. "EB" 464+72.50 To STA. "EB" 464+88.00
 "EB" 464+88.00 To "EB" 466+96.00 (Taper Section)

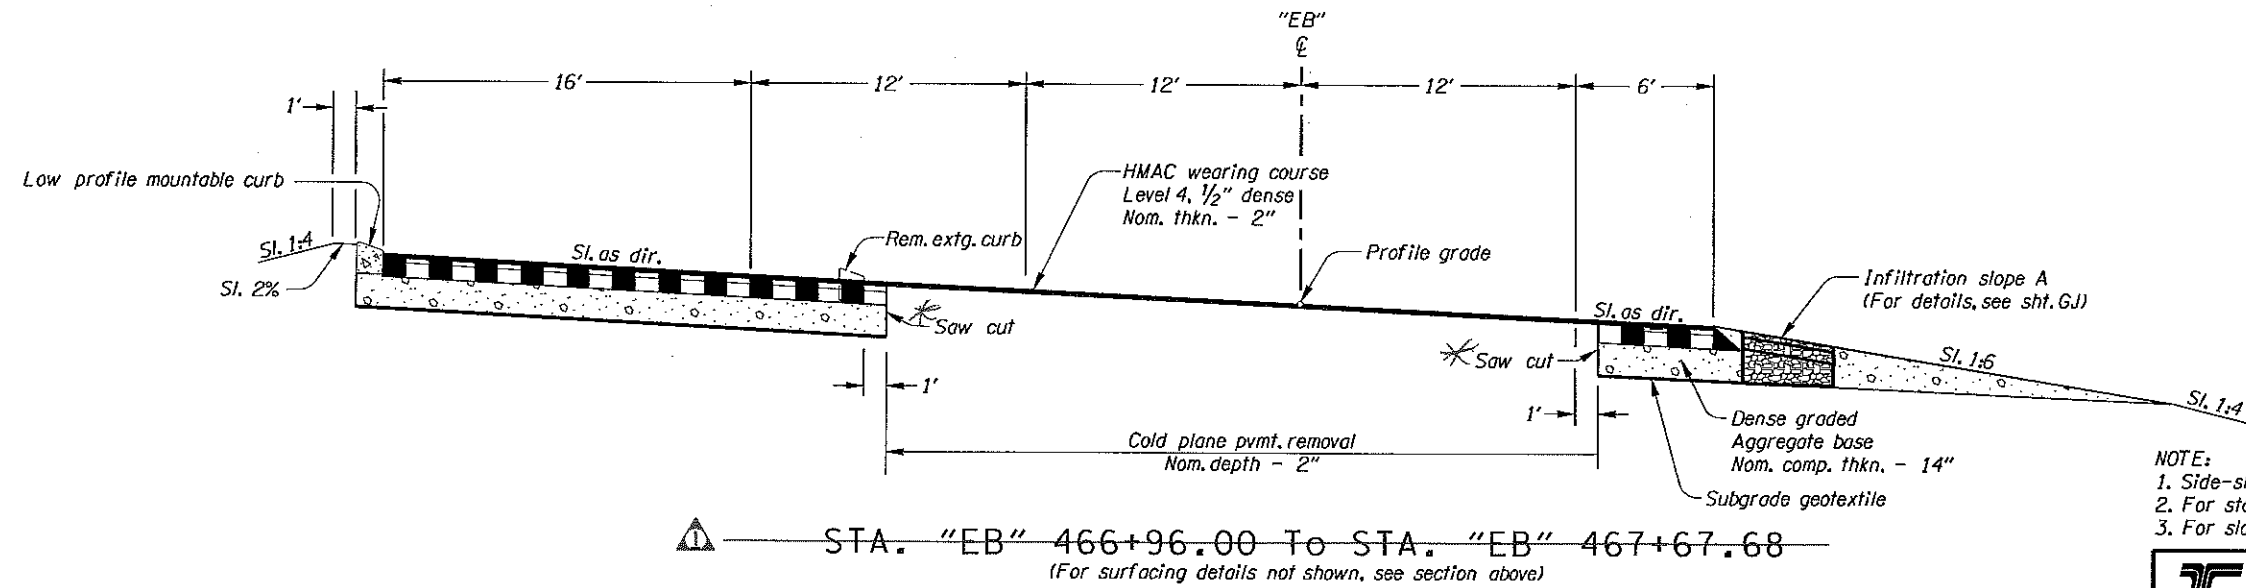

- NOTE:
1. Side-slopes are shown as vert. to horiz.
 2. For standard superelevation, see drg. no. RD140.
 3. For slope rounding, see drg. no. RD150.



* See TABLE ON 2A-3

"AS CONSTRUCTED"
 Mark Bean
 Date 4-26-12 Project Mngr

REGISTERED PROFESSIONAL
 ENGINEER
 14468
 OREGON
 JULY 26, 1989
 LAWRENCE A. KRETTLER
 EXPIRATION DATE: 6-30-2011

OREGON DEPARTMENT OF TRANSPORTATION	
REGION 1 - ROADWAY ENGINEERING SECTION	
I-84 AT 257TH AVE (TROUTDALE INTERCHANGE) SEC. COLUMBIA RIVER HIGHWAY MULTNOMAH COUNTY	
Design Team Leader - Lawrence Krettler Designed By - Marco Singer & Dave Haase Drafted By - Carolyn Allen	
TYPICAL SECTIONS	SHEET NO. 2A-2

EB ALIGNMENT As Built Saw Cuts			
EB STATION	Sawcut Left	EB STATION	Sawcut Right
Sta 464+72.78	-14.0	Sta 460+14	18.0
Sta 466+63.25	-14.5	Sta 460+44.8	13.7
Sta 468+39.75	-26.5	Sta 463+72.7	13.0
Sta 470+00	-27.6	Sta 467+50	13.0
Sta 470+41	-26.8	Sta 467+67.7	6.0
Sta 471+59	-16.5	Sta 471+00	6.0
		Sta 471+21.16	10.7
		Sta 471+42	13.2

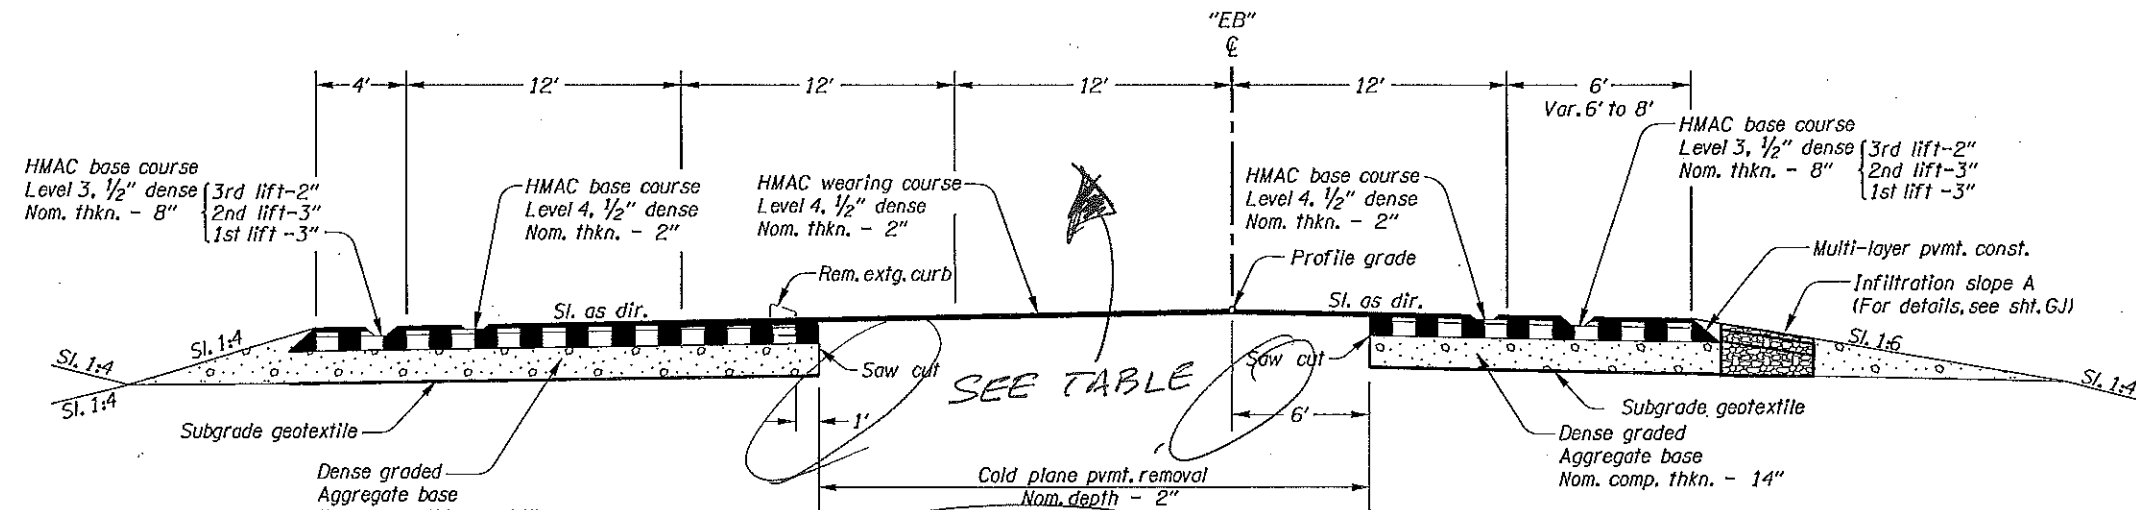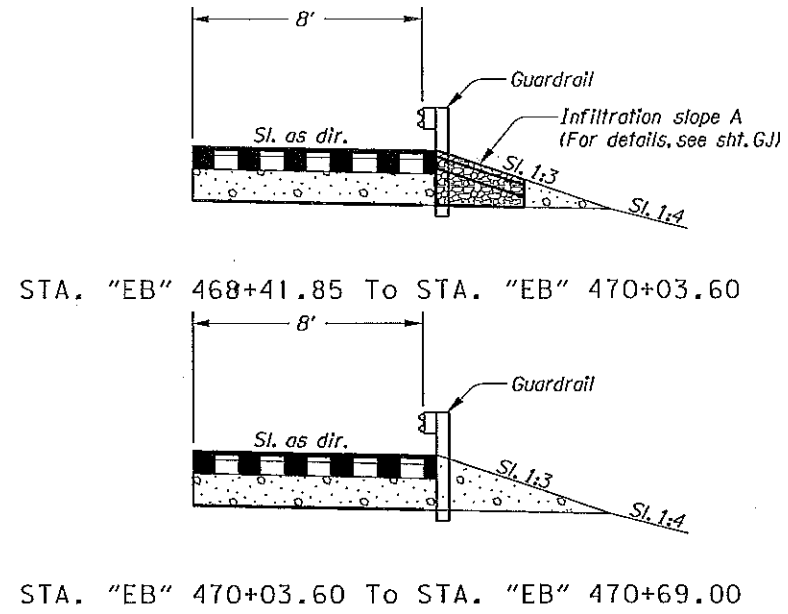



STA. "EB" 466+96.00 To STA. "EB" 472+25.00
 "EB" 468+22.12 To "EB" 468+41.85 (Taper)

⚠ Note: Curb Section ends as cut section left changes to fill.

- NOTE:
 1. Side-slopes are shown as vert. to horiz.
 2. For standard superelevation, see drg. no. RD140.
 3. For slope rounding, see drg. no. RD150.

"AS CONSTRUCTED"

Mark Stein
 Date 4-26-12 Project Mngr

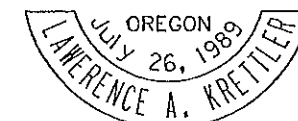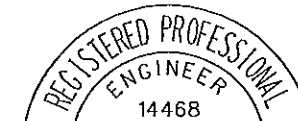

EXPIRATION DATE: 6-30-2011

OREGON DEPARTMENT OF TRANSPORTATION

REGION 1 - ROADWAY ENGINEERING SECTION

I-84 AT 257TH AVE (TROUTDALE INTERCHANGE) SEC.
 COLUMBIA RIVER HIGHWAY
 MULTNOMAH COUNTY

Design Team Leader - Lawrence Kretzler
 Designed By - Marco Singer & Dave Haase
 Drafted By - Carolyn Allen


TYPICAL SECTIONS

SHEET NO.

2A-3

44V-028

Sec. 26, T. 1 N, R. 3 E, W.M.

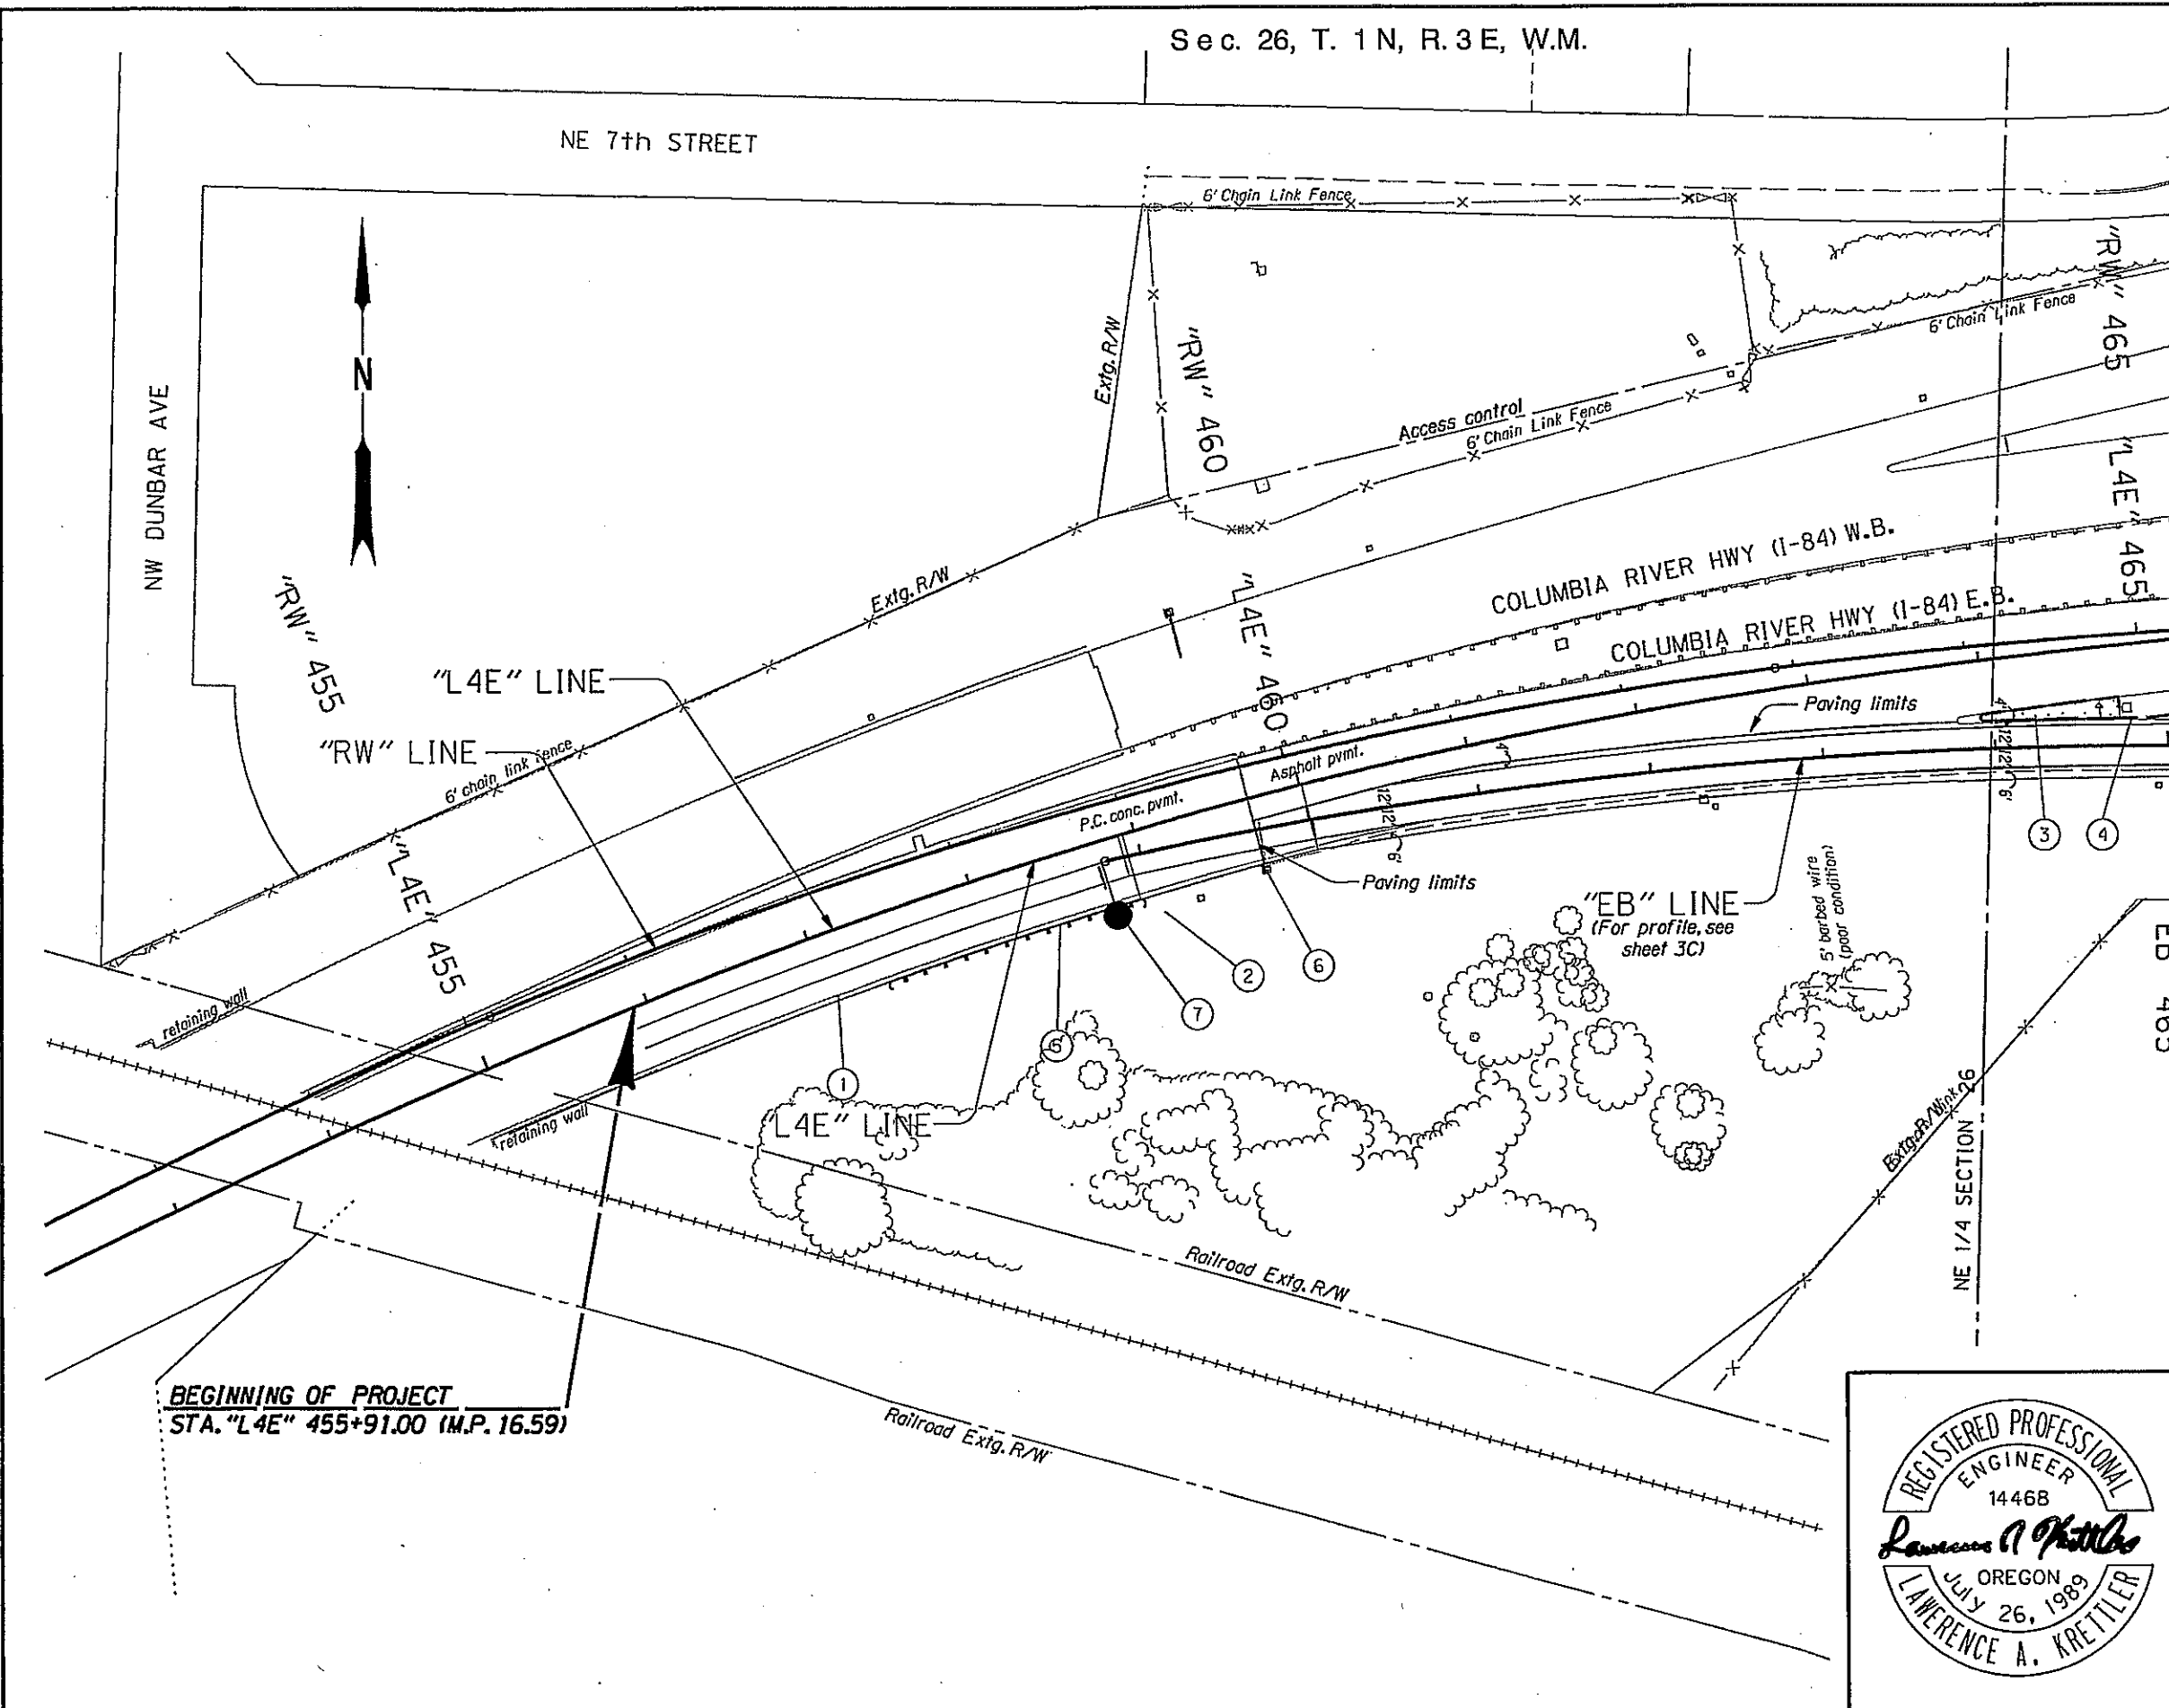

- ① Sta. "L4E" 456+05 to Sta. "L4E" 467+64, Rt. Remove extg. conc. shldr. barrier - 1162.5' (Clean pvmt. area and fill and seal holes with approved patch material from the QPL list, as directed)
- ② Const. random fill - 40 cu. yd.
- ③ Remove extg. conc. island Const. type "C" conc. island (Mountable) (See drg. no. RD705) (For details, see sht. 2B-4)
- ④ Const. low profile mountable curb (See drg. no. RD700)
- ⑤ Sta. "L4E" 457+39 to Sta. "EB" 458+95, Rt. Const. guardrail - 25' (Type 3) Const. guardrail - 100' (Type 2A) Const. anchor (Type 1 modified) Inst. end piece (Type B) Const. guardrail terminal, non-flared - 37.5' Test level 3 W=1', E=2' (See drg. nos. RD400, RD405, RD415, RD420 & RD450)
- ⑥ Sta. "EB" 459+70.5, Rt. Remove extg. cantilever sign structure
- ⑦ Br. no. 18162 Sta. "EB" 458+80, Rt. Const. cantilever sign structure (For drg. nos., see sht. 1A)

BEGINNING OF PROJECT
 STA. "L4E" 455+91.00 (I.P. 16.59)

"AS CONSTRUCTED"
Mark Barr
 Date 7-26-12 Project Mgr

OREGON DEPARTMENT OF TRANSPORTATION	
REGION 1 - ROADWAY ENGINEERING SECTION	
I-84 AT 257TH AVE (TROUTDALE INTERCHANGE) SEC. COLUMBIA RIVER HIGHWAY MULTNOMAH COUNTY	
Design Team Leader - Lawrence Krettler Designed By - Marco Singer & Dave Haase Drafted By - Carolyn Allen	
GENERAL CONSTRUCTION	SHEET NO. 3A


REGISTERED PROFESSIONAL
 ENGINEER
 14468
Lawrence A. Krettler
 OREGON
 JULY 26, 1989
 LAWRENCE A. KRETTLER


EXPIRATION DATE: 6-30-2011


Sec. 26, T. 1 N, R. 3 E, W.M.


NE 7th STREET

- ① Sta. "EB" 460+65.88, 12.11' Rt.
Remove extg. inlet
Const. shallow manhole
Rim 39.20
F.L. 36.10 (Extg. 12" E)
F.L. 35.90 (Extg. 12" NW)
(See drg, RD342)
- ② Sta. "EB" 463+64.45, 10.63' Rt.
Remove extg. inlet
Const. shallow manhole
Rim 42.72
F.L. 37.90 (Extg. 12" W)
F.L. 37.80 (Extg. 12" NE)
- ③ Remove extg. inlet
Plug and abandon extg. 12" storm sew. pipe - 131'
- ④ Remove extg. inlet
Plug and abandon extg. 12" storm sew. pipe - 97'
- ⑤ Sta. "EB" 462+76.50, 47.23' Rt.
Extend 24" culvert pipe - 20'
5' depth
(See drg, nos. RD300, RD316, RD326 & RD380)
- ⑥ Sta. "L4E" 455+91.80, Rt. to Sta. "EB" 470+03.60, Rt.
Const. infiltration slope type A - 428.0 cu. yd.
Inst. delineators, type S1-2
Inst. delineators, type S2
(For details, see shfs. GJ & GJ-2)


Infiltration slope shown thus: 

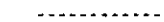Fill line shown thus: 


Remove extg. inlet shown thus: 

Plug and abandon pipe shown thus: 


 OREGON DEPARTMENT OF TRANSPORTATION


 DAVID EVANS AND ASSOCIATES INC.
2100 Southwest River Parkway
Portland Oregon 97201 Ph: 503.223.6663

I-84 AT 257TH AVE (TROUTDALE INTERCHANGE) SEC.
COLUMBIA RIVER HIGHWAY
MULTNOMAH COUNTY


Reviewed By - Craig Sheehan 
Designed By - Karina Nordahl
Drafted By - Edita Boguslawski

DRAINAGE & UTILITIES SHEET NO. 3B

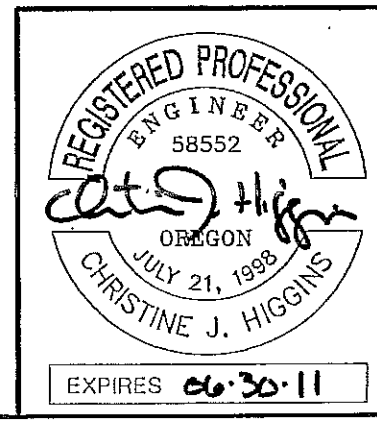

"AS CONSTRUCTED"

Date 4-26-12 Project Mngr

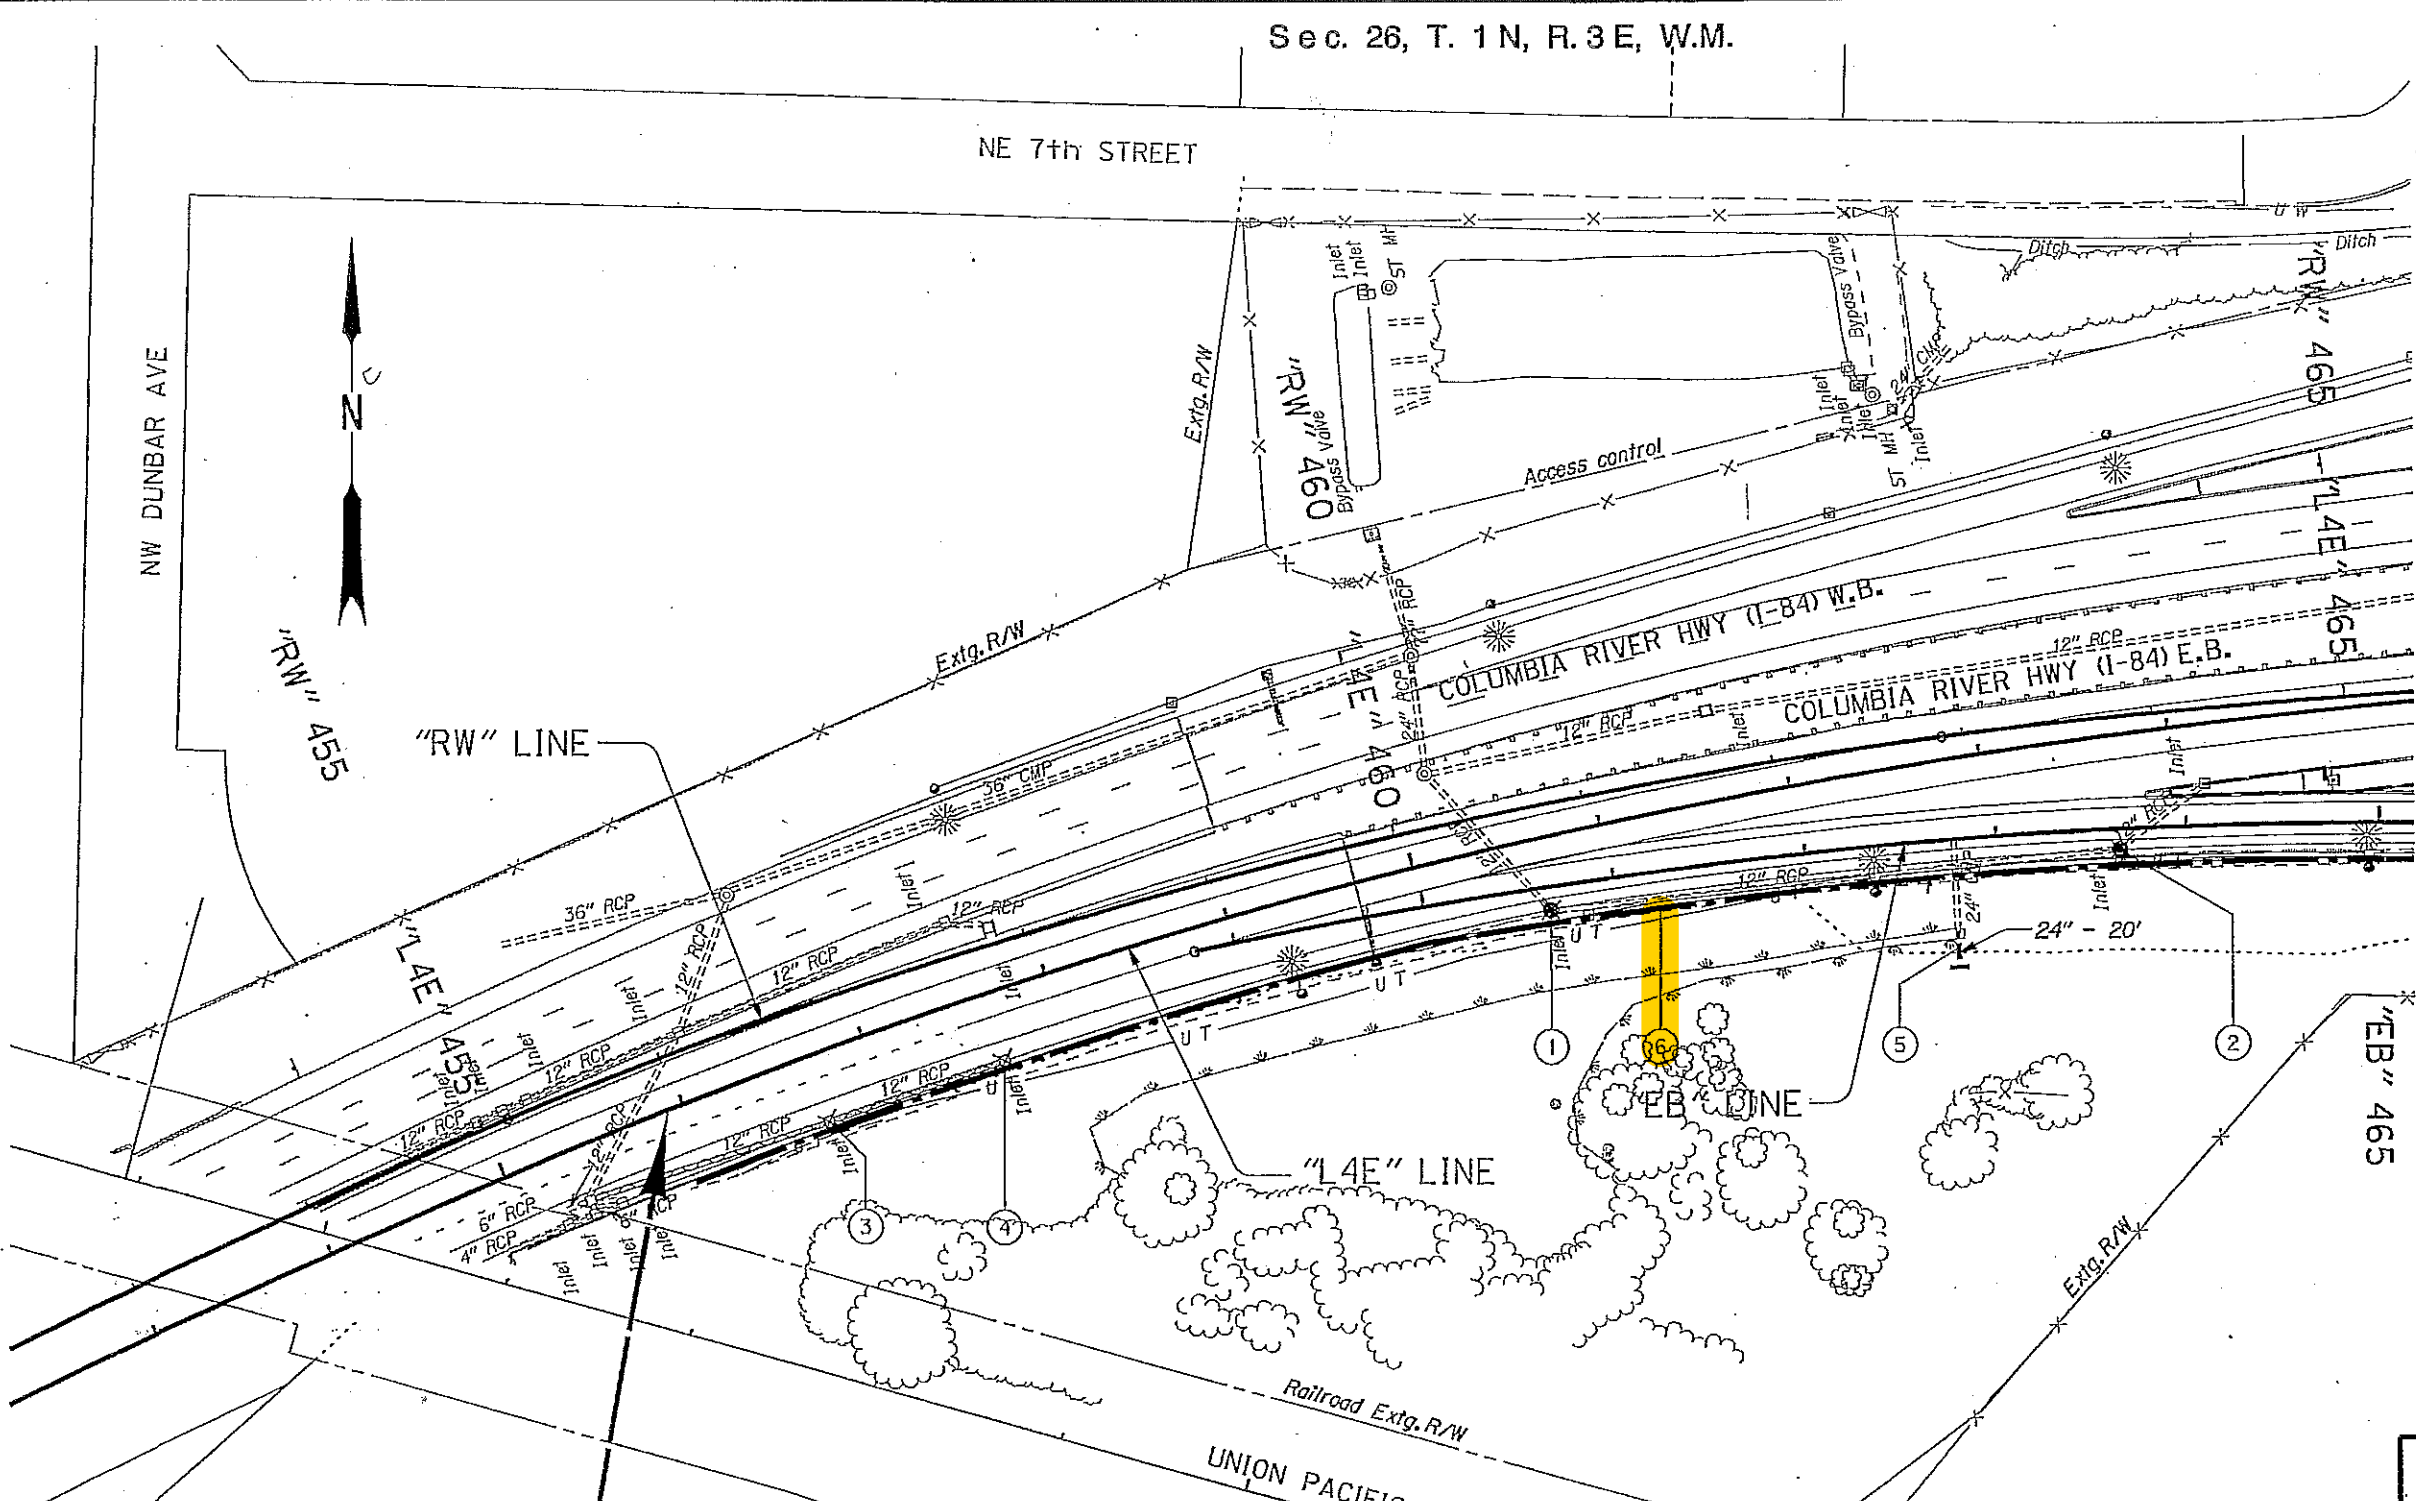
BEGINNING OF PROJECT
STA. "L4E" 455+91.00 (M.P. 16.59)



"EB" LINE

44V-028

BEGIN SOUTH FRONTAGE RD.
WORK AREA
STA. "EB" 459+91.00

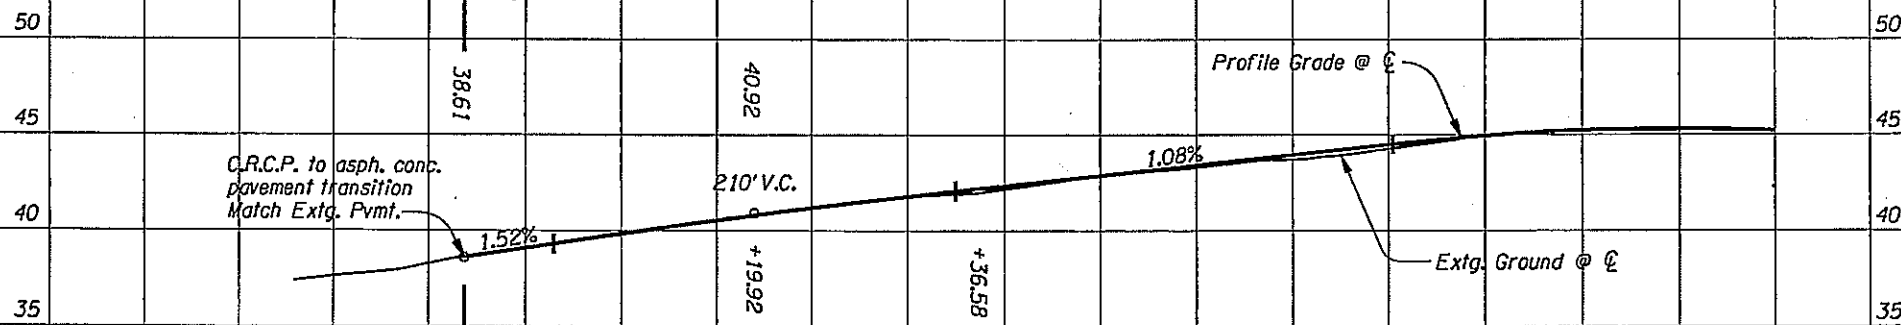

C.R.C.P. to asph. conc.
pavement transition
Match Extg. Pvmt.

210' V.C.

1.08%

1.52%

+19.92

+36.58

+68.35

+68.35

Earthwork
Exc. 464 C.Y.

Emb. 2693 C.Y.

465+00

460+00

"AS CONSTRUCTED"


Marco Singer
Date 4-26-12 Project Mgr

OREGON DEPARTMENT OF TRANSPORTATION

REGION 1 - ROADWAY ENGINEERING SECTION

I-84 AT 257TH AVE (TROUTDALE INTERCHANGE) SEC.
COLUMBIA RIVER HIGHWAY
MULTNOMAH COUNTY

Design Team Leader - Lawrence Krettlar
Designed By - Marco Singer & Dave Haase
Drafted By - Carolyn Allan

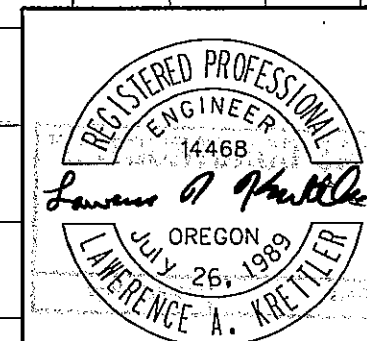


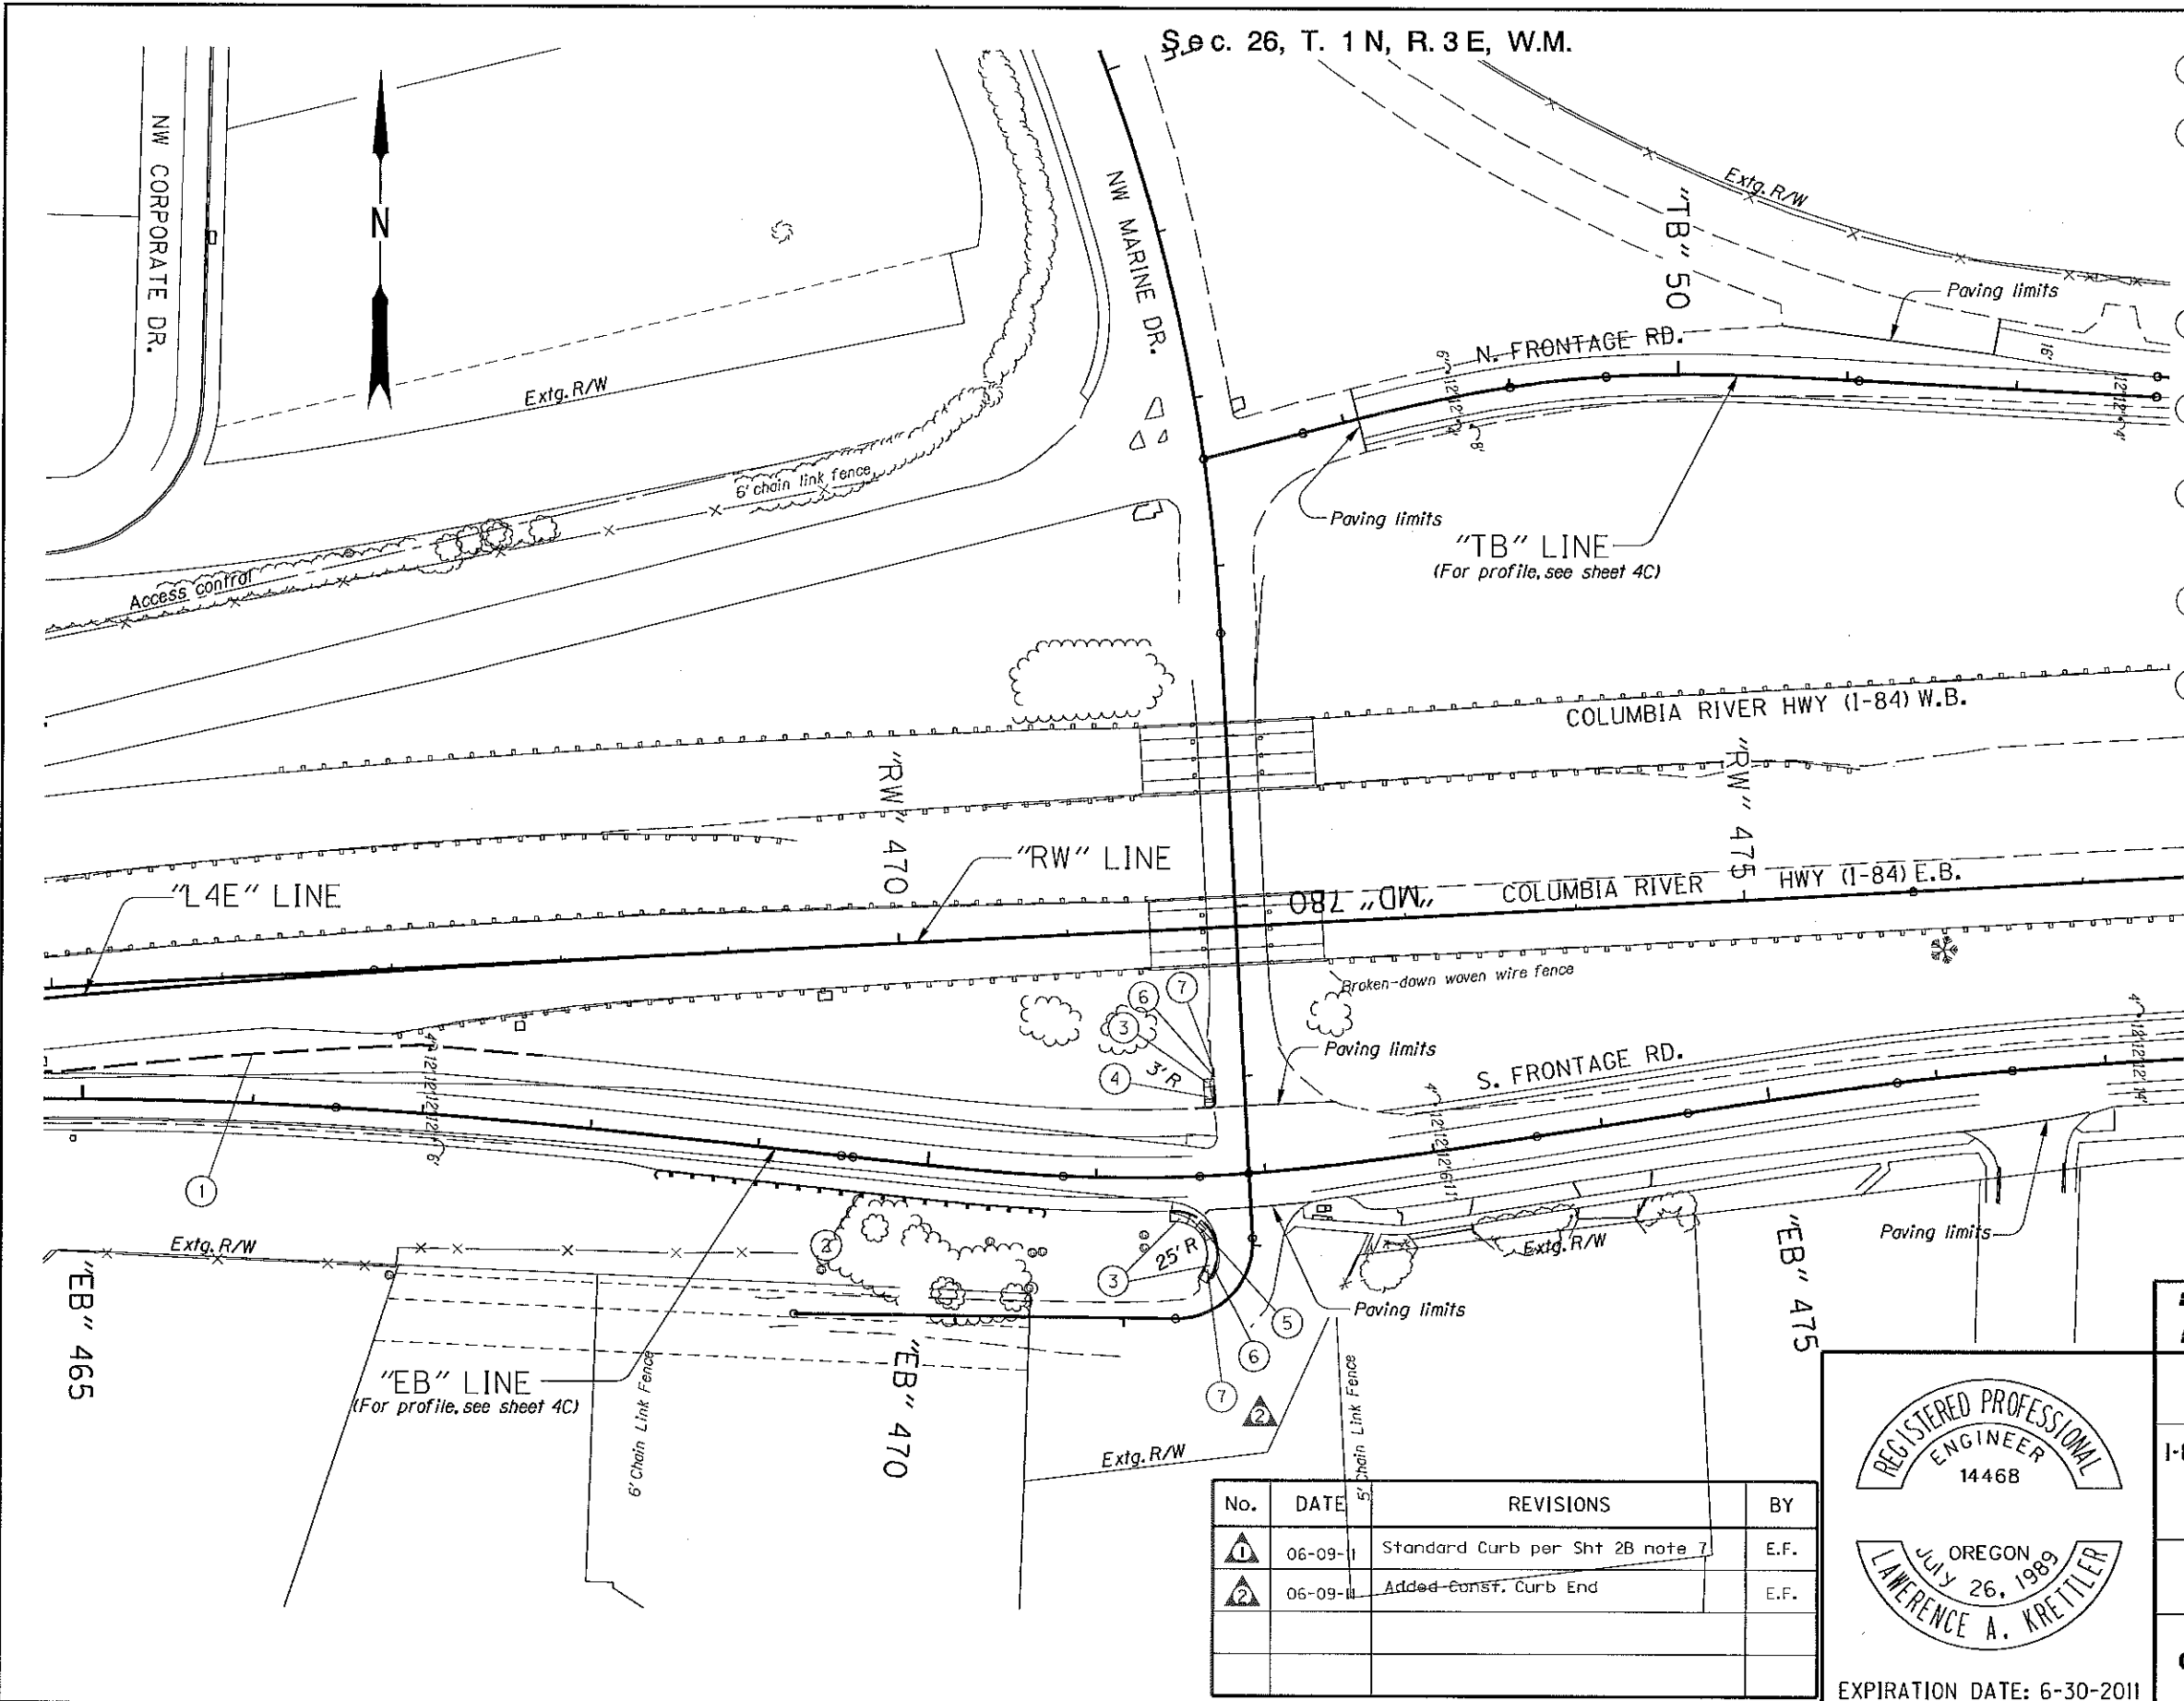
EXPIRATION DATE: 6-30-2011

PROFILE

SHEET NO.

3C

- ① See sht. 3A, note 4
- ② Sta. "EB"468+43 to Sta. "EB"470+69, Rt. Const. guardrail - 175' (Type 2A) Const. anchor (Type 1 modified) Inst. end piece (Type B) Const. guardrail terminal non-flared - 50' Test level 3 W=1, E=2'
- ③ Const. P.C. conc. sidewalk (See drg. no. RD720)
- ④ Const. sidewalk ramp (For details, see sht. 2B)
- ⑤ Remove extg. curb & sidewalk Const. parallel sidewalk ramp (See drg. no. RD755)
- ⑥ Const. standard curb (See drg. no. RD700) 
- ⑦ Const. curb end (See drg. no. RD700)



"AS CONSTRUCTED"
Mark Ben
 Date 4-26-12 Project Mngr

 OREGON DEPARTMENT OF TRANSPORTATION

REGION 1 - ROADWAY ENGINEERING SECTION

I-84 AT 257TH AVE (TROUTDALE INTERCHANGE) SEC.
 COLUMBIA RIVER HIGHWAY
 MULTNOMAH COUNTY

Design Team Leader - Lawrence Krettl
 Designed By - Marco Singer & Dave Haase
 Drafted By - Carolyn Allen

GENERAL CONSTRUCTION SHEET NO. 4A

REGISTERED PROFESSIONAL ENGINEER 14468

OREGON JULY 26, 1989 LAWRENCE A. KRETTLER


EXPIRATION DATE: 6-30-2011

No.	DATE	REVISIONS	BY
①	06-09-11	Standard Curb per Sht 2B note 7	E.F.
②	06-09-11	Added Const. Curb End	E.F.

Sec. 26, T. 1 N, R. 3 E, W.M.

"AS CONSTRUCTED"

Wanda Nason
Date 4-26-12 Project Mng'r

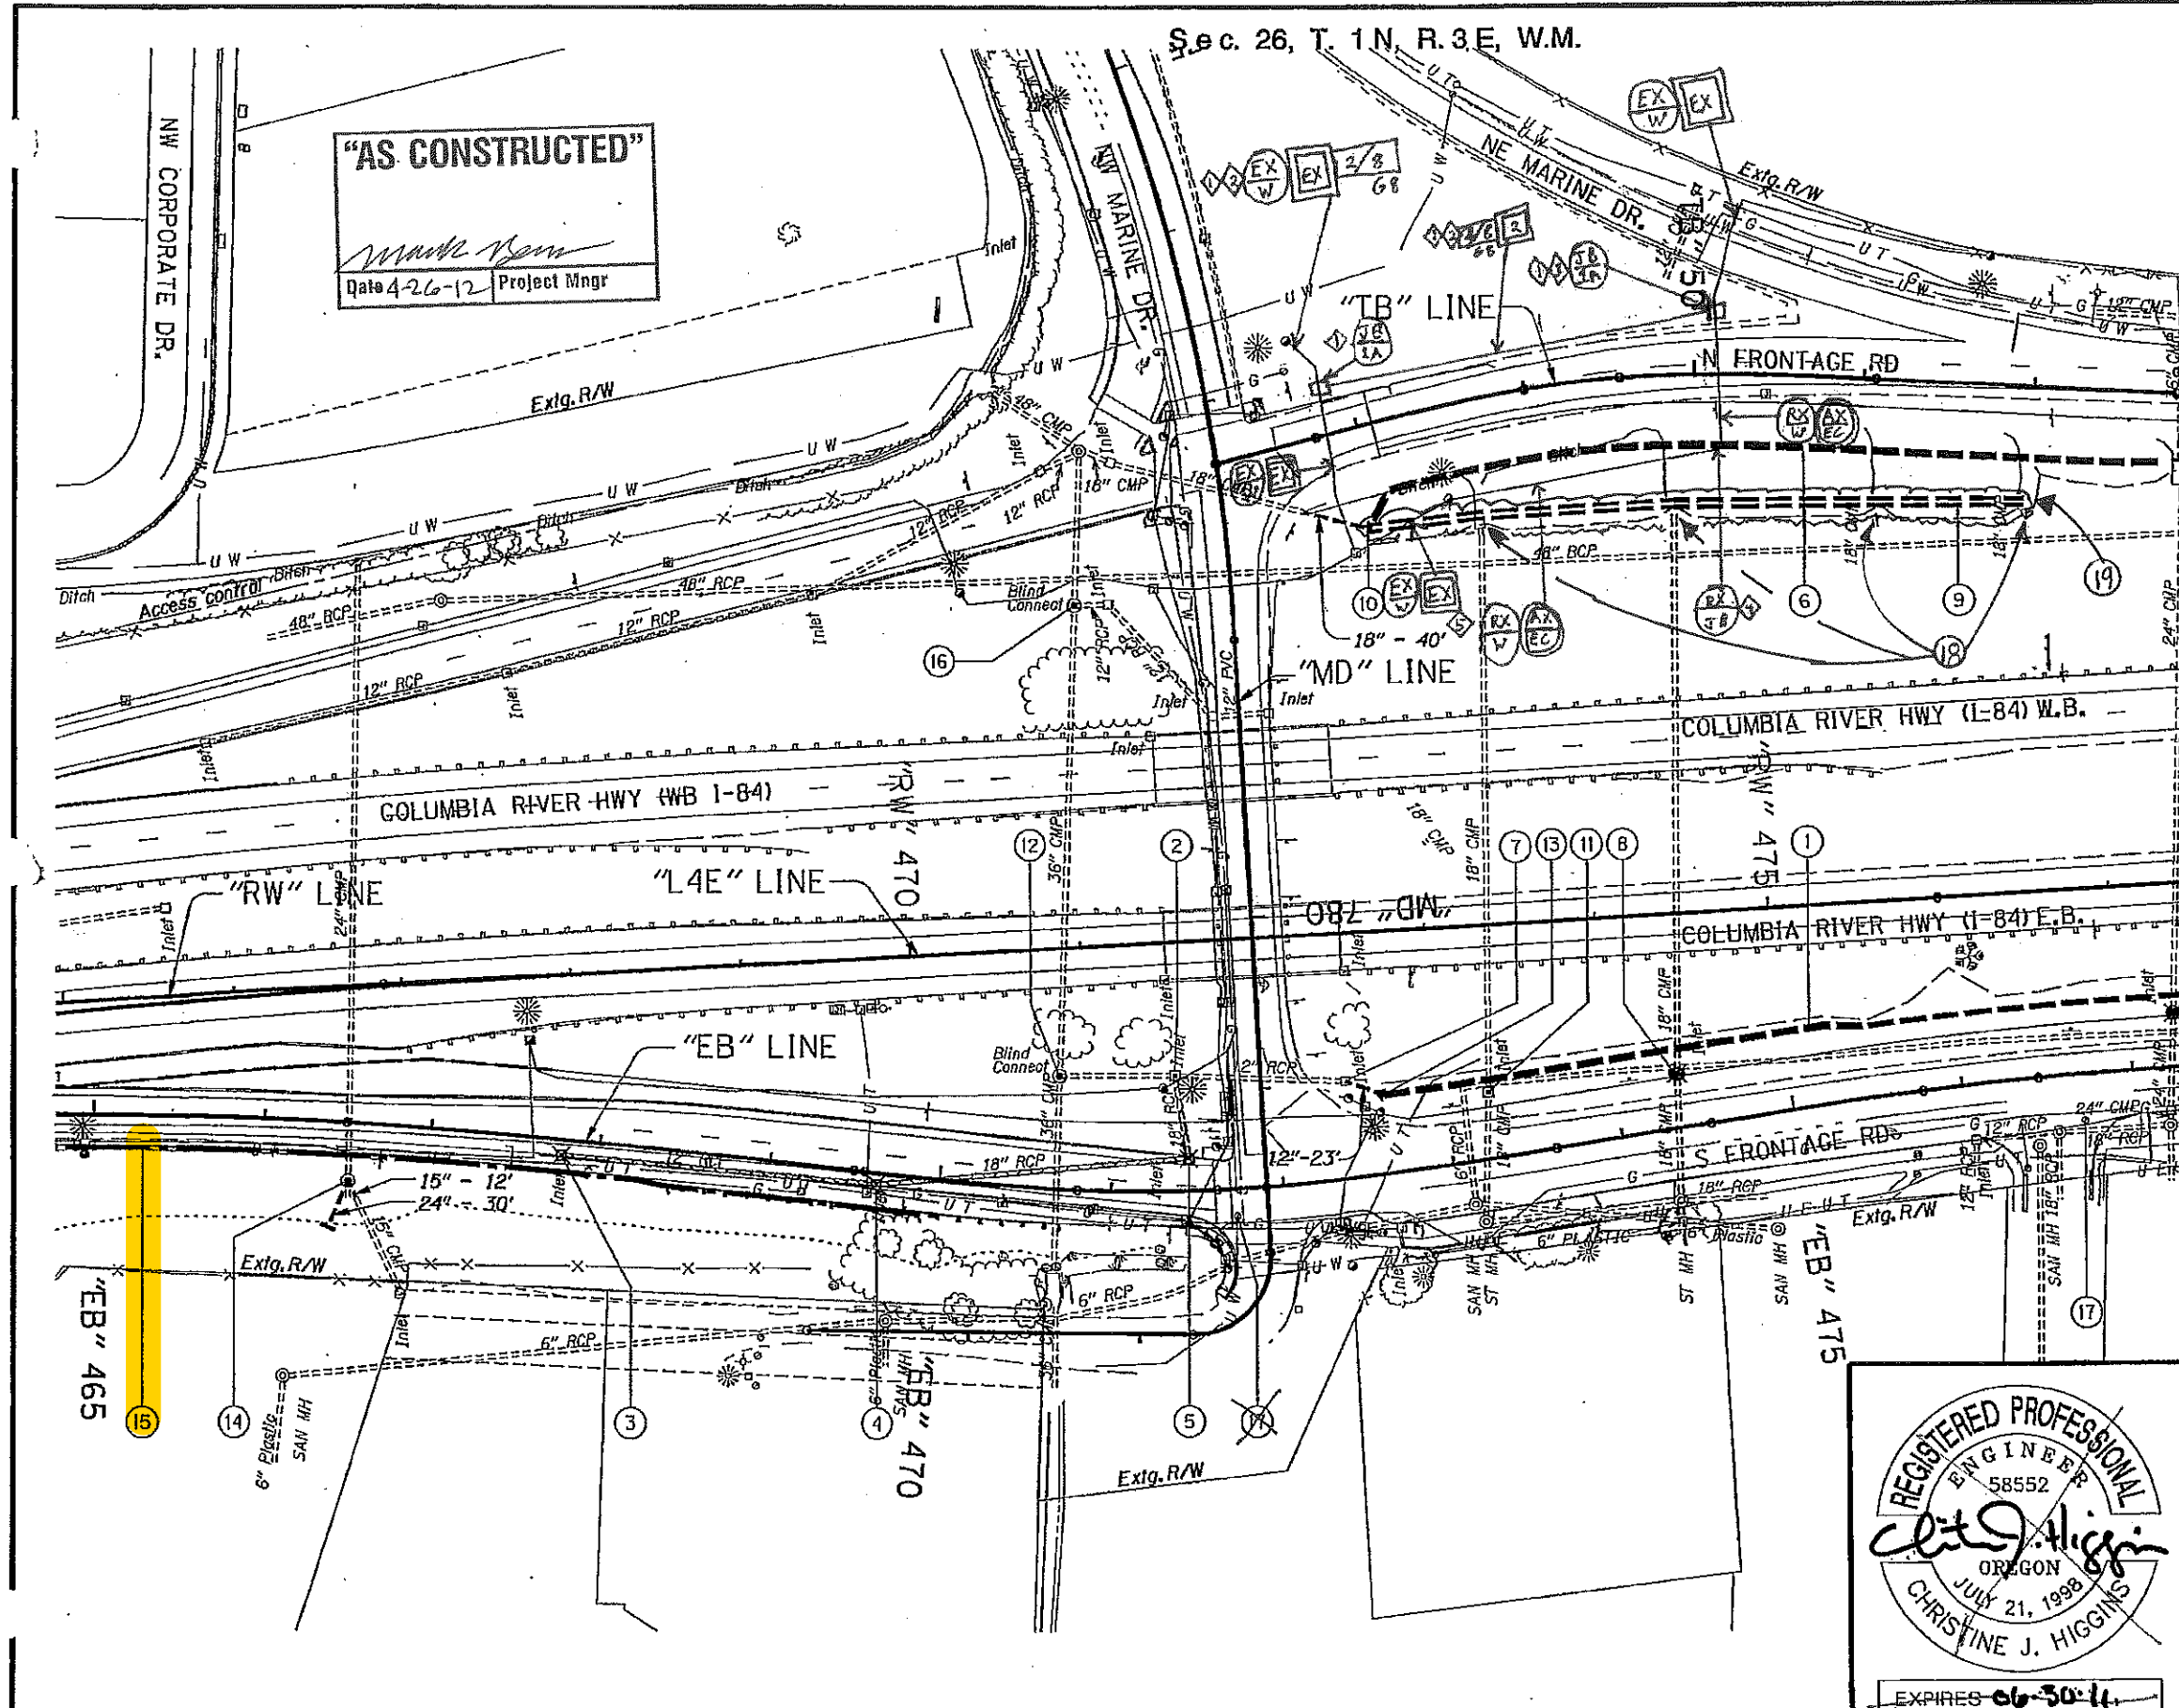

EX
W Retain and protect existing wiring

1 Field locate to avoid conflicts with existing utilities

2 Verify new wiring is sufficient for existing lighting circuit.

3 Splice new wire to existing wire.

4 Remove & dispose of existing light pole base according to section 00310

5 Conduit previously rerouted beneath drainage ditch
See R. T.
8/19/11

18 & 19 For added detail see GJ-4 Eric Fosgard


- Ditch shown thus:
- Infiltration swale shown thus:
- Infiltration slope shown thus:
- Cut line shown thus:
- Fill line shown thus:
- Adjust inlet shown thus:
- Remove extg. inlet shown thus:
- Plug and abandon pipe shown thus:

OREGON DEPARTMENT OF TRANSPORTATION

DAVID EVANS AND ASSOCIATES INC.
2100 Southwest River Parkway
Portland Oregon 97201 Ph: 503.223.6663

I-84 AT 257TH AVE (TROUTDALE INTERCHANGE) SEC.
COLUMBIA RIVER HIGHWAY
MULTNOMAH COUNTY

Reviewed By - Craig Sheahan
Designed By - Karina Nordahl
Drafted By - Edita Bagustawski

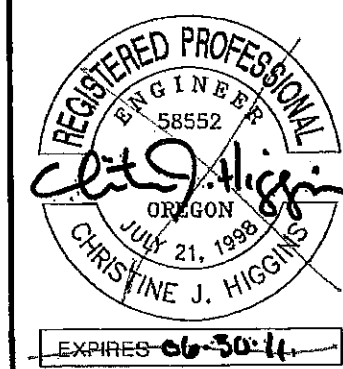

EXPIRES 06-30-11

DRAINAGE & UTILITIES

SHEET NO.
4B

① Sta. "EB" 472+65.42, 46.05' Lt. to Sta. "EB" 475+50.00, 41.93' Lt.
Const. infiltration swale type A - 38.9 cu.yd.
Inst. delineators, type S1
Inst. delineators, type S2
(For details, see shfs. GJ & GJ-2)

② Sta. "EB" 471+38.77, 67.53' Lt.
Adjust inlet
Rim 33.50
(See drg. no. RD376)

③ Remove extg. inlet
Plug and abandon extg. 12" storm sew. pipe - 185'

④ Remove extg. inlet
Plug and abandon extg. 18" storm sew. pipe - 182'

⑤ Remove extg. inlet
Plug and abandon extg. 18" storm sew. pipe - 49'

⑥ Sta. "TB" ~~48+42.47, 59.00'~~ Rt. to Sta. "TB" ~~53+25.05, 40.29'~~ Rt. **52+73.8, 40.3'**
Const. infiltration swale type C - 34.5 cu.yd.
Inst. delineators, type S1
(For details, see shfs. GJ & GJ-2)

⑦ Sta. "EB" 472+43.38, 57.00' Lt.
Connect 12" storm sew. pipe to extg. inlet

⑧ Sta. "EB" 474+36.61, 31.60' Lt.
Remove extg. inlet
Const. manhole
Rim 35.43
F.L. 30.30 (Extg. 18" S)
F.L. 30.80 (Extg. 18" N)
(See drg. no. RD336)

⑨ Sta. "TB" ~~48+42.47, 59.00'~~ Rt. to Sta. "TB" ~~52+47.00, 67.00'~~ Rt. **47+91.18, 59.02'**
Const. ditch - 555 cu.yd.
(For details, see shf. GJ) **51+95.71, 67.00'** Rt

⑩ Sta. "TB" ~~48+42.47, 59.00'~~ Rt. **47+91.18, 59'** Rt.
Const. paved end slope - 44 sq.ft.
Extend 18" culvert pipe - 40'
5' depth
(See drg. nos. RD316, RD320 & RD326)

⑪ Sta. "EB" 473+26.58, 38.83' Lt.
Adjust inlet
Rim 33.67

⑫ Sta. "EB" 470+66.76, 66.29' Lt.
Const. large precast manhole (60" dia.) over extg. 36" storm sew. pipe
Connect extg. 12" storm sew. pipe
Field locate
(See drg. no. RD346)

⑬ Sta. "EB" 472+65.42, 46.05' Lt.
Const. paved end slope - 32 sq.ft.
Inst. 12" storm sew. pipe - 23'
5' depth
(See drg. nos. RD318 & RD386)

⑭ Sta. "EB" 466+51.51, 34.06' Rt.
Const. manhole
Connect extg. 24" storm sew. pipe
Inst. 24" storm sew. pipe - 30'
10' depth
Extend 15" storm sew. pipe - 12'
10' depth
Inst. manhole slope protector
(See drg. no. RD358)

⑮ See note 6, shf. 3B

⑯ Sta. "EB" 470+58.65, 339.25' Lt.
Const. large precast manhole (60" dia.) over extg. 36" storm sewer pipe
Connect extg. 12" storm sew. pipe
Rim 32.33
F.L. 27.19± (Extg. 12" E)
F.L. 27.19± (Extg. 36" S)
F.L. 27.19± (Extg. 36" N)
Field locate

⑰ Adjust water valve - **X** 1


⑱ Install Class 50 RIPRAP BASIN (6'x15'x1') - 4 (For Details, SEE SHF. GJ-4)

⑲ Install TYPE F MATTING - 870 S.Y. (See DRG. No. RD 1055)


NOTE: TB Alignment Stationing changed. New stationing shown.

"AS CONSTRUCTED"


Mark Beer
Date **4-26-12** Project Mngr

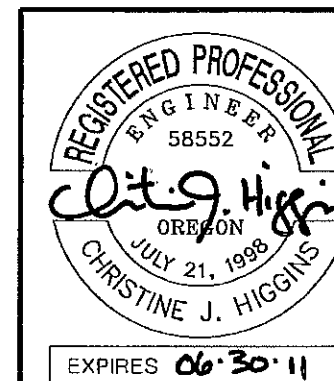

OREGON DEPARTMENT OF TRANSPORTATION	
DAVID EVANS AND ASSOCIATES INC. 2100 Southwest River Parkway Portland Oregon 97201 Ph: 503.223.6663	
I-84 AT 257TH AVE (TROUTDALE INTERCHANGE) SEC. COLUMBIA RIVER HIGHWAY MULTNOMAH COUNTY.	
Reviewed By - Craig Sheahan <i>CSH</i> Designed By - Karina Nordahl Drafted By - Edita Boguslawski	
DRAINAGE & UTILITIES	SHEET NO. 4B-2

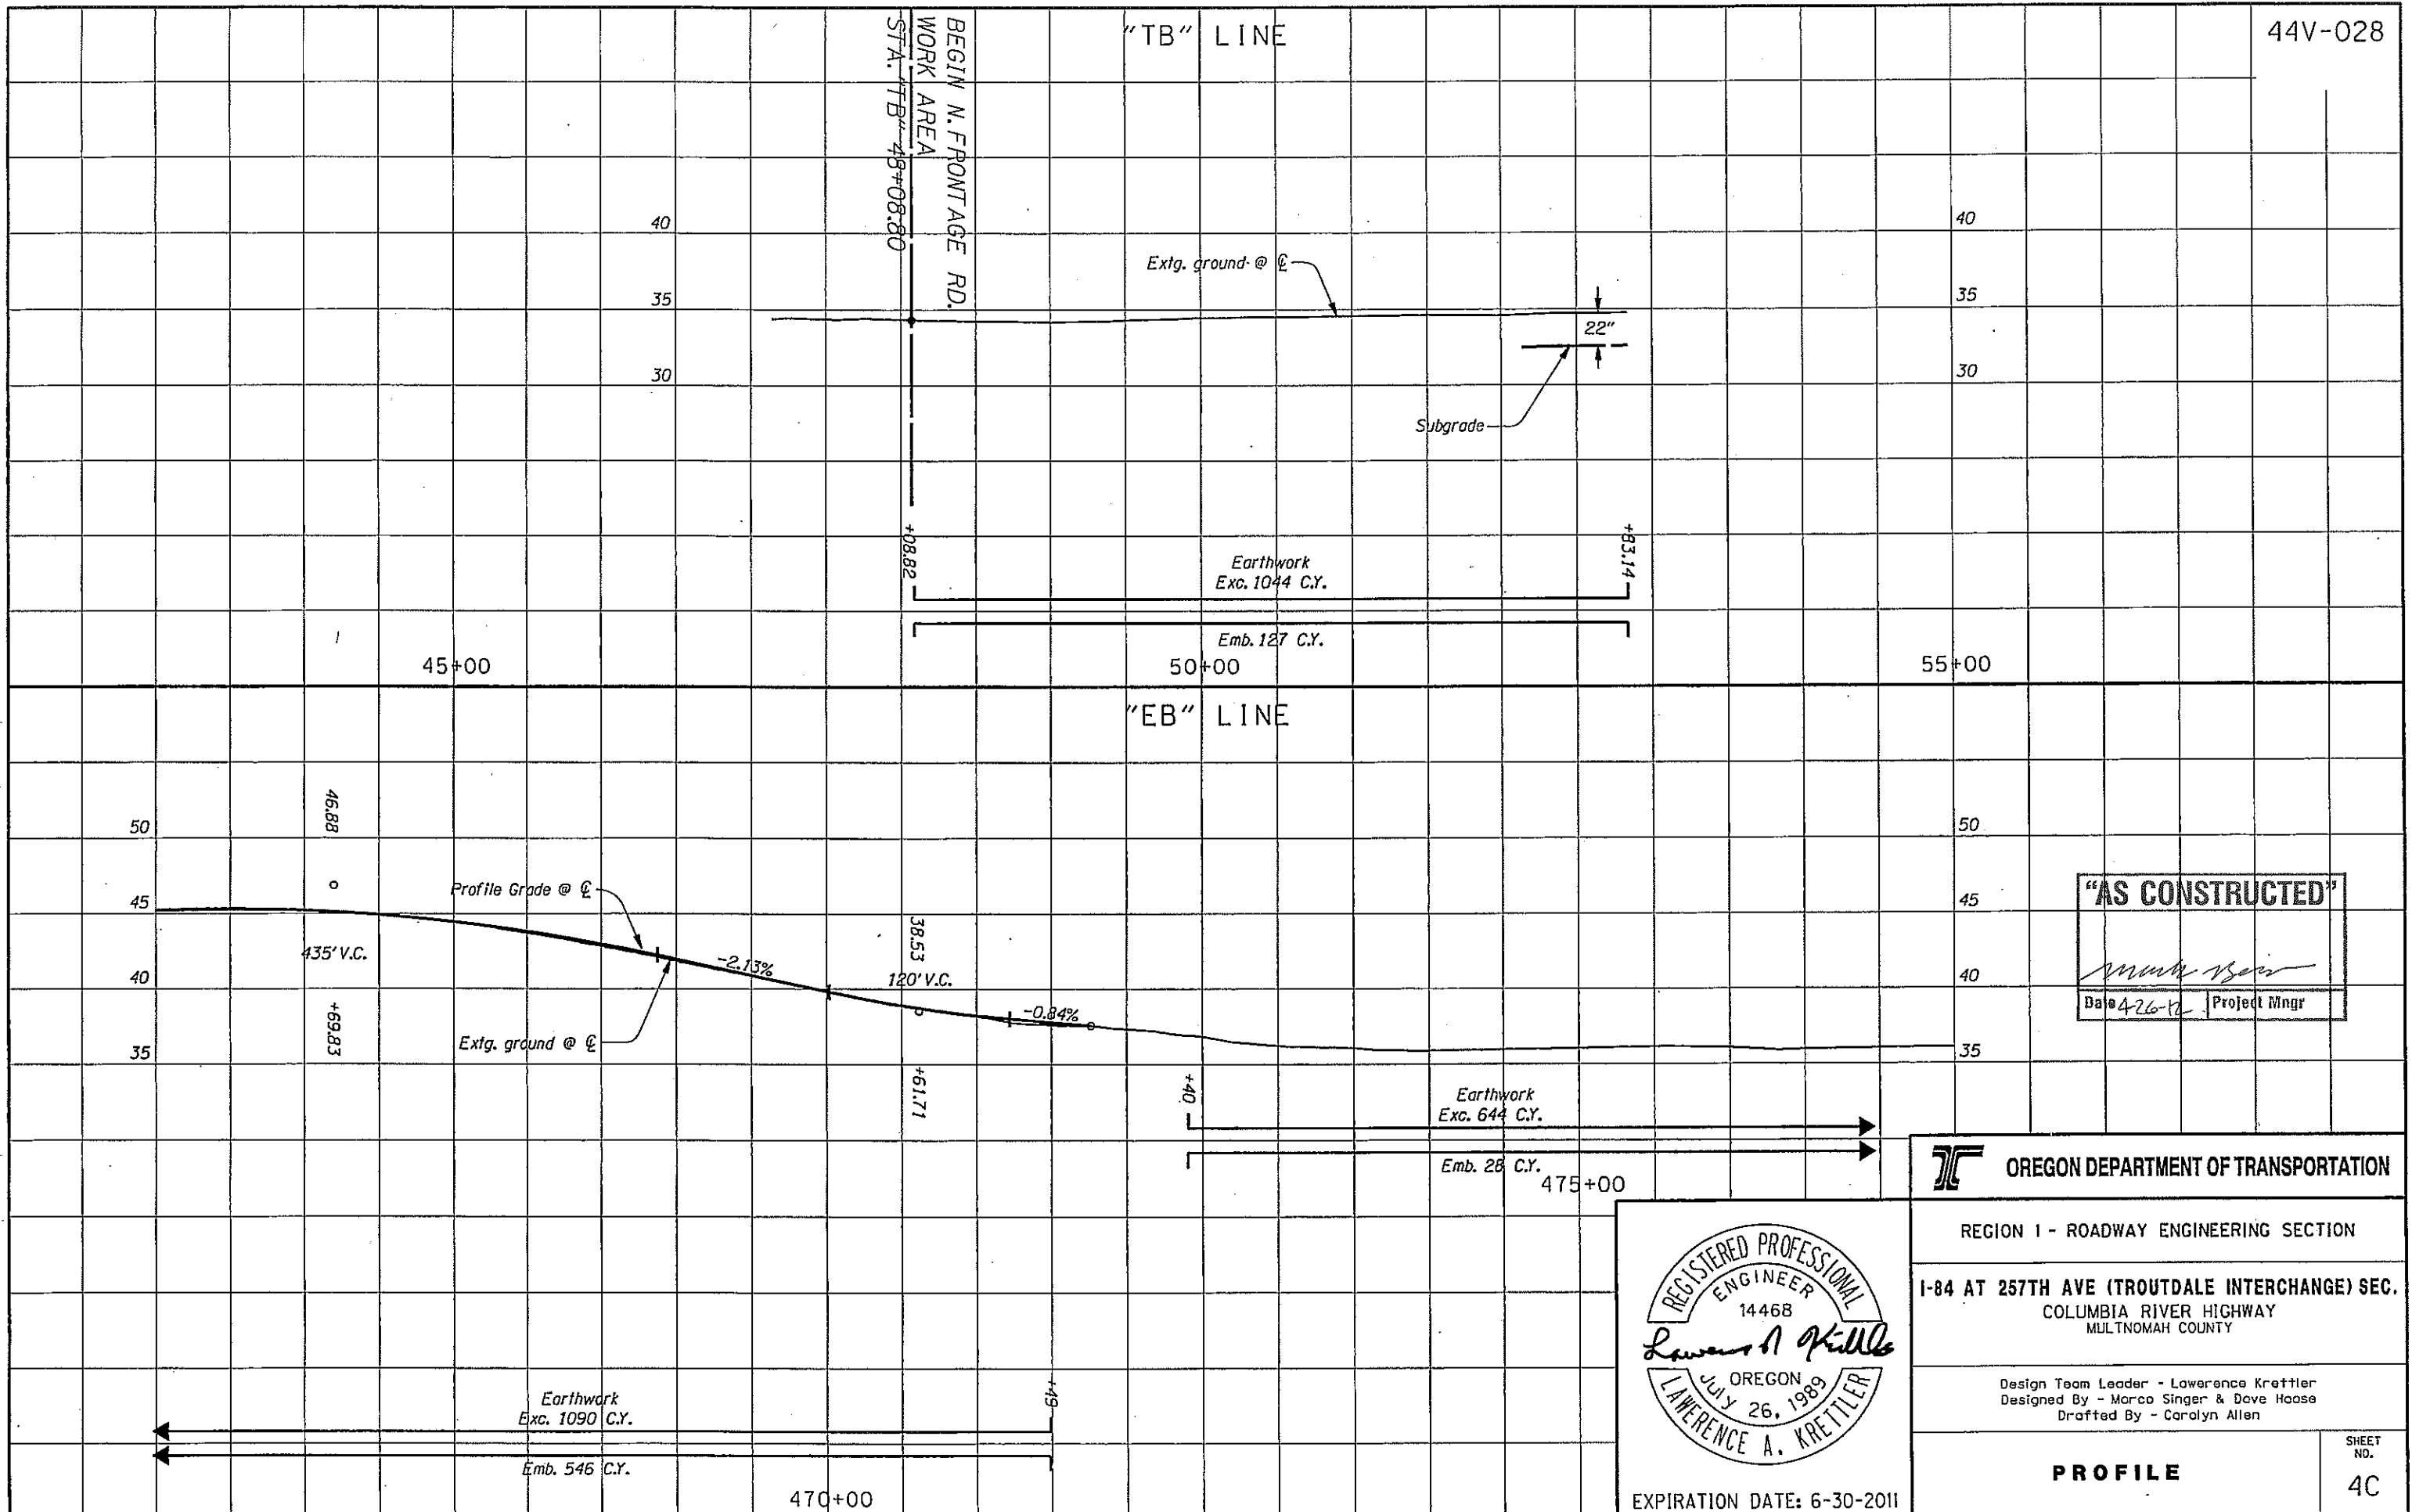

"AS CONSTRUCTED"
Marco Singer
 Date 4-26-10 Project Mngr

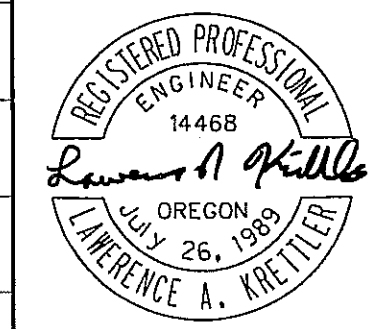

OREGON DEPARTMENT OF TRANSPORTATION

REGION 1 - ROADWAY ENGINEERING SECTION


1-84 AT 257TH AVE (TROUTDALE INTERCHANGE) SEC.
 COLUMBIA RIVER HIGHWAY
 MULTNOMAH COUNTY

Design Team Leader - Lawrence Kretzler
 Designed By - Marco Singer & Deve Hoese
 Drafted By - Carolyn Allen


PROFILE

SHEET NO. 4C


EXPIRATION DATE: 6-30-2011

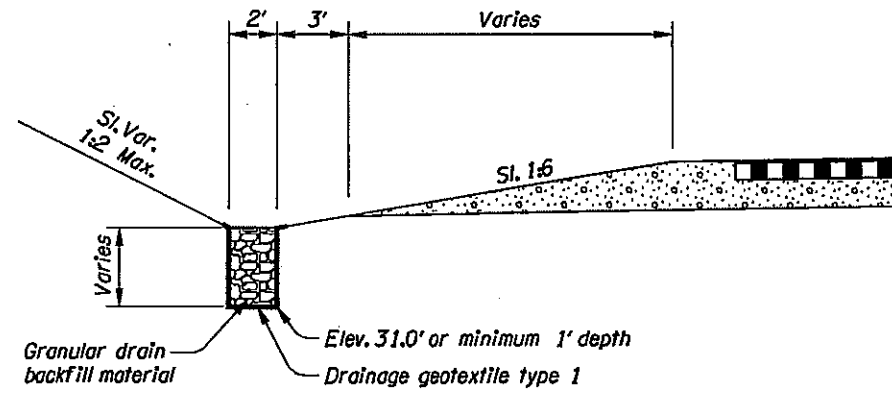


INFILTRATION SWALE TYPE A

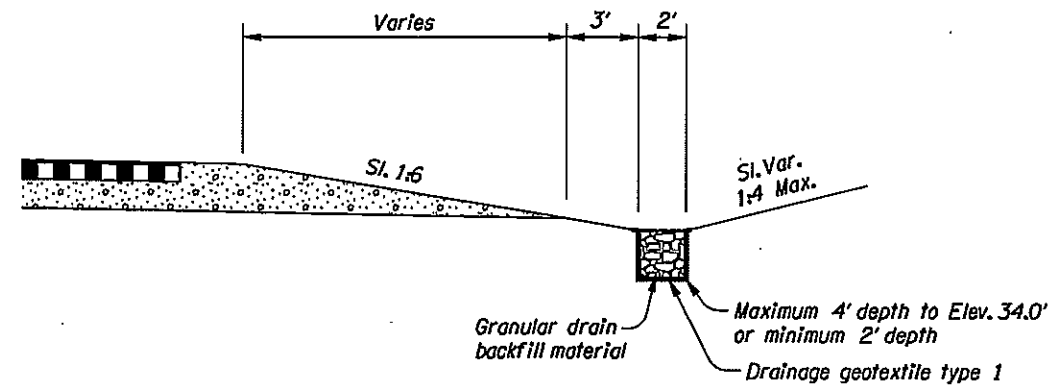


INFILTRATION SWALE TYPE B

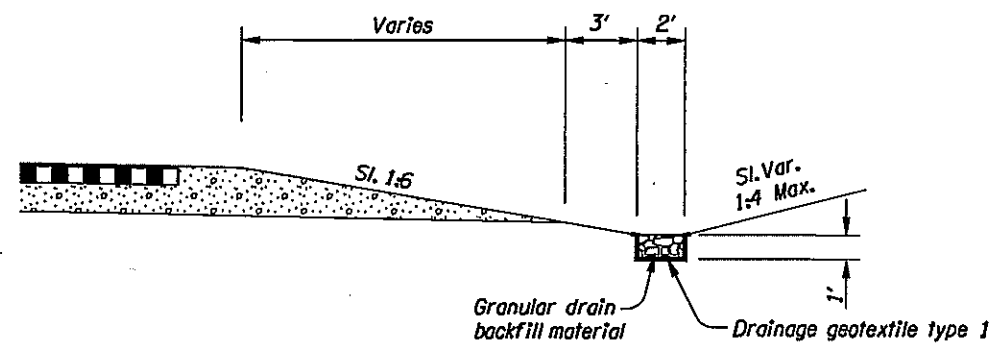


INFILTRATION SWALE TYPE C

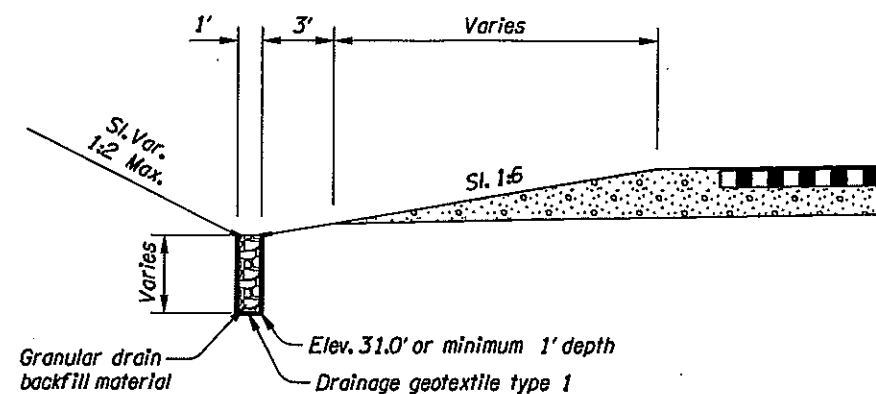

INFILTRATION SWALE TYPE D

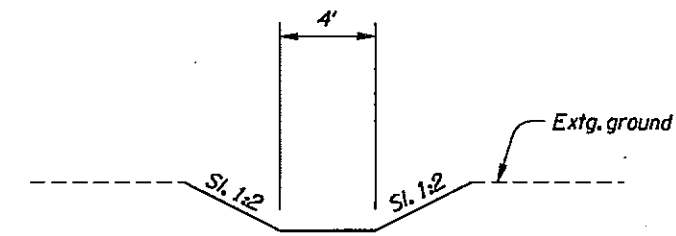


DITCH

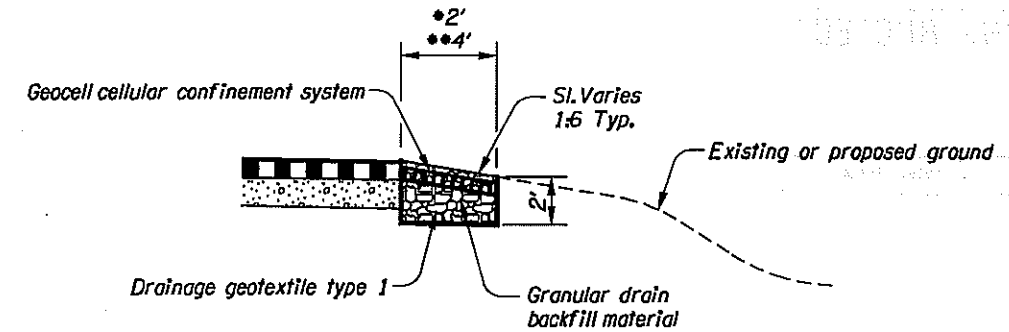

- Sta. "L4E" 455+91.80 to Sta. "L4E" 459+70.00
- Sta. "EB" 459+71.35 to Sta. "EB" 470+03.60

INFILTRATION SLOPE TYPE A

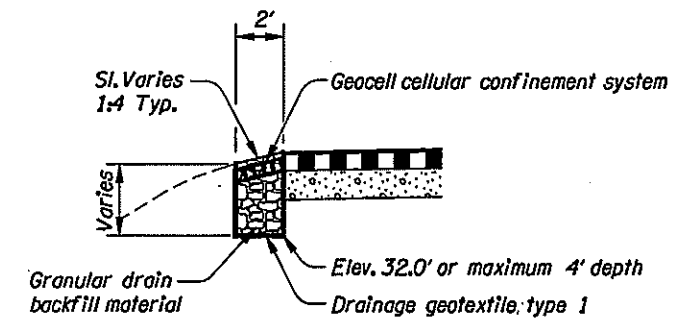


INFILTRATION SLOPE TYPE B

"AS CONSTRUCTED"
 Mark Van
 Date 4-26-12 Project Mngr


REGISTERED PROFESSIONAL ENGINEER
 58552
 OREGON
 JULY 21, 1998
 CHRISTINE J. HIGGINS
 EXPIRES 06-30-11

<p>OREGON DEPARTMENT OF TRANSPORTATION</p>	
<p>DAVID EVANS AND ASSOCIATES INC. 2100 Southwest River Parkway Portland Oregon 97201 Ph: 503.223.6663</p>	
<p>I-84 AT 257TH AVE (TROUTDALE INTERCHANGE) SEC. COLUMBIA RIVER HIGHWAY MULTNOMAH COUNTY</p>	
<p>Reviewed By - Craig Sheahan Designed By - Karina Nordahl Drafted By - Edita Bogustawski</p>	
<p>DRAINAGE DETAILS</p>	<p>SHEET NO. GJ</p>

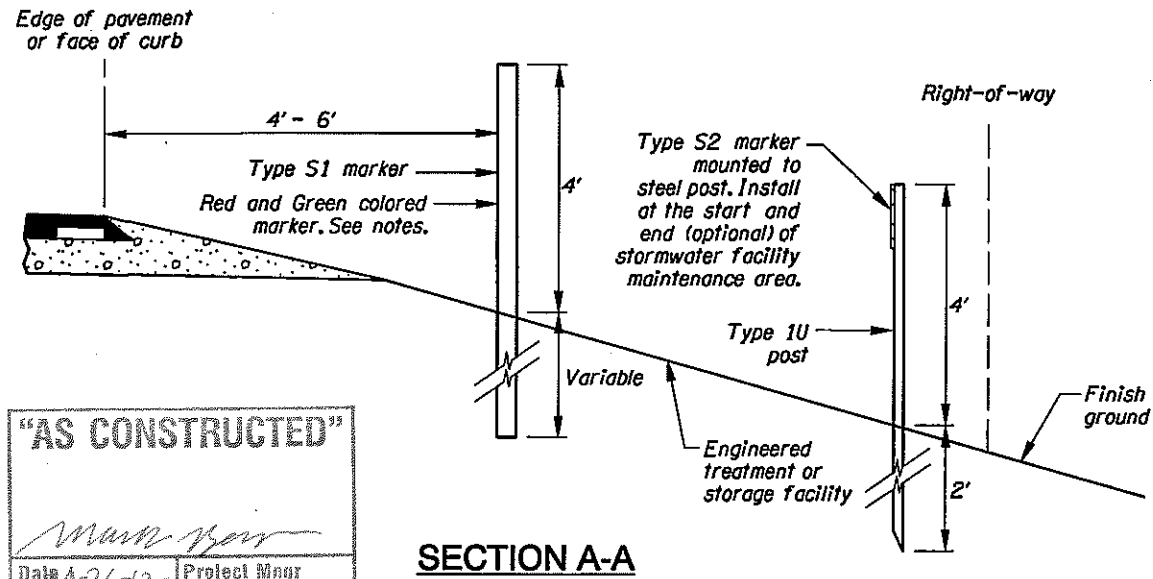


"AS CONSTRUCTED"
 Date 4-26-12 Project Mngr

SECTION A-A

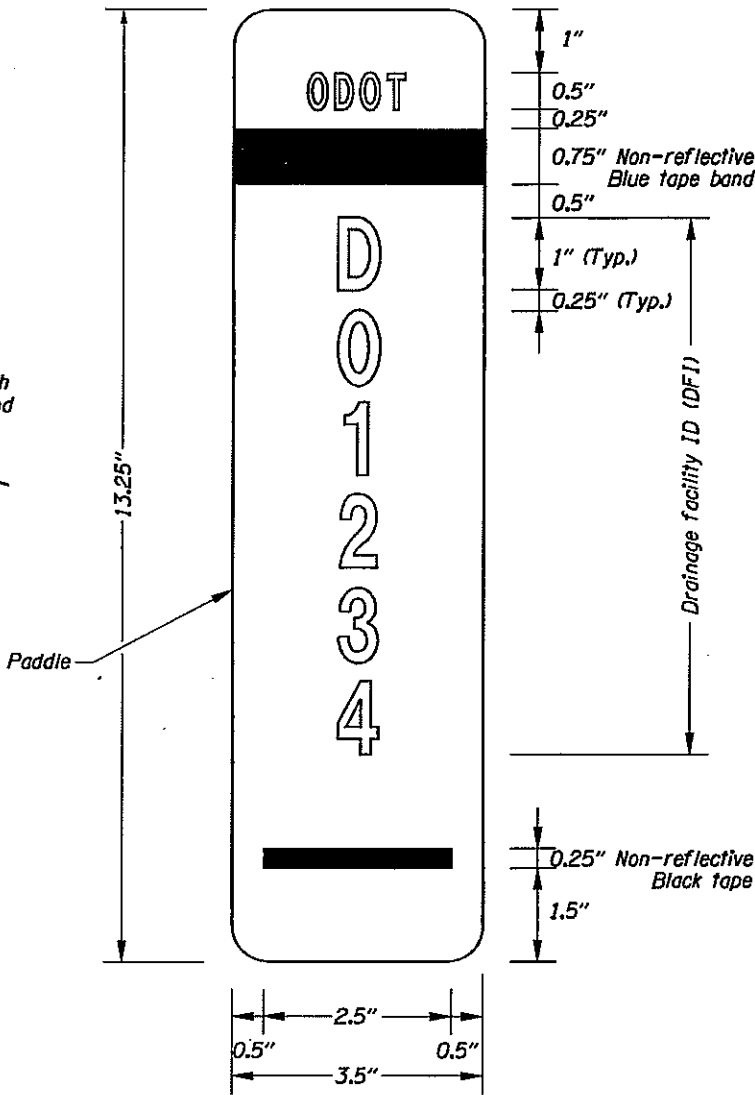

TYPE S2 MARKER
 (STATE SUPPLIED ITEM)

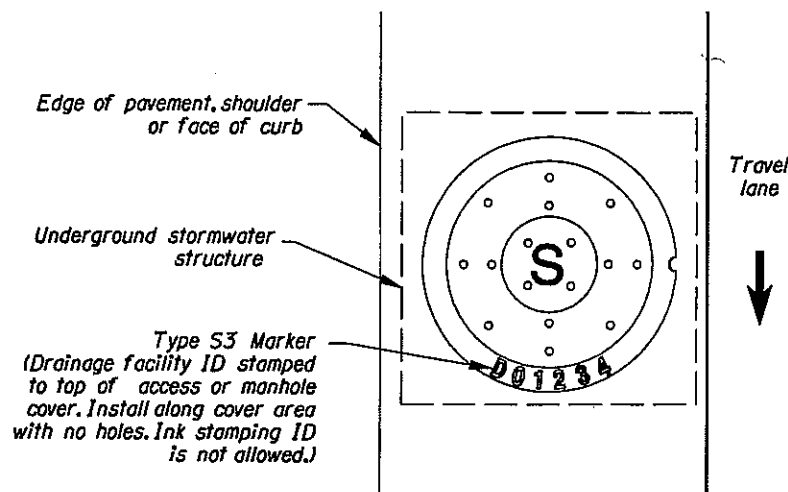

TYPE S3 MARKER INSTALLATION DETAIL


MARKER TABLE

FACILITY LOCATION		DFI #	TYPE S2 MARKER LOCATION		TYPE S1 MARKER	
STATION	MP		BEGIN	END	RED	GREEN
"L4E" 455+91.80	16.59	DXXXXX	✓		✓	
"EB" 470+03.60	-	DXXXXX				✓
"EB" 472+65.42	-	DXXXXX	✓		✓	
"EB" 488+68.12	-	DXXXXX				✓
"XBS" 22+84.67	-	DXXXXX	✓		✓	
"TB" 48+42.47	-	DXXXXX				✓
"XBS" 22+97.33	-	DXXXXX	✓		✓	
"XBS" 5+50.09	-	DXXXXX				✓
"XB" 34+33.10	17.35	DXXXXX	✓		✓	
"GR" 2+67.50	-	DXXXXX				✓

✓ Check where appropriate
 Red = Beginning of facility
 Green = End of facility

Notes:

- Stormwater Facility Field Marker Type S1:**
- See Standard Drawing TM570 for Type 2 flexible plastic post dimensions. Do not mount reflective sheeting to flexible plastic post.
 - A red Type S1 marker is used to mark the start of a stormwater facility maintenance area. A green Type S1 marker is used to mark the end of a stormwater facility maintenance area.
 - Place 4 to 6 feet from edge of pavement or face of curb.
 - See marker table for installation locations.
- Stormwater Facility Field Marker Type S2:**
- Paddle:**
 - Aluminum sheet, nominal thickness 0.050"
 - White non-reflective background
 - Mount paddle to one (1) Type 1U steel post using 3/16" diameter aluminum blind rivets and washers. See Standard Drawing TM 570 detail labeled "Steel Posts" for mounting a traffic target. Install paddle onto Type 1U steel post using the same hole pattern.
 - Text and numbers are Type C font in non-reflectorized black
 - Band is non-reflective blue tape
 - Do not mount paddle to other highway signing posts
 - Install paddle parallel to travel lane
 - Prepare paddle for each "DFI" noted in the marker table
 - Steel Posts:**
 - See Standard Drawing TM571 for Type 1U steel post dimensions
- Stormwater Facility Field Marker Type S3:**
- The top of access or manhole cover shall be stamped with the drainage facility ID. Ink stamping ID is not allowed.

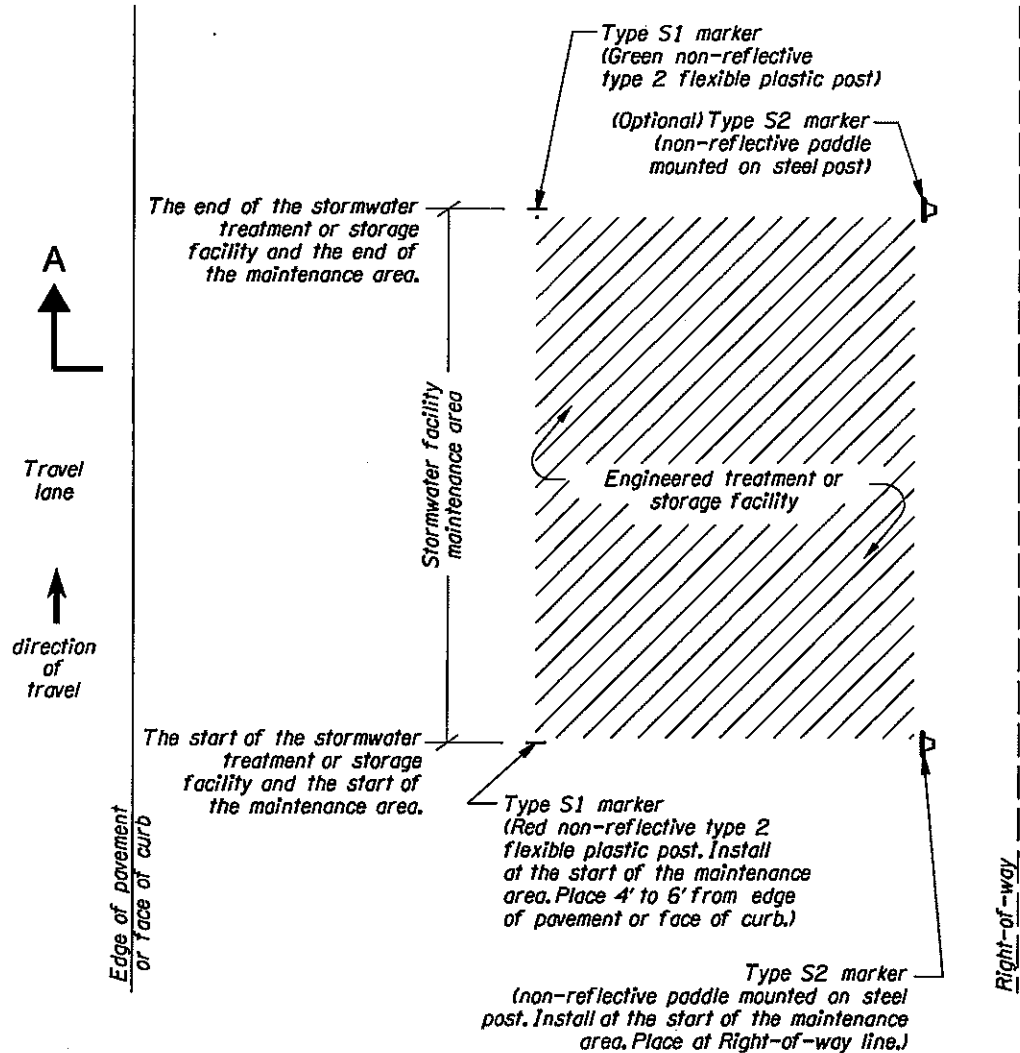

TYPE S1 & S2 MARKERS INSTALLATION DETAIL

OREGON DEPARTMENT OF TRANSPORTATION

DAVID EVANS AND ASSOCIATES INC.
 2100 Southwest River Parkway
 Portland Oregon 97201 Ph: 503.223.6663

I-84 AT 257TH AVE (TROUTDALE INTERCHANGE) SEC.
 COLUMBIA RIVER HIGHWAY
 MULTNOMAH COUNTY

Reviewed By - Craig Sheahan *CSH*
 Designed By - Karina Nordahl
 Drafted By - Edita Boguslawski

STORMWATER TREATMENT AND STORAGE FACILITY FIELD MARKERS

SHEET NO. **GJ-2**