

OPERATION & MAINTENANCE MANUAL

Water Quality Infiltration Swale

Manual prepared: April 2019



DFI No. D00540

Figure 1: DFI No. D00540, looking East

Identification

Drainage Facility ID (DFI): D00540
Facility Type: Water Quality Infiltration Swale
Construction Drawings: (V-File Numbers) 44V-028
Location: District: 2B
Highway No.: 002
Mile Post: 16.93 to 17.21,
I-84 East, NW Frontage Rd.

1. Manual Purpose

The purpose of this manual is to outline inspection needs and summarize maintenance actions.

2. Facility Location

DFI D00540 replaces the existing water quality DFI's D01050 and D00282. The location map below details the facility location. The location map below details the facility location. The highway, mile posts, side streets, access location, and stormwater flow directions are noted on the map.

Facility location type: Roadway shoulder

Flow direction: East to West, Infiltration Swale





Figure 2: NW Frontage Rd. D00540


3. Facility Summary

The length and width of a swale is based on the bottom dimensions.


The bottom length and bottom width of the swale is:

Component	Length (feet)	Width (feet)	Type
Infiltration Swale			
“EB” 472+65 to 475+50	285	2	A
“EB” 475+50 to 480+75	525	1	D
“EB” 480+75 to 488+68	793	2	A

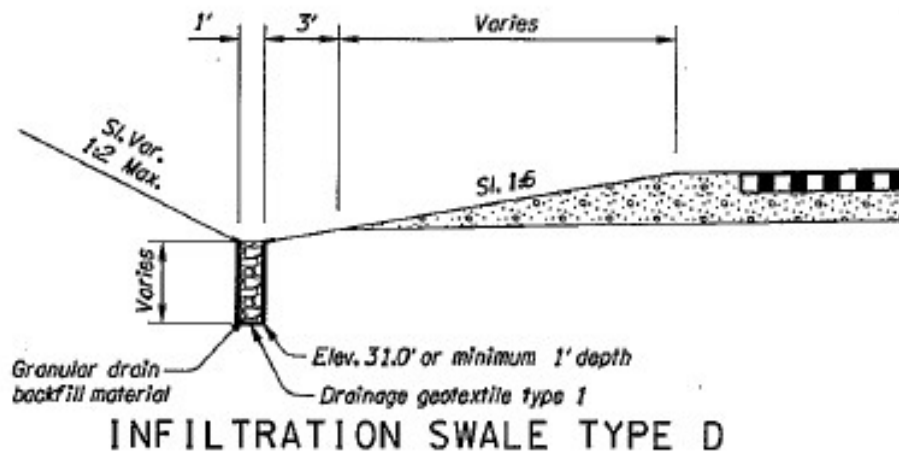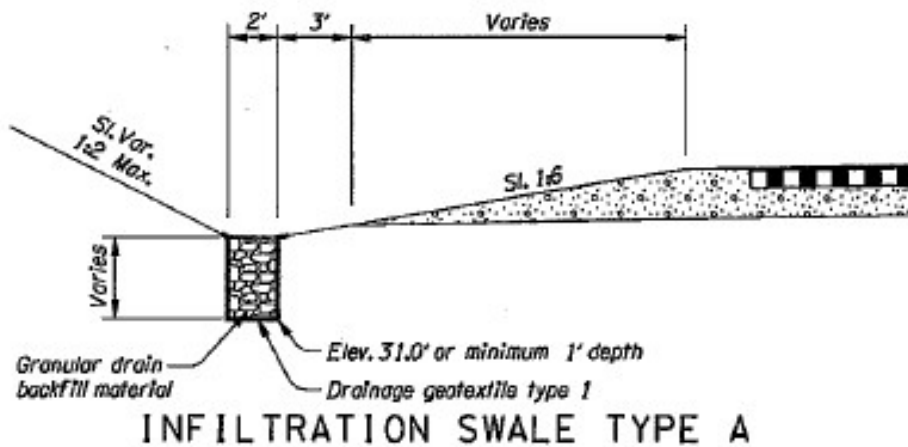

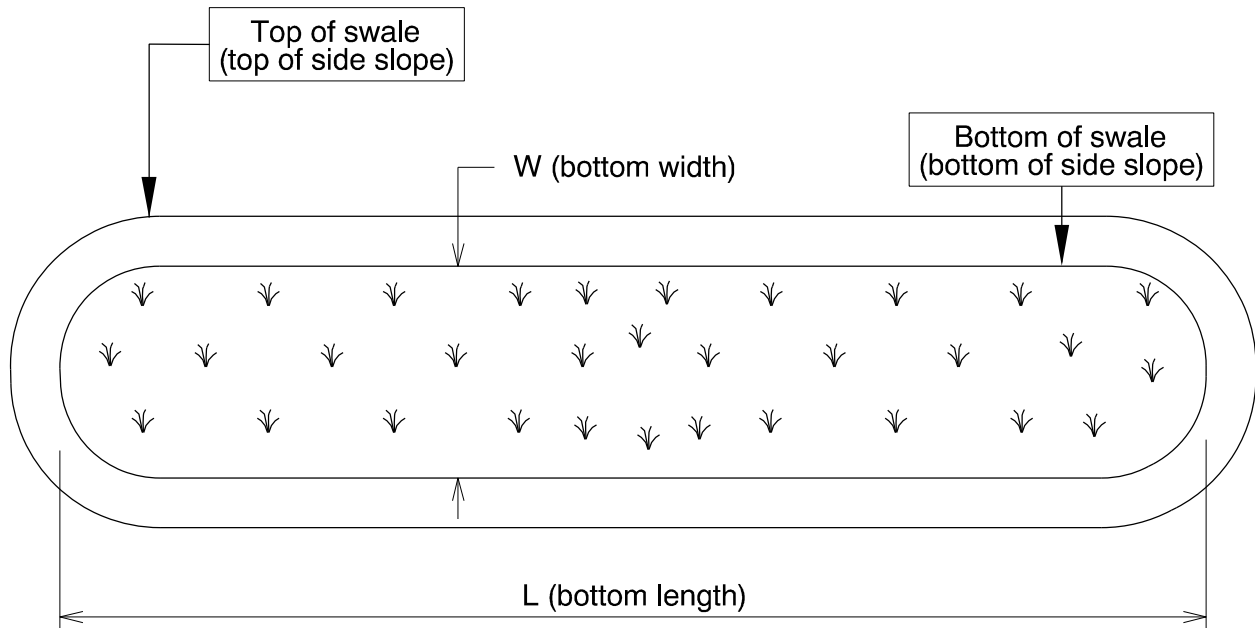

The depth of the swale is the vertical distance measured from the bottom of the swale to the top. The slope of the swale sides is presented by a vertical distance (rise) followed by the horizontal distance (run).

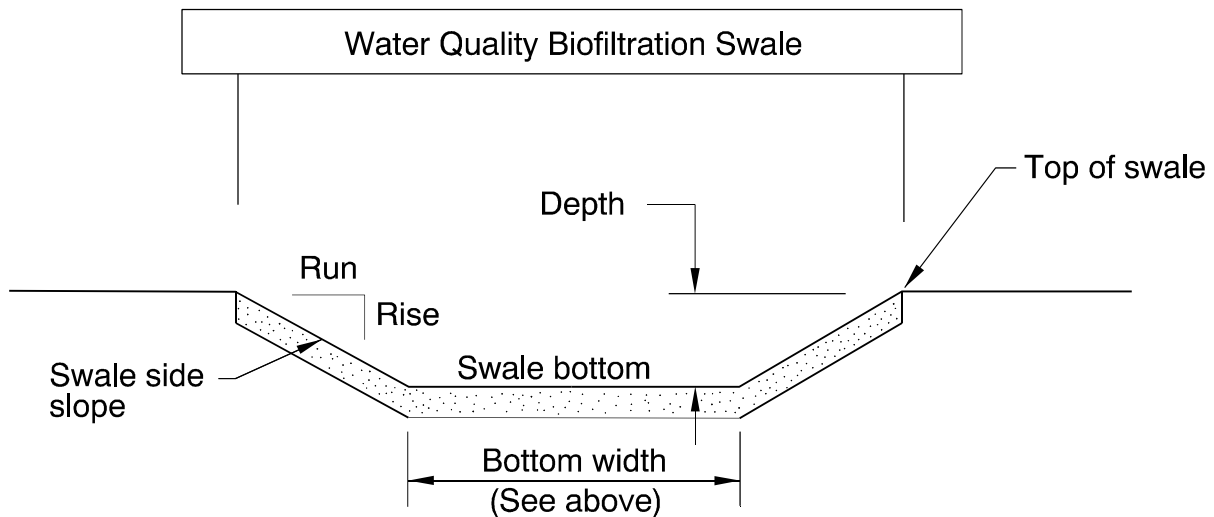

Site Specific Information: NW Frontage Rd. is a one way road, traveling east to west. The infiltration swale is similar to a Biofiltration Swale, it is long and linearly constructed into the existing slope. The treatment is provided and pollutants are removed by infiltration processes. The water is stored in the voids in the trench gravels until it percolates into the surrounding soil. There are no subsurface drain pipes in this facility.

The water generally is conveyed into the ground during routine storms and the facility can act as a roadside ditch during the more severe storms.

4. Facility Access

Maintenance access to the facility:

<input type="checkbox"/> Roadside pad	<input checked="" type="checkbox"/> Roadside shoulder
<input type="checkbox"/> Access road with Gate	<input type="checkbox"/> Access road without Gate



Figure 3: Looking west at Infiltration Swale

5. Operational Components / Maintenance Items

Classification

This facility is classified as an:

<input checked="" type="checkbox"/> On-line Swale	<input type="checkbox"/> Off-line Swale
A swale that does not include a high flow bypass component; flow drains into and through the facility	A swale that treats low/small flows and diverts high flows using a bypass component

Bypass Component

This facility includes a high flow bypass component:

<input checked="" type="checkbox"/> No	<input type="checkbox"/> Yes
There is no bypass component. High flows drain into and through the facility	There is a bypass component. Only low/small flows drain into the swale. High flows are diverted around the swale using a bypass component

Operational Components

A swale has many components that assist with treatment, conveyance, and reducing flow velocity to minimize erosion. The components in use can vary depending if the facility was designed to operate on-line or off-line. The facility components table (**Table 1**) has been provided to highlight the applicable components for this facility. The component is in use when the box contains an “x” (e.g.).

The Standard Operation Manual for Water Quality Biofiltration Swales (implemented March 2017) outlines facility operation, typical footprint configuration, and component definitions and details. A link to the manual is attached to the feature marker in TransGIS. <https://gis.odot.state.or.us/TransGIS/>

Operational Plan

The applicable standard operational plan for this facility is:

<input checked="" type="checkbox"/> Operational Plan A	<input type="checkbox"/> Operational Plan B	<input type="checkbox"/> Operational Plan C
An on-line swale with roadside ditches	An on-line swale with piped inlets and outlets	An off-line swale with a piped high flow bypass
A standard operational plan illustrates the general facility footprint configuration and explains the purpose of each facility component. Operational plans (A, B, C) are provided in the Standard Operation Manual.		

See Appendix A for the site specific operational plan.

Maintenance Items

Operational components marked in **Table 1** should be inspected and maintained according to Section 7. Each facility component is defined and detailed in the Standard Operation Manual using the associated ID number indicated below.

Table 1: Swale Components		ID #
Manholes/Structures		
Pre-treatment manhole	<input type="checkbox"/>	S1
Weir type flow splitter/flow splitter manhole	<input type="checkbox"/>	S2
Orifice type flow splitter/flow splitter manhole	<input type="checkbox"/>	S3
Standard manhole	<input type="checkbox"/>	S4
Swale Inlet		
Pavement sheet flow	<input checked="" type="checkbox"/>	S5
Inlet Pipe (s)	<input type="checkbox"/>	S6
Open channel inlet	<input type="checkbox"/>	S7
Riprap pad	<input type="checkbox"/>	S8
Ground Cover		
Grass bottom	<input type="checkbox"/>	S9
Grass side slopes	<input type="checkbox"/>	S10
Granular drain rock	<input checked="" type="checkbox"/>	S11
Plantings	<input type="checkbox"/>	S12
Underground Components		
Geotextile fabric	<input checked="" type="checkbox"/>	S13
Water quality mix	<input type="checkbox"/>	S14
Perforated pipe	<input type="checkbox"/>	S15
Porous pavers (access grid)	<input type="checkbox"/>	S16
Flow Spreader		
Rock basin (used at inlet)	<input type="checkbox"/>	S17
Anchored board (midpoint of swale or every 50 feet along swale bottom)	<input type="checkbox"/>	S18
Other: Infiltration Swale	<input checked="" type="checkbox"/>	S19
Swale Outlet		
Catch basin with grate	<input type="checkbox"/>	S20
Outlet Pipe (s)	<input type="checkbox"/>	S21
Open channel outlet	<input type="checkbox"/>	S22
Auxiliary Outlet:	<input type="checkbox"/>	S23
Outfall Type		
Waterbody (Creek/Lake/Ocean)	<input type="checkbox"/> C <input type="checkbox"/> L <input type="checkbox"/> O	S24
Ditch	<input type="checkbox"/>	S25
Storm drain system	<input type="checkbox"/>	S26
Outfall Components		
Riprap pad	<input type="checkbox"/>	S27
Riprap bank protection	<input type="checkbox"/>	S28

6. Maintenance

Maintenance Frequency/Maintain Records

- a. Inspect annually. Preferably prior to the rainy season.
- b. Clean and maintain as necessary. Refer to Activity 125 for conditions when maintenance is needed.
- c. Keep a record of inspections, maintenance, and repairs.

Maintenance Guide/Maintenance Actions

The ODOT Routine Road Maintenance Water Quality and Habitat Guide (the *Blue Book*) outlines the standard maintenance actions for water quality facilities under Activity 125.

There are standard maintenance tables for standard ODOT designs. The maintenance tables describe the maintenance component, the defect or problem, the condition when maintenance is needed, and the recommended maintenance to correct the problem. Use the following tables to maintain ODOT swales:

- Table 1 (General Maintenance): Contains general maintenance and inspection guidelines that are applicable to all ODOT water quality facilities
- Table 3 (Maintenance of Water Quality or Biofiltration Swales): Contains maintenance information for swales

The *Blue Book* can be viewed at the following website:

http://www.oregon.gov/ODOT/Maintenance/Documents/blue_book.pdf

7. Limitations

Access grid installed:

<input checked="" type="checkbox"/> No	<input type="checkbox"/> Yes
There are no duty porous pavers installed in this swale	

Swales are designed to allow equipment access along the bottom. If an access grid is **NOT** installed, vehicles entering the swale can create depressions (tire ruts), damage vegetation, and damage structural components (e.g. flow spreaders). These conditions may result in poor treatment and drainage performance.

Equipment wheels should be kept on the tops and side slopes. Mower arms may be run along the swale bottom.

8. Waste Material Handling

Material removed from the facility is defined as waste by the Department of Environmental Quality (DEQ). Refer to the roadwaste section of the ODOT Maintenance Yard Environmental Management System (EMS) Policy and Procedures Manual for disposal options:

http://www.oregon.gov/ODOT/Maintenance/Documents/ems_manual.pdf


Contact any of the following for more detailed information about management of waste materials found on site:

ODOT Clean Water Unit	(503) 986-3008
ODOT Statewide Hazmat Coordinator	(503) 667-7442
ODOT Region 1 Hazmat Coordinator	(503) 731-8290
ODOT Region 2 Hazmat Coordinator	(503) 986-2647
ODOT Region 3 Hazmat Coordinator	(541) 957-3594
ODOT Region 4 Hazmat Coordinator	(541) 388-6186
ODOT Region 5 Hazmat Coordinator	(541) 963-1590
ODEQ Northwest Region Office	(503) 229-5263


A Appendix A – Site Specific Operational Plan

Contents: Appendix A plan sheets include raster images of the as-built plans. The original drawings were not located.

Operational Plan: DFI D00540

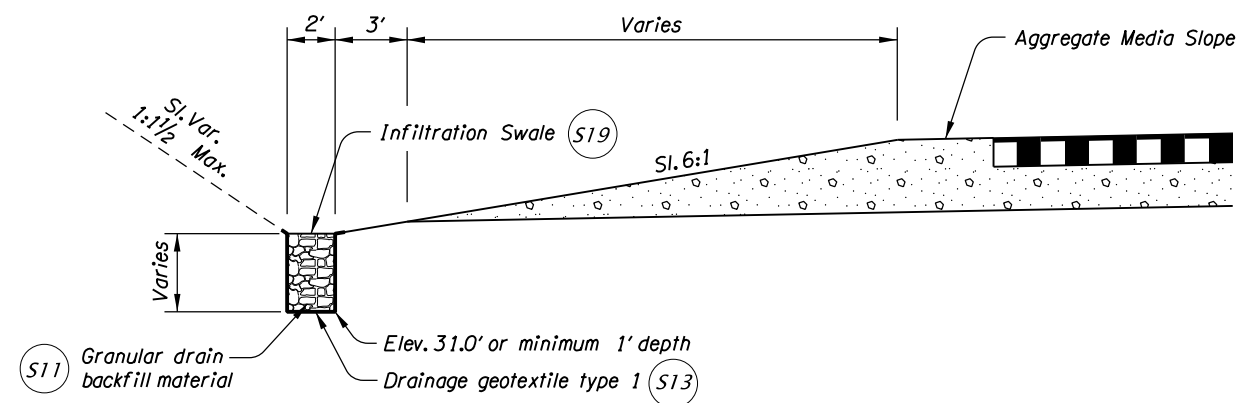

INFILTRATION SWALE TYPE A

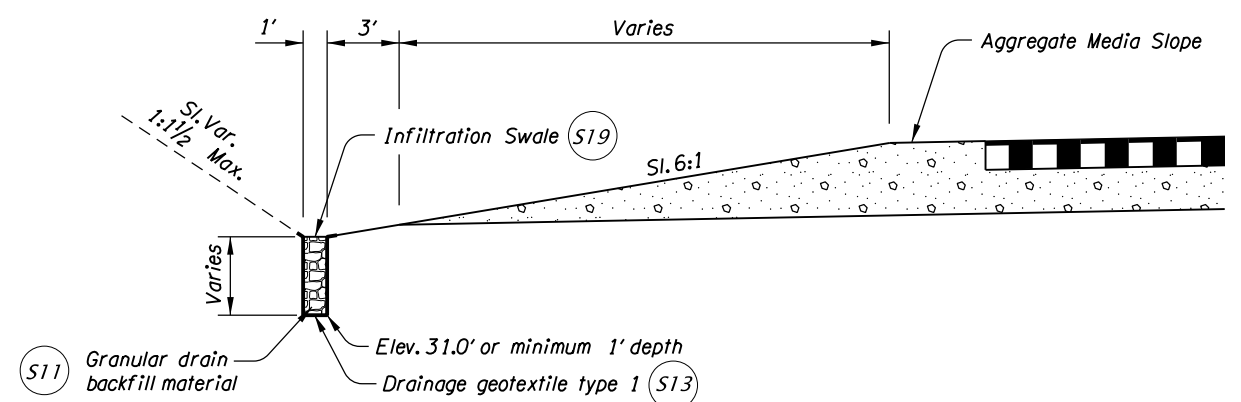

INFILTRATION SWALE TYPE D

TYPICAL SECTION
N.T.S.

- LEGEND:
- (X#) Facility Component (see table 1 in O&M Manual)
 - and ○ or ● and ○ Manhole
 - and □ or ■ and □ Inlet
 - Storm Pipe (Facility)
 - Storm Pipe
 - ← Conveyance Direction
 - ↔ Pavement / Facility Flow Path
 - ← Traffic Flow Direction



Sht. 1 of 3

Prepared By:
Alan Babicky

Drafted By:
Alan Babicky



DFI D00540
MAINTENANCE DISTRICT 2B HWY 002
INFILTRATION SWALE
 HIGHWAY MP 16.93 - 17.21
 MULTNOMAH COUNTY

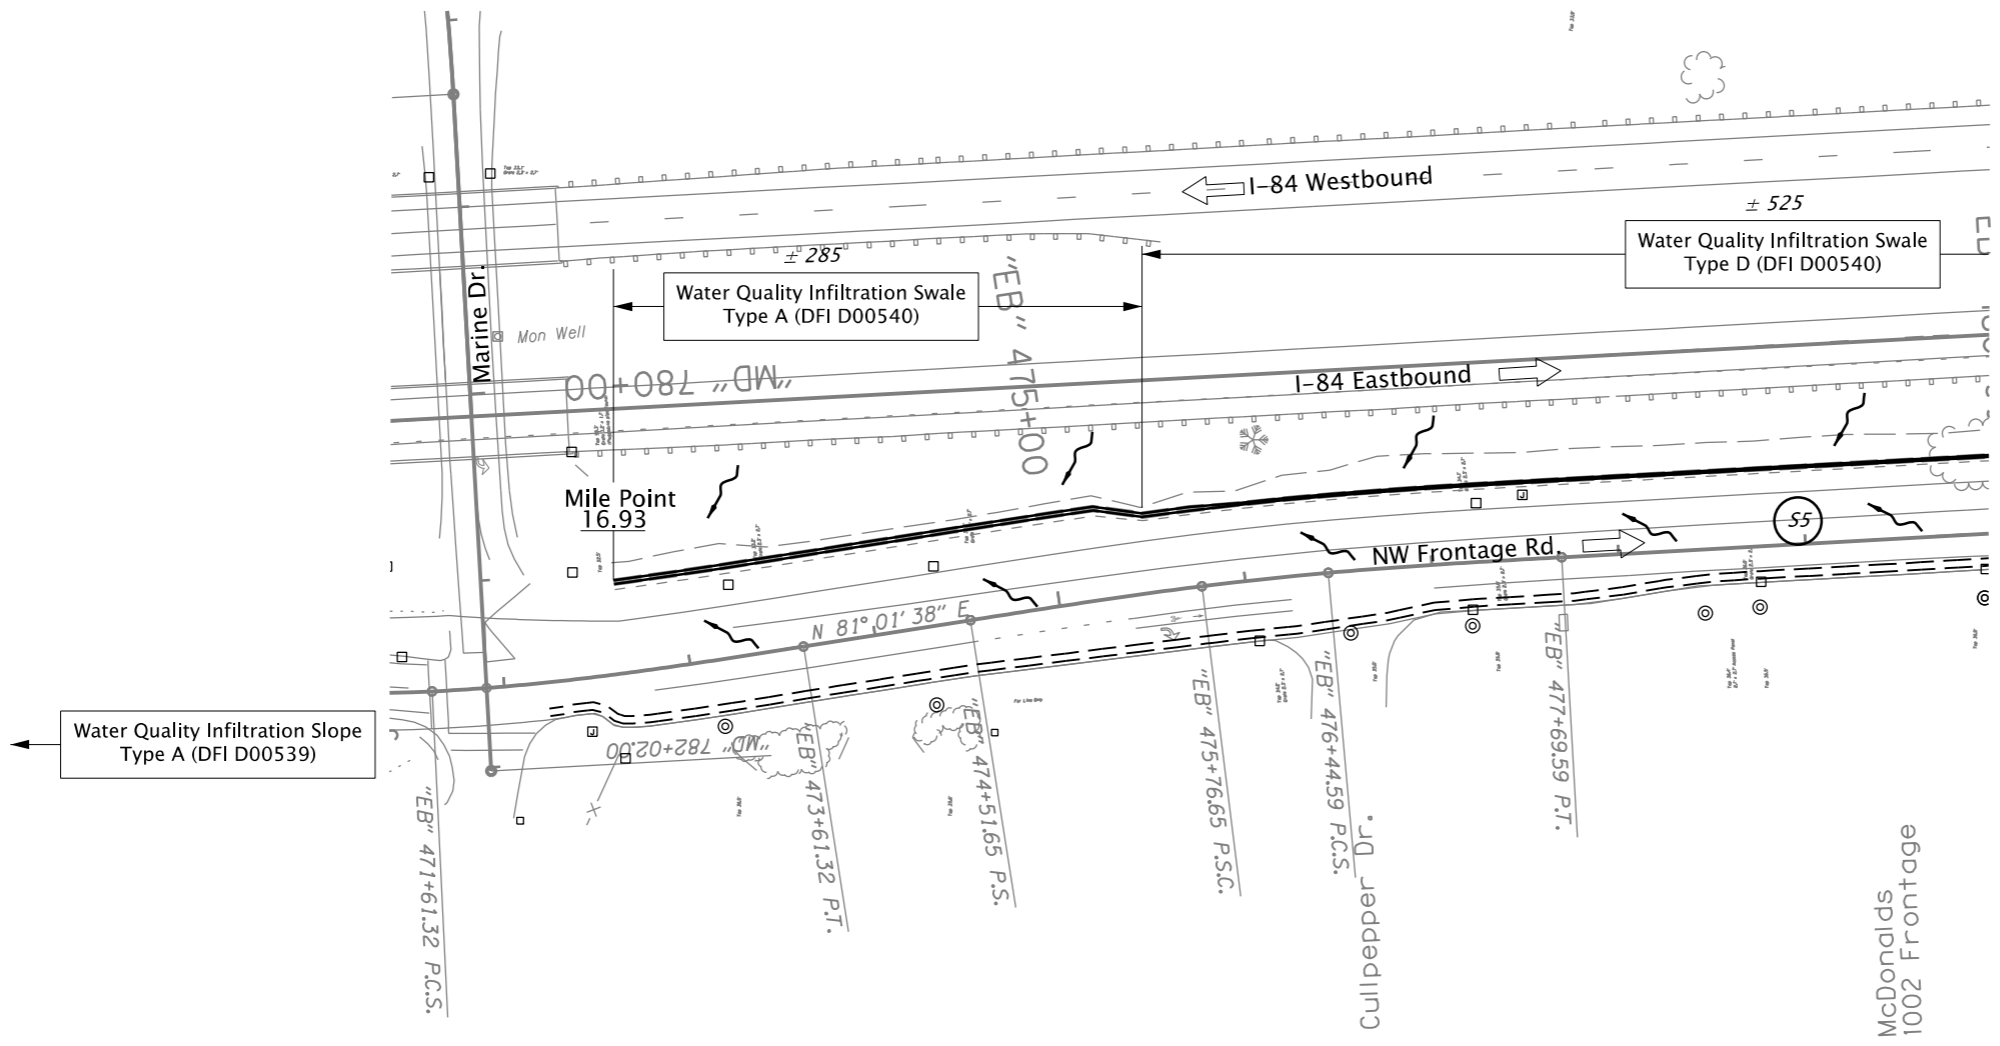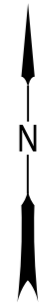


- LEGEND:**
- Facility Component (see table 1 in O&M Manual)
 - Manhole
 - Inlet
 - Storm Pipe (Facility)
 - Storm Pipe
 - Conveyance Direction
 - Pavement / Facility Flow Path
 - Traffic Flow Direction

PLAN
N.T.S.


Sht. 2 of 3

Prepared By:
Alan Babicky

Drafted By:
Alan Babicky

 OREGON DEPARTMENT OF TRANSPORTATION

DFI D00540
MAINTENANCE DISTRICT 2B HWY 002
INFILTRATION SWALE
HIGHWAY MP 16.93 - 17.21
MULTNOMAH COUNTY

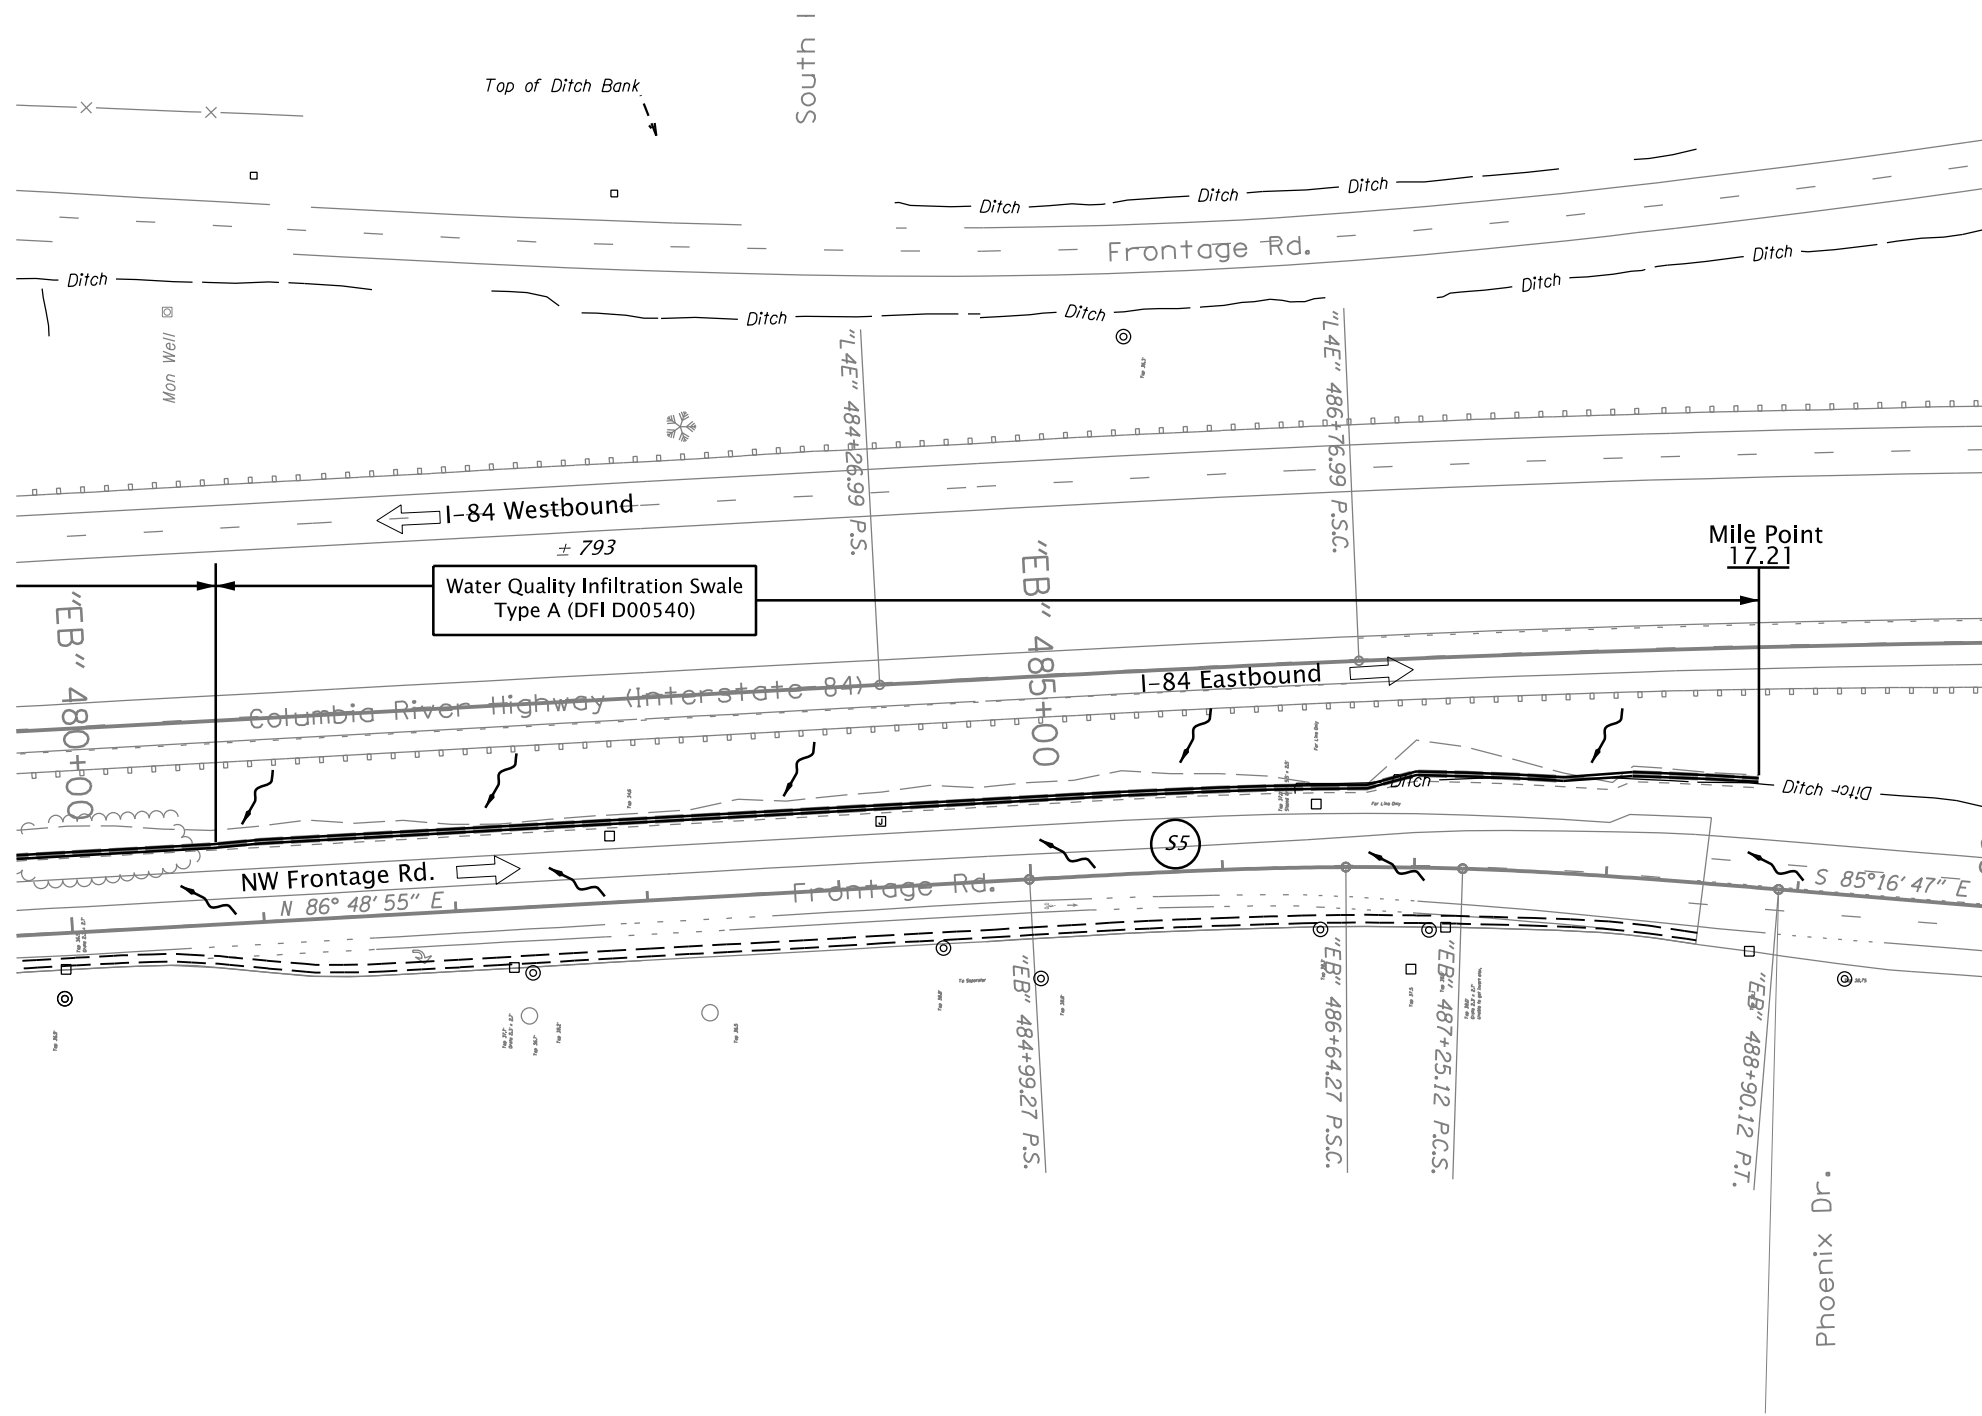

- LEGEND:**
- Facility Component (see table 1 in O&M Manual)
 - Manhole
 - Inlet
 - Storm Pipe (Facility)
 - Storm Pipe
 - Conveyance Direction
 - Pavement / Facility Flow Path
 - Traffic Flow Direction

PLAN
N.T.S.

Sht. 3 of 3

Prepared By:
Alan Babicky

Drafted By:
Alan Babicky



DFI D00540
MAINTENANCE DISTRICT 2B HWY 002
INFILTRATION SWALE
 HIGHWAY MP 16.93 - 17.21
 MULTNOMAH COUNTY

B Appendix B – Project Contract Plans

Contents:

Site Specific Subset of Project Contract Plan 44V-028

INDEX OF SHEETS	
SHEET NO.	DESCRIPTION
1	Title Sheet
1A	Index Of Sheets Cont'd. & Std. Drg. Nos.
1B	Std. Drg. Nos. Cont'd.

STATE OF OREGON DEPARTMENT OF TRANSPORTATION

PLANS FOR PROPOSED PROJECT

**GRADING, DRAINAGE, PAVING, PAVEMENT MARKERS, SIGNING,
ILLUMINATION, SIGNALS & ROADSIDE DEVELOPMENT**

I-84 AT 257TH AVE (TROUTDALE INTERCHANGE) SEC. COLUMBIA RIVER HIGHWAY

MULTNOMAH COUNTY
MARCH 2011


**BEGINNING OF
CONTRACT PROJECT**

STA. "RW" 317+09 (M.P. 13.96)

"AS CONSTRUCTED"
M. M. M. M.
Date 4-26-12 Project Mngr

END OF PROJECT

**STA. "XB" 36+38.20 =
STA. "RW" 501+60.55 (M.P. 17.44)**

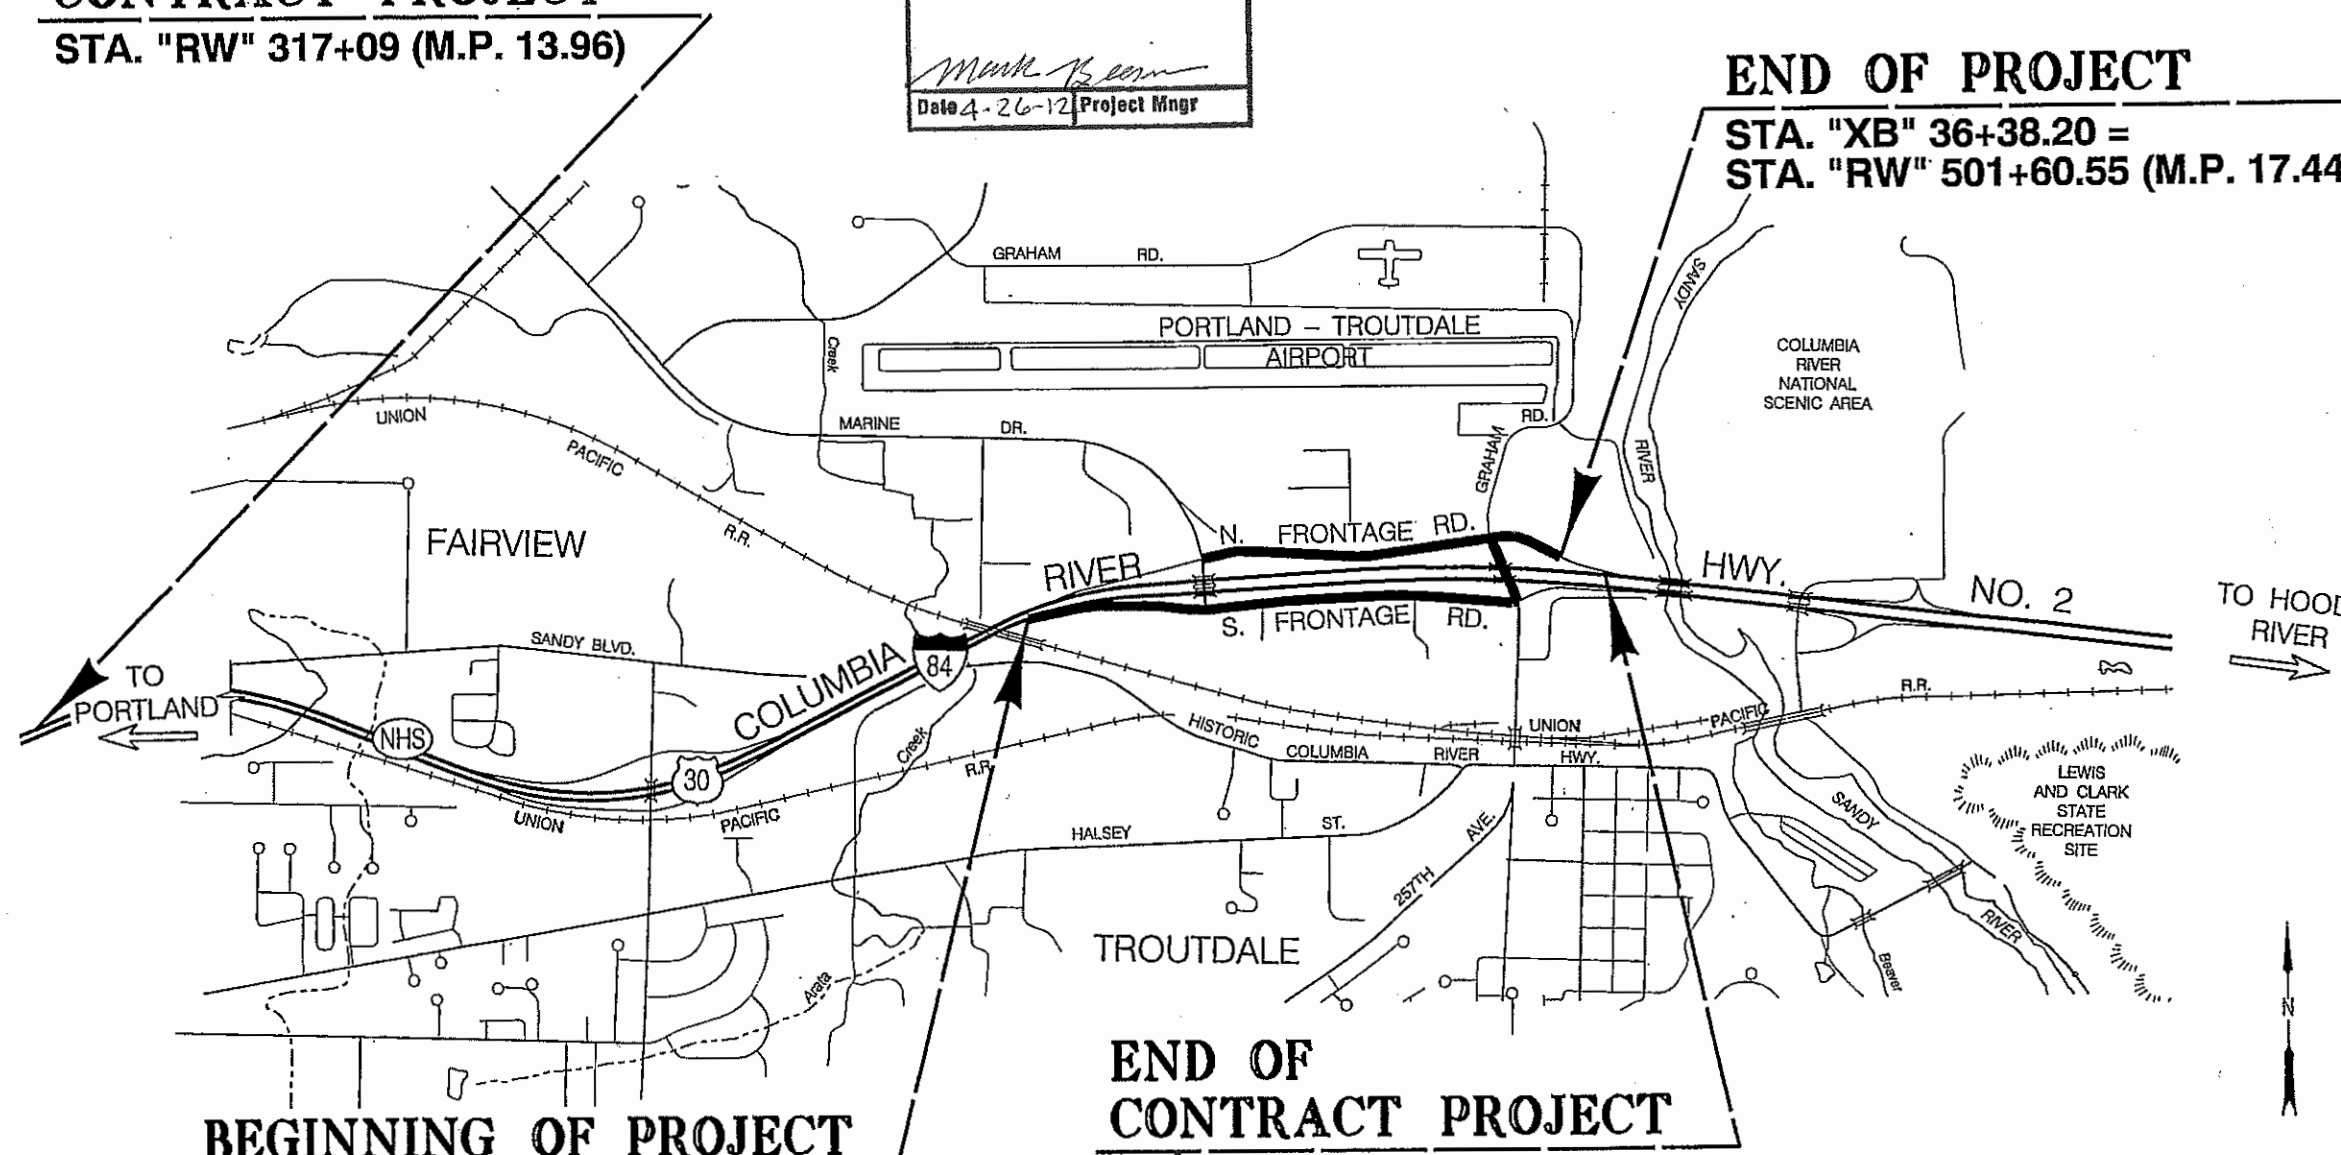


BEGINNING OF PROJECT

**STA. "L4E" 455+91.00
STA. "RW" 455+94.16 (M.P. 16.59)**

**END OF
CONTRACT PROJECT**

**STA. "XB" 42+00.30 (109.63 Lt.) =
STA. "RW" 507+19.70 (M.P. 17.54)**

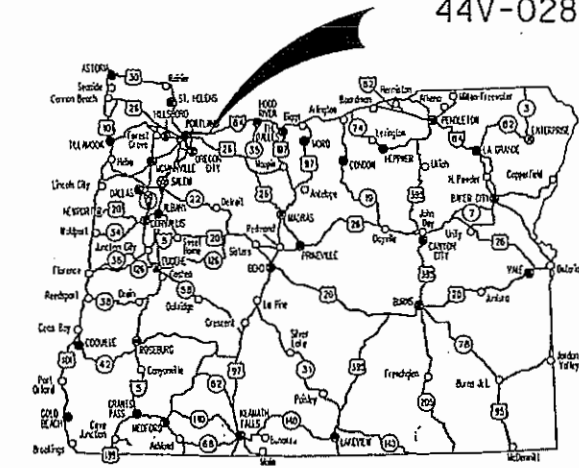

Overall Length Of Project - 0.85 Miles

ATTENTION:
Oregon Law Requires You To Follow Rules Adopted By The Oregon Utility Notification Center. Those Rules Are Set Forth In OAR 952-001-0010 Through OAR 952-001-0090. You May Obtain Copies Of The Rules By Calling The Center. (Note: The Telephone Number For The Oregon Utility Center Is (503) 232-1987.)

**LET'S ALL
WORK TOGETHER
TO MAKE THIS
JOB SAFE**

OREGON TRANSPORTATION COMMISSION

Gail Achterman	CHAIR
Michael Nelson	VICE-CHAIR
Mary Olson	COMMISSIONER
Alan Brown	COMMISSIONER
David Lohman	COMMISSIONER
Matthew L. Garrett	DIRECTOR OF TRANSPORTATION

These plans were developed using ODOT design standards. Exceptions to these standards, if any, have been submitted and approved by the ODOT Chief Engineer or their delegated authority.

Approving Authority: *Naveen G. Chandra*
Naveen G. Chandra, P.E.
Project Delivery Manager, Region 1

J. M. M.
Concurrence by ODOT Chief Engineer

**I-84 AT 257TH AVE (TROUTDALE INTERCHANGE) SEC.
COLUMBIA RIVER HIGHWAY
MULTNOMAH COUNTY**

FEDERAL HIGHWAY ADMINISTRATION	PROJECT NUMBER	SHEET NO.
OREGON DIVISION	STATE	1

T. 1 N., R. 3 E., W.M.



PE001770 000 J13

INDEX OF SHEETS, CONT'D.	
SHEET NO.	DESCRIPTION
2, 2A, 2A-2 thru 2A-13, Incl.	Typical Sections
2B, 2B-2 thru 2B-4, Incl.	Details <i>Added Sht 2B-3A</i>
2C, 2C-2 & 2C-3	Detour
2C-4 thru 2C-16, Incl.	Traffic Control Plans
2D	Pipe Data Sheet
3	Alignment
3A	General Construction
3B	Drainage & Utilities
3C	Profiles
4	Alignment
4A	General Construction
4B	Drainage & Utilities
4B-2	Drainage & Utilities
4C	Profiles
4D	Drainage Profiles
5	Alignment
5A	General Construction
5B	Drainage & Utilities
5B-2	Drainage & Utilities
5C	Profiles
5D	Drainage Profiles
6	Alignment
6A	General Construction
6B	Drainage & Utilities
6B-2	Drainage & Utilities
6C	Profiles
6D	Drainage Profiles
7	Alignment
7A	General Construction
7C	Profiles
B	Alignment
8A	General Construction
GEO/HYDRO	
GA	Erosion Control Details
GA-2 thru GA-8	Erosion Control Plans
GB, GB-2 & GB-3	Geotechnical Data
GJ	Drainage Details
GJ-2, GJ-3, GJ-4	Stormwater Treatment and Storage Facility Field Markers
BRIDGE STRUCTURE 17365	
85233	Bridge General Layout
85235	Structural Mount
85236	Structure Mount Details
PERMANENT PAVEMENT MARKINGS	
ST, ST-2 thru ST-7, Incl.	Pavement Marking Plan
PERMANENT SIGNING	
S-12500 thru S-12517, Incl.	Permanent Signing
BRIDGE STRUCTURE 21529	
S-12518	Cantilever Sign Support, Sta. "EB" 458+80

INDEX OF SHEETS, CONT'D.	
DRAWING NO.	DESCRIPTION
ILLUMINATION	
I-1827	Illumination Legend
I-1828 & I-1829	Illumination Removal Plan
I-1830 & I-1831	Illumination Plan
I-1832	Illumination Details
TRAFFIC SIGNALS	
15969	Signal and Detector Plan Legend
15970	Detector Plan
15971	Signal Removal Plan
15972	Temporary Signal Plan
15973	Signal Plan
15974	Detector Plan
15975	Existing Utility Plan
15976	Signal Removal Plan
15977	Temporary Signal Plan
15978	Signal Plan
15979	Detector Plan
15980	Existing Utility Plan
15981	Temporary Pole Entrance Chart
15982	Pole Entrance Chart
ITS	
ITS-1044	ITS Legend & Symbols
ITS-1045 thru ITS-1049, Incl.	ITS Plan
ITS-1050 thru ITS-1055, Incl.	ITS Details

ADDED 15978A GRADING For Signal Pole # 18

Standard Drg. Nos.

- RD140 - Roadway Cross Slopes Superelevated Sections
- RD150 - Slope Rounding
- RD300 - Trench Backfill, Bedding, Pipe Zone And Mult. Installations
- RD302 - Street Cut
- RD316 - Sloped Ends For Metal Pipe
- RD318 - Sloped Ends For Concrete Pipe
- RD320 - Paved End Slope For Culverts 60" Maximum Pipe Size
- RD326 - Coupling Bands For Corrugated Metal Pipe
- RD336, RD342, RD344, RD346 - Manholes
- RD356 - Manhole Cover & Frames
- RD358 - Manhole Slope Protectors
- RD364, RD370, RD376 - Concrete Inlets
- RD380, RD384, RD386 - Pipe Fill Height Tables
- RD400, RD405, RD415, RD420, RD450 - Guardrail

- RD500 - Precast Concrete Barrier Pin And Loop Assembly
- RD510 - Concrete Barrier Terminal
- RD700 - Curbs
- RD705 - Islands
- RD710 - Accessible Route Islands
- RD715 - Approaches And Non-Sidewalk Driveways
- RD720 - Sidewalks
- RD755 - Sidewalk Ramp Details
- RD759 - Truncated Dome Detectable Warning Surface Details And Locations
- RD1000 - Construction Entrances
- RD1005 - Check Dams
- RD1010, RD1015 - Inlet Protection
- RD1040 - Sediment Fence
- TM200 - Sign Installation Details
- TM201 - Miscellaneous Sign Placement Details
- TM204 - Flag Board Mounting Details
- TM211 - Signage Details
- TM223, TM224 - Directional Sign Layout
- TM225 - Exit Number & Gore Signage Details
- TM230, TM231, TM232, TM233 - Mounting Details For Removable Legend
- TM300, TM301 - Illumination Control Cabinets
- TM450 - Mast Arm Pole Details
- TM452 - Strain Pole Details
- TM455 - Temporary Signal Details
- TM457 - Vehicle, Ped. Signal & Push Button Mounting Details
- TM458 - Pedestrian Ramp Placement Details
- TM460 - Vehicle Signal Details
- TM462 - Adjustable Signal Head Mounting Details
- TM463 - Spanwire Mounting Details
- TM465 - Overhead Sign, Fire Preemption & Photoelectronic Details
- TM467 - Ped. Signal And Ped. Push Button Details
- TM470 - Color Code Charts
- TM472 - Traffic Signal Junction Boxes
- TM475 - Loop Details
- TM480 - Loop Entrance Details
- TM482 - Controller Cabinet And Foundation Details
- TM485 - Service Cabinets And Service Cabinet Wiring Details
- TM488 - Terminal Cabinet Detail
- TM490 - Crosswalk Closure Detail

"AS CONSTRUCTED"
Mark Beem
Date 4-26-12 Project Mgr

I-84 AT 257TH AVE (TROUTDALE INTERCHANGE) SEC.
COLUMBIA RIVER HIGHWAY
MUTNOMAH COUNTY

FEDERAL HIGHWAY ADMINISTRATION	PROJECT NUMBER	SHEET NO.
OREGON DIVISION	STATE	1A

Standard Drawings located on the web at:
http://www.oregon.gov/ODOT/HWY/ENGSERVICES/standard_drawings_home.shtml

Standard Drg. Nos. (contd.)

- TM500, TM501, TM503 - Pavement Marking Standard Details
- TM525 - Turn Arrow Marking Details
- TM530 - Intersection Pavement Markings
- TM551 - Freeway Exit Ramp Pavement Markings
- TM560, TM561 - Alignment Layout
- TM570 - Traffic Delineators
- TM571 - Traffic Delineators Steel Post Details
- TM575 - Traffic Delineator Installation

- TM600, TM601 - Multi-Post Breakaway Sign Supports
- TM602 - Triangular Base Breakaway Multi-Direction Slip Base
- TM618 - Truss Type Sign Bridge
- TM622, TM623, TM624, TM625, TM626, TM627 - Monotube Cantilever Sign Support

- TM629, TM630 - Slip Base & Fixed Base Luminaire Supports

- TM635 - Breakaway Sign & Luminaire Supports
- TM650, TM651, TM652, TM653 - Traffic Signal Supports
- TM670 - Wood Post Sign Supports
- TM671 - 3 Second Gust Wind Speed Isotach
- TM675 - Extruded Aluminum Panels
- TM676 - Sign Attachments
- TM677 - Sign Mounts
- TM678 - Secondary Sign Mounting Details
- TM679 - Signal Mast Arm Street Name Sign Mounts
- TM680 - Signal Pole Mounts
- TM681, TM687, TM688 - Square Tube Sign Supports

- TM800 - Tables, Abrupt Edge And PCMS Details
- TM810 - Temporary Reflective Pavement Markers
- TM820 - Temporary Barricades
- TM821 - Temporary Sign Supports
- TM830 - Temporary Concrete Barrier And Rumble Strips
- TM831, TM832 - Temporary Impact Attenuators
- TM840 - Closure Details
- TM841 - Intersection Work Zone Details
- TM842 - Signalized Intersection Details
- TM843 - Intersection Details
- TM851 - 2-Lane, 2-Way Roadways
- TM860 - Freeway Sections

R/W Map Nos. 6B-15-13, 1A-22-7,
1R-3-1477 and 1R-3-1477


"AS CONSTRUCTED"

Mark Beer

Date 4-26-12 Project Mgr

1-84 AT 257TH AVE (TROUTDALE INTERCHANGE) SEC. COLUMBIA RIVER HIGHWAY MUTNOMAH COUNTY		
FEDERAL HIGHWAY ADMINISTRATION	PROJECT NUMBER STATE	SHEET NO. 1B
OREGON DIVISION		

Standard Drawings located on the web at:
http://www.oregon.gov/ODOT/HWY/ENGSERVICES/standard_drawings_home.shtml

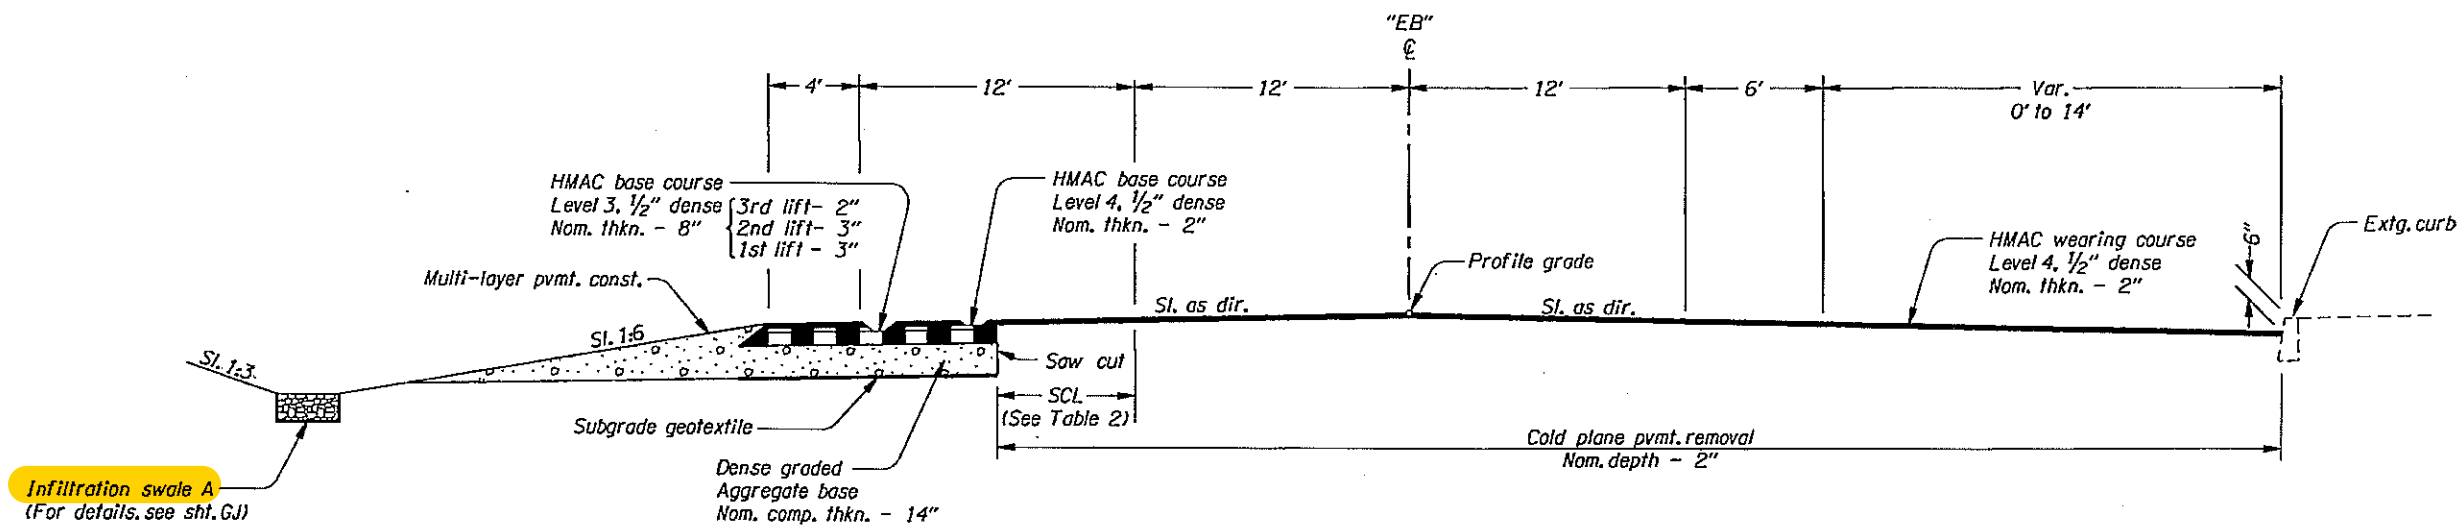

STA. "EB" 472+25.00 To STA. "EB" 474+30.36
 "EB" 486+25.00 To "EB" 488+68.12

- NOTE:
1. Side-slopes are shown as vert. to horiz.
 2. For standard superelevation, see drg. no. RD140.
 3. For slope rounding, see drg. no. RD150.

See AS BUILT SAW CUT TABLE ON SHEET 2A-5

TABLE 2

STA. To	STA.	SCL (Ft.)
472+25.00	474+30.36	6
486+25.00	487+03.00	6 to 15
487+03.00	488+68.12	15 to 22

"AS CONSTRUCTED"

Mark Bean
 Date 4-26-12 Project Mgr

REGISTERED PROFESSIONAL ENGINEER
 14468
Lawrence A. Kretzler
 OREGON
 JULY 26, 1989
 LAWRENCE A. KRETTLER
 EXPIRATION DATE: 6-30-2011

OREGON DEPARTMENT OF TRANSPORTATION

REGION 1 - ROADWAY ENGINEERING SECTION


I-84 AT 257TH AVE (TROUTDALE INTERCHANGE) SEC.
 COLUMBIA RIVER HIGHWAY
 MULTNOMAH COUNTY

Design Team Leader - Lawrence Kretzler
 Designed By - Marco Singer & Dave Haase
 Drafted By - Carolyn Allen

TYPICAL SECTIONS

SHEET NO. 2A-4

EB ALIGNMENT As Built Saw Cuts	
EB STATION	Sawcut Left
Sta 472+71.95	-24.9
Sta 473+00.69	-19.9
Sta 473+48.74	-18.0
Sta 475+47.35	-15.9
Sta 475+84.28	-14.8
Sta 477+07.56	-15.4
Sta 477+81.69	-15.1
Sta 477+81.69	-15.8
Sta 480+44.51	-16.1
Sta 485+95.74	-16.2
Sta 487+26.52	-24.1
Sta 487+54.49	-24.5
Sta 487+56.94	-23.3
Sta 487+65.45	-23.5
Sta 487+68.91	-24.9
Sta 488+68.09	-28.5

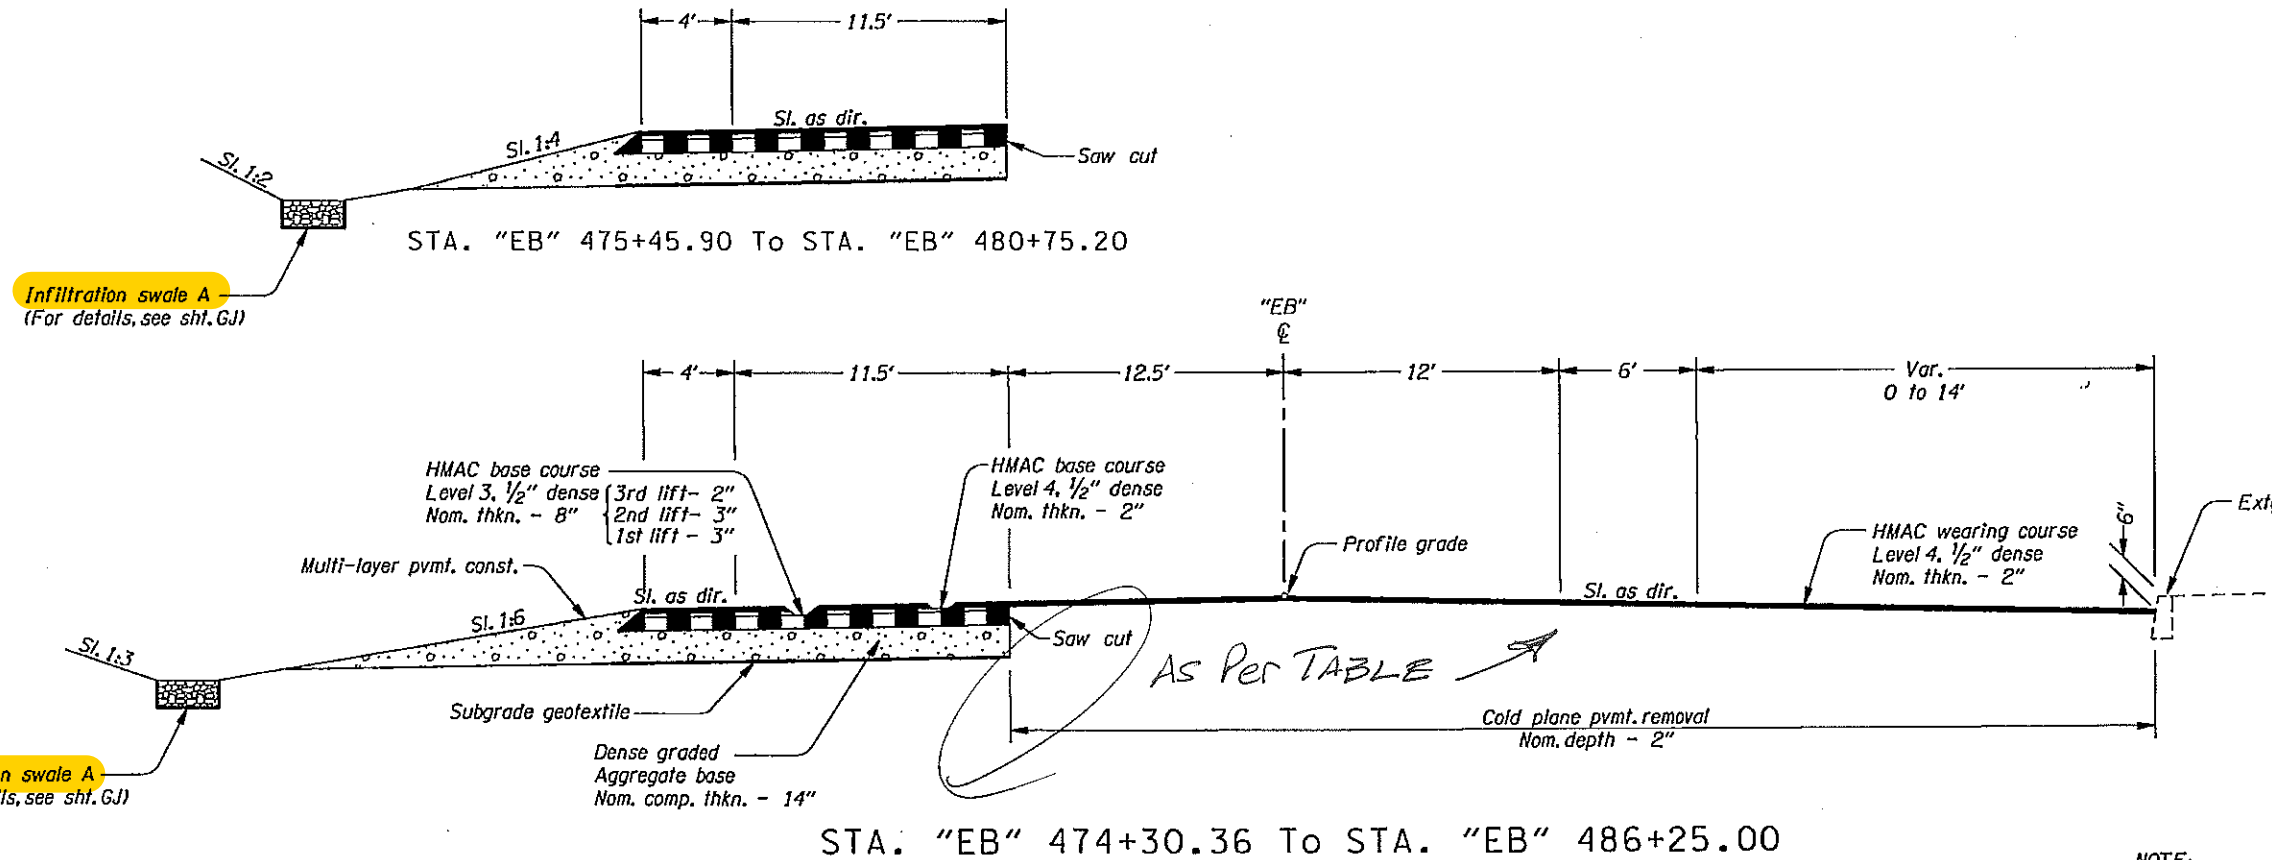

NOTE:
 1. Side-slopes are shown as vert. to horiz.
 2. For standard superelevation, see drg. no. RD140.
 3. For slope rounding, see drg. no. RD150.

Infiltration swale A
 (For details, see sht. GJ)

Infiltration swale A
 (For details, see sht. GJ)

AS PER TABLE

"AS CONSTRUCTED"
Mark Bein
 Date 4-26-12 Project Mngr

REGISTERED PROFESSIONAL ENGINEER
 14468
Lawrence A. Krettl
 OREGON
 JULY 26, 1989
 LAWRENCE A. KRETTLER
 EXPIRATION DATE: 6-30-2011

OREGON DEPARTMENT OF TRANSPORTATION


REGION I - ROADWAY ENGINEERING SECTION


I-84 AT 257TH AVE (TROUTDALE INTERCHANGE) SEC.
 COLUMBIA RIVER HIGHWAY
 MULTNOMAH COUNTY

Design Team Leader - Lawrence Krettl
 Designed By - Marco Singer & Dave Haase
 Drafted By - Carolyn Allen

TYPICAL SECTIONS

SHEET NO.
 2A-5

- ① See sht. 3A, note 4
- ② Sta. "EB"468+43 to Sta. "EB"470+69, Rt. Const. guardrail - 175' (Type 2A) Const. anchor (Type 1 modified) Inst. end piece (Type B) Const. guardrail terminal non-flared - 50' Test level 3 W=1, E=2'
- ③ Const. P.C. conc. sidewalk (See drg. no. RD720)
- ④ Const. sidewalk ramp (For details, see sht. 2B)
- ⑤ Remove extg. curb & sidewalk Const. parallel sidewalk ramp (See drg. no. RD755)
- ⑥ Const. standard curb (See drg. no. RD700) 
- ⑦ Const. curb end (See drg. no. RD700)

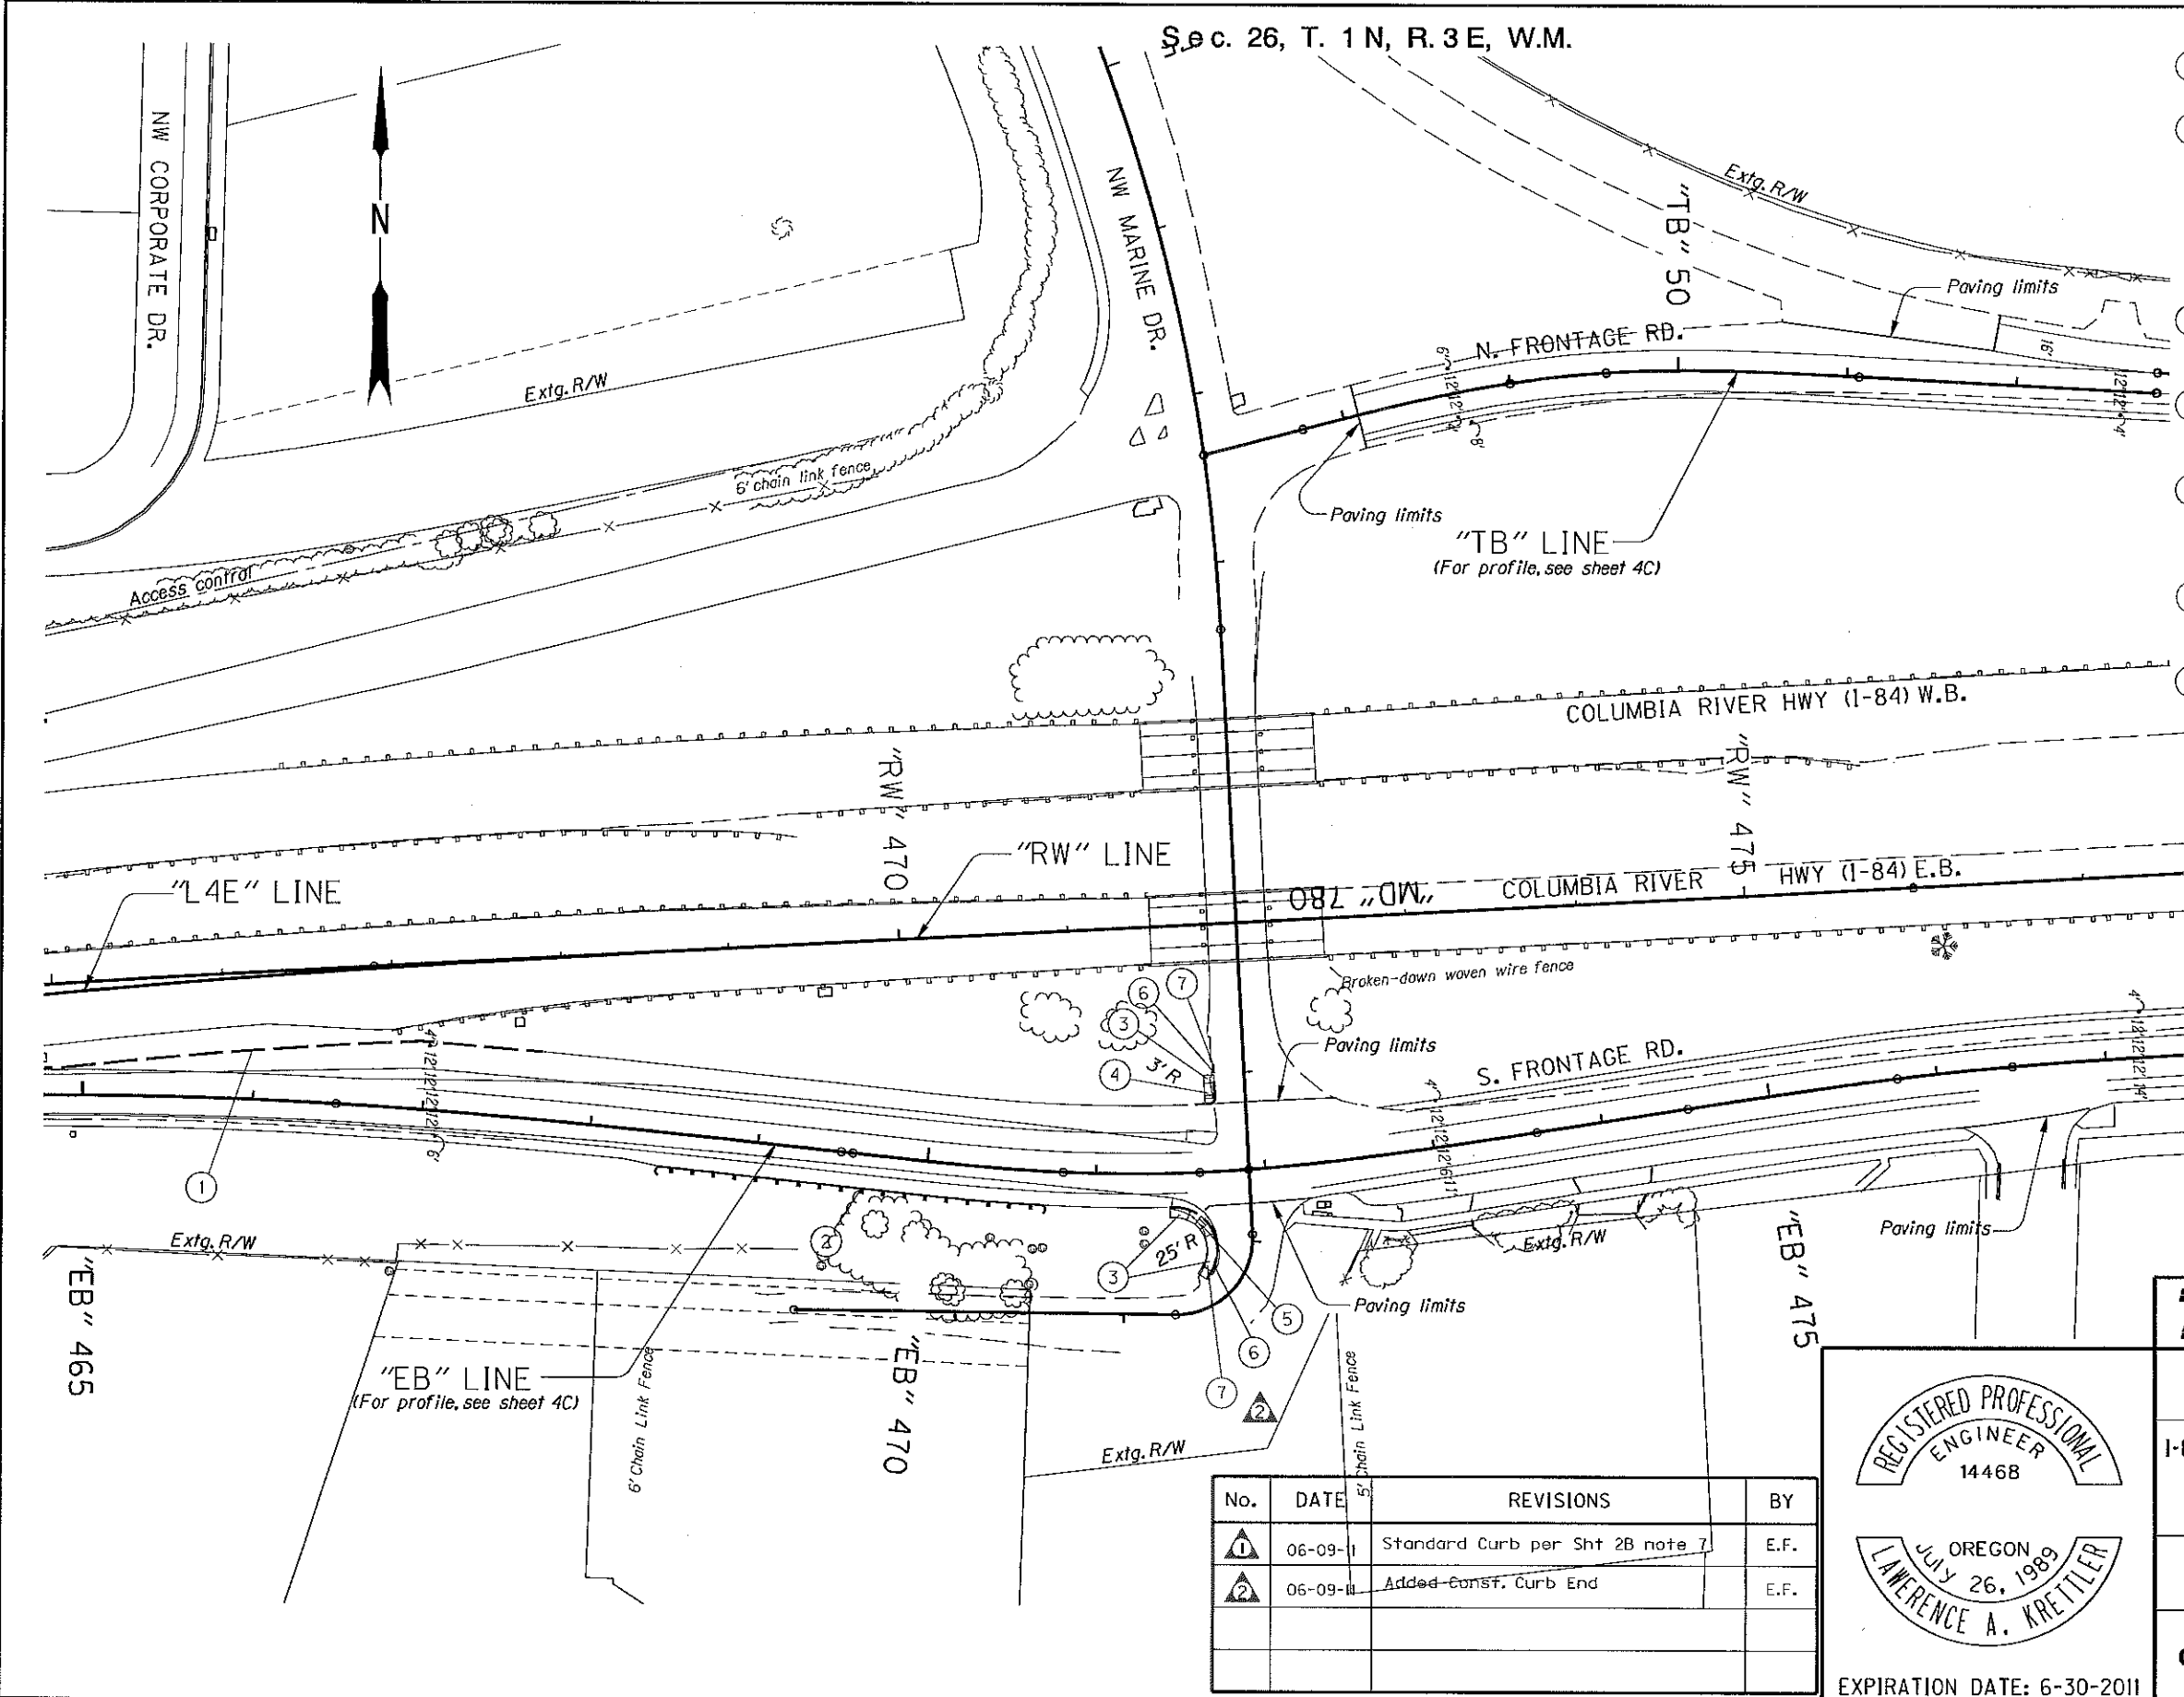

"AS CONSTRUCTED"
Mark Ben
 Date 4-26-12 Project Mngr

OREGON DEPARTMENT OF TRANSPORTATION

REGION 1 - ROADWAY ENGINEERING SECTION

I-84 AT 257TH AVE (TROUTDALE INTERCHANGE) SEC.
 COLUMBIA RIVER HIGHWAY
 MULTNOMAH COUNTY

Design Team Leader - Lawrence Krettl
 Designed By - Marco Singer & Dave Haase
 Drafted By - Carolyn Allen

GENERAL CONSTRUCTION

SHEET NO. **4A**

REGISTERED PROFESSIONAL ENGINEER
 14468

JULY 26, 1989
LAWRENCE A. KRETTLER


EXPIRATION DATE: 6-30-2011

No.	DATE	REVISIONS	BY
①	06-09-11	Standard Curb per Sht 2B note 7	E.F.
②	06-09-11	Added Const. Curb End	E.F.

Sec. 26, T. 1 N, R. 3 E, W.M.

"AS CONSTRUCTED"

Wanda Nason
Date 4-26-12 Project Mng'r

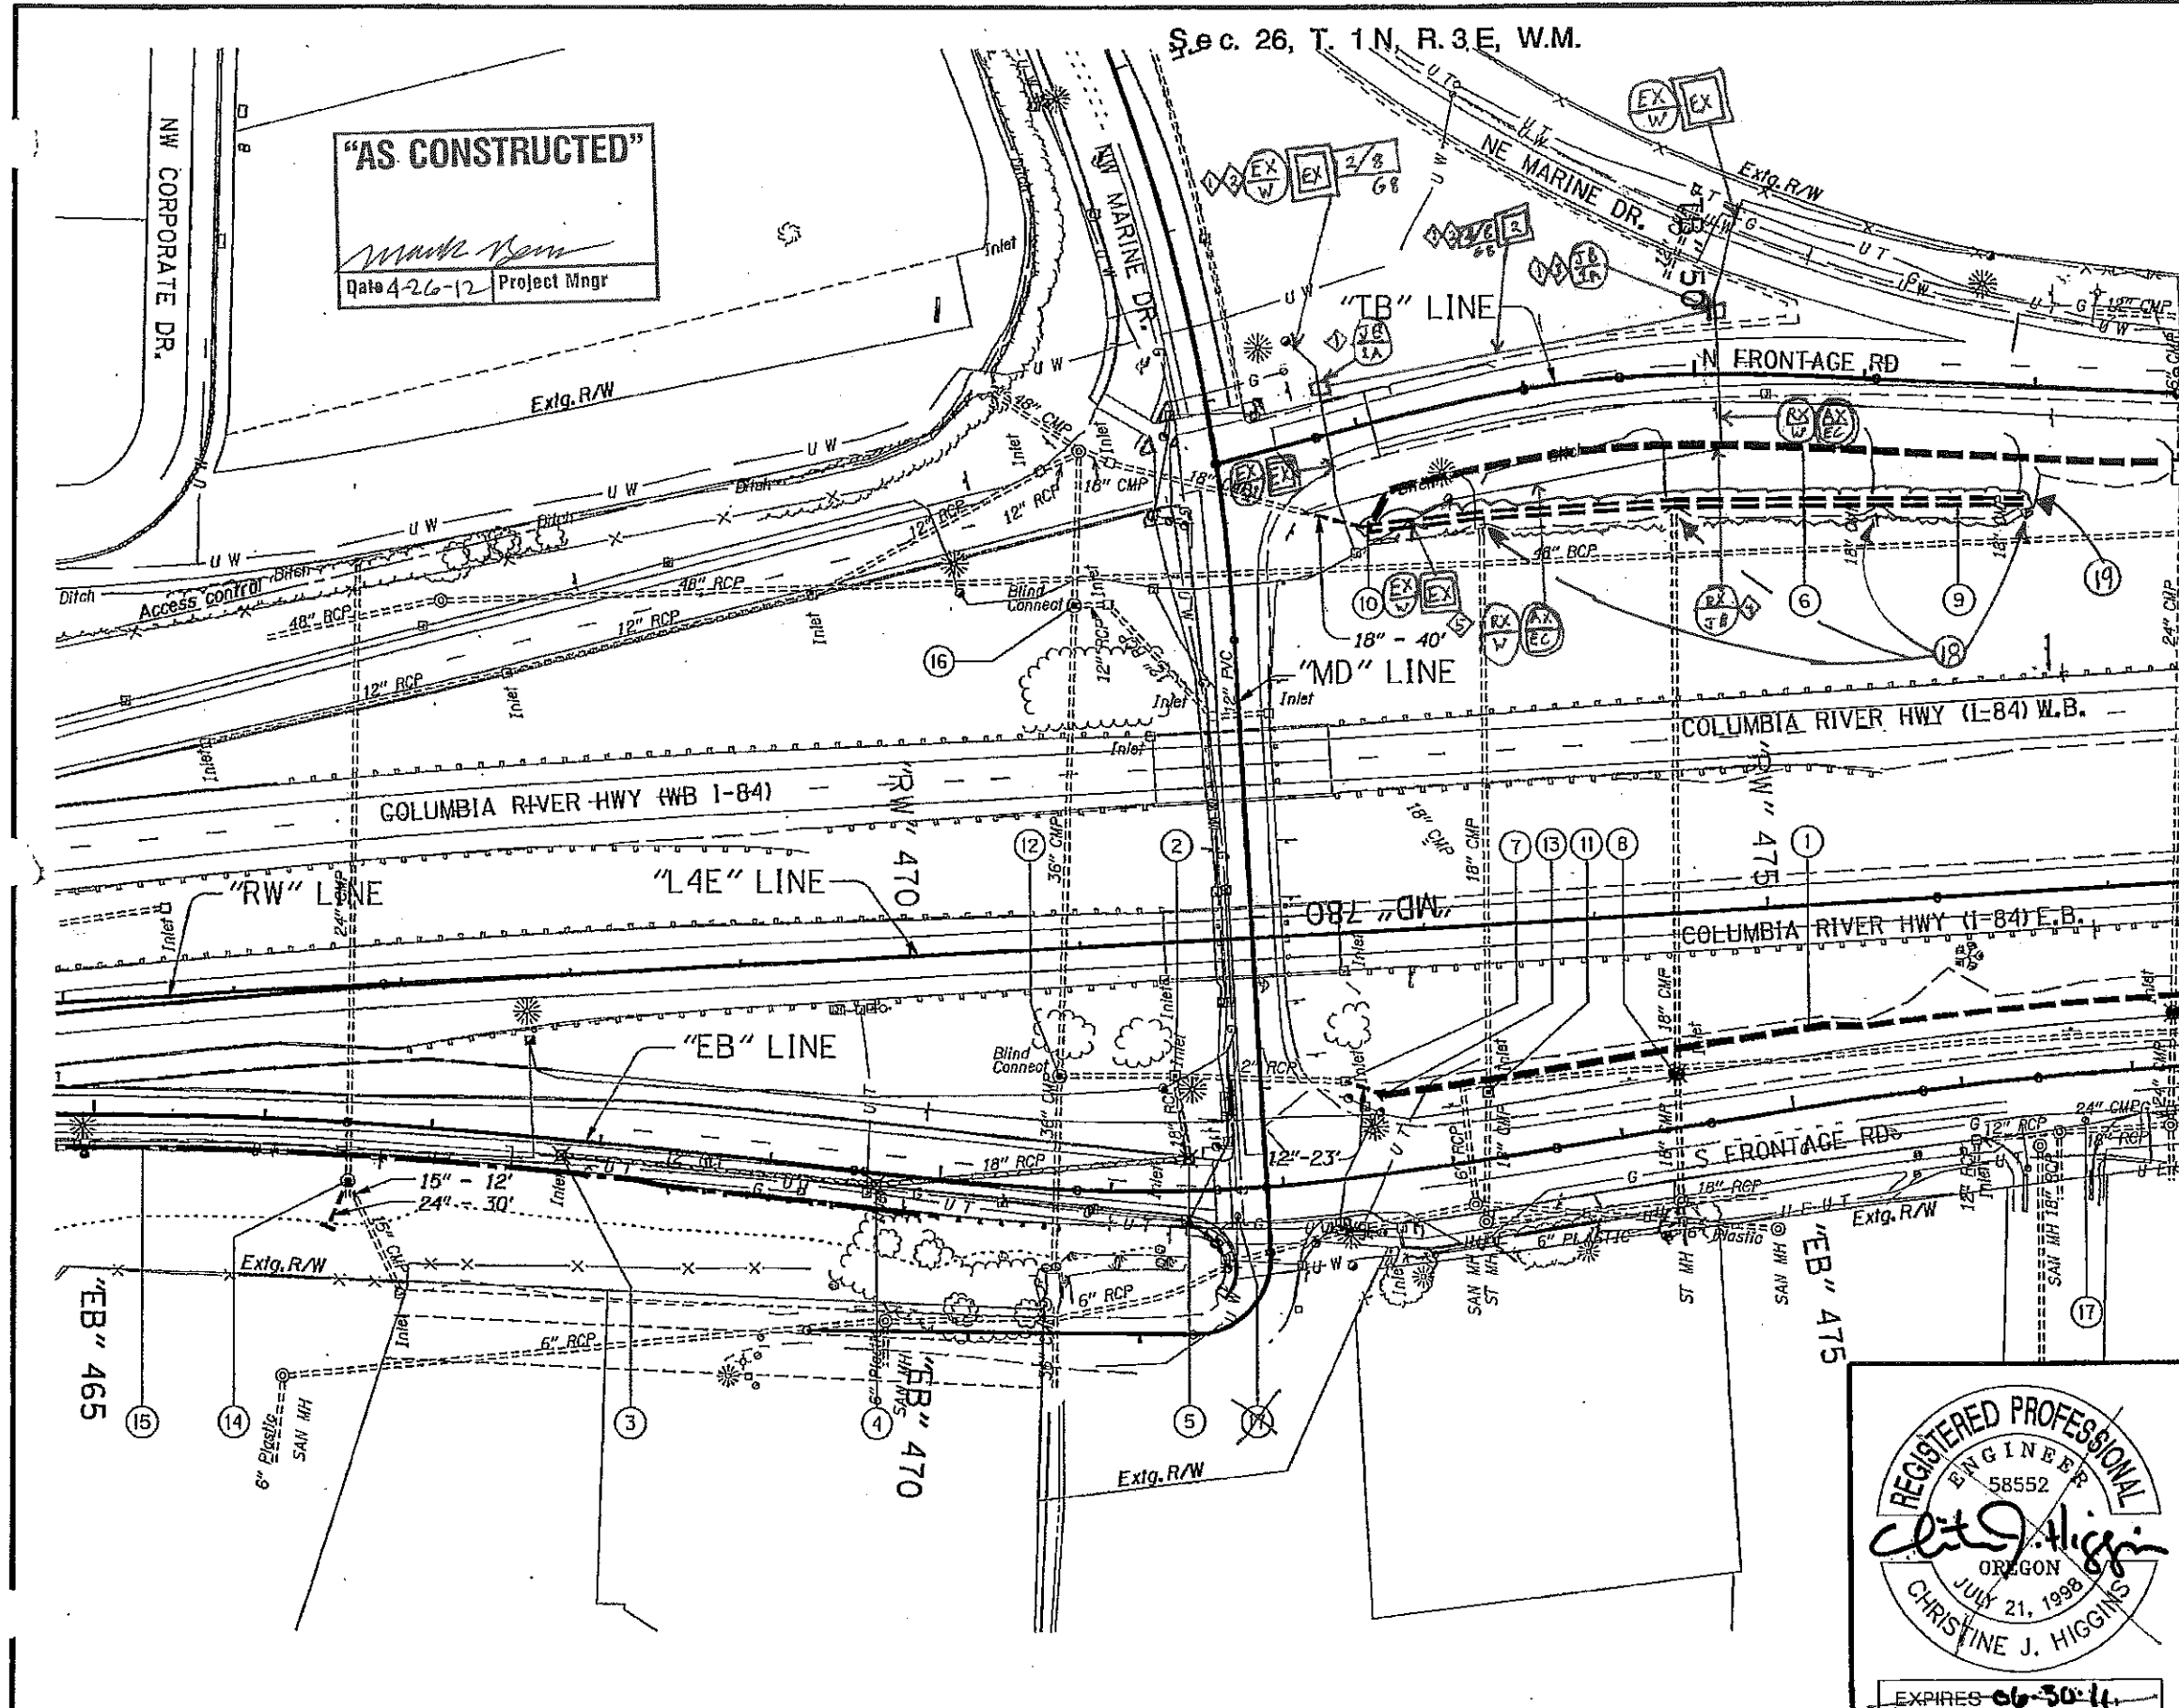

EX
W Retain and protect existing wiring

1 Field locate to avoid conflicts with existing utilities

2 Verify new wiring is sufficient for existing lighting circuit.

3 Splice new wire to existing wire.

4 Remove & dispose of existing light pole base according to section 00310

5 Conduit previously rerouted beneath drainage ditch
See R. T.
8/19/11

18 & 19 For added detail see GJ-4 Eric Fosgard

Ditch shown thus:

Infiltration swale shown thus:

Infiltration slope shown thus:


Cut line shown thus:

Fill line shown thus:

Adjust inlet shown thus:

Remove extg. inlet shown thus:

Plug and abandon pipe shown thus:

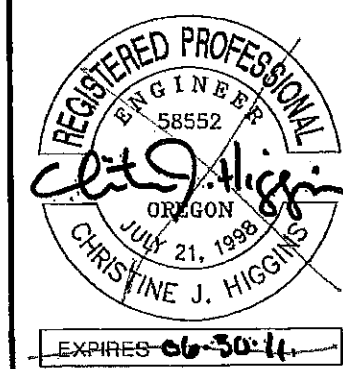

OREGON DEPARTMENT OF TRANSPORTATION


DAVID EVANS AND ASSOCIATES INC.
2100 Southwest River Parkway
Portland Oregon 97201 Ph: 503.223.6663

I-84 AT 257TH AVE (TROUTDALE INTERCHANGE) SEC.
COLUMBIA RIVER HIGHWAY
MULTNOMAH COUNTY

Reviewed By - Craig Sheahan
Designed By - Karina Nordahl
Drafted By - Edita Bagustawski

DRAINAGE & UTILITIES

SHEET NO.
4B

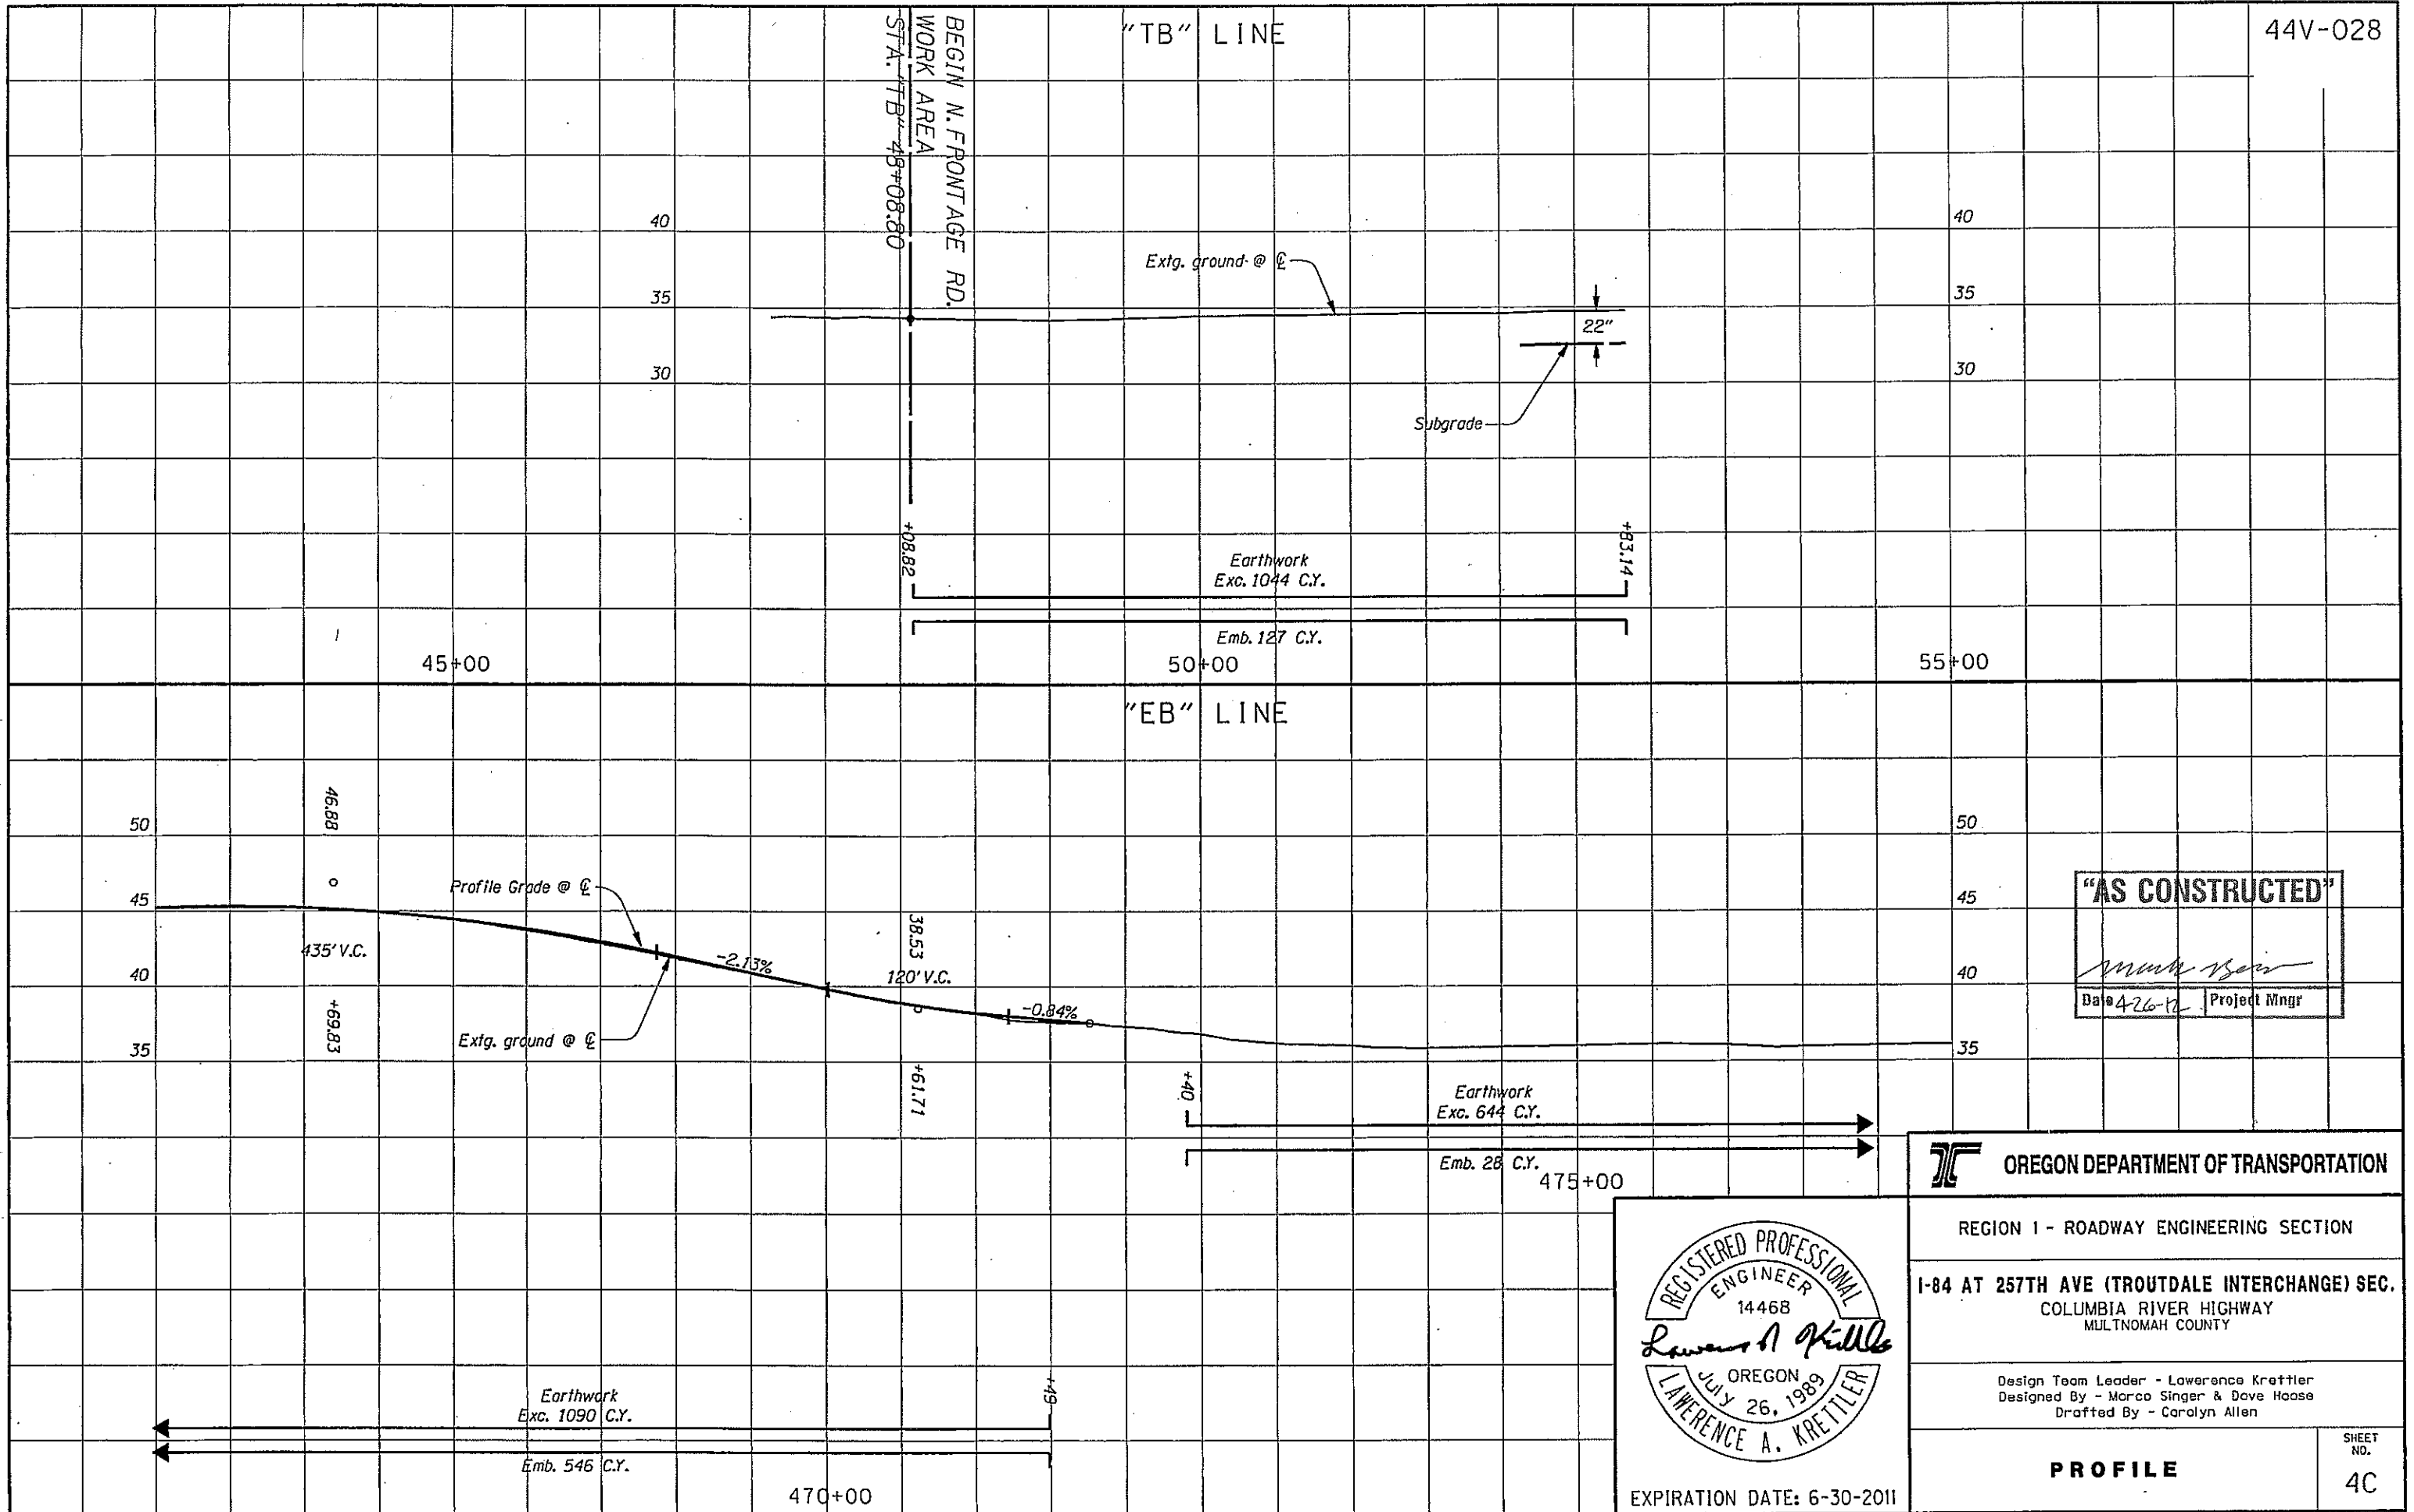

"AS CONSTRUCTED"
Marco Singer
 Date 4-26-10 Project Mng'r



OREGON DEPARTMENT OF TRANSPORTATION

REGION 1 - ROADWAY ENGINEERING SECTION
 I-84 AT 257TH AVE (TROUTDALE INTERCHANGE) SEC.
 COLUMBIA RIVER HIGHWAY
 MULTNOMAH COUNTY


Design Team Leader - Lawrence Kretzler
 Designed By - Marco Singer & Deve Hoese
 Drafted By - Carolyn Allen

PROFILE
 SHEET NO. 4C

EXPIRATION DATE: 6-30-2011


"TB" LINE

"EB" LINE

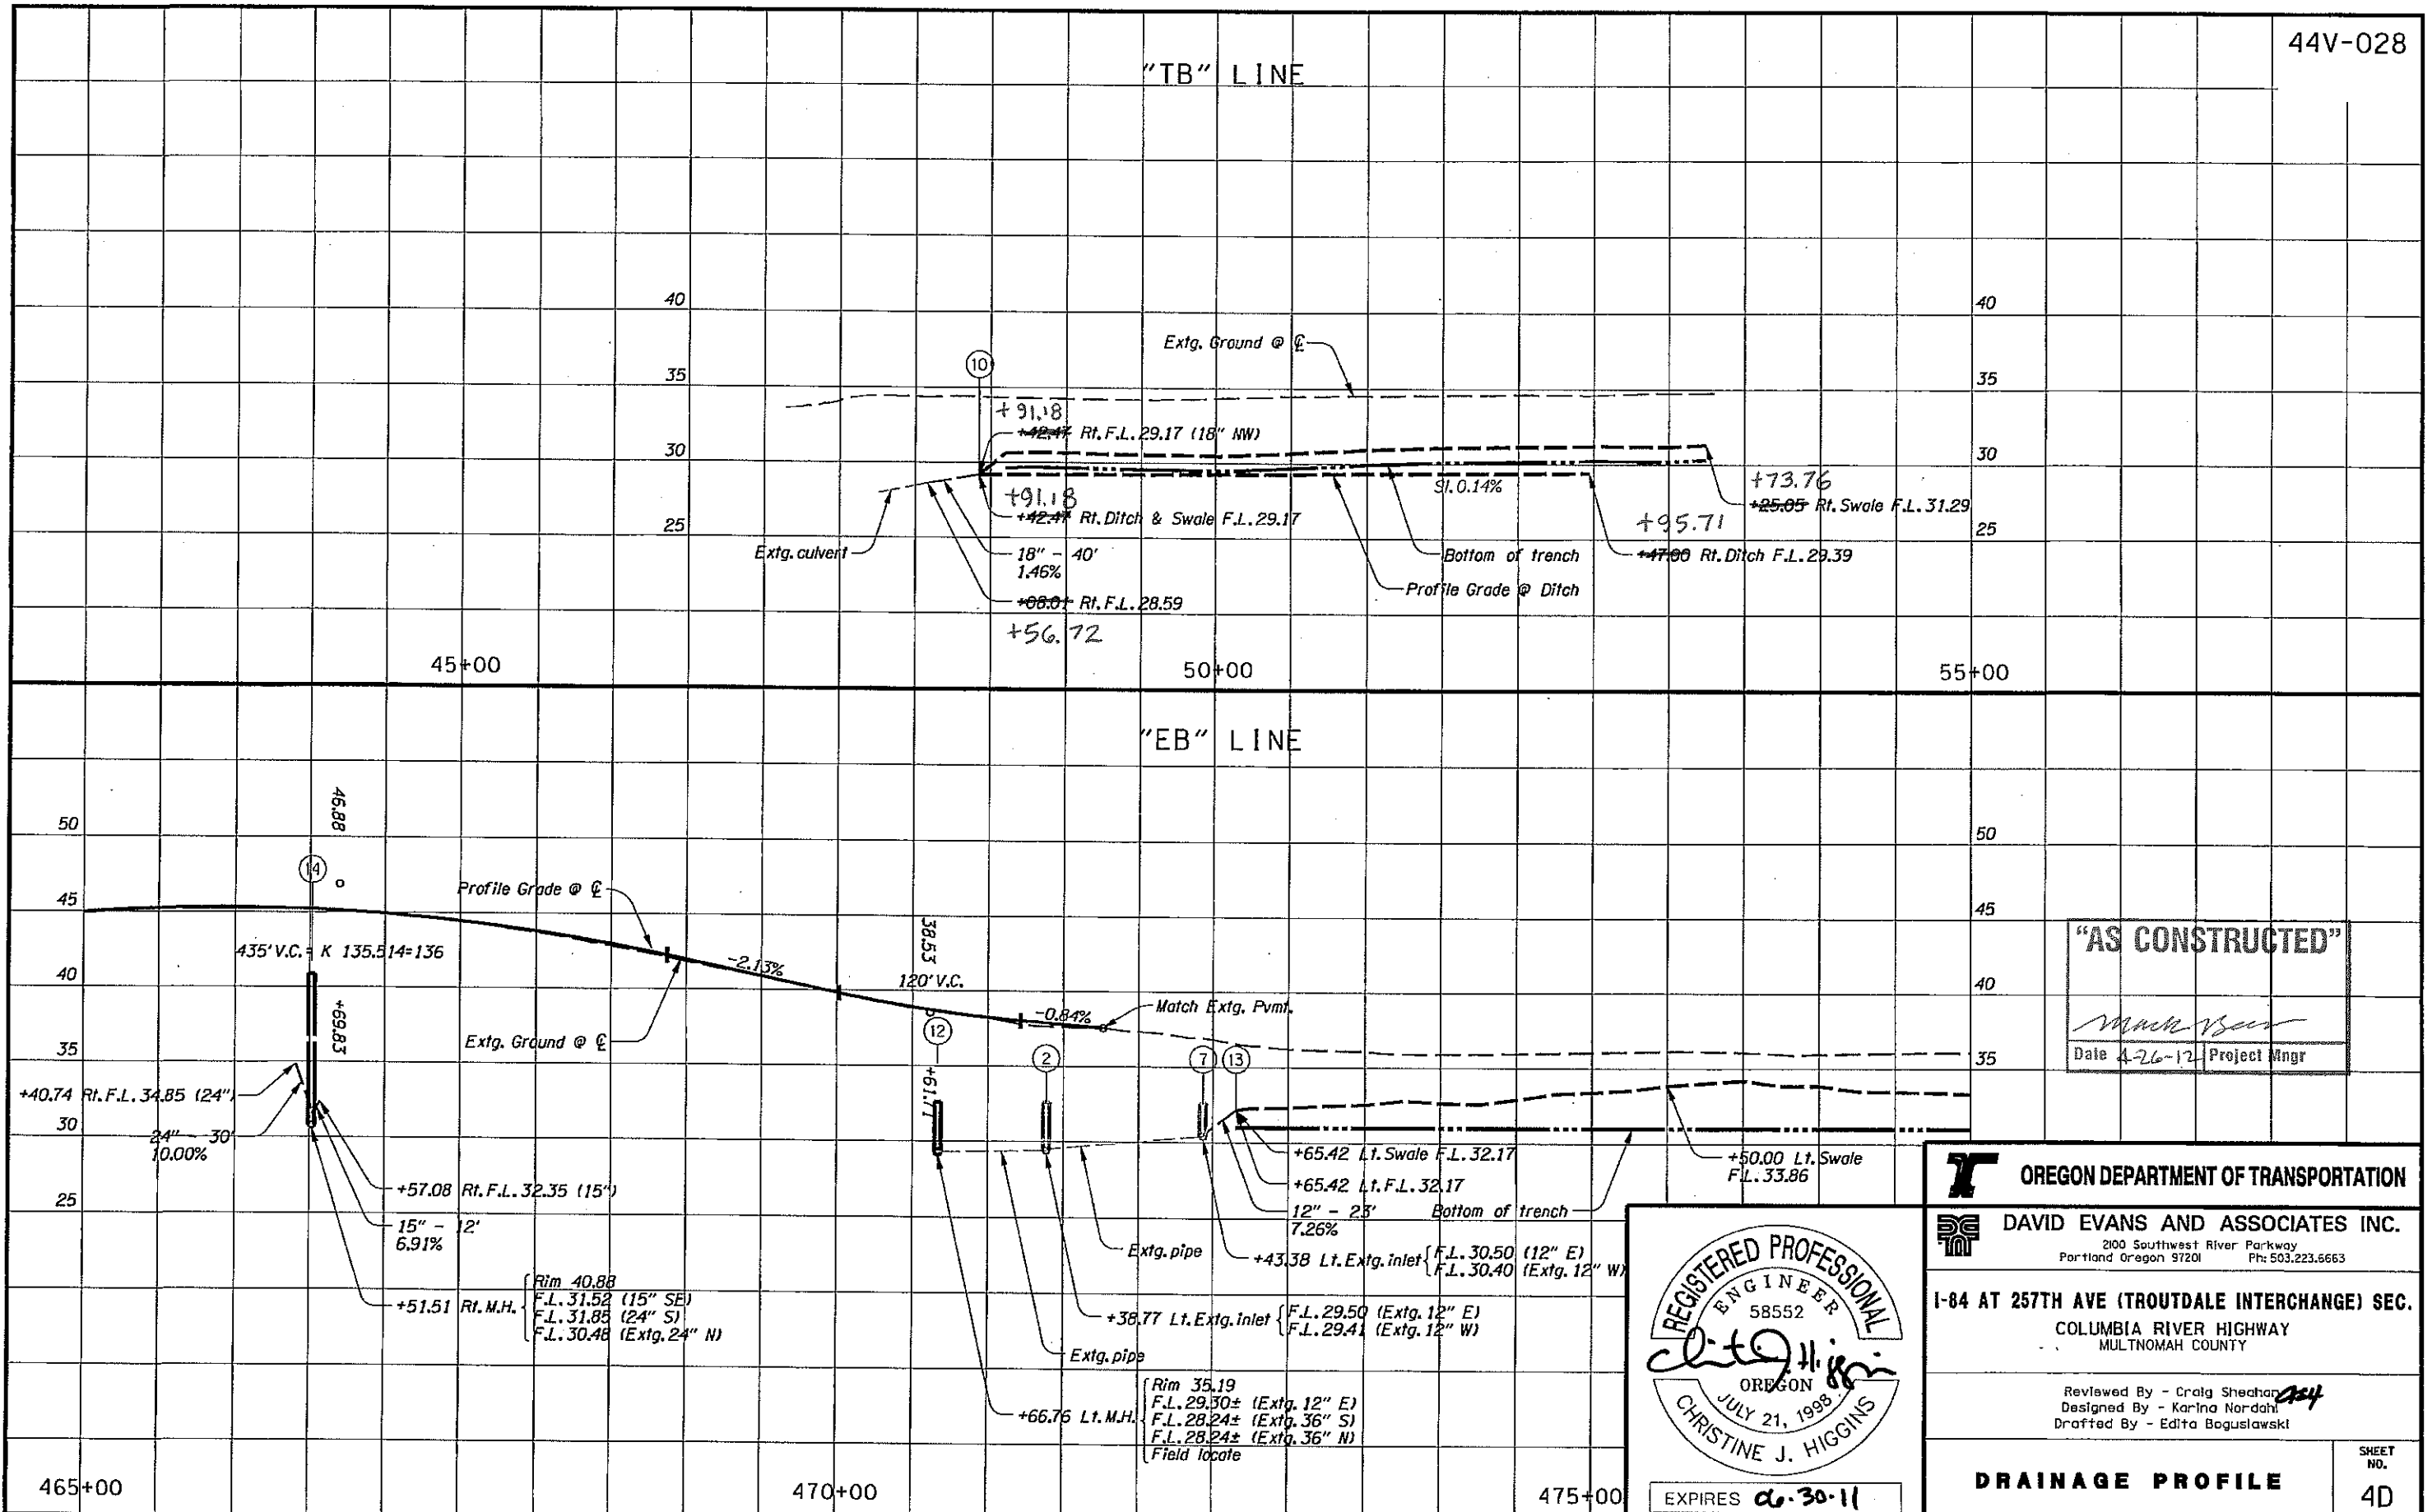

"AS CONSTRUCTED"

Mark Beer
 Date 4-26-12 Project Ingr

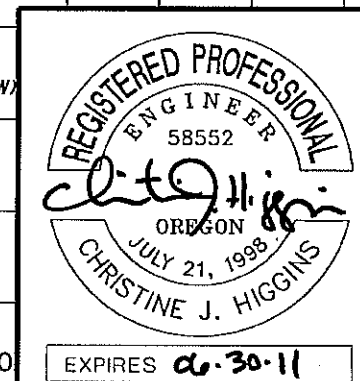

OREGON DEPARTMENT OF TRANSPORTATION

DAVID EVANS AND ASSOCIATES INC.
 200 Southwest River Parkway
 Portland Oregon 97201 Ph: 503.223.6663

I-84 AT 257TH AVE (TROUTDALE INTERCHANGE) SEC.
 COLUMBIA RIVER HIGHWAY
 MULTNOMAH COUNTY


Reviewed By - Craig Sheehan
 Designed By - Karina Nordahl
 Drafted By - Edita Boguslawski

DRAINAGE PROFILE

SHEET NO. **4D**

Sec. 26, T. 1 N, R. 3 E, W.M.


① Const. appr. - 2
(See drg. no. RD715)

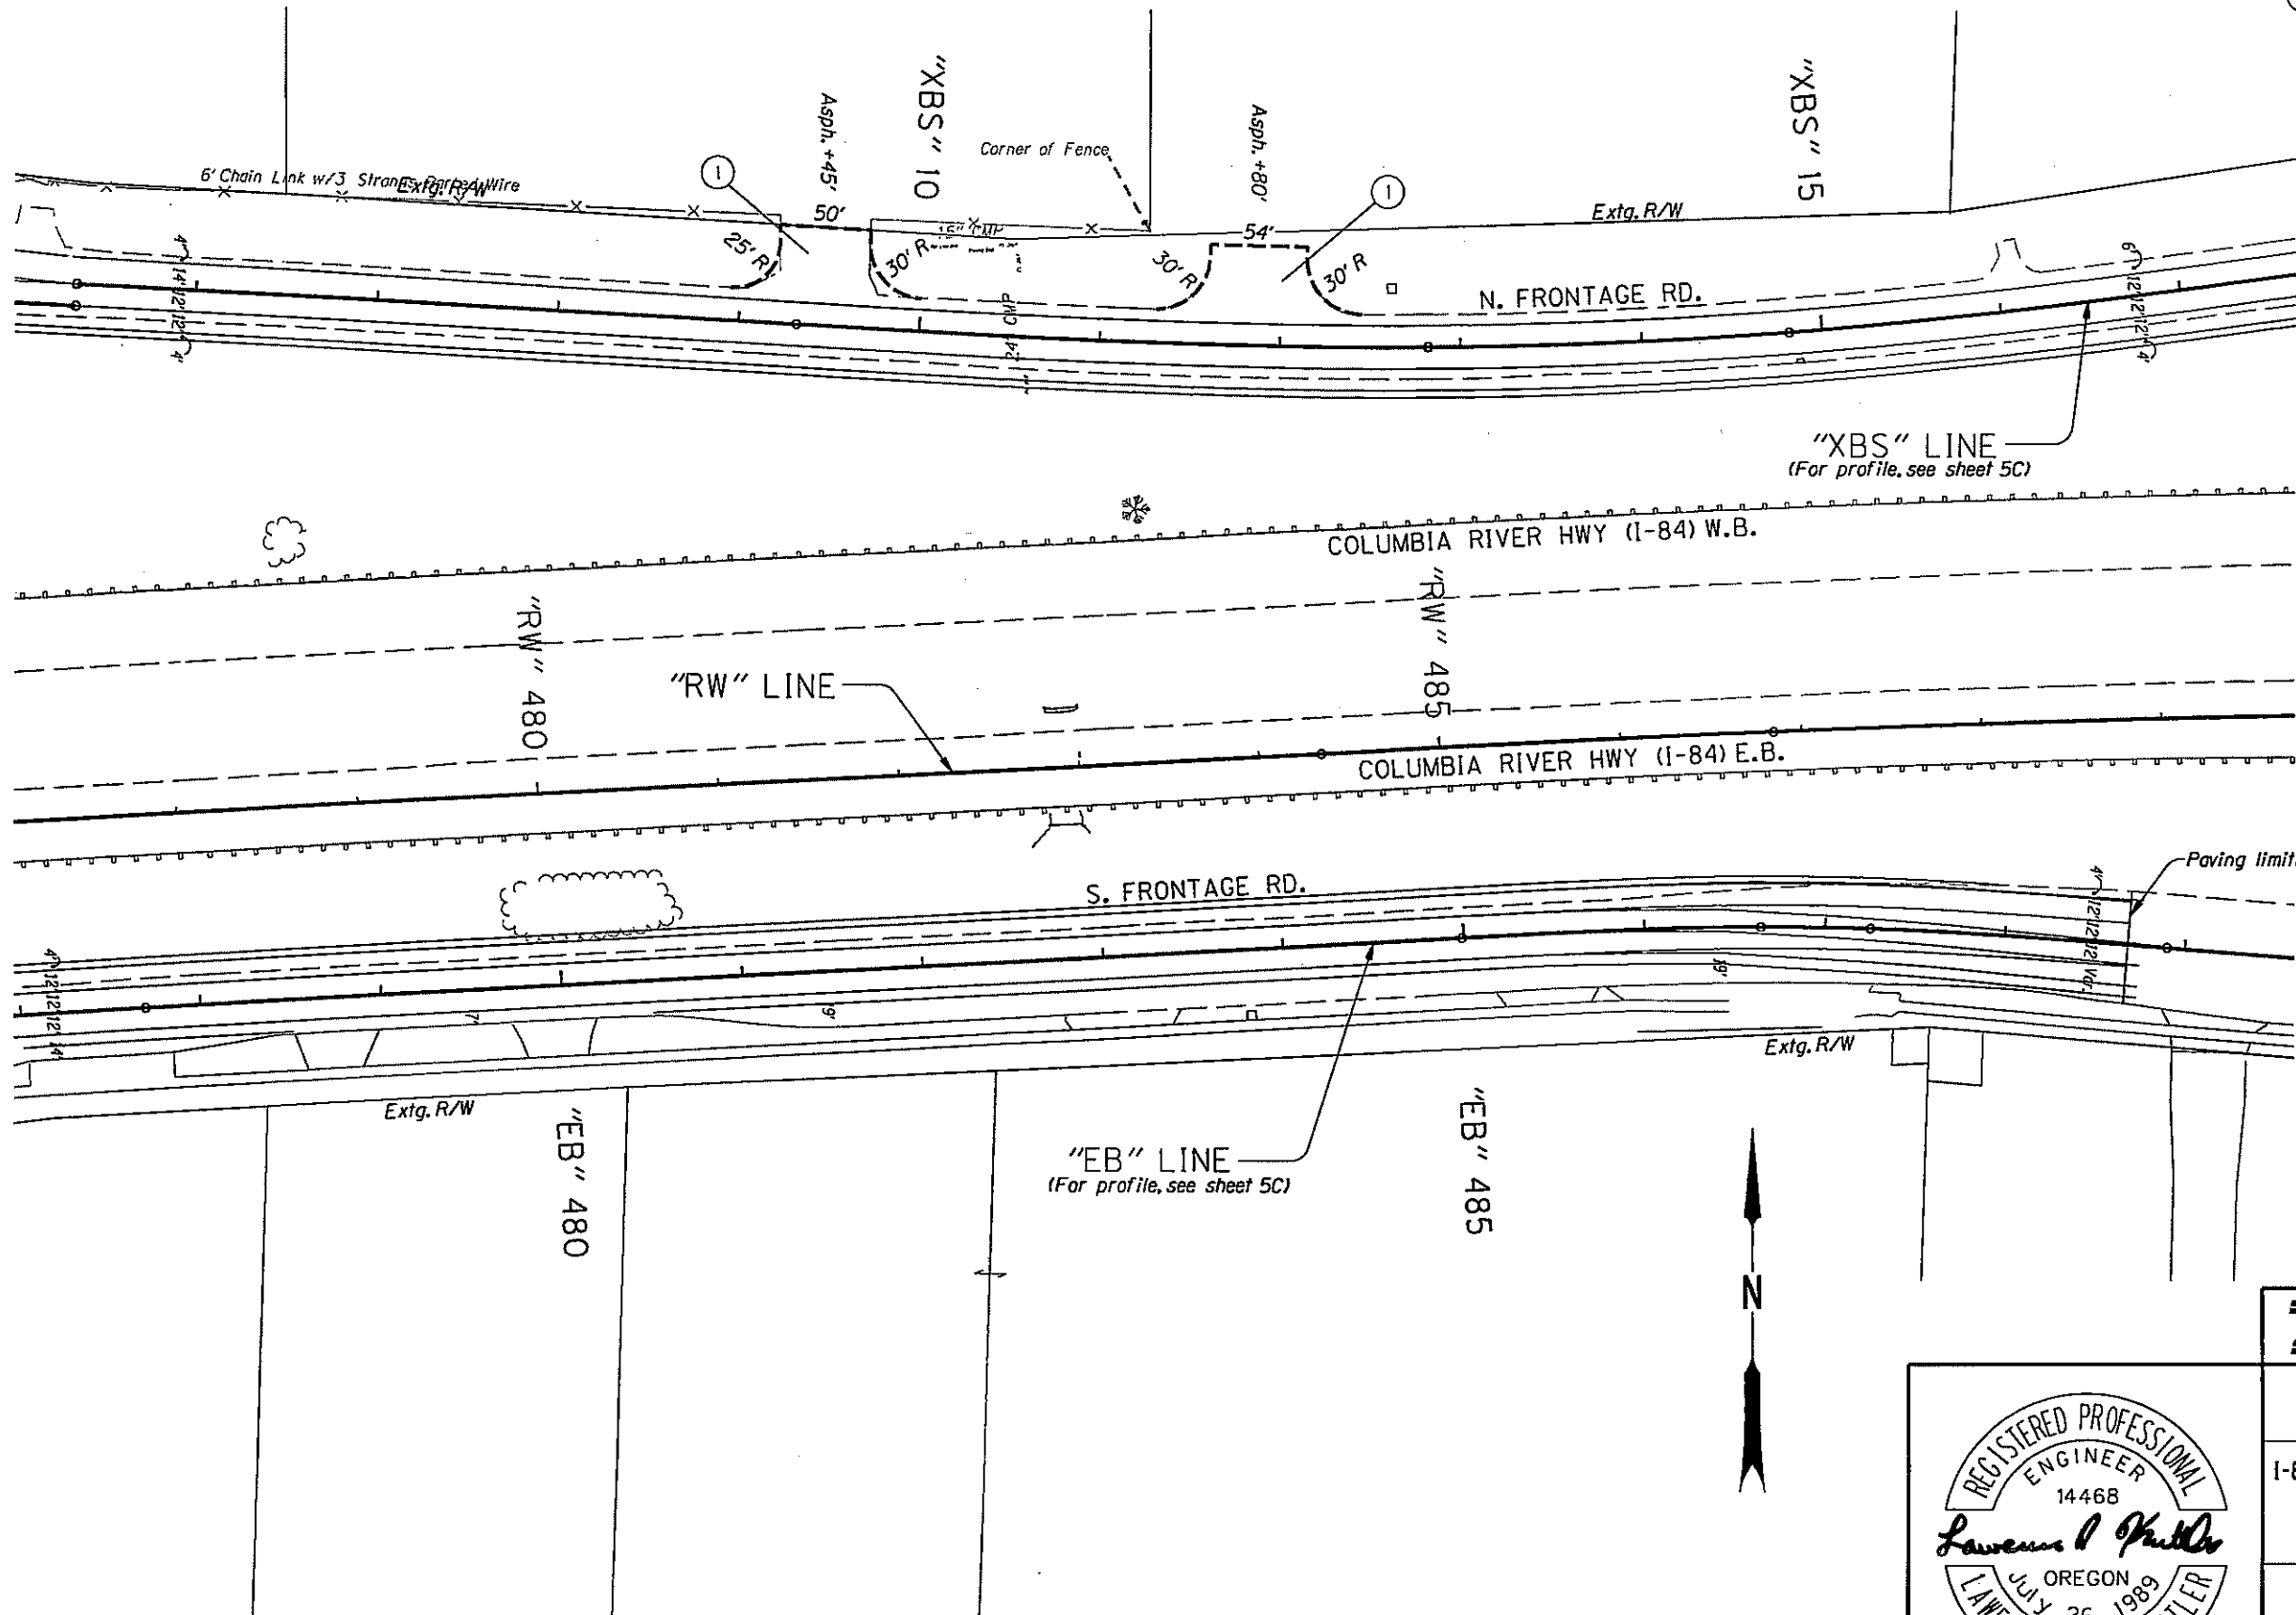

"AS CONSTRUCTED"

Mark Brown

Date 4-26-12 | Project Mngr

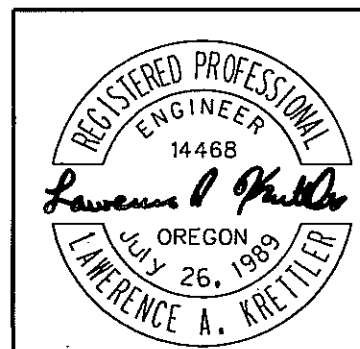






EXPIRATION DATE: 6-30-2011

OREGON DEPARTMENT OF TRANSPORTATION	
REGION 1 - ROADWAY ENGINEERING SECTION	
I-84 AT 257TH AVE (TROUTDALE INTERCHANGE) SEC. COLUMBIA RIVER HIGHWAY MULTNOMAH COUNTY	
Design Team Leader - Lawrence Krettlar Designed By - Marco Singer & Dave Hoase Drafted By - Carolyn Allen	
GENERAL CONSTRUCTION	SHEET NO. 5A

20 As per cco #15

EXISTING PIPE & Type D Inlet (ADDED)

Out of paving limits

- Infiltration swale shown thus: 
- Infiltration slope shown thus: 
- Cut line shown thus: 
- Adjust manhole shown thus: 
- Adjust inlet shown thus: 

OREGON DEPARTMENT OF TRANSPORTATION

DAVID EVANS AND ASSOCIATES INC.
 2100 Southwest River Parkway
 Portland Oregon 97201 Ph: 503.223.6663

I-84 AT 257TH AVE (TROUTDALE INTERCHANGE) SEC.
 COLUMBIA RIVER HIGHWAY
 MULTNOMAH COUNTY

Reviewed By - Craig Sheahan
 Designed By - Karina Nordahl
 Drafted By - Edita Bogustawski

DRAINAGE & UTILITIES

SHEET NO. **5B**


REGISTERED PROFESSIONAL ENGINEER
 58552

OREGON
 JULY 21, 1998
CHRISTINE J. HIGGINS

EXPIRES

"AS CONSTRUCTED"


Mark Beer
 Date 4-26-12 Project Mgr

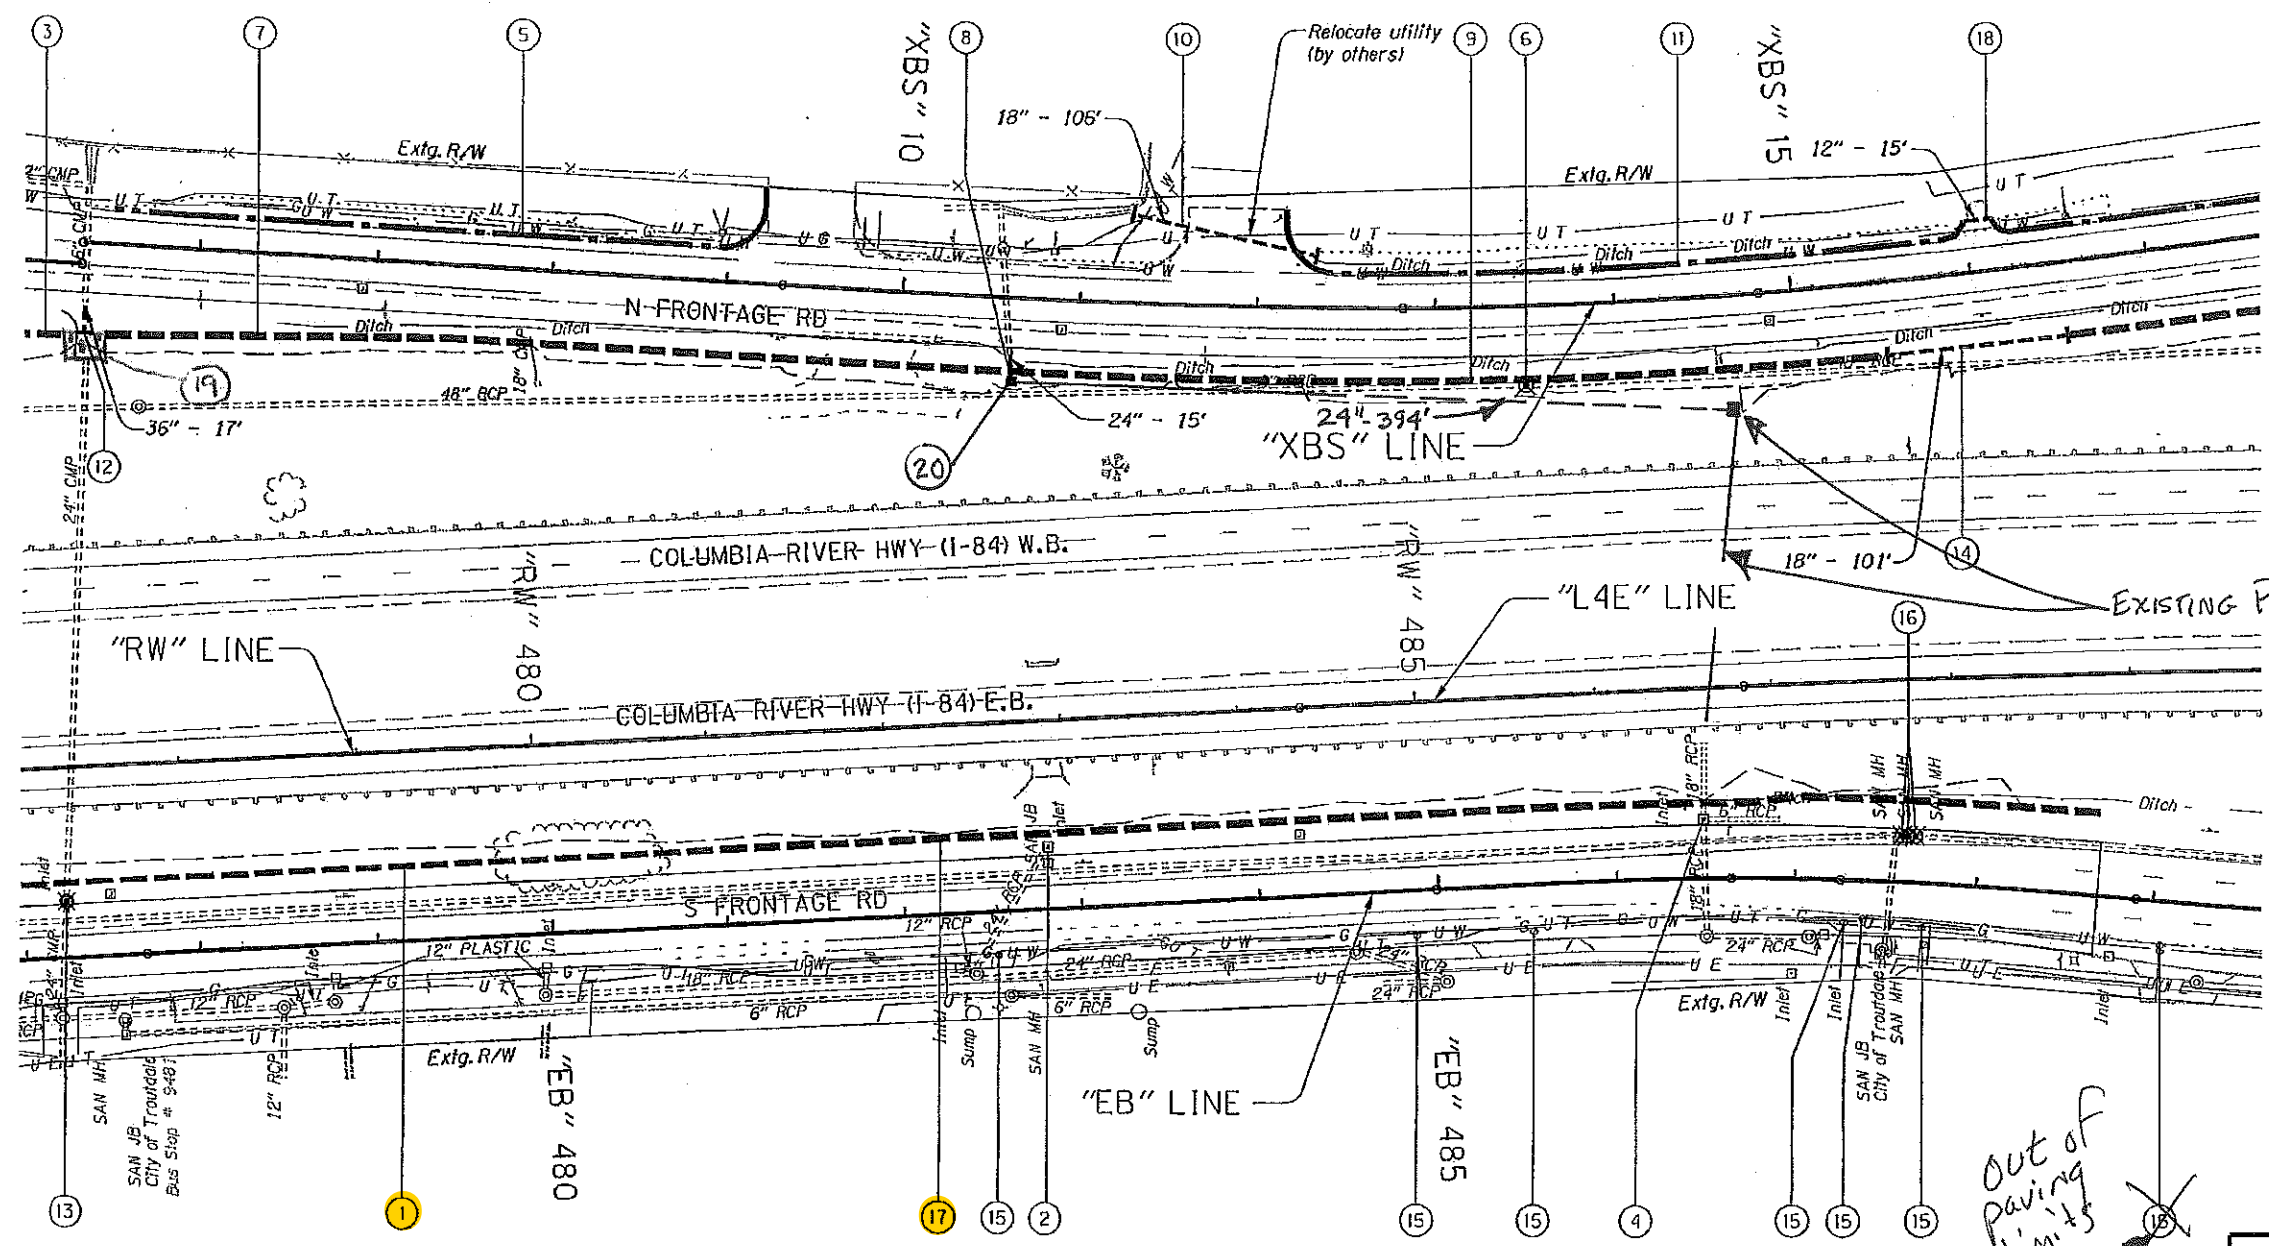

* CHANGE ORDER FOR NOTES ② & ④

- ① Sta. "EB" 475+50.00, 41.93' Lt. to Sta. "EB" 480+75.00, 41.93' Lt. Const. infiltration swale type D - 49.3 cu. yd. (For detail, see sht. GJ)
- ② Sta. "EB" 482+82.16, 34.62' Lt. ~~Adjust inlet~~ Rim 36.34
- ③ See note 6, sht. 4B-2
- ④ Sta. "EB" 486+49.32, 32.97' Lt. ~~Adjust inlet~~ Rim 38.36
- ⑤ Sta. "XBS" 5+50.09, Lt. to Sta. "XBS" 9+19.31, Lt. Const. infiltration slope type B - 88.2 cu. yd. Inst. delineators, type S1 (For details, see shts. GJ & GJ-2)
- ⑥ Sta. "XBS" 13+49.46, 44.75' Rt. Const. granular drain backfill diversion Major adjust manhole (For details, see sht. GJ-3)
- ⑦ Sta. "XBS" 5+48.50, 51.06' Rt. to Sta. "XBS" 10+60.00, 41.42' Rt. Const. infiltration swale type B - 75.9 cu. yd. (For details, see sht. GJ)
- ⑧ Sta. "XBS" 10+63.01, 46.91' Rt. Const. ditch inlet type "D" Extend 24" culvert pipe - 15' 5' depth (See drg. no. RD370)
- ⑨ Sta. "XBS" 10+62.13, 41.42' Rt. to Sta. "XBS" 15+50.03, 41.42' Rt. Const. infiltration swale type B - 72.7 cu. yd. (For details, see sht. GJ)
- ⑩ Sta. "XBS" 11+28.87, 49.67' Lt. to Sta. "XBS" 12+33.30, 28.98' Lt. Inst. 18" culvert pipe - 106' 5' depth Trench resurf. - 34 sq. yd. (See drg. no. RD302)
- ⑪ Sta. "XBS" 12+15.60 Lt. to Sta. "XBS" 16+00.00 Lt. Const. infiltration slope type B - 113.9 cu. yd. (For details, see sht. GJ)
- ⑫ Sta. "XBS" 5+36.35, 33.50' Rt. Extend 36" culvert pipe - 17' 5' depth
- ⑬ Sta. "EB" 477+25.60, 31.52' Lt. Remove extg. inlet Const. shallow manhole Connect extg. 24" storm sew. pipes Rim 35.90 F.L. 31.80 (Extg. 24" N) F.L. 31.70 (Extg. 24" S)

- ⑭ Sta. "XBS" 15+50.03, 41.42' Rt. to Sta. "XBS" 16+50.00, 41.42' Rt. Inst. 18" culvert pipe - 101' 5' depth
- ⑮ Adjust water valve - * 6
- ⑯ Minor adjust sanitary manhole - 3
- ⑰ Sta. "EB" 480+75.00, 41.93' Lt. to Sta. "EB" 488+68.12, 46.52' Lt. Const. infiltration swale type A - 276.6 cu. yd. Inst. delineators, type S1 (For details, see shts. GJ & GJ-2)
- ⑱ Sta. "XBS" 16+00.00, 28.97' Lt. to Sta. "XBS" 16+14.91, 29.00' Lt. Inst. 12" storm sew. pipe - 15' 5' depth
- ⑲) REPAIR CURB AND RIMMAGE BENCH (25' X 20' X 1') WITH REPAIR GRANULAR, TAP 1
- ⑳ Install 24" storm sew. pipe - 394' 5' DEPTH Connect to ~~Extg~~ Type D Inlet NEW

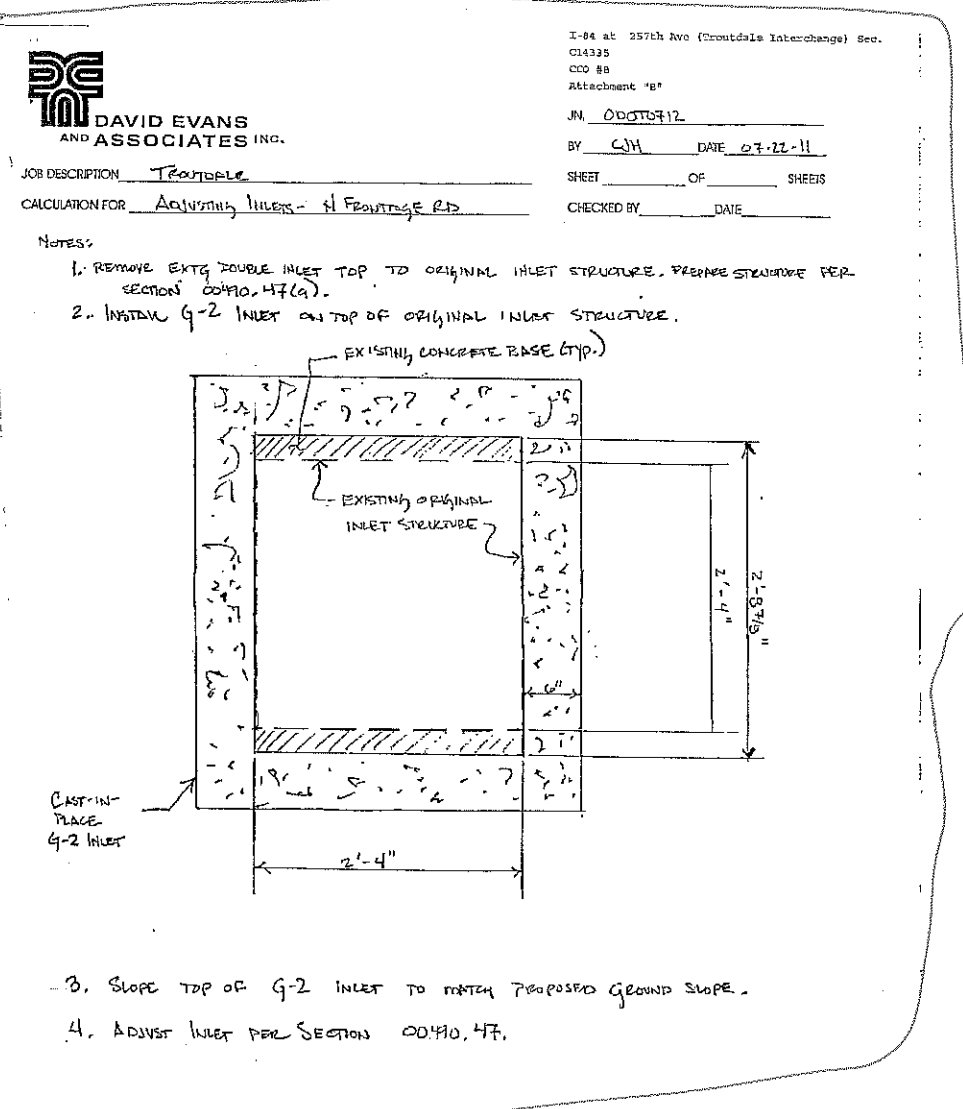

"AS CONSTRUCTED"
 Mark Ben
 Date 4-26-12 Project Mngt

REGISTERED PROFESSIONAL ENGINEER 58552
 OREGON JULY 21, 1998
 CHRISTINE J. HIGGINS
 EXPIRES

OREGON DEPARTMENT OF TRANSPORTATION


DAVID EVANS AND ASSOCIATES INC.
 2100 Southwest River Parkway
 Portland Oregon 97201 Ph: 503.223.6663

I-84 AT 257TH AVE (TROUTDALE INTERCHANGE) SEC.
 COLUMBIA RIVER HIGHWAY
 MULTNOMAH COUNTY

Reviewed By - Craig Sheehan
 Designed By - Karina Nordahl
 Drafted By - Edita Boguslawski

DRAINAGE & UTILITIES

SHEET NO. **5B-2**

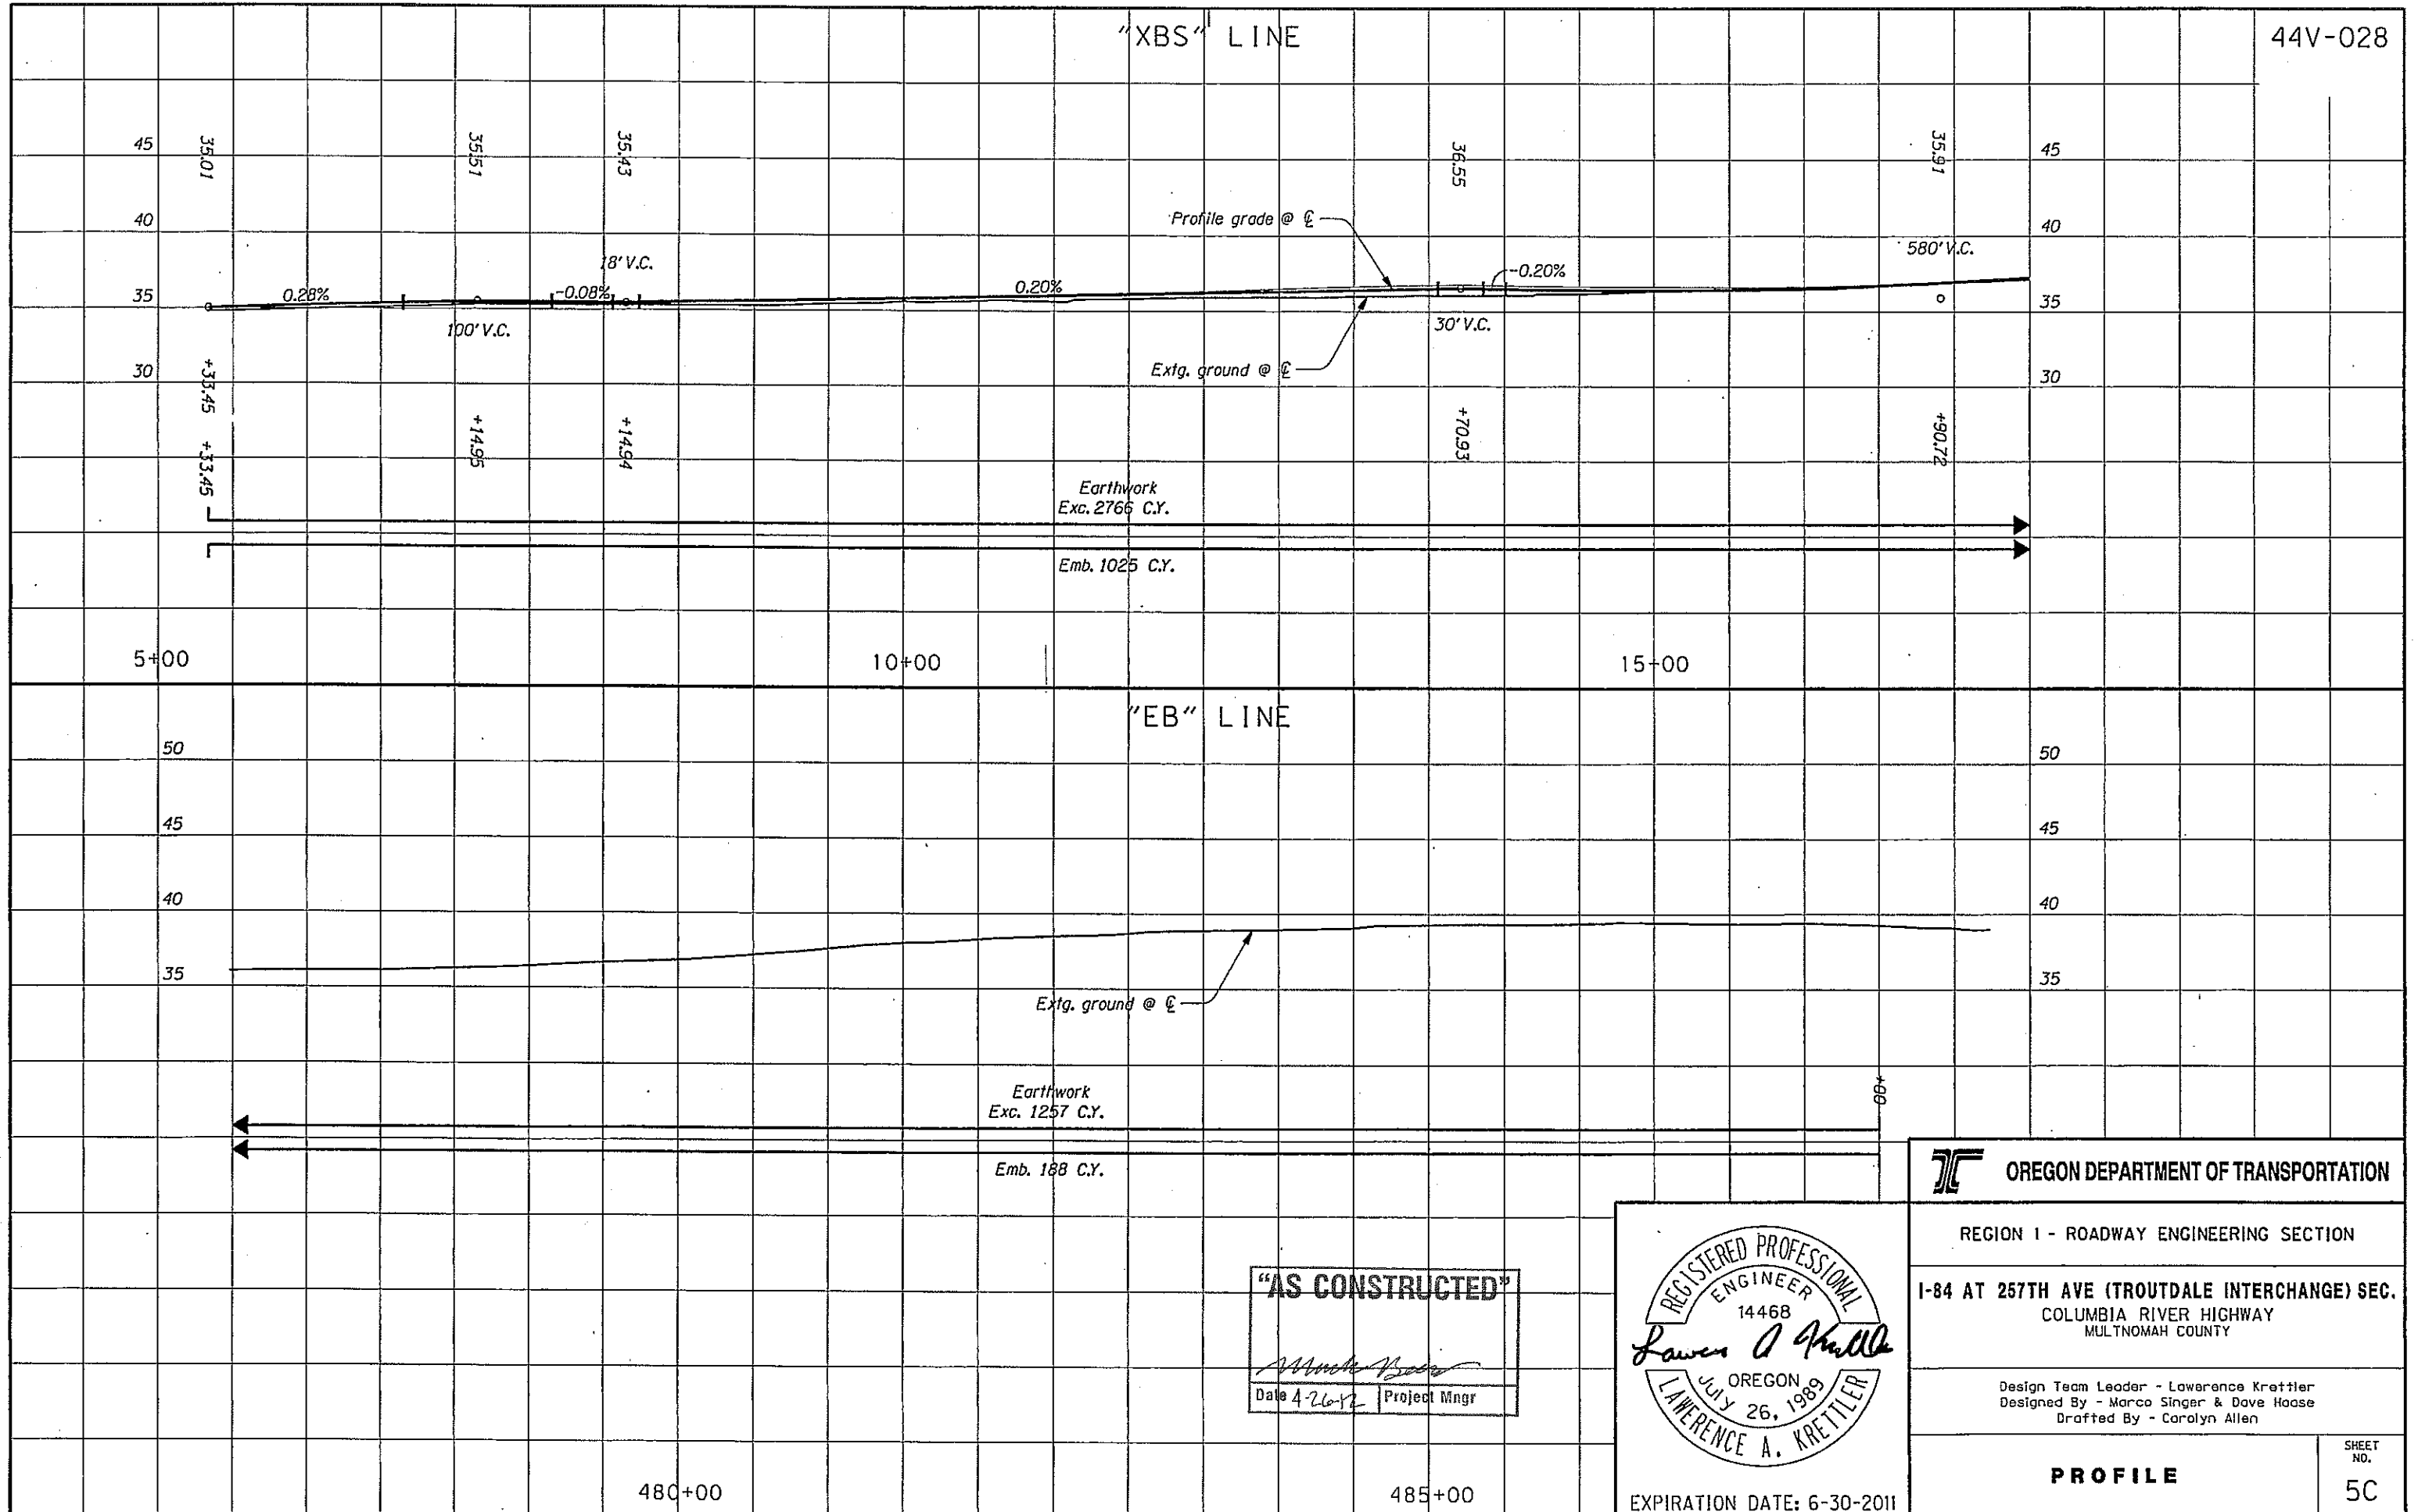

44V-028

"XBS" LINE

"EB" LINE

OREGON DEPARTMENT OF TRANSPORTATION

REGION 1 - ROADWAY ENGINEERING SECTION

I-84 AT 257TH AVE (TROUTDALE INTERCHANGE) SEC.
COLUMBIA RIVER HIGHWAY
MULTNOMAH COUNTY

Design Team Leader - Lawrence Kretler
Designed By - Marco Singer & Dave Hoase
Drafted By - Carolyn Allen


PROFILE

SHEET NO.
5C


"AS CONSTRUCTED"
Marco Singer
Date 4-26-92 Project Mngr

REGISTERED PROFESSIONAL
ENGINEER
14468
Lawrence A. Kretler
OREGON
JULY 26, 1989
LAWRENCE A. KRETLER


EXPIRATION DATE: 6-30-2011

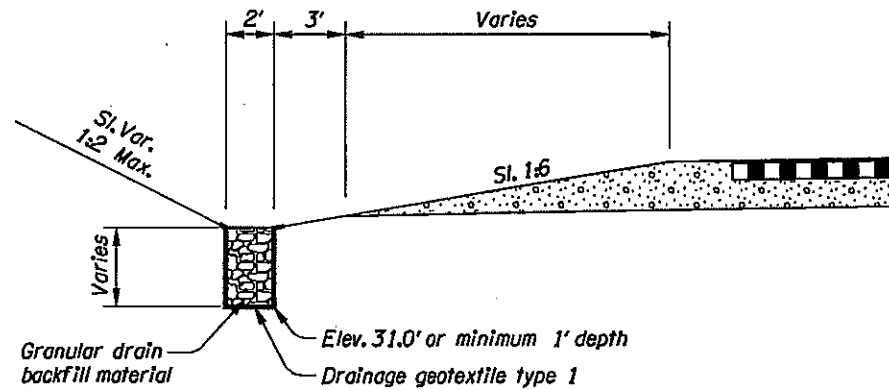


INFILTRATION SWALE TYPE A

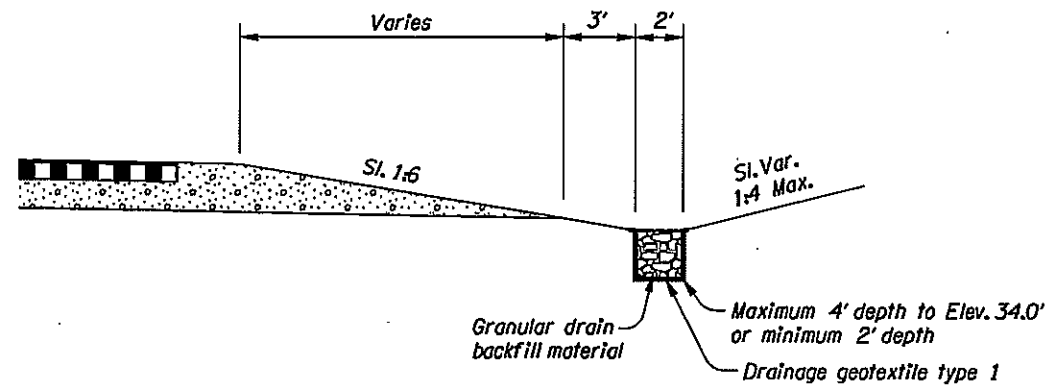


INFILTRATION SWALE TYPE B

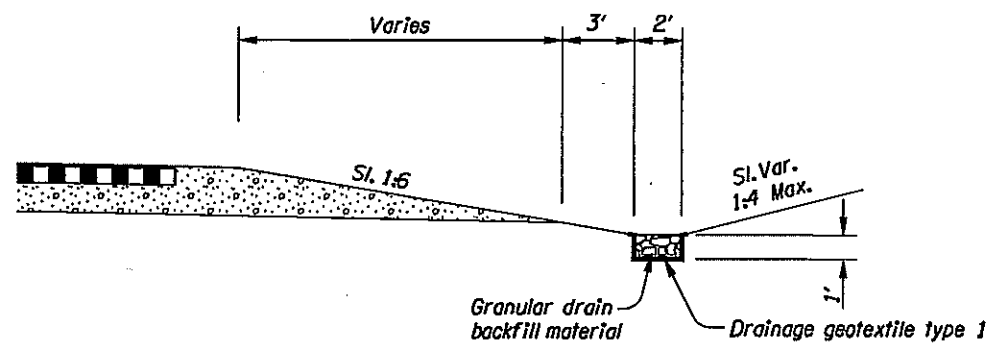


INFILTRATION SWALE TYPE C

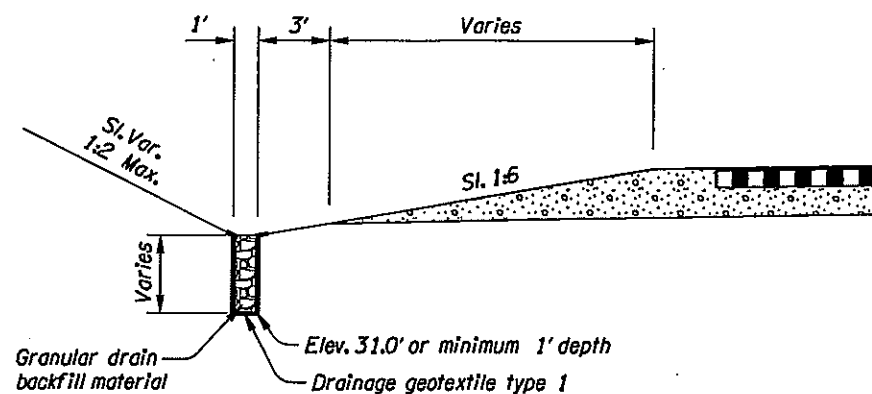

INFILTRATION SWALE TYPE D

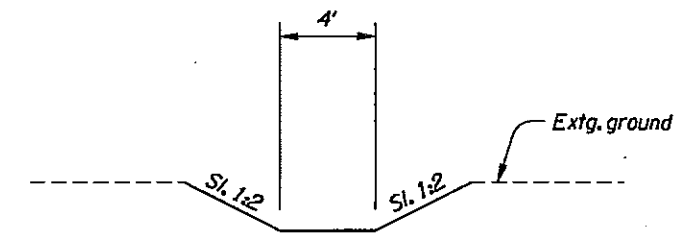


DITCH

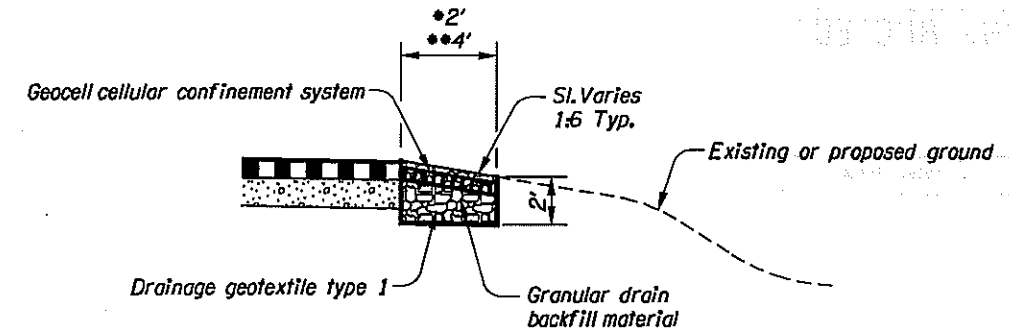

INFILTRATION SLOPE TYPE A

- Sta. "L4E" 455+91.80 to Sta. "L4E" 459+70.00
- Sta. "EB" 459+71.35 to Sta. "EB" 470+03.60

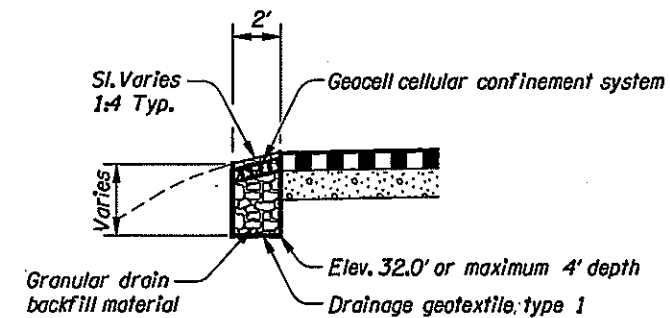

INFILTRATION SLOPE TYPE B

"AS CONSTRUCTED"
Mark Van
 Date 4-26-12 Project Mngr

REGISTERED PROFESSIONAL ENGINEER
 58552
Christine J. Higgins
 OREGON
 JULY 21, 1998
 CHRISTINE J. HIGGINS
 EXPIRES 06-30-11

OREGON DEPARTMENT OF TRANSPORTATION	
DAVID EVANS AND ASSOCIATES INC. 2100 Southwest River Parkway Portland Oregon 97201 Ph: 503.223.6663	
I-84 AT 257TH AVE (TROUTDALE INTERCHANGE) SEC. COLUMBIA RIVER HIGHWAY MULTNOMAH COUNTY	
Reviewed By - Craig Sheahan <i>CSH</i> Designed By - Karina Nordahl Drafted By - Edita Bogustawski	
DRAINAGE DETAILS	SHEET NO. GJ