

# OPERATION & MAINTENANCE MANUAL

## Water Quality Infiltration Swale

Manual prepared: March 2019

DFI No. D00542



Figure 1: DFI No. D00542, looking west

## 1. Identification

Drainage Facility ID (DFI): D00542  
Facility Type: Water Quality Infiltration Swale  
Construction Drawings: (V-File Numbers) 44V-028  
Location: District: 2B  
Highway No.: 002  
Mile Post: 16.00 to 16.43,  
South Side of NW Frontage Rd.

## 2. Manual Purpose

The purpose of this manual is to outline inspection needs and summarize maintenance actions.

## 3. Facility Location

The location map below details the facility location. The highway, mile posts, side streets, access location, and stormwater flow directions are noted on the map.

Facility location type: Roadway shoulder

Flow direction: West

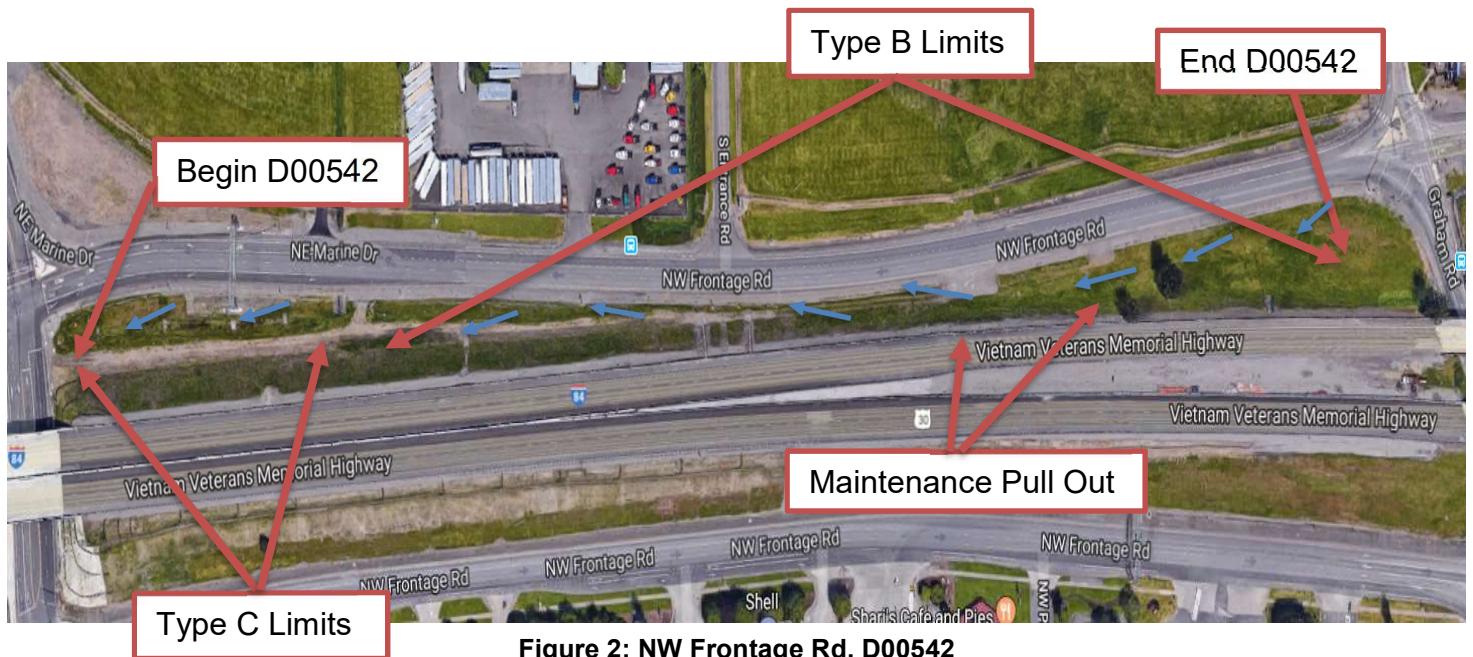



Figure 2: NW Frontage Rd. D00542

#### 4. Facility Summary

The length and width of a swale is based on the bottom dimensions.

The bottom length and bottom width of the swale is:


Bottom Length (feet)	Bottom Width (feet)
2245	2

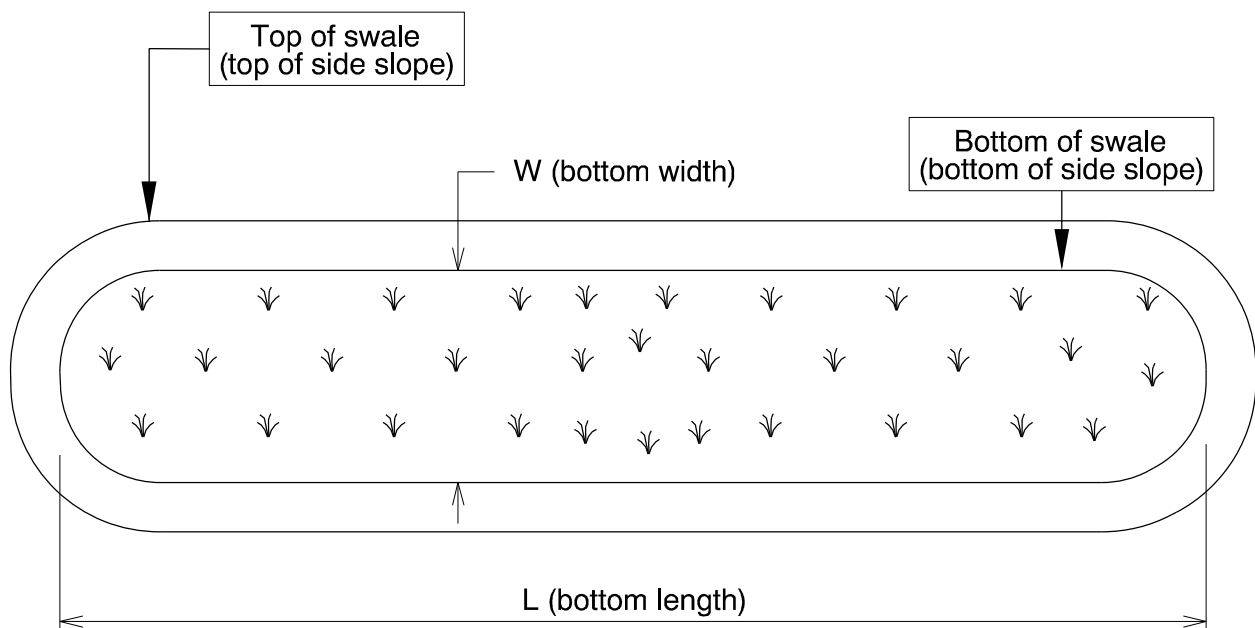

The depth of the swale is the vertical distance measured from the bottom of the swale to the top. The slope of the swale sides is presented by a vertical distance (rise) followed by the horizontal distance (run).

Depth and side slopes:

Depth (feet)	Rise (feet)	Run (feet)
Varies	1	6

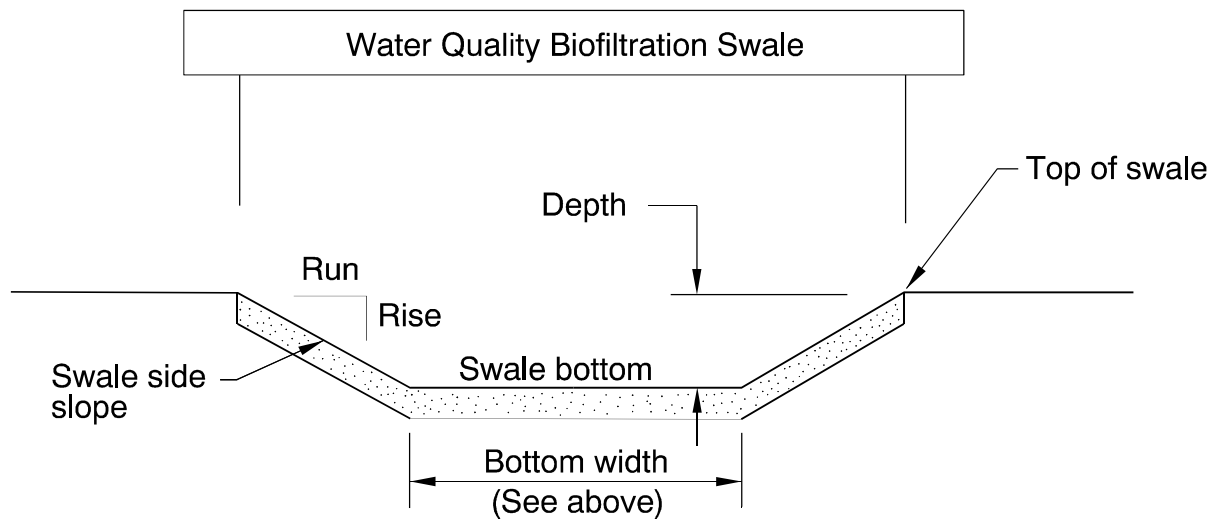

**Site Specific Information:** NW Frontage Rd. is a one way road, traveling east to west. The infiltration swale is similar to a Biofiltration Swale, it is long and linearly swale constructed into the existing slope. Infiltration testing was performed in the soil near this location and the infiltration rate was 100 inches/hour. The treatment is provided and pollutants are removed by infiltration processes. The water is stored in the voids in the trench gravels until it percolates into the surrounding soil. There are no subsurface drain pipes in this facility. The water generally is conveyed into the ground during routine storms and the facility can act as a roadside ditch during the more severe storms.

Swale Type	Station	Depth of Granular Drain Backfill
Type B	“TB” 47+91.2 to 52+73.8	2’ min
Type C	“XBS” 5+48.5 to 22+84.7	1’

## 5. Facility Access

Maintenance access to the facility:

<input checked="" type="checkbox"/> Roadside pad	<input type="checkbox"/> Roadside shoulder
<input type="checkbox"/> Access road with Gate	<input type="checkbox"/> Access road without Gate



**Figure 3: Two Maintenance Pull Out, looking Southwest**

Note: Existing culvert pipes under the maintenance pull out locations

## 6. Operational Components / Maintenance Items

### Classification

This facility is classified as an:

<input type="checkbox"/> <b>On-line Swale</b>	<input checked="" type="checkbox"/> <b>Off-line Swale</b>
A swale that does not include a high flow bypass component; flow drains into and through the facility	A swale that treats low/small flows and diverts high flows using a bypass component

### Bypass Component

This facility includes a high flow bypass component:

<input type="checkbox"/> <b>No</b>	<input checked="" type="checkbox"/> <b>Yes</b>
There is no bypass component. High flows drains into and through the facility	There is a bypass component. Only low/small flows drain into the swale. High flows are diverted around the swale using a bypass component

### Operational Components

A swale has many components that assist with treatment, conveyance, and reducing flow velocity to minimize erosion. The components in use can vary depending if the facility was designed to operate on-line or off-line. The facility components table (**Table 1**) has been provided to highlight the applicable components for this facility. The component is in use when the box contains an “x” (e.g.  ).

The Standard Operation Manual for Water Quality Biofiltration Swales (implemented March 2017) outlines facility operation, typical footprint configuration, and component definitions and details. A link to the manual is attached to the feature marker in TransGIS. <https://gis.odot.state.or.us/TransGIS/>

## Operational Plan

The applicable standard operational plan for this facility is:

<input type="checkbox"/> Operational Plan A	<input type="checkbox"/> Operational Plan B	<input checked="" type="checkbox"/> Operational Plan C
An on-line swale with roadside ditches	An on-line swale with piped inlets and outlets	An off-line swale with a piped high flow bypass
A standard operational plan illustrates the general facility footprint configuration and explains the purpose of each facility component. Operational plans (A, B, C) are provided in the Standard Operation Manual.		

See Appendix A for the site specific operational plan.

The high flow bypass is a 24' CMP cross culvert at approximately station "XBS" 10+50.

## Maintenance Items

Operational components marked in **Table 1** should be inspected and maintained according to Section 7. Each facility component is defined and detailed in the Standard Operation Manual using the associated ID number indicated below.

Table 1: Swale Components		ID #
<b>Manholes/Structures</b>		
Pre-treatment manhole	<input type="checkbox"/>	<b>S1</b>
Weir type flow splitter/flow splitter manhole	<input type="checkbox"/>	<b>S2</b>
Orifice type flow splitter/flow splitter manhole	<input type="checkbox"/>	<b>S3</b>
Standard manhole	<input type="checkbox"/>	<b>S4</b>
<b>Swale Inlet</b>		
Pavement sheet flow	<input checked="" type="checkbox"/>	<b>S5</b>
Inlet Pipe (s)	<input type="checkbox"/>	<b>S6</b>
Open channel inlet	<input type="checkbox"/>	<b>S7</b>
Riprap pad	<input type="checkbox"/>	<b>S8</b>
<b>Ground Cover</b>		
Grass bottom	<input type="checkbox"/>	<b>S9</b>
Grass side slopes	<input type="checkbox"/>	<b>S10</b>
Granular drain rock	<input checked="" type="checkbox"/>	<b>S11</b>
Plantings	<input type="checkbox"/>	<b>S12</b>
<b>Underground Components</b>		
Geotextile fabric	<input checked="" type="checkbox"/>	<b>S13</b>
Water quality mix	<input type="checkbox"/>	<b>S14</b>
Perforated pipe	<input type="checkbox"/>	<b>S15</b>
Porous pavers (access grid)	<input type="checkbox"/>	<b>S16</b>

<b>Flow Spreader</b>		
Rock basin (used at inlet)	<input type="checkbox"/>	<b>S17</b>
Anchored board (midpoint of swale or every 50 feet along swale bottom)	<input type="checkbox"/>	<b>S18</b>
Other:	<input type="checkbox"/>	<b>S19</b>
<b>Swale Outlet</b>		
Catch basin with grate	<input type="checkbox"/>	<b>S20</b>
Outlet Pipe (s)	<input type="checkbox"/>	<b>S21</b>
Open channel outlet	<input type="checkbox"/>	<b>S22</b>
Auxiliary Outlet: Infiltration Swale with over flow cross Culverts	<input checked="" type="checkbox"/>	<b>S23</b>
<b>Outfall Type</b>		
Waterbody (Creek/Lake/Ocean)	<input type="checkbox"/> <b>C</b>	<b>S24</b>
	<input type="checkbox"/> <b>L</b>	
	<input type="checkbox"/> <b>O</b>	
Ditch	<input type="checkbox"/>	<b>S25</b>
Storm drain system	<input type="checkbox"/>	<b>S26</b>
<b>Outfall Components</b>		
Riprap pad	<input type="checkbox"/>	<b>S27</b>
Riprap bank protection	<input type="checkbox"/>	<b>S28</b>



## 7. Maintenance

### Maintenance Frequency/Maintain Records

- a. Inspect annually. Preferably prior to the rainy season.
- b. Clean and maintain as necessary. Refer to Activity 125 for conditions when maintenance is needed.
- c. Keep a record of inspections, maintenance, and repairs.

### Maintenance Guide/Maintenance Actions

The ODOT Routine Road Maintenance Water Quality and Habitat Guide (the *Blue Book*) outlines the standard maintenance actions for water quality facilities under Activity 125.

There are standard maintenance tables for standard ODOT designs. The maintenance tables describe the maintenance component, the defect or problem, the condition when maintenance is needed, and the recommended maintenance to correct the problem. Use the following tables to maintain ODOT swales:

- Table 1 (General Maintenance): Contains general maintenance and inspection guidelines that are applicable to all ODOT water quality facilities
- Table 3 (Maintenance of Water Quality or Biofiltration Swales): Contains maintenance information for swales

The *Blue Book* can be viewed at the following website:

[http://www.oregon.gov/ODOT/Maintenance/Documents/blue\\_book.pdf](http://www.oregon.gov/ODOT/Maintenance/Documents/blue_book.pdf)

## 8. Limitations

Access grid installed:

<input checked="" type="checkbox"/> No	<input type="checkbox"/> Yes
There are <b>no</b> duty porous pavers installed in this swale	

Swales are designed to allow equipment access along the bottom. If an access grid is **NOT** installed, vehicles entering the swale can create depressions (tire ruts), damage vegetation, and damage structural components (e.g. flow spreaders). These conditions may result in poor treatment and drainage performance.

Equipment wheels should be kept on the tops and side slopes. Mower arms may be run along the swale bottom.

## 9. Waste Material Handling

Material removed from the facility is defined as waste by the Department of Environmental Quality (DEQ). Refer to the roadwaste section of the ODOT Maintenance Yard Environmental Management System (EMS) Policy and Procedures Manual for disposal options:

[http://www.oregon.gov/ODOT/Maintenance/Documents/ems\\_manual.pdf](http://www.oregon.gov/ODOT/Maintenance/Documents/ems_manual.pdf)


Contact any of the following for more detailed information about management of waste materials found on site:

ODOT Clean Water Unit	(503) 986-3008
ODOT Statewide Hazmat Coordinator	(503) 667-7442
ODOT Region 1 Hazmat Coordinator	(503) 731-8290
ODOT Region 2 Hazmat Coordinator	(503) 986-2647
ODOT Region 3 Hazmat Coordinator	(541) 957-3594
ODOT Region 4 Hazmat Coordinator	(541) 388-6186
ODOT Region 5 Hazmat Coordinator	(541) 963-1590
ODEQ Northwest Region Office	(503) 229-5263


## **A Appendix A – Site Specific Operational Plan**

**Contents: Appendix A plan sheets include raster images of the as-built plans. The original drawings were not located.**

**Operational Plan: DFI **D00542****

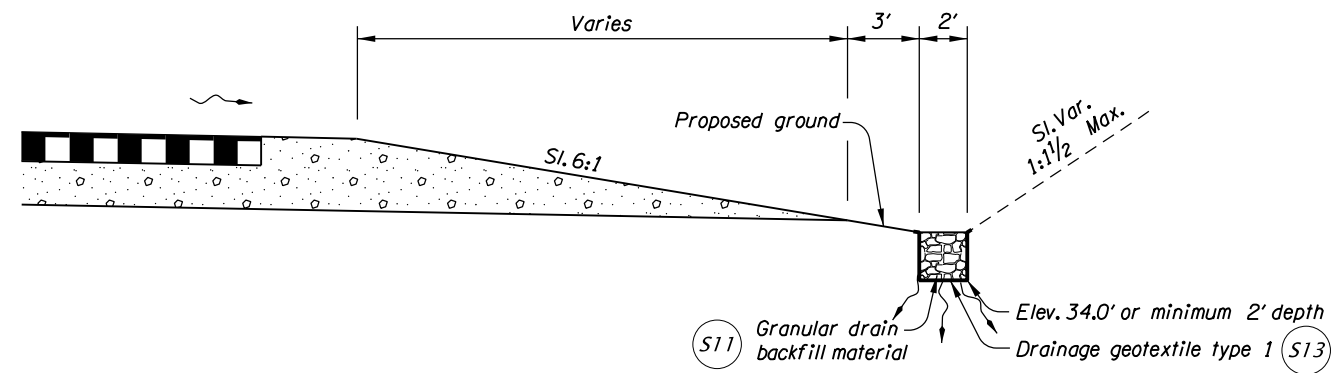

INFILTRATION SWALE TYPE B

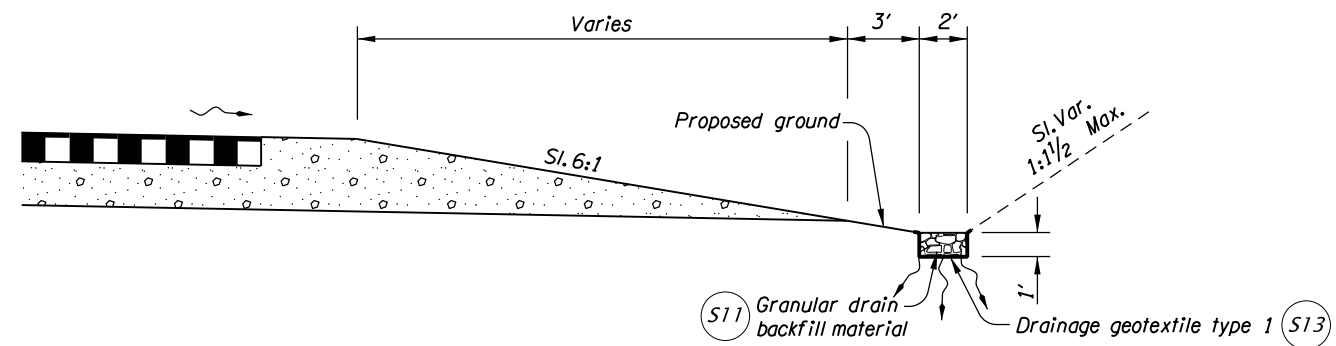

INFILTRATION SWALE TYPE C


- LEGEND:
- (X#) Facility Component (see table 1 in O&M Manual)
  - and ○ Manhole
  - and □ Inlet
  - Storm Pipe (Facility)
  - Storm Pipe
  - ← Conveyance Direction
  - ~ Pavement / Facility Flow Path
  - ← Traffic Flow Direction


TYPICAL SECTION  
N.T.S.

Sht. 1 of 2

Prepared By:  
Alan Babicky

Drafted By:  
Alan Babicky


**OREGON DEPARTMENT OF TRANSPORTATION**  
**DFI D00542**  
**MAINTENANCE DISTRICT 2B HWY 002**  
**INFILTRATION SWALE**  
 HIGHWAY MP 16.00 - 16.43  
 MULTNOMAH COUNTY

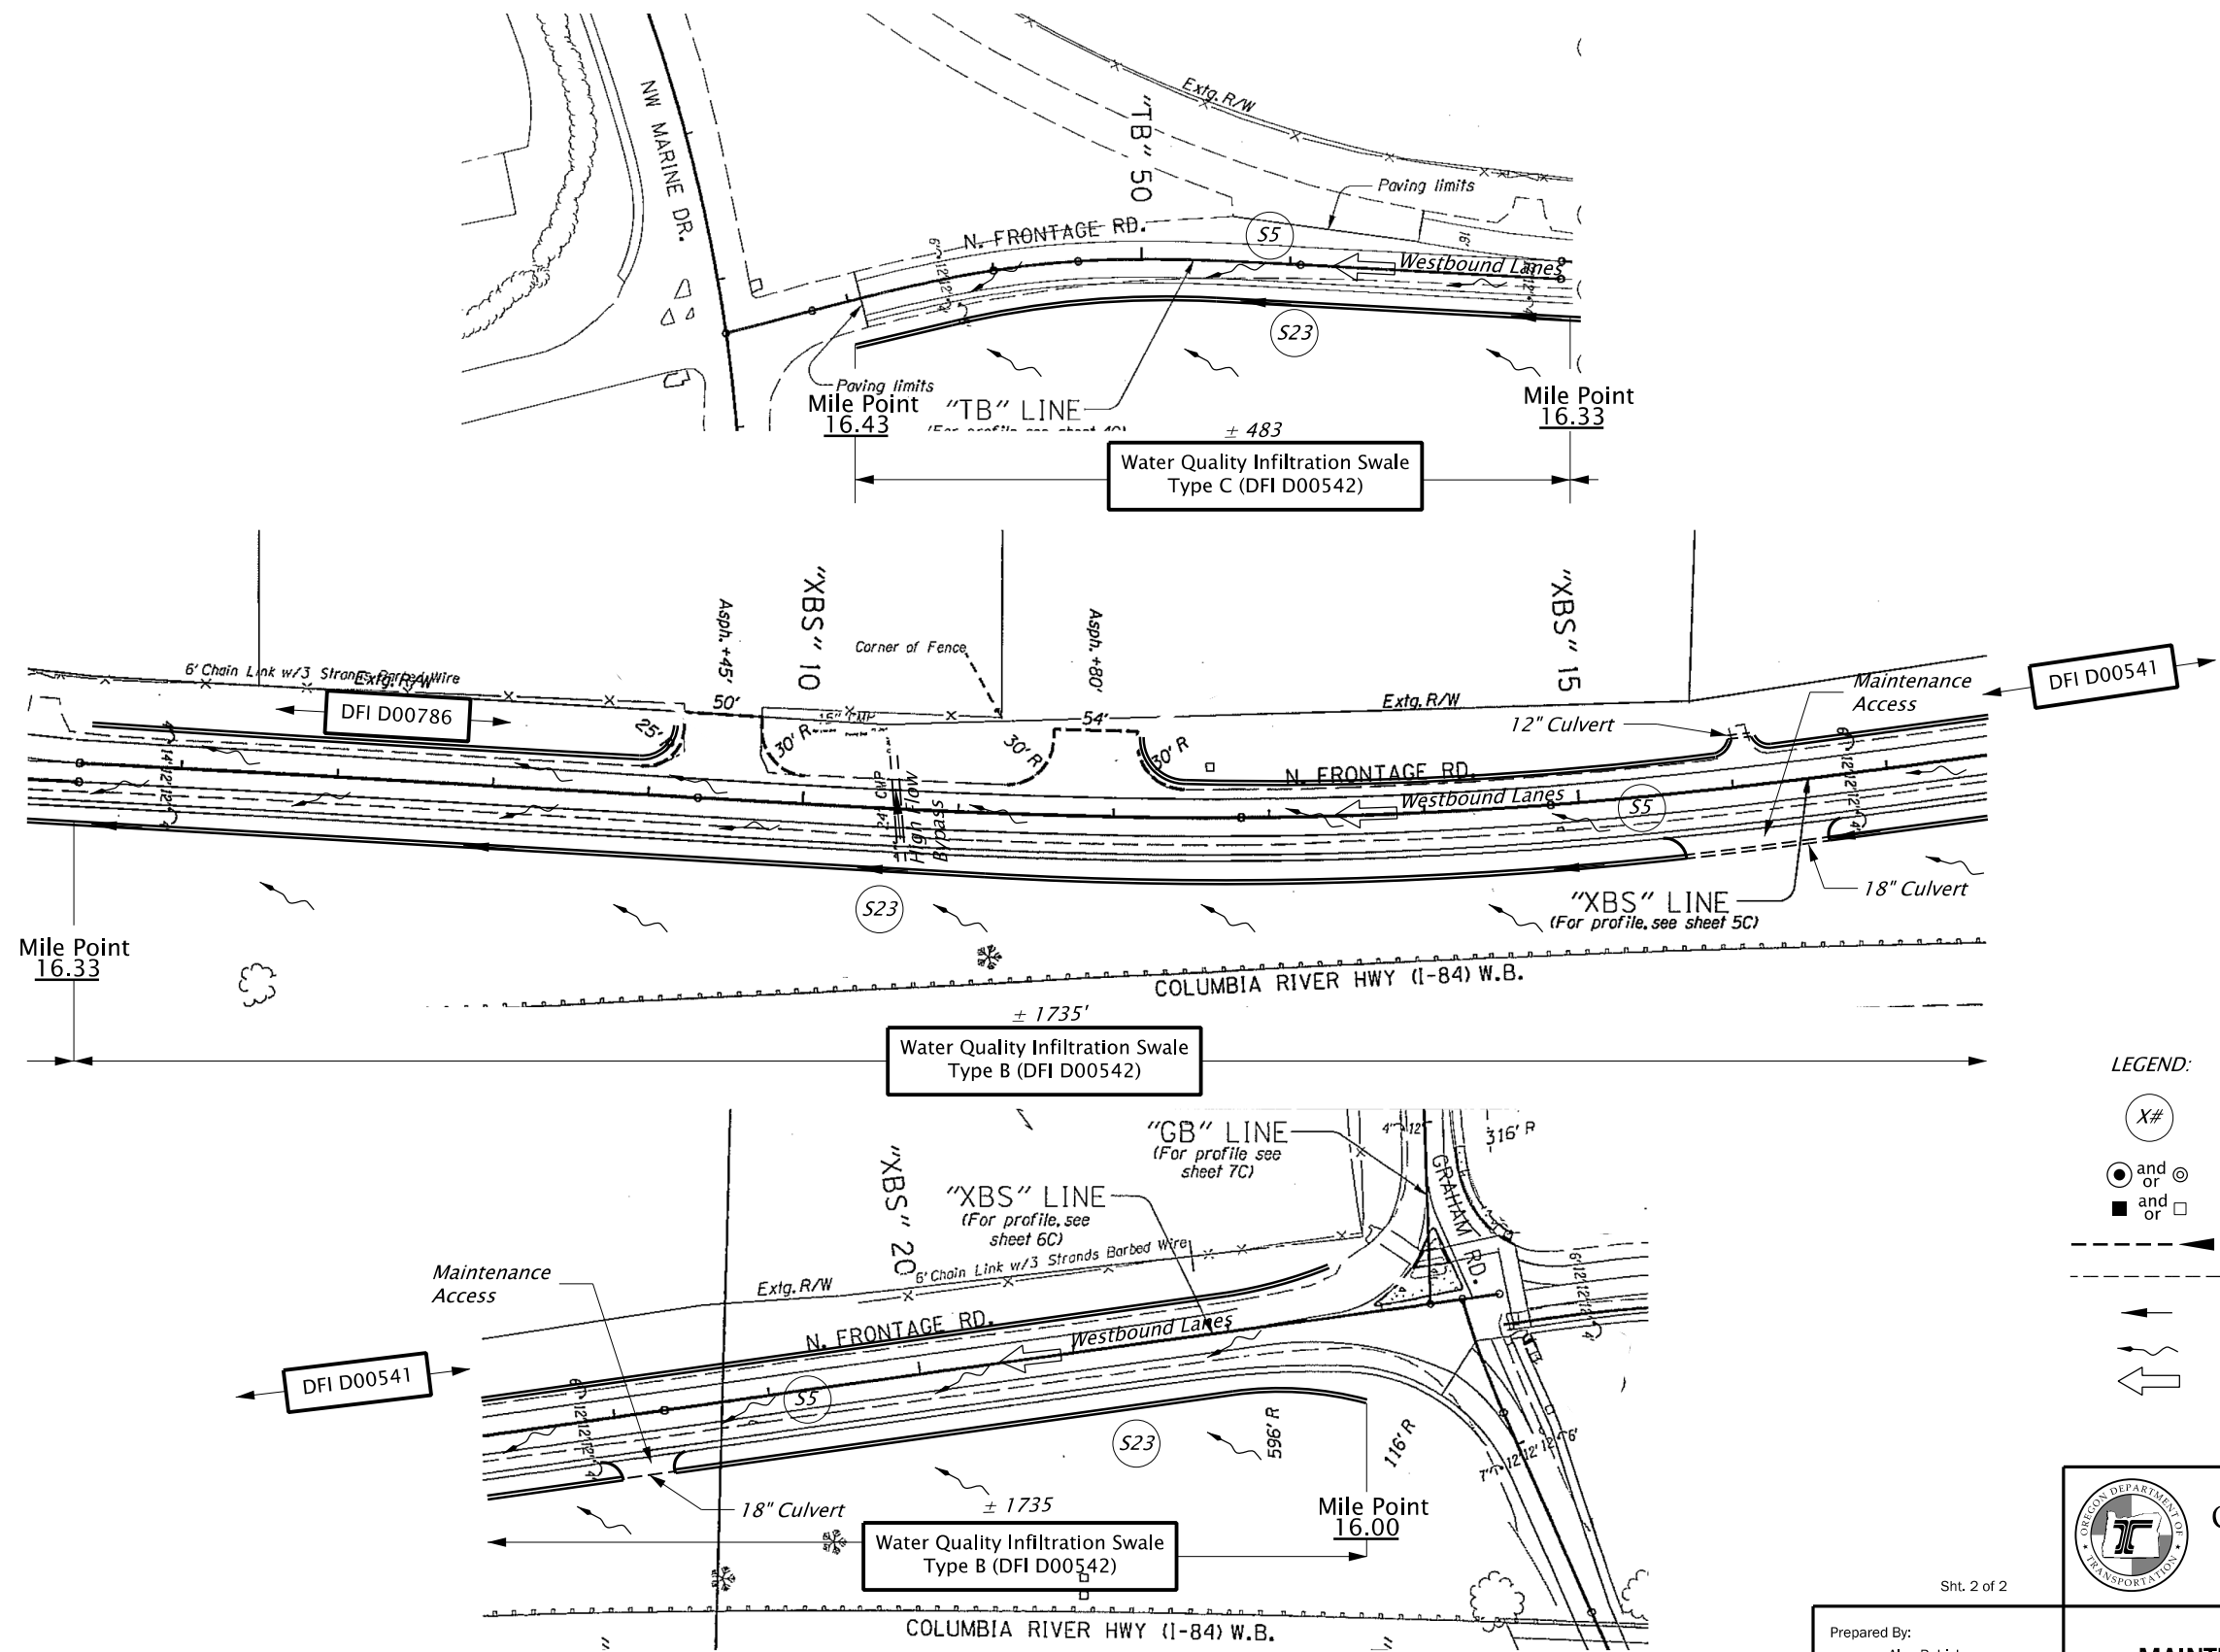

- LEGEND:**
- Facility Component (see table 1 in O&M Manual)
  - Manhole
  - Inlet
  - Storm Pipe (Facility)
  - Storm Pipe
  - Conveyance Direction
  - Pavement / Facility Flow Path
  - Traffic Flow Direction



**OREGON DEPARTMENT OF TRANSPORTATION**

Sht. 2 of 2

Prepared By:  
Alan Babicky

Drafted By:  
Alan Babicky

**DFI D00542**  
**MAINTENANCE DISTRICT 2B HWY 002**  
**INFILTRATION SWALE**  
 HIGHWAY MP 16.00 - 16.43  
 MULTNOMAH COUNTY

## **B Appendix B – Project Contract Plans**

### **Contents:**

**Site Specific Subset of Project Contract Plan 44V-028**

INDEX OF SHEETS	
SHEET NO.	DESCRIPTION
1	Title Sheet
1A	Index Of Sheets Cont'd. & Std. Drg. Nos.
1B	Std. Drg. Nos. Cont'd.

STATE OF OREGON  
DEPARTMENT OF TRANSPORTATION

PLANS FOR PROPOSED PROJECT

GRADING, DRAINAGE, PAVING, PAVEMENT MARKERS, SIGNING,  
ILLUMINATION, SIGNALS & ROADSIDE DEVELOPMENT

**I-84 AT 257TH AVE (TROUTDALE INTERCHANGE) SEC.**  
**COLUMBIA RIVER HIGHWAY**

MULTNOMAH COUNTY  
MARCH 2011

**BEGINNING OF CONTRACT PROJECT**



STA. "RW" 317+09 (M.P. 13.96)

"AS CONSTRUCTED"

*Mark Beem*  
Date 4-26-12 Project Mgr

**END OF PROJECT**

STA. "XB" 36+38.20 =  
STA. "RW" 501+60.55 (M.P. 17.44)

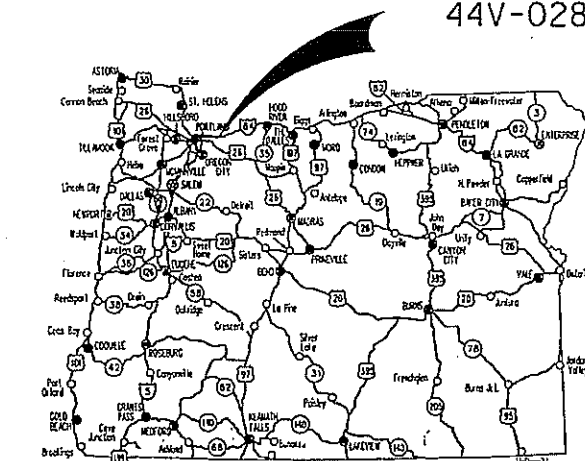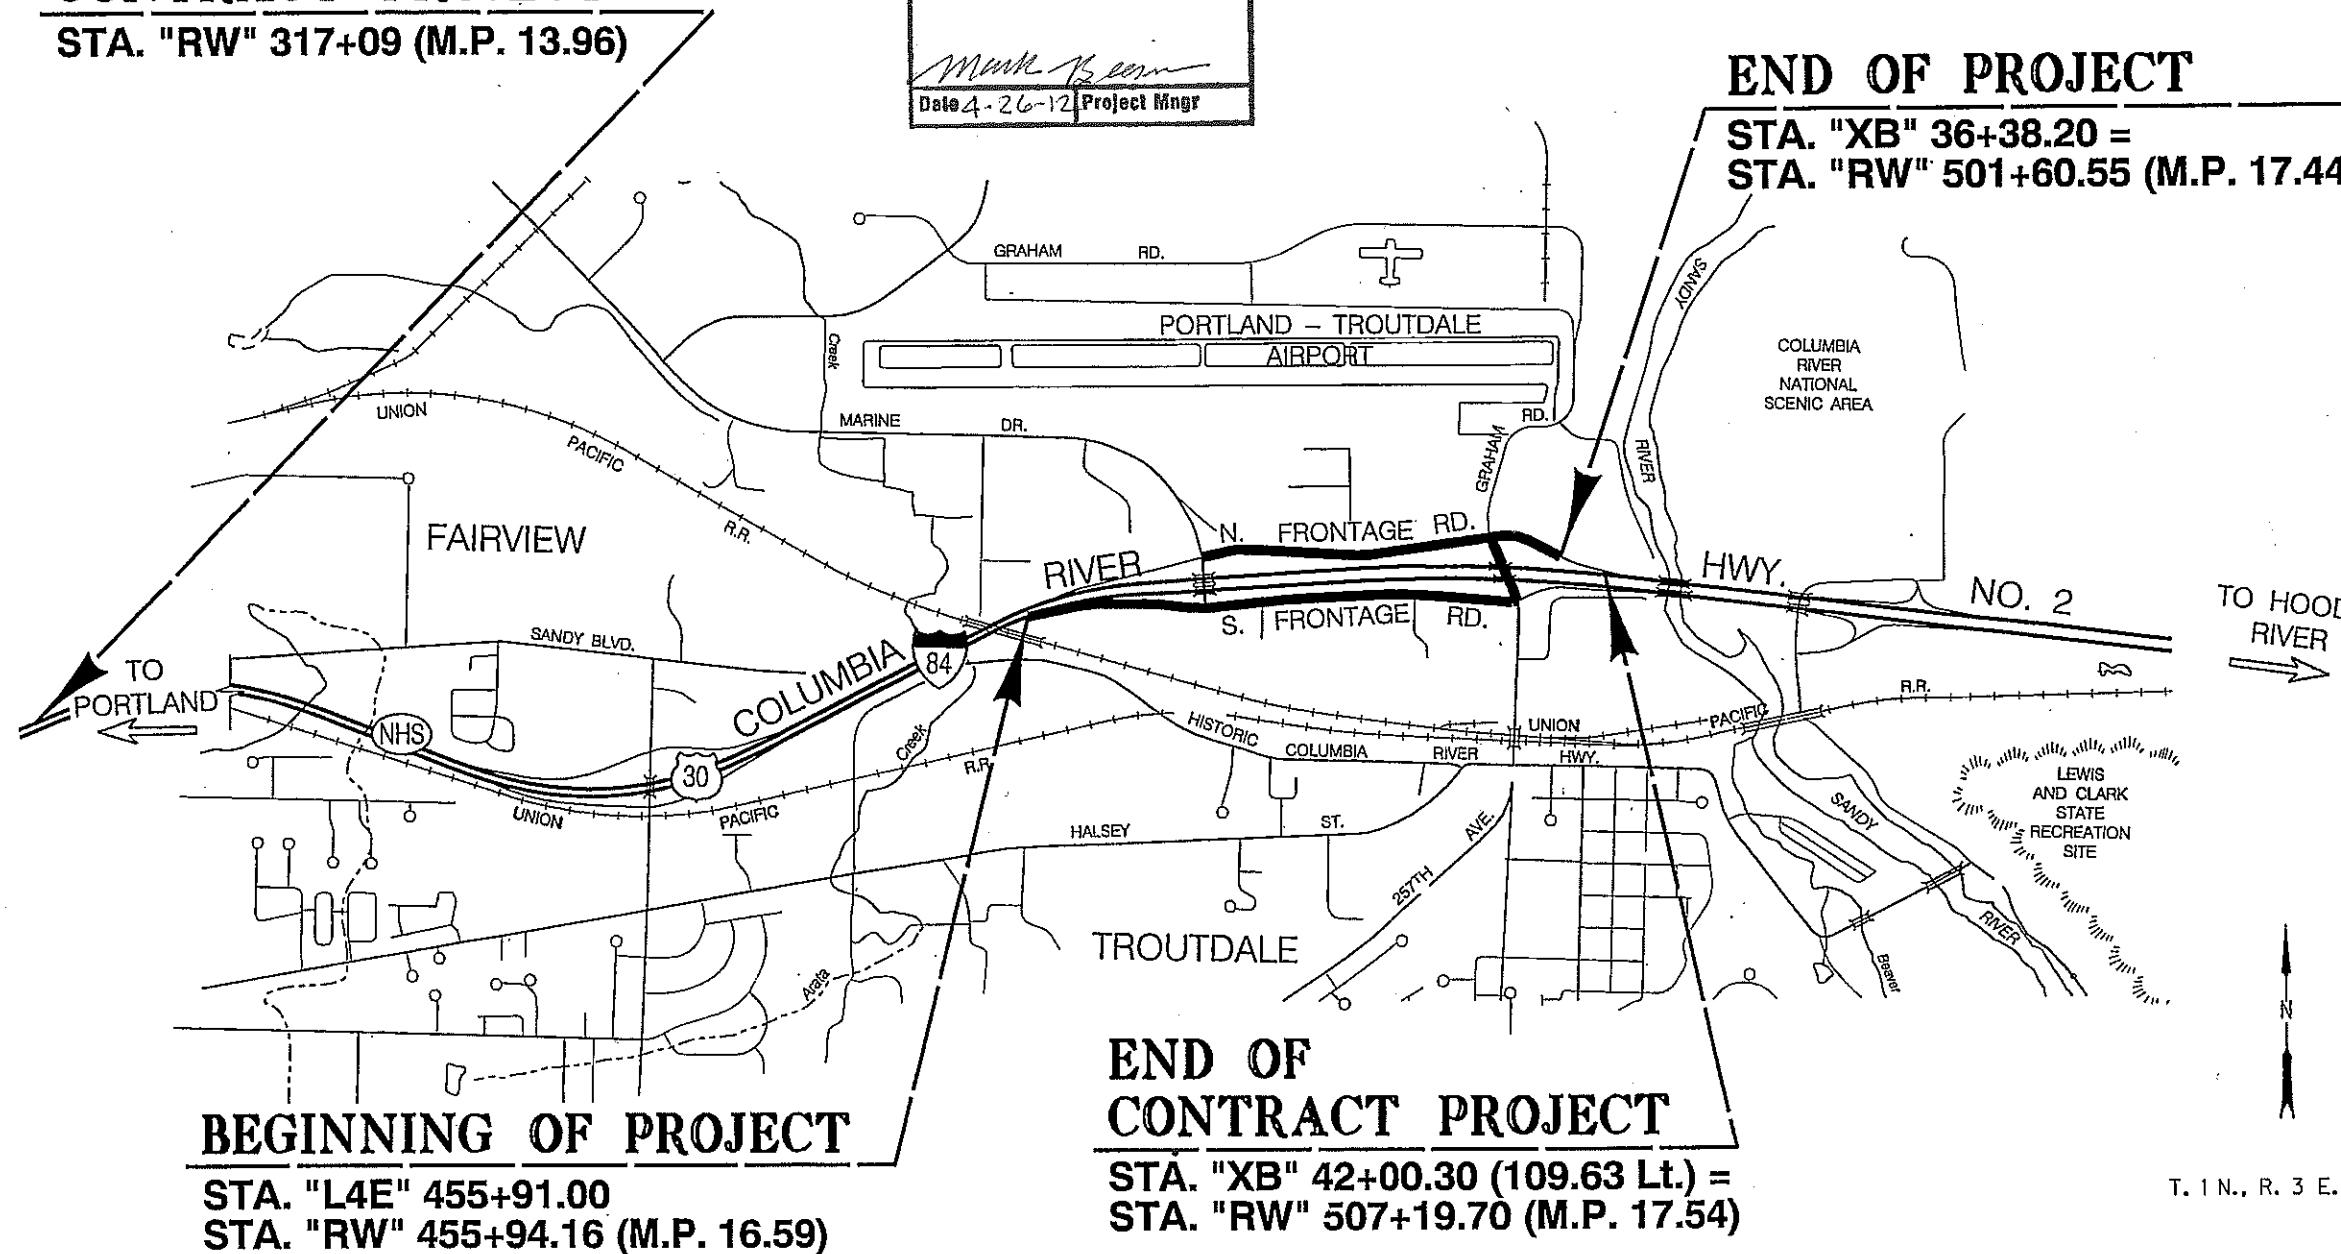

Overall Length Of Project - 0.85 Miles

**ATTENTION:**  
Oregon Law Requires You To Follow Rules Adopted By The Oregon Utility Notification Center. Those Rules Are Set Forth In OAR 952-001-0010 Through OAR 952-001-0090. You May Obtain Copies Of The Rules By Calling The Center. (Note: The Telephone Number For The Oregon Utility Center Is (503) 232-1987.)

LET'S ALL  
WORK TOGETHER  
TO MAKE THIS  
JOB SAFE

**OREGON TRANSPORTATION COMMISSION**  
Gail Achterman CHAIR  
Michael Nelson VICE-CHAIR  
Mary Olson COMMISSIONER  
Alan Brown COMMISSIONER  
David Lohman COMMISSIONER  
Matthew L. Garrett DIRECTOR OF TRANSPORTATION

These plans were developed using ODOT design standards. Exceptions to these standards, if any, have been submitted and approved by the ODOT Chief Engineer or their delegated authority.

Approving Authority: *Naveen G. Chandra*  
Naveen G. Chandra, P.E.  
Project Delivery Manager, Region 1

*J. M. W.*  
Concurrence by ODOT Chief Engineer

I-84 AT 257TH AVE (TROUTDALE INTERCHANGE) SEC.  
COLUMBIA RIVER HIGHWAY  
MULTNOMAH COUNTY

FEDERAL HIGHWAY ADMINISTRATION	PROJECT NUMBER	SHEET NO.
OREGON DIVISION	STATE	1

T. 1 N., R. 3 E., W.M.



PE001770 000 J13

INDEX OF SHEETS, CONT'D.	
SHEET NO.	DESCRIPTION
2, 2A, 2A-2 thru 2A-13, Incl.	Typical Sections
2B, 2B-2 thru 2B-4, Incl.	Details <i>Added Sht 2B-3A</i>
2C, 2C-2 & 2C-3	Detour
2C-4 thru 2C-16, Incl.	Traffic Control Plans
2D	Pipe Data Sheet
3	Alignment
3A	General Construction
3B	Drainage & Utilities
3C	Profiles
4	Alignment
4A	General Construction
4B	Drainage & Utilities
4B-2	Drainage & Utilities
4C	Profiles
4D	Drainage Profiles
5	Alignment
5A	General Construction
5B	Drainage & Utilities
5B-2	Drainage & Utilities
5C	Profiles
5D	Drainage Profiles
6	Alignment
6A	General Construction
6B	Drainage & Utilities
6B-2	Drainage & Utilities
6C	Profiles
6D	Drainage Profiles
7	Alignment
7A	General Construction
7C	Profiles
B	Alignment
8A	General Construction
<b>GEO/HYDRO</b>	
GA	Erosion Control Details
GA-2 thru GA-8	Erosion Control Plans
GB, GB-2 & GB-3	Geotechnical Data
GJ	Drainage Details
GJ-2, GJ-3, GJ-4	Stormwater Treatment and Storage Facility Field Markers
<b>BRIDGE STRUCTURE 17365</b>	
85233	Bridge General Layout
85235	Structural Mount
85236	Structure Mount Details
<b>PERMANENT PAVEMENT MARKINGS</b>	
ST, ST-2 thru ST-7, Incl.	Pavement Marking Plan
<b>PERMANENT SIGNING</b>	
S-12500 thru S-12517, Incl.	Permanent Signing
<b>BRIDGE STRUCTURE 21529</b>	
S-12518	Cantilever Sign Support, Sta. "EB" 458+80

INDEX OF SHEETS, CONT'D.	
DRAWING NO.	DESCRIPTION
<b>ILLUMINATION</b>	
I-1827	Illumination Legend
I-1828 & I-1829	Illumination Removal Plan
I-1830 & I-1831	Illumination Plan
I-1832	Illumination Details
<b>TRAFFIC SIGNALS</b>	
15969	Signal and Detector Plan Legend
15970	Detector Plan
15971	Signal Removal Plan
15972	Temporary Signal Plan
15973	Signal Plan
15974	Detector Plan
15975	Existing Utility Plan
15976	Signal Removal Plan
15977	Temporary Signal Plan
15978	Signal Plan
15979	Detector Plan
15980	Existing Utility Plan
15981	Temporary Pole Entrance Chart
15982	Pole Entrance Chart
<b>ITS</b>	
ITS-1044	ITS Legend & Symbols
ITS-1045 thru ITS-1049, Incl.	ITS Plan
ITS-1050 thru ITS-1055, Incl.	ITS Details

*ADDED 15978A GRADING For Signal Pole # 18*

Standard Drg. Nos.

- RD140 - Roadway Cross Slopes Superelevated Sections
- RD150 - Slope Rounding
- RD300 - Trench Backfill, Bedding, Pipe Zone And Mult. Installations
- RD302 - Street Cut
- RD316 - Sloped Ends For Metal Pipe
- RD318 - Sloped Ends For Concrete Pipe
- RD320 - Paved End Slope For Culverts 60" Maximum Pipe Size
- RD326 - Coupling Bands For Corrugated Metal Pipe
- RD336, RD342, RD344, RD346 - Manholes
- RD356 - Manhole Cover & Frames
- RD358 - Manhole Slope Protectors
- RD364, RD370, RD376 - Concrete Inlets
- RD380, RD384, RD386 - Pipe Fill Height Tables
- RD400, RD405, RD415, RD420, RD450 - Guardrail

- RD500 - Precast Concrete Barrier Pin And Loop Assembly
- RD510 - Concrete Barrier Terminal
- RD700 - Curbs
- RD705 - Islands
- RD710 - Accessible Route Islands
- RD715 - Approaches And Non-Sidewalk Driveways
- RD720 - Sidewalks
- RD755 - Sidewalk Ramp Details
- RD759 - Truncated Dome Detectable Warning Surface Details And Locations
- RD1000 - Construction Entrances
- RD1005 - Check Dams
- RD1010, RD1015 - Inlet Protection
- RD1040 - Sediment Fence
- TM200 - Sign Installation Details
- TM201 - Miscellaneous Sign Placement Details
- TM204 - Flag Board Mounting Details
- TM211 - Signage Details
- TM223, TM224 - Directional Sign Layout
- TM225 - Exit Number & Gore Signage Details
- TM230, TM231, TM232, TM233 - Mounting Details For Removable Legend
- TM300, TM301 - Illumination Control Cabinets
- TM450 - Mast Arm Pole Details
- TM452 - Strain Pole Details
- TM455 - Temporary Signal Details
- TM457 - Vehicle, Ped. Signal & Push Button Mounting Details
- TM458 - Pedestrian Ramp Placement Details
- TM460 - Vehicle Signal Details
- TM462 - Adjustable Signal Head Mounting Details
- TM463 - Spanwire Mounting Details
- TM465 - Overhead Sign, Fire Preemption & Photoelectronic Details
- TM467 - Ped. Signal And Ped. Push Button Details
- TM470 - Color Code Charts
- TM472 - Traffic Signal Junction Boxes
- TM475 - Loop Details
- TM480 - Loop Entrance Details
- TM482 - Controller Cabinet And Foundation Details
- TM485 - Service Cabinets And Service Cabinet Wiring Details
- TM488 - Terminal Cabinet Detail
- TM490 - Crosswalk Closure Detail

**"AS CONSTRUCTED"**  
*Mark Beem*  
Date 4-26-12 Project Mgr

**I-84 AT 257TH AVE (TROUTDALE INTERCHANGE) SEC.**  
COLUMBIA RIVER HIGHWAY  
MUTNOMAH COUNTY

FEDERAL HIGHWAY ADMINISTRATION	PROJECT NUMBER	SHEET NO.
OREGON DIVISION	<b>STATE</b>	1A

Standard Drawings located on the web at:  
[http://www.oregon.gov/ODOT/HWY/ENGSERVICES/standard\\_drawings\\_home.shtml](http://www.oregon.gov/ODOT/HWY/ENGSERVICES/standard_drawings_home.shtml)



Standard Drg. Nos. (contd.)

- TM500, TM501, TM503 - Pavement Marking Standard Details
- TM525 - Turn Arrow Marking Details
- TM530 - Intersection Pavement Markings
- TM551 - Freeway Exit Ramp Pavement Markings
- TM560, TM561 - Alignment Layout
- TM570 - Traffic Delineators
- TM571 - Traffic Delineators Steel Post Details
- TM575 - Traffic Delineator Installation
  
- TM600, TM601 - Multi-Post Breakaway Sign Supports
- TM602 - Triangular Base Breakaway Multi-Direction Slip Base
- TM618 - Truss Type Sign Bridge
- TM622, TM623, TM624, TM625, TM626, TM627 - Monotube Cantilever Sign Support
  
- TM629, TM630 - Slip Base & Fixed Base Luminaire Supports
  
- TM635 - Breakaway Sign & Luminaire Supports
- TM650, TM651, TM652, TM653 - Traffic Signal Supports
- TM670 - Wood Post Sign Supports
- TM671 - 3 Second Gust Wind Speed Isotach
- TM675 - Extruded Aluminum Panels
- TM676 - Sign Attachments
- TM677 - Sign Mounts
- TM678 - Secondary Sign Mounting Details
- TM679 - Signal Mast Arm Street Name Sign Mounts
- TM680 - Signal Pole Mounts
- TM681, TM687, TM688 - Square Tube Sign Supports
  
- TM800 - Tables, Abrupt Edge And PCMS Details
- TM810 - Temporary Reflective Pavement Markers
- TM820 - Temporary Barricades
- TM821 - Temporary Sign Supports
- TM830 - Temporary Concrete Barrier And Rumble Strips
- TM831, TM832 - Temporary Impact Attenuators
- TM840 - Closure Details
- TM841 - Intersection Work Zone Details
- TM842 - Signalized Intersection Details
- TM843 - Intersection Details
- TM851 - 2-Lane, 2-Way Roadways
- TM860 - Freeway Sections

R/W Map Nos. 6B-15-13, 1A-22-7,  
1R-3-1477 and 1R-3-1477


**"AS CONSTRUCTED"**

*Mark Beer*

Date 4-26-12 Project Mngr

<b>1-84 AT 257TH AVE (TROUTDALE INTERCHANGE) SEC.</b> COLUMBIA RIVER HIGHWAY MULTNOMAH COUNTY		
FEDERAL HIGHWAY ADMINISTRATION	PROJECT NUMBER	SHEET NO.
OREGON DIVISION	<b>STATE</b>	<b>1B</b>

Standard Drawings located on the web at:  
[http://www.oregon.gov/ODOT/HWY/ENGSERVICES/standard\\_drawings\\_home.shtml](http://www.oregon.gov/ODOT/HWY/ENGSERVICES/standard_drawings_home.shtml)

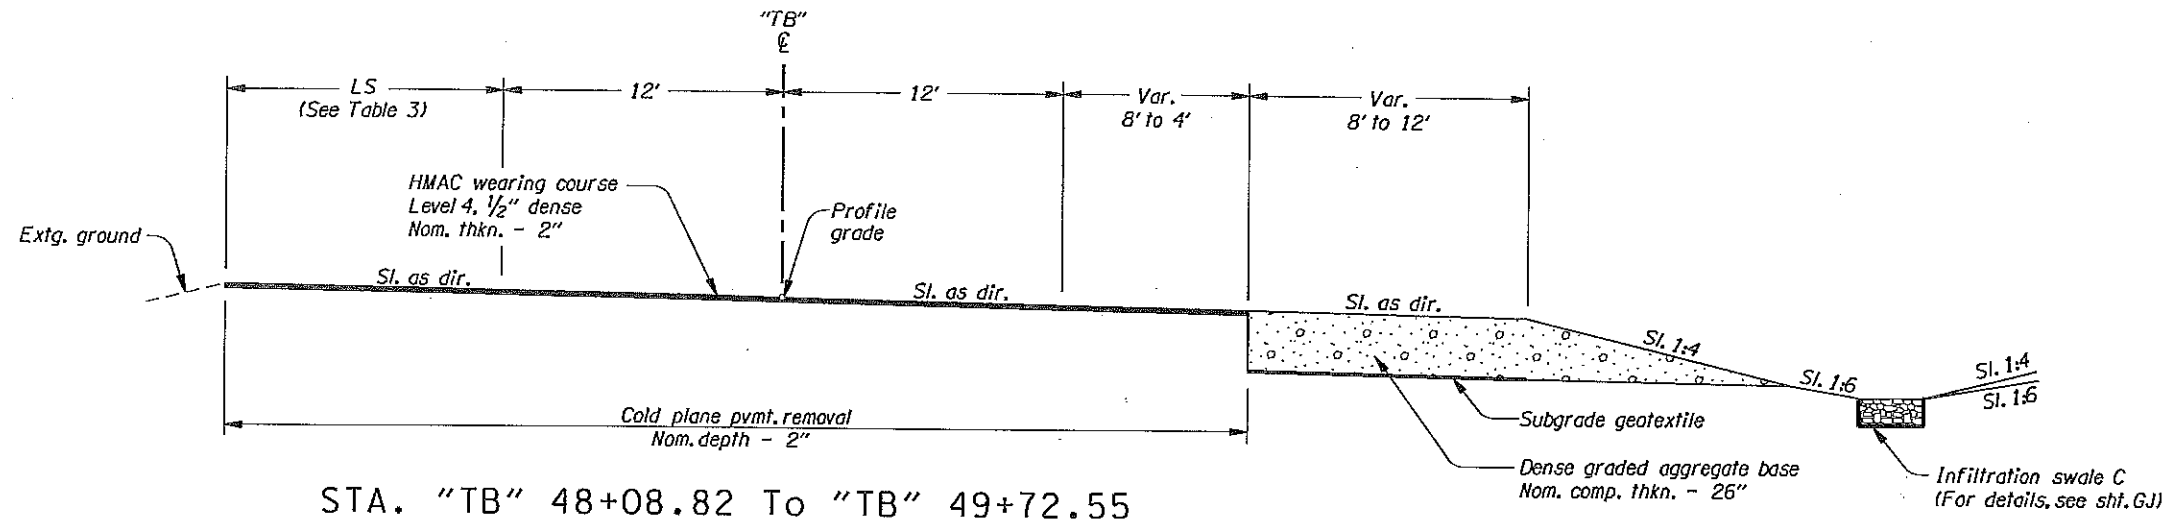


**TABLE 3**

STA. To	STA.	LS (Ft.)
48+08.82	49+24.00	6
49+24.00	50+60.37	6 to 18
50+60.37	51+85.81	18 to 8
51+85.81	52+83.14	29 to 20

**TABLE 4**

STA. To	STA.	SCR (Ft.)
49+72.55	50+28.83	12
50+28.83	52+08.16	6
52+08.16	52+83.14	0

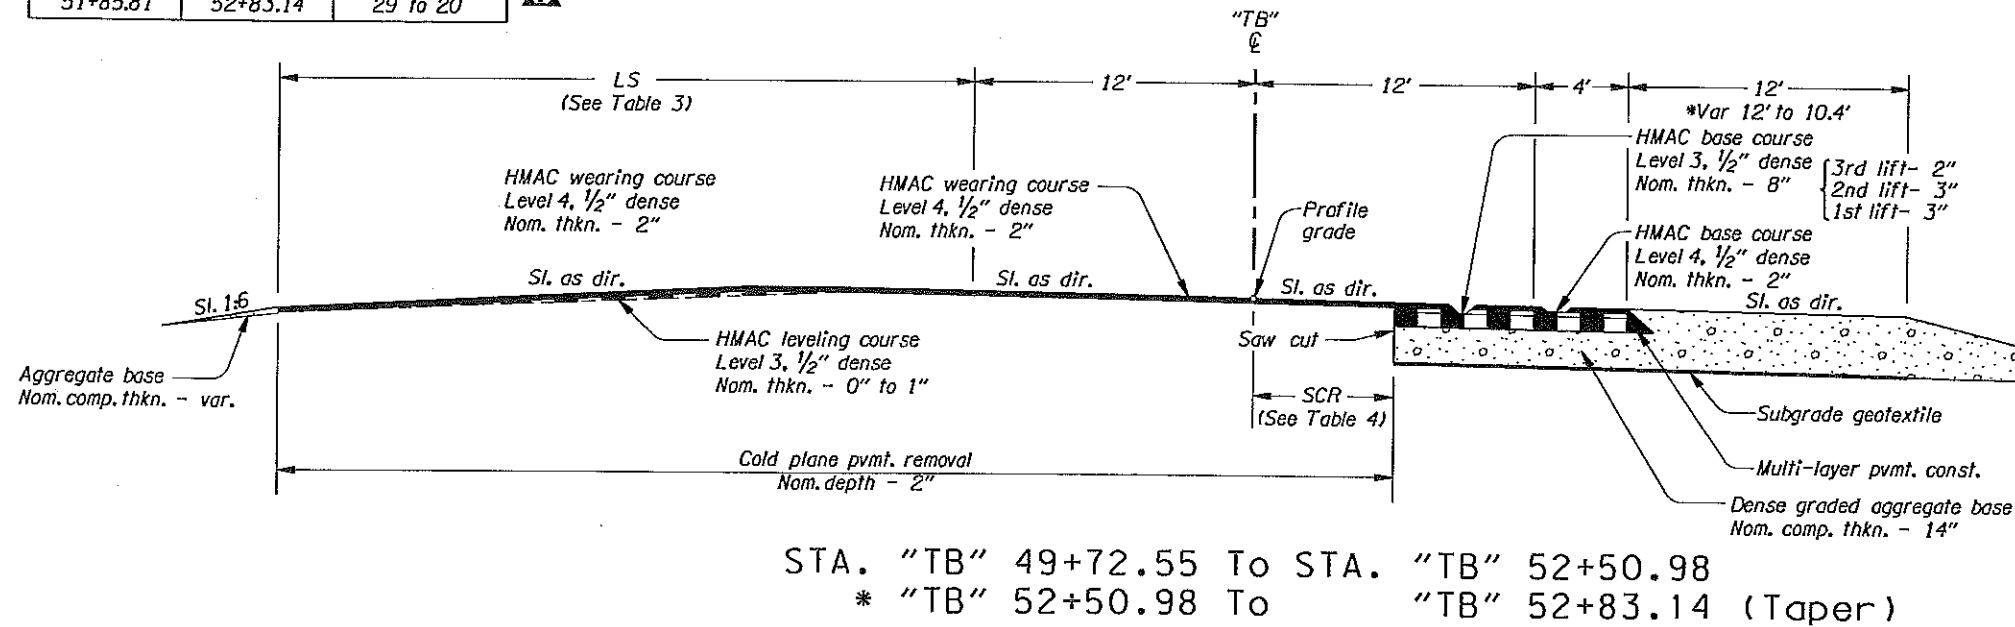

As Built saw cut was 1.5 ft from the original right edge of pavement

- NOTE:**
1. Side-slopes are shown as vert. to horiz.
  2. For standard superelevation, see drg. no. RD140.
  3. For slope rounding, see drg. no. RD150.

**"AS CONSTRUCTED"**

*Mark Barr*  
Date 4-26-12 Project Mngr

No.	DATE	REVISIONS	BY
1	05-16-11	Limits of paving mod.	L.A.K

REGISTERED PROFESSIONAL ENGINEER  
14468

JULY 26, 1989  
LAWRENCE A. KRETTLER

EXPIRATION DATE: 6-30-2011

**OREGON DEPARTMENT OF TRANSPORTATION**


REGION 1 - ROADWAY ENGINEERING SECTION

I-84 AT 257TH AVE (TROUTDALE INTERCHANGE) SEC.  
COLUMBIA RIVER HIGHWAY  
MULTNOMAH COUNTY

Design Team Leader - Lawrence Krettlar  
Designed By - Marco Singer & Dave Haase  
Drafted By - Carolyn Allen


**TYPICAL SECTIONS**

SHEET NO. 2A-6

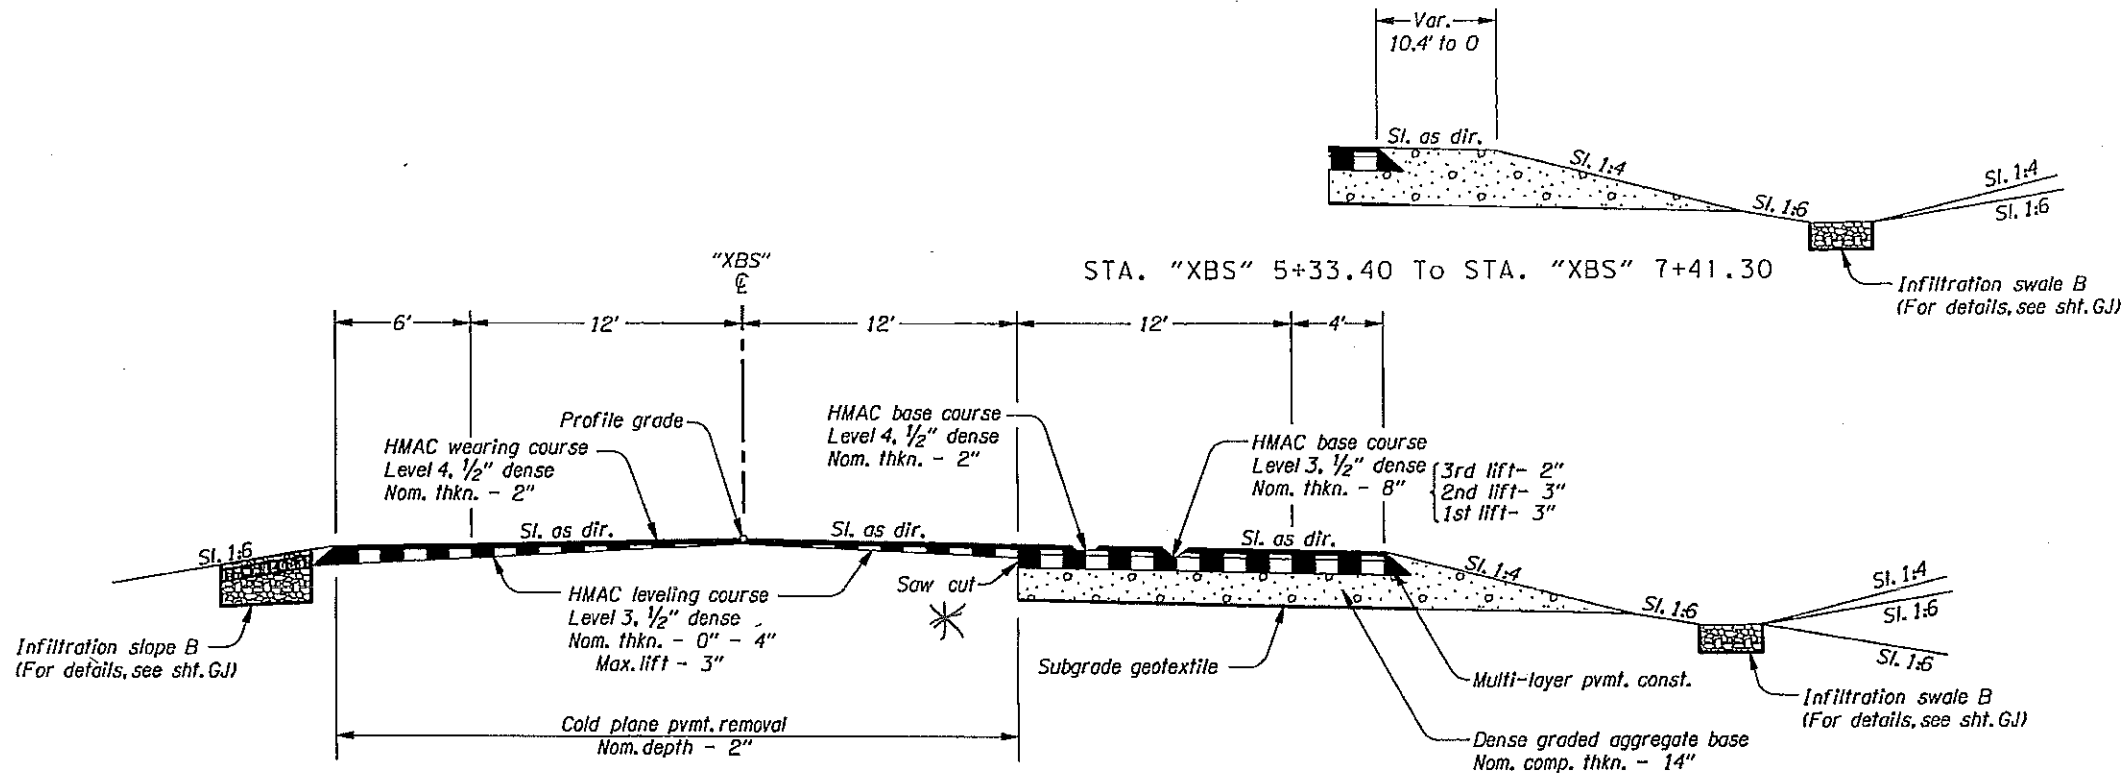

\* As-Built saw cut was 1.5 ft. from the original right edge of pavement.


STA. "XBS" 5+33.45 To STA. "XBS" 19+35.00  
 "XBS" 20+40.00 To "XBS" 23+52.50

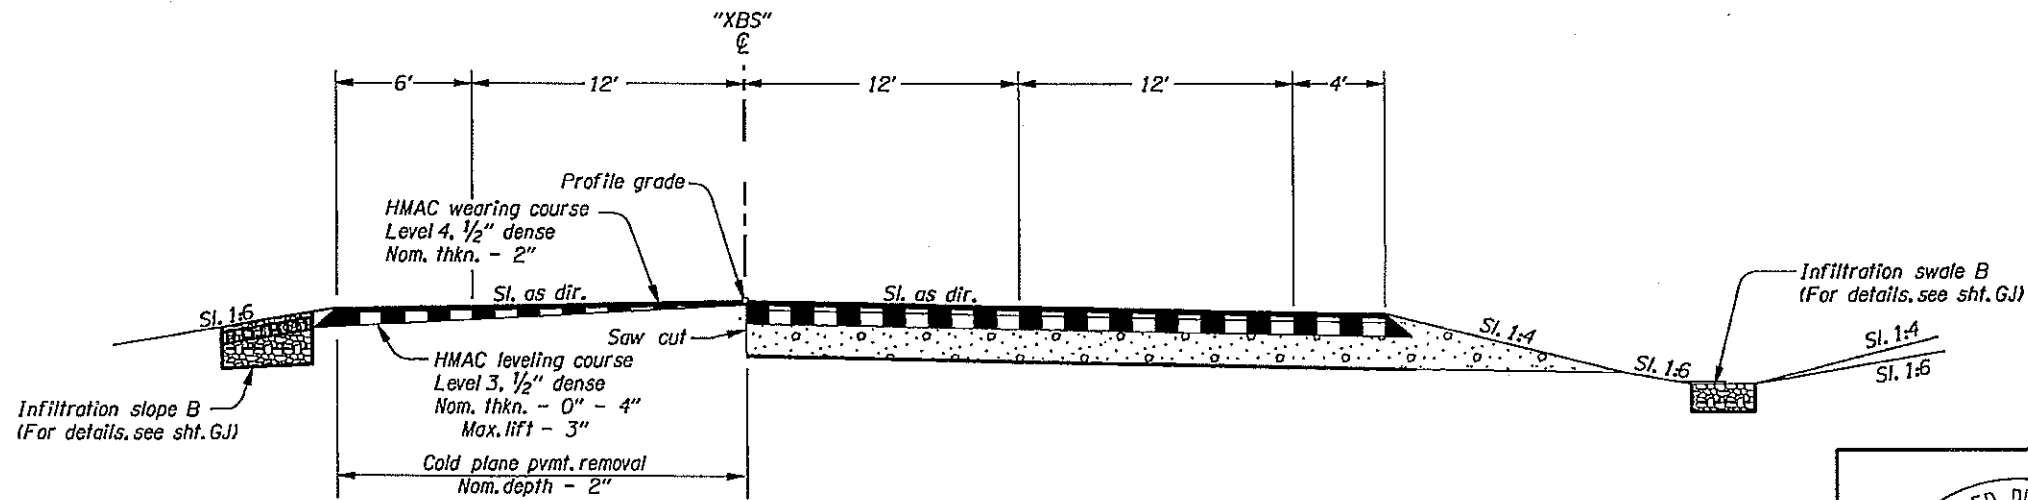

STA. "XBS" 19+35.00 To STA. "XBS" 20+40.00  
 (For surfacing details not shown, see section above)


- NOTE:  
 1. Side-slopes are shown as vert. to horiz.  
 2. For standard superelevation, see drg. no. RD140.  
 3. For slope rounding, see drg. no. RD150.

"AS CONSTRUCTED"  
 [Signature]  
 Date 4-26-12 Project Mngr

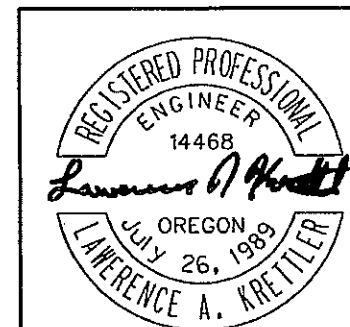


EXPIRATION DATE: 6-30-2011

<b>OREGON DEPARTMENT OF TRANSPORTATION</b>	
REGION 1 - ROADWAY ENGINEERING SECTION	
I-84 AT 257TH AVE (TROUTDALE INTERCHANGE) SEC. COLUMBIA RIVER HIGHWAY MULTNOMAH COUNTY	
Design Team Leader - Lawrence Kretzler Designed By - Marco Singer & Dave Hoase Drafted By - Carolyn Allen	
<b>TYPICAL SECTIONS</b>	SHEET NO. <b>2A-7</b>

- ① See sht. 3A, note 4
- ② Sta. "EB"468+43 to Sta. "EB"470+69, Rt. Const. guardrail - 175' (Type 2A) Const. anchor (Type 1 modified) Inst. end piece (Type B) Const. guardrail terminal non-flared - 50' Test level 3 W=1, E=2'
- ③ Const. P.C. conc. sidewalk (See drg. no. RD720)
- ④ Const. sidewalk ramp (For details, see sht. 2B)
- ⑤ Remove extg. curb & sidewalk Const. parallel sidewalk ramp (See drg. no. RD755)
- ⑥ Const. standard curb (See drg. no. RD700) 
- ⑦ Const. curb end (See drg. no. RD700)

**"AS CONSTRUCTED"**

*Mark Ben*  
Date 4-26-12 Project Mngr

 OREGON DEPARTMENT OF TRANSPORTATION

REGION 1 - ROADWAY ENGINEERING SECTION

**I-84 AT 257TH AVE (TROUTDALE INTERCHANGE) SEC.**  
COLUMBIA RIVER HIGHWAY  
MULTNOMAH COUNTY

Design Team Leader - Lawrence Krettl  
Designed By - Marco Singer & Dave Haase  
Drafted By - Carolyn Allen

**GENERAL CONSTRUCTION**


SHEET NO. **4A**

REGISTERED PROFESSIONAL ENGINEER  
14468

JULY 26, 1989  
LAWRENCE A. KRETTLER

EXPIRATION DATE: 6-30-2011


No.	DATE	REVISIONS	BY
①	06-09-11	Standard Curb per Sht 2B note 7	E.F.
②	06-09-11	Added Const. Curb End	E.F.

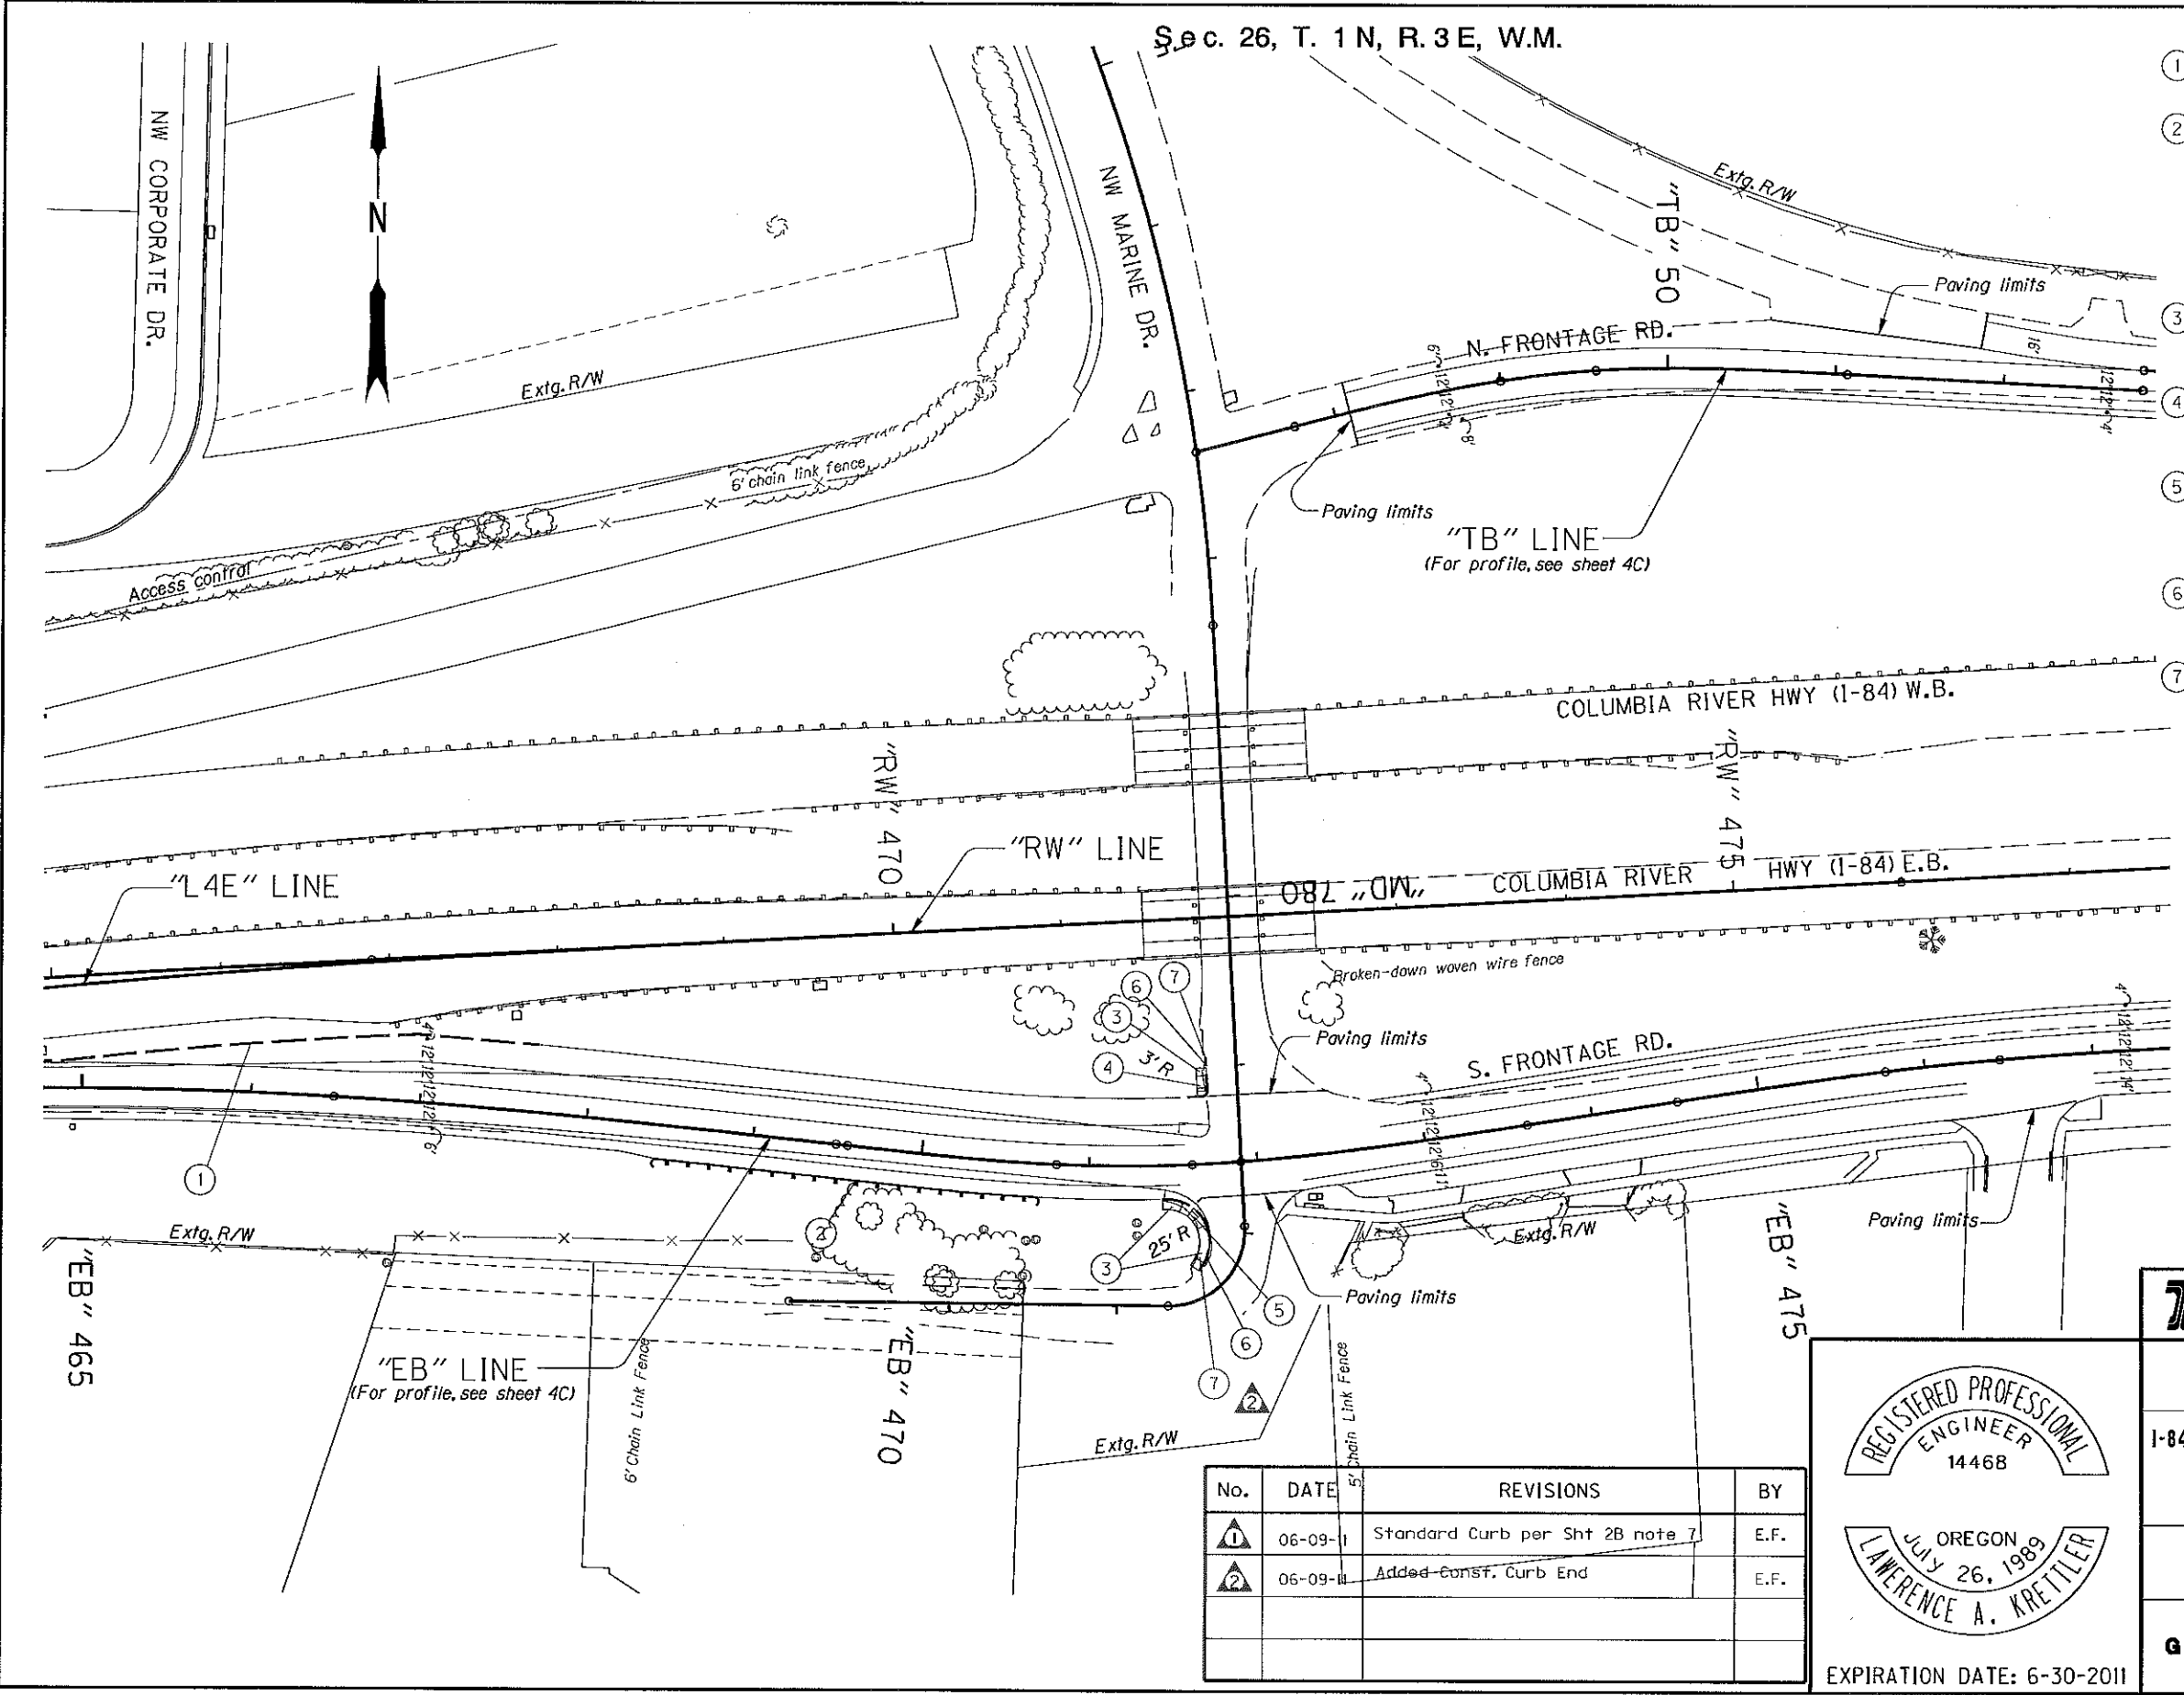

Sec. 26, T. 1 N, R. 3 E, W.M.

**"AS CONSTRUCTED"**

*Wanda Nason*  
Date 4-26-12 Project Mng'r

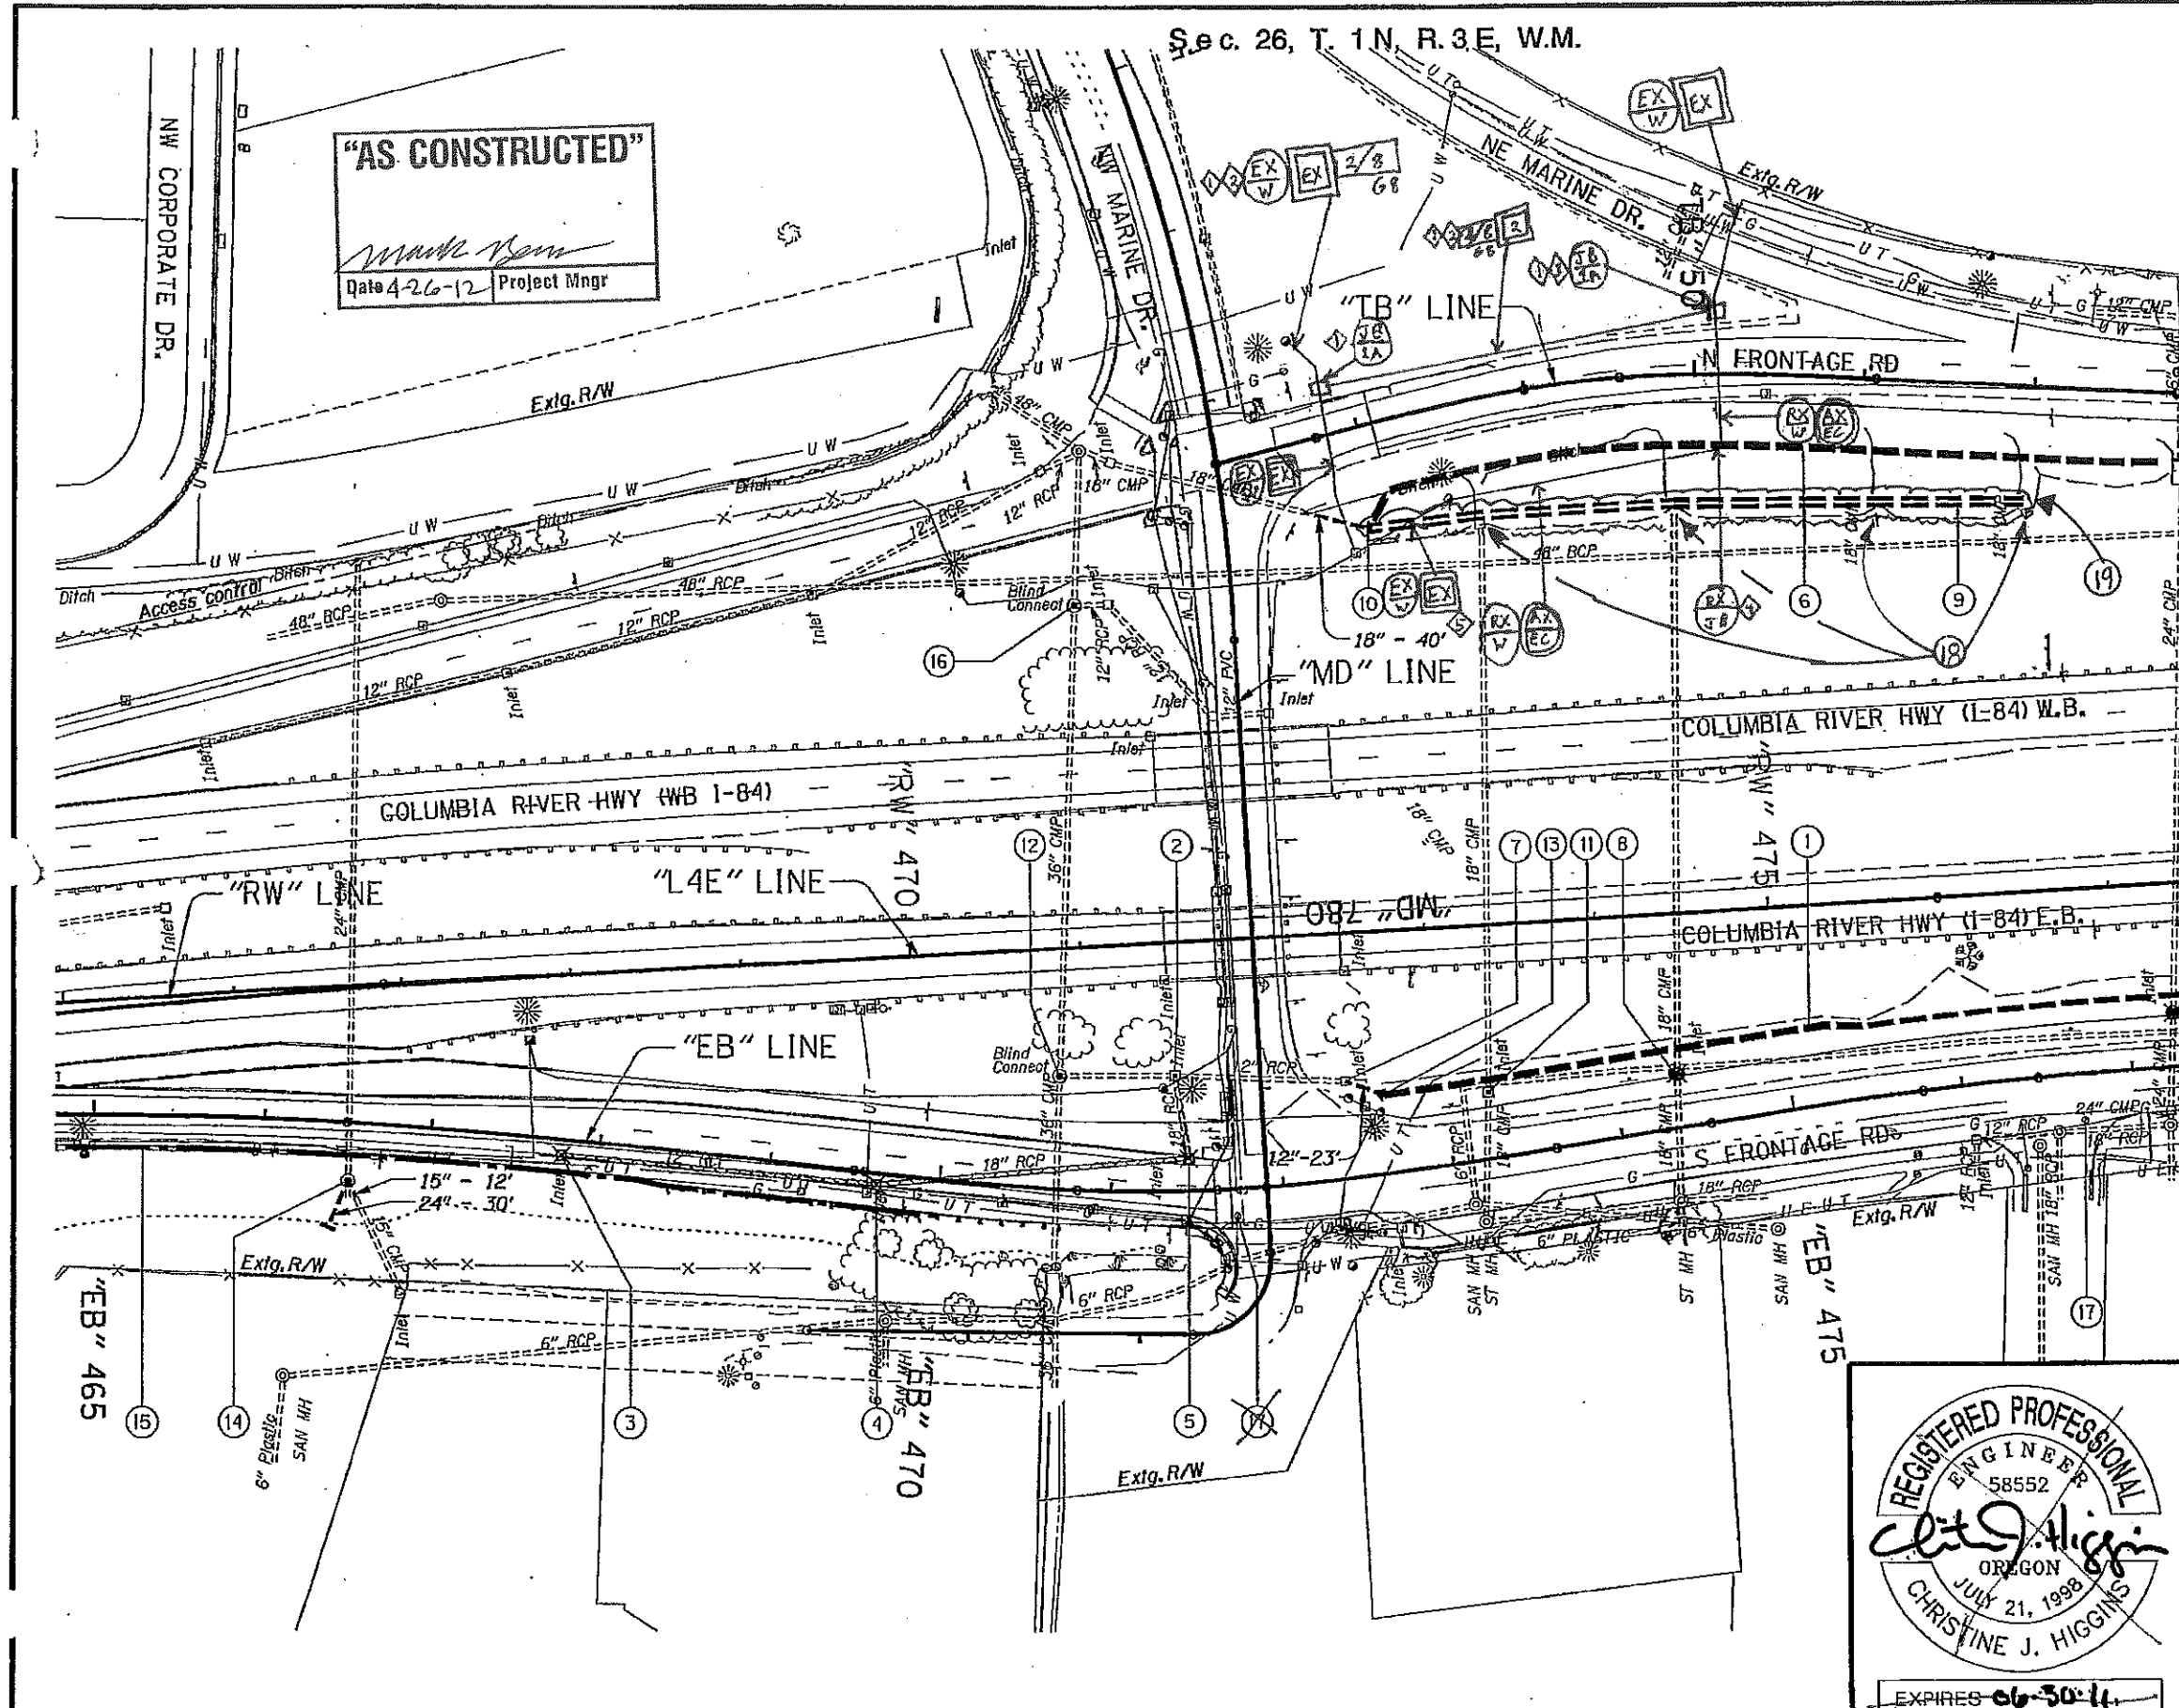

**EX**  
**W** Retain and protect existing wiring

1 Field locate to avoid conflicts with existing utilities

2 Verify new wiring is sufficient for existing lighting circuit.


3 Splice new wire to existing wire.

4 Remove & dispose of existing light pole base according to section 00310

5 Conduit previously rerouted beneath drainage ditch  
See R. T.  
8/19/11

18 & 19 For added detail see GJ-4 Eric Fosgard

- Ditch shown thus:
- Infiltration swale shown thus:
- Infiltration slope shown thus:
- Cut line shown thus:
- Fill line shown thus:
- Adjust inlet shown thus:
- Remove extg. inlet shown thus:
- Plug and abandon pipe shown thus:

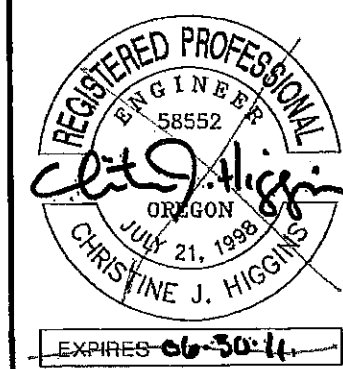

**OREGON DEPARTMENT OF TRANSPORTATION**

**DAVID EVANS AND ASSOCIATES INC.**  
2100 Southwest River Parkway  
Portland Oregon 97201 Ph: 503.223.6663

**I-84 AT 257TH AVE (TROUTDALE INTERCHANGE) SEC.**  
COLUMBIA RIVER HIGHWAY  
MULTNOMAH COUNTY

Reviewed By - Craig Sheahan  
Designed By - Karina Nordahl  
Drafted By - Edita Bagustawski

**DRAINAGE & UTILITIES**

SHEET NO.  
**4B**

1 Sta. "EB" 472+65.42, 46.05' Lt. to Sta. "EB" 475+50.00, 41.93' Lt.  
Const. infiltration swale type A - 38.9 cu.yd.  
Inst. delineators, type S1  
Inst. delineators, type S2  
(For details, see shfs. GJ & GJ-2)

2 Sta. "EB" 471+38.77, 67.53' Lt.  
Adjust inlet  
Rim 33.50  
(See drg. no. RD376)

3 Remove extg. inlet  
Plug and abandon extg. 12" storm sew. pipe - 185'

4 Remove extg. inlet  
Plug and abandon extg. 18" storm sew. pipe - 182'

5 Remove extg. inlet  
Plug and abandon extg. 18" storm sew. pipe - 49'

6 Sta. "TB" ~~48+42.47, 59.00'~~ Rt. to Sta. "TB" ~~53+25.05, 40.29'~~ Rt. **47+91.2, 59.0'**  
Const. infiltration swale type C - 34.5 cu.yd.  
Inst. delineators, type S1  
(For details, see shfs. GJ & GJ-2)

7 Sta. "EB" 472+43.38, 57.00' Lt.  
Connect 12" storm sew. pipe to extg. inlet

8 Sta. "EB" 474+36.61, 31.60' Lt.  
Remove extg. inlet  
Const. manhole  
Rim 35.43  
F.L. 30.30 (Extg. 18" S)  
F.L. 30.80 (Extg. 18" N)  
(See drg. no. RD336)

9 Sta. "TB" ~~48+42.47, 59.00'~~ Rt. to Sta. "TB" ~~52+47.00, 67.00'~~ Rt. **47+91.18, 59.02'**  
Const. ditch - 555 cu.yd.  
(For details, see shf. GJ) **51+95.71, 67.00'**

10 Sta. "TB" ~~48+42.47, 59.00'~~ Rt. **47+91.18, 59'** Rt.  
Const. paved end slope - 44 sq.ft.  
Extend 18" culvert pipe - 40'  
5' depth  
(See drg. nos. RD316, RD320 & RD326)

11 Sta. "EB" 473+26.58, 38.83' Lt.  
Adjust inlet  
Rim 33.67

12 Sta. "EB" 470+66.76, 66.29' Lt.  
Const. large precast manhole (60" dia.)  
over extg. 36" storm sew. pipe  
Connect extg. 12" storm sew. pipe  
Field locate  
(See drg. no. RD346)

13 Sta. "EB" 472+65.42, 46.05' Lt.  
Const. paved end slope - 32 sq.ft.  
Inst. 12" storm sew. pipe - 23'  
5' depth  
(See drg. nos. RD318 & RD386)

14 Sta. "EB" 466+51.51, 34.06' Rt.  
Const. manhole  
Connect extg. 24" storm sew. pipe  
Inst. 24" storm sew. pipe - 30'  
10' depth  
Extend 15" storm sew. pipe - 12'  
10' depth  
Inst. manhole slope protector  
(See drg. no. RD358)

15 See note 6, shf. 3B

16 Sta. "EB" 470+58.65, 339.25' Lt.  
Const. large precast manhole (60" dia.)  
over extg. 36" storm sewer pipe  
Connect extg. 12" storm sew. pipe  
Rim 32.33  
F.L. 27.19± (Extg. 12" E)  
F.L. 27.19± (Extg. 36" S)  
F.L. 27.19± (Extg. 36" N)  
Field locate

17 Adjust water valve -  1

18 Install Class 50 RIPRAP BASIN (6'x15'x1') - 4 (For Details, SEE SHF. GJ-4)

19 Install TYPE F MATTING - 870 S.Y. (See DRG. No. RD 1055)

NOTE: TB Alignment Stationing changed. New stationing shown.


"AS CONSTRUCTED"  
*Mark Bean*  
Date 4-26-12 Project Mngr

REGISTERED PROFESSIONAL ENGINEER  
58552  
*Christine J. Higgins*  
OREGON  
JULY 21, 1998  
CHRISTINE J. HIGGINS  
EXPIRES 06-30-11

OREGON DEPARTMENT OF TRANSPORTATION	
DAVID EVANS AND ASSOCIATES INC. 2100 Southwest River Parkway Portland Oregon 97201 Ph: 503.223.6663	
I-84 AT 257TH AVE (TROUTDALE INTERCHANGE) SEC. COLUMBIA RIVER HIGHWAY MULTNOMAH COUNTY.	
Reviewed By - Craig Sheahan <i>CSH</i> Designed By - Karina Nordahl Drafted By - Edita Boguslawski	
DRAINAGE & UTILITIES	SHEET NO. 4B-2


"TB" LINE

"EB" LINE

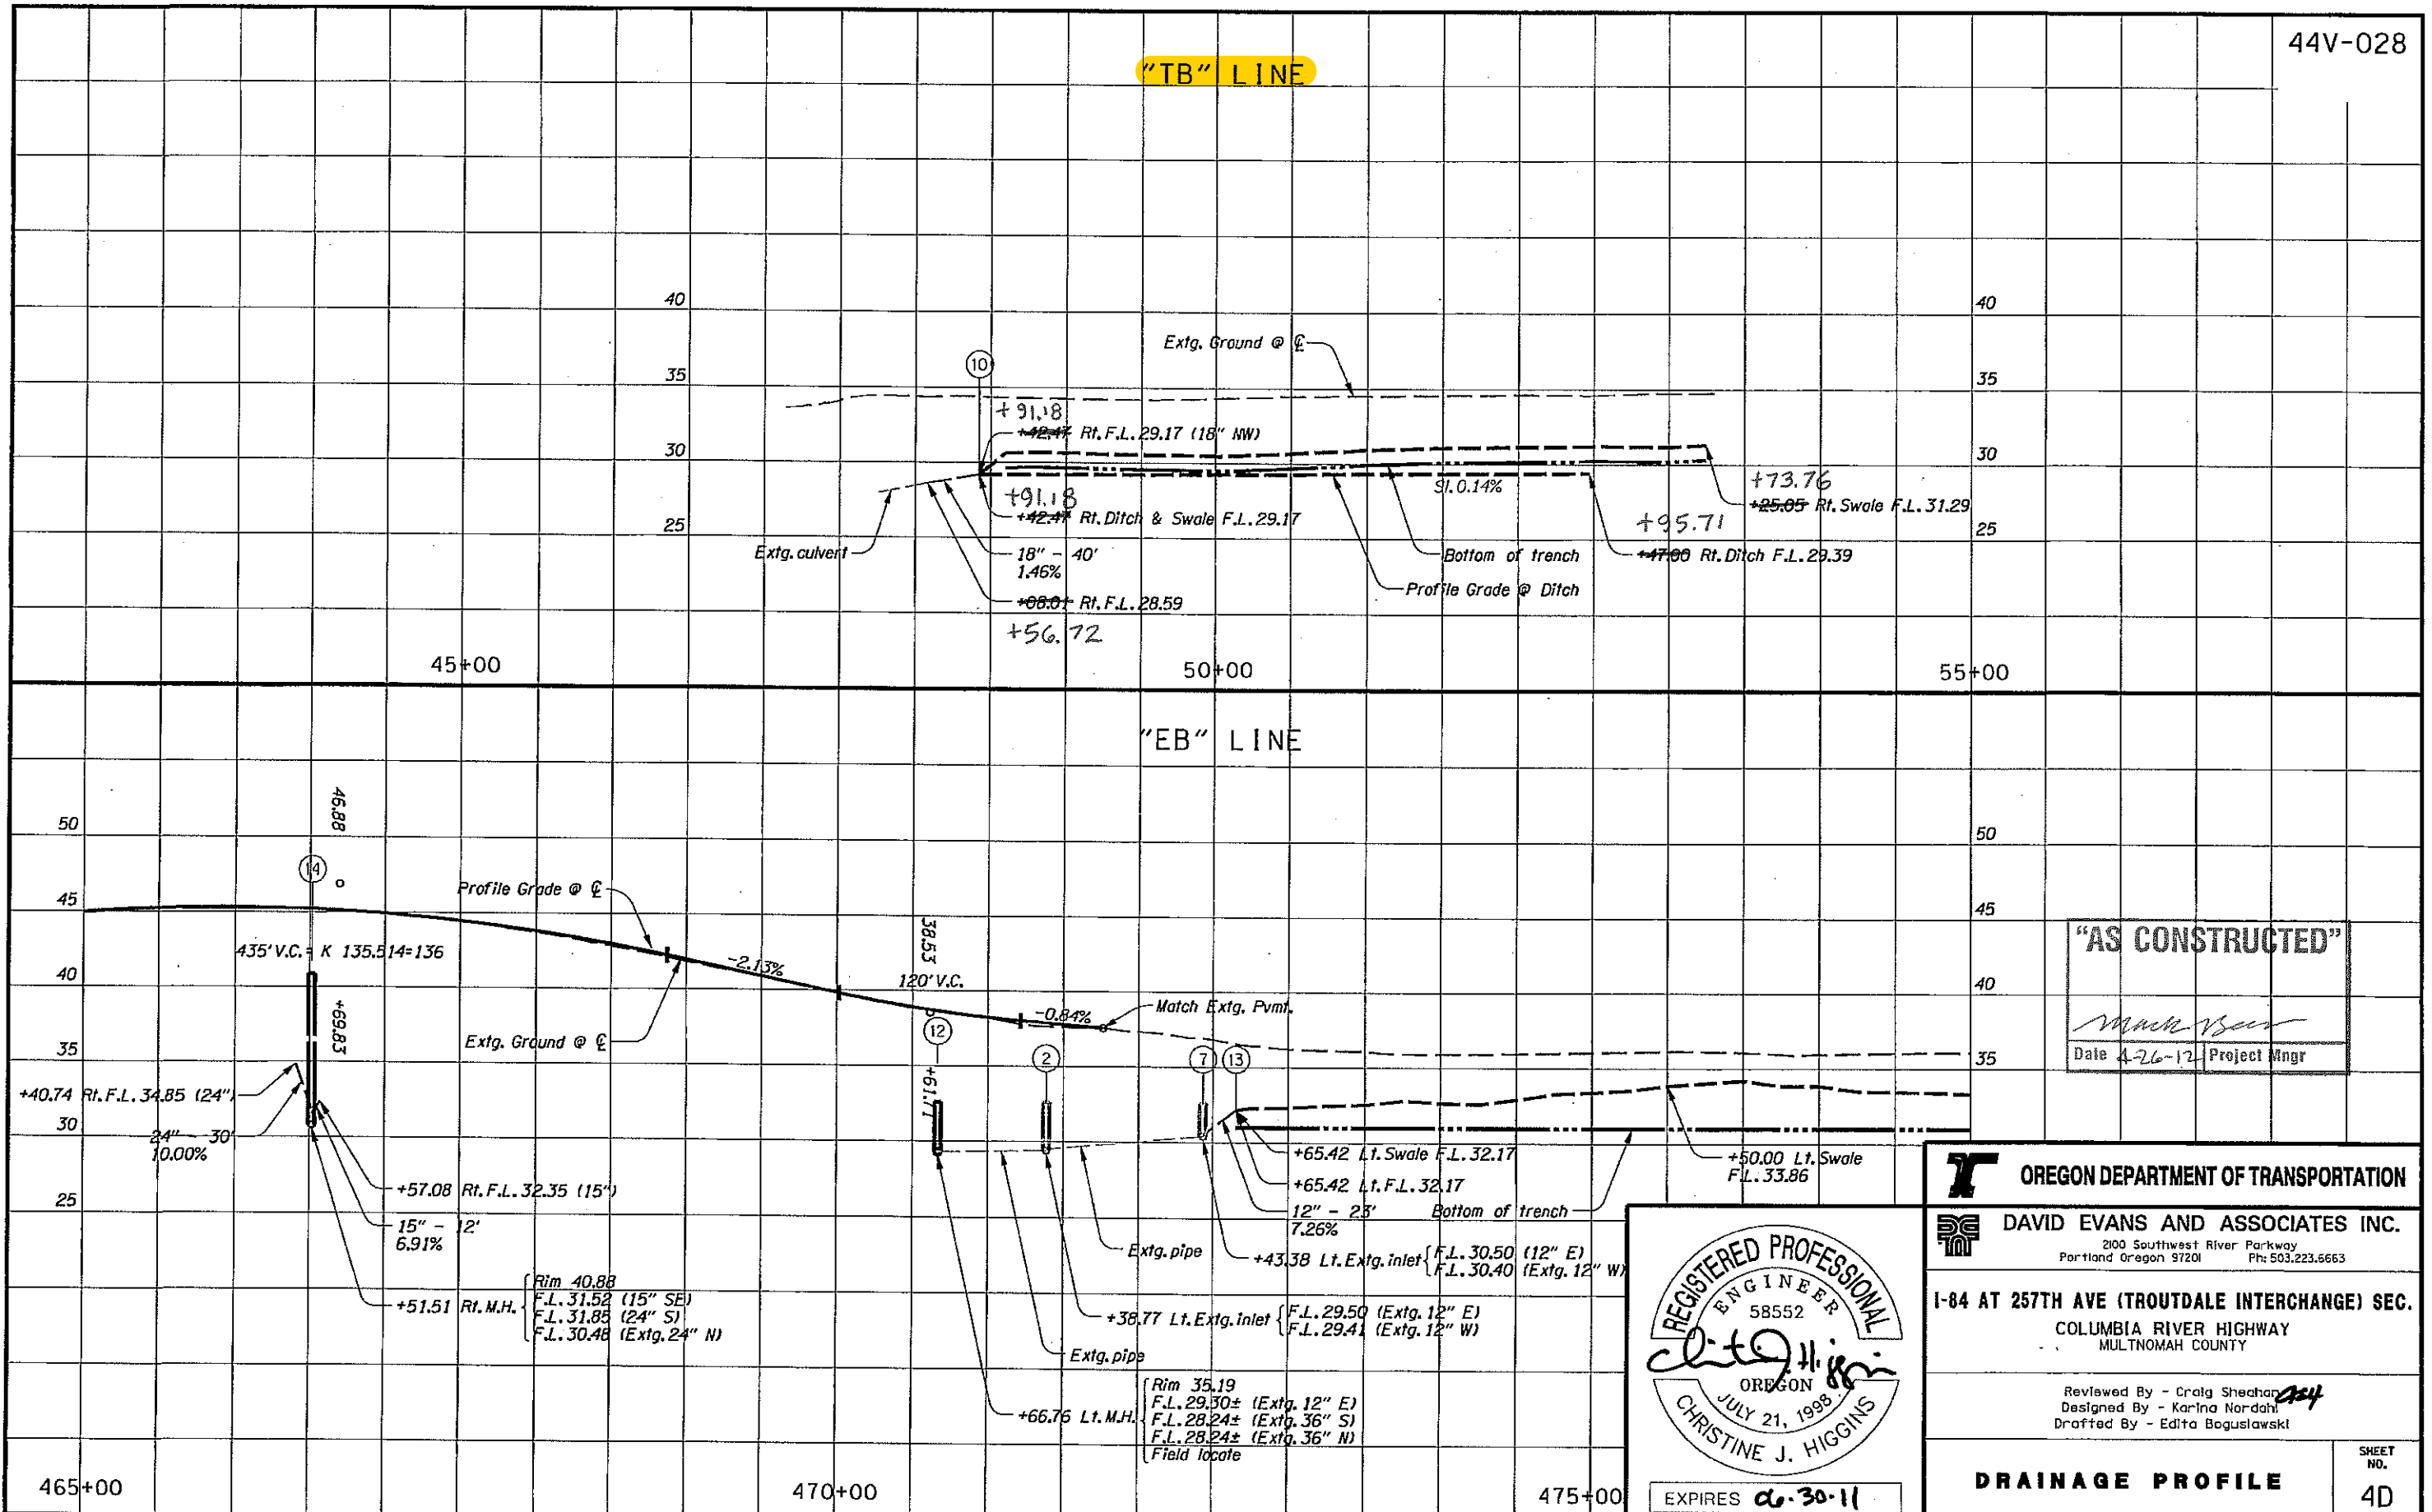

**"AS CONSTRUCTED"**

*Mark Beer*  
 Date 4-26-12 Project Mngr

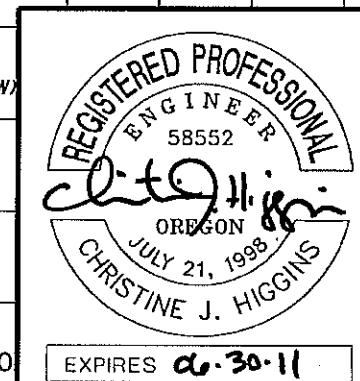

**OREGON DEPARTMENT OF TRANSPORTATION**

**DAVID EVANS AND ASSOCIATES INC.**  
 200 Southwest River Parkway  
 Portland Oregon 97201 Ph: 503.223.6663

**I-84 AT 257TH AVE (TROUTDALE INTERCHANGE) SEC.**  
 COLUMBIA RIVER HIGHWAY  
 MULTNOMAH COUNTY


Reviewed By - Craig Sheehan  
 Designed By - Karina Nordahl  
 Drafted By - Edita Boguslawski

**DRAINAGE PROFILE**

SHEET NO. **4D**

Sec. 26, T. 1 N, R. 3 E, W.M.


① Const. appr. - 2  
(See drg. no. RD715)

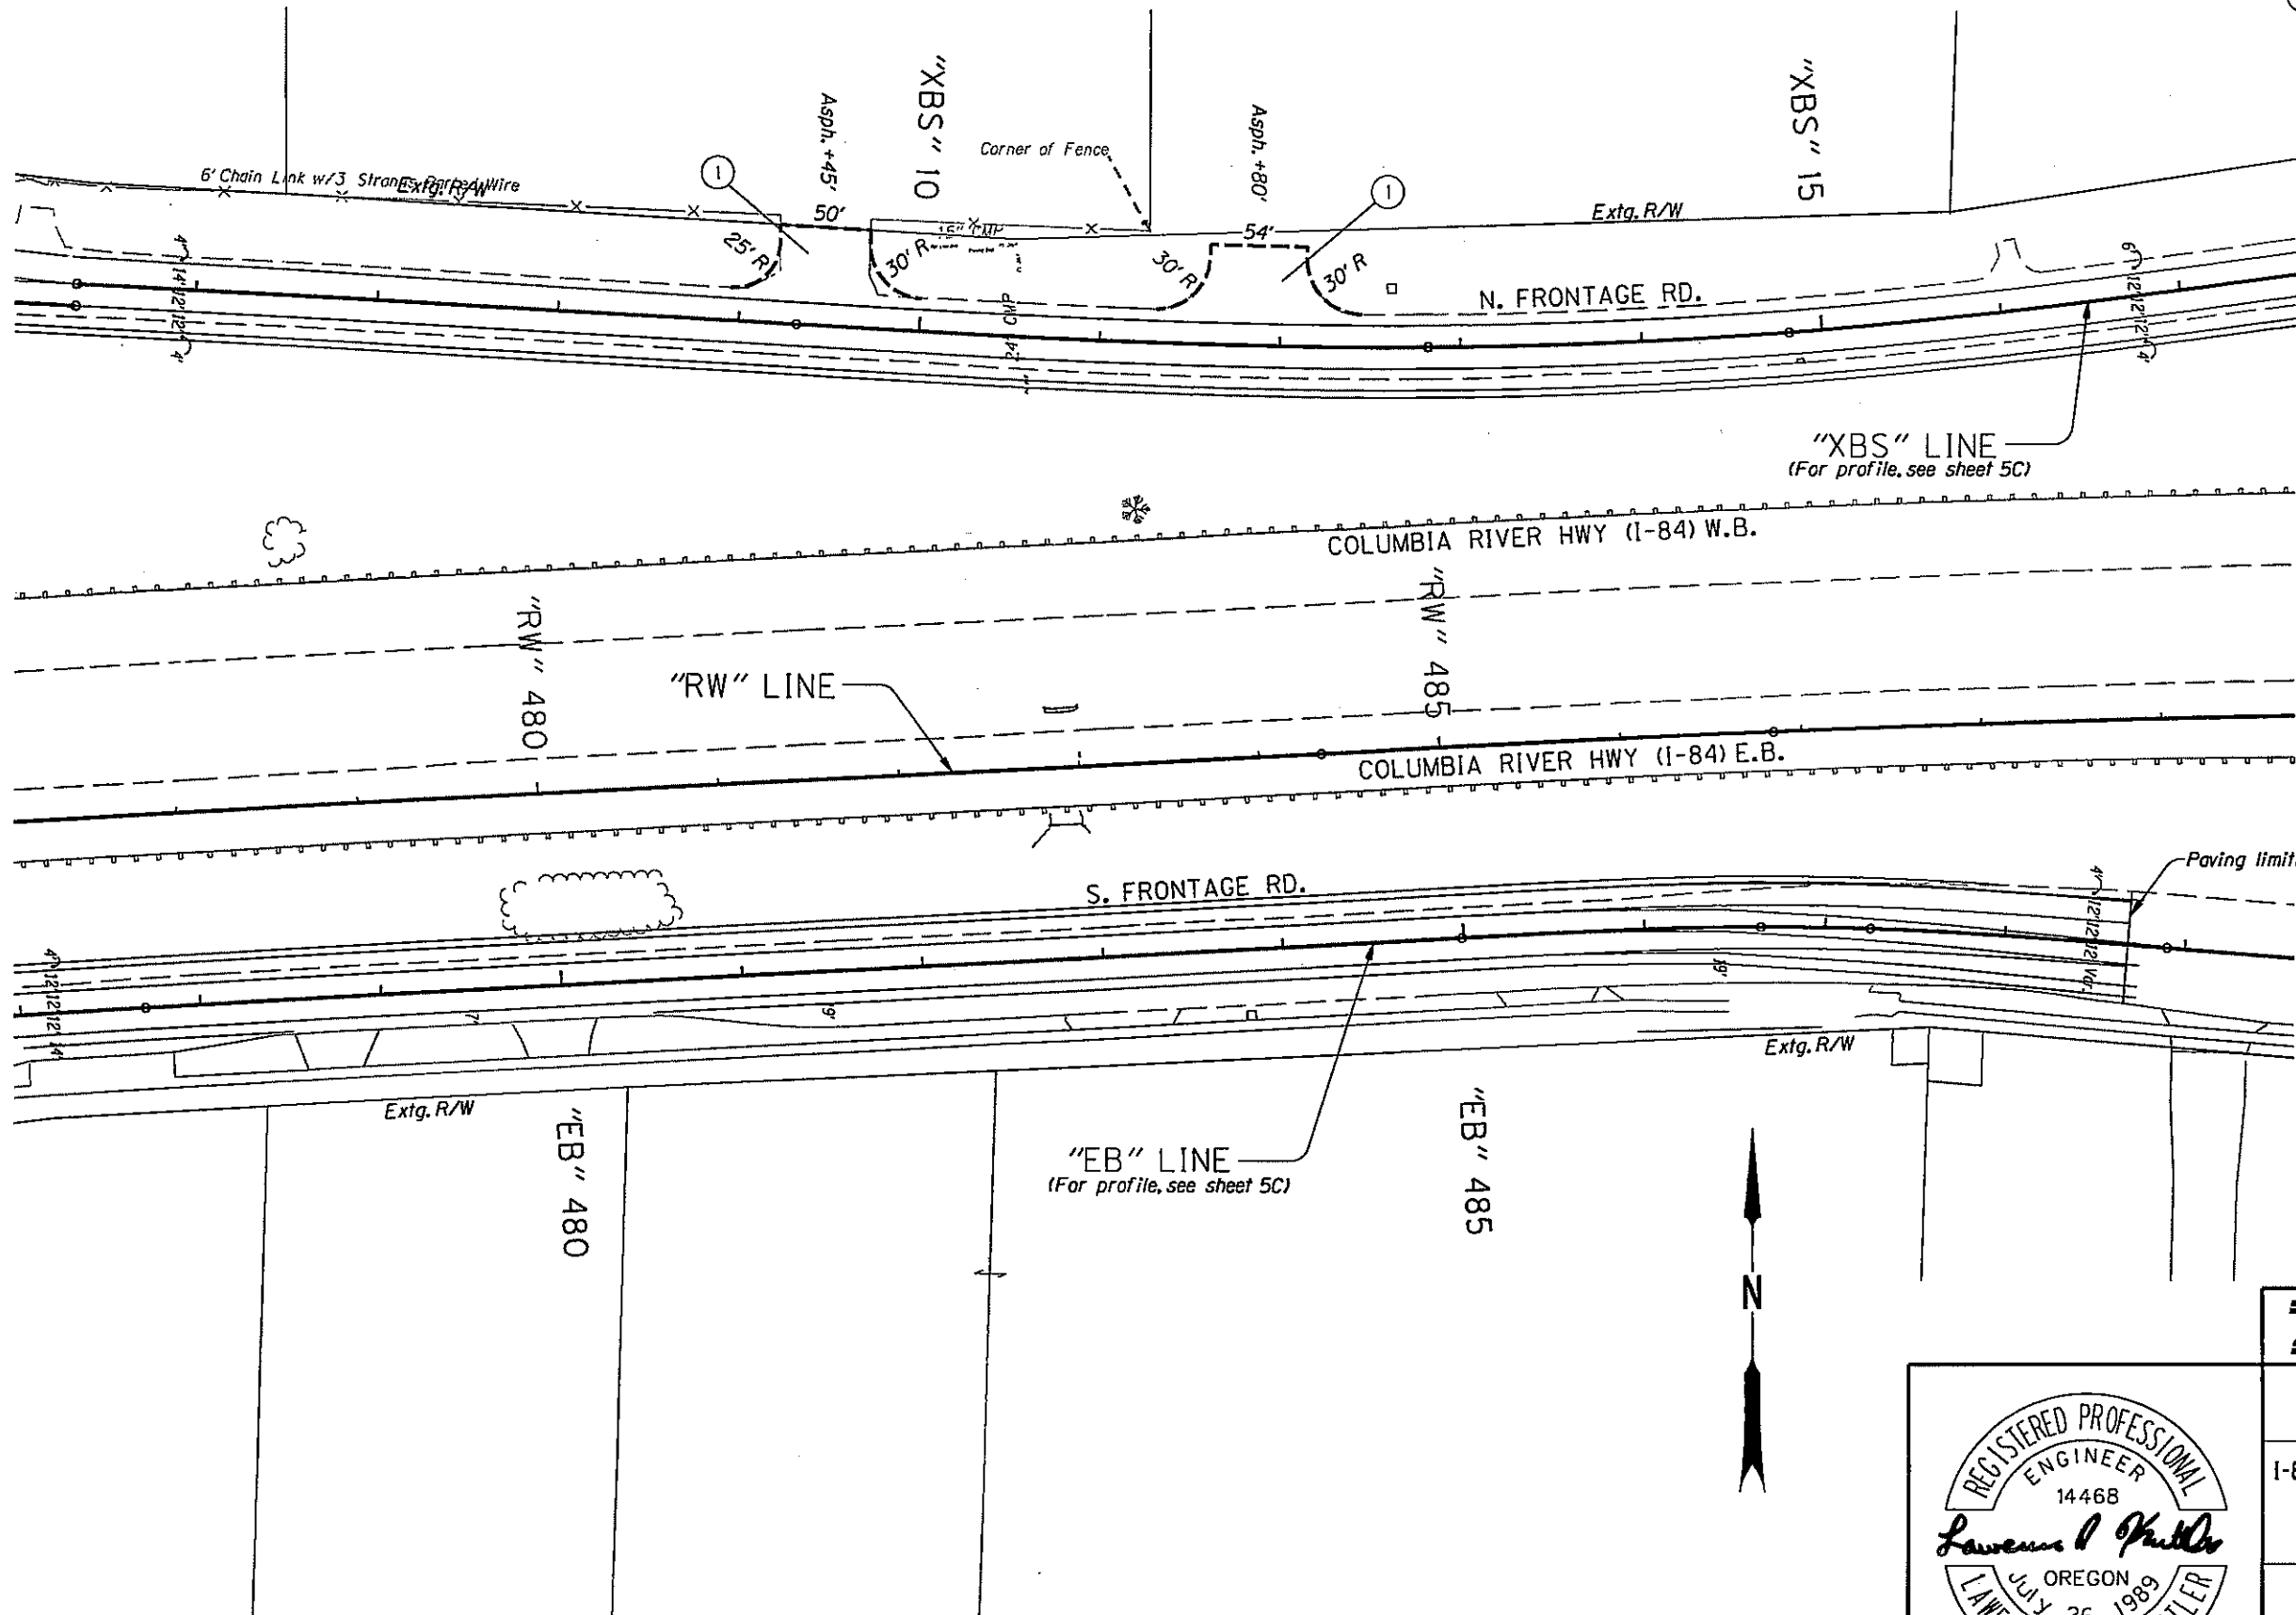

**"AS CONSTRUCTED"**

*Mark Bevan*

Date 4-26-12 | Project Mngr

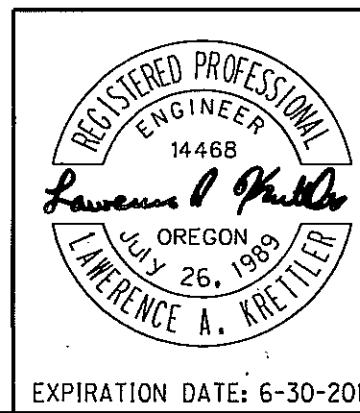

<b>OREGON DEPARTMENT OF TRANSPORTATION</b>	
REGION 1 - ROADWAY ENGINEERING SECTION	
I-84 AT 257TH AVE (TROUTDALE INTERCHANGE) SEC. COLUMBIA RIVER HIGHWAY MULTNOMAH COUNTY	
Design Team Leader - Lawrence Krettlar Designed By - Marco Singer & Dave Hoase Drafted By - Carolyn Allen	
<b>GENERAL CONSTRUCTION</b>	SHEET NO. <b>5A</b>



20 As per cco #15

EXISTING PIPE & Type D Inlet (ADDED)

Out of paving limits

- Infiltration swale shown thus:
- Infiltration slope shown thus:
- Cut line shown thus:
- Adjust manhole shown thus:
- Adjust inlet shown thus:

**OREGON DEPARTMENT OF TRANSPORTATION**

**DAVID EVANS AND ASSOCIATES INC.**  
 2100 Southwest River Parkway  
 Portland Oregon 97201 Ph: 503.223.6663

**I-84 AT 257TH AVE (TROUTDALE INTERCHANGE) SEC.**  
 COLUMBIA RIVER HIGHWAY  
 MULTNOMAH COUNTY

Reviewed By - Craig Sheahan  
 Designed By - Karina Nordahl  
 Drafted By - Edita Bogustawski

**DRAINAGE & UTILITIES**

SHEET NO. **5B**


**REGISTERED PROFESSIONAL ENGINEER**  
 58552

OREGON  
 JULY 21, 1998  
**CHRISTINE J. HIGGINS**

EXPIRES

**"AS CONSTRUCTED"**


*Mark Beer*  
 Date 4-26-12 Project Mgr

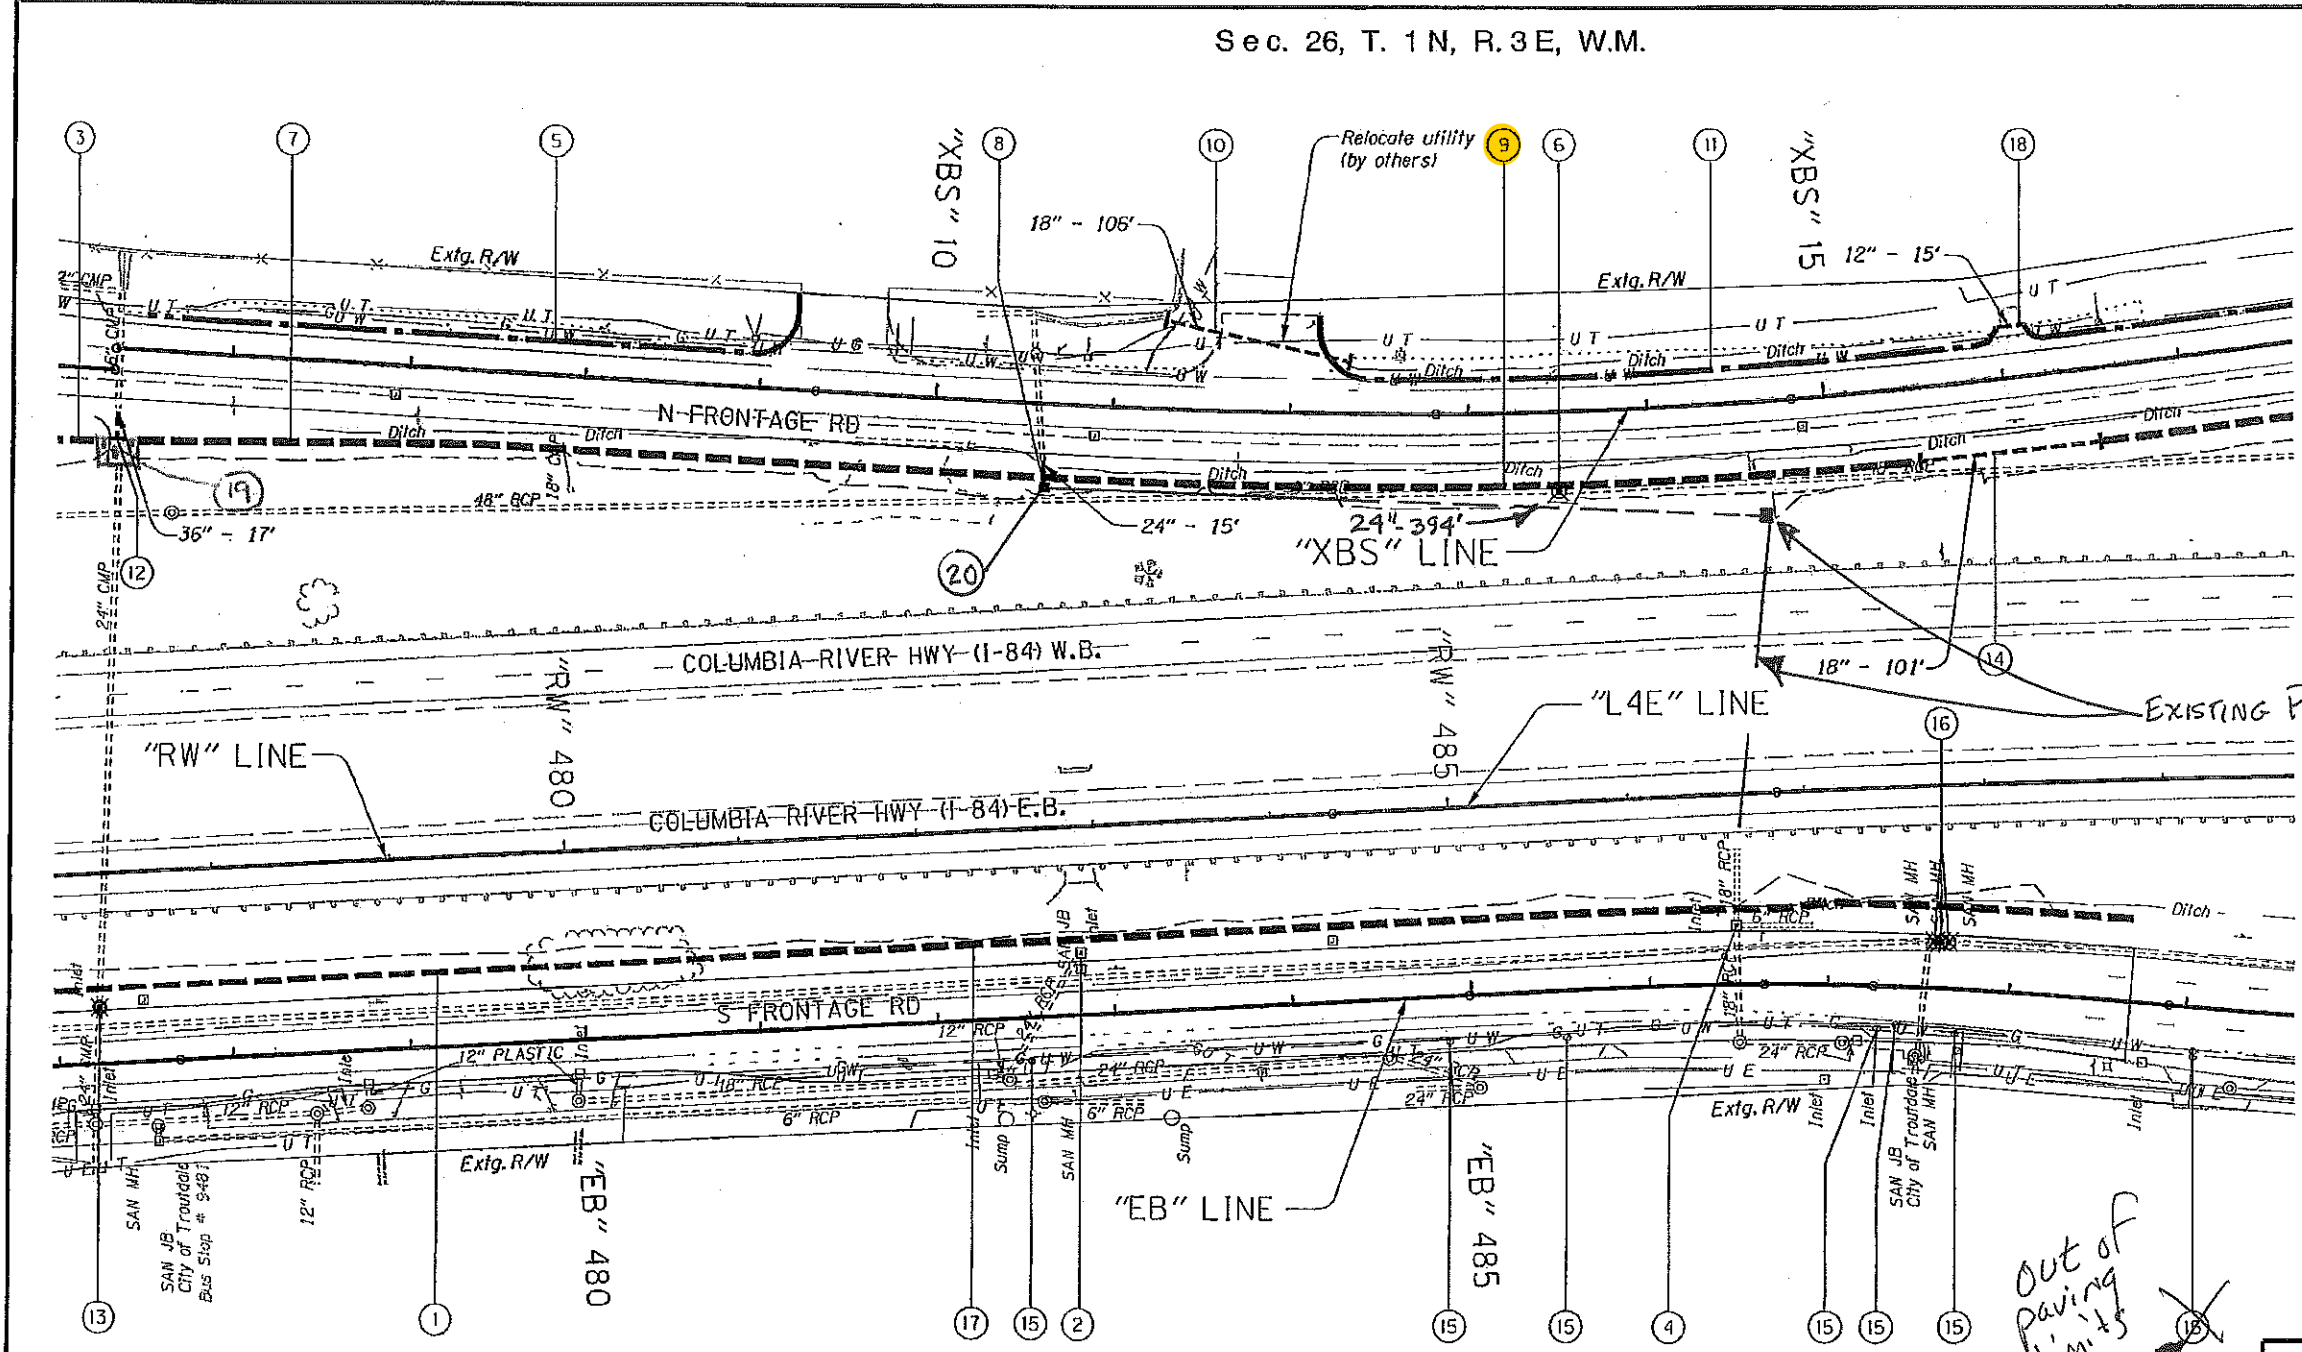

\* CHANGE ORDER FOR NOTES ② & ④

- ① Sta. "EB" 475+50.00, 41.93' Lt. to Sta. "EB" 480+75.00, 41.93' Lt. Const. infiltration swale type D - 49.3 cu. yd. (For detail, see sht. GJ)
- ② Sta. "EB" 482+82.16, 34.62' Lt. ~~Adjust inlet~~ Rim 36.34
- ③ See note 6, sht. 4B-2
- ④ Sta. "EB" 486+49.32, 32.97' Lt. ~~Adjust inlet~~ Rim 38.36
- ⑤ Sta. "XBS" 5+50.09, Lt. to Sta. "XBS" 9+19.31, Lt. Const. infiltration slope type B - 88.2 cu. yd. Inst. delineators, type S1 (For details, see shts. GJ & GJ-2)
- ⑥ Sta. "XBS" 13+49.46, 44.75' Rt. Const. granular drain backfill diversion Major adjust manhole (For details, see sht. GJ-3)
- ⑦ Sta. "XBS" 5+48.50, 51.06' Rt. to Sta. "XBS" 10+60.00, 41.42' Rt. Const. infiltration swale type B - 75.9 cu. yd. (For details, see sht. GJ)
- ⑧ Sta. "XBS" 10+63.01, 46.91' Rt. Const. ditch inlet type "D" Extend 24" culvert pipe - 15' 5' depth (See drg. no. RD370)
- ⑨ Sta. "XBS" 10+62.13, 41.42' Rt. to Sta. "XBS" 15+50.03, 41.42' Rt. Const. infiltration swale type B - 72.7 cu. yd. (For details, see sht. GJ)
- ⑩ Sta. "XBS" 11+28.87, 49.67' Lt. to Sta. "XBS" 12+33.30, 28.98' Lt. Inst. 18" culvert pipe - 106' 5' depth Trench resurf. - 34 sq. yd. (See drg. no. RD302)
- ⑪ Sta. "XBS" 12+15.60 Lt. to Sta. "XBS" 16+00.00 Lt. Const. infiltration slope type B - 113.9 cu. yd. (For details, see sht. GJ)
- ⑫ Sta. "XBS" 5+36.35, 33.50' Rt. Extend 36" culvert pipe - 17' 5' depth
- ⑬ Sta. "EB" 477+25.60, 31.52' Lt. Remove extg. inlet Const. shallow manhole Connect extg. 24" storm sew. pipes Rim 35.90 F.L. 31.80 (Extg. 24" N) F.L. 31.70 (Extg. 24" S)

- ⑭ Sta. "XBS" 15+50.03, 41.42' Rt. to Sta. "XBS" 16+50.00, 41.42' Rt. Inst. 18" culvert pipe - 101' 5' depth
- ⑮ Adjust water valve - \* 6
- ⑯ Minor adjust sanitary manhole - 3
- ⑰ Sta. "EB" 480+75.00, 41.93' Lt. to Sta. "EB" 488+68.12, 46.52' Lt. Const. infiltration swale type A - 276.6 cu. yd. Inst. delineators, type S1 (For details, see shts. GJ & GJ-2)
- ⑱ Sta. "XBS" 16+00.00, 28.97' Lt. to Sta. "XBS" 16+14.91, 29.00' Lt. Inst. 12" storm sew. pipe - 15' 5' depth
- ⑲) REPAIR CURB AND RAMP BENCH (25' X 20' X 1') WITH REPAIR GRANULAR, TAP 1
- ⑳ Install 24" storm sew. pipe - 394' 5' DEPTH Connect to ~~Extg~~ Type D Inlet NEW

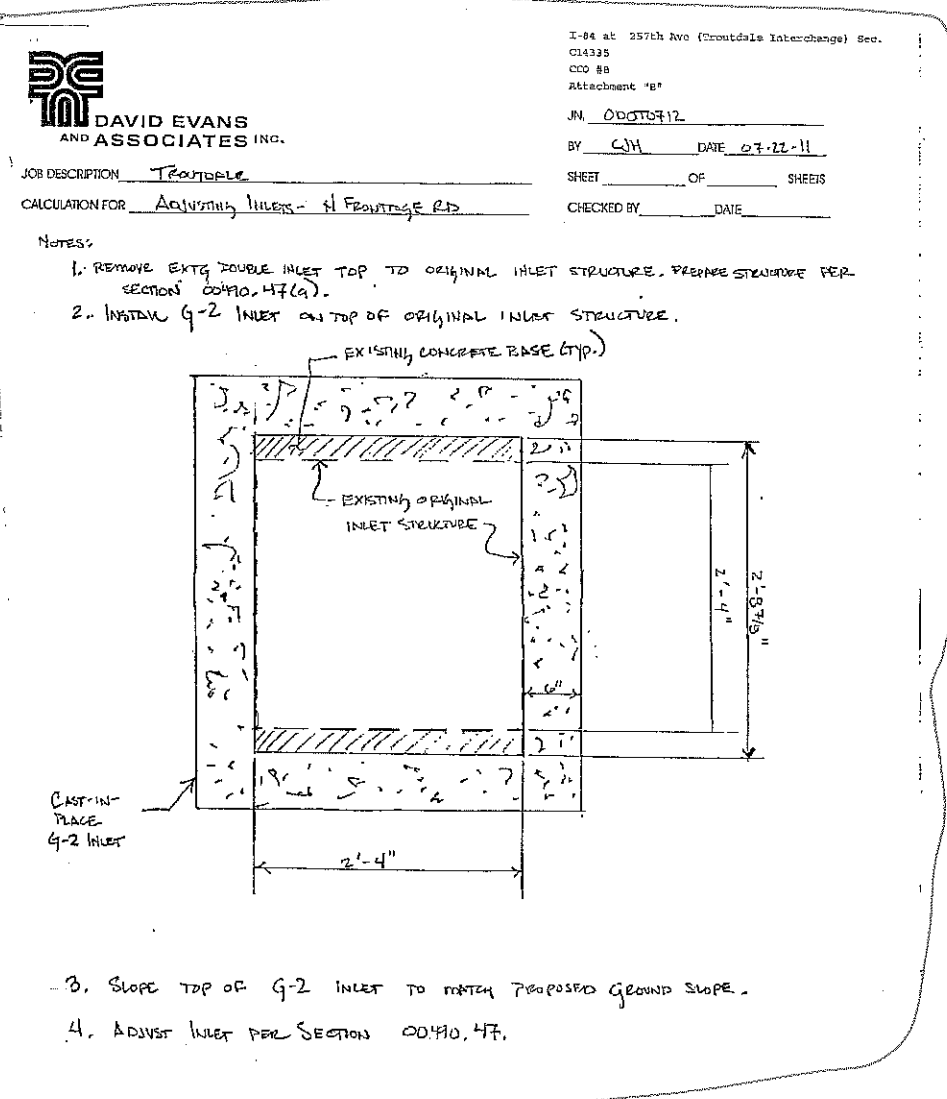

"AS CONSTRUCTED"  
 Mark Ben  
 Date 4-26-12 Project Mngt

REGISTERED PROFESSIONAL ENGINEER 58552  
 OREGON JULY 21, 1998  
 CHRISTINE J. HIGGINS  
 EXPIRES

**OREGON DEPARTMENT OF TRANSPORTATION**


**DAVID EVANS AND ASSOCIATES INC.**  
 2100 Southwest River Parkway  
 Portland Oregon 97201 Ph: 503.223.6663

**I-84 AT 257TH AVE (TROUTDALE INTERCHANGE) SEC.**  
 COLUMBIA RIVER HIGHWAY  
 MULTNOMAH COUNTY


Reviewed By - Craig Sheehan  
 Designed By - Karina Nordahl  
 Drafted By - Edita Boguslawski

**DRAINAGE & UTILITIES**

SHEET NO. **5B-2**

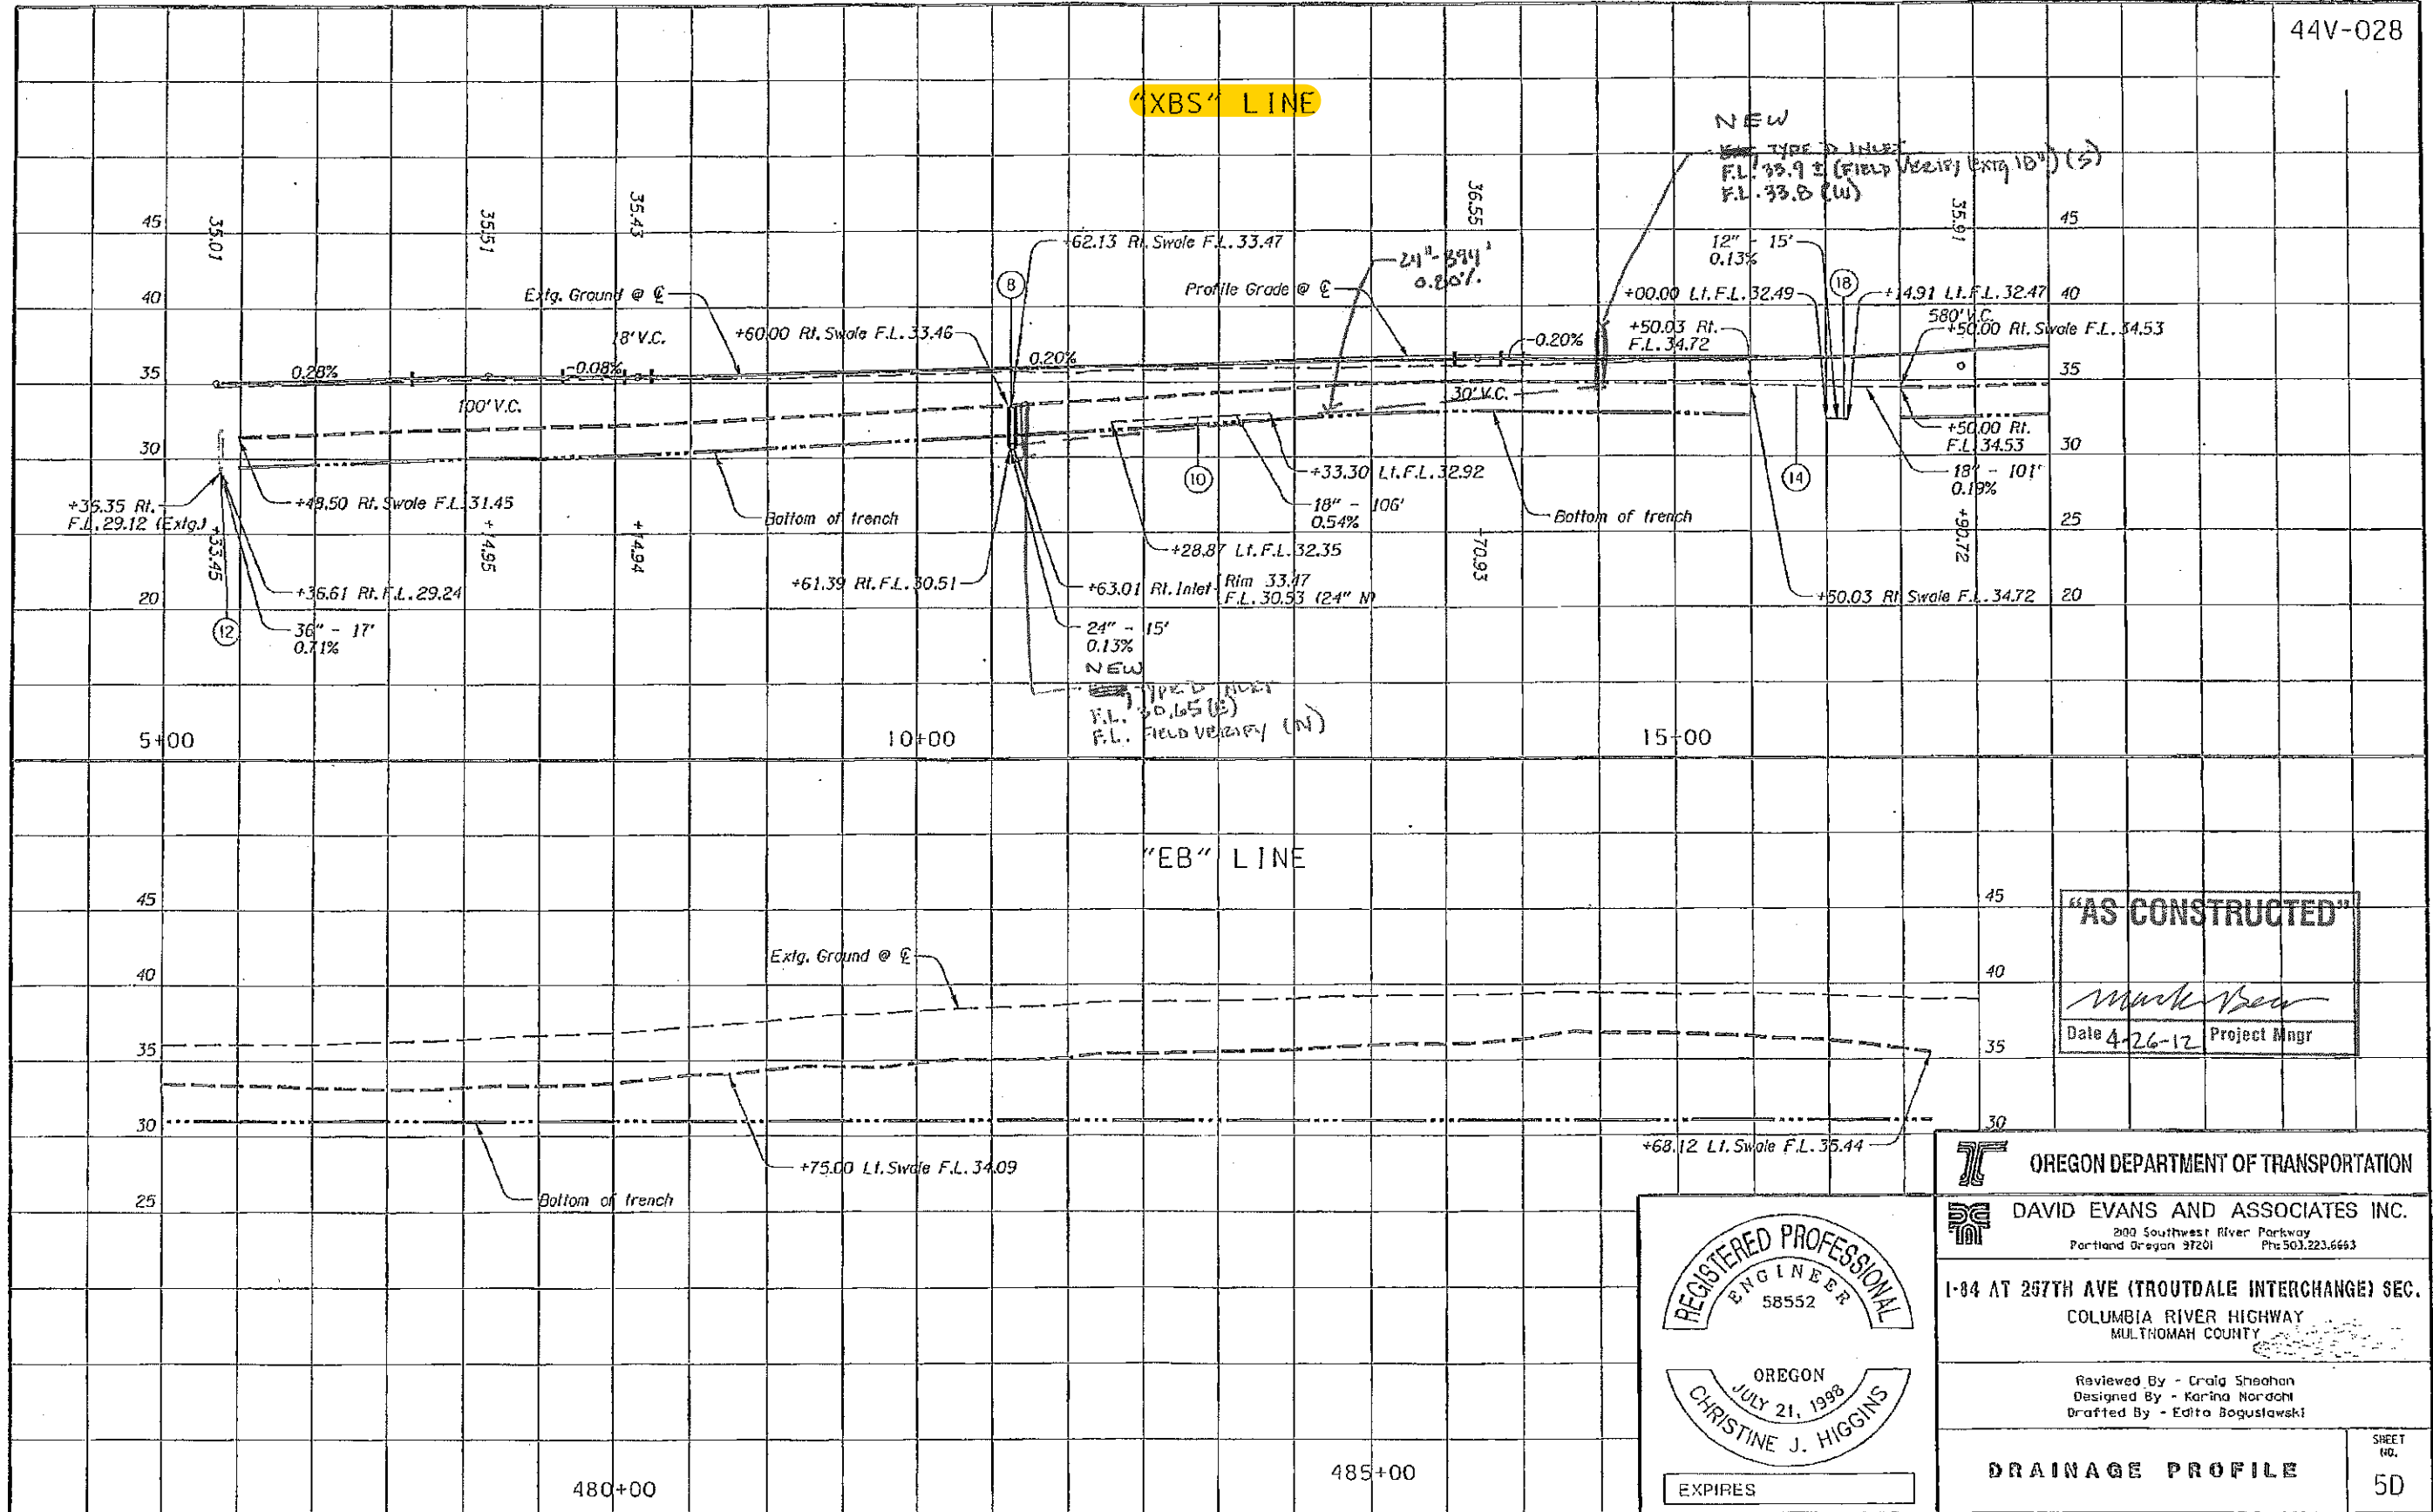

**"AS CONSTRUCTED"**  
*Mark Van*  
 Date 4-26-12 Project Mgr

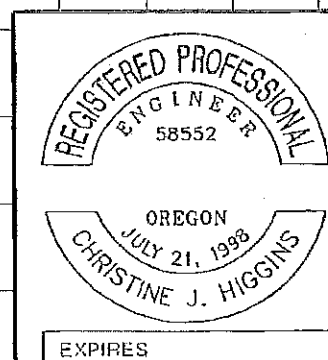


**OREGON DEPARTMENT OF TRANSPORTATION**  
**DAVID EVANS AND ASSOCIATES INC.**  
 200 Southwest River Parkway  
 Portland Oregon 97201 Ph: 503.223.6663  
 I-84 AT 257TH AVE (TROUTDALE INTERCHANGE) SEC.  
 COLUMBIA RIVER HIGHWAY  
 MULTNOMAH COUNTY  
 Reviewed By - Craig Sheahan  
 Designed By - Karina Nordohm  
 Drafted By - Edito Boguslawski

**DRAINAGE PROFILE** SHEET NO. 5D

Sec. 25, 26 T. 1 N, R. 3 E, W.M.

MATCH LINE A  
See shf. 8A

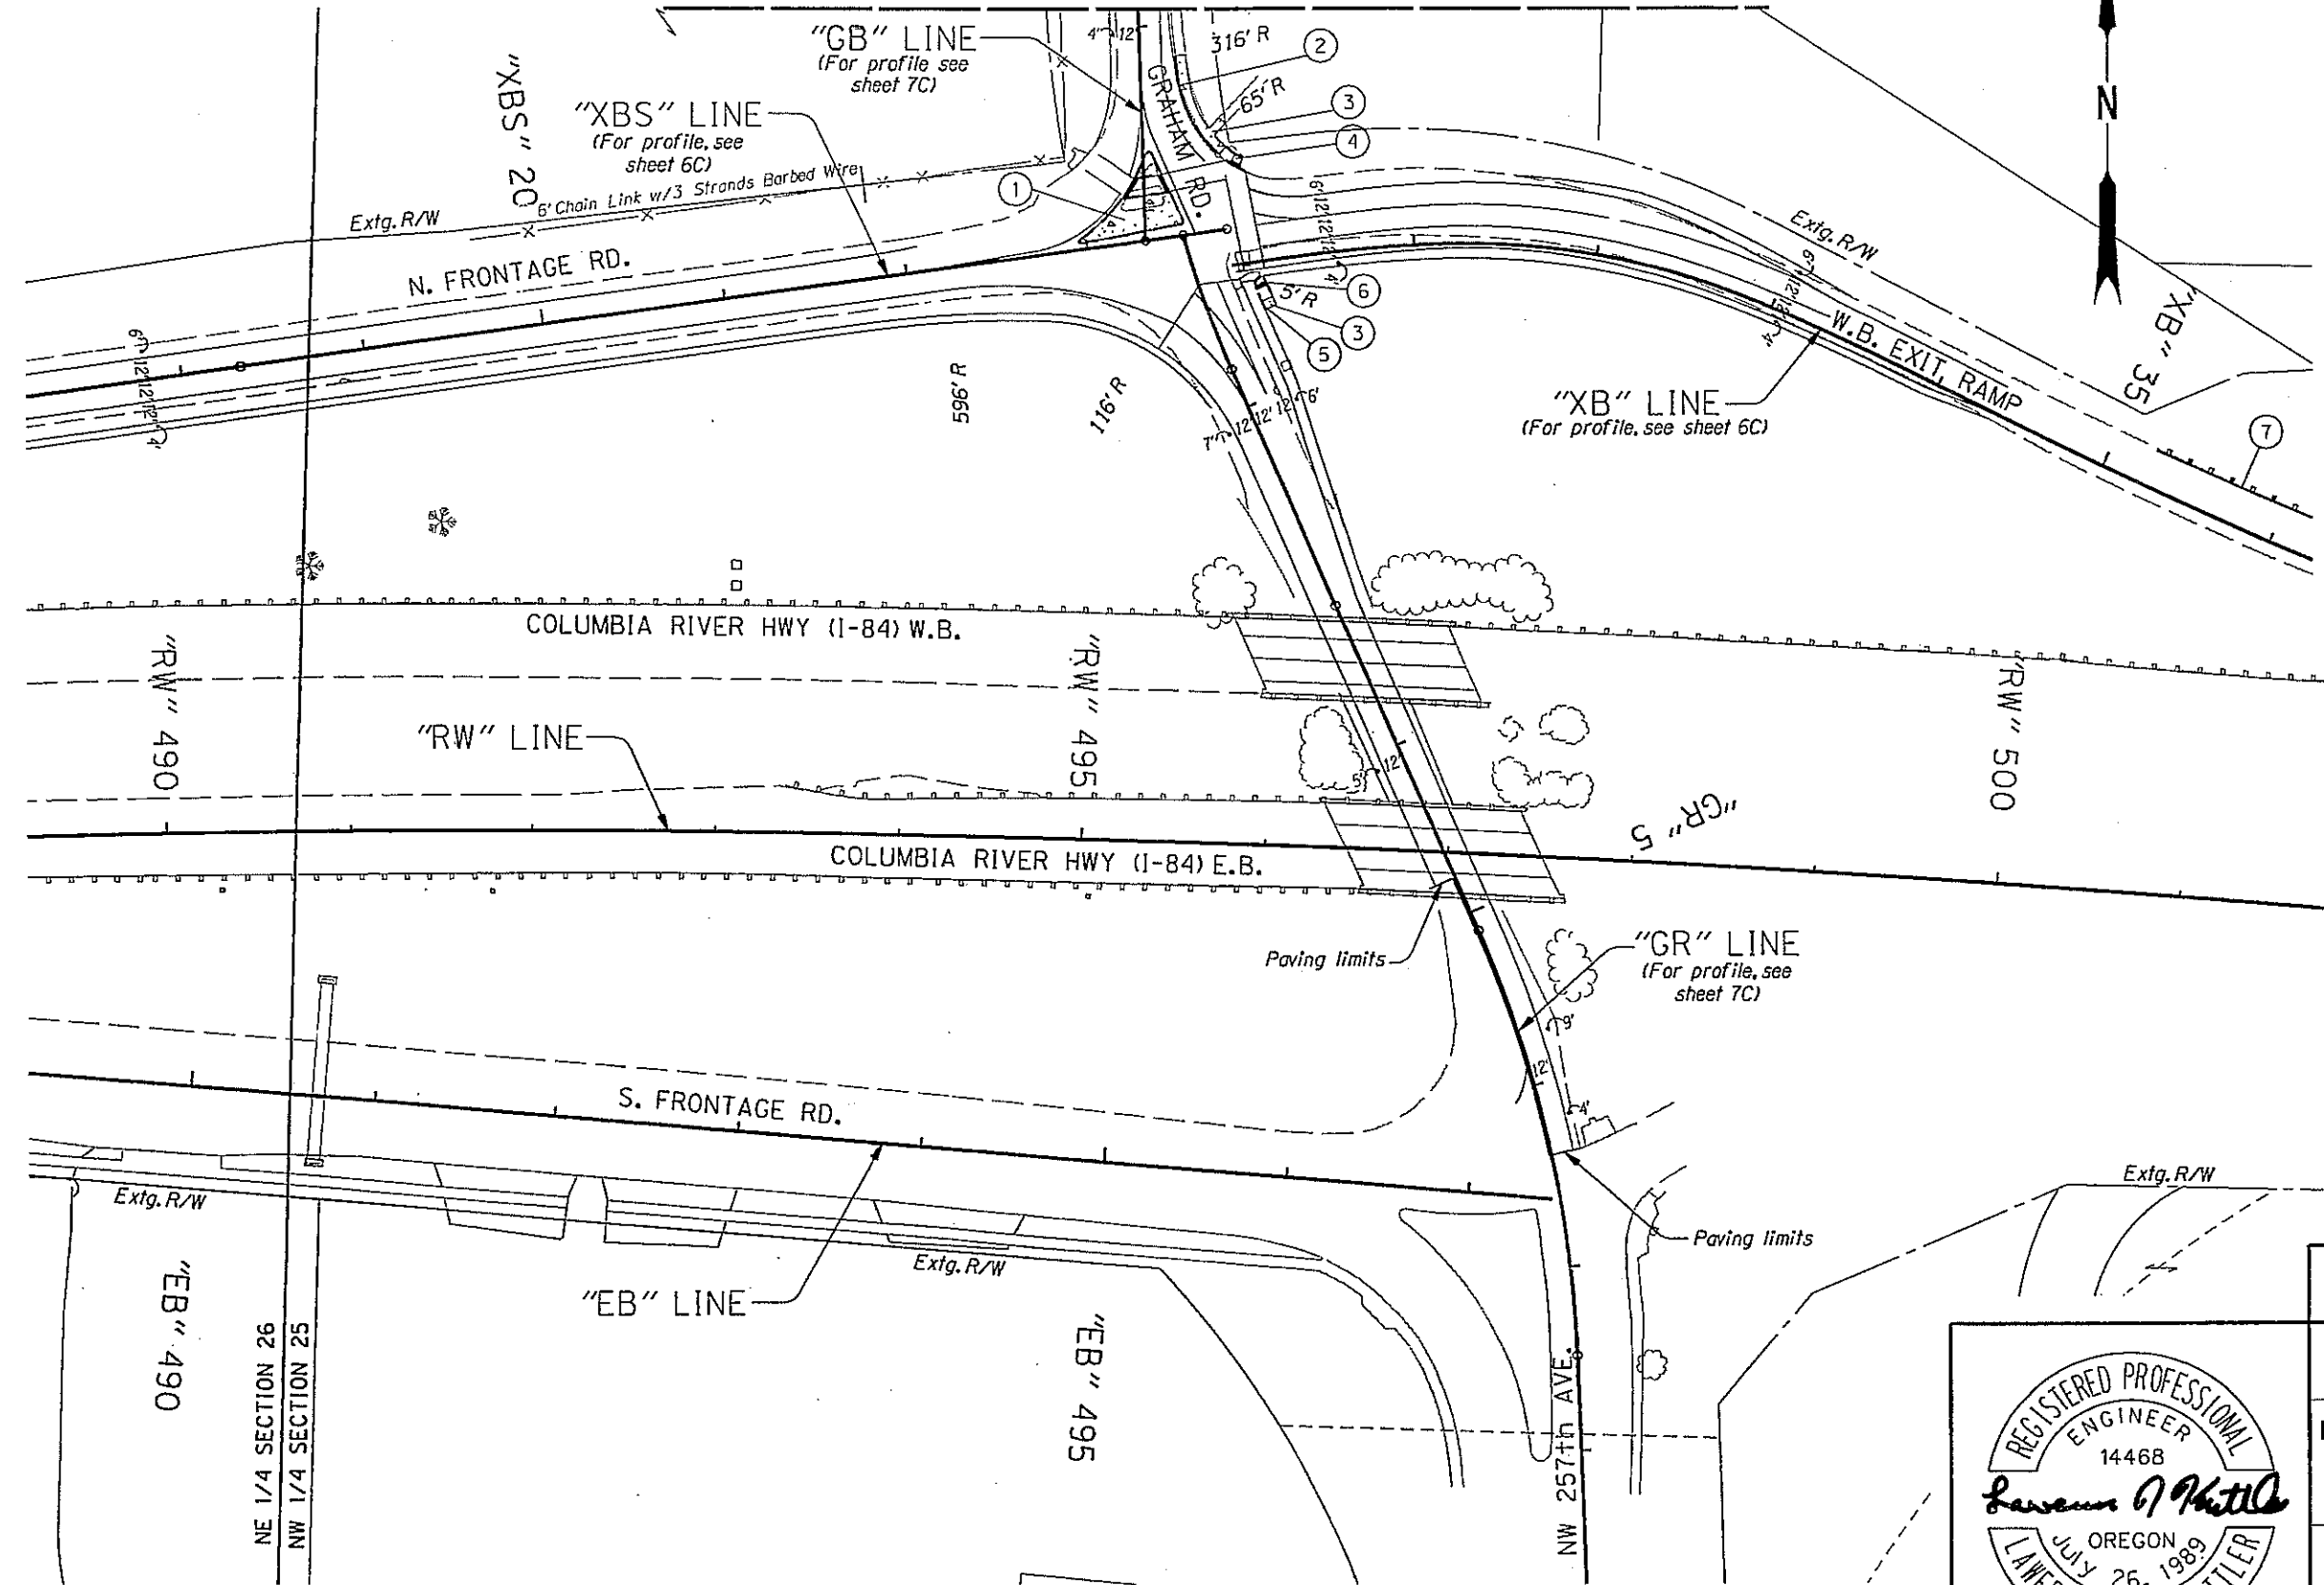

- ① Remove extg. island  
Const. raised rt turn channelization island  
(Cut through design)  
(See drg. no. RD710)  
(For details, see shf. 2B-3)
- ② Const. curb & gutter  
(See drg. no. RD700)
- ③ Const. P.C. conc. sidewalk
- ④ Const. parallel sidewalk ramp - (Modified)  
(For details, see shf. 2B)
- ⑤ Const. standard curb  
(See drg. no. RD700)
- ⑥ Const. sidewalk ramp  
(For details, see shf. 2B)
- ⑦ Adjust extg. guardrail - 125'  
(As directed)

**"AS CONSTRUCTED"**


*Mark New*  
Date 4-26-12 Project Mngr

**OREGON DEPARTMENT OF TRANSPORTATION**

REGION 1 - ROADWAY ENGINEERING SECTION

I-84 AT 257TH AVE (TROUTDALE INTERCHANGE) SEC.  
COLUMBIA RIVER HIGHWAY  
MULTNOMAH COUNTY


Design Team Leader - Lawrence Krettlar  
Designed By - Marco Singer & Dave Hoase  
Drafted By - Carolyn Allen

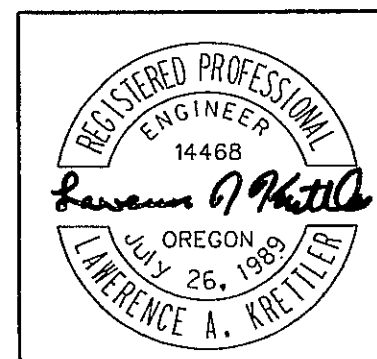

EXPIRATION DATE: 6-30-2011

**GENERAL CONSTRUCTION** SHEET NO. 6A


Sec. 25, T. 1N, R. 3E, W.M.

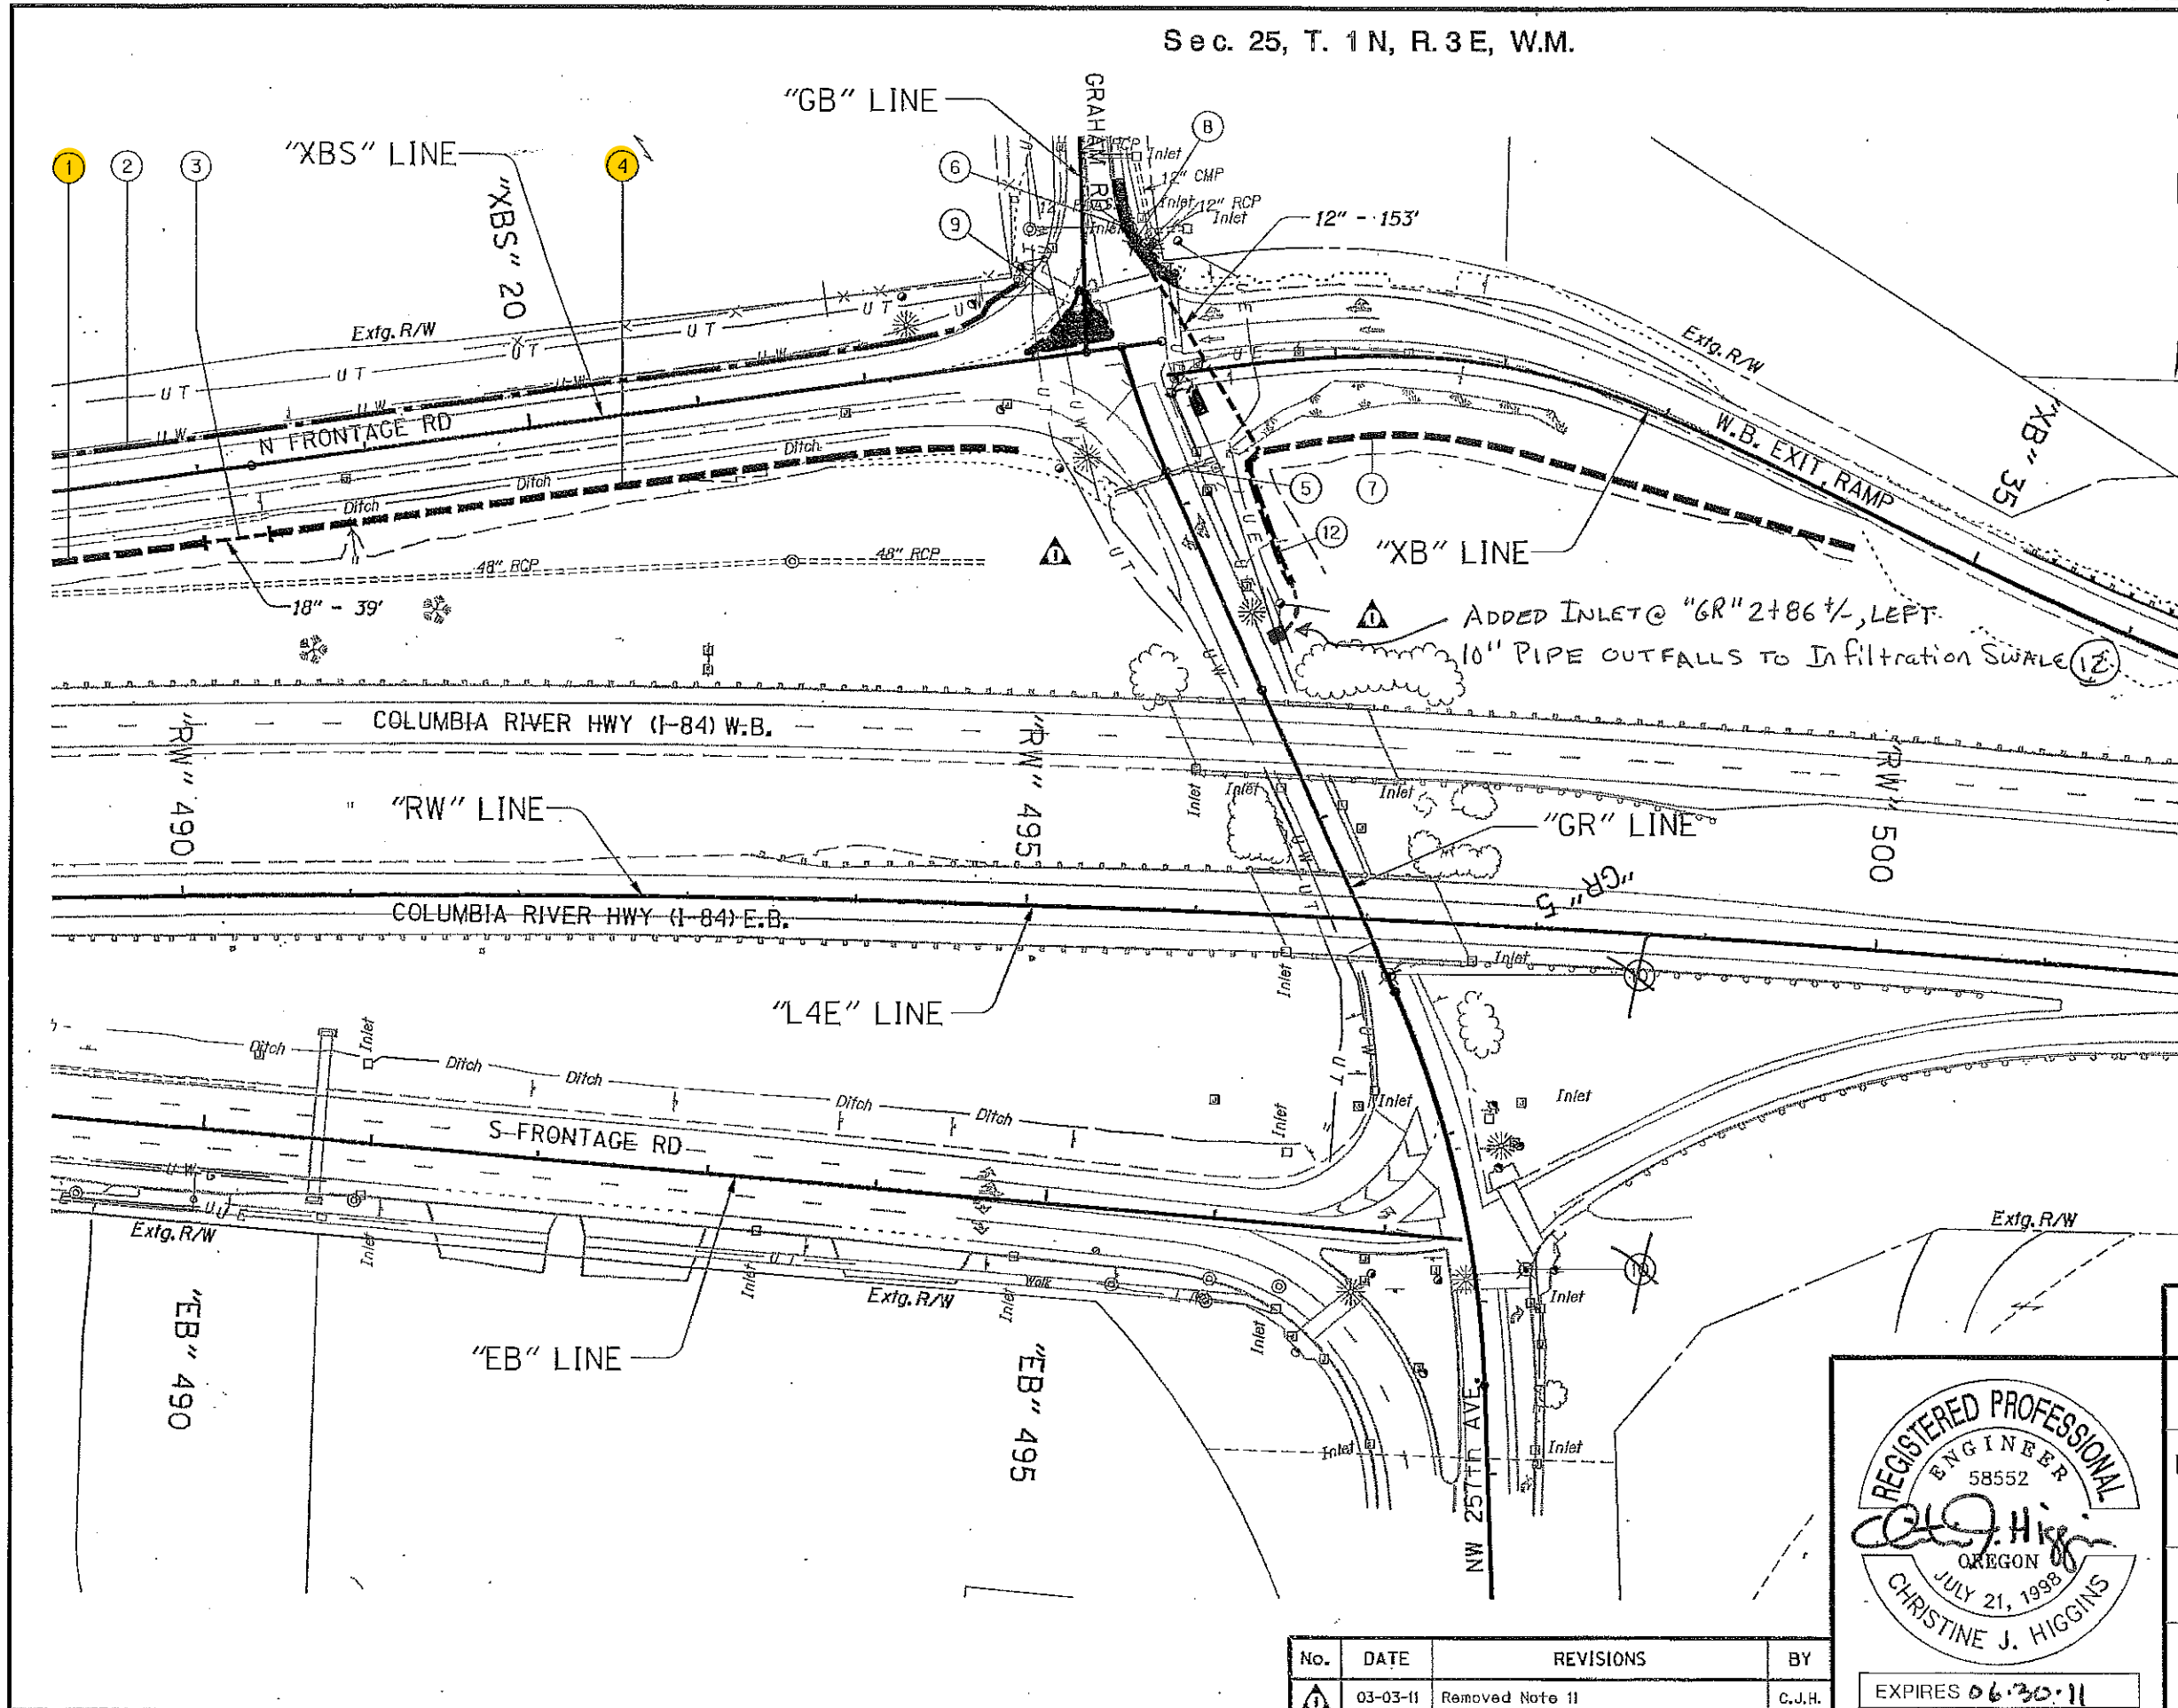

**"AS CONSTRUCTED"**

*Mark Berry*  
 Date 4-16-12 Project Mng'r

- Infiltration swale shown thus:
- Infiltration slope shown thus:
- Fill line shown thus:
- Cut line shown thus:
- Adjust manhole shown thus:
- Remove extg. inlet shown thus:
- Plug and abandon pipe shown thus:

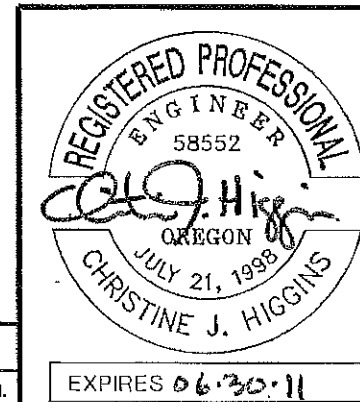

**OREGON DEPARTMENT OF TRANSPORTATION**

**DAVID EVANS AND ASSOCIATES INC.**  
 2100 Southwest River Parkway  
 Portland Oregon 97201 Ph: 503.223.6663


**I-84 AT 257TH AVE (TROUTDALE INTERCHANGE) SEC.**  
 COLUMBIA RIVER HIGHWAY  
 MULTNOMAH COUNTY


Reviewed By - Craig Sheahan *CSH*  
 Designed By - Karina Nordahl  
 Drafted By - Edita Bogustawski


**DRAINAGE & UTILITIES**




SHEET NO. **6B**

No.	DATE	REVISIONS	BY
1	03-03-11	Removed Note 11	C.J.H.

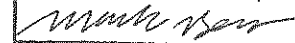- ① Sta. "XBS" 16+50.00, 41.42' Rt. to  
Sta. "XBS" 17+98.66, 41.42' Rt.  
Const. infiltration swale type B - 22.1 cu.yd.  
(For details, see shf. GJ)
- ② Sta. "XBS" 16+14.91 Lt. to  
Sta. "XBS" 22+97.33 Lt.  
Const. infiltration slope type B - 202.9 cu.yd.  
Inst. delineators, type S1  
Inst. delineators, type S2  
(For details, see shfs. GJ & GJ-2)
- ③ Sta. "XBS" 17+98.66, 41.42' Rt. to  
Sta. "XBS" 18+37.63, 41.42' Rt.  
Inst. 18" culvert pipe - 39'  
5' depth
- ④ Sta. "XBS" 18+37.63, 41.42' Rt. to  
Sta. "XBS" 22+84.67, 52.53' Rt.  
Const. infiltration swale type B - 100.3 cu.yd.  
Inst. delineators, type S1  
Inst. delineators, type S2  
(For details, see shfs. GJ & GJ-2)
- ⑤ Plug and abandon extg. 18" storm sew. pipe - 62'
- ⑥ Sta. "GB" 13+44.21 Lt. + 24.9 Lt.  
Const. type "G-2" inlet  
Inst. 12" storm sew. pipe - 155' 180'  
5' depth  
Trench resurf. - 29 sq.yd.  
(See drg. no. RD364)
- ⑦ Sta. "XB" 30+48.87, 52.01' Rt. to  
Sta. "XB" 34+33.10, 22.48' Rt.  
Const. infiltration swale type B - 97.0 cu.yd.  
Inst. delineators, type S1  
Inst. delineators, type S2  
(For details, see shfs. GJ & GJ-2)
- ⑧ Remove extg. inlet  
Plug and abandon extg. 12" storm sew. pipe - 13'
- ⑨ Adjust water valve
- ⑩ Minor adjust manhole - 2
- ⑪ Note not used 
- ⑫ Sta. "GR" 1+89.46, 54.84' Lt. = Sta. "XB" 30+48.87, 52.01' Rt. to  
Sta. "GR" 2+67.50, 40.75' Lt.  
Const. infiltration swale type B - 11.6 cu.yd.  
Inst. delineators, type S1  
(For details, see shfs. GJ & GJ-2)

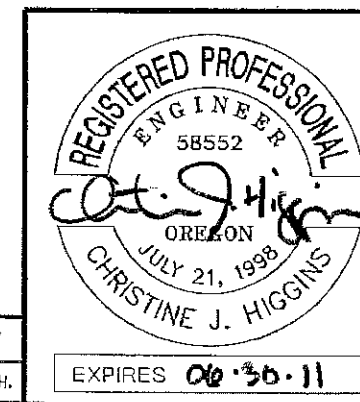
**"AS CONSTRUCTED"**  
  
 Date 4-26-12 Project Mngr

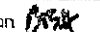

 OREGON DEPARTMENT OF TRANSPORTATION	
 DAVID EVANS AND ASSOCIATES INC. 200 Southwest River Parkway Portland Oregon 97201 Ph: 503.223.6663	
<b>I-84 AT 257TH AVE (TROUTDALE INTERCHANGE) SEC.</b> COLUMBIA RIVER HIGHWAY MULTNOMAH COUNTY	
Reviewed By - Craig Sheahan  Designed By - Karina Nordahl Drafted By - Edita Boguslawski	
<b>DRAINAGE &amp; UTILITIES</b>	SHEET NO. <b>6B-2</b>

No.	DATE	REVISIONS	BY
①	03-03-11	Removed Note II	C.J.H.


EXPIRES 06-30-11

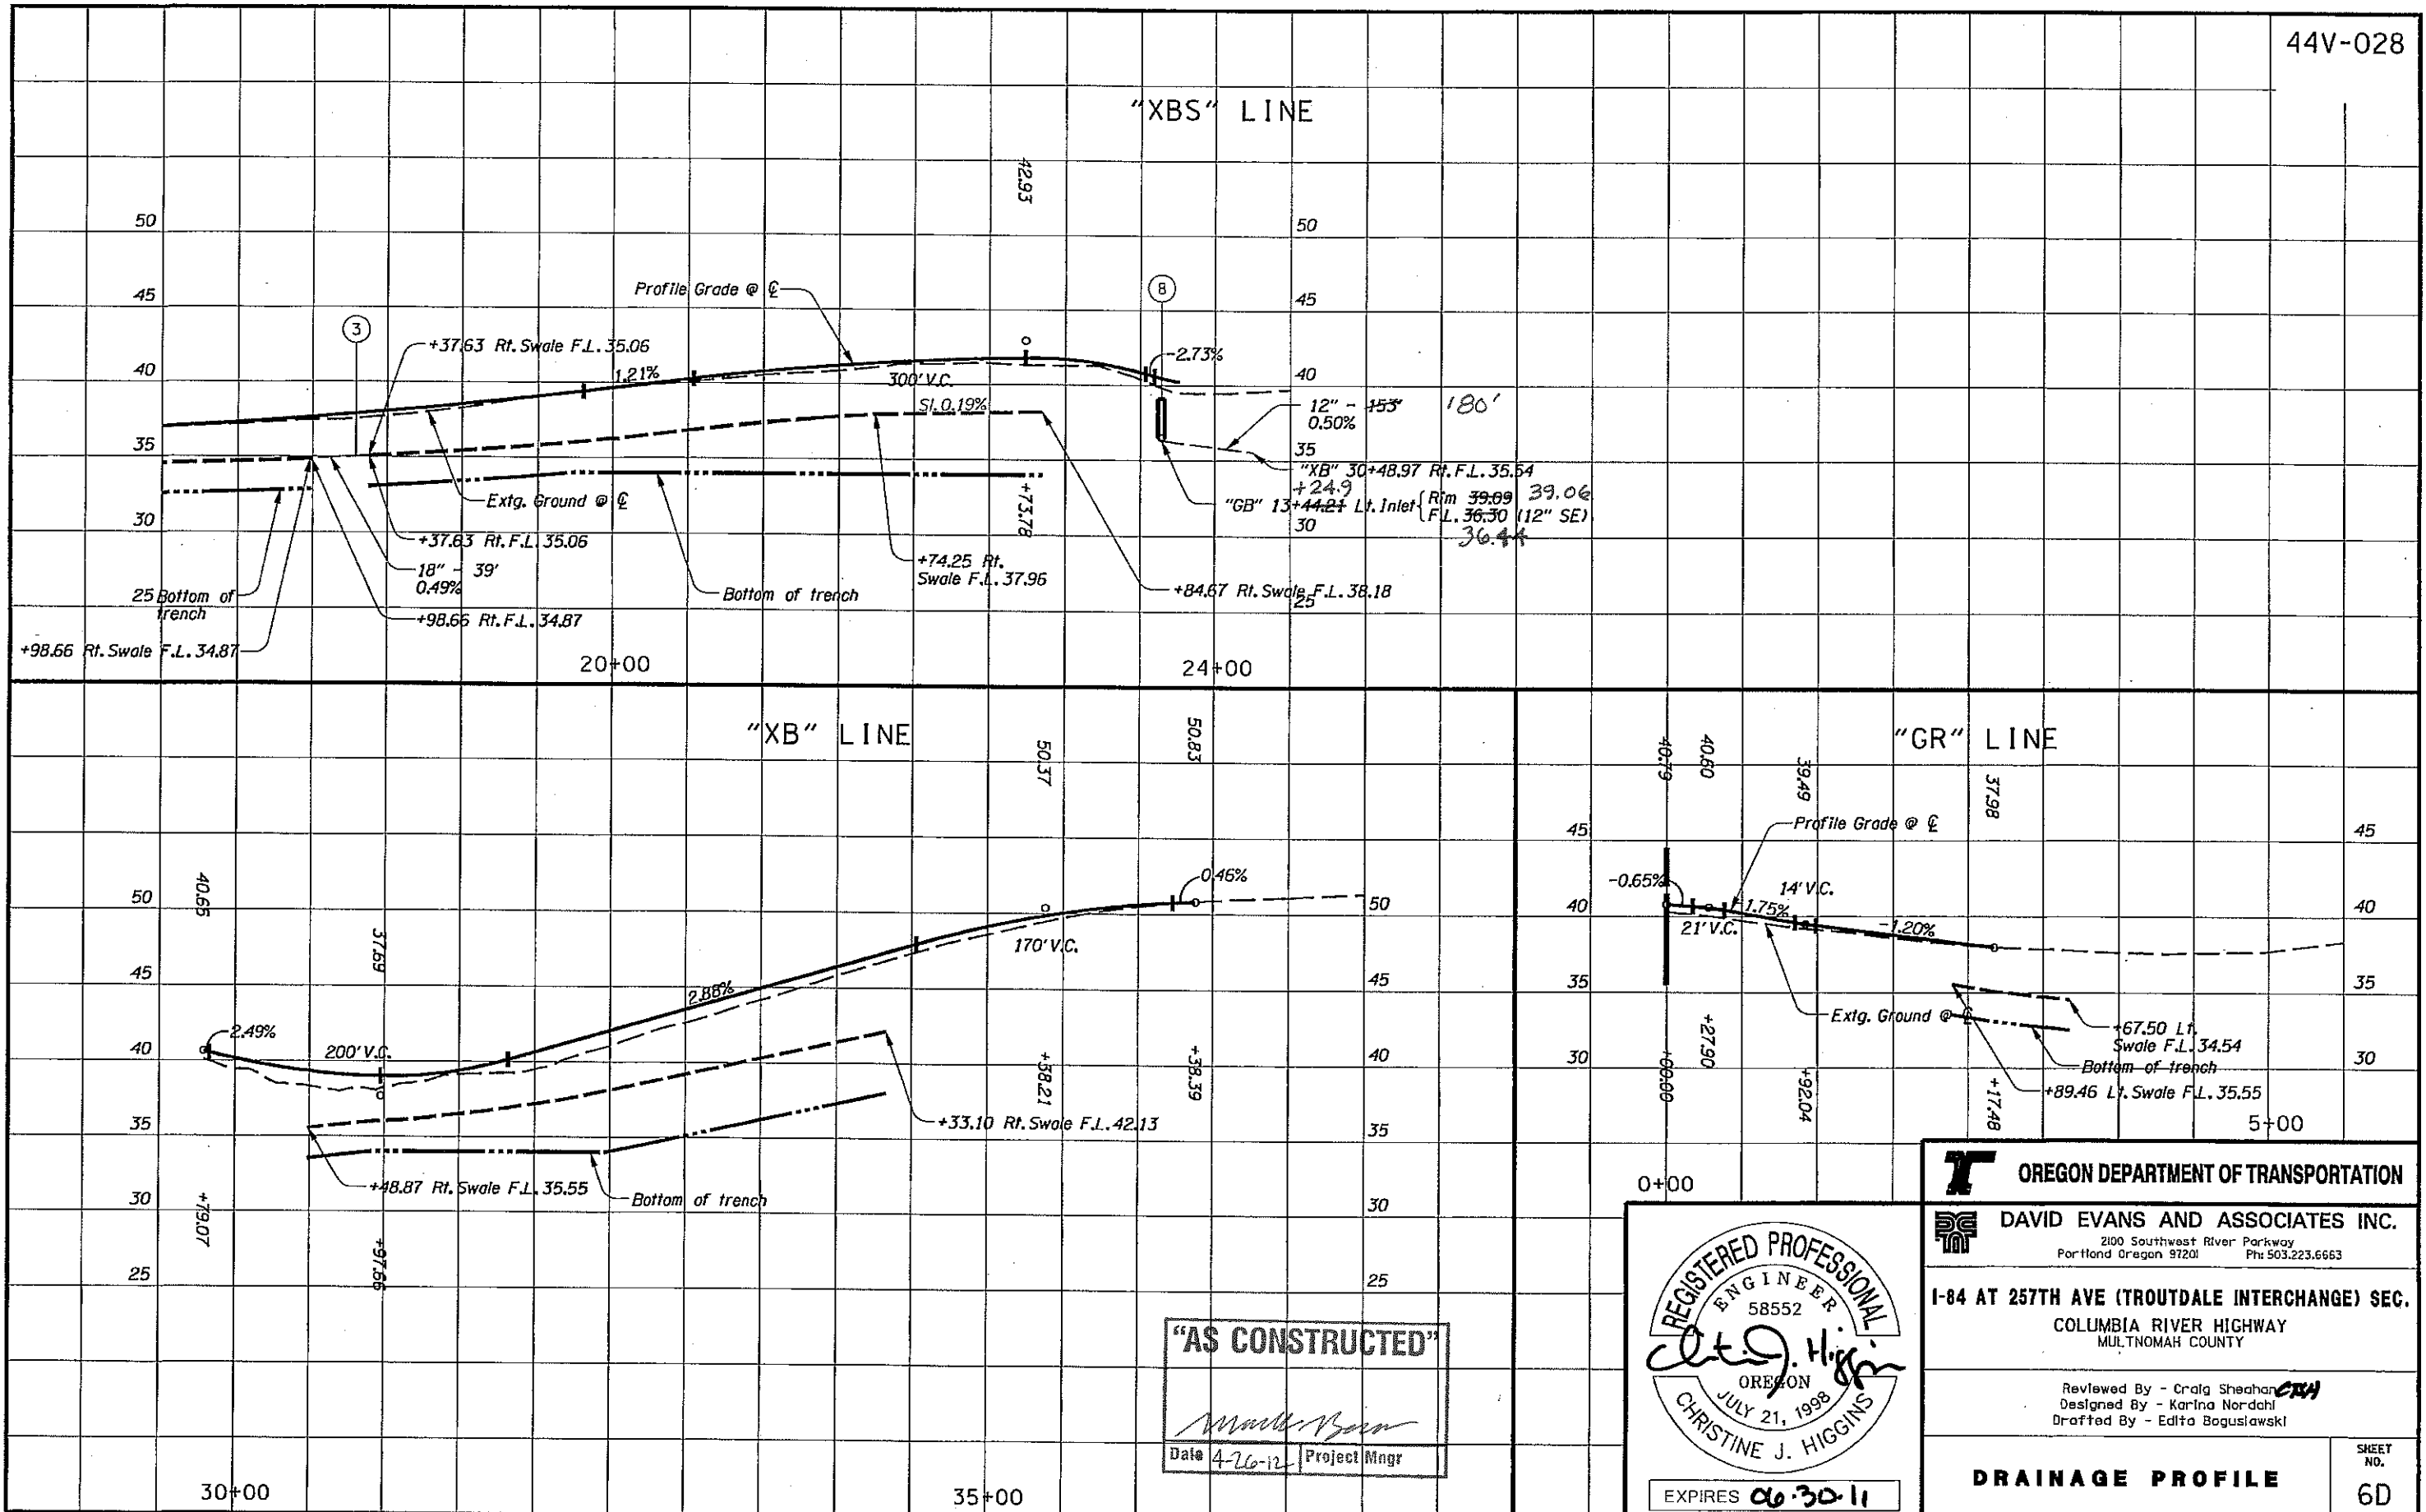

**"AS CONSTRUCTED"**

*Mark Bain*

Date 4-26-12 Project Mngr

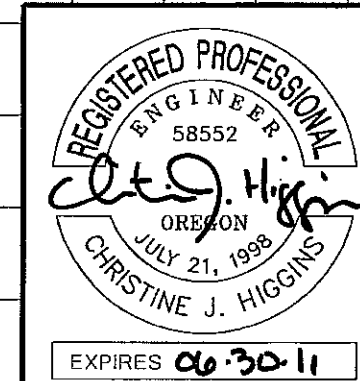

**OREGON DEPARTMENT OF TRANSPORTATION**


**DAVID EVANS AND ASSOCIATES INC.**  
2100 Southwest River Parkway  
Portland Oregon 97201 Ph: 503.223.6663

**I-84 AT 257TH AVE (TROUTDALE INTERCHANGE) SEC.**  
COLUMBIA RIVER HIGHWAY  
MULTNOMAH COUNTY


Reviewed By - Craig Sheahan  
Designed By - Karina Nordahl  
Drafted By - Edita Boguslawski

**DRAINAGE PROFILE**


SHEET NO. 6D

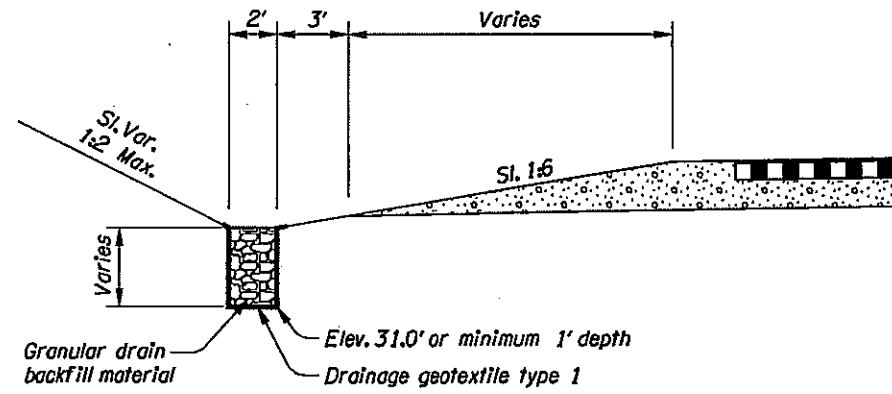


INFILTRATION SWALE TYPE A

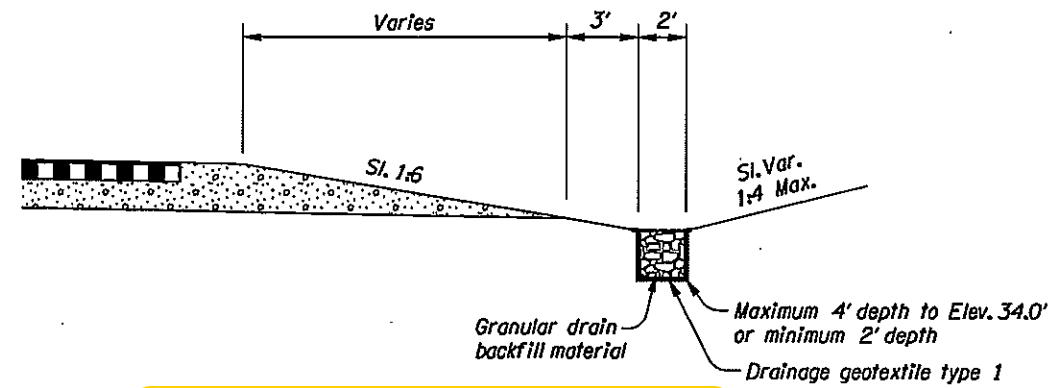


INFILTRATION SWALE TYPE B

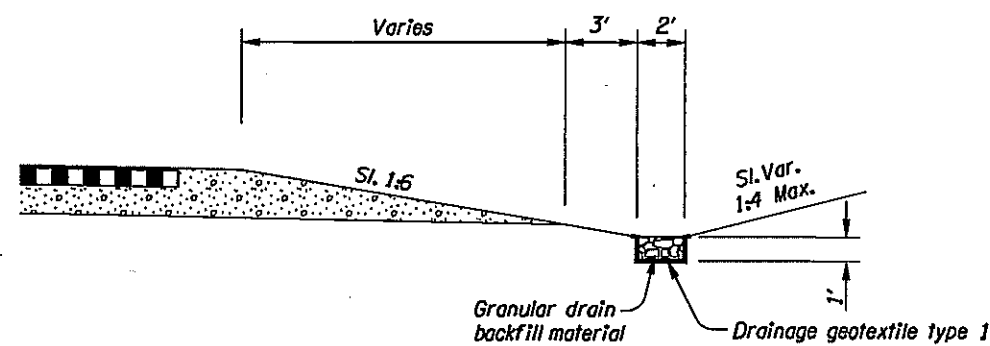


INFILTRATION SWALE TYPE C

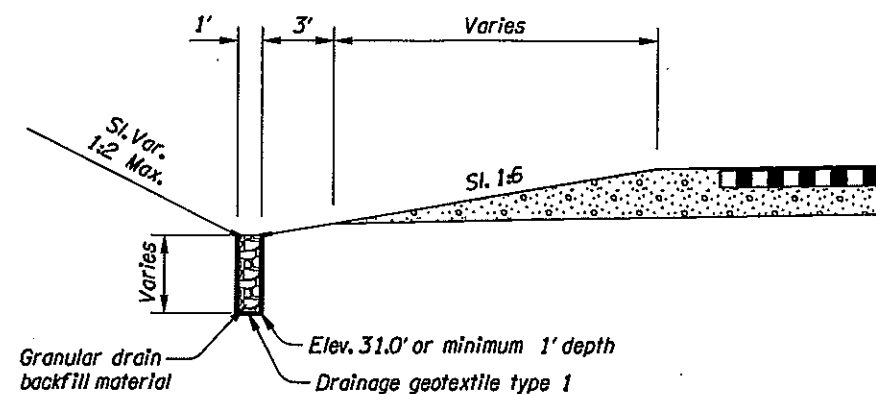

INFILTRATION SWALE TYPE D

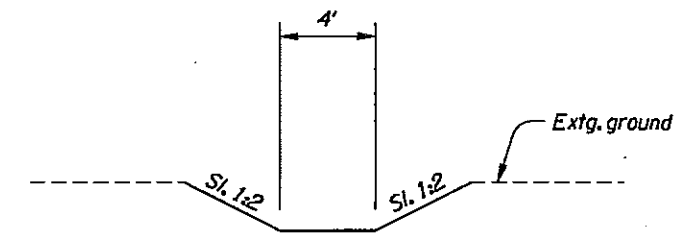


DITCH

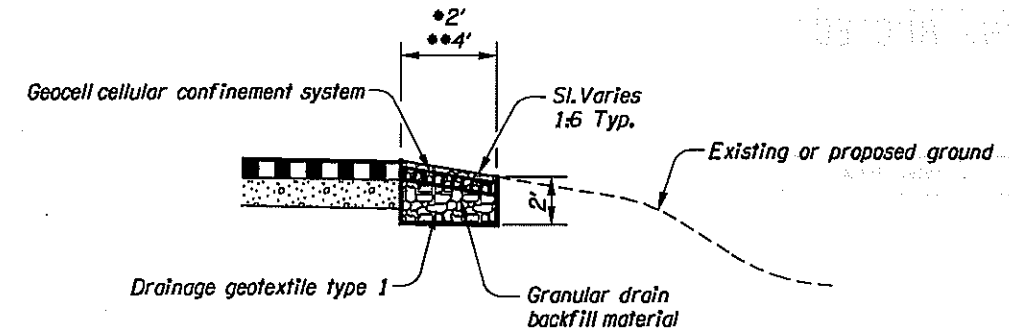

- Sta. "L4E" 455+91.80 to Sta. "L4E" 459+70.00
- Sta. "EB" 459+71.35 to Sta. "EB" 470+03.60

INFILTRATION SLOPE TYPE A

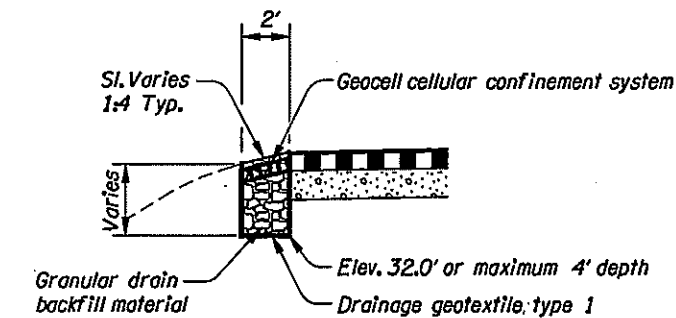


INFILTRATION SLOPE TYPE B

"AS CONSTRUCTED"  
 [Signature]  
 Date 4-26-12 Project Mngr

REGISTERED PROFESSIONAL ENGINEER  
 58552  
 [Signature]  
 OREGON  
 JULY 21, 1998  
 CHRISTINE J. HIGGINS  
 EXPIRES 06-30-11


<b>OREGON DEPARTMENT OF TRANSPORTATION</b>	
<b>DAVID EVANS AND ASSOCIATES INC.</b> 2100 Southwest River Parkway Portland Oregon 97201 Ph: 503.223.6663	
<b>I-84 AT 257TH AVE (TROUTDALE INTERCHANGE) SEC.</b> COLUMBIA RIVER HIGHWAY MULTNOMAH COUNTY	
Reviewed By - Craig Sheahan <i>CSH</i> Designed By - Karina Nordahl Drafted By - Edita Bogustawski	
<b>DRAINAGE DETAILS</b>	SHEET NO. GJ



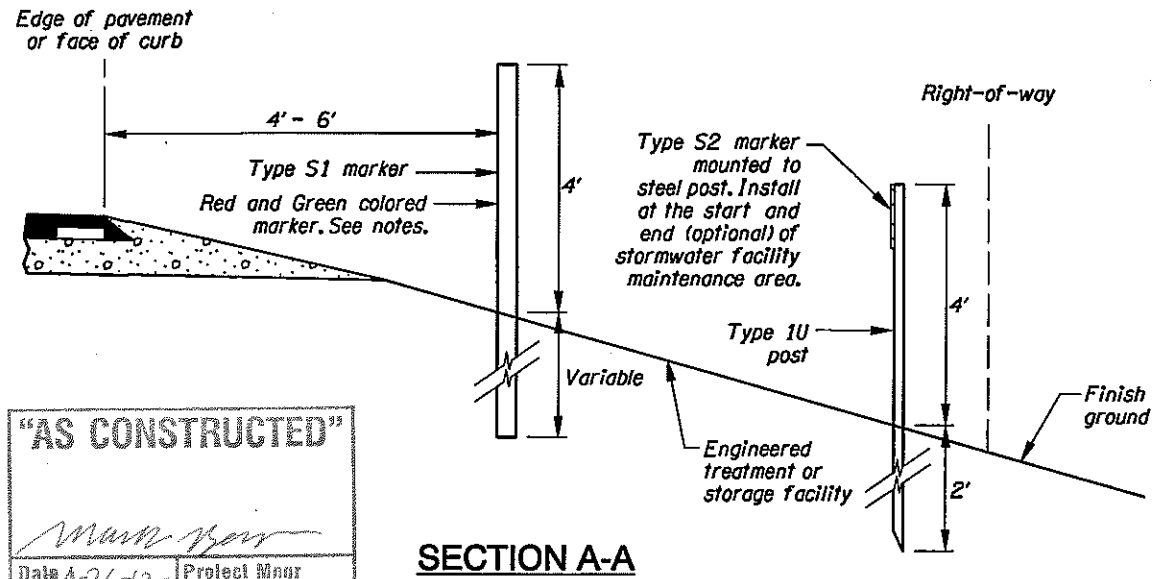

**"AS CONSTRUCTED"**  
 Date 4-26-12 Project Mngr

**SECTION A-A**

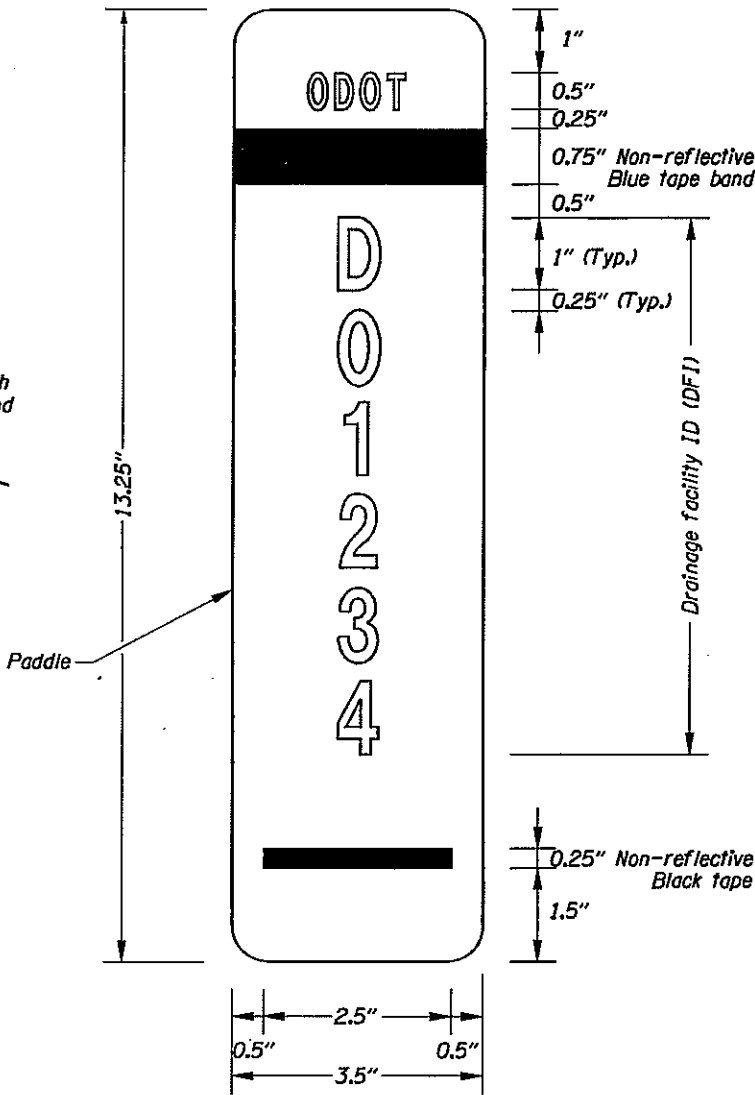

**TYPE S2 MARKER**  
 (STATE SUPPLIED ITEM)

**MARKER TABLE**

FACILITY LOCATION		DFI #	TYPE S2 MARKER LOCATION		TYPE S1 MARKER	
STATION	MP		BEGIN	END	RED	GREEN
"L4E" 455+91.80	16.59	DXXXXX	✓		✓	
"EB" 470+03.60	-	DXXXXX				✓
"EB" 472+65.42	-	DXXXXX	✓		✓	
"EB" 488+68.12	-	DXXXXX				✓
"XBS" 22+84.67	-	DXXXXX	✓		✓	
"TB" 48+42.47	-	DXXXXX				✓
"XBS" 22+97.33	-	DXXXXX	✓		✓	
"XBS" 5+50.09	-	DXXXXX				✓
"XB" 34+33.10	17.35	DXXXXX	✓		✓	
"GR" 2+67.50	-	DXXXXX				✓


✓ Check where appropriate  
 Red = Beginning of facility  
 Green = End of facility

**Notes:**


- Stormwater Facility Field Marker Type S1:**
- See Standard Drawing TM570 for Type 2 flexible plastic post dimensions. Do not mount reflective sheeting to flexible plastic post.
  - A red Type S1 marker is used to mark the start of a stormwater facility maintenance area. A green Type S1 marker is used to mark the end of a stormwater facility maintenance area.
  - Place 4 to 6 feet from edge of pavement or face of curb.
  - See marker table for installation locations.

- Stormwater Facility Field Marker Type S2:**
- Paddle:**
    - Aluminum sheet, nominal thickness 0.050"
    - White non-reflective background
    - Mount paddle to one (1) Type 1U steel post using 3/16" diameter aluminum blind rivets and washers. See Standard Drawing TM 570 detail labeled "Steel Posts" for mounting a traffic target. Install paddle onto Type 1U steel post using the same hole pattern.
    - Text and numbers are Type C font in non-reflectorized black
    - Band is non-reflective blue tape
    - Do not mount paddle to other highway signing posts
    - Install paddle parallel to travel lane
    - Prepare paddle for each "DFI" noted in the marker table
  - Steel Posts:**
    - See Standard Drawing TM571 for Type 1U steel post dimensions


- Stormwater Facility Field Marker Type S3:**
- The top of access or manhole cover shall be stamped with the drainage facility ID. Ink stamping ID is not allowed.

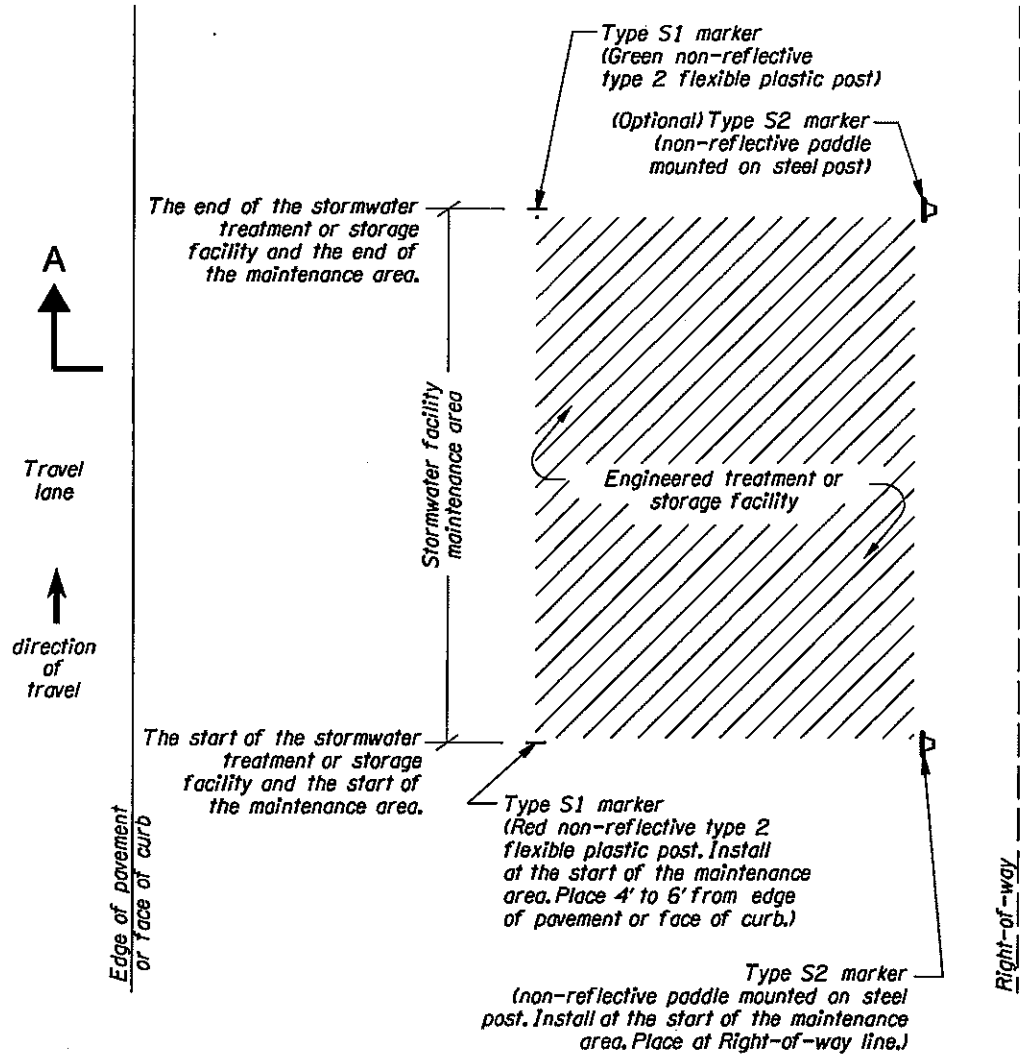

**TYPE S1 & S2 MARKERS INSTALLATION DETAIL**

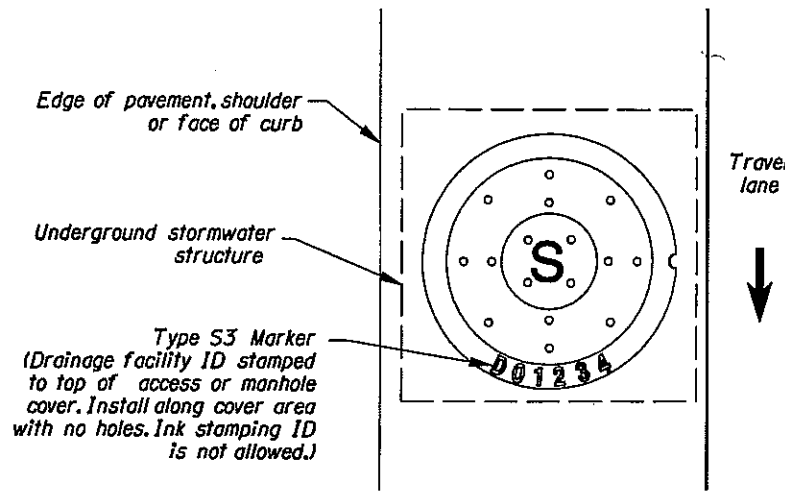

**TYPE S3 MARKER INSTALLATION DETAIL**

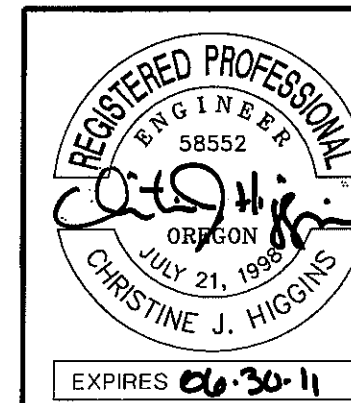

**OREGON DEPARTMENT OF TRANSPORTATION**

**DAVID EVANS AND ASSOCIATES INC.**  
 2100 Southwest River Parkway  
 Portland Oregon 97201 Ph: 503.223.6663

**I-84 AT 257TH AVE (TROUTDALE INTERCHANGE) SEC.**  
 COLUMBIA RIVER HIGHWAY  
 MULTNOMAH COUNTY

Reviewed By - Craig Sheahan  
 Designed By - Karina Nordahl  
 Drafted By - Edita Boguslawski

**STORMWATER TREATMENT AND STORAGE FACILITY FIELD MARKERS**

SHEET NO. **GJ-2**