

STORMWATER FACILITY OPERATION & MAINTENANCE MANUAL

US 30 @ Eilertsen Creek Project

Lower Columbia River Hwy

Columbia County

Prepared for:

Oregon Department of Transportation

ODOT Project Key No. 17037

Drainage Facility ID	Facility Type	Highway Name	Highway Number	Route Number	MP (Begin)	MP (End)	County
D 00548	Biofiltration Swale and Filter Strip	Lower Columbia River Hwy	092	US 30	67.94 (Rt.)	67.87 (Rt.)	Columbia
D 00549	Water Quality Biofiltration Swale	Lower Columbia River Hwy	092	US 30	67.93 (Lt.)	67.88 (Lt.)	Columbia
D 00550	Water Quality Biofiltration Swale	Lower Columbia River Hwy	092	US 30	67.81 (Rt.)	67.83 (Rt.)	Columbia
D 00551	Water Quality Filter Strip	Lower Columbia River Hwy	092	US 30	67.85 (Lt.)	67.84 (Lt.)	Columbia
D 00552	Water Quality Filter Strip	Lower Columbia River Hwy	092	US 30	67.84 (Lt.)	67.81 (Lt.)	Columbia

Prepared By:

David Evans and Associates, Inc.
2100 SW River Parkway
Portland, Oregon 97201

DEA Project No. ODOT0000-0700

November 2010

Table of Contents

1.0	IDENTIFICATION	3
2.0	DESIGNER.....	3
3.0	SYSTEM OVERVIEW	3
4.0	MAINTENANCE REQUIREMENTS	4
4.1	Schedule.....	4
4.2	Inlets and Pipe.....	4
4.3	Embankments, Berms, & Side Slopes.....	4
4.4	Sediment & Debris Management.....	4
4.5	Vegetation.....	5
4.6	Hazardous Material Spill	5
4.7	Access	5
4.8	Insects & Rodents	5
5.0	WASTE MATERIAL HANDLING	6
6.0	MAINTENANCE CHECKLIST	7

1.0 IDENTIFICATION

Project Name: **US 30 @ Eilertsen Creek Project (K17037)**
Facility Type: Storm Drainage, Biofiltration Swales, and Filter Strips
Location: US 30 @ Eilertsen Creek in Columbia County (M.P. 67.99 to M.P. 67.72)

2.0 DESIGNER

Company: David Evans and Associates, Inc.
Contact: Christine Higgins, PE (503) 223-6663

3.0 SYSTEM OVERVIEW

The project area includes US Hwy 30 from MP 67.99 to MP 67.72, and the intersections of US Hwy 30 with Woodson Road and Marshland District Road. Project improvements include replacing the 6-foot by 8-foot box culvert with a single span bridge and the roadway improvements associated with the work. Additional work includes replacing two 6-foot diameter CMP culverts crossing the Portland and Western Railroad (P&WRR) tracks with a single span bridge. The project also includes installing water quality facilities and new drainage system as needed.

Stormwater from the total contributing project impervious area will be treated with four filter strips and three biofiltration swales. A filter strip and biofiltration swale on the south side of the highway from Station 468+76 (M.P. 67.94) to Station 472+34 (M.P. 67.87) will treat 7,899 square feet. A second filter strip and biofiltration swale is proposed on the north side of the highway between Station 469+05 (M.P. 67.93) and Station 472+07 (M.P. 67.88) to treat 8,020 square feet. The proposed bridge will be curbed and the water will not be allowed to flow directly into Eilertsen Creek. Drainage curb is proposed from the end of the bride east to Station 473+67 (M.P. 67.85). The stormwater from this project segment will be piped to a biofiltration swale located on the south side of the highway from Station 475+50 (M.P. 67.81) to Station 474+24 (M.P. 67.83). A third filter strip is proposed at the northwest corner of Marshland District Road and US Hwy 30 and extends to the northside of the P&WRR tracks. This filter strip drains to an existing vegetated swale, where additional water quality treatment will occur prior to draining into Eilertsen Creek.

At the same intersection a fourth filter strip is proposed at the northeast corner and will extend to the northside of the P&WRR tracks and to Station 475+70 (M.P. 67.81). The filter strip will drain to the existing vegetated roadside ditch where infiltration most likely occurs.

System layout and details are shown in Appendix A of the Advance Stormwater Management Plan.

4.0 MAINTENANCE REQUIREMENTS

The treatment swales and filter strips are constructed for biofiltration. All facility components and vegetation need to be inspected for proper operation and structural stability.

4.1 *Schedule*

- Conduct a special inspection of the facility after the first 24-hr rainfall that is greater than 0.50 inches. Regular inspections should occur, at a minimum, quarterly for the first 2 years from the date of installation, and 2 times per year thereafter, and within 48 hours after each major storm event. Perform maintenance as necessary.
- Every two to five years, remove sediment from the pond bottom and from sumped inlets.

4.2 *Inlets and Pipe*

- Visually inspect and remove sediment and debris from inlets and manholes.
- Remove debris from surface grates as required.
- Visually inspect, supplemented by remote television inspection, all pipe. Clean accumulations of sediment from all pipe.

4.3 *Embankments, Berms, & Side Slopes*

- Check for, repair, and identify the sources of the following along all embankments, berms, and side slopes:
 - Cracking,
 - Erosion channels deeper than 2 inches,
 - Sloughing,
 - Piping,
 - Rodent holes,
 - Debris,
 - Settlement greater than 4 inches.
- Slopes shall be stabilized using appropriate erosion control measures if native soil is exposed or erosion channels are forming.
- **All material from side slope sloughing shall be removed and disposed of outside of the swale limits.**

4.4 *Sediment & Debris Management*

Sediment & debris management shall prevent loss of swale volume caused by sedimentation.

- The swale shall be dredged when 2 inches of sediment accumulates.
- Debris in quantities sufficient to inhibit operation shall be removed routinely, e.g. no less than quarterly, or upon discovery.

4.5 Vegetation

Vegetation shall be healthy and dense enough to provide filtering while protecting underlying soils from erosion.

- Vegetation, large shrubs or trees that limit access, shade, or otherwise interfere with swale or filter operation shall be pruned.
- Grass along the bottom and side slopes and where applicable shall be mowed to a height of between 4 and 6 inches, and grass clippings shall be removed.
- Fallen leaves and debris from deciduous plant foliage shall be raked and removed.
- Remove noxious or foul smelling vegetation.
- Dead vegetation shall be removed when it exceeds 10% of area coverage or when function is impaired. Vegetation shall be replaced within 3 months, or immediately if required to maintain cover density and control erosion where soils are exposed.
- Herbicides shall not be used to control vegetation.

4.6 Hazardous Material Spill

Hazardous material spills can harmfully impact the surface water, groundwater and soils. Spills should be prevented.

- Spill Prevention measures shall be exercised when handling substances that can contaminate stormwater.
- Remove all contaminated sediment and sludge from all portions of the affected system immediately following any hazardous material spill event.
- Dispose of all removed hazardous material off-site in an appropriate manner.

4.7 Access

Access to the swale or filter strip shall be safe and efficient. Access shall be maintained to accommodate size and weight of maintenance vehicles. Access by vehicles should be limited to dry weather to prevent rutting and erosion.

- Obstacles preventing maintenance personnel and/or equipment access to the swale shall be removed.
- Gravel or ground cover shall be added if erosion occurs.

4.8 Insects & Rodents

Insects and rodents shall be discouraged from congregating in or around the swale.

- Control insects that breed or congregate in the swale.
- Remove burrowing animals from side slopes.
- Holes in the ground located in and around the swale shall be filled and compacted.

5.0 WASTE MATERIAL HANDLING

Material cleaned from the facility is defined as waste by DEQ. All waste must be disposed of at a permitted waste management facility or managed, reused, or recycled according to DEQ waste rules.

Road waste materials can be contaminated with chemical pollutants. If waste material is sent to a permitted waste management facility, facility operators may require testing for specific pollutants before the material will be accepted for disposal.

If waste material is being stockpiled or recycled, it should be determined if the material is contaminated with pollutants and at what levels. Chemical testing for total metals and hydrocarbons is usually adequate. Be aware, other pollutants might be present and test accordingly. All trash and litter must be removed and properly disposed. Whenever placing roadwaste material, ensure it will not migrate or erode and does not contain pollutants that will impact adjacent land, waterways, or groundwater.

If waste material is to be reused, DEQ will likely require a “Solid Waste Letter of Authorization” for approval of the waste material’s final placement. Typically, DEQ will assist to ensure the proper permits and papers are obtained, needed pollutant testing is completed, and final placement of material is appropriate.

More detailed guidance on management of roadwaste can be found at the ODOT Research website: <http://www.odot.state.or.us/tddresearch/reports.htm>. Contact any of the following departments for more detailed waste material management information and assistance:

ODOT Clean Water Unit	(503) 986-3008
ODOT Statewide Hazmat Coordinator	(503) 731-8252
ODOT Region Hazmat Coordinator	(503) 731-8304
ODEQ Northwest Region Office	(503) 229-5263

6.0 MAINTENANCE CHECKLIST

All facility components, vegetation, and source controls need to be inspected for proper operation and structural stability. These inspections should occur quarterly for the first 2 years from the date of installation. At a minimum, the swales and filter strips shall be inspected twice a year, and sediment removed as necessary.

INLETS, PIPE AND RIPRAP OUTFALL

The pipe and riprap outfall shall assure unrestricted stormwater flow to the swale.

- Sediment and Debris Removal** – Remove sediment and debris when sediment and debris is more than 2 inches thick or is damaging vegetation.
- Catch Basins and Manholes** - Remove sediment and debris from inlets when accumulated to 3 inches below pipe invert elevation.
- Pipe Clearing** – Remove sediment and debris when sediment and debris fills half the pipe diameter

SIDE SLOPES

Side slopes retain water in the swale.

- Slope Maintenance (Stabilization)** – Stabilize slopes using appropriate erosion control measures when native soil is exposed or erosion channels are forming

SWALE AND FILTER STRIP MEDIA

Swale and filter strip media shall be maintained so that the swale flows freely with no debris present.

- Tilling and Replanting** - Till and replant swale according to design specifications if the swale does not drain within 48 hours
- Debris Removal** - Remove debris that inhibits the swale operation

SWALE AND FILTER STRIP

Vegetation shall be healthy and dense enough to provide filtering while protecting underlying soils from erosion and minimizing solar exposure of open water areas.

Vegetation Control

- Prune large shrubs or trees that interfere with the swale operation
- Remove fallen leaves and debris from deciduous plant foliage
- Remove nuisance vegetation, such as blackberries or English Ivy
- Remove invasive vegetation contributing up to 25% of vegetation of all species
- Remove dead vegetation and woody material and replace to maintain cover density

Insects and Rodent Removal

- Remove pests and/or rodents when present.
- Fill burrows and compact. Reestablish vegetation.

Maintenance Record:

Record date, description, and contractor (if applicable) for all structural repairs, landscape maintenance, and facility cleanout activities.

EXAMPLE

Date: 10/1/07 Initial BJK
Work performed by: AAA Landscaper under 3yr contract.
Work performed: Replanted parking lot swale with sedges & rushes.
Details: *Work Order on file and available upon request.

Date: _____ Initials: _____
Work performed by: _____
Work performed: _____
Details: _____

Date: _____ Initials: _____
Work performed by: _____
Work performed: _____
Details: _____

Appendix A

Drainage Plans And Details


INDEX OF SHEETS	
SHEET NO.	DESCRIPTION
1	Title Sheet
1A	Index Of Sheets Cont'd. & Std. Drg. Nos.

STATE OF OREGON
DEPARTMENT OF TRANSPORTATION

PLANS FOR PROPOSED PROJECT
GRADING, DRAINAGE, STRUCTURES, PAVING,
SIGNING & ROADSIDE DEVELOPMENT


US 30 @ EILERTSEN CREEK PROJECT
LOWER COLUMBIA RIVER HWY.

COLUMBIA COUNTY
FEBRUARY 2011

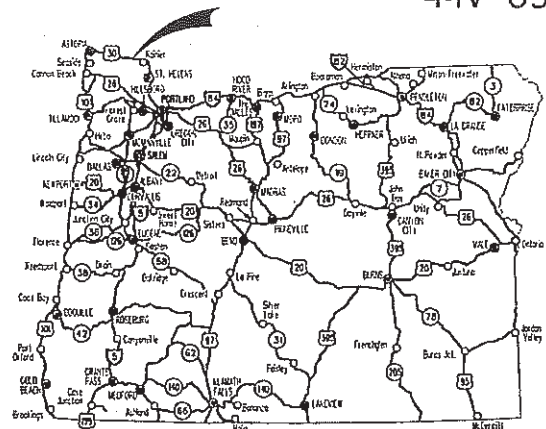

Overall Length Of Project - 0.27 Miles

ATTENTION:
Oregon Law Requires You To Follow Rules Adopted By The Oregon Utility Notification Center. Those Rules Are Set Forth In OAR 952-001-0010 Through OAR 952-001-0090. You May Obtain Copies Of The Rules By Calling The Center. (Note The Telephone Number For The Oregon Utility Center Is (503) 232-1987.)

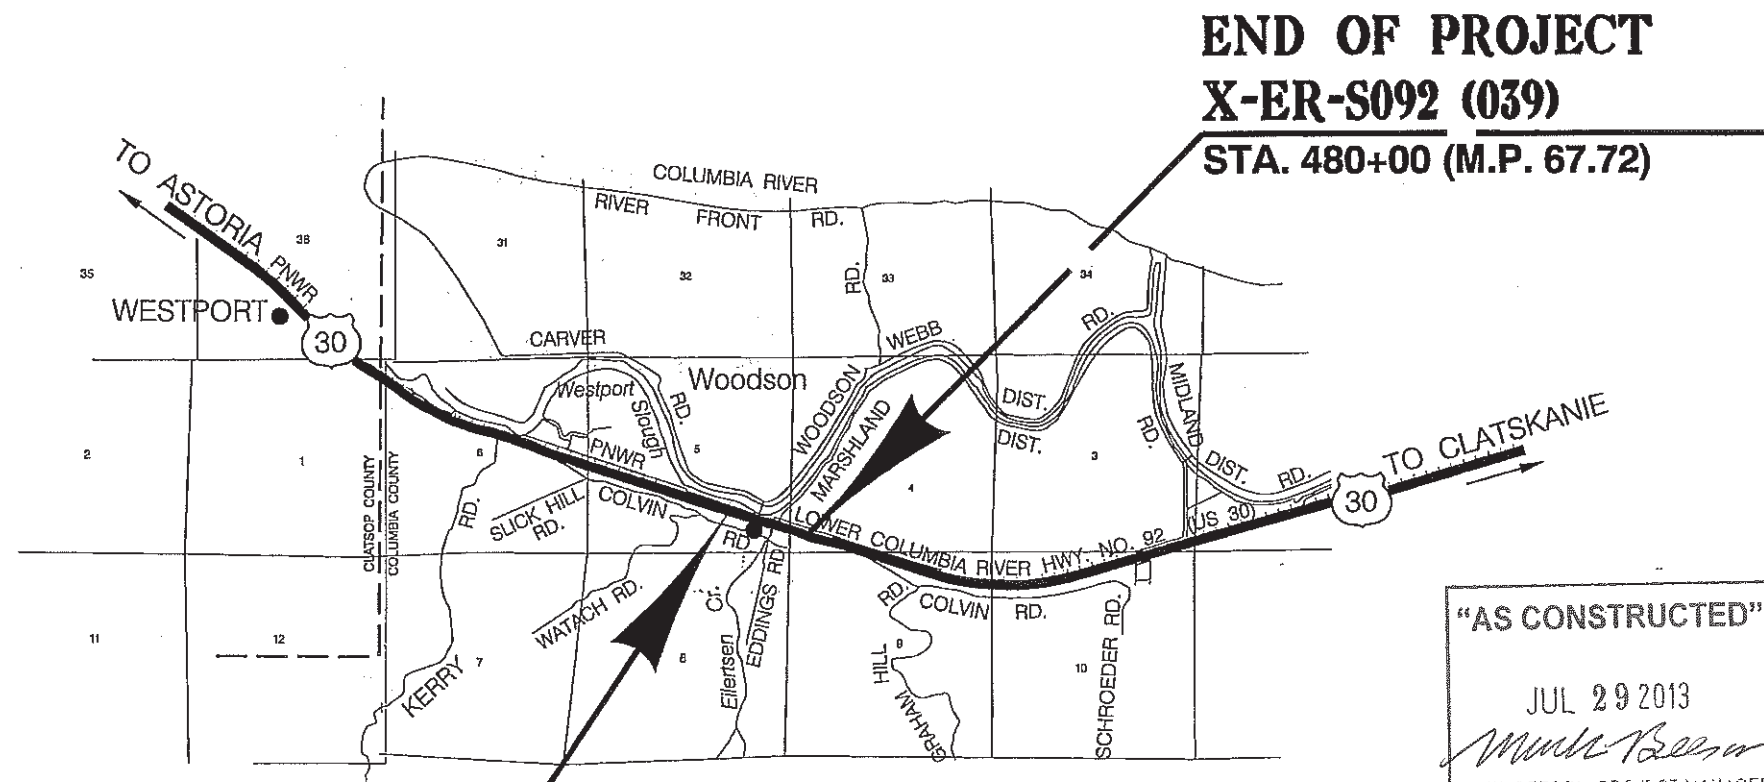

END OF PROJECT
X-ER-S092 (039)
STA. 480+00 (M.P. 67.72)

BEGINNING OF PROJECT
X-ER-S092 (039)
STA. 466+00 (M.P. 67.99)


"AS CONSTRUCTED"
JUL 29 2013
Mark Beeson
MARK BEESON, PROJECT MANAGER

T. 7 N., R. 5 W., W.M.




<p>OREGON TRANSPORTATION COMMISSION</p> <p>Gail Achterman CHAIR Michael Nelson VICE-CHAIR Mary F. Olson COMMISSIONER Alan Brown COMMISSIONER David Lohman COMMISSIONER Matthew L. Corraff DIRECTOR OF TRANSPORTATION</p>		
<p>PLANS PREPARED FOR ODOT BY:</p> <p>DAVID EVANS AND ASSOCIATES INC. 2100 Southwest River Parkway Portland Oregon 97201 Ph: 503.223.6663</p> <p>These plans were developed using ODOT design standards. Exceptions to these standards, if any, have been submitted and approved by the ODOT Chief Engineer or their delegated authority.</p>		
<p>Approving Authority: <i>[Signature]</i> 12-09-10 Signature & date</p>		<p>JEFFREY PARKER - PROJECT MANAGER Print name and title</p> <p><i>[Signature]</i> Concurrence by ODOT Chief Engineer</p>
<p>US 30 @ EILERTSEN CREEK PROJECT LOWER COLUMBIA RIVER HWY. COLUMBIA COUNTY</p>		
FEDERAL HIGHWAY ADMINISTRATION	PROJECT NUMBER	SHEET NO.
OREGON DIVISION	X-ER-S092 (039)	1

Sec. 5, T. 7N., R. 5W., W.M.

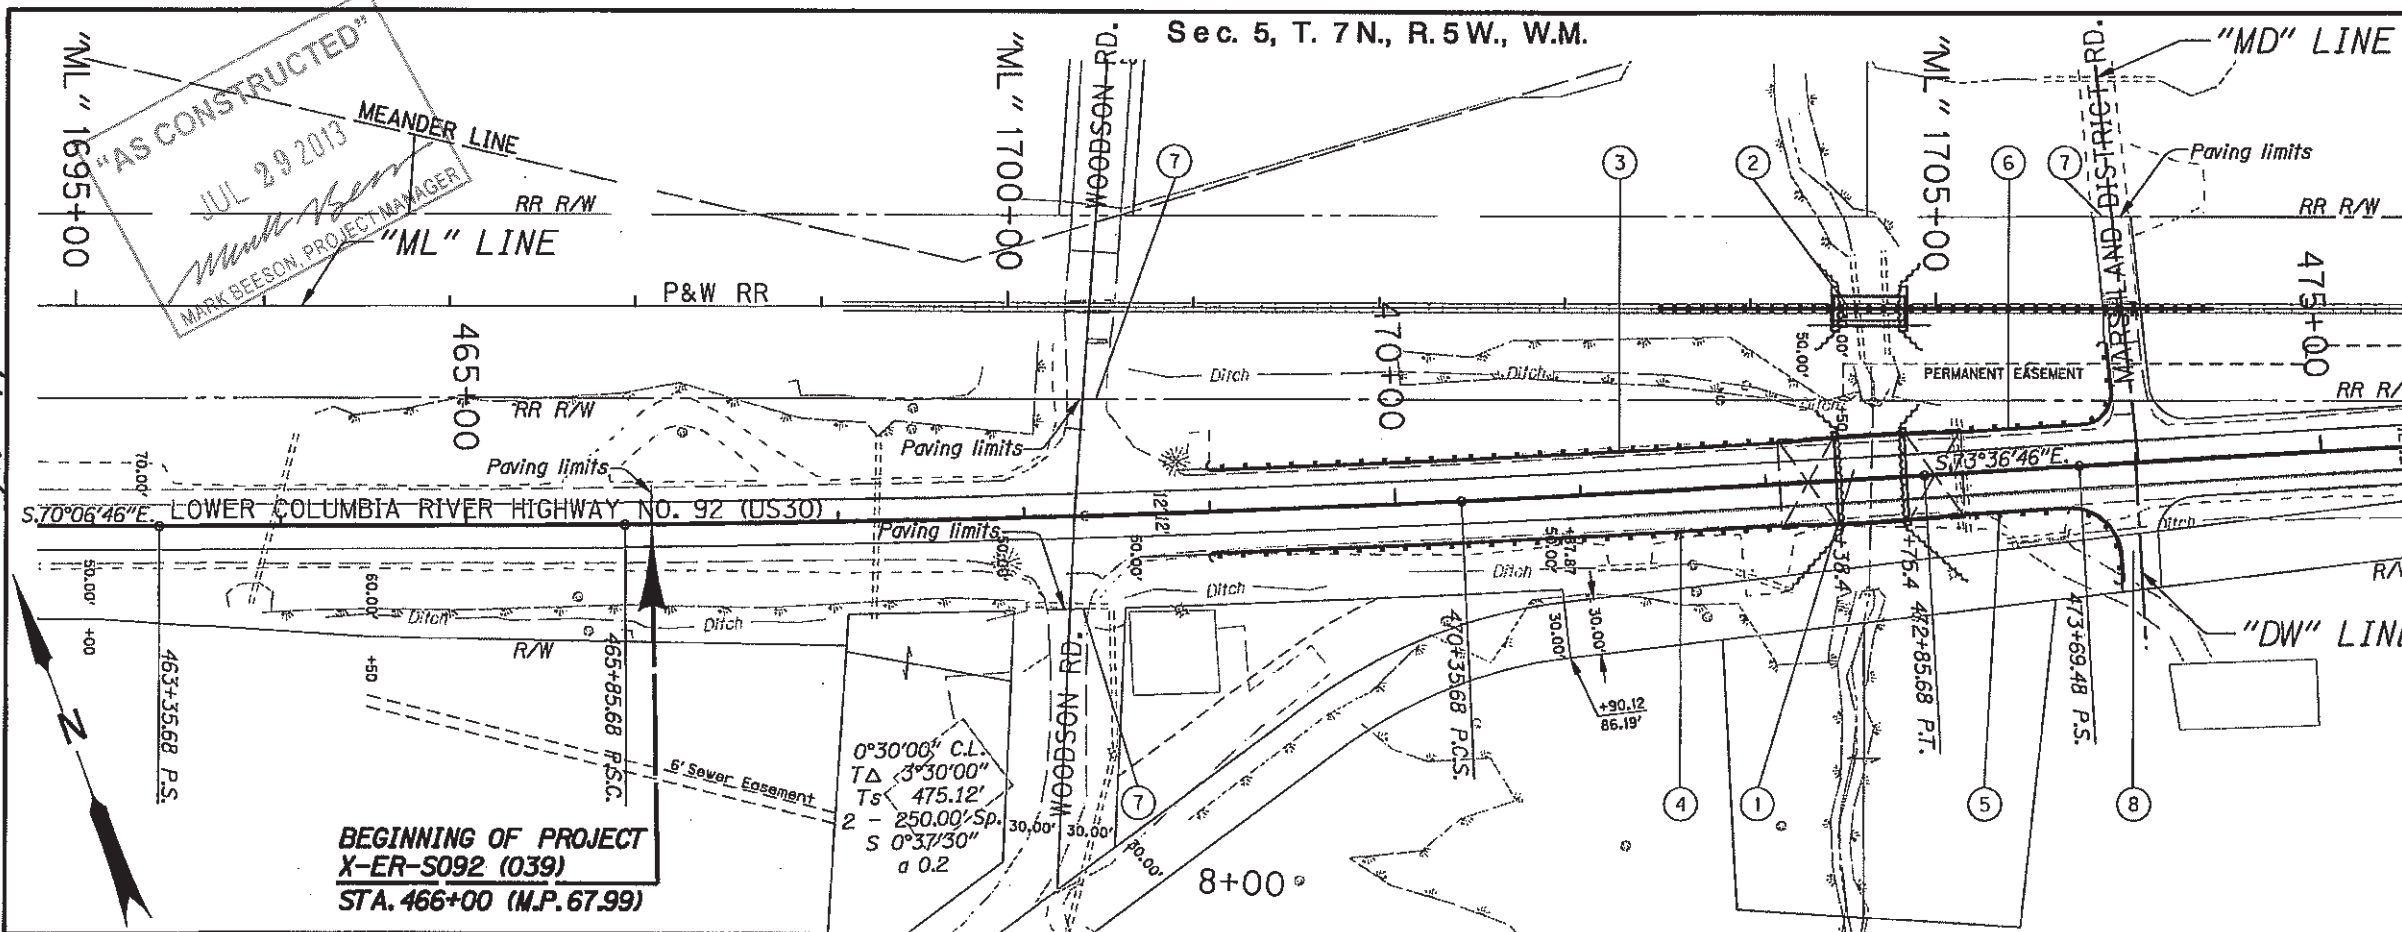

- ① Structure no. 21455
Remove exis. 8'x6' box culvert
Const. structure - 37'
Rdwy. width 45'-4"
and reinf. panel at bridge ends
(For drg. nos., see sht. 1A)
- ② Structure no. 21454
Remove pipes - (2-60" CMP)
Const. structure - 37'
(For drg. nos., see sht. 1A)
- ③ Sta. 469+01 to Sta. 472+07, Lt.
Const. guardrail - 237.5' (Type 2A)
Const. guardrail - 12.5' (Type 3)
Const. guardrail terminal, non-flared
Test level 3
Const. guardrail to bridge transition
(See drg. nos. RD400, RD405, RD410, RD415, RD420, RD440 & BR203)
- ④ Sta. 469+01 to Sta. 472+07, Rt.
Const. guardrail - 237.5' (Type 2A)
Const. guardrail - 12.5' (Type 3)
Const. guardrail terminal, non-flared
Test level 3
Const. guardrail to bridge transition
- ⑤ Sta. 473+06 to Sta. 473+94, Rt.
Const. guardrail - 37.5' (Type 2A)
Const. guardrail - 43.8' (Type 2A, mod.)
Const. guardrail - 12.5' (Type 3)
Const. anchor (Type 1, mod.)
Const. anchor (Type 5)
Const. guardrail to bridge transition
(See drg. no. RD450)
(For details, see shts. 2B-3 & 2B-4)
- ⑥ Sta. 473+06 to Sta. 473+88, Lt.
Const. guardrail - 31.3' (Type 2A)
Const. guardrail - 31.3' (Type 2A, mod.)
Const. guardrail - 12.5' (Type 3)
Const. guardrail terminal, non-flared
Test level 2
Const. anchor (Type 1, mod.)
Const. guardrail to bridge transition
(For details, see sht. 2B-3)
- ⑦ Const. street connection
(For details, see sht. 2B-2)
- ⑧ Const. appr.
(For details, see sht. 2B-2)

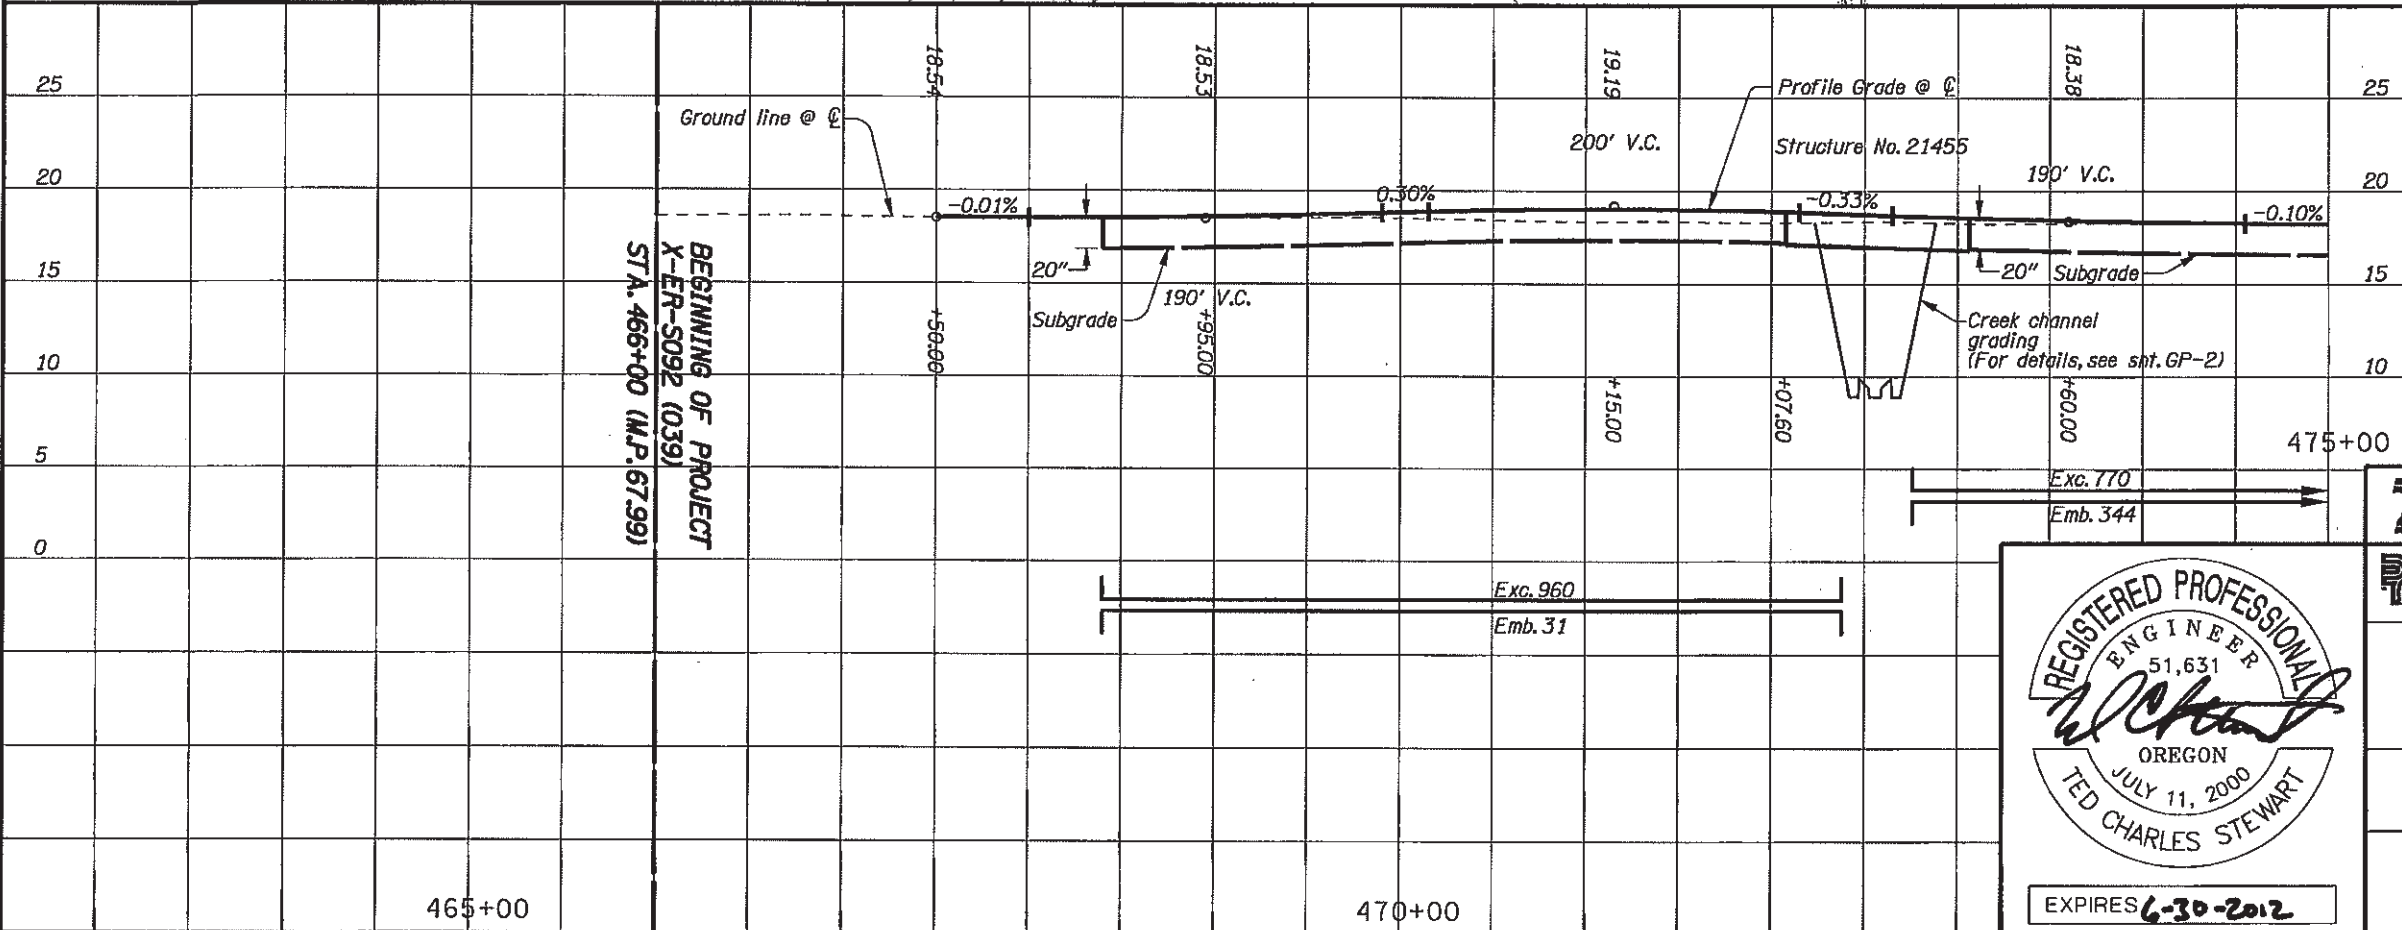

OREGON DEPARTMENT OF TRANSPORTATION

DAVID EVANS AND ASSOCIATES INC.
2100 Southwest River Parkway
Portland Oregon 97201 Ph: 503.223.6663

US 30 @ EILERTSEN CREEK PROJECT
LOWER COLUMBIA RIVER HWY.
COLUMBIA COUNTY


Reviewed By - **DYH**
Designed By - Ted Stewart
Drafted By - Mike Youngs

ALIGNMENT AND GENERAL CONSTRUCTION

SHEET NO. **3**

STRUCTURAL DETAILS CHECKED FOR A.M.P.C.

Sec. 5, T. 7 N., R. 5 W., W.M.

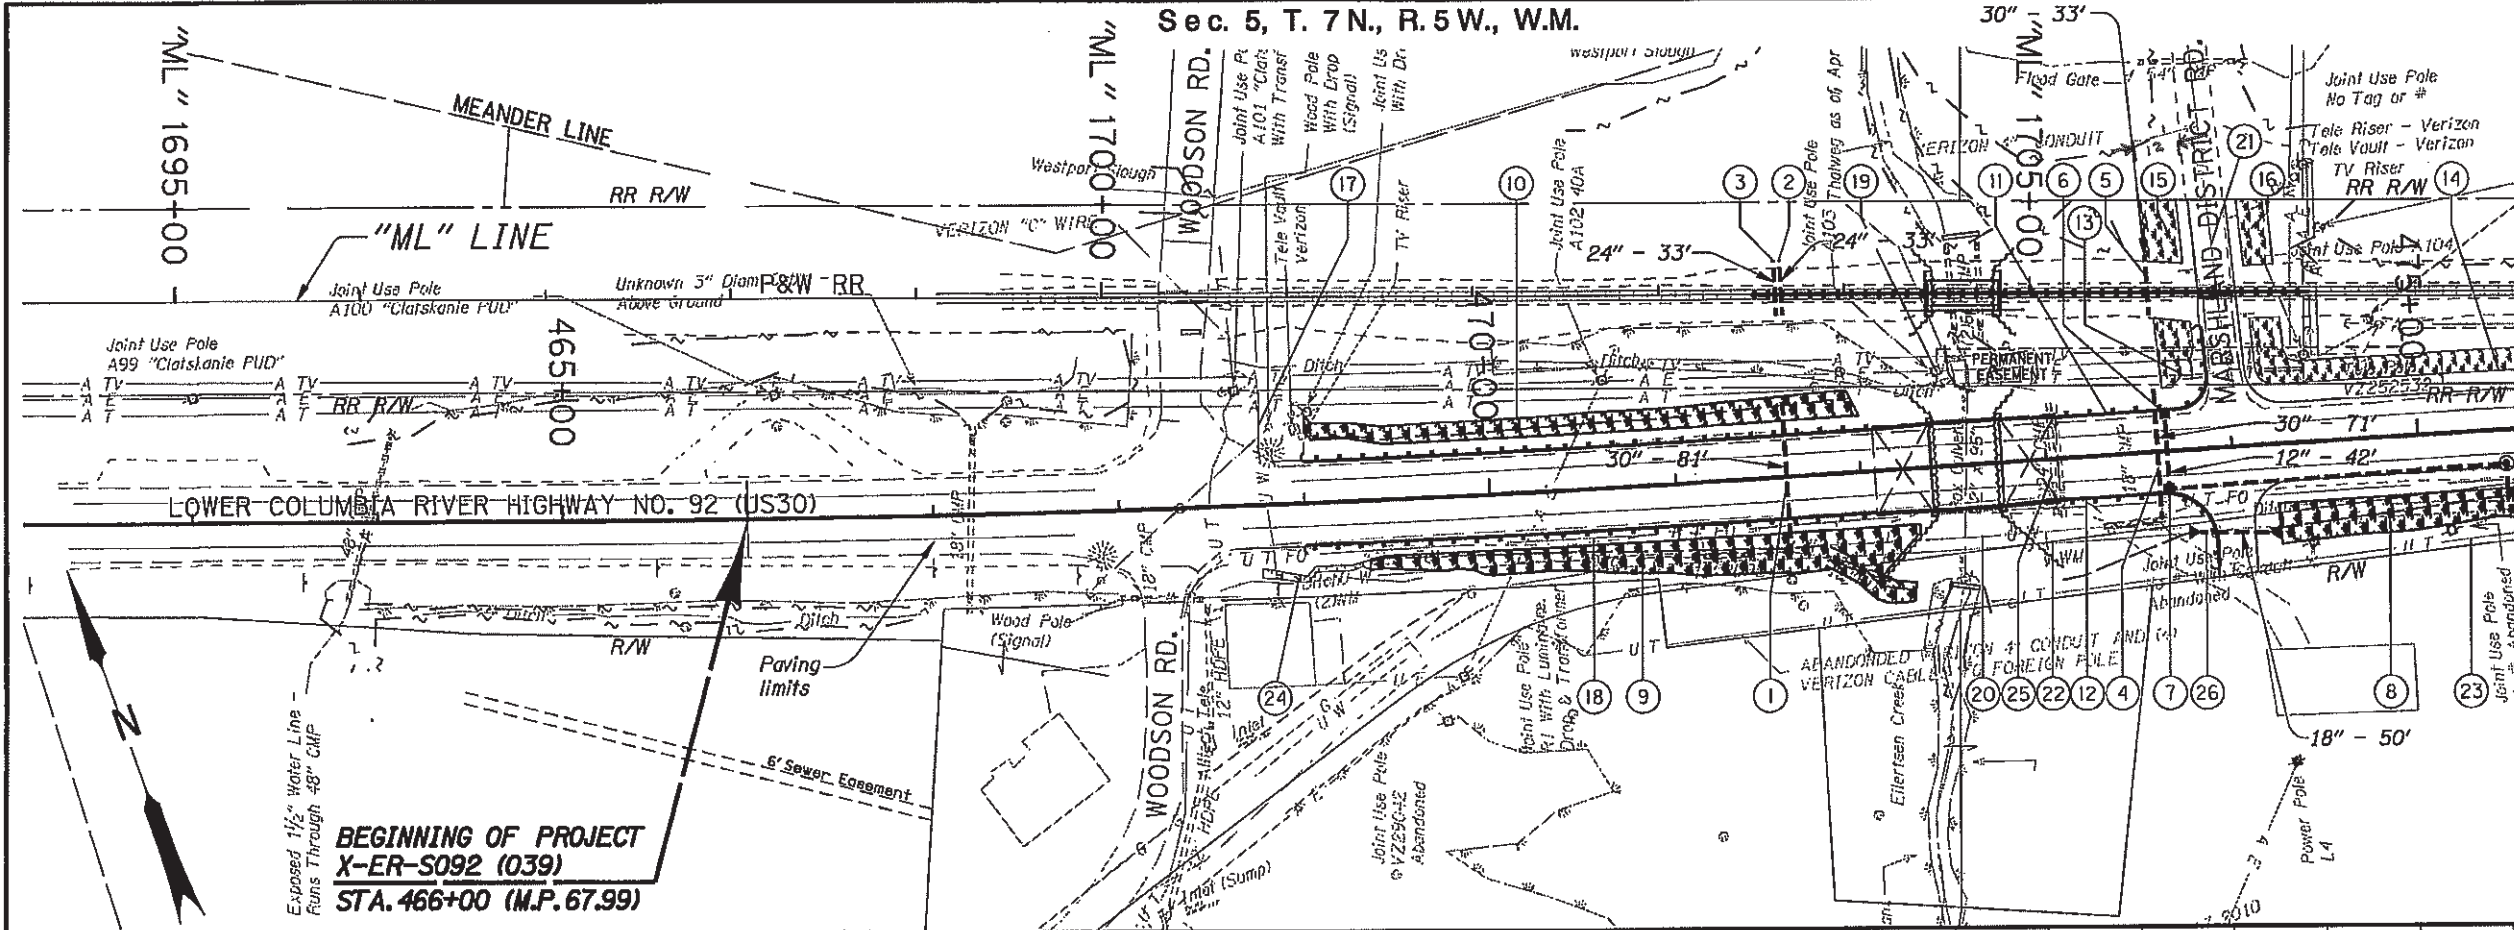


Filter strip Laid out Based on X-sections Approx. Top of Slope Min. 12'

"AS CONSTRUCTED"
 JUL 29 2013
 MARK BEESON, PROJECT MANAGER

Ordinary high water line shown thus: ~ ~ ~ ~
 Abandon extg. storm sew. pipe shown thus: ~ ~ ~ ~

Note: Utility engineering performed by Convergent Pacific.

BEGINNING OF PROJECT X-ER-S092 (039) STA. 466+00 (M.P. 67.99)

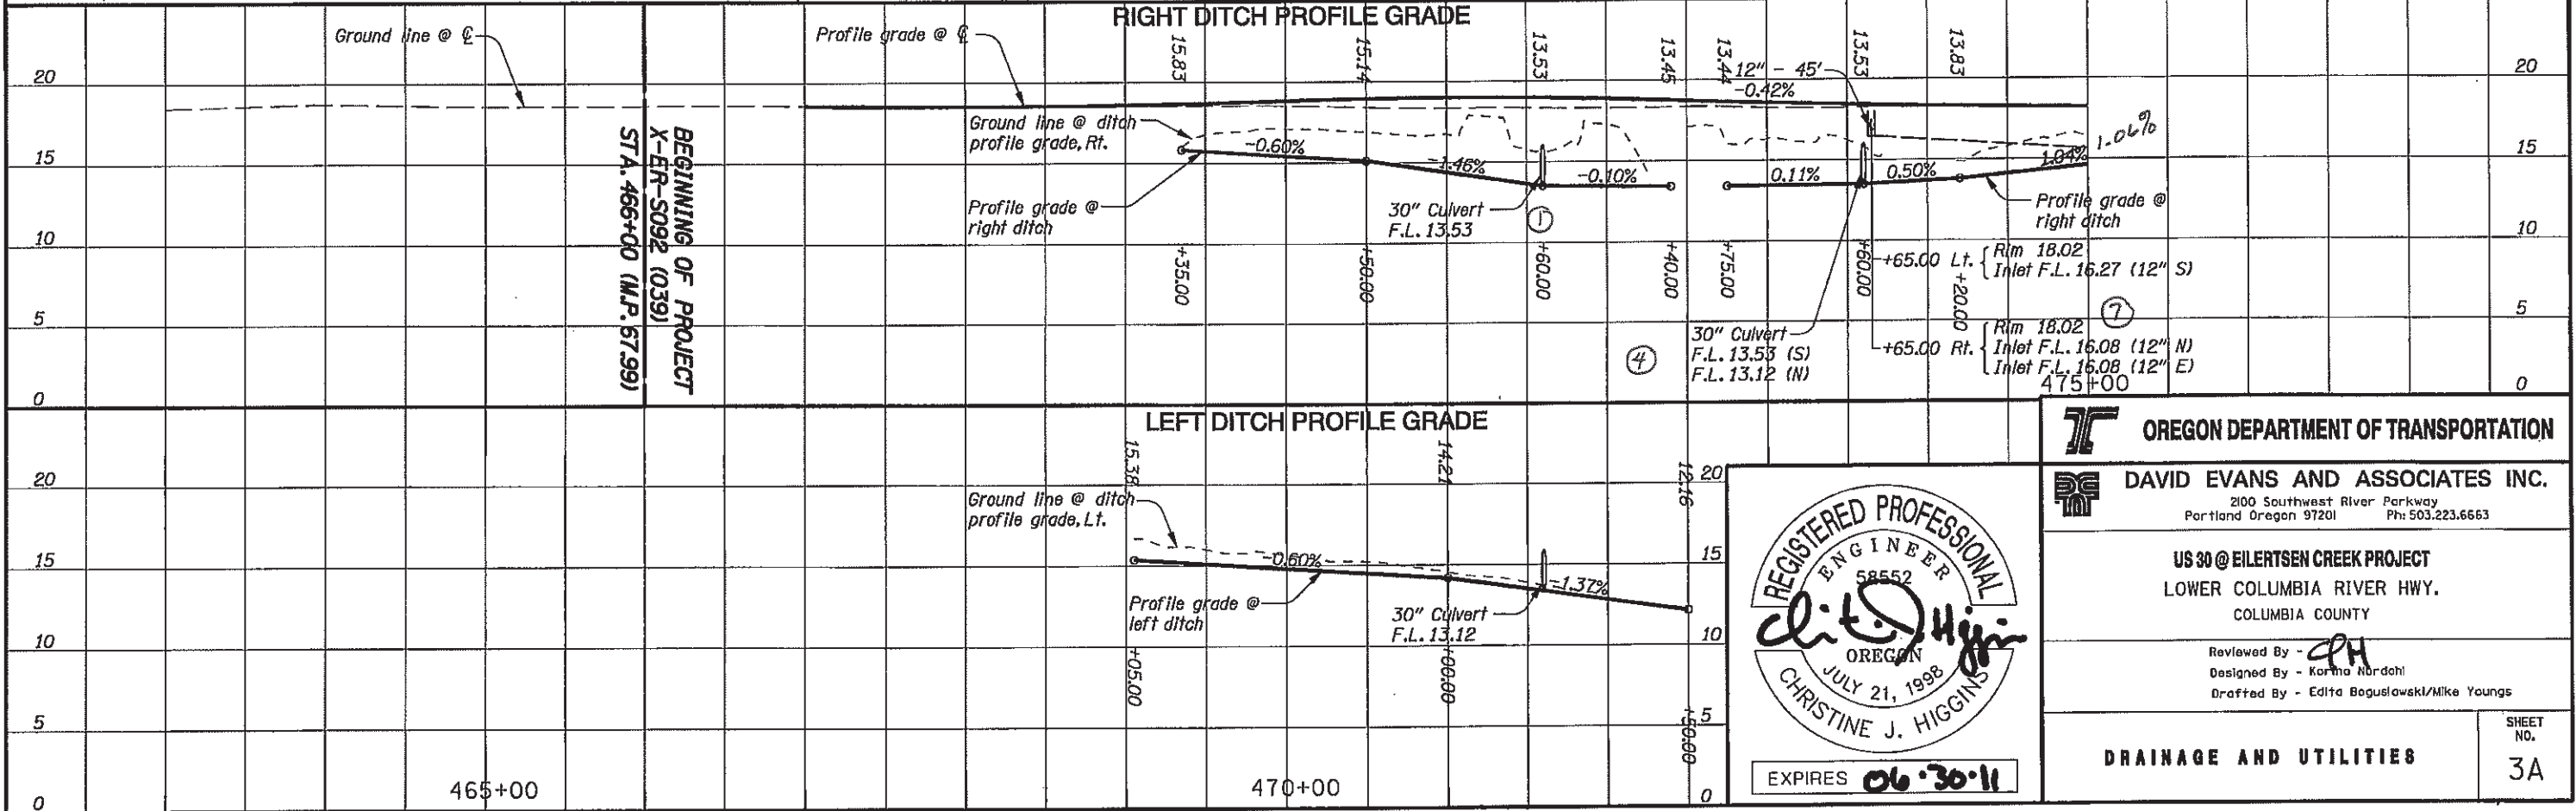

OREGON DEPARTMENT OF TRANSPORTATION

DAVID EVANS AND ASSOCIATES INC.
 2100 Southwest River Parkway
 Portland Oregon 97201 Ph: 503.223.6663

US 30 @ EILERTSEN CREEK PROJECT
 LOWER COLUMBIA RIVER HWY.
 COLUMBIA COUNTY

Reviewed By - *CPH*
 Designed By - Kormia Nordahl
 Drafted By - Edita Boguslawski/Mike Youngs


DRAINAGE AND UTILITIES

SHEET NO. **3A**

- ① Sta. 471+60.00, 39.90' Rt. to 40.50' Lt.
Inst. 30" culv. pipe - 81'
5' depth
Const. paved end slopes Lt. and Rt. - 94 SF
(See drg. nos. RD300 & RD320)
- ② Sta. 471+60.00, 86.90' Lt. to 116.80' Lt.
Inst. 24" culv. pipe - 33'
5' depth
F.L. 12.34 (24" S)
F.L. 12.18 (24" N)
Const. paved end slopes Lt. - 74 SF
- ③ Sta. 471+63.00, 86.90' Lt. to 116.80' Lt.
Inst. 24" culv. pipe - 33'
5' depth
F.L. 12.34 (24" S)
F.L. 12.18 (24" N)
Const. paved end slopes Lt. - 74 SF
- ④ Sta. 473+60.00, 36.10' Lt. to 34.10' Lt.
Inst. 30" ductile iron pipe - 71'
5' depth
Const. paved end slopes Lt. & Rt. - 94 SF
- ⑤ Sta. 473+60.00, 74.00' Lt. to 106.20' Lt.
Inst. 30" culv. pipe - 33'
5' depth
F.L. 11.34 (30" S)
F.L. 11.18 (30" N)
Const. paved end slopes Lt. - 94 SF
- ⑥ Sta. 473+65.00, Lt.
Const. type "G-2" inlet
(See drg. no. RD364)
- ⑦ Sta. 473+65.00, Rt.
Const. type "G-2" inlet
Inst. 12" ductile iron pipe - 42'
5' depth
(See drg. no. RD300)
- ⑧ Sta. 474+23.55 Rt. to Sta. 475+50.00 Rt.
Const. biofiltration swale - 42.9 Cu.Yd.
Inst. delineators, type S1-2
Inst. delineators, type S2-2
(For details, see shts. GJ & GJ-2)
- ⑨ Sta. 469+35.00 Rt. to Sta. 472+33.72 Rt.
Const. biofiltration swale - 96.9 Cu.Yd.
Inst. delineators, type S1
Inst. delineators, type S2
(For details, see shts. GJ & GJ-2)
- ⑩ Sta. 469+05.00 Lt. to Sta. 472+07.00 Lt.
Const. biofiltration swale - 59.3 Cu.Yd.
Inst. delineators, type S1-2
(For details, see sht. GJ & GJ-2)
- ⑪ Sta. 473+06.94 Lt. to Sta. 473+67.00 Lt.
Inst. drainage curb - 60'
(See drg. no. RD701)
- ⑫ Sta. 473+06.92 Rt. to Sta. 473+67.00 Rt.
Inst. drainage curb - 60'
- ⑬ Sta. "MD" 11+29.00 Rt. to Sta. "MD" 11+75.00 Rt.
Const. filter strip - 11.2 Cu.Yd.
Inst. delineators, Type S1
(For details, see shts. GJ & GJ-2)
- ⑭ Sta. "MD" 11+34.50 Lt. to Sta. 475+69.50 Lt.
Const. filter strip - 41.3 Cu.Yd.
Inst. delineators, type S1
(For details, see sht. GJ & GJ-2)
- ⑮ Sta. "MD" 10+97.50 Rt. to Sta. "MD" 10+64.50 Rt.
Const. filter strip - 11.9 Cu.Yd.
Inst. delineators, type S1
(For details, see sht. GJ & GJ-2)
- ⑯ Sta. "MD" 11+03.60 Lt. to Sta. "MD" 10+77.50 Lt.
Const. filter strip - 10.6 Cu.Yd.
Inst. delineators, type S1
(For details, see shts. GJ & GJ-2)
- ⑰ Protect extg. waterline
- ⑱ Relocate fiber optics line (by others)
- ⑲ Relocate power pole (by others)
- ⑳ Abandon waterline
- ㉑ Abandon communication line
- ㉒ Relocate gas line (by others)
- ㉓ Abandon communication line
- ㉔ Sta. 468+76.34 Rt. to Sta. 469+35.00 Rt.
Const. filter strip - 4 Cu.Yd.
Inst. delineators, type S1
Inst. delineators, type S2
(For details, see sht. GJ & GJ-2)
- ㉕ Salvage and stockpile 24 inch pipe - 120'
- ㉖ Sta. 473+74.00, 44.42 Rt. to Sta. 474+23.55, 46.88 Rt.
Inst. 18" culv. pipe - 50'
5' depth
Const. paved end slopes Rt. - 88 SF

"AS CONSTRUCTED"
 JUL 29 2013
 Mark Beeson
 MARK BEESON, PROJECT MANAGER


Revisions	
⚠	Revised 1-24-2011 Changed quantity of delineators, clarified paved end slopes

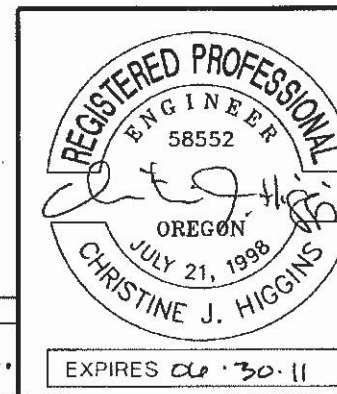

OREGON DEPARTMENT OF TRANSPORTATION	
DAVID EVANS AND ASSOCIATES INC. 2100 Southwest River Parkway Portland Oregon 97201 Ph: 503.223.6663	
US 30 @ EILERTSEN CREEK PROJECT LOWER COLUMBIA RIVER HWY. COLUMBIA COUNTY	
Reviewed By - Designed By - Korlno Nardoni Drafted By - Edita Baguslawski/Mike Youngs	
DRAINAGE AND UTILITY NOTES	SHEET NO. 3A-2

Sec. 5, T. 7N., R. 5W., W.M.



BEGINNING OF PROJECT
X-ER-S092 (039)
STA. 466+00 (M.P. 67.99)

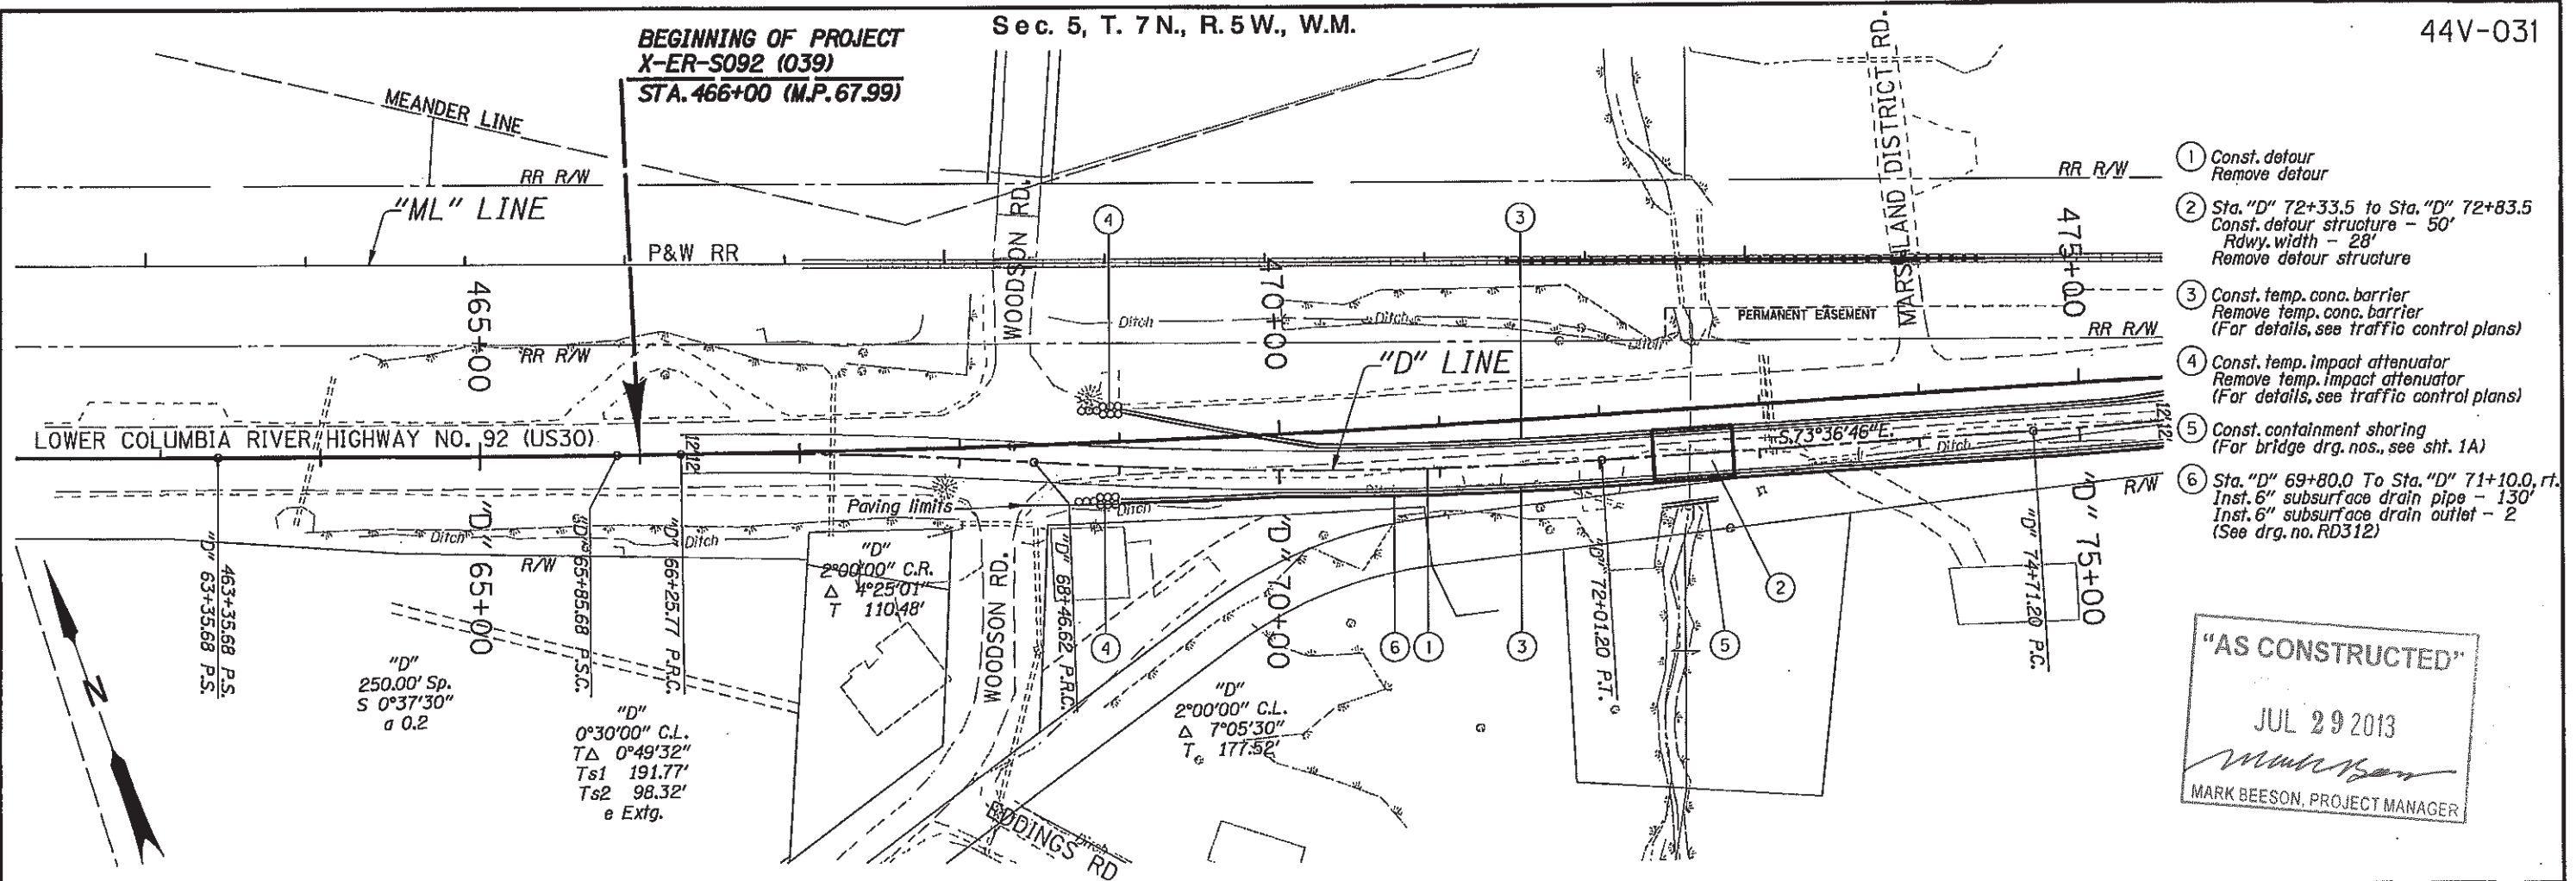

- 1 Const. detour
Remove detour
- 2 Sta. "D" 72+33.5 to Sta. "D" 72+83.5
Const. detour structure - 50'
Rdwy. width - 28'
Remove detour structure
- 3 Const. temp. conc. barrier
Remove temp. conc. barrier
(For details, see traffic control plans)
- 4 Const. temp. impact attenuator
Remove temp. impact attenuator
(For details, see traffic control plans)
- 5 Const. containment shoring
(For bridge drg. nos., see sht. 1A)
- 6 Sta. "D" 69+80.0 To Sta. "D" 71+10.0, rt.
Inst. 6" subsurface drain pipe - 130'
Inst. 6" subsurface drain outlet - 2
(See drg. no. RD312)

"AS CONSTRUCTED"
 JUL 29 2013

 MARK BEESON, PROJECT MANAGER

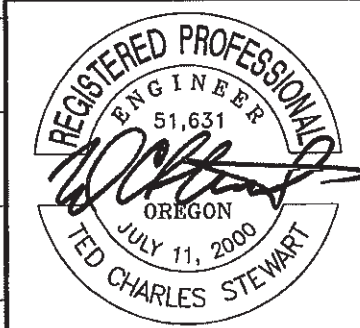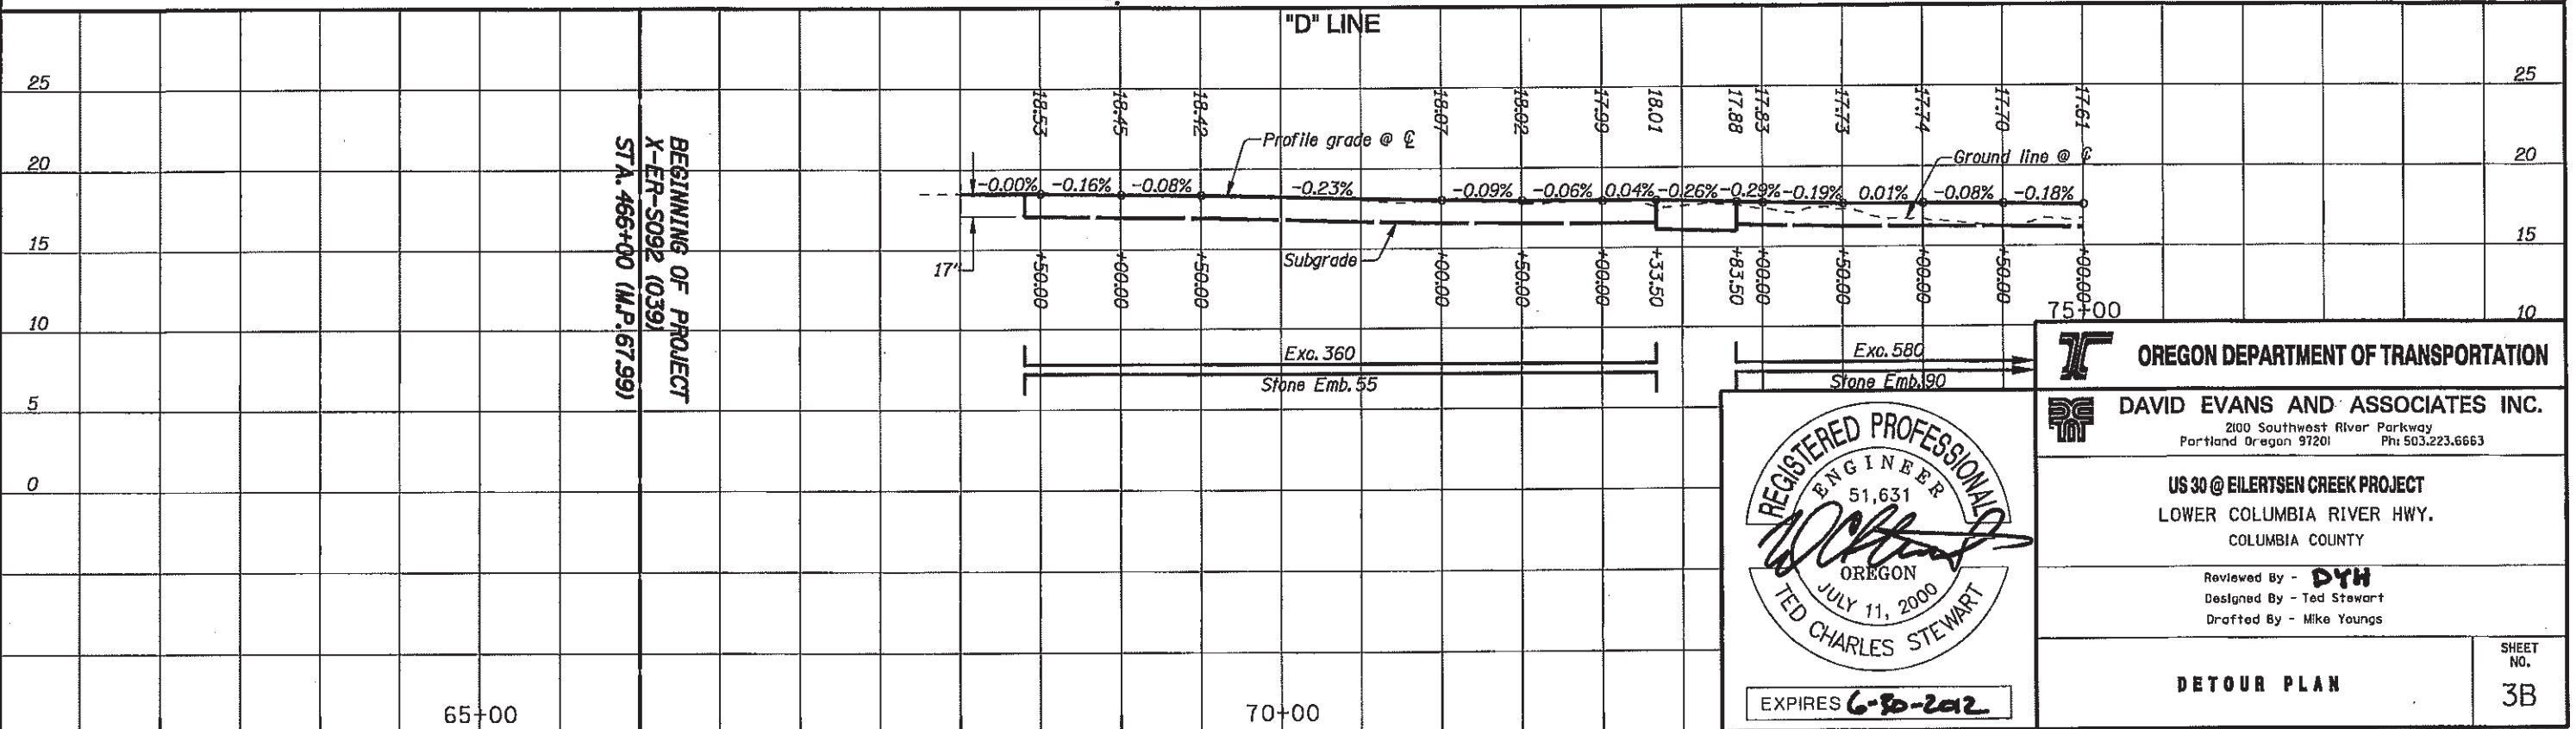

OREGON DEPARTMENT OF TRANSPORTATION

DAVID EVANS AND ASSOCIATES INC.
 2100 Southwest River Parkway
 Portland Oregon 97201 Ph: 503.223.6663

US 30 @ EILERTSEN CREEK PROJECT
 LOWER COLUMBIA RIVER HWY.
 COLUMBIA COUNTY


Reviewed By - **DYH**
 Designed By - Ted Stewart
 Drafted By - Mike Youngs

DETOUR PLAN



SHEET NO.
3B

STRUCTURAL DETAILS CHECKED

T. 7 N., R. 5 W., W.M.

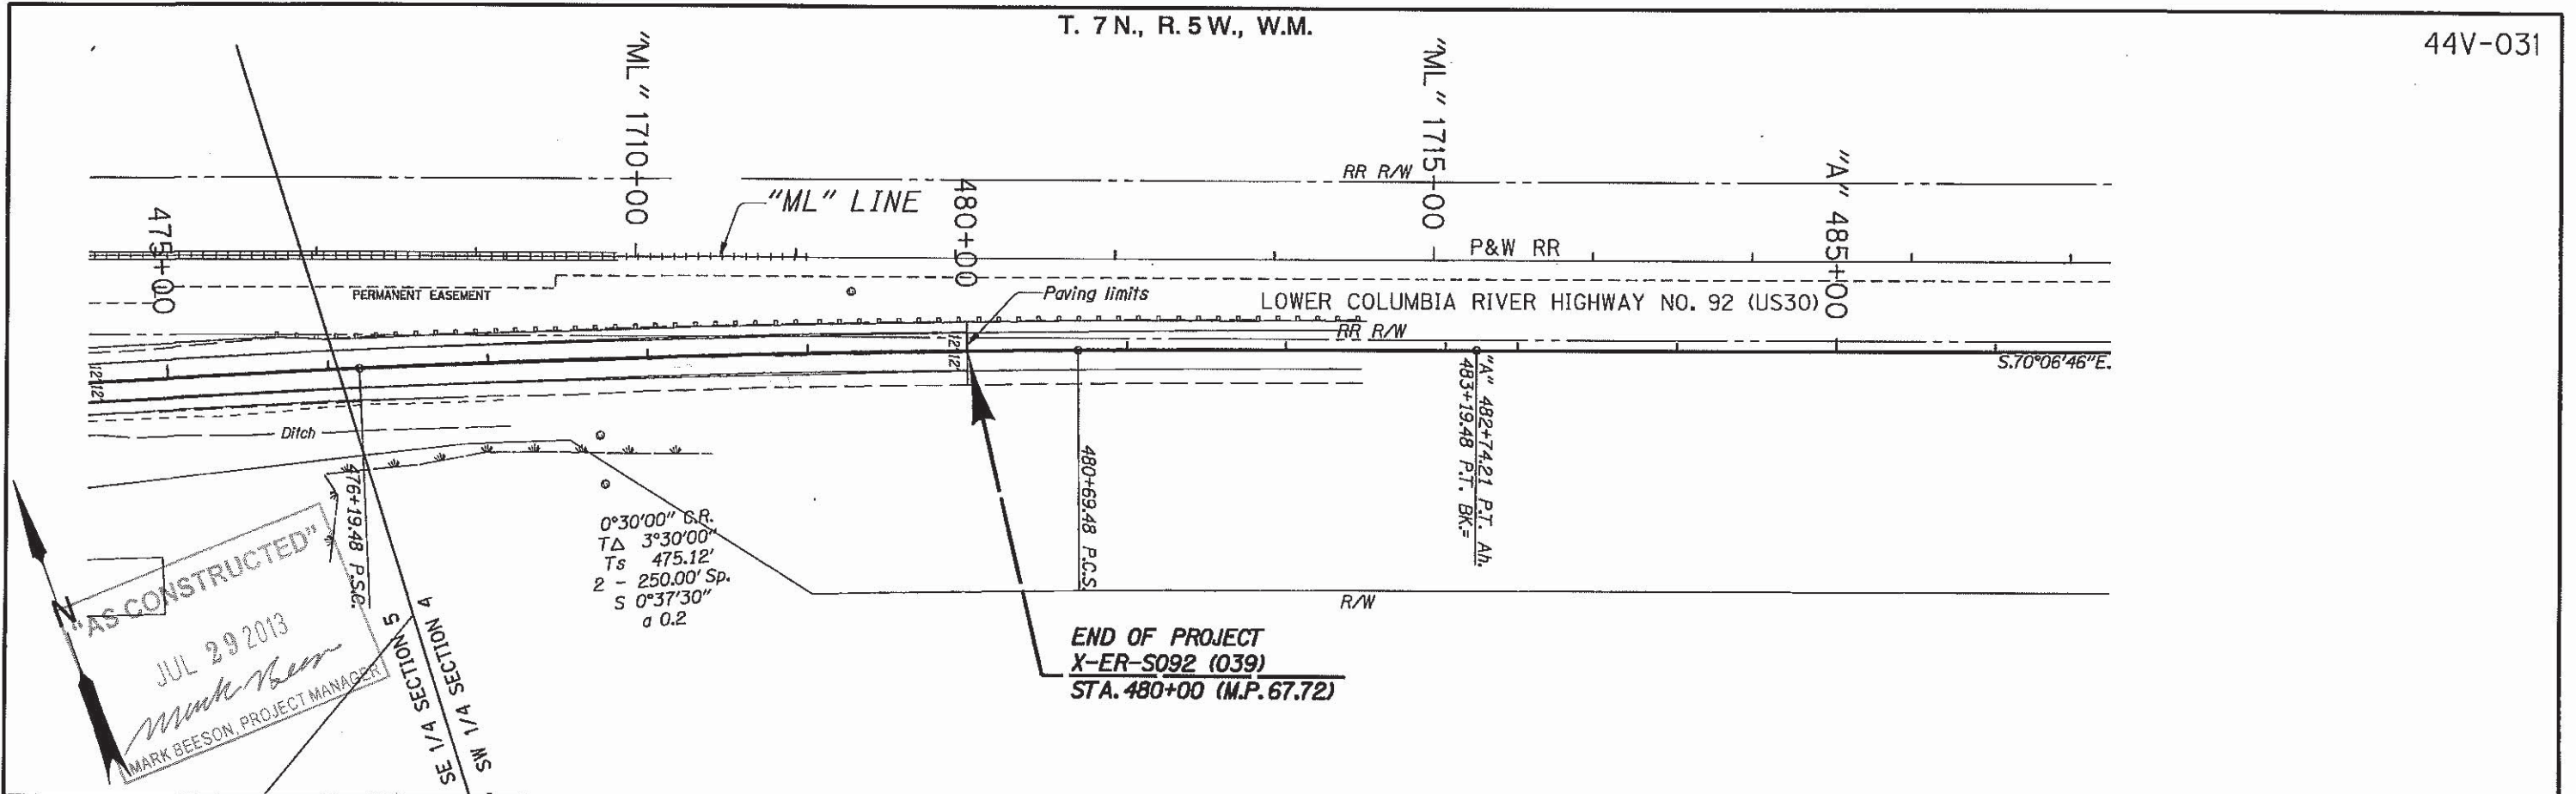

END OF PROJECT
X-ER-S092 (039)
STA. 480+00 (M.P. 67.72)

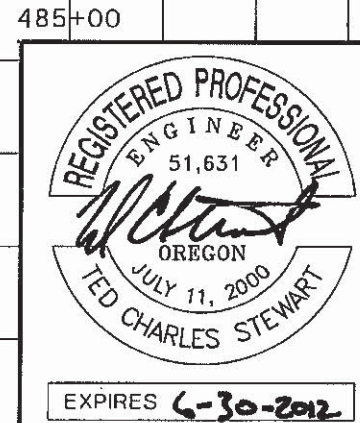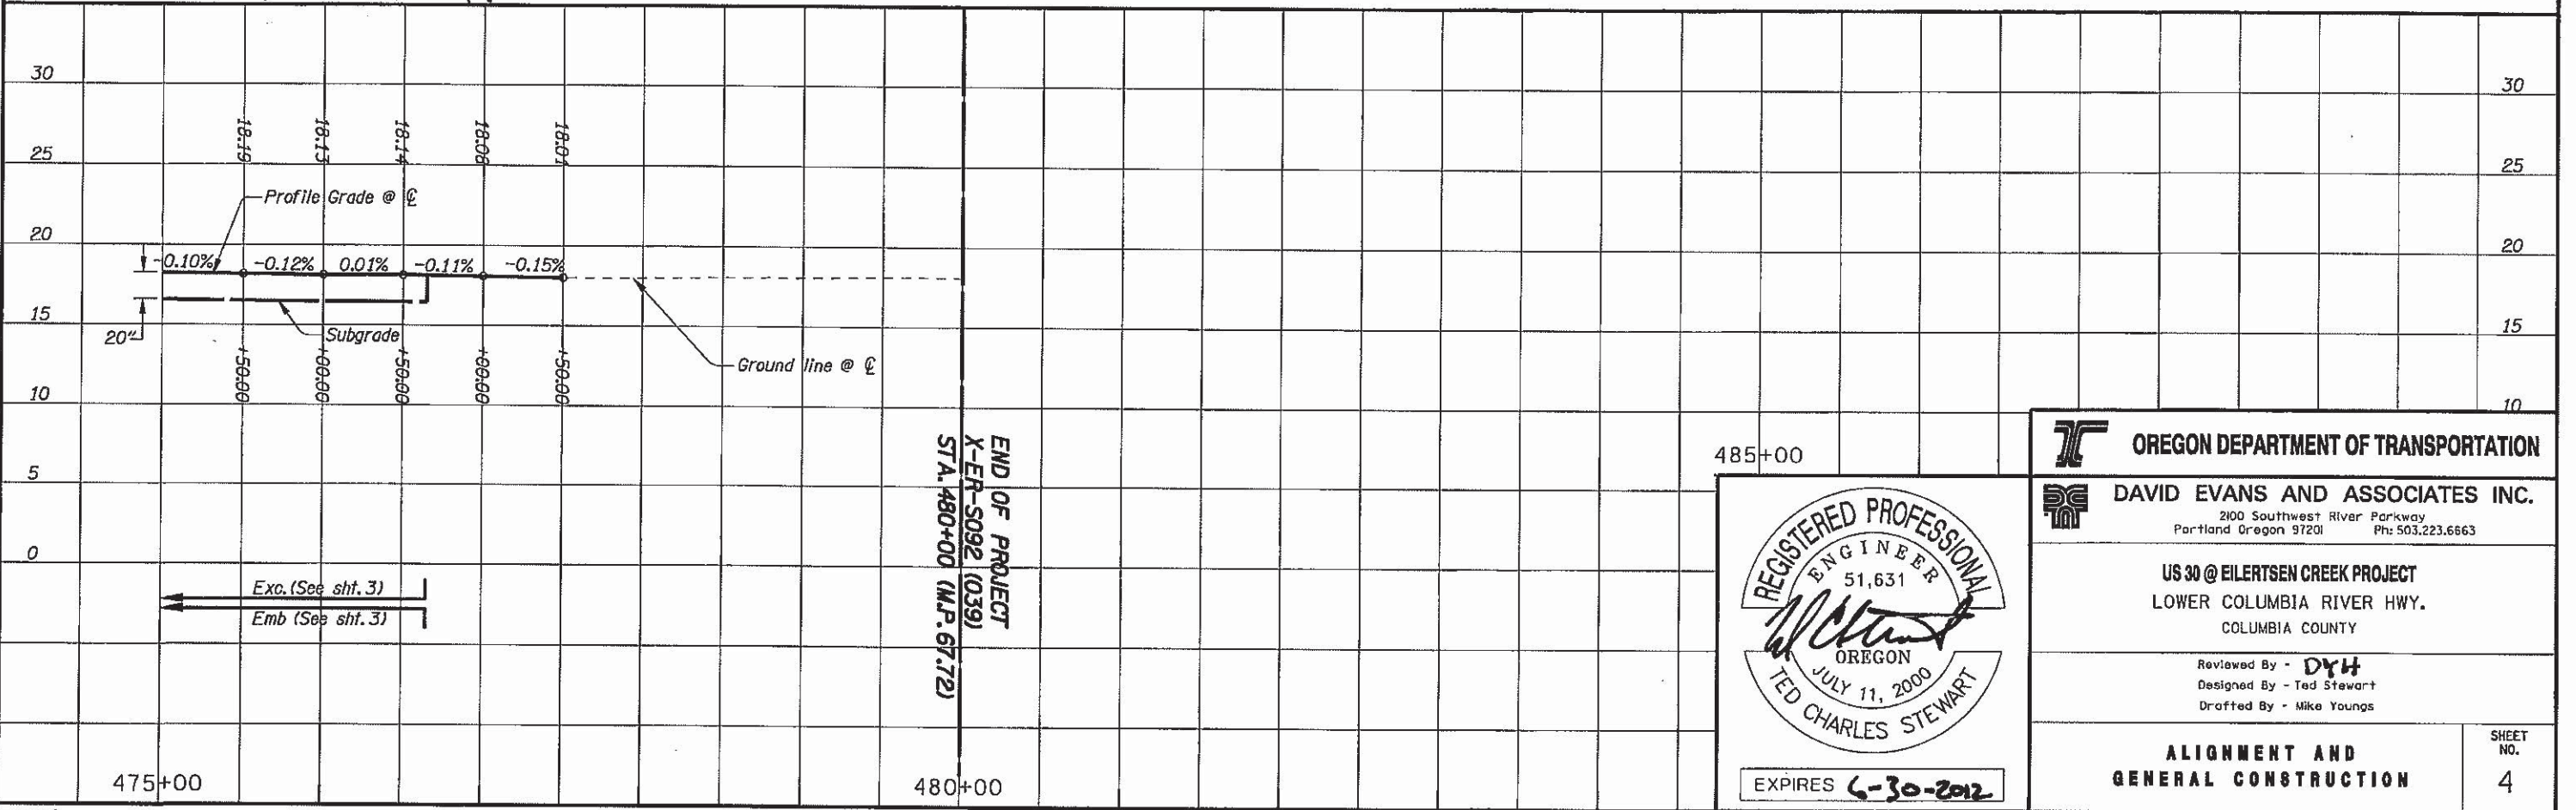


OREGON DEPARTMENT OF TRANSPORTATION
DAVID EVANS AND ASSOCIATES INC.
 2100 Southwest River Parkway
 Portland Oregon 97201 Ph: 503.223.6663

US 30 @ EILERTSEN CREEK PROJECT
 LOWER COLUMBIA RIVER HWY.
 COLUMBIA COUNTY



Reviewed By - **DYH**
 Designed By - Ted Stewart
 Drafted By - Mike Youngs

ALIGNMENT AND GENERAL CONSTRUCTION

SHEET NO. **4**

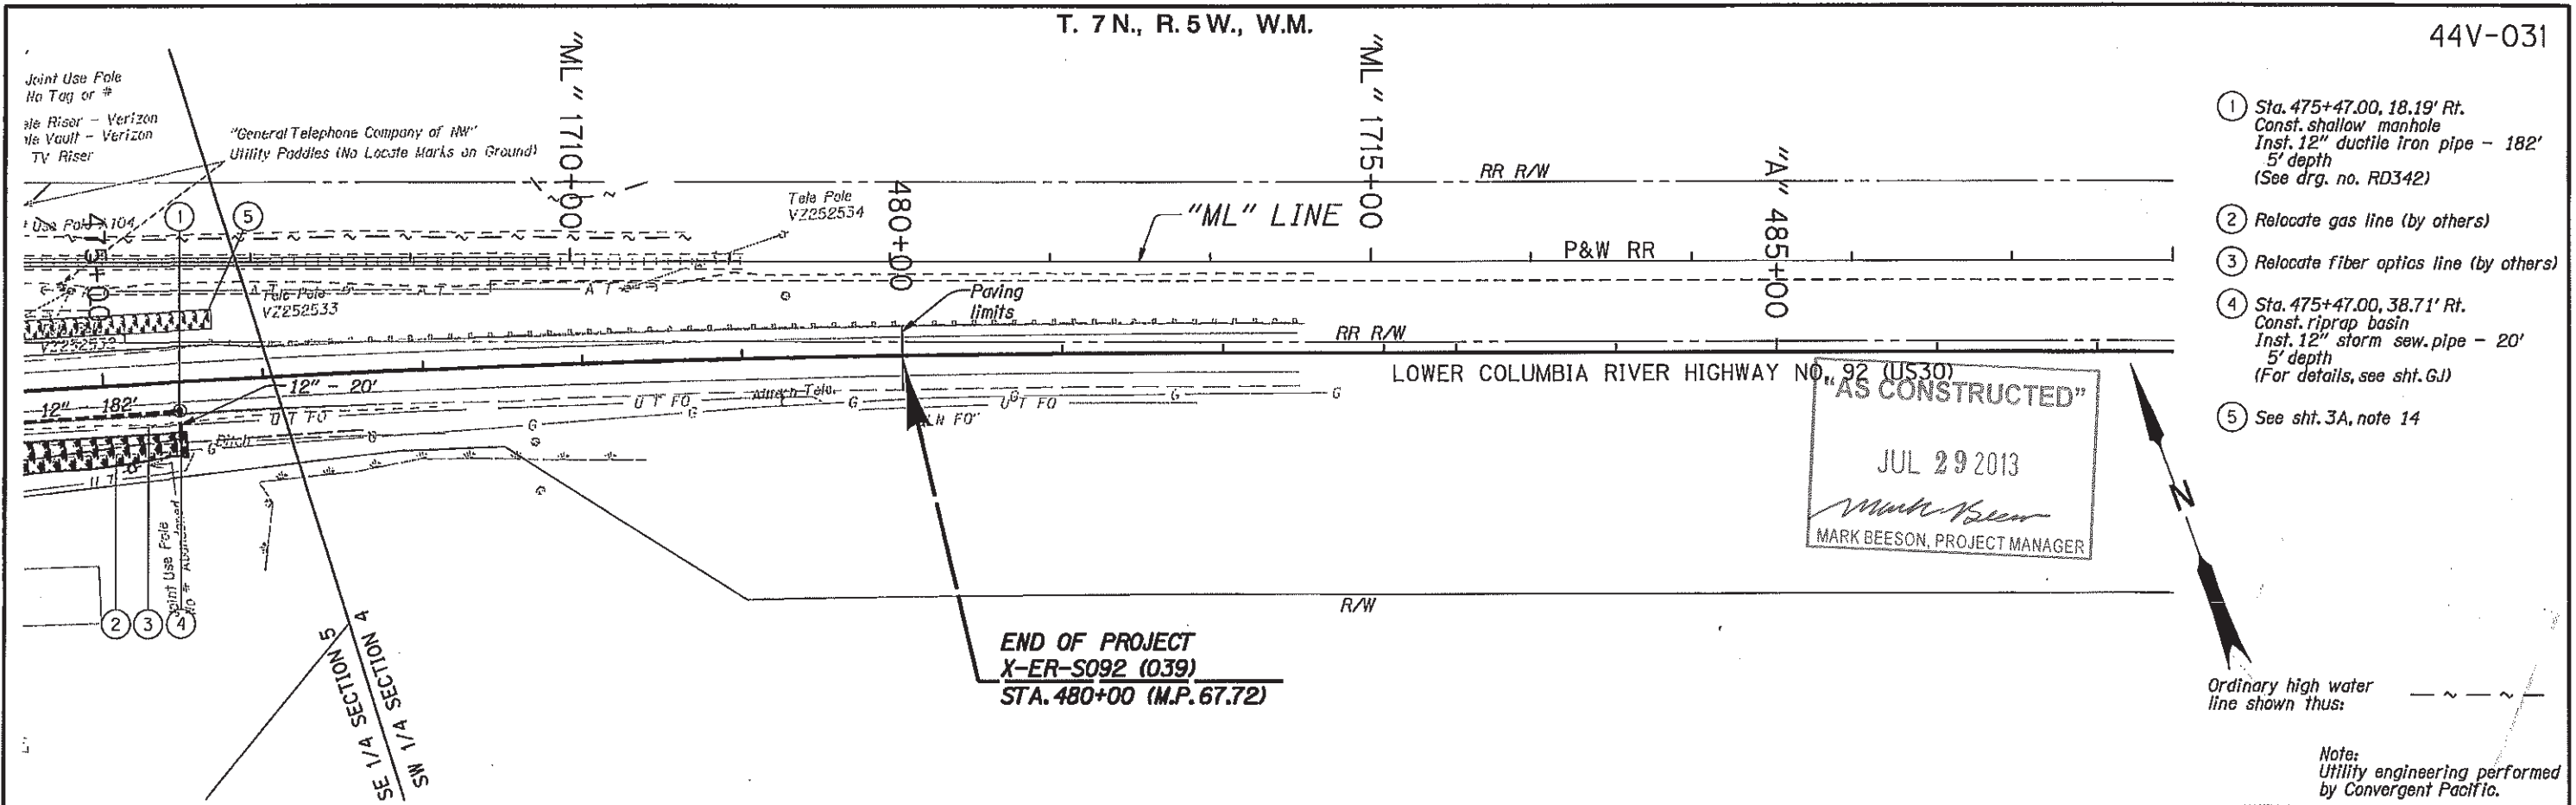

RIGHT DITCH PROFILE GRADE

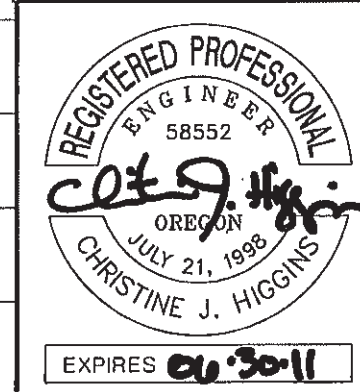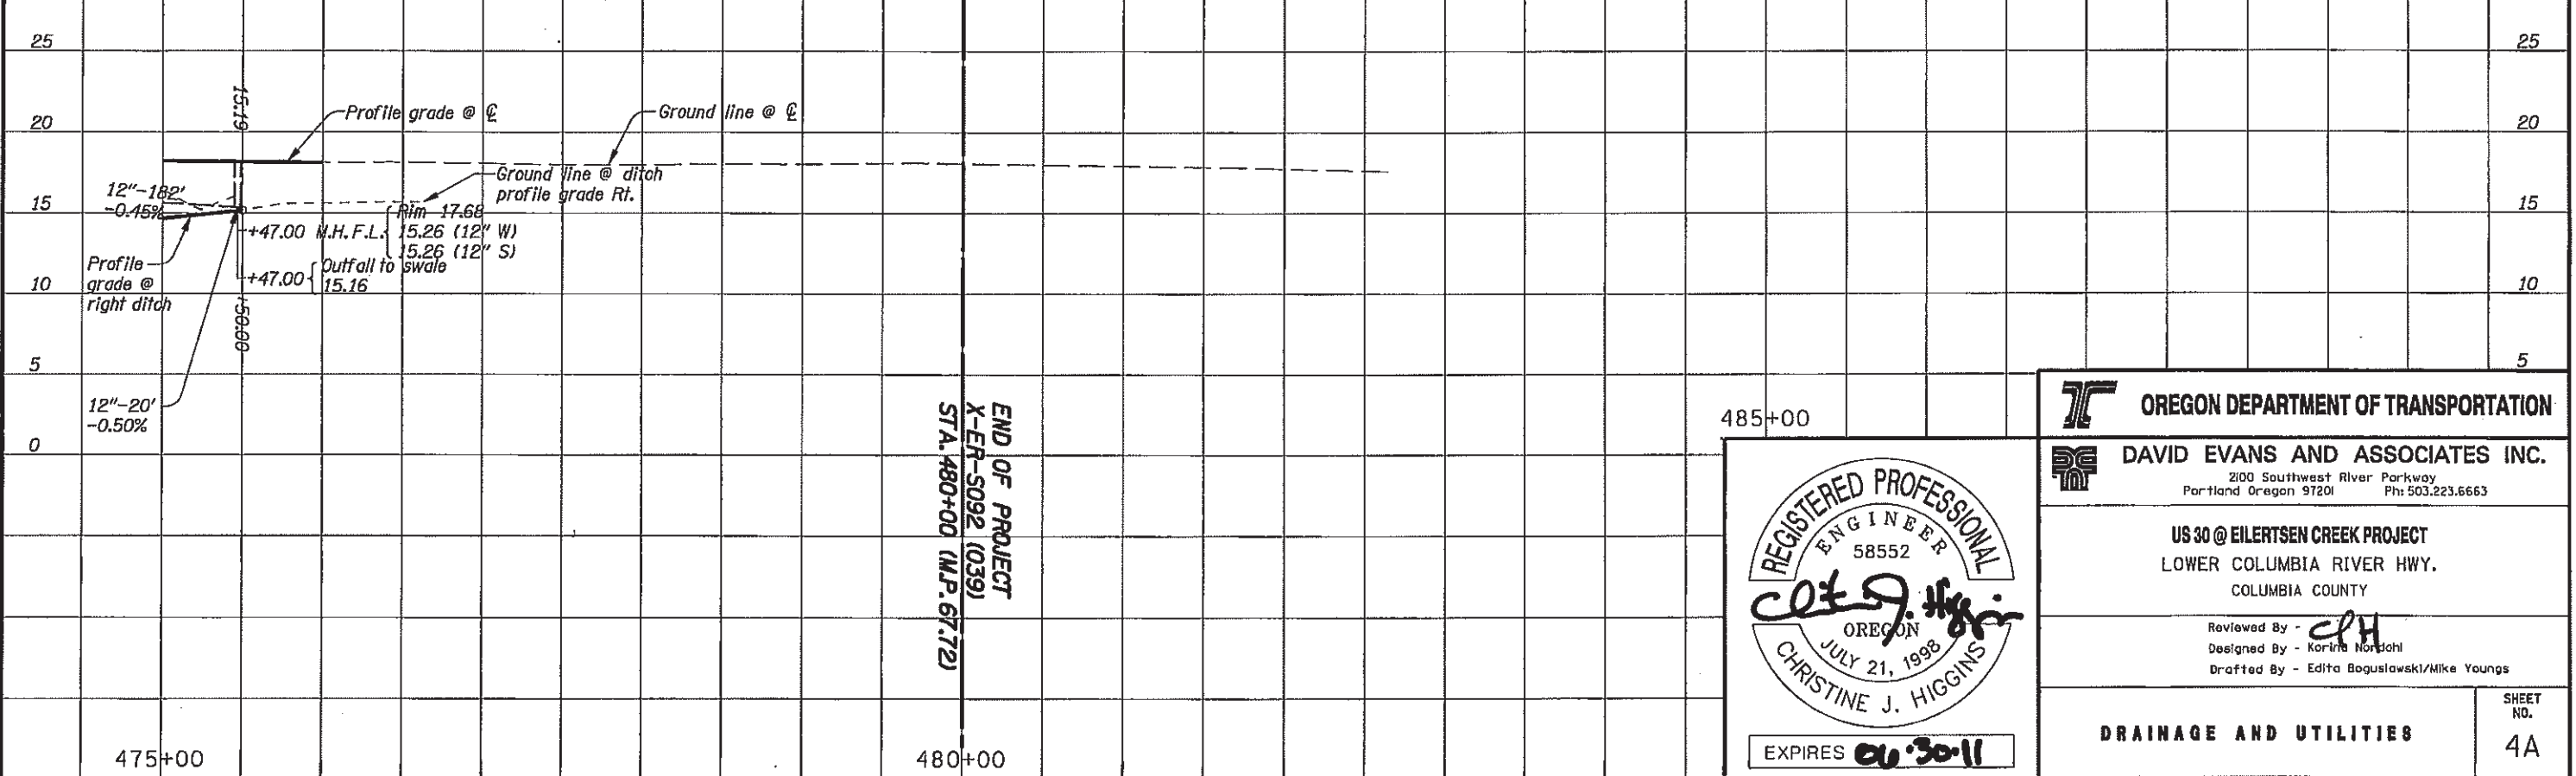

OREGON DEPARTMENT OF TRANSPORTATION


DAVID EVANS AND ASSOCIATES INC.
 2100 Southwest River Parkway
 Portland Oregon 97201 Ph: 503.223.6663

US 30 @ EILERTSEN CREEK PROJECT
 LOWER COLUMBIA RIVER HWY.
 COLUMBIA COUNTY

Reviewed By - *CPH*
 Designed By - Korina Nordahl
 Drafted By - Edita Boguslawski/Mike Youngs


DRAINAGE AND UTILITIES

SHEET NO. **4A**

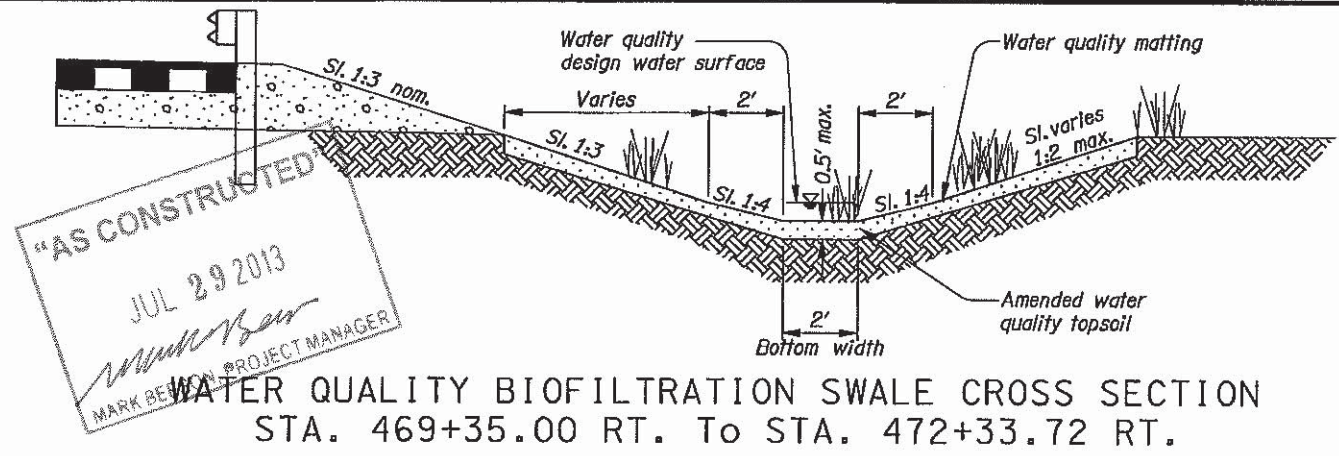


"AS CONSTRUCTED"
 JUL 29 2013
 MARK BEYON PROJECT MANAGER


WATER QUALITY BIOFILTRATION SWALE CROSS SECTION
 STA. 469+35.00 RT. To STA. 472+33.72 RT.

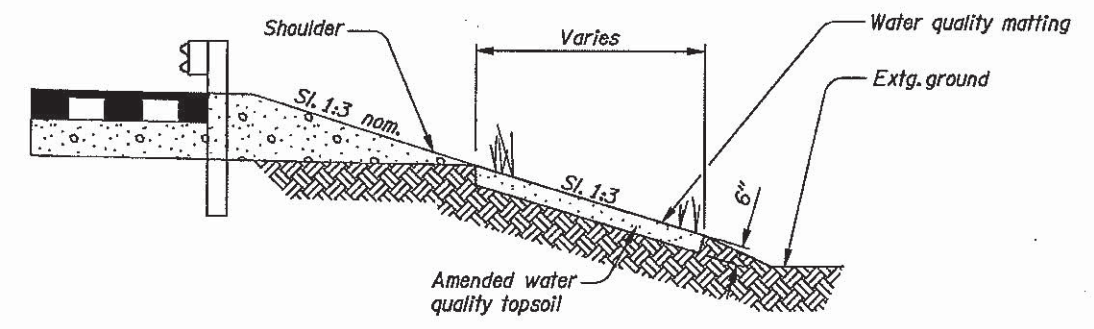


WATER QUALITY FILTER STRIP
 STA. 468+76.34 RT. To STA. 469+35.00 RT.
 STA. "MD" 11+29.00 RT. To STA. "MD" 11+75.00 RT.

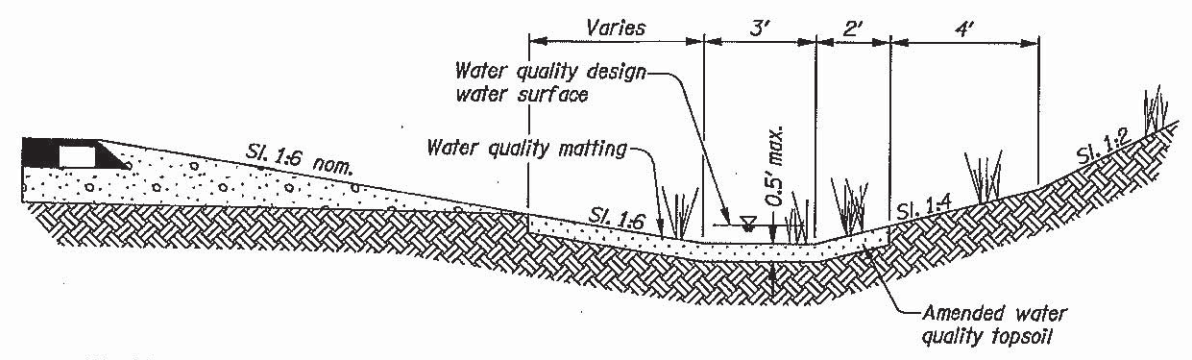


WATER QUALITY BIOFILTRATION SWALE CROSS SECTION
 STA. 474+23.55 RT. To STA. 475+50.00 RT.

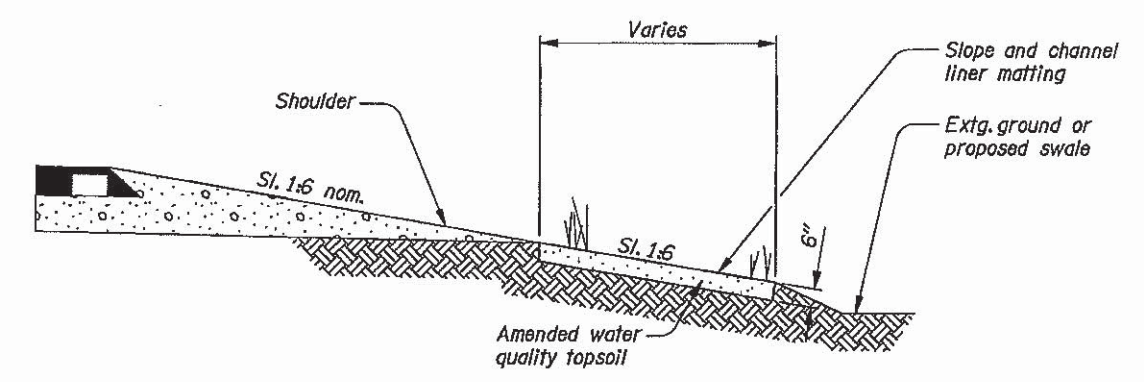


WATER QUALITY FILTER STRIP
 STA. "MD" 11+34.50 LT. To STA. 475+69.50 LT.
 STA. "MD" 10+97.50 RT. To STA. "MD" 10+64.50 RT.
 STA. "MD" 11+03.60 LT. To STA. "MD" 10+64.50 RT.

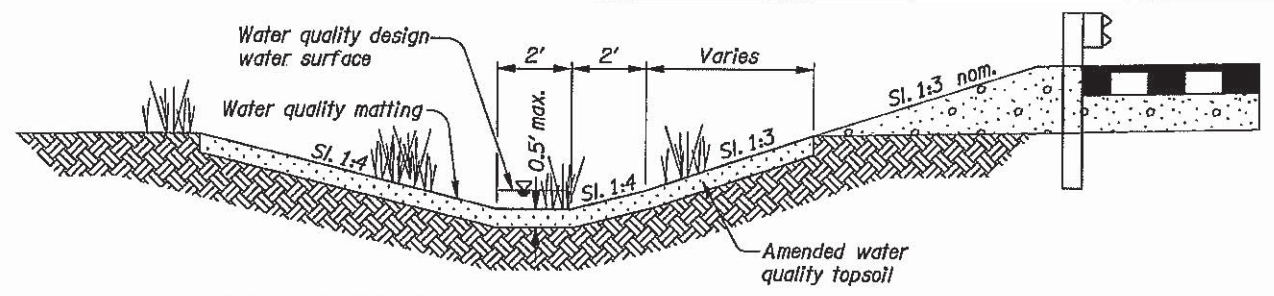

WATER QUALITY BIOFILTRATION SWALE CROSS SECTION
 STA. 469+05.00 LT. To STA. 472+07.00 LT.

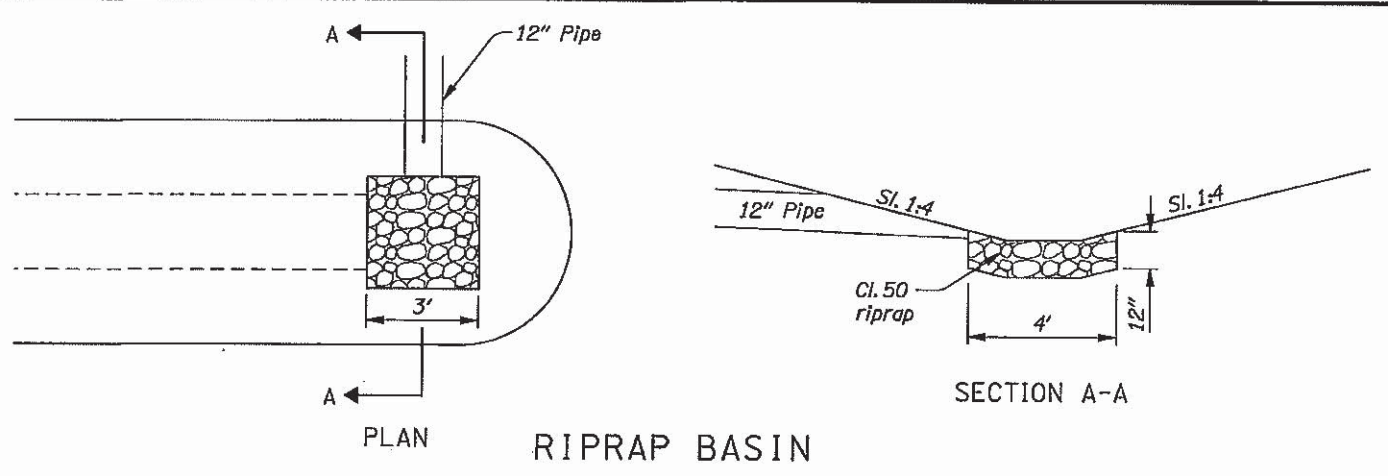

PLAN
 RIPRAP BASIN

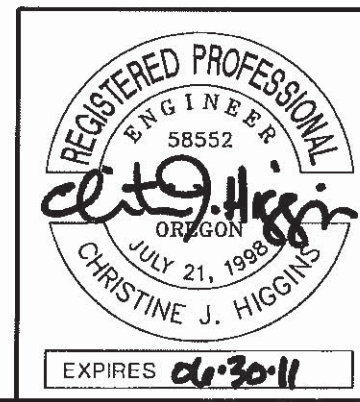

<p>OREGON DEPARTMENT OF TRANSPORTATION</p>	
<p>DAVID EVANS AND ASSOCIATES INC. 2100 Southwest River Parkway Portland Oregon 97201 Ph: 503.223.6663</p>	
<p>US 30 @ EILERTSEN CREEK PROJECT LOWER COLUMBIA RIVER HWY. COLUMBIA COUNTY</p>	
<p>Reviewed By - <i>CPH</i> Designed By - Karima Nordahl Drafted By - Edita Boguslawski/Mike Youngs</p>	
<p>DRAINAGE DETAILS</p>	<p>SHEET NO. GJ</p>