

OPERATION & MAINTENANCE MANUAL

Water Quality Bioslope

Manual prepared: July, 2019

DFI No. D00561, 00565, 00567 & 00571



Figure 1: DFI No. D00561, looking East



Figure 2: DFI No. D00565, looking East



Figure 3: DFI No. D00567, looking East



Figure 4: DFI No. D00571, looking East

1. Identification

Drainage Facility ID (DFI): D00561
 Facility Type: Water Quality Bioslope
 Construction Drawings: (V-File Numbers) 45V-035
 Location: District: 1
 Highway No.: 037
 Mile Post: 1.0 to 1.64, [Left]

Drainage Facility ID (DFI): D00565
 Facility Type: Water Quality Bioslope
 Construction Drawings: (V-File Numbers) 45V-035
 Location: District: 1
 Highway No.: 037
 Mile Post: 1.90 to 2.07, [Left]

Drainage Facility ID (DFI): D00567
Facility Type: Water Quality Bioslope
Construction Drawings: (V-File Numbers) 45V-035
Location: District: 1
Highway No.: 037
Mile Post: 2.10 to 2.31, [Left]

Drainage Facility ID (DFI): D00571
Facility Type: Water Quality Bioslope
Construction Drawings: (V-File Numbers) 45V-035
Location: District: 1
Highway No.: 037
Mile Post: 2.02 to 2.07, [Left]

2. Manual Purpose

The purpose of this manual is to outline inspection needs and summarize maintenance actions.

3. Facility Location

The location map below details the facility location. The highway, mile posts, side streets, access location, and stormwater flow directions are noted on the map. **NOTE: Mile posts are based off of the V-File, and may vary from TransGIS mile posts.**

Facility location type: **Roadway shoulder**

Flow direction: East to West

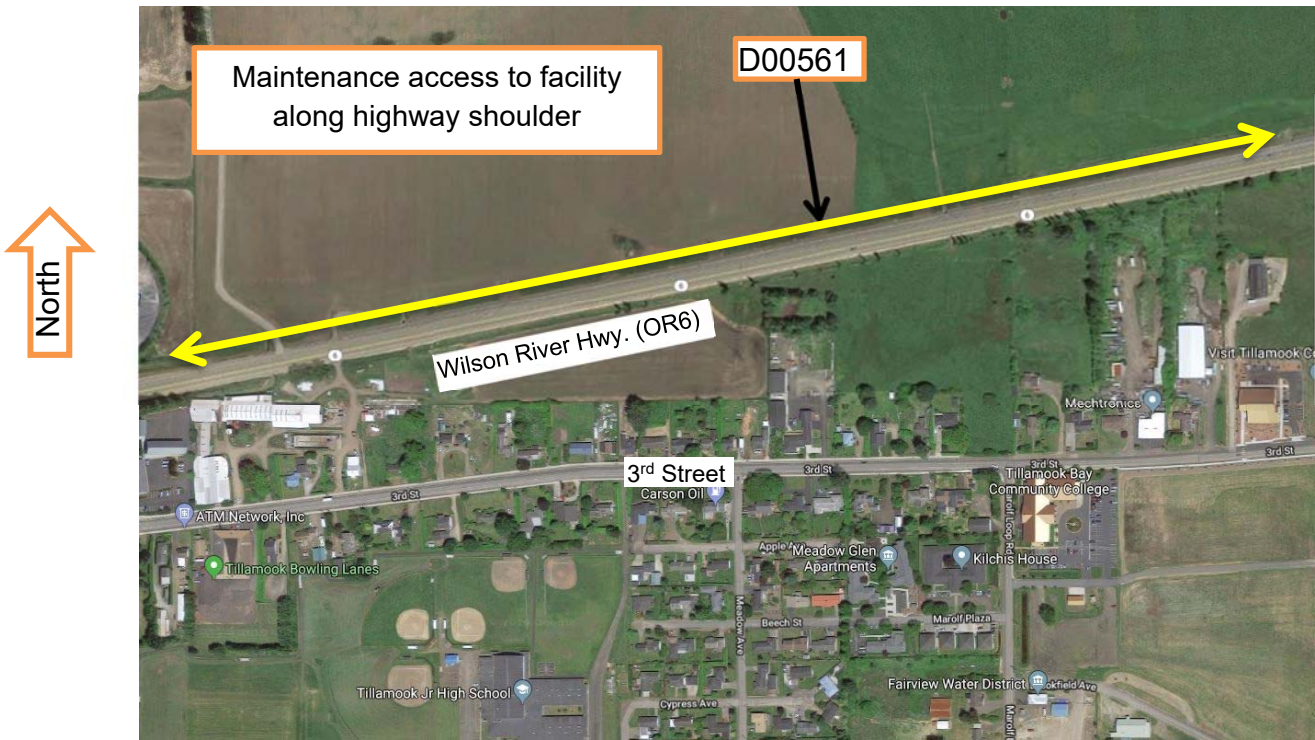


Figure 5: D00561 facility location map

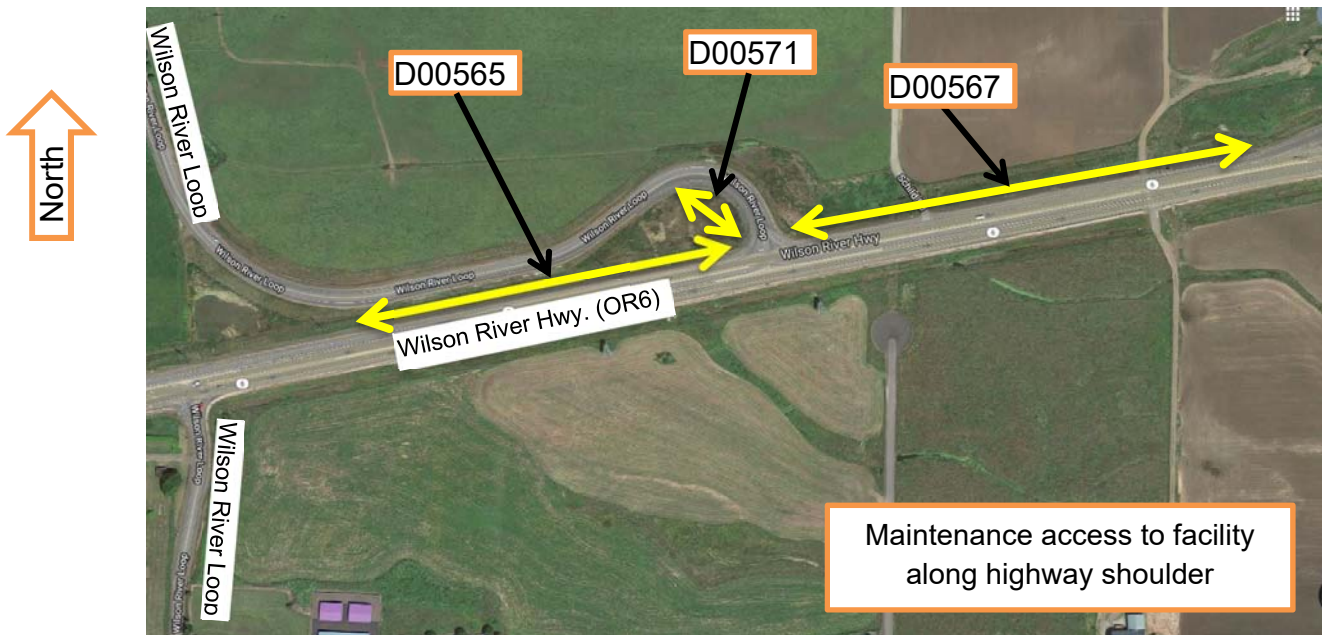


Figure 6: D00565, D00567, D00571 facility location map

4. Facility Summary


The width is measured perpendicular to the edge of pavement and is equivalent to the flow length. The length is measured parallel to the edge of pavement and is equivalent to the length of the contributing impervious area.

The length and width of the applicable facility components are:

Component	Length (feet)	Width (feet)
D00561	3,379	7
D00565	895	7
D00567	1,140	7
D00571	440	7

The slope of the facility is presented by a vertical distance (rise) followed by the horizontal distance (run).

Side Slope	Rise (feet)	Run (feet)
D00561	1	4
D00565	1	4
D00567	1	4
D00571	1	4

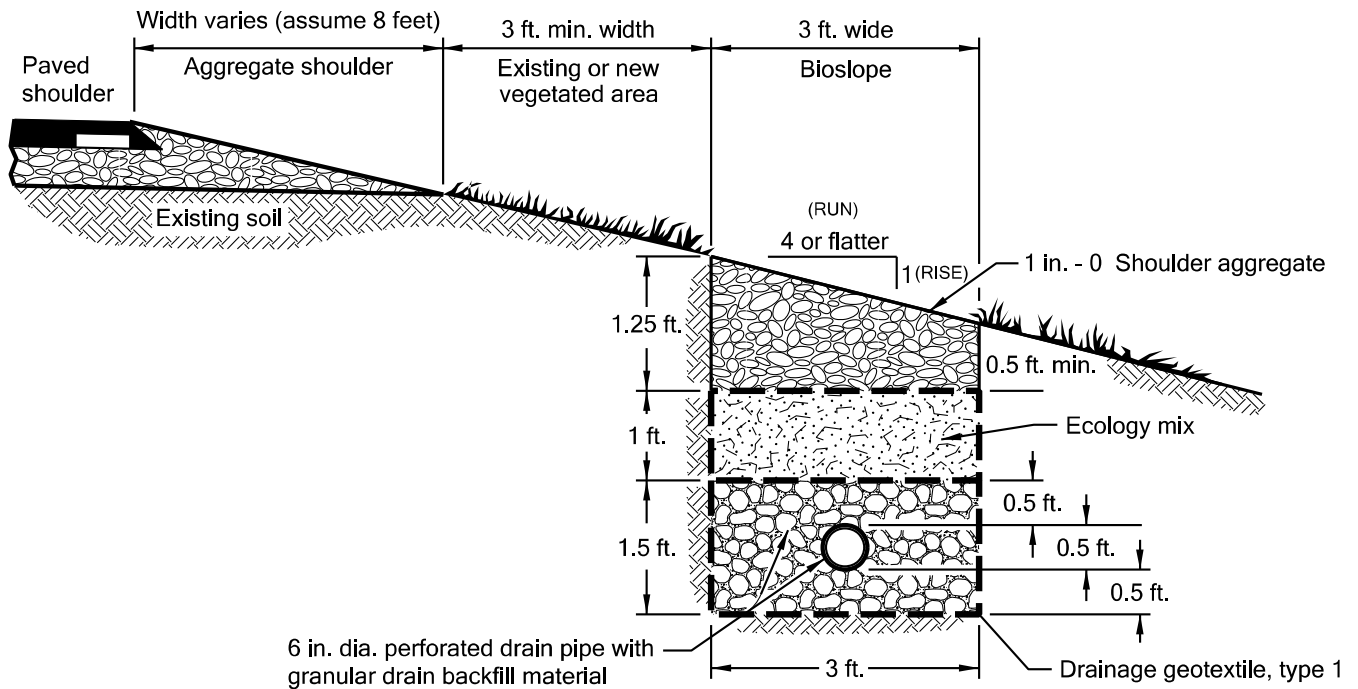

SECTION A-A
NTS

Figure 2: BioSlope Section

Site Specific Information: Control run-off and provide treatment for the intersection of Wilson River Loop and Wilson River Highway (OR6). Water flows thru project area towards Tillamook Bay located 4.5 miles northwest.

5. Facility Access

Maintenance access to the facility:

<input type="checkbox"/> Roadside pad	<input checked="" type="checkbox"/> Roadside shoulder
<input type="checkbox"/> Access road with Gate	<input type="checkbox"/> Access road without Gate



Figure 7: Roadside shoulder access

6. Operational Components / Maintenance Items

Classification and Standard Operational (Op) Plan:

This facility is classified as a:

<input type="checkbox"/> Filter Strip (Op Plan A)	<input checked="" type="checkbox"/> Bioslope (Op Plan B)
<p>A filter strip consists of a vegetated or media slope located parallel to the edge of pavement. It maintains sheet flow of stormwater runoff over the width of the strip.</p>	<p>A bioslope consists of a filter strip and treatment zone. It is a flow-through stormwater treatment facility located along roadside embankments.</p>
<p>A standard operational plan illustrates the general facility footprint configuration and explains the purpose of each facility component. Operational plans (A, B) are provided in the Standard Operation Manual.</p>	

See Appendix A for the site specific operational plan.

Operational Components

Filter strips and bioslopes have many components that assist with treatment, conveyance, and infiltration of stormwater runoff. The components in use can vary depending on the facility design. The facility components table (Table 1) has been provided to highlight the applicable components for this facility. The component is in use when the box contains an “x” (e.g.).

The Standard Operation Manual for Water Quality Filter Strips and Bioslopes (implemented **May 2019**) outlines facility operation, typical footprint configuration, and component definitions and details. A link to the manual is attached to the feature marker in TransGIS.

<https://gis.odot.state.or.us/TransGIS/>

Maintenance Items

Operational components marked in Table 1 should be inspected and maintained according to Section 7. Each facility component is defined and detailed in the Standard Operation Manual using the associated ID number indicated below.

Table 1: Bioslope Components		ID #
Facility Inlet		
Pavement Sheet Flow	<input checked="" type="checkbox"/>	B1
Shoulder Aggregate	<input checked="" type="checkbox"/>	B2
Ground Cover		
Vegetated Slope	<input checked="" type="checkbox"/>	B3
Aggregate Media Slope	<input checked="" type="checkbox"/>	B4
Underground Components		
Water Quality Mix	<input type="checkbox"/>	B5
Ecology Mix	<input checked="" type="checkbox"/>	B6
Granular Drain Backfill Material	<input type="checkbox"/>	B7
Geotextile Fabric	<input checked="" type="checkbox"/>	B8
Geocell Grid	<input type="checkbox"/>	B9
Structures		
Curb/Berm	<input type="checkbox"/>	B10
Check Dam	<input type="checkbox"/>	B11
Cleanout	<input type="checkbox"/>	B12
Facility Outlet		
Perforated Drain Pipe	<input type="checkbox"/>	B13
Open Slope Outlet	<input type="checkbox"/>	B14
Open Channel Outlet	<input type="checkbox"/>	B15
Storm Drain Outlet Pipe	<input type="checkbox"/>	B16
Outfall Type		
Waterbody (Creek/Lake/Ocean)	<input type="checkbox"/> C	B17
	<input type="checkbox"/> L	
	<input type="checkbox"/> O	
Outfall Channel	<input type="checkbox"/>	B18
Storm Drain System	<input type="checkbox"/>	B19
Outfall Components		
Pervious Berm	<input type="checkbox"/>	B20
Riprap Pad	<input type="checkbox"/>	B21

7. Maintenance

Maintenance Frequency/Maintain Records

- a. Inspect annually. Preferably prior to the rainy season.
- b. Clean and maintain as necessary. Refer to Activity 125 for conditions when maintenance is needed.
- c. Keep a record of inspections, maintenance, and repairs.

Maintenance Guide/Maintenance Actions

The ODOT Routine Road Maintenance Water Quality and Habitat Guide (the *Blue Book*) outlines the standard maintenance actions for water quality facilities under Activity 125.

There are standard maintenance tables for standard ODOT designs. The maintenance tables describe the maintenance component, the defect or problem, the condition when maintenance is needed, and the recommended maintenance to correct the problem. Use the following tables to maintain ODOT filter strips and bioslopes:

- Table 1 (General Maintenance): Contains general maintenance and inspection guidelines that are applicable to all ODOT water quality facilities
- Table 4 (Water Quality Filter Strips)
- Table 5 (Water Quality Bioslopes)

The ODOT Maintenance Guide can be viewed at the following website:

<http://www.oregon.gov/ODOT/HWY/OOM/pages/mguide.aspx>

The *Blue Book* can be viewed at the following website:

http://www.oregon.gov/ODOT/Maintenance/Documents/blue_book.pdf

8. Limitations

Filter strips and bioslopes are NOT designed to allow the use of heavy equipment. Vehicles entering the facility can create depressions (tire ruts), damage vegetation, and damage structural components (e.g. flow spreaders). These conditions may result in poor treatment and drainage performance.

9. Waste Material Handling

Material removed from the facility is defined as waste by the Department of Environmental Quality (DEQ). Refer to the road waste section of the ODOT Maintenance Yard Environmental Management System (EMS) Policy and Procedures Manual for disposal options:

<http://www.oregon.gov/ODOT/HWY/OOM/pages/ems.aspx>


Contact any of the following for more detailed information about management of waste materials found on site:

ODOT Clean Water Unit	(503) 986-3008
ODOT Statewide Hazmat Coordinator	(503) 667-7442
ODOT Region 1 Hazmat Coordinator	(503) 731-8290
ODOT Region 2 Hazmat Coordinator	(503) 986-2647
ODOT Region 3 Hazmat Coordinator	(541) 957-3594
ODOT Region 4 Hazmat Coordinator	(541) 388-6186
ODOT Region 5 Hazmat Coordinator	(541) 963-1590
ODEQ Northwest Region Office	(503) 229-5263


A Appendix A – Site Specific Operational Plan

Contents:

Operational Plan: DFI D00561, 00565, 00567 & 00571

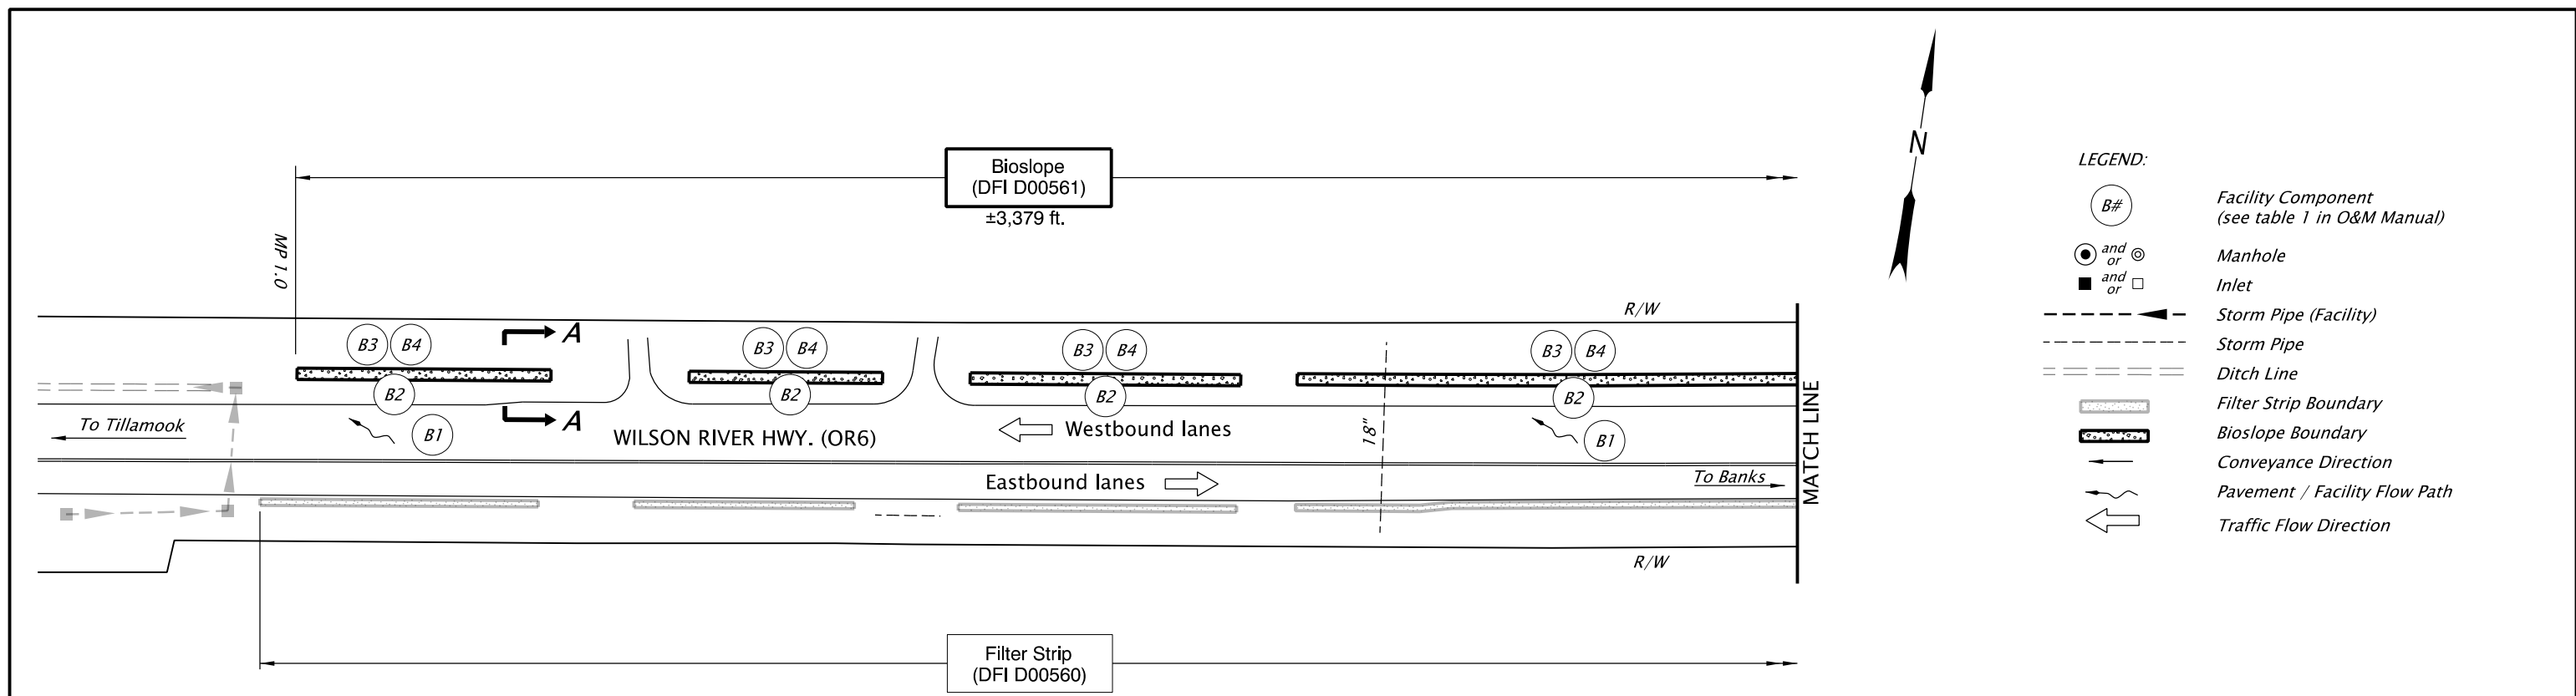

PLAN
N.T.S.

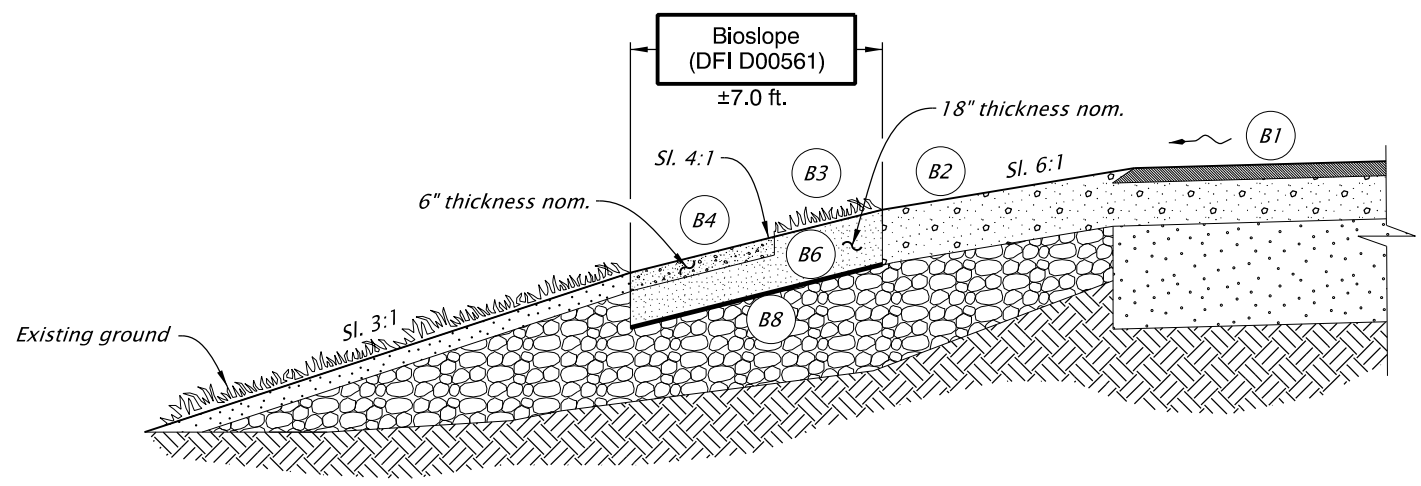

SECTION A-A
N.T.S.




Sht. 1 of 4

Prepared By:
Ramiro Perez

Drafted By:
Jeff Coon

DFI D00561
MAINTENANCE DISTRICT 1 HWY 37
WATER QUALITY BIOSLOPE
WILSON RIVER HIGHWAY MP 1.0
TILLAMOOK COUNTY

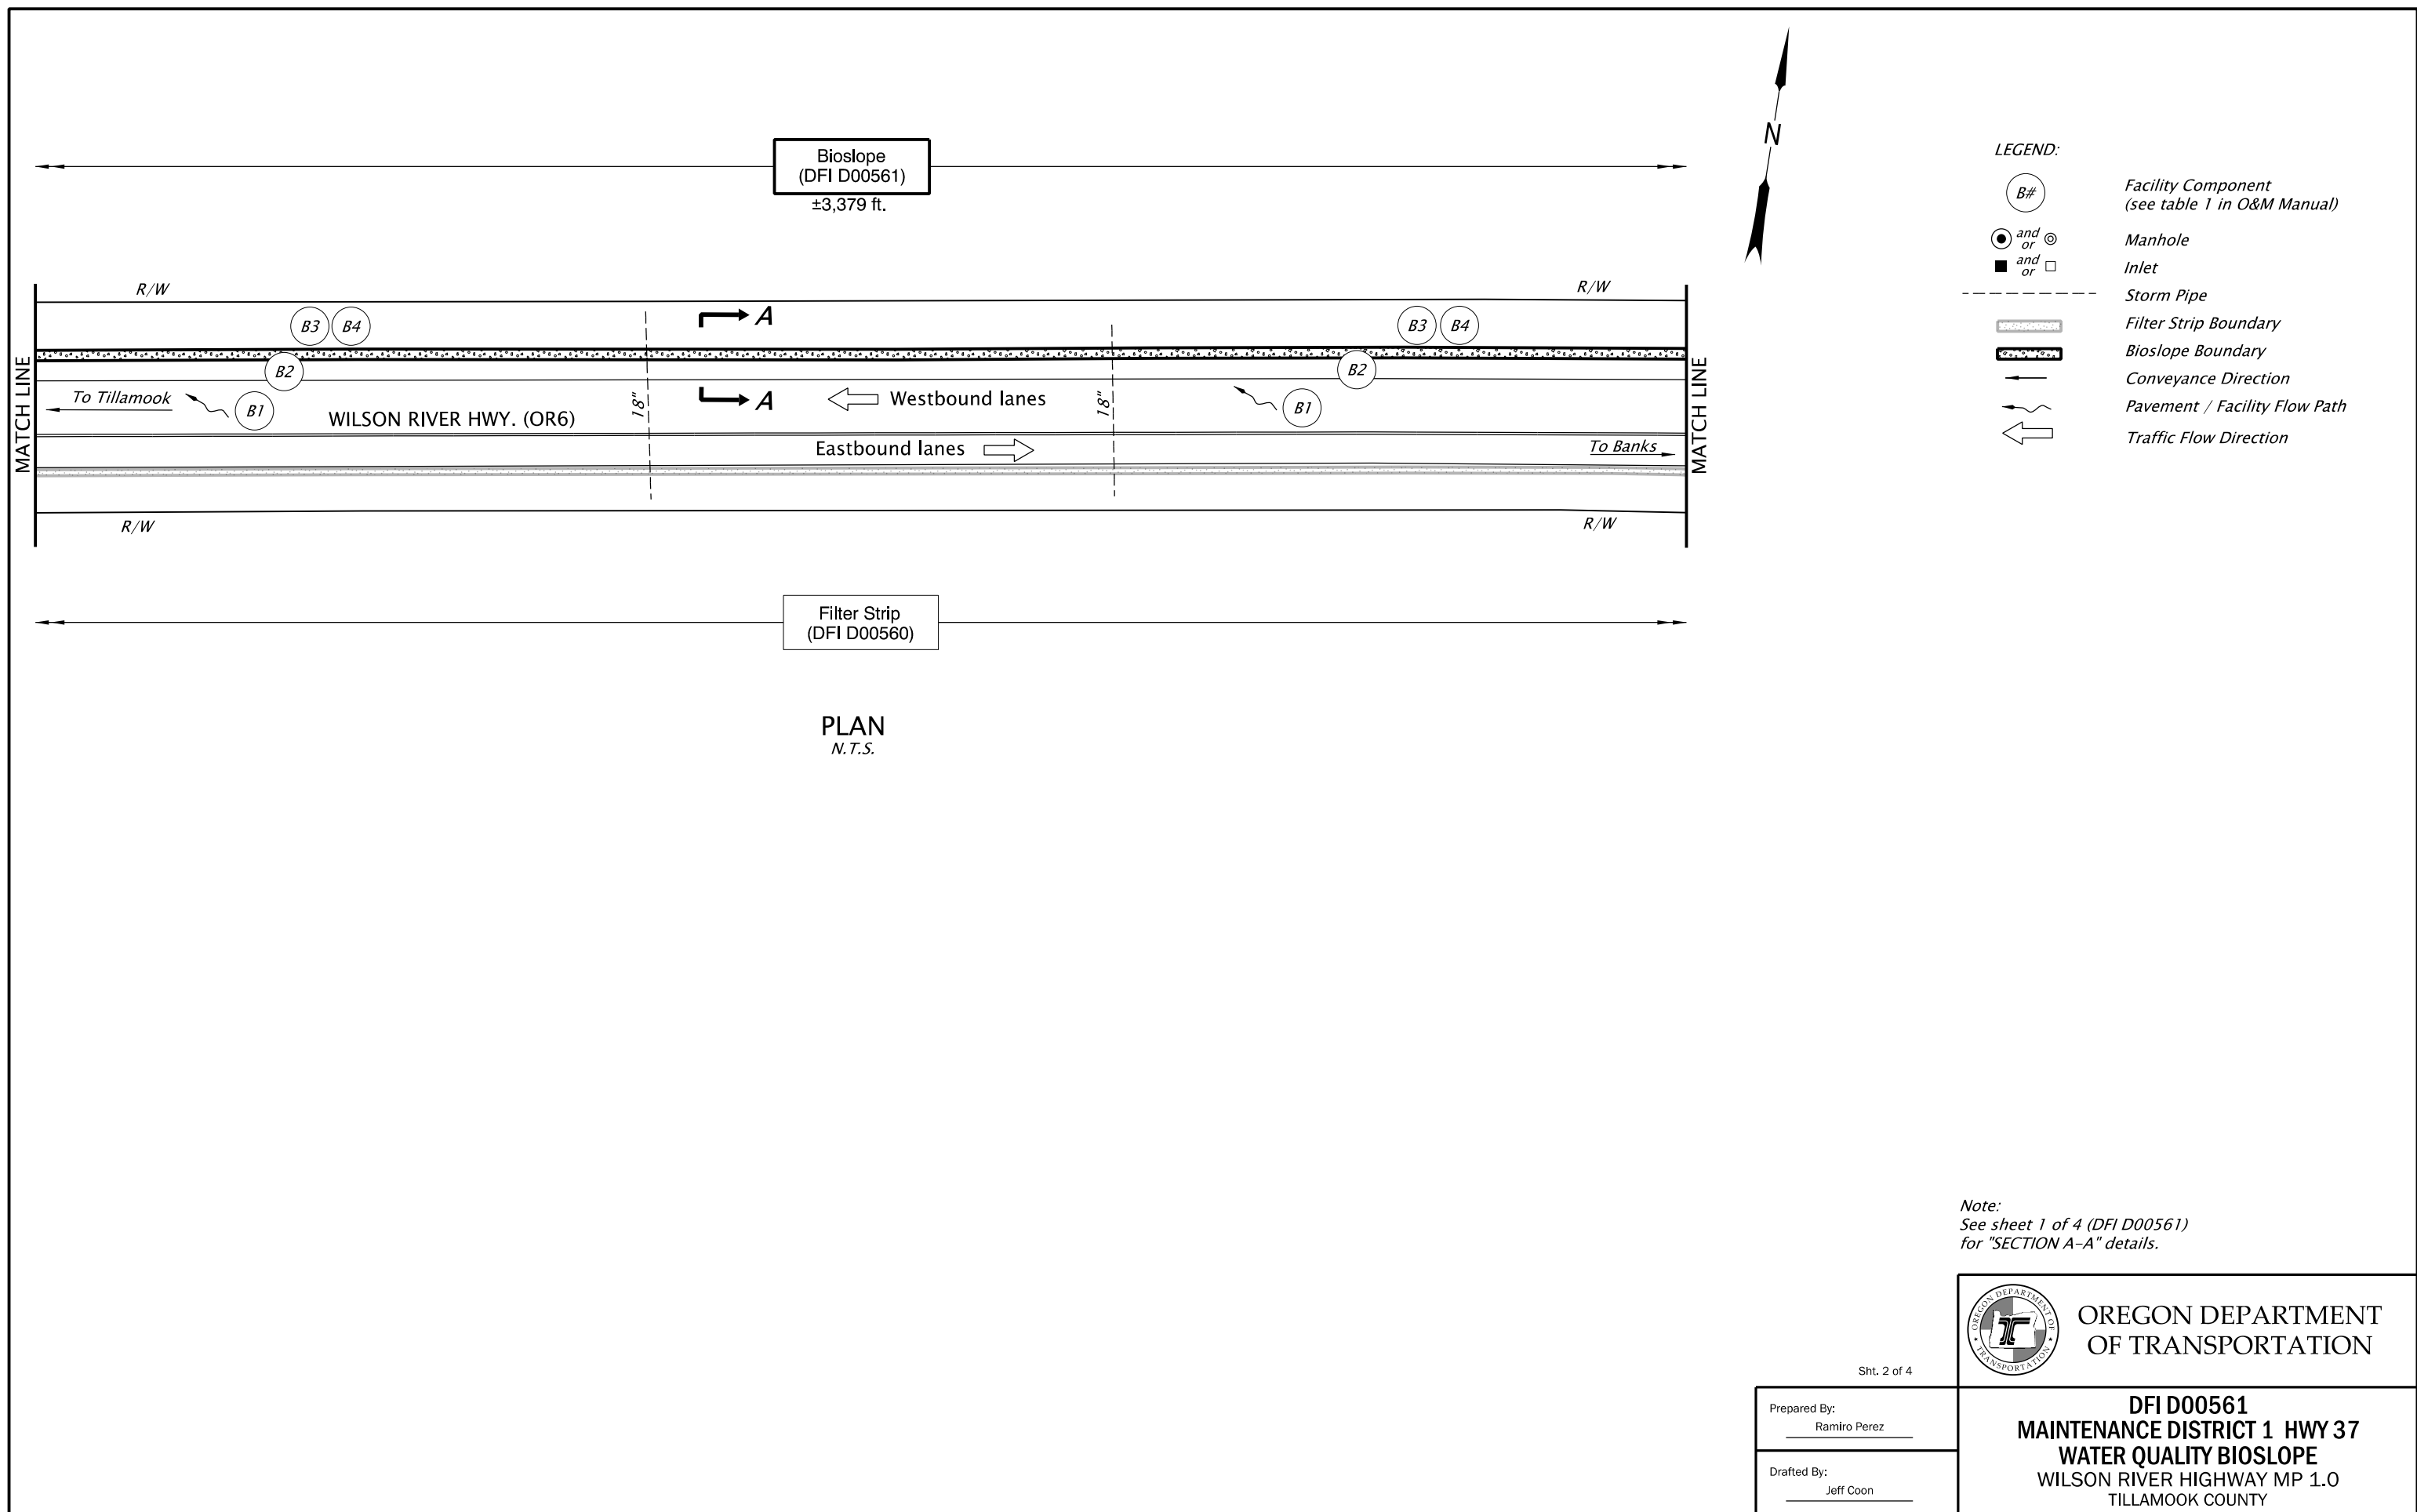

- LEGEND:**
- B# Facility Component (see table 1 in O&M Manual)
 - and ⊙ Manhole
 - and Inlet
 - Storm Pipe
 - Filter Strip Boundary
 - Bioslope Boundary
 - Conveyance Direction
 - Pavement / Facility Flow Path
 - Traffic Flow Direction

Note:
See sheet 1 of 4 (DFI D00561)
for "SECTION A-A" details.





Sht. 2 of 4

Prepared By:
Ramiro Perez

Drafted By:
Jeff Coon

DFI D00561
MAINTENANCE DISTRICT 1 HWY 37
WATER QUALITY BIOSLOPE
WILSON RIVER HIGHWAY MP 1.0
TILLAMOOK COUNTY

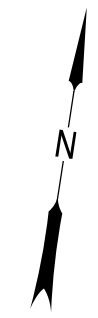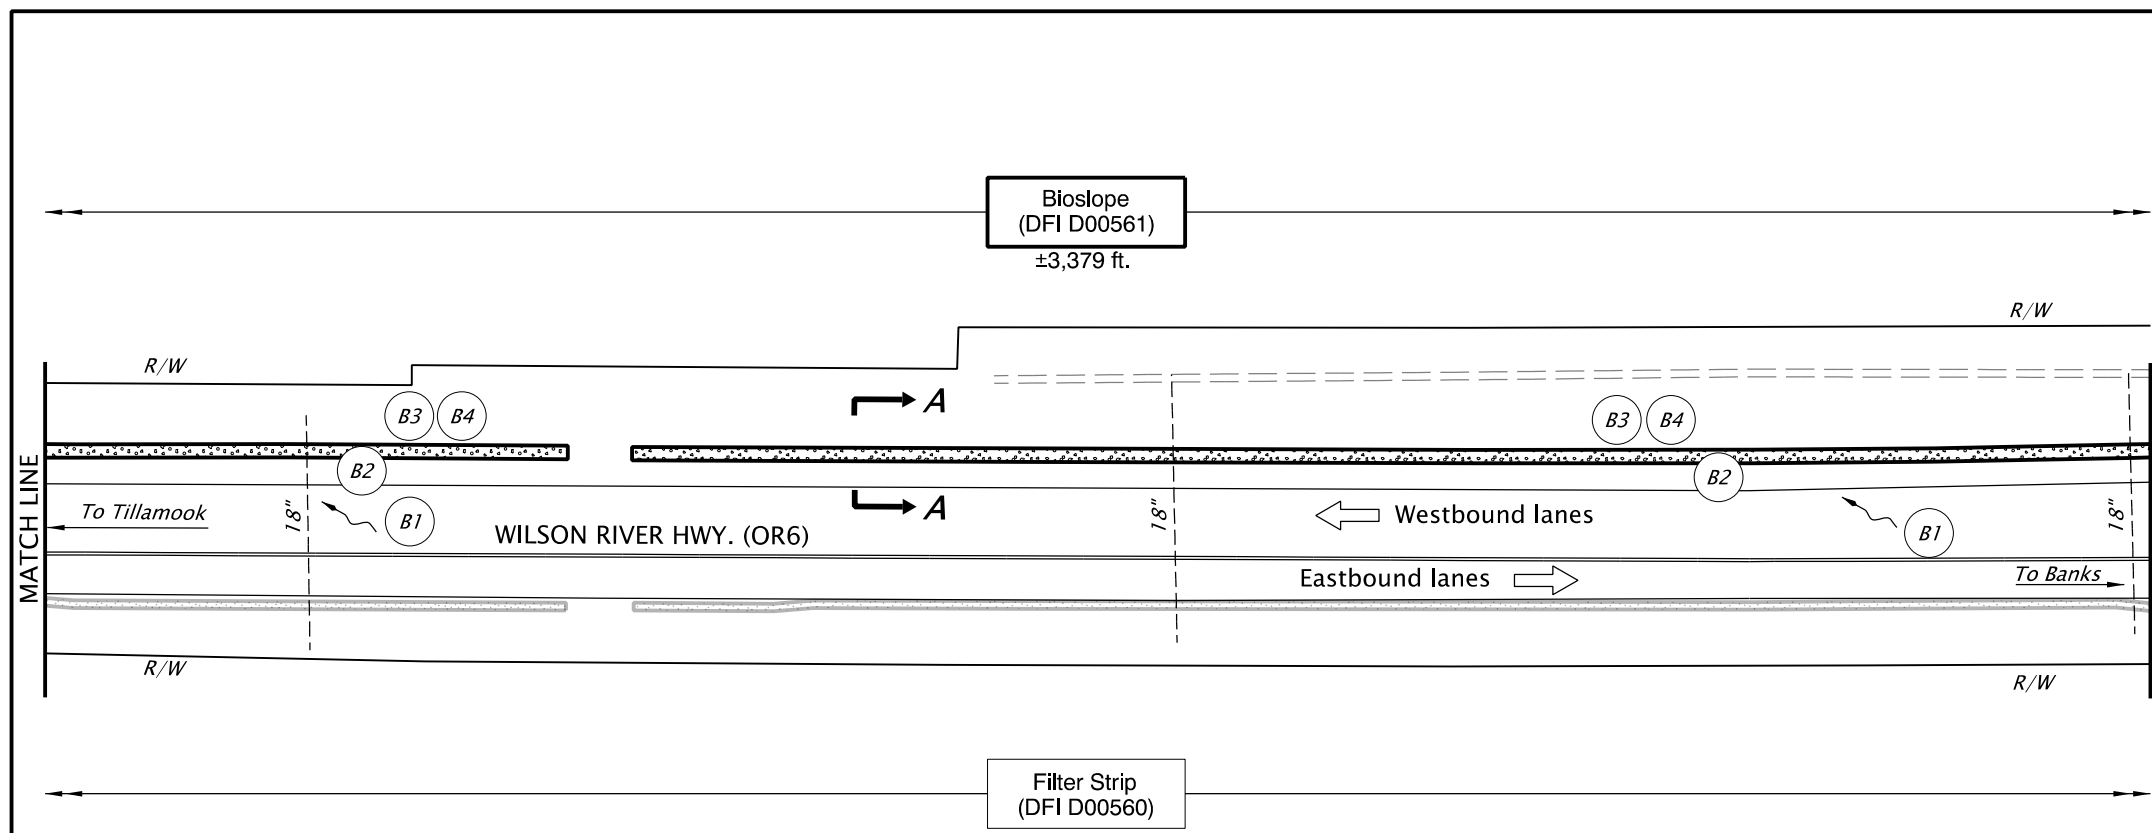

- LEGEND:**
- B# Facility Component (see table 1 in O&M Manual)
 - and ⊙ Manhole
 - and Inlet
 - Storm Pipe
 - Ditch Line
 - ▬ Filter Strip Boundary
 - ▬ Bioslope Boundary
 - Conveyance Direction
 - Pavement / Facility Flow Path
 - Traffic Flow Direction

PLAN
N.T.S.

Note:
See sheet 1 of 4 (DFI D00561)
for "SECTION A-A" details.


Sht. 3 of 4

Prepared By:
Ramiro Perez

Drafted By:
Jeff Coon

OREGON DEPARTMENT OF TRANSPORTATION

DFI D00561
MAINTENANCE DISTRICT 1 HWY 37
WATER QUALITY BIOSLOPE
WILSON RIVER HIGHWAY MP 1.0
TILLAMOOK COUNTY

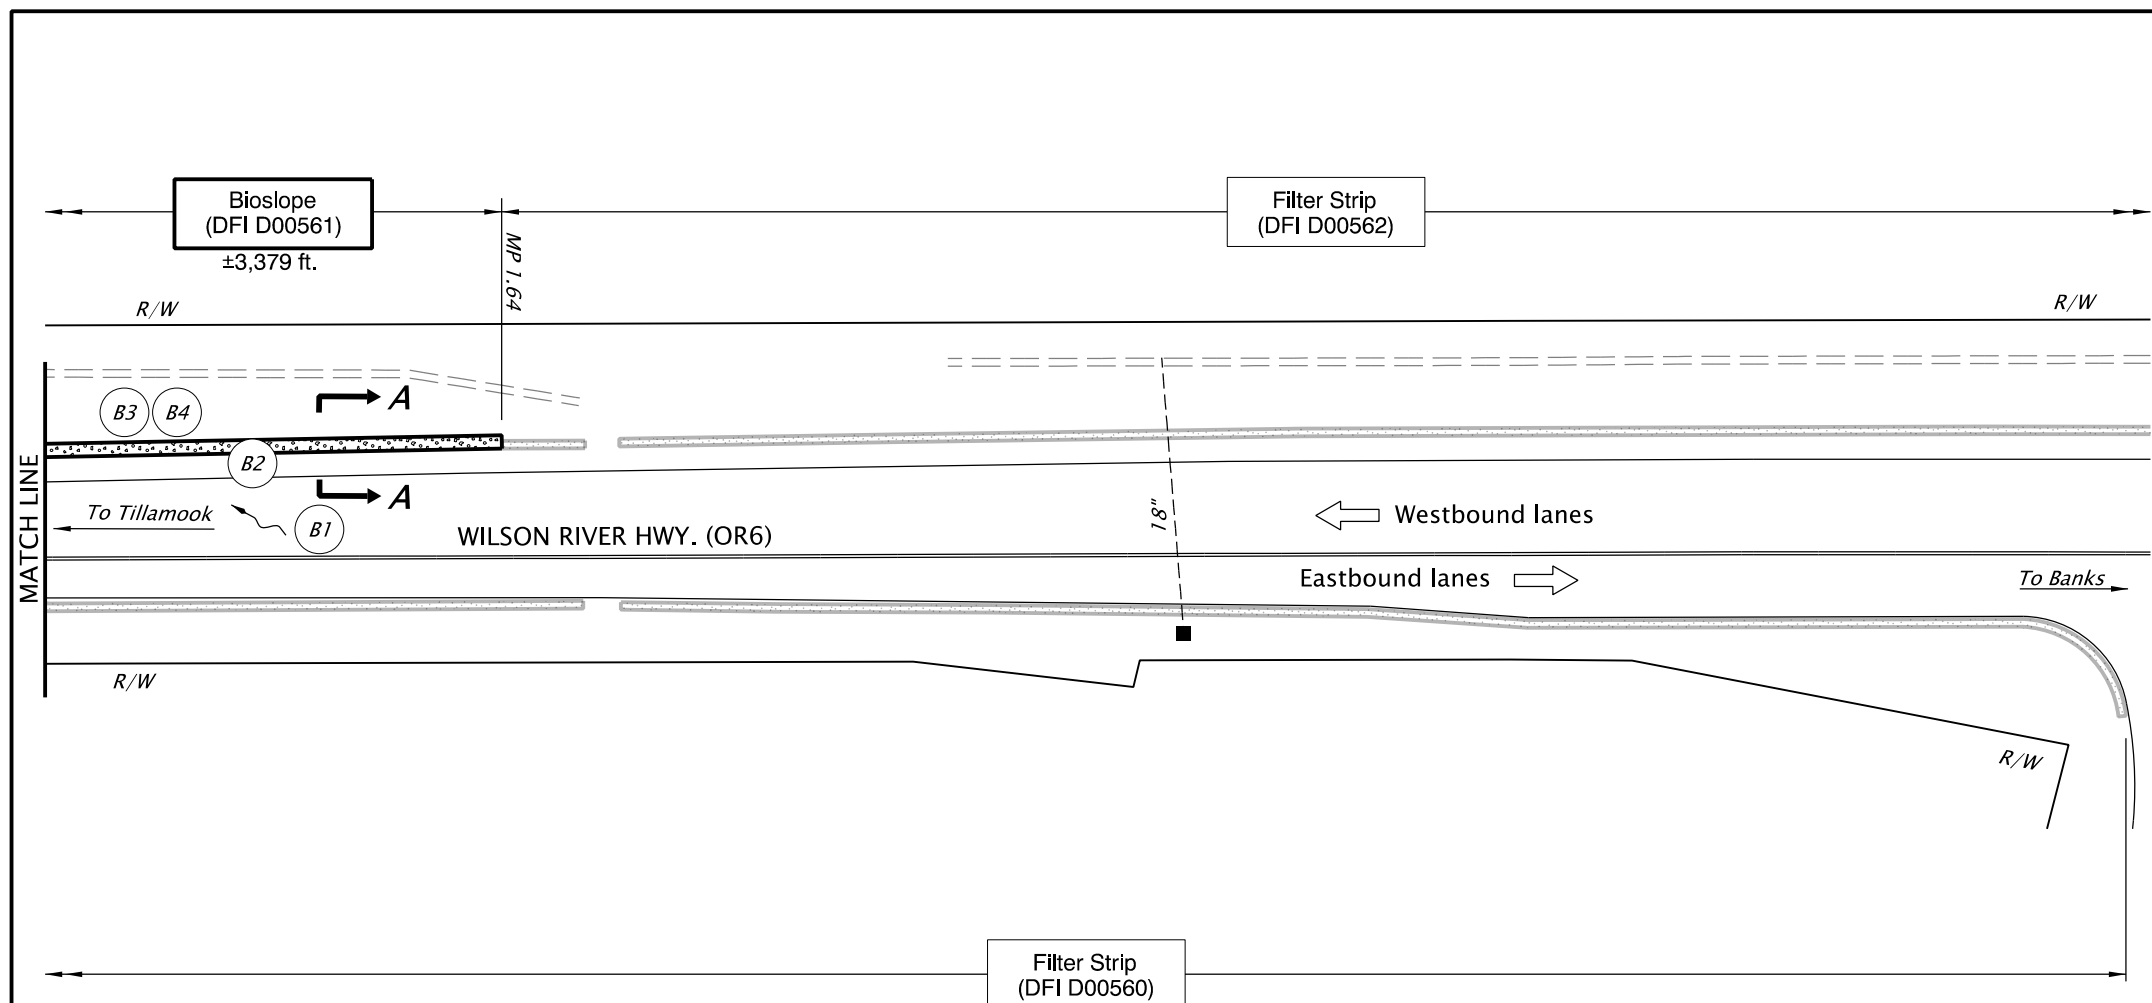

- LEGEND:**
- B# Facility Component (see table 1 in O&M Manual)
 - and ⊙ Manhole
 - and Inlet
 - Storm Pipe
 - Ditch Line
 - Filter Strip Boundary
 - Bioslope Boundary
 - Conveyance Direction
 - Pavement / Facility Flow Path
 - Traffic Flow Direction

PLAN
N.T.S.

Note:
See sheet 1 of 4 (DFI D00561)
for "SECTION A-A" details.




Sht. 4 of 4


Prepared By:
Ramiro Perez

Drafted By:
Jeff Coon

DFI D00561
MAINTENANCE DISTRICT 1 HWY 37
WATER QUALITY BIOSLOPE
WILSON RIVER HIGHWAY MP 1.0
TILLAMOOK COUNTY

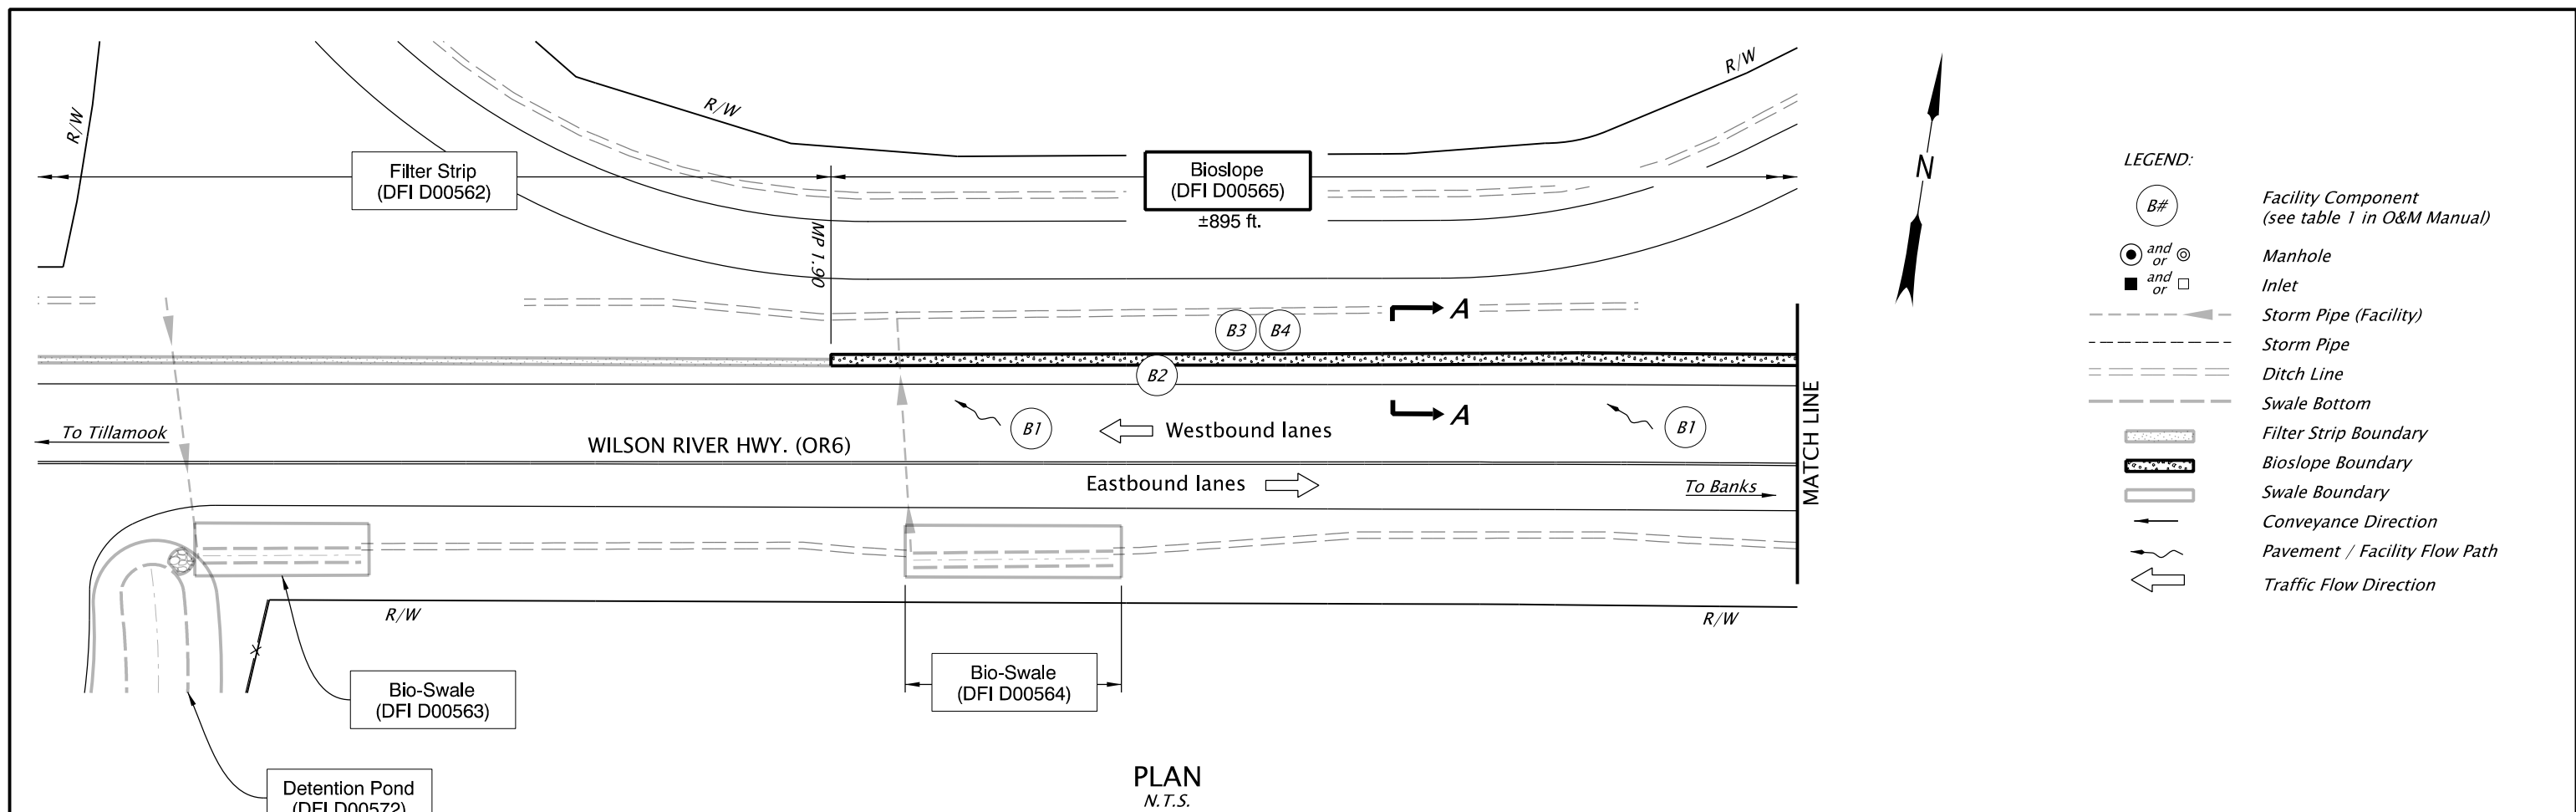

PLAN
N.T.S.

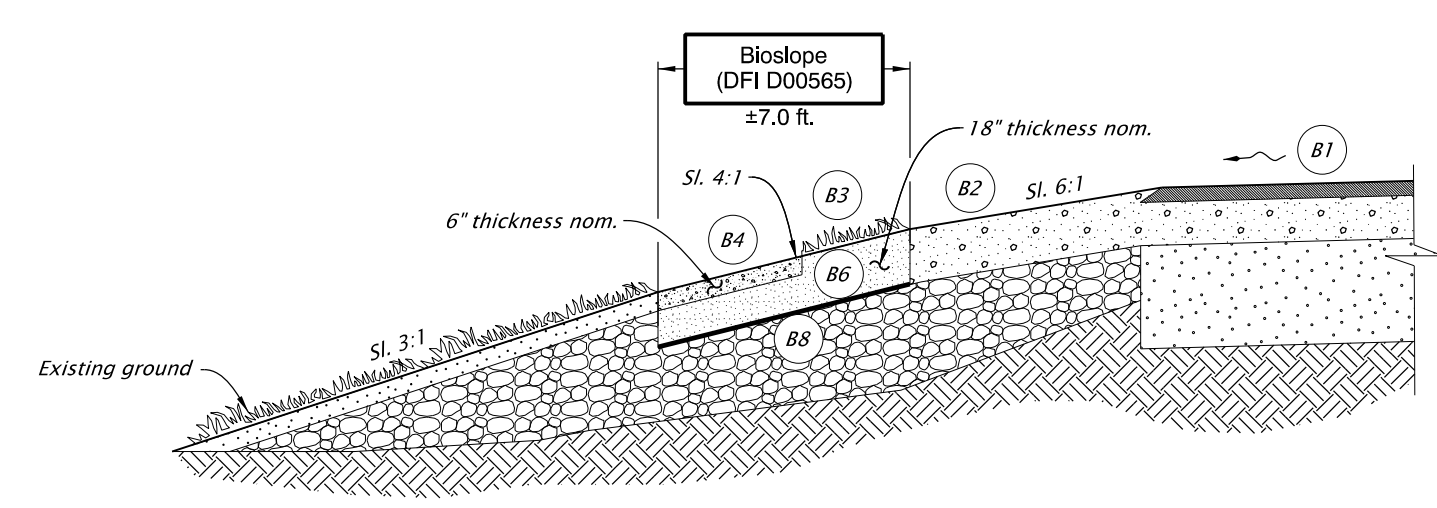

SECTION A-A
N.T.S.

- LEGEND:**
- B# Facility Component (see table 1 in O&M Manual)
 - and Manhole
 - and Inlet
 - Storm Pipe (Facility)
 - Storm Pipe
 - Ditch Line
 - Swale Bottom
 - Filter Strip Boundary
 - Bioslope Boundary
 - Swale Boundary
 - Conveyance Direction
 - Pavement / Facility Flow Path
 - Traffic Flow Direction


Sht. 1 of 2

Prepared By:
Ramiro Perez

Drafted By:
Jeff Coon



DFI D00565
MAINTENANCE DISTRICT 1 HWY 37
WATER QUALITY BIOSLOPE
WILSON RIVER HIGHWAY MP 1.90
TILLAMOOK COUNTY

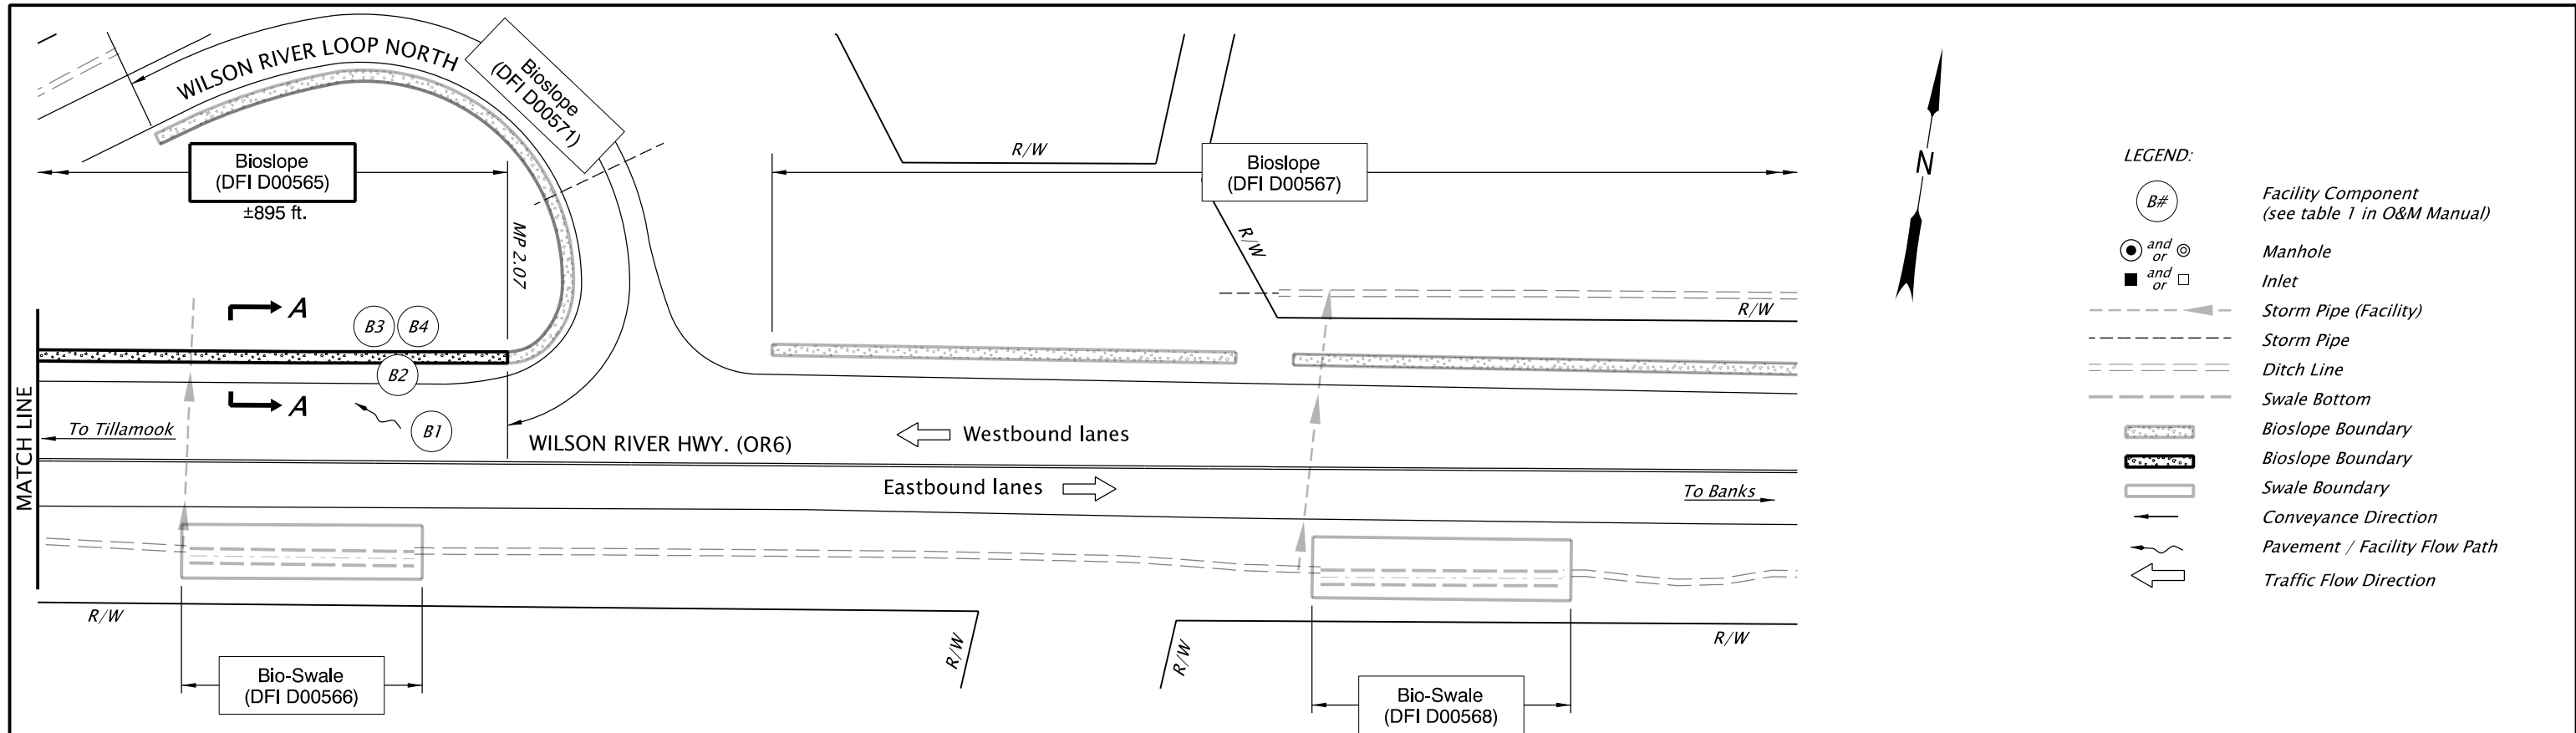

PLAN
N.T.S.

- LEGEND:**
- B# Facility Component (see table 1 in O&M Manual)
 - and Manhole
 - and Inlet
 - Storm Pipe (Facility)
 - Storm Pipe
 - Ditch Line
 - Swale Bottom
 - Bioslope Boundary
 - Bioslope Boundary
 - Swale Boundary
 - Conveyance Direction
 - Pavement / Facility Flow Path
 - Traffic Flow Direction

Note:
See sheet 1 of 2 (DFI D00565)
for "SECTION A-A" details.




Sht. 2 of 2

Prepared By:
Ramiro Perez


Drafted By:
Jeff Coon

DFI D00565
MAINTENANCE DISTRICT 1 HWY 37
WATER QUALITY BIOSLOPE
WILSON RIVER HIGHWAY MP 1.90
TILLAMOOK COUNTY

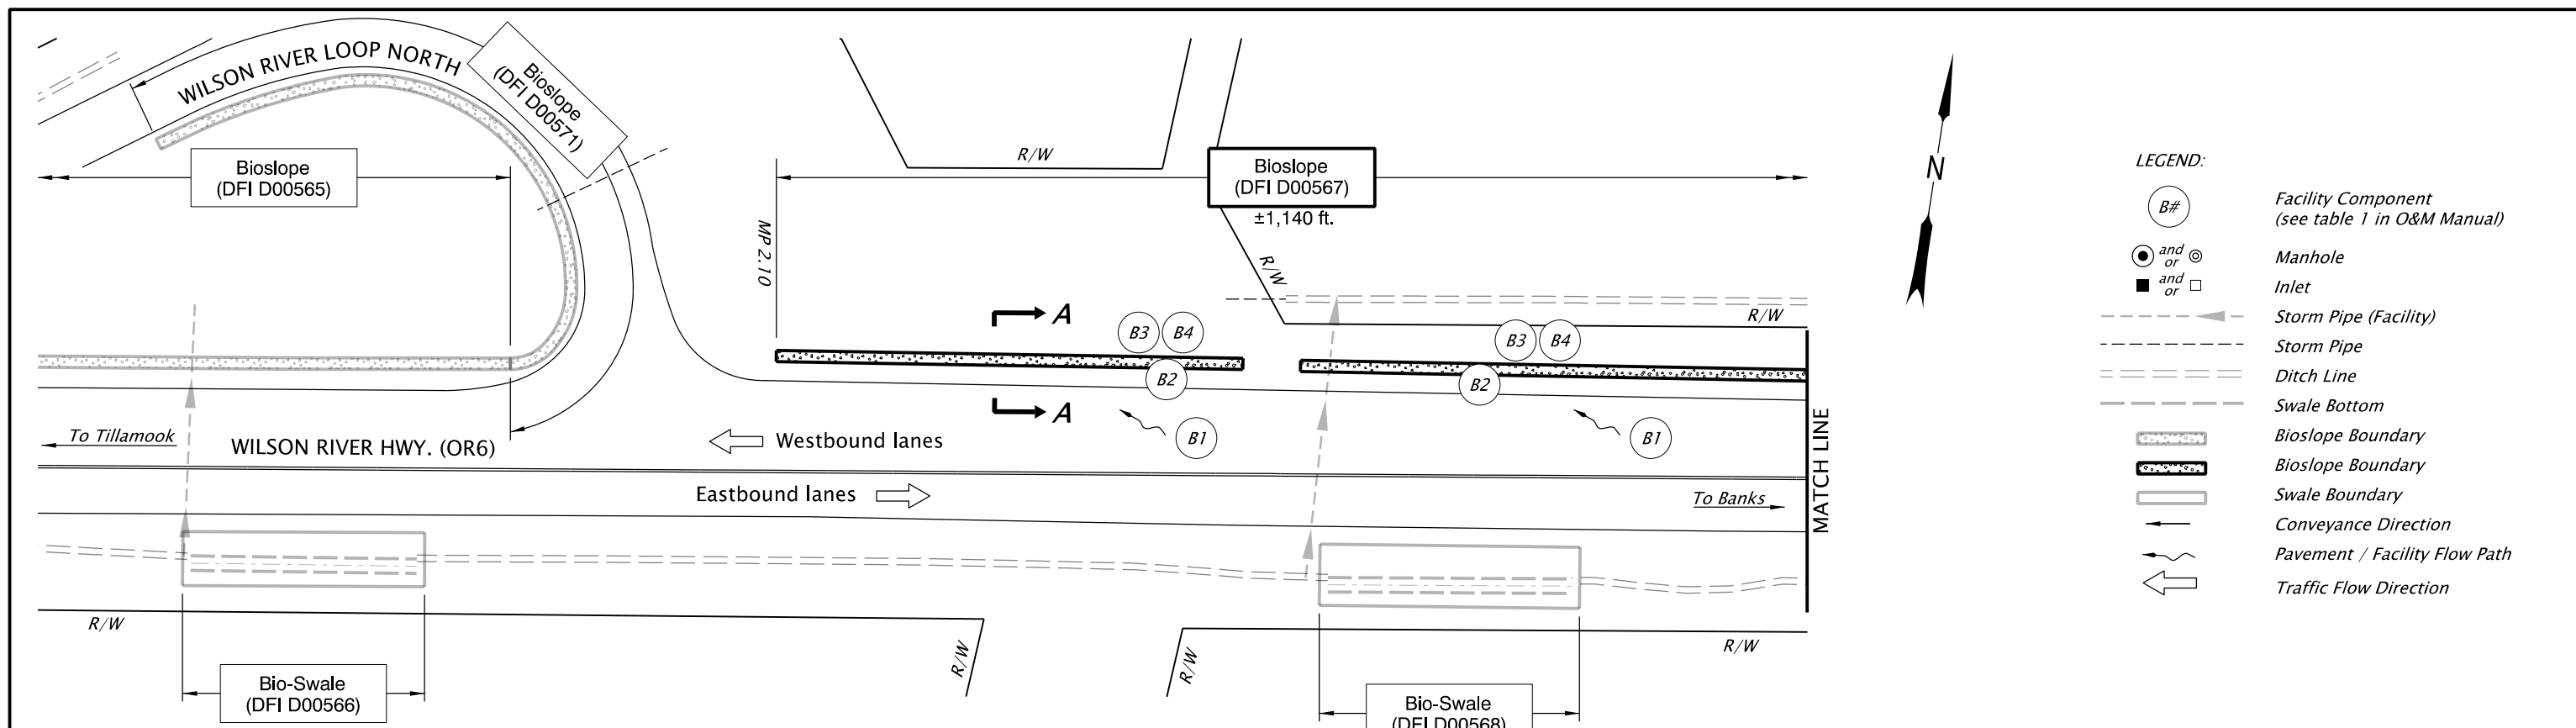

- LEGEND:**
- B# Facility Component (see table 1 in O&M Manual)
 - and ⊙ Manhole
 - and Inlet
 - Storm Pipe (Facility)
 - Storm Pipe
 - Ditch Line
 - Swale Bottom
 - Bioslope Boundary
 - Bioslope Boundary
 - Swale Boundary
 - Conveyance Direction
 - Pavement / Facility Flow Path
 - Traffic Flow Direction

PLAN
N.T.S.

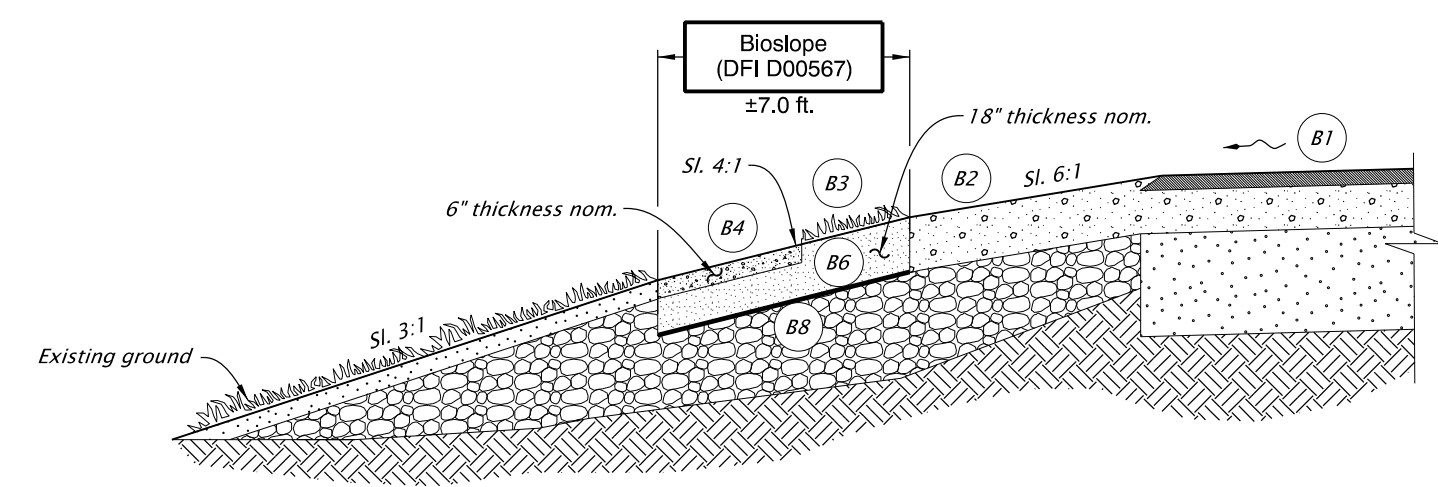


SECTION A-A
N.T.S.

Sht. 1 of 2

Prepared By:
Ramiro Perez
Drafted By:
Jeff Coon



DFI D00567
MAINTENANCE DISTRICT 1 HWY 37
WATER QUALITY BIOSLOPE
WILSON RIVER HIGHWAY MP 2.10
TILLAMOOK COUNTY

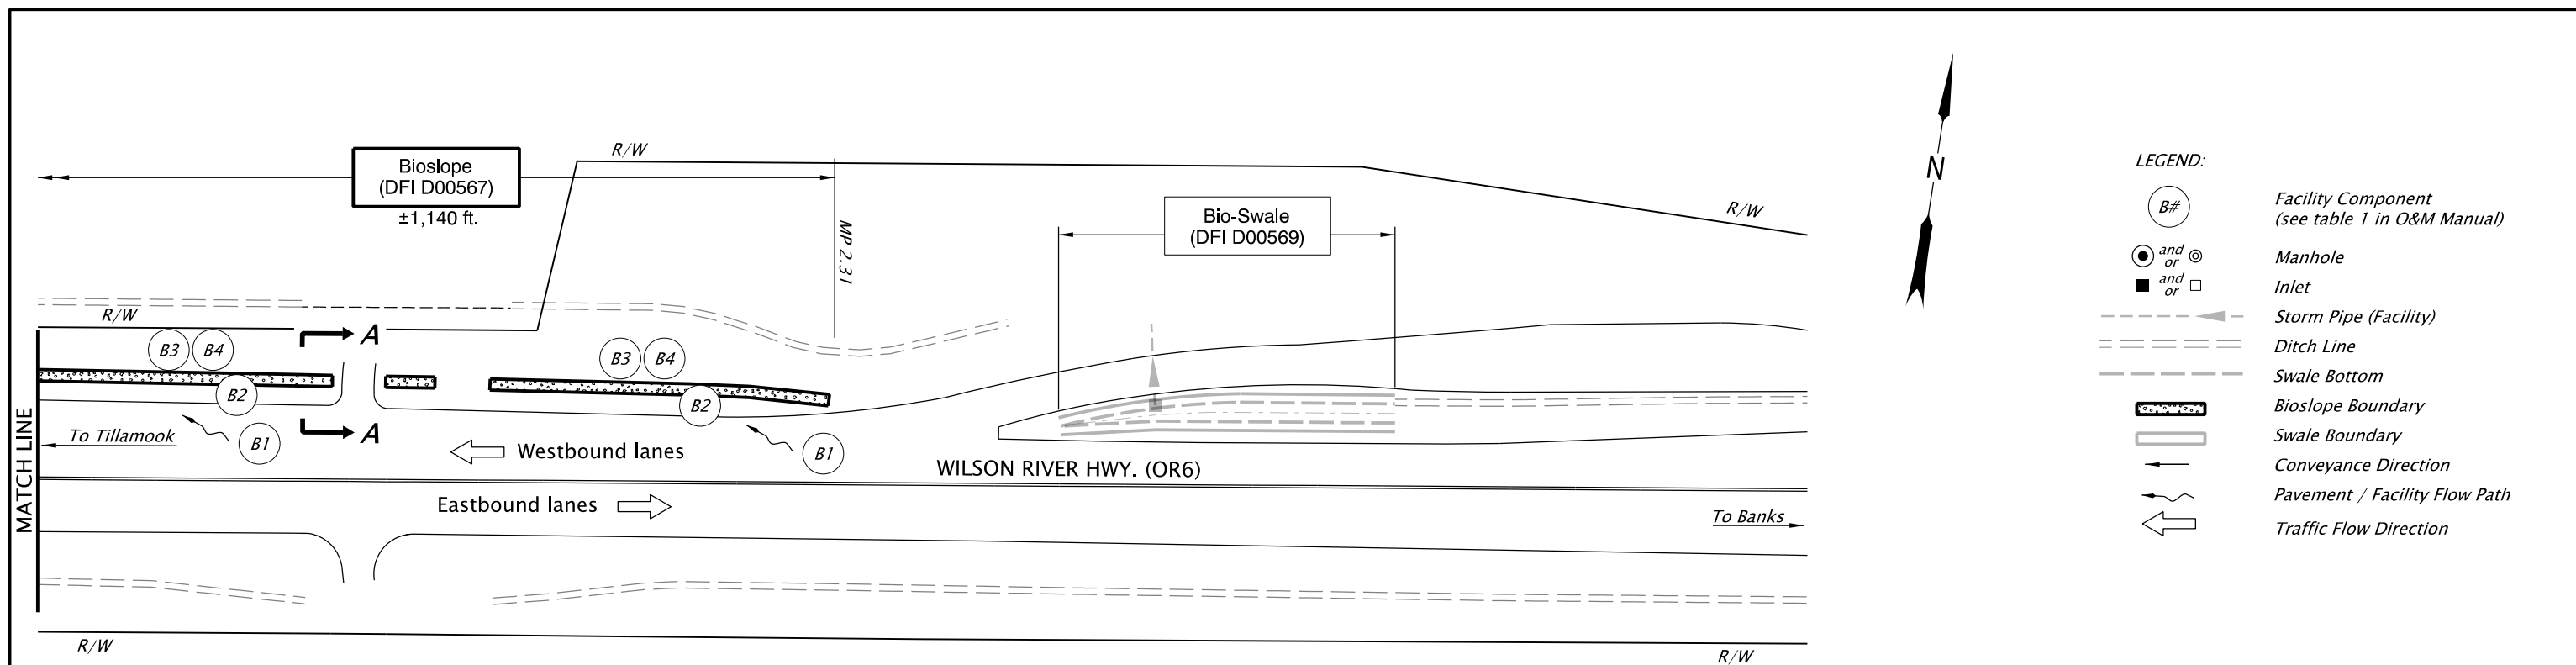

PLAN
N.T.S.

- LEGEND:**
- B# Facility Component (see table 1 in O&M Manual)
 - and Manhole
 - and Inlet
 - Storm Pipe (Facility)
 - Ditch Line
 - Swale Bottom
 - Bioslope Boundary
 - Swale Boundary
 - Conveyance Direction
 - Pavement / Facility Flow Path
 - Traffic Flow Direction



Note:
See sheet 1 of 2 (DFI D00567)
for "SECTION A-A" details.

Sht. 2 of 2


Prepared By:
Ramiro Perez

Drafted By:
Jeff Coon



OREGON DEPARTMENT
OF TRANSPORTATION

DFI D00567
MAINTENANCE DISTRICT 1 HWY 37
WATER QUALITY BIOSLOPE
WILSON RIVER HIGHWAY MP 2.10
TILLAMOOK COUNTY

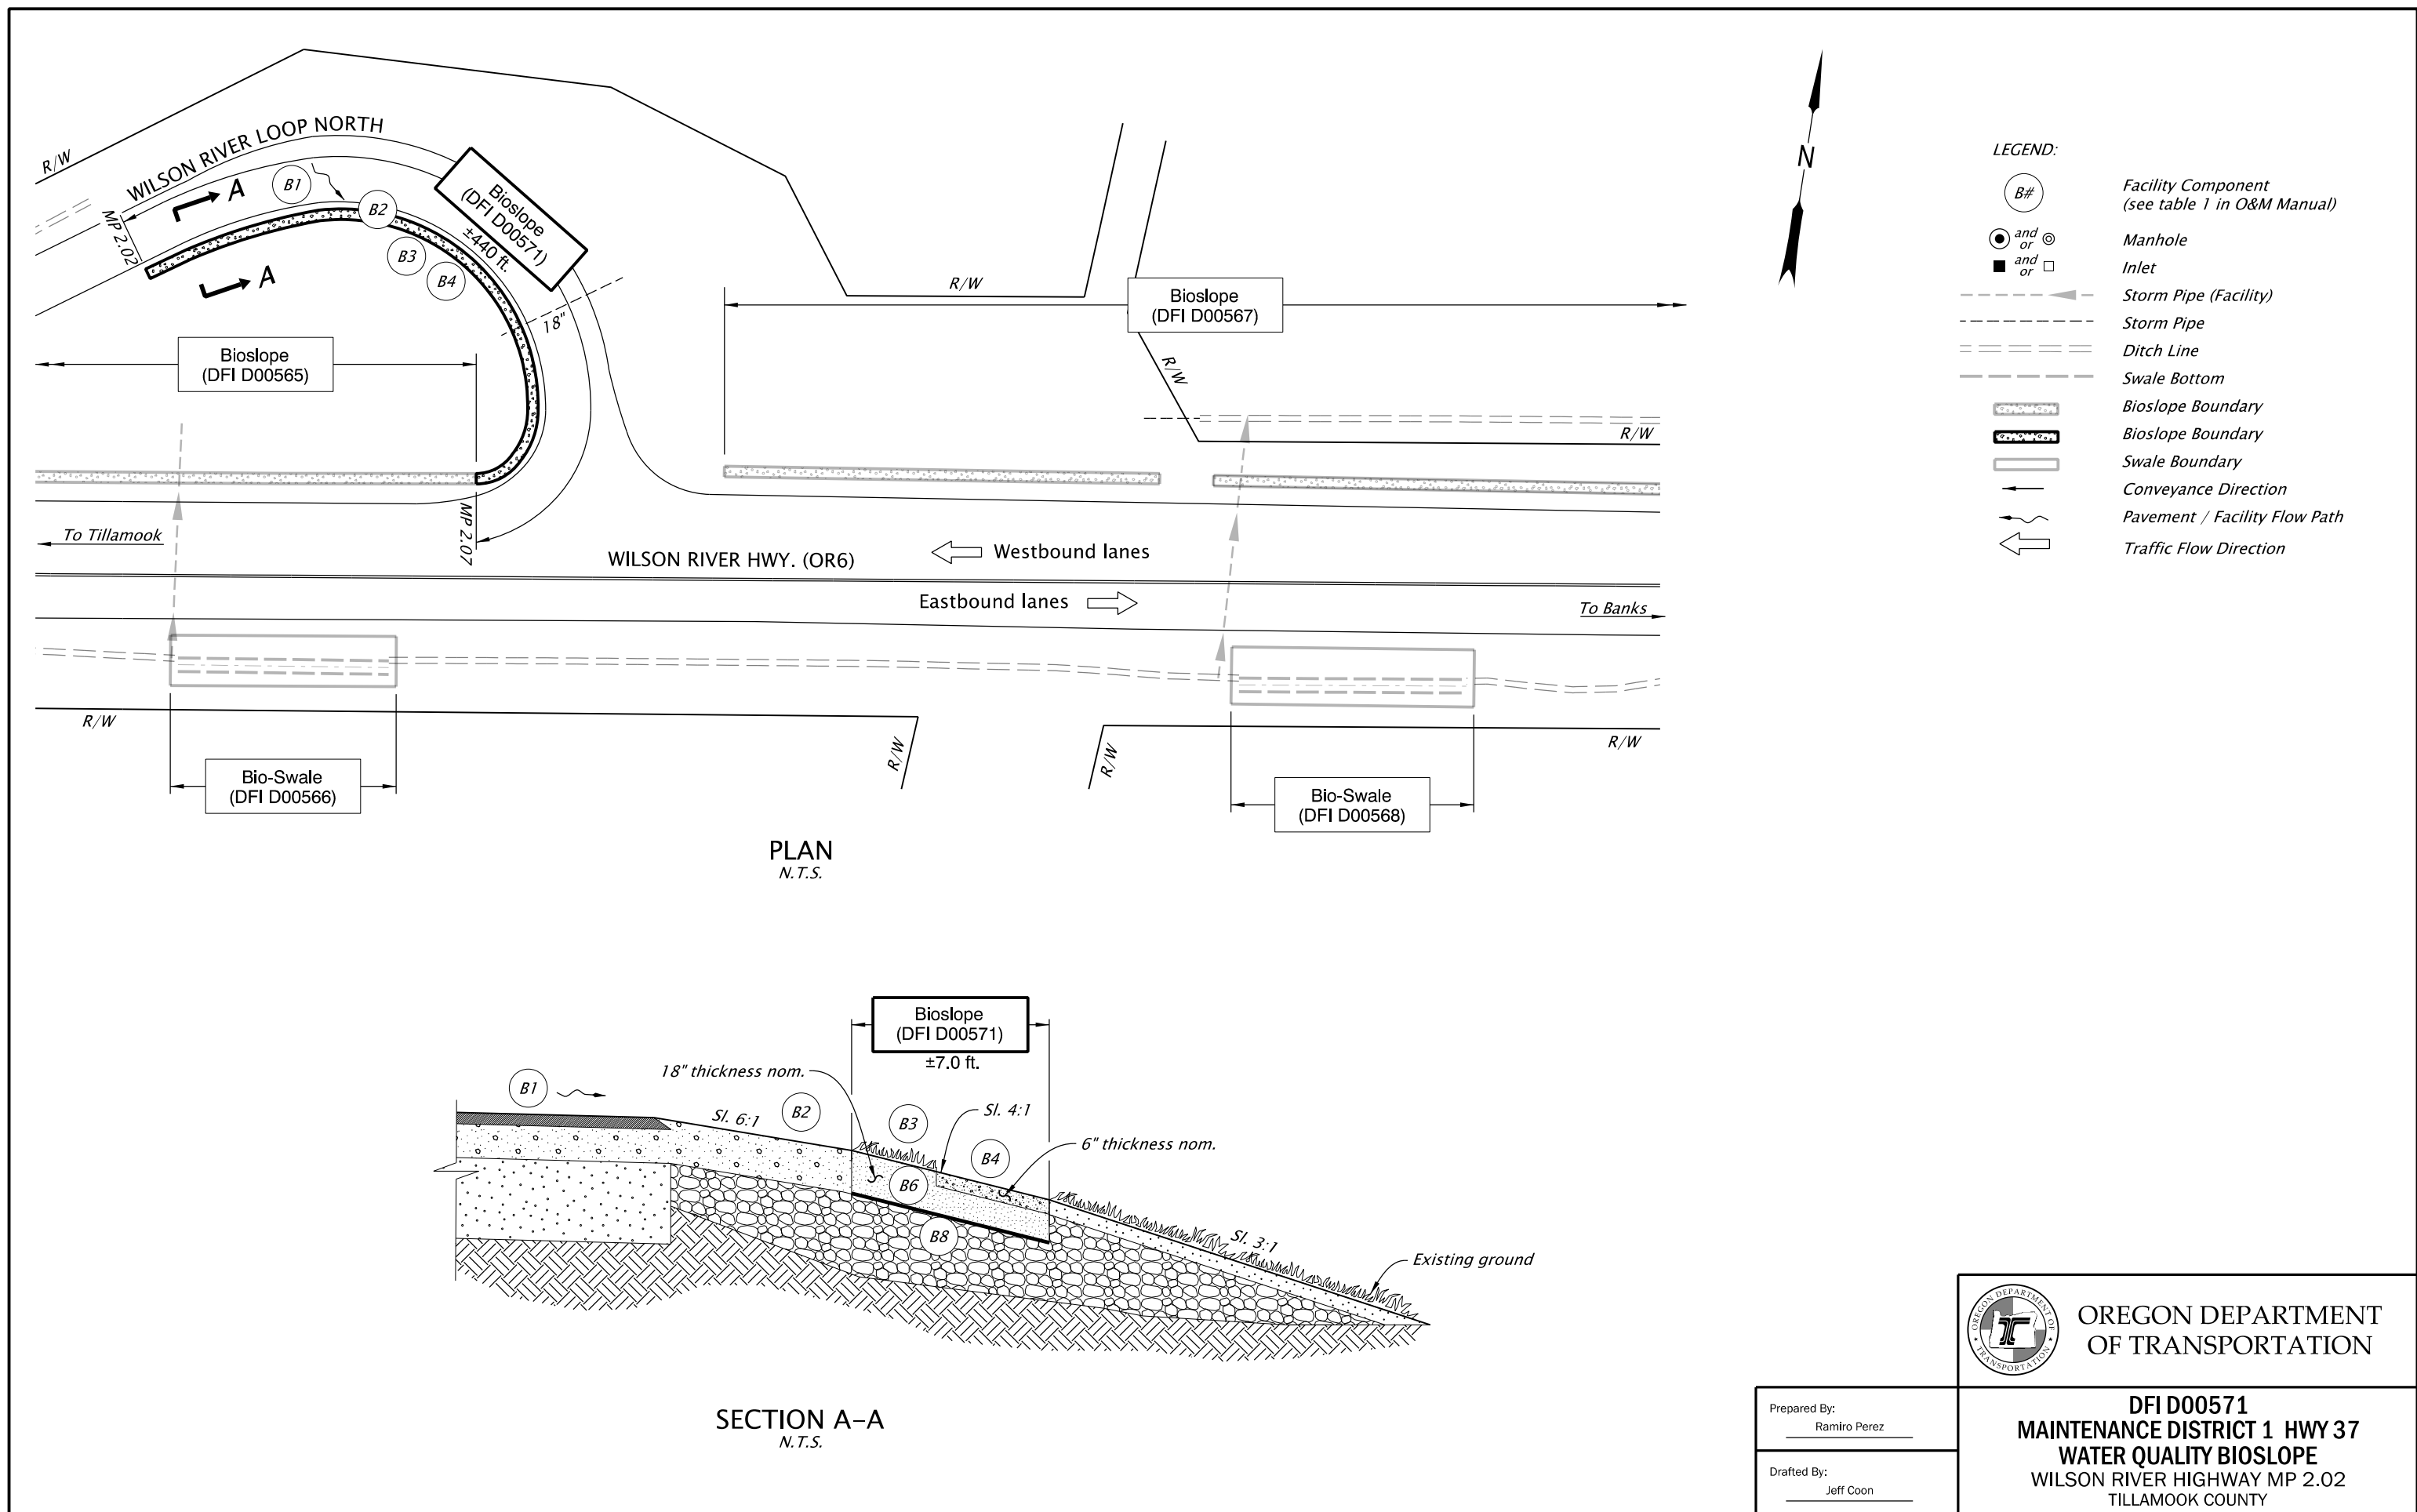

Prepared By:
Ramiro Perez

Drafted By:
Jeff Coon

DFI D00571
MAINTENANCE DISTRICT 1 HWY 37
WATER QUALITY BIOSLOPE
WILSON RIVER HIGHWAY MP 2.02
TILLAMOOK COUNTY

B Appendix B – Project Contract Plans

Contents:

Site Specific Subset of Project Contract Plan 45V-035

B-1

Facility Specific O&M Manual – Filter Strip, Bioslope
D00561, 00565, 00567 & 00571

INDEX OF SHEETS	
SHEET NO.	DESCRIPTION
1	Title Sheet
1A	Index Of Sheets Cont'd. & Std. Drg. Nos.

STATE OF OREGON
DEPARTMENT OF TRANSPORTATION

PLANS FOR PROPOSED PROJECT


GRADING, DRAINAGE, STRUCTURES, PAVING,
SIGNING, ILLUMINATION, AND ROADSIDE DEVELOPMENT

OR6 @ WILSON RIVER
LOOP ROAD SEC.

WILSON RIVER HIGHWAY

TILLAMOOK COUNTY


JUNE 2012

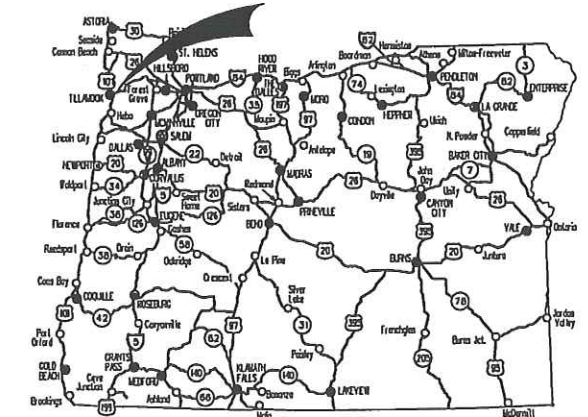

Overall Length Of Project - 1.78 Miles




BEGINNING OF PROJECT
NH-S037(026)
STA. "L" 39+50 (M.P. 0.75)

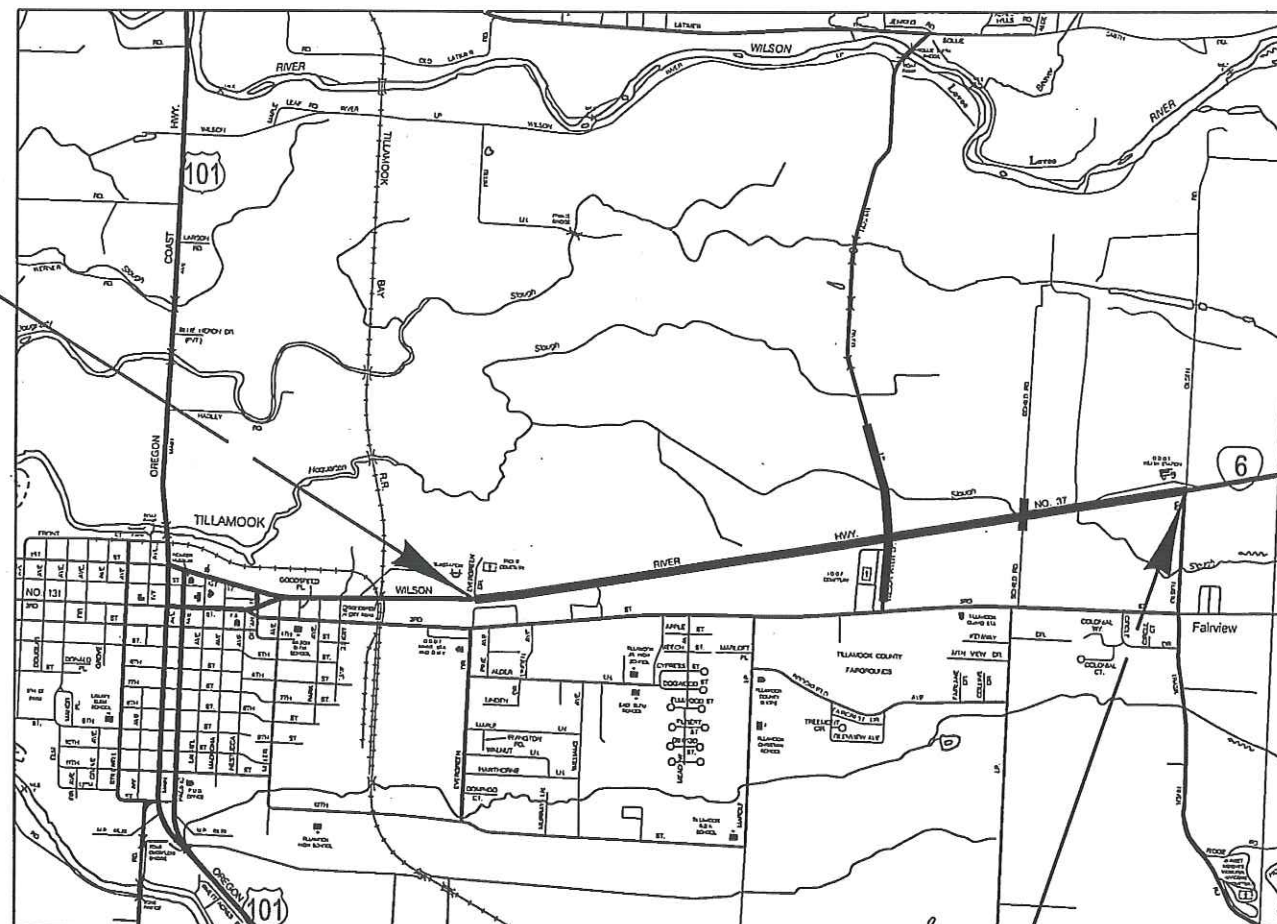

END OF PROJECT
NH-S037(026)

STA. "L" 133+35 (M.P. 2.52)

T. 1 S., R. 9 W., W.M.

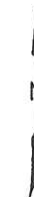

PLANS PREPARED FOR
OREGON DEPARTMENT OF TRANSPORTATION

BY:

WHPacific

3470 Pipebend Place
Suite 170
Salem, OR 97301
t: 503.362.4675 f: 503.362.5078

OREGON TRANSPORTATION COMMISSION

- | | |
|--------------------|----------------------------|
| Pat Egan | CHAIR |
| Mary F. Olson | COMMISSIONER |
| David Lohman | COMMISSIONER |
| Mark Frohnmayer | COMMISSIONER |
| Tommy Boney | COMMISSIONER |
| Matthew L. Garrett | DIRECTOR OF TRANSPORTATION |

These plans were developed using ODOT design standards. Exceptions to these standards, if any, have been submitted and approved by the ODOT Chief Engineer or their delegated authority.

Approving Authority: *Ed Chamberland* 4/25/12
Signature & date


Ed Chamberland, Sr. P.M.
Print name and title

[Signature]
Concurrence by ODOT Chief Engineer


**OR6 @ WILSON RIVER
LOOP ROAD SEC.
WILSON RIVER HIGHWAY
TILLAMOOK COUNTY**

FEDERAL HIGHWAY ADMINISTRATION	PROJECT NUMBER	SHEET NO.
OREGON DIVISION	NH-S037(026)	1

ATTENTION:
Oregon Law Requires You to Follow Rules Adopted By The Oregon Utility Notification Center. Those Rules Are Set Forth In OAR 952-001-0010 Through OAR 952-001-0090. You May Obtain Copies Of The Rules By Calling The Center. (Notes The Telephone Number For The Oregon Utility Center Is (503) 232-1987.)

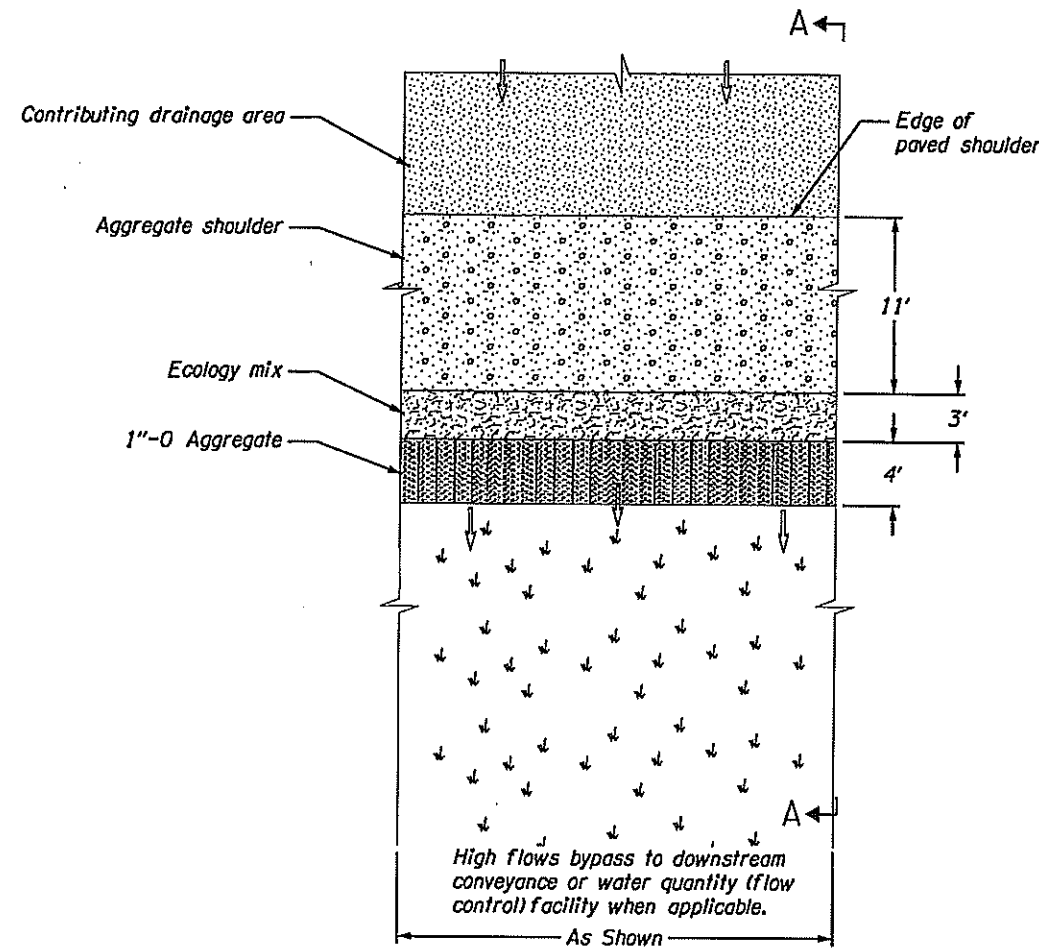


BIOSLOPE - PLAN VIEW
N.T.S.

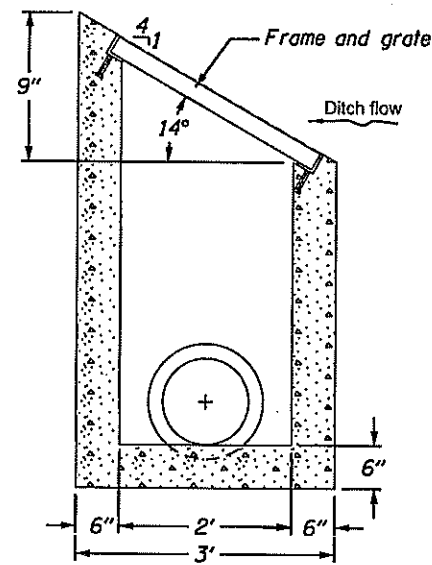


Note: Reduce standard grate and frame lengths by 4". For all other details, see drg. no. RD370.


MODIFIED TYPE D DITCH INLET
N.T.S.

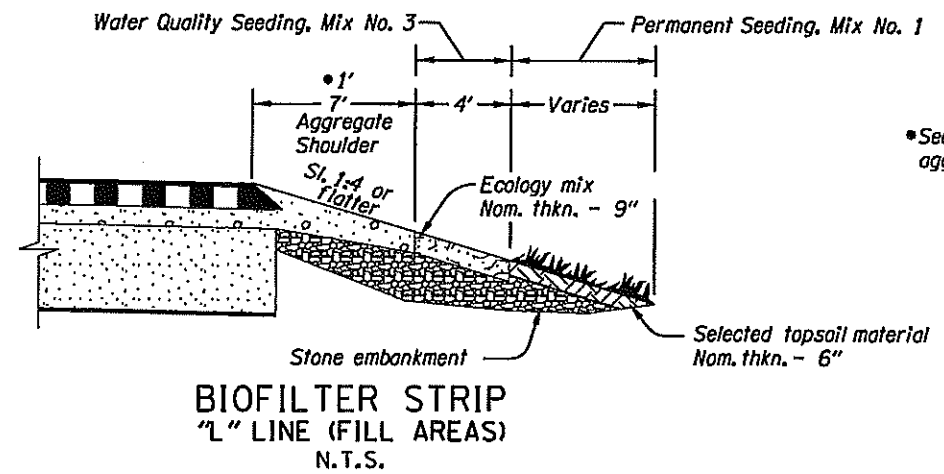


*See shts. 2 thru 2A-9 for aggregate shoulder width.

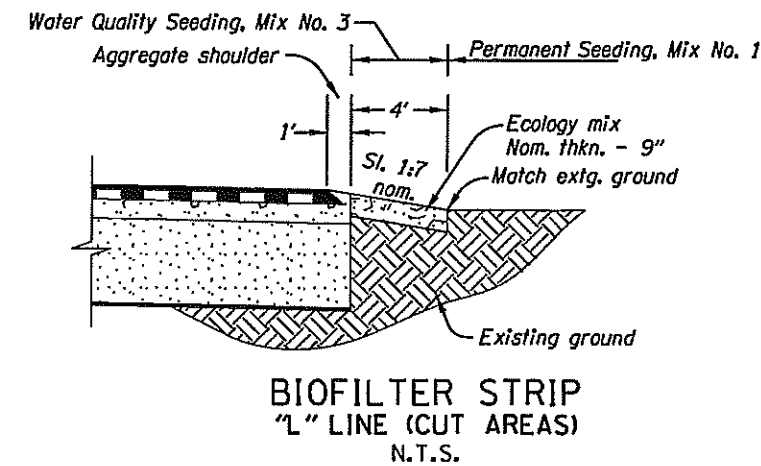

BIOFILTER STRIP
"L" LINE (CUT AREAS)
N.T.S.

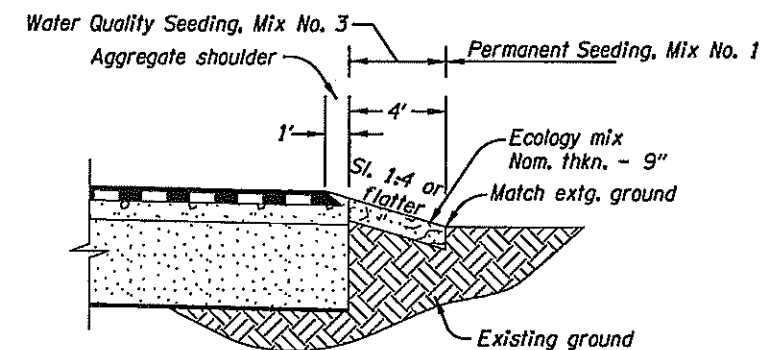


BIOFILTER STRIP
"WRLN" LINE
N.T.S.

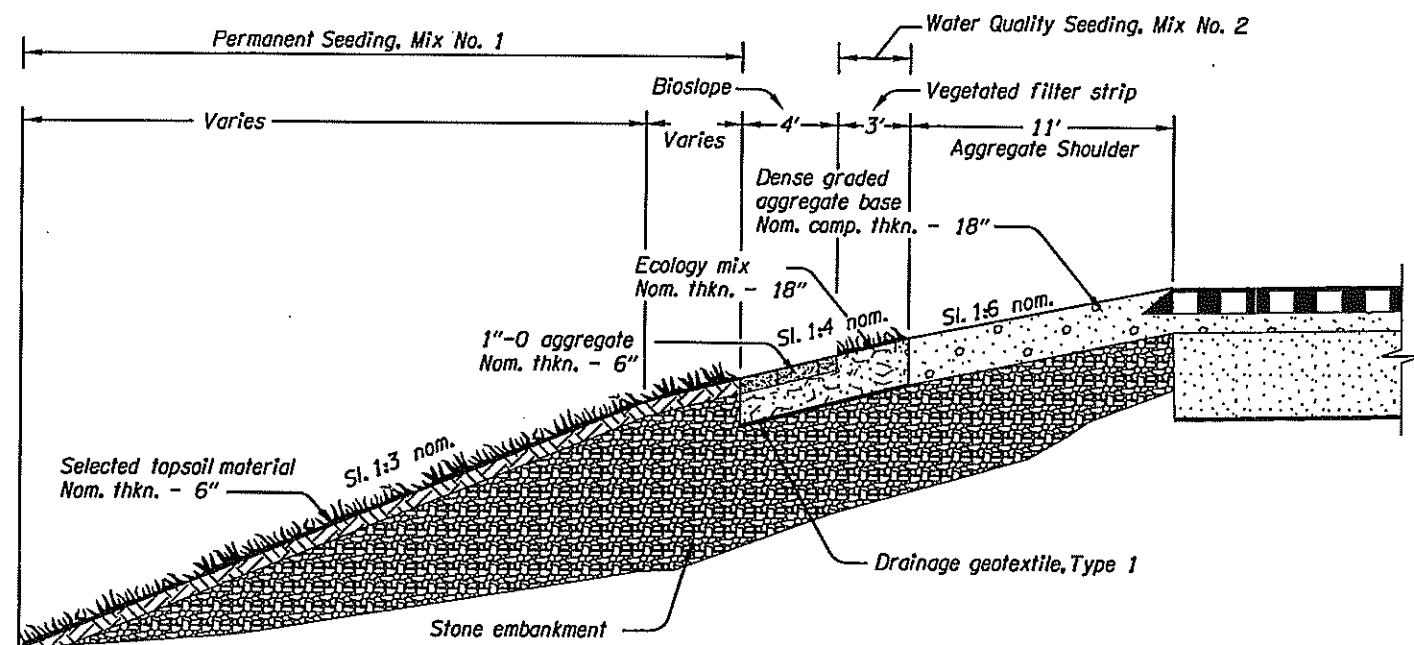

SECTION A-A
N.T.S.

Note: See GN series for seed mix in ditches, wetland mitigation areas, bioslopes, bioswales, biofilter strips, and biofiltration pond.

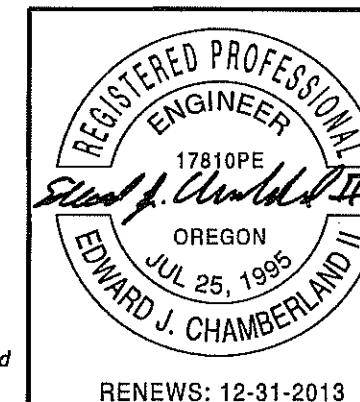

OREGON DEPARTMENT OF TRANSPORTATION


WHPacific 3470 Pipebend Place Suite 170
Salem, OR 97301
t: 503.362.4675 f: 503.362.5078

OR6 @ WILSON RIVER
LOOP ROAD SEC.
WILSON RIVER HIGHWAY
TILLAMOOK COUNTY

Design Team Leader - Ed Chamberland
Designed By - Calvin Larwood, Devin Darling
Drafted By - Linda Foote

STORMWATER DETAILS


SHEET NO.
GJ

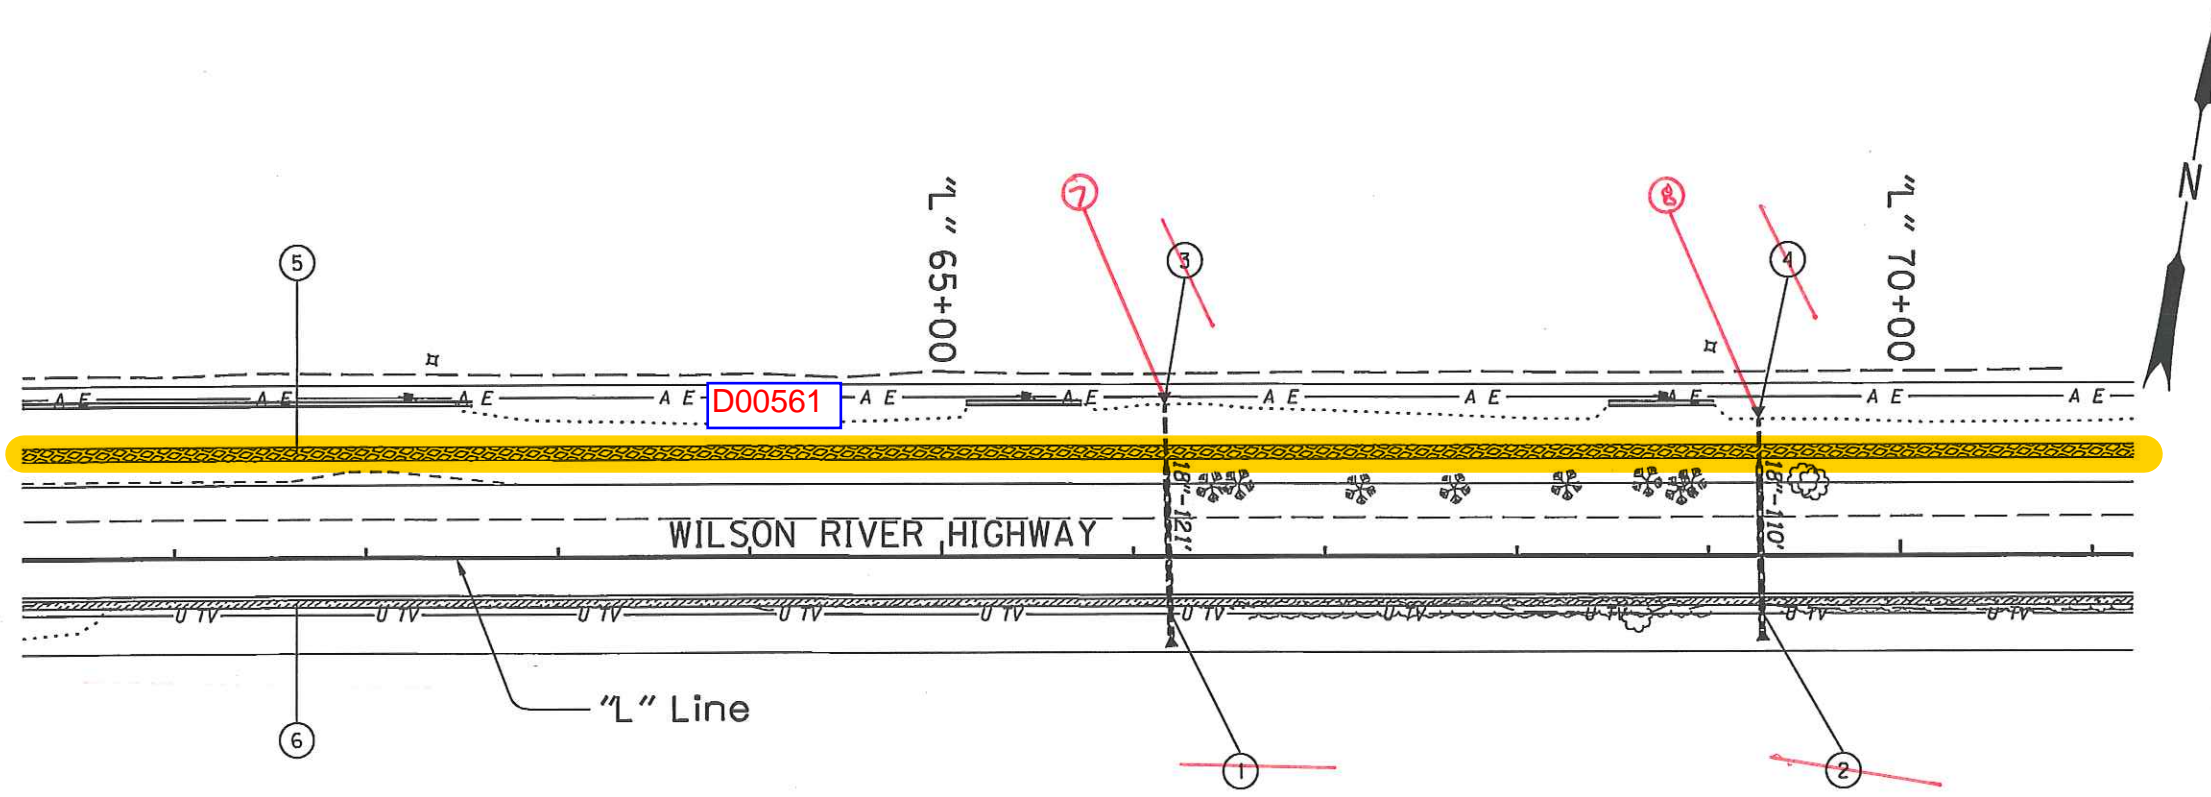


- ① Sta. "L" 66+17
Remove 18" pipe - 92'
- ② Sta. "L" 69+26
Remove 18" pipe - 92'
- ③ Sta. "L" 66+17, 80' Lt. to 41' Rt.
Inst. 18" culv. pipe - 121', 5' depth
Sl.=2.08%
I.E.=13.40' (N)
I.E.=15.92' (S)
Const. paved end slope, Lt. & Rt. - 55 sq.ft.
- ④ Sta. "L" 69+26, 71.5' Lt. to 38.5' Rt.
Inst. 18" culv. pipe - 110', 5' depth
Sl.=0.5%
I.E.=15.68' (N)
I.E.=16.22' (S)
Const. paved end slope, Lt. & Rt. - 55 sq.ft.
- ⑤ See Sht. GJ-7, note 6
Const. bioslope
- ⑥ See Sht. GJ-7, note 7
Const. biofilter strip
- ⑦ STA "L" 66+17. 80' LT to 41' RT
EXTEND 18" CULVERT 20' LEFT
AND EXTEND 10' RT
Construct paved End Slope Lt & RT
- ⑧ STA "L" 69+26 71.5' Lt to 38.5' RT
Extend 18" Culvert 20' LEFT
Extend 10' RT
Construct Paved End Slopes Lt & RT

REVISED AS CONSTRUCTED
CONTRACT 14479



Dave True
Dave True, Project Manager
DATE: 2/26/14

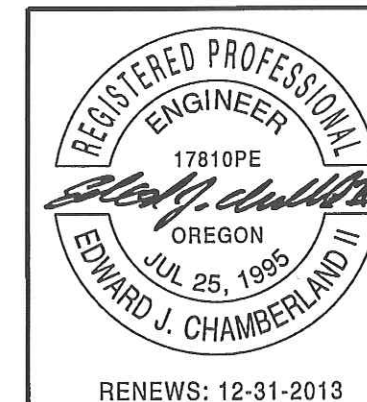

WHPacific 3470 Pipebend Place Suite 170 Salem, OR 97301 t: 503.362.4675 f: 503.362.5078	
OR6 @ WILSON RIVER LOOP ROAD SEC. WILSON RIVER HIGHWAY TILLAMOOK COUNTY	
Design Team Leader - Ed Chamberland Designed By - Calvin Larwood, Devin Doring Drafted By - Linda Foote	
STORMWATER PLAN	SHEET NO. GJ-8

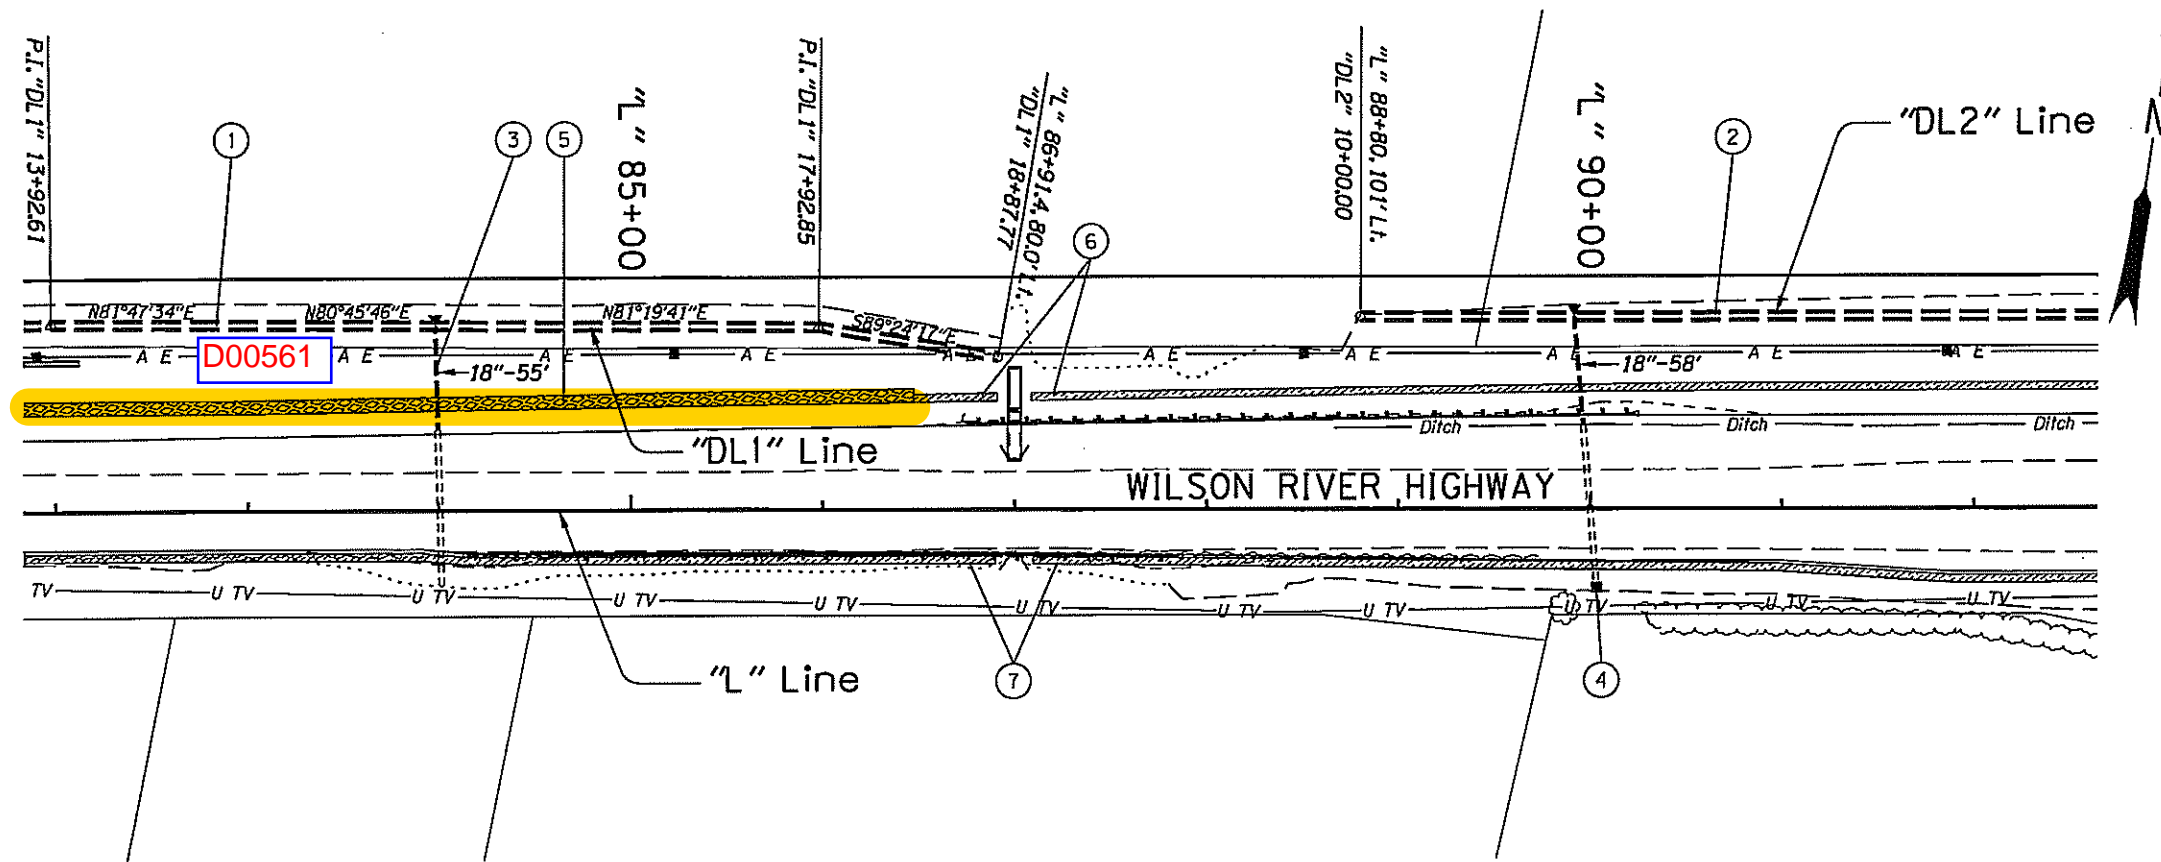

- ① See Sht. GJ-9, note 1
Const. ditch
- ② Sta. "DL2" 10+00 to Sta. "DL2" 17+05
Const. ditch
"V" bottom, 1:4 slopes
- ③ Sta. "L" 83+98
Extend 18" culv. pipe 55' Lt., 5' depth
Match extg. slope
Const. paved end slope, Lt. - 35 sq.ft.
- ④ Sta. "L" 89+96
Const. modified Type D ditch inlet
Extend 18" culv. pipe 58' Lt., 5' depth
Rim=20.3'
Match extg. slope
Const. paved end slope, Lt. - 35 sq.ft.
(For details, see sht. GJ)
- ⑤ See Sht. GJ-7, note 6
Const. bioslope
- ⑥ Sta. "L" 86+48 to Sta. "L" 100+00, Lt.
Const. biofilter strip, DF1# D00562
(For details, see sht. GJ)
- ⑦ See Sht. GJ-7, note 7
Const. biofilter strip

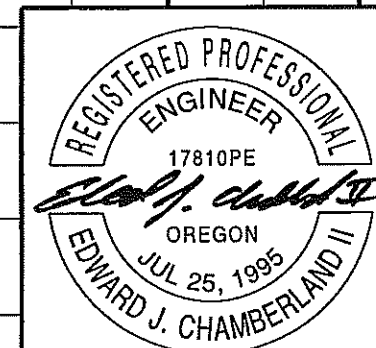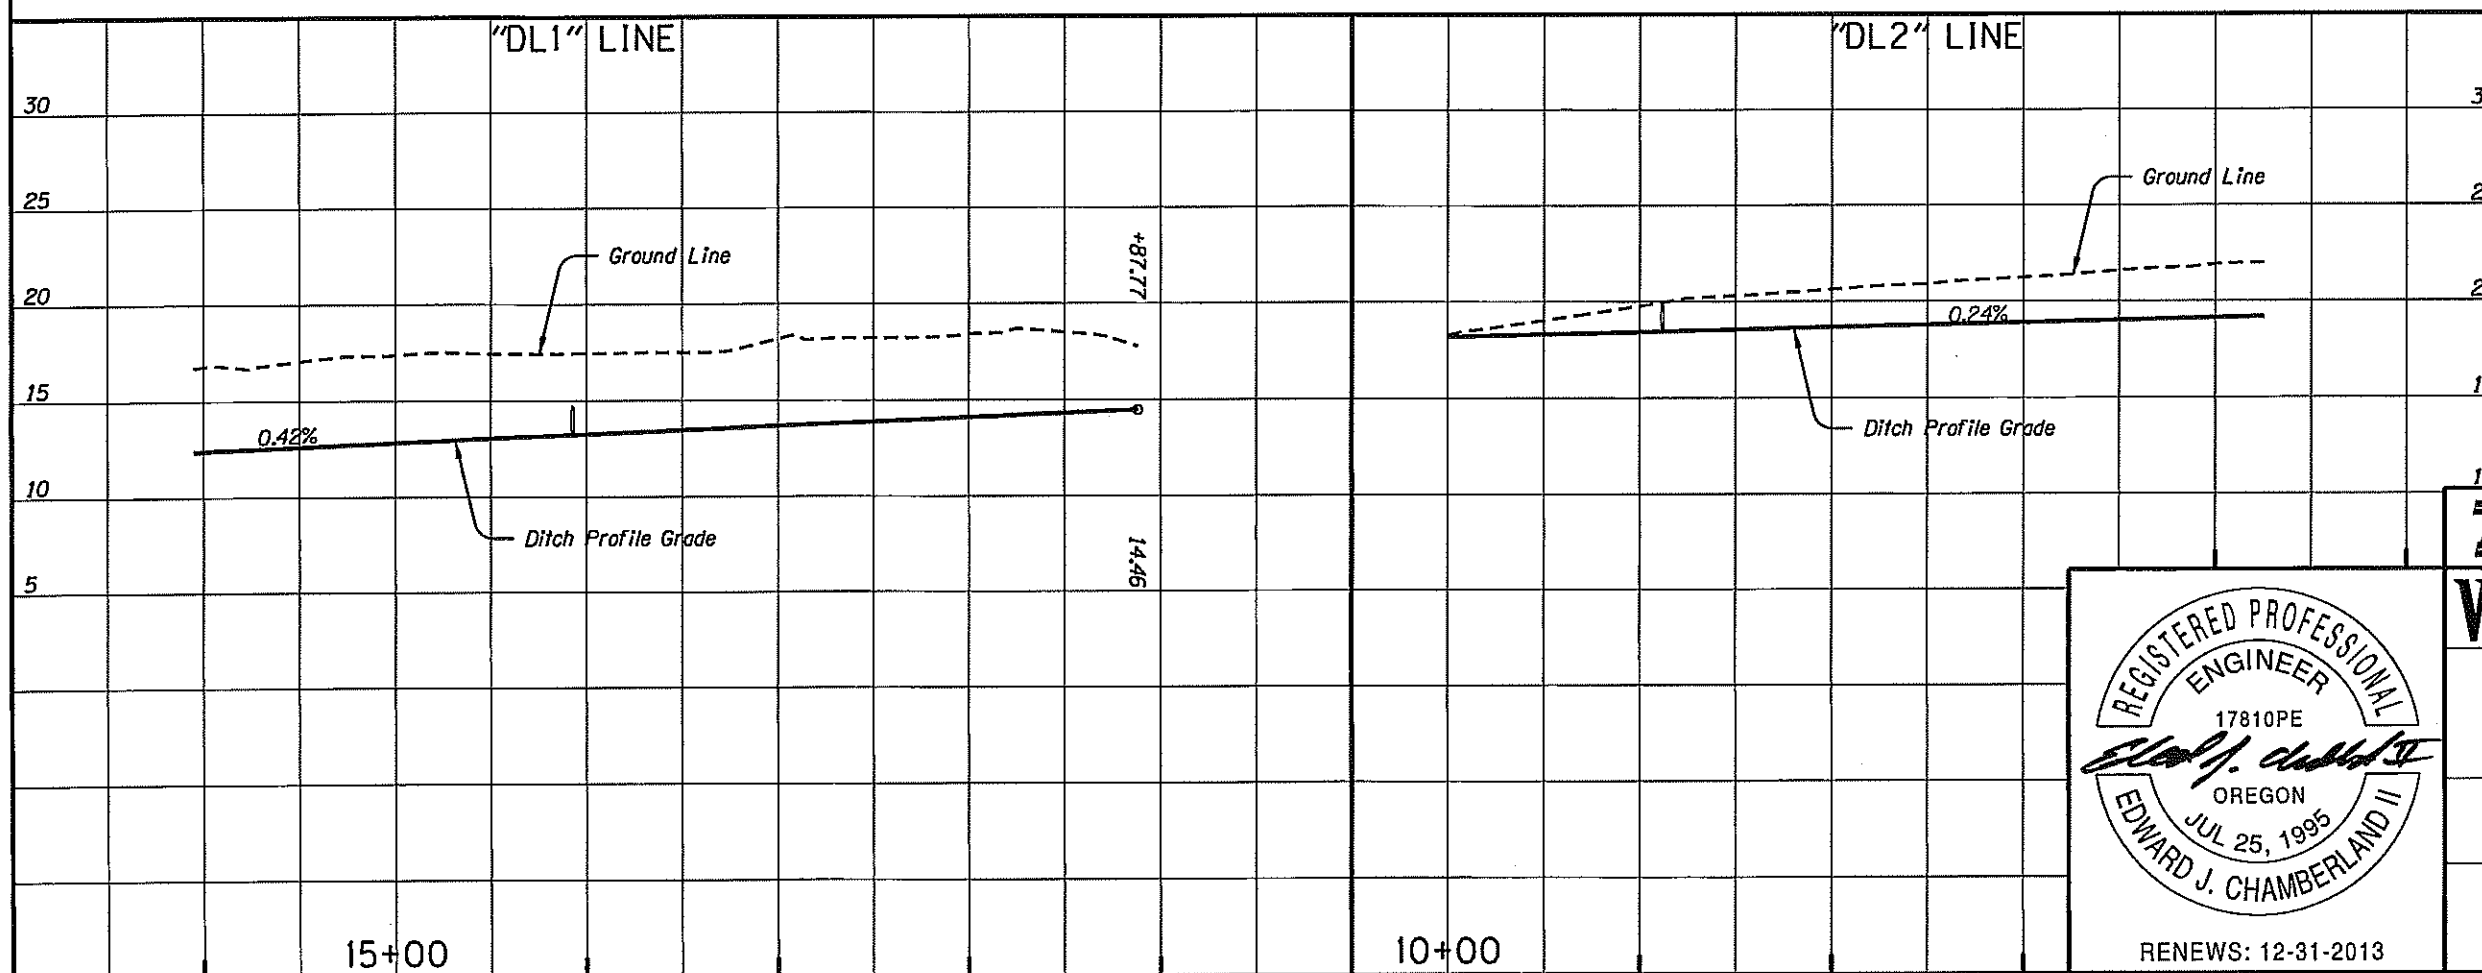

RENEWS: 12-31-2013

OREGON DEPARTMENT OF TRANSPORTATION


WHPacific 3470 Pipebend Place Suite 170
Salem, OR 97301
t: 503.362.4675 f: 503.362.5078

OR6 @ WILSON RIVER LOOP ROAD SEC.
WILSON RIVER HIGHWAY
TILLAMOOK COUNTY

Design Team Leader - Ed Chamberland
Designed By - Calvin Larwood, Devin Doring
Drafted By - Linda Foote

STORMWATER PLAN & PROFILE

SHEET NO. **GJ-10**

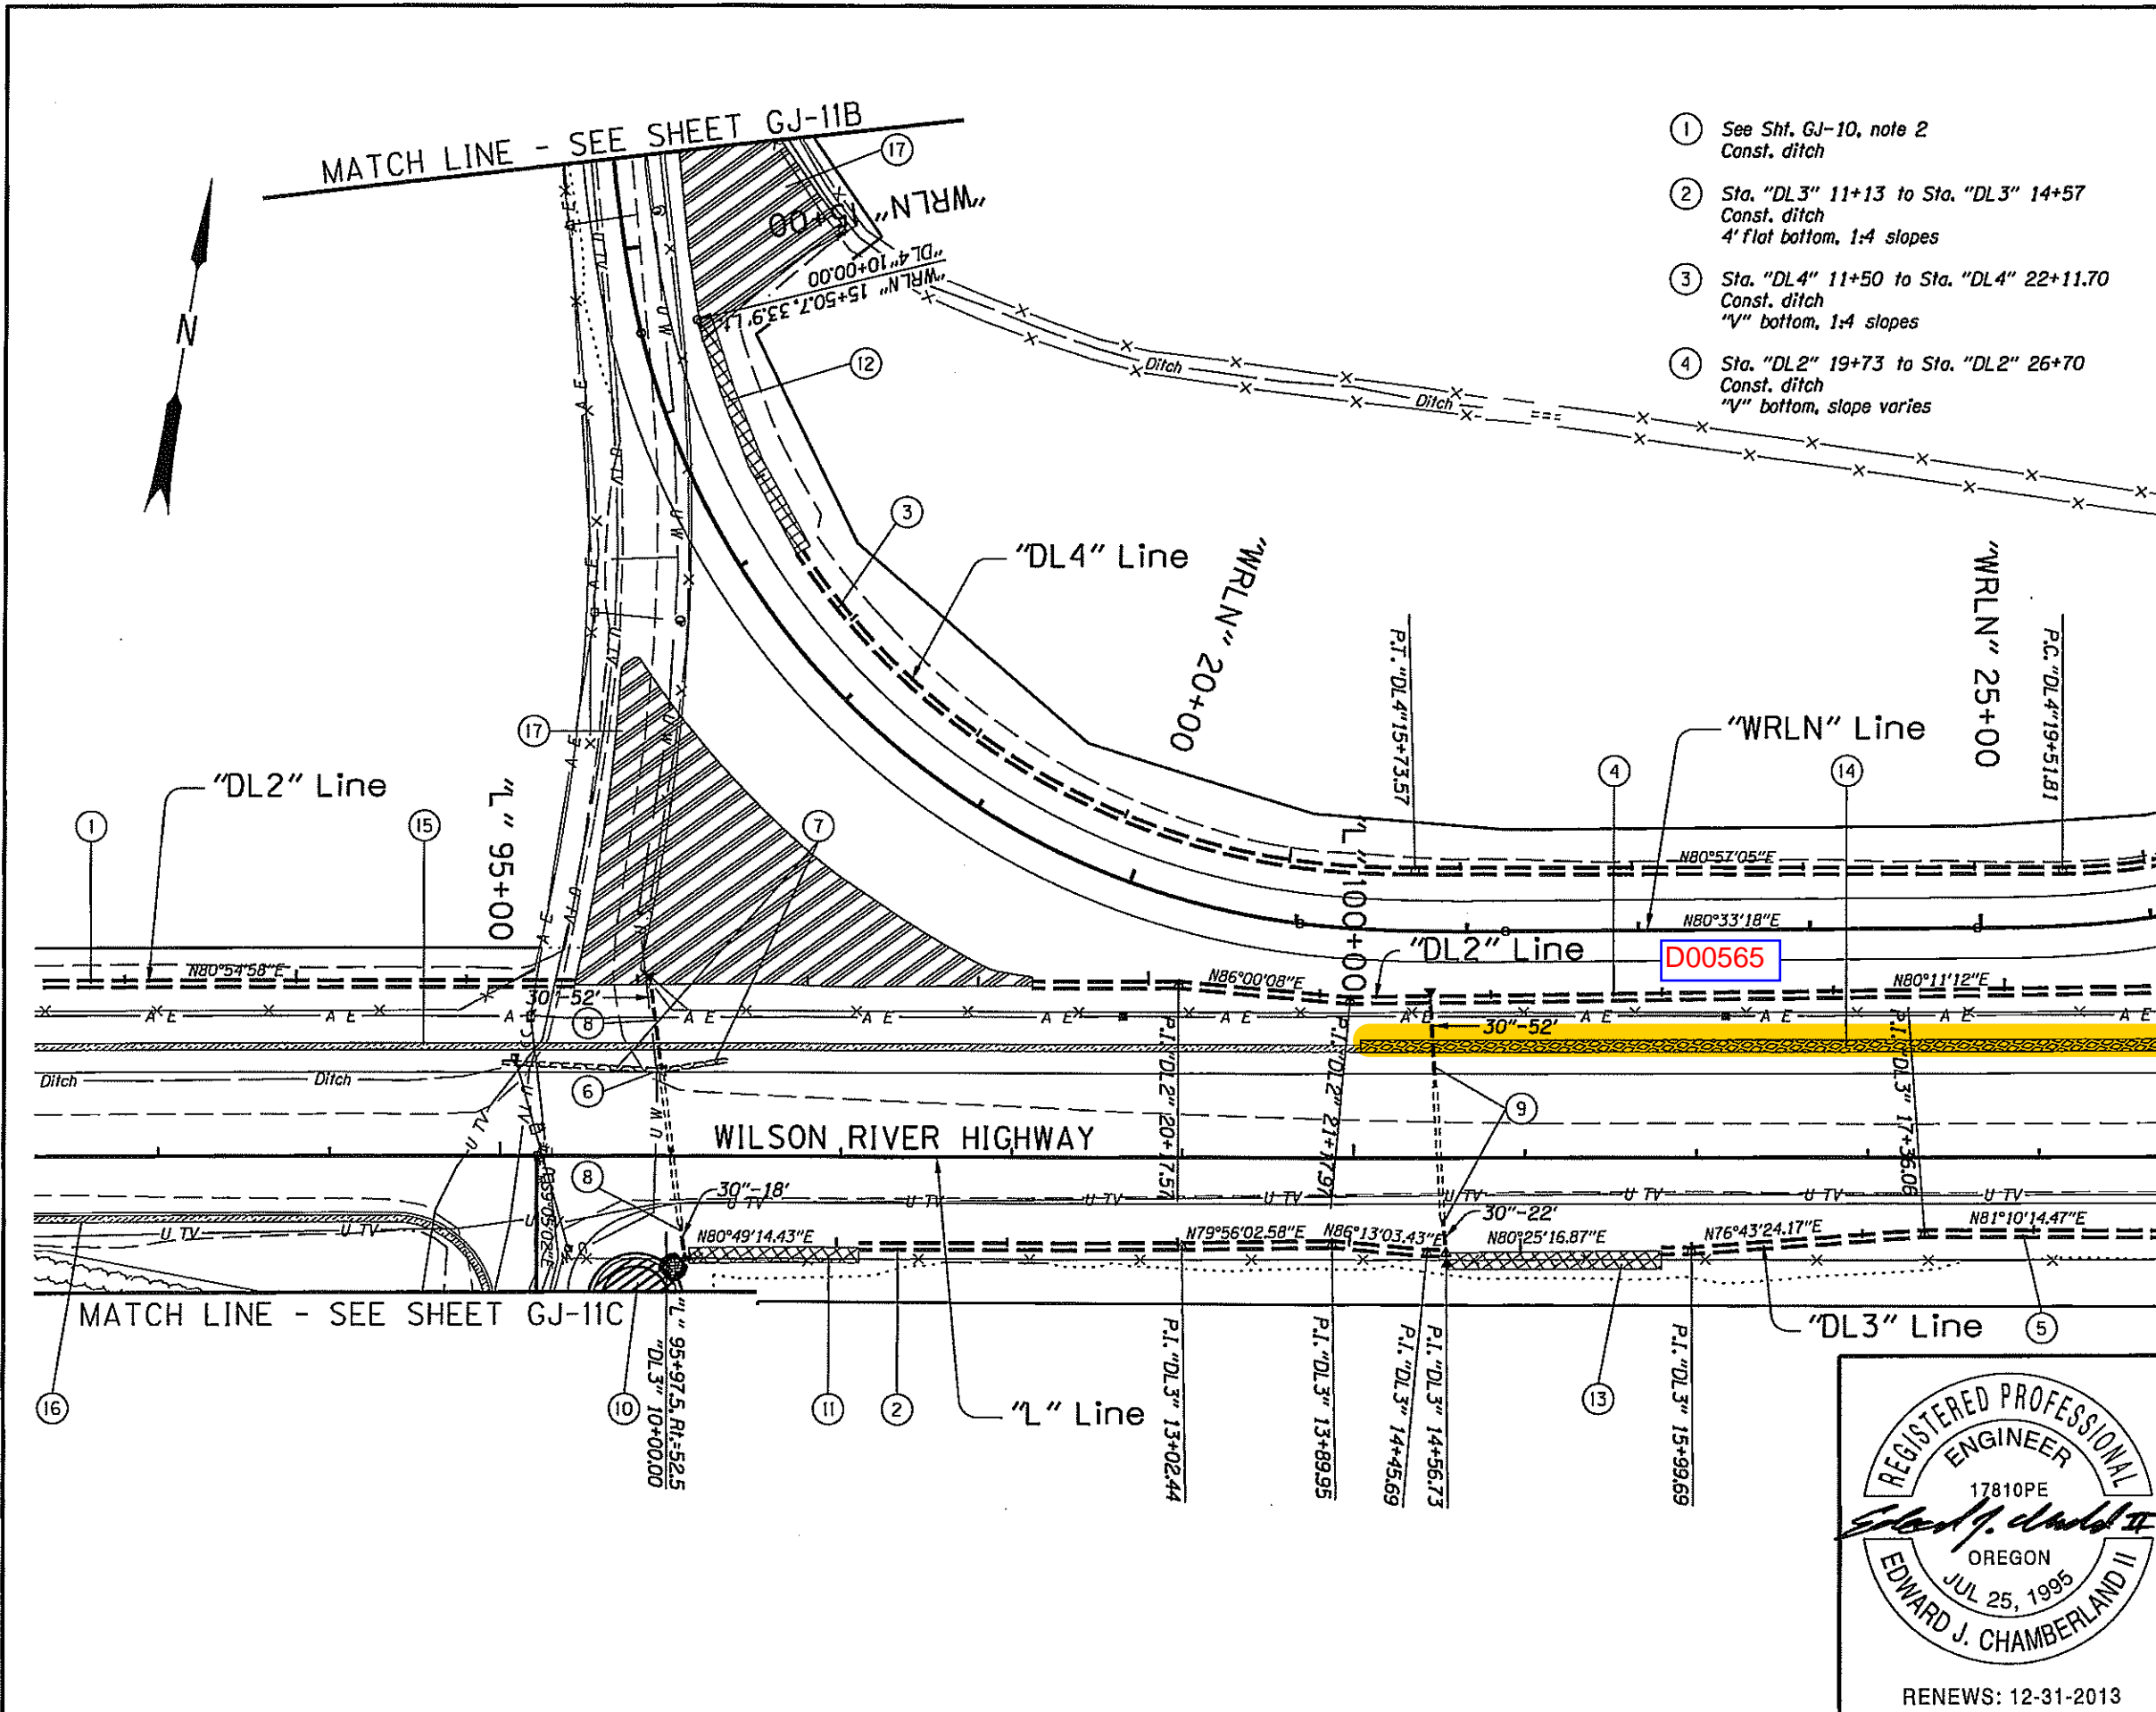

- ① See Sht. GJ-10, note 2
Const. ditch
- ② Sta. "DL3" 11+13 to Sta. "DL3" 14+57
Const. ditch
4' flat bottom, 1:4 slopes
- ③ Sta. "DL4" 11+50 to Sta. "DL4" 22+11.70
Const. ditch
"V" bottom, 1:4 slopes
- ④ Sta. "DL2" 19+73 to Sta. "DL2" 26+70
Const. ditch
"V" bottom, slope varies
- ⑤ Sta. "DL3" 15+82 to Sta. "DL3" 21+05
Const. ditch
4' flat bottom, 1:4 slopes
- ⑥ Sta. "L" 95+94, 50' Lt.
Remove storm junction box
- ⑦ Sta. "L" 95+01, 54.4' Lt.
Remove 36" pipes - 133'
- ⑧ Sta. "L" 96+00
Extend 30" culv. pipe - 52' Lt., 5' depth
- 18' Rt., 5' depth
Match extg. slope
Const. paved end slope, Lt. & Rt. - 70 sq.ft.
- ⑨ Sta. "L" 100+50
Extend 30" culv. pipe - 52' Lt., 5' depth
- 22' Rt., 5' depth
Match extg. slope
Const. paved end slope, Lt. & Rt. - 110 sq.ft.
- ⑩ Const. biofiltration pond, DF1# D00572
(For details, see sht. GJ-3)
- ⑪ Sta. "DL3" 10+00 to Sta. "DL3" 11+13
Const. bioswale, DF1# D00563
(For details, see sht. GJ-2)
- ⑫ Sta. "DL4" 10+00 to Sta. "DL4" 11+50
Const. bioswale, DF1# D00570
(For details, see sht. GJ-2)
- ⑬ Sta. "DL3" 14+57 to Sta. "DL3" 15+82
Const. bioswale, DF1# D00564
(For details, see sht. GJ-2)
- ⑭ Sta. "L" 100+00 to Sta. "L" 109+00, Lt.
Const. bioslope, DF1# D00565
(For details, see sht. GJ)
- ⑮ See Sht. GJ-10, note 6
Const. biofilter strip
- ⑯ See Sht. GJ-7, note 7
Const. biofilter strip
- ⑰ Const. wetlands shown thus
(For drg. nos., see sht. 1A)

OREGON DEPARTMENT OF TRANSPORTATION

WHPacific 3470 Pipebend Place Suite 170
Salem, OR 97301
t: 503.362.4675 f: 503.362.5078

**ORG @ WILSON RIVER
LOOP ROAD SEC.
WILSON RIVER HIGHWAY
TILLAMOOK COUNTY**

Design Team Leader - Ed Chamberland
Designed By - Calvin Lorwood, Devin Doring
Drafted By - Linda Foote


STORMWATER PLAN SHEET NO. **GJ-11**

REGISTERED PROFESSIONAL ENGINEER
17810PE
Edward J. Chamberland II
OREGON
JUL 25, 1995
EDWARD J. CHAMBERLAND II
RENEWS: 12-31-2013


① Sta. "DL5" 9+75 to "DL5" 10+20, 110' Lt.
Inst. 48" culv. pipe - 45', 5' depth
Sl.=1.0%
I.E.=25.60
I.E.=26.05'
Const. sloped end

- ① See Sht. GJ-11, note 3
Const. ditch
- ② See Sht. GJ-11, note 4
Const. ditch
- ③ See Sht. GJ-11, note 5
Const. ditch
- ④ Sta. "DL3" 22+45 to Sta. "DL3" 28+12
Const. ditch
4' flat bottom, 1:4 slopes
- ⑤ Sta. "DL5" 9+75 to Sta. "DL5" 19+49.80
Const. ditch
Width varies, slope varies

- ⑥ Sta. "DL3" 29+62 to Sta. "DL3" 47+43.80
Const. ditch
4' flat bottom, 1:4 slopes
- ⑦ Sta. "L" 112+47, 41' Rt.
Remove 24" pipe - 45'
- ⑧ Sta. "L" 112+70, 59' Lt.
Remove 48" pipe - 66'
- ⑨ Sta. "L" 114+00, 59' Rt.
Remove 24" pipe - 50'
- ⑩ Sta. "L" 107+00
Extend 24" culv. pipe - 59' Lt., 5' depth
- 19' Rt., 5' depth
Match extg. slope
Const. paved end slope, Lt. & Rt. - 88 sq.ft.
- ⑪ Sta. "L" 114+00
Extend 36" culv. pipe - 61' Lt., 5' depth
- 25' Rt., 5' depth
Match extg. slope
Const. paved end slope, Lt. & Rt. - 115 sq.ft.
- ⑫ Sta. "WRLN" 31+50, 42' Lt. to 39' Rt.
Inst. 18" culv. pipe - 81', 5' depth
Sl.=1.25%
I.E.=25.00' (SW)
I.E.=26.00' (NE)
Const. paved end slope, Lt. & Rt. - 70 sq.ft.
- ⑬ Sta. "DL3" 21+05 to Sta. "DL3" 22+45
Const. bioswale, DF1# D00566
(For details, see sht. GJ-2)
- ⑭ Sta. "DL3" 28+12 to Sta. "DL3" 29+62
Const. bioswale, DF1# D00568
(For details, see sht. GJ-2)
- ⑮ Sta. "WRLN" 28+20 to Sta. "WRLN" 32+60
Const. bioslope, DF1# D00571
- ⑯ See Sht. GJ-11, note 14
Const. bioslope
- ⑰ Sta. "L" 110+60 to Sta. "L" 122+00
Const. bioslope, DF1# D00567
(For details, see sht. GJ)
- ⑱ Const. wetlands shown thus
(For drg. nos., see sht. 1A)

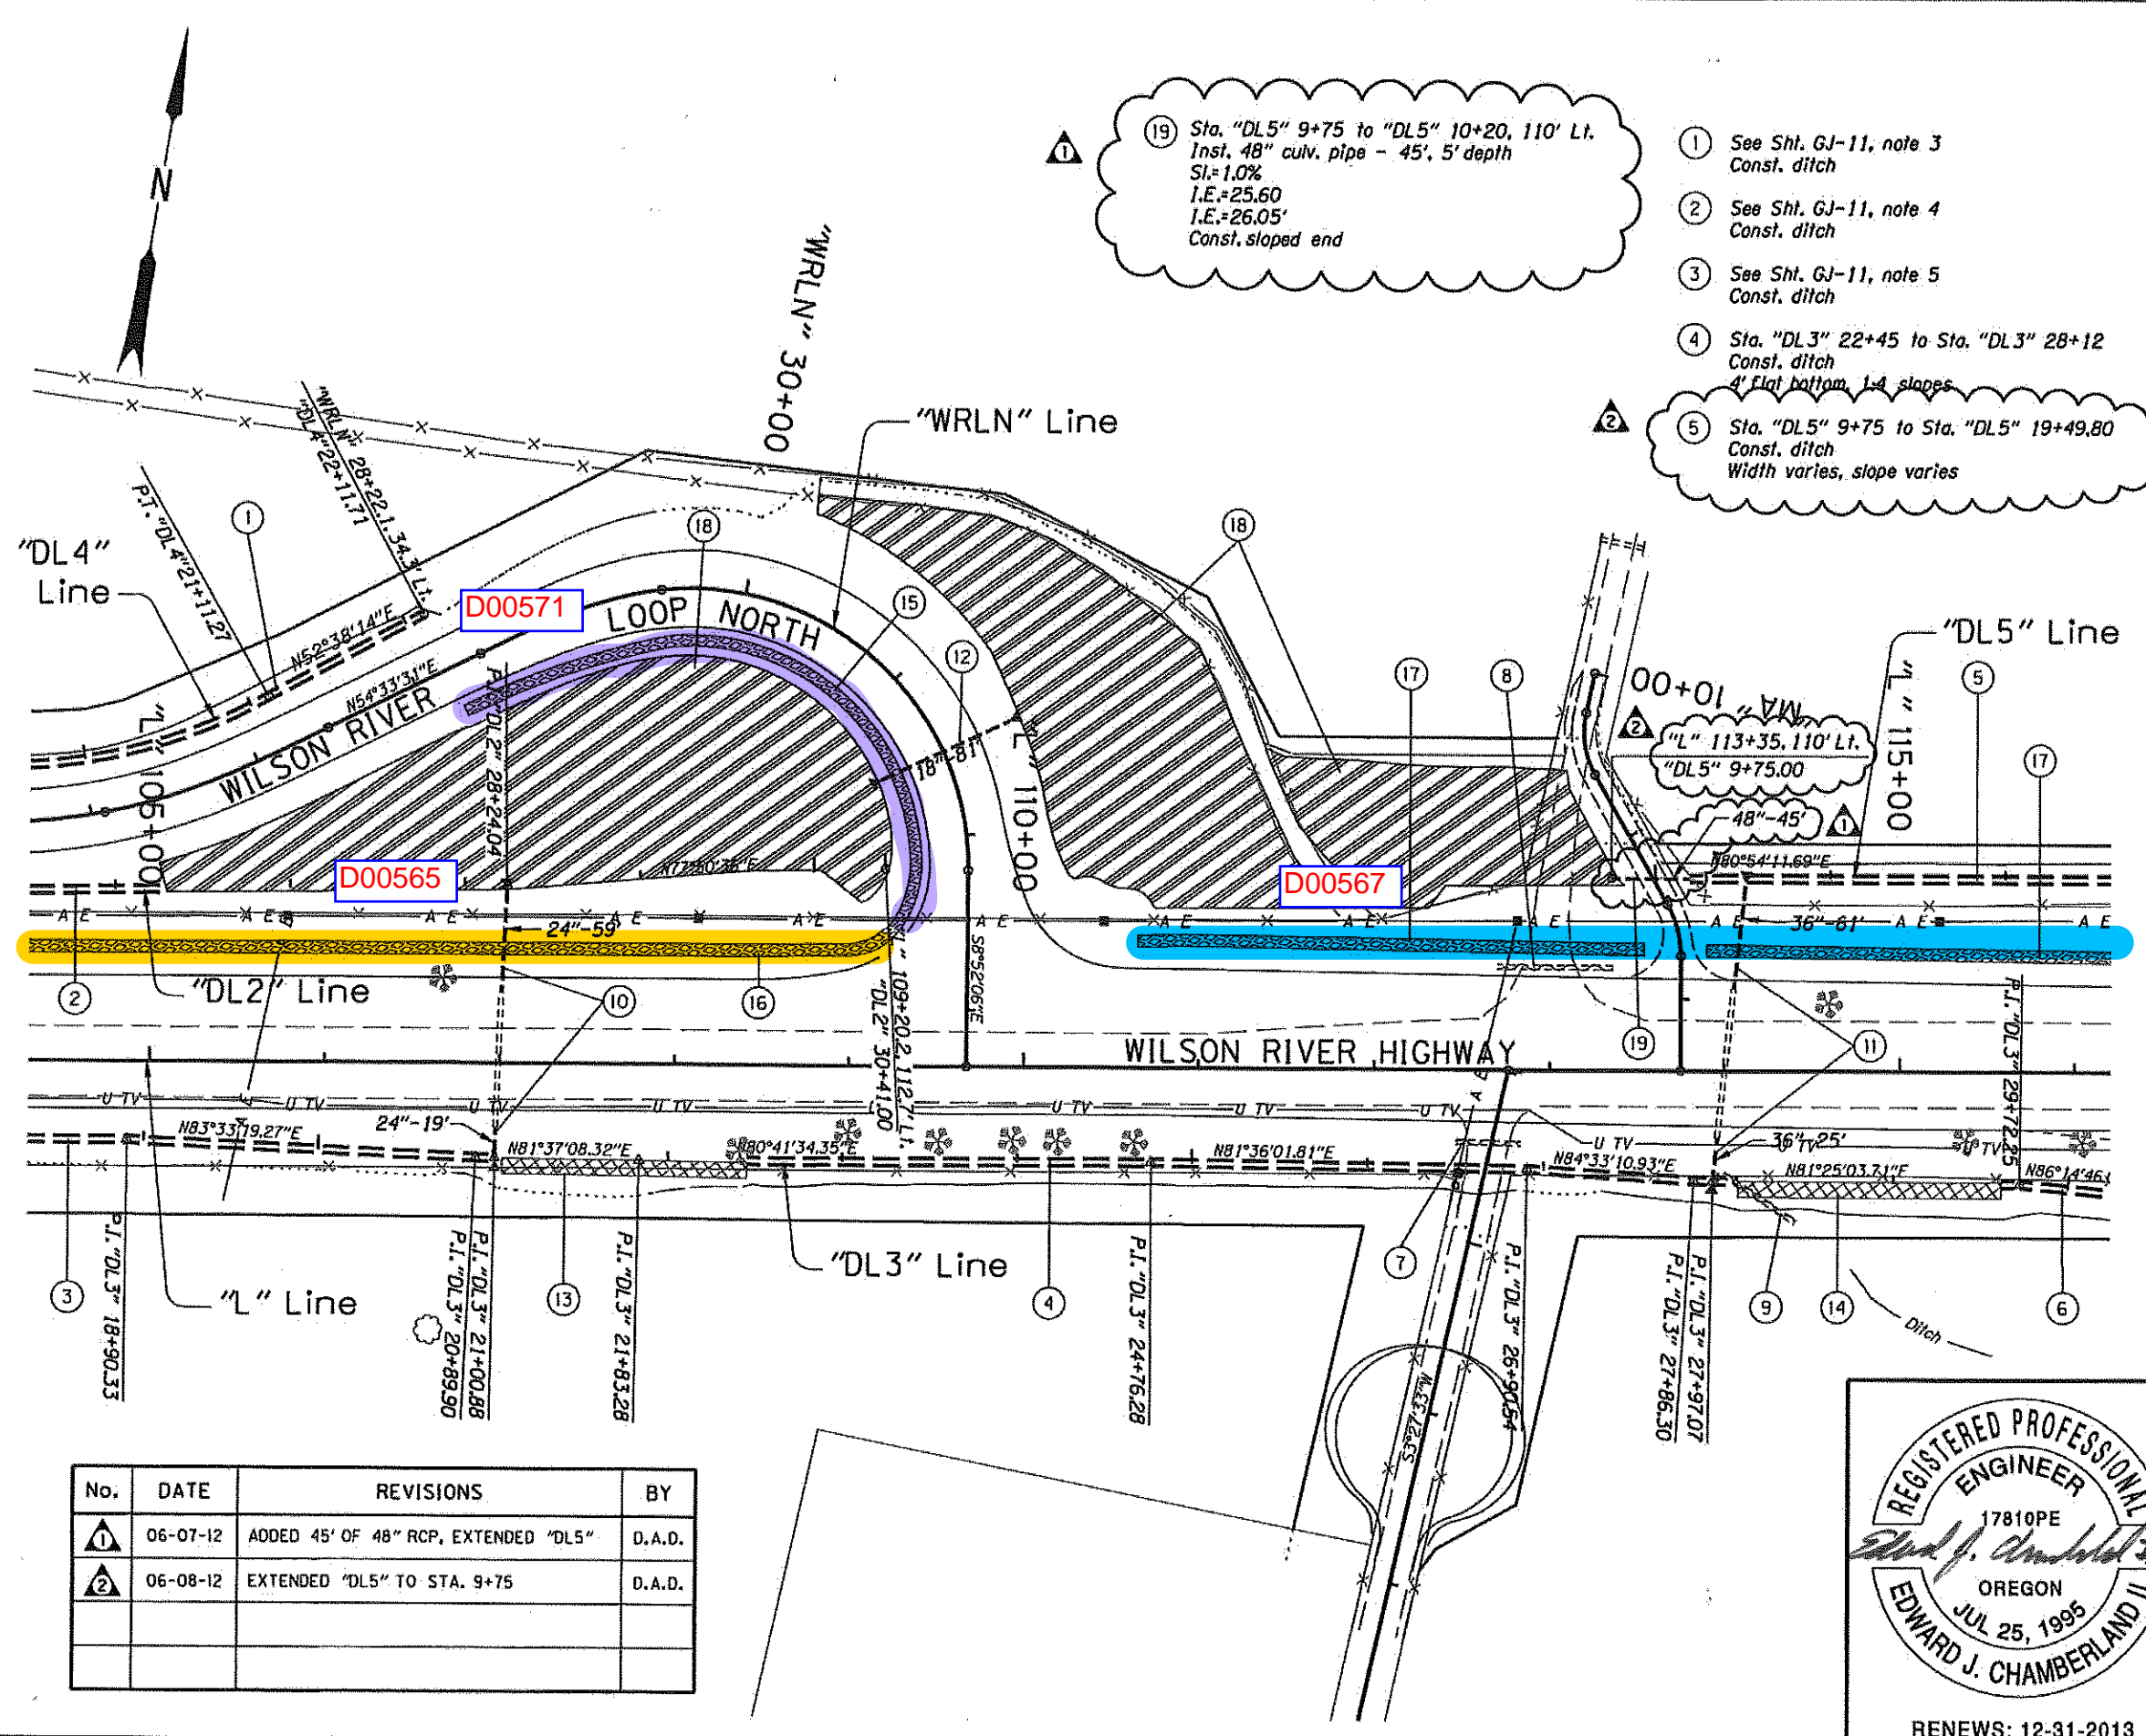

No.	DATE	REVISIONS	BY
①	06-07-12	ADDED 45' OF 48" RCP, EXTENDED "DL5"	D.A.D.
②	06-08-12	EXTENDED "DL5" TO STA. 9+75	D.A.D.

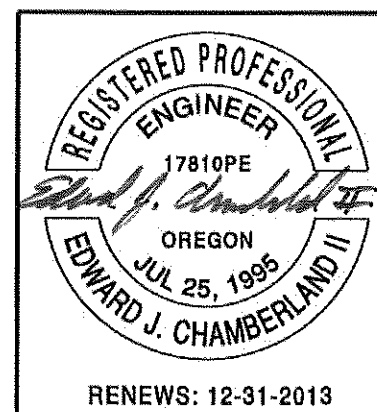

OREGON DEPARTMENT OF TRANSPORTATION

WHPacific 3470 Pipebend Place Suite 170
Salem, OR 97301
t: 503.362.4675 f: 503.362.5078


**OR6 @ WILSON RIVER
LOOP ROAD SEC.
WILSON RIVER HIGHWAY
TILLAMOOK COUNTY**

Design Team Leader - Ed Chamberland
Designed By - Calvin Larwood, Devin Doring
Drafted By - Linda Foote


STORMWATER PLAN

RENEWS: 12-31-2013

SHEET NO. **GJ-12**

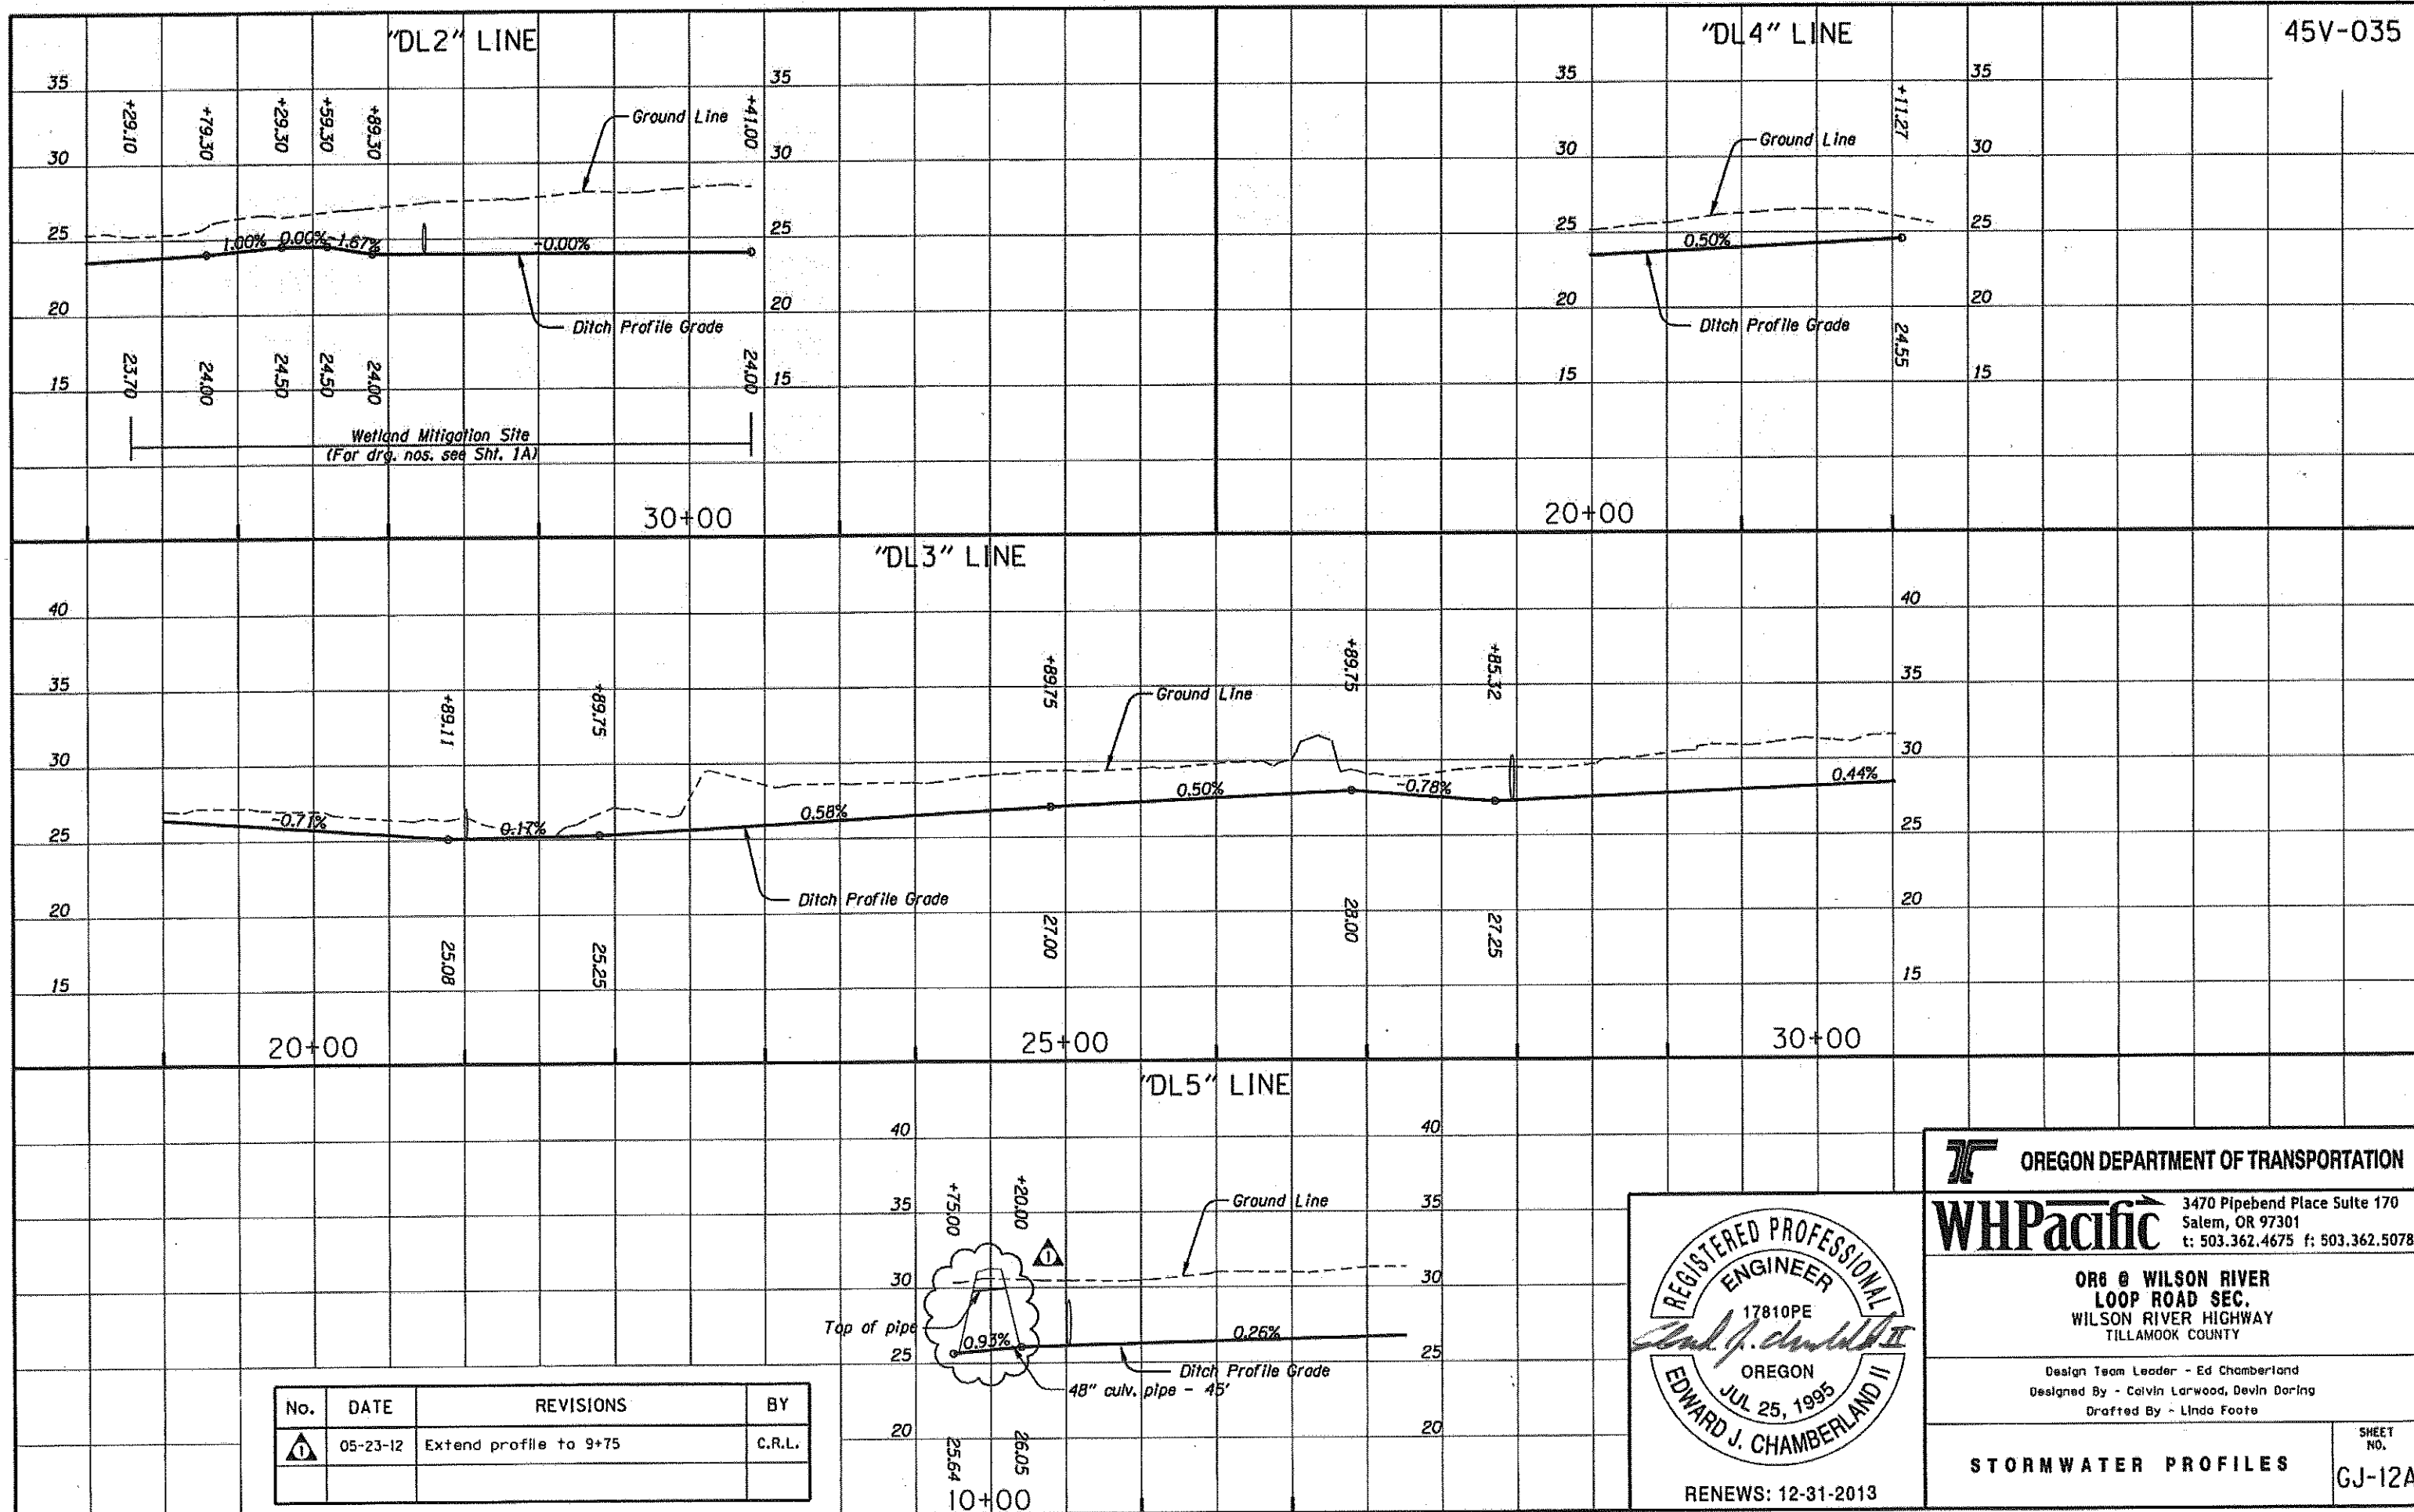

No.	DATE	REVISIONS	BY
1	05-23-12	Extend profile to 9+75	C.R.L.

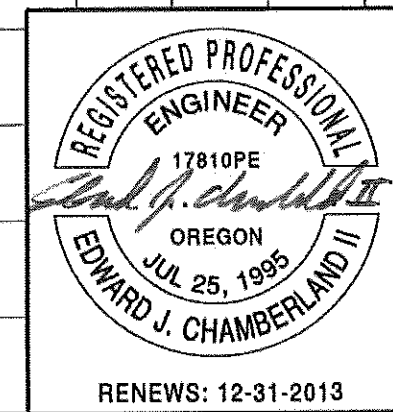

OREGON DEPARTMENT OF TRANSPORTATION


WHPacific 3470 Pipebend Place Suite 170
Salem, OR 97301
t: 503.362.4675 f: 503.362.5078

ORB @ WILSON RIVER LOOP ROAD SEC.
WILSON RIVER HIGHWAY
TILLAMOOK COUNTY

Design Team Leader - Ed Chamberland
Designed By - Calvin Larwood, Devin Doring
Drafted By - Linda Foote

STORMWATER PROFILES


SHEET NO. **GJ-12A**

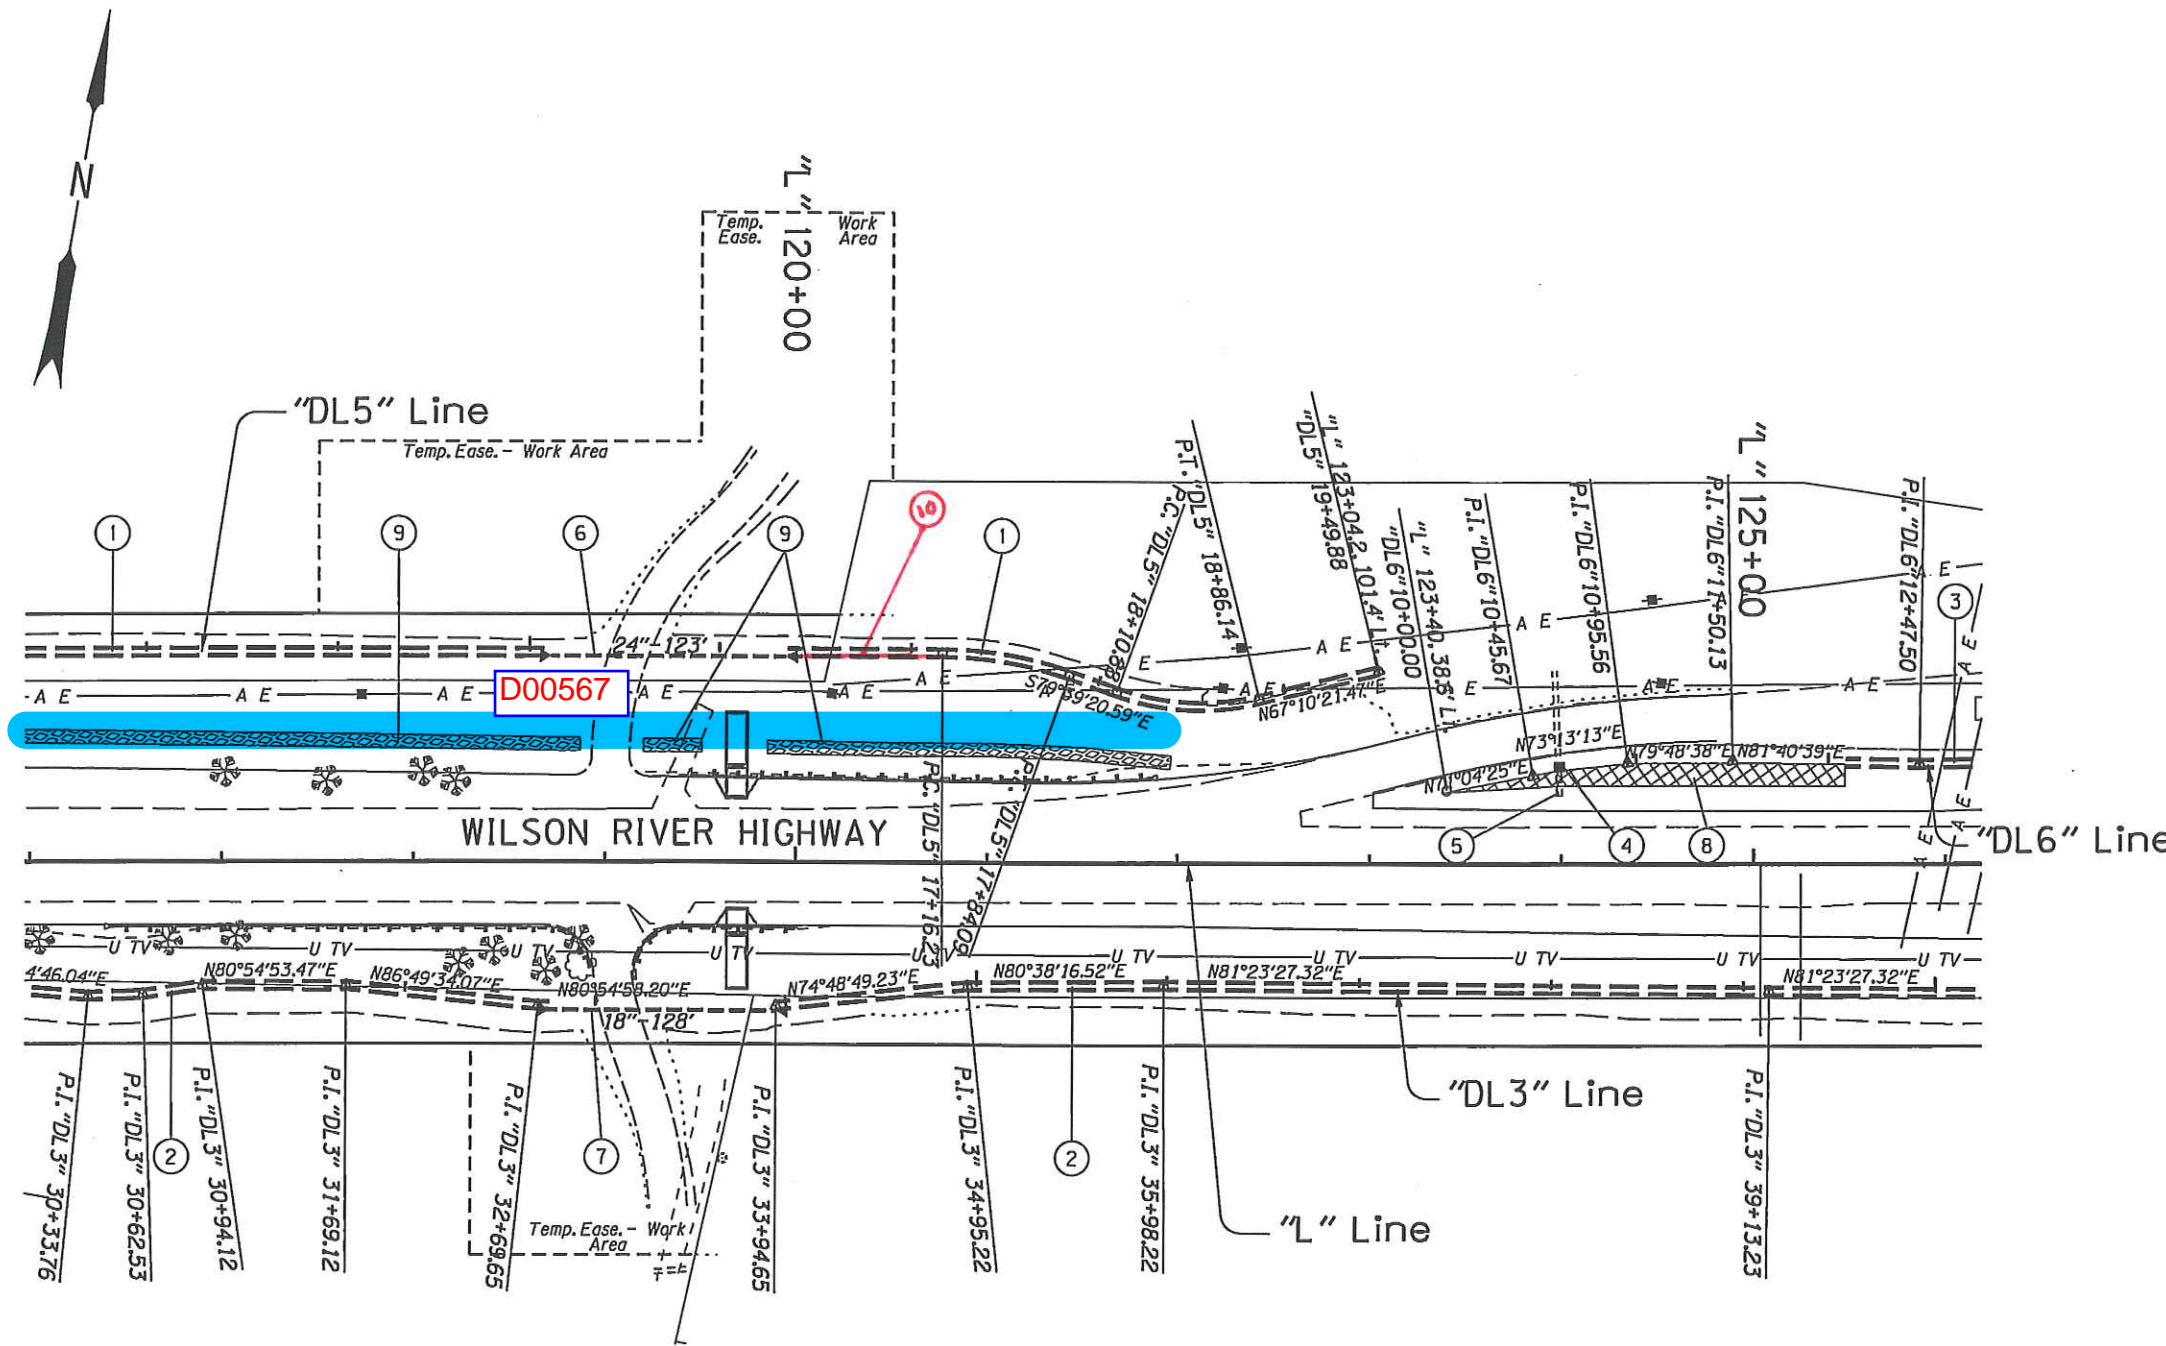

- ① See Sht. GJ-12, note 5
Const. ditch
- ② See Sht. GJ-12, note 6
Const. ditch
- ③ Sta. "DL6" 12+10 to Sta. "DL6" 19+10.70
Const. ditch, width varies
- ④ Sta. "DL6" 10+60, 2.8' Lt.
Const. modified Type D ditch inlet
Rim=36.2'
Connect to extg. pipe
(For details, see sht. GJ)
- ⑤ Sta. "L" 123+99, 35.8' Lt.
Remove 15' of 18" pipe
- ⑥ Sta. "DL5" 15+11.40 to
Sta. "DL5" 16+34.62, 2' Rt.
Inst. 24" culv. pipe - 123', 5' depth
I.E.=27.34' (W)
I.E.=27.68' (E)
Const. paved end slope, Lt. & Rt. - 88 sq.ft.
- ⑦ Sta. "DL3" 32+75.60, 2.25' Rt. to
Sta. "DL3" 33+94.70, 2.5' Rt.
Inst. 18" culv. pipe - 128', 5' depth
I.E.=29.43' (W)
I.E.=30.03' (E)
Const. paved end slope, Lt. & Rt. - 70 sq.ft.
- ⑧ Sta. "DL6" 10+00 to Sta. "DL6" 12+10
Const. bioswale, width varies, DF1# D00569
(For details, see sht. GJ-2)
- ⑨ See Sht. GJ-12, note 17
Const. bioslope
- ⑩ Sta. "DL5" 16+34.62 to
16+90.62 2' RT EXTEND
24" culvert pipe - 56', 5' depth
I.E. = 27.83' (E)



REVISED AS CONSTRUCTED
CONTRACT 14479

Dave True
DATE: 2/26/14
Dave True, Project Manager

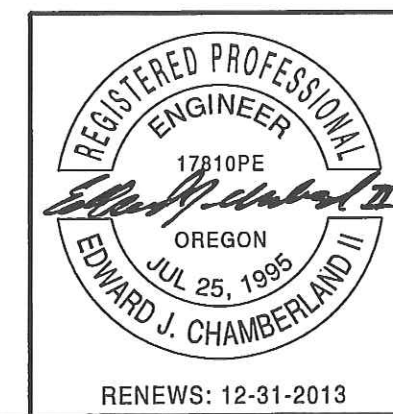

RENEWS: 12-31-2013

OREGON DEPARTMENT OF TRANSPORTATION	
WHPacific	
3470 Pipebend Place Suite 170 Salem, OR 97301 t: 503.362.4675 f: 503.362.5078	
OR6 @ WILSON RIVER LOOP ROAD SEC. WILSON RIVER HIGHWAY TILLAMOOK COUNTY	
Design Team Leader - Ed Chamberland Designed By - Calvin Larwood, Devin Doring Drafted By - Linda Foote	
STORMWATER PLAN	SHEET NO. GJ-13

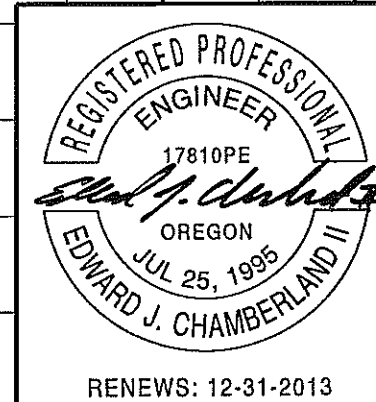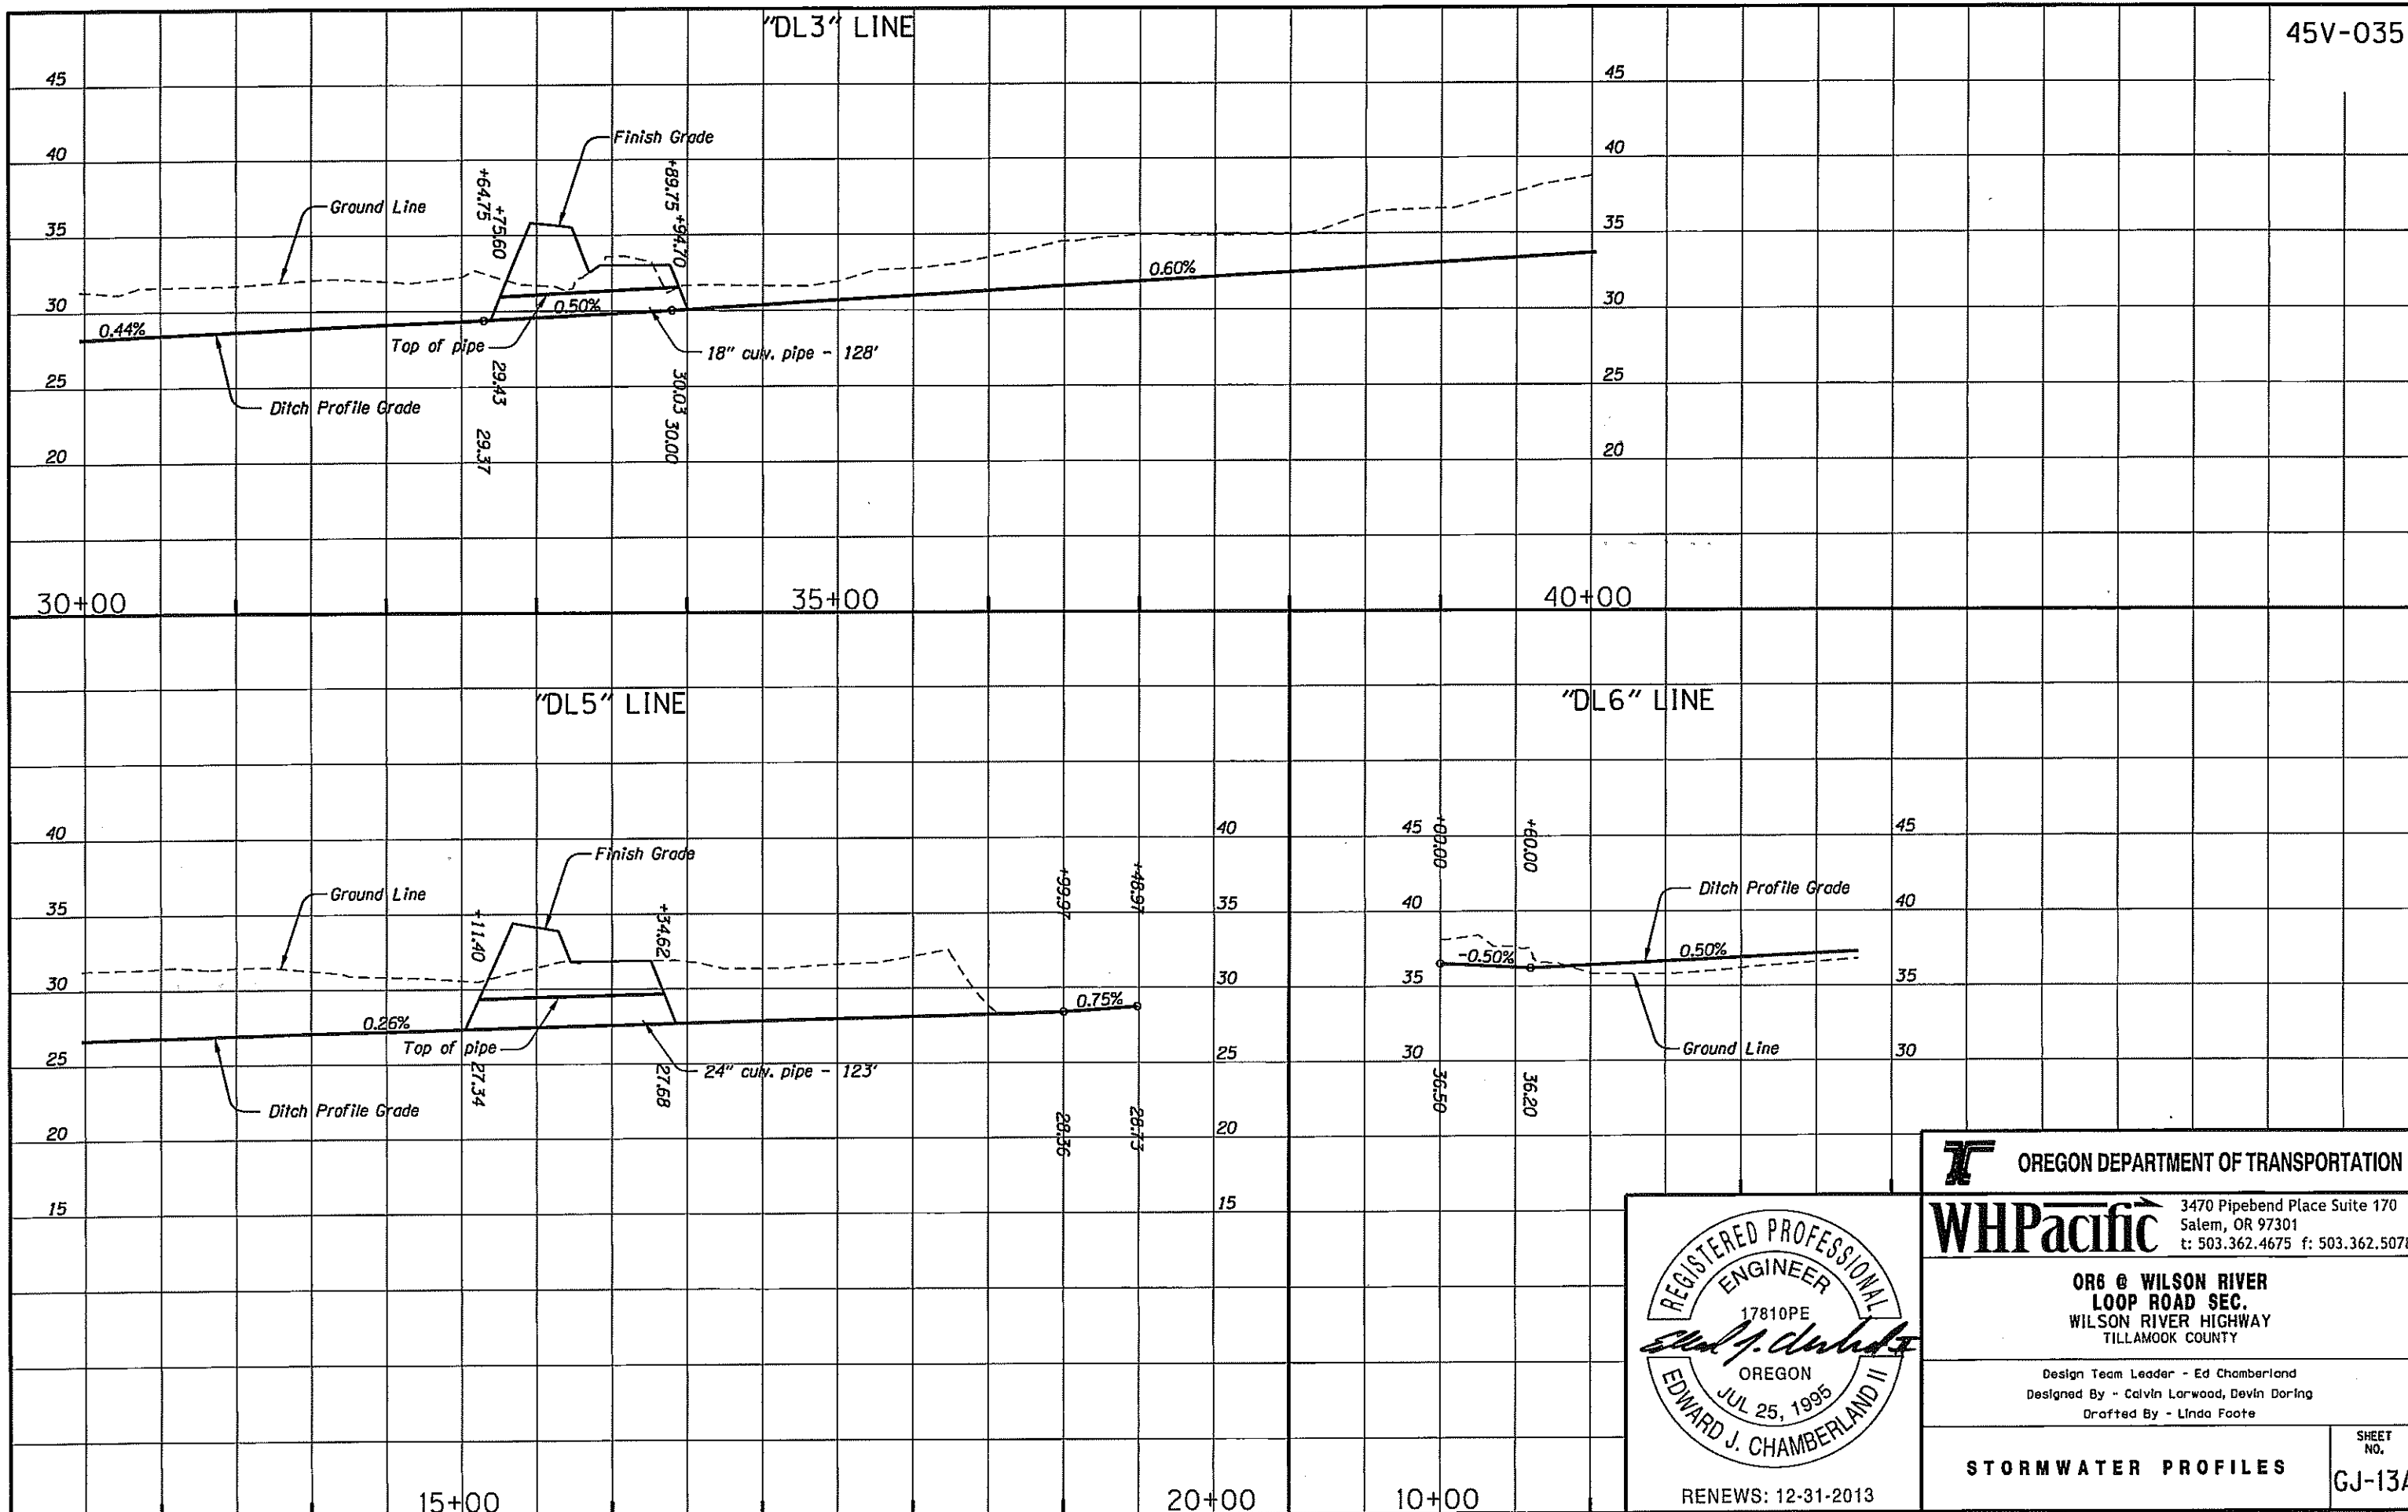

OREGON DEPARTMENT OF TRANSPORTATION

WHPacific 3470 Pipebend Place Suite 170
Salem, OR 97301
t: 503.362.4675 f: 503.362.5078

OR6 @ WILSON RIVER LOOP ROAD SEC.
WILSON RIVER HIGHWAY
TILLAMOOK COUNTY

Design Team Leader - Ed Chamberland
Designed By - Calvin Larwood, Devin Doring
Drafted By - Linda Foote

STORMWATER PROFILES SHEET NO. **GJ-13A**