

OPERATION & MAINTENANCE MANUAL

Water Quality Biofiltration Swale

Manual prepared: August 2017

DFI No. D00573



Figure 1: DFI No. D00573, looking northeast

1. Identification

Drainage Facility ID (DFI): D00573
Facility Type: Water Quality Biofiltration Swale
Construction Drawings: (V-File Numbers) 45V-34
Location: District: 3
Highway No.: 160
Mile Post: 24.21 to 24.27, right side

2. Manual Purpose

The purpose of this manual is to outline inspection needs and summarize maintenance actions.

3. Facility Location

The location map below details the facility location. The highway, mile posts, side streets, access location, and stormwater flow directions are noted on the map.

Flow direction: northeast




Figure 2: Facility location map

4. Facility Summary

The length and width of a swale is based on the bottom dimensions.

The bottom length and bottom width of the swale is:


Bottom Length (feet)	Bottom Width (feet)
317	3

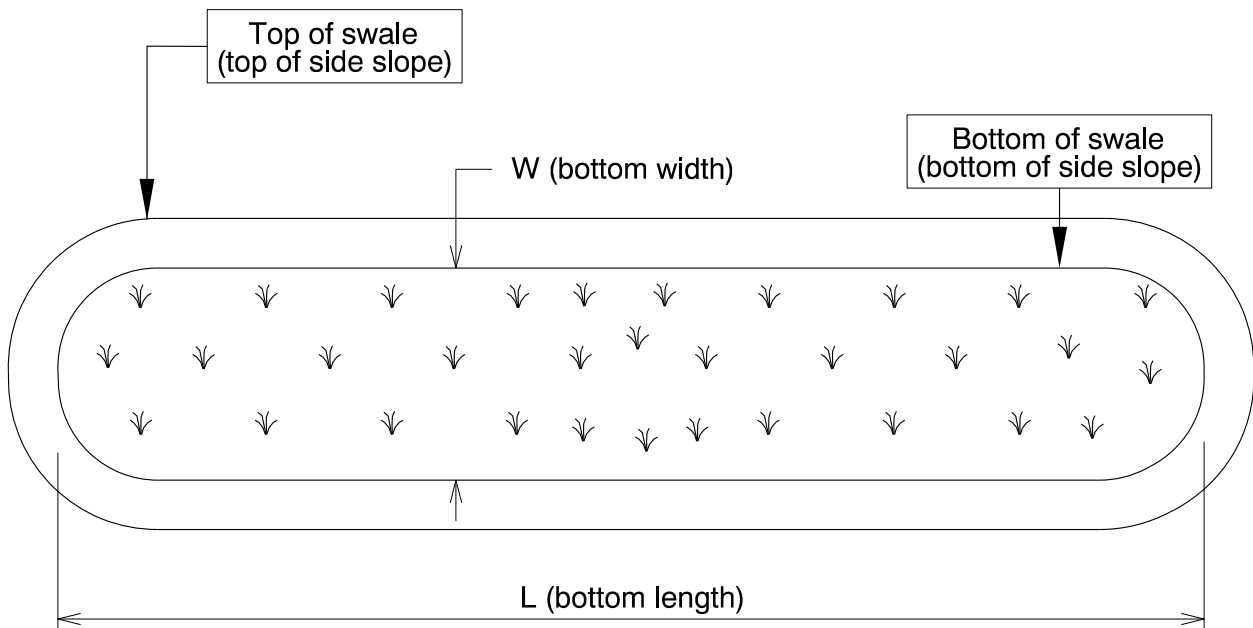

The depth of the swale is the vertical distance measured from the bottom of the swale to the top. The slope of the swale sides is presented by a vertical distance (rise) followed by the horizontal distance (run).

Depth and side slopes:

Depth (feet)	Rise (feet)	Run (feet)
5	1	3

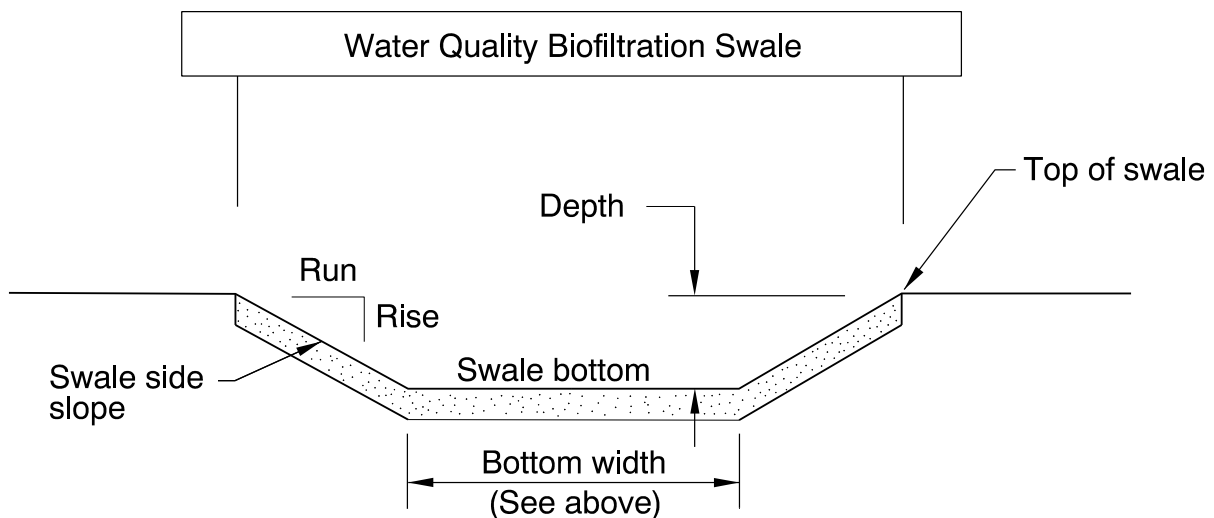

Site Specific Information: The facility runs parallel to Cascade Highway South (OR 213). Treated stormwater outfalls into Butte Creek. The contract plans indicate that four plastic board flow spreaders were to be installed in the facility. The spreaders were not installed. Two erosion control flow spreaders made of aggregate and straw were left in place.

5. Facility Access

Maintenance access to the facility:

<input type="checkbox"/> Roadside pad	<input checked="" type="checkbox"/> Roadside shoulder
<input type="checkbox"/> Access road with Gate	<input type="checkbox"/> Access road without Gate



Figure 3: Swale inlet looking southwest towards Wagon Road (access)

6. Operational Components / Maintenance Items

Classification

This facility is classified as an:

<input checked="" type="checkbox"/> On-line Swale	<input type="checkbox"/> Off-line Swale
A swale that does not include a high flow bypass component; flow drains into and through the facility	A swale that treats low/small flows and diverts high flows using a bypass component

Bypass Component

This facility includes a high flow bypass component:

<input checked="" type="checkbox"/> No	<input type="checkbox"/> Yes
There is no bypass component. High flows drains into and through the facility	There is a bypass component. Only low/small flows drain into the swale. High flows are diverted around the swale using a bypass component

Operational Components

A swale has many components that assist with treatment, conveyance, and reducing flow velocity to minimize erosion. The components in use can vary depending if the facility was designed to operate on-line or off-line. The facility components table (**Table 1**) has been provided to highlight the applicable components for this facility. The component is in use when the box contains an “x” (e.g.).

The Standard Operation Manual for Water Quality Biofiltration Swales (implemented March 2017) outlines facility operation, typical footprint configuration, and component definitions and details. A link to the manual is attached to the feature marker in TransGIS.

<https://gis.odot.state.or.us/TransGIS/>

Operational Plan

The applicable standard operational plan for this facility is:

Operational Plan A **Operational Plan B** **Operational Plan C**

A standard operational plan illustrates the general facility footprint configuration and explains the purpose of each facility component. Operational plans (A, B, C) are provided in the Standard Operation Manual.

See Appendix A for the site specific operational plan.

Maintenance Items

Operational components marked in **Table 1** should be inspected and maintained according to Section 7. Each facility component is defined and detailed in the Standard Operation Manual using the associated ID number indicated below.

Table 1: Swale Components		ID #
Manholes/Structures		
Pre-treatment manhole	<input type="checkbox"/>	S1
Weir type flow splitter/flow splitter manhole	<input type="checkbox"/>	S2
Orifice type flow splitter/flow splitter manhole	<input type="checkbox"/>	S3
Standard manhole	<input type="checkbox"/>	S4
Swale Inlet		
Pavement sheet flow	<input type="checkbox"/>	S5
Inlet pipe(s)	<input checked="" type="checkbox"/>	S6
Open channel inlet	<input type="checkbox"/>	S7
Riprap pad	<input checked="" type="checkbox"/>	S8
Ground Cover		
Grass bottom	<input checked="" type="checkbox"/>	S9
Grass side slopes	<input checked="" type="checkbox"/>	S10
Granular drain rock	<input type="checkbox"/>	S11
Plantings	<input type="checkbox"/>	S12
Underground Components		
Geotextile fabric	<input type="checkbox"/>	S13
Water quality mix	<input checked="" type="checkbox"/>	S14
Perforated pipe	<input type="checkbox"/>	S15
Porous pavers (access grid)	<input type="checkbox"/>	S16
Flow Spreader		
Rock basin (used at inlet)	<input type="checkbox"/>	S17
Anchored board (midpoint of swale or every 50 feet along swale bottom)	<input type="checkbox"/>	S18
Other: aggregate rock and straw check dams	<input checked="" type="checkbox"/>	S19
Swale Outlet		
Catch basin with grate	<input type="checkbox"/>	S20
Outlet pipe(s)	<input type="checkbox"/>	S21
Open channel outlet	<input type="checkbox"/>	S22
Auxiliary Outlet	<input type="checkbox"/>	S23
Outfall Type		
Waterbody (Creek/Lake/Ocean)	<input checked="" type="checkbox"/> C	S24
	<input type="checkbox"/> L	
	<input type="checkbox"/> O	
Ditch	<input type="checkbox"/>	S25
Storm drain system	<input type="checkbox"/>	S26
Outfall Components		
Riprap pad	<input type="checkbox"/>	S27
Riprap bank protection	<input checked="" type="checkbox"/>	S28

7. Maintenance

Maintenance Frequency/Maintain Records

- a. Inspect annually. Preferably prior to the rainy season.
- b. Clean and maintain as necessary. Refer to Activity 125 for conditions when maintenance is needed.
- c. Keep a record of inspections, maintenance, and repairs.

Maintenance Guide/Maintenance Actions

The ODOT Routine Road Maintenance Water Quality and Habitat Guide (the *Blue Book*) outlines the standard maintenance actions for water quality facilities under Activity 125.

There are standard maintenance tables for standard ODOT designs. The maintenance tables describe the maintenance component, the defect or problem, the condition when maintenance is needed, and the recommended maintenance to correct the problem. Use the following tables to maintain ODOT swales:

- Table 1 (General Maintenance): Contains general maintenance and inspection guidelines that are applicable to all ODOT water quality facilities
- Table 3 (Maintenance of Water Quality or Biofiltration Swales): Contains maintenance information for swales

The *Blue Book* can be viewed at the following website:

http://www.oregon.gov/ODOT/Maintenance/Documents/blue_book.pdf

8. Limitations

Access grid installed:

<input checked="" type="checkbox"/> No	<input type="checkbox"/> Yes
There are no porous pavers installed in this swale.	

Swales are designed to allow equipment access along the bottom. An access grid is **NOT** installed. Vehicles entering the swale can create depressions (tire ruts), damage vegetation, and damage structural components (e.g. flow spreaders). These conditions may result in poor treatment and drainage performance.

Equipment wheels should be kept on the tops and side slopes. Mower arms may be run along the swale bottom.

9. Waste Material Handling

Material removed from the facility is defined as waste by the Department of Environmental Quality (DEQ). Refer to the roadwaste section of the ODOT Maintenance Yard Environmental Management System (EMS) Policy and Procedures Manual for disposal options:

http://www.oregon.gov/ODOT/Maintenance/Documents/ems_manual.pdf


Contact any of the following for more detailed information about management of waste materials found on site:

ODOT Clean Water Unit	(503) 986-3008
ODOT Statewide Hazmat Coordinator	(503) 667-7442
ODOT Region 1 Hazmat Coordinator	(503) 731-8290
ODOT Region 2 Hazmat Coordinator	(503) 986-2647
ODOT Region 3 Hazmat Coordinator	(541) 957-3594
ODOT Region 4 Hazmat Coordinator	(541) 388-6186
ODOT Region 5 Hazmat Coordinator	(541) 963-1590
ODEQ Northwest Region Office	(503) 229-5263

A Appendix A – Site Specific Operational Plan

Contents:

Operational Plan: DFI D00573

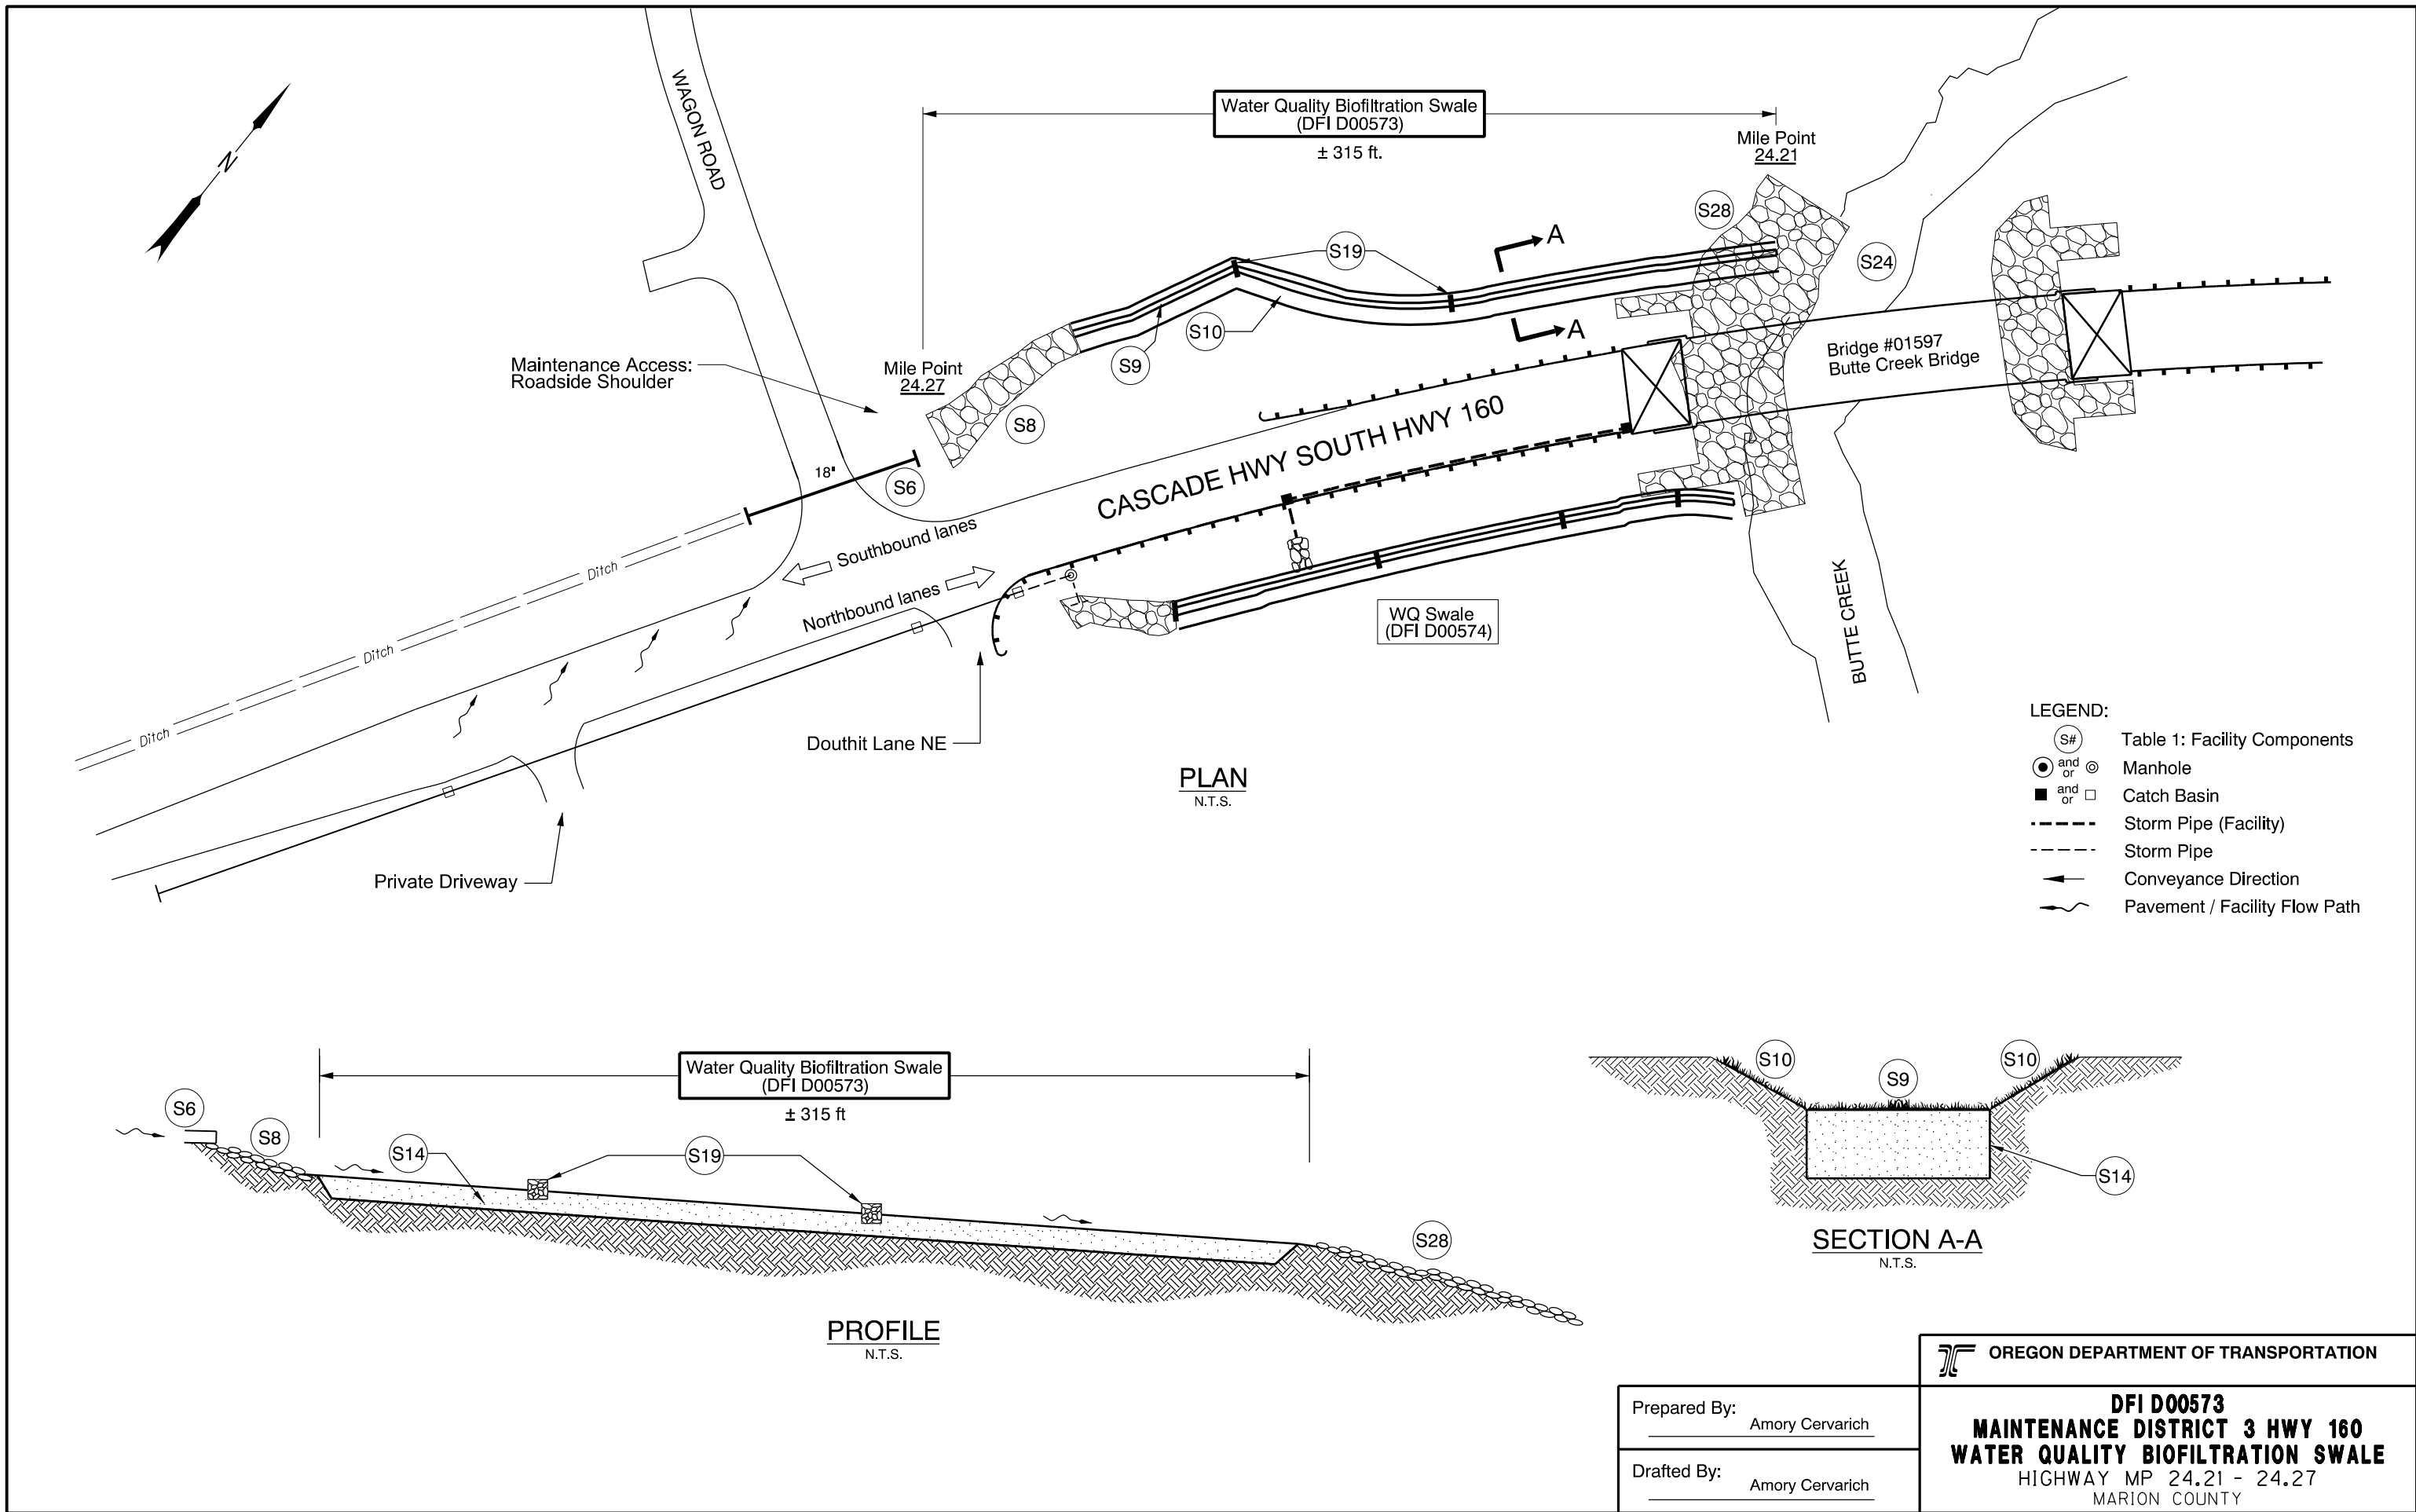

OREGON DEPARTMENT OF TRANSPORTATION

Prepared By: Amory Cervarich

Drafted By: Amory Cervarich

DFI D00573
MAINTENANCE DISTRICT 3 HWY 160
WATER QUALITY BIOFILTRATION SWALE
 HIGHWAY MP 24.21 - 24.27
 MARION COUNTY

B Appendix B – Project Contract Plans

Contents:

Site Specific Subset of Project Contract Plan 45V-34

INDEX OF SHEETS	
SHEET NO.	DESCRIPTION
1	Title Sheet
1A	Index Of Sheets
1A-2	Std. Drg. Nos.

STATE OF OREGON
DEPARTMENT OF TRANSPORTATION

PLANS FOR PROPOSED PROJECT

GRADING, STRUCTURE, PAVING & SIGNING


OR213: BUTTE CREEK (JACKS) BRIDGE SEC.

CASCADE HIGHWAY SOUTH

MARION & CLACKAMAS COUNTIES

MAY 2012


REVISED AS CONSTRUCTED
6/24/14 CONTRACT 14457
PROJ. MGR. *[Signature]*

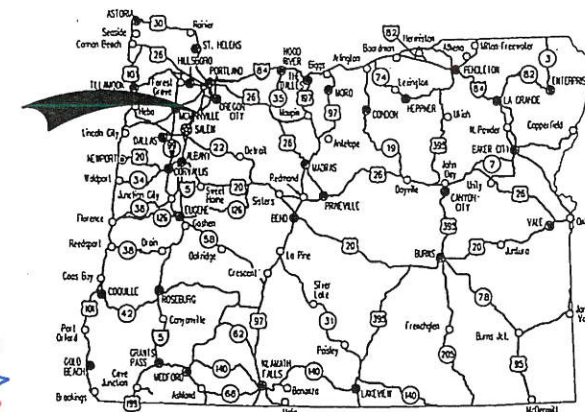

Overall Length Of Project - 0.38 Miles

**BRO-S160(051)
END OF PROJECT**


STA. "L"674+50 (M.P. 24.02)

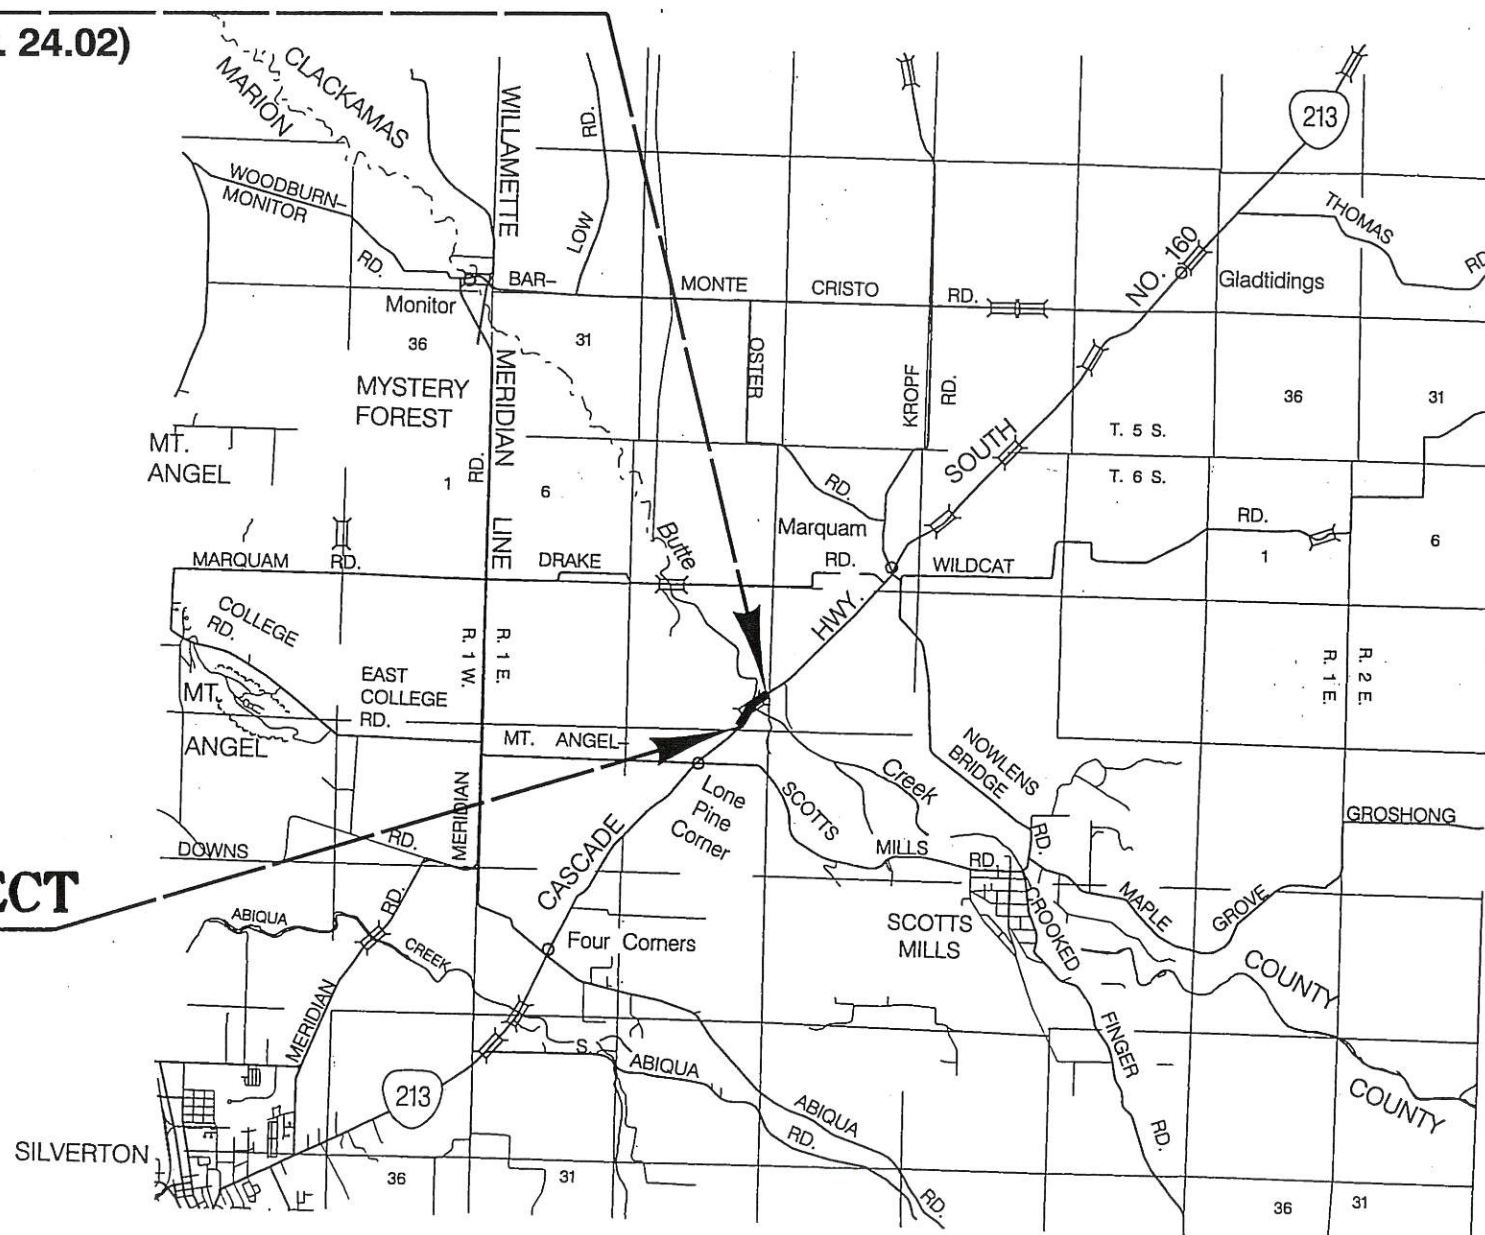

**BRO-S160(051)
BEGINNING OF PROJECT**

STA. "L"655+50 (M.P. 24.4)

ATTENTION:
Oregon Law Requires You to Follow Rules Adopted By The Oregon Utility Notification Center. Those Rules Are Set Forth In OAR 952-001-0010 Through OAR 952-001-0090. You May Obtain Copies Of The Rules By Calling The Center. (Note: The Telephone Number For The Oregon Utility Center Is (503) 232-1987.)

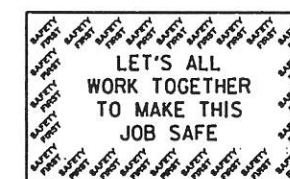

OREGON TRANSPORTATION COMMISSION

Pat Egan CHAIR
David Lohman COMMISSIONER
Mary F. Olson COMMISSIONER
Mark Frohnmayer COMMISSIONER
Tommy Boney COMMISSIONER
Matthew L. Garrett DIRECTOR OF TRANSPORTATION

These plans were developed using ODOT design standards. Exceptions to these standards, if any, have been submitted and approved by the ODOT Chief Engineer or their delegated authority.


By: *[Signature]* 3/26/12
Signature & date

for: Carol A. Cartwright - R2 Tech Center Manager
Print name and title


[Signature]
Concurrence by ODOT Chief Engineer

OR213: BUTTE CREEK (JACKS) BRIDGE SEC.		
CASCADE HIGHWAY SOUTH		
MARION & CLACKAMAS COUNTIES		
FEDERAL HIGHWAY ADMINISTRATION	PROJECT NUMBER	SHEET NO.
OREGON DIVISION	BRO-S160(051)	1


PE001452

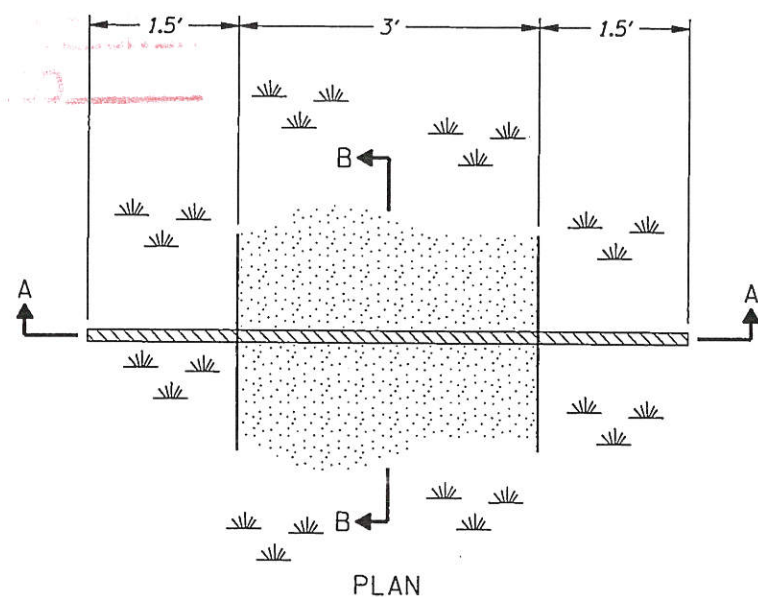

PLAN

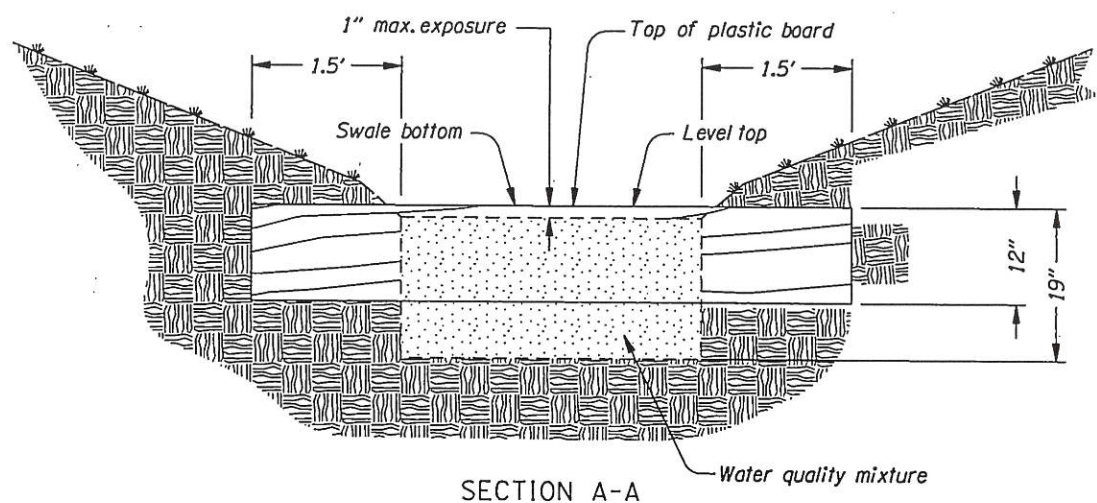


SECTION A-A

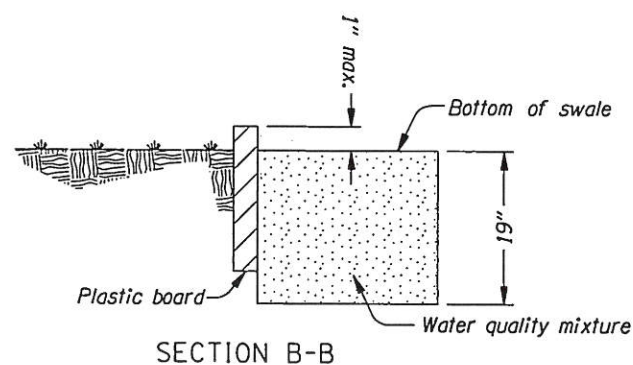

SECTION B-B


PLASTIC BOARD FLOW SPREADER

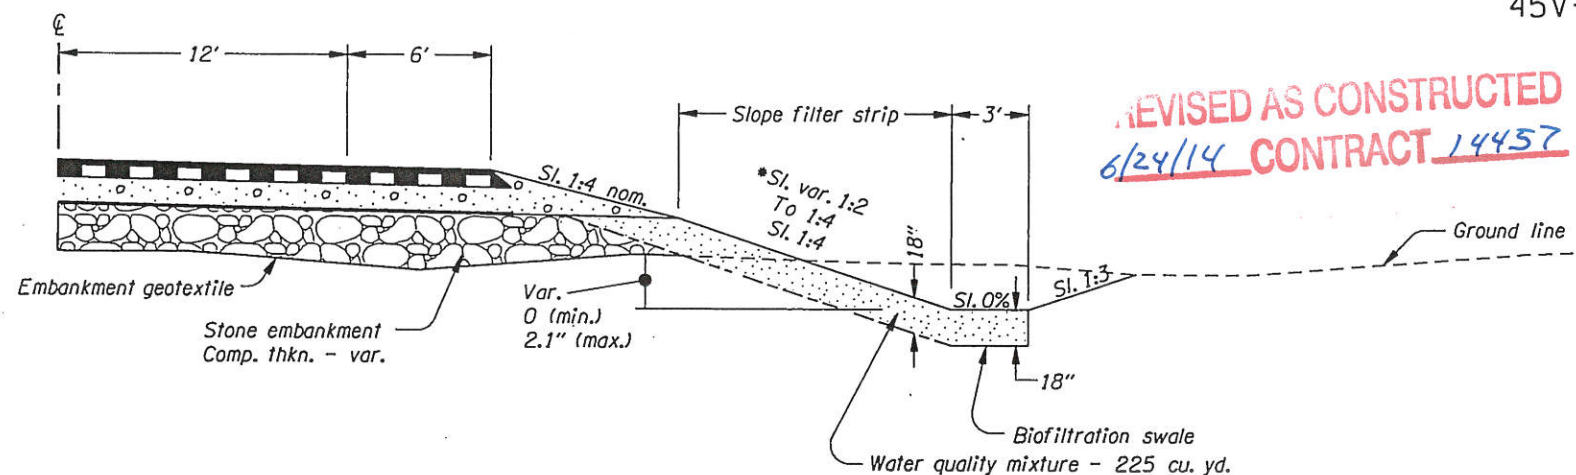

REVISED AS CONSTRUCTED
6/24/14 CONTRACT 14457

(For surfacing details not shown, see typical sections)
**WATER QUALITY BIOFILTRATION SWALE
AND SLOPE FILTER STRIP**


* STA. "L"667+42 To STA. "L"668+03, Rt.
STA. "L"668+03 To STA. "L"670+60, Rt.

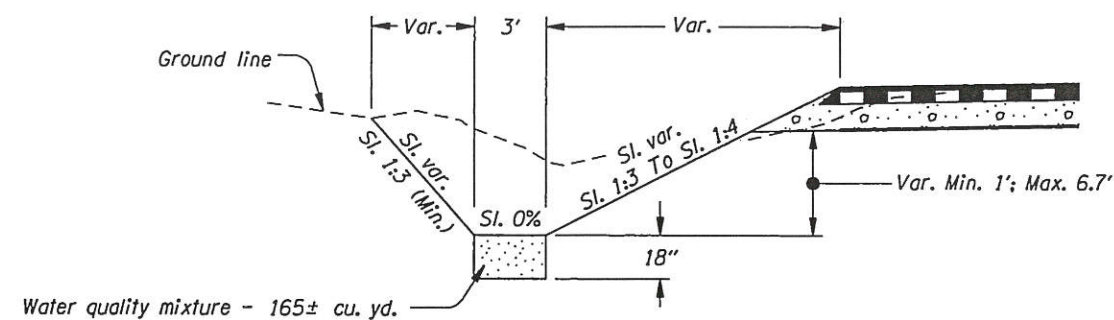

(For surfacing details not shown, see typical sections)

**FLAT BOTTOM WATER QUALITY
BIOFILTRATION SWALE**

STA. "L"661+05 To STA. "L"664+50, Lt.
STA. "L"661+10 To STA. "L"664+10, Rt.
STA. "L"670+60 To STA. "L"672+60, Rt.
STA. "L"671+15 To STA. "L"672+60, Lt.

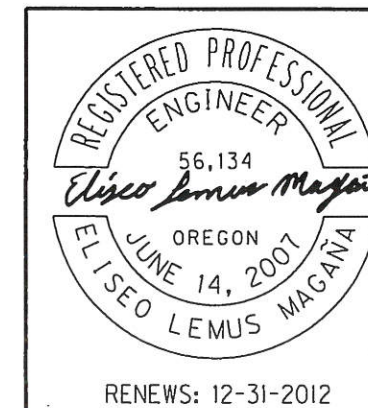

OREGON DEPARTMENT OF TRANSPORTATION

REGION 2 TECH CENTER

OR213: BUTTE CREEK (JACKS) BRIDGE SEC.
CASCADE HIGHWAY SOUTH
MARION & CLACKAMAS COUNTIES

Design Team Leader - Edward W. Contrall
Designed By - Eliseo Lemus Magaña
Drafted By - D. Gentner-Day

DETAILS


SHEET
NO.
2B-4

T. 6 S., R. 1 E., W.M.

REVISED AS CONSTRUCTED
6/24/14 CONTRACT 14457

STRUCTURAL DETAILS CHECKED

BEGINNING OF PROJECT BR0-S16010511
STA. "L" 655+50 (M.P. 24.4)

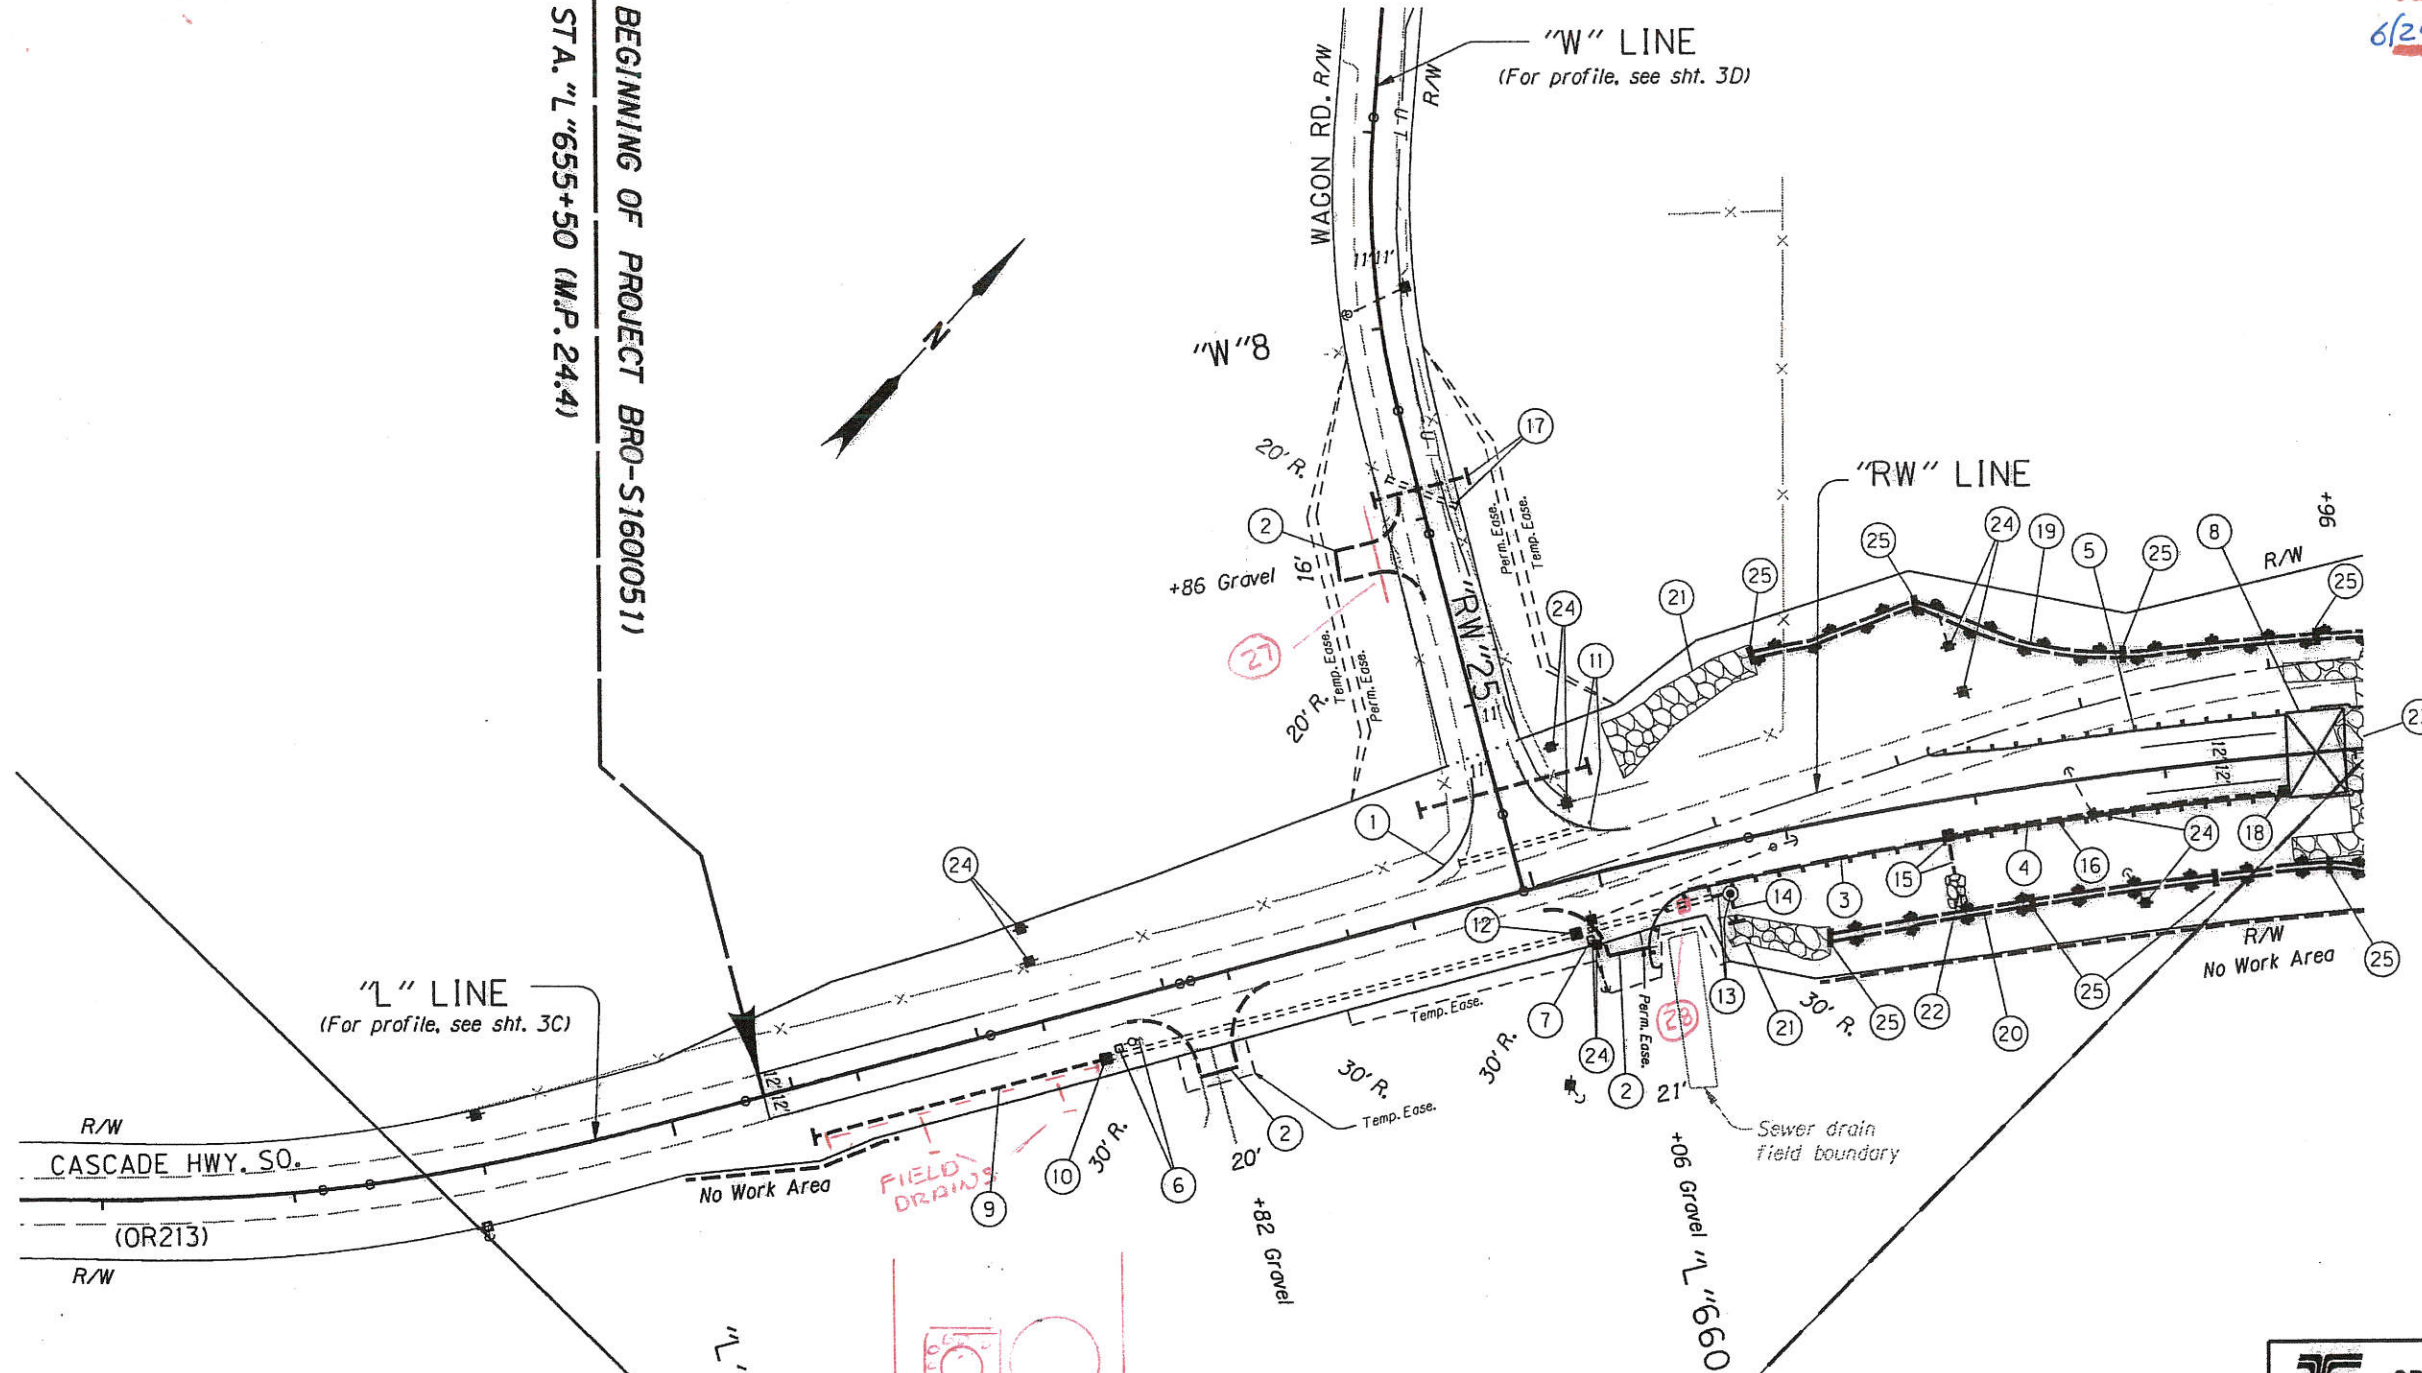

"L" LINE
(For profile, see sht. 3C)

"W" LINE
(For profile, see sht. 3D)

"RW" LINE

R/W
CASCADE HWY. SO.
(OR213)
R/W

No Work Area


FIELD DRAINS

Sewer drain field boundary

R/W
No Work Area


"L" 655

SEC. 8
SEC. 17

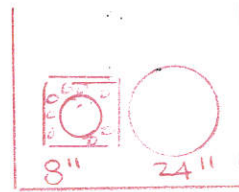

THOMAS P. JACK
DLC NO. 43

JEREMIAH JACK
DLC NO. 41

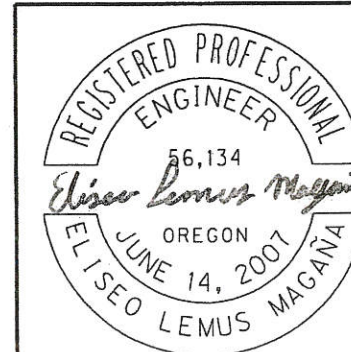

RENEWS: 12-31-2012

OREGON DEPARTMENT OF TRANSPORTATION

REGION 2 TECH CENTER

OR213: BUTTE CREEK (JACKS) BRIDGE SEC.
CASCADE HIGHWAY SOUTH
MARION & CLACKAMAS COUNTIES

Design Team Leader - Edward W. Cantrell
Designed By - Eliseo Lemus Magaña
Drafted By - D. Gentner-Day

GENERAL CONSTRUCTION

SHEET NO.
3A

- ① Const. road connection
- ② Const. approach - 3
(See drg. no. RD715)
- ③ Sta. "L"660+17.21 To Sta. "L"663+63, Rt.
Const. guardrail - 281.5' (Type 2A)
 - 37.5' (Type 2A) (30' radius)
 - 12.5' (Type 3)
Const. anchor - 2 (Type 1 mod.)
Inst. end piece (Type B)
(See drg. nos. RD400, RD415, RD440, RD450 & RD470)
- ④ Sta. "L"660+40 To Sta. "L"663+63, Rt.
Const. drainage curb
(See drg. no. RD701)
- ⑤ Sta. "L"661+84.9 To Sta. "L"663+65, Lt.
Const. guardrail - 112.5' (Type 2A)
 - 12.5' (Type 3)
Flare rate=0, W=3', E=2'
Const. guardrail terminal, flared
(See drg. nos. RD420)
- ⑥ Sta. "L"657+27, Rt.
Remove extg. mailbox support
Inst. single mailbox support
(See drg. nos. RD100 & RD101)
- ⑦ Sta. "L"559+88, Rt.
Inst. single mailbox support
- ⑧ Structure no. 21281
Const. structure
Roadway width - 40'
and reinforced panel of bridge ends
(For drg. nos. see sht. 1A)

- ⑨ Sta. "L"655+70 To Sta. "L"657+27, Rt.
Inst. 24" culv. pipe - 157'
5' Depth
Const. slope end
(See drg. nos. RD300, RD316, RD318, RD326,
RD380 & RD386)
- ⑩ Sta. "L"657+27, 27.4' Rt.
Const. type "D" inlet
(See drg. no. RD370)
- ⑪ Sta. "L"659+17.79 To Sta. "L"660+08.79, 53.9' Lt.
Remove extg. pipe - 78.8'
Inst. 18" culv. pipe - 91'
5' Depth
Const. slope end - 2
- ⑫ Sta. "L"659+81.2, 27.8' Rt.
Remove extg. pipe - 3'
Const. type "D" inlet
- ⑬ Sta. "L"660+57, 26.3' Rt.
24" culv. pipe (In pl.)
Extend - 9' Rt., 5' depth
Const. storm sew. manhole
(See drg. nos. RD336, RD344 & RD346)
- ⑭ Sta. "L"660+65, Rt.
Inst. 24" culv. pipe - 13'
5' Depth
- ⑮ Sta. "L"661+82.7, 18.3' Rt.
Const. type "G-2" inlet
Inst. 12" storm sew. pipe - 17.5'
10' Depth
(See drg. no. RD364)

REVISED AS CONSTRUCTED
6/24/14 CONTRACT 14457

- ⑯ Sta. "L"661+83.9 To Sta. "L"663+60.2, Rt.
Inst. 12" storm sew. pipe - 175'
10' Depth
- ⑰ Sta. "W"7+15
Remove extg. culv. pipe - 39'
Inst. 18" culv. pipe - 60'
5' Depth
Const. slope end - 2
- ⑱ Sta. "L"663+48, 18.3' Rt.
Const. type "G-2" inlet
- ⑲ Sta. "L"661+05 To Sta. "L"664+50, Lt.
Const. No. 00573 water quality biofiltration swale
(For details, see sht. 2B-4)
- ⑳ Sta. "L"661+10 To Sta. "L"664+10, Rt.
Const. No. 00574 water quality biofiltration swale
(For details, see sht. 2B-4)
- ㉑ Const. ditch protection
Const. loose riprap (Class 50) - 100 cu. yd.
(For details, see sht. 2B-2)
- ㉒ Const. slope protection
Const. loose riprap (Class 50) - 4 cu. yd.
(For details, see sht. 2B-3)
- ㉓ Const. bank protection
(For drg. nos., see sht. 1A)
- ㉔ Remove extg. power pole - 5
Inst. power pole - 5
(By others)
- ㉕ Inst. plastic board flow spreader - 8
(For details, see sht. 2B-4)

⑳ INSTALL 8" DRAIN PIPE
STA 655+80 TO 657+27 RT
TIE INT TYP "D" INLET
TIE 2 FIELD DRAIN
INTO 8" PIPE

㉑ "W" 6+55 - 7+15
INST 12 CULV PIPE -
60' CONST. SLOPE END 2


㉒ STA "L" 660+40 26.6 RT
CONST TYPE "D" INLET.
REMOVE EXTG PIPE - 3'

 OREGON DEPARTMENT OF TRANSPORTATION

REGION 2 TECH CENTER

OR213: BUTTE CREEK (JACKS) BRIDGE SEC.
CASCADE HIGHWAY SOUTH
MARION & CLACKAMAS COUNTIES

Design Team Leader - Edward W. Cantrell
Designed By - Eliseo Lemus Magoña
Drafted By - D. Gentner-Day

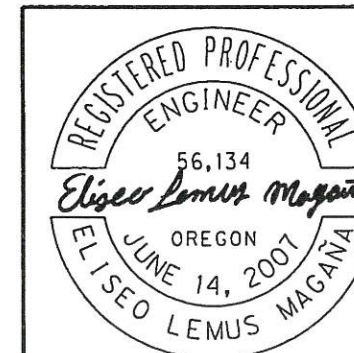

RENEWS: 12-31-2012

NOTES

SHEET NO.


3A-2

STRUCTURAL DETAILS CHECKED

Sec. 8, T.6S., R.1E., W.M.

REVISIONS TO BE MADE
AS NOTED

REVISED AS CONSTRUCTED
1/14/14 CONTRACT 14457

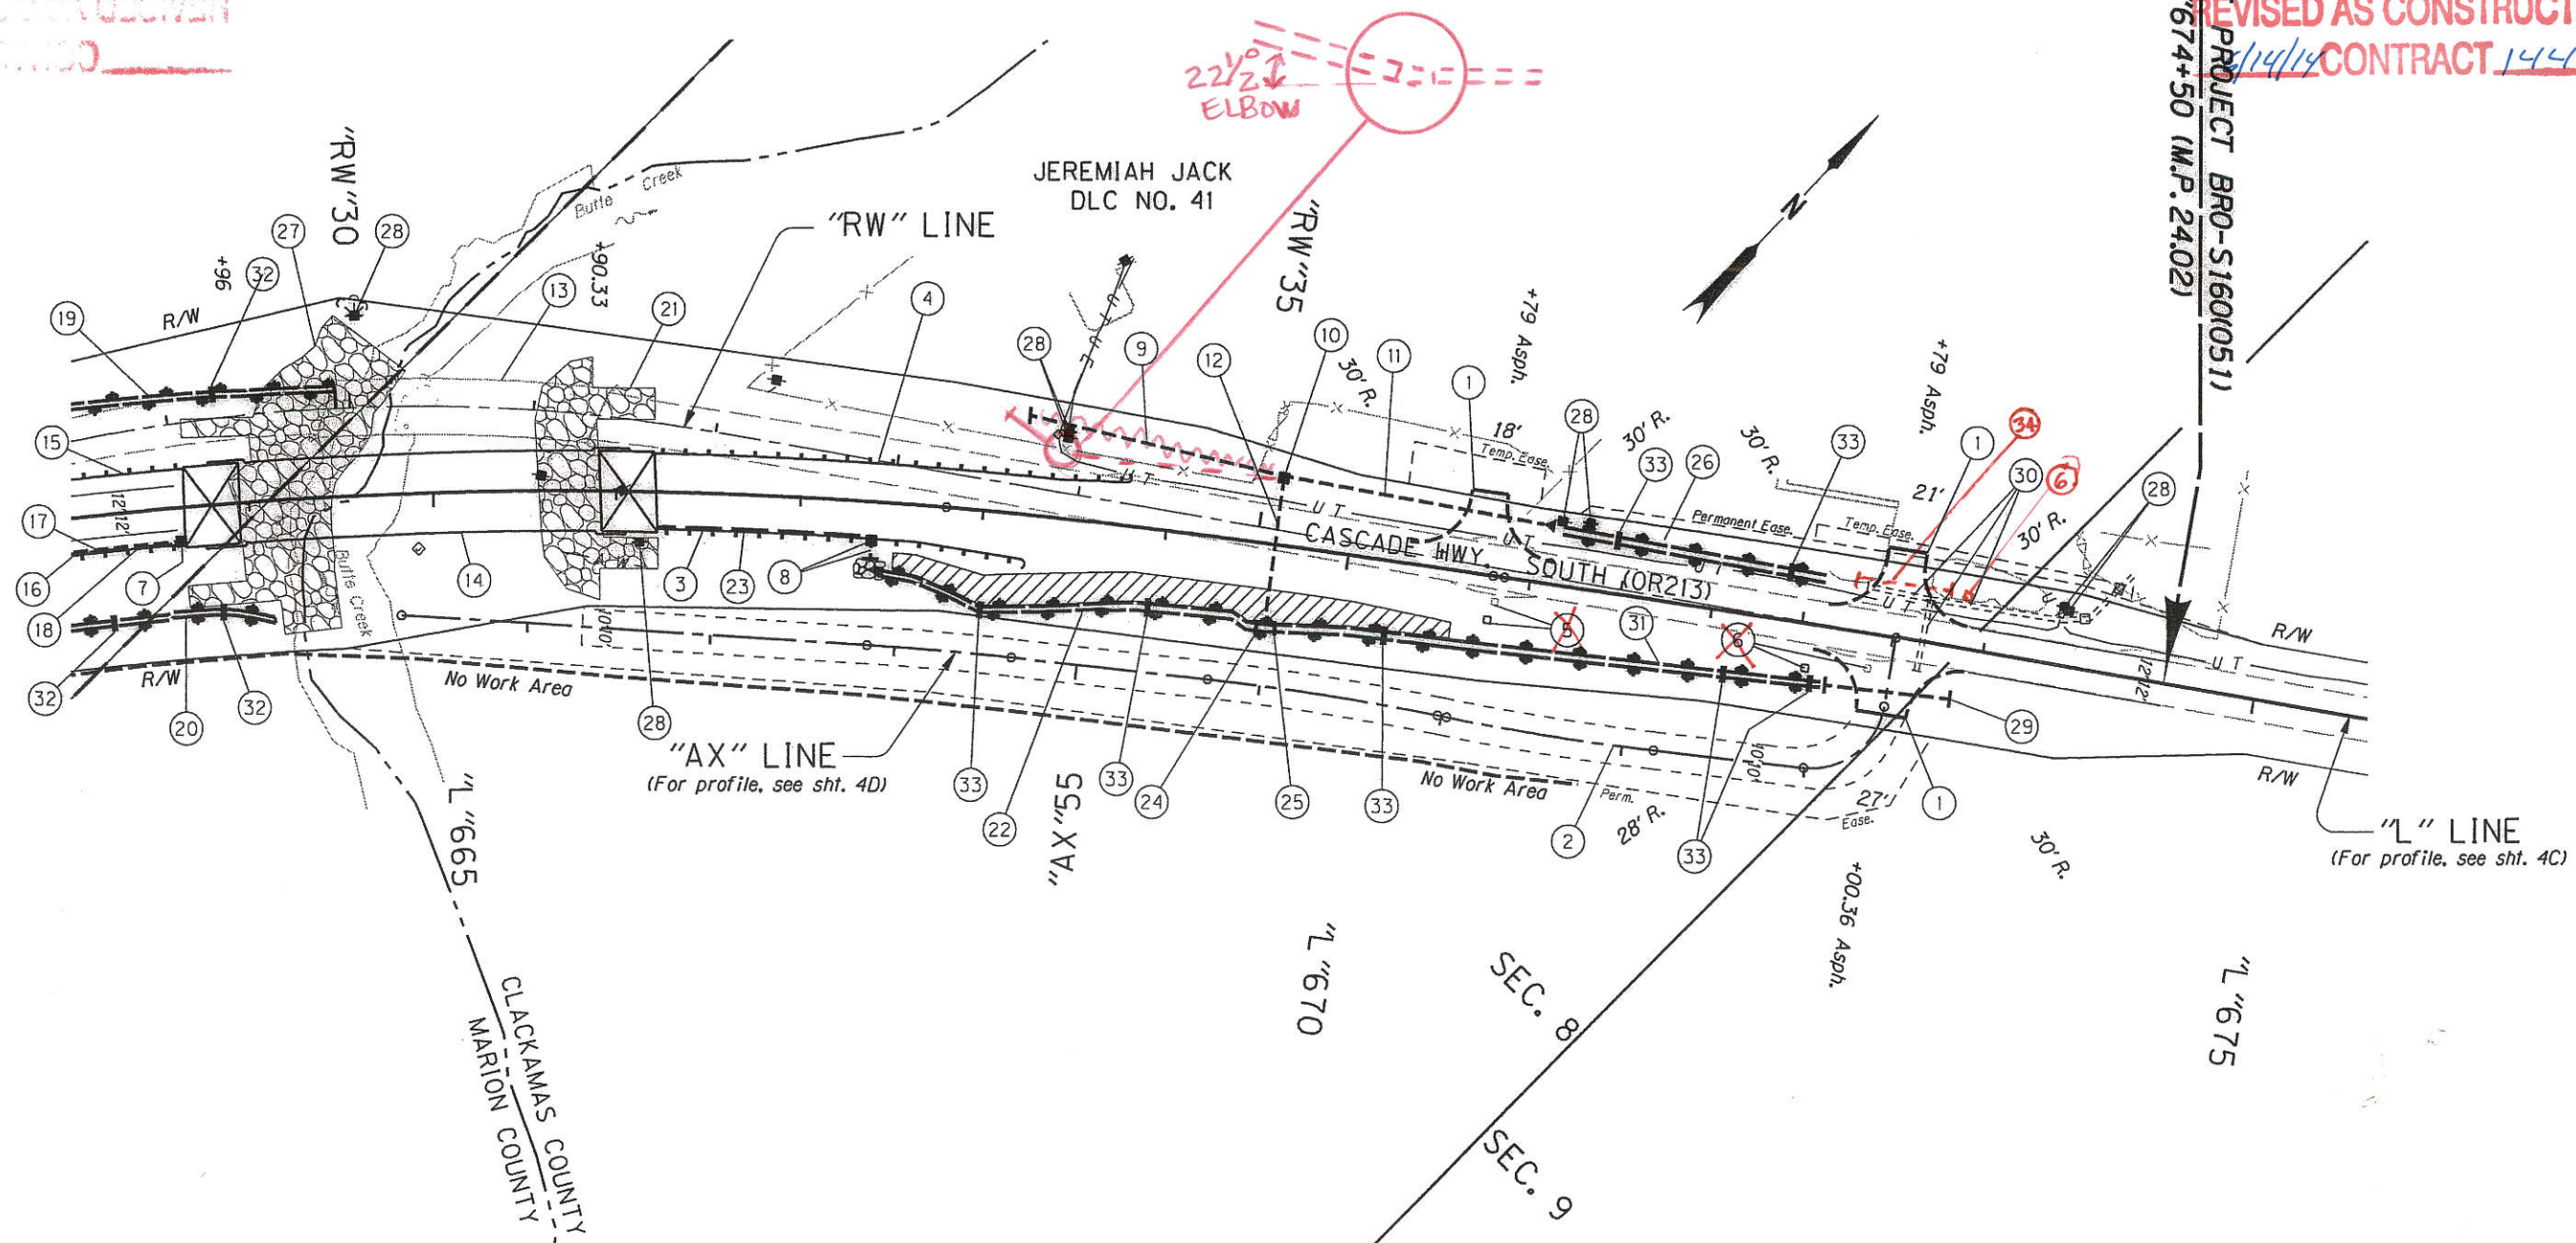


STRUCTURAL DETAILS CHECKED

OREGON DEPARTMENT OF TRANSPORTATION

REGION 2 TECH CENTER

OR213: BUTTE CREEK (JACKS) BRIDGE SEC.
CASCADE HIGHWAY SOUTH
MARION & CLACKAMAS COUNTIES

Design Team Leader - Edward W. Cantrell
Designed By - Eliseo Lemus Magaña
Drafted By - D. Gentner-Day

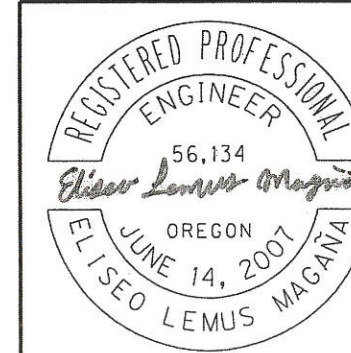

RENEWS: 12-31-2012

GENERAL CONSTRUCTION

SHEET NO.
4A

① Const. approach - 3

② Const. access road
(For details, see sht. 2A-2)

③ Sta. "L"666+23.1 To Sta. "L"668+07.4, Rt.
Const. guardrail - 112.5' (Type 2A)
- 12.5' (Type 3)
Flare rate=0, W=3', E=2'
Const. guardrail terminal, flared
Const. guardrail to bridge transition
(See drg. nos. RD410, BR208 & BR209)

④ Sta. "L"666+20.55 To Sta. "L"668+76.8, Lt.
Const. guardrail - 187.5' (Type 2A)
- 12.5' (Type 3)
Flare rate=0, W=3', E=2'
Const. guardrail terminal, non-flared
Const. guardrail to bridge transition

⑤ Sta. "L"670+80, Rt. **RELOCATE MAILBOX TO STA. "L"673+35 LEFT**
Remove extg. mailbox support
Inst. single mailbox support

⑥ Sta. "L"672+80, Rt. **RELOCATE "L" 673+35 LEFT**
Remove extg. mailbox support **(B) "L" 672 + 85 Rt. MULT.**
Inst. single mailbox support

⑦ See sht. 3A-2, note 18
Const. inlet

⑧ Sta. "L"667+40, 18.3' Rt.
Const. type "G-2" inlet
Inst. 12" culv. pipe - 10'
5' Depth
Const. culvert slope protection
Const. loose riprap (Class 50) - 1.5 cu. yd.
(For details, see sht. 2B-3)

⑨ Sta. "L"668+19.6 To Sta. "L"669+59, Lt.
Inst. 18" storm sew. pipe - 140.5'
5' Depth **SEE DETAIL @ LEFT**

⑩ Sta. "L"669+60, 37.5' Lt.
Const. type "D" inlet

⑪ Sta. "L"679+61 To Sta. 671+03.3, Lt.
Inst. 18" storm sew. pipe - 142.5'
5' Depth
Const. slope end - 2

⑫ Sta. "L"669+60
Inst. 18" storm sew. pipe - 79.8'
5' Depth
Const. slope end, Rt.

⑬ Remove extg. structure
(For drg. nos. see sht. 1A)

⑭ See sht. 3A-2, note 8
Const. structure

⑮ See sht. 3A-2, note 5
Const. guardrail
Const. guardrail to bridge transition

⑯ See sht. 3A-2, note 3
Const. guardrail
Const. guardrail to bridge transition


⑰ See sht. 3A-2, note 4
Const. drainage curb

⑱ See sht. 3A-2, note 16
Inst. storm sew. pipe

⑲ See sht. 3A-2, note 19
Const. water quality biofiltration swale

⑳ See sht. 3A-2, note 20
Const. water quality biofiltration swale

㉑ Const. bank protection
(For drg. nos., see sht. 1A)

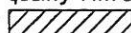㉒ Sta. "L"667+42 To Sta. "L"670+60, Rt.
Const. No. 00575 water quality biofiltration swale
Const. water quality filtration strip
Shown thus: 
(For details, see sht. 2B-4)

REVISED AS CONSTRUCTED
6/24/14 CONTRACT 14457

㉓ Sta. "L"666+22.9 To Sta. "L"667+38.8, Rt.
Const. drainage curb

㉔ Sta. "L"699+55, 45.4' Rt.
Inst. steel plate
(For details, see sht. GJ)

㉕ Sta. "L"699+65, 44.9' Rt.
Inst. steel plate
(For details, see sht. GJ)

㉖ Sta. "L"671+15 To Sta. "L"672+60, Lt.
Const. No. 00608 water quality biofiltration swale
(For details, see sht. 2B-4)

㉗ See sht. 3A-2, note 23
Const. bank protection

㉘ Remove extg. power pole - 3
Inst. power pole - 3
(By others)

㉙ Sta. "L"672+67.4 To Sta. 673+36, Rt.
Inst. 12" culv. pipe - 68.5'
5' Depth
Const. slope end - 2


㉚ Remove extg. pipe - 127'

㉛ Sta. "L"670+60 To Sta. "L"672+60, Rt.
Const. No. 00575 water quality biofiltration swale
(For details, see sht. 2B-4)


㉜ See sht. 3A-2, note 25

㉝ Inst. plastic board flow spreader - 8
(For details, see sht. 2B-4)



㉞ **INSTALLED 12" X 60' DUCTILE IRON**

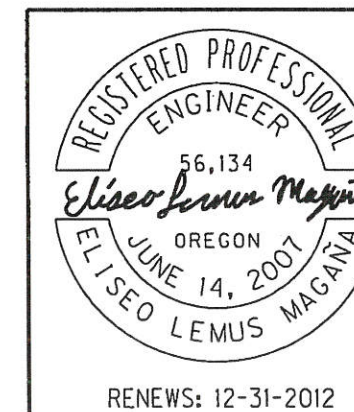


RENEWS: 12-31-2012

 OREGON DEPARTMENT OF TRANSPORTATION	
REGION 2 TECH CENTER	
OR213: BUTTE CREEK (JACKS) BRIDGE SEC. CASCADE HIGHWAY SOUTH MARION & CLACKAMAS COUNTIES	
Design Team Leader - Edward W. Cantrell Designed By - Eliseo Lemus Magaña Drafted By - D. Gentner-Day	
NOTES	SHEET NO. 4A-2

REVISED AS CONSTRUCTED
6/24/14 CONTRACT 14457

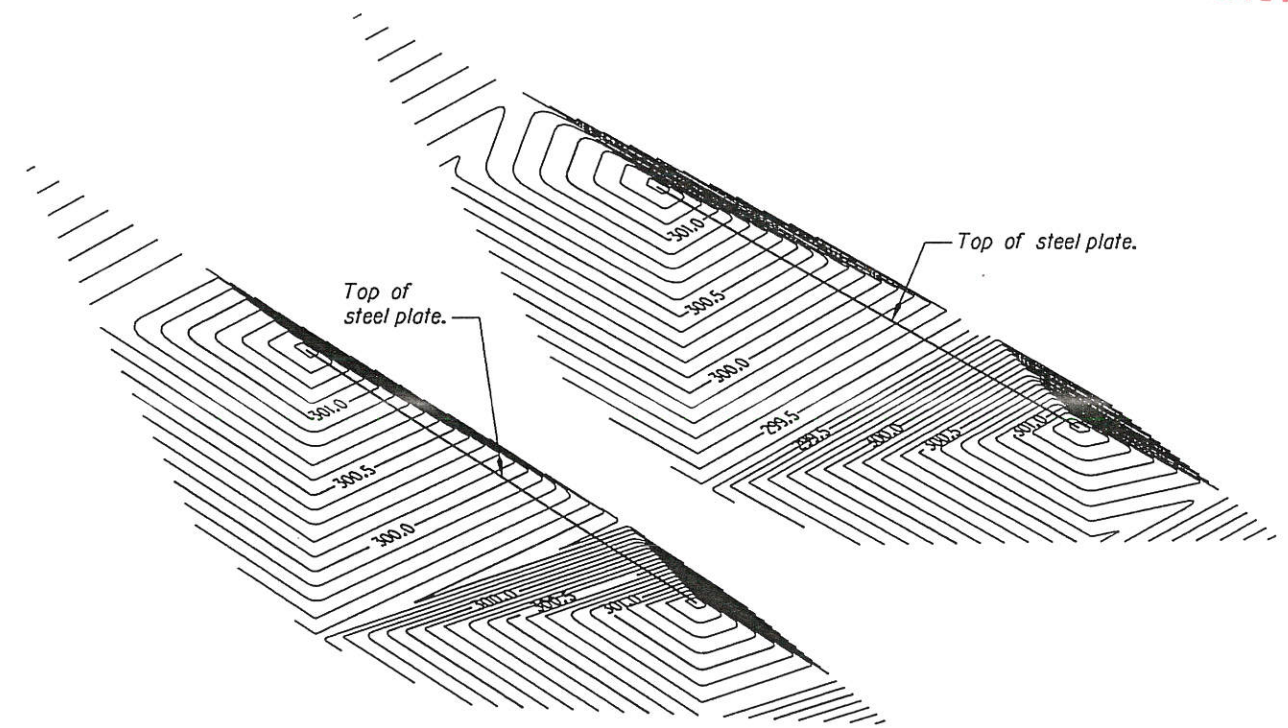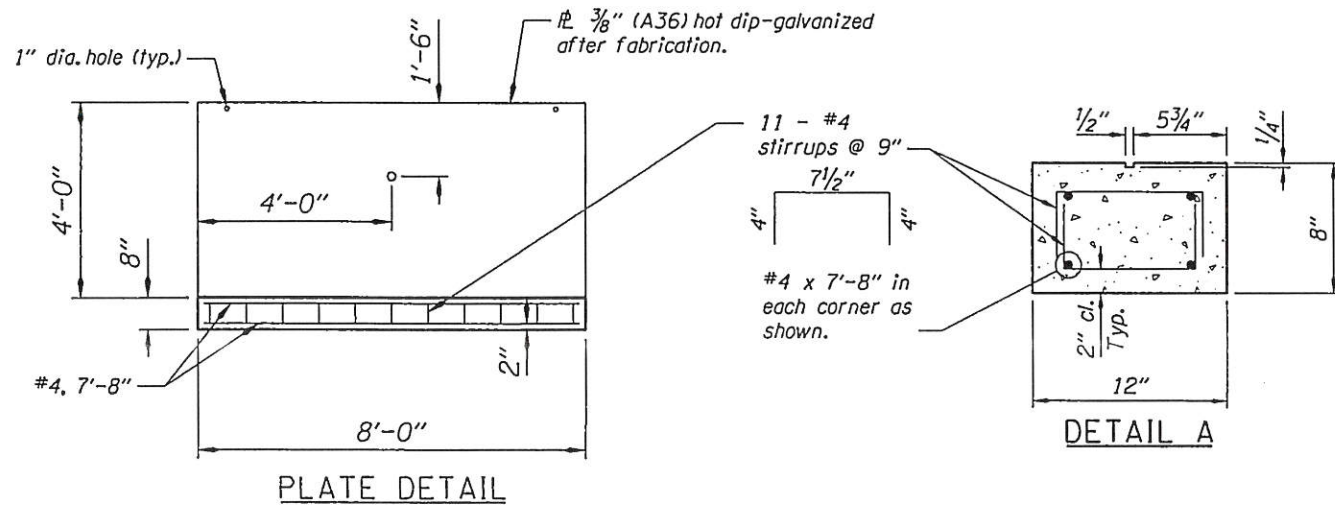

ISOMETRIC EARTHEN BERM AROUND STEEL PLATES

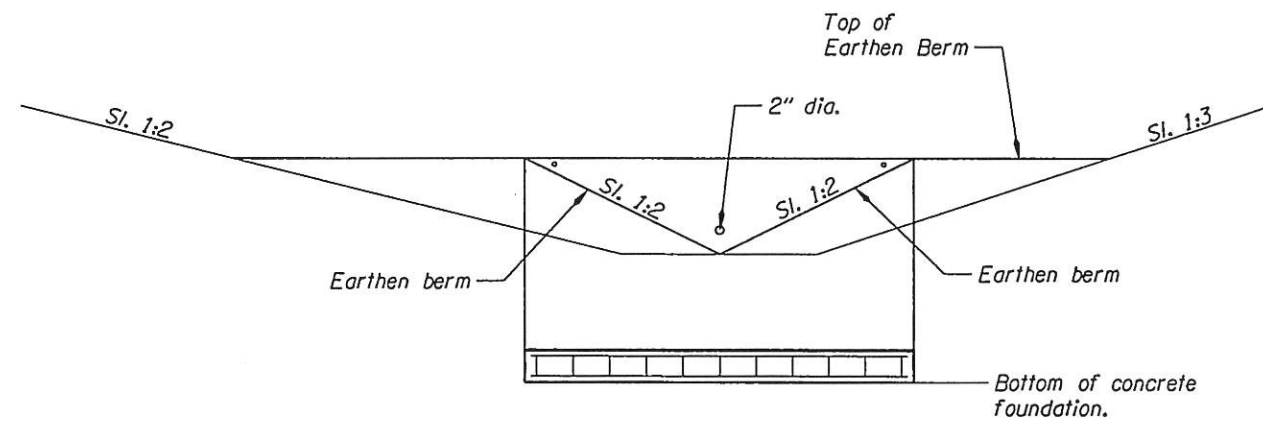

BERM ELEVATION

Plate Elevation Table


Station	Bottom of concrete foundation	Top of steel plate and berm
"L"669+55	296.81	301.48
"L"669+65	296.69	301.36

OREGON DEPARTMENT OF TRANSPORTATION

REGION 2 TECH CENTER

OR213: BUTTE CREEK (JACKS)
BRIDGE NO. 01597 SEC.
CASCADE HIGHWAY SOUTH
MARION & CLACKAMAS COUNTIES


Reviewed By - Bruce Carmichael, P.E.
Designed By - Chris Carman, P.E.
Drafted By - Michael Skelton

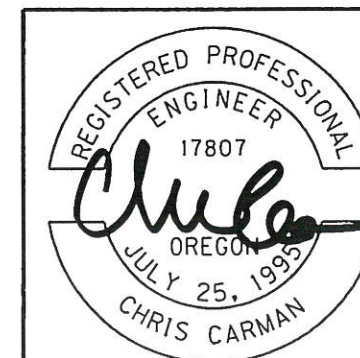

RENEWS: 12-31-2013

STORMWATER

SHEET NO.
GJ

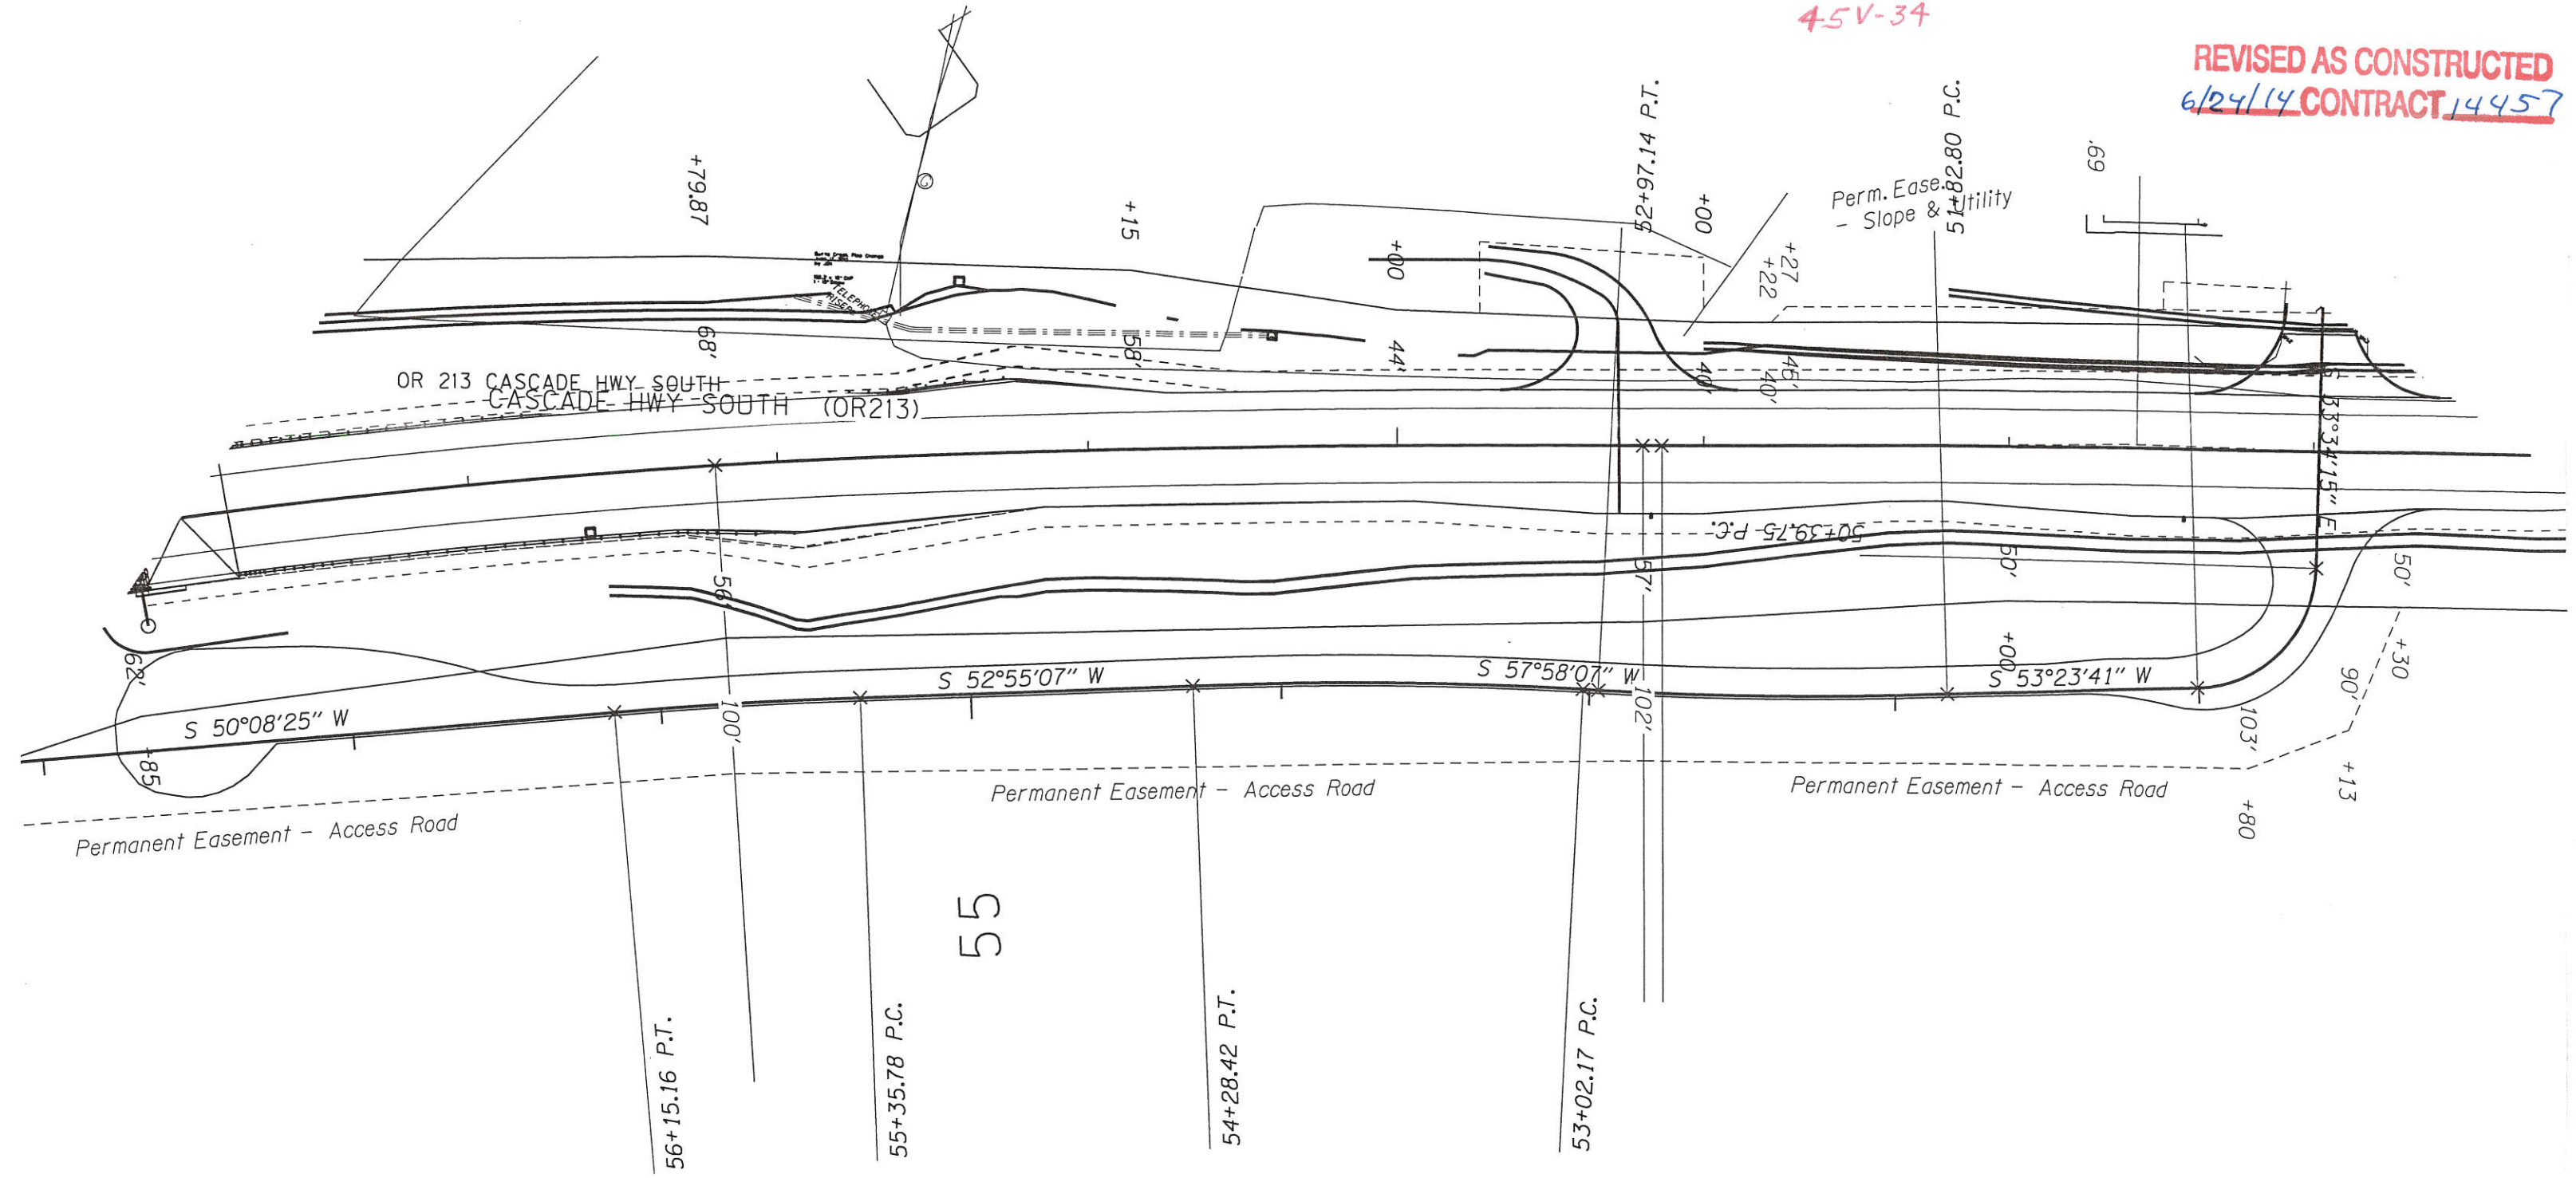

ODOT

OR 213: BUTTE CREEK (JACK'S) BRIDGE
CASCADE HIGHWAY SOUTH
MARION AND CLACKAMAS COUNTIES
"AX" ALIGNMENT - PLAN SHEET 4-SUPPL.