


# **OPERATION & MAINTENANCE MANUAL**

**DFI No. : D00576**  
**Facility Type: Water Quality**  
**Biofiltration Swale**

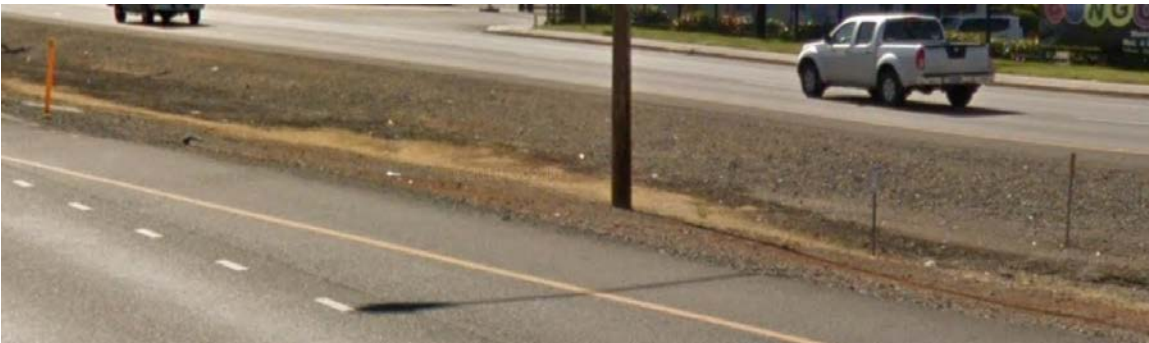

**JULY, 2018**

**INDEX**

1. IDENTIFICATION..... 1

2. FACILITY CONTACT INFORMATION..... 1

3. CONSTRUCTION..... 1

4. STORM DRAIN SYSTEM AND FACILITY OVERVIEW ..... 2

5. FACILITY HAZ MAT SPILL FEATURE(S)..... 2

6. AUXILIARY OUTLET (HIGH FLOW BYPASS)..... 2

7. MAINTENANCE REQUIREMENTS..... 3

8. WASTE MATERIAL HANDLING..... 4

**APPENDIX A:** Operational Plan and Profile Drawing(s)

**APPENDIX B:** ODOT Project Plan Sheets

## 1. Identification

Drainage Facility ID (DFI): **D00576**  
Facility Type: Water Quality Biofiltration Swale  
Construction Drawings: 45V-101  
Location: District: 08  
Highway No.: 025  
Mile Post: 0.65; 0.75 (beg./end)  
Description: This facility is located in the median of US 199. Access to the facility can be obtained along the shoulder of US 199.

## 2. Facility Contact Information

Contact the Engineer of Record, Region Technical Center, or Geo-Environmental's Senior Hydraulics Engineer for:

- Operational clarification
- Maintenance clarification
- Repair or restoration assistance

### Engineering Contacts:

Region Technical Center Hydro Unit Manager

Or

Geo-Environmental Senior Hydraulics Engineer (503) 986-3365.

## 3. Construction

Engineer of Record: Jason Sheadel – Region 3 Tech Center

Facility construction: 2013  
Contractor: N/A

|

#### **4. Storm Drain System and Facility Overview**

A water quality swale is a flat-bottomed open channel designed to treat stormwater runoff from highway pavement areas. This type of facility is lined with grass. Treatment by trapping sedimentation occurs when stormwater runoff flows through the grass.

This facility is located along the median of US 199 (No. 025). Access for this facility is available from the median shoulder of US 199. Stormwater enters the facility via roadway runoff and a drainage ditch. As the water flows west it is treated as it slows and spreads out within the swale before outfalling into a storm drainage pipe.

A. Maintenance equipment access:

This facility can be accessed from the median of US 199 (Hwy 025) shoulder.

B. Heavy equipment access into facility:

- Allowed (no limitations)
- Allowed (with limitations)
- Not allowed

C. Special Features:

- Amended Soils
- Porous Pavers
- Liners
- Underdrains

#### **5. Facility Haz Mat Spill Feature(s)**

The water quality biofiltration swale can be used to store a volume of liquid by blocking the facility outlet through use of sandbags.

#### **6. Auxiliary Outlet (High Flow Bypass)**

Auxiliary Outlets are provided if the primary outlet control structure can not safely pass the projected high flows. Broad-crested spillway weirs and over flow risers are the two most common auxiliary outlets used in stormwater treatment facility design. The auxiliary outlet feature is either a part of the facility or an additional storm drain feature/structure.

The auxiliary outlet feature for this facility is:

Designed into facility

Other

There are no auxiliary outlets built into this facility. In the event that flows exceed design flows the water will overtop the swale.

## 7. Maintenance Requirements

Routine maintenance table for non-proprietary stormwater treatment and storage/detention facilities have been incorporated into ODOT's Maintenance Guide. These tables summarize the maintenance requirements for ponds, swales, filter strips, bioslopes, and detention tanks and vaults. Special maintenance requirements in addition to the routine requirements are noted below when applicable.

The ODOT Maintenance Guide can be viewed at the following website:

<http://www.oregon.gov/ODOT/HWY/OOM/MGuide.shtml>

Maintenance requirements for proprietary structures, such as underground water quality manholes and/or vaults with filter media are noted in Appendix C when applicable.

The following stormwater facility maintenance table (See ODOT Maintenance Guide) should be used to maintain the facility outlined in this Operation and Maintenance Manual or follow the Maintenance requirements outlined in Appendix C when proprietary structure is selected below:

- Table 1 (general maintenance)
- Table 2 (stormwater ponds)
- Table 3 (water quality biofiltration swales)
- Table 4 (water quality filter strips)
- Table 5 (water quality bioslopes)
- Table 6 (detention tank)
- Table 7 (detention vault)
- Appendix C (proprietary structure)
- Special Maintenance requirements:

Note: Special maintenance Requirements Require Concurrence from ODOT SR Hydraulics Engineer.

## 8. Waste Material Handling

Material removed from the facility is defined as waste by the Department of Environmental Quality (DEQ). Refer to the roadwaste section of the ODOT Maintenance Yard Environmental Management System (EMS) Policy and Procedures Manual for disposal options:

[http://www.oregon.gov/ODOT/Maintenance/Documents/ems\\_manual.pdf](http://www.oregon.gov/ODOT/Maintenance/Documents/ems_manual.pdf)


Contact any of the following for more detailed information about management of waste materials found on site:

|                                   |                |
|-----------------------------------|----------------|
| ODOT Clean Water Unit             | (503) 986-3008 |
| ODOT Statewide Hazmat Coordinator | (503) 667-7442 |
| ODOT Region 1 Hazmat Coordinator  | (503) 731-8290 |
| ODOT Region 2 Hazmat Coordinator  | (503) 986-2647 |
| ODOT Region 3 Hazmat Coordinator  | (541) 957-3594 |
| ODOT Region 4 Hazmat Coordinator  | (541) 388-6186 |
| ODOT Region 5 Hazmat Coordinator  | (541) 963-1590 |
| ODEQ Northwest Region Office      | (503) 229-5263 |


# Appendix A

## Content:


- **Operational Plan and Profile Drawing(s)**

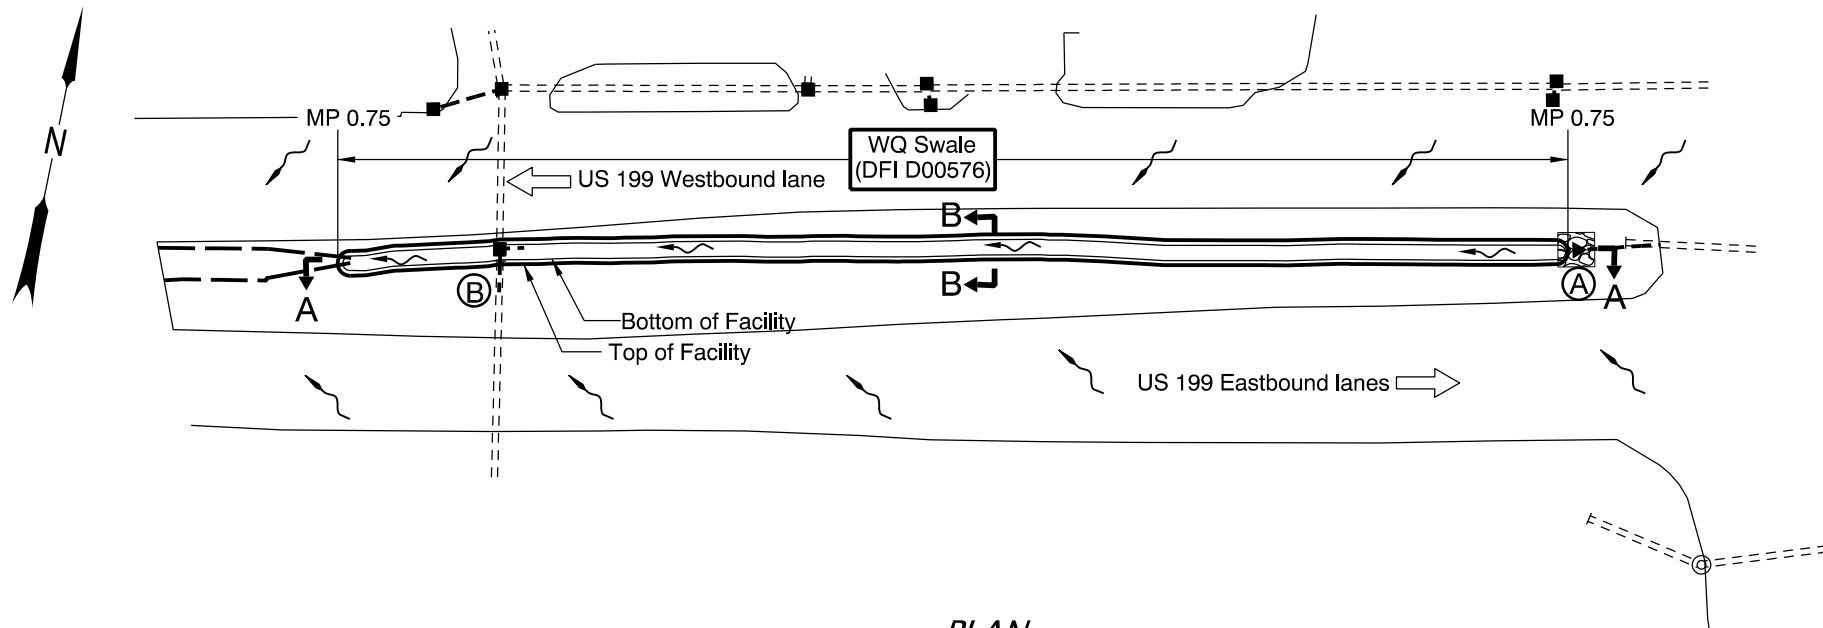

PLAN  
N.T.S.

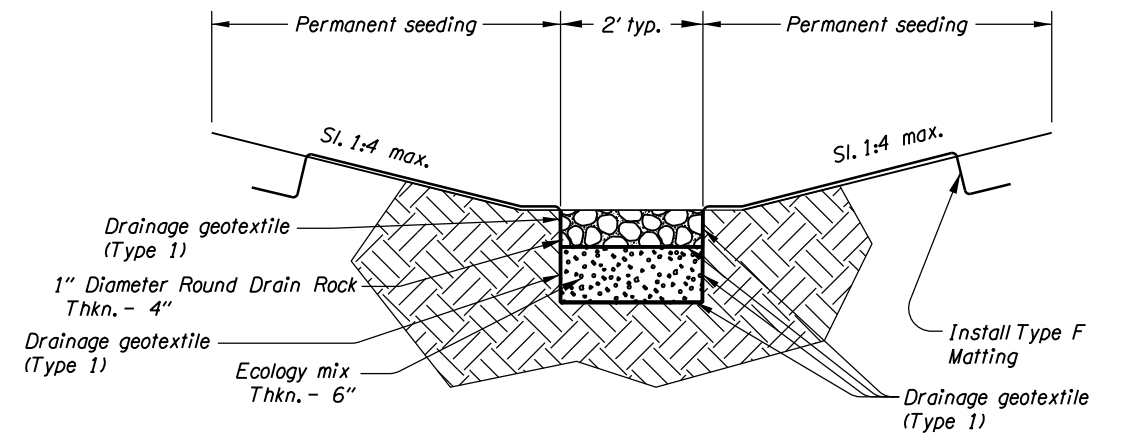

SECTION B-B  
N.T.S.

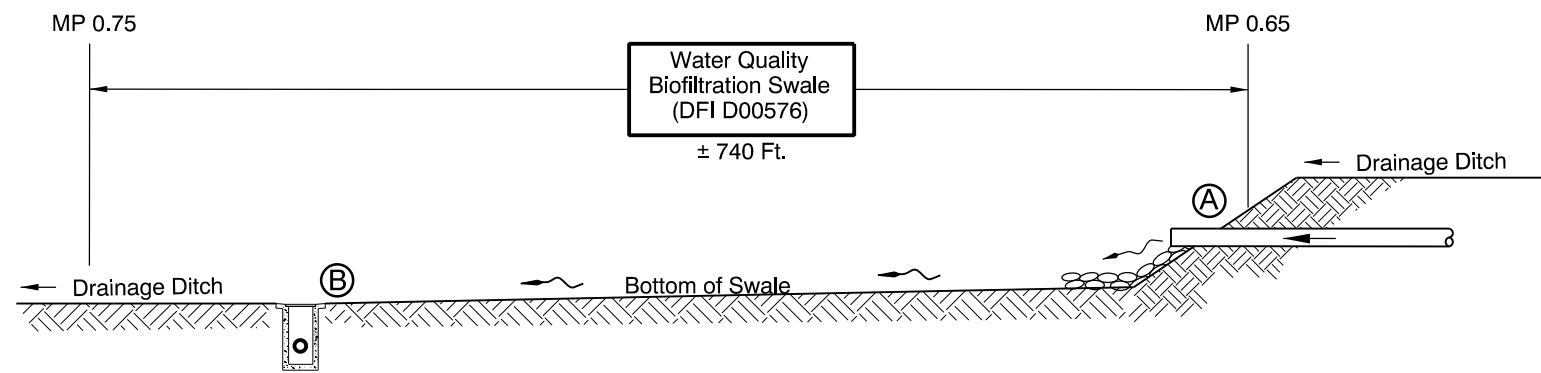

SECTION A-A  
N.T.S.

LEGEND:

- (A) Swale Inlet w/Flow Spreader
- (B) Swale Outlet
- and □ Inlet
- and ○ Manhole
- Storm Pipe (Facility)
- Storm Pipe
- ← Conveyance Direction
- ~ Pavement / Facility Flow Path



OREGON DEPARTMENT  
OF TRANSPORTATION

Prepared By:  
T. BURRIER

Drafted By:  
T. BURRIER

**DFI D00576**  
**MAINTENANCE DISTRICT 8 HWY 025**  
**WATER QUALITY BIOFILTRATION SWALE**  
HIGHWAY MP 0.65 TO MP 0.75  
JOSEPHINE COUNTY



# Appendix B

## Content:

- **ODOT Project Plan Sheets**
  - *Cover/Title Sheet*
  - *Water Quality/Detention Plan Sheets*
  - *Other Details*

| INDEX OF SHEETS |  |
|-----------------|--|
| SHEET NO.       | DESCRIPTION                            |
| 1               | Title Sheet                            |
| 1A              | Index Of Sheets Cont. & Std. Dwg. Nos. |

STATE OF OREGON  
 DEPARTMENT OF TRANSPORTATION  
 PLANS FOR PROPOSED PROJECT  
**SIGNAL REMOVAL, PAVING & SIGNING**

**US 199 @ JOSEPHINE COUNTY FAIRGROUNDS**

**END OF PROJECT STP-S025(047)**


**REDWOOD HIGHWAY**

**STA. "RW" 824+60.86 (M.P. 0.520) =**  
**STA. "WB" 38+26.66, OFFSET 90.53' Lt.**

**JOSEPHINE COUNTY**  
**AUGUST 2012**

**BEGINNING OF PROJECT**  
**STP-S025(047)**


**STA. "RW" 797+25.98 (M.P. 1.038) =**  
**STA. "WB" 10+90.99, OFFSET 50.76' Lt.**  
**& STA. "EB" 22+06.47, OFFSET 10.73' Lt.**

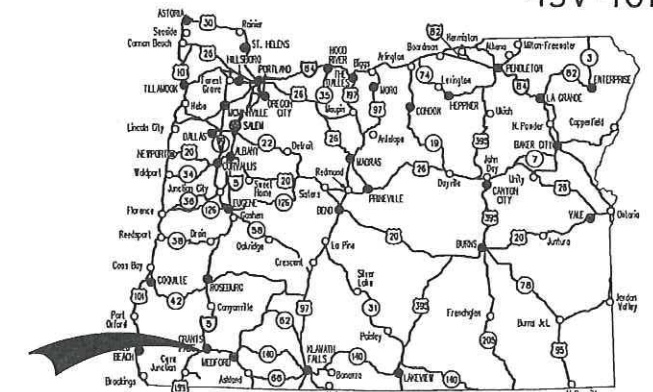

Overall Length Of Project - 0.54 Miles

**ATTENTION:**  
 Oregon Law Requires You To Follow Rules Adopted By The Oregon Utility Notification Center. Those Rules Are Set Forth In OAR 952-001-0010 Through OAR 952-001-0090. You May Obtain Copies Of The Rules By Calling The Center. (Note: The Telephone Number For The Oregon Utility Center Is (503) 232-1987.)

**LET'S ALL WORK TOGETHER TO MAKE THIS JOB SAFE**

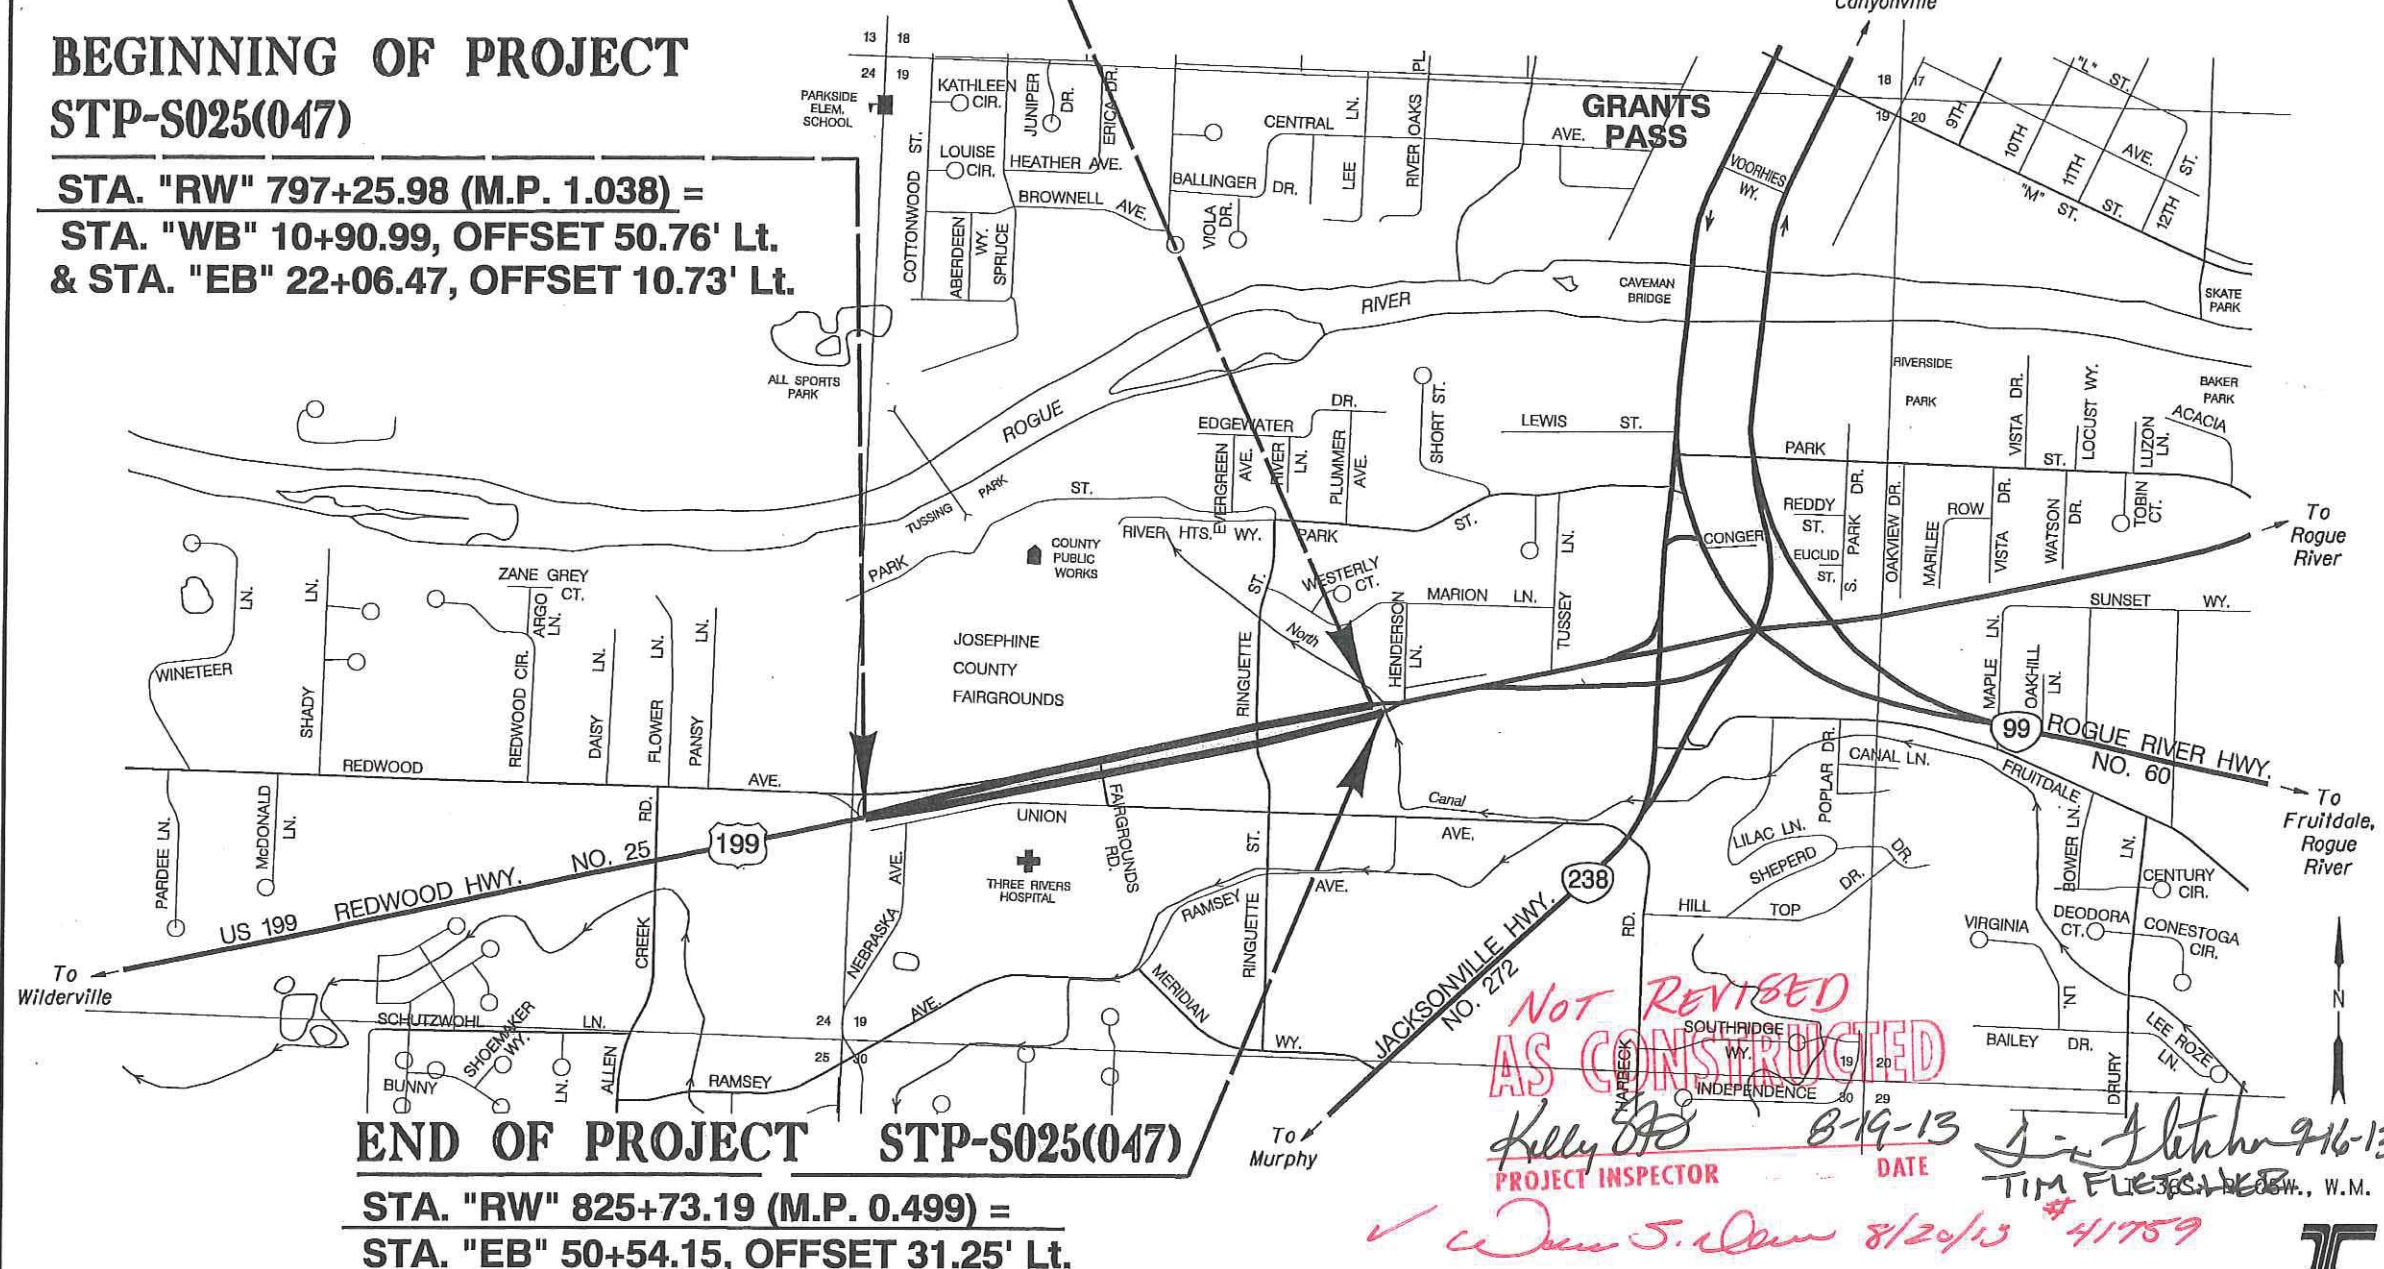

**END OF PROJECT STP-S025(047)**  
**STA. "RW" 825+73.19 (M.P. 0.499) =**  
**STA. "EB" 50+54.15, OFFSET 31.25' Lt.**

**NOT REVISED AS CONSTRUCTED**  
 Kelly [Signature] PROJECT INSPECTOR DATE 8-19-13  
 [Signature] DATE 8-16-13  
 [Signature] W.M.  
 [Signature] DATE 8/20/13 # 41759

**OREGON TRANSPORTATION COMMISSION**  
 Pat Egan CHAIR  
 David Lohman COMMISSIONER  
 Mary F. Olson COMMISSIONER  
 Mark Frohnmayer COMMISSIONER  
 Tammy Boney COMMISSIONER  
 Matthew L. Garrett DIRECTOR OF TRANSPORTATION

These plans were developed using ODOT design standards. Exceptions to these standards, if any, have been submitted and approved by the ODOT Chief Engineer or their delegated authority.

Approving Authority: [Signature] Signature & date 7-10-2012  
 MARK THOMPSON, TECH CENTER MGR  
 Print name and title  
 [Signature] Concurrence by ODOT Chief Engineer

|  |                |           |
|--|----------------|-----------|
| US 199 @ JOSEPHINE COUNTY FAIRGROUNDS<br>REDWOOD HIGHWAY<br>JOSEPHINE COUNTY |                |           |
| FEDERAL HIGHWAY ADMINISTRATION   | PROJECT NUMBER | SHEET NO. |
| OREGON DIVISION  | STP-S025(047)  | 1         |

| INDEX OF SHEETS, CONT'D.    |                          |
|-----------------------------|--------------------------|
| SHEET NO.                   | DESCRIPTION              |
| 2 & 2A                      | Typical Sections         |
| 2B Thru 2B-7 incl.          | Details                  |
| 2C                          | Pipe Data Sheet          |
| 3, 4 & 5                    | General Construction     |
| 3A, 4A & 5A                 | Drainage & Utilities     |
| 3B & 4B                     | Profile                  |
| PERMANENT PAVEMENT MARKINGS |                          |
| ST Thru ST-3 incl.          | Striping Plan            |
| PERMANENT SIGNING           |                          |
| S-13105 & S-13106           | Signing Plan             |
| S-13107 & S-13108           | Signing Details          |
| S-13109 Thru S-13112 incl.  | Sign & Post Data Table   |
| SIGNALS                     |                          |
| 16456                       | Detector Plan            |
| 16457                       | Signal Removal Plan      |
| 16458                       | Temporary Detection Plan |
| 16459                       | Signal Plan              |
| 16460                       | Detector Plan            |
| 16461                       | Existing Utilities       |
| 16462                       | Interconnect Plan        |

Standard Dwg. Nos.

- RD100 - Mailbox Support
- RD101 - Mailbox Installation
- RD300 - Trench Backfill, Bedding, Pipe Zone And Multiple Installations
- RD302 - Street Cut
- RD312 - Subsurface Drain
- RD318 - Sloped Ends For Concrete Pipe
- RD320 - Paved End Slope For Culverts 60" Maximum Pipe Size
- RD336 - Manholes
- RD364 - Concrete Inlets Type G-1, G-2, G-2M & G-2MA
- RD366 - Concrete Inlets Type CG-1, CG-2 And Curb Inlet Channel
- RD370 - Ditch Inlet Type D
- RD371 - Concrete Inlet Base Type CG-3
- RD372 - Concrete Inlet Top, Option 1 Type CG-3
- RD376 - Miscellaneous Drainage Structures Siphon Box, Inlet Cap & Inlet Adjustment
- RD378 - Type "3" Catch Basin, Frame and Grate
- RD386 - Fill Height Table For Circular Concrete Pipe
- RD610 - Asphalt Pavement Details
- RD700 - Curbs
- RD705 - Islands
- RD706 - Traffic Separators And Transitions
- RD720 - Sidewalks
- RD735 - Curb Line Sidewalk Driveways Or Alleys (Options F & G) ODOT Highways
- RD755 - Sidewalk Ramp Details
- RD757 - Sidewalk Ramp Placement Options Curb Radii & 15'
- RD759 - Truncated Dome Detectable Warning Surface Details & Locations
- RD1005 - Check Dams
- RD1010 - Inlet Protection (Type 1, 2 & 3)
- RD1040 - Sediment Fence
- RD1055 - Matting
- TM200 - Sign Installation Details
- TM201 - Miscellaneous Sign Placement Details
- TM211 - Signing Details US & Interstate Route Shields
- TM221 - Signing Details Milepost Markers
- TM222 - Installation Details Milepost Marker Posts
- TM223 - Conventional Roads Directional Sign Layout Street Name Signs
- TM230 - Mounting Details For Removable Legend 4" Through 8" Letters & Numbers
- TM233 - Mounting Details For Removable Legend Various Arrow Sizes
- TM450 - Mast Arm Pole Details
- TM457 - Vehicle, Pedestrian Signal And Pushbutton Mounting Option Details
- TM458 - Pedestrian Ramp Placement Details
- TM462 - Adjustable Signal Head Mounting Details
- TM465 - Overhead Sign, Fire Preemption And Photoelectric Control Details
- TM467 - Pedestrian Signal And Pedestrian Push Button Details
- TM470 - Color Code Charts
- TM472 - Traffic Signal Junction Boxes
- TM475 - Loop Details
- TM480 - Loop Entrance Details


Standard Dwg. Nos. Contd.

- TM500, TM501, TM502, TM503 - Pavement Marking Standard Detail Blocks
  - TM517 - Recessed Pavement Markers
  - TM521 - Durable Pavement Markings Method 'B' Extruded & Method 'F' Spray
  - TM530 - Intersection Pavement Markings (Crosswalk, Stop Bar, & Bike Lane Stencil)
  - TM531 - Turn Arrow Marking Details
  - TM551 - Freeway Exit Ramp Pavement markings
  - TM560 - Alignment Layout: General
  - TM570 - Traffic Delineators
  - TM571 - Traffic Delineators Steel Post Details
  - TM576 - Traffic Delineator Installation
  - TM635 - Breakaway Sign & Luminaire Supports - Support Location Guidelines
  - TM670 - Wood Post Sign Supports
  - TM671 - 3 Second Gust Wind Speed Map
  - TM675 - Extruded Aluminum Panels
  - TM676 - Sign Attachments
  - TM677 - Sign Mounts
  - TM678 - Secondary Sign Mounting Details
  - TM680 - Signal Pole Mounts
  - TM681 - Perforated Steel Square Tube (PSST) Sign Support Installation
  - TM687 - Perforated Steel Square Tube (PSST) Anchor Foundation
  - TM688 - Perforated Steel Square Tube (PSST) Slip Base Foundation
  - TM800 - Tables, Abrupt Edge And PCMS Details
  - TM820 - Temporary Barricades
  - TM821 - Temporary Sign Supports
  - TM841 - Intersection Work Zone Details
  - TM843 - Multi-Lane Signalized Intersection Details
  - TM851 - Non-Freeway Multi-Lane Sections
- R/W Map No. 8B-10-9


NOT REVISED  
AS CONSTRUCTED  
*Kelly SP*  
PROJECT INSPECTOR      8-19-13  
DATE

|  |                |              |
|--|----------------|--------------|
| US 199 @ JOSEPHINE COUNTY FAIRGROUNDS<br>REDWOOD HIGHWAY<br>JOSEPHINE COUNTY |                |              |
| FEDERAL HIGHWAY<br>ADMINISTRATION  | PROJECT NUMBER | SHEET<br>NO. |
| OREGON<br>DIVISION   | STP-S025 (047) | 1A           |


Standard Drawings located on the web at:  
[http://www.oregon.gov/ODOT/HWY/ENGSERVICES/standard\\_drawings\\_home.shtml](http://www.oregon.gov/ODOT/HWY/ENGSERVICES/standard_drawings_home.shtml)

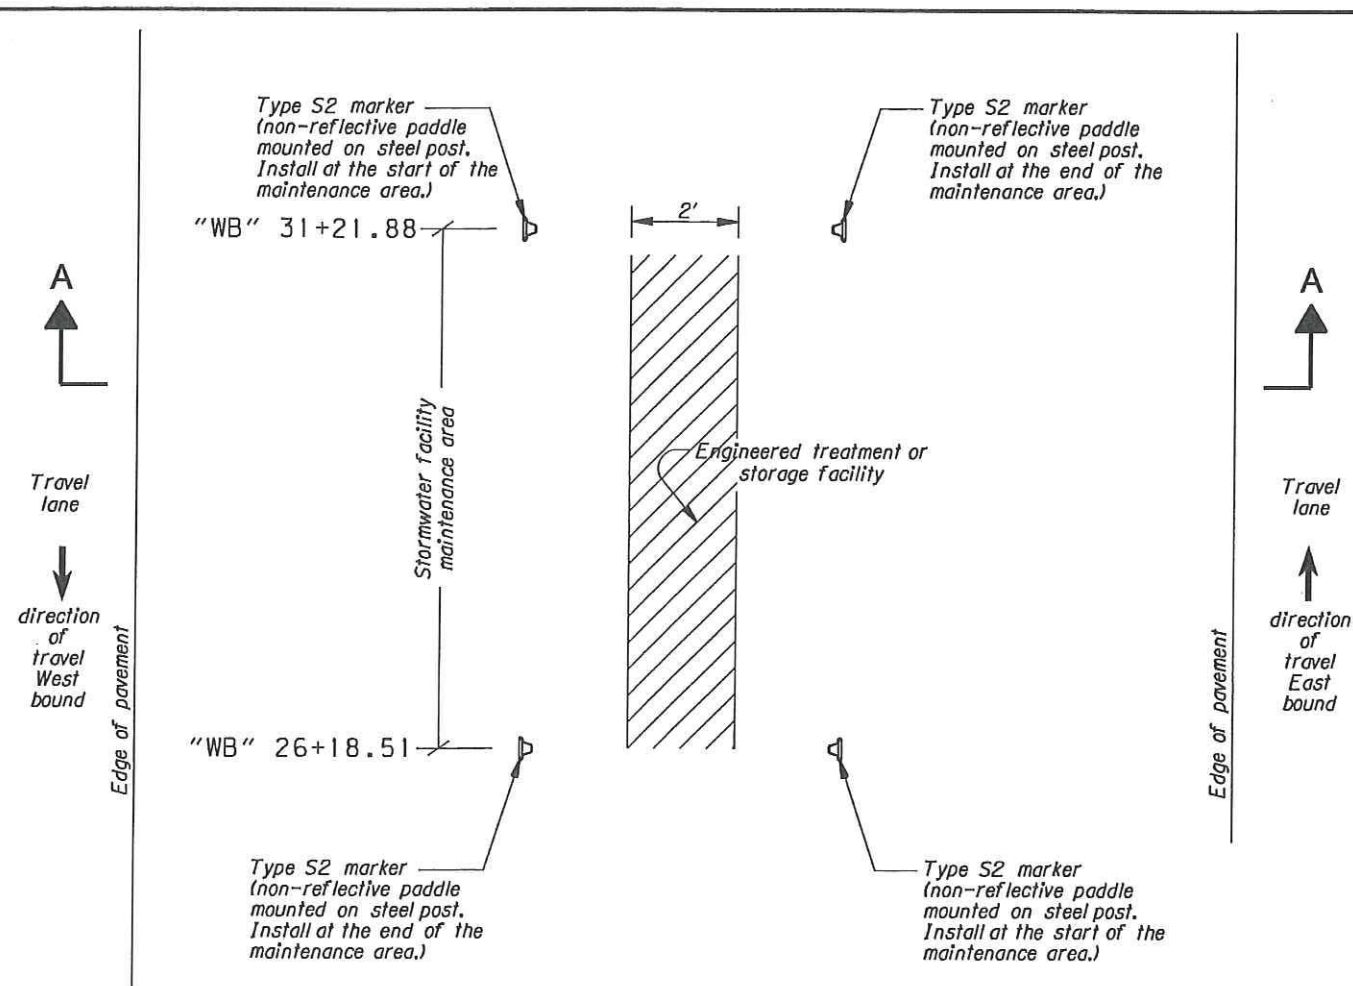

**TYPE S2 MARKERS INSTALLATION DETAIL**

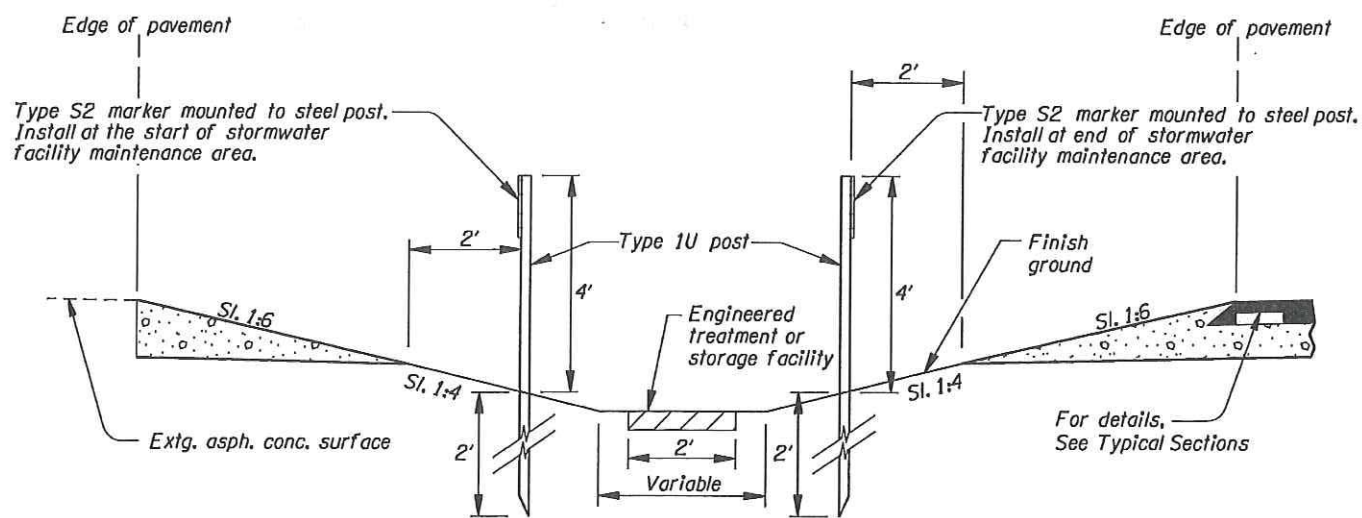

**SECTION A-A**

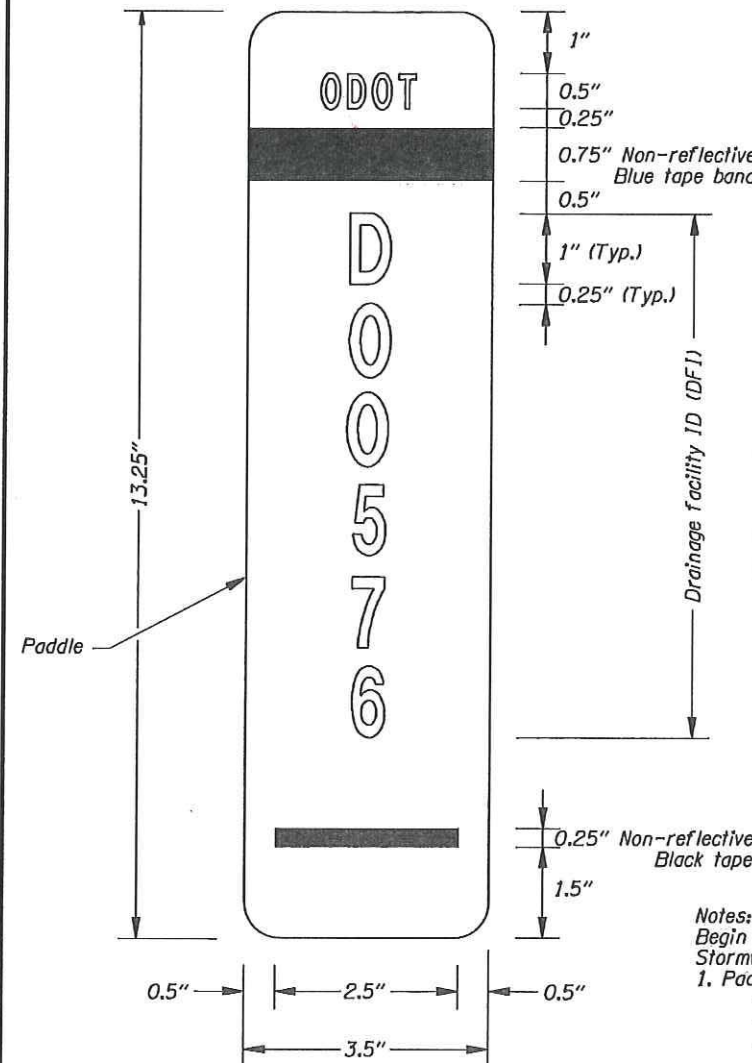

**TYPE S2 MARKER**


**MARKER TABLE**

| FACILITY LOCATION         |       | DFI #  | TYPE S2 MARKER LOCATION |     |
|---------------------------|-------|--------|-------------------------|-----|
| STATION                   | MP    |        | BEGIN                   | END |
| "WB" 26+18.51, 53.53' Rt. | 0.749 | D00576 | ✓                       |     |
| "WB" 31+21.88, 45.12' Rt. | 0.654 | D00576 |                         | ✓   |
| "WB" 31+21.88, 26.80' Rt. | 0.654 | D00576 | ✓                       |     |
| "WB" 26+18.51, 26.16' Rt. | 0.749 | D00576 |                         | ✓   |

✓ Check where appropriate

- Notes:  
Begin and End Locations of type S2 markers correspond to the direction of travel. Stormwater Facility Field Marker Type S2:
- Paddle:
    - Aluminum sheet, nominal thickness 0.050"
    - White non-reflective background
    - Mount paddle to one (1) Type 1U steel post using 3/16" diameter aluminum blind rivets and washers. See Standard Drawing TM570 detail labeled "Steel Posts" for mounting a traffic target. Install paddle onto Type 1U steel post using the same hole pattern.
    - Text and numbers are Type C font in non-reflectORIZED black
    - Band is non-reflective blue tape
    - Do not mount paddle to other highway signing posts
    - Install paddle parallel to travel lane
    - Prepare paddle for each "DFI" noted in the marker table
  - Steel Posts:
    - See Standard Drawing TM571 for Type 1U steel post dimensions

*NOT REVISION*  
**AS CONSTRUCTED**  
*Kelly* PROJECT INSPECTOR  
*8-19-13* DATE

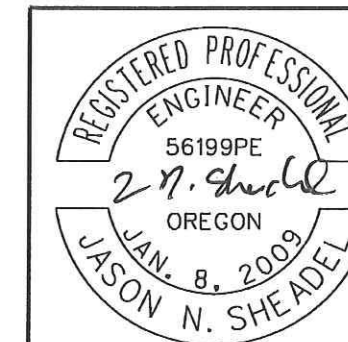

EXPIRES: JUNE 30, 2014

**OREGON DEPARTMENT OF TRANSPORTATION**

**REGION 3 - TECHNICAL CENTER**


**US 199 @ JOSEPHINE COUNTY FAIRGROUNDS**  
REDWOOD HIGHWAY  
JOSEPHINE COUNTY

Designed By - Nelly Salazar Lazara  
Reviewed By - Chris Zeimer  
Drafted By - Judy Hardin

**DETAILS**

SHEET NO.  
**2B-3**


CONTAMINATED SOIL BERM

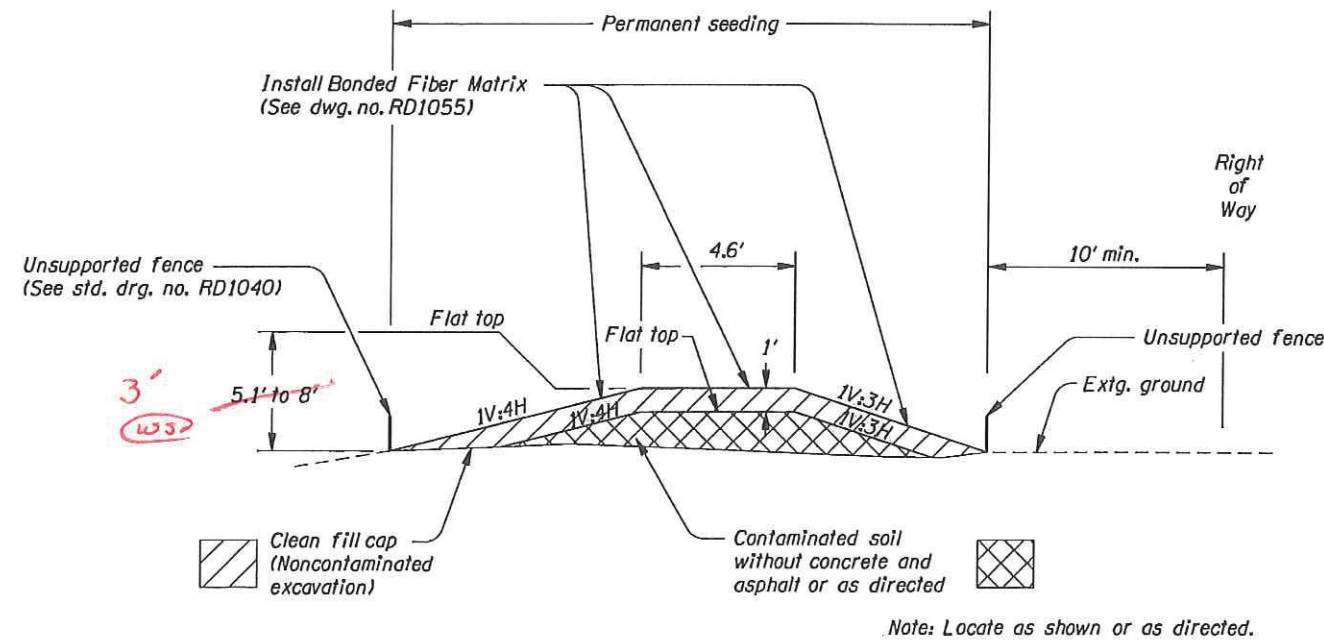

WATER QUALITY SWALE

(Not to Scale)

STA. "WB" 26+18.57 to STA. "WB" 31+18.93 Rt.

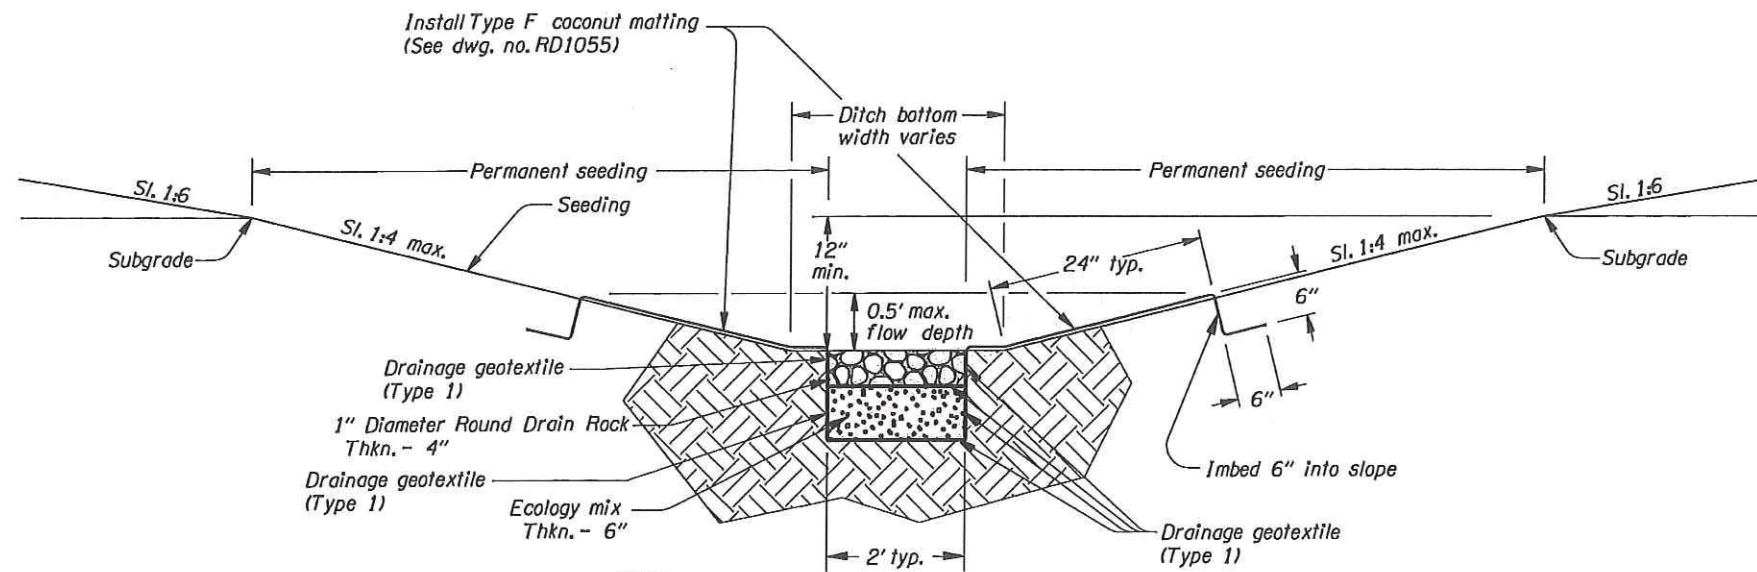

- Notes:
1. Amended soils as specified in Section 1092.
  2. Apply permanent seeding to sideslopes in accordance with Section 1030 of the Specifications.
  3. See sheets 4 and 3B for Water Quality Swale Plan and Profile Views.
  4. Apply coconut matting to side slopes according to Specifications Subsection 280.44(e).


NOT REVISED  
AS CONSTRUCTED  
Kelly SD  
PROJECT INSPECTOR  
8-19-13  
DATE



|   |                           |
|---|---------------------------|
| <p>OREGON DEPARTMENT OF TRANSPORTATION</p>  |                           |
| <p>REGION 3 - TECHNICAL CENTER</p>  |                           |
| <p>US 199 @ JOSEPHINE COUNTY FAIRGROUNDS<br/>REDWOOD HIGHWAY<br/>JOSEPHINE COUNTY</p>                 |                           |
| <p>Designed By - Nelly Salazar Lazaro<br/>Reviewed By - Chris Zelmer<br/>Drafted By - Judy Hardin</p> |                           |
| <p>DETAILS</p>  | <p>SHEET NO.<br/>2B-4</p> |


45V-101

INLET G-2MA, MODIFIED  
STA. "WB" 26+79.27, 32.09' Rt.

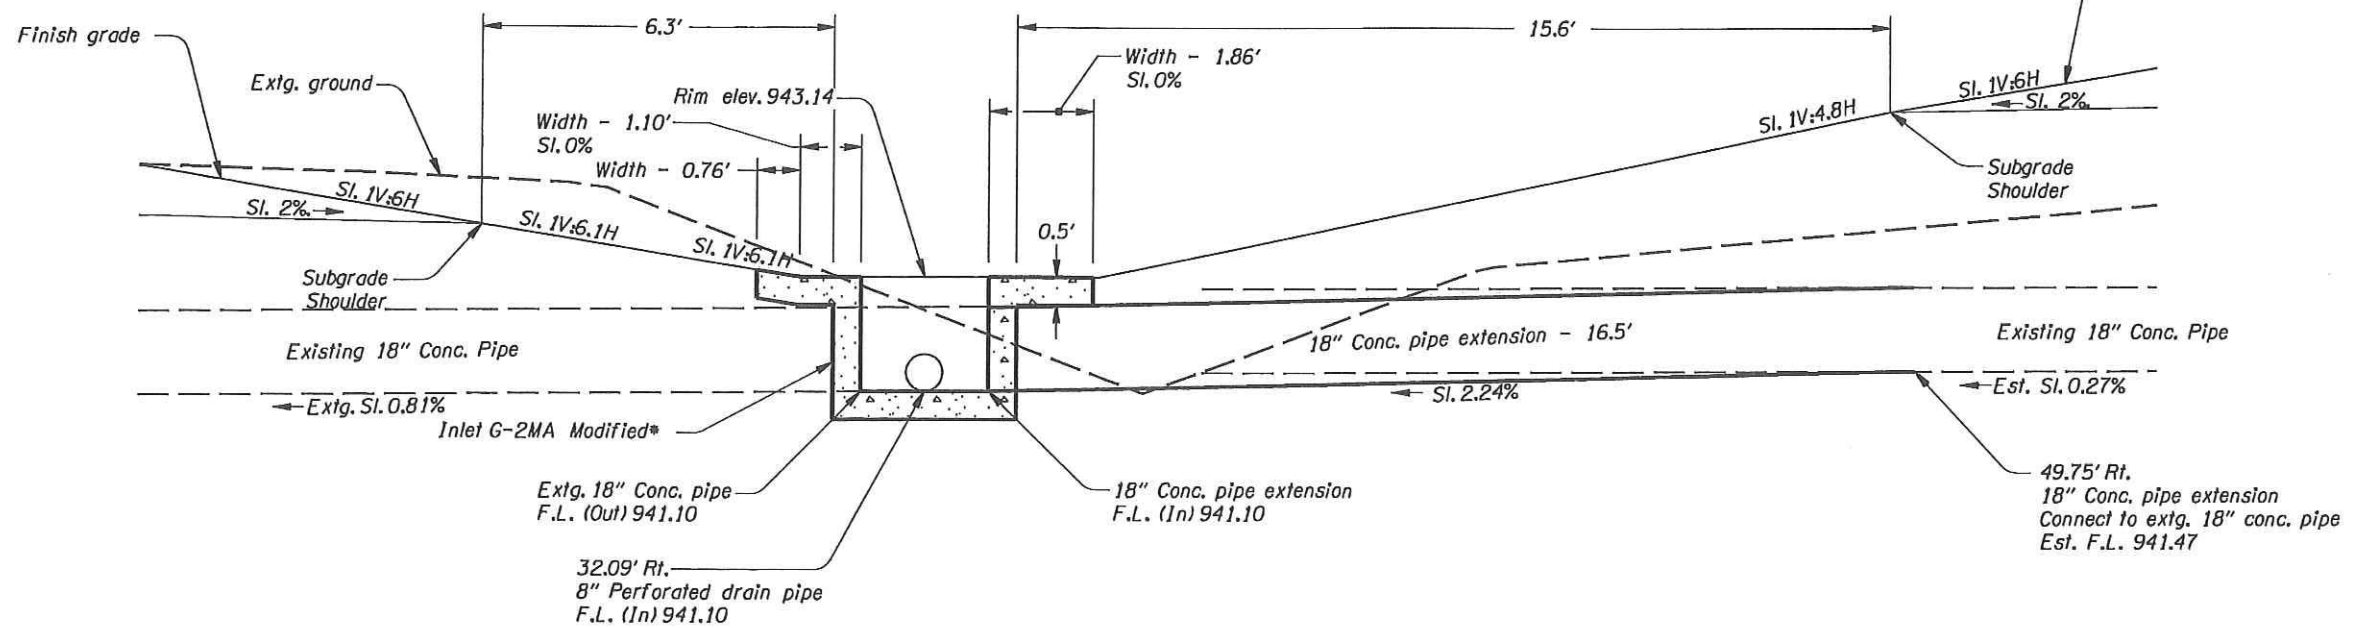

\* For details not shown, see std. drg. no. RD364 and sheets 4A & 4B.

STONE EMBANKMENT ARMORED DITCH  
AND RIPRAP PAD

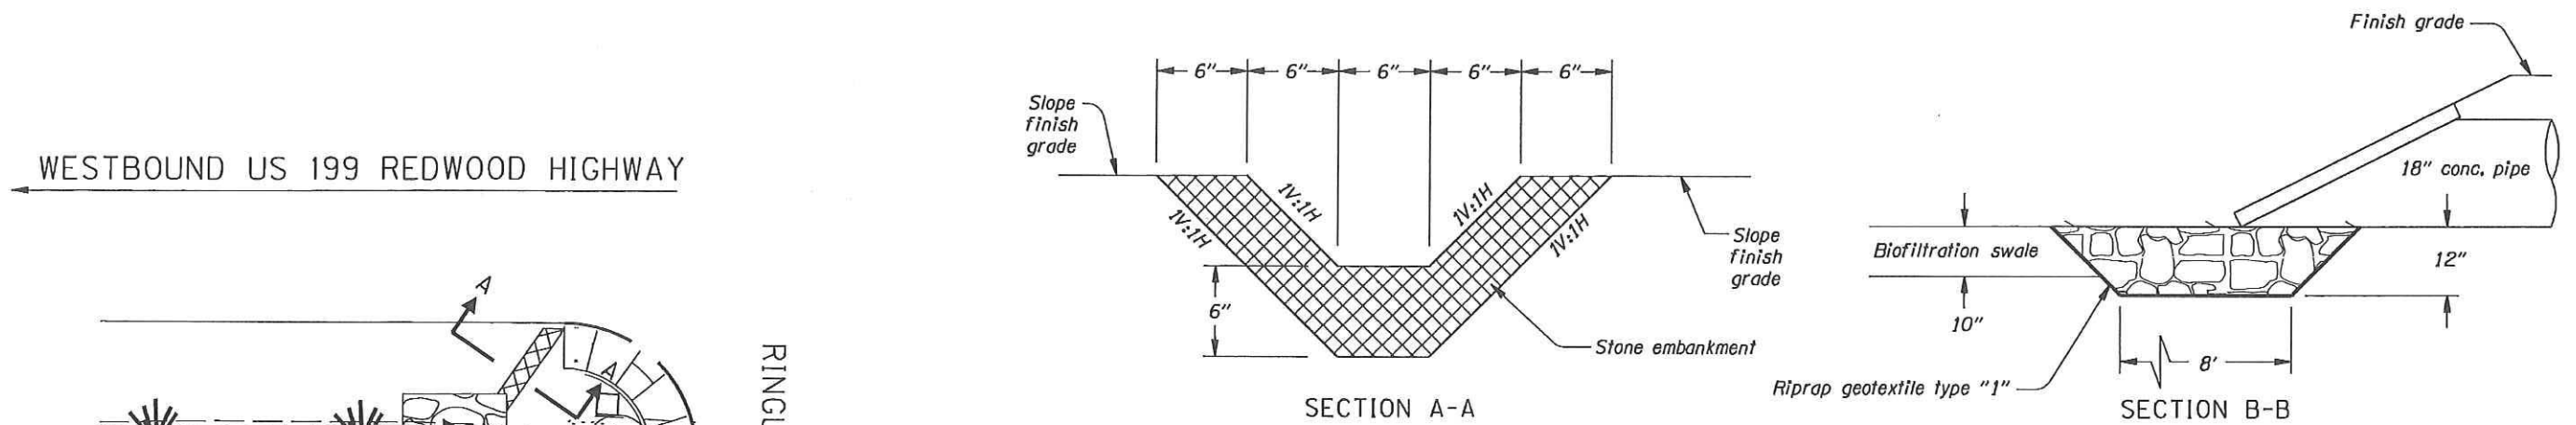

WESTBOUND US 199 REDWOOD HIGHWAY

EASTBOUND US 199 REDWOOD HIGHWAY

RINGETTE ST.


PLAN VIEW

*Not Revised*  
**AS CONSTRUCTED**  
*Kelly JF* 8-19-13  
PROJECT INSPECTOR DATE


Remove extg. pipe shown thus:   
Stone embankment shown thus:   
Class 50 Riprap shown thus:



|  |                          |
|--|--------------------------|
| OREGON DEPARTMENT OF TRANSPORTATION  |                          |
| REGION 3 - TECHNICAL CENTER  |                          |
| US 199 @ JOSEPHINE COUNTY FAIRGROUNDS<br>REDWOOD HIGHWAY<br>JOSEPHINE COUNTY                 |                          |
| Designed By - Nelly Salazar Lazaro<br>Reviewed By - Chris Zelmer<br>Drafted By - Judy Hardin |                          |
| <b>DETAILS</b>   | SHEET NO.<br><b>2B-5</b> |

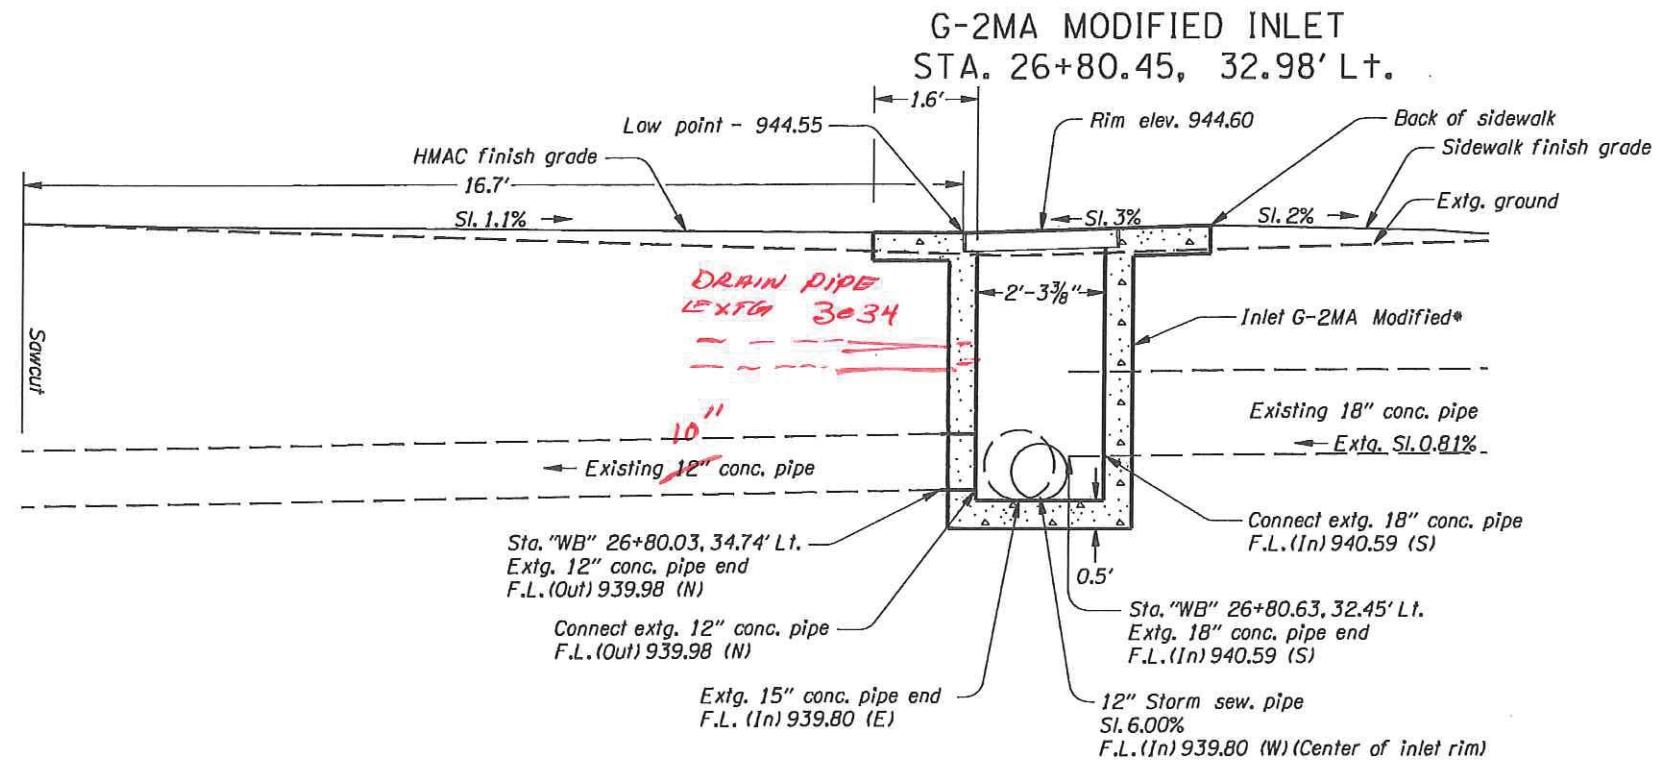


SECTION A-A

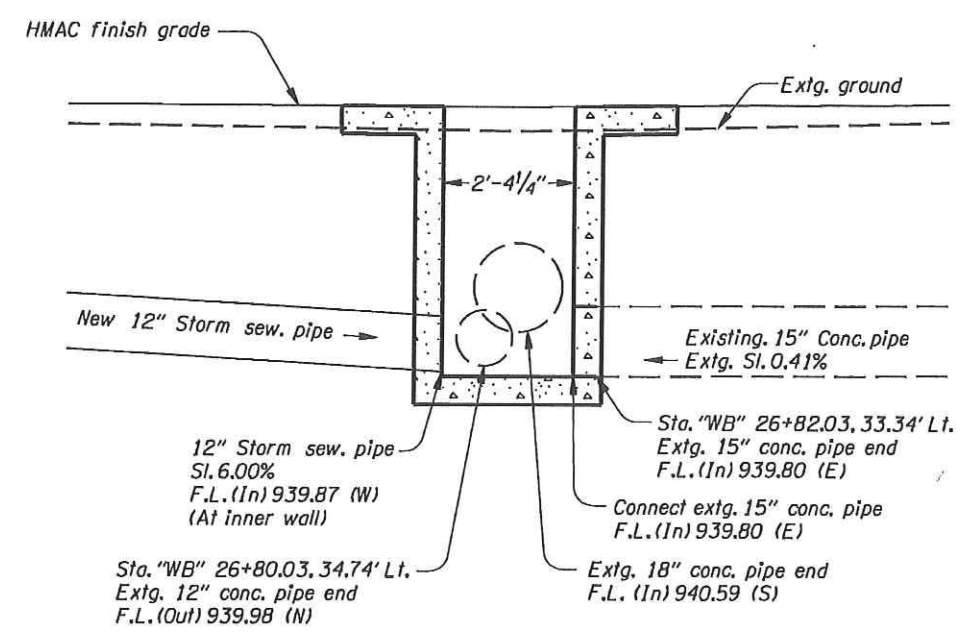

SECTION B-B


\* For details not shown, see std. drg. no. RD364 and sheets 4A & 4B

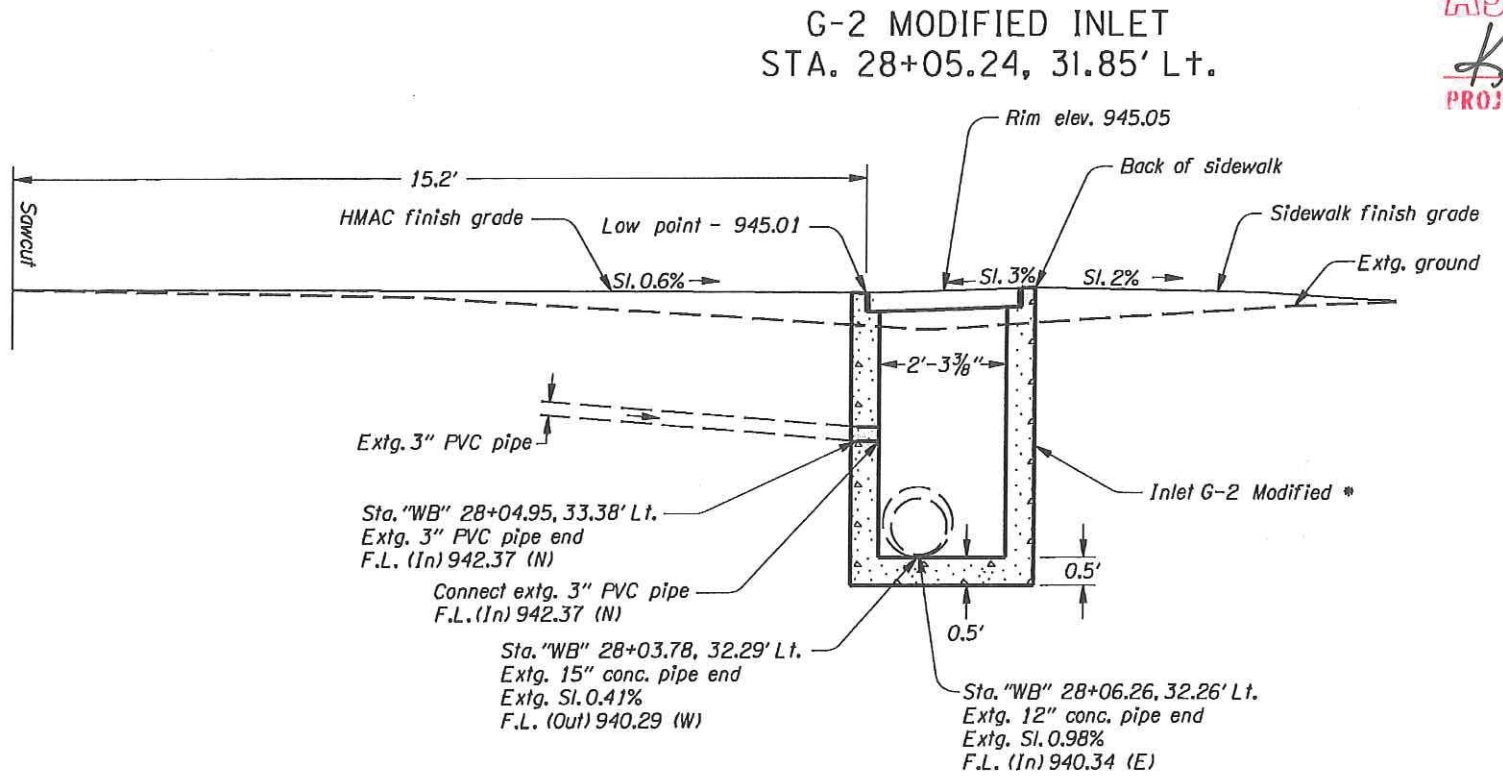

SECTION A-A

NOT REVISED  
AS CONSTRUCTED

Kelly Ste 8-19-13  
PROJECT INSPECTOR DATE


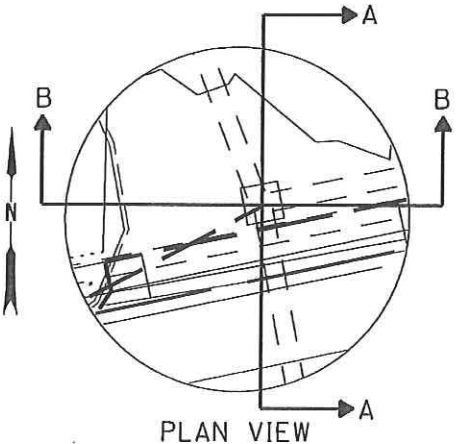


\* For details not shown, see std. drg. no. RD364 and sheets 4A & 4B



|  |                          |
|--|--------------------------|
| <b>OREGON DEPARTMENT OF TRANSPORTATION</b>   |                          |
| <b>REGION 3 - TECHNICAL CENTER</b>   |                          |
| US 199 @ JOSEPHINE COUNTY FAIRGROUNDS<br>REDWOOD HIGHWAY<br>JOSEPHINE COUNTY                 |                          |
| Designed By - Nelly Salazar Lazara<br>Reviewed By - Chris Zelmer<br>Drafted By - Judy Hardin |                          |
| <b>DETAILS</b>   | SHEET NO.<br><b>2B-6</b> |


G-2 MODIFIED INLET  
STA. "WB" 28+53.49, 34.06' Lt.  
N.T.S.

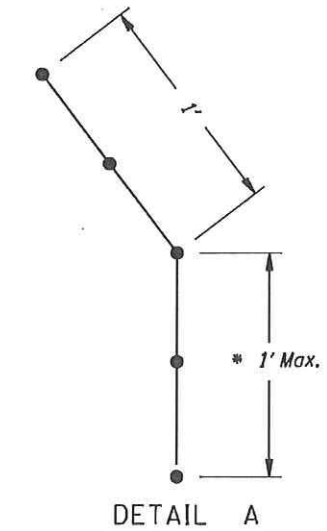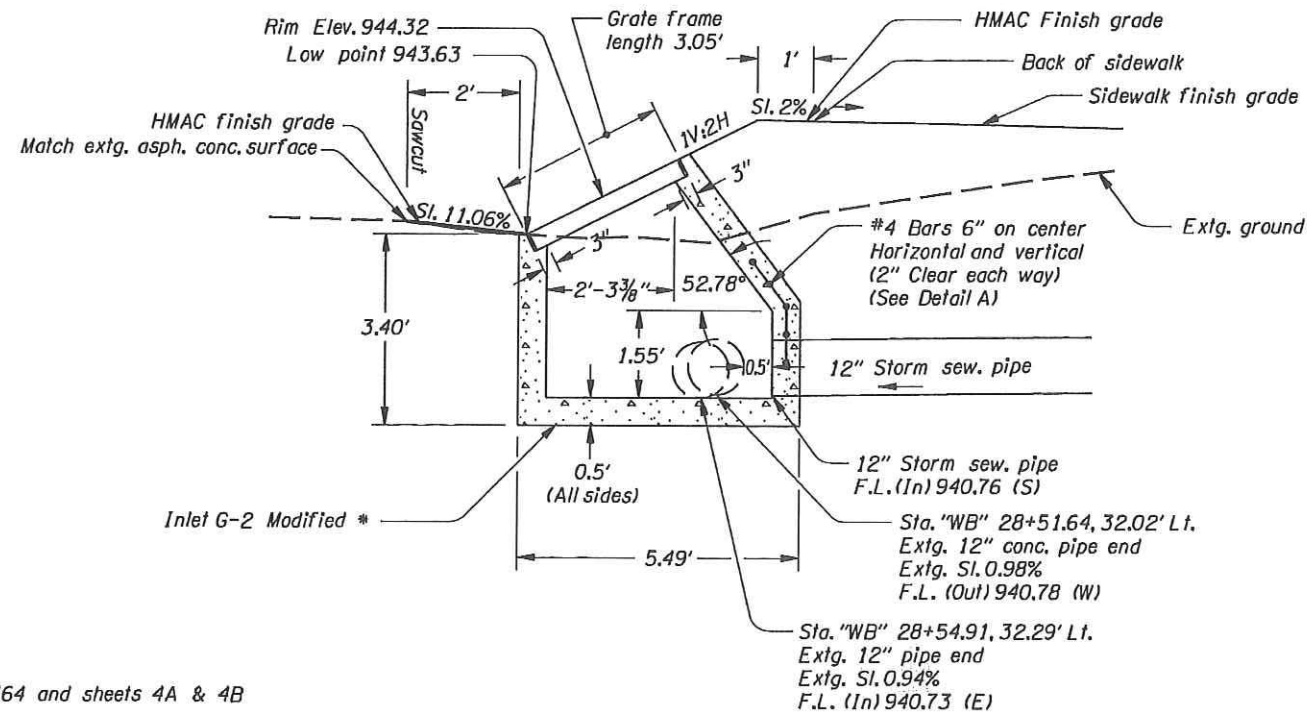

\* Adjust length of bar to stay 2" clear of incoming storm drain pipe


\* For detail, not shown, see std. drg. no. RD364 and sheets 4A & 4B

G-2 MODIFIED INLET  
STA. "WB" 31+09.85, 33.28' Lt.  
N.T.S.

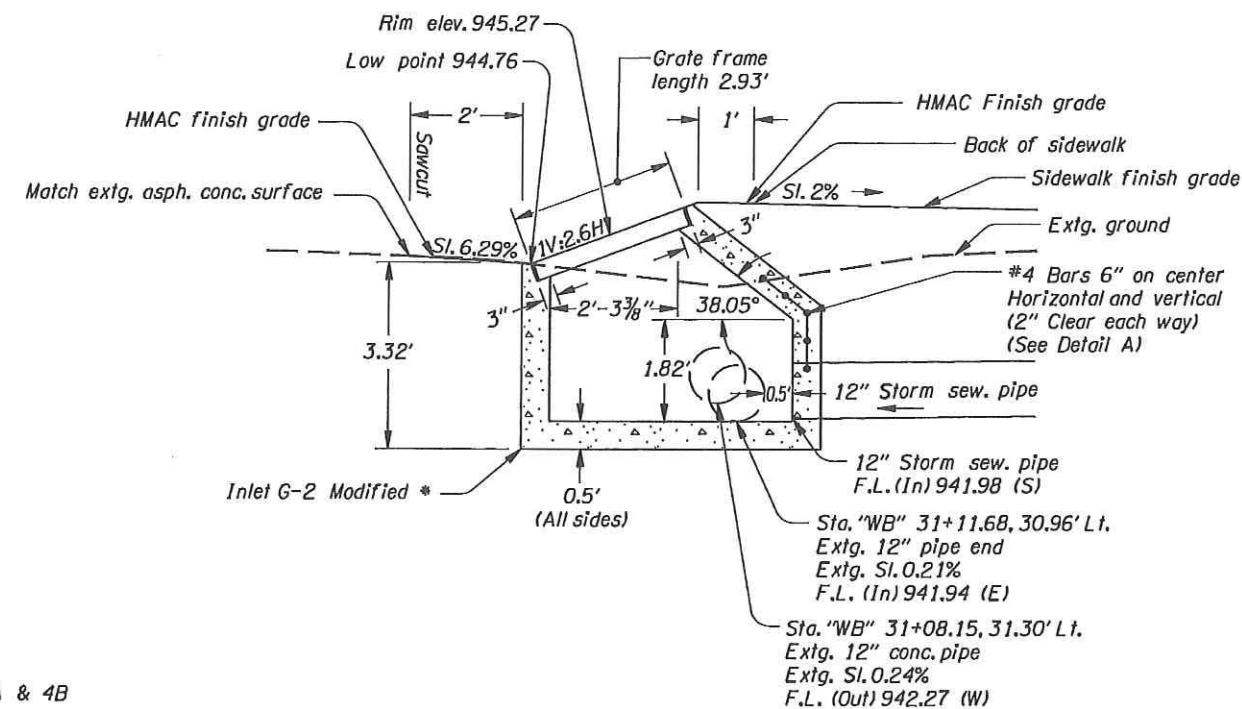

*NOT REVISED*  
**AS CONSTRUCTED**  
Kelly *SD* 8-19-13  
PROJECT INSPECTOR DATE

\* For detail, not shown, see std. drg. no. RD364 and sheets 4A & 4B

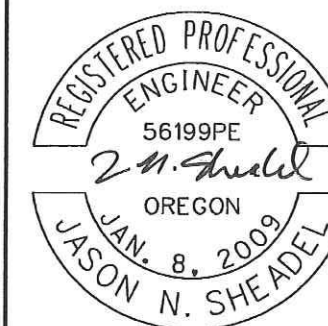


EXPIRES: JUNE 30, 2014

|  |                          |
|--|--------------------------|
| OREGON DEPARTMENT OF TRANSPORTATION  |                          |
| REGION 3 - TECHNICAL CENTER  |                          |
| US 199 @ JOSEPHINE COUNTY FAIRGROUNDS<br>REDWOOD HIGHWAY<br>JOSEPHINE COUNTY                 |                          |
| Designed By - Nelly Salazar Lazaro<br>Reviewed By - Chris Zelmer<br>Drafted By - Judy Hardin |                          |
| <b>DETAILS</b>   | SHEET NO.<br><b>2B-7</b> |



Sec. 19, T. 36S, R. 05W, W.M.

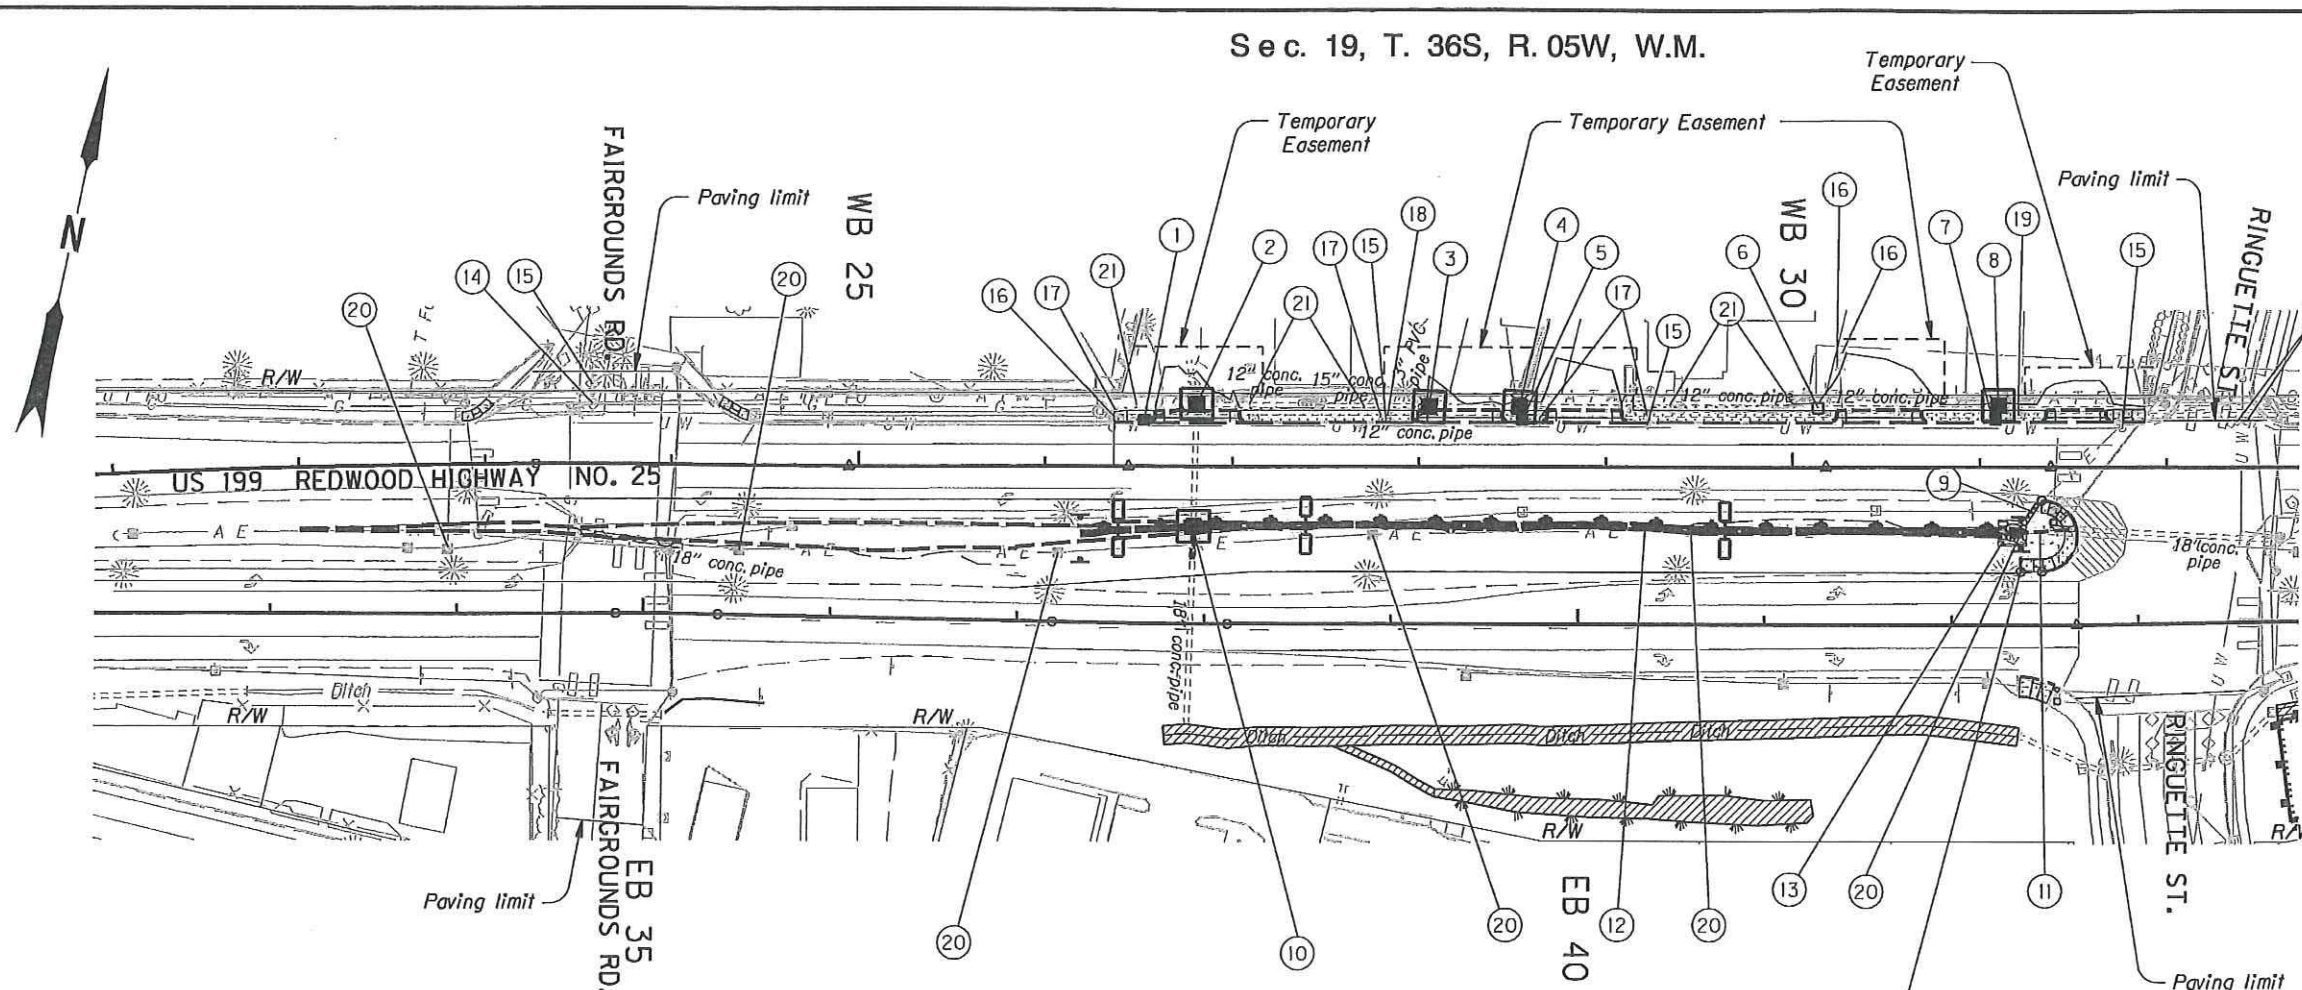

- 1 Sta. "WB" 26+52.56, 24.92' Lt.  
Const. type "CG-3" inlet (Option 1)  
Rim - 945.39  
(See std. dwg. nos. RD371 & RD372)  
**INSTALL 18" CONC. PIPE - 4'**
- 2 Sta. "WB" 26+80.45, 32.98' Lt.  
Remove extg. inlet  
Const. type "G-2MA Modified" conc. inlet  
Rim - 944.60  
Inst. 12" storm sew. pipe - **29' 30'**  
5' depth  
S=0.0600'/ft.  
I.E. (12" In)=941.54  
I.E. (12" Out)=939.80  
Connect to extg. 12" conc. pipe (N)  
Connect to extg. 18" conc. pipe (S)  
Connect to extg. 15" conc. pipe (E)  
(For details, see sht. 2B-6)  
(See std. drg. no. RD364)
- 3 Sta. "WB" 28+05.24, 31.85' Lt.  
Remove extg. inlet  
Const. type "G-2 Modified" conc. inlet  
Rim - 945.05  
Connect to extg. 15" conc. pipe (W)  
Connect to extg. 12" conc. pipe (E)  
Connect to extg. 3" PVC pipe (N)  
(For details, see sht. 2B-6)  
(See dwg. no. RD364)
- 4 Sta. "WB" 28+53.49, 34.06' Lt.  
Remove extg. inlet  
Const. type "G-2 Modified" conc. inlet  
Rim - 944.32  
Inst. 12" storm sew. pipe - 9'  
5' depth  
S=0.0100'/ft.  
I.E. (12" In)=940.82  
I.E. (12" Out)=940.73  
Connect to extg. 12" conc. pipe (W)  
Connect to extg. 12" pipe (E)  
(For details, see sht. 2B-7)  
(See dwg. no. RD364)

- 6 Sta. "WB" 30+13.54, 32.62' Lt.  
Cap extg. inlet  
(See drg. no. RD376)  
**CAPPED WITH CONCRETE AND PIPE  
SEE DETAIL, ATTACHED, "A4", NEXT PAGE**
- 7 Sta. "WB" 31+08.28, 25.67' Lt.  
Const. type "CG-3" inlet (Option 1)  
Rim - ~~946.17~~ **945.74 KS**
- 8 Sta. "WB" 31+09.85, 33.28' Lt.  
Remove extg. inlet  
Const. type "G-2 Modified" conc. inlet  
Rim - 945.27  
Inst. 12" storm sew. pipe - 8'  
5' depth  
S=0.0150'/ft.  
I.E. (12" In)=942.06  
I.E. (12" Out)=941.94  
Connect to extg. 12" conc. pipe (W)  
Connect to extg. 12" pipe (E)  
(For details, see sht. 2B-7)
- 9 Sta. "WB" 31+23.84, 27.79' Rt. to  
Sta. "WB" 31+33.05, 18.83' Rt.  
Const. stone embankment armored ditch - 0.5 cu. yd.  
(For details, see sht. 2B-5)

- 10 Sta. "WB" 26+79.27, 32.09' Rt.  
Const. type "G-2MA Modified" inlet  
Rim - 943.14  
Extend - 18" culvert pipe, 5' depth **17' (Lt.)**  
S=0.0224'/ft.  
I.E. (18" In)=941.47  
I.E. (18" Out)=941.10  
Connect to extg. 18" conc. pipe(s)  
Inst. 8" perforated drain pipe - 10'  
5' depth  
S=0.0030'/ft.  
I.E. (8" In)=941.13  
I.E. (8" Out)=941.10  
Connect to extg. 18" conc. pipe (N)  
(See dwg. nos. RD312 & RD364)  
(For details, see sht. 2B-5)
- 11 Sta. "WB" 31+51.97, 33.40' Rt. to  
Sta. "WB" 31+22.06, 34.79' Rt. **13.75'**  
Extend - 18" culvert pipe, 5' depth **30' (Lt.)**  
S=0.0000'/ft.  
Const. sloped end section, 18"  
Connect to extg. 18" conc. pipe (E)  
I.E. (18" In)=942.71  
I.E. (18" Out)=942.71  
Const. **1V:8.1H** paved end slope **1V:4H**  
(18" conc. pipe) - 76 sq. ft.
- 12 Sta. "WB" 26+18.57 to  
Sta. "WB" 31+18.93, Rt.  
Const. water quality swale, D00576  
Inst. field facility markers (Type S2) - 4  
(See std. drg. nos. TM570 & TM571)  
(For details, see shts. 2B-3 & 2B-4)

- 13 Sta. "WB" 31+10.05, 27.80' Rt. to  
Sta. "WB" 31+25.05, 27.79' Rt.  
Const. loose riprap (Class 50) - 8 cu. yd.  
Riprap geotextile type "1" - 24 sq. yd.  
(For details, see sht. 2B-5)
- 14 Adjust box (gas valve) (By others)
- 15 Adjust box - (water valve) - 6
- 16 Maintain and protect extg. water meter - 3
- 17 Adjust box - (water meter) - 4
- 18 Relocate fire hydrant (by others)
- 19 Minor adjust sewer manhole
- 20 Maintain and protect power pole
- 21 Remove and cap extg. Irrigation sprinklers & lines  
in conflict with conc. sidewalk and driveway  
construction - Est. 15 ea.

Eq. "MSW" 10+00.00=  
"WB" 31+21.88, 56.16' Rt.

- Unsupported sediment fence shown thus: [Symbol]
- Check Dam shown thus: [Symbol]
- Remove extg. inlet shown thus: [Symbol]
- NO WORK AREA shown thus: [Symbol]
- Compost Filter Berm shown thus: [Symbol]
- Riprap (Class 50) shown thus: [Symbol]
- Berm shown thus: [Symbol]
- Remove extg. pipes shown thus: [Symbol]
- Biofiltration swale shown thus: [Symbol]
- WETLAND surfacing shown thus: [Symbol]
- Construct ditch flat bottom shown thus: [Symbol]
- Inlet protection shown thus: [Symbol]

- 5 Sta. "WB" 28+55.00, 25.31' Lt.  
Const. type "CG-3" inlet (Option 1)  
Rim - ~~945.88~~ **945.58 KS**  
For temporary easement Sta./Offset, See sheet 4  
For drainage profiles, See sheet 4B

REGISTERED PROFESSIONAL  
ENGINEER  
56199PE  
*Jason N. Sheadel*  
JAN. 8, 2009  
OREGON  
JASON N. SHEADEL  
EXPIRES: JUNE 30, 2014

**OREGON DEPARTMENT OF TRANSPORTATION**

**REGION 3 - TECHNICAL CENTER**

**US 199 @ JOSEPHINE COUNTY FAIRGROUNDS**  
REDWOOD HIGHWAY  
JOSEPHINE COUNTY

Designed By - Nelly Salazar Lazaro  
Reviewed By - Chris Zelmer  
Drafted By - Judy Hardin

**DRAINAGE & UTILITIES**

SHEET NO. **4A**

**AS CONSTRUCTED**  
*Kelly*  
PROJECT INSPECTOR  
8-19-13


45V-101

"WB" LINE

36' RIGHT OF "WB" LINE

42' RIGHT OF "WB" LINE

"MSW" LINE

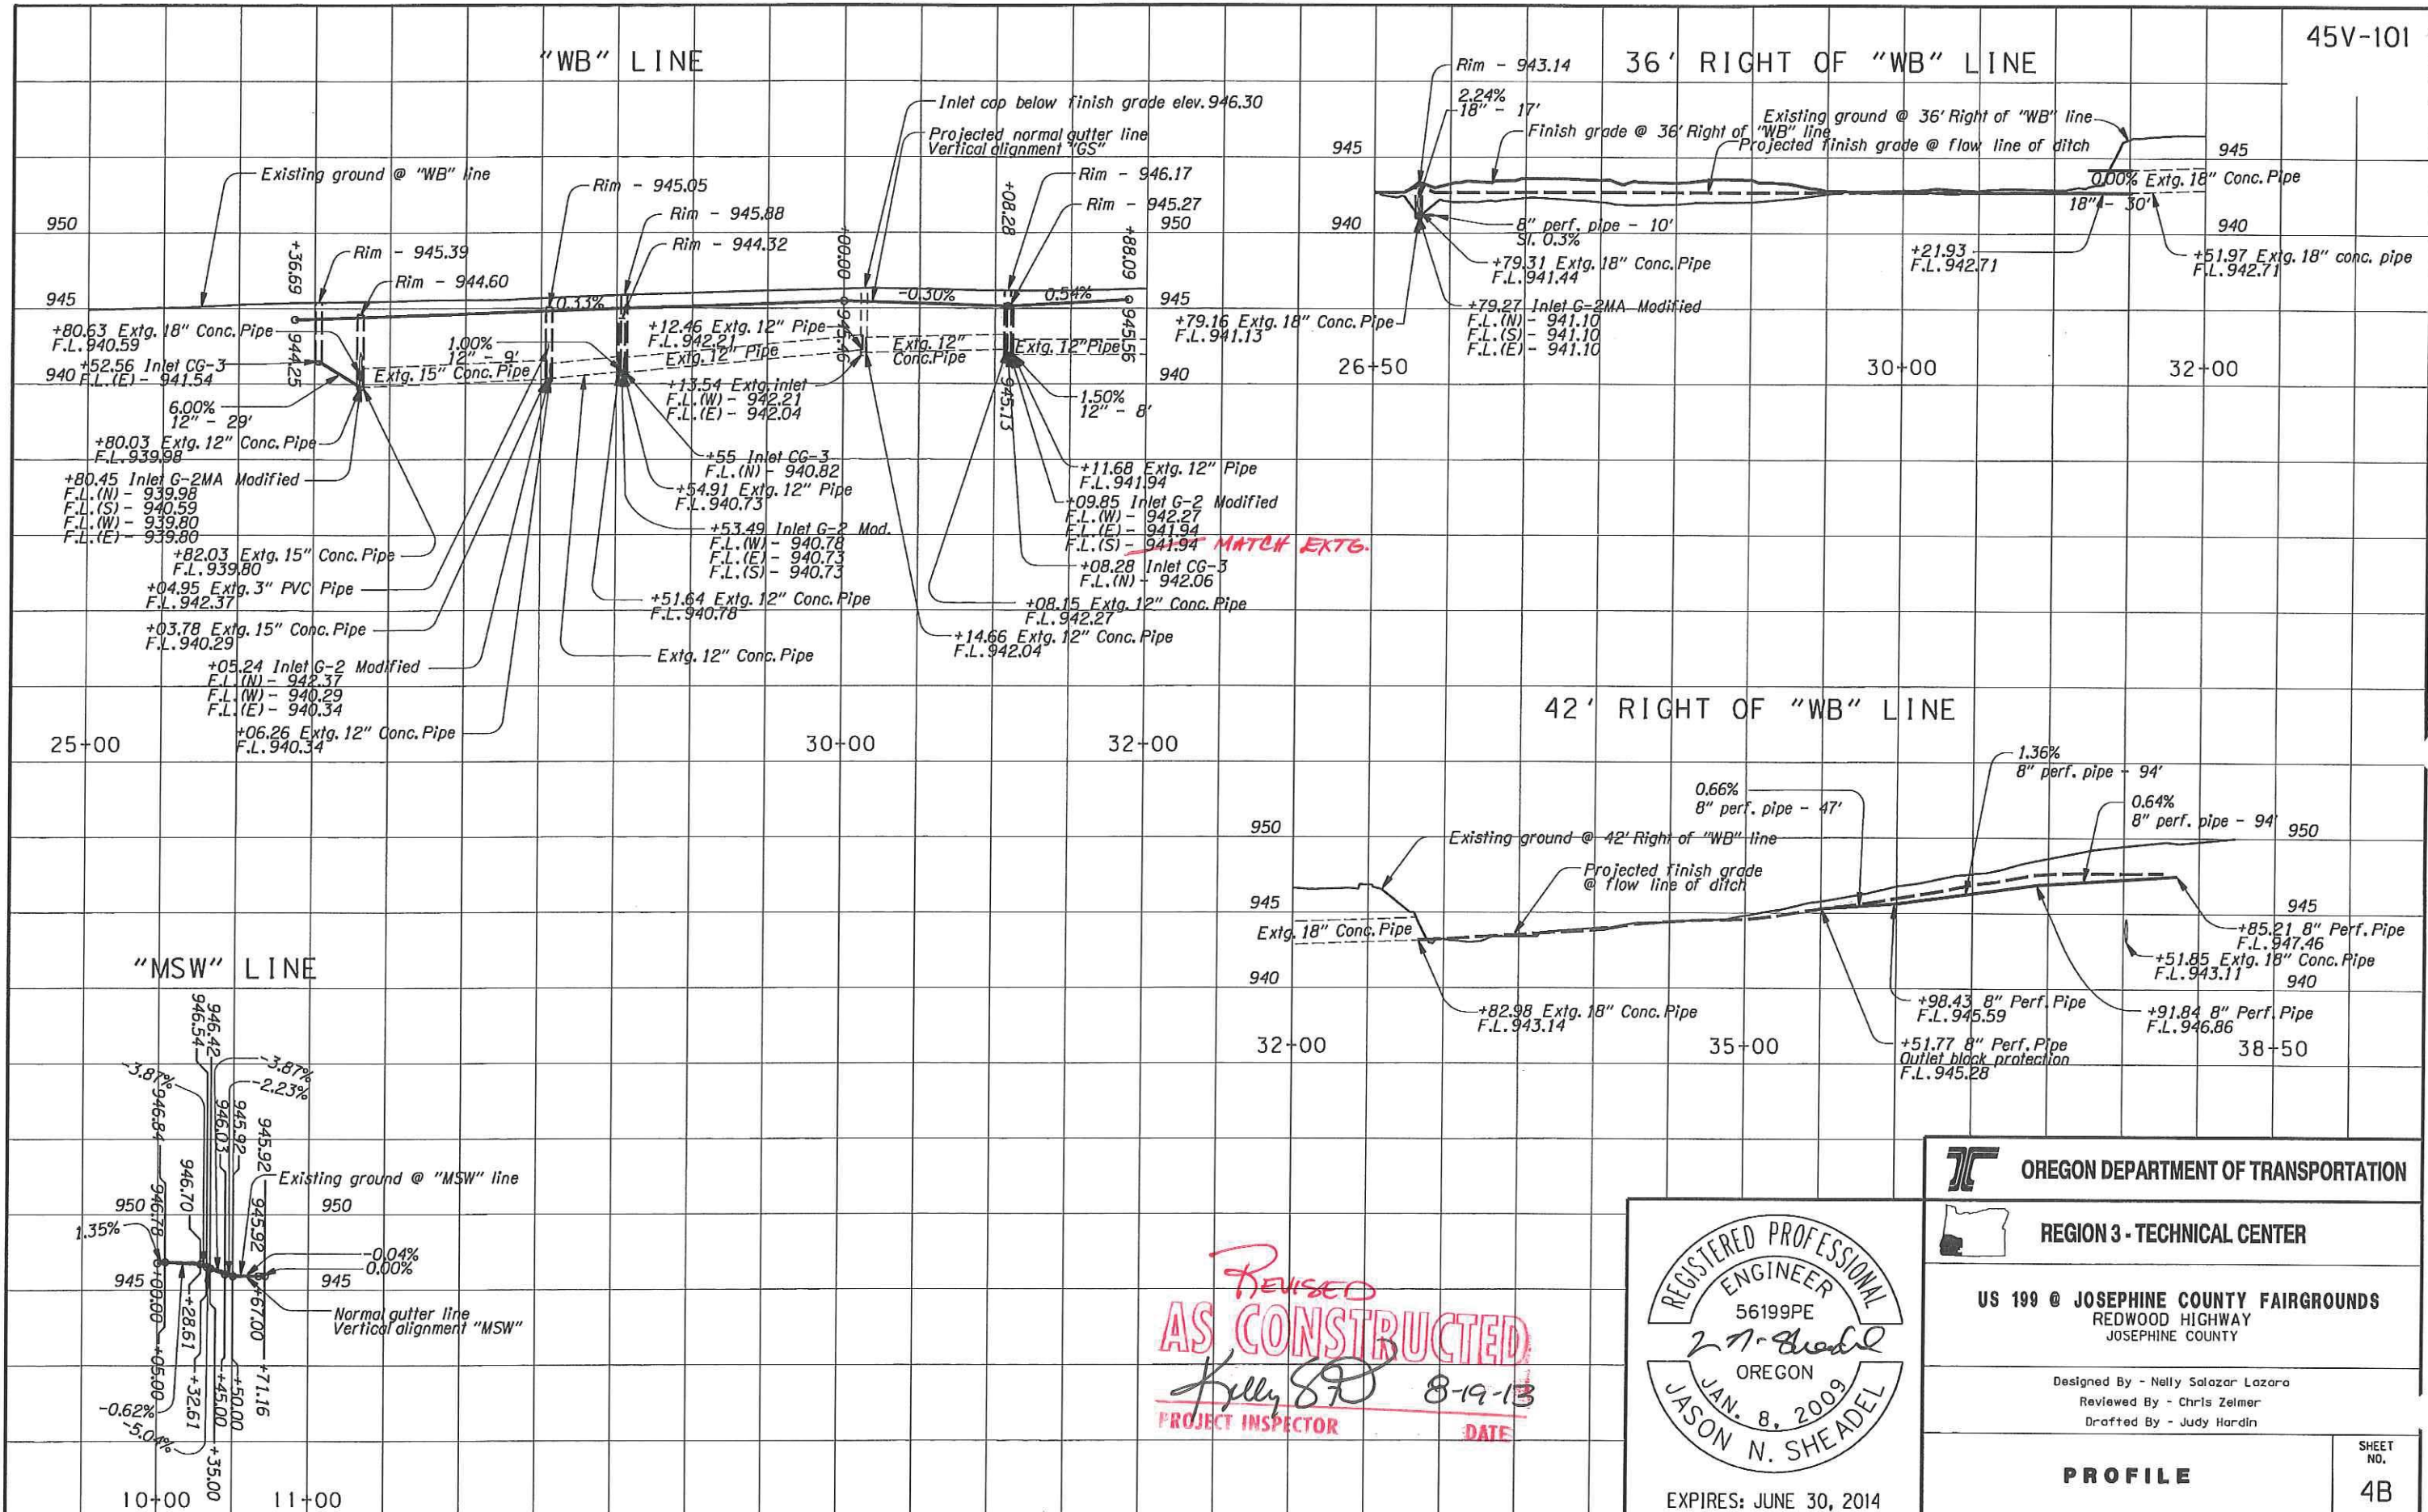

**REVISED**  
**AS CONSTRUCTED**  
 Kelly SD  
 PROJECT INSPECTOR  
 8-19-13  
 DATE



**OREGON DEPARTMENT OF TRANSPORTATION**

**REGION 3 - TECHNICAL CENTER**

US 199 @ JOSEPHINE COUNTY FAIRGROUNDS  
 REDWOOD HIGHWAY  
 JOSEPHINE COUNTY

Designed By - Nelly Salazar Lazara  
 Reviewed By - Chris Zelmer  
 Drafted By - Judy Hardin

**PROFILE** SHEET NO. **4B**