

OPERATION & MAINTENANCE MANUAL

Water Quality Biofiltration Swale

Manual prepared: October 2018

DFI No. D00579



Figure 1: DFI No. D00579, looking northeast

Identification

Drainage Facility ID (DFI): D00579
Facility Type: Water Quality Biofiltration Swale
Construction Drawings: (V-File Numbers) 45V-038
Location: District: 2B
Highway No.: 123
Mile Post: 12.56-12.59 (beginning-end;
ramp alignment AF)

1. Manual Purpose

The purpose of this manual is to outline inspection needs and summarize maintenance actions.

2. Facility Location

The location map below details the facility location. The highway, mile posts, side streets, access location, and stormwater flow directions are noted on the map.

Facility location type: Roadway shoulder

Flow direction: West




Figure 2: Facility location map

3. Facility Summary

The length and width of a swale is based on the bottom dimensions.

The bottom length and bottom width of the swale is:


Bottom Length (feet)	Bottom Width (feet)
173	4

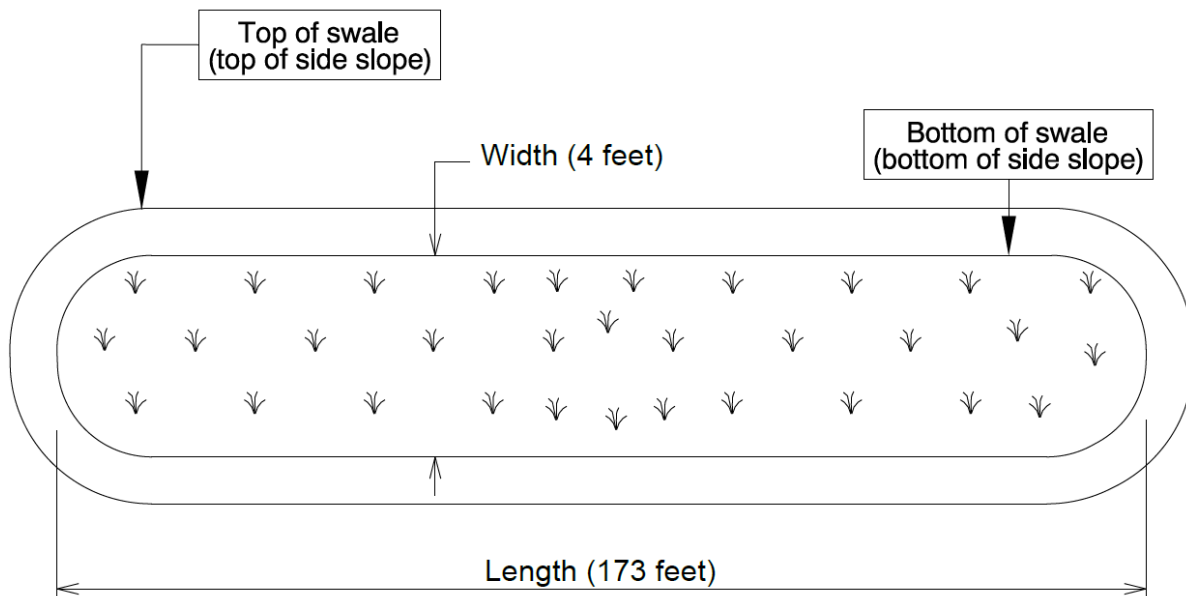

The depth of the swale is the vertical distance measured from the bottom of the swale to the top. The slope of the swale sides is presented by a vertical distance (rise) followed by the horizontal distance (run).

Depth and side slopes:

Depth (feet)	Rise (feet)	Run (feet)
1	1	2

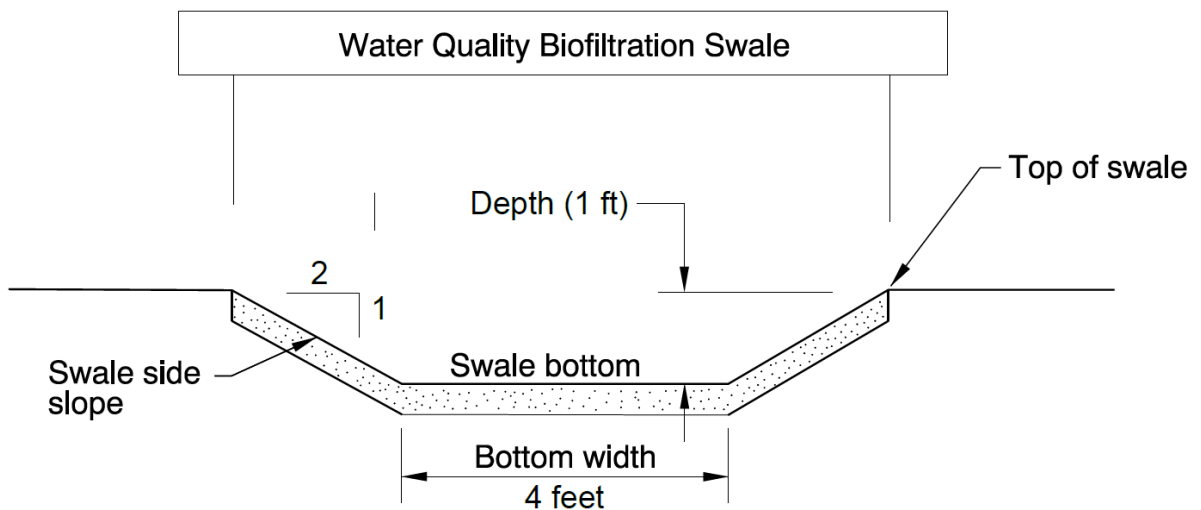

Site Specific Information: The swale is located on the north side of NE 122nd Ave Connector. There is an access point on the south side of NE Sandy Ave that allows access to the swale.

4. Facility Access

Maintenance access to the facility:

<input type="checkbox"/> Roadside pad	<input type="checkbox"/> Roadside shoulder
<input type="checkbox"/> Access road with Gate	<input checked="" type="checkbox"/> Access Pull out without Gate



Figure 3: Pull in access off of NE Sandy Blvd

5. Operational Components / Maintenance Items

Classification

This facility is classified as an:

<input checked="" type="checkbox"/> On-line Swale	<input type="checkbox"/> Off-line Swale
A swale that does not include a high flow bypass component; flow drains into and through the facility	A swale that treats low/small flows and diverts high flows using a bypass component

Bypass Component

This facility includes a high flow bypass component:

<input checked="" type="checkbox"/> No	<input type="checkbox"/> Yes
There is no bypass component. High flows drain into and through the facility	There is a bypass component. Only low/small flows drain into the swale. High flows are diverted around the swale using a bypass component

Operational Components

A swale has many components that assist with treatment, conveyance, and reducing flow velocity to minimize erosion. The components in use can vary depending if the facility was designed to operate on-line or off-line. The facility components table (**Table 1**) has been provided to highlight the applicable components for this facility. The component is in use when the box contains an “x” (e.g.).

The Standard Operation Manual for Water Quality Biofiltration Swales (implemented March 2017) outlines facility operation, typical footprint configuration, and component definitions and details. A link to the manual is attached to the feature marker in TransGIS.

<https://gis.odot.state.or.us/TransGIS/>

Operational Plan

The applicable standard operational plan for this facility is:

<input type="checkbox"/> Operational Plan A	<input checked="" type="checkbox"/> Operational Plan B	<input type="checkbox"/> Operational Plan C
An on-line swale with roadside ditches	An on-line swale with piped inlets and outlets	An off-line swale with a piped high flow bypass
A standard operational plan illustrates the general facility footprint configuration and explains the purpose of each facility component. Operational plans (A, B, C) are provided in the Standard Operation Manual.		

See Appendix A for the site specific operational plan.

Maintenance Items

Operational components marked in **Table 1** should be inspected and maintained according to Section 7. Each facility component is defined and detailed in the Standard Operation Manual using the associated ID number indicated below.

Table 1: Swale Components		ID #
Manholes/Structures		
Pre-treatment manhole	<input type="checkbox"/>	S1
Weir type flow splitter/flow splitter manhole	<input type="checkbox"/>	S2
Orifice type flow splitter/flow splitter manhole	<input type="checkbox"/>	S3
Standard manhole	<input checked="" type="checkbox"/>	S4
Swale Inlet		
Pavement sheet flow	<input type="checkbox"/>	S5
Inlet Pipe (s) (Type "D")	<input type="checkbox"/>	S6
Open channel inlet	<input checked="" type="checkbox"/>	S7
Riprap pad	<input type="checkbox"/>	S8
Ground Cover		
Grass bottom	<input checked="" type="checkbox"/>	S9
Grass side slopes	<input checked="" type="checkbox"/>	S10
Granular drain rock	<input type="checkbox"/>	S11
Plantings	<input type="checkbox"/>	S12
Underground Components		
Geotextile fabric	<input type="checkbox"/>	S13
Water quality mix	<input checked="" type="checkbox"/>	S14
Perforated pipe	<input type="checkbox"/>	S15
Porous pavers (access grid)	<input type="checkbox"/>	S16
Flow Spreader		
Rock basin (used at inlet)	<input type="checkbox"/>	S17
Anchored board (midpoint of swale or every 50 feet along swale bottom)	<input type="checkbox"/>	S18
Other: Untreated Cedar Chips	<input checked="" type="checkbox"/>	S19
Swale Outlet		
Catch basin with grate	<input type="checkbox"/>	S20
Outlet Pipe (s)	<input type="checkbox"/>	S21
Open channel outlet	<input type="checkbox"/>	S22
Auxiliary Outlet: Type "D" Inlet	<input checked="" type="checkbox"/>	S23
Outfall Type		
Waterbody (Creek/Lake/Ocean)	<input type="checkbox"/> C <input type="checkbox"/> L <input type="checkbox"/> O	S24
Ditch	<input type="checkbox"/>	S25
Storm drain system	<input checked="" type="checkbox"/>	S26
Outfall Components		
Riprap pad	<input type="checkbox"/>	S27
Riprap bank protection	<input type="checkbox"/>	S28



Figure 4: Swale and water inlet, looking northwest

6. Maintenance

Maintenance Frequency/Maintain Records

- a. Inspect annually. Preferably prior to the rainy season.
- b. Clean and maintain as necessary. Refer to Activity 125 for conditions when maintenance is needed.
- c. Keep a record of inspections, maintenance, and repairs.

Maintenance Guide/Maintenance Actions

The ODOT Routine Road Maintenance Water Quality and Habitat Guide (the *Blue Book*) outlines the standard maintenance actions for water quality facilities under Activity 125.

There are standard maintenance tables for standard ODOT designs. The maintenance tables describe the maintenance component, the defect or problem, the condition when maintenance is needed, and the recommended maintenance to correct the problem. Use the following tables to maintain ODOT swales:

- Table 1 (General Maintenance): Contains general maintenance and inspection guidelines that are applicable to all ODOT water quality facilities
- Table 3 (Maintenance of Water Quality or Biofiltration Swales): Contains maintenance information for swales

The *Blue Book* can be viewed at the following website:

http://www.oregon.gov/ODOT/Maintenance/Documents/blue_book.pdf

7. Limitations

Access grid installed:

<input checked="" type="checkbox"/> No	<input type="checkbox"/> Yes
There are no duty porous pavers installed in this swale	

Swales are designed to allow equipment access along the bottom. If an access grid is **NOT** installed, vehicles entering the swale can create depressions (tire ruts), damage vegetation, and damage structural components (e.g. flow spreaders). These conditions may result in poor treatment and drainage performance.

Equipment wheels should be kept on the tops and side slopes. Mower arms may be run along the swale bottom.

8. Waste Material Handling

Material removed from the facility is defined as waste by the Department of Environmental Quality (DEQ). Refer to the roadwaste section of the ODOT Maintenance Yard Environmental Management System (EMS) Policy and Procedures Manual for disposal options:

http://www.oregon.gov/ODOT/Maintenance/Documents/ems_manual.pdf


Contact any of the following for more detailed information about management of waste materials found on site:

ODOT Clean Water Unit	(503) 986-3008
ODOT Statewide Hazmat Coordinator	(503) 667-7442
ODOT Region 1 Hazmat Coordinator	(503) 731-8290
ODOT Region 2 Hazmat Coordinator	(503) 986-2647
ODOT Region 3 Hazmat Coordinator	(541) 957-3594
ODOT Region 4 Hazmat Coordinator	(541) 388-6186
ODOT Region 5 Hazmat Coordinator	(541) 963-1590
ODEQ Northwest Region Office	(503) 229-5263







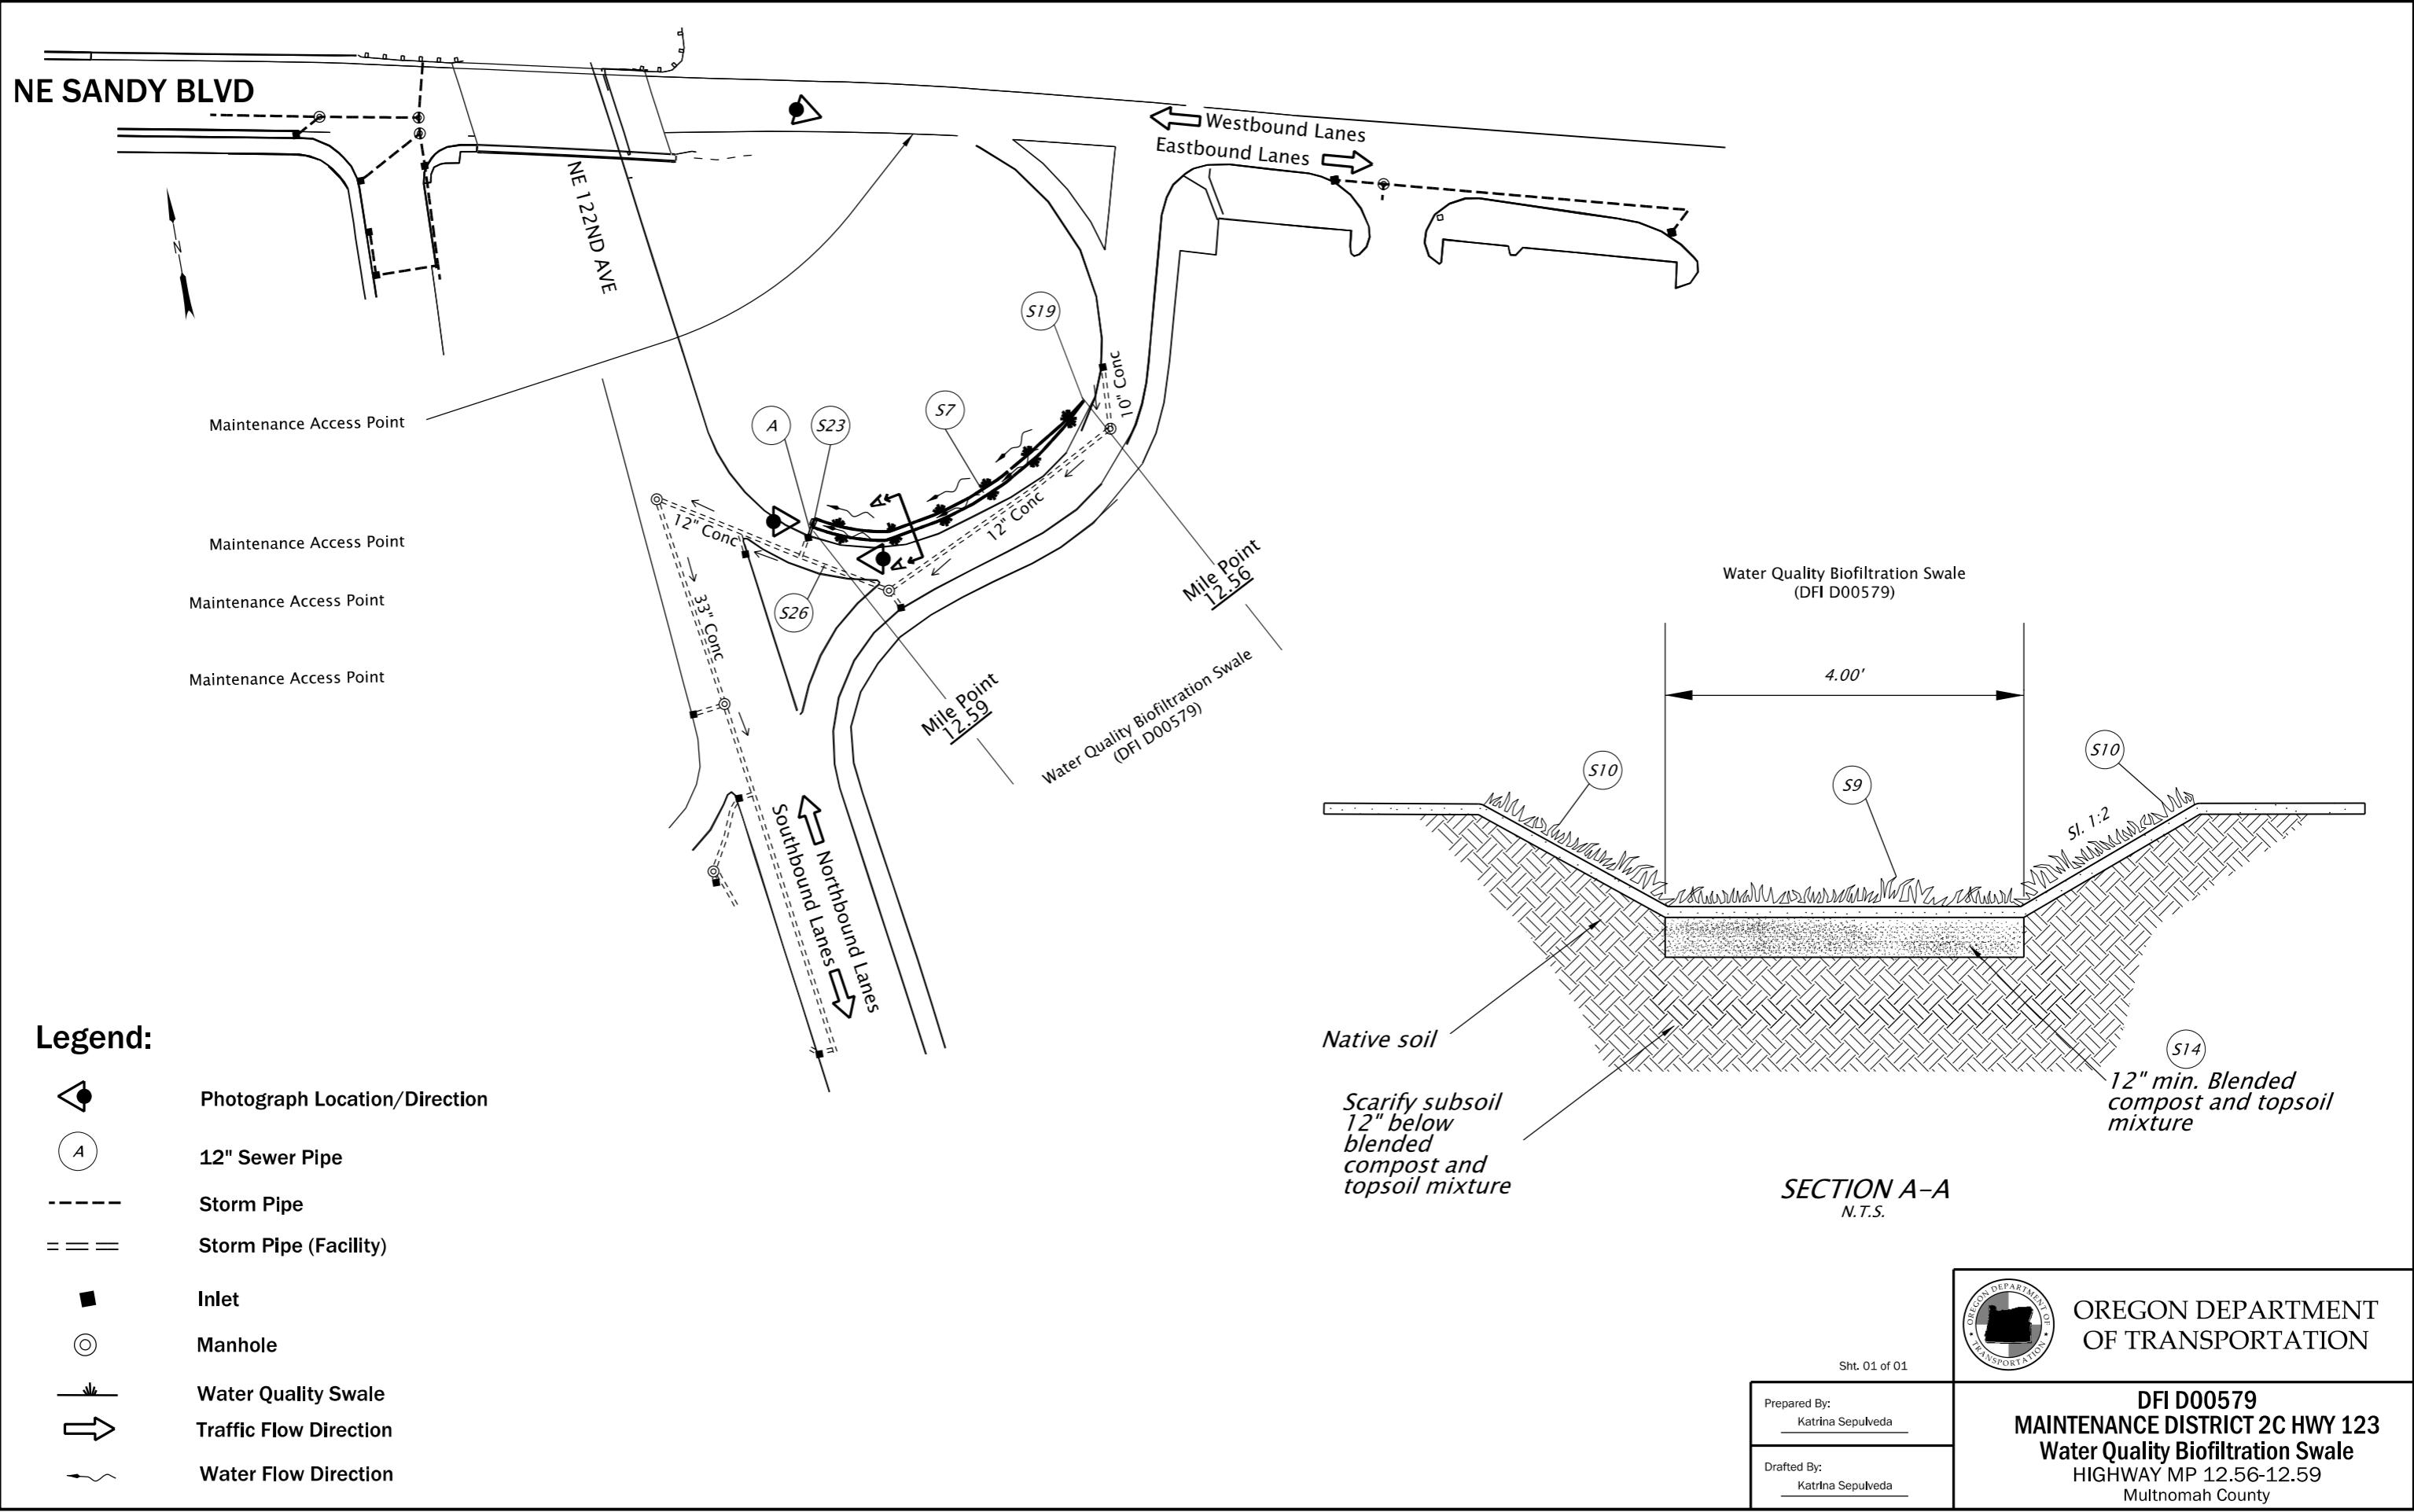


A Appendix A – Site Specific Operational Plan


Contents:

Operational Plan: DFI D00579

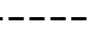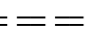

Legend:

-  Photograph Location/Direction
-  12" Sewer Pipe
-  Storm Pipe
-  Storm Pipe (Facility)
-  Inlet
-  Manhole
-  Water Quality Swale
-  Traffic Flow Direction
-  Water Flow Direction

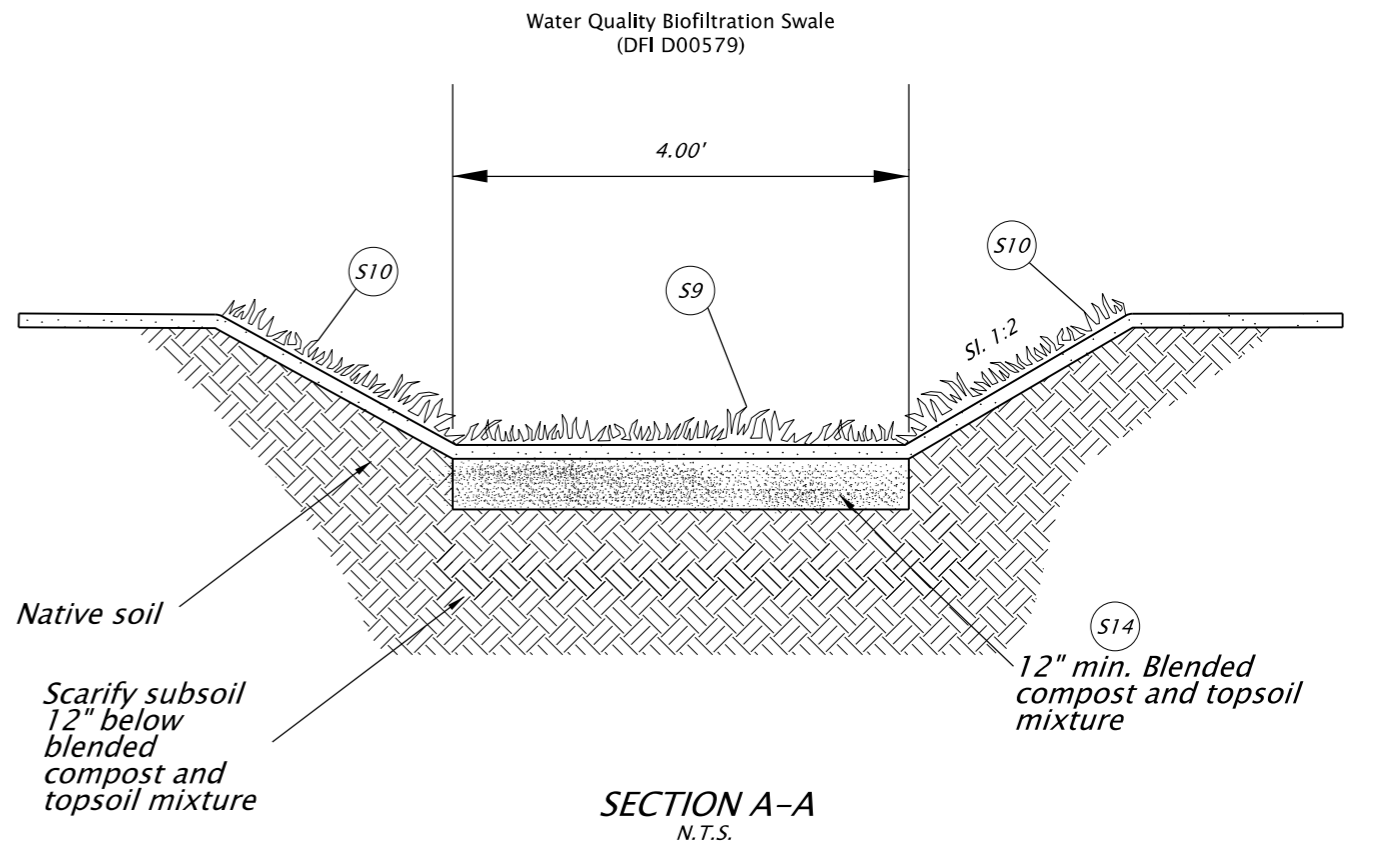

Sht. 01 of 01		<p>DFI D00579 MAINTENANCE DISTRICT 2C HWY 123 Water Quality Biofiltration Swale HIGHWAY MP 12.56-12.59 Multnomah County</p>
Prepared By:	Katrina Sepulveda	
Drafted By:	Katrina Sepulveda	

B Appendix B – Project Contract Plans

Contents:

Site Specific Subset of Project Contract Plan 45V-038

INDEX OF SHEETS	
SHEET NO.	DESCRIPTION
1	Title Sheet
1A	Index Of Sheets Cont'd. & Std. Drg. Nos.

STATE OF OREGON
DEPARTMENT OF TRANSPORTATION

PLANS FOR PROPOSED PROJECT

GRADING, DRAINAGE, PAVING, PAVEMENT MARKERS, SIGNING,
SIGNALS & ROADSIDE DEVELOPMENT

US 30 BYPASS: NE 122ND - M.P. 13.54 SEC.

NORTHEAST PORTLAND HIGHWAY


BEGINNING OF PROJECT &
CONTRACT PROJECT
HSIP-STP-S123(016)

STA. "RW" 112+79.00 (M.P. 12.45)

MULTNOMAH COUNTY
MAY 2012

END OF CONTRACT PROJECT
HSIP-STP-S123(016)

STA. "RW" 177+93.00 (M.P. 13.68)

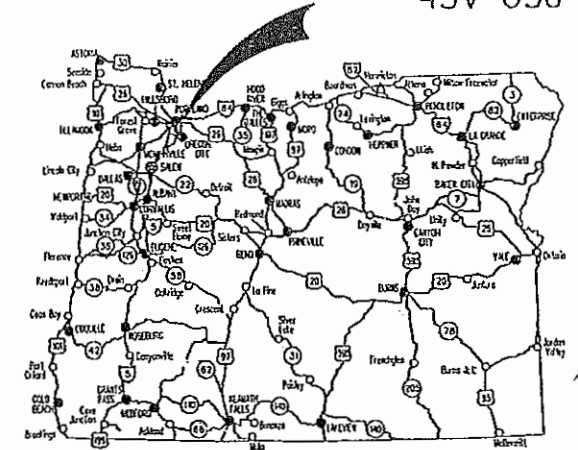

Overall Length Of Project - 1.09 Miles

ATTENTION:
Oregon Law Requires You To Follow Rules Adopted By The Oregon Utility Notification Center. Those Rules Are Set Forth In OAR 952-001-0010 Through OAR 952-001-0090. You May Obtain Copies Of The Rules By Calling The Center. (Note: The Telephone Number For The Oregon Utility Center Is (503) 232-1987.)



OREGON TRANSPORTATION COMMISSION
Pat Egan CHAIR
Mary F. Olson COMMISSIONER
David Lohman COMMISSIONER
Mark Frohnmayer COMMISSIONER
Tommy Boney COMMISSIONER
Matthew L. Garrett DIRECTOR OF TRANSPORTATION


These plans were developed using ODOT design standards. Exceptions to these standards, if any, have been submitted and approved by the ODOT Chief Engineer or their delegated authority.

Approving Authority: *Naveen G. Chandra*
Naveen G. Chandra, P.E.
Project Delivery Manager, Region 1

J.M. Hill
Concurrence by ODOT Chief Engineer

US 30 BYPASS: NE 122ND - M.P. 13.54 SEC.
NORTHEAST PORTLAND HIGHWAY
MULTNOMAH COUNTY

FEDERAL HIGHWAY ADMINISTRATION	PROJECT NUMBER	SHEET NO.
OREGON DIVISION	HSIP-STP-S123(016)	1

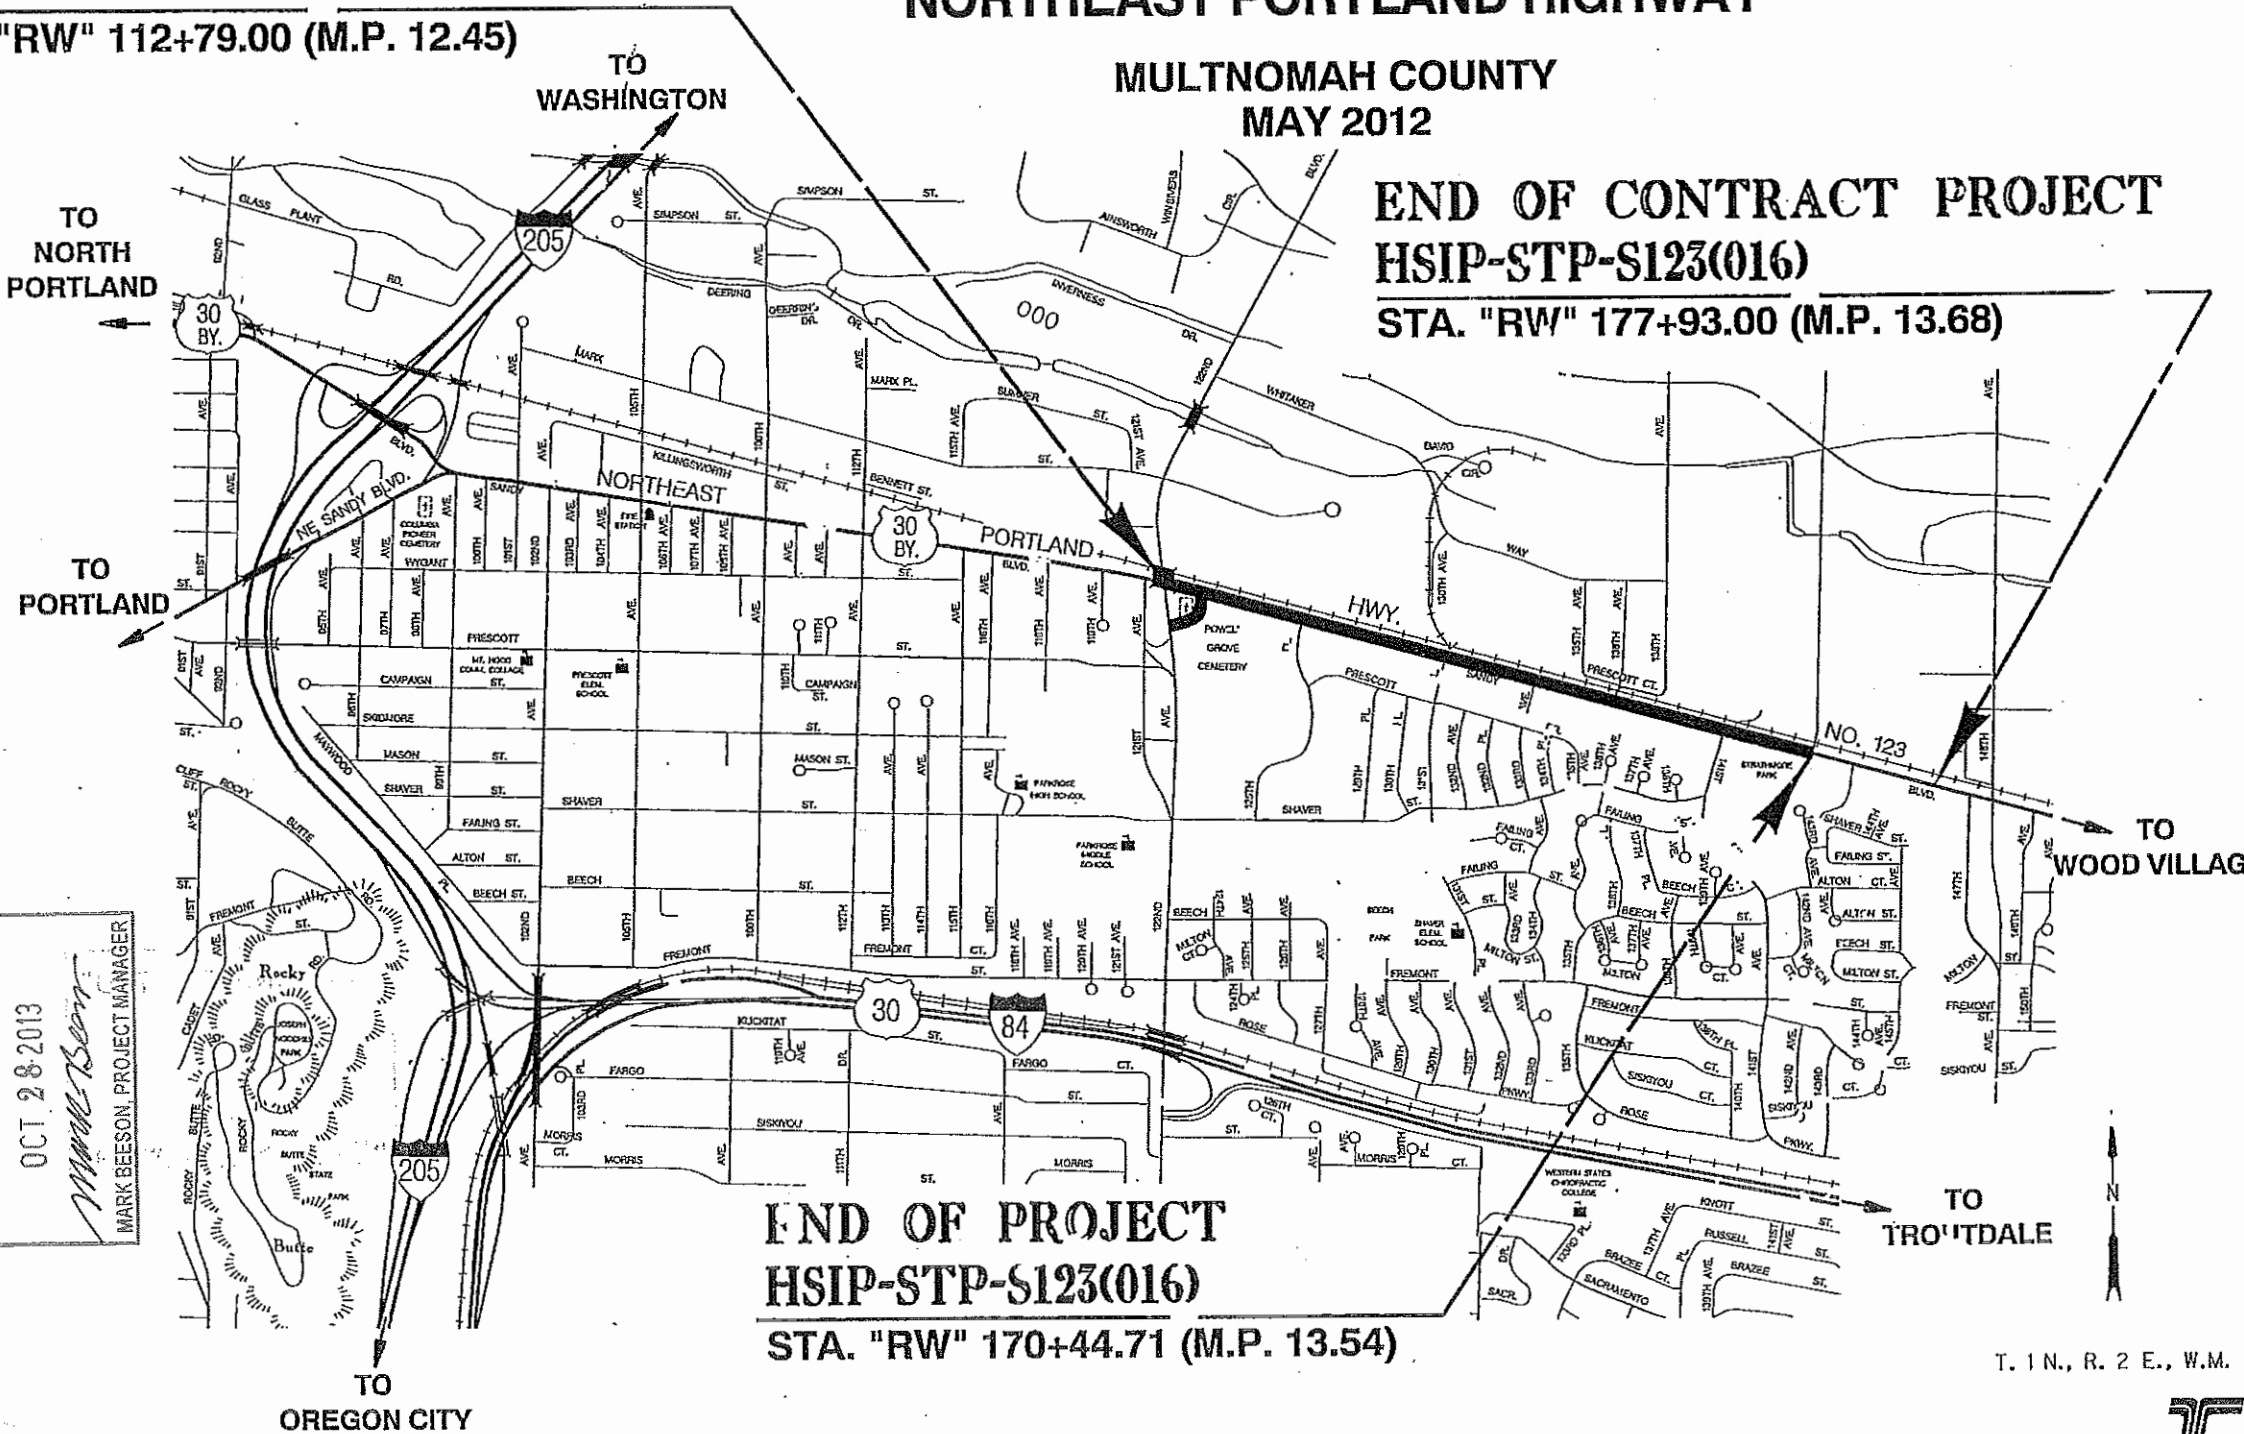

"AS CONSTRUCTED"
OCT 28 2013
Mark Beeson
MARK BEESON, PROJECT MANAGER

END OF PROJECT
HSIP-STP-S123(016)
STA. "RW" 170+44.71 (M.P. 13.54)

T. 1 N., R. 2 E., W.M.



INDEX OF SHEETS, CONT'D.	
SHEET NO.	DESCRIPTION
2, 2A, 2A-2 thru 2A-5	Typical Sections
2B, 2B-2 thru 2B-8	Details
2C, 2C-2 Thru 2C-5	Traffic Control Plans
2D	Pipe Data Sheet
3	General Construction
3A & 3A-2	Drainage & Utilities
3B	Profile
4	General Construction
4A & 4A-2	Drainage & Utilities
4B	Profile
5	General Construction
5A & 5A-2	Drainage & Utilities
5B	Profile
6	General Construction
6A & 6A-2	Drainage & Utilities
7	General Construction
7A & 7A-2	Drainage & Utilities
7B	Profile
8	General Construction
8A	Drainage & Utilities
GEO/HYDRO	
GA, GA-2 Thru GA-10	Erosion Control
GB & GB-2	Geotechnical Data
GM	Mandatory Disposal Site
ROADSIDE DEVELOPMENT	
GN, GN-2 & GN-3	Details
GN-4 Thru GN-8	Roadside Development Plans
PERMANENT PAVEMENT MARKINGS	
ST, ST-2 Thru ST-5 Incl.	Striping Plans
PERMANENT SIGNING	
S-13094 Thru S-13104	Permanent Signing


INDEX OF SHEETS, CONT'D.	
SHEET NO.	DESCRIPTION
TRAFFIC SIGNALS	
16463	Legend
16464	Removal Plan
16465	Signal Plan
16466	Detector Plan
16467	Existing Utilities
16468	Removal Plan
16469	Signal Plan
16470	Detector Plan
16471	Existing Utilities
16472	Interconnect Plan
16473	Flashing Beacon Plan
16474	Existing Utilities
16475	Details
16476	Details
16494	Details
16495	Details

Standard Drg. Nos.

- RD140 - Roadway Cross Slopes Superelevated Sections
- RD150 - Slope Rounding
- RD300 - Trench Backfill, Bedding, Pipe Zone And Mult. Installations
- RD302 - Street Cut
- RD312 - Subsurface Drain
- RD336, RD338, RD342 - Manholes
- RD344, RD346 - Manhole Cover & Frames
- RD356 - Manhole Frame Adjustment
- RD360 - Sanitary Cleanout
- RD362 - Concrete Inlets
- RD370 - Pipe Fill Height Tables
- RD380, RD386, RD388 - Stormwater Treatment and Storage Facility Field Markers
- RD390
- RD399
- RD400, RD405, RD410, RD415, RD420, RD425, RD430, RD435, RD440, RD445, RD450, RD470 - Guardrail
- RD610 - Asphalt Pavement Details
- RD700, RD701 - Curbs
- RD705 - Islands
- RD710 - Accessible Route Islands
- RD715 - Approaches And Non-Sidewalk Driveways
- RD720 - Sidewalks
- RD725 - Separated Sidewalk Driveways or Alleys
- RD735 - Curb Line Sidewalk Driveways or Alleys
- RD755 - Sidewalk Ramp Details
- RD759 - Truncated Dome Detectable Warning Surface Details And Locations


- RD1000 - Construction Entrances
- RD1015 - Inlet Protection
- RD1040 - Sediment Fence
- BR270 - Rail Transition From Flex Beam Rail To Curb & Parapet Rail
- TM204 - Details
- TM211 - Sign Bracing Detail
- TM457 - Vehicle, Ped. Signal & Push Button Mounting Details
- TM458 - Pedestrian Ramp Placement Details
- TM462 - Adjustable Signal Head Mounting Details
- TM465 - Overhead Sign, Fire Preemption & Photoelectronic Details
- TM500, TM501, TM503 - Pavement Marking Standard Details
- TM505 - Rail Crossing Pavement Markings
- TM520, TM521 - Durable Pavement Markings
- TM525 - Turn Arrow Marking Details
- TM530 - Intersection Pavement Markings
- TM539 - Median And Left Turn Channelization Details
- TM560, TM561 - Alignment Layout
- TM570 - Traffic Delineators
- TM571 - Traffic Delineators Steel Post Details
- TM576 - Traffic Delineator Installation
- TM670 - Wood Post Sign Supports
- TM671 - 3 Second Gust Wind Speed Isotach
- TM677 - Sign Mounts
- TM681, TM687, TM688 - Square Tube Sign Supports
- TM800 - Tables, Abrupt Edge And PCMS Details
- TM810 - Temporary Reflective Pavement Markers
- TM820 - Temporary Barricades
- TM821 - Temporary Sign Supports
- TM840, TM841, TM842 - Closure Details
- TM844 - Temporary Pedestrian Access Routing
- TM850 - 2-Lane, 2 Way Roadways
- TM851 - Non-Freeway Multi-Lane Sections

R/W Map No. 11B-05-0025

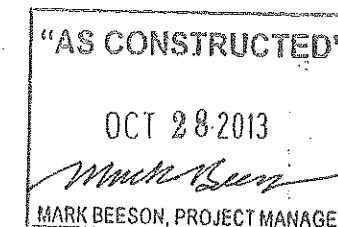


US 30 BYPASS: NE 122ND - M.P. 13.54 SEC. NORTHEAST PORTLAND HIGHWAY MULTNOMAH COUNTY		
FEDERAL HIGHWAY ADMINISTRATION	PROJECT NUMBER	SHEET NO.
OREGON DIVISION	HSIP-STP-S123(016)	1A


Standard Drawings located on the web at:
http://www.oregon.gov/ODOT/HWY/ENGSERVICES/standard_drawings_home.shtml

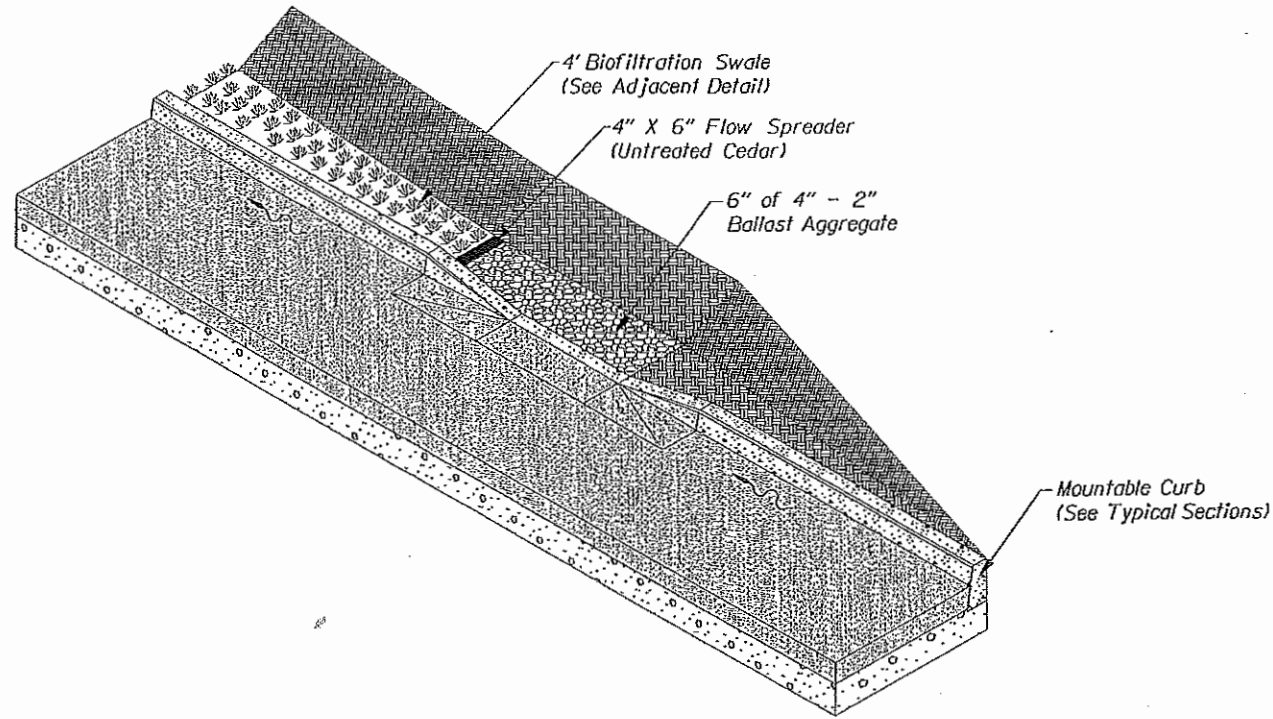


CURB CUT INLET FOR BIOFILTRATION SWALE
Isometric View
Not to scale

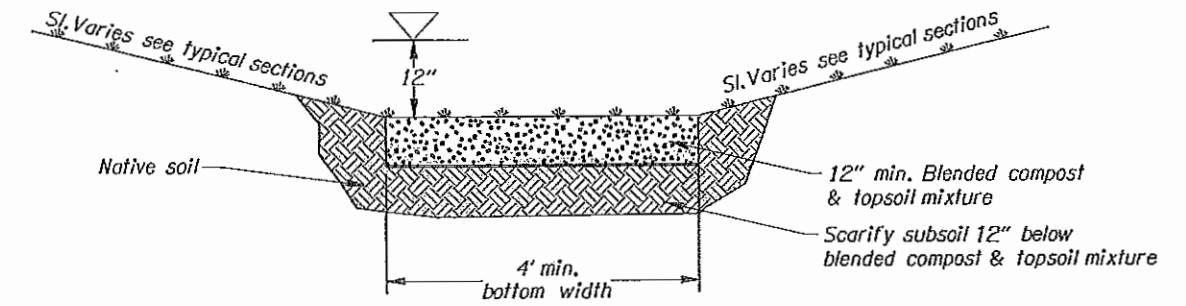

4' BIOFILTRATION SWALE
Not to scale

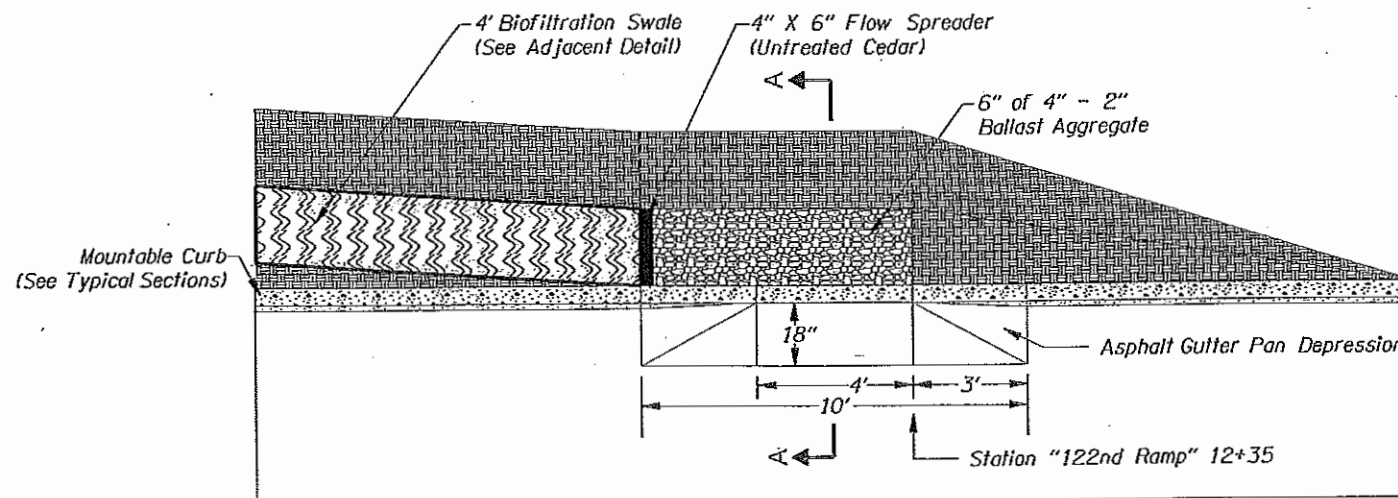

CURB CUT INLET FOR BIOFILTRATION SWALE
Top View
Not to scale

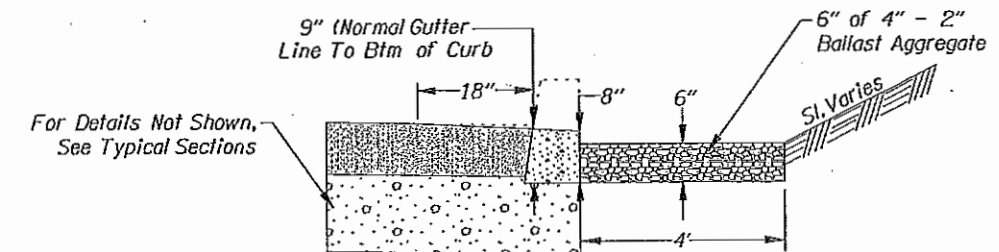

SECTION A-A
Top View
Not to scale

"AS CONSTRUCTED"

OCT 28 2013


MARK BEESON, PROJECT MANAGER

REGISTERED PROFESSIONAL ENGINEER
74492PE
JERED W. CARPENTER
JAN. 13, 2009
OREGON
EXPIRES: 12-31-2013

OREGON DEPARTMENT OF TRANSPORTATION	
REGION 1 - GEO/HYDRO/HAZMAT UNIT	
US 30 BYPASS: NE 122ND - M.P. 13.54 SEC. NORTHEAST PORTLAND HIGHWAY MULTNOMAH COUNTY	
Reviewed By - Ed Foltyn Designed By - Jered Carpenter Drafted By - Billy Shofer	
DETAILS	SHEET NO. 2B-8

T. 1 N., R. 2 E., W.M.

BEGINNING OF PROJECT
STA. "RW" 112+77.29 (M.P. 12.45)

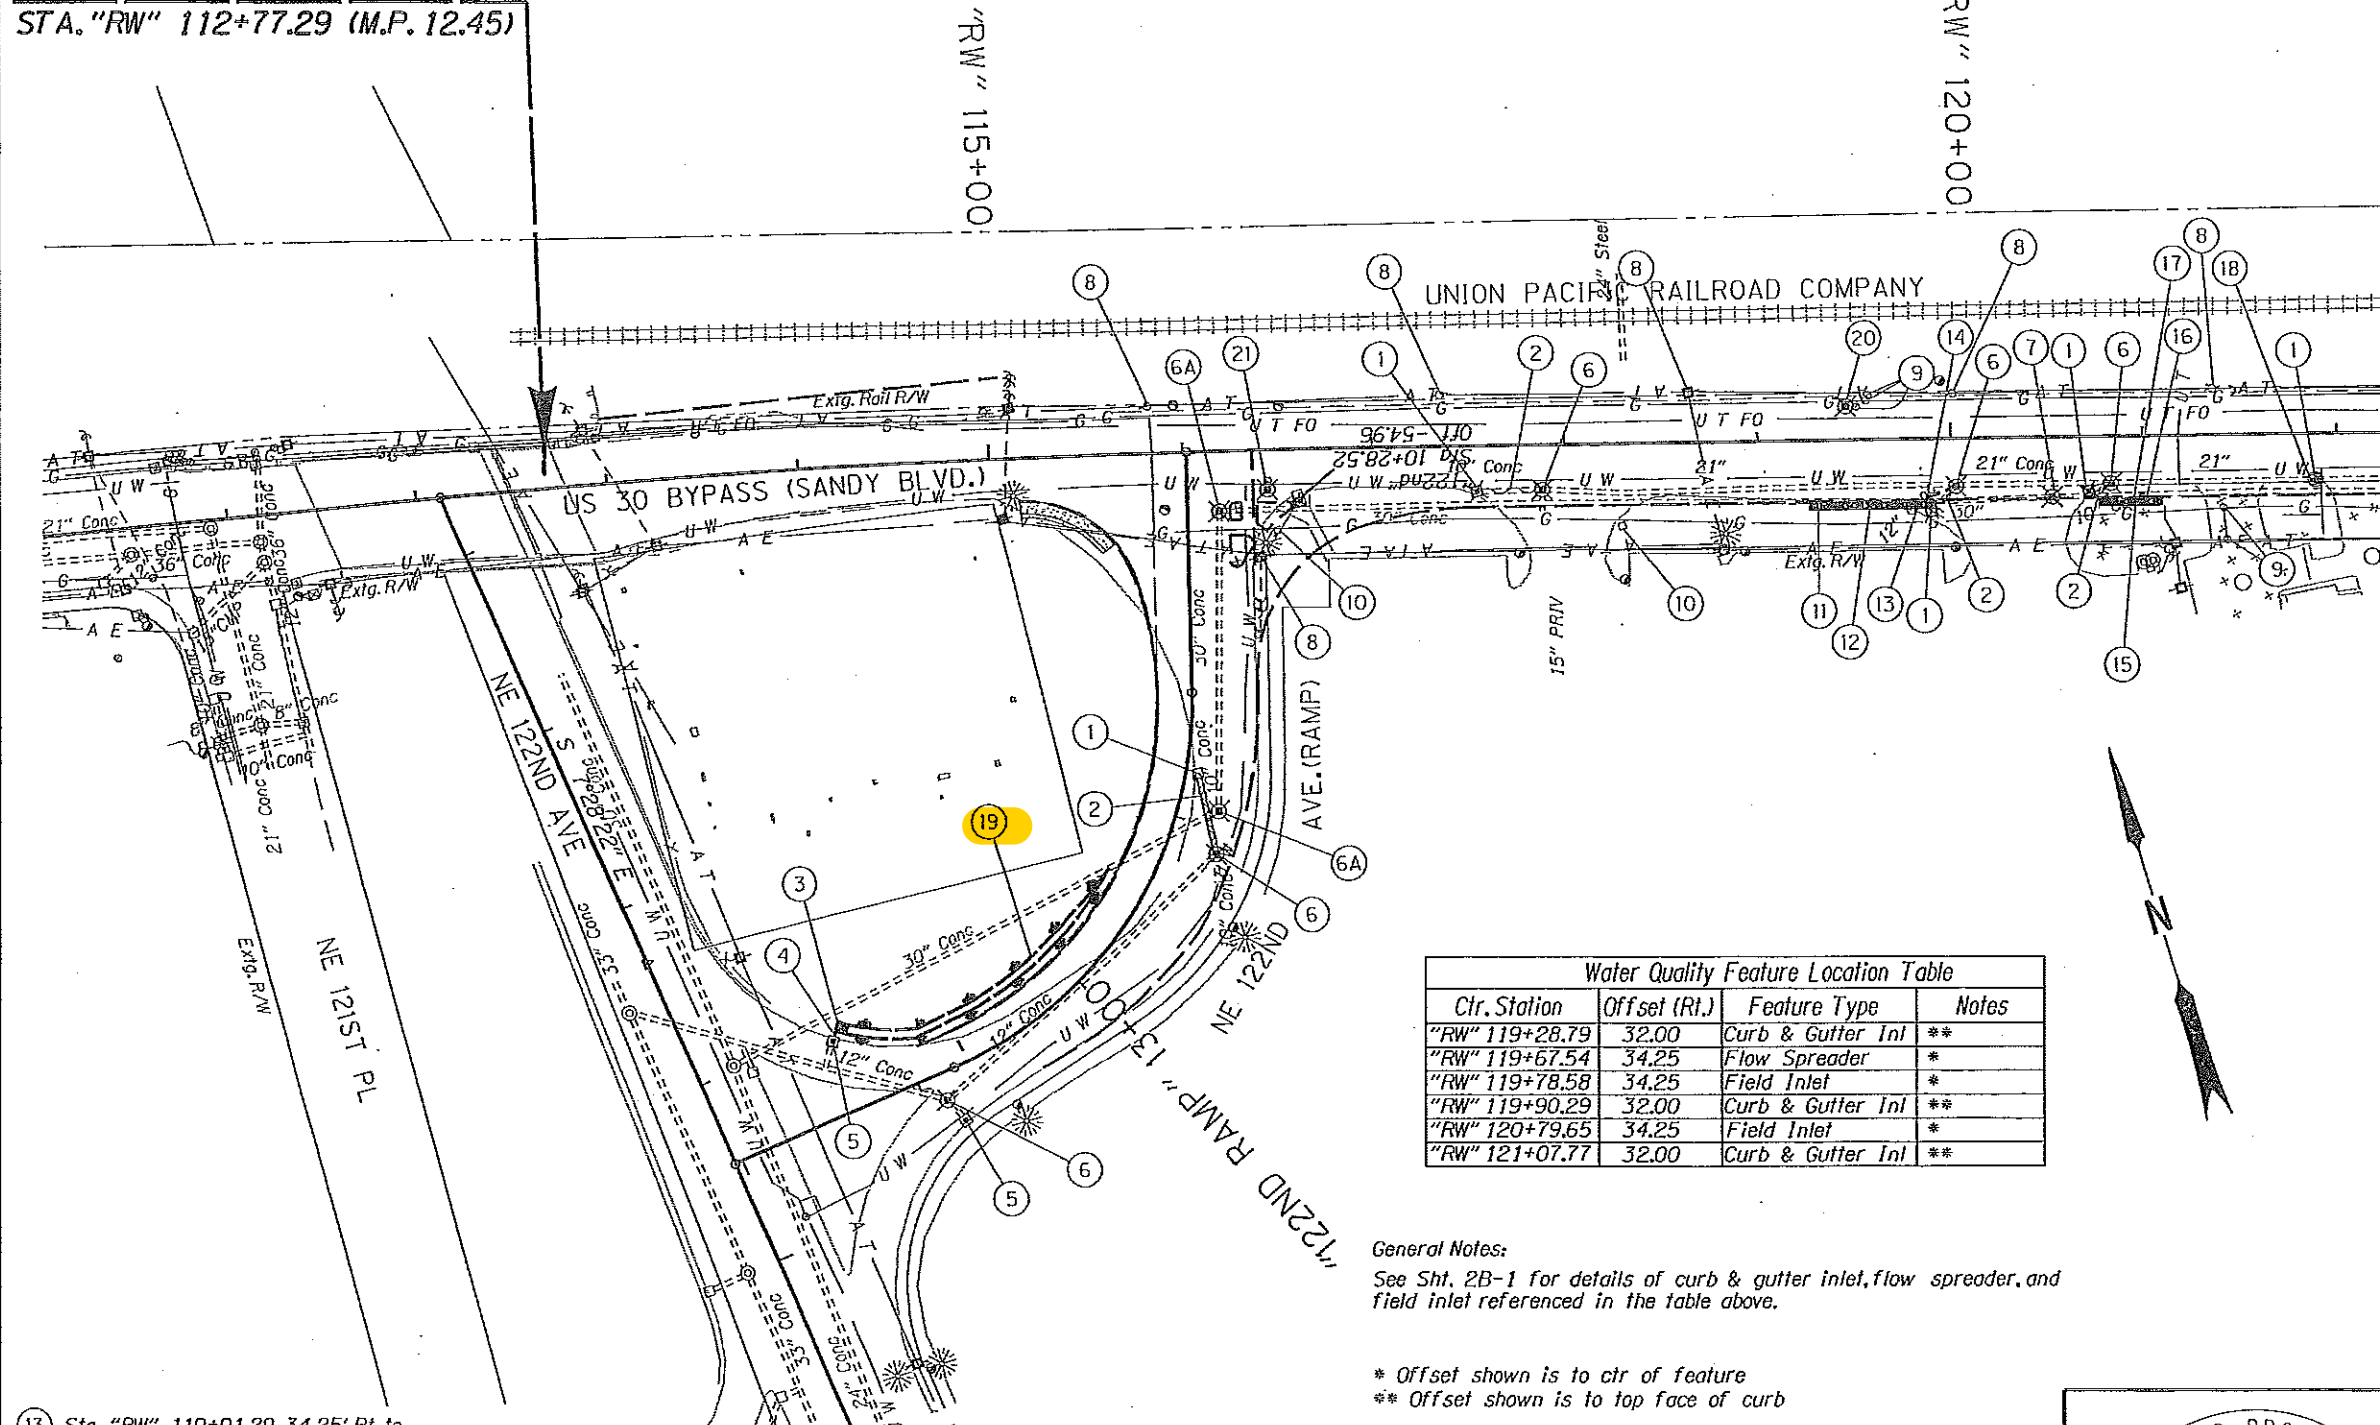

- ① Remove Inlet - 5
- ② Abandon pipe - 108'
- ③ Sta. "122nd" 14+26.48, 43.86' Rt. Const. Type "D" inlet (See dwg. no. RD370)
- ④ Sta. "122nd Ramp" 14+26.48, 43.86' Rt. to Sta. "122nd Ramp" 14+31.57, 37.68' Rt. Inst. 12" sewer pipe - 8" Ø, 10' depth Connect to extg. inlet
- ⑤ Adjust inlet - 2
- ⑥ Minor adjust manhole - 5 (See dwg. no. RD360)
- ⑥A Minor adjust manhole - 2 (By others)
- ⑦ Relocate sanitary manhole (By others)
- ⑧ Relocate utility poles - 6 (By others)
- ⑨ Adjust gas valve box - 5
- ⑩ Relocate riser - 2 (By others)
- ⑪ Sta. "RW" 119+27.29 to Sta. "RW" 119+91.79 Const. water quality planter strip - 28.7 sq. yds. (Drainage facility ID# D00580) (For details, see shts. 2B & 2B-2)
- ⑫ Sta. "RW" 119+27.80, 34.00' Rt. to Sta. "RW" 119+78.58, 34.25' Rt. Inst. 6" drain pipe - 51' 5' depth (For details see shts. 2B & 2B-2)

Clr. Station	Offset (Rt.)	Feature Type	Notes
"RW" 119+28.79	32.00	Curb & Gutter Inl	**
"RW" 119+67.54	34.25	Flow Spreader	*
"RW" 119+78.58	34.25	Field Inlet	*
"RW" 119+90.29	32.00	Curb & Gutter Inl	**
"RW" 120+79.65	34.25	Field Inlet	*
"RW" 121+07.77	32.00	Curb & Gutter Inl	**

General Notes:
See Sht. 2B-1 for details of curb & gutter inlet, flow spreader, and field inlet referenced in the table above.

* Offset shown is to ctr of feature
** Offset shown is to top face of curb

Abandoned pipe shown thus

⑬ Sta. "RW" 119+91.29, 34.25' Rt. to Sta. "RW" 119+78.58, 34.25' Rt. Inst. 6" drain pipe - 13' 5' depth (For details see shts. 2B & 2B-2)

⑭ Sta. "RW" 119+78.58, 34.25' Rt. to Sta. "RW" 120+02.68, 25.08' Rt. Inst. 12" sew pipe - 26' 5' depth connect to extg. manhole

⑮ Sta. "RW" 120+77.40 to Sta. "RW" 121+09.27 Const. water quality planter strip - 14.2 sq. yds. (Drainage facility ID# D00581) (For details, see shts. 2B & 2B-2)

⑯ Sta. "RW" 120+79.65, 34.25' Rt. to Sta. "RW" 121+08.77, 34.25' Rt. Inst. 6" drain pipe - 29' (For details see shts. 2B & 2B-2)

⑰ Sta. "RW" 120+79.65, 34.25' Rt. to Sta. "RW" 120+83.28, 24.63' Rt. Inst. 12" sew pipe - 10' 10' depth Connect to extg. manhole


⑱ Sta. "RW" 121+89.02, 24.07' Rt. Const. manhole over extg. storm sewer (See dwg. no. RD336)

⑲ Const. bio-swale - 173 ft. Install stormwater treatment markers (Drainage facility ID# D00579) (For details see sht. 2B-8 and RD399)

⑳ Minor adjust communication manhole

㉑ Relocate waterline access vault (By others)

"AS CONSTRUCTED"
OCT 28 2013
MARK BEESON, PROJECT MANAGER

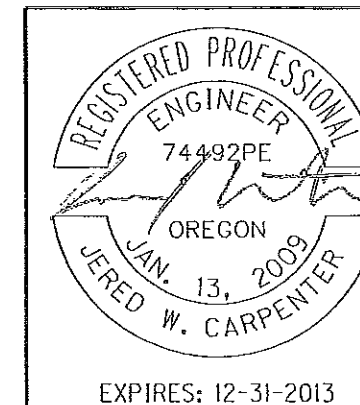

OREGON DEPARTMENT OF TRANSPORTATION


REGION 1 - Geo/Hydro/HazMat Unit

US30 BYPASS: NE 122ND - M.P. 13.54 SEC.
NORTHEAST PORTLAND HIGHWAY
MULTNOMAH COUNTY

Reviewed by - Ed Foltyn
Designed by - Jered Carpenter
Drafted by - Billy Shafer


DRAINAGE & UTILITIES

SHEET NO. 3A

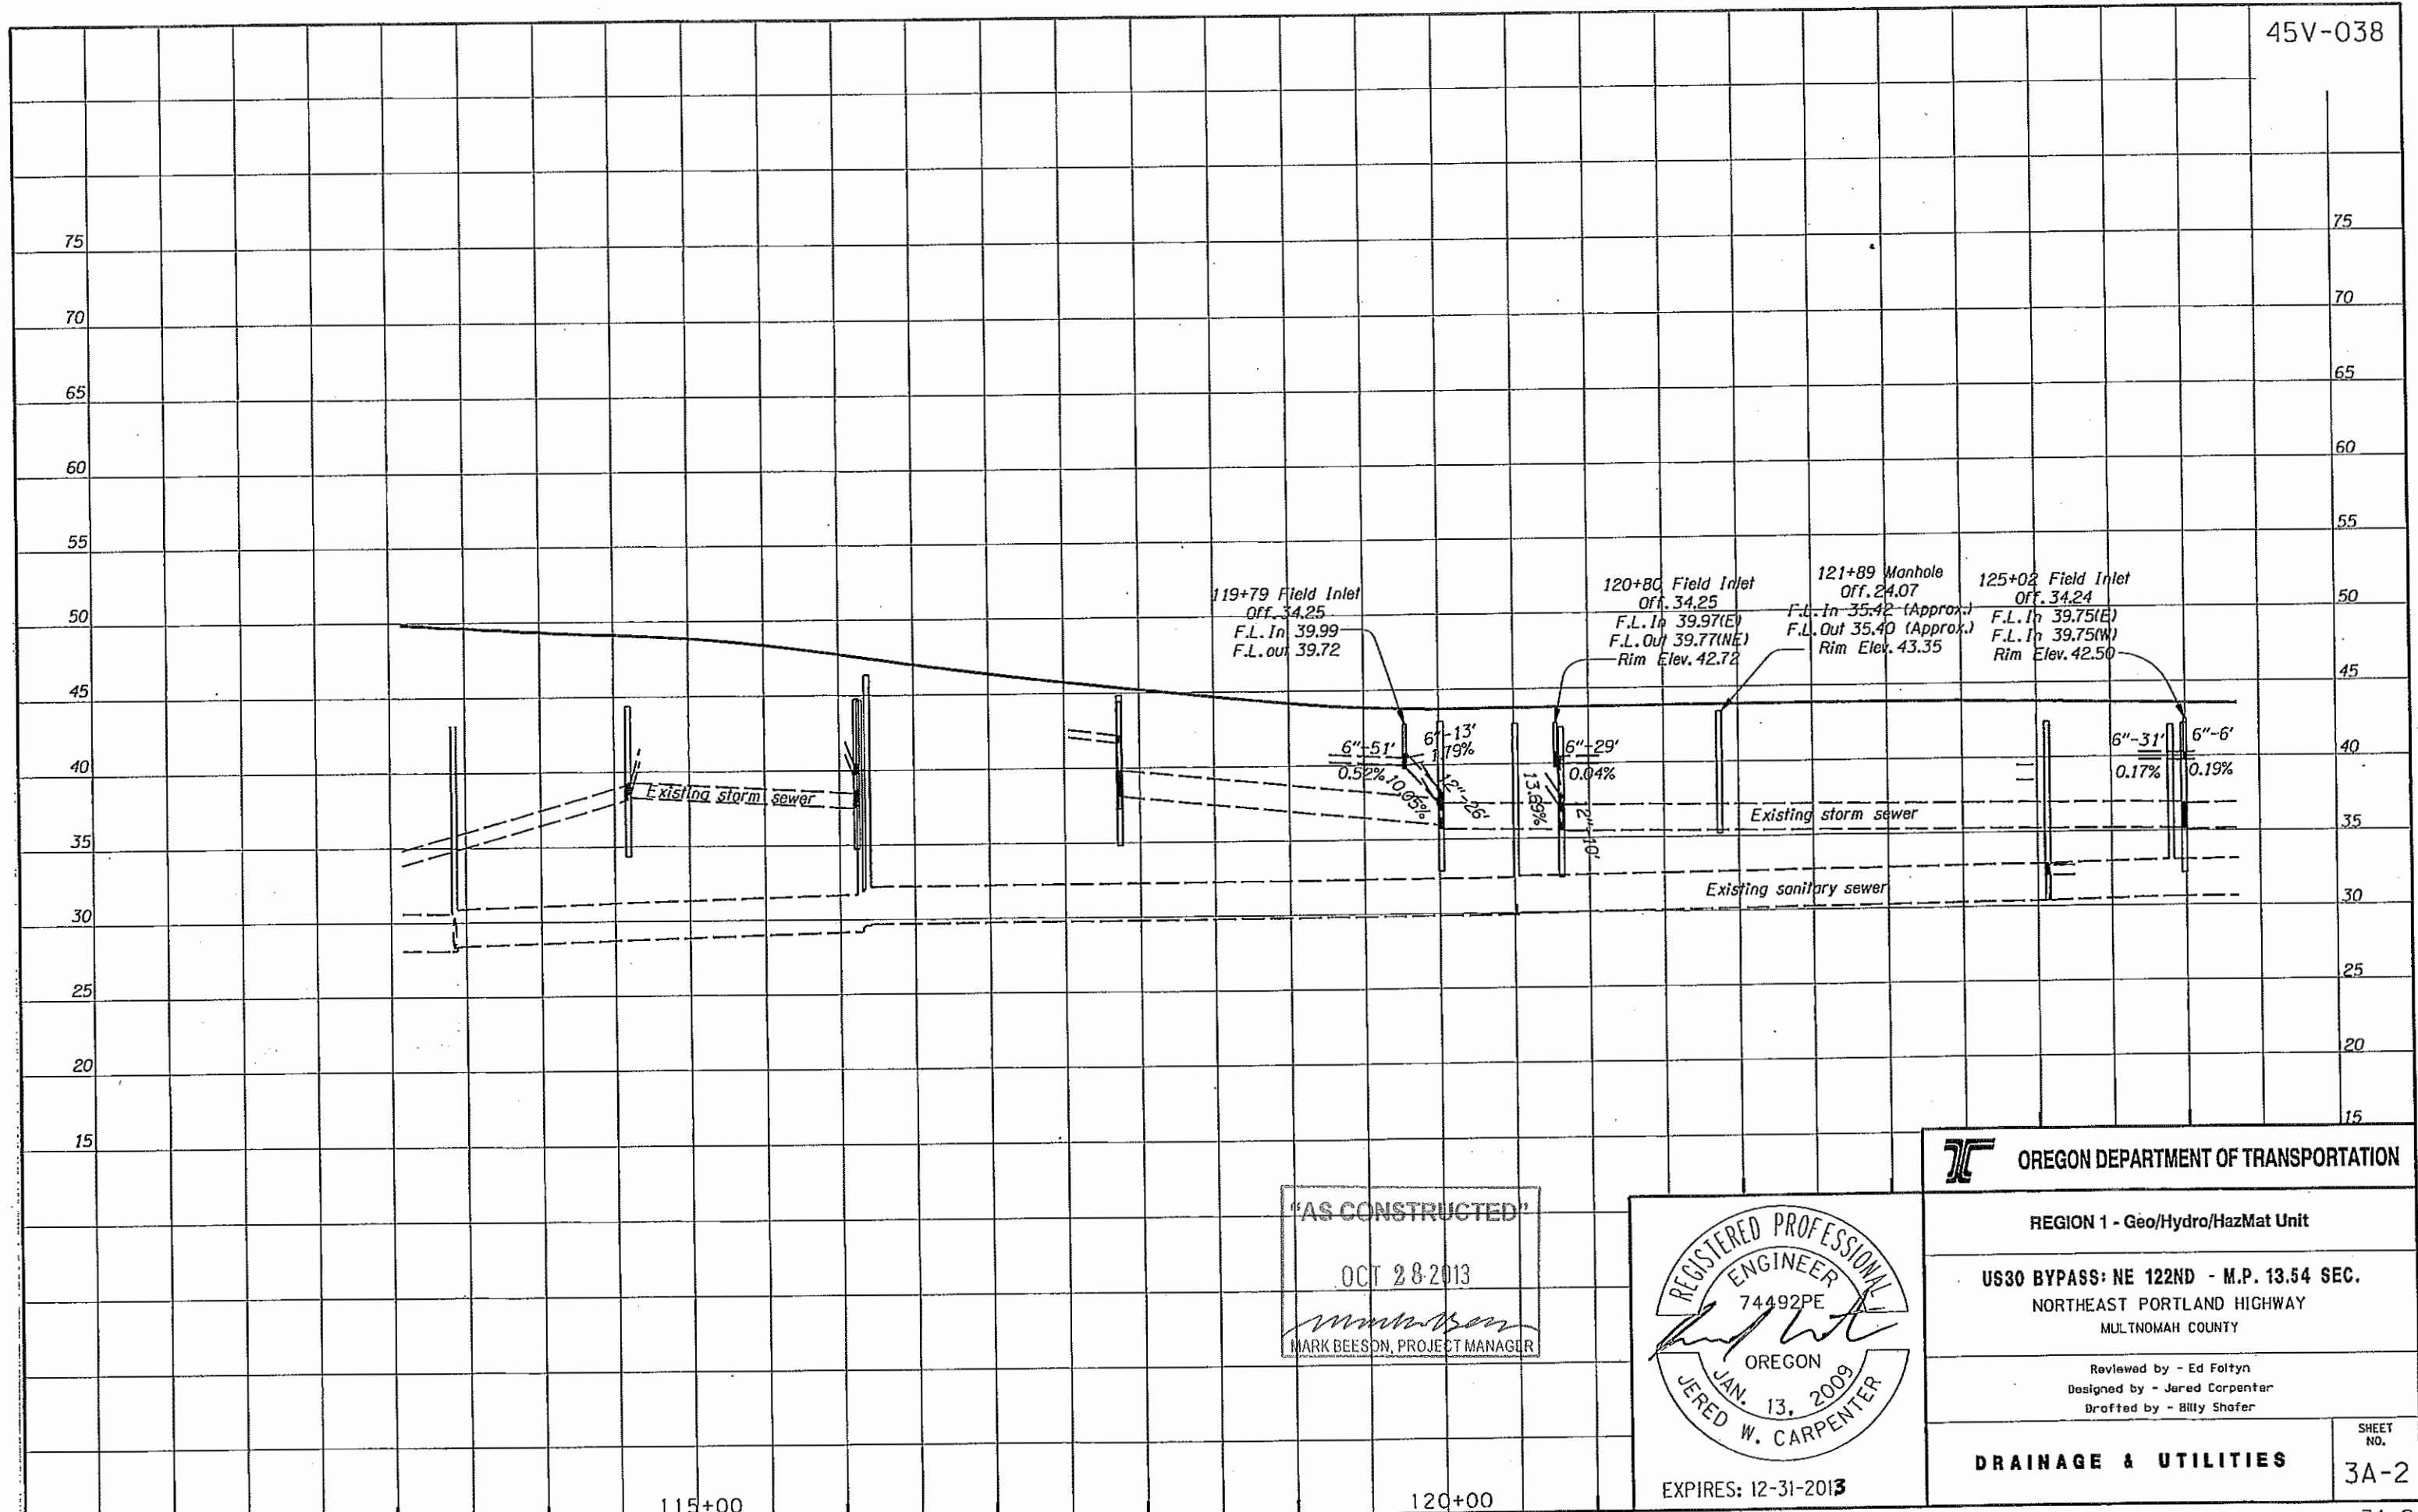


'AS CONSTRUCTED'
 OCT 28 2013
Mark Beeson
 MARK BEESON, PROJECT MANAGER

REGISTERED PROFESSIONAL
 ENGINEER
 74492PE
Jared W. Carpenter
 OREGON
 JAN. 13, 2009
 JERED W. CARPENTER
 EXPIRES: 12-31-2013

 OREGON DEPARTMENT OF TRANSPORTATION	
REGION 1 - Geo/Hydro/HazMat Unit	
US30 BYPASS: NE 122ND - M.P. 13.54 SEC. NORTHEAST PORTLAND HIGHWAY MULTNOMAH COUNTY	
Reviewed by - Ed Foltyn Designed by - Jared Carpenter Drafted by - Billy Shofer	
DRAINAGE & UTILITIES	SHEET NO. 3A-2

115+00

120+00

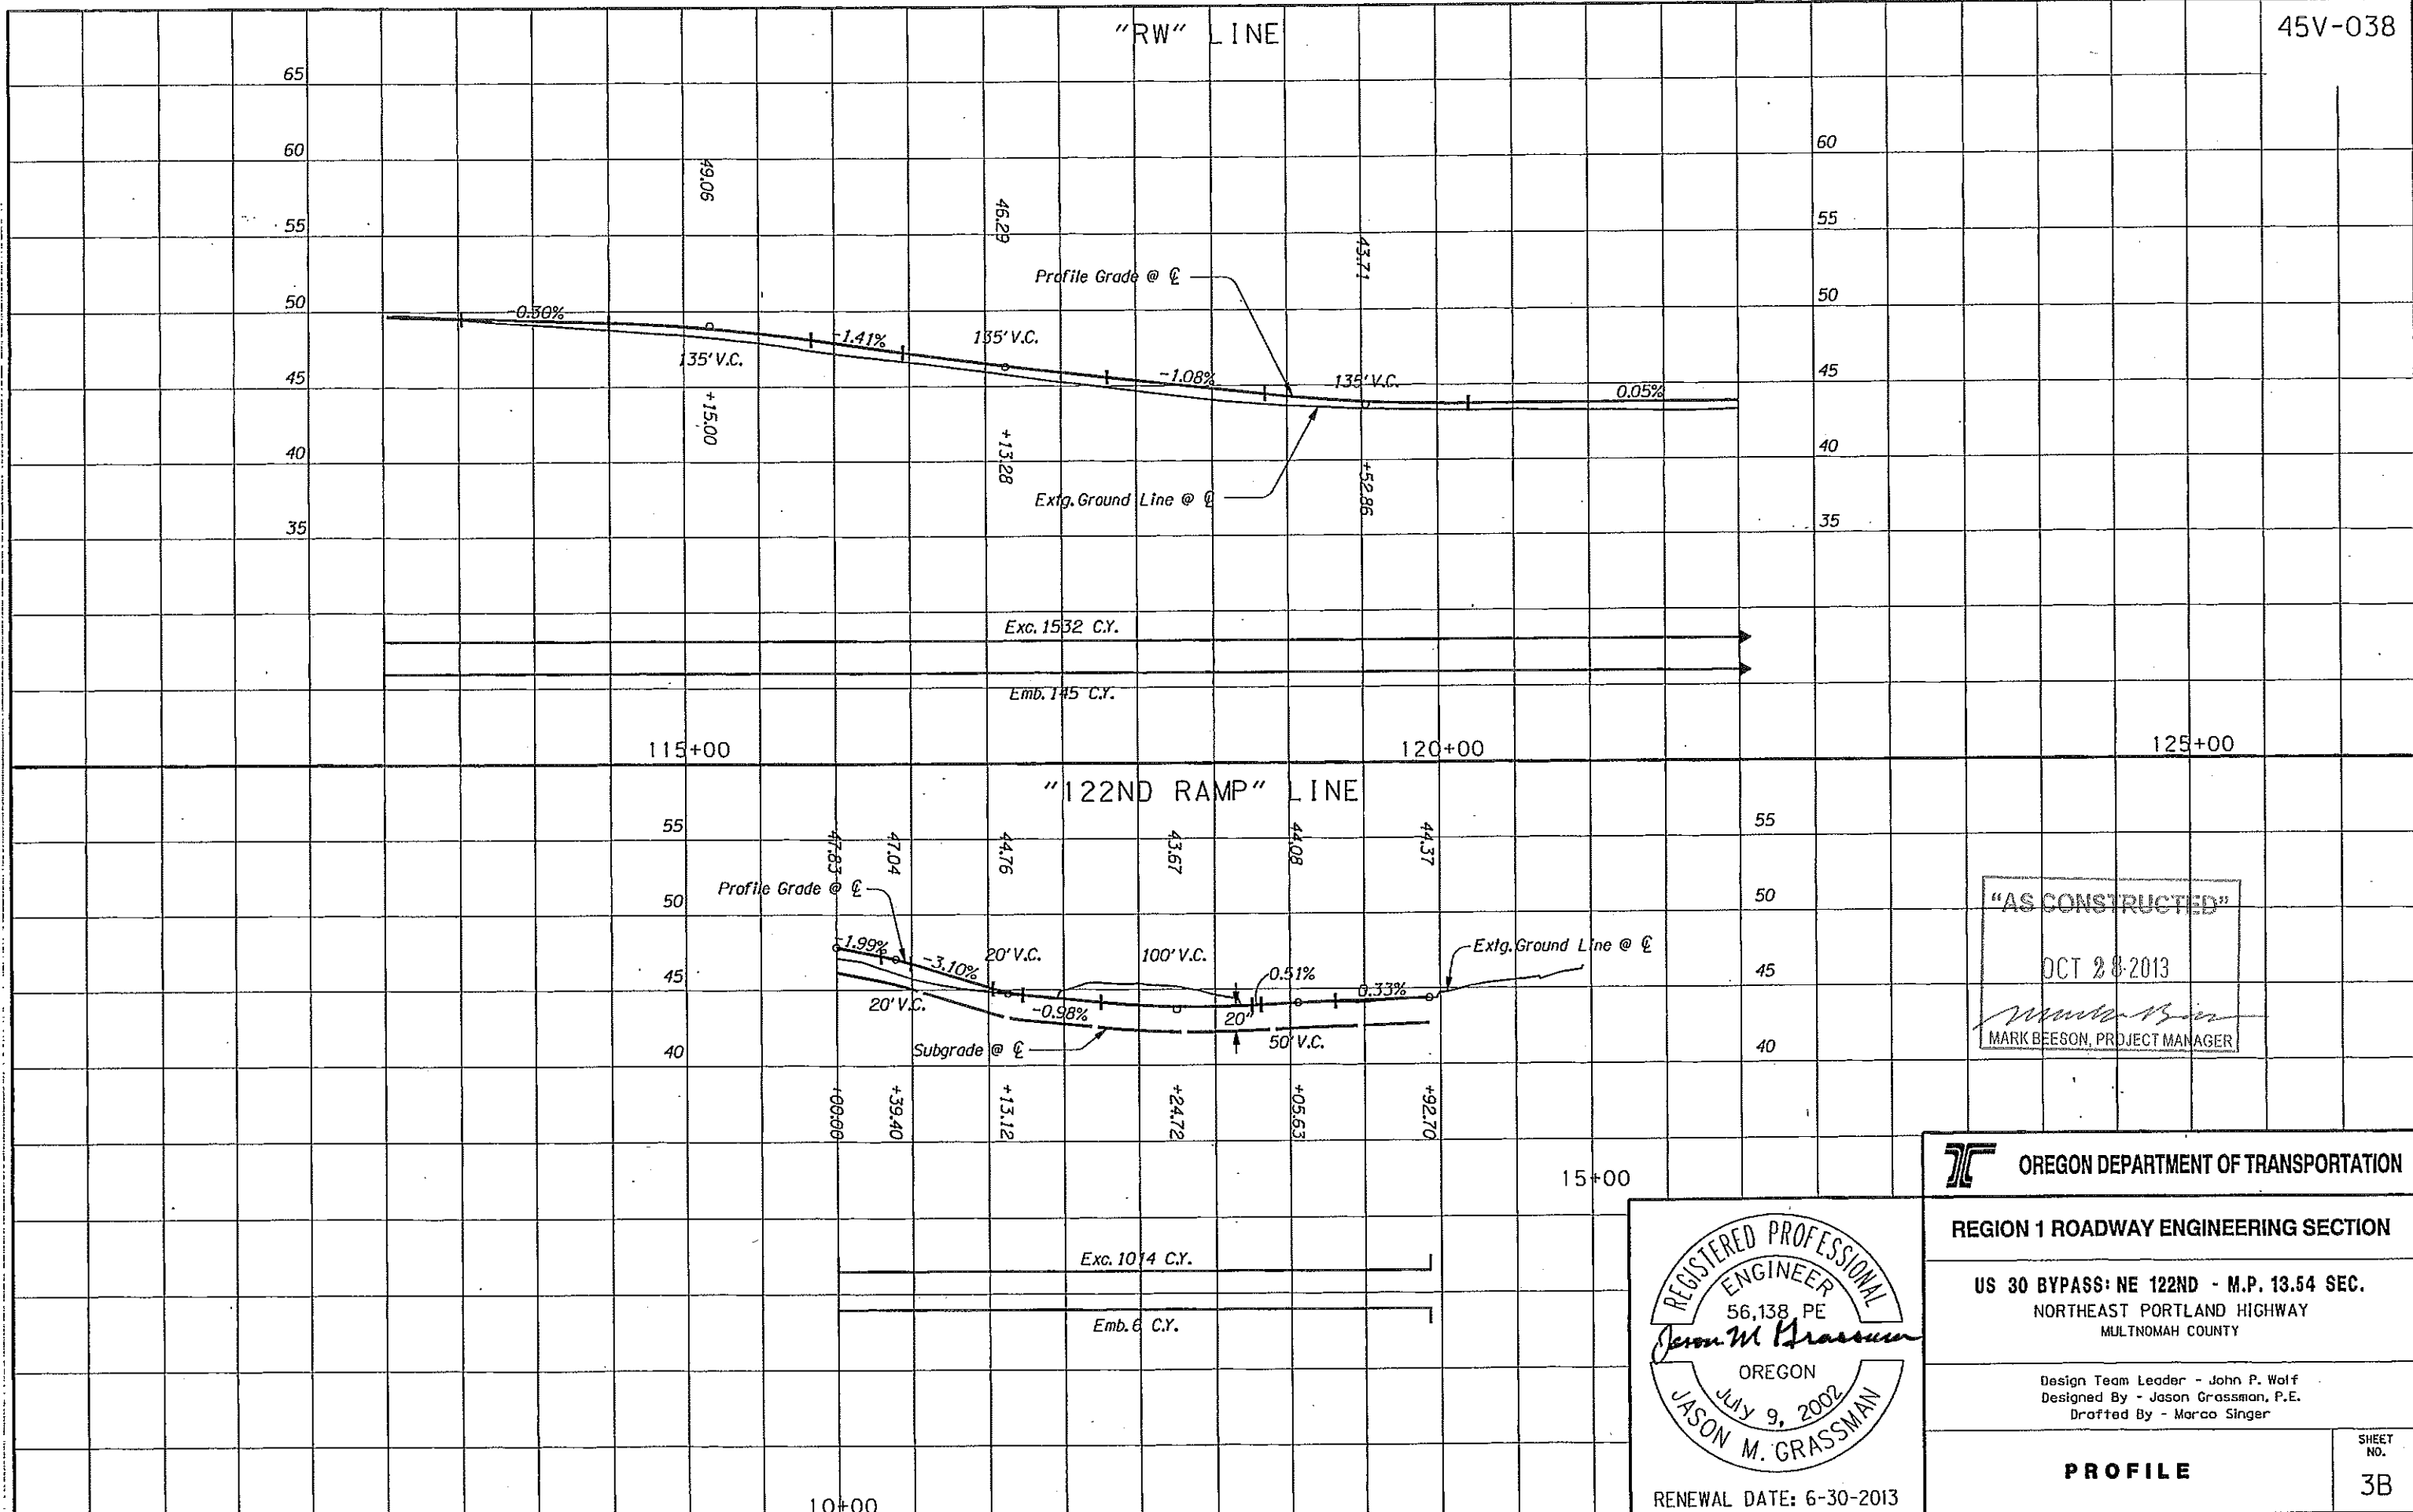

"AS CONSTRUCTED"
 OCT 28 2013
 MARK BEESON, PROJECT MANAGER

OREGON DEPARTMENT OF TRANSPORTATION
REGION 1 ROADWAY ENGINEERING SECTION
 US 30 BYPASS: NE 122ND - M.P. 13.54 SEC.
 NORTHEAST PORTLAND HIGHWAY
 MULTNOMAH COUNTY

Design Team Leader - John P. Wolf
 Designed By - Jason Grassman, P.E.
 Drafted By - Marco Singer

PROFILE

SHEET NO. 3B

