

OPERATION & MAINTENANCE MANUAL

Water Quality Planter

Manual prepared: November 2018

DFI No. D00580, D00581, D00582



Figure 1: DFI No D00581, looking South

1. Identification

Drainage Facility ID (DFI): D00580
Facility Type: Water Quality Planter
Construction Drawings: 45V-038
Locations: District: 2B
Highway No.: 123
Mile Post: 12.57-12.58

Drainage Facility ID (DFI): D00581
Facility Type: Water Quality Planter
Construction Drawings: 45V-038
Locations: District: 2B
Highway No.: 123
Mile Post: 12.60-12.61

Drainage Facility ID (DFI): D00582
Facility Type: Water Quality Planter
Construction Drawings: 45V-038
Locations: District: 2B
Highway No.: 123
Mile Post: 12.67-12.68

2. Manual Purpose

The purpose of this manual is to outline inspection needs and summarize maintenance actions for water quality planters.

3. Facility Location

The location map below details the facility location. The highway, mile posts, side streets, access location, and stormwater flow directions are noted on the map.

Facility location type: In Sidewalk

Flow direction: East

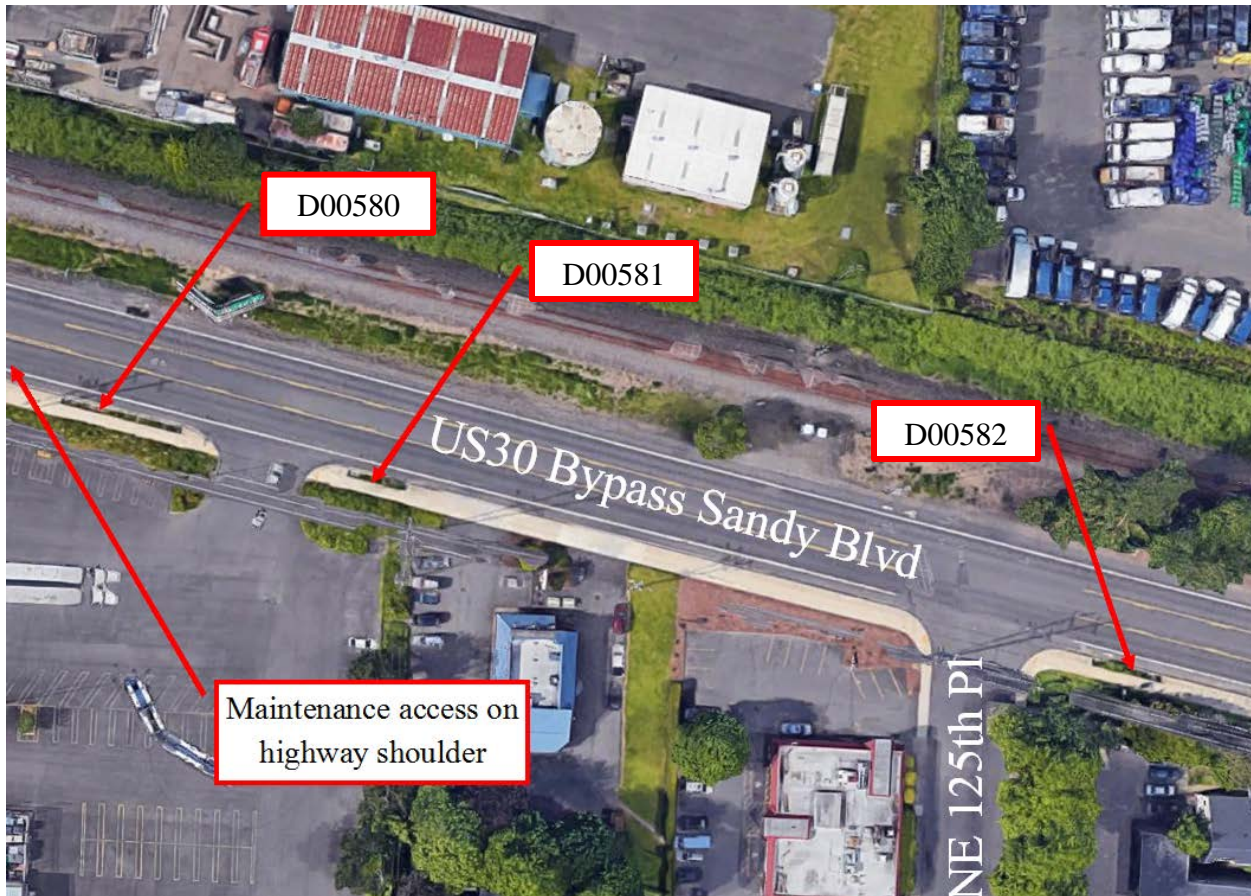



Figure 2: Facility Location Map

4. Facility Summary

The length and width of the WQ Planter is based on the dimensions of the inside of the treatment cell.

The length and width of the WQ Planters are:

Facility DFI	Length (Feet)	Width (Feet)
D00580	64	3.5
D00581	32	3.5
D00582	38	3.5

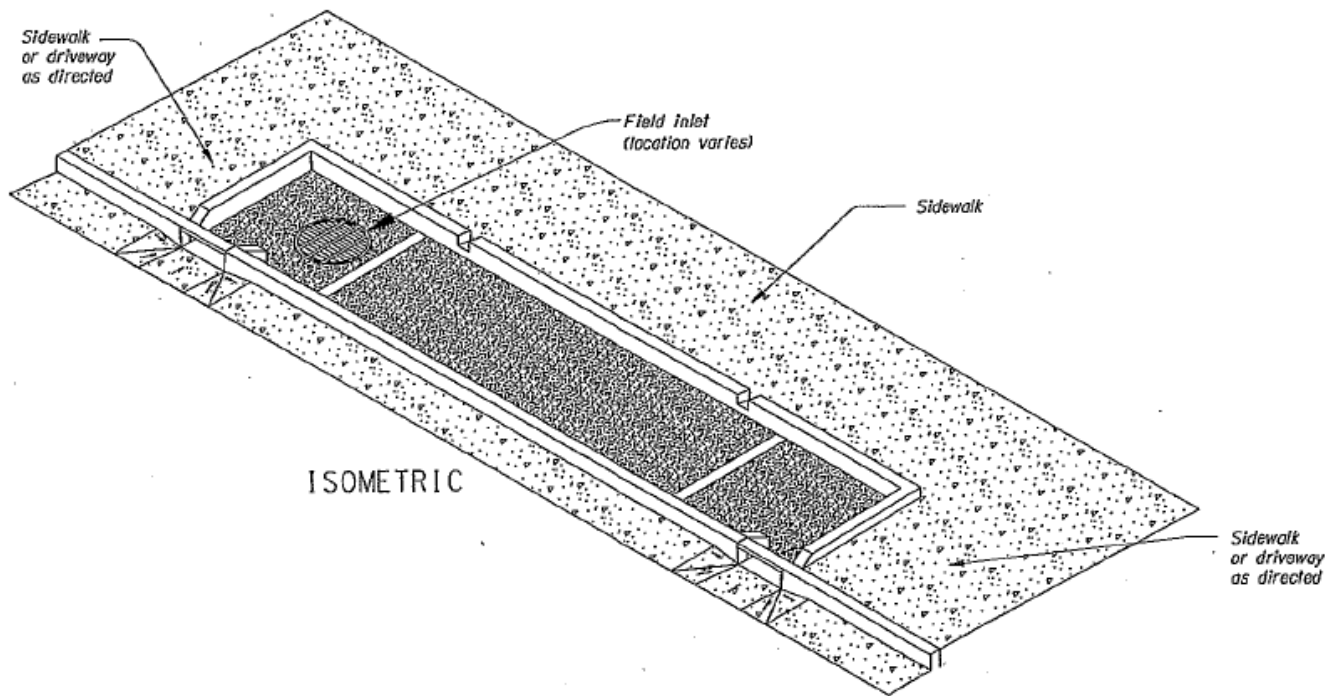

Site Specific Information: The planters have blended compost and topsoil mixture. There are also three types of grasses in the planters and two curb inlets. There are no bypass inlets on the planters.

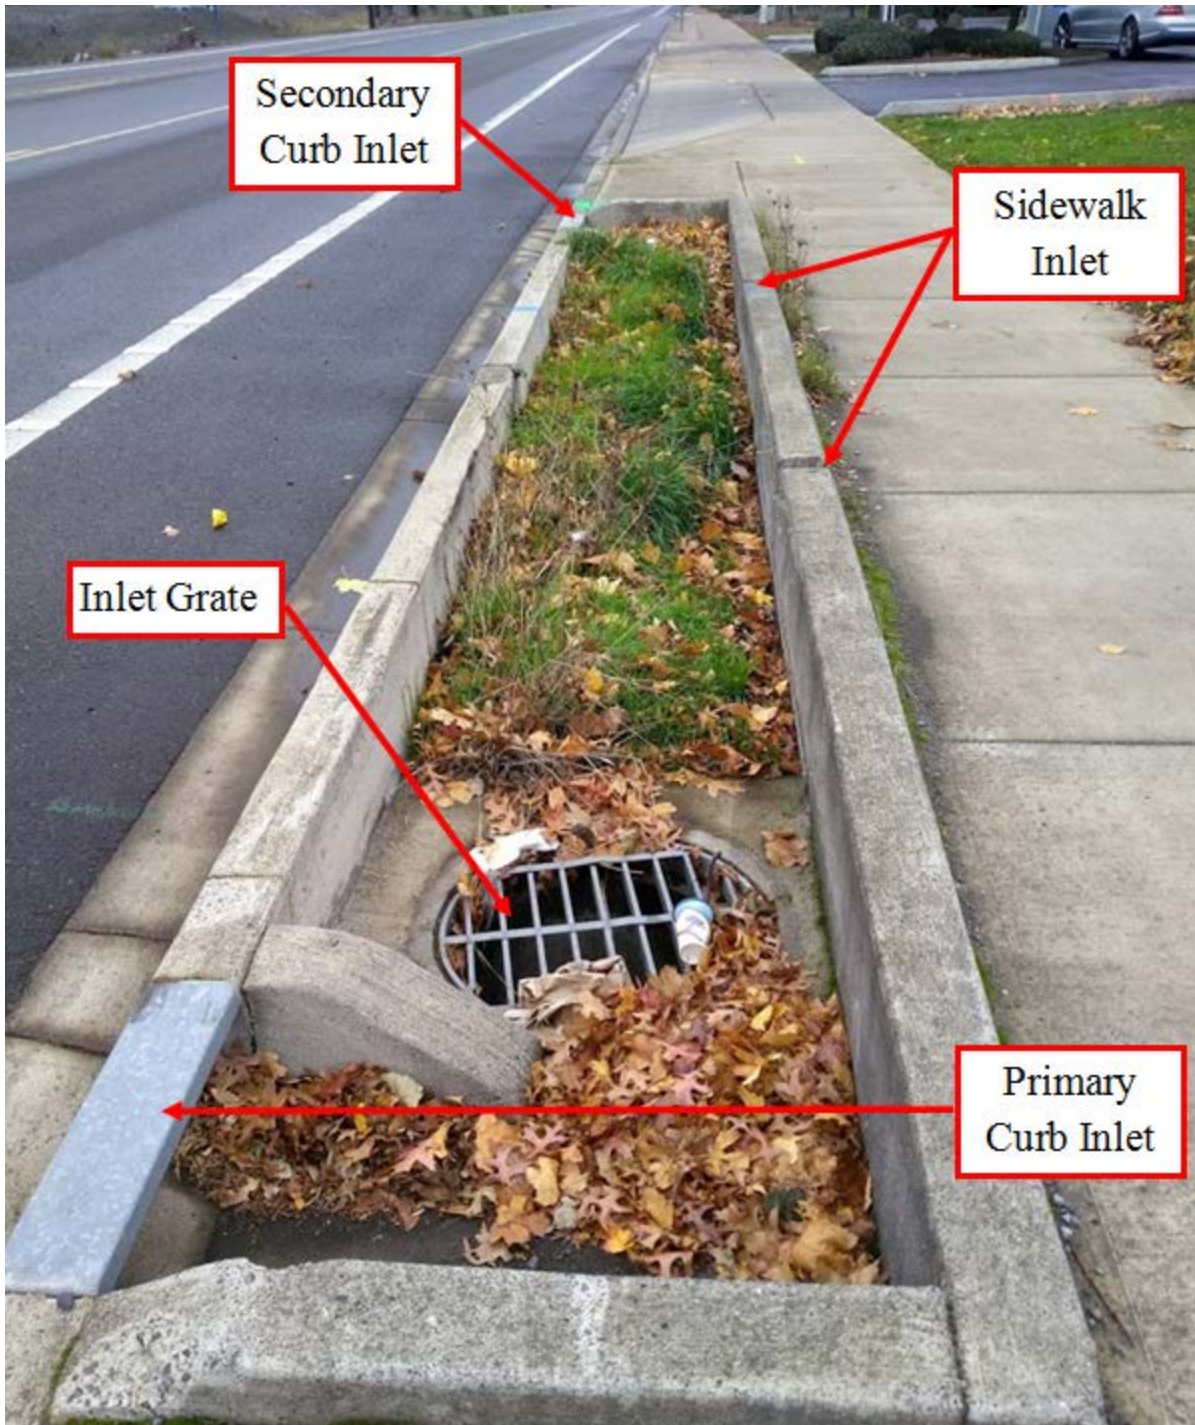


Figure 3: Facility Components



Figure 4: Facility Components

5. Facility Access

Maintenance access to the facility: Curb and gutter (travel lane)

Lane Closure Needed

Water quality planters do not typically have access roads/access pads, nor are they gated, as they are located in urban areas alongside sidewalks and curbs. Use caution when accessing these facilities as there may be pedestrians or cyclists in the vicinity.

6. Operational Components / Maintenance Items

Classification and Standard Operational (Op) Plan:

This facility is classified as a:

<input type="checkbox"/> Filterra (Op Plan A)	<input checked="" type="checkbox"/> WQ Planter (Op Plan B)	<input type="checkbox"/> MWS (Op Plan C)
<p>A Filterra is a single chamber treatment cell that utilizes filter media, a plant, and a perforated underdrain.</p>	<p>A WQ Planter is a single chamber treatment cell that utilizes plants, filter media, and a perforated underdrain. The auxiliary outlet is located inside of the treatment cell.</p>	<p>A <u>Modular Wetland System</u> is a three chamber treatment cell that utilizes plants, filter media, filter media cartridges, and a perforated underdrain network.</p>
<p>A standard operational plan illustrates the general facility footprint configuration and explains the purpose of each facility component. Operational plans (A and B) are provided in the Standard Operation Manual.</p>		

See Appendix A for the site specific operational plan.

Operational Components

The facility components table (**Table 1**) has been provided to highlight the applicable components for this facility. The component is in use when the box contains an “x” (e.g.).

The Standard Operation Manual for Water Quality Planters (implemented April 2018) outlines facility operation, typical footprint configuration, and component definitions and details. A link to the manual is attached to the feature marker in TransGIS.

<https://gis.odot.state.or.us/TransGIS/>

Maintenance Items

Operational components marked in **Table 1** should be inspected and maintained according to Section 7. Each facility component is defined and detailed in the Standard Operation Manual using the associated ID number indicated below.

Table 1: Facility Components		ID #
Facility Inlet		
Inlet Grate	<input type="checkbox"/>	P1
Curb Inlet	<input checked="" type="checkbox"/>	P2
Sidewalk Chute	<input type="checkbox"/>	P3
Bypass Inlet	<input type="checkbox"/>	P4
Treatment		
Plants (Tree or Shrub)	<input type="checkbox"/>	P5
Grass	<input checked="" type="checkbox"/>	P6
Filter Media	<input type="checkbox"/>	P7
Filter Media Cartridge	<input type="checkbox"/>	P8
Planter Components		
Perforated Pipe	<input checked="" type="checkbox"/>	P9
Outlet Grate	<input checked="" type="checkbox"/>	P10
Outfall Type		
Waterbody (Creek/Lake/Ocean)	<input type="checkbox"/>	P11
Ditch	<input type="checkbox"/>	P12
Storm Drain System	<input checked="" type="checkbox"/>	P13

7. Maintenance

Maintenance Frequency/Maintain Records

- Full inspection annually. Preferably prior to the rainy season.
- Clean and maintain as necessary. Refer to Activity 125 for conditions when maintenance is needed.
- Keep a record of inspections, maintenance, and repairs.

Maintenance Guide/Maintenance Actions

The ODOT Routine Road Maintenance Water Quality and Habitat Guide (the *Blue Book*) outlines the standard maintenance actions for water quality facilities under Activity 125.

There are standard maintenance tables for standard ODOT designs. The maintenance tables describe the maintenance component, the defect or problem, the condition

when maintenance is needed, and the recommended maintenance to correct the problem. Use the following tables to maintain these water quality planters:

- Table 1 (General Maintenance): Contains general maintenance and inspection guidelines that are applicable to all ODOT water quality facilities. Maintenance of inlets, outlets, trash removal and noxious weeds is recommended seasonally.
- Table 3 (Maintenance of Water Quality or Biofiltration Swales): Contains maintenance information for swales. The planted area of these planters should be maintained as described for the bottom and sides of swales, by using equipment other than mowers to control plant height. Replant if needed with plants from the original plans, or as recommended by ODOT landscaping and stormwater staff.

The *Blue Book* can be viewed at the following website:

http://www.oregon.gov/ODOT/Maintenance/Documents/blue_book.pdf

8. Limitations

Vactors may be used at the inlet, outlet, and grated areas. No heavy equipment may be used in the planted areas.

9. Waste Material Handling

Material removed from the facility is defined as waste by the Department of Environmental Quality (DEQ). Refer to the road waste section of the ODOT Maintenance Yard Environmental Management System (EMS) Policy and Procedures Manual for disposal options:

<http://www.oregon.gov/ODOT/HWY/OOM/pages/ems.aspx>


Contact any of the following for more detailed information about management of waste materials found on site:

ODOT Clean Water Unit	(503) 986-3008
ODOT Statewide Hazmat Coordinator	(503) 667-7442
ODOT Region 1 Hazmat Coordinator	(503) 731-8290
ODOT Region 2 Hazmat Coordinator	(503) 986-2647
ODOT Region 3 Hazmat Coordinator	(541) 957-3594
ODOT Region 4 Hazmat Coordinator	(541) 388-6186
ODOT Region 5 Hazmat Coordinator	(541) 963-1590

A Appendix A – Site Specific Operational Plan

Contents:

Operational Plan: DFI D00580, D00581, D00582

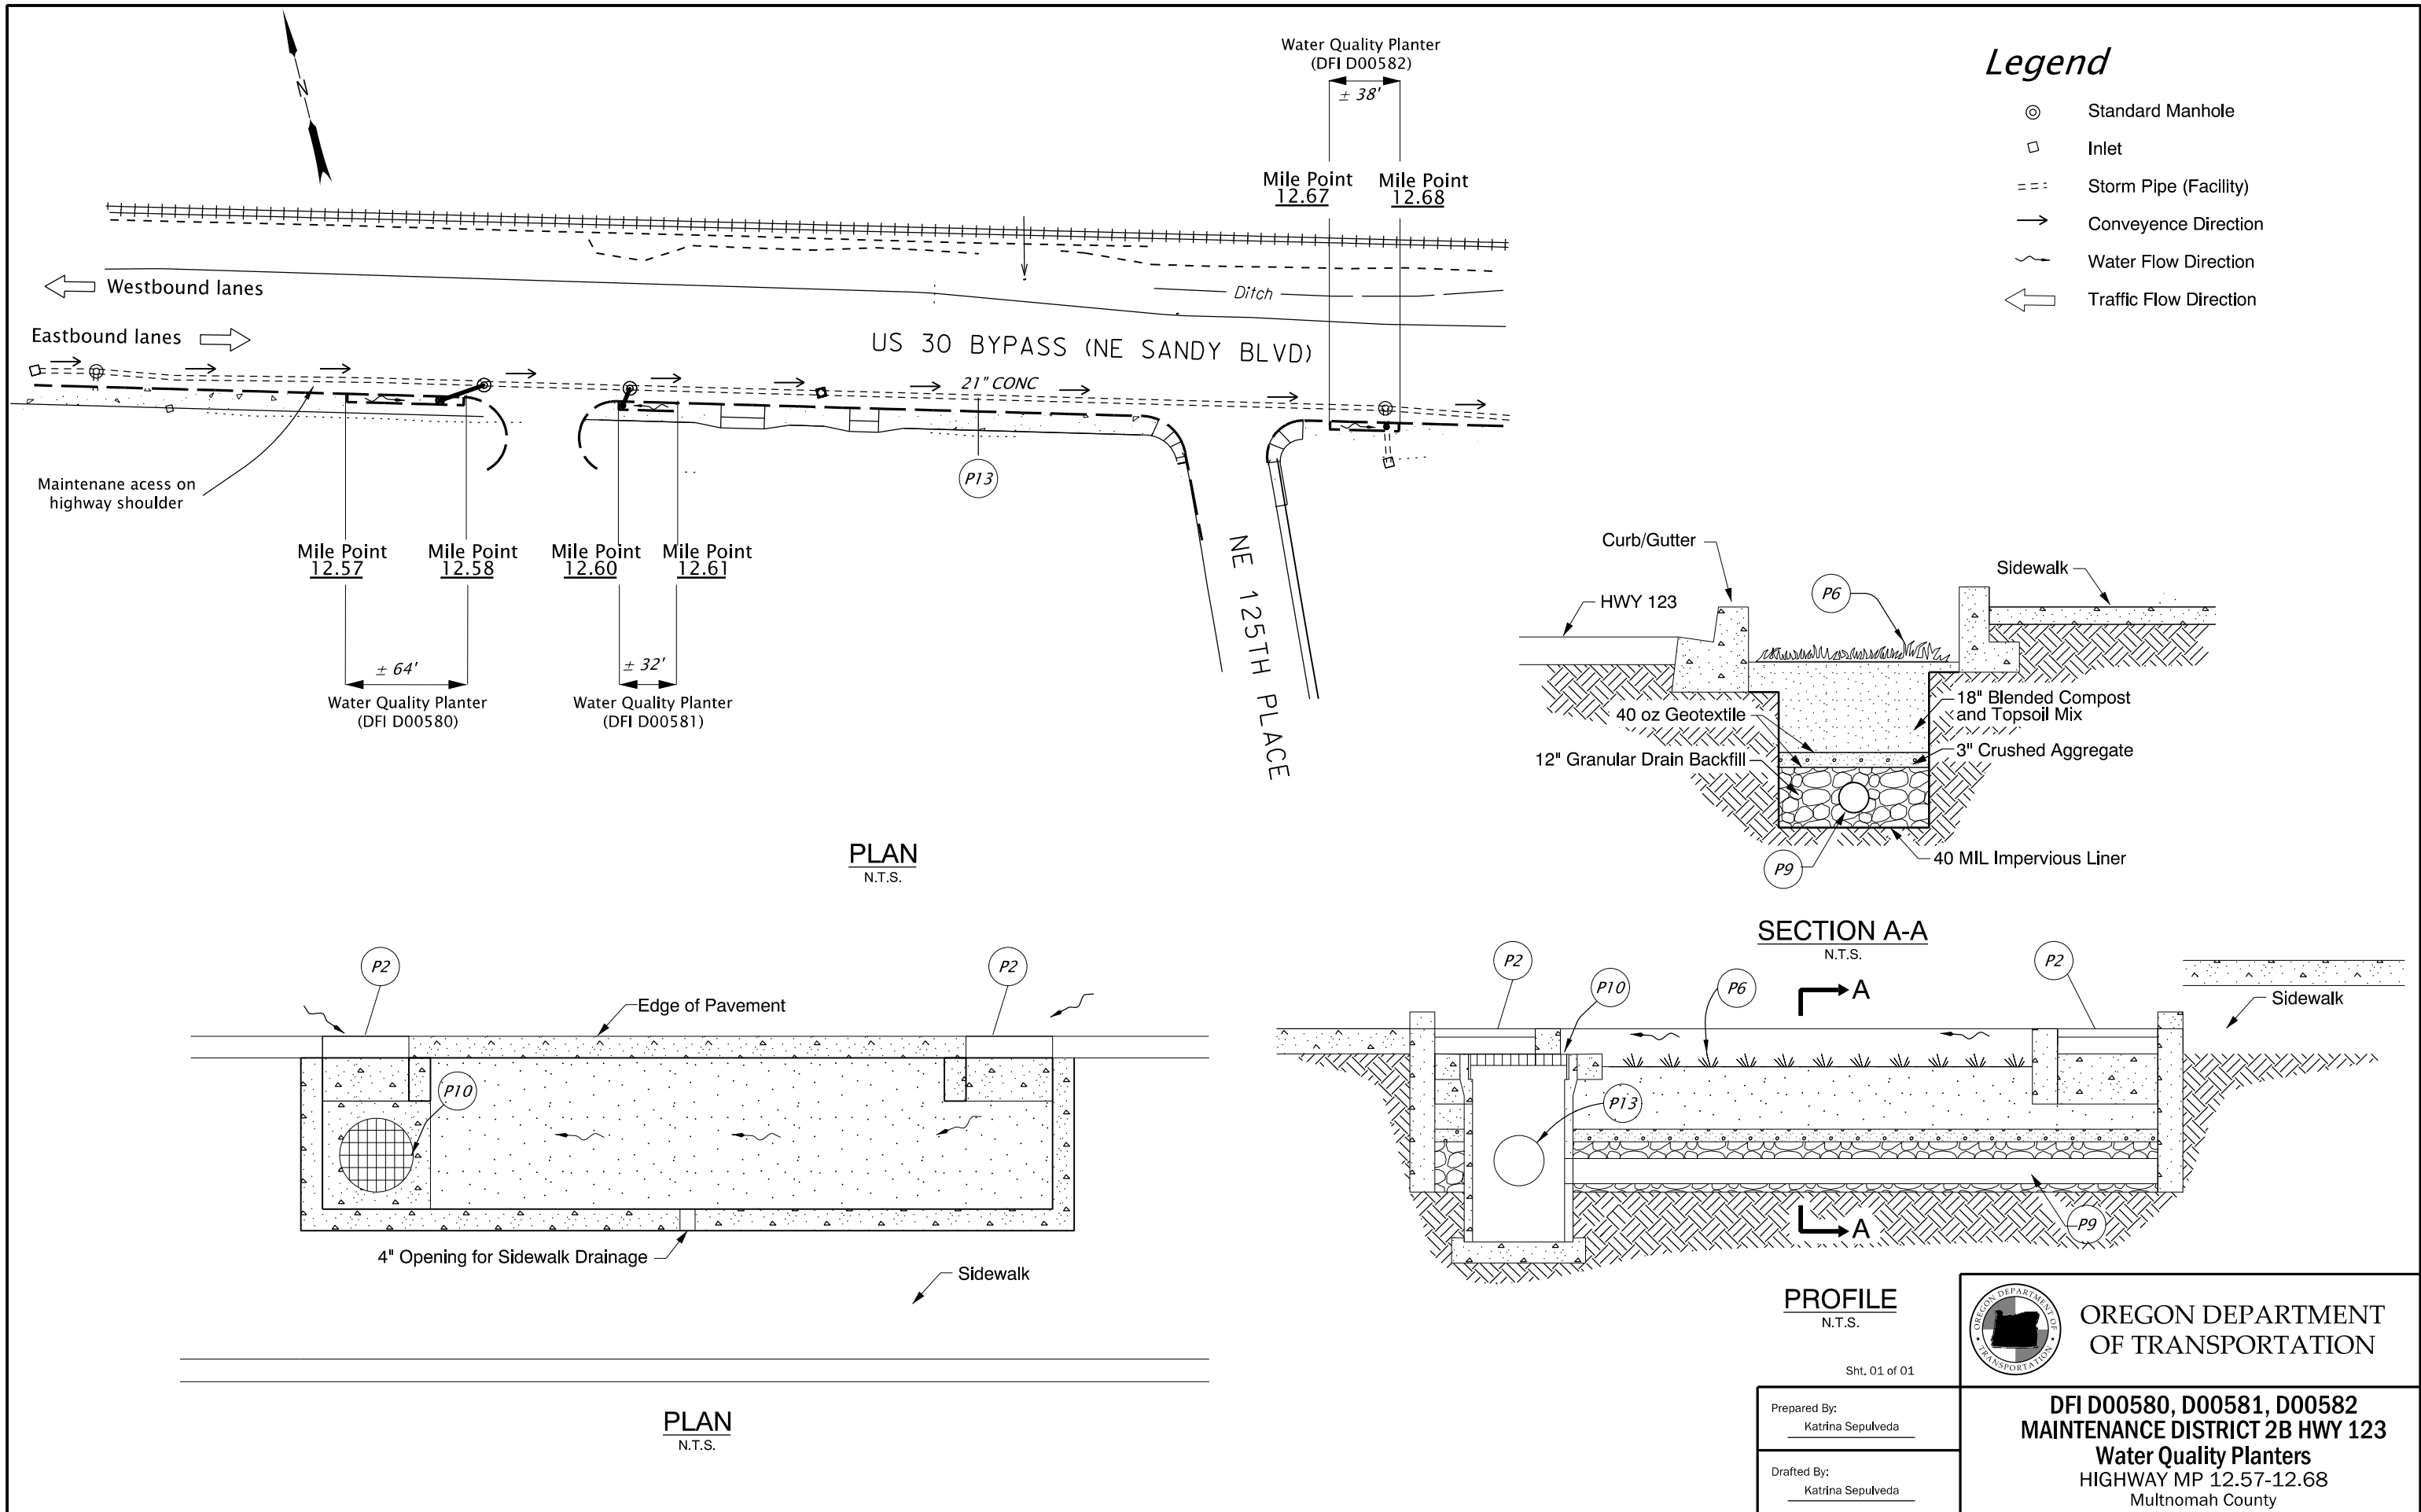

- Legend**
- ⊙ Standard Manhole
 - Inlet
 - Storm Pipe (Facility)
 - Conveyence Direction
 - ~ Water Flow Direction
 - ← Traffic Flow Direction

PLAN
N.T.S.

SECTION A-A
N.T.S.

PROFILE
N.T.S.



Sht. 01 of 01

Prepared By:
Katrina Sepulveda

Drafted By:
Katrina Sepulveda

DFI D00580, D00581, D00582
MAINTENANCE DISTRICT 2B HWY 123
Water Quality Planters
HIGHWAY MP 12.57-12.68
Multnomah County

B Appendix B – Project Contract Plans

Contents:

Site Specific Subset of Project Contract Plan 45V-038

STATE OF OREGON
DEPARTMENT OF TRANSPORTATION

PLANS FOR PROPOSED PROJECT

GRADING, DRAINAGE, PAVING, PAVEMENT MARKERS, SIGNING,
SIGNALS & ROADSIDE DEVELOPMENT

US 30 BYPASS: NE 122ND - M.P. 13.54 SEC.

NORTHEAST PORTLAND HIGHWAY

MULTNOMAH COUNTY
MAY 2012

END OF CONTRACT PROJECT
HSIP-STP-S123(016)

STA. "RW" 177+93.00 (M.P. 13.68)


END OF PROJECT
HSIP-STP-S123(016)

STA. "RW" 170+44.71 (M.P. 13.54)

INDEX OF SHEETS	
SHEET NO.	DESCRIPTION
1	Title Sheet
1A	Index Of Sheets Cont'd. & Std. Drg. Nos.


BEGINNING OF PROJECT &
CONTRACT PROJECT
HSIP-STP-S123(016)

STA. "RW" 112+79.00 (M.P. 12.45)

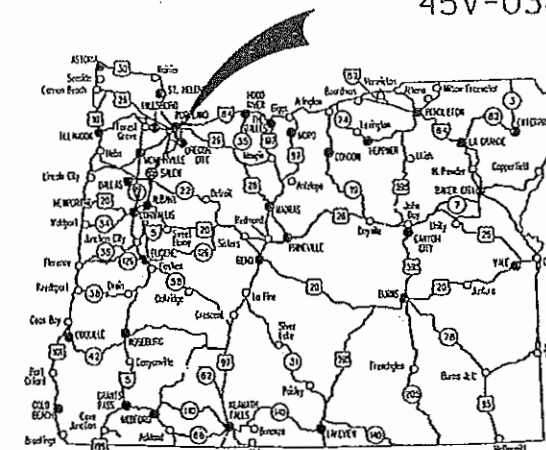

Overall Length Of Project - 1.09 Miles

ATTENTION:
Oregon Law Requires You To Follow Rules Adopted By The Oregon Utility Notification Center. Those Rules Are Set Forth In OAR 952-001-0010 Through OAR 952-001-0090. You May Obtain Copies Of The Rules By Calling The Center. (Note: The Telephone Number For The Oregon Utility Center Is (503) 232-1987.)

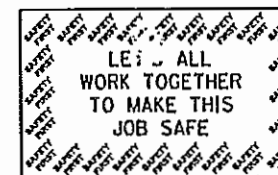

OREGON TRANSPORTATION COMMISSION
Pat Egan CHAIR
Mary F. Olson COMMISSIONER
David Lohman COMMISSIONER
Mark Frohnmayer COMMISSIONER
Tommy Boney COMMISSIONER
Matthew L. Garrett DIRECTOR OF TRANSPORTATION


These plans were developed using ODOT design standards. Exceptions to these standards, if any, have been submitted and approved by the ODOT Chief Engineer or their delegated authority.

Approving Authority: *Naveen G. Chandra*
Naveen G. Chandra, P.E.
Project Delivery Manager, Region 1

J.M. Hill
Concurrence by ODOT Chief Engineer

US 30 BYPASS: NE 122ND - M.P. 13.54 SEC.
NORTHEAST PORTLAND HIGHWAY
MULTNOMAH COUNTY

FEDERAL HIGHWAY ADMINISTRATION	PROJECT NUMBER	SHEET NO.
OREGON DIVISION	HSIP-STP-S123(016)	1

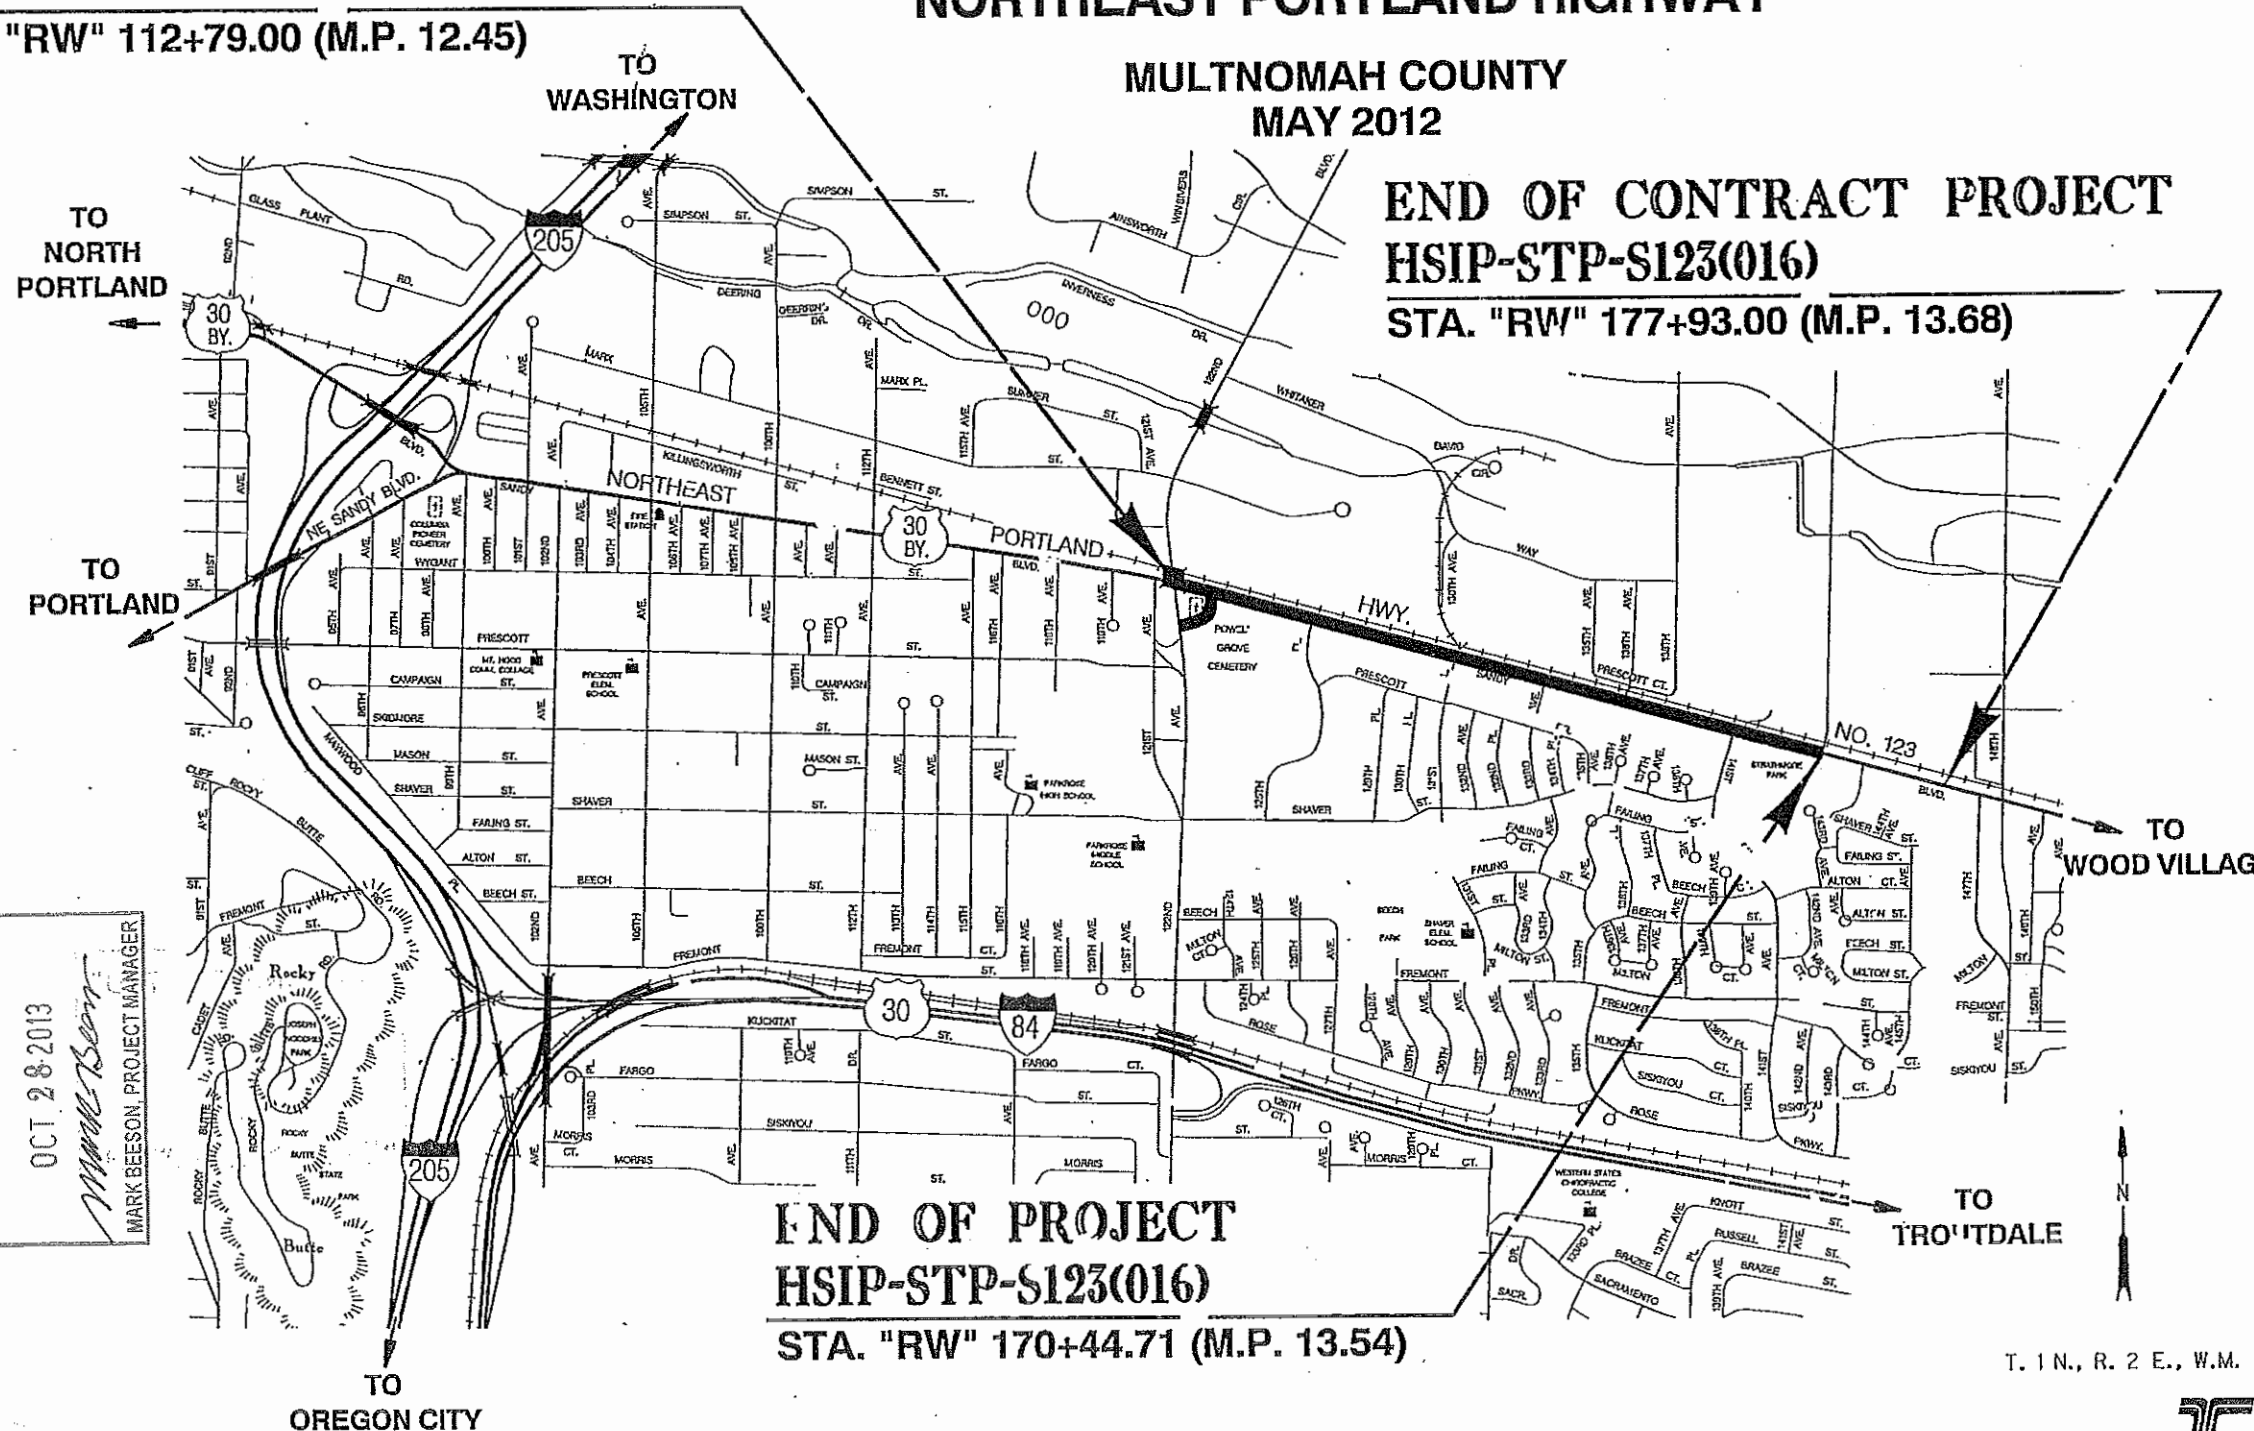

"AS CONSTRUCTED"
OCT 28 2013
Mark Beeson
MARK BEESON, PROJECT MANAGER

T. 1 N., R. 2 E., W.M.



PE001435 000

INDEX OF SHEETS, CONT'D.	
SHEET NO.	DESCRIPTION
2, 2A, 2A-2 thru 2A-5	Typical Sections
2B, 2B-2 thru 2B-8	Details
2C, 2C-2 Thru 2C-5	Traffic Control Plans
2D	Pipe Data Sheet
3	General Construction
3A & 3A-2	Drainage & Utilities
3B	Profile
4	General Construction
4A & 4A-2	Drainage & Utilities
4B	Profile
5	General Construction
5A & 5A-2	Drainage & Utilities
5B	Profile
6	General Construction
6A & 6A-2	Drainage & Utilities
7	General Construction
7A & 7A-2	Drainage & Utilities
7B	Profile
8	General Construction
8A	Drainage & Utilities
GEO/HYDRO	
GA, GA-2 Thru GA-10	Erosion Control
GB & GB-2	Geotechnical Data
GM	Mandatory Disposal Site
ROADSIDE DEVELOPMENT	
GN, GN-2 & GN-3	Details
GN-4 Thru GN-8	Roadside Development Plans
PERMANENT PAVEMENT MARKINGS	
ST, ST-2 Thru ST-5 Incl.	Striping Plans
PERMANENT SIGNING	
S-13094 Thru S-13104	Permanent Signing


INDEX OF SHEETS, CONT'D.	
SHEET NO.	DESCRIPTION
TRAFFIC SIGNALS	
16463	Legend
16464	Removal Plan
16465	Signal Plan
16466	Detector Plan
16467	Existing Utilities
16468	Removal Plan
16469	Signal Plan
16470	Detector Plan
16471	Existing Utilities
16472	Interconnect Plan
16473	Flashing Beacon Plan
16474	Existing Utilities
16475	Details
16476	Details
16494	Details
16495	Details

Standard Drg. Nos.

- RD140 - Roadway Cross Slopes Superelevated Sections
- RD150 - Slope Rounding
- RD300 - Trench Backfill, Bedding, Pipe Zone And Mult. Installations
- RD302 - Street Cut
- RD312 - Subsurface Drain
- RD336, RD338, RD342 - Manholes
- RD344, RD346 - Manhole Cover & Frames
- RD356 - Manhole Frame Adjustment
- RD360 - Sanitary Cleanout
- RD362 - Concrete Inlets
- RD370 - Pipe Fill Height Tables
- RD380, RD386, RD388 - Stormwater Treatment and Storage Facility Field Markers
- RD390
- RD399
- RD400, RD405, RD410, RD415, RD420, RD425, RD430, RD435, RD440, RD445, RD450, RD470 - Guardrail
- RD610 - Asphalt Pavement Details
- RD700, RD701 - Curbs
- RD705 - Islands
- RD710 - Accessible Route Islands
- RD715 - Approaches And Non-Sidewalk Driveways
- RD720 - Sidewalks
- RD725 - Separated Sidewalk Driveways or Alleys
- RD735 - Curb Line Sidewalk Driveways or Alleys
- RD755 - Sidewalk Ramp Details
- RD759 - Truncated Dome Detectable Warning Surface Details And Locations



- RD1000 - Construction Entrances
- RD1015 - Inlet Protection
- RD1040 - Sediment Fence
- BR270 - Rail Transition From Flex Beam Rail To Curb & Parapet Rail
- TM204 - Details
- TM211 - Sign Bracing Detail
- TM457 - Vehicle, Ped. Signal & Push Button Mounting Details
- TM458 - Pedestrian Ramp Placement Details
- TM462 - Adjustable Signal Head Mounting Details
- TM465 - Overhead Sign, Fire Preemption & Photoelectronic Details
- TM500, TM501, TM503 - Pavement Marking Standard Details
- TM505 - Rail Crossing Pavement Markings
- TM520, TM521 - Durable Pavement Markings
- TM525 - Turn Arrow Marking Details
- TM530 - Intersection Pavement Markings
- TM539 - Median And Left Turn Channelization Details
- TM560, TM561 - Alignment Layout
- TM570 - Traffic Delineators
- TM571 - Traffic Delineators Steel Post Details
- TM576 - Traffic Delineator Installation
- TM670 - Wood Post Sign Supports
- TM671 - 3 Second Gust Wind Speed Isotach
- TM677 - Sign Mounts
- TM681, TM687, TM688 - Square Tube Sign Supports
- TM800 - Tables, Abrupt Edge And PCMS Details
- TM810 - Temporary Reflective Pavement Markers
- TM820 - Temporary Barricades
- TM821 - Temporary Sign Supports
- TM840, TM841, TM842 - Closure Details
- TM844 - Temporary Pedestrian Access Routing
- TM850 - 2-Lane, 2 Way Roadways
- TM851 - Non-Freeway Multi-Lane Sections

R/W Map No. 11B-05-0025

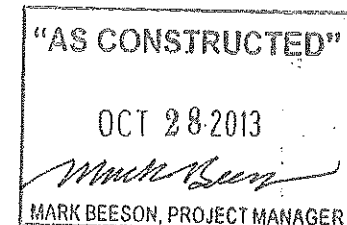


US 30 BYPASS: NE 122ND - M.P. 13.54 SEC. NORTHEAST PORTLAND HIGHWAY MULTNOMAH COUNTY		
FEDERAL HIGHWAY ADMINISTRATION	PROJECT NUMBER	SHEET NO.
OREGON DIVISION	HSIP-STP-S123(016)	1A


Standard Drawings located on the web at:
http://www.oregon.gov/ODOT/HWY/ENGSERVICES/standard_drawings_home.shtml

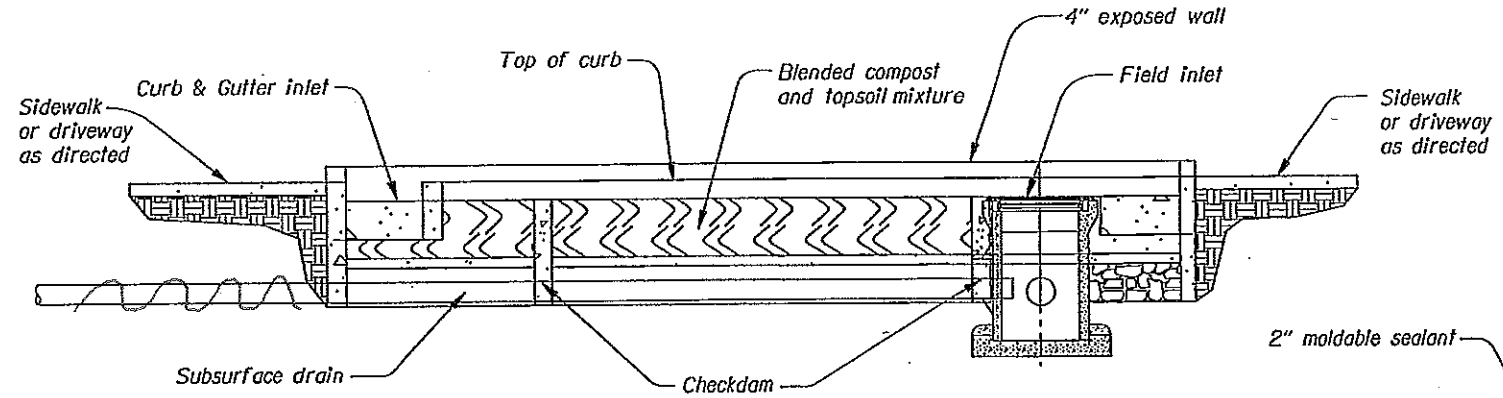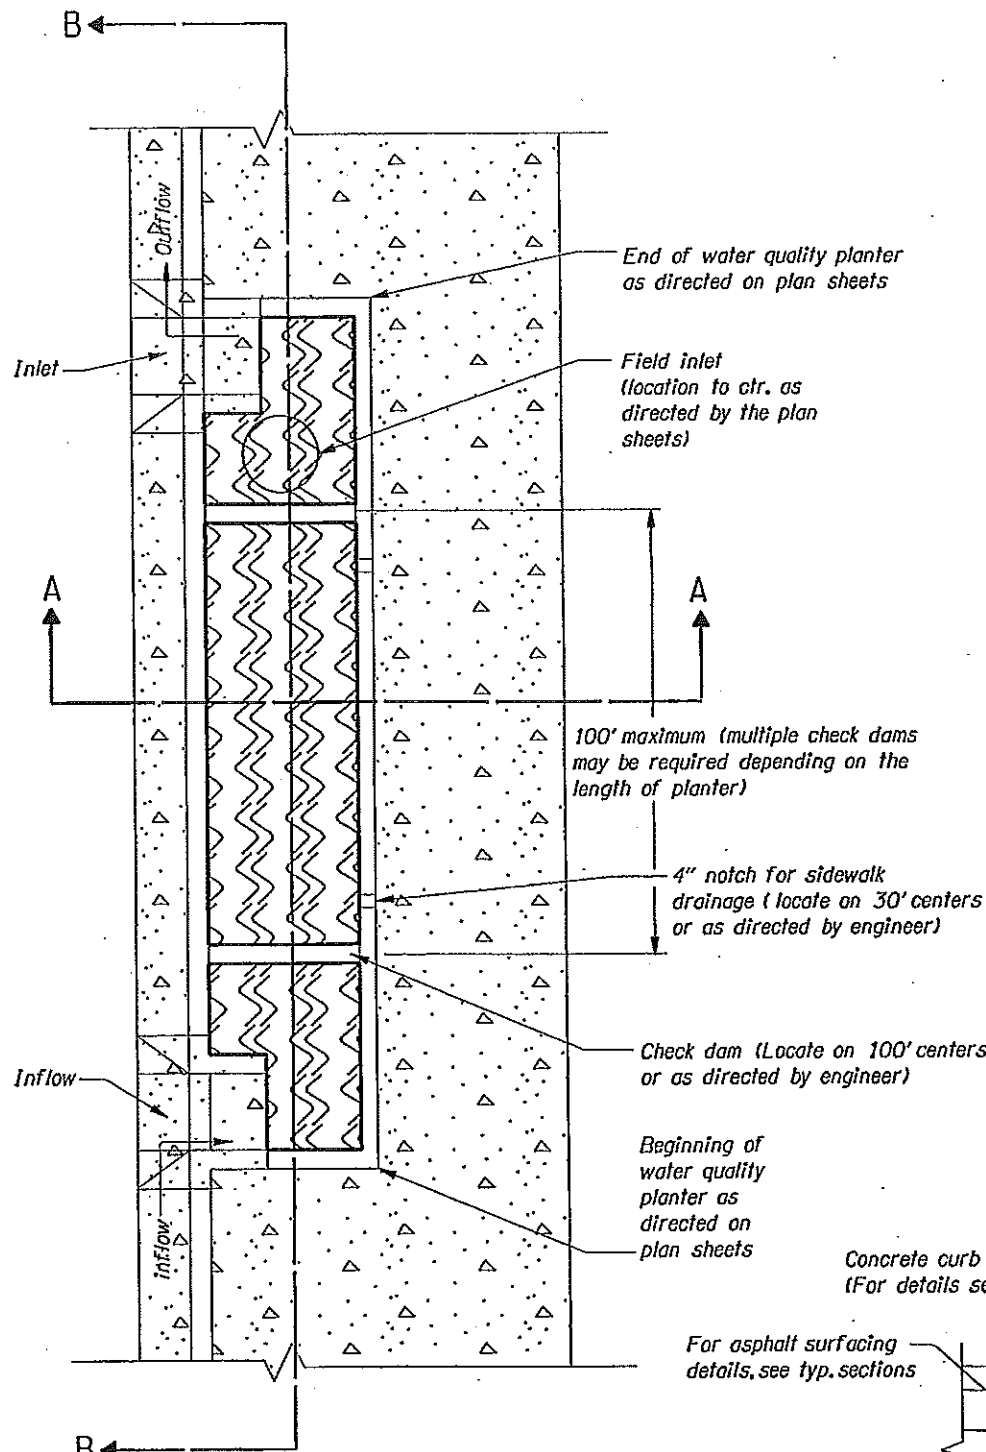

SECTION B-B STORM WATER PLANTER

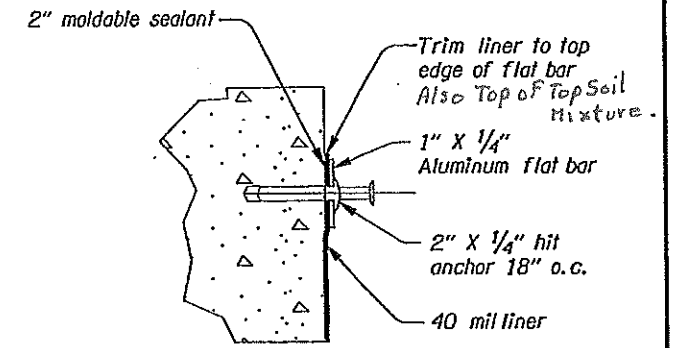


LINER ATTACHMENT

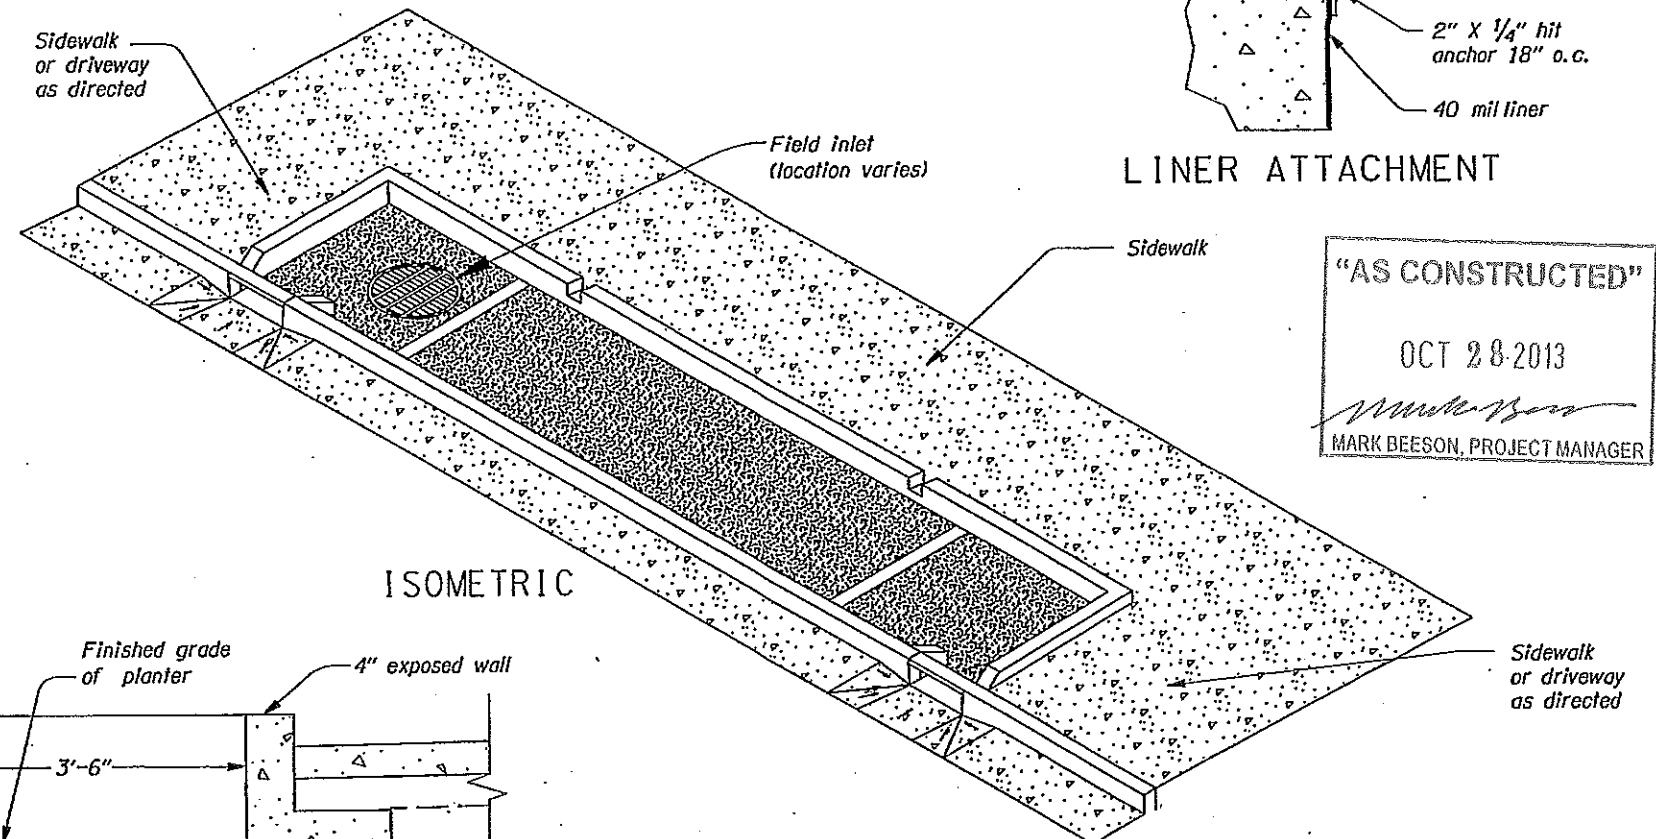


ISOMETRIC

"AS CONSTRUCTED"
 OCT 28 2013
 MARK BEESON, PROJECT MANAGER


STORM WATER PLANTER DETAIL

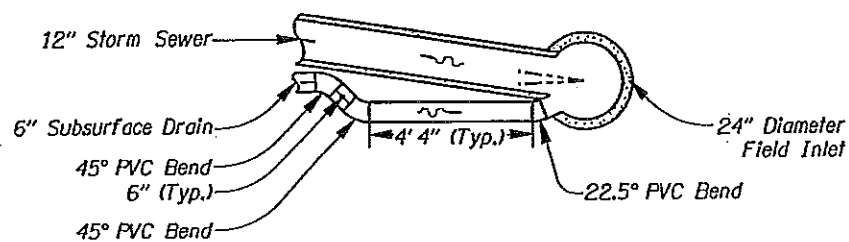






ACUTE ANGLE PIPE CONNECTION DETAIL (As Required)

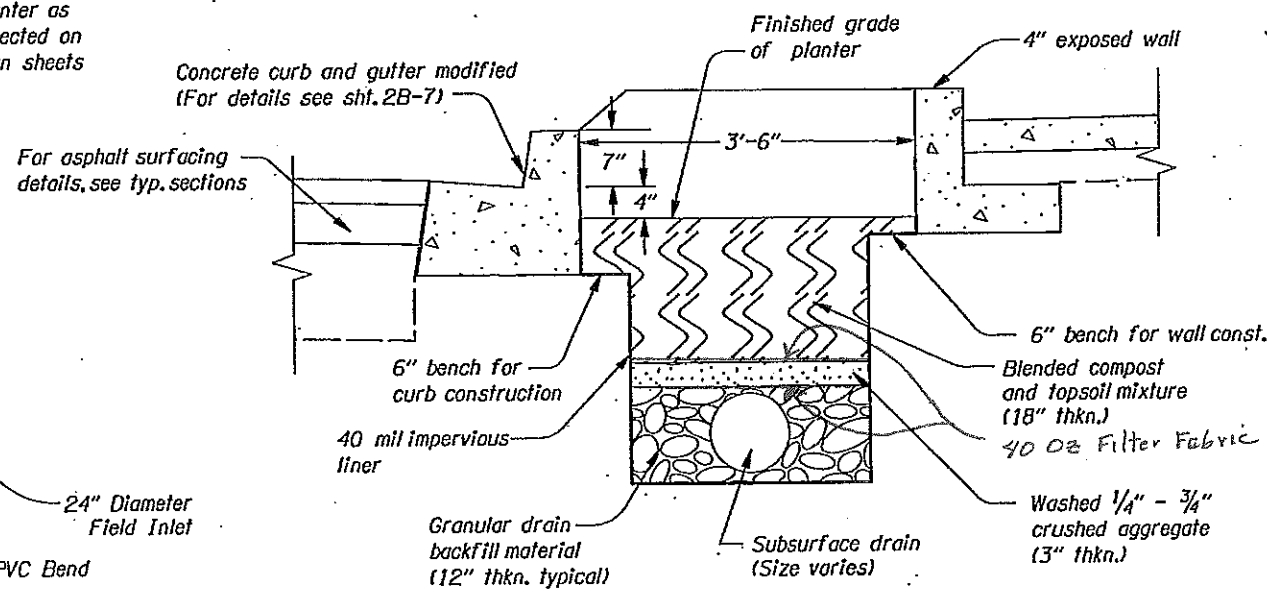

SECTION A-A STORM WATER PLANTER

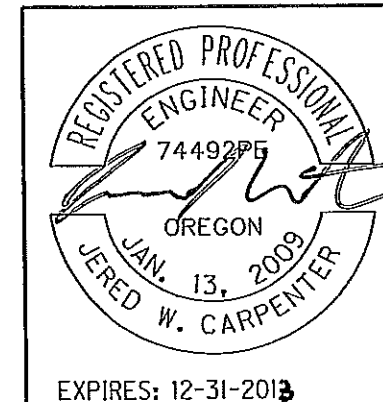


OREGON DEPARTMENT OF TRANSPORTATION	
REGION 1 - GEO/HYDRO/HAZMAT UNIT	
US 30 BYPASS: NE 122ND - M.P. 13.54 SEC. NORTHEAST PORTLAND HIGHWAY MULTNOMAH COUNTY	
Reviewed By - Ed Foltyn Designed By - Jered Carpenter Drafted By - Billy Shafer	
DETAILS	SHEET NO. 2B

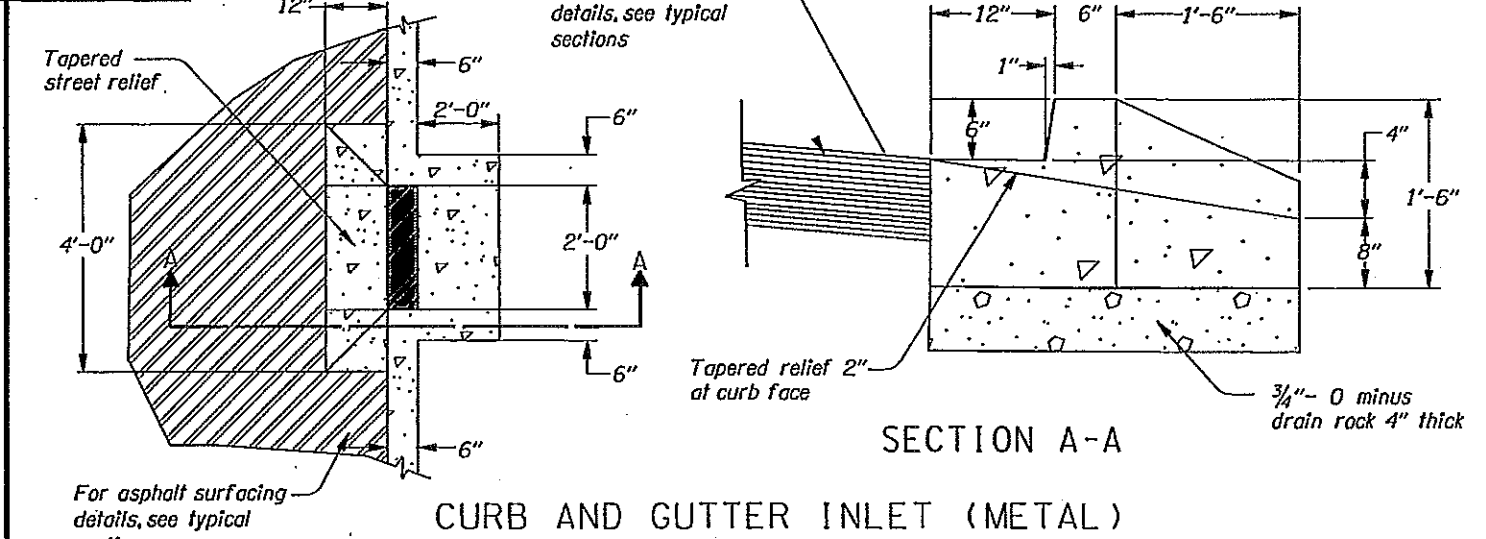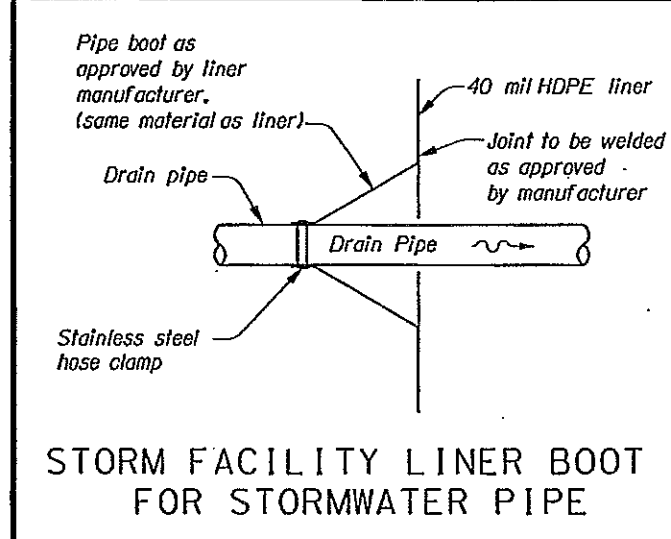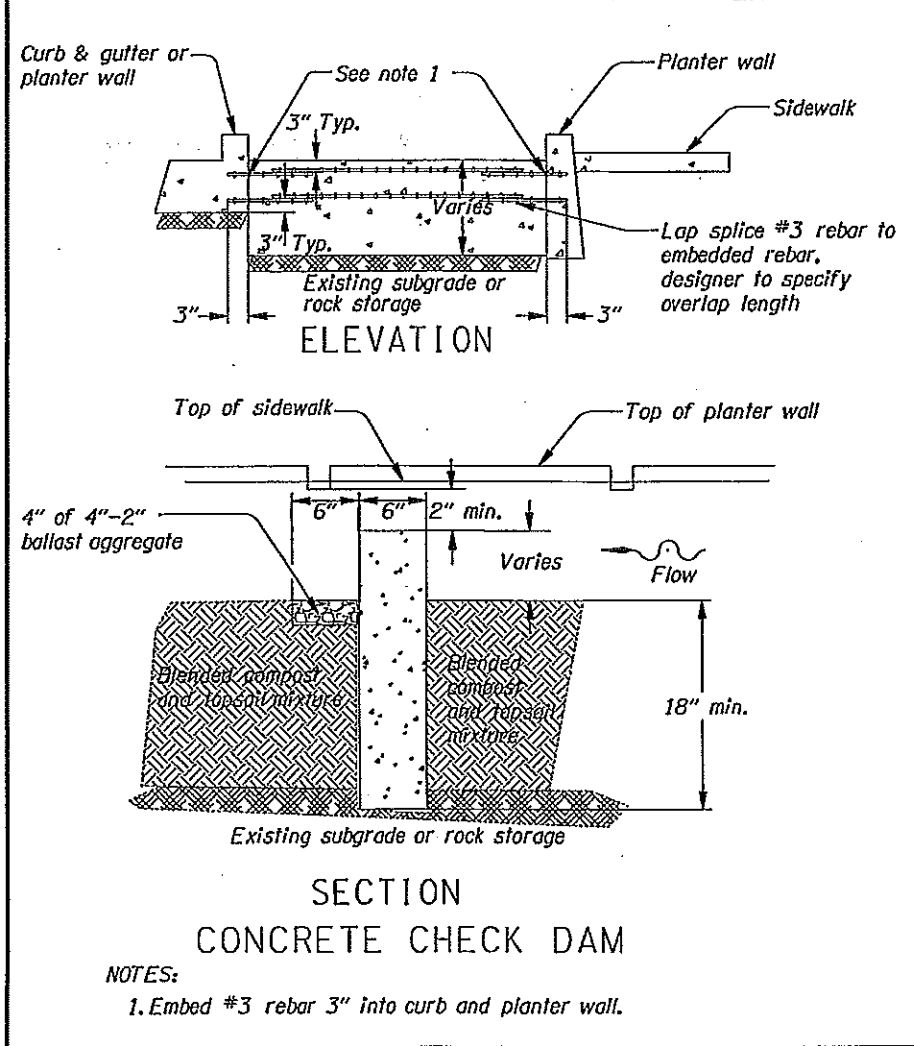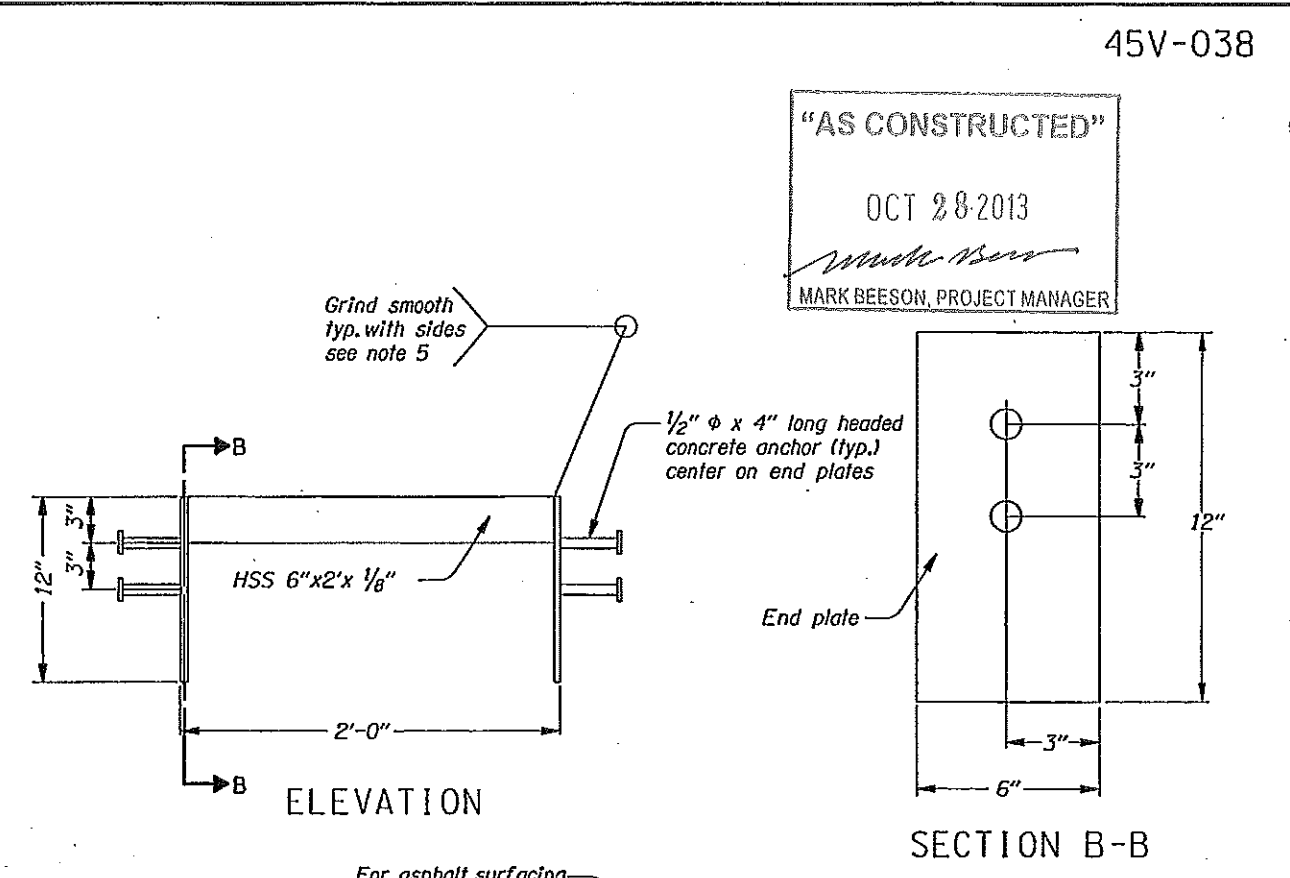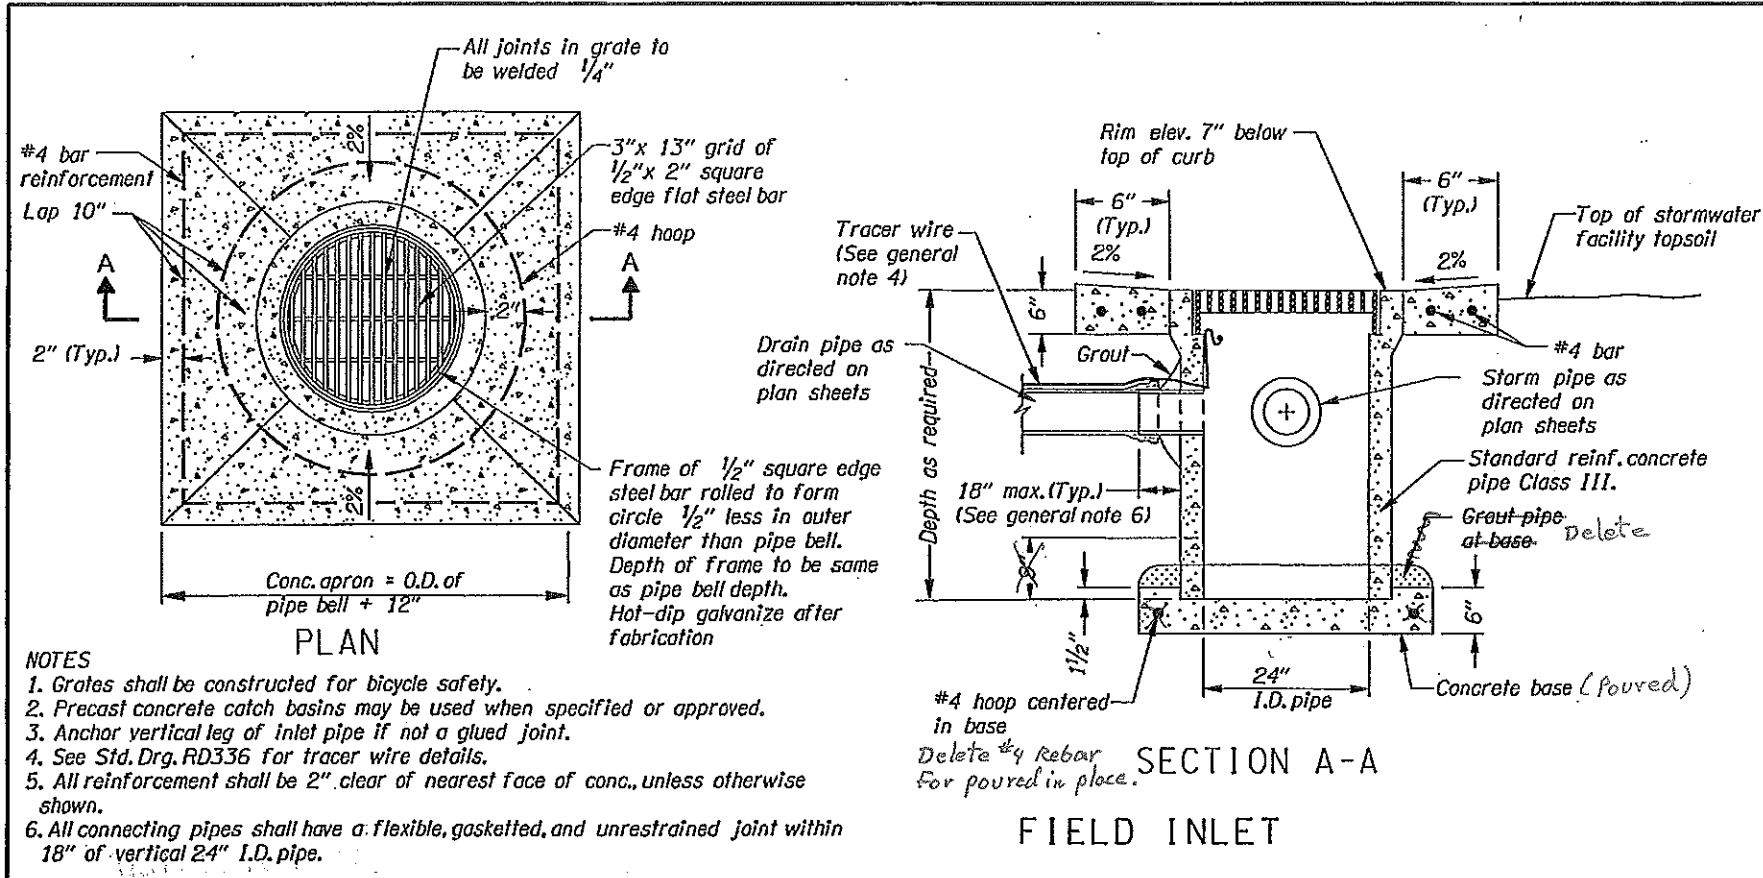

Notes:


1. Headed concrete anchors shall meet the requirements of ASTM A-10B.
2. HSS 6" X 2" X 1/8" shall meet the requirements of ASTM A-500 Grade B.
3. End plates shall meet the requirements of ASTM A-36.
4. Entire assembly shall be hot dip galvanized in accordance with ASTM A-123.
5. Single Bevel groove weld.

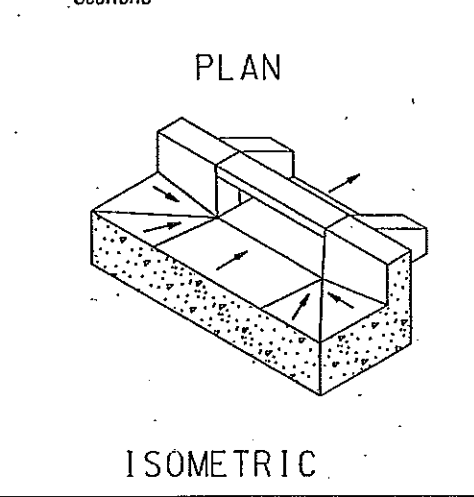

REGISTERED PROFESSIONAL ENGINEER
 74492PE
 OREGON
 JAN. 13, 2009
 JERED W. CARPENTER
 EXPIRES: 12-31-2013

OREGON DEPARTMENT OF TRANSPORTATION	
REGION 1 - GEO/HYDRO/HAZMAT UNIT	
US 30 BYPASS: NE 122ND - M.P. 13.54 SEC. NORTHEAST PORTLAND HIGHWAY MULTNOMAH COUNTY	
Reviewed By - Ed Foltyn Designed By - Jared Carpenter Drafted By - Billy Shafer	
DETAILS	SHEET NO. 2B-2

BEGINNING OF PROJECT
STA. "RW" 112+77.29 (M.P. 12.45)

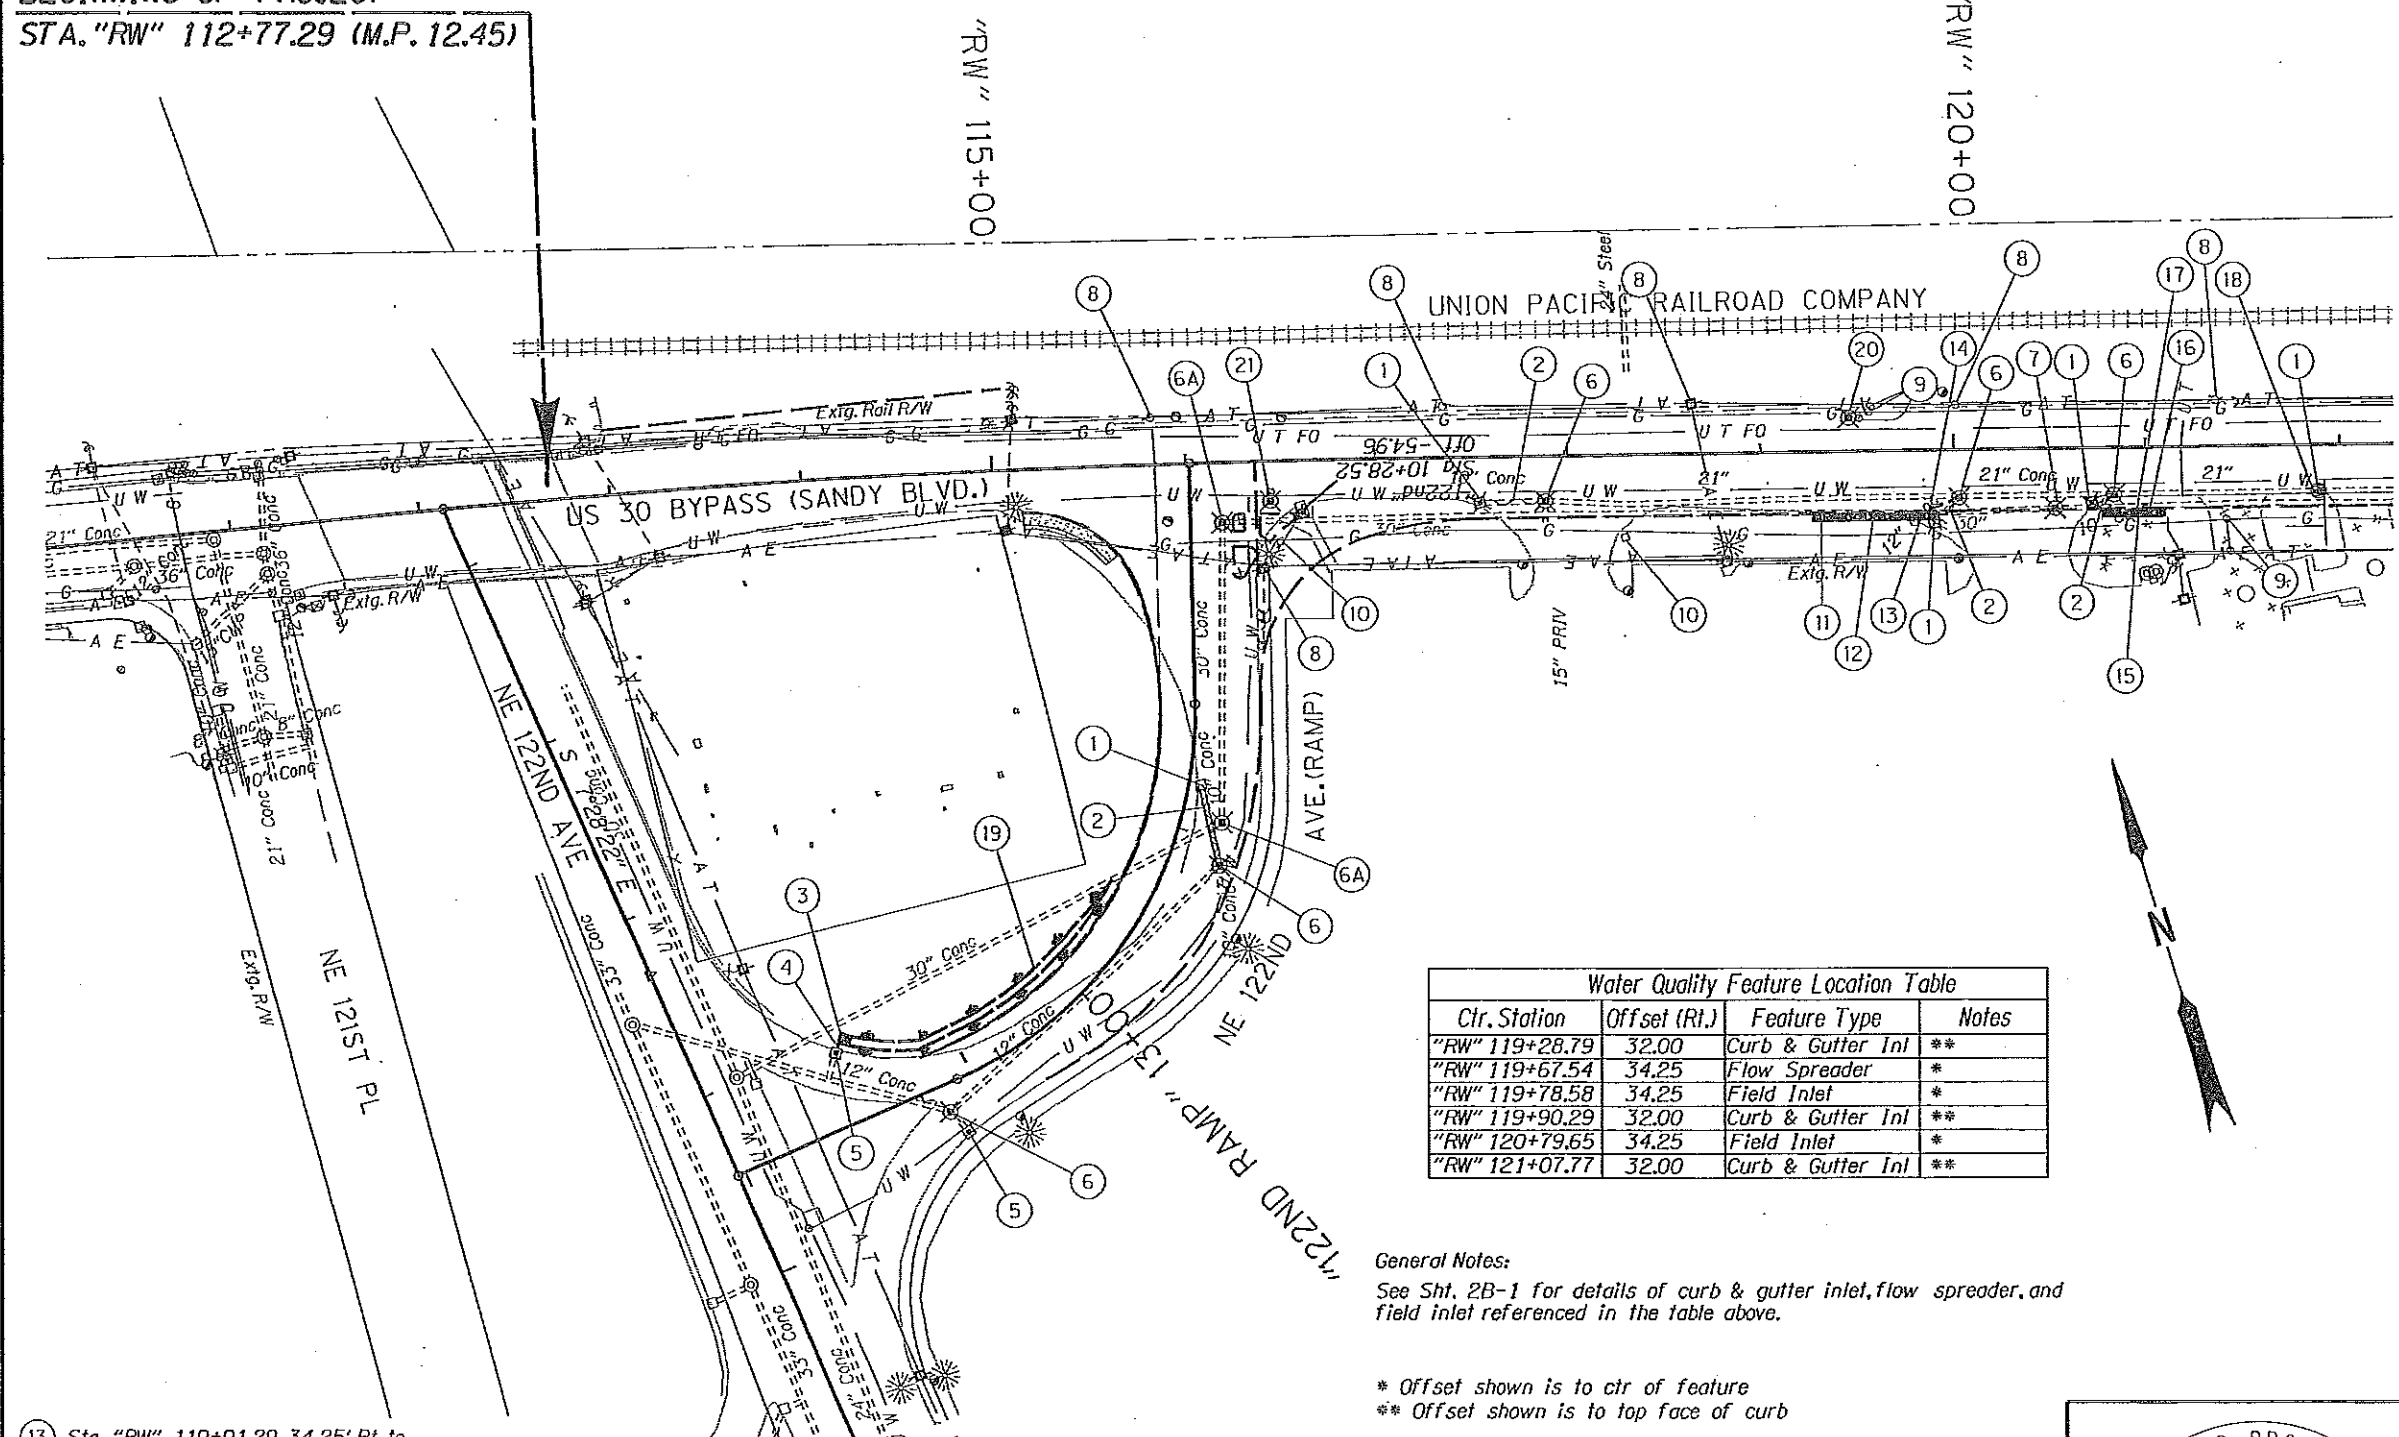

- ① Remove Inlet - 5
- ② Abandon pipe - 108'
- ③ Sta. "122nd" 14+26.48, 43.86' Rt. Const. Type "D" inlet (See dwg. no. RD370)
- ④ Sta. "122nd Ramp" 14+26.48, 43.86' Rt. to Sta. "122nd Ramp" 14+31.57, 37.68' Rt. Inst. 12" sewer pipe - 8" Ø, 10' depth Connect to extg. inlet
- ⑤ Adjust inlet - 2
- ⑥ Minor adjust manhole - 5 (See dwg. no. RD360)
- ⑥A Minor adjust manhole - 2 (By others)
- ⑦ Relocate sanitary manhole (By others)
- ⑧ Relocate utility poles - 6 (By others)
- ⑨ Adjust gas valve box - 5
- ⑩ Relocate riser - 2 (By others)
- ⑪ Sta. "RW" 119+27.29 to Sta. "RW" 119+91.79 Const. water quality planter strip - 28.7 sq. yds. (Drainage facility ID# D00580) (For details, see shts. 2B & 2B-2)
- ⑫ Sta. "RW" 119+27.80, 34.00' Rt. to Sta. "RW" 119+78.58, 34.25' Rt. Inst. 6" drain pipe - 51' 5' depth (For details see shts. 2B & 2B-2)

Clr. Station	Offset (Rt.)	Feature Type	Notes
"RW" 119+28.79	32.00	Curb & Gutter Inl	**
"RW" 119+67.54	34.25	Flow Spreader	*
"RW" 119+78.58	34.25	Field Inlet	*
"RW" 119+90.29	32.00	Curb & Gutter Inl	**
"RW" 120+79.65	34.25	Field Inlet	*
"RW" 121+07.77	32.00	Curb & Gutter Inl	**

General Notes:
 See Sht. 2B-1 for details of curb & gutter inlet, flow spreader, and field inlet referenced in the table above.

* Offset shown is to ctr of feature
 ** Offset shown is to top face of curb

Abandoned pipe shown thus

- ⑬ Sta. "RW" 119+91.29, 34.25' Rt. to Sta. "RW" 119+78.58, 34.25' Rt Inst. 6" drain pipe - 13' 5' depth (For details see shts. 2B & 2B-2)
- ⑭ Sta. "RW" 119+78.58, 34.25' Rt. to Sta. "RW" 120+02.68, 25.08' Rt Inst. 12" sew pipe - 26' 5' depth connect to extg. manhole
- ⑮ Sta. "RW" 120+77.40 to Sta. "RW" 121+09.27 Const. water quality planter strip - 14.2 sq. yds. (Drainage facility ID# D00581) (For details, see shts. 2B & 2B-2)

- ⑯ Sta. "RW" 120+79.65, 34.25' Rt. to Sta. "RW" 121+08.77, 34.25' Rt Inst. 6" drain pipe - 29' (For details see shts. 2B & 2B-2)
- ⑰ Sta. "RW" 120+79.65, 34.25' Rt. to Sta. "RW" 120+83.28, 24.63' Rt Inst. 12" sew pipe - 10' 10' depth Connect to extg. manhole
- ⑱ Sta. "RW" 121+89.02, 24.07' Rt. Const. manhole over extg. storm sewer (See dwg. no. RD336)

- ⑲ Const. bio-swale - 173 ft. Install stormwater treatment markers (Drainage facility ID# D00579) (For details see sht. 2B-8 and RD399)
- ⑳ Minor adjust communication manhole
- ㉑ Relocate waterline access vault (By others)

"AS CONSTRUCTED"
 OCT 28 2013

 MARK BEESON, PROJECT MANAGER

REGISTERED PROFESSIONAL ENGINEER
 74492PE

 OREGON
 JAN. 13, 2009
 JERED W. CARPENTER
 EXPIRES: 12-31-2013

OREGON DEPARTMENT OF TRANSPORTATION


REGION 1 - Geo/Hydro/HazMat Unit

US30 BYPASS: NE 122ND - M.P. 13.54 SEC.
 NORTHEAST PORTLAND HIGHWAY
 MULTNOMAH COUNTY

Reviewed by - Ed Foltyn
 Designed by - Jered Carpenter
 Drafted by - Billy Shafer

DRAINAGE & UTILITIES

SHEET NO. 3A

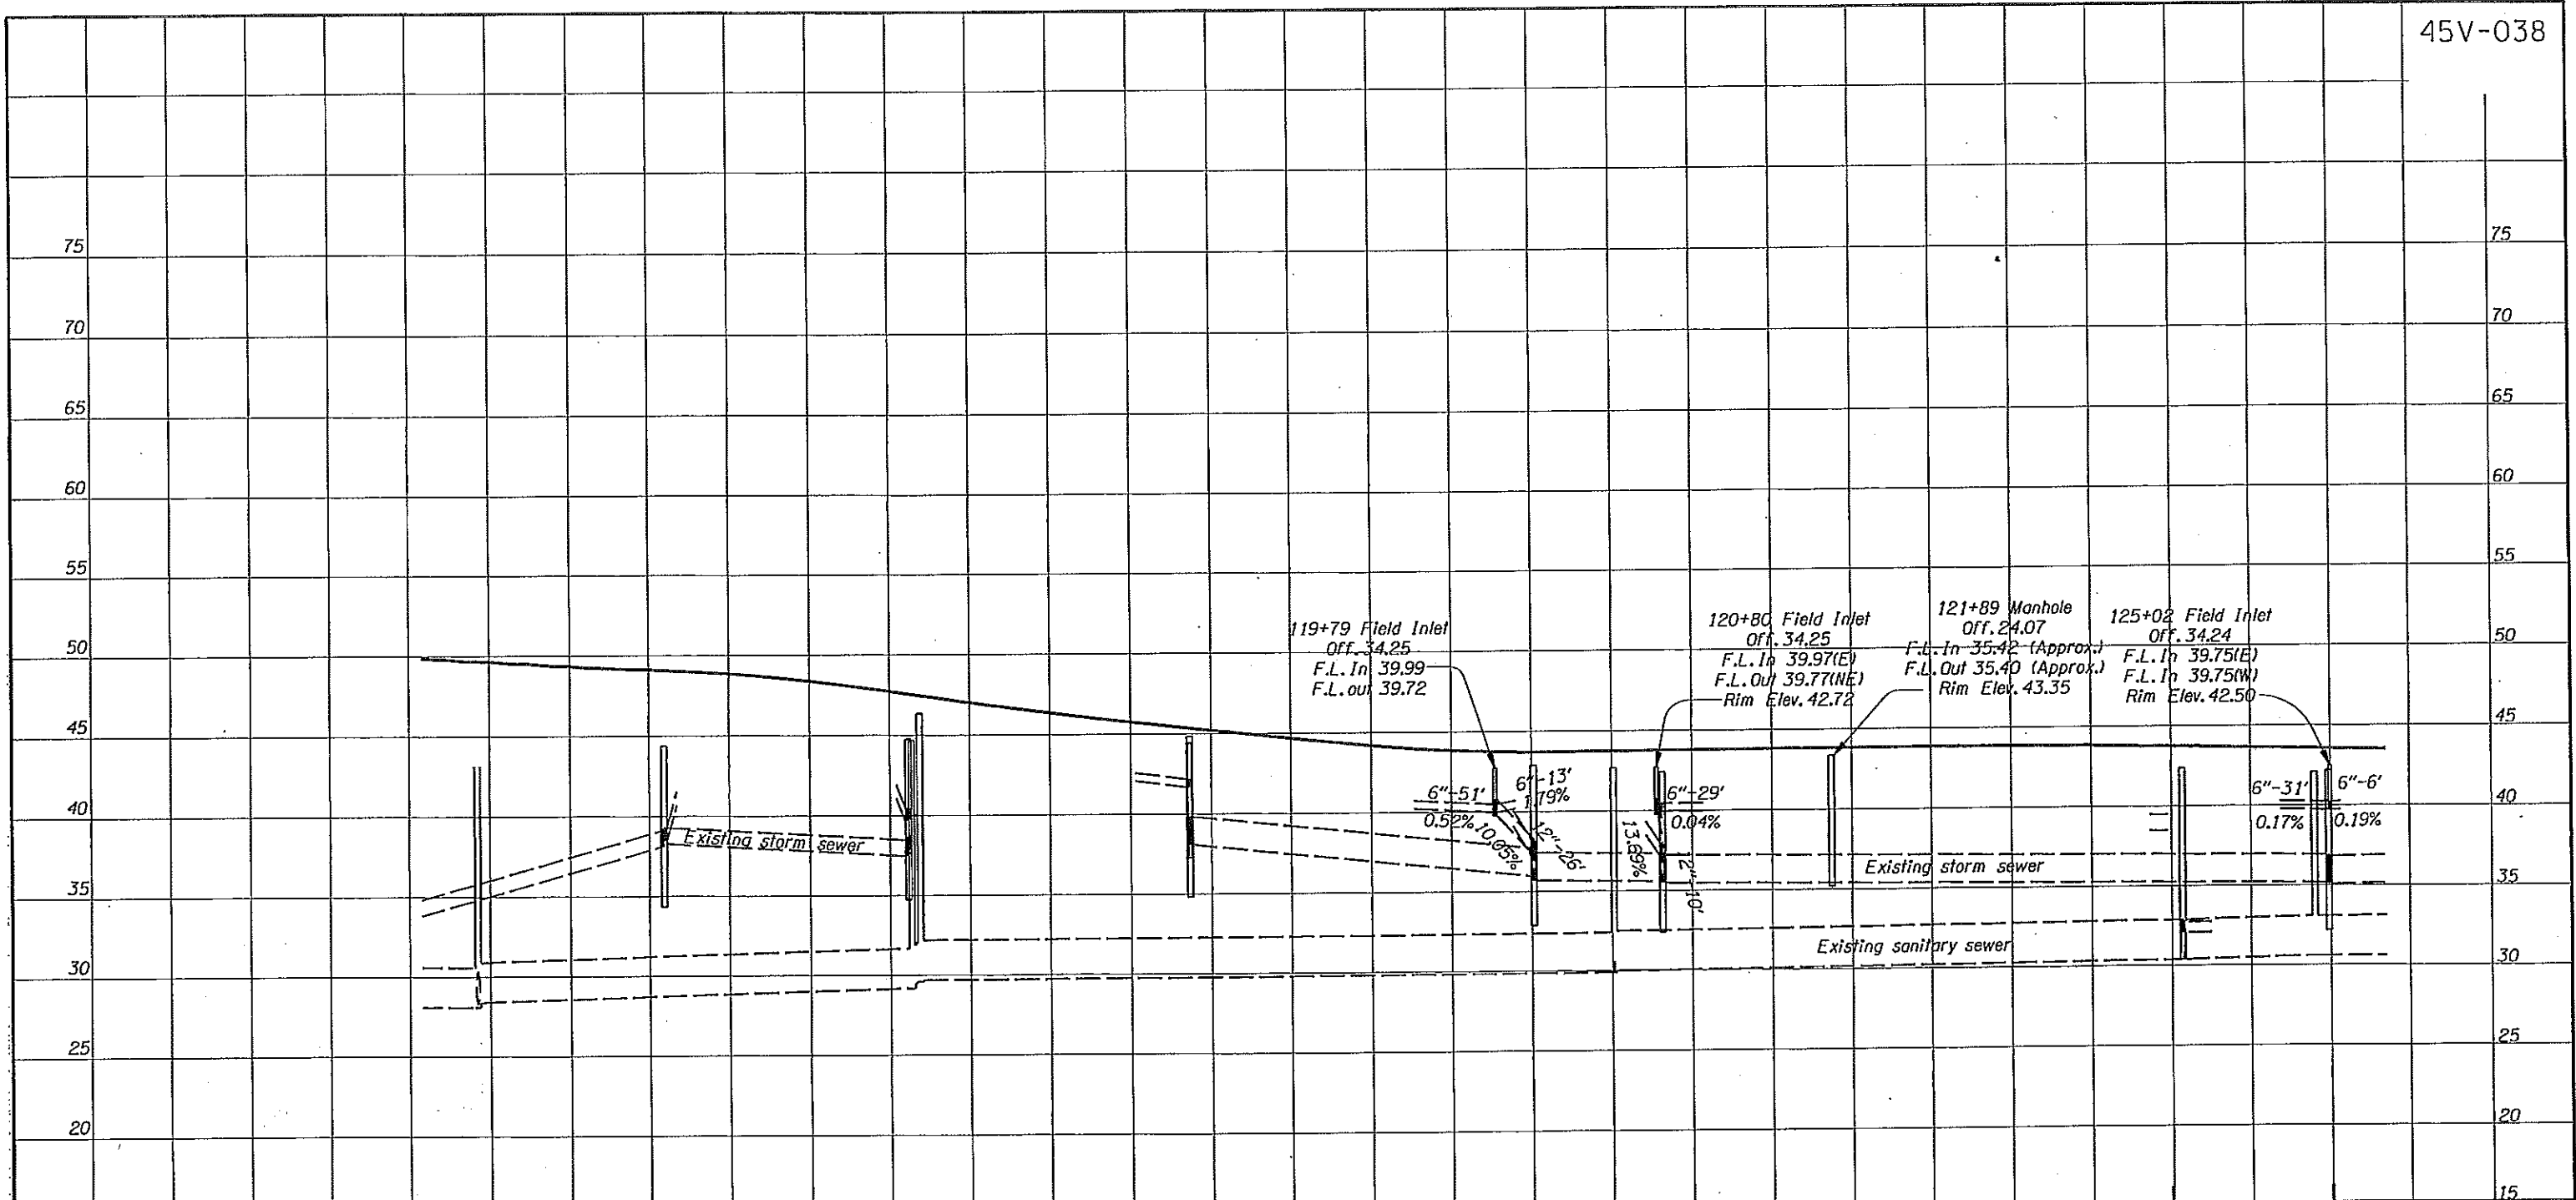

"AS CONSTRUCTED"


OCT 28 2013

Mark Beeson

MARK BEESON, PROJECT MANAGER

REGISTERED PROFESSIONAL ENGINEER
74492PE
OREGON
JAN. 13, 2009
JERED W. CARPENTER
EXPIRES: 12-31-2013

OREGON DEPARTMENT OF TRANSPORTATION	
REGION 1 - Geo/Hydro/HazMat Unit	
US30 BYPASS: NE 122ND - M.P. 13.54 SEC. NORTHEAST PORTLAND HIGHWAY MULTNOMAH COUNTY	
Reviewed by - Ed Foltyn Designed by - Jared Carpenter Drafted by - Billy Shafer	
DRAINAGE & UTILITIES	SHEET NO. 3A-2

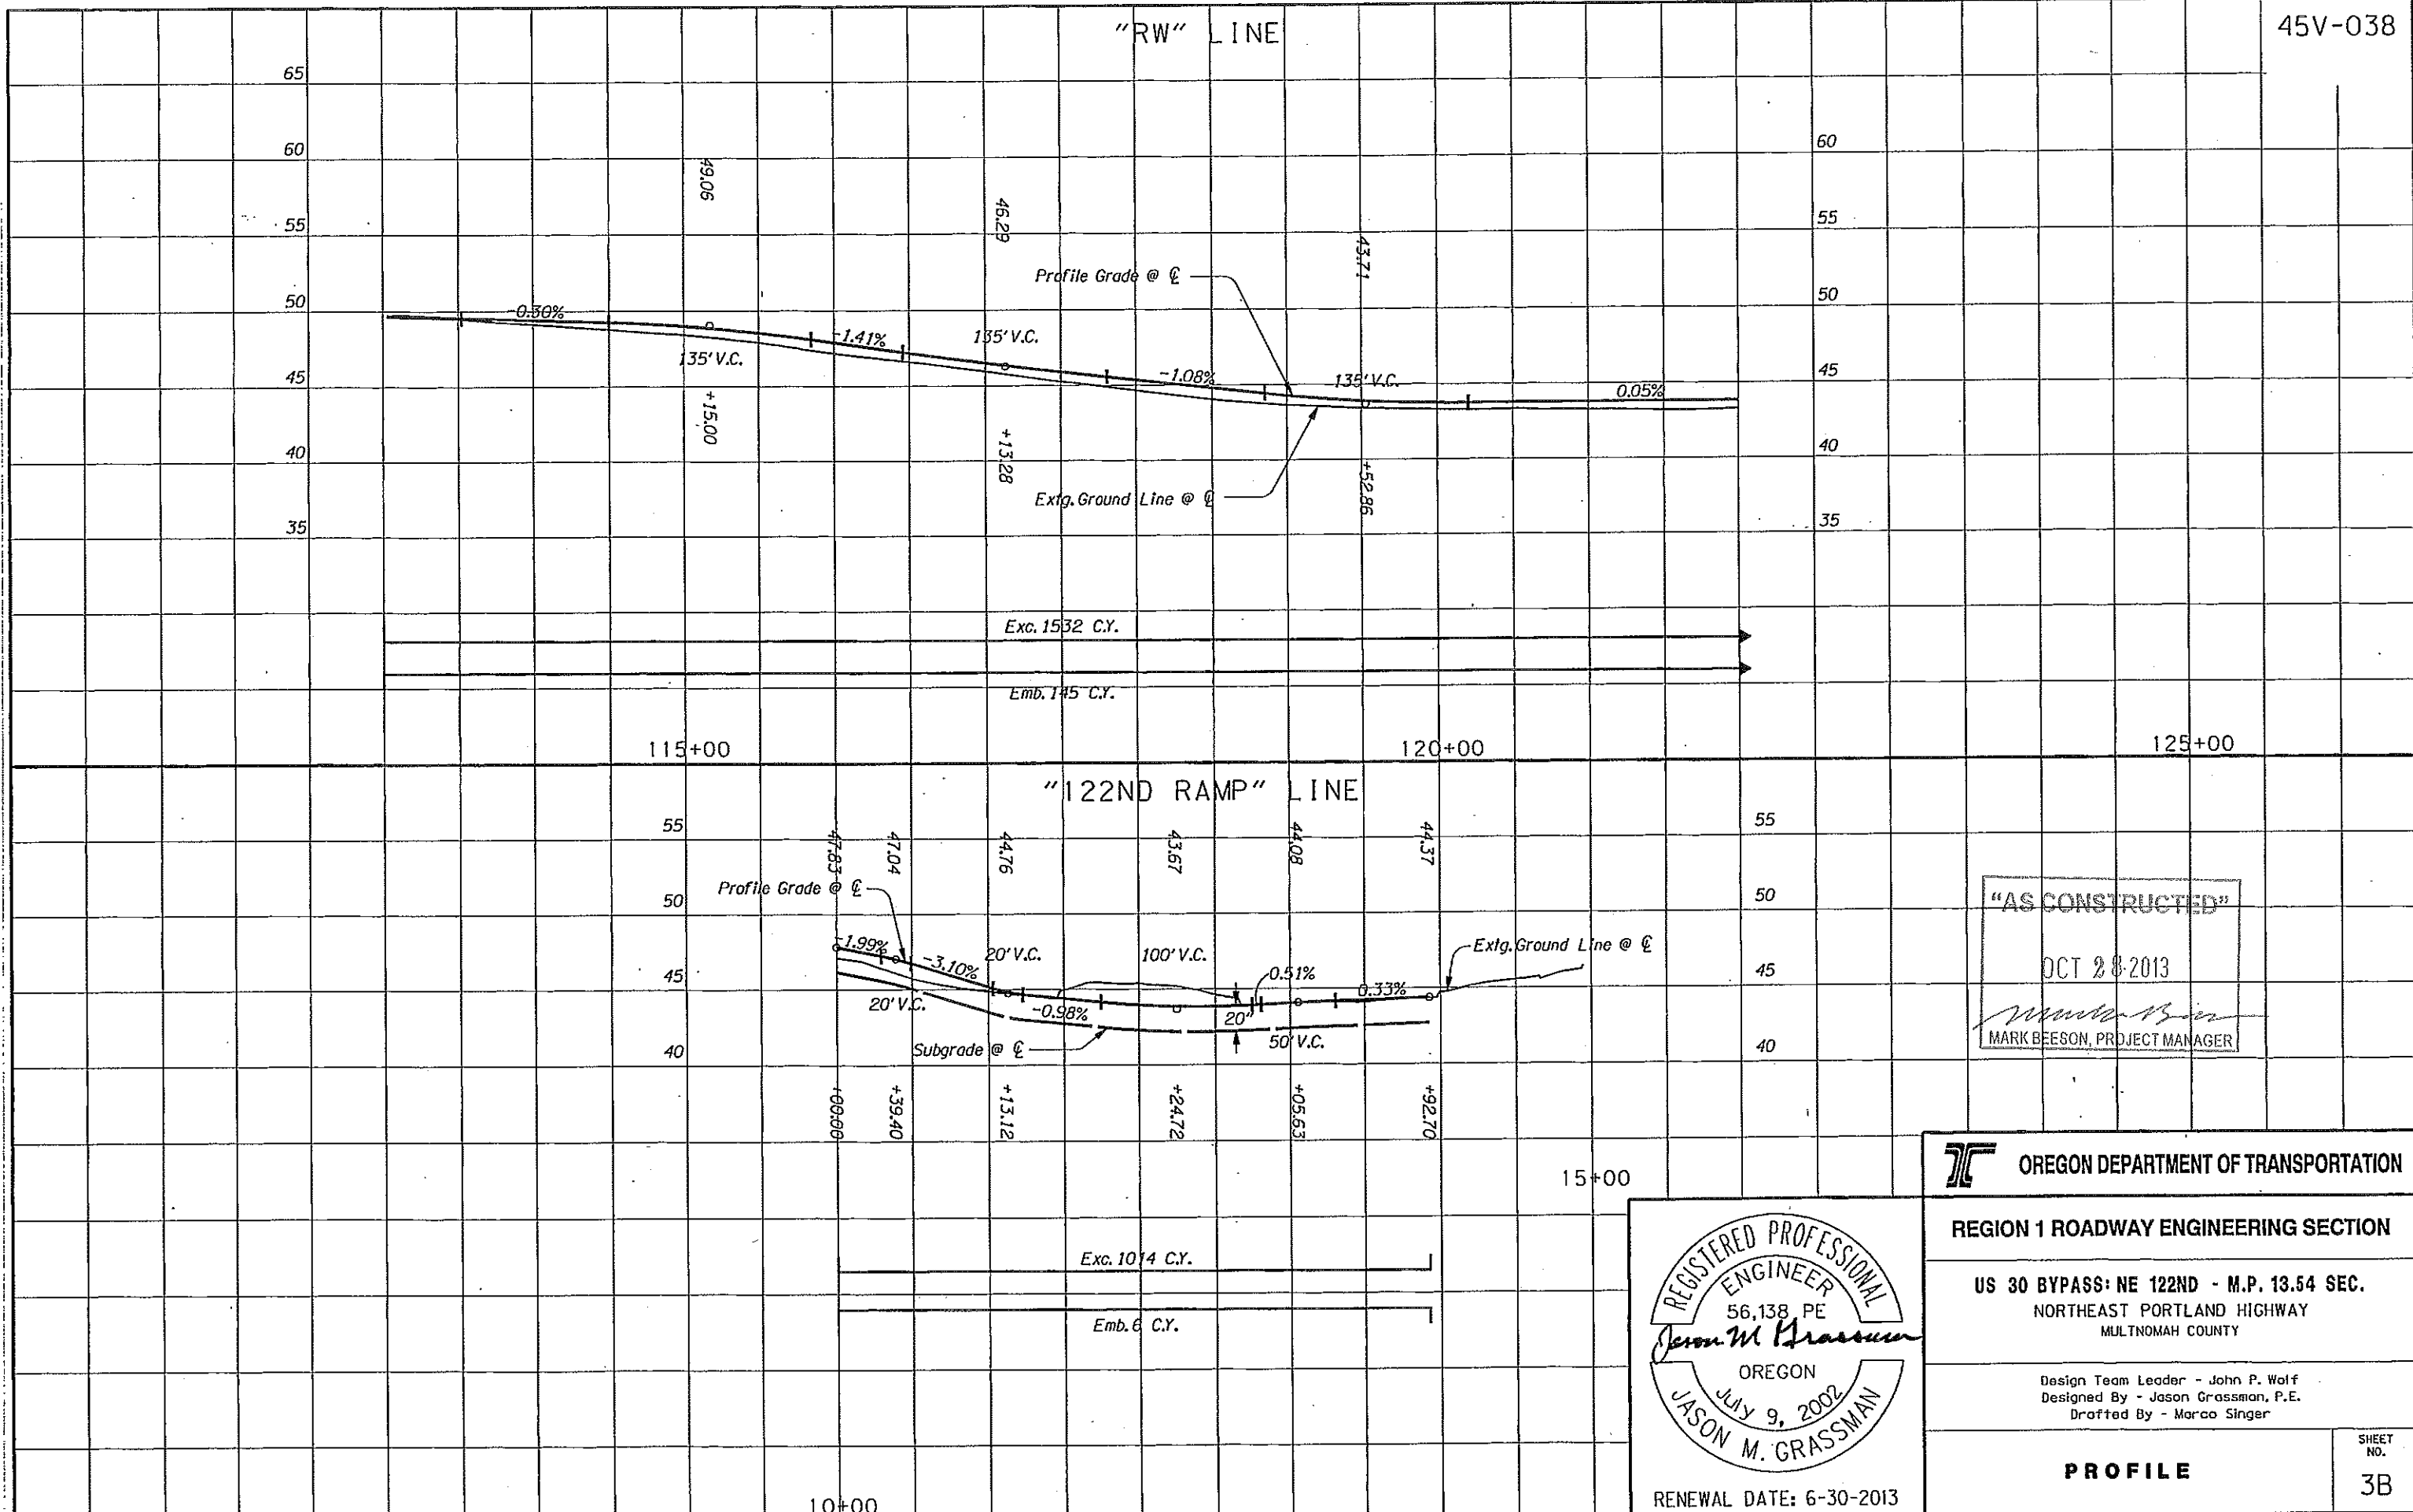

"AS CONSTRUCTED"

OCT 28 2013

Mark Beeson
MARK BEESON, PROJECT MANAGER

OREGON DEPARTMENT OF TRANSPORTATION

REGION 1 ROADWAY ENGINEERING SECTION

US 30 BYPASS: NE 122ND - M.P. 13.54 SEC.
NORTHEAST PORTLAND HIGHWAY
MULTNOMAH COUNTY

Design Team Leader - John P. Wolf
Designed By - Jason Grassman, P.E.
Drafted By - Marco Singer

PROFILE


SHEET NO. **3B**

REGISTERED PROFESSIONAL ENGINEER
56,138 PE
Jason M. Grassman
OREGON
JULY 9, 2002
JASON M. GRASSMAN

RENEWAL DATE: 6-30-2013

"125TH" LINE

45V-038

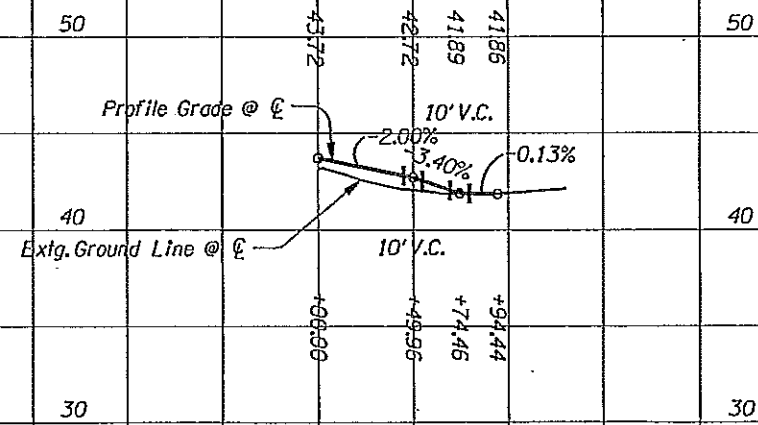

"AS CONSTRUCTED"

OCT 28 2013


Mark Beeson
MARK BEESON, PROJECT MANAGER

OREGON DEPARTMENT OF TRANSPORTATION

REGION 1 ROADWAY ENGINEERING SECTION

US 30 BYPASS: NE 122ND - M.P. 13.54 SEC.
NORTHEAST PORTLAND HIGHWAY
MULTNOMAH COUNTY


Design Team Leader - John P. Wolf
Designed By - Jason Grassman, P.E.
Drafted By - Marco Singer

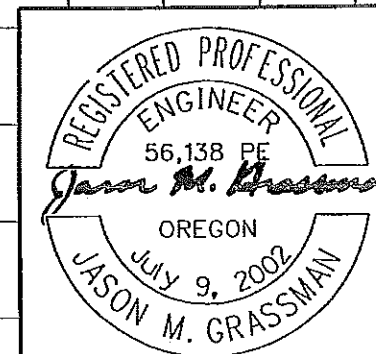


RENEWAL DATE: 6-30-2013

PROFILE

SHEET NO.
4B

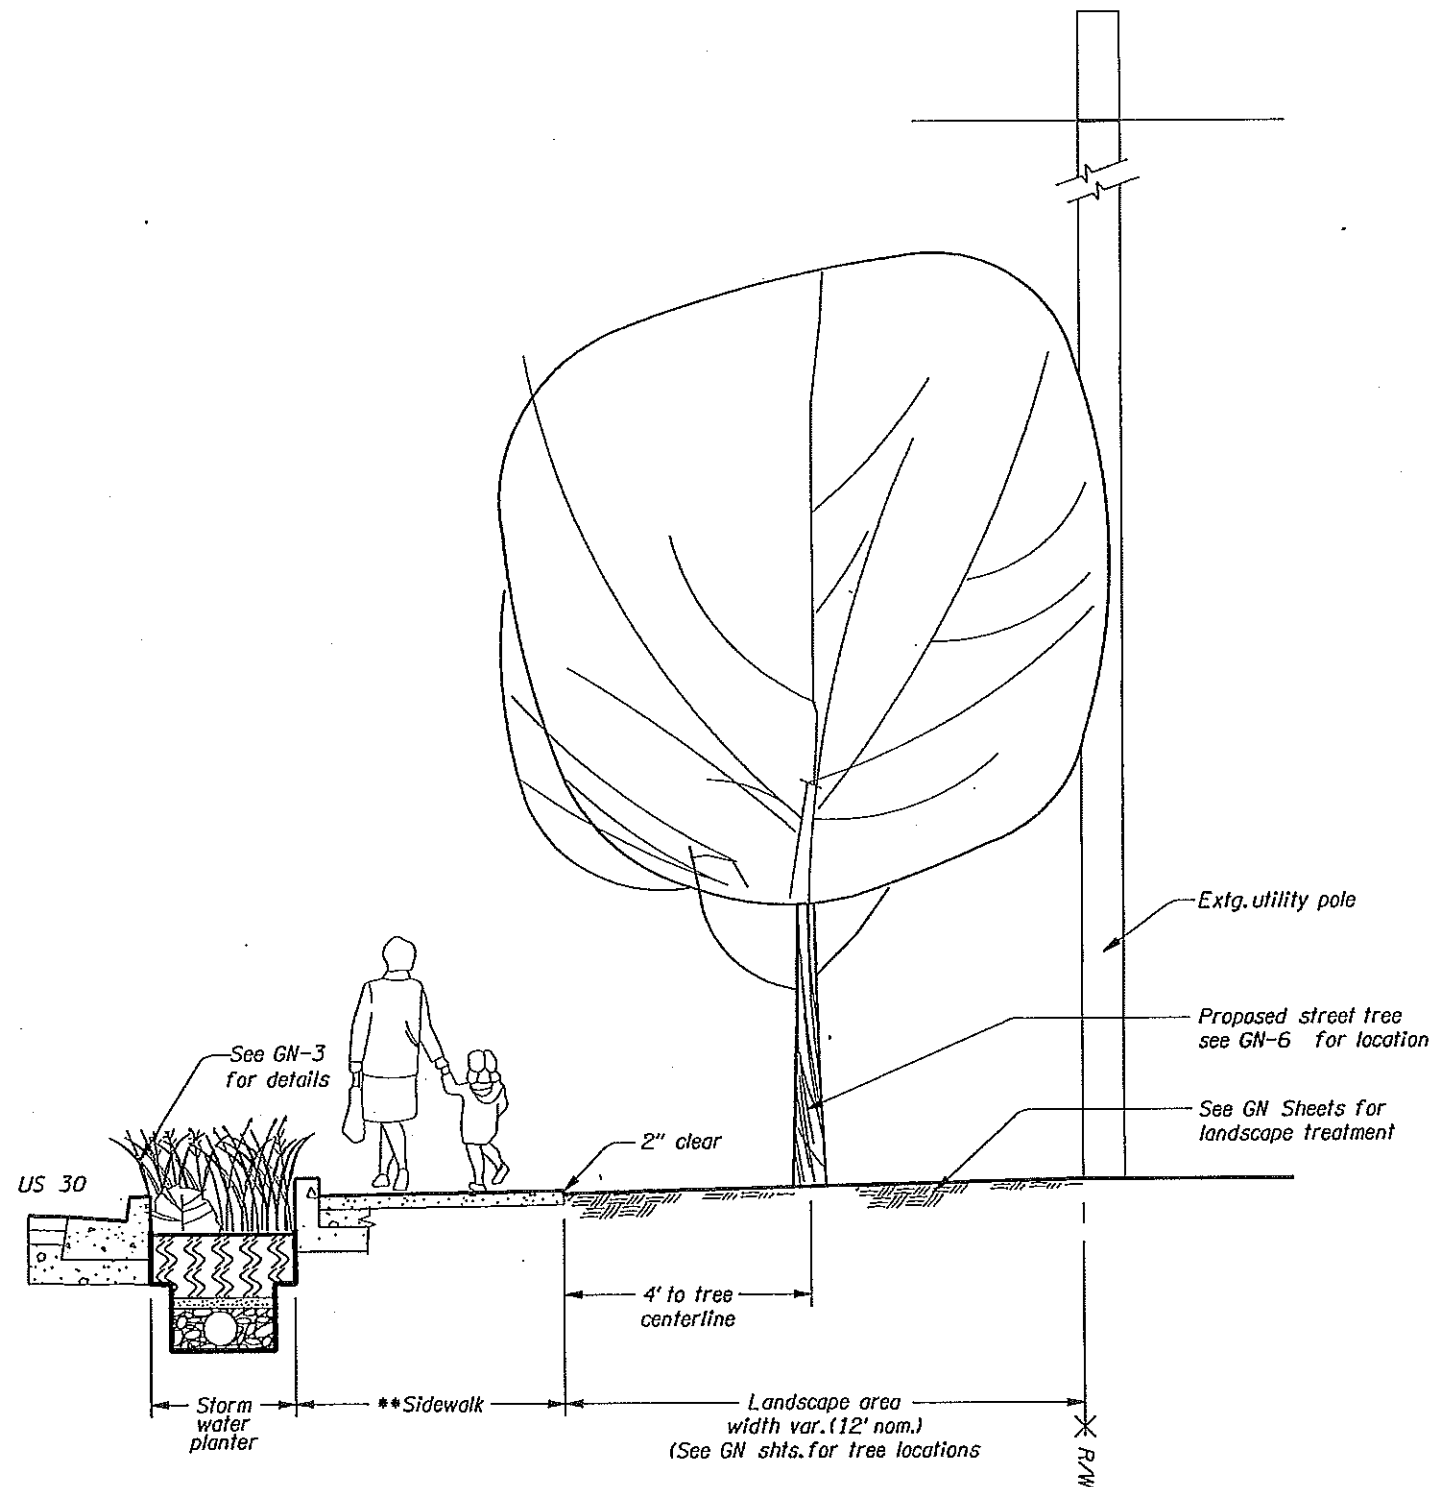

1 STORM WATER PLANTER AND TREE PLANTING SECTION
Not to scale

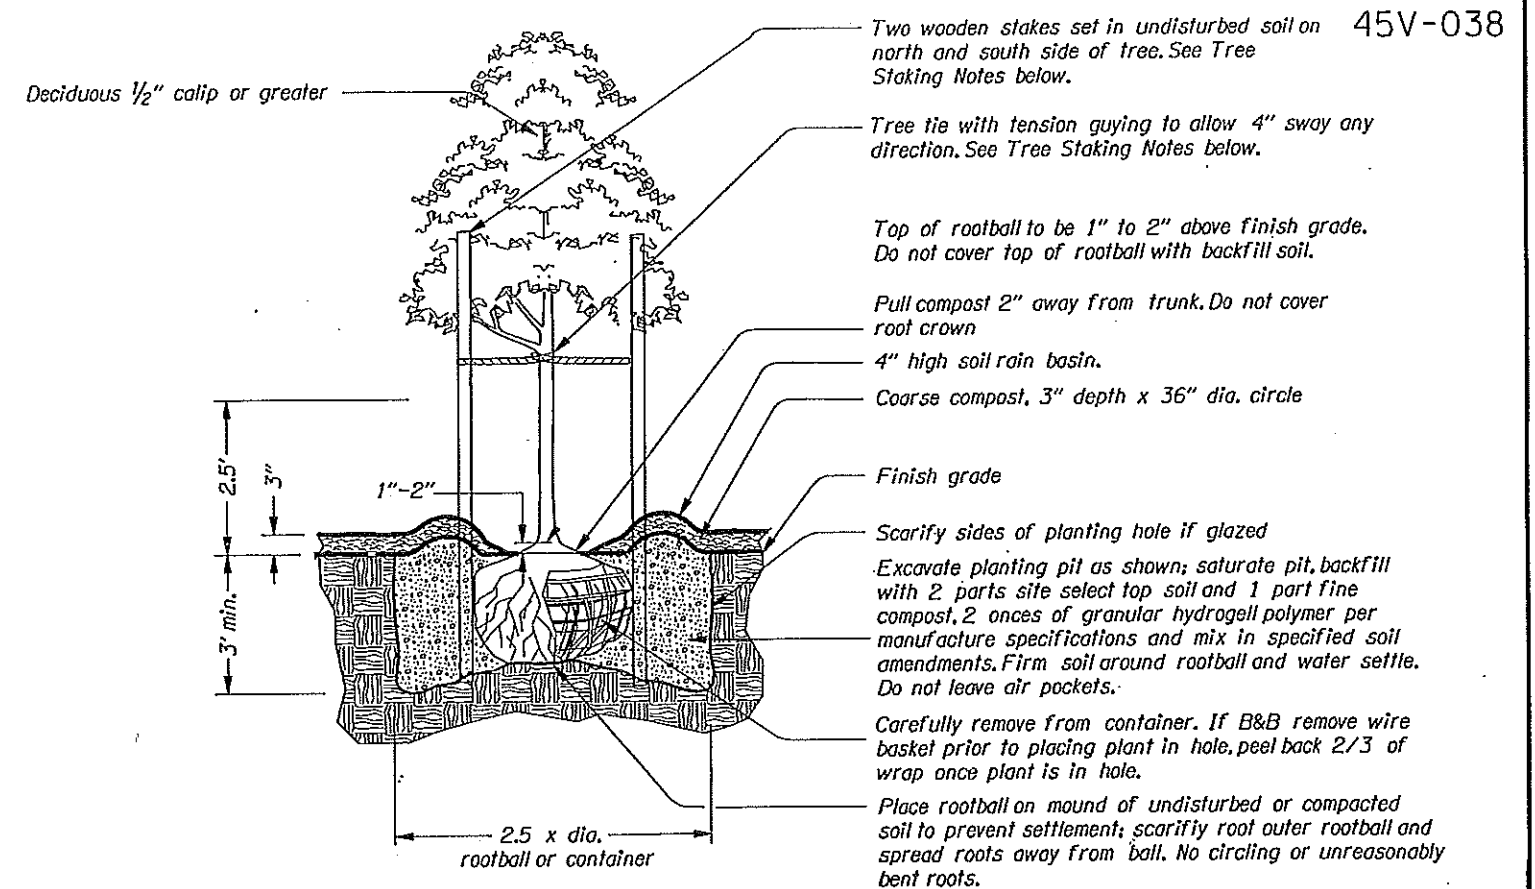

TREE STAKING NOTES:

1) Tree ties to be either:
Rigid guy system as manufactured by Alpine Nursery, Boring Oregon. Galvanized wire to be approx. 1/8" thickness and 24" length. There is a plastic sleeve over portion that goes around tree. The wire tie is to go thru the wood stake and be securely fastened.
Plastic chain type, approx. 1" width by 1/8" depth where two stakes are required. Cross ties between stakes and wrap tie around tree. Fasten securely to stake.


2) Furnish tree stakes on all tree plantings. Stakes to be construction grade, rough sawn or finished Douglas Fir or Pine. Stain with approved green penetrating oil. Stake size is to be 1 1/2" x 1 1/2" by following lengths:
Trees 36" and shorter - Use one - 6' (approx.) stake
Trees taller than 36" - Use one - 8' (approx.) stake
Drive stakes vertically and at least 24" into undisturbed soil. Do not drive stakes thru root ball. Locate stakes to best resist prevailing winds.

2 STREET TREE PLANTING AND STAKING
Not to scale


"AS CONSTRUCTED"
OCT 28 2013
MARK BEESON, PROJECT MANAGER

REGISTERED
424
Magnus U. Bernhardt
OREGON
04/14/99
LANDSCAPE ARCHITECT


OREGON DEPARTMENT OF TRANSPORTATION	
REGION 1 ROADWAY ENGINEERING SECTION	
US 30 BYPASS: NE 122ND - M.P. 13.54 SEC. NORTHEAST PORTLAND HIGHWAY MULTNOMAH COUNTY	
Design Team Leader - Magnus Bernhardt Designed By - Magnus Bernhardt Drafted By - Marco Singer	
DETAILS	SHEET NO. GN-2

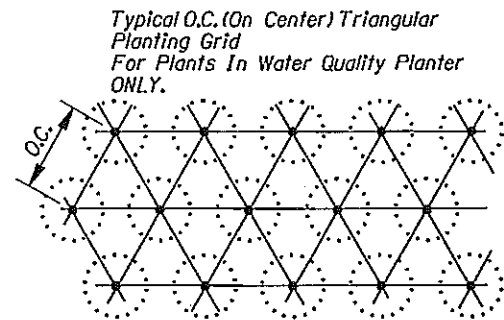


3 STORM WATER PLANT SPACING
Not to scale

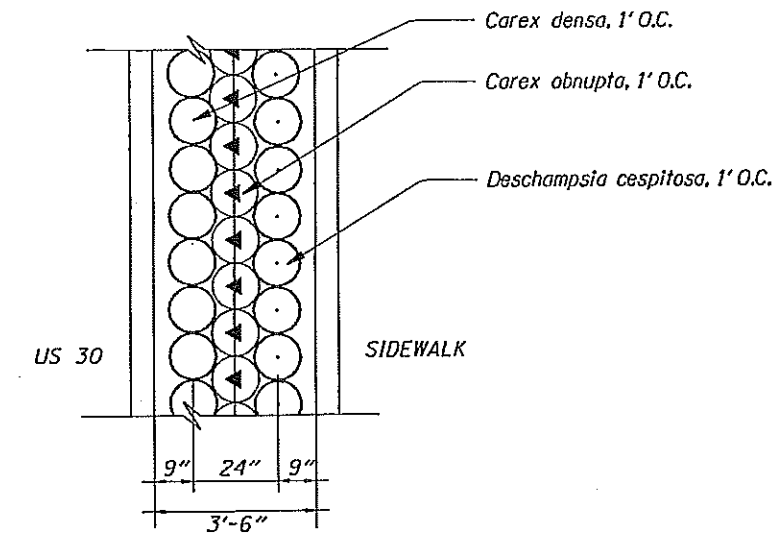

5 STORM WATER PLANTER PLANTING LAYOUT DETAIL
Plan layout Not to scale

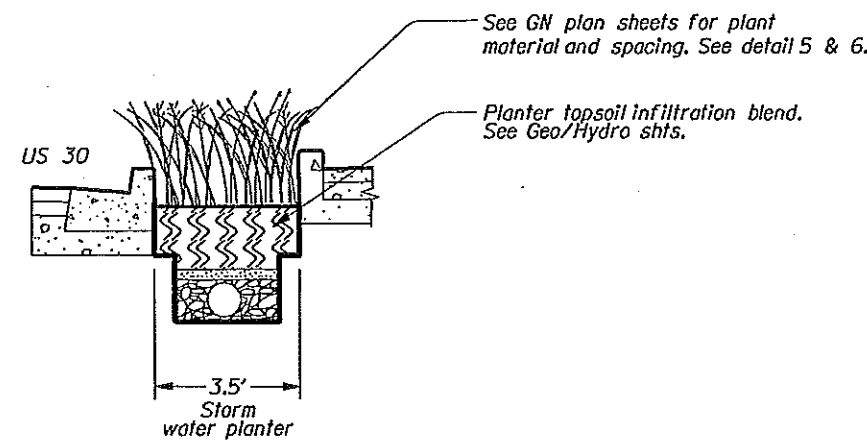


4 STORM WATER PLANTER PLANTING DETAIL
SECTION Not to scale

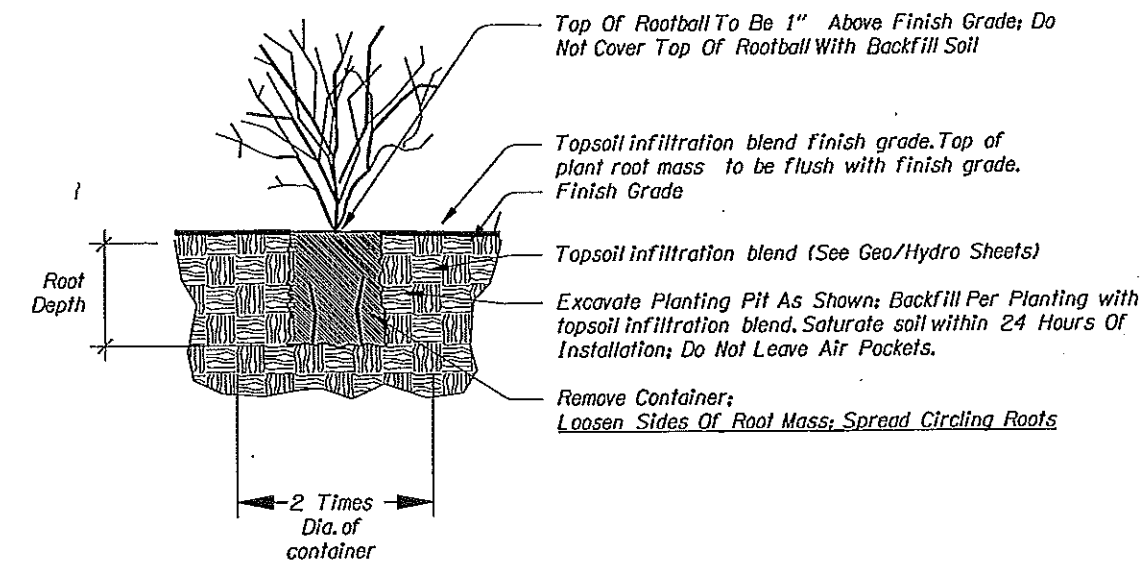


6 CONTAINER SHRUB PLANTING
Water Quality Planter Planting Not To Scale

"AS CONSTRUCTED"
OCT 28 2013
Mark Beeson
MARK BEESON, PROJECT MANAGER

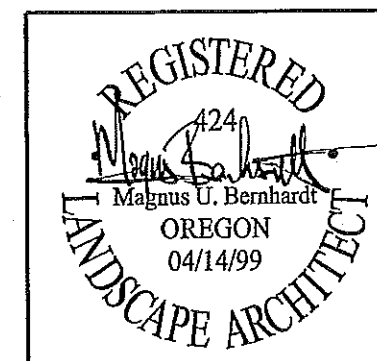

OREGON DEPARTMENT OF TRANSPORTATION	
REGION 1 ROADWAY ENGINEERING SECTION	
US 30 BYPASS: NE 122ND - M.P. 13.54 SEC. NORTHEAST PORTLAND HIGHWAY MULTNOMAH COUNTY	
Design Team Leader - Magnus Bernhardt Designed By - Magnus Bernhardt Drafted By - Marco Singer	
DETAILS	SHEET NO. GN-3

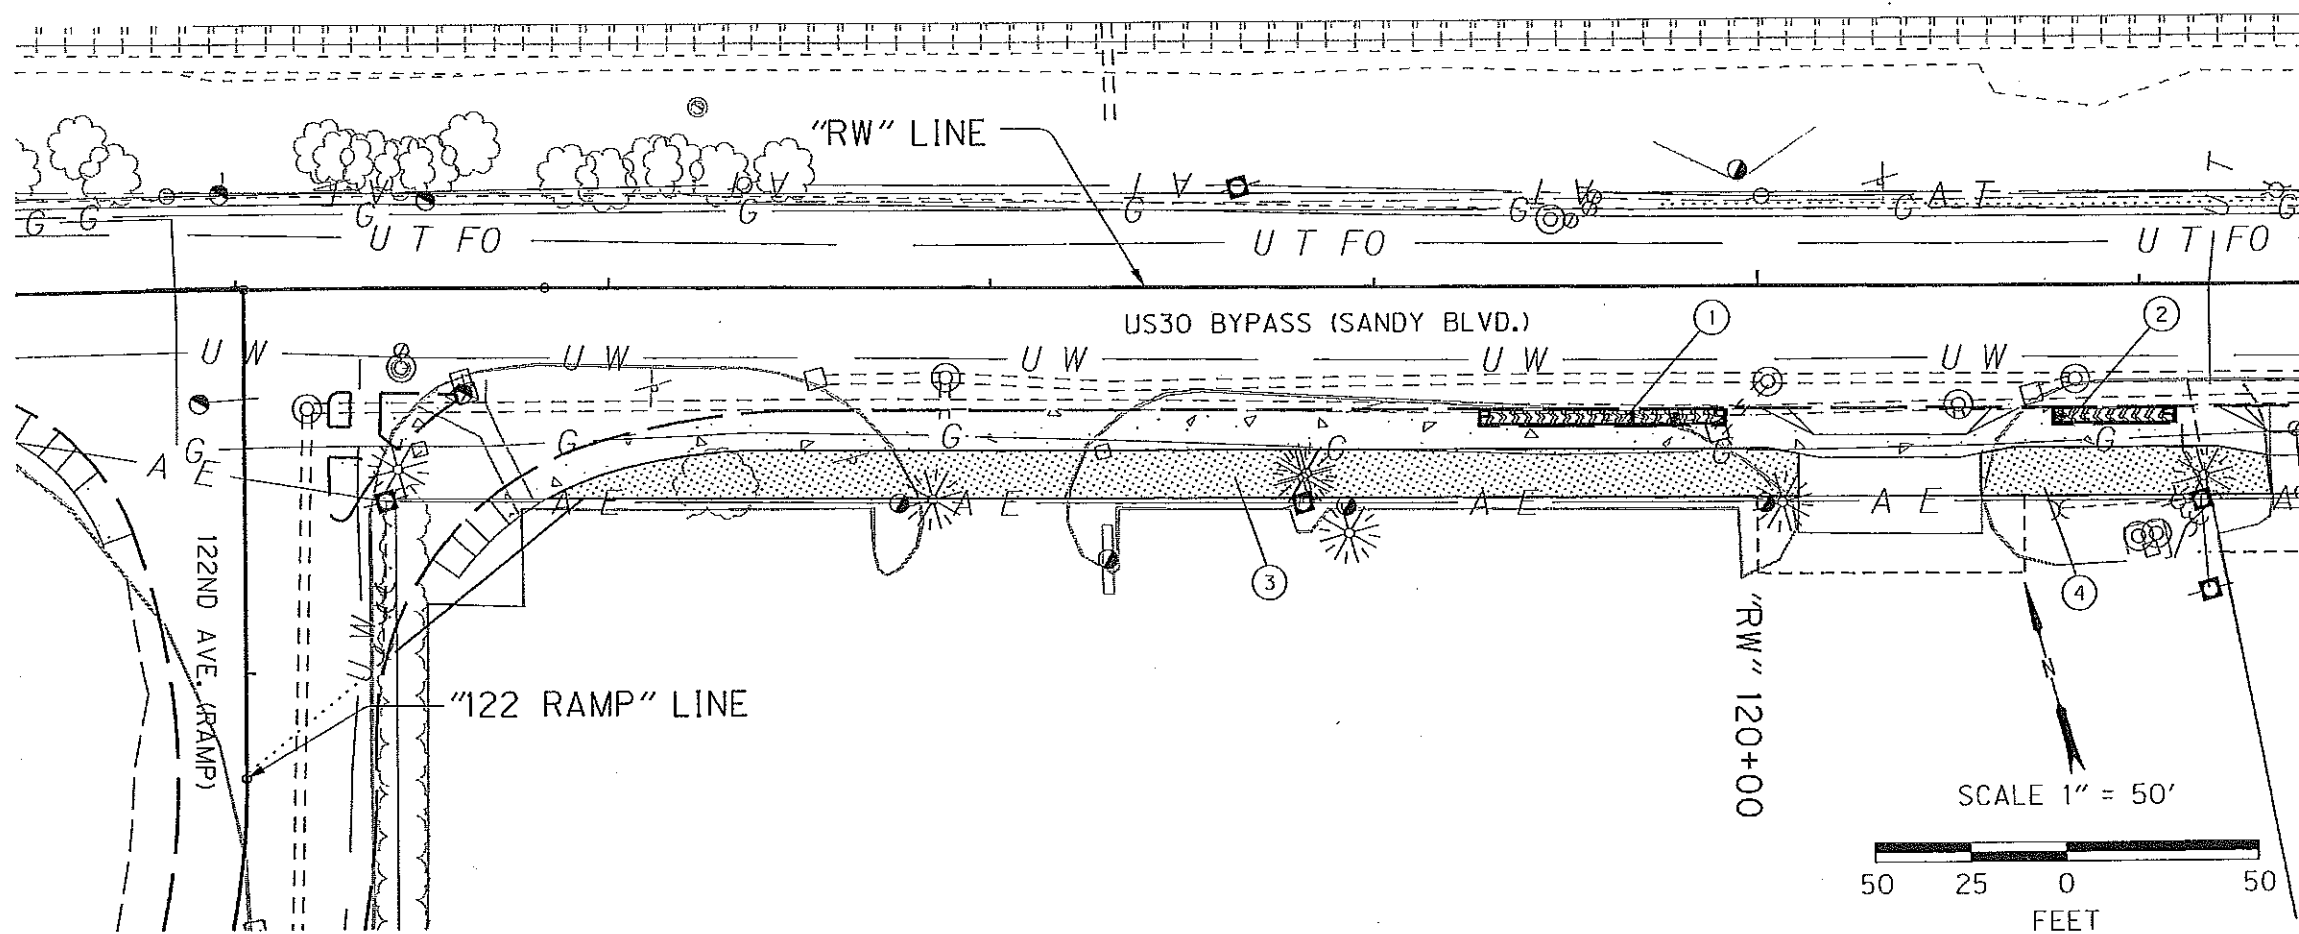


- ① 209 SF Storm water planter. Install the following plants:
60--Carex obnupta
60--Carex densa
60--Deschampsia cespitosa
- ② 99 SF Storm water planter. Install the following plants:
28--Carex obnupta
28--Carex densa
28--Deschampsia cespitosa
- ③ Apply 24 CUYD of 2" thick coarse compost over 3870 SF.
- ④ Apply 5.7 CUYD of 2" thick coarse compost over 915 SF.
- ⑤ Apply 3.0 CUYD of 2" thick coarse compost over 490 SF.
- ⑥ Apply 11.6 CUYD of 2" thick coarse compost over 1880 SF.
- ⑦ 120 SF Storm water planter. Install the following plants:
34--Carex obnupta
34--Carex densa
34--Deschampsia cespitosa
- ⑧ Apply 37.5 CUYD of 2" thick coarse compost over 6090 SF.

"AS CONSTRUCTED"

OCT 28-2013


Mark Beeson
MARK BEESON, PROJECT MANAGER

NOTES:
 1. See Plant and Material Schedule
 2. See General Notes, and GN-2 & GN-3 details.
 3. Remove weeds per 01030.42. Weeds requiring special attention include English Ivy (*Hedera Helix*) and Himalayan Blackberry (*Rubus armeniacus*).
 4. See Special Provisions 03020 for compost types: fine, medium & coarse

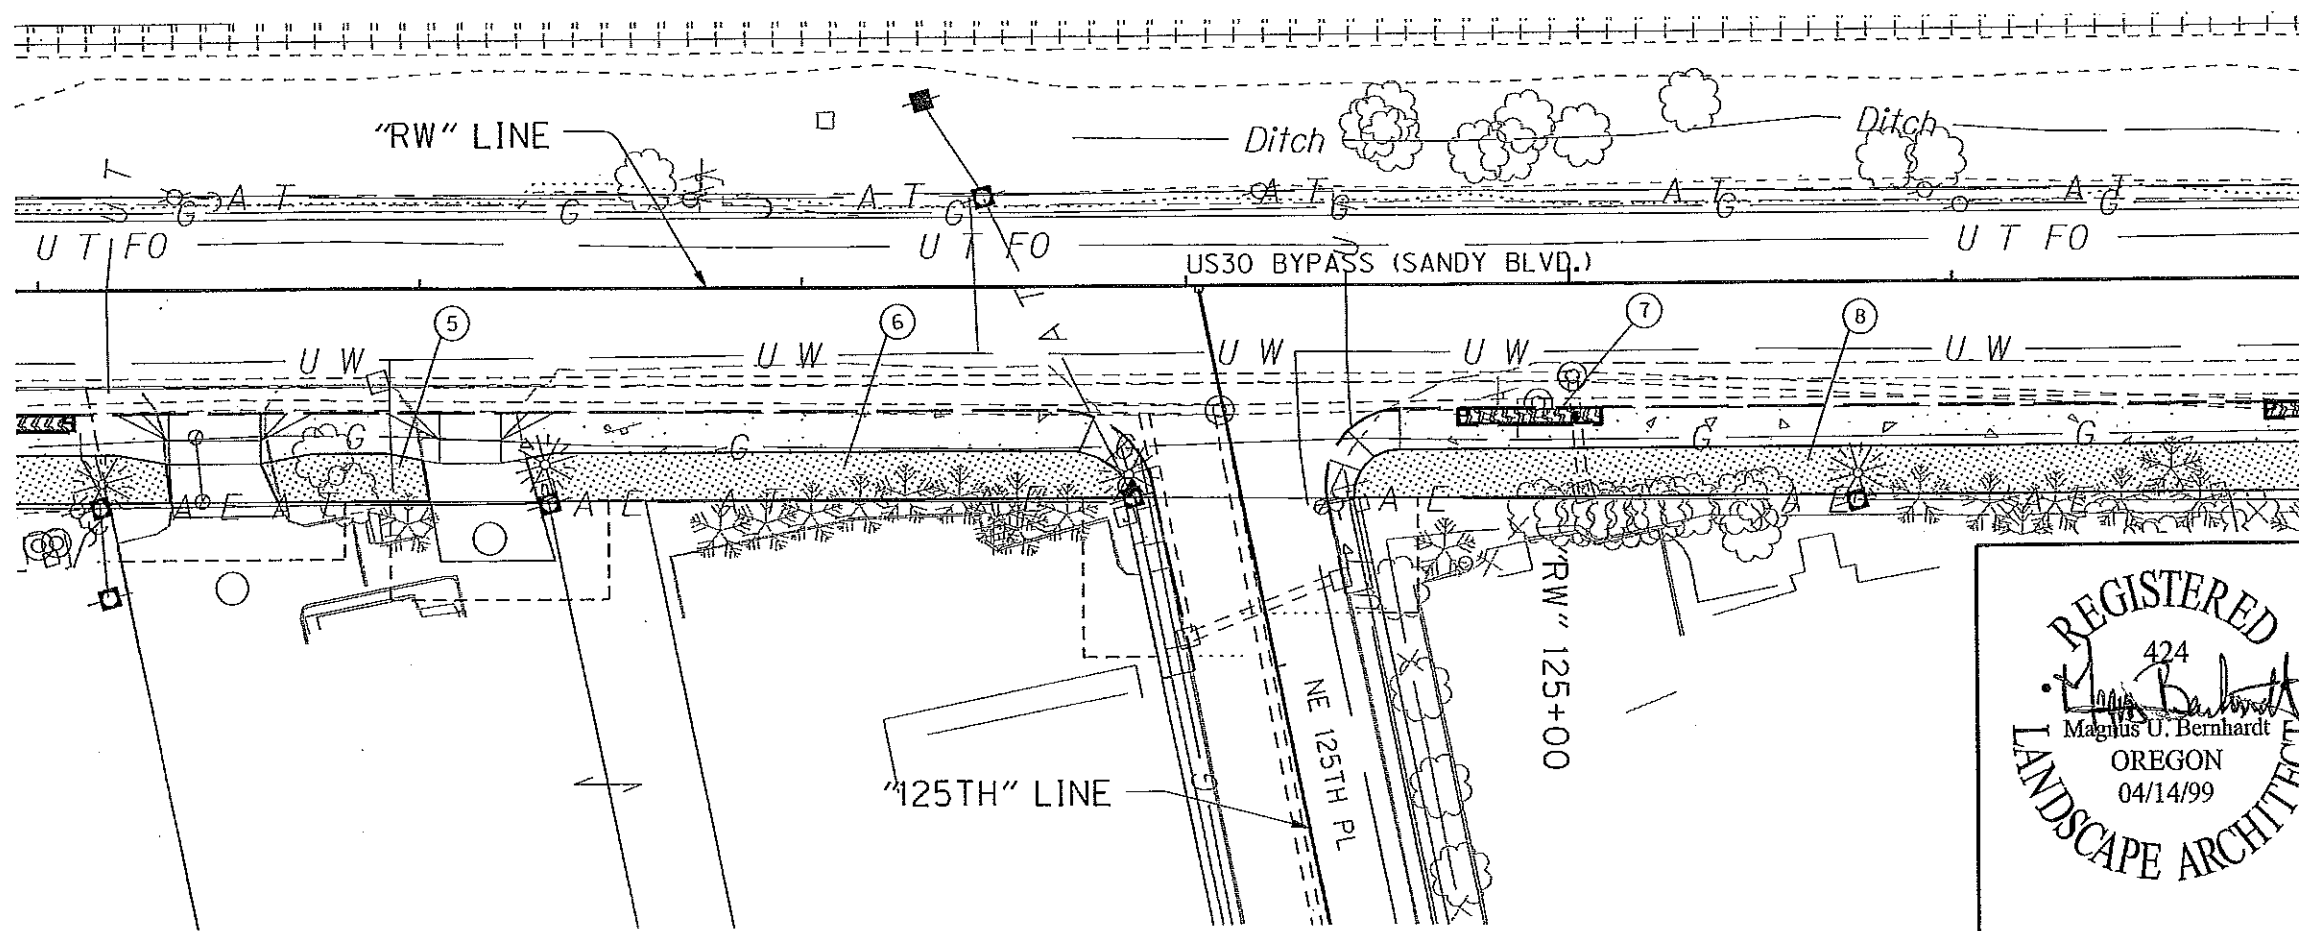


REGISTERED
 424
Magnus U. Bernhardt
 Magnus U. Bernhardt
 OREGON
 04/14/99
 LANDSCAPE ARCHITECT

OREGON DEPARTMENT OF TRANSPORTATION	
REGION 1 ROADWAY ENGINEERING SECTION	
US 30 BYPASS: NE 122ND - M.P. 13.54 SEC. NORTHEAST PORTLAND HIGHWAY MULTNOMAH COUNTY	
Design Team Leader - Magnus Bernhardt Designed By - Magnus Bernhardt Drafted By - Marco Singer	
ROADSIDE DEVELOPMENT PLAN	SHEET NO. GN-4

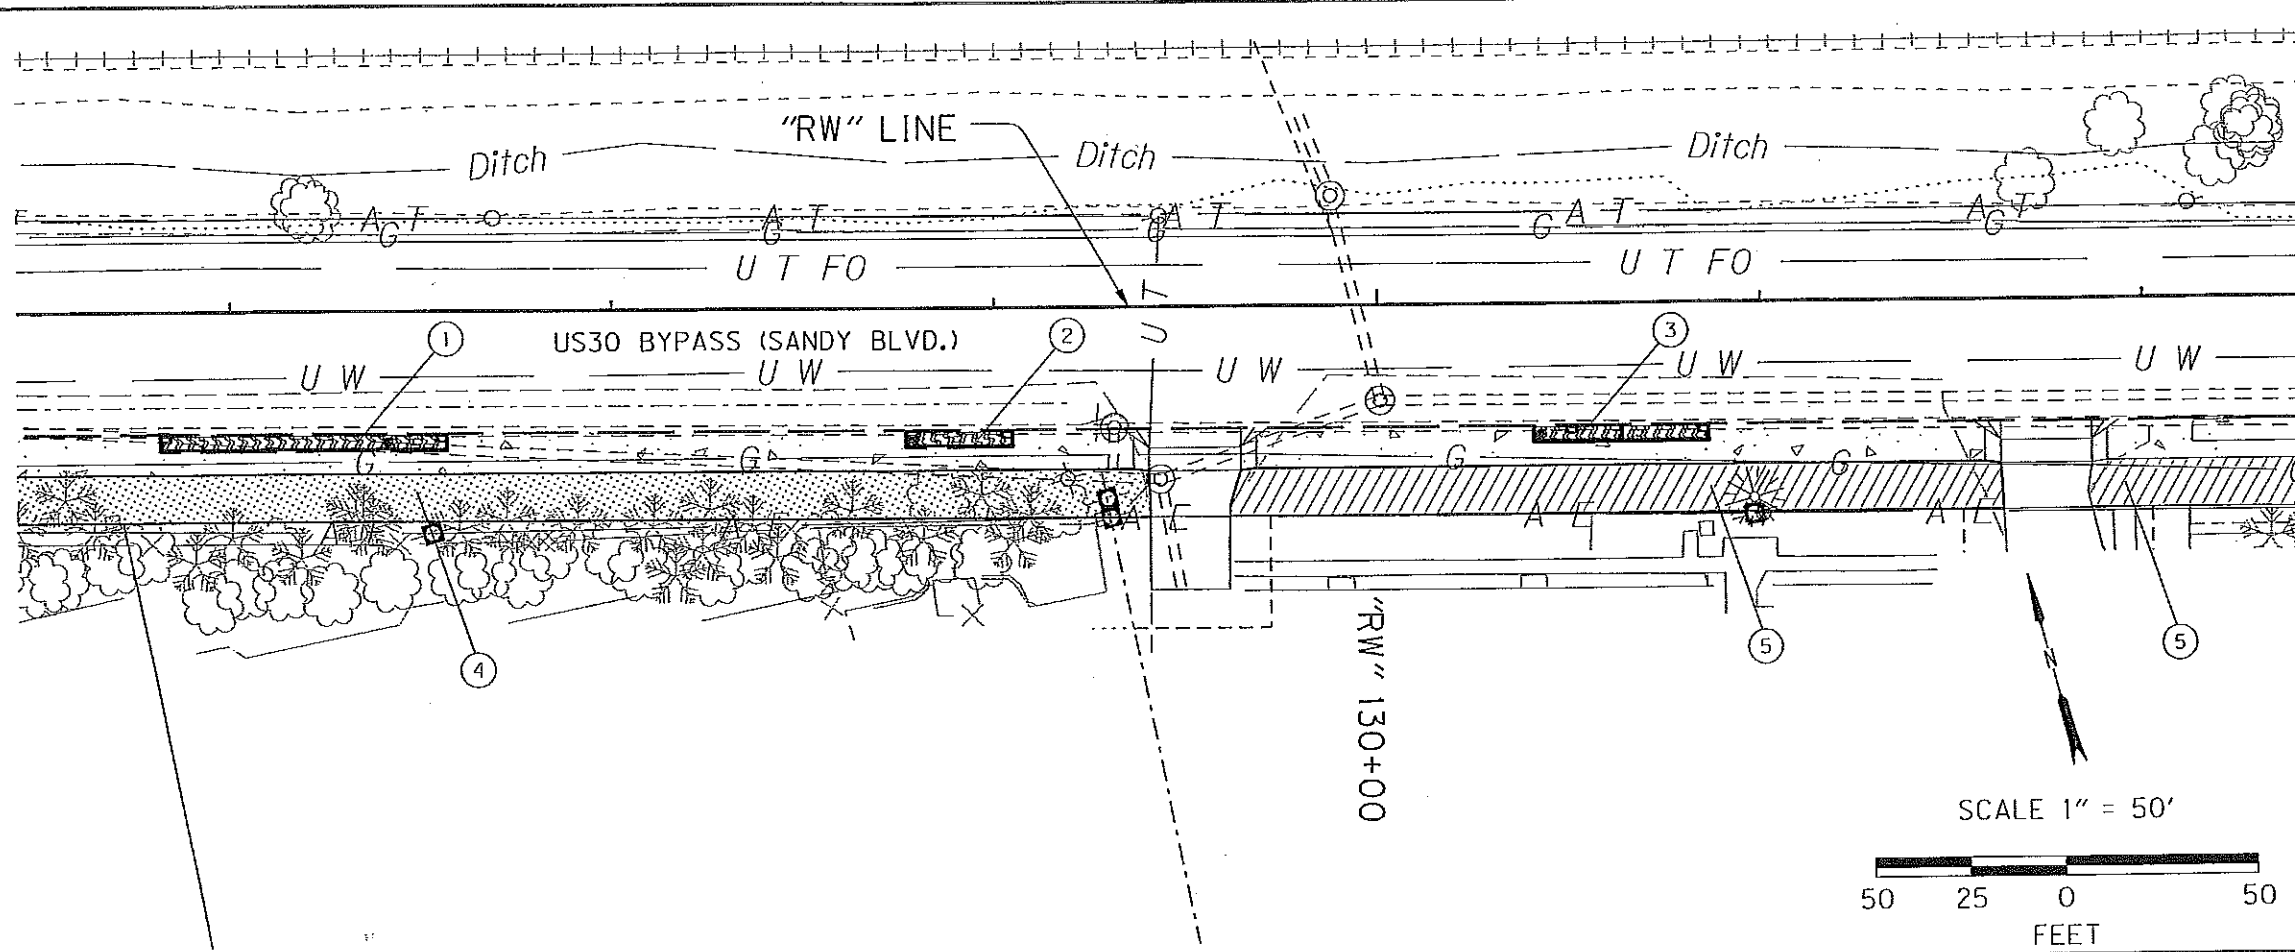

- ① 248 SF Storm water planter. Install the following plants:
70-Carex obnupta
70-Carex densa
70-Deschampsia cespitosa
- ② 85 SF Storm water planter. Install the following plants:
24-Carex obnupta
24-Carex densa
24-Deschampsia cespitosa
- ③ 144 SF Storm water planter. Install the following plants:
41-Carex obnupta
41-Carex densa
41-Deschampsia cespitosa
- ④ Apply 2" thick coarse compost per note 8, sheet GN-4
- ⑤ Existing lawn to remain to edge of new sidewalk. Coordinate with land owner to move existing irrigation where present. Areas left bare between new sidewalk and existing lawn shall be re-seeded with similar seed to match existing lawn.
- ⑥ 104 SF Storm water planter. Install the following plants:
30-Carex obnupta
30-Carex densa
30-Deschampsia cespitosa
- ⑦ 140 SF Storm water planter. Install the following plants:
40-Carex obnupta
40-Carex densa
40-Deschampsia cespitosa
- ⑧ Apply 11.2 CUYD of 2" thick coarse compost over 1820 SF.
- ⑨ Tree cluster to be removed cleared and grubbed

NOTES:
 1. See Plant and Material Schedule
 2. See General Notes, and GN-2 & GN-3 details.
 3. Remove weeds per 01030.42. Weeds requiring special attention include English Ivy (*Hedera Helix*) and Himalayan Blackberry (*Rubus armeniacus*).
 4. See Special Provisions 03020 for compost types: fine, medium & coarse

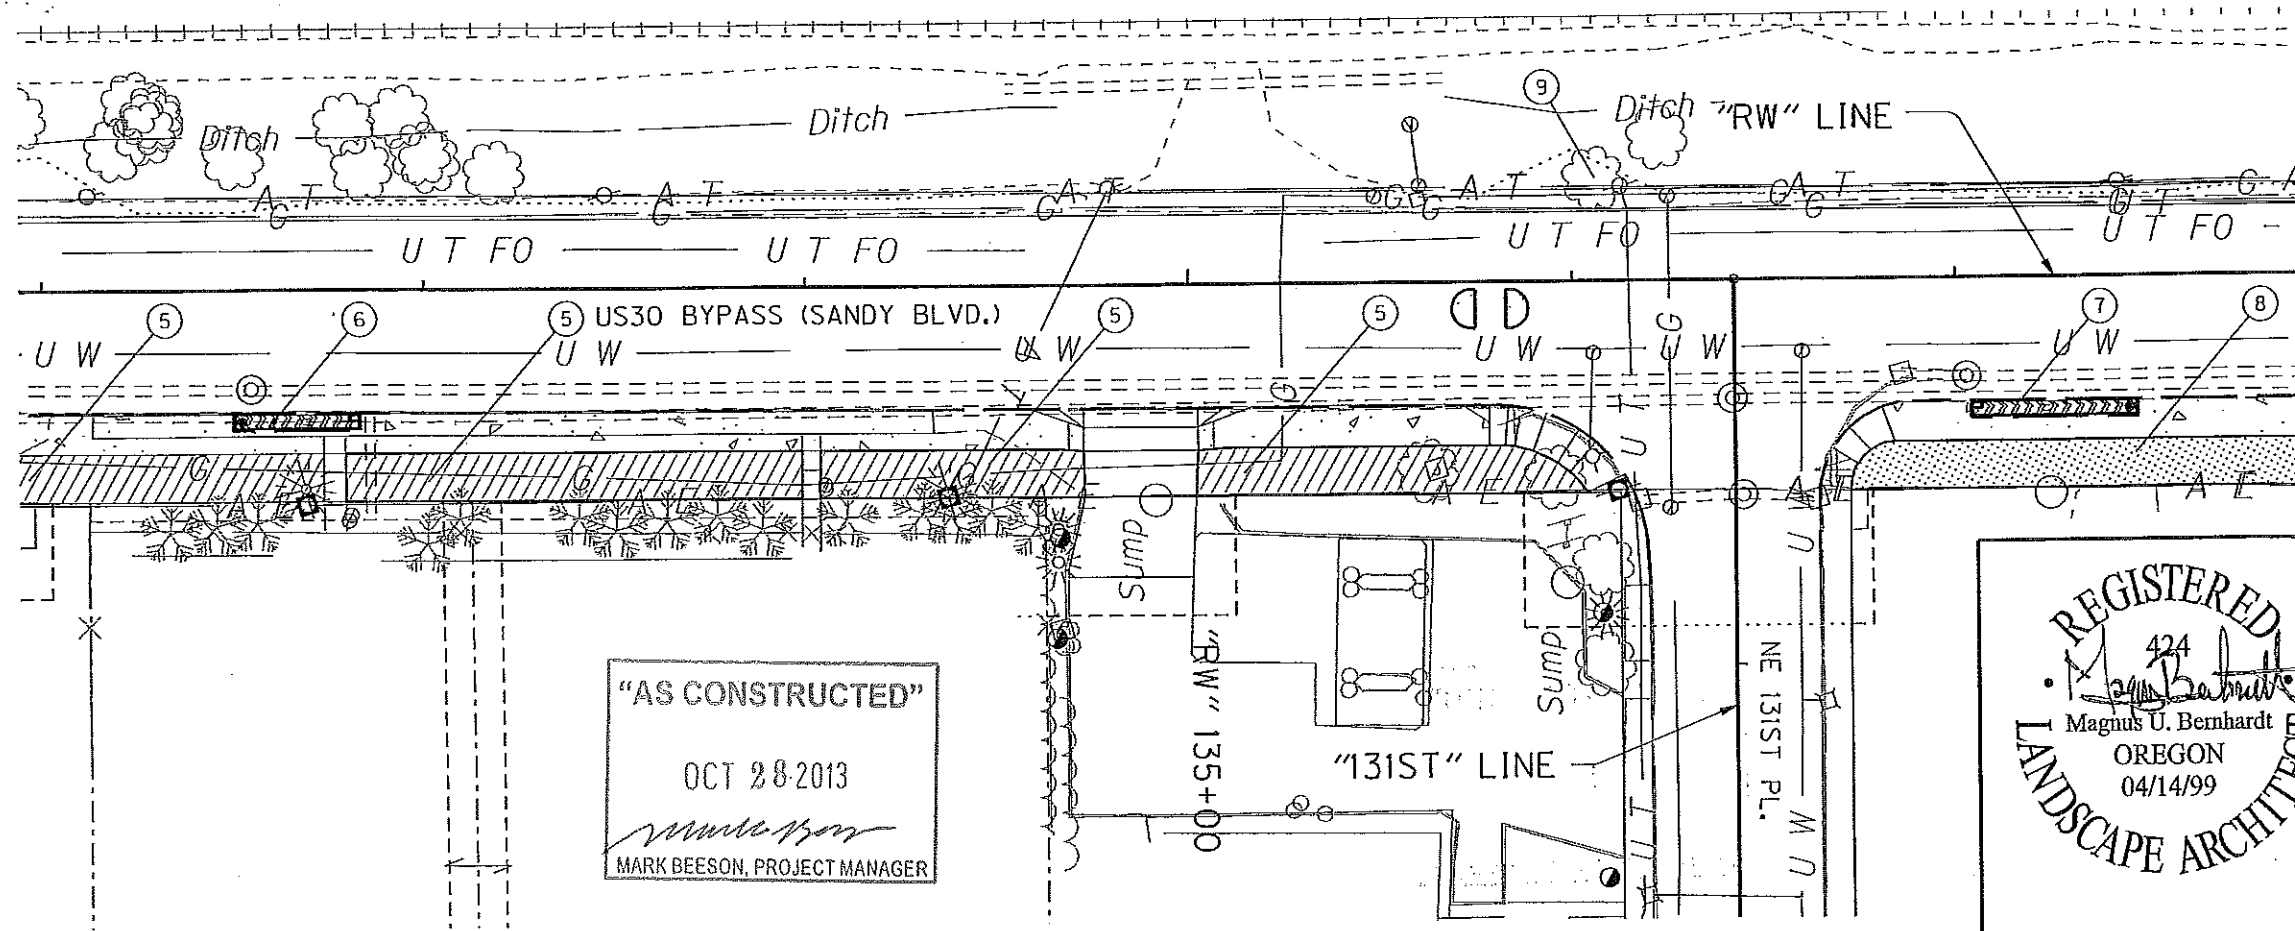

OREGON DEPARTMENT OF TRANSPORTATION	
REGION 1 ROADWAY ENGINEERING SECTION	
US 30 BYPASS: NE 122ND - M.P. 13.54 SEC. NORTHEAST PORTLAND HIGHWAY MULTNOMAH COUNTY	
Design Team Leader - Magnus Bernhardt Designed By - Magnus Bernhardt Drafted By - Marco Singer	
ROADSIDE DEVELOPMENT PLAN	SHEET NO. GN-5