

# OPERATION & MAINTENANCE MANUAL

## Water Quantity Detention Vault

Manual prepared: November 2018

DFI No. D00609



Figure 1: DFI No. D00609, looking southeast

## 1. Identification

Drainage Facility ID (DFI): D00609  
Facility Type: Water Quantity Detention Vault  
Construction Drawings: (V-File Numbers) 45V-062  
Location: District: 2B  
Highway No.: 144  
Mile Post: 0.85-0.89 [left side]

## 2. Manual Purpose

The purpose of this manual is to outline inspection needs and summarize maintenance actions.

## 3. Facility Location

The location map below details the facility location. The highway, mile posts, side streets, access location, and stormwater flow directions are noted on the map.

Facility location type: Roadway shoulder

Flow direction: South

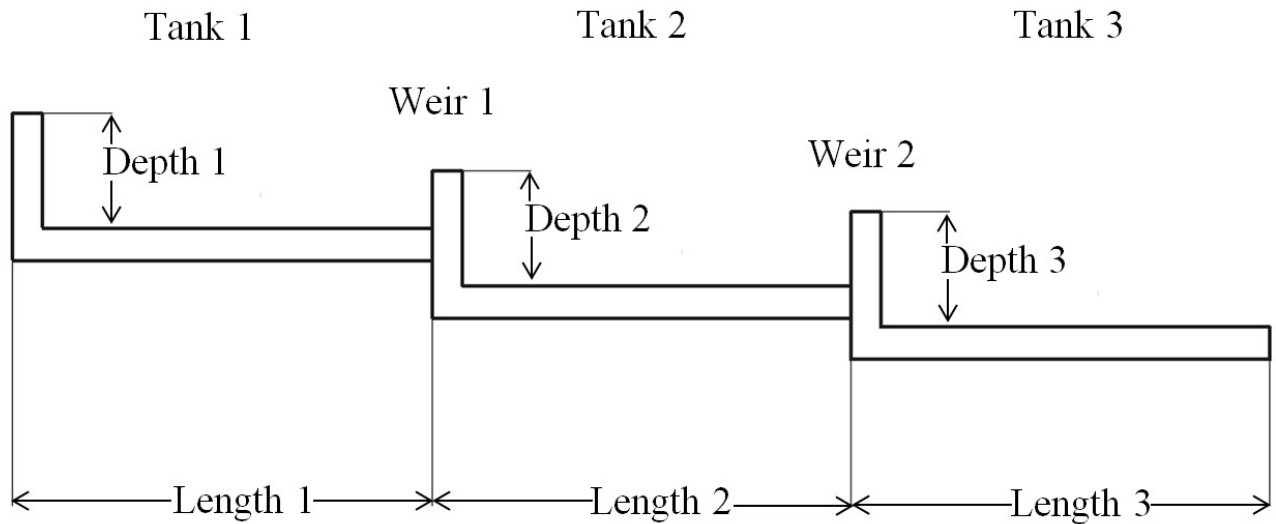


Figure 2: Facility location map


#### 4. Facility Summary

The length of a detention vault is based on the bottom dimension. The depth of a detention vault is the vertical distance from the bottom of the tank to the top of the tank or the top of the weir. D00609 has three tanks with weirs between each one. The dimensions of each tank are given in the table below (the numbers start from the northernmost tank):

Tank Number	Bottom Length (feet)	Depth (feet)
1	60	8
2	60	6
3	60	6



The width of the detention vault varies throughout the water quality facility. The schematic below shows the varying dimensions of the detention vault.

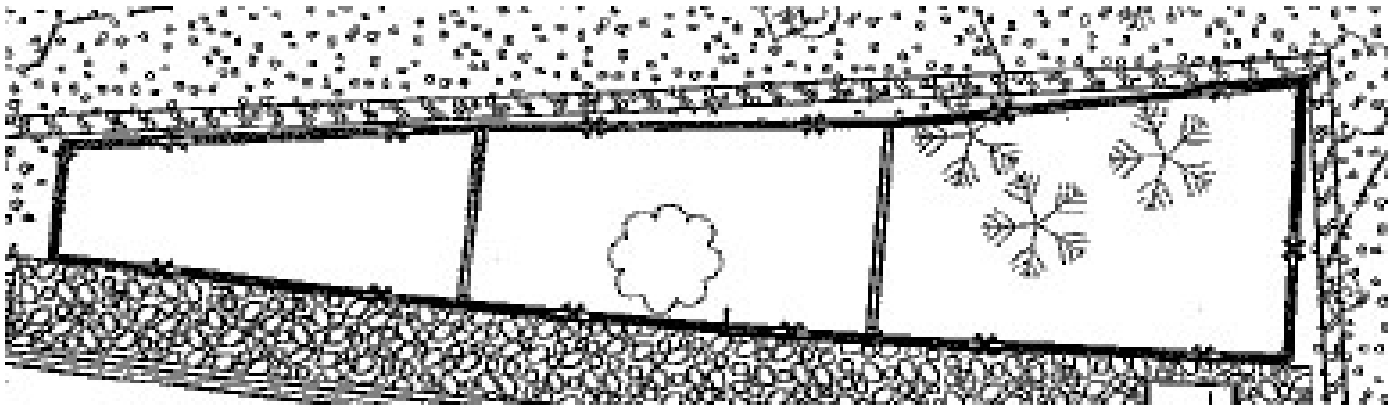

**Site Specific Information:** Maintenance can access the detention vault via a roadside pad on the northbound lanes of OR217 at MP: 0.85. The pad leads to an access road that runs parallel to the detention vault. There are three maintenance platforms in the vault.

## 5. Facility Access

Maintenance access to the facility:

<input checked="" type="checkbox"/> Roadside pad	<input type="checkbox"/> Roadside shoulder
<input type="checkbox"/> Access road with Gate	<input type="checkbox"/> Access road without Gate



Figure 3: Access for D00609, looking south

## 6. Storm Drain System and Facility Overview

A detention facility is designed to control the quantity of runoff, by reducing the peak discharge and only detaining runoff for some short period of time. These facilities are designed to store and gradually release or attenuate stormwater runoff via a control structure or release mechanism, and completely drain after the design storm has passed. The most common detention facilities include:

- Dry ponds – these are depressed storage areas that store runoff during wet weather and are dry the rest of the time. Usually they are earthen depressions.
- Tanks – these are underground storage facilities that are typically constructed from large diameter pipe

- Vaults – these are enclosed underground storage facilities. They are typically constructed from reinforced concrete.

This detention vault is composed of three detentions tanks that are each approximately 60 feet long with varying widths. There are two weirs separating each tank from the others. The northernmost tank has two inlet pipes draining into it. The water flows south over the weir into the second and third tanks. The third tank has a 36" diameter stormwater outlet pipe constructed through the wall. The 36" storm sewer pipe enters a flow control manhole (Appendix A, Sheet 2). The flow control device at the facility includes a flow restricting orifice (16" diameter) and an overflow weir inside the manhole. The orifice, located at the base of the weir, meters stormwater flow leaving the system (Appendix B, GJ). Higher flows are detained in the manhole (those greater than what the orifice will allow to pass), but able to flow over the top of the weir if necessary. The stormwater is then directed into a 21" diameter pipe that drains to the southwest.

**A. Heavy equipment access into facility:**

- Allowed (no limitations)
- Allowed (with limitations)
- Not allowed

**B. Special Features:**

- Amended Soils
- Porous Pavers
- Liners
- Underdrains

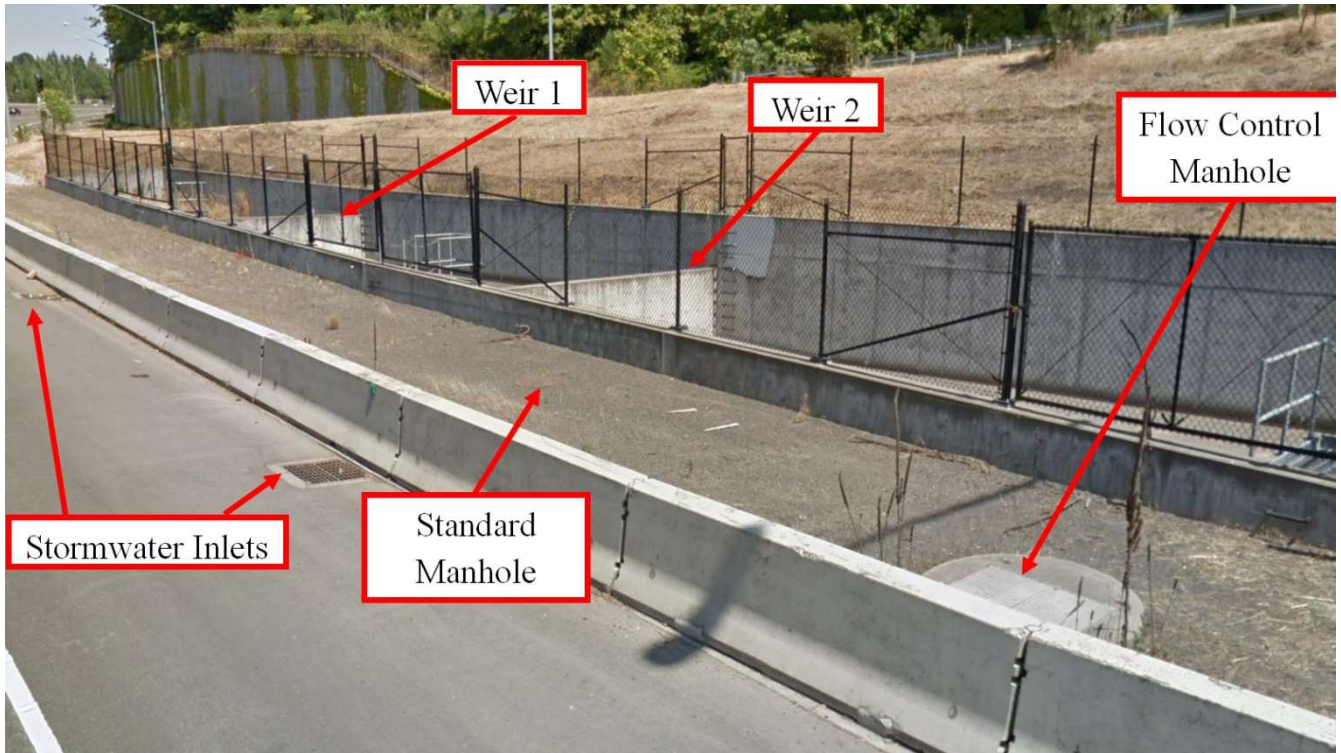


Figure 4: D00609 and its components, looking northeast

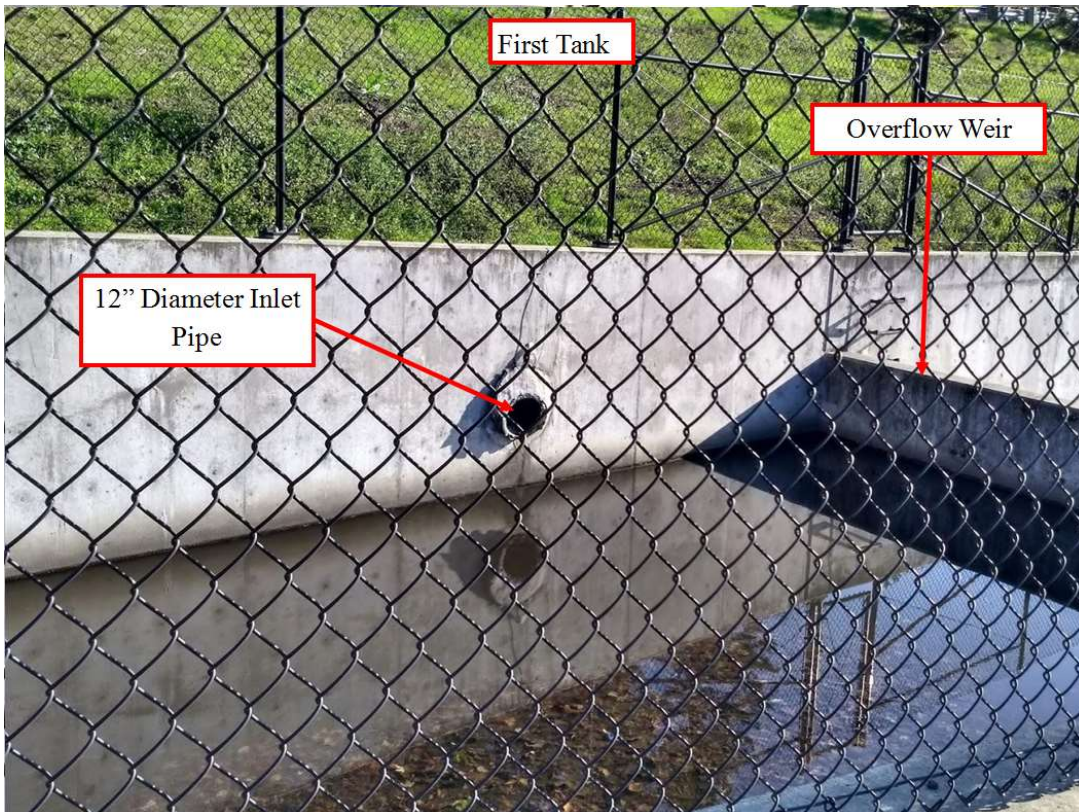


Figure 5: First tank of D00609 and one inlet pipe


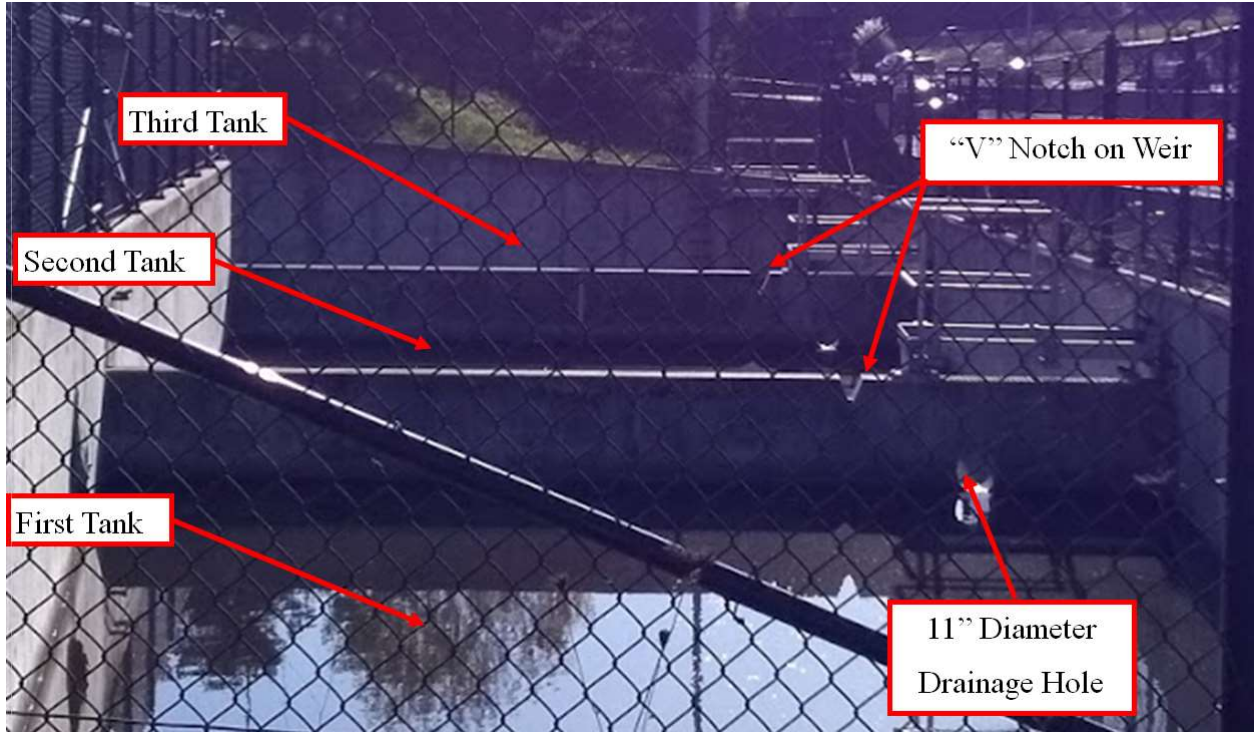


Figure 6: Detention Vault with Drainage shown, looking south

Figure 7: Facility Drainage Outlet, looking west



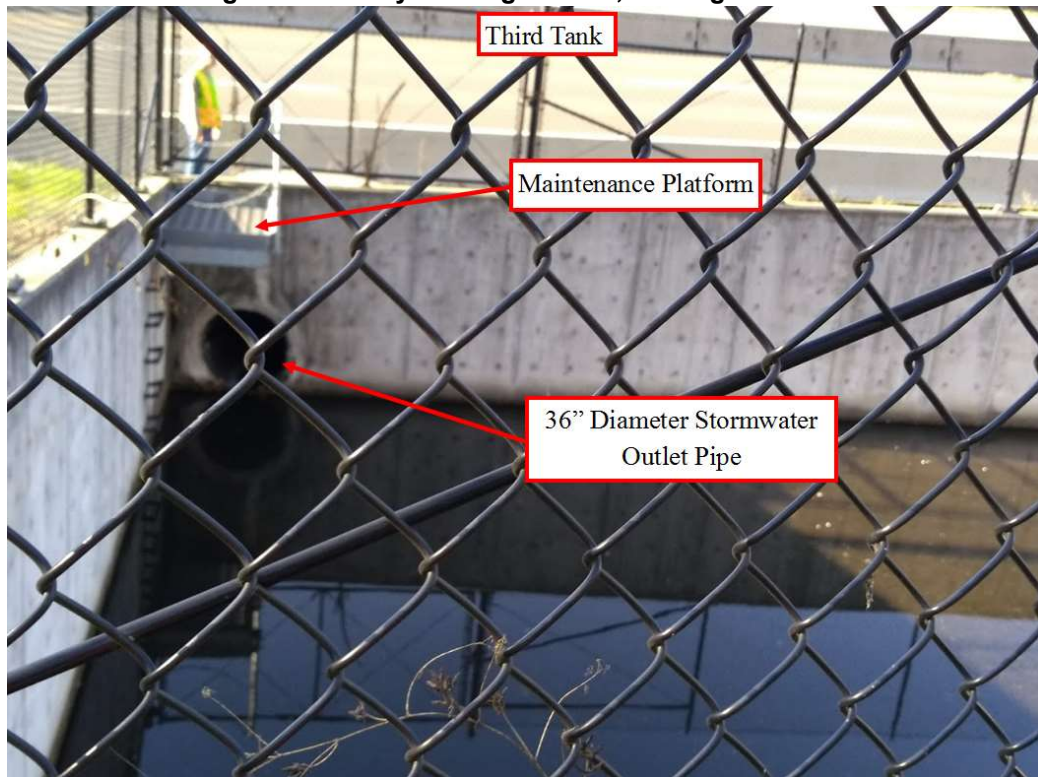

## 7. Maintenance

### Maintenance Frequency/Maintain Records

- a. Inspect annually. Preferably prior to the rainy season.
- b. Clean and maintain as necessary. Refer to Activity 125 for conditions when maintenance is needed.
- c. Keep a record of inspections, maintenance, and repairs.

### Maintenance Guide/Maintenance Actions

The ODOT Routine Road Maintenance Water Quality and Habitat Guide (the *Blue Book*) outlines the standard maintenance actions for water quality facilities under Activity 125.

There are standard maintenance tables for standard ODOT designs. The maintenance tables describe the maintenance component, the defect or problem, the condition when maintenance is needed, and the recommended maintenance to correct the problem. Use the following tables to maintain ODOT swales:

- Table 1 (General Maintenance): Contains general maintenance and inspection guidelines that are applicable to all ODOT water quality facilities
- Table 7 (Maintenance of Detention Vault): Contains maintenance information for detention vaults.

The *Blue Book* can be viewed at the following website:

[http://www.oregon.gov/ODOT/Maintenance/Documents/blue\\_book.pdf](http://www.oregon.gov/ODOT/Maintenance/Documents/blue_book.pdf)

## 8. Auxiliary Outlet (High Flow Bypass)

Auxiliary Outlets are provided if the primary outlet control structure cannot safely pass the projected high flows. Broad-crested spillway weirs and over flow risers are the two most common auxiliary outlets used in stormwater treatment facility design. The auxiliary outlet feature is either a part of the facility or an additional storm drain feature/structure.

The auxiliary outlet feature for this facility is:

Designed into facility –

High flows are allowed to overtop the weir located within the detention manhole itself, (Operation Plan, Point “C”). In the event the restricting orifice is plugged or the flows exceed the anticipated high flow, the water can overtop the weir and exit the detention facility through the outlet pipe.

Other, as noted below:

## 9. Waste Material Handling

Material removed from the facility is defined as waste by the Department of Environmental Quality (DEQ). Refer to the road waste section of the ODOT Maintenance Yard Environmental Management System (EMS) Policy and Procedures Manual for disposal options:

[http://www.oregon.gov/ODOT/Maintenance/Documents/ems\\_manual.pdf](http://www.oregon.gov/ODOT/Maintenance/Documents/ems_manual.pdf)


Contact any of the following for more detailed information about management of waste materials found on site:

ODOT Clean Water Unit	(503) 986-3008
ODOT Statewide Hazmat Coordinator	(503) 667-7442
ODOT Region 1 Hazmat Coordinator	(503) 731-8290
ODOT Region 2 Hazmat Coordinator	(503) 986-2647
ODOT Region 3 Hazmat Coordinator	(541) 957-3594
ODOT Region 4 Hazmat Coordinator	(541) 388-6186
ODOT Region 5 Hazmat Coordinator	(541) 963-1590
ODEQ Northwest Region Office	(503) 229-5263

## **A Appendix A – Site Specific Operational Plan**

### **Contents:**

**Operational Plan: DFI D00609**


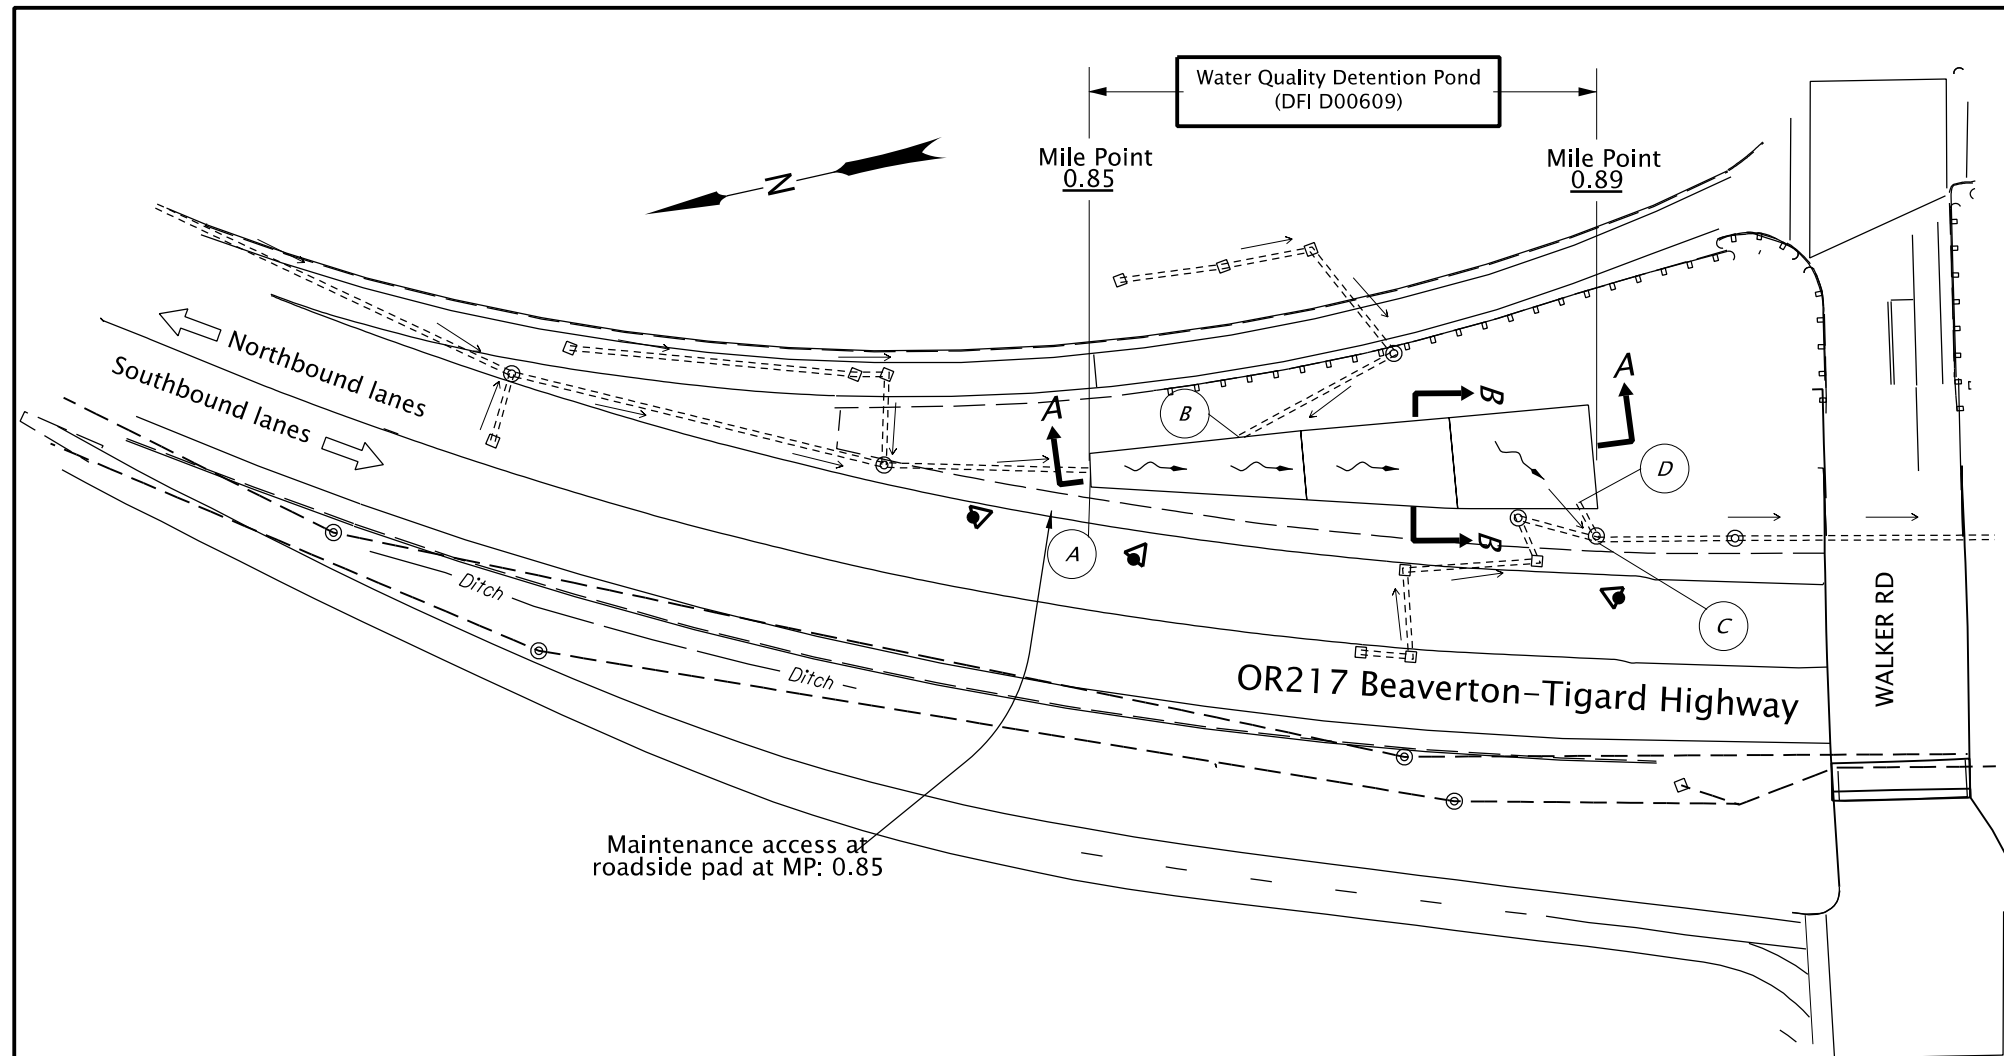


### Legend

- (A) 18" HDPE Stormwater Inlet Pipe
- (B) 12" HDPE Stormwater Inlet Pipe
- (C) Flow Control Manhole
- (D) 36" HDPE Stormwater Outlet Pipe
- (E) Flow Control Weir
- ⊙ Manhole
- Inlet
- ~ Water Flow Direction
- Conveyance Direction
- ⇨ Traffic Flow Direction
- ◀ Photo Location/Direction

Maintenance access at roadside pad at MP: 0.85

Weir "V" Notch for Overflow Control

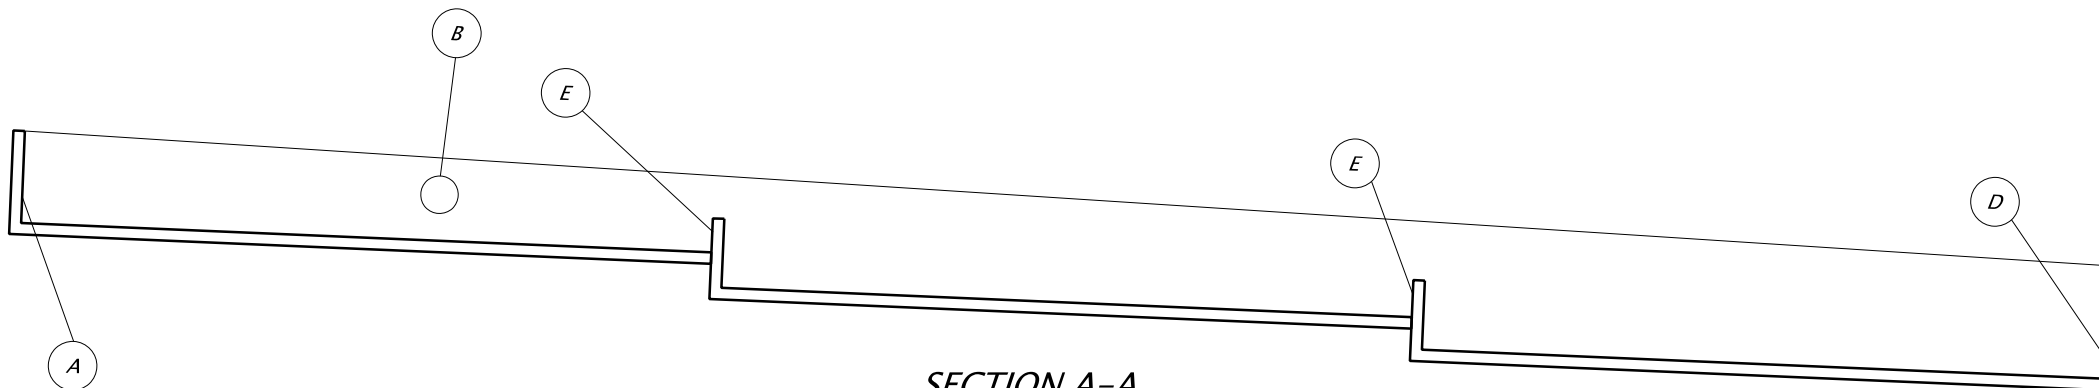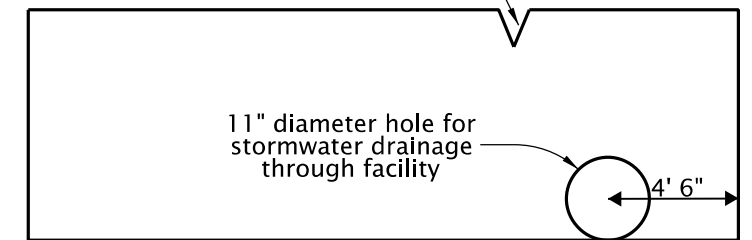

SECTION A-A  
N.T.S.




OREGON DEPARTMENT OF TRANSPORTATION

Sht. 01 of 02


Prepared By:  
Katrina Sepulveda

Drafted By:  
Katrina Sepulveda

**DFI D00609**  
**MAINTENANCE DISTRICT 1 HWY 144**  
**Water Quantity Detention Vault**  
Beaverton-Tigard Highway MP 0.85-0.89  
Washington County

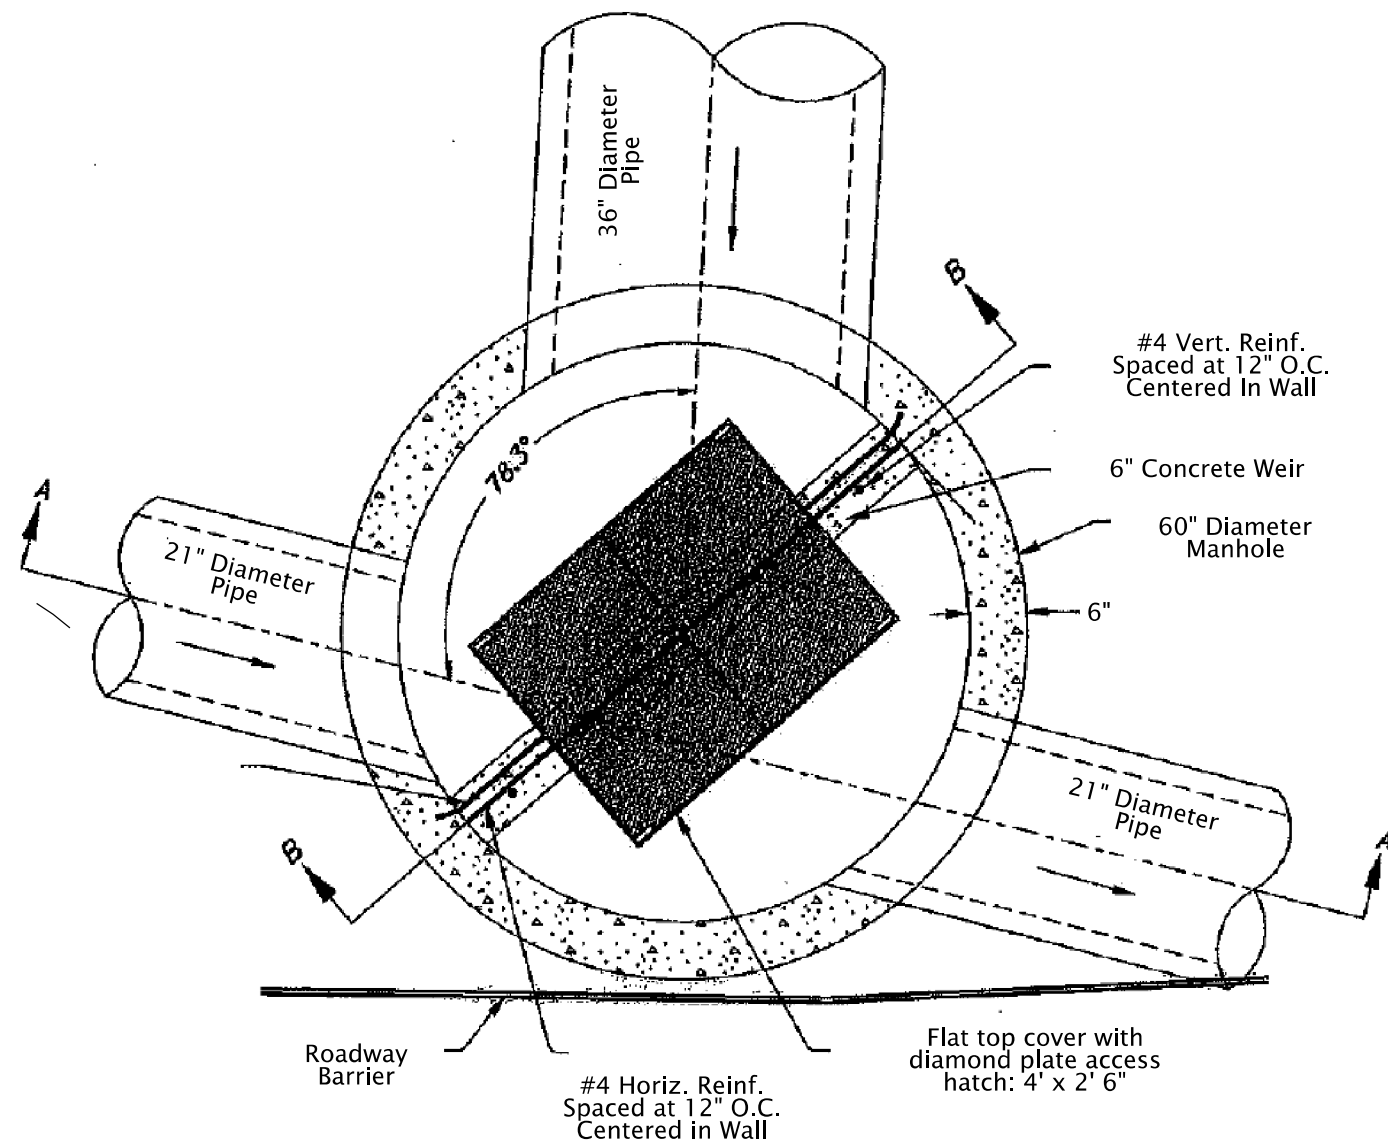

**SCHMATIC OF FLOW CONTROL MANHOLE**  
N.T.S.

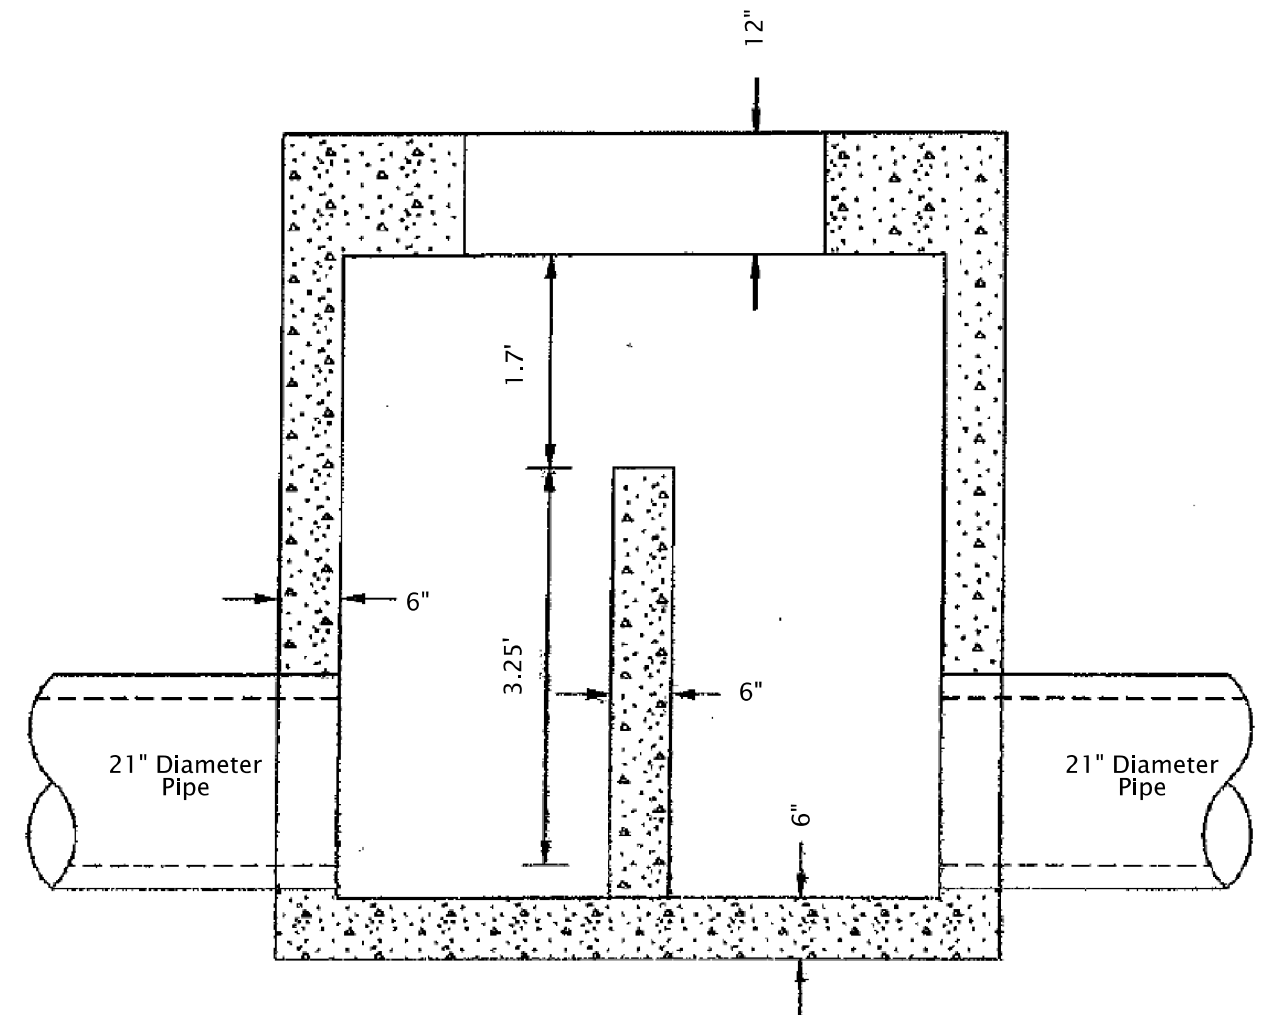

**SECTION A-A**  
N.T.S.



Sht. 02 of 02

Prepared By:  
Katrlna Sepulveda

Drafted By:  
Katrlna Sepulveda

**DFI D00609**  
**MAINTENANCE DISTRICT 1 HWY 144**  
**Water Quantity Detention Vault**  
Beaverton-Tigard Highway MP 0.85-0.89  
Washington County

## **B Appendix B – Project Contract Plans**

### **Contents:**

**Site Specific Subset of Project Contract Plan 45V-062**

INDEX OF SHEETS	
SHEET NO.	DESCRIPTION
1	Title Sheet
1A	Index Of Sheets Cont'd & Std. Drg. Nos.
1B	Sheet Layout

STATE OF OREGON  
DEPARTMENT OF TRANSPORTATION  
PLANS FOR PROPOSED PROJECT

GRADING, DRAINAGE, STRUCTURES & ILLUMINATION


OR 217: SUNSET HWY - TV HWY DETENTION FACILITY

BEAVERTON - TIGARD HIGHWAY

WASHINGTON COUNTY

MAY 2012


*Ronald Larson*  
REVISED AS CONSTRUCTED  
12-18-12 CONTRACT 14462  
PROJ. MGR.

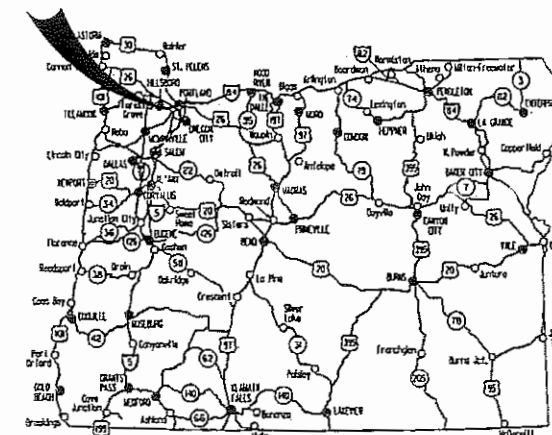

Overall Length Of Project - 0.17 Miles

PROJECT SITE

Sta. "L217NB" 139 + 80 (M.P. 0.86)

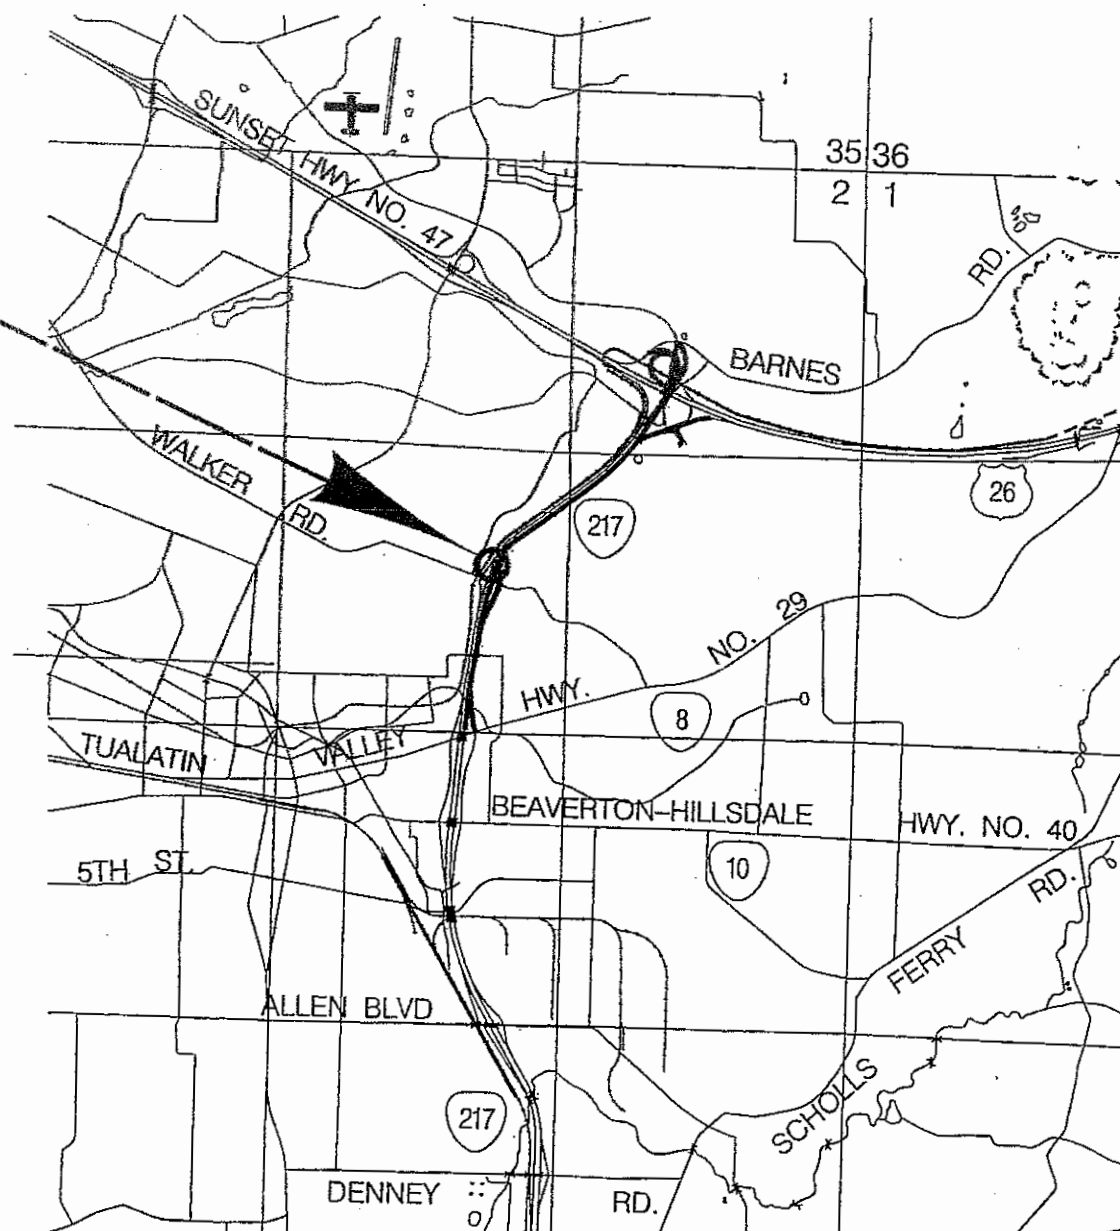

**ATTENTION:**  
Oregon Law Requires You To Follow Rules Adopted By The Oregon Utility Notification Center. Those Rules Are Set Forth In OAR 952-001-0010 Through OAR 952-001-0090. You May Obtain Copies Of The Rules By Calling The Center. (Note: The Telephone Number For The Oregon Utility Center Is (503) 232-1987.)

OREGON TRANSPORTATION COMMISSION	
Pat Egan	CHAIR
David Lohman	COMMISSIONER
Mary F. Olson	COMMISSIONER
Mark Frohnmayer	COMMISSIONER
Tommy Baney	COMMISSIONER
Matthew L. Garrett	DIRECTOR OF TRANSPORTATION


PLANS PREPARED FOR  
ODOT  
BY:  
DAVID EVANS AND ASSOCIATES, INC.  
2100 Southwest River Parkway  
Portland Oregon 97201 Ph: 503.223.6663

These plans were developed using ODOT design standards. Exceptions to these standards, if any, have been submitted and approved by the ODOT Chief Engineer or their delegated authority.

Approving Authority: *J. [Signature]* 3-20-12  
Signature & date  
*Terrence M. Stoner*  
Print name and title *Sen. Assoc.*  
*[Signature]*  
Concurrence by ODOT Chief Engineer

OR 217: SUNSET HWY - TV HWY DETENTION FACILITY  
BEAVERTON - TIGARD HIGHWAY  
WASHINGTON COUNTY

FEDERAL HIGHWAY ADMINISTRATION	PROJECT NUMBER	SHEET NO.
OREGON DIVISION	STP-S144(023)	1

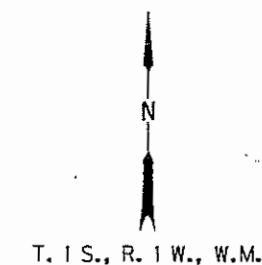

DATE PLOTTED: 3/19/2012 9:08:55 AM

INDEX OF SHEETS, CONT'D	
SHEET NO.	DESCRIPTION
2	Typical Sections
2A	Details
2A-2	Grading Plan
2B	Traffic Control Plan
2C	Pipe Data Sheet
3	Alignment And General Construction
3A	Construction Notes
3B	Drainage & Utilities
3B-2	Drainage & Utilities Notes
3C	Drainage Profile
4	Drainage & Utilities
4A	Drainage Profile
<b>GEO/HYDRO</b>	
GA	Erosion Control Details
GA-2, GA-3	Erosion Control Plans
GJ Thru GJ-3 Incl.	Drainage Details
<b>STRUCTURE NO. 21676 TV HWY DETENTION FACILITY</b>	
88092	Plan And Elevation
88093	General Notes
88094	Foundation Data
88095	Wall Details
88096	Weir Details
88097	Maintenance Platform Details 1 of 2
88098	Maintenance Platform Details 2 of 2
<b>ILLUMINATION</b>	
IL	Illumination Plan
IL-2	Illumination Legend And Pole Table

Standard Drg. Nos.

- RD300 - Trench Backfill, Bedding, Pipe Zone And Mult. Installations
- RD302 - Street Cut
- RD336 - Standard Storm Sewer Manhole
- RD344 - Standard Manhole Base Section
- RD346 - Manholes
- RD356 - Manhole Cover & Frames
- RD364 - Concrete Inlets Type G-1, G-2, G-2M, & G-2MA
- RD380, RD384, RD386, RD390 - Pipe Fill Height Tables
  
- RD500 - Precast Conc. Bar, Pin & Loop Assembly
  
- RD700 - Curbs
  
- RD815 - Chain Link Fence
  
- RD1000 - Construction Entrances
- RD1010 - Inlet Protection (Type 1, 2 and 3)
  
- BR240 - Protective Fencing
- BR241 - Protective Fencing Details - 1
- BR242 - Protective Fencing Details - 2
  
- TM200 - Sign Installation Details
  
- TM570 - Traffic Delineators
- TM571 - Traffic Delineators, Steel Post Details
  
- TM629 - Slip Base and Fixed Base Luminaire Supports (Details and Design Criteria)
- TM630 - Slip Base and Fixed Base Luminaire Supports (Base Plate and Footing Details)
- TM653 - Traffic Signal Supports
- TM670 - Wood Post sign Supports
- TM671 - 3 Second Gust Wind Speed Isotach
- TM676 - Perforated Steel Square Tube (PSST) Sign Support Installation
- TM681 - Sign Attachments
- TM687 - Perforated Steel Square Tube (PSST) Anchor Foundation
  
- TM800 - Tables, Abrupt Edge And PCMS Details
- TM820 - Temporary Barricades
- TM821 - Temporary Sign Supports
  
- TM831 - Temporary Impact Attenuators
  
- TM860 - Freeway Sections

No R/W Map


*Ronald Larson*  
 NOT REVISED AS CONSTRUCTED  
 12-18-12 CONTRACT 14462  
 PROJ. MGR.

<b>OR 217: SUNSET HWY - TV HWY DETENTION FACILITY</b>		
BEAVERTON - TIGARD HIGHWAY		
WASHINGTON COUNTY		
FEDERAL HIGHWAY ADMINISTRATION	PROJECT NUMBER	SHEET NO.
OREGON DIVISION	STP-S144(023)	1A



Sec. 10, T. 1S, R. 1W, W.M.

45V-062  
Revised as Constructed  
12-18-12 CONTRACT 14462  
PROJ. MGR.

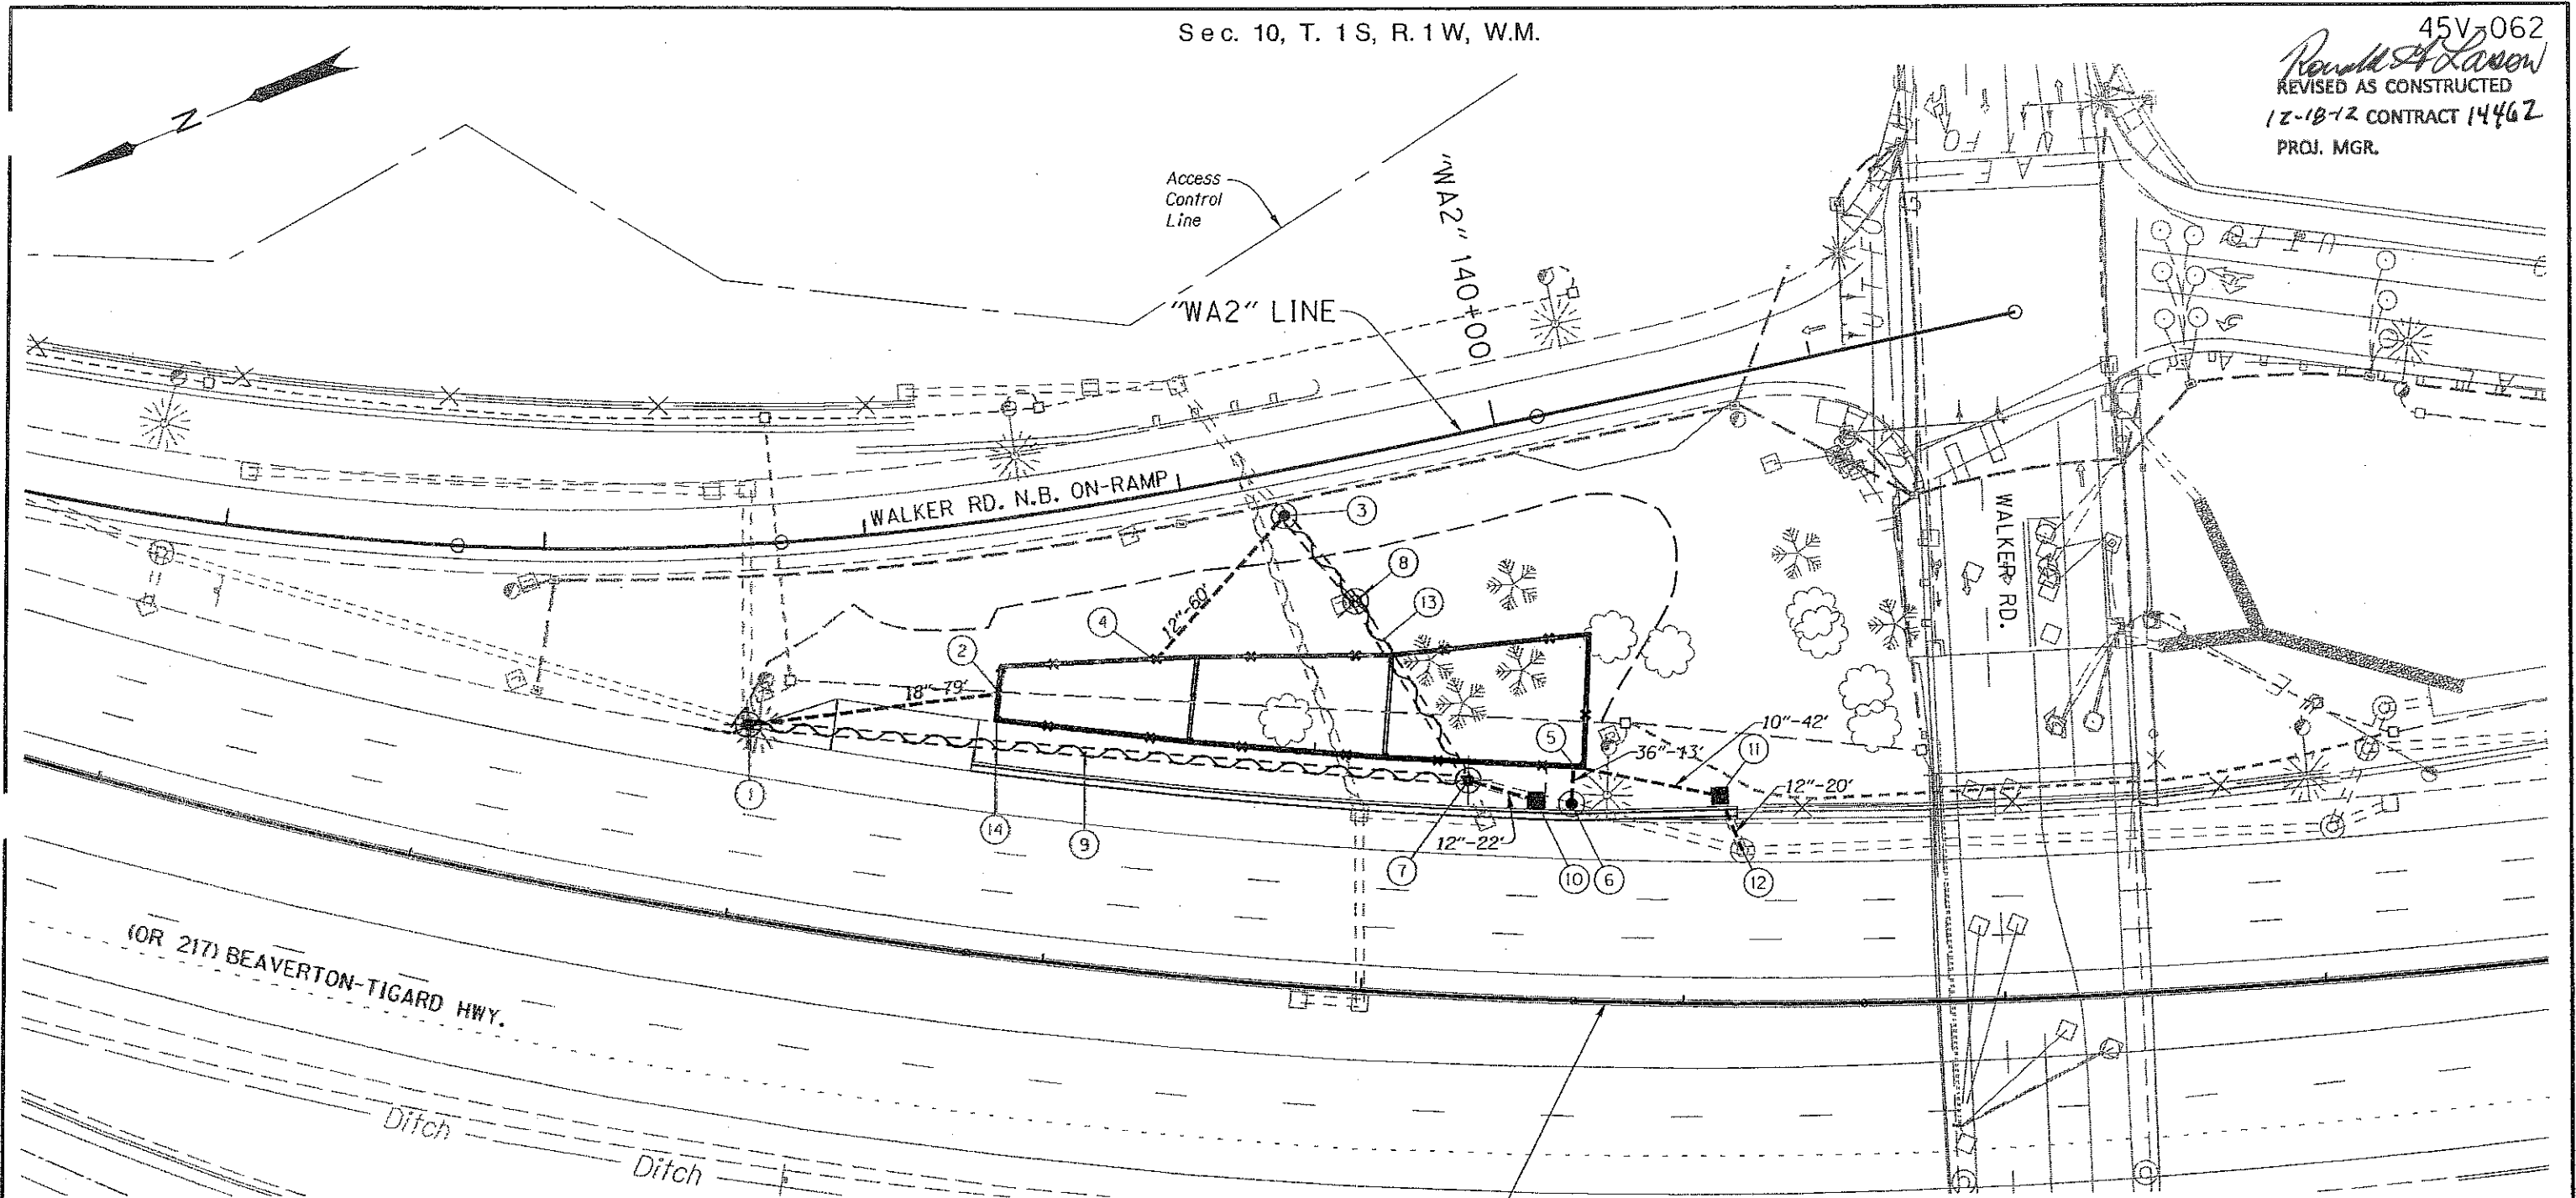

- Notes:**
1. Contractor to design and construct a temporary Drainage facility in conformance with section 00240 Of the specifications.
  2. The estimated 25 year flow at manhole (3) is 2 CFS.

Remove abandoned storm sewer pipe filled with cdf

Remove or abandon storm sewer pipe

REGISTERED PROFESSIONAL ENGINEER 58552  
*Christine J. Higgins*  
 OREGON  
 JULY 21, 1998  
 CHRISTINE J. HIGGINS  
 EXPIRES 06-30-13

**OREGON DEPARTMENT OF TRANSPORTATION**

DAVID EVANS AND ASSOCIATES, INC.  
 2100 Southwest River Parkway  
 Portland Oregon 97201 Ph: 503.223.6663

**OR 217: SUNSET HWY - TV HWY DETENTION FACILITY**  
 BEAVERTON - TIGARD HIGHWAY  
 WASHINGTON COUNTY

Reviewed By - Terry Wheeler  
 Designed By - Karina Nordahl  
 Drafted By - Mike Youngs

**DRAINAGE AND UTILITIES**

SHEET NO. 3B

*Ronald Larson*  
 REVISED AS CONSTRUCTED  
 12-18-12 CONTRACT 14462  
 PROJ. MGR.

59.99'  
 ① Sta. "L217NB" 137+96.21, 65.87' Lt.  
 Protect extg. manhole  
 Connect 18" storm sew. pipe to extg. manhole

⑭ Inst. field facility marker, Type S1 Red  
 Inst. field facility marker, Type S1 Green  
 Inst. field facility marker, Type S2  
 (For details, see sht. GJ-2)

② Sta. "L217NB" 138+76.45, 80.92' Lt. =  
 Sta. "DT" 0+00.07, 7.90' Lt.  
 Connect 18" storm sew. pipe through wall  
 Inst. 18" storm sew. pipe - 79'  
 10' depth  
 (For details, see drawing 88095)  
 (See drg. no. RD300)

③ Sta. "L217NB" 139+64.28, 144.87' Lt.  
 Const. manhole over extg. pipe  
 (See drg. nos. RD336, RD344 & RD356)

④ Sta. "L217NB" 139+26.06, 96.49' Lt. =  
 Sta. "DT" 0+47.60, 23.27' Lt.  
 Connect 12" storm sew. pipe through wall  
 Inst. 12" storm sew. pipe - 60'  
 5' depth  
 (For details, see drawing 88093)

⑤ Sta. "L217NB" 140+63.61, 73.07' Lt. =  
 Sta. "DT" 1+80.41, 0.00' Rt.  
 Connect 36" storm sew. pipe through wall  
 (For details, see drawing 88093)

⑥ Sta. "L217NB" 140+63.42, 61.87' Lt.  
 Const. flow control manhole over extg. sew. - 60" dia.  
 Inst. 36" storm sew. pipe - 13'  
 10' depth  
 (For details, see sht. GJ)  
 (See drg no. RD346)

⑦ Sta. "L217NB" 140+30.38, 67.85' Lt.  
 Minor adjust manhole  
 Inst. 12" ductile iron storm sew. pipe - 22'  
 5' Depth  
 Connect to extg. manhole

⑧ Remove extg. manhole


⑨ Pipe to remain functioning  
 during construction to maintain  
 conveyance for stormwater

⑩ Sta. "L217NB" 140+52.60, 60.88' Lt.  
 Const. type G-2 inlet  
 (See drg. no. RD364)

⑪ Sta. 141+10.74, 64.52' Lt.  
 Remove extg. inlet  
 Const. type G2-MA inlet  
 Inst. 10" storm sew. pipe - 42'  
 10' Depth  
 (For details, see drawings 88092 and 88095)  
 (See drg. no. RD364)


⑫ Sta. 141+19.00, 46.39' Lt.  
 Sta. 141+18.21, 47.50' Lt.  
 Inst. 12" storm sew. pipe - 20'  
 10' depth  
 Connect to extg. manhole  
 (See drg. no. RD302)

⑬ Construct temporary drainage facility

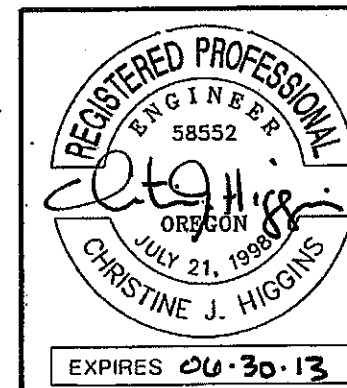



<b>OREGON DEPARTMENT OF TRANSPORTATION</b>	
DAVID EVANS AND ASSOCIATES, INC. 2100 Southwest River Parkway Portland Oregon 97201 Ph: 503.223.6663	
<b>OR 217: SUNSET HWY - TV HWY DETENTION FACILITY</b> BEAVERTON - TIGARD HIGHWAY WASHINGTON COUNTY	
Reviewed By - Terry Wheeler Designed By - Karina Nordahl Drafted By - Mike Youngs	
<b>DRAINAGE AND UTILITY NOTES</b>	SHEET NO. 3B-2

45V-062  
*Ronald Lawson*  
 REVISOR AS CONSTRUCTED  
 12-18-12 CONTRACT 14462  
 PROJ. MGR.

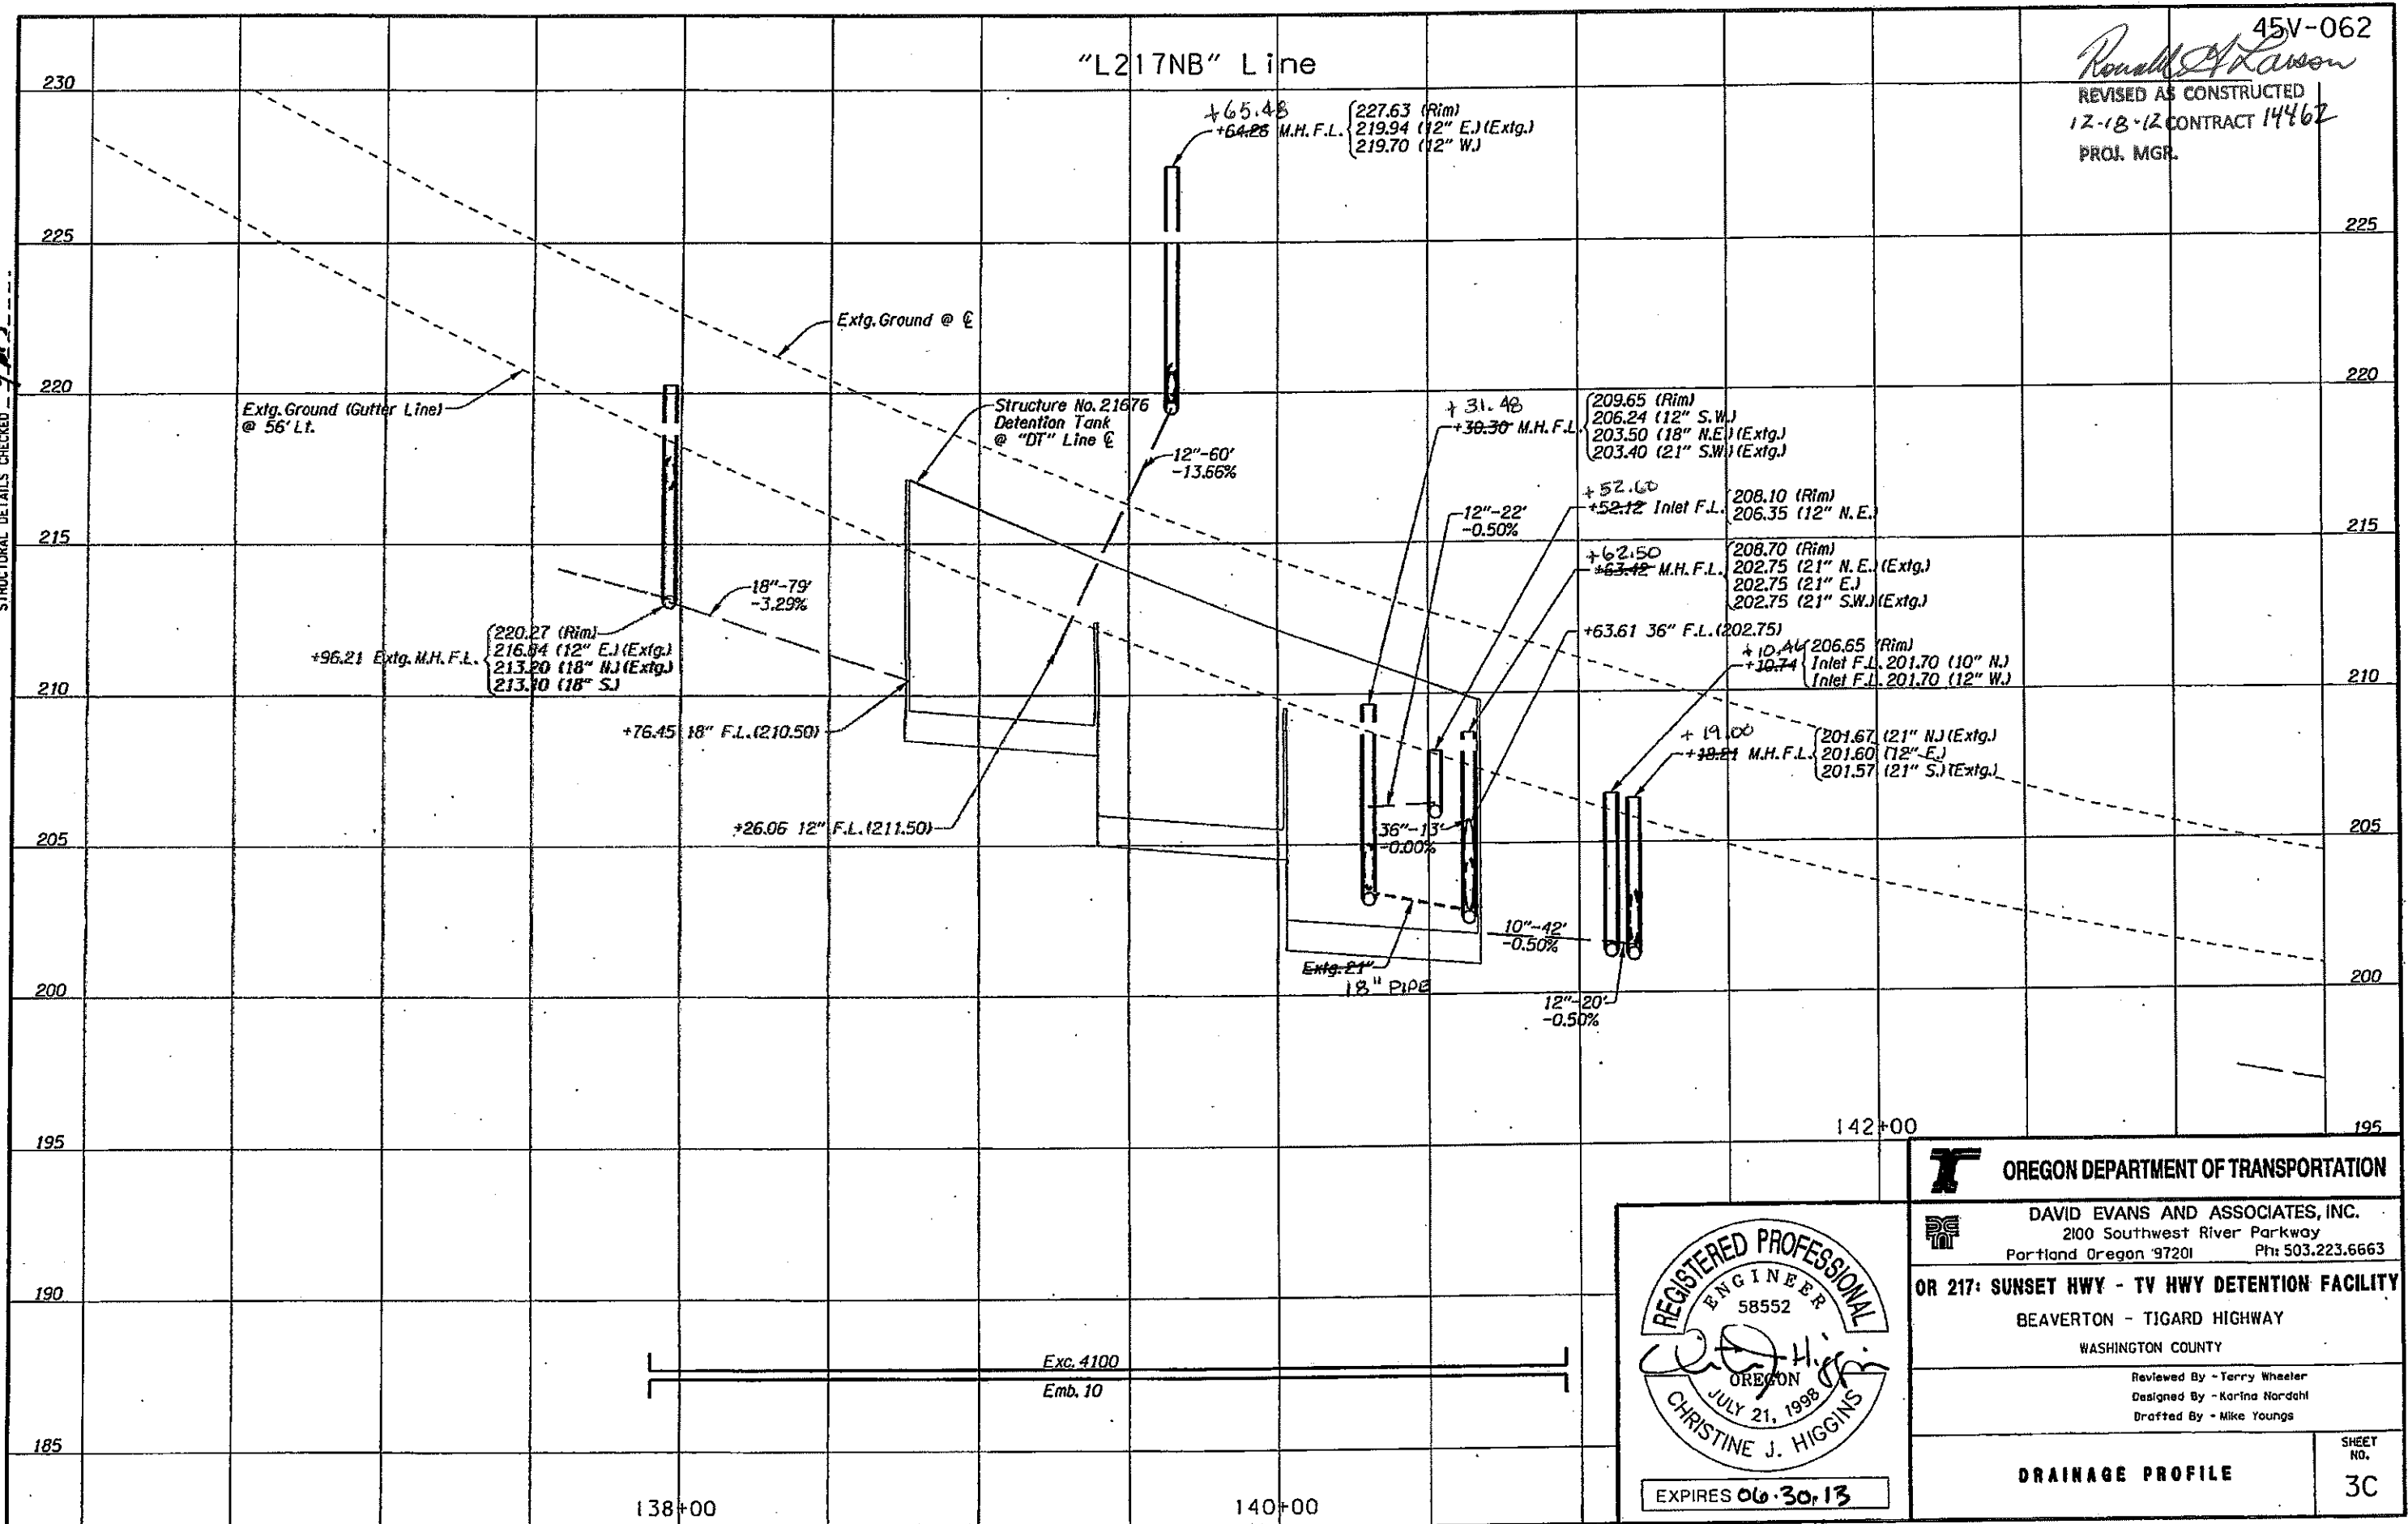

STRUCTURAL DETAILS CHECKED  
*AMS*


142+00

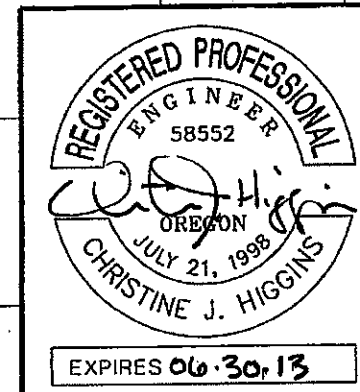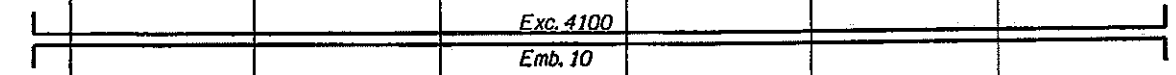


<b>OREGON DEPARTMENT OF TRANSPORTATION</b>	
DAVID EVANS AND ASSOCIATES, INC. 200 Southwest River Parkway Portland Oregon 97201 Ph: 503.223.6663	
<b>OR 217: SUNSET HWY - TV HWY DETENTION FACILITY</b>	
BEAVERTON - TIGARD HIGHWAY WASHINGTON COUNTY	
Reviewed By - Terry Wheeler Designed By - Karina Nordahl Drafted By - Mike Youngs	
<b>DRAINAGE PROFILE</b>	SHEET NO. <b>3C</b>

A5V-062


*Ronald Larson*  
 REVISED AS CONSTRUCTED  
 12-10-12 CONTRACT 14462  
 PROJ. MGR.

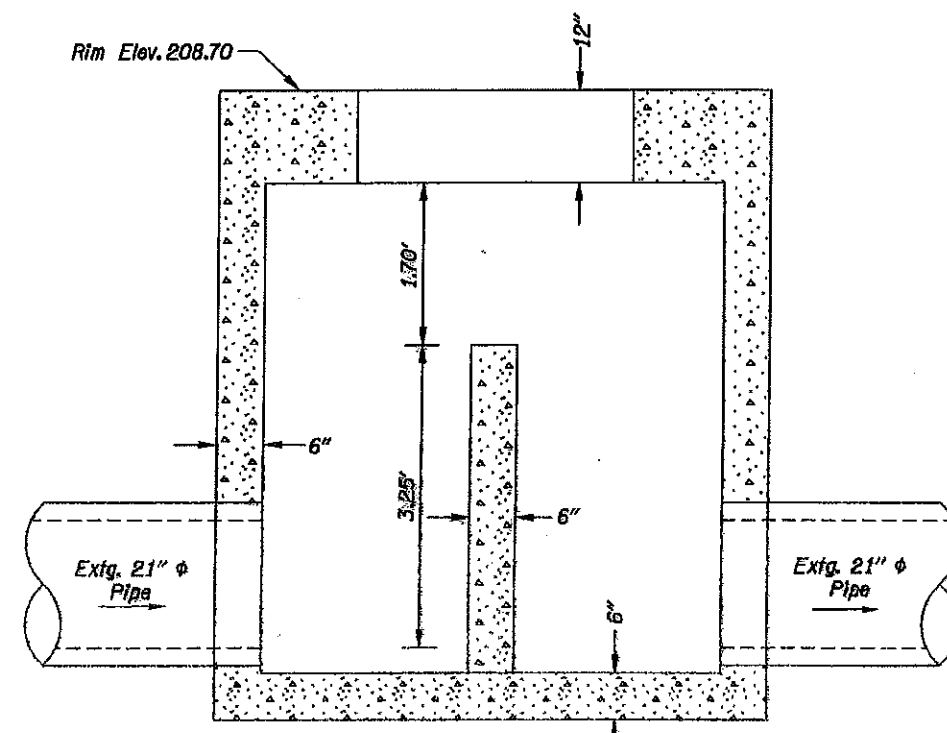

**SECTION A-A**  
(NTS)

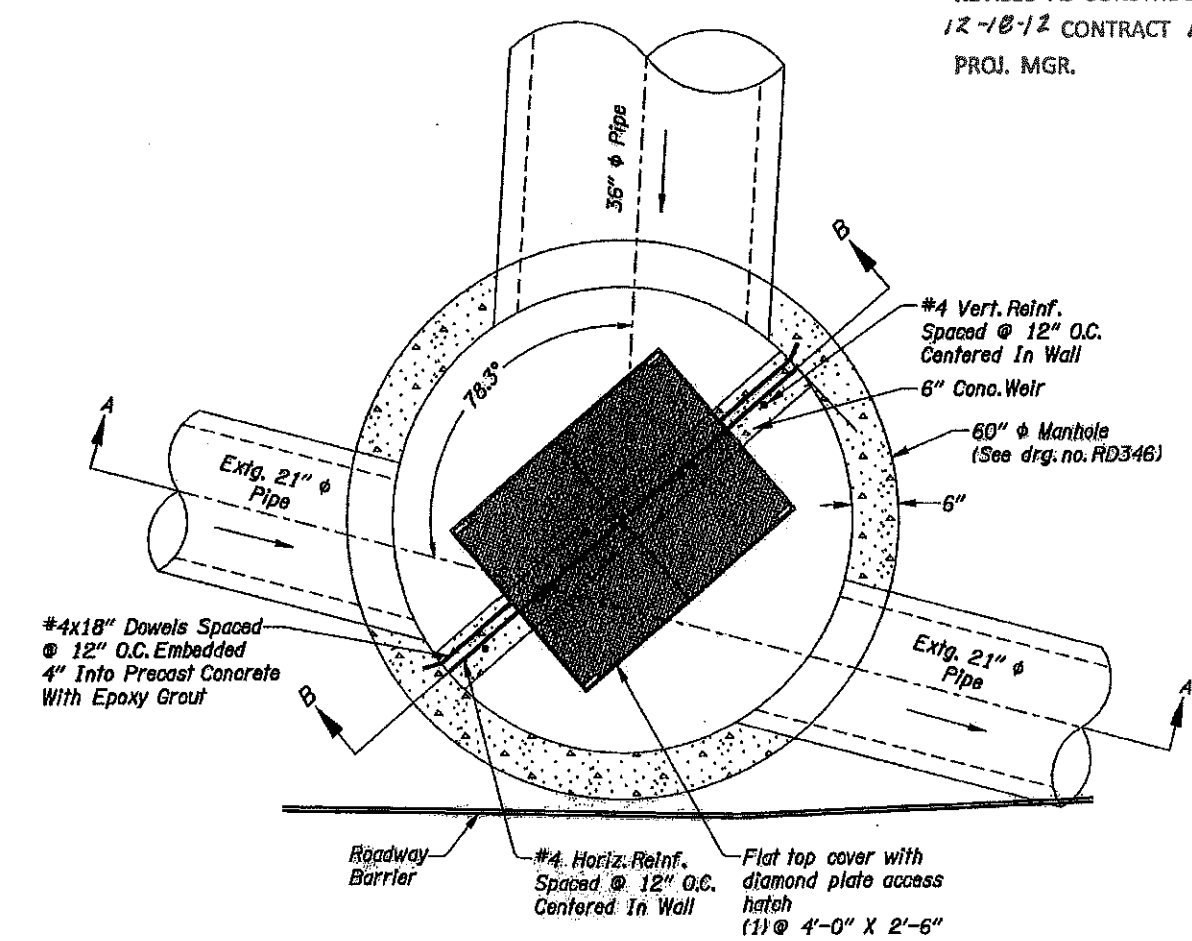


**FLOW CONTROL MANHOLE PLAN VIEW**  
(NTS)

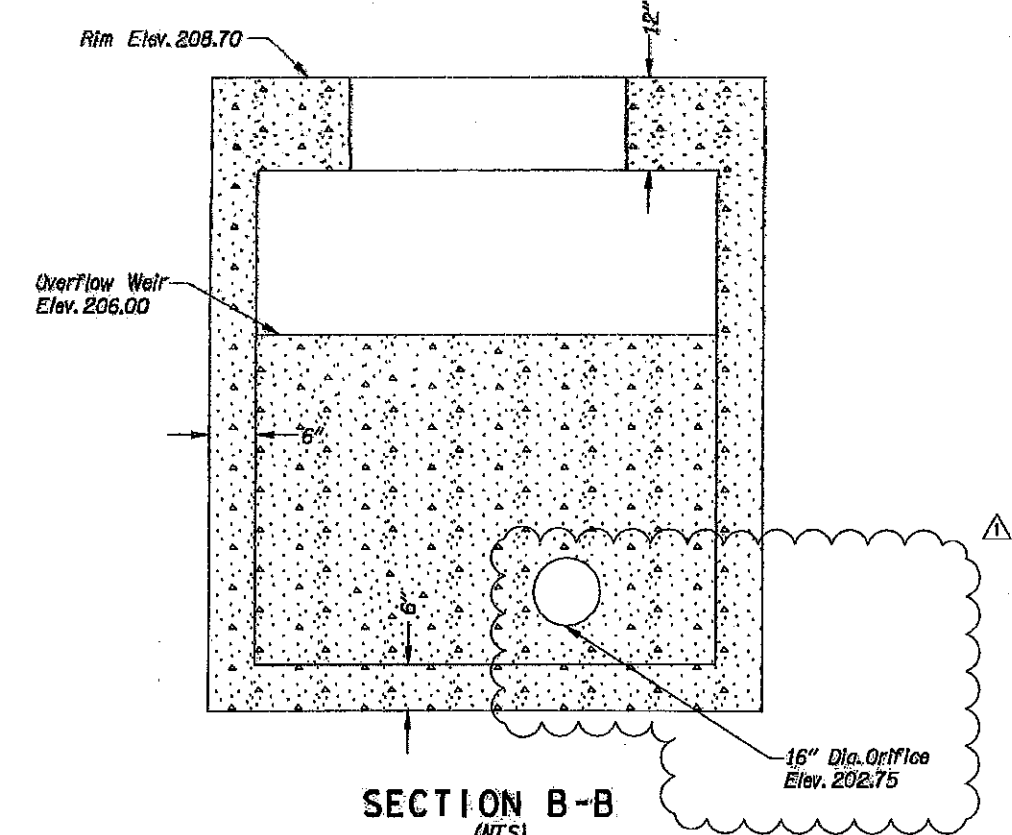

**SECTION B-B**  
(NTS)

Revisions
Revised 4-13-2012 Storm Sewer Modifications

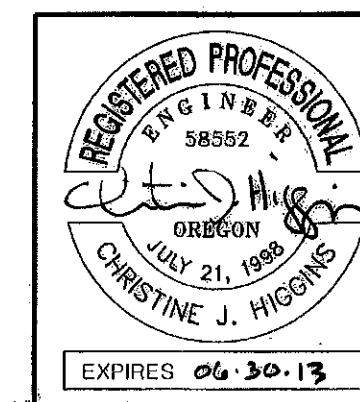

<b>OREGON DEPARTMENT OF TRANSPORTATION</b>	
DAVID EVANS AND ASSOCIATES, INC. 2100 Southwest River Parkway Portland Oregon 97201 Ph: 503.223.6663	
<b>OR 217: SUNSET HWY - TV HWY DETENTION FACILITY</b> BEAVERTON - TIGARD HIGHWAY WASHINGTON COUNTY	
Reviewed By - Terry Wheeler Designed By - Karina Nordahl Drafted By - Mike Youngs	
<b>DRAINAGE DETAILS</b>	SHEET NO. GJ

*Ronald W. Larson*  
 REVISED AS CONSTRUCTED  
 12-18-12 CONTRACT 14462  
 PROJ. MGR.

SEE NOTE AT TOP OF  
 STANDARD DETAIL #020.  
 FOR LARGE DIAMETER  
 MANHOLES SEE  
 STANDARD DETAIL #160

NOTES:

1. ALL MANHOLE SECTIONS SHALL CONFORM TO THE REQUIREMENTS OF ASTM C-478 AND APPLICABLE PROVISIONS OF STD. MANHOLE DRAWING NO. 010
2. INLET AND OUTLET PIPE NOT TO EXCEED 18" DIA.
3. PROVIDE SPECIAL DETAIL FOR OUTLET FLOW CONTROL EXCEEDING 18" DIA.
4. ALL OUTLETS SHALL HAVE FLOW CONTROL DEVICE.

ALL HOODS AND TRAPS FOR CATCH BASINS AND WATER QUALITY STRUCTURES SHALL BE AS MANUFACTURED BY:  
 BEST MANAGEMENT PRODUCTS, INC.  
 53 MT. ARCHER RD.  
 LYME, CT 06371  
 (888) 434-0277, (860) 434-3195  
 FAX TOLL FREE: (800) 504-8008  
 OR (888) 354-7585  
 WEB SITE: WWW.BESTMP.COM  
 OR PRE-APPROVED EQUAL

SUMP VOLUME AVAILABLE


MINIMUM	MAXIMUM	
60" M.H.=	58.9 CF	98.1 CF
72" M.H.=	84.8 CF	141.3 CF
84" M.H.=	115.4 CF	192.3 CF

PROVIDE SPECIAL DETAIL FOR VOLUME REQUIREMENTS EXCEEDING 192.3 CF

SUMP VOLUME REQUIREMENTS

20 CF/1.0 CFS OF INFLOW


58.9 CF MINIMUM REQUIRED

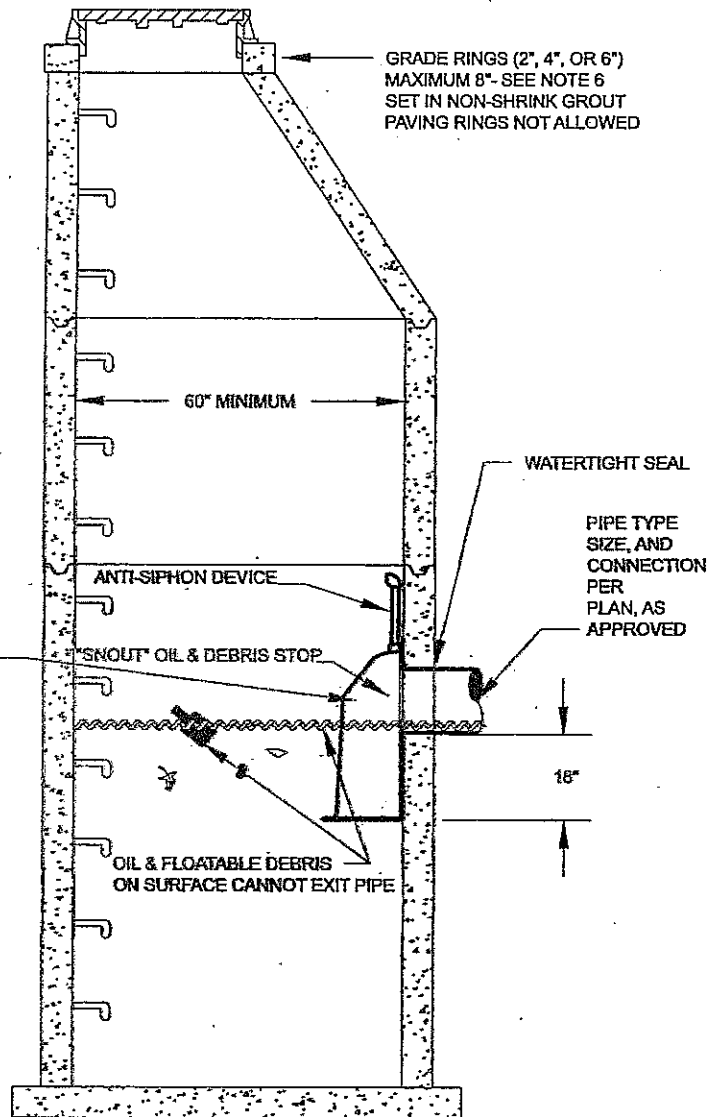



WATER QUALITY  
 MANHOLE (SNOUT) A

DRAWING NO. 250

REVISED 12-06

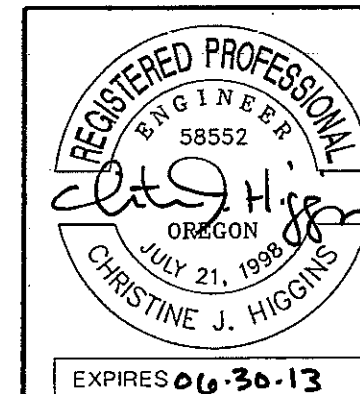


OREGON DEPARTMENT OF TRANSPORTATION	
DAVID EVANS AND ASSOCIATES, INC. 2100 Southwest River Parkway Portland Oregon 97201 Ph: 503.223.6663	
OR 217: SUNSET HWY - TV HWY DETENTION FACILITY BEAVERTON - TIGARD HIGHWAY WASHINGTON COUNTY	
Reviewed By - Terry Wheeler Designed By - Christine Higgins Drafted By - Mike Youngs	
DRAINAGE DETAILS	SHEET NO. GJ-3

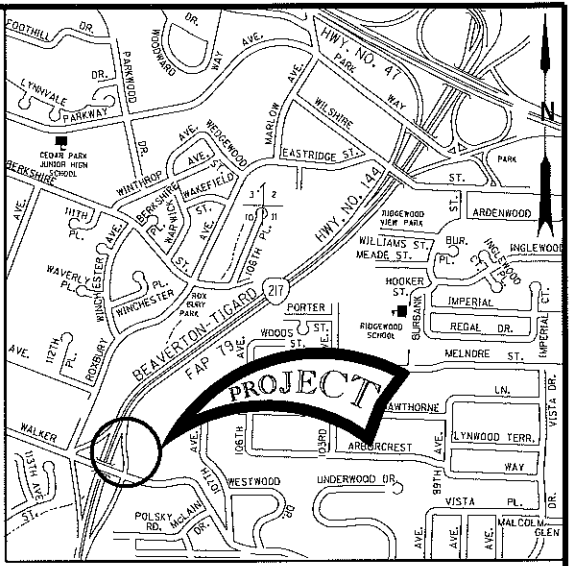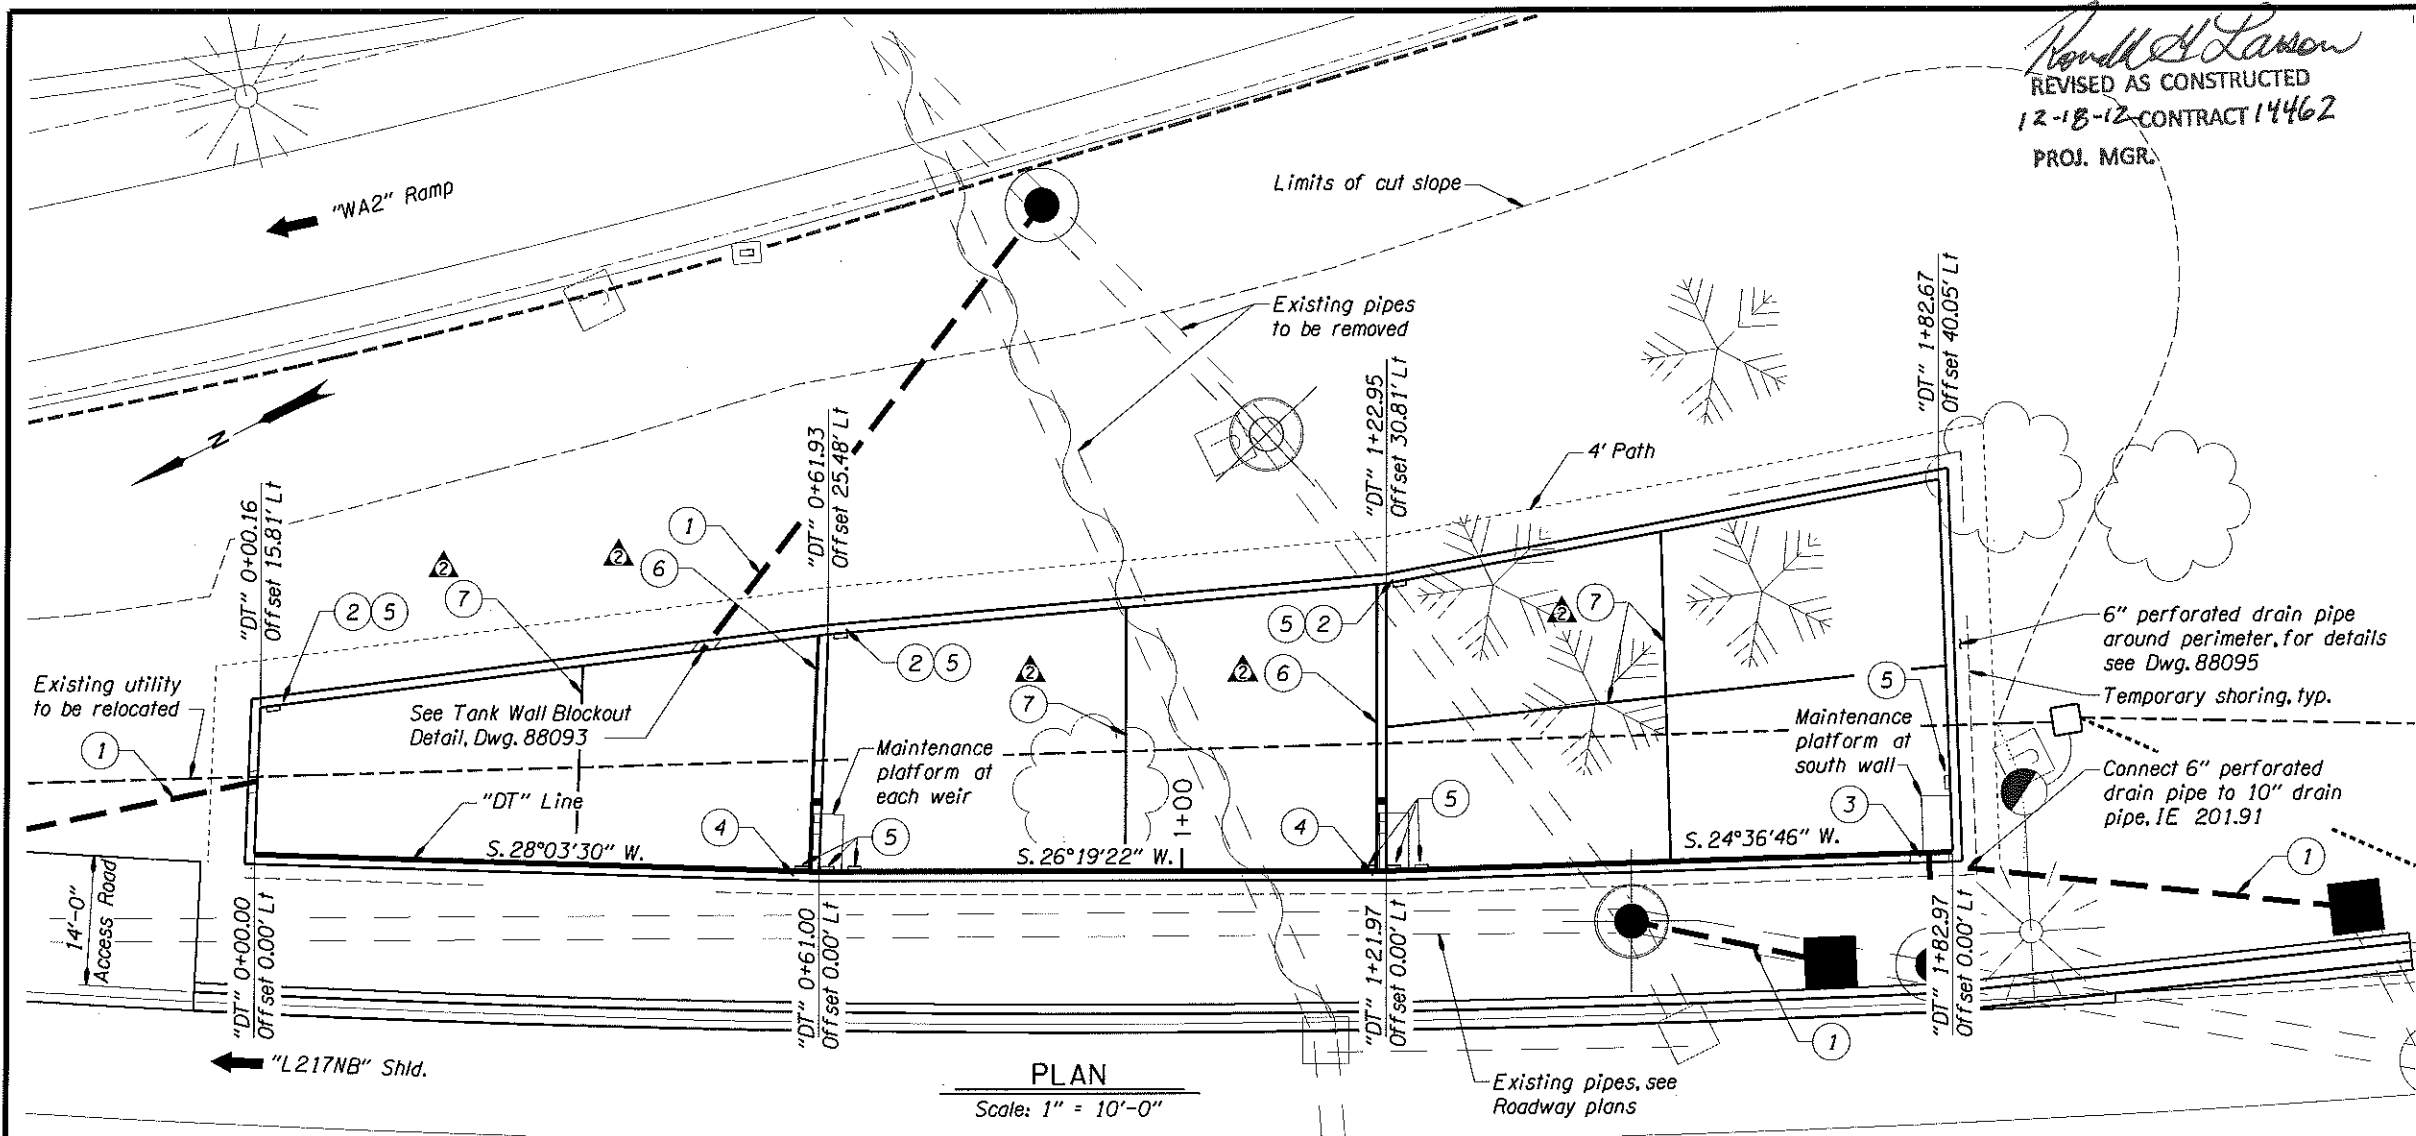

Sec. 10 T. 1 S., R. 1 W., W.M.  
**LOCATION MAP**  
 No Scale

- 1 See Rdwy. plans for drainage details.
- 2 Install 3' single maintenance gate
- 3 Install 12' single maintenance gate
- 4 Install 12' double maintenance gate (See Fence Notes Dwg. 88093)
- 5 Install maintenance ladder For Ladder details see RD336.
- 6 Construct expansion joint.
- 7 Construct contraction joint.

**PLAN**  
 Scale: 1" = 10'-0"

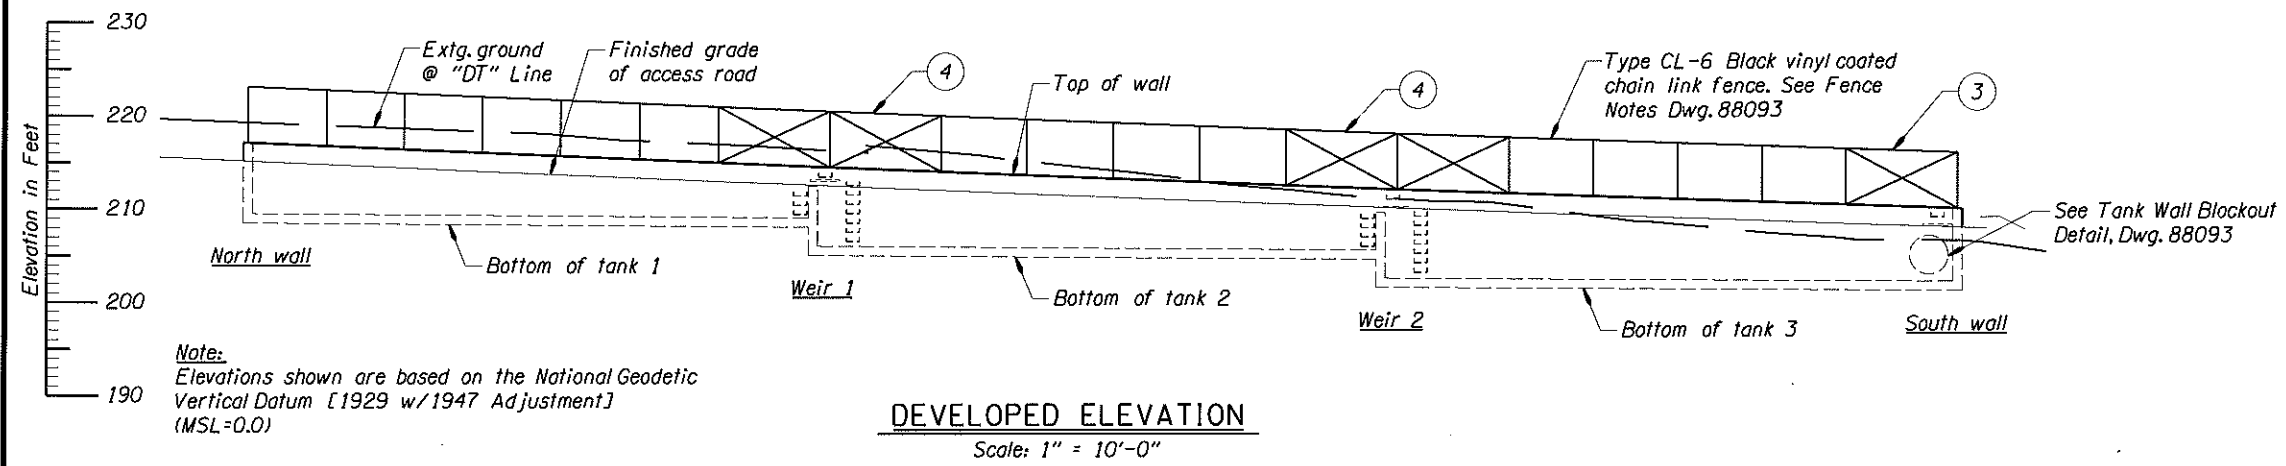

**DEVELOPED ELEVATION**  
 Scale: 1" = 10'-0"

<table border="1"> <thead> <tr> <th>DATE</th> <th>REVISION</th> <th>BY</th> </tr> </thead> <tbody> <tr> <td>4-13-12</td> <td>FORMATTING</td> <td>AMB</td> </tr> <tr> <td>7-08-13</td> <td>As Constructed</td> <td>AMB</td> </tr> </tbody> </table>	DATE	REVISION	BY	4-13-12	FORMATTING	AMB	7-08-13	As Constructed	AMB	DRAFTER: Alan Mitchell DESIGNER: Laura Barker CHECKER: Amanda Blankenship REVIEWER: Terry Stones	<b>As Constructed</b> This drawing has had as-constructed comments added. Original stamped & signed design mylar is stored at Salem Headquarters.	<b>OREGON DEPARTMENT OF TRANSPORTATION</b> DAVID EVANS AND ASSOCIATES INC. 530 Center Street, N.E., Suite 605 Salem, Oregon 97301 Phone: 503.381.8835	STRUCTURE NO. 21676 DATE March - 2012 CALC. BOOK 6484	DETENTION STRUCTURE, HWY 144 NB AT M.P. 0.85, LEFT OR217; SUNSET HWY-TV HWY DETENTION FACILITY BEAVERTON-TIGARD HWY NO. 144 M.P. 0.85 WASHINGTON COUNTY <b>PLAN AND ELEVATION</b>	SHEET 1 OF 7 DRAWING NO. 88092
DATE	REVISION	BY													
4-13-12	FORMATTING	AMB													
7-08-13	As Constructed	AMB													

**GENERAL NOTES:**

All material and workmanship shall conform to the 2008 Oregon Standard Specifications for Highway Construction of the Oregon Department Transportation (ODOT), as supplemented by the Special Provisions.

Foundation excavations shall be examined and approved by the Soils Engineer or his Representative. See Project Specifications and the Geotechnical Report for material and method of compaction and backfill.

Walls are designed in accordance to the 2010 AASHTO Load and Resistance Factor Design (LRFD) Bridge Design Specifications.

	Density	Internal friction angle
Foundation soils:	120 pcf	30°
Wall backfill:	135 pcf	34°

Factored Bearing Resistance = 2500 psf

For lateral pressure and other design criteria, see Geotechnical Engineering Memo by GeoDesign.

All reinforcing steel shall conform to AASHTO M31, Grade 60, ASTM Specification A706 or A615, grade 60. Use the following splice lengths (unless shown otherwise):

Reinforcing Splice Lengths (Class B)											
Bar Size	#3	#4	#5	#6	#7	#8	#9	#10	#11	#14	#18
Uncoated	1'-5"	1'-10"	2'-4"	2'-9"	3'-5"	4'-6"	5'-9"	7'-3"	8'-11"	Not Permitted	

Splice reinforcing steel at alternate bars, staggered at least one splice length or as far as possible, unless shown otherwise.

All reinforcing shall have 2" of concrete cover unless shown otherwise.

All reinforcing spacing is intended to be maximum unless otherwise noted.


Provide a 3/4" chamfer on all exposed concrete edges unless noted otherwise.

Provide Class 4000 - 1/2", 1", or 3/4" Foundation Concrete in base 1'-0" slabs.

Provide Class 4000 - 1/2", 1", or 3/4" General Structure Concrete for all other concrete.

**Fence Notes:**


- Type CL-6 Black Vinyl Coated Chain Link Fence, see RDB15 for details. Use 3 1/2" fabric w/2" dia. std. steel pipe line post, 2 1/2" dia. std. steel pipe end/corner post. Provide pipe conforming to ASTM A53 Grade B.
- Concrete anchors will be 3/4" x 10" grade 36 anchor bolts. Install according to Type "B" fence specifications. See BR240-BR242 for details.
- Chain link fencing shall be black vinyl coated over galvanizing. Galvanize posts and base plates after fabrication. Field coat installed anchors and nuts.

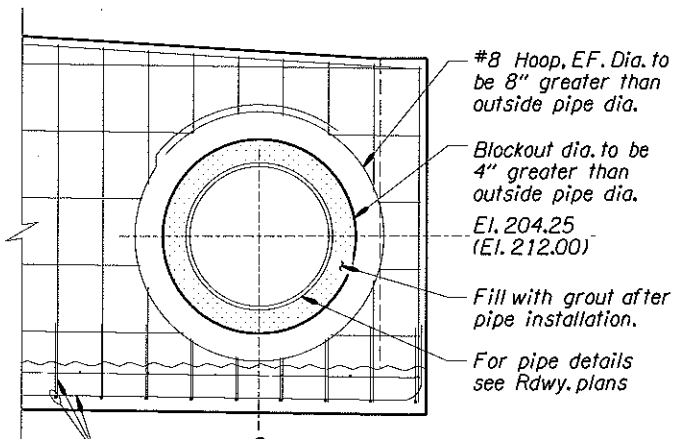

**Notes:**  
Align blockouts with pipe alignment.  
Adjust all reinf. to maintain 2" clear of blockout.  
( ) = Dimensions and elevations for blockout in tank 1 east wall.

**TANK WALL BLOCKOUT DETAIL**

Scale: 1/2" = 1'-0"

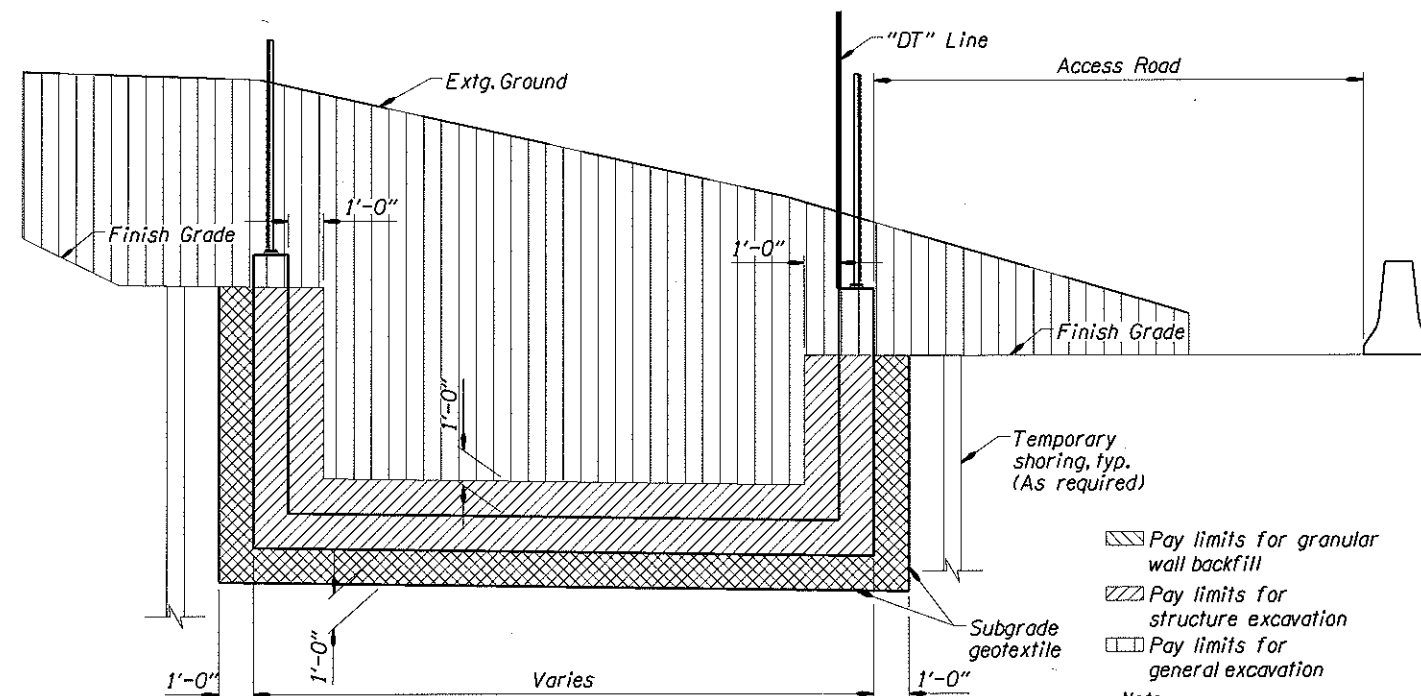


**TYPICAL TRANSVERSE SECTION**

- Pay limits for granular wall backfill
- Pay limits for structure excavation
- Pay limits for general excavation

**Note:**  
Place backfill behind walls at equal lifts.

*Ronald Lawson*  
REVISED AS CONSTRUCTED  
12-18-12 CONTRACT 14462  
PROJ. MGR.

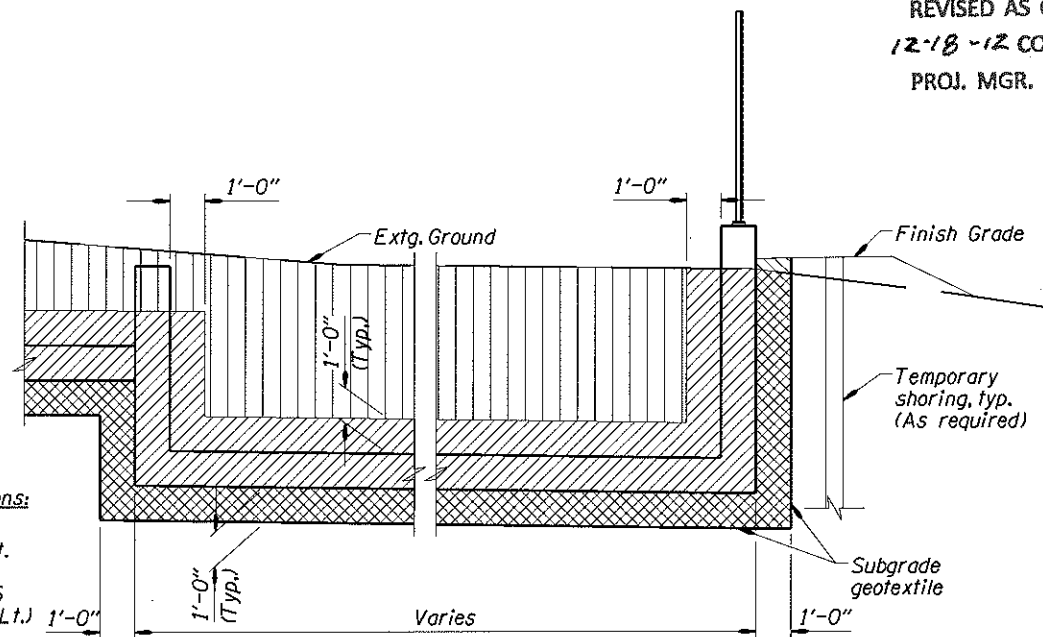

**TYPICAL LONGITUDINAL SECTION EXCAVATION/BACKFILL DIAGRAM**

No Scale




DATE 7-08-13	REVISION As Constructed	BY AMB	DRAFTER Alan Mitchell	As Constructed This drawing has had as-constructed comments added. Original stamped & signed design mylar is stored at Salem Headquarters.	STRUCTURE NO. 21676	DETENTION STRUCTURE, HWY 144 NB AT M.P. 0.85, LEFT OR217: SUNSET HWY-TV HWY DETENTION FACILITY BEAVERTON-TIGARD HWY NO. 144 M.P. 0.85 WASHINGTON COUNTY	SHEET 2 OF 7
			DESIGNER Laura Barker		DATE March - 2012		DRAWING NO. 88093
ACCOMPANIED BY DWGS. See Sheet 1 for this structure			CHECKER Amanda Blankenship	REVIEWER Terry Stones	CALC. BOOK 6484	GENERAL NOTES	



**SCALE WARNING**  
If scale bar doesn't measure one inch then drawing is not to scale



REVISED AS CONSTRUCTED  
 12-18-12 CONTRACT 14462  
 PROJ. MGR.  
*Ronald Larson*

**LEGEND OF MATERIALS**

-  CLAY
-  SILT
-  SILTY GRAVEL

**Notes:**  
 Contours shown are existing.

Geotechnical data shown on this drawing are a consolidation of and/or revision in terminology from the drill logs. The drill logs and any other exploration data used in compiling this drawing are available upon request. Contractor shall refer to the Geotechnical Reports and drill logs and the information contained therein.

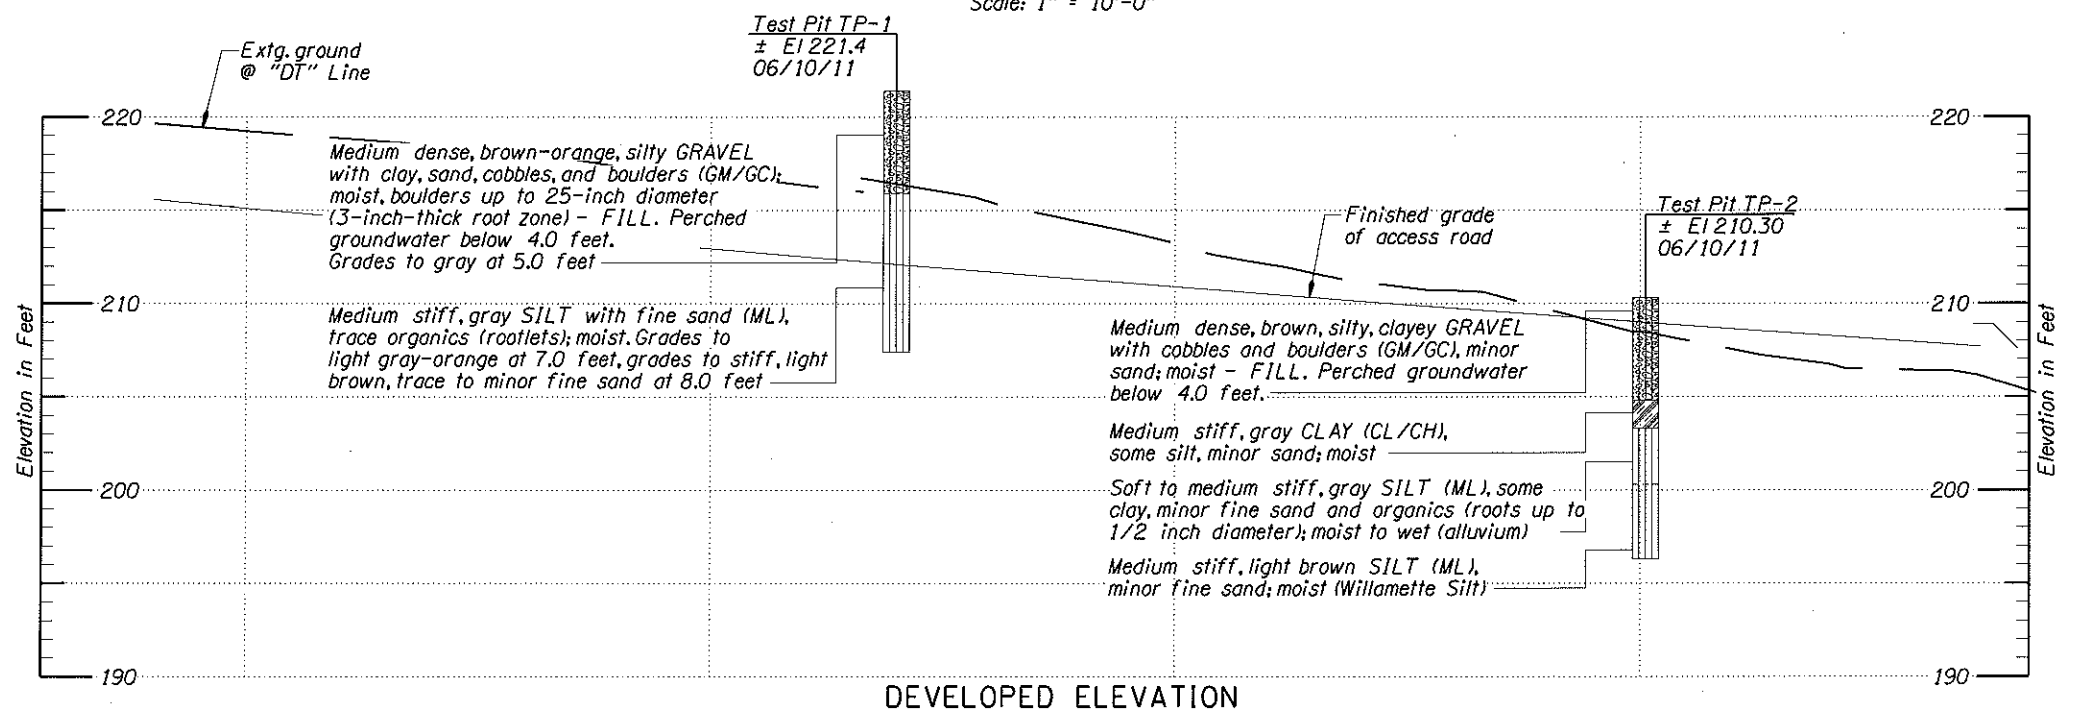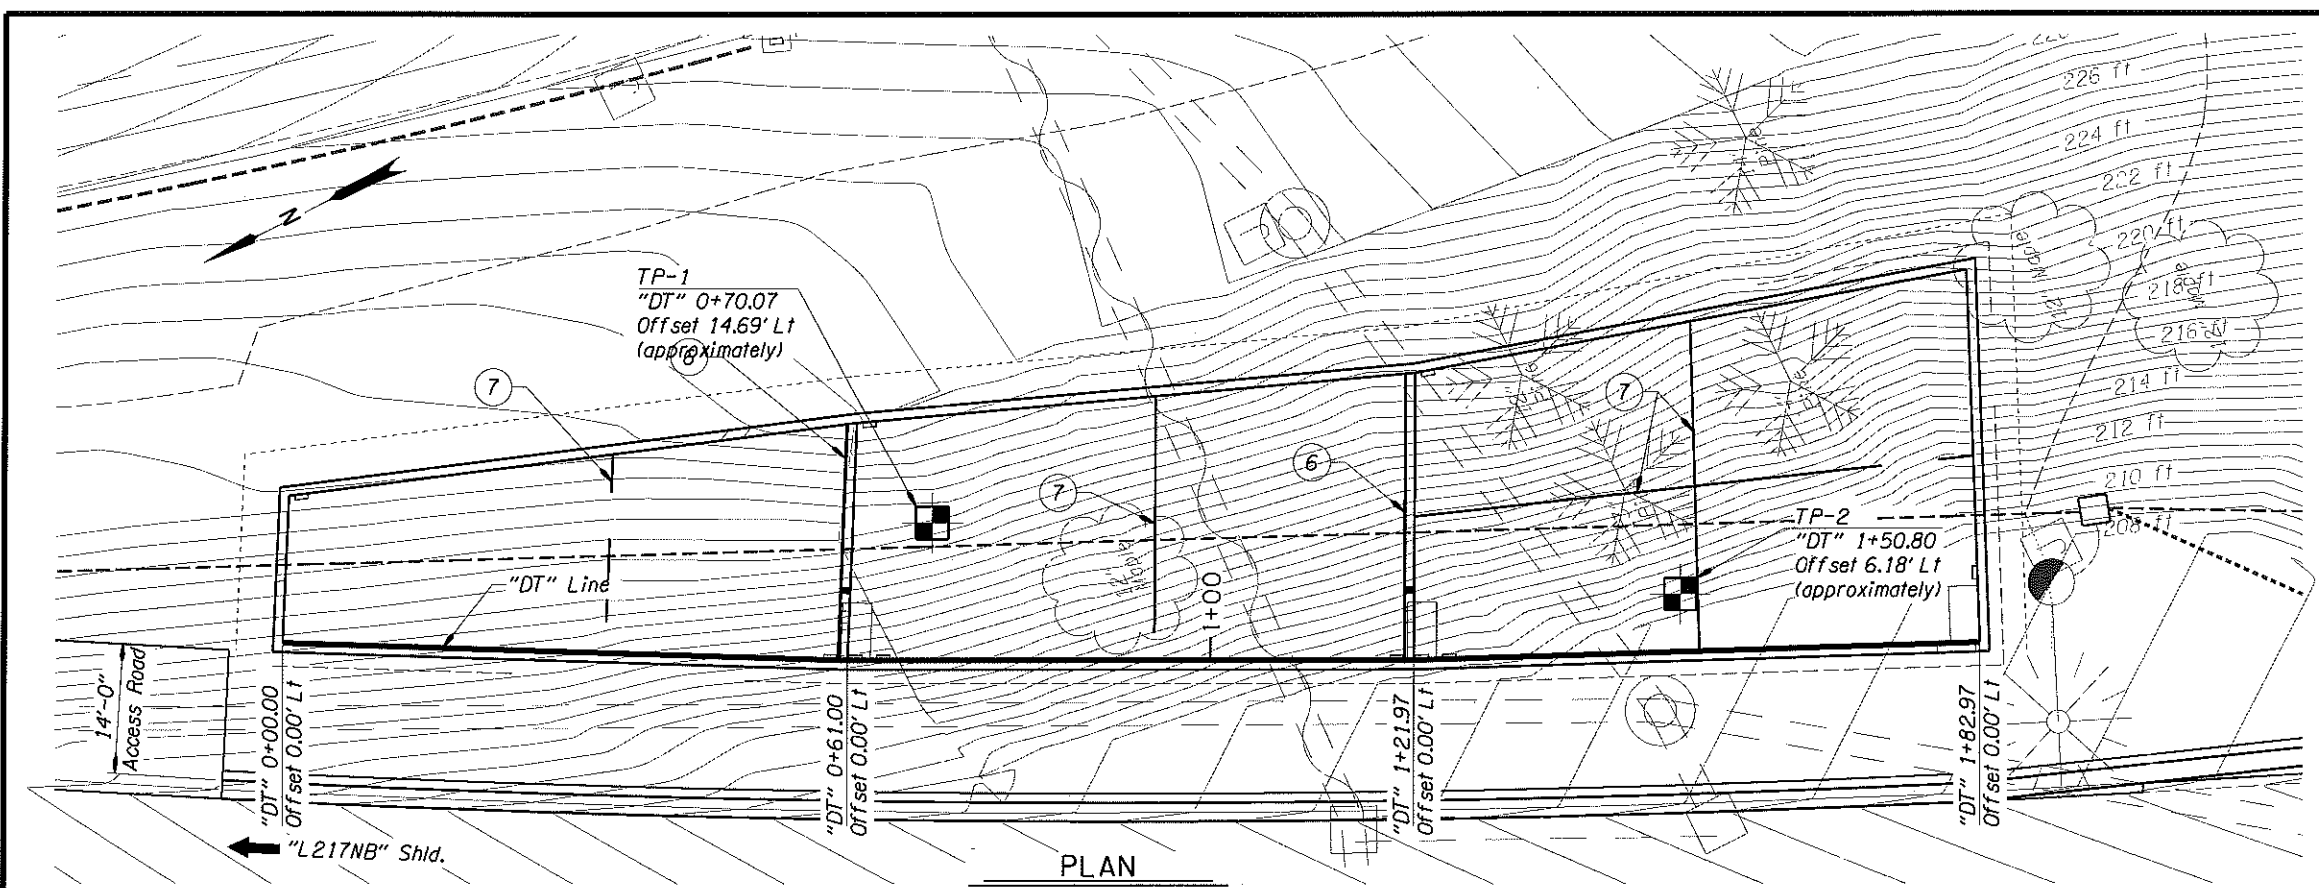


▲	DATE	REVISION	BY	DRAFTER: <i>Alan Mitchell</i>	As Constructed	STRUCTURE NO. 21676	DETENTION STRUCTURE, HWY 144 NB AT M.P. 0.85, LEFT OR217: SUNSET HWY-TV HWY DETENTION FACILITY BEAVERTON-TIGARD HWY NO. 144 M.P. 0.85 WASHINGTON COUNTY	SHEET 3 OF 7
	7-08-13	As Constructed	JDF					
ACCOMPANIED BY DWGS. See Sheet 1 for this structure				CHECKER: <i>Joe Heidgerken</i>	This drawing has had as-constructed comments added. Original stamped & signed design mylar is stored at Salem Headquarters.	CALC. BOOK 6484	FOUNDATION DATA	88094
				REVIEWER: <i>Jeff Tucker</i>		EXPIRES: 6-30-2012		



SCALE WARNING  
 If scale bar doesn't measure one inch then drawing is not to scale




*Ronald L. Lawson*  
 REVISED AS CONSTRUCTED  
 12-18-12 CONTRACT 14462  
 PROJ. MGR.

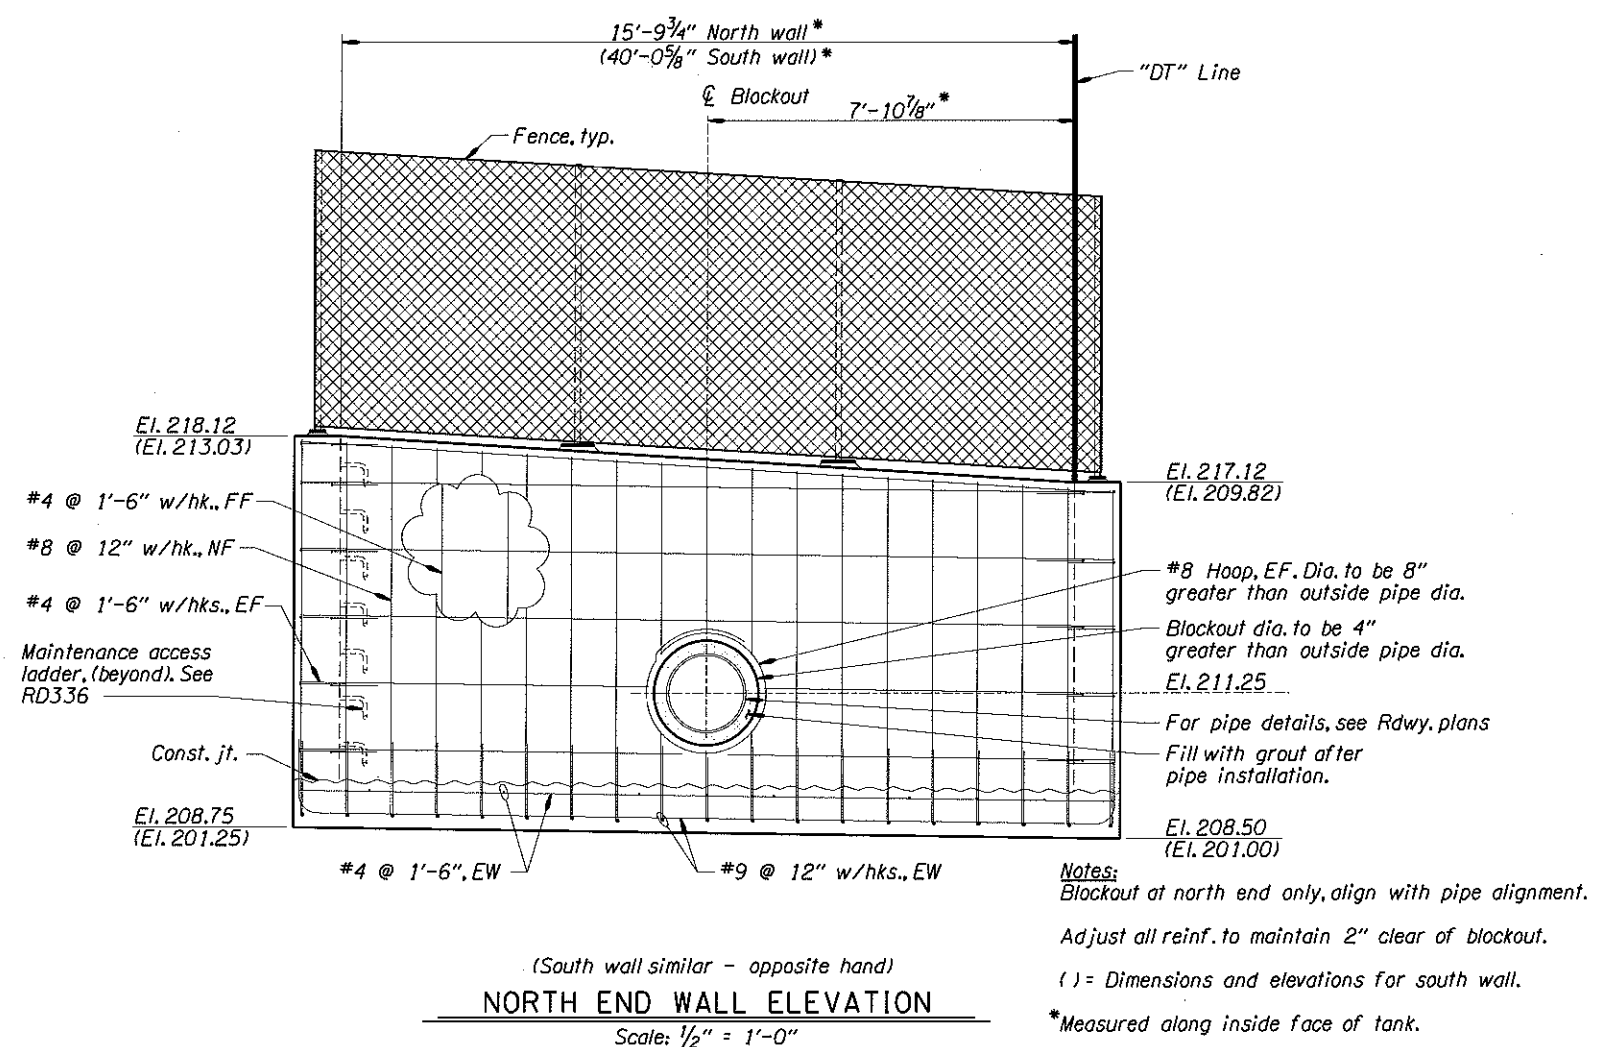

(South wall similar - opposite hand)  
**NORTH END WALL ELEVATION**  
 Scale: 1/2" = 1'-0"


**Notes:**  
 Blockout at north end only, align with pipe alignment.  
 Adjust all reinf. to maintain 2" clear of blockout.  
 ( ) = Dimensions and elevations for south wall.  
 \*Measured along inside face of tank.

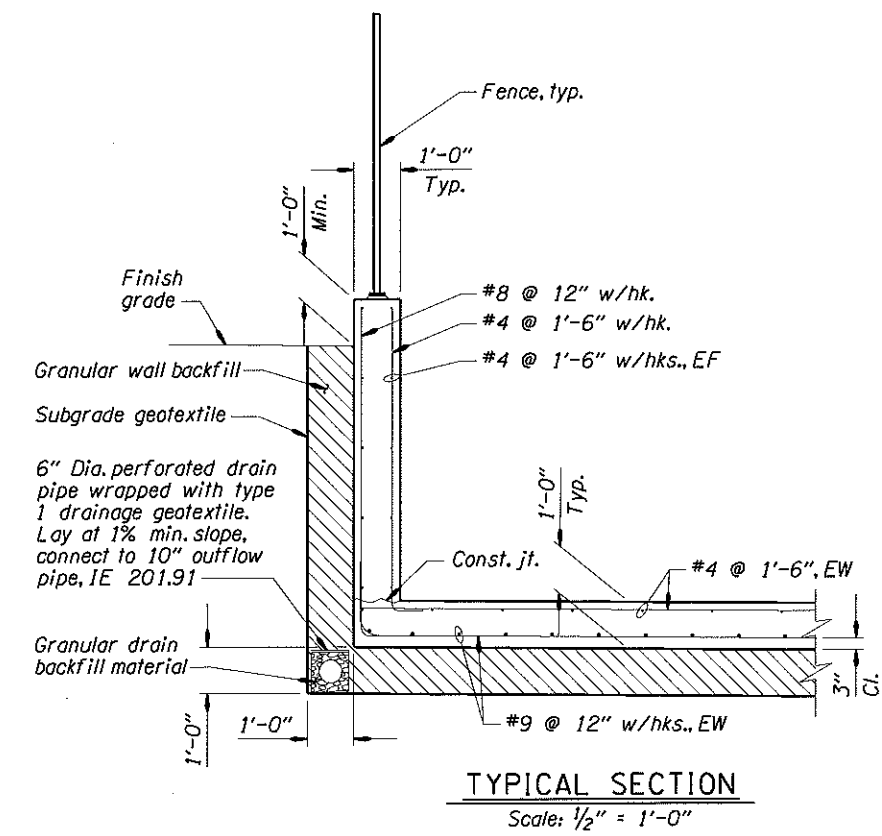


**TYPICAL SECTION**  
 Scale: 1/2" = 1'-0"

DATE 7-08-13	REVISION AS CONSTRUCTED	BY AMB	DRAFTER: Alan Mitchell	As Constructed This drawing has had as-constructed comments added. Original stamped & signed design mylar is stored at Salem Headquarters.	STRUCTURE NO. 21676	DETENTION STRUCTURE, HWY 144 NB AT M.P. 0.85, LEFT OR217: SUNSET HWY-TV HWY DETENTION FACILITY BEAVERTON-TIGARD HWY NO. 144 M.P. 0.85 WASHINGTON COUNTY	SHEET 4 OF 7
			DESIGNER: Laura Barker				
ACCOMPANIED BY DWGS. See Sheet 1 for this structure			CHECKER: Amanda Blankenship	SCALE WARNING If scale bar doesn't measure one inch then drawing is not to scale	CALC. BOOK 6484	WALL DETAILS	88095
			REVIEWER: Terry Stones				


*Ronald Larson*  
 REVISED AS CONSTRUCTED  
 12-18-12 CONTRACT 1446Z  
 PROJ. MGR.

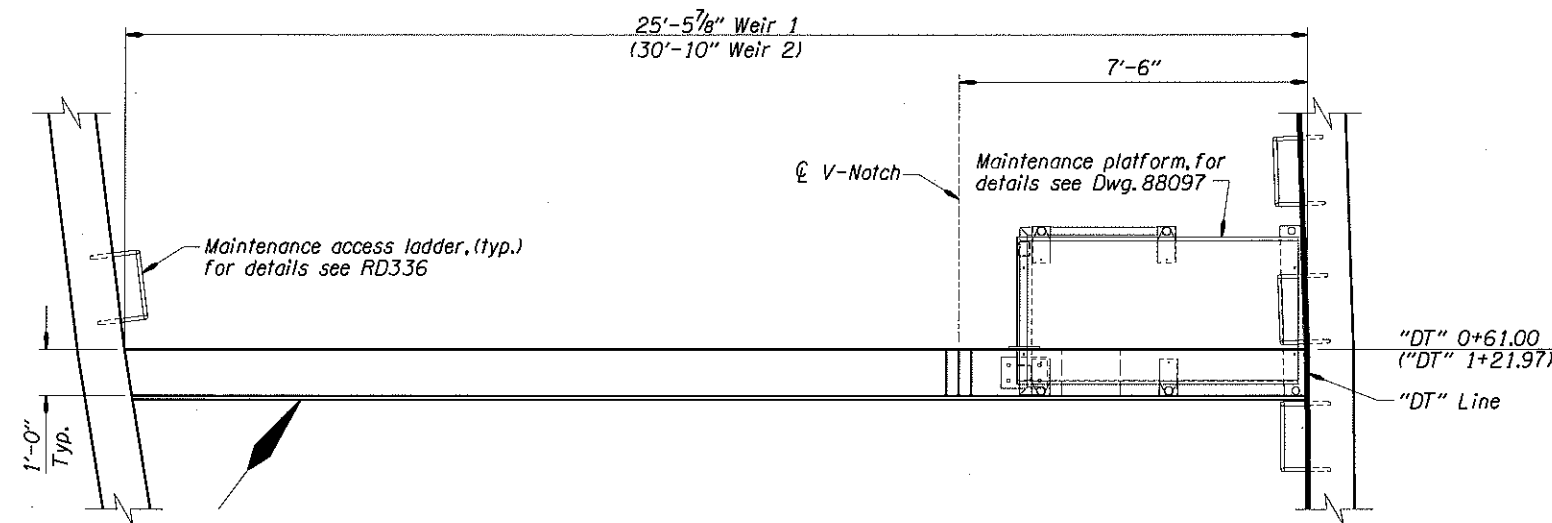


(Weir 2 similar)  
**WEIR 1 PLAN**  
 Scale: 1/2" = 1'-0"

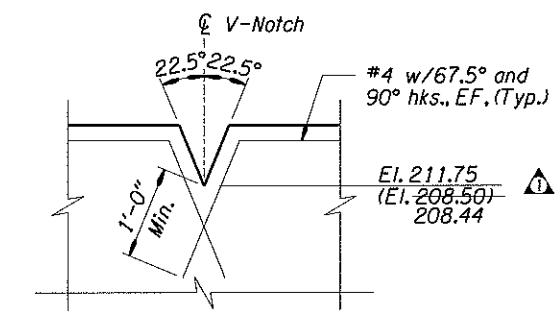

**V-NOTCH DETAIL**  
 Scale: 1" = 1'-0"

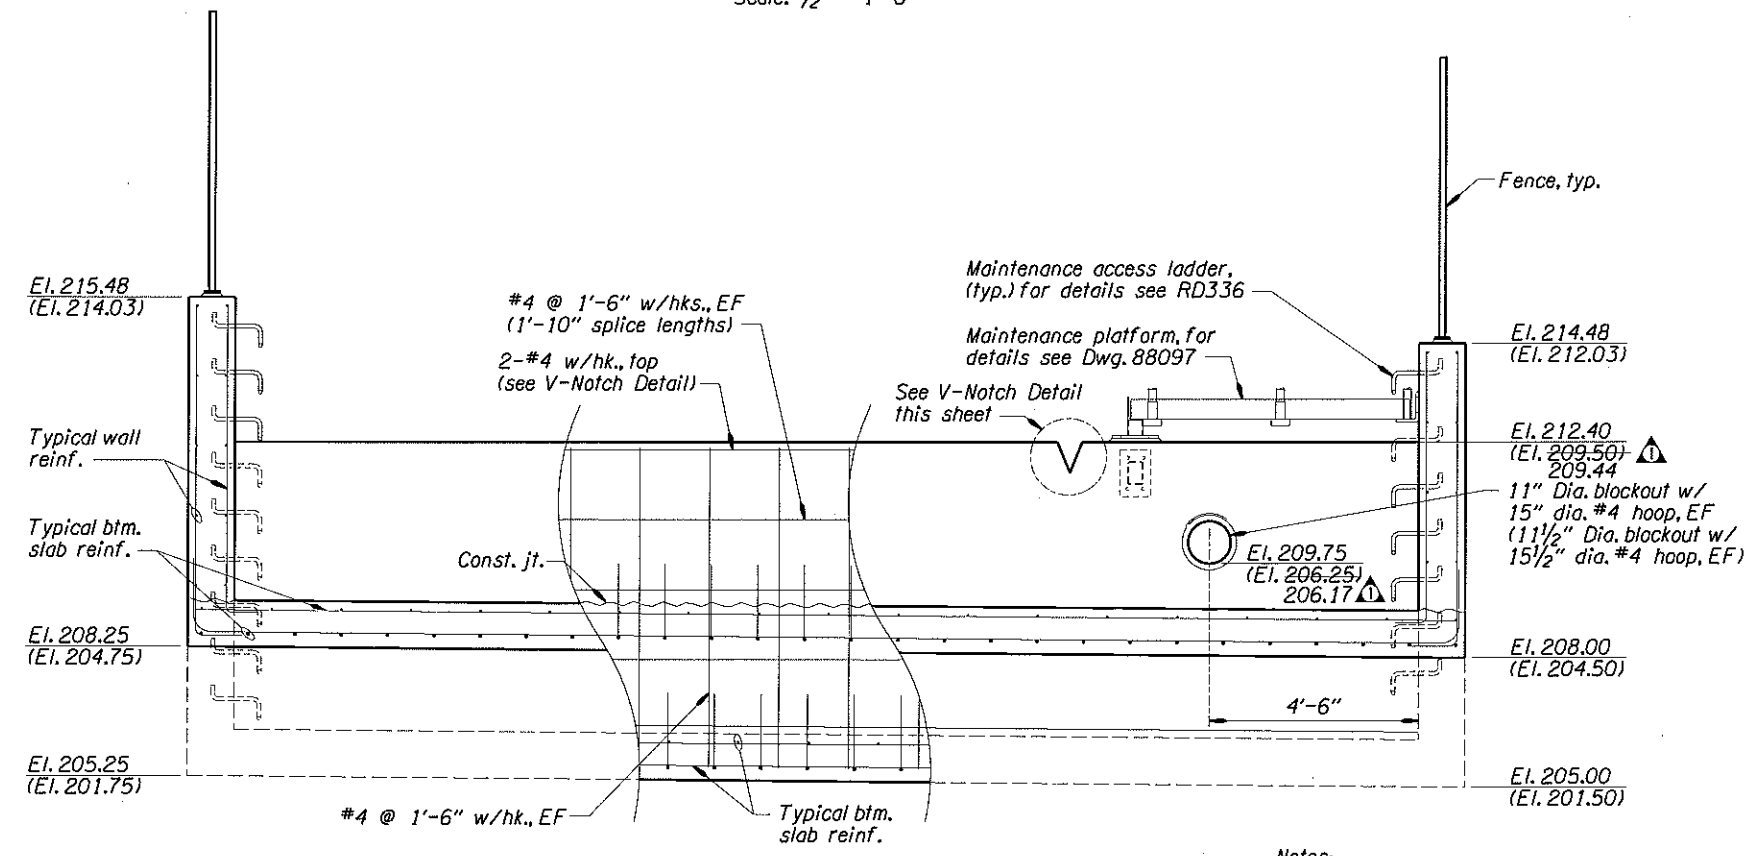

(Weir 2 similar)  
**WEIR 1 ELEVATION**  
 Scale: 1/2" = 1'-0"

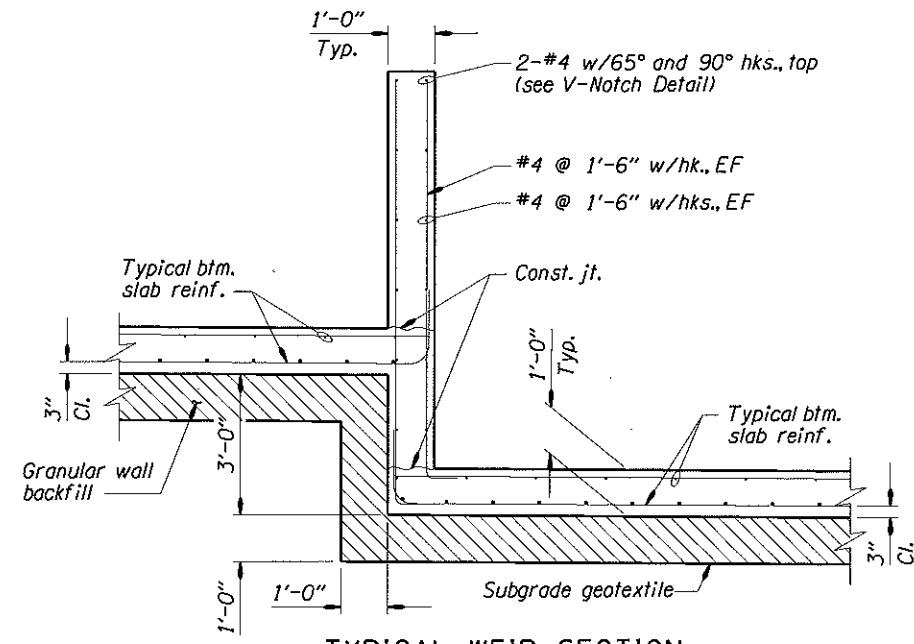

**TYPICAL WEIR SECTION**  
 Scale: 1/2" = 1'-0"

**Notes:**  
 Adjust all reinf. to maintain 2" clear of blockouts.  
 ( ) = Dimensions and elevations for Weir 2.

DATE: 7-08-13 REVISION: As Constructed BY: AMB	REVISION: As Constructed DRAFTER: Alan Mitchell DESIGNER: Laura Barker CHECKER: Amanda Blankenship REVIEWER: Terry Stones	<b>As Constructed</b> This drawing has had as-constructed comments added. Original stamped & signed design mylar is stored at Salem Headquarters.		STRUCTURE NO. 21676 DATE: March - 2012 CALC. BOOK: 6484	DETENTION STRUCTURE, HWY 144 NB AT M.P. 0.85, LEFT OR217: SUNSET HWY-TV HWY DETENTION FACILITY BEAVERTON-TIGARD HWY NO. 144 M.P. 0.85 WASHINGTON COUNTY	SHEET 5 OF 7 DRAWING NO. 88096
				<b>WEIR DETAILS</b>		

**General Notes:**

Use Hilti: HIT-HY 150 Max + HAS, 3/8" dia. high strength resin bonded anchors with washer and self locking nut, or approved equal. Embed 4".

Use Cooper B-Line 36" Heavy Duty Grip Strut Walkway x 6'-0", 11 gauge, or approved equal.

Use Cooper B-Line Heavy-Duty Grip Strut Hold-Down Clip with 3/8" dia. square-shank carriage bolts, nuts, and washers, or approved equal.

\*Field drill 1/2" dia. holes through angles and HSS as shown.




Provide all steel angles and plates conforming to ASTM Grade 36.

Provide all HSS sections conforming to ASTM A500 Grade B steel.


Provide 1 1/2" dia. Schedule 40 pipe conforming to ASTM A53, Grade B for handrail posts and rails.

Provide Galvanized Chain with quick release connections one end of each length of chain.



Hot-dip galvanize all steel material after fabrication.

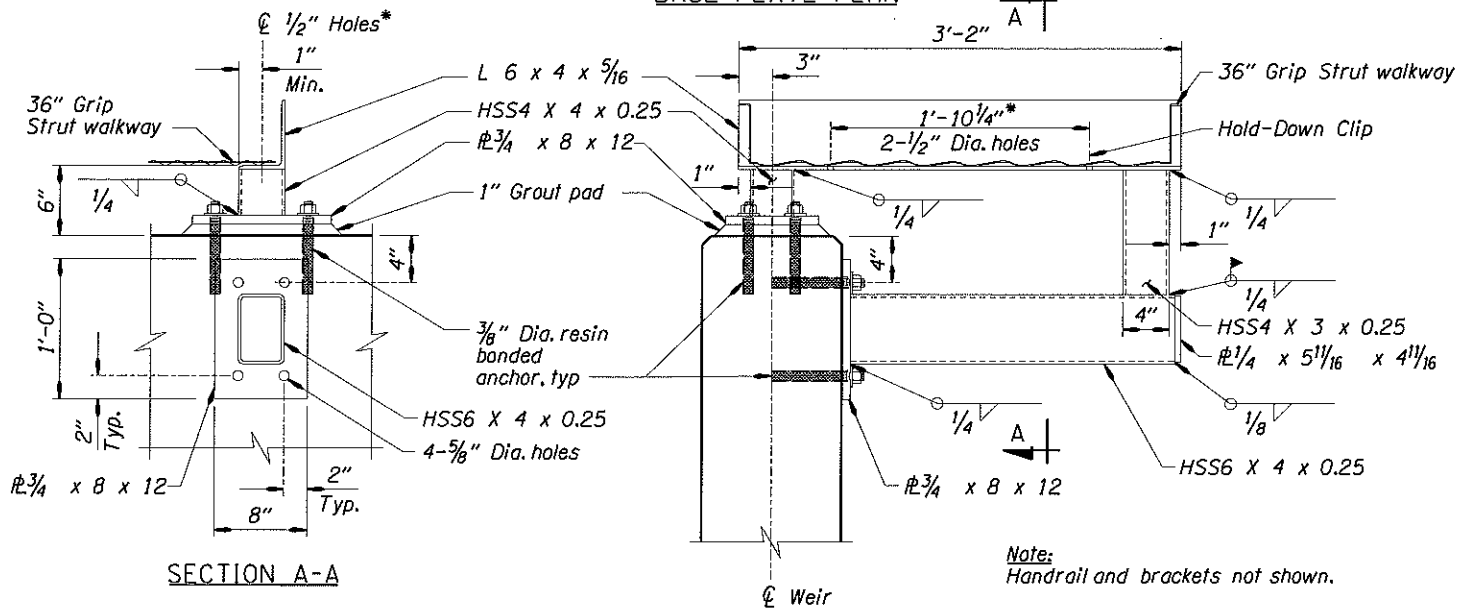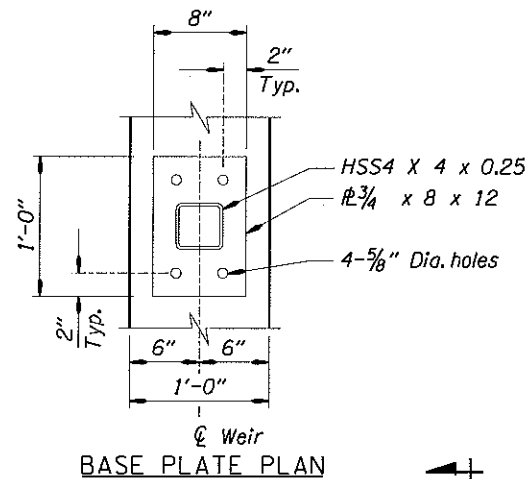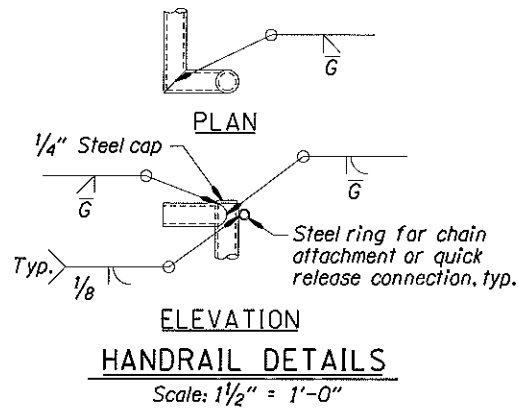

**EAST END PLATFORM CONNECTION DETAIL**  
Scale: 1 1/2" = 1'-0"

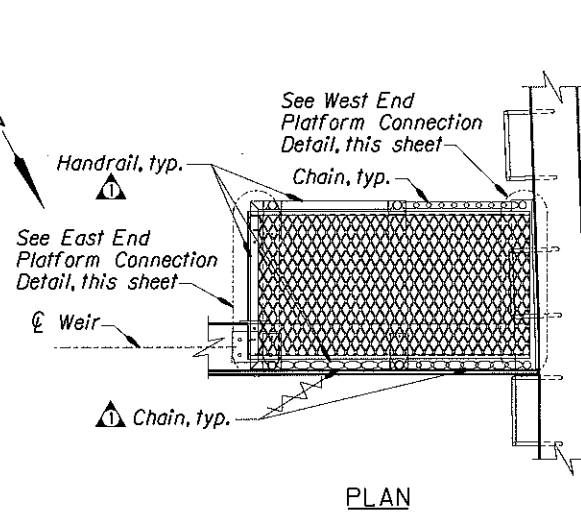

**MAINTENANCE PLATFORM - AT WEIR**  
Scale: 1/2" = 1'-0"

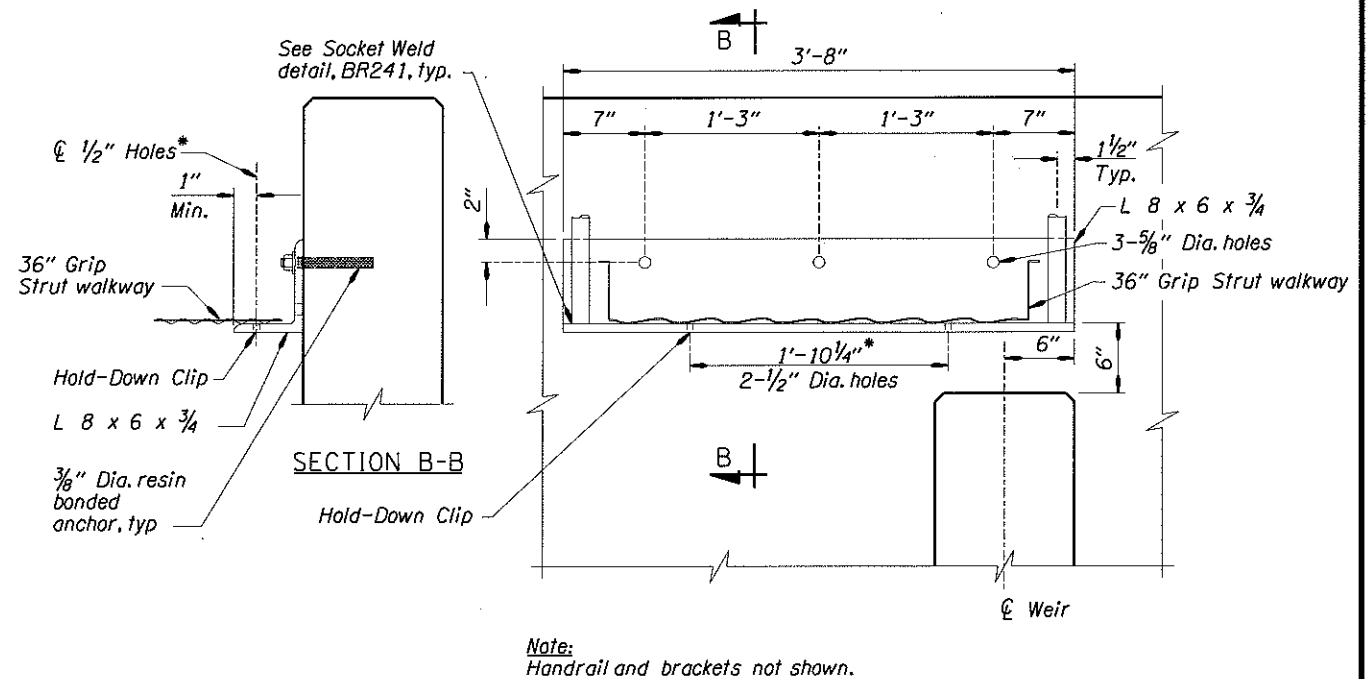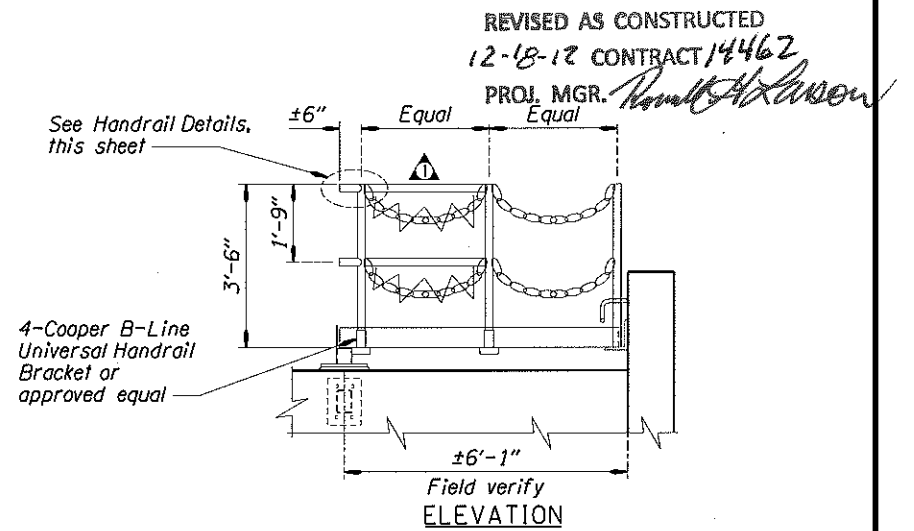




**WEST END PLATFORM CONNECTION DETAIL**  
Scale: 1 1/2" = 1'-0"

DATE	REVISION	BY	Alan Mitchell	As Constructed	STRUCTURE NO. 21676	DETENTION STRUCTURE, HWY 144 NB AT M.P. 0.85, LEFT OR217: SUNSET HWY-TV HWY DETENTION FACILITY BEAVERTON-TIGARD HWY NO. 144 M.P. 0.85 WASHINGTON COUNTY	SHEET 6 OF 7
	07-08-13		As Constructed				
DESIGNER:			Laura Barker	CHECKER:	CALC. BOOK 6484	DRAWING NO. 88097	
CHECKER:			Amanda Blankenship				
REVIEWER:			Terry Stones	MAINTENANCE PLATFORM DETAILS 1 of 2			
ACCOMPANIED BY DWGS. See Sheet 1 for this structure			EXPIRES:				




SCALE WARNING  
If scale bar doesn't measure one inch then drawing is not to scale


*Randall Lawson*  
 REVISED AS CONSTRUCTED  
 12-18-12 CONTRACT 14462  
 PROJ. MGR.

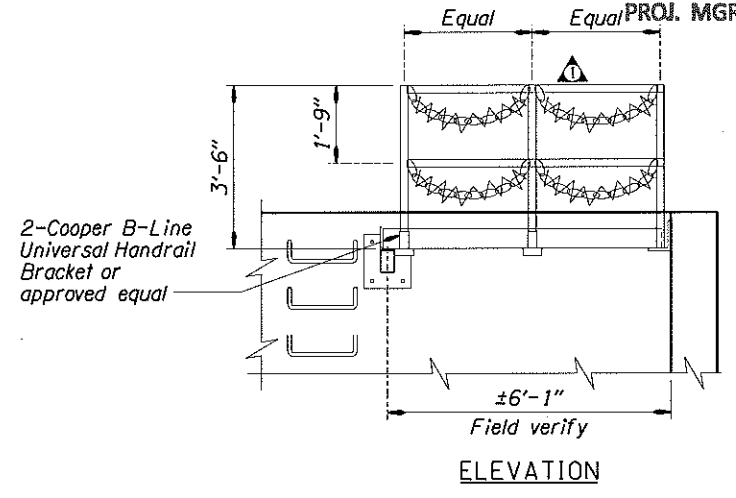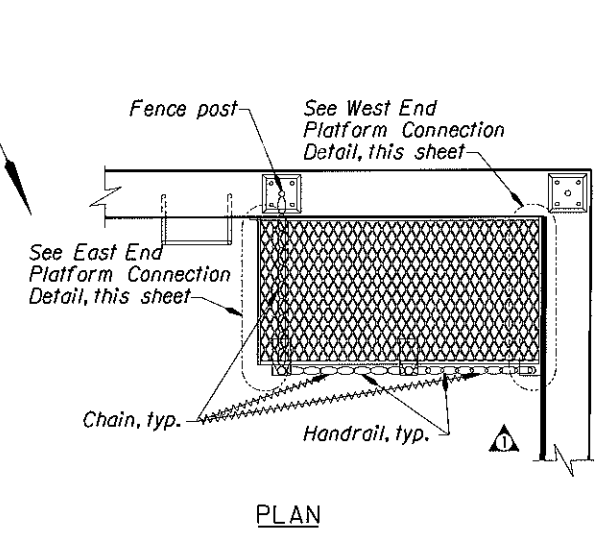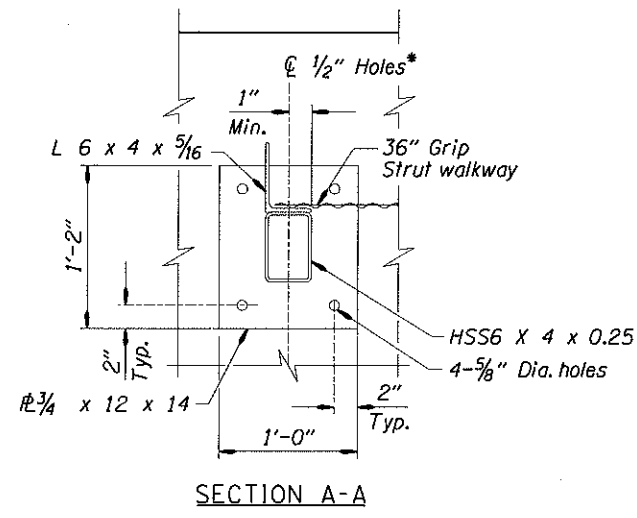


**MAINTENANCE PLATFORM - AT SOUTH WALL**  
 Scale: 1/2" = 1'-0"

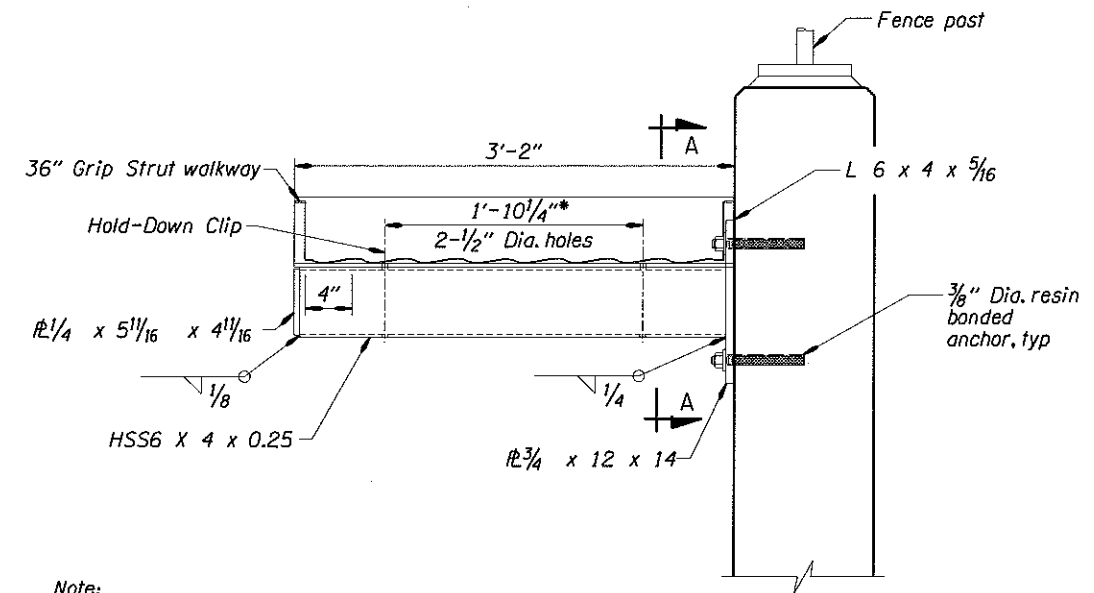

**EAST END PLATFORM CONNECTION DETAIL**  
 Scale: 1/2" = 1'-0"

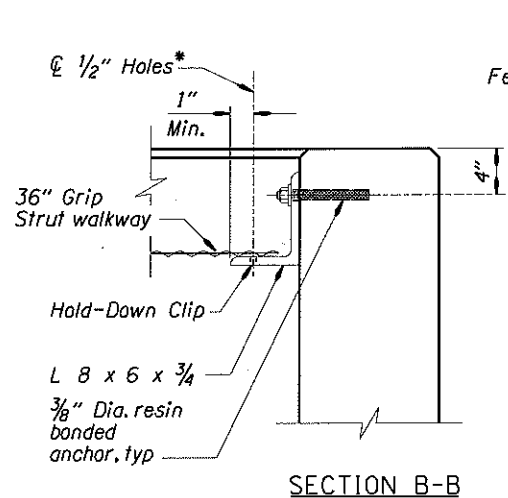

**SECTION B-B**

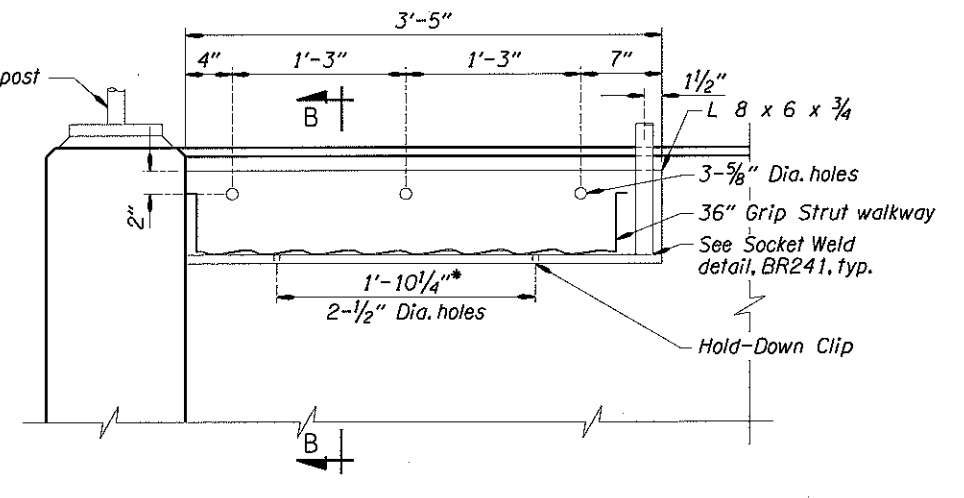

**WEST END PLATFORM CONNECTION DETAIL**  
 Scale: 1/2" = 1'-0"

Note: Handrail and brackets not shown.

Note: Handrail and brackets not shown.

	DATE	REVISION	BY	Alan Mitchell Laura Barker Amanda Blankenship Terry Stones	<b>As Constructed</b> This drawing has had as-constructed comments added. Original stamped & signed design mylar is stored at Salem Headquarters.		STRUCTURE NO.	DETENTION STRUCTURE, HWY 144 NB AT M.P. 0.85, LEFT OR217: SUNSET HWY-TV HWY DETENTION FACILITY BEAVERTON-TIGARD HWY NO. 144 M.P. 0.85 WASHINGTON COUNTY	SHEET
	7-08-13	As Constructed	AMB				21676		7
ACCOMPANIED BY DWGS. See Sheet 1 for this structure				DESIGNER:	If scale bar doesn't measure one inch then drawing is not to scale	OREGON DEPARTMENT OF TRANSPORTATION	DATE	MAINTENANCE PLATFORM DETAILS 2 OF 2	OF
				CHECKER:			6484		7
				REVIEWER:					DRAWING NO.
									88098