

OPERATION & MAINTENANCE MANUAL

Water Quality Biofiltration Swale

Manual prepared: April 2019

DFI No. D00642



Figure 1: DFI No. D00642, (looking East on the SB off ramp)

Identification

Drainage Facility ID (DFI):	D00642
Facility Type:	Water Quality Biofiltration Swale
Construction Drawings:	(V-File Numbers) 46V-51
Location:	District: 3
	Highway No.: 1
	Mile Post: 271.91 to 271.95, [left]

1. Manual Purpose

The purpose of this manual is to outline inspection needs and summarize maintenance actions.

2. Facility Location

The location map below details the facility location. The highway, mile posts, side streets, access location, and stormwater flow directions are noted on the map.

Facility location type: Roadway shoulder

Flow direction: Southwest




Figure 2: Facility location map

3. Facility Summary

The length and width of a swale is based on the bottom dimensions.

The bottom length and bottom width of the swale is:


Bottom Length (feet)	Bottom Width (feet)
180	6

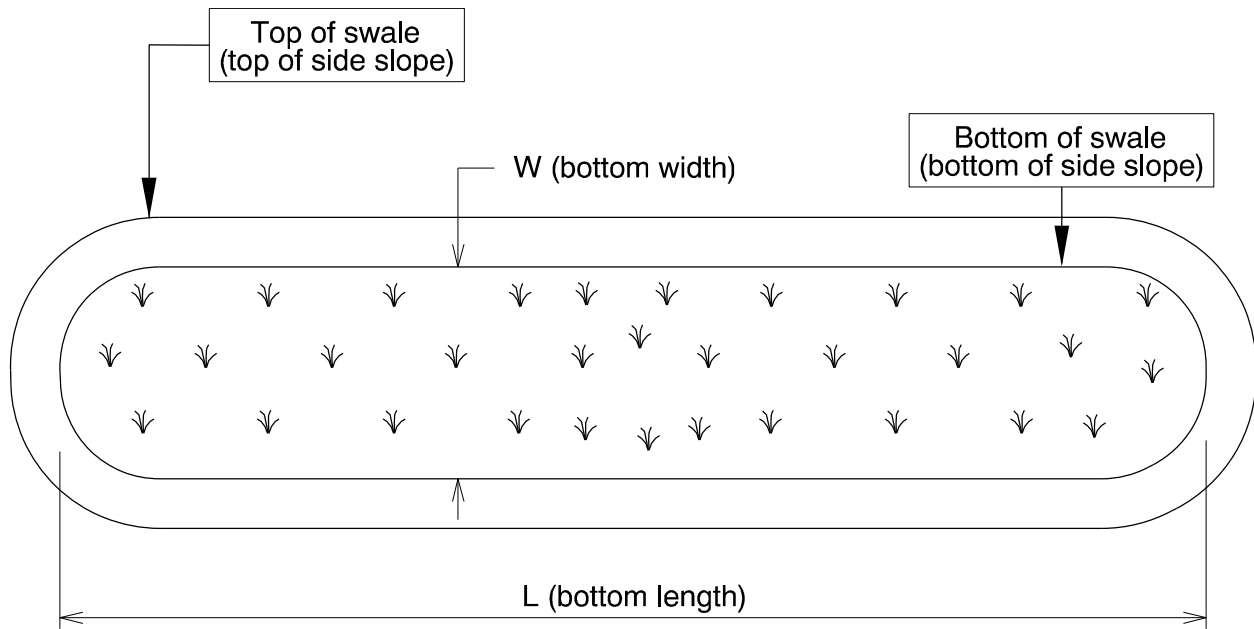

The depth of the swale is the vertical distance measured from the bottom of the swale to the top. The slope of the swale sides is presented by a vertical distance (rise) followed by the horizontal distance (run).

Depth and side slopes:

Depth (feet)	Rise (feet)	Run (feet)
1.6	1	6

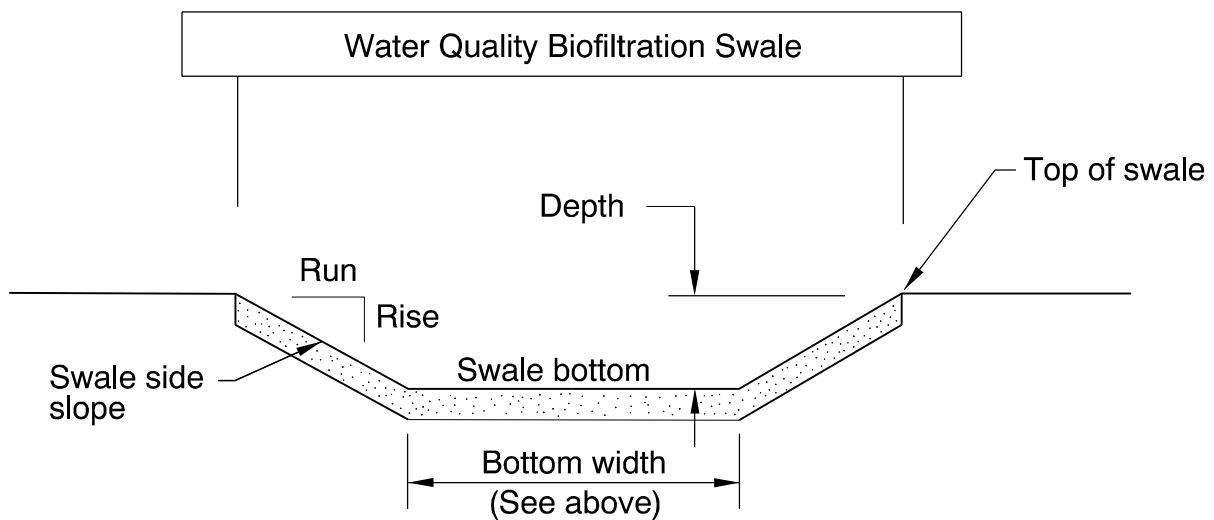

Site Specific Information:

4. Facility Access

Maintenance access to the facility:

<input type="checkbox"/> Roadside pad	<input checked="" type="checkbox"/> Roadside shoulder
<input type="checkbox"/> Access road with Gate	<input type="checkbox"/> Access road without Gate



Figure 3: DFI D00642 between SB off ramp and SB I-5

5. Operational Components / Maintenance Items

Classification

This facility is classified as an:

<input checked="" type="checkbox"/> On-line Swale	<input type="checkbox"/> Off-line Swale
A swale that does not include a high flow bypass component; flow drains into and through the facility	A swale that treats low/small flows and diverts high flows using a bypass component

Bypass Component

This facility includes a high flow bypass component:

<input checked="" type="checkbox"/> No	<input type="checkbox"/> Yes
---	-------------------------------------

There is no bypass component. High flows drain into and through the facility	There is a bypass component. Only low/small flows drain into the swale. High flows are diverted around the swale using a bypass component
--	---

Operational Components

A swale has many components that assist with treatment, conveyance, and reducing flow velocity to minimize erosion. The components in use can vary depending if the facility was designed to operate on-line or off-line. The facility components table (**Table 1**) has been provided to highlight the applicable components for this facility. The component is in use when the box contains an “x” (e.g.).

The Standard Operation Manual for Water Quality Biofiltration Swales (implemented March 2017) outlines facility operation, typical footprint configuration, and component definitions and details. A link to the manual is attached to the feature marker in TransGIS.

<https://gis.odot.state.or.us/TransGIS/>

Operational Plan

The applicable standard operational plan for this facility is:

<input type="checkbox"/> Operational Plan A	<input checked="" type="checkbox"/> Operational Plan B	<input type="checkbox"/> Operational Plan C
An on-line swale with roadside ditches	An on-line swale with piped inlets and outlets	An off-line swale with a piped high flow bypass
A standard operational plan illustrates the general facility footprint configuration and explains the purpose of each facility component. Operational plans (A, B, C) are provided in the Standard Operation Manual.		

See Appendix A for the site specific operational plan.

Maintenance Items

Operational components marked in **Table 1** should be inspected and maintained according to Section 7. Each facility component is defined and detailed in the Standard Operation Manual using the associated ID number indicated below.

Table 1: Swale Components		ID #
Manholes/Structures		
Pre-treatment manhole	<input type="checkbox"/>	S1
Weir type flow splitter/flow splitter manhole	<input type="checkbox"/>	S2
Orifice type flow splitter/flow splitter manhole	<input type="checkbox"/>	S3
Standard manhole	<input checked="" type="checkbox"/>	S4
Swale Inlet		

Pavement sheet flow	<input checked="" type="checkbox"/>	S5
Inlet Pipe (s)	<input checked="" type="checkbox"/>	S6
Open channel inlet	<input type="checkbox"/>	S7
Riprap pad	<input type="checkbox"/>	S8
Ground Cover		
Grass bottom	<input checked="" type="checkbox"/>	S9
Grass side slopes	<input checked="" type="checkbox"/>	S10
Granular drain rock	<input type="checkbox"/>	S11
Plantings	<input type="checkbox"/>	S12
Underground Components		
Geotextile fabric	<input type="checkbox"/>	S13
Water quality mix	<input checked="" type="checkbox"/>	S14
Perforated pipe	<input type="checkbox"/>	S15
Porous pavers (access grid)	<input type="checkbox"/>	S16
Flow Spreader		
Rock basin (used at inlet)	<input type="checkbox"/>	S17
Anchored board (midpoint of swale or every 50 feet along swale bottom)	<input type="checkbox"/>	S18
Other:	<input type="checkbox"/>	S19
Swale Outlet		
Catch basin with grate	<input type="checkbox"/>	S20
Outlet Pipe (s)	<input checked="" type="checkbox"/>	S21
Open channel outlet	<input type="checkbox"/>	S22
Auxiliary Outlet:	<input type="checkbox"/>	S23
Outfall Type		
Waterbody (Creek/Lake/Ocean)	<input type="checkbox"/> C	S24
	<input type="checkbox"/> L	
	<input type="checkbox"/> O	
Ditch	<input type="checkbox"/>	S25
Storm drain system	<input checked="" type="checkbox"/>	S26
Outfall Components		
Riprap pad	<input type="checkbox"/>	S27
Riprap bank protection	<input type="checkbox"/>	S28

6. Maintenance

Maintenance Frequency/Maintain Records

- a. Inspect annually. Preferably prior to the rainy season.
- b. Clean and maintain as necessary. Refer to Activity 125 for conditions when maintenance is needed.
- c. Keep a record of inspections, maintenance, and repairs.

Maintenance Guide/Maintenance Actions

The ODOT Routine Road Maintenance Water Quality and Habitat Guide (the *Blue Book*) outlines the standard maintenance actions for water quality facilities under Activity 125.

There are standard maintenance tables for standard ODOT designs. The maintenance tables describe the maintenance component, the defect or problem, the condition when maintenance is needed, and the recommended maintenance to correct the problem. Use the following tables to maintain ODOT swales:

- Table 1 (General Maintenance): Contains general maintenance and inspection guidelines that are applicable to all ODOT water quality facilities
- Table 3 (Maintenance of Water Quality or Biofiltration Swales): Contains maintenance information for swales

The *Blue Book* can be viewed at the following website:

http://www.oregon.gov/ODOT/Maintenance/Documents/blue_book.pdf

7. Limitations

Access grid installed:

<input checked="" type="checkbox"/> No	<input type="checkbox"/> Yes
There are no porous pavers installed in this swale	

Swales are designed to allow equipment access along the bottom. If an access grid is **NOT** installed, vehicles entering the swale can create depressions (tire ruts), damage vegetation, and damage structural components (e.g. flow spreaders). These conditions may result in poor treatment and drainage performance.

Equipment wheels should be kept on the tops and side slopes. Mower arms may be run along the swale bottom.

8. Waste Material Handling

Material removed from the facility is defined as waste by the Department of Environmental Quality (DEQ). Refer to the roadwaste section of the ODOT Maintenance Yard Environmental Management System (EMS) Policy and Procedures Manual for disposal options:

http://www.oregon.gov/ODOT/Maintenance/Documents/ems_manual.pdf


Contact any of the following for more detailed information about management of waste materials found on site:

ODOT Clean Water Unit	(503) 986-3008
ODOT Statewide Hazmat Coordinator	(503) 667-7442
ODOT Region 1 Hazmat Coordinator	(503) 731-8290
ODOT Region 2 Hazmat Coordinator	(503) 986-2647
ODOT Region 3 Hazmat Coordinator	(541) 957-3594
ODOT Region 4 Hazmat Coordinator	(541) 388-6186
ODOT Region 5 Hazmat Coordinator	(541) 963-1590
ODEQ Northwest Region Office	(503) 229-5263

A Appendix A – Site Specific Operational Plan

Contents:

Operational Plan: DFI D00642

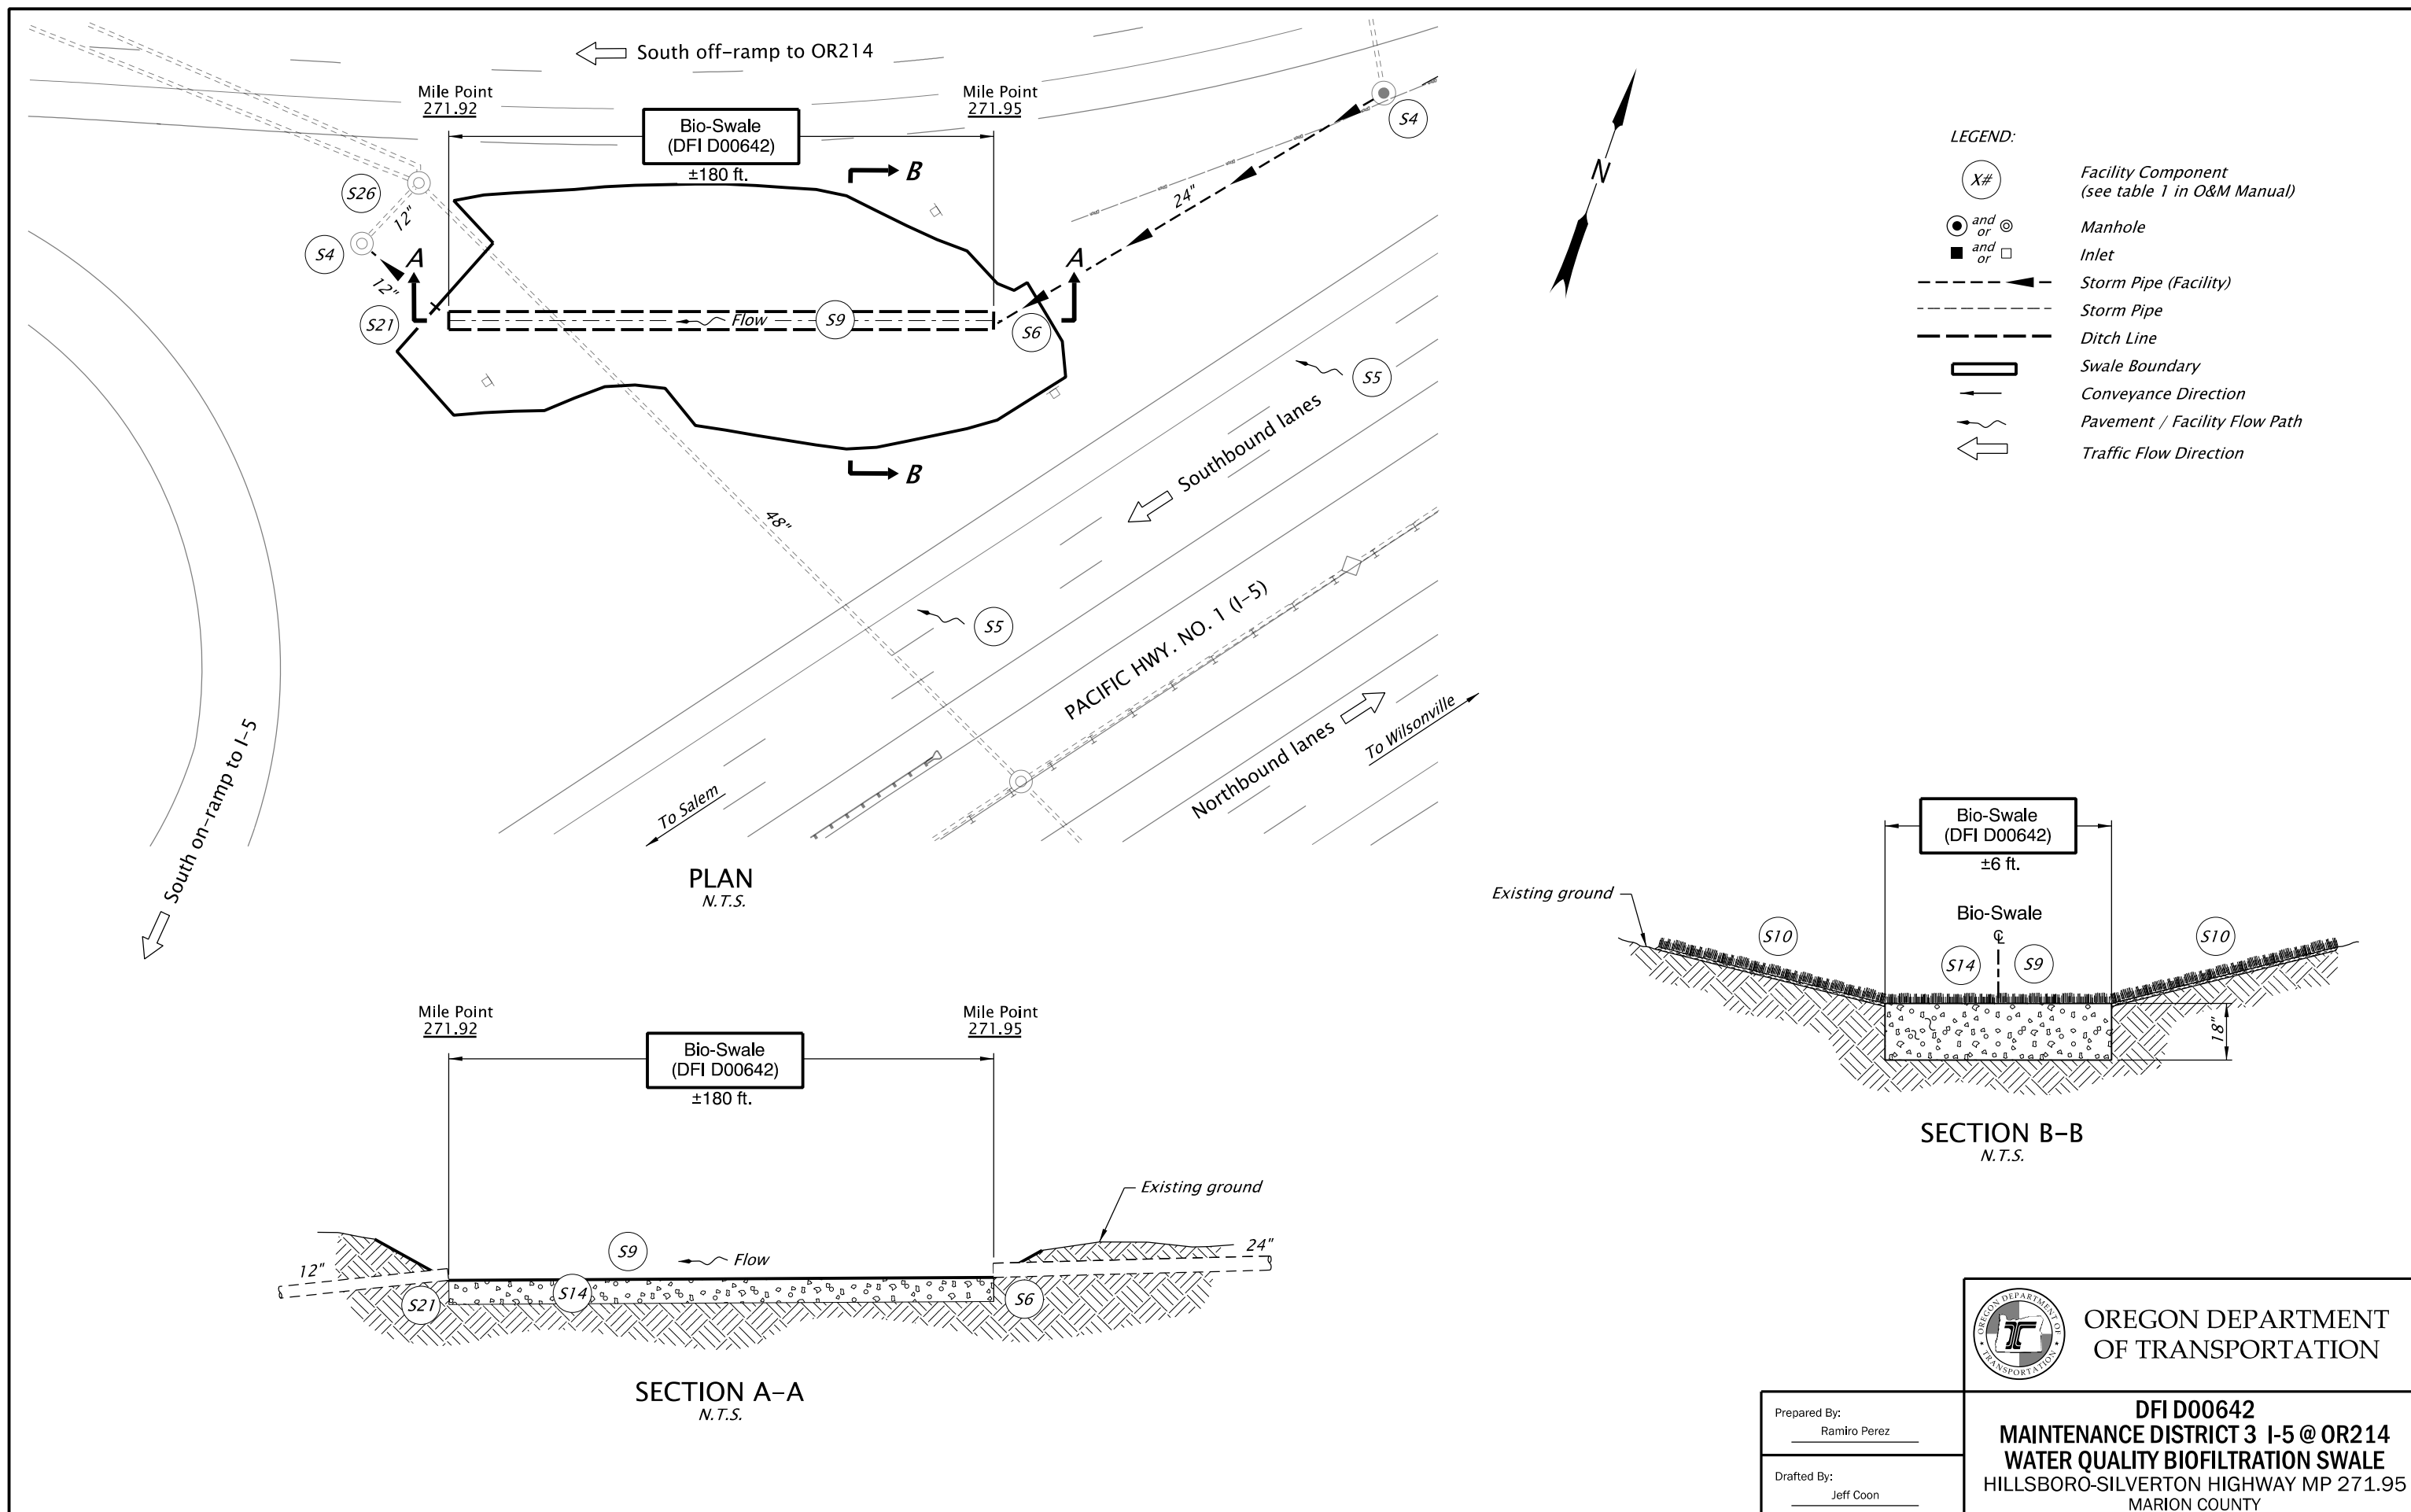

PLAN
N.T.S.

SECTION B-B
N.T.S.

SECTION A-A
N.T.S.



OREGON DEPARTMENT OF TRANSPORTATION

Prepared By:
Ramiro Perez
Drafted By:
Jeff Coon

DFI D00642
MAINTENANCE DISTRICT 3 I-5 @ OR214
WATER QUALITY BIOFILTRATION SWALE
HILLSBORO-SILVERTON HIGHWAY MP 271.95
MARION COUNTY

B Appendix B – Project Contract Plans

Contents:

Site Specific Subset of Project Contract Plan 46V-51

46V-51

INDEX OF SHEETS	
SHEET NO.	DESCRIPTION
1	Title Sheet
1A	Index Of Sheets Contd.
1A-2	Index Of Sheets Contd.
1A-3	Standard Drg. Nos.

STATE OF OREGON
 DEPARTMENT OF TRANSPORTATION
 PLANS FOR PROPOSED PROJECT

GRADING, DRAINAGE, STRUCTURES, PAVING, SIGNING,
 ILLUMINATION, SIGNAL & ROADSIDE DEVELOPMENT


**FFO - I-5 @ OR214 INTERCHANGE
 (WOODBURN) DEVELOPMENT SEC.**

HILLSBORO - SILVERTON HIGHWAY

MARION COUNTY

Ⓔ JUNE 2013

**BEGINNING OF
 CONTRACT PROJECT**
STP-S140(045)
 STA. "L"952+05 (M.P. 276.01)

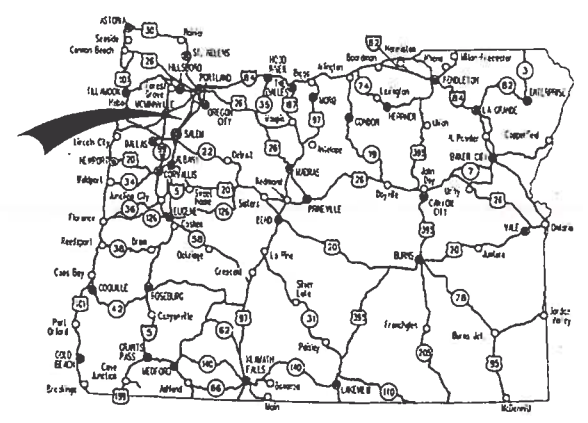


Overall Length Of Project - 2.76 Miles

ATTENTION:
 Oregon Law Requires You To Follow Rules
 Adopted By The Oregon Utility Notification
 Center. Those Rules Are Set Forth In
 OAR 952-001-0010 Through OAR 952-001-0090.
 You May Obtain Copies Of The Rules By Calling
 The Center. (Note: The Telephone Number For
 The Oregon Utility Center Is (503) 232-1987.)

REVISED AS CONSTRUCTED
 CONTRACT

John [Signature] 10/26/17

No.	DATE	REVISIONS	BY
Ⓔ	4-18-13	Edited station & MP for the end of contract	J.O.L.
Ⓕ	5-16-13	Changed date	C.A.C.

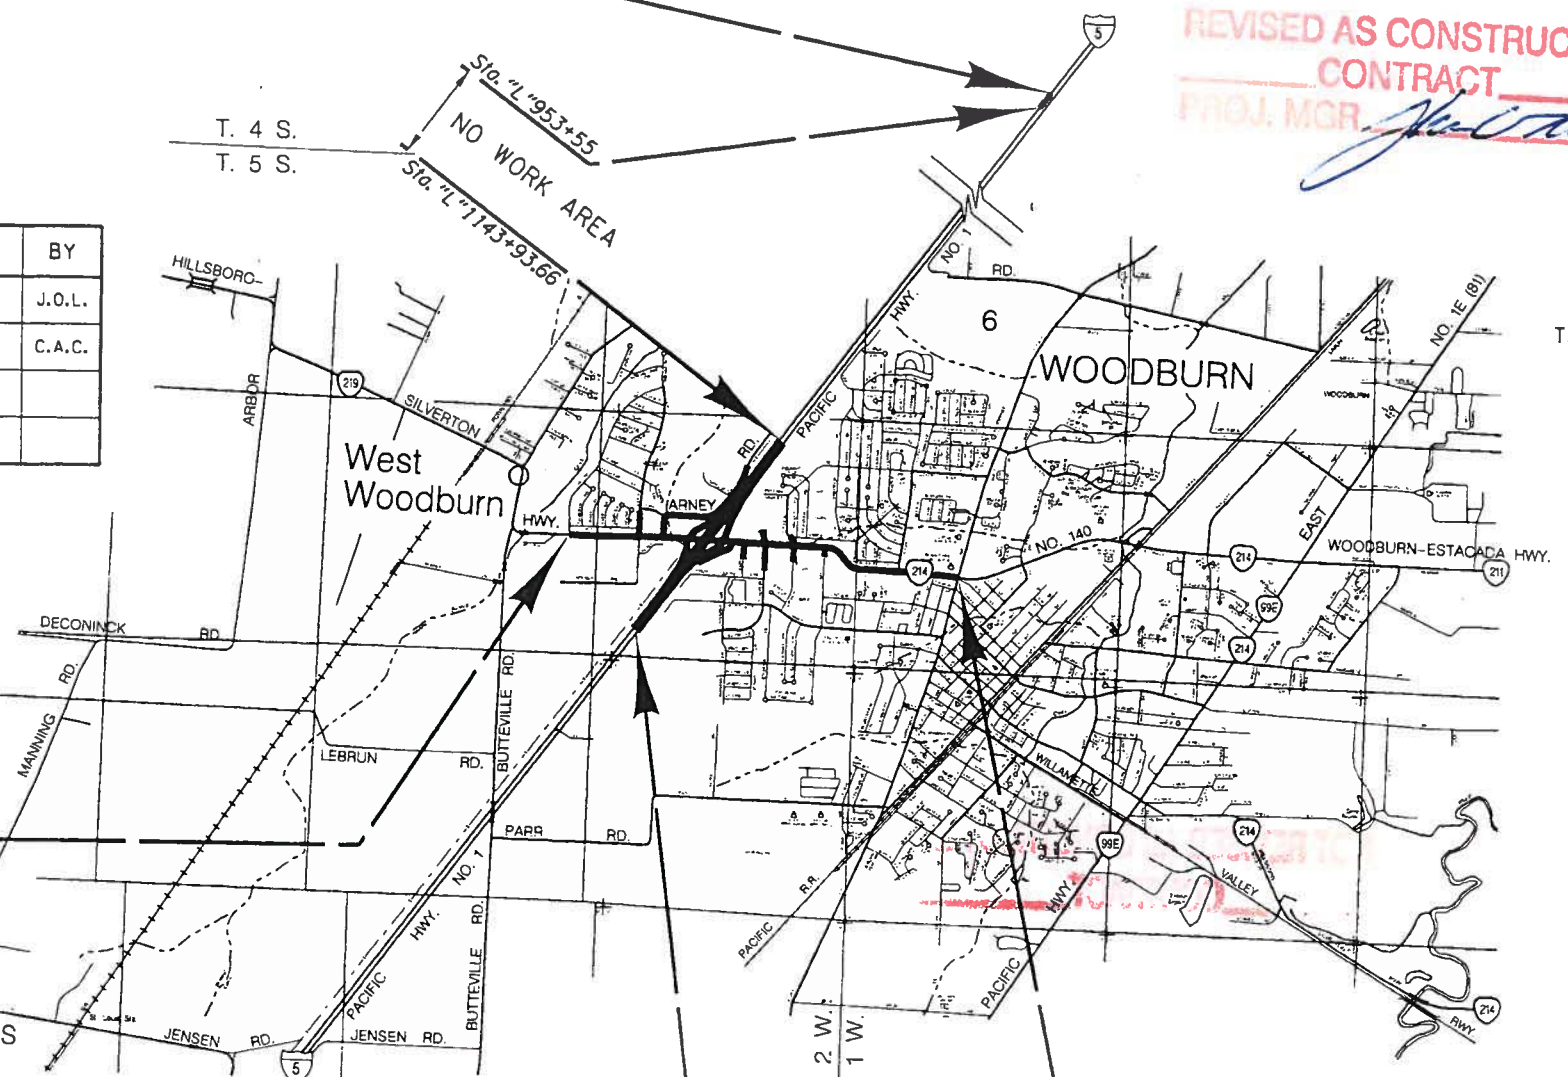

T. 5 S., R. 1 & 2 W., W.M.



**BEGINNING OF
 PROJECT**
STP-S140(045)
 STA. "HSc"477+21
 (M.P. 36.24)

END OF CONTRACT PROJECT
STP-S140(045)
 Ⓔ STA. "L"1199+66.06 (M.P. 271.35)

END OF PROJECT
STP-S140(045)
 STA. "HSc"562+67.5 (M.P. 37.87)

OREGON TRANSPORTATION COMMISSION
 Pat Egan CHAIR
 David Lohman COMMISSIONER
 Mary F. Olson COMMISSIONER
 Mark Frahmoyer COMMISSIONER
 Tammy Boney COMMISSIONER
 Matthew L. Garrett DIRECTOR OF TRANSPORTATION

These plans were developed using ODOT design standards. Exceptions to these standards, if any, have been submitted and approved by the ODOT Chief Engineer or their delegated authority.

By: *Michael T. Long* 5-20-13
 Signature & date
 Michael T. Long - R2 Tech Center Manager
 Print name and title

 Concurrence by ODOT Chief Engineer

FFO - I-5 @ OR214 INTERCHANGE
 (WOODBURN) DEVELOPMENT SEC.
 HILLSBORO - SILVERTON HIGHWAY
 MARION COUNTY


FEDERAL HIGHWAY ADMINISTRATION	PROJECT NUMBER	SHEET NO.
OREGON DIVISION	STP-S140(045)	1

PE00 0559 040

- ① Sta. "S1"0+14.06 to Sta. "S1"2+35.09
Const. water quality biofiltration
swale no. 00642
Water quality mixture - 70 cu.yd.
Gen. exc. - 850 cu.yd.
- ② Stormwater facility marker
(See "Swale No. 00642 Marker Table")
(See dwg. RD399)


SWALE NO. 00642 MARKER TABLE

TYPE		LOCATION			
S1	S2	RED	GREEN	NORTHING	EASTING
	✓			550718.37	7589105.91
✓		✓		550762.22	7589048.71
✓			✓	550660.21	7588927.21

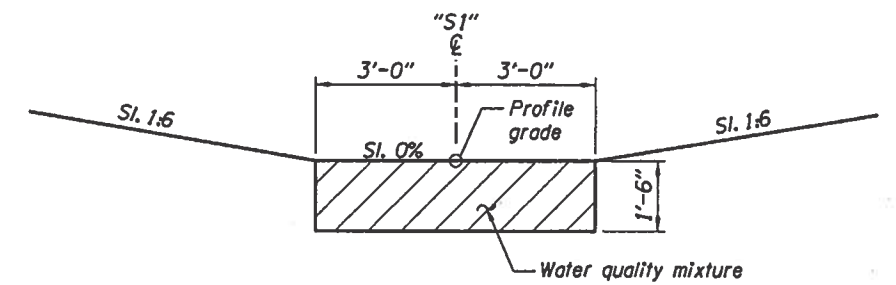


STA. "S1"0+40 To STA. "S1"2+19

TYPICAL SECTION

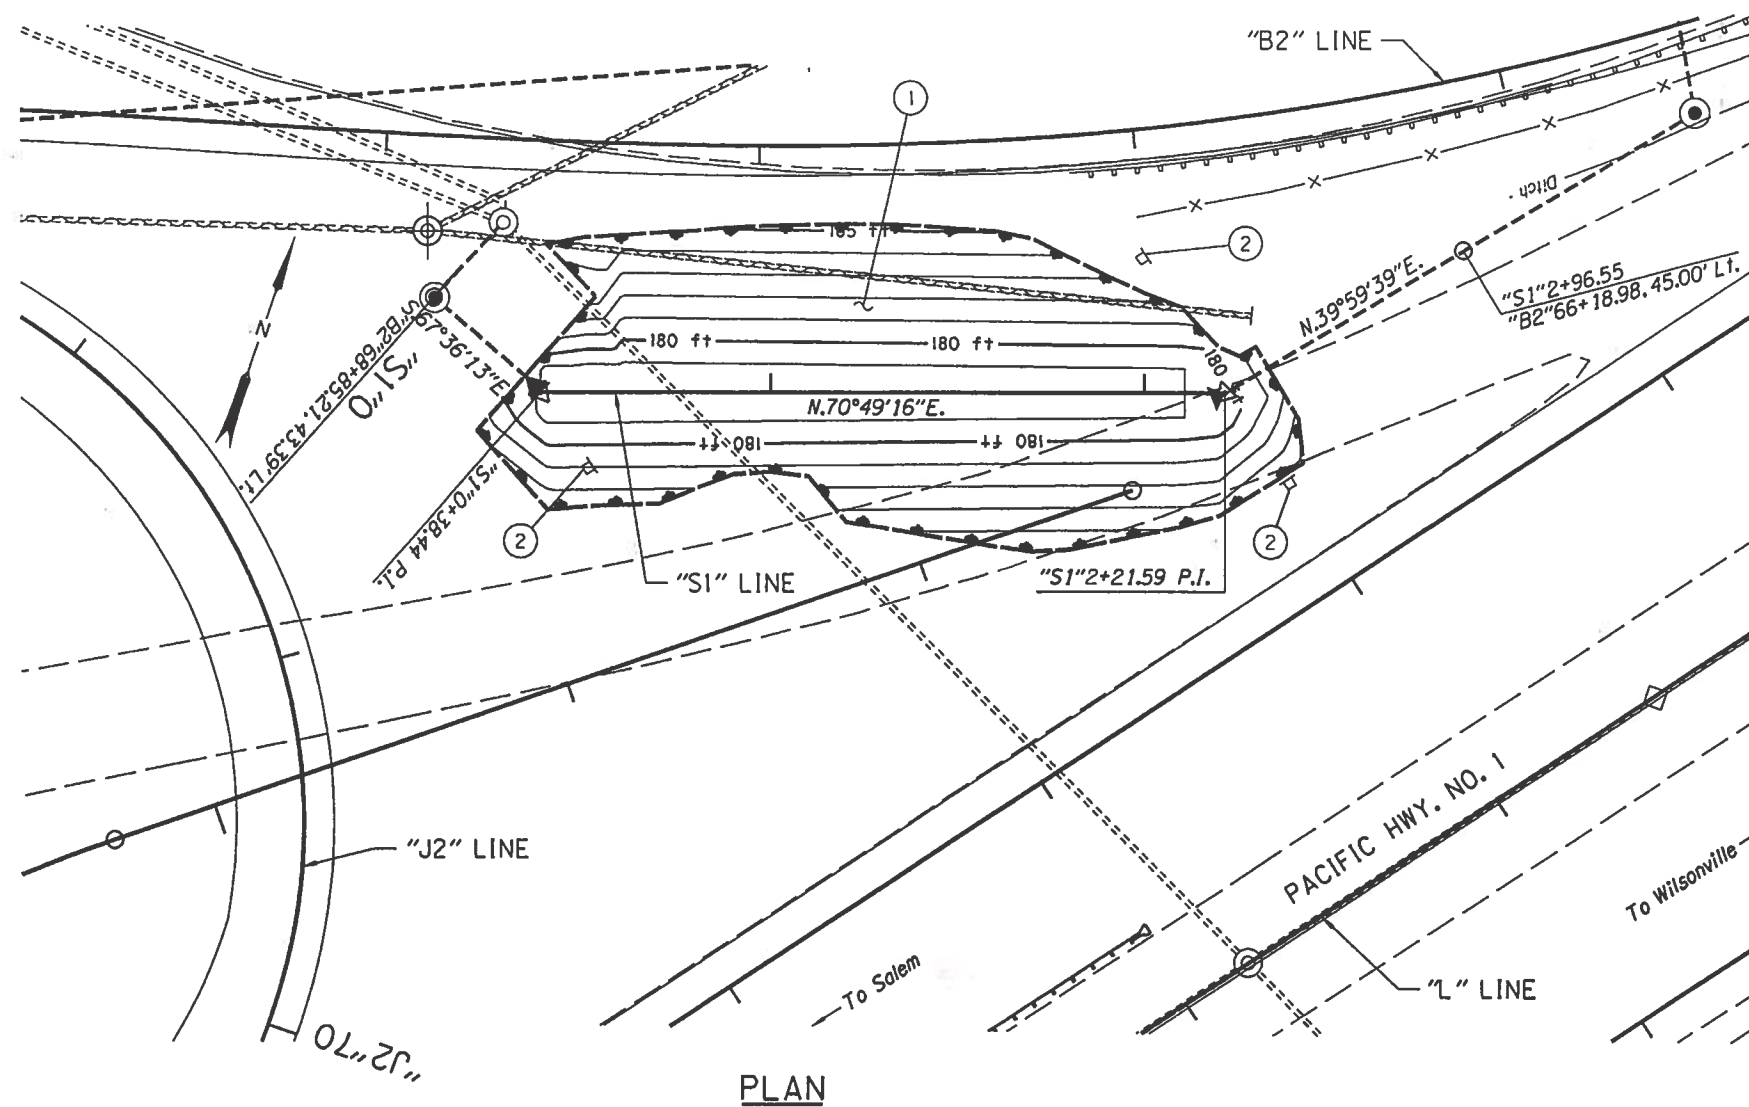

PLAN

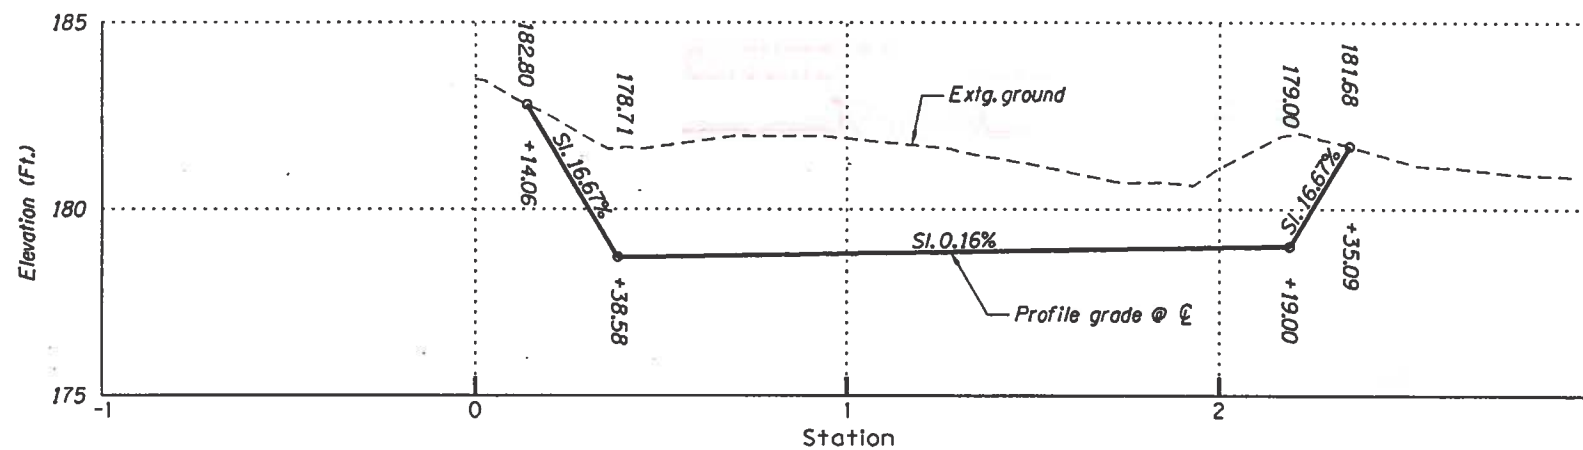


PROFILE AT "S1" LINE

Elevations shown are based on North American Vertical Datum (1988)


NOT REVISED AS CONSTRUCTED CONTRACT

NOTE: Slopes are shown as vertical to horizontal.

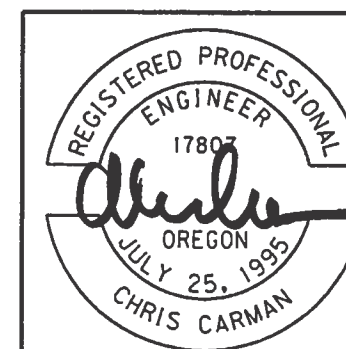

RENEWS: 12-31-2013

OREGON DEPARTMENT OF TRANSPORTATION	
REGION 2 TECH CENTER	
FFO-1-5 @ OR214 INTERCHANGE (WOODBURN) DEVELOPMENT SEC. HILLSBORO - SILVERTON HIGHWAY MARION COUNTY	
Reviewed By - Bruce Carmichael Designed By - Chris Carman Drafted By - Sandra Gish	
STORMWATER STORAGE POND NO. 00641 PLAN	SHEET NO. GJ-2

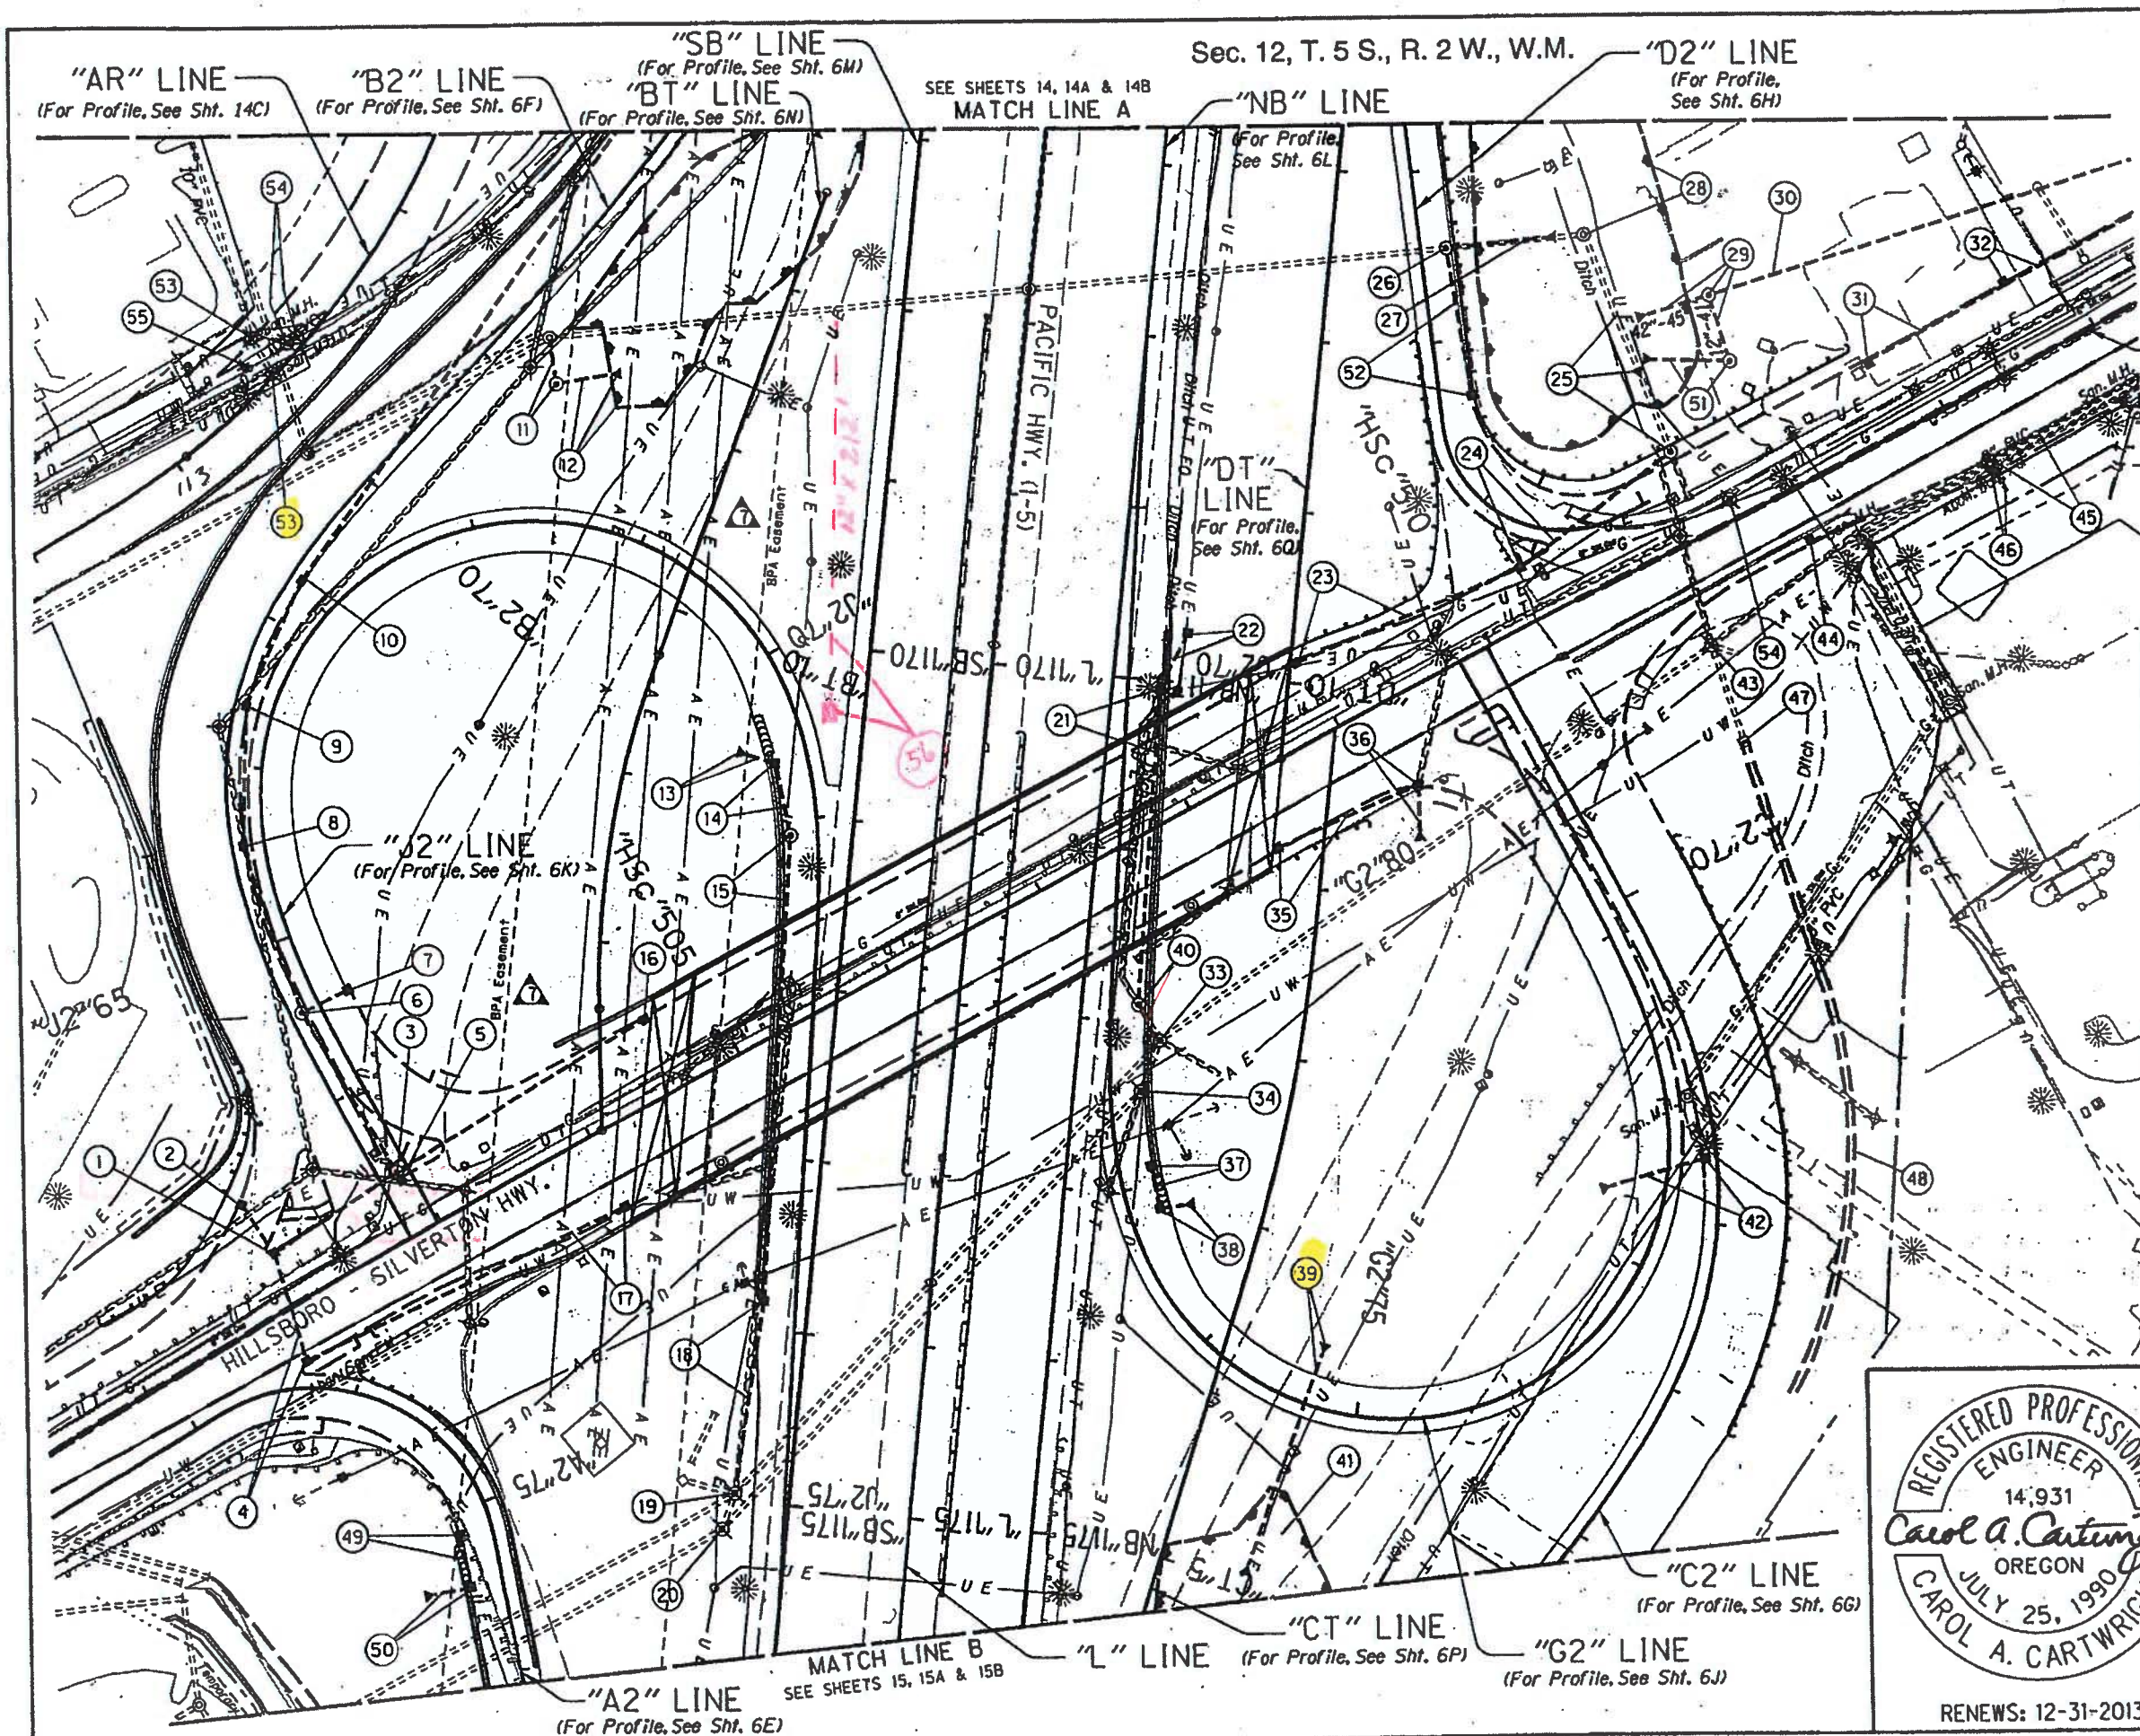

No.	DATE	REVISIONS	BY
7	5-21-13	Added BPA Easement	C.A.C.

REVISED AS CONSTRUCTED
CONTRACT

Plug and abandon extg. pipe shown thus:

Remove extg. inlet shown thus:

Remove extg. manhole shown thus:



RENEWS: 12-31-2013

OREGON DEPARTMENT OF TRANSPORTATION

REGION 2 TECH CENTER

FFO-15 @ OR214 INTERCHANGE
(WOODBURN) DEVELOPMENT SEC.
HILLSBORO - SILVERTON HIGHWAY
MARION COUNTY

Design Team Leader - Carol Cartwright
Designed By - John Lucas
Drafted By - Charlotte Gerken

DRAINAGE & UTILITIES

SHEET NO. **6B**

- ① See sht. 5B-2, note 17
Const. inlet
Inst. pipe
- ② See sht. 5B-2, note 18
Const. inlet
Inst. pipe
- ③ See sht. 5B-2, note 19
Const. manhole
Inst. pipe
- ④ See sht. 5B-2, note 32
Const. inlet
Inst. pipe
- ⑤ See sht. 5B-2, note 25
Const. inlet
Inst. pipe
- ⑥ See sht. 5B-2, note 20
Const. manhole
Inst. pipe
- ⑦ See sht. 5B-2, note 24
Const. inlet
Inst. pipe
- ⑧ See sht. 5B-2, note 21
Const. inlet
Inst. pipe
- ⑨ See sht. 5B-2, note 22
Const. inlet
Inst. pipe
- ⑩ See sht. 5B-2, note 23
Const. inlet
Inst. pipe
- ⑪ Sta. "B2"68+85.2 to Sta. "B2"68+67.6, Lt.
Const. manhole
Step orientation - 267°
Inst. 12" storm sew. pipe - 28'
5' depth
Connect to extg. manhole
- ⑫ Sta. "B2"68+85.2 to Sta. "B2"68+66.3, Lt.
Const. stormwater quality biofiltration swale no. 00642
Inst. 12" storm sew. pipe - 38' 3B'
5' depth
Const. paved end slope, Lt.
(For details, see sht. GJ- 2)
(See drg. nos. RD318, RD319 & RD320)
- ⑬ Sta. "J2"70+50.6 to Sta. "J2"70+63.9, Rt.
Inst. 18" storm sew. pipe - 22' 23'
5' depth
Const. paved end slope, Rt.
- ⑭ Sta. "J2"70+63.9 to Sta. "J2"71+10, Rt.
Const. type "G-2" inlet
Inst. 18" storm sew. pipe - 42' 44'
5' depth
- ⑮ Sta. "J2"71+10 to Sta. "J2"71+10, Rt.
Const. shallow manhole
Inst. 15" storm sew. pipe - 268'
5' depth
- ⑯ Sta. "B2"74+52.7 to Sta. "HSc"504+60.6, Lt.
Const. type "CG-2" inlet
Inst. 12" storm sew. pipe - 170'
5' depth
- ⑰ Sta. "HSc"501+91.5 to Sta. "HSc"503+98.5, Lt.
Const. type "CG-2" inlet
Adjust inlet
Inst. 12" storm sew. pipe - 205'
5' depth
(For details, see sht. 2B-15)
- ⑱ Sta. "J2"73+79.7 to Sta. "J2"74+95.2, Rt.
Const. type "G-2" inlet
Inst. 15" storm sew. pipe - 116'
5' depth
Connect to extg. manhole
- ⑲ Sta. "J2"74+95.2, Rt.
Minor adjust manhole
- ⑳ Sta. "J2"75+16.1, Rt.
Minor adjust manhole
- ㉑ Sta. "G2"70+05.4 to Sta. "G2"71+90.2, Lt.
Const. type "G-2" inlet
Inst. 18" storm sew. pipe - 183' 185'
5' depth
Connect to extg. manhole
- ㉒ Sta. "G2"69+71.7 to Sta. "G2"70+05.4, Lt.
Const. type "D" inlet
Inst. 18" storm sew. pipe - 34' 37'
5' depth
(See drg. no. RD370)
- ㉓ Sta. "HSc"508+95.2 to Sta. "HSc"510+36.4, Lt.
Const. type "CG-2" inlet
Inst. 12" storm sew. pipe - 143'
5' depth
- ㉔ Sta. "HSc"510+36.4 to Sta. "HSc"511+45.1, Lt.
Const. type "CG-2" inlet
Adjust inlet
Inst. 12" storm sew. pipe - 111'
5' depth
(For details, see sht. 2B-15)
- ㉕ Sta. "HSc"511+45.1, Lt.
Const. manhole, 48" dia. with tamperproof cover
Step orientation - 180°
Minor adjust manhole
48" conc. storm sew. pipe - 165' (In pl.)
Remove 95' Lt.
Extend 12" 10' depth
Const. paved end slope, Lt.
INST. 18" STORM SEW PIPE - 62'
- ㉖ Sta. "D2"67+46, Lt.
Const. flow control manhole, 108" dia.
Connect to extg. storm sew. pipe
(For details, see shts. GJ-7 & GJ-8)
- ㉗ Sta. "D2"67+46 to Sta. "D2"67+47.2, Lt.
Remove extg. pipe - 64'
Inst. 48" storm sew. pipe - 65' 46"
20' depth
Const. paved end slope, Lt.
(For details, see sht. GJ-3)
- ㉘ Sta. "D2"66+42 to Sta. "D2"69+94, Lt.
Remove extg. manhole
Const. stormwater control pond no. 00643
(For details, see sht. GJ-3)
- ㉙ Sta. "HSc"511+63.2 to Sta. "HSc"512+08.5, Lt.
Const. flow control manhole
Inst. 12" storm sew. pipe - 41'
10' depth
Inst. 42" storm sew. pipe - 45' 41'
10' depth
Const. paved end slope, Lt.
(For details, see sht. GJ-9)
- ㉚ Sta. "HSc"512+06.5 to Sta. "HSc"514+72.1, Lt.
Inst. 42" storm sew. pipe - 265' 270'
10' depth
- ㉛ Sta. "HSc"512+73.5 to Sta. "HSc"513+66.4, Lt.
Const. type "CG-2" inlet
Adjust inlet
Inst. 12" storm sew. pipe - 92'
5' depth
(For details, see sht. 2B-15)
- ㉜ Sta. "HSc"513+66.4 to Sta. "HSc"514+58.8, Lt.
Const. type "CG-2" inlet
Adjust inlet
Inst. 12" storm sew. pipe - 92'
5' depth
(For details, see sht. 2B-15)
- ㉝ Sta. "G2"72+11.2, Lt.
Major adjust manhole
- ㉞ Sta. "G2"72+42.2, Lt.
Major adjust manhole
- ㉟ Sta. "HSc"508+34.2 to Sta. "HSc"509+23.7, Rt.
Const. type "CG-2" inlet
Adjust inlet
Inst. 12" storm sew. pipe - 90'
5' depth
(For details, see sht. 2B-15)
- ①③⑥ Sta. "HSc"509+08.7 to Sta. "HSc"509+23.7, Rt.
Const. type "CG-2" inlet
Adjust inlet
Inst. 12" storm sew. pipe - 31' 33'
5' depth
Const. paved end slope, Rt.
(For details, see sht. 2B-15)
- ①③⑦ Sta. "G2"72+88.4 to Sta. "G2"73+15.8, Lt.
Const. type "G-2" inlet
Inst. 12" slotted drain pipe - 25'
5' depth
(See drg. no. RD328)
- ①③⑧ Sta. "G2"73+15.8 to Sta. "G2"73+20, Lt.
Const. type "G-2" inlet
Inst. 12" storm sew. pipe - 20'
5' depth
Const. paved end slope
- ①③⑨ Sta. "G2"74+69.3
Inst. 18" culv. pipe - 142'
5' depth
Const. paved end slope, Lt. & Rt.
- ①④① Sta. "G2"71+90.2, Lt.
Const. shallow manhole
Connect to extg. storm sew.
INST. 12" STORM SEW PIPE - 23'
- ①④② Sta. "C2"74+38 to Sta. "C2"78+35, Rt.
Const. stormwater quality biofiltration swale no. 00641
(For details, see sht. GJ)
- ①④③ Sta. "G2"77+40, Lt. to Sta. "C2"71+60.7, Rt.
Const. type "G-2" inlet
Inst. 12" storm sew. pipe - 63'
5' depth
Const. paved end slope
- ①④④ Sta. "HSc"511+14.5, Rt.
Major adjust manhole
- ①④⑤ Sta. "HSc"511+93.7 to Sta. "HSc"513+08, Rt.
Const. type "CG-2" inlet
Adjust inlet
Inst. 12" storm sew. pipe - 115'
5' depth
(For details, see sht. 2B-15)
- ①④⑥ Sta. "HSc"513+08 to Sta. "HSc"514+03.7, Rt.
Const. manhole
Step orientation - 269°
Inst. 12" storm sew. pipe - 96'
5' depth
Minor AD. 111' 112'
- ①④⑦ Sta. "HSc"513+08 to Sta. "HSc"513+08.4, Rt.
Remove extg. inlet
Const. type "CG-2" inlet
Adjust inlet
Inst. 12" storm sew. pipe - 7'
5' depth
(For details, see sht. 2B-15)
- ①④⑧ Sta. "HSc"511+14.5, Rt.
Adjust inlet
- ①④⑨ Sta. "C2"69+53.5 to Sta. "C2"73+70, Lt.
Const. ditch
3' flat bottom, 1:4 slopes
Dt. exc. - 54 cu. yd.
(For details, see sht. 2B-12)
- ①⑤① Sta. "A2"75+15.4 to Sta. "A2"75+47.4, Rt.
Const. type "G-2" inlet
Inst. 12" slotted drain pipe - 31'
5' depth
- ①⑤② Sta. "A2"75+47.4, Rt.
Const. type "G-2" inlet
Inst. 12" storm sew. pipe - 28'
5' depth
Const. paved end slope, Rt.
- ①⑤③ Sta. "HSc"511+55.7 to Sta. "HSc"512+01.5, Lt.
Const. manhole
Step orientation - 224°
Inst. 12" storm sew. pipe - 51'
10' depth
Const. paved end slope, Lt.
(For details, see sht. GJ-3)
- ①⑤④ Sta. "D2"67+46 to Sta. "D2"68+33.2, Lt.
Const. type "CG-2" inlet
Inst. 12" storm sew. pipe - 87'
5' depth
- ①⑤⑤ Minor adjust manhole - 112+21.6
(For details, see sht. 2B-23)
MAJOR ADJ. MH "A2" 112+15 RT
- ①⑤⑥ Adjust manhole - 3 (By others)
- ①⑤⑦ Adjust water valve box
(For details, see sht. 2B-22)

REVISED AS CONSTRUCTED
CONTRACT

No.	DATE	REVISIONS	BY
①	4-18-13	Edited text	J.O.L.
②	5-21-13	Edited text	C.A.C.



RENEWS: 12-31-2013

OREGON DEPARTMENT OF TRANSPORTATION

REGION 2 TECH CENTER


FFO-15 @ OR214 INTERCHANGE (WOODBURN) DEVELOPMENT SEC. HILLSBORO - SILVERTON HIGHWAY MARION COUNTY

Design Team Leader - Carol Cartwright
Designed By - John Lucas
Drafted By - Charlotte Gerken

DRAINAGE NOTES

SHEET NO. **6B-2**

Sec. 12, T. 5 S., R. 2 W., W.M.

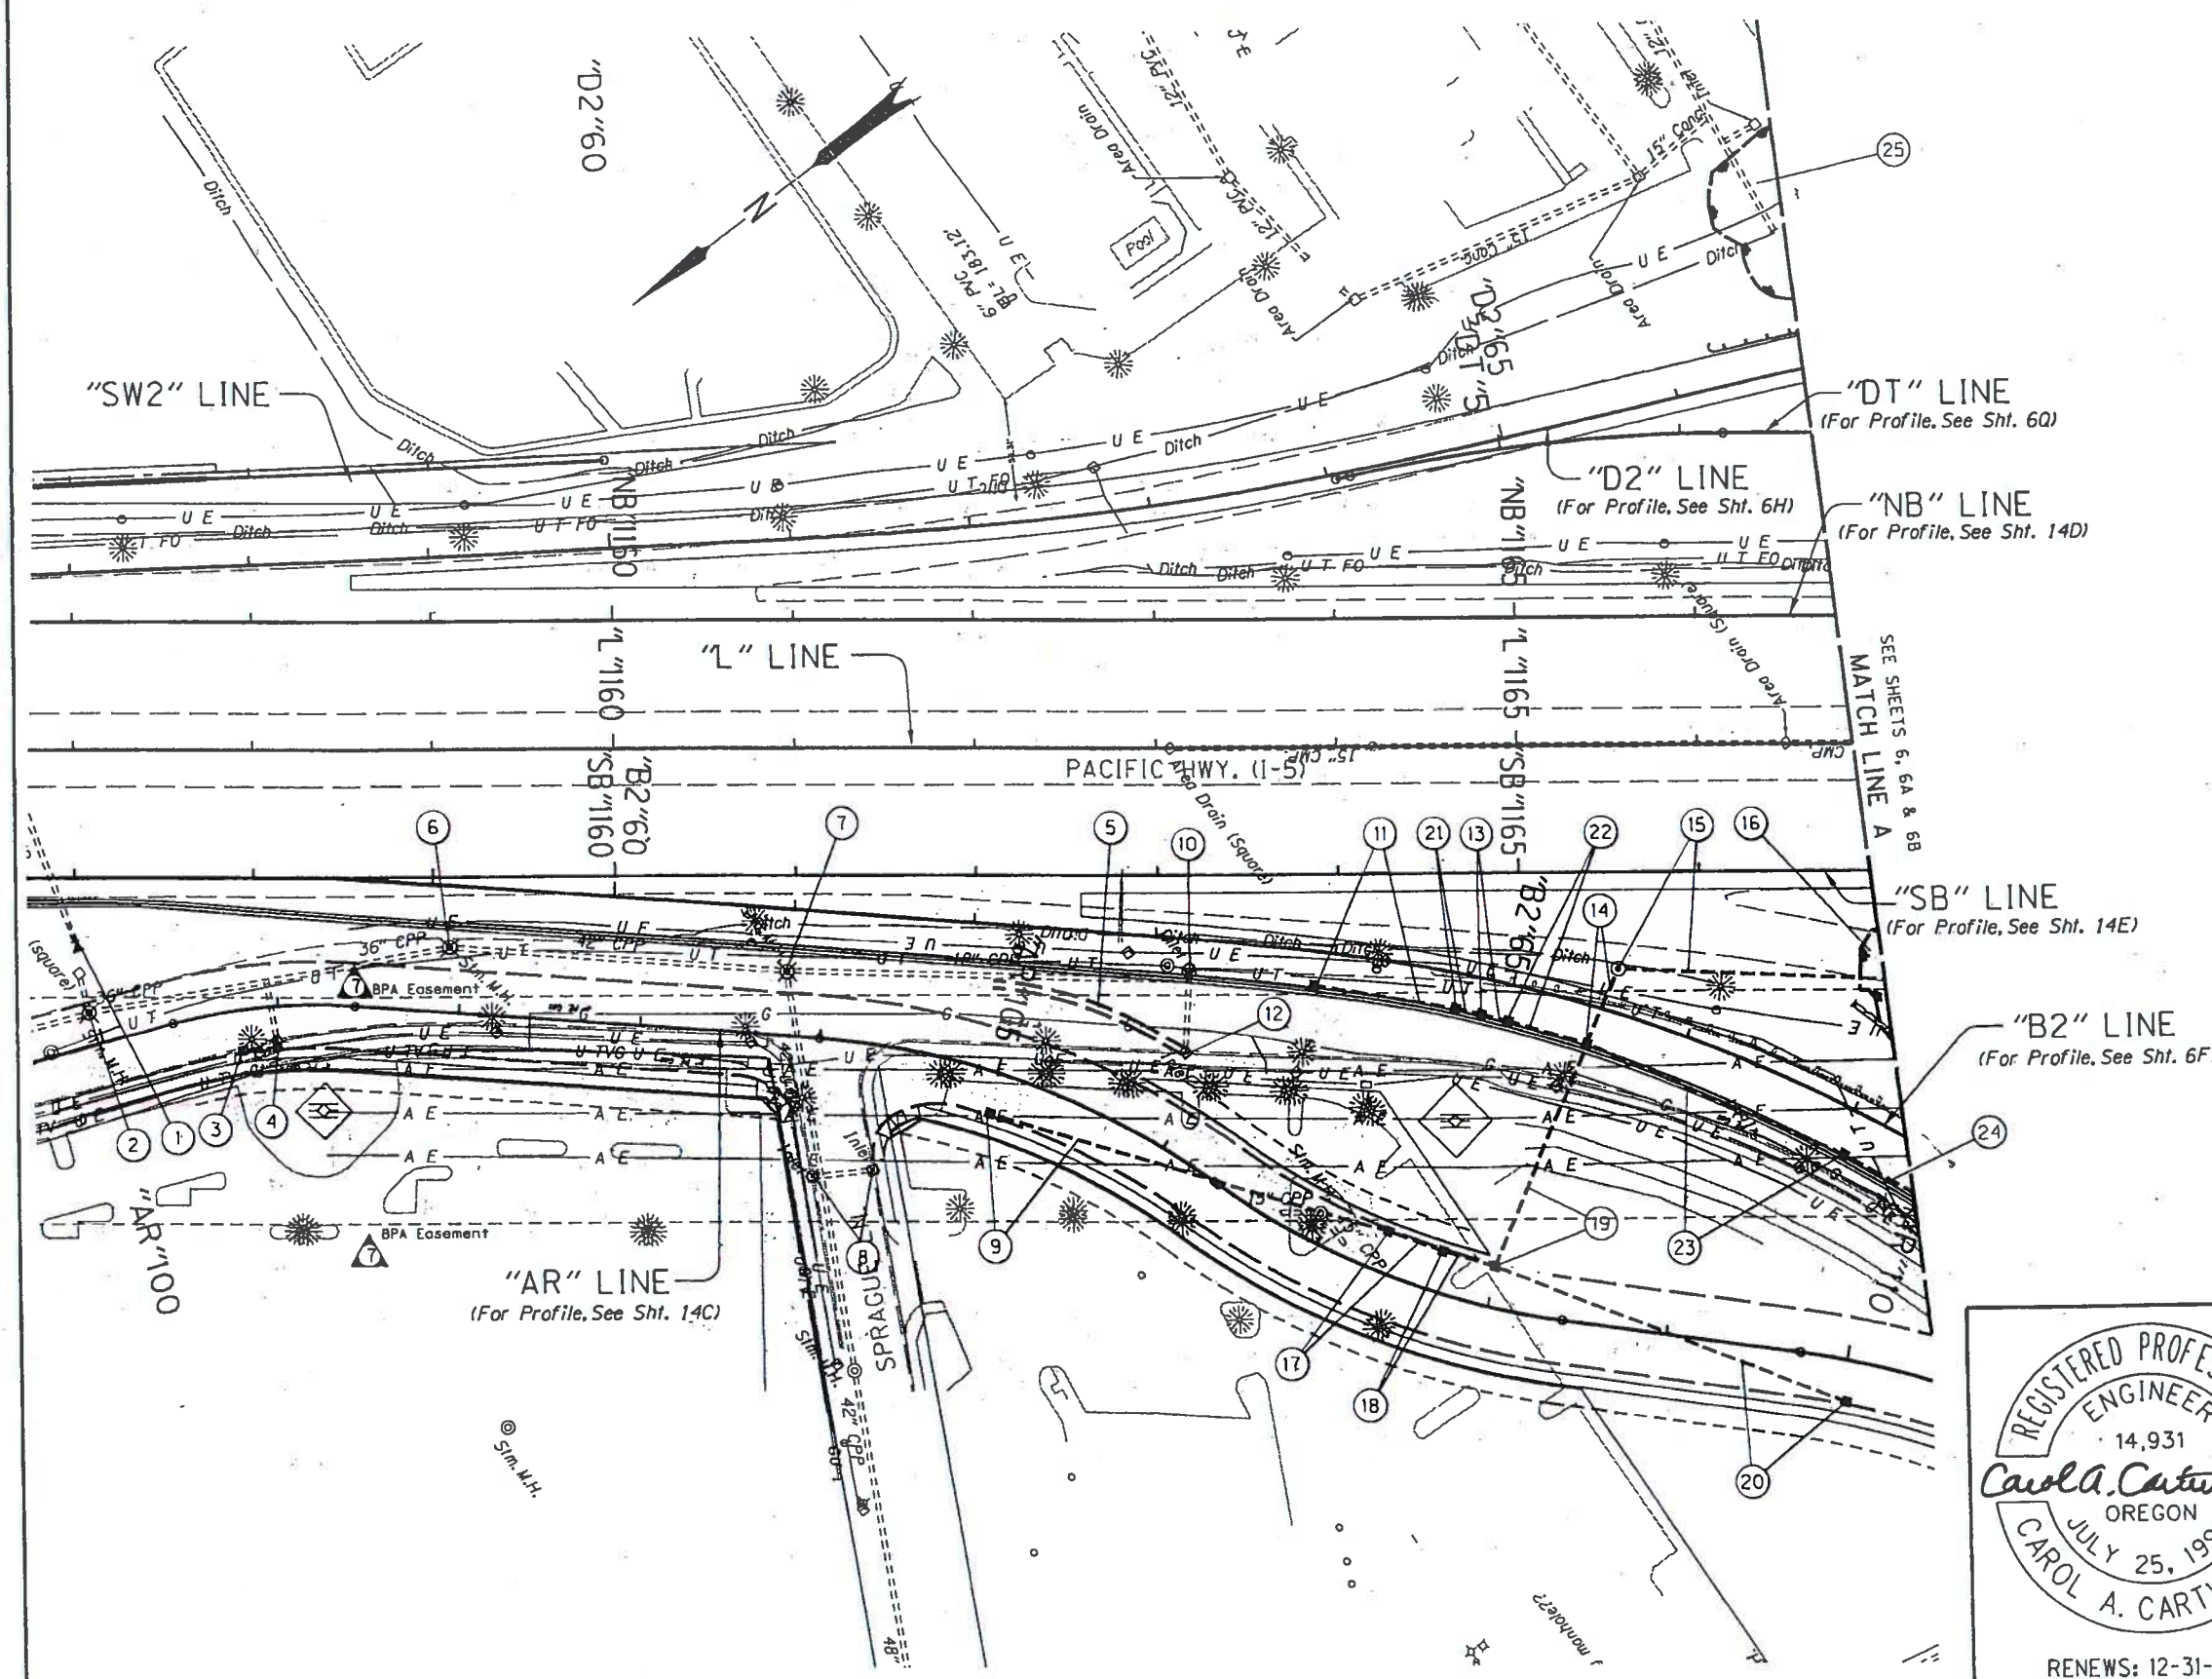

No.	DATE	REVISIONS	BY
7	5-21-13	Added BPA Easement	C.A.C.

NOT REVISED AS CONSTRUCTED
CONTRACT



RENEWS: 12-31-2013

OREGON DEPARTMENT OF TRANSPORTATION

REGION 2 TECH CENTER

FFO - I-5 @ OR214 INTERCHANGE
(WOODBURN) DEVELOPMENT SEC.
HILLSBORO - SILVERTON HIGHWAY
MARION COUNTY

Design Team Leader - Carol Cartwright
Designed By - John Lucas
Drafted By - Charlotte Garken

DRAINAGE & UTILITIES

SHEET NO. 14B

- ① See sht. 13A, note 3
Inst. pipe
- ② See sht. 13A, note 4
Adjust manhole
- ③ Sta. "AR"100+76.8 to Sta. "AR"100+98.2, Rt.
Const. type "CG-2" inlet
Inst. 12" storm sew. pipe - 20'
5' depth
- ④ Sta. "AR"100+98.2, Rt.
Remove inlet
Const. type "CG-2" Inlet
12" CPP storm sew. pipe - 32' (In pl.)
Remove - 3'
Extend - 8' Rt., 5' depth
- ⑤ Sta. "AR"100+68 to Sta. "AR"105+00, Lt.
Const. ditch
"V" bottom, 1:3 slopes
Dt. exc. - 62 cu. yd.
(For details, see sht. 2B- 12)
- ⑥ Sta. "AR"100+93, Lt.
Major adjust manhole
MINOR
- ⑦ Sta. "AR"103+79.4, Lt.
Major adjust manhole
- ⑧ Sta. "SL"9+23.6 to Sta. "SL"9+25.6, Lt. & Rt.
Adjust inlet - 2
- ⑨ Sta. "AR"105+02.8, Rt. to Sta. "AR"107+33.6, Lt.
Const. type "CG-2" inlet
Inst. 12" storm sew. pipe - 228'
5' depth
- ⑩ Sta. "B2"63+20, Rt.
Remove Inlet
~~Const. manhole 24" dia.~~
- ⑪ Sta. "B2"63+90 to Sta. "B2"64+70.5, Rt.
Const. type "G-2" inlet
Inst. 15" storm sew. pipe - 79'
5' depth
- ⑫ Sta. "AR"105+85.2, Lt.
~~Adjust Inlet~~
REMOVE EXIST. INLET
CONSTR. G-2 DIA. INLET
- ⑬ Sta. "B2"64+85.9 to Sta. "B2"65+01.3, Rt.
Const. type "G-2" Inlet
Inst. 18" storm sew. pipe - 15'
5' depth
- ⑭ Sta. "B2"65+47.7 Rt. to Sta. "B2"65+52.7, Lt.
Const. type "G-2" inlet
Inst. 24" storm sew. pipe - 45'
5' depth
- ⑮ Sta. "B2"65+52.7 to Sta. "B2"66+85.3, Lt.
Const. shallow manhole
Inst. 24" storm sew. pipe - ~~48'~~ 49'
5' depth
Const. paved end slope, Lt.
- ⑯ See sht. 6B-2, note 12
Const. pond
- ⑰ Sta. "AR"107+33.6 to Sta. "AR"107+67.5, Lt.
Const. type "CG-2" inlet
Inst. 18" storm sew. pipe - 32'
5' depth
- ⑱ Sta. "AR"107+67.5 to Sta. "AR"107+99.3, Lt.
Const. type "CG-2" Inlet
Inst. 18" storm sew. pipe - 30'
5' depth
- ⑲ Sta. "AR"107+99.3 Lt. to Sta. "B2"65+47.7, Rt.
Const. type "CG-2" Inlet
Inst. 18" storm sew. pipe - 133'
5' depth
- ⑳ Sta. "AR"107+99.3 to Sta. "AR"110+03.8, Lt.
Const. type "CG-2" inlet
Inst. 12" storm sew. pipe - 207'
5' depth
- ㉑ Sta. "B2"64+70.5 to Sta. "B2"64+85.9, Rt.
Const. type "G-2" inlet
Inst. 15" storm sew. pipe - 15'
5' depth
- ㉒ Sta. "B2"65+01.3 to Sta. "B2"65+47.7, Rt.
Const. type "G-2" inlet
Inst. 18" storm sew. pipe - 45'
5' depth
- ㉓ Sta. "B2"65+47.7 to Sta. "B2"67+06, Rt.
Const. type "G-2" inlet
Inst. 18" storm sew. pipe - 154'
5' depth
- ㉔ See sht. 5B-2, note 23
Inst. pipe
- ㉕ See sht. 6B-2, note 28
Const. pond

REVISED AS CONSTRUCTED
~~CONTACT~~



OREGON DEPARTMENT OF TRANSPORTATION	
REGION 2 TECH CENTER	
FFO-15 @ OR214 INTERCHANGE (WOODBURN) DEVELOPMENT SEC. HILLSBORO - SILVERTON HIGHWAY MARION COUNTY	
Design Team Leader - Carol Cartwright Designed By - John Lucas Drafted By - Charlotte Gerken	
DRAINAGE NOTES	SHEET NO. 14B-2